

INDEX TO DRAWINGS	
SHEET NO.	DESCRIPTION
1	TITLE SHEET
2-4	LIST OF DRAWINGS
5	ABBREVIATIONS
6	STANDARD PLANS SUMMARY
7-15	TOPOGRAPHIC SURVEY
16-41	BORING LOGS
42-93	CIVIL - VIADUCT PLANS & DETAILS
94-132	CIVIL - ACCESS ROAD PLANS & DETAILS
133-182	CIVIL - STREAM IMPROVEMENT PLANS & DET.
183-233	CIVIL - CROSS SECTIONS
234-591	STRUCTURAL - VIADUCT PLANS & DETAILS
592-618	ELECTRICAL - PLANS & DETAILS
① ② ③	

PLAN SHT NOS. ① 235 S-1, ② 476 A, & ③ 364 S-1,
368 S-1, 372 S-1, 376 S-1, 380 S-1, 384 S-1,
388 S-1, 391 S-1, 395 S-1, 400 S-1, 405 S-1,
410 S-1, 415 S-1, 420 S-1, 425 S-1, 430 S-1,
435 S-1, 440 S-1, 445 S-1, 450 S-1, 455 S-1, 460 S-1,
465 S-1, 470 S-1, 475 S-1, 480 S-1, 485 S-1, 490 S-1,
495 S-1, 500 S-1, 505 S-1, 510 S-1, 515 S-1 ARE
SUPPLEMENTARY SHEETS TO THIS PROJECT,
ADDED DURING ADDENDUM & "AS BUILT"
POSTINGS.

TOTAL SHEET COUNT AFTER ADDENDUM &
"AS BUILT" POSTINGS IS 650 SHEETS.

NAKAMURA & TYAU, INC.
DESIGNED BY
G. YAMAMOTO
P. S. & E. BY
548-6156
PHONE
APRIL 15, 1991
DATE

STATE OF HAWAII

DEPARTMENT OF TRANSPORTATION

HIGHWAYS DIVISION

HONOLULU, HAWAII

"AS BUILT"

PLANS FOR

CONSTRUCTION OF A PORTION OF


INTERSTATE ROUTE H-3

NORTH HALAWA VALLEY VIADUCT

FEDERAL AID INTERSTATE PROJECT NO. I-H3-1(71)

DISTRICT OF EWA

ISLAND OF OAHU

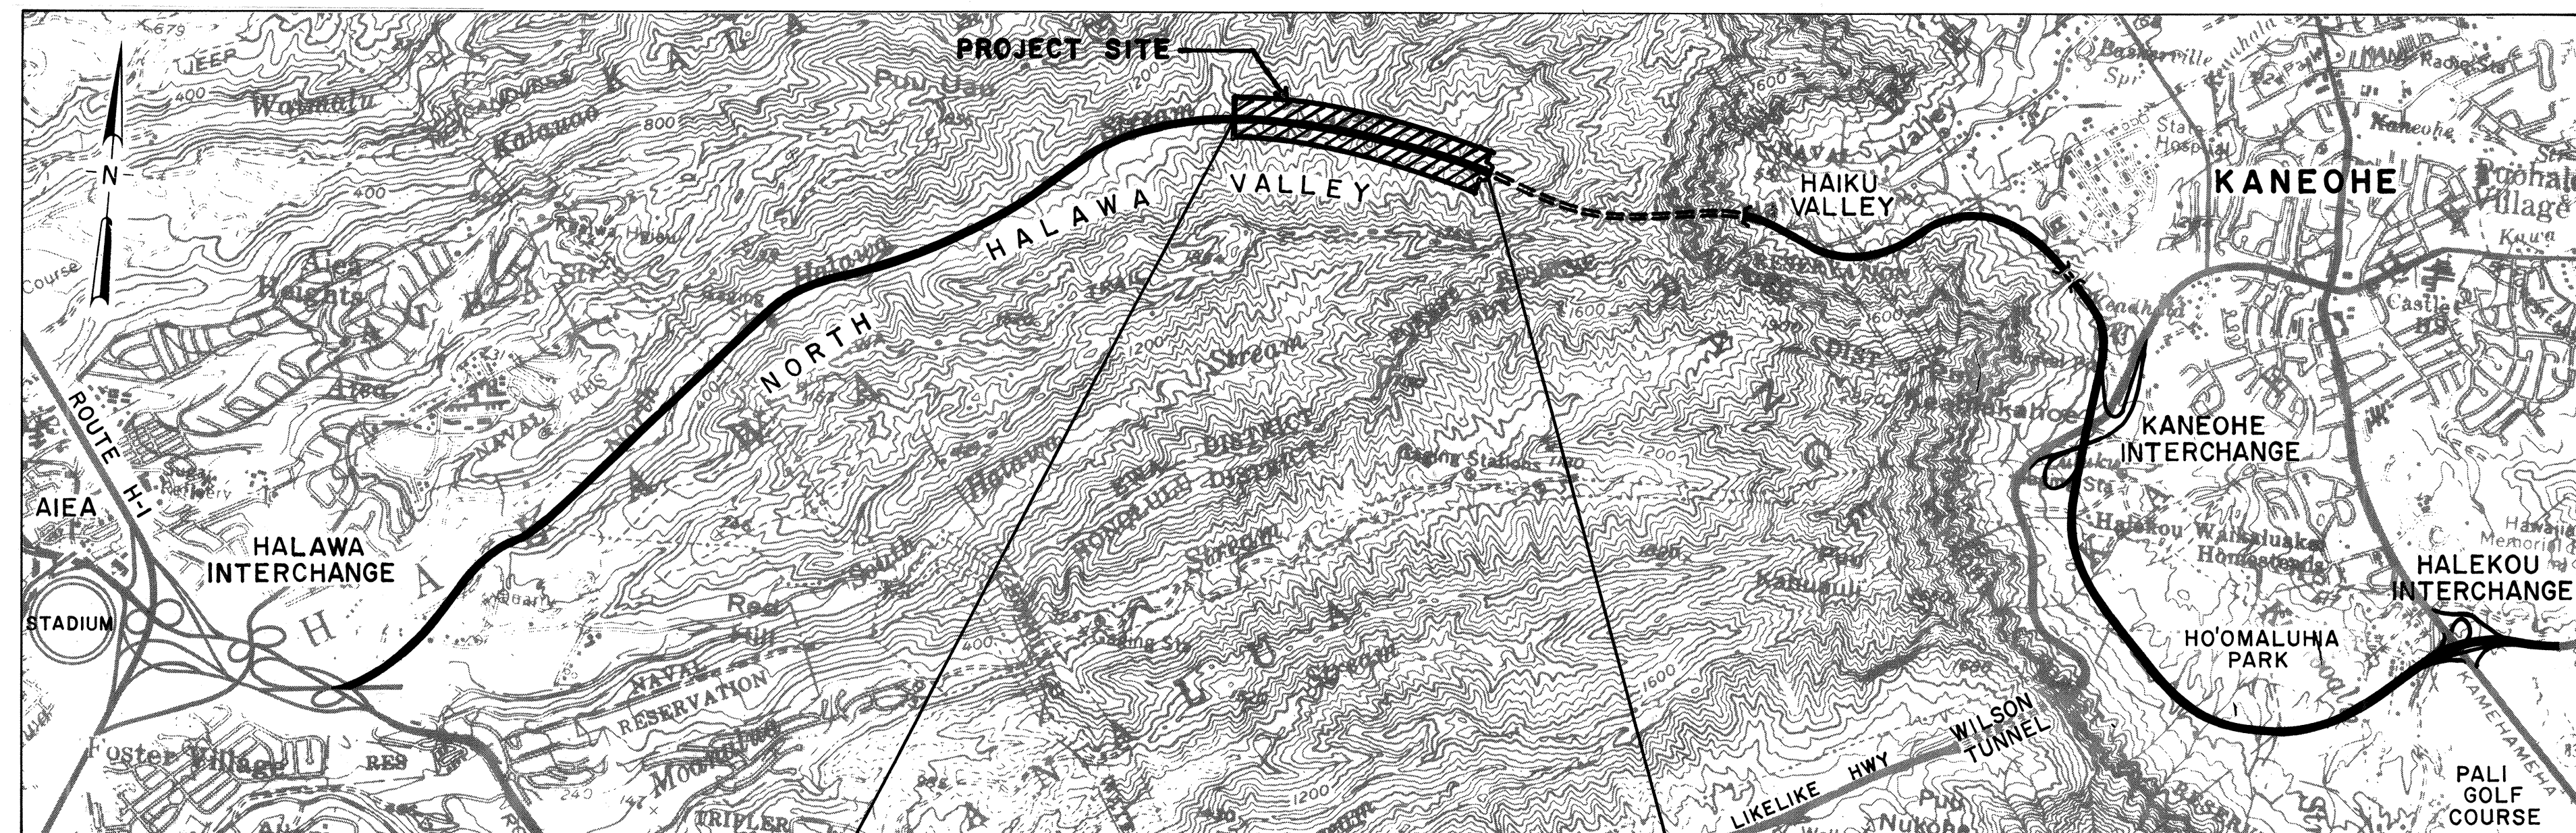


BEGIN PROJECT
I. B. STA 534 + 22.93
O.B. STA 534 + 58.24

END PROJECT
I. B. STA 599 + 95.00
O.B. STA 594 + 50.00

LAYOUT PLAN

1/2 0 1/2
SCALE IN MILES

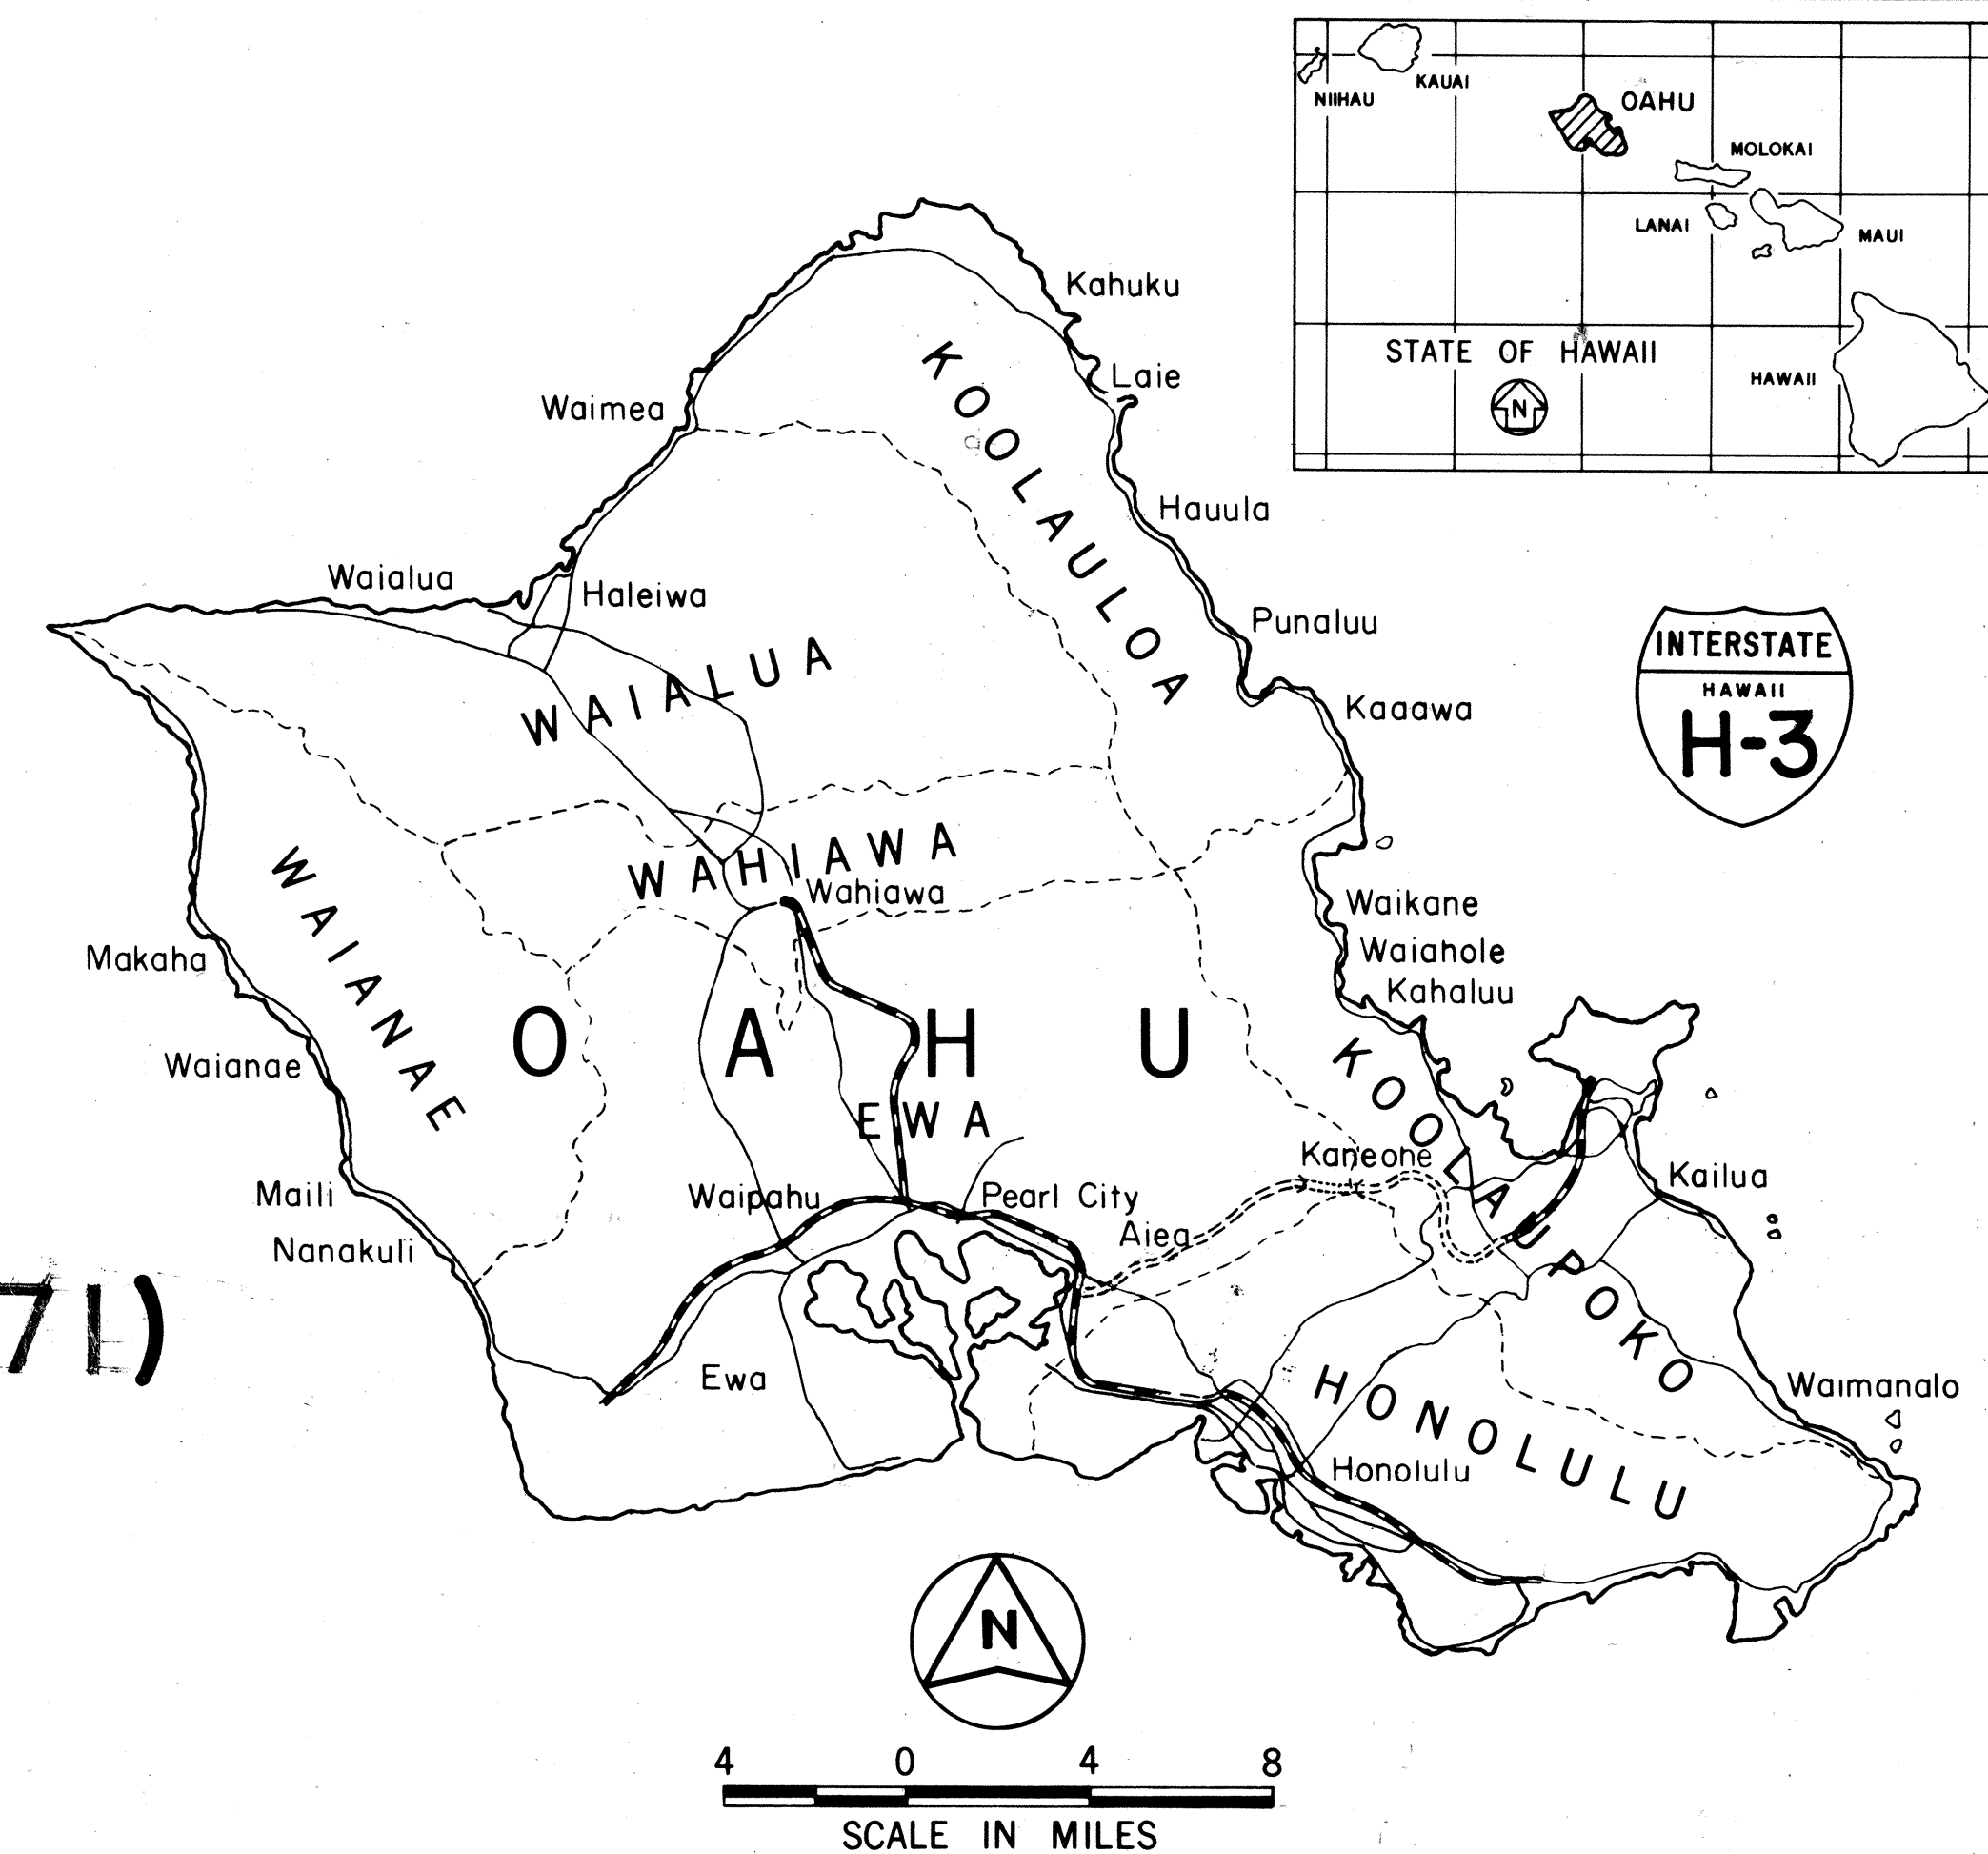

FEDERAL AID INTERSTATE PROJECTS PREVIOUSLY CONSTRUCTED
OR UNDER CONSTRUCTION

DESIGN CLASSIFICATION

DESIGN ADT (2,008).....45,220
DHV.....4282
D.....76/24
T.....2.1 %
T24.....4.1 %
V.....60 MPH

ALL CHANGES MADE DURING CONSTRUCTION HAVE
BEEN INCORPORATED ON THESE PLANS IN RED
EXCEPT CHANGES IN THE ORIGINAL THEORETICAL
QUANTITIES. FOR ACTUAL QUANTITIES, REFER TO
PROJECT LEDGER AND/OR COMPUTATION BOOK.

[Signature]
RESIDENT ENGINEER

01/03/02
DATE

DEPARTMENT OF TRANSPORTATION
FEDERAL HIGHWAY ADMINISTRATION
APPROVED:
[Signature] 5/30/91
DIVISION ADMINISTRATOR DATE

DEPARTMENT OF TRANSPORTATION
STATE OF HAWAII
APPROVED:
[Signature] 5/3/91
DIR. OF TRANSPORTATION DATE