










| FED. ROAD DIST. NO. | STATE | FED. AID PROJ. NO. | FISCAL YEAR | SHEET NO. | TOTAL SHEETS |
|---------------------|-------|--------------------|-------------|-----------|--------------|
| HAWAII              | HAW   | I-H3-1(66)         | 1992        | 401       | 440          |

TYPE "N"  
(RED/NON)  
REFLECTIVE  
MARKERS

TYPE "M"  
CLEAR/NON  
REFLECTIVE  
MARKERS

# PAVEMENT MARKER ARROW DETAIL

NTS


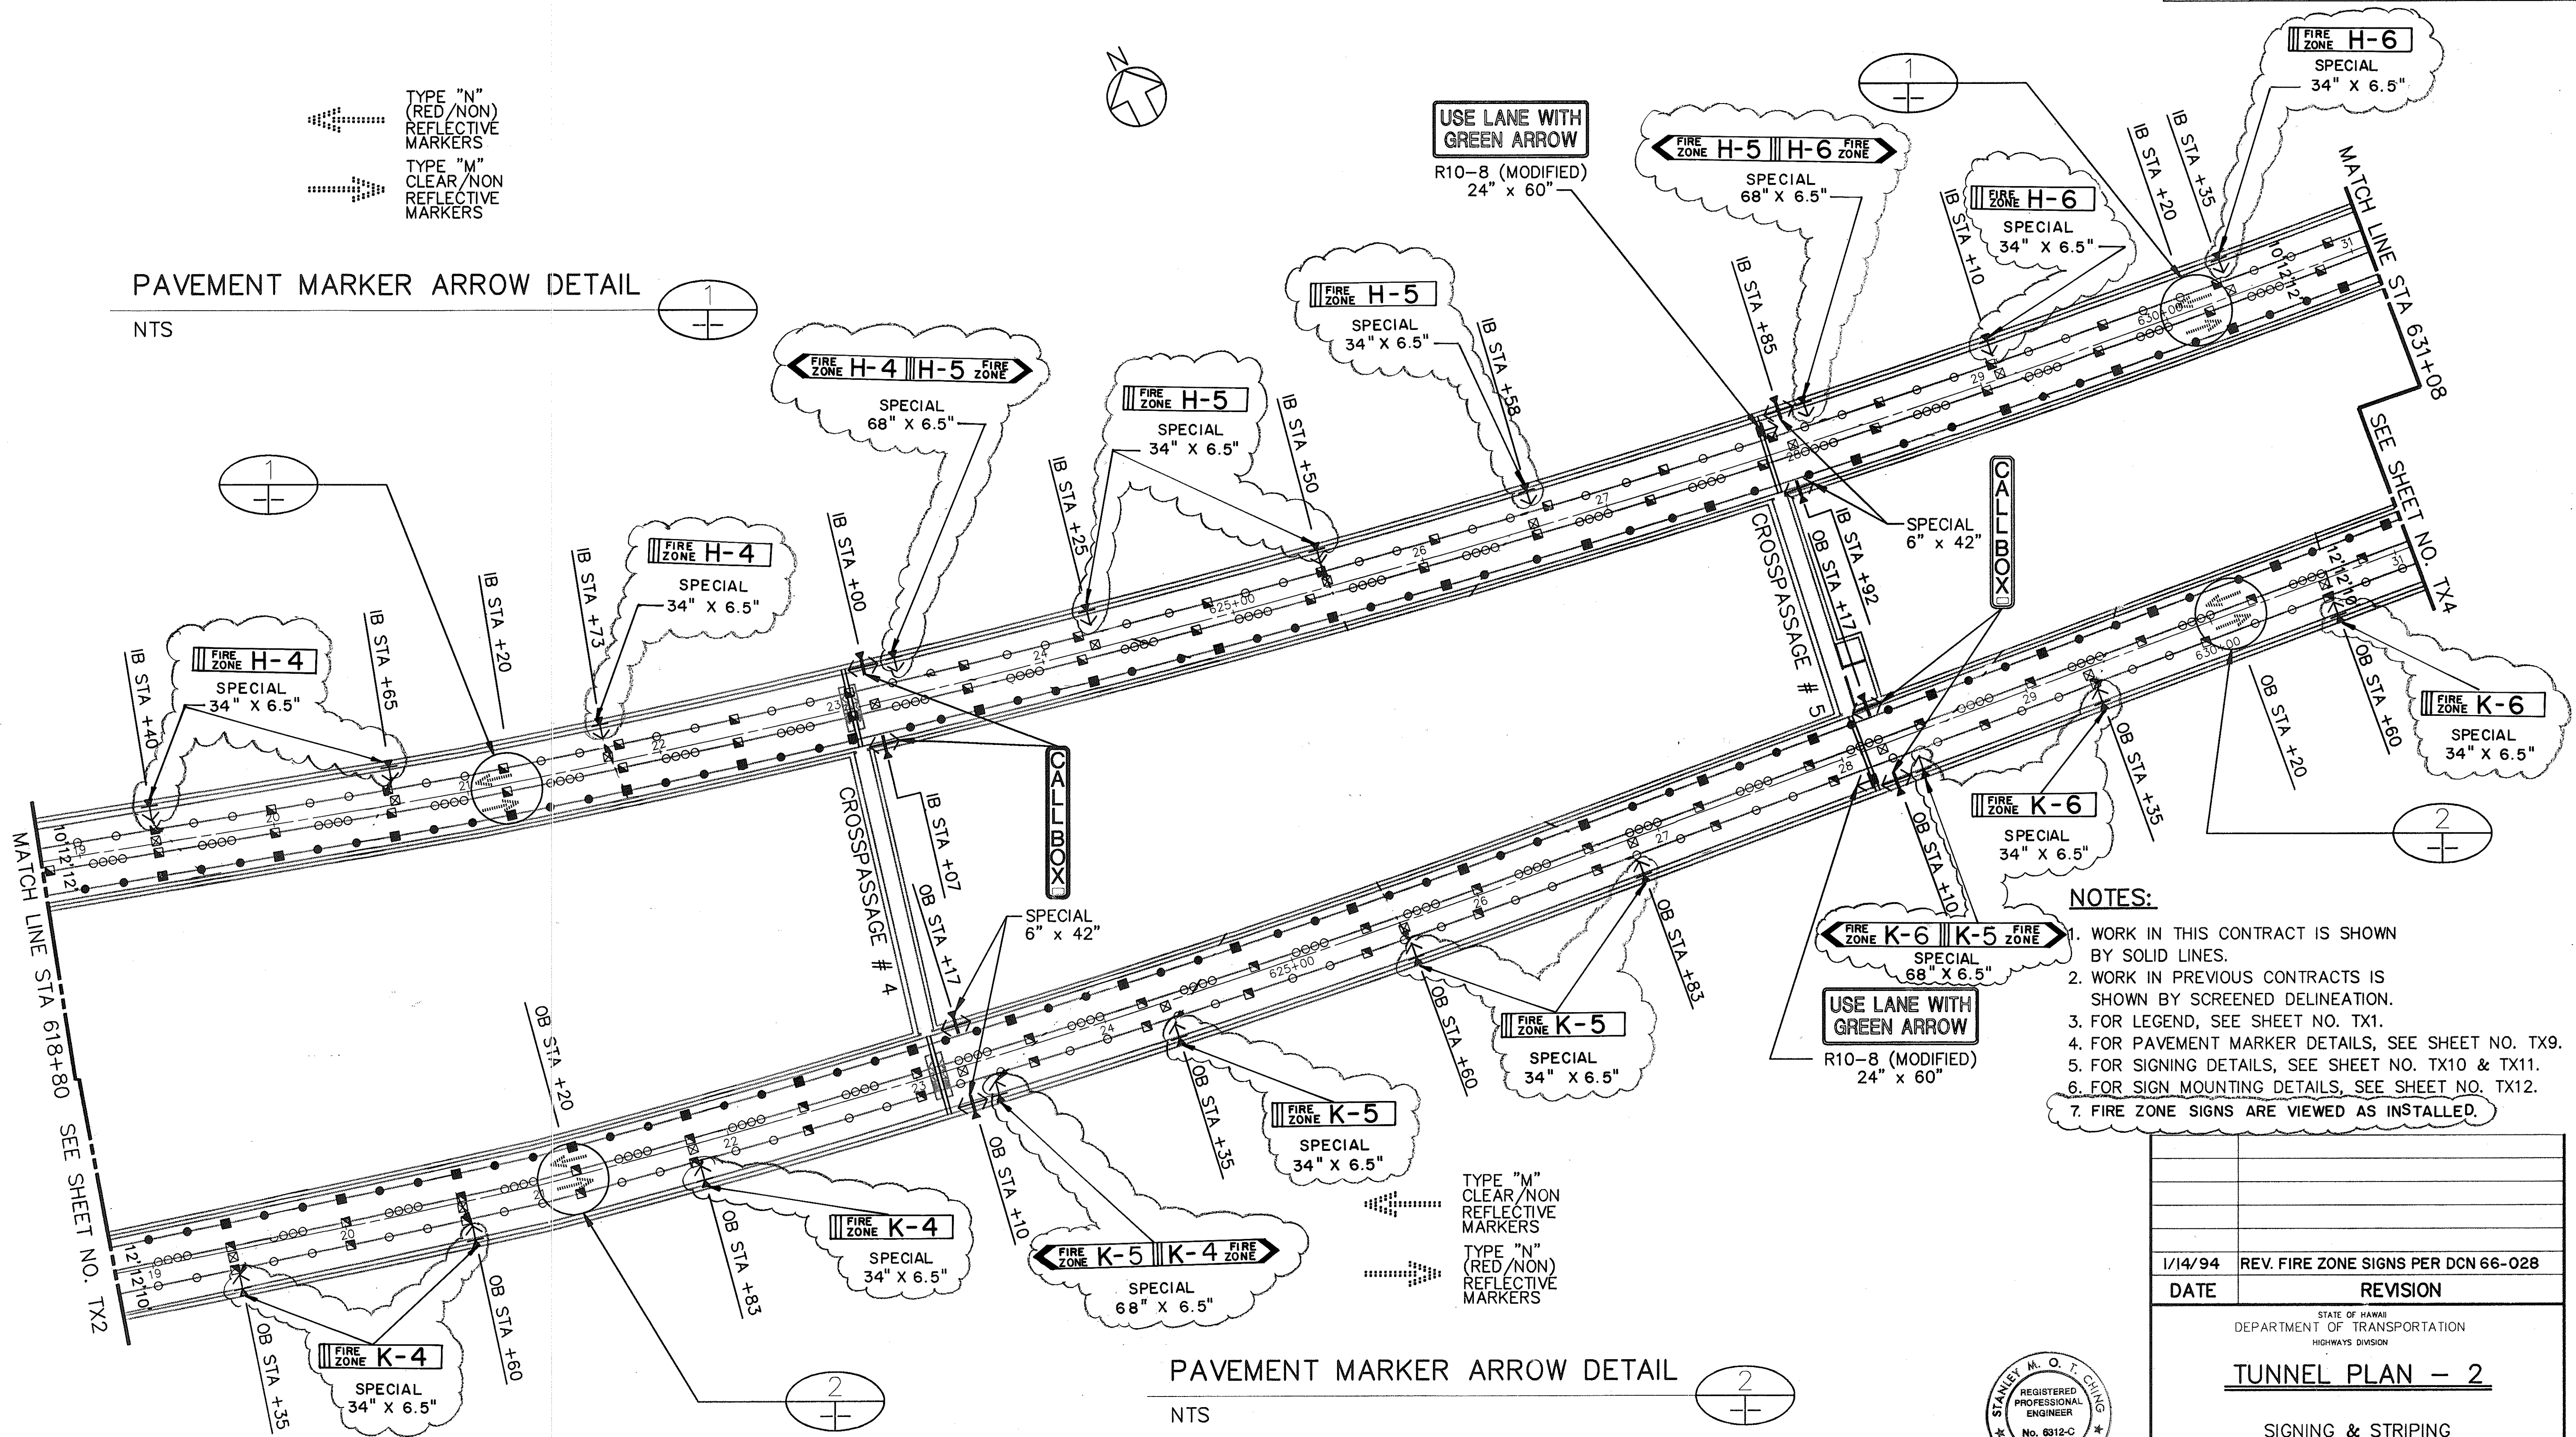


- NOTES:**
1. WORK IN THIS CONTRACT IS SHOWN BY SOLID LINES.
  2. WORK IN PREVIOUS CONTRACTS IS SHOWN BY SCREENED DELINEATION.
  3. FOR LEGEND, SEE SHEET NO. TX1.
  4. FOR PAVEMENT MARKER DETAILS, SEE SHEET NO. TX9.
  5. FOR SIGNING DETAILS, SEE SHEET NO. TX10 & TX11.
  6. FOR SIGN MOUNTING DETAILS, SEE SHEET NO. TX12.
  7. FIRE ZONE SIGNS ARE VIEWED AS INSTALLED.

|                   |              |
|-------------------|--------------|
| DATE              | 12/12/91     |
| SURVEY PLOTTED BY | CAUD         |
| DRAWN BY          | N. TRAN      |
| DESIGNED BY       | D. MCCORMICK |
| CHECKED BY        |              |
| ORIGINAL PLAN     |              |
| NOTEBOOK          |              |
| No.               |              |

# PAVEMENT MARKER ARROW DETAIL

NTS

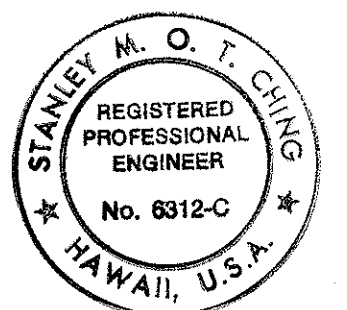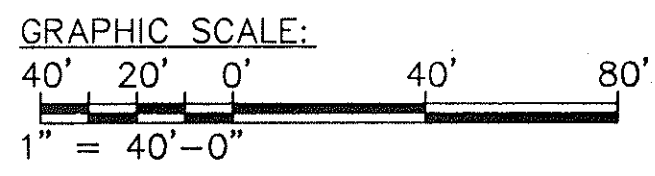

THIS WORK WAS PREPARED BY ME  
OR UNDER MY SUPERVISION  
*Stanley M. O. T. Chang*

|                                                                      |                                     |
|----------------------------------------------------------------------|-------------------------------------|
| 1/14/94                                                              | REV. FIRE ZONE SIGNS PER DCN 66-028 |
| DATE                                                                 | REVISION                            |
| STATE OF HAWAII<br>DEPARTMENT OF TRANSPORTATION<br>HIGHWAYS DIVISION |                                     |
| <b>TUNNEL PLAN - 2</b>                                               |                                     |
| SIGNING & STRIPING                                                   |                                     |
| INTERSTATE ROUTE H-3                                                 |                                     |
| F.A.I. PROJ. NO. I-H3-1(66)                                          |                                     |
| SCALE: 1" = 40'-0"                                                   | DATE: APR 1992                      |
| SHEET NO. TX3 OF 12 SHEETS                                           |                                     |



| FED. ROAD DIST. NO. | STATE | FED. AID PROJ. NO. | FISCAL YEAR | SHEET NO. | TOTAL SHEETS |
|---------------------|-------|--------------------|-------------|-----------|--------------|
| HAWAII              | HAW   | I-H3-1(66)         | 1992        | 402       | 440          |

TYPE "N"  
(RED/NON)  
REFLECTIVE  
MARKERS

TYPE "M"  
(CLEAR/NON)  
REFLECTIVE  
MARKERS

PAVEMENT MARKER ARROW DETAIL


NTS

TYPE "M"  
(CLEAR/NON)  
REFLECTIVE  
MARKERS

TYPE "N"  
(RED/NON)  
REFLECTIVE  
MARKERS

PAVEMENT MARKER ARROW DETAIL

NTS

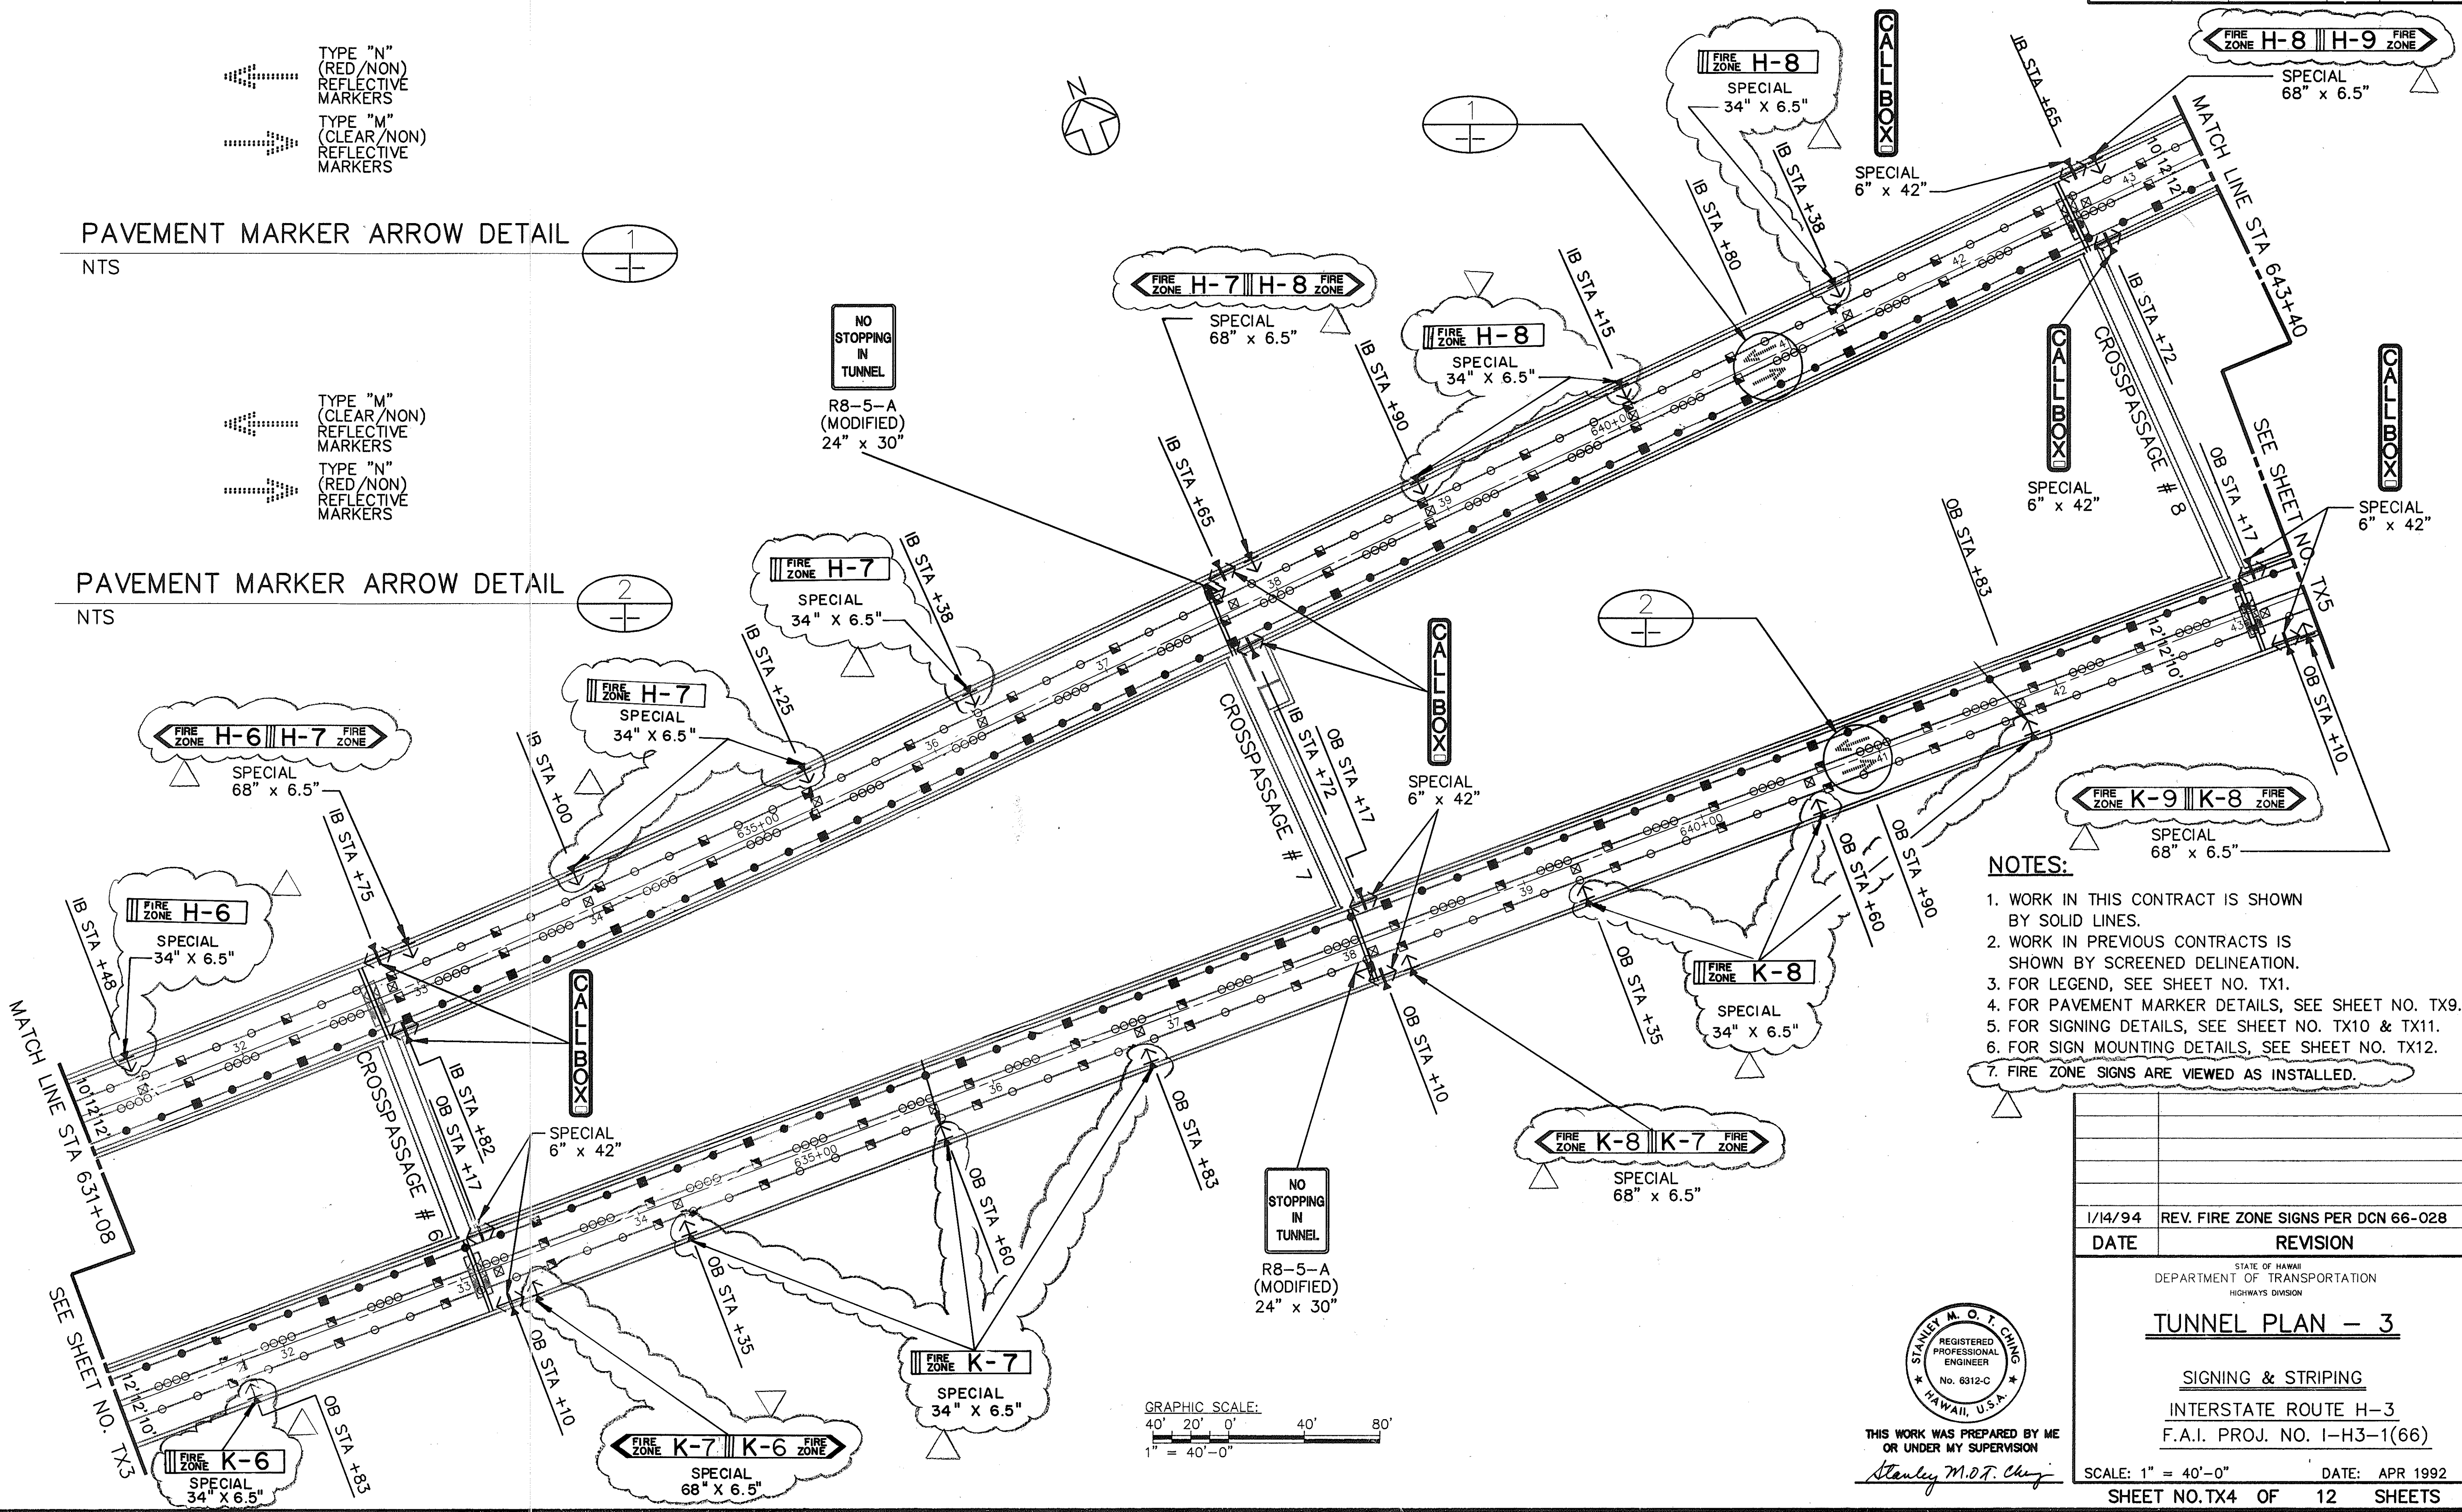

- NOTES:
1. WORK IN THIS CONTRACT IS SHOWN BY SOLID LINES.
  2. WORK IN PREVIOUS CONTRACTS IS SHOWN BY SCREENED DELINEATION.
  3. FOR LEGEND, SEE SHEET NO. TX1.
  4. FOR PAVEMENT MARKER DETAILS, SEE SHEET NO. TX9.
  5. FOR SIGNING DETAILS, SEE SHEET NO. TX10 & TX11.
  6. FOR SIGN MOUNTING DETAILS, SEE SHEET NO. TX12.
  7. FIRE ZONE SIGNS ARE VIEWED AS INSTALLED.


|                   |          |
|-------------------|----------|
| SURVEY PLOTTED BY | DATE     |
| DRAWN BY          | 12/12/91 |
| DESIGNED BY       | 12/12/91 |
| QUANTITIES BY     | 12/12/91 |
| CHECKED BY        | 12/12/91 |
| ORIGINAL PLAN     |          |
| NOTEBOOK          |          |
| No.               |          |

|                                                                      |                                     |
|----------------------------------------------------------------------|-------------------------------------|
| 1/14/94                                                              | REV. FIRE ZONE SIGNS PER DCN 66-028 |
| DATE                                                                 | REVISION                            |
| STATE OF HAWAII<br>DEPARTMENT OF TRANSPORTATION<br>HIGHWAYS DIVISION |                                     |
| TUNNEL PLAN - 3                                                      |                                     |
| SIGNING & STRIPING                                                   |                                     |
| INTERSTATE ROUTE H-3                                                 |                                     |
| F.A.I. PROJ. NO. I-H3-1(66)                                          |                                     |
| SCALE: 1" = 40'-0"                                                   | DATE: APR 1992                      |
| SHEET NO. TX4 OF 12 SHEETS                                           |                                     |

STANLEY M. O. T. CHING  
REGISTERED PROFESSIONAL ENGINEER  
No. 6312-C  
HAWAII, U.S.A.

THIS WORK WAS PREPARED BY ME  
OR UNDER MY SUPERVISION

Stanley M.O.T. Ching

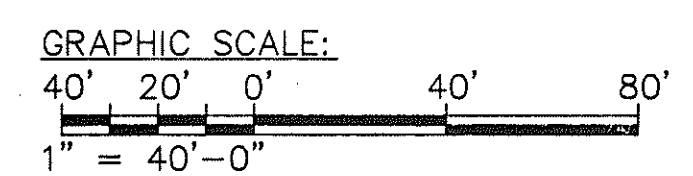



| FED. ROAD DIST. NO. | STATE | FED. AID PROJ. NO. | FISCAL YEAR | SHEET NO. | TOTAL SHEETS |
|---------------------|-------|--------------------|-------------|-----------|--------------|
| HAWAII              | HAW   | I-H3-1(66)         | 1992        | 403       | 440          |

TYPE "N"  
(RED/NON)  
REFLECTIVE  
MARKERS

TYPE "M"  
(CLEAR/NON)  
REFLECTIVE  
MARKERS

# PAVEMENT MARKER ARROW DETAIL


NTS

TYPE "M"  
(CLEAR/NON)  
REFLECTIVE  
MARKERS


TYPE "N"  
(RED/NON)  
REFLECTIVE  
MARKERS

# PAVEMENT MARKER ARROW DETAIL

NTS

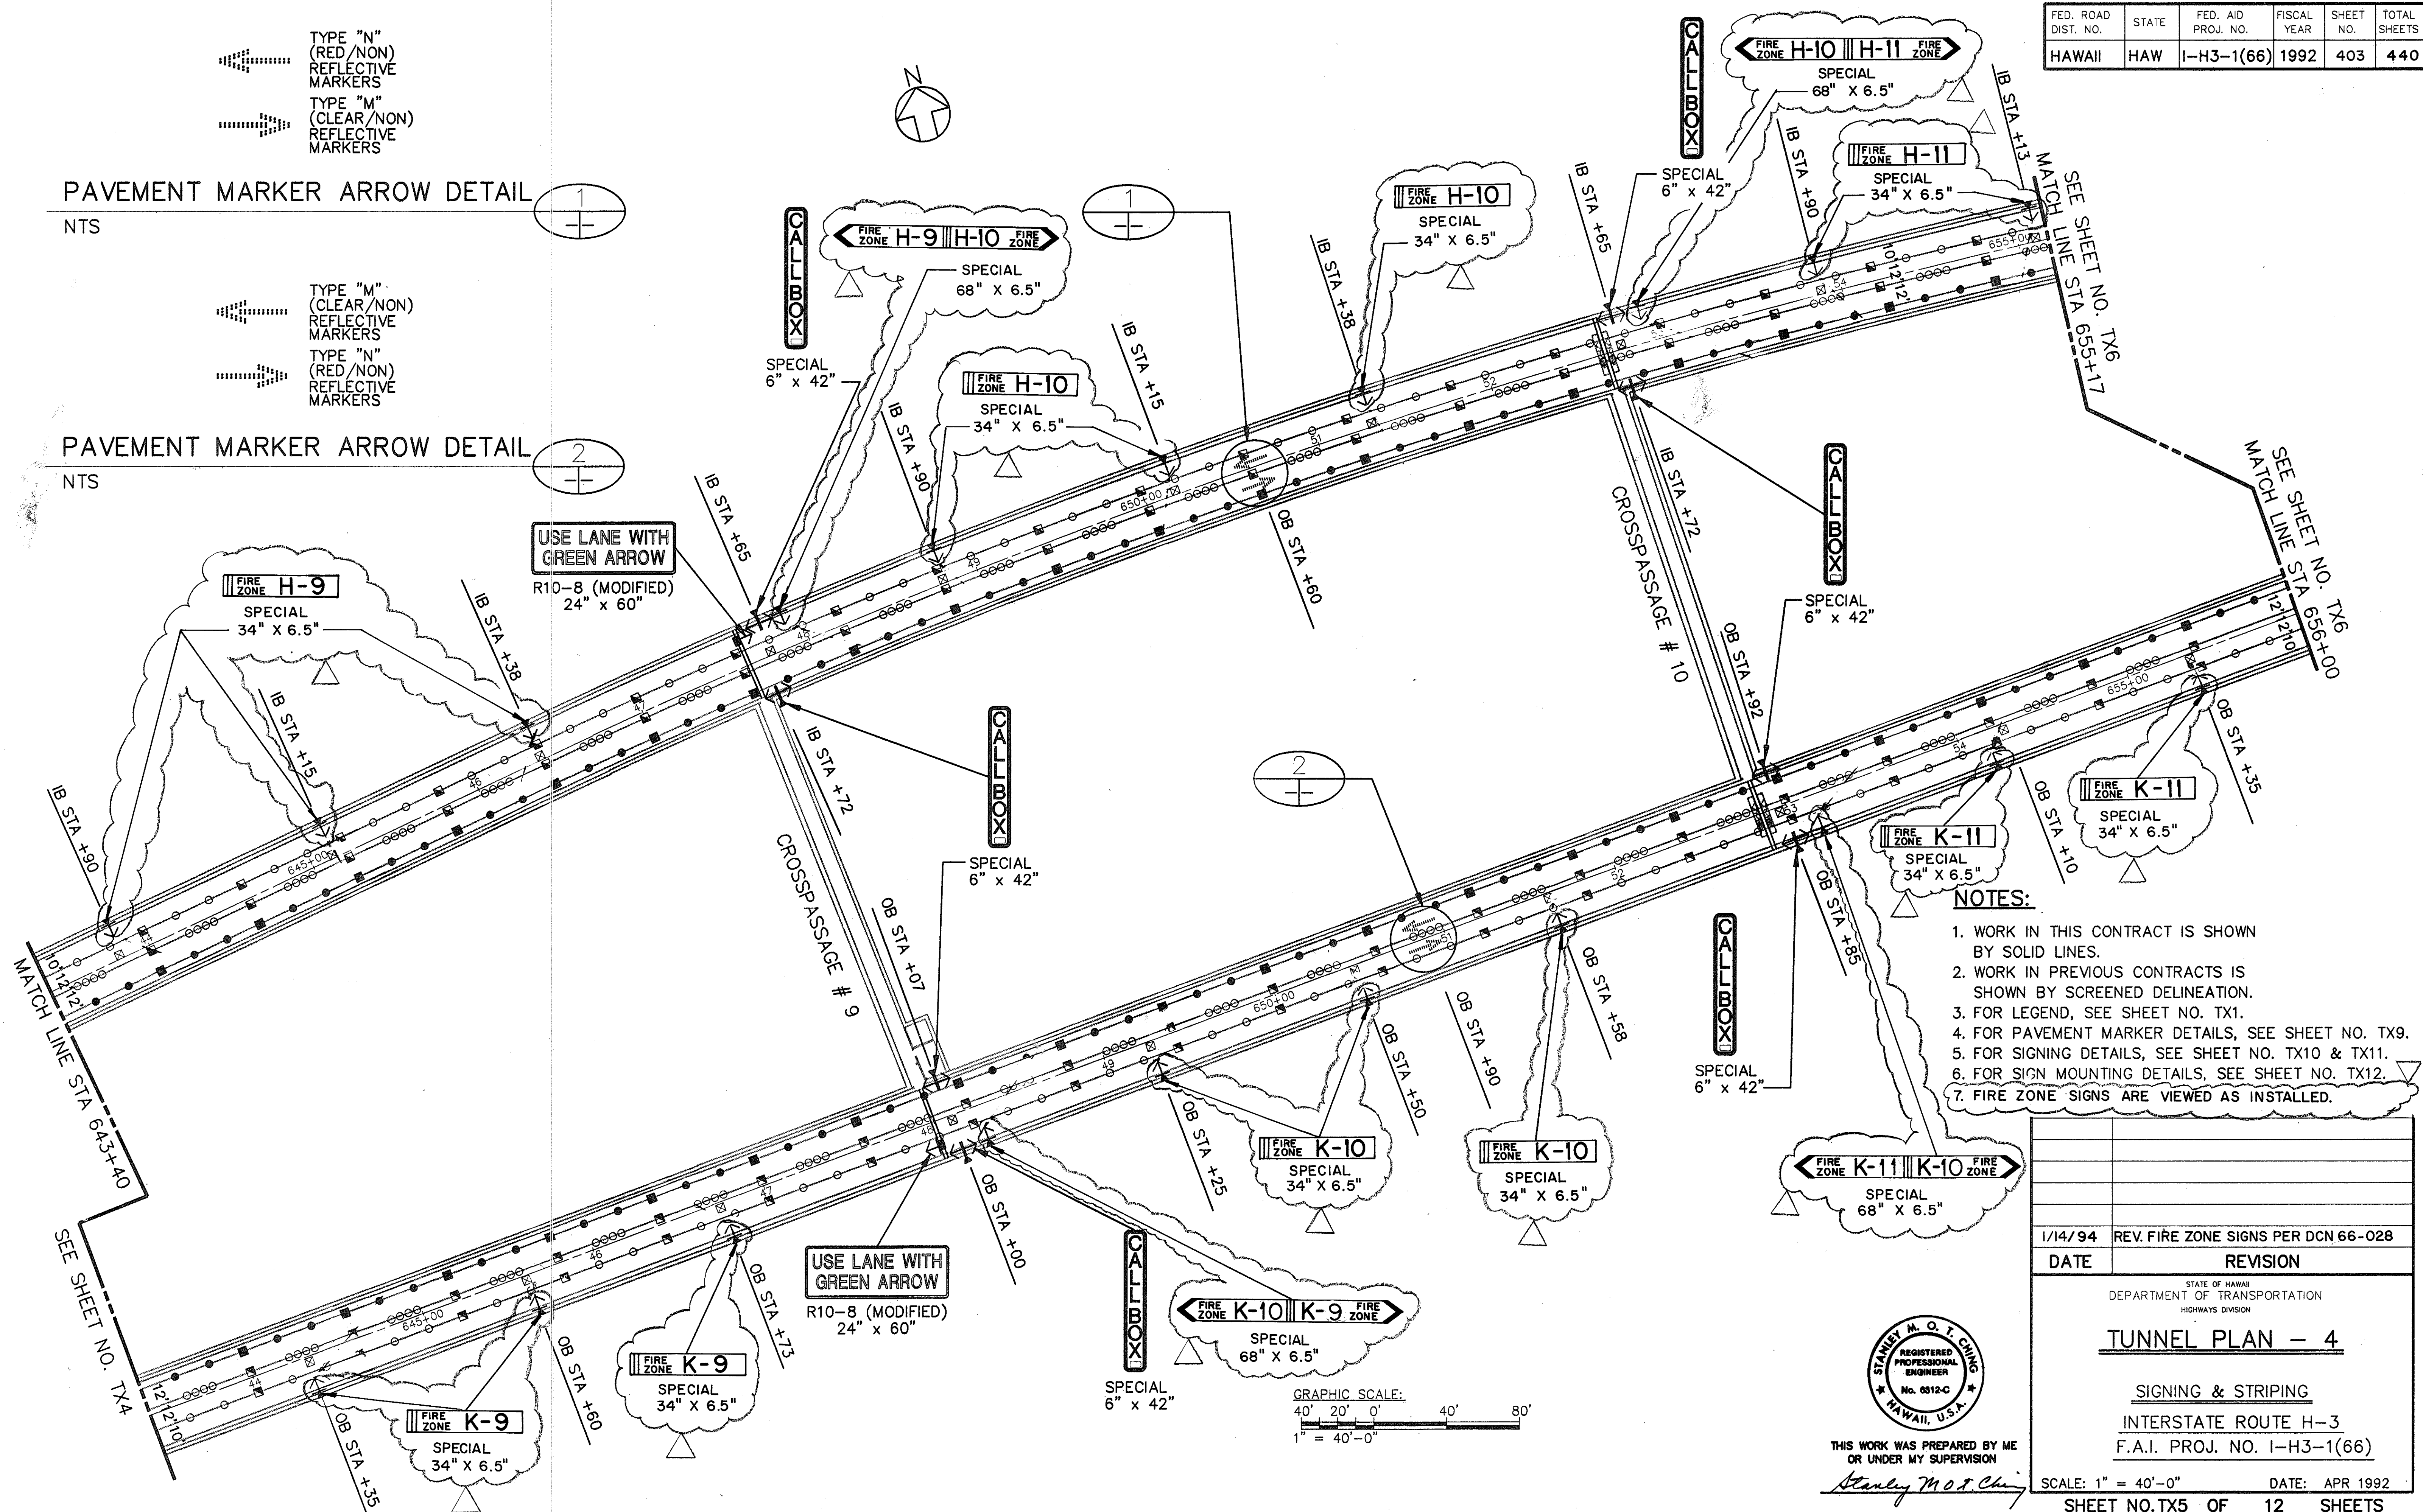

|                   |          |
|-------------------|----------|
| SURVEY PLOTTED BY | DATE     |
| DRAWN BY          | 12/11/91 |
| TRACED BY         | 12/05/91 |
| CHECKED BY        | 12/11/91 |
| ORIGINAL PLAN     |          |
| NOTEBOOK          |          |
| No.               |          |

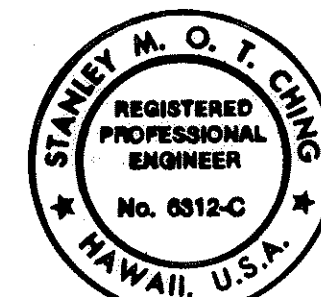

THIS WORK WAS PREPARED BY ME  
OR UNDER MY SUPERVISION

*Stanley M. O. T. Ching*

|                                                                      |                                     |
|----------------------------------------------------------------------|-------------------------------------|
| 1/14/94                                                              | REV. FIRE ZONE SIGNS PER DCN 66-028 |
| DATE                                                                 | REVISION                            |
| STATE OF HAWAII<br>DEPARTMENT OF TRANSPORTATION<br>HIGHWAYS DIVISION |                                     |
| TUNNEL PLAN - 4                                                      |                                     |
| SIGNING & STRIPING                                                   |                                     |
| INTERSTATE ROUTE H-3                                                 |                                     |
| F.A.I. PROJ. NO. I-H3-1(66)                                          |                                     |
| SCALE: 1" = 40'-0"                                                   | DATE: APR 1992                      |
| SHEET NO. TX5 OF 12 SHEETS                                           |                                     |



| FED. ROAD DIST. NO. | STATE | FED. AID PROJ. NO. | FISCAL YEAR | SHEET NO. | TOTAL SHEETS |
|---------------------|-------|--------------------|-------------|-----------|--------------|
| HAWAII              | HAW   | I-H3-1(66)         | 1992        | 404       | 440          |

CURVE DATA

| CURVE | DATA                                                                                 |
|-------|--------------------------------------------------------------------------------------|
| (R1)  | $\Delta = 33^{\circ} 22' 28''$<br>$R = 306.00'$<br>$LC = 178.24'$<br>$TAN = 91.73'$  |
| (R2)  | $\Delta = 41^{\circ} 23' 20''$<br>$R = 306.00'$<br>$LC = 221.04'$<br>$TAN = 115.59'$ |
| (R3)  | $\Delta = 27^{\circ} 17' 4''$<br>$R = 306.00'$<br>$LC = 145.72'$<br>$TAN = 74.27'$   |
| (R4)  | $\Delta = 34^{\circ} 55' 38''$<br>$R = 306.00'$<br>$LC = 186.54'$<br>$TAN = 96.27'$  |


LEGEND:

 PAVEMENT MARKERS NOT INSTALLED

NOTES:

1. WORK IN THIS CONTRACT IS SHOWN BY SOLID LINES.
2. WORK IN PREVIOUS CONTRACTS IS SHOWN BY SCREENED DELINEATION.
3. FOR LEGEND, SEE SHEET NO. TX1.
4. FOR PAVEMENT MARKER DETAILS, SEE SHEET NO. TX9.
5. FOR SIGNING DETAILS, SEE SHEET NO. TX10 & TX11.
6. FOR SIGN MOUNTING DETAILS, SEE SHEET NO. TX12.
7. FIRE ZONE SIGNS ARE VIEWED AS INSTALLED.

|         |                                     |
|---------|-------------------------------------|
| 1/14/94 | REV. FIRE ZONE SIGNS PER DCN 66-028 |
| DATE    | REVISION                            |

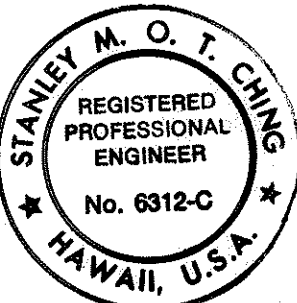

THIS WORK WAS PREPARED BY ME  
OR UNDER MY SUPERVISION

*Stanley M. O. T. Ching*

### HAIKU CROSSOVER PLAN

SIGNING & STRIPING

INTERSTATE ROUTE H-3


F.A.I. PROJ. NO. I-H3-1(66)

SCALE: 1" = 40'-0" DATE: APR 1992  
SHEET NO. TX6 OF 12 SHEETS

TYPE "N"  
(RED/NON)  
REFLECTIVE  
MARKERS

### PAVEMENT MARKER ARROW DETAIL


NTS

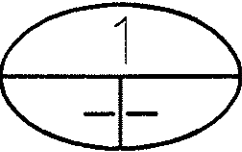

TYPE "N"  
(RED/NON)  
REFLECTIVE  
MARKERS

### PAVEMENT MARKER ARROW DETAIL


NTS

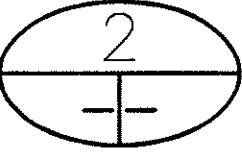

|                   |              |
|-------------------|--------------|
| DATE              | 12/12/91     |
| SURVEY PLOTTED BY | CAD          |
| DRAWN BY          | N. TRAN      |
| DESIGNED BY       | N. TRAN      |
| QUANTITIES BY     | D. MCCORMICK |
| CHECKED BY        | D. MCCORMICK |
| NO.               |              |



| FED. ROAD<br>DIST. NO. | STATE | FED. AID<br>PROJ. NO. | FISCAL<br>YEAR | SHEET<br>NO. | TOTAL<br>SHEETS |
|------------------------|-------|-----------------------|----------------|--------------|-----------------|
| HAWAII                 | HAW   | I-H3-1(66)            | 1992           | 405          | 440             |

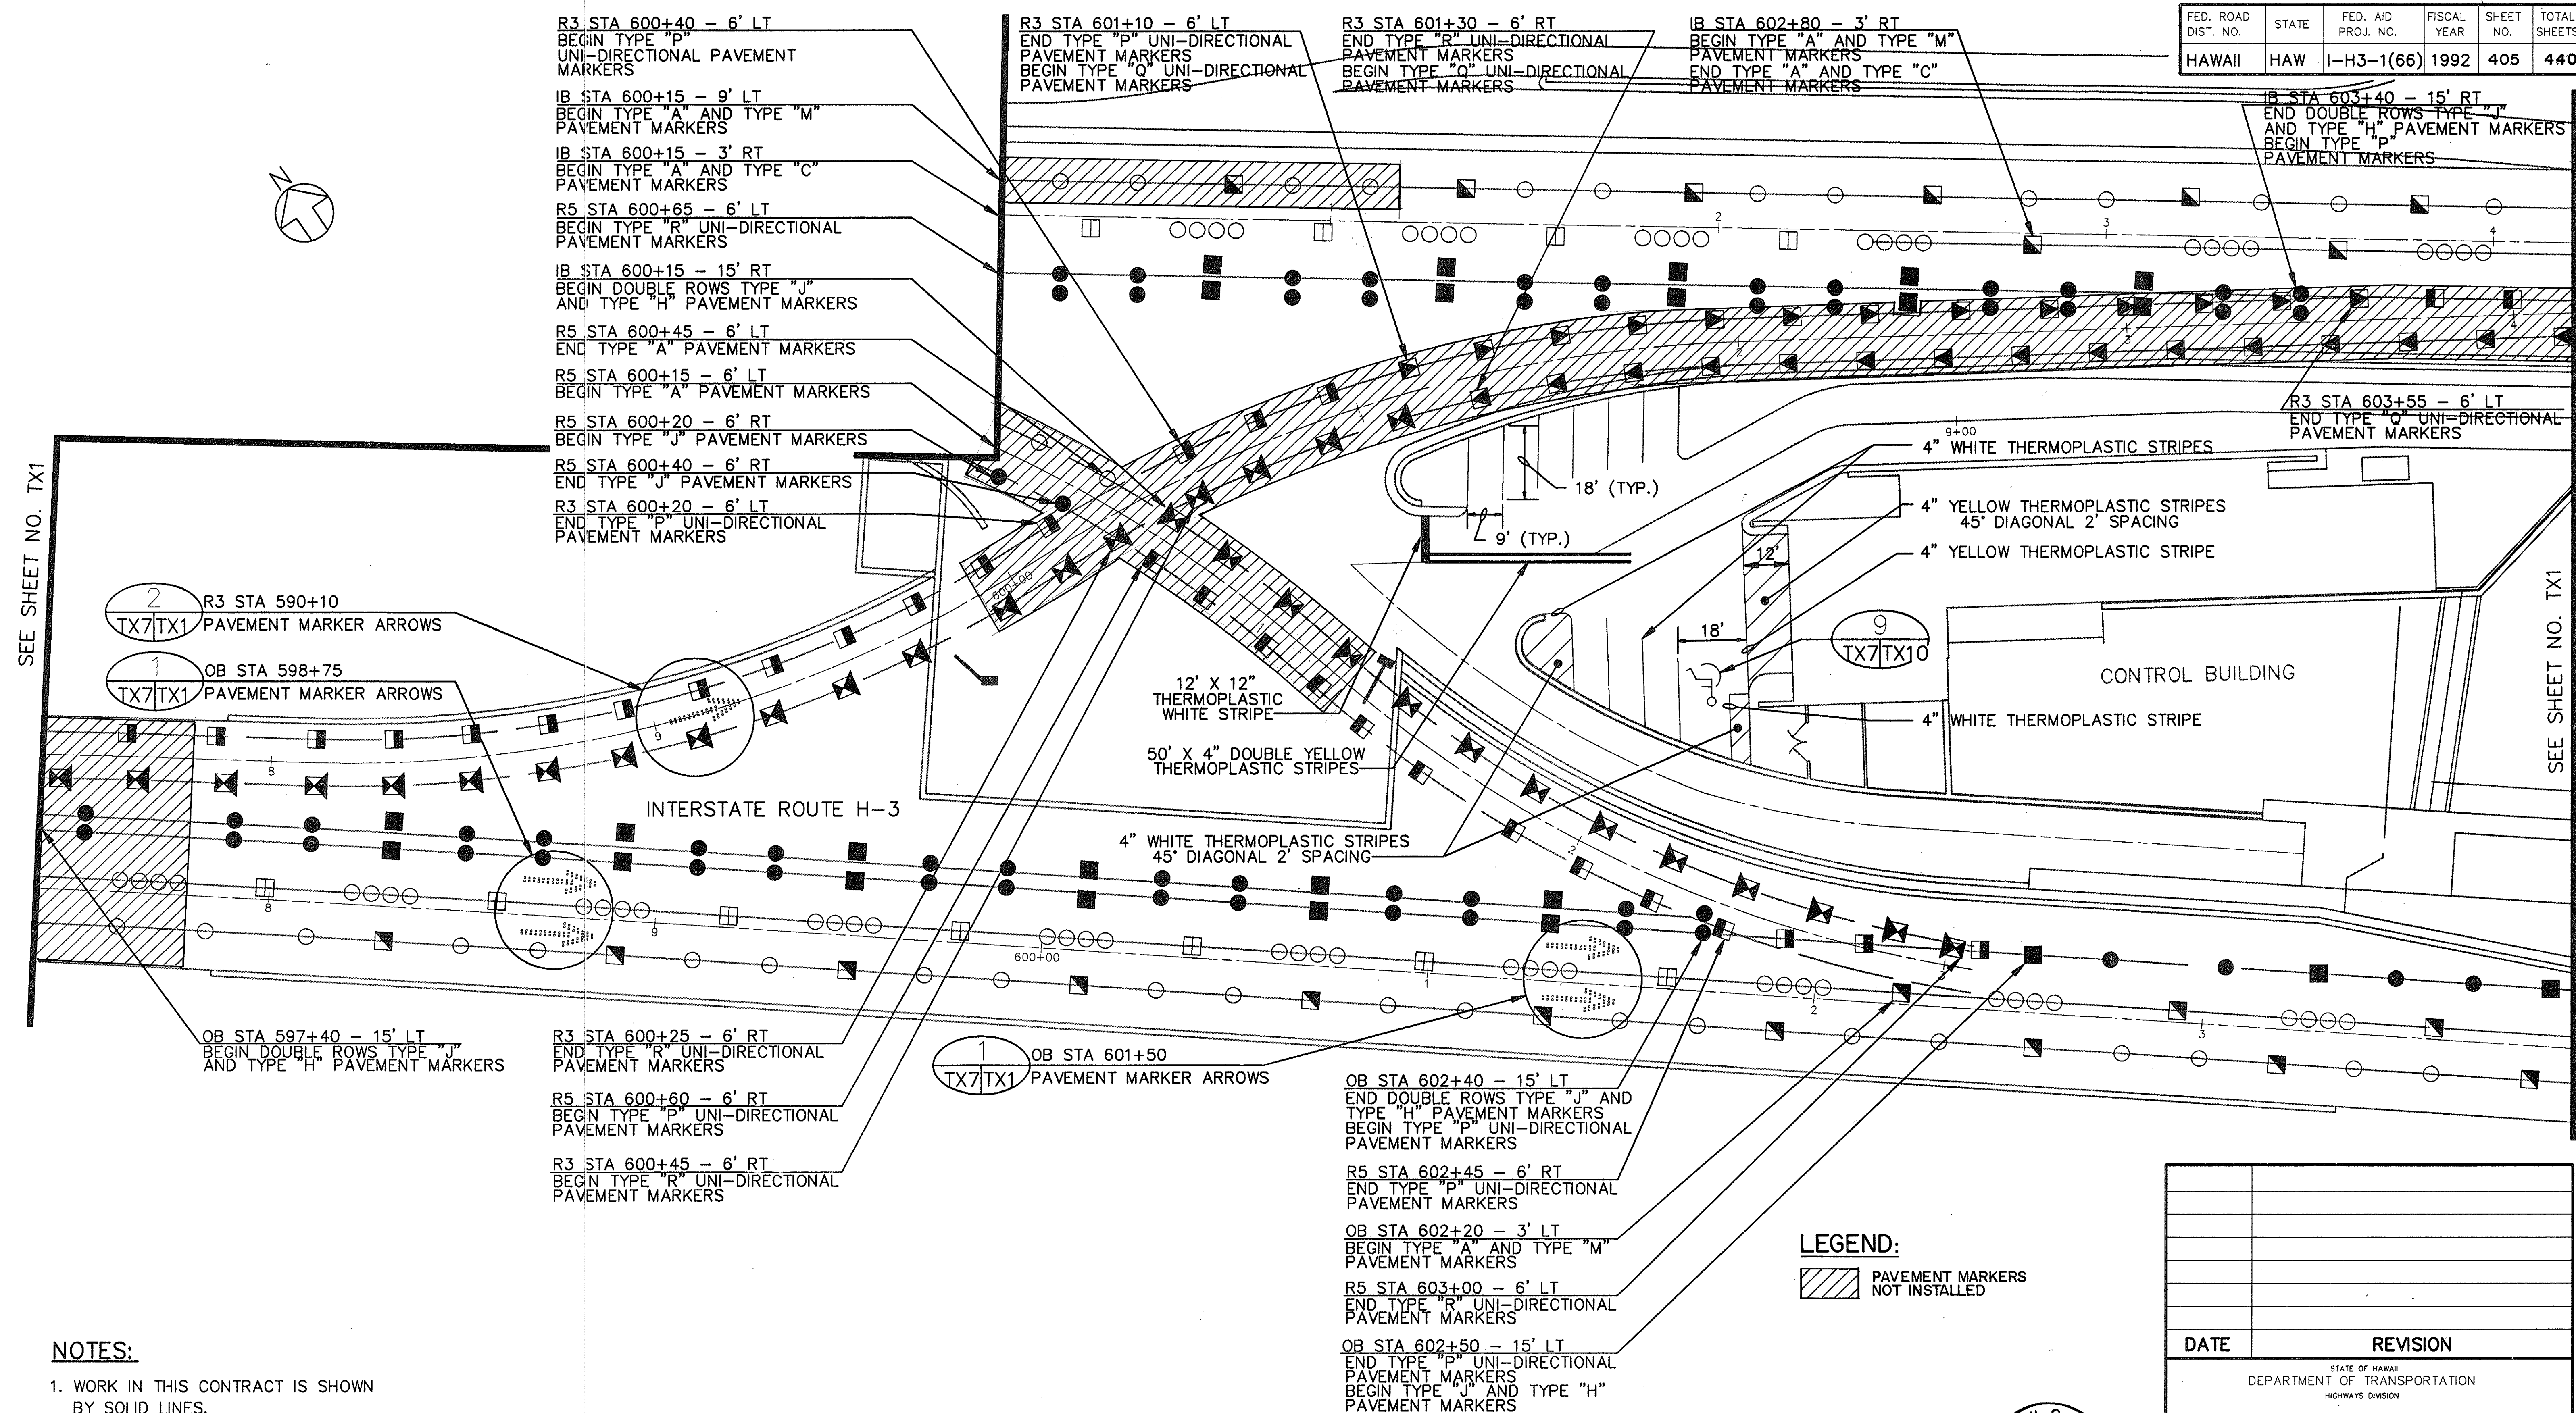

- NOTES:**
1. WORK IN THIS CONTRACT IS SHOWN BY SOLID LINES.
  2. WORK IN PREVIOUS CONTRACTS IS SHOWN BY SCREENED DELINEATION.
  3. FOR LEGEND, SEE SHEET NO. TX1.
  4. FOR PAVEMENT MARKER DETAILS, SEE SHEET NO. TX9.
  5. FOR SIGNING DETAILS, SEE SHEET NO. TX10 & TX11.
  6. FOR SIGN MOUNTING DETAILS, SEE SHEET NO. TX12.

**LEGEND:**

 PAVEMENT MARKERS NOT INSTALLED

|             |                 |
|-------------|-----------------|
|             |                 |
|             |                 |
| <b>DATE</b> | <b>REVISION</b> |

STATE OF HAWAII  
 DEPARTMENT OF TRANSPORTATION  
 HIGHWAYS DIVISION

HALAWA CROSSOVER DETAIL

SIGNING & STRIPING

INTERSTATE ROUTE H-3

F.A.I. PROJ. NO. I-H3-1(66)

SCALE: 1" = 20'-0"
DATE: APR 1992

SHEET NO.TX7 OF 12 SHEETS




STANLEY M. O. T. CHING  
REGISTERED  
PROFESSIONAL  
ENGINEER  
No. 5312-C  
HAWAII, U.S.A.

THIS WORK WAS PREPARED  
OR UNDER MY SUPERVIS

*Stanley M.O.T.*



| FED. ROAD<br>DIST. NO. | STATE | FED. AID<br>PROJ. NO. | FISCAL<br>YEAR | SHEET<br>NO. | TOTAL<br>SHEETS |
|------------------------|-------|-----------------------|----------------|--------------|-----------------|
| HAWAII                 | HAW   | I-H3-1(66)            | 1992           | 406          | 440             |

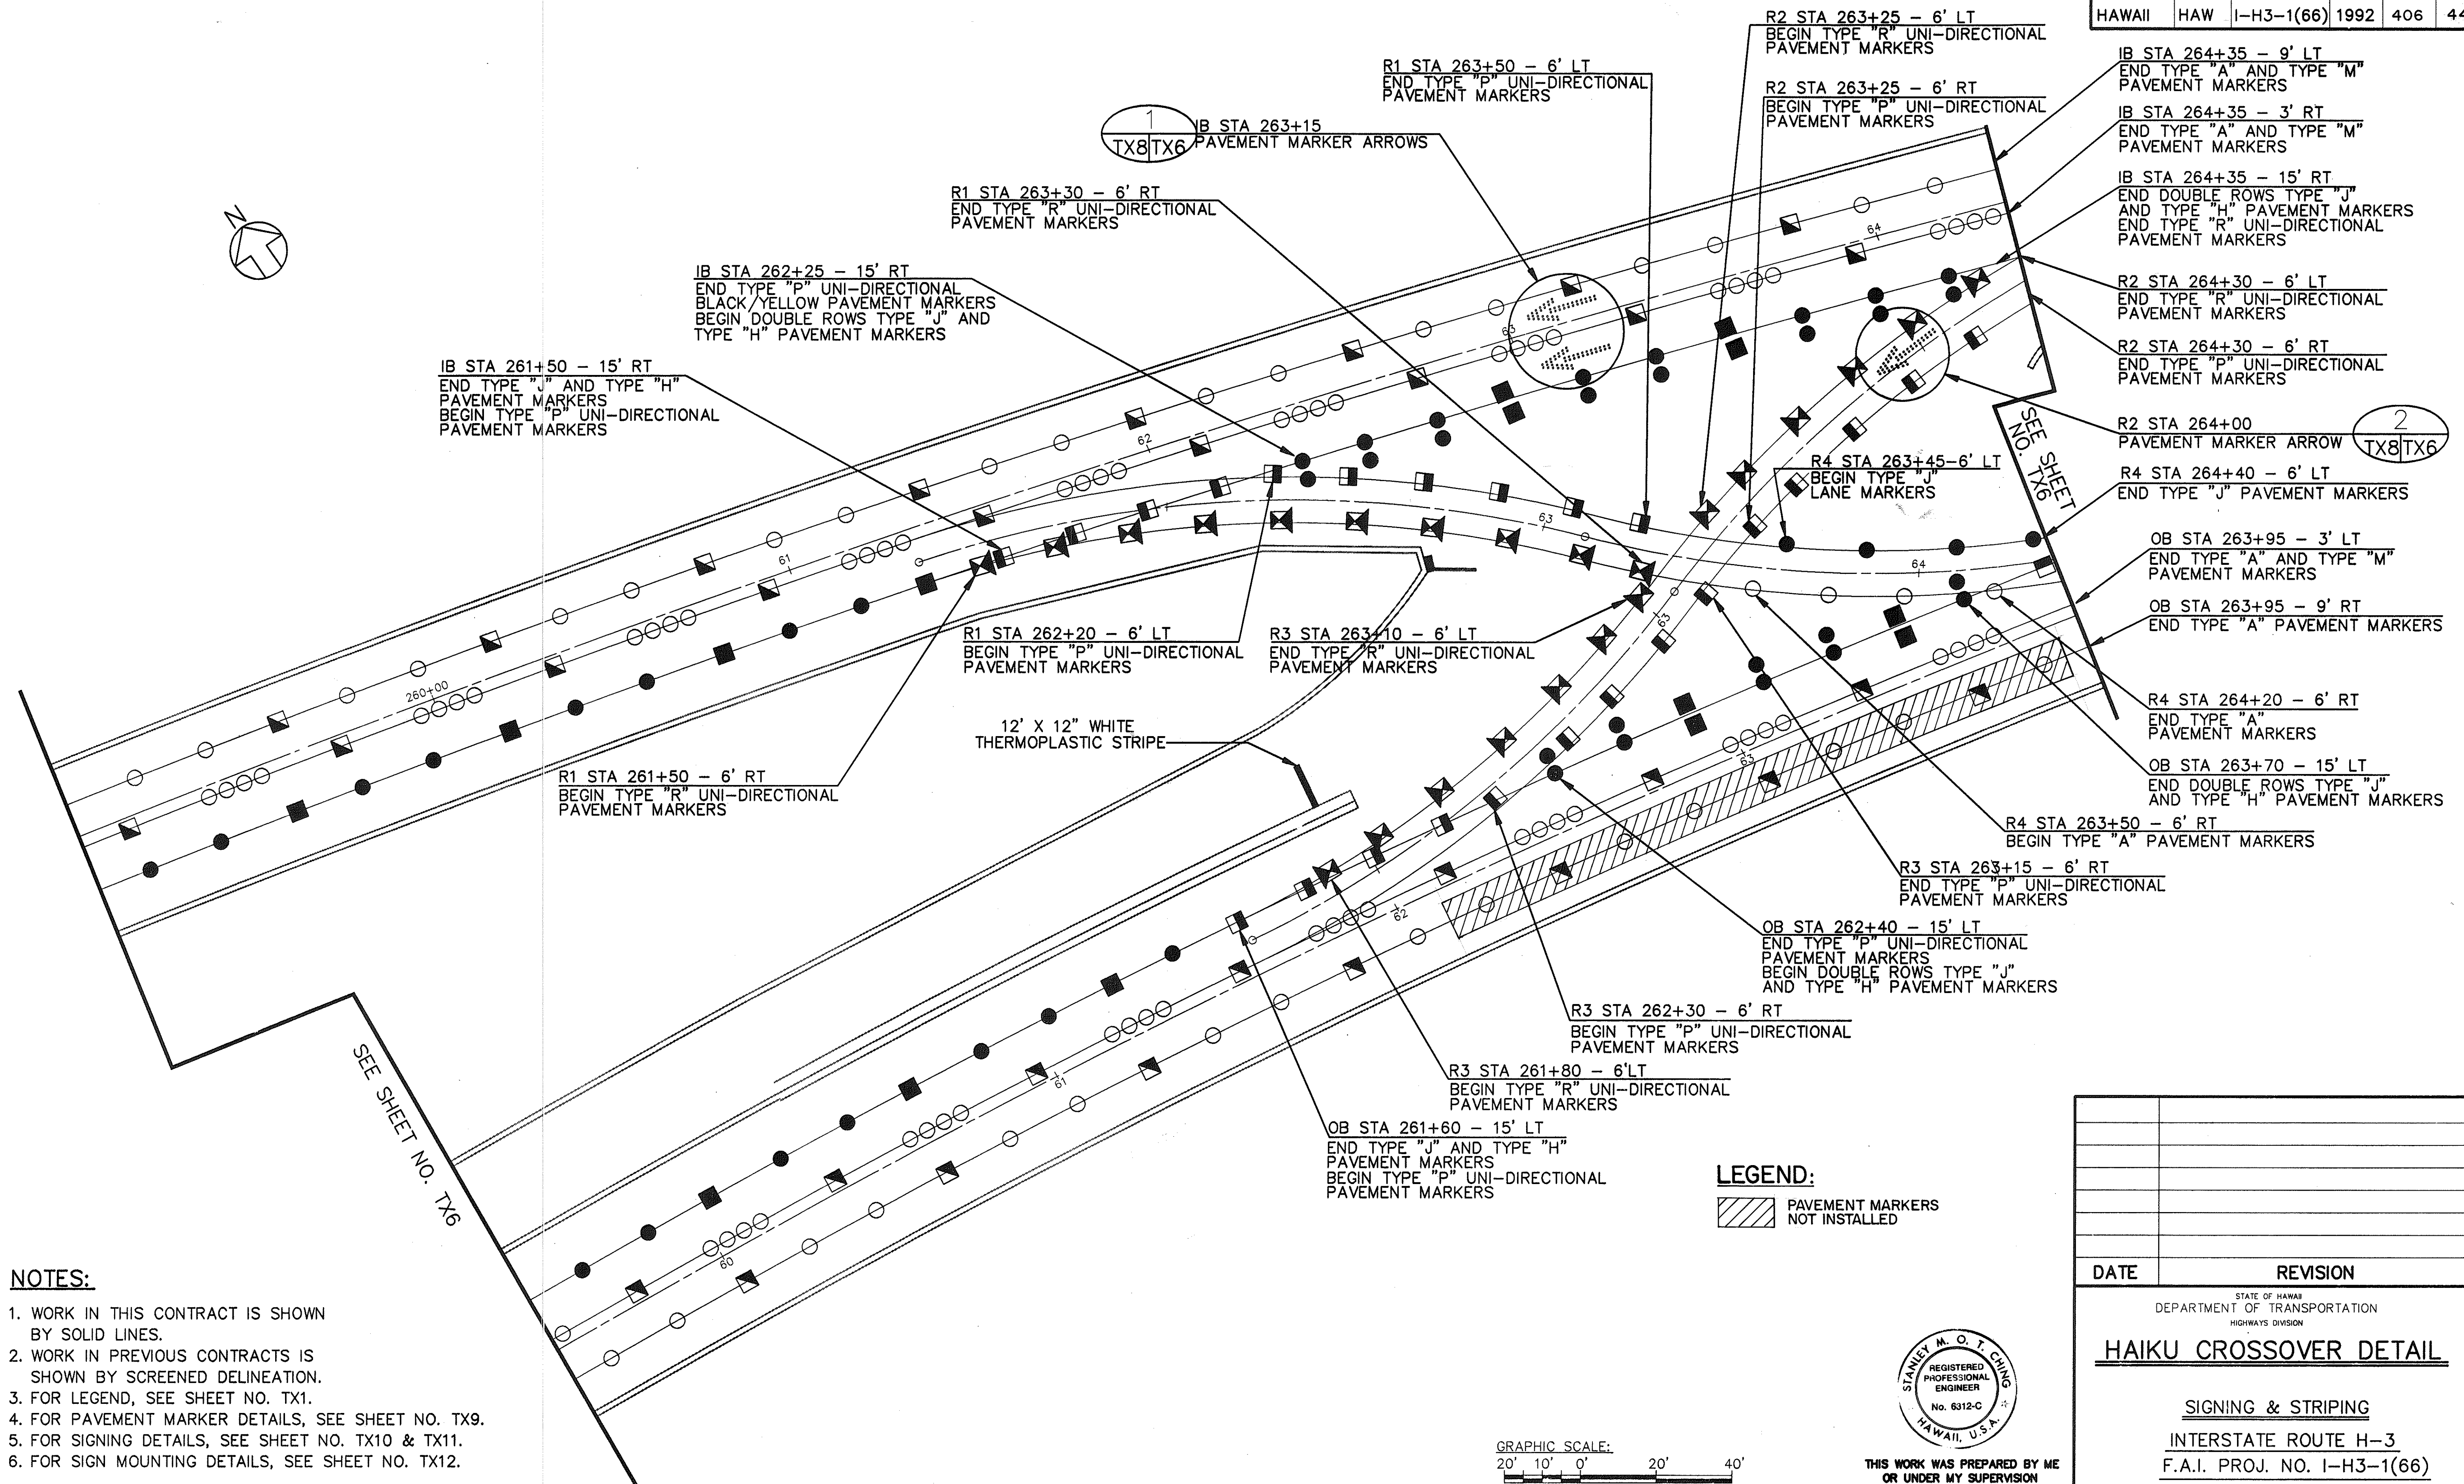

- ## NOTES:
1. WORK IN THIS CONTRACT IS SHOWN BY SOLID LINES.
  2. WORK IN PREVIOUS CONTRACTS IS SHOWN BY SCREENED DELINEATION.
  3. FOR LEGEND, SEE SHEET NO. TX1.
  4. FOR PAVEMENT MARKER DETAILS, SEE SHEET NO. TX9.
  5. FOR SIGNING DETAILS, SEE SHEET NO. TX10 & TX11.
  6. FOR SIGN MOUNTING DETAILS, SEE SHEET NO. TX12.

**LEGEND:**

 PAVEMENT MARKERS  
NOT INSTALLED

[illegible]

THIS WORK WAS PREPARED BY ME  
OR UNDER MY SUPERVISION  
Stanley M. O.T. Chang


h3-6tx8 -/h3/c6 -03-25-92









| FED. ROAD<br>DIST. NO. | STATE | FED. AID<br>PROJ. NO. | FISCAL<br>YEAR | SHEET<br>NO. | TOTAL<br>SHEETS |
|------------------------|-------|-----------------------|----------------|--------------|-----------------|
| HAWAII                 | HAW.  | I-H3-1(66)            | 1992           | 408          | 440             |

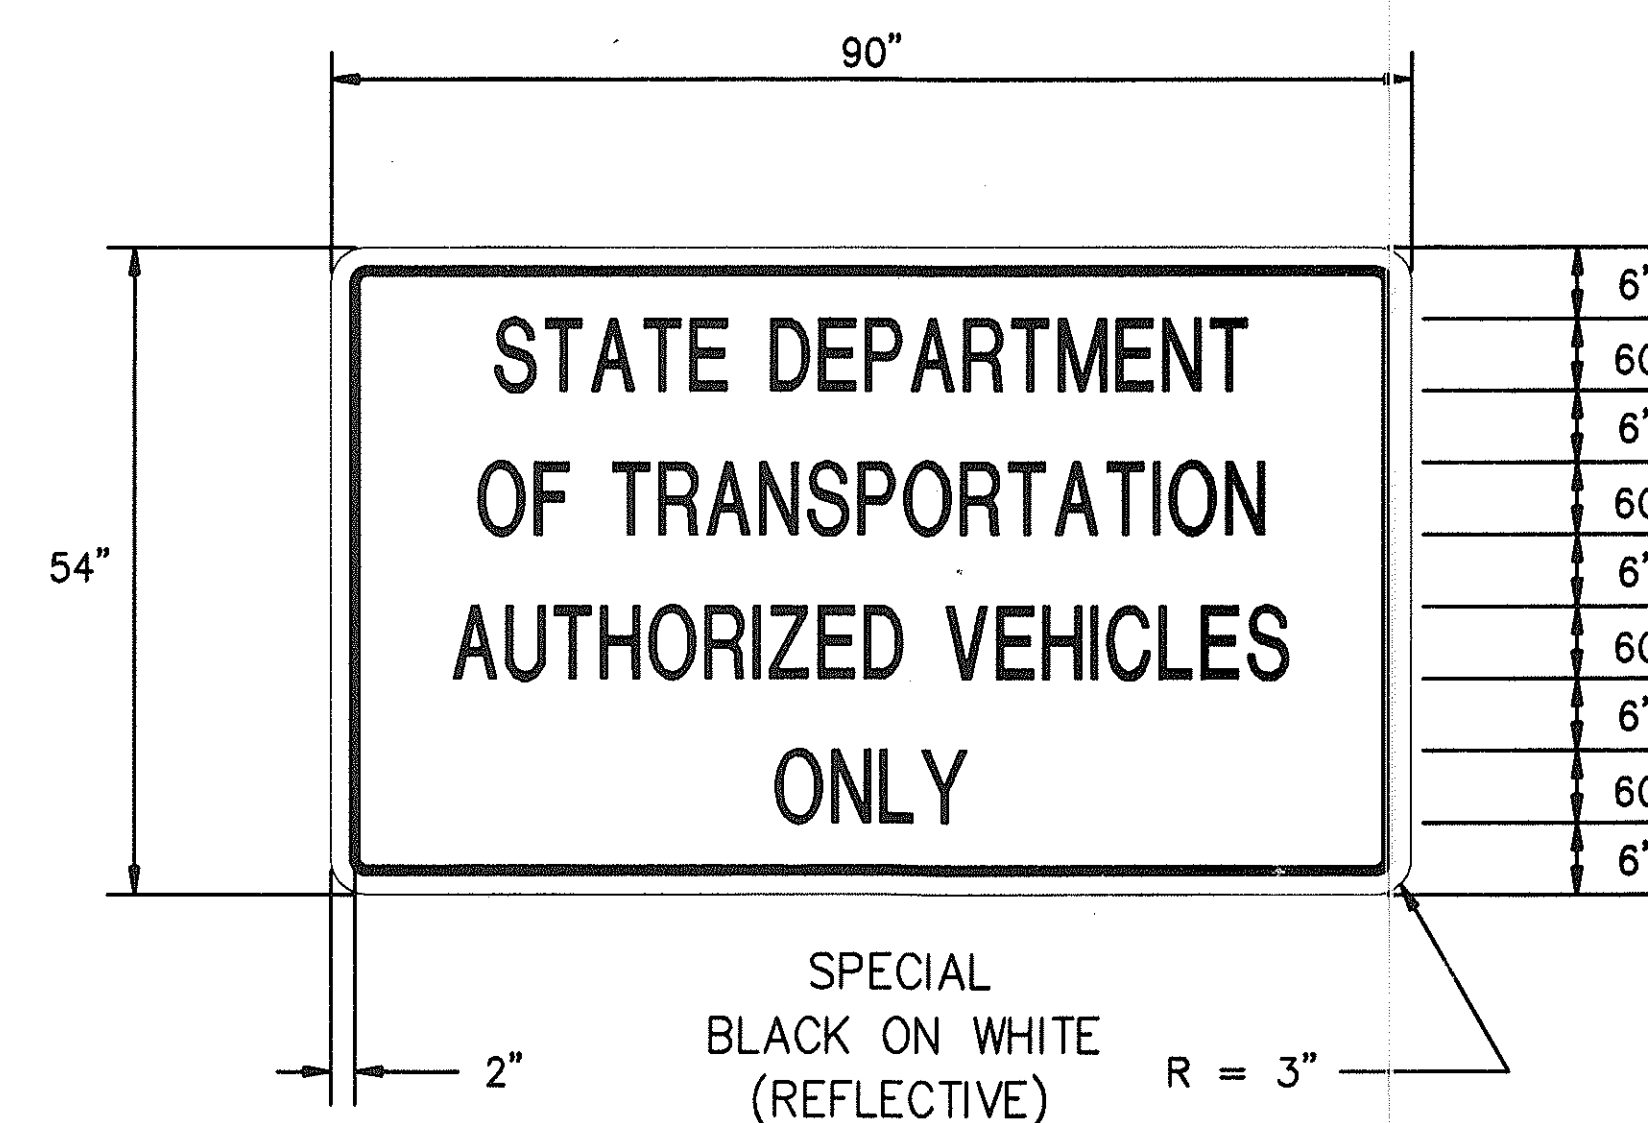


DETAIL 1

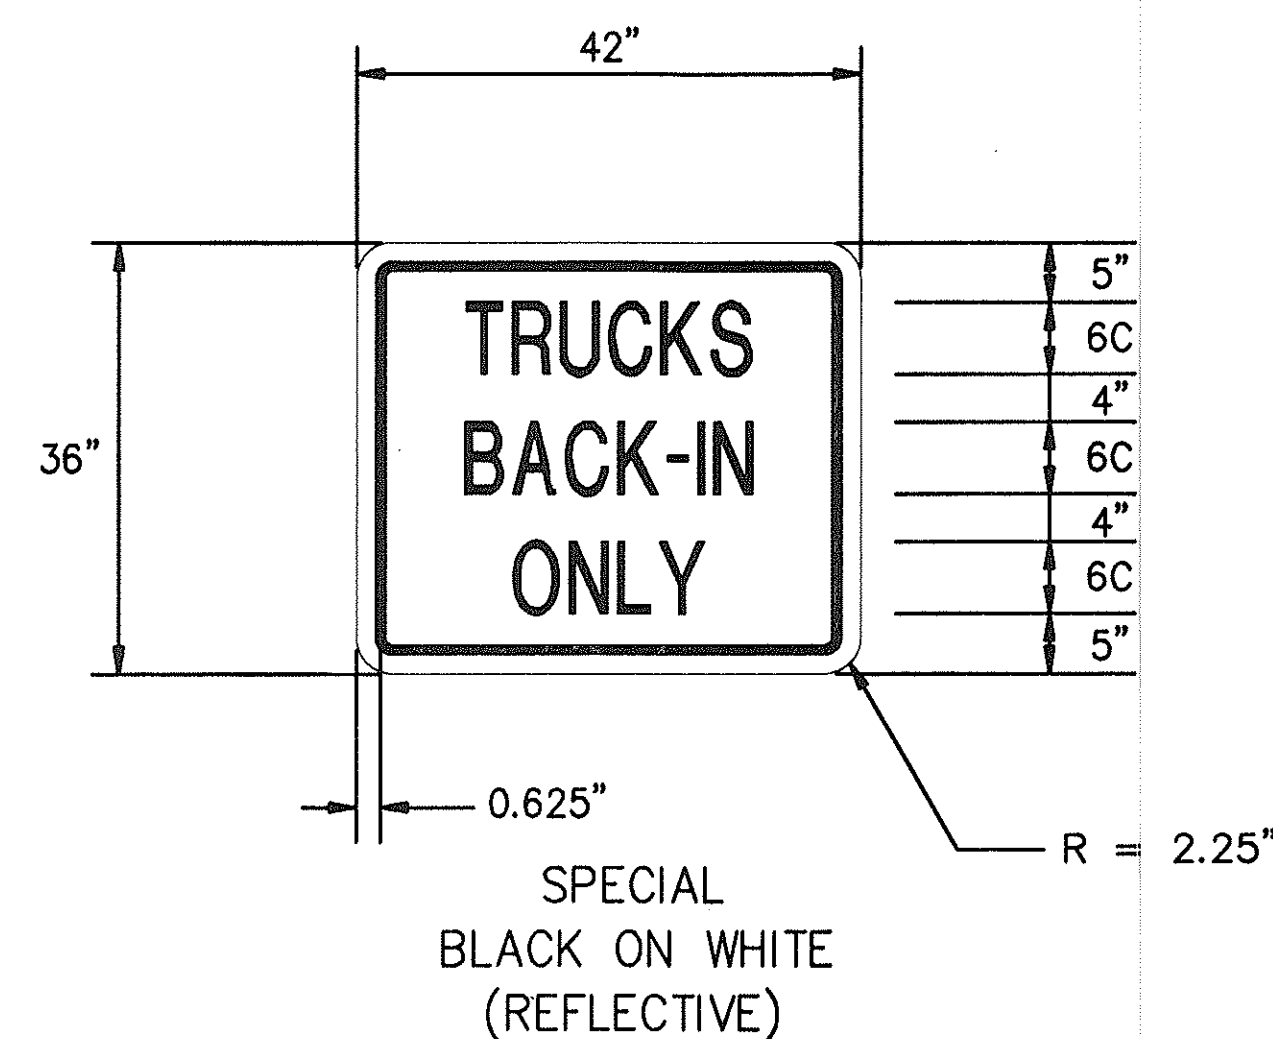


DETAIL 2

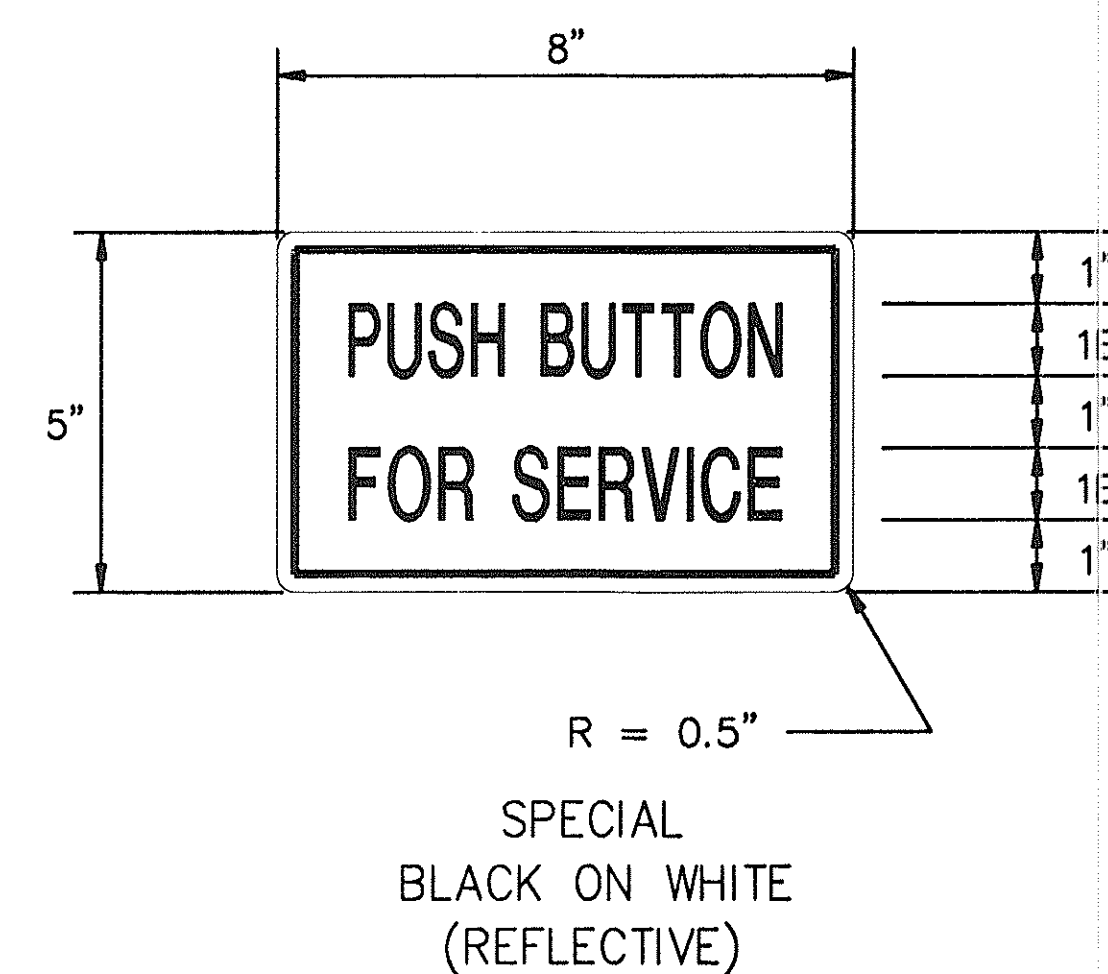


DETAIL 3

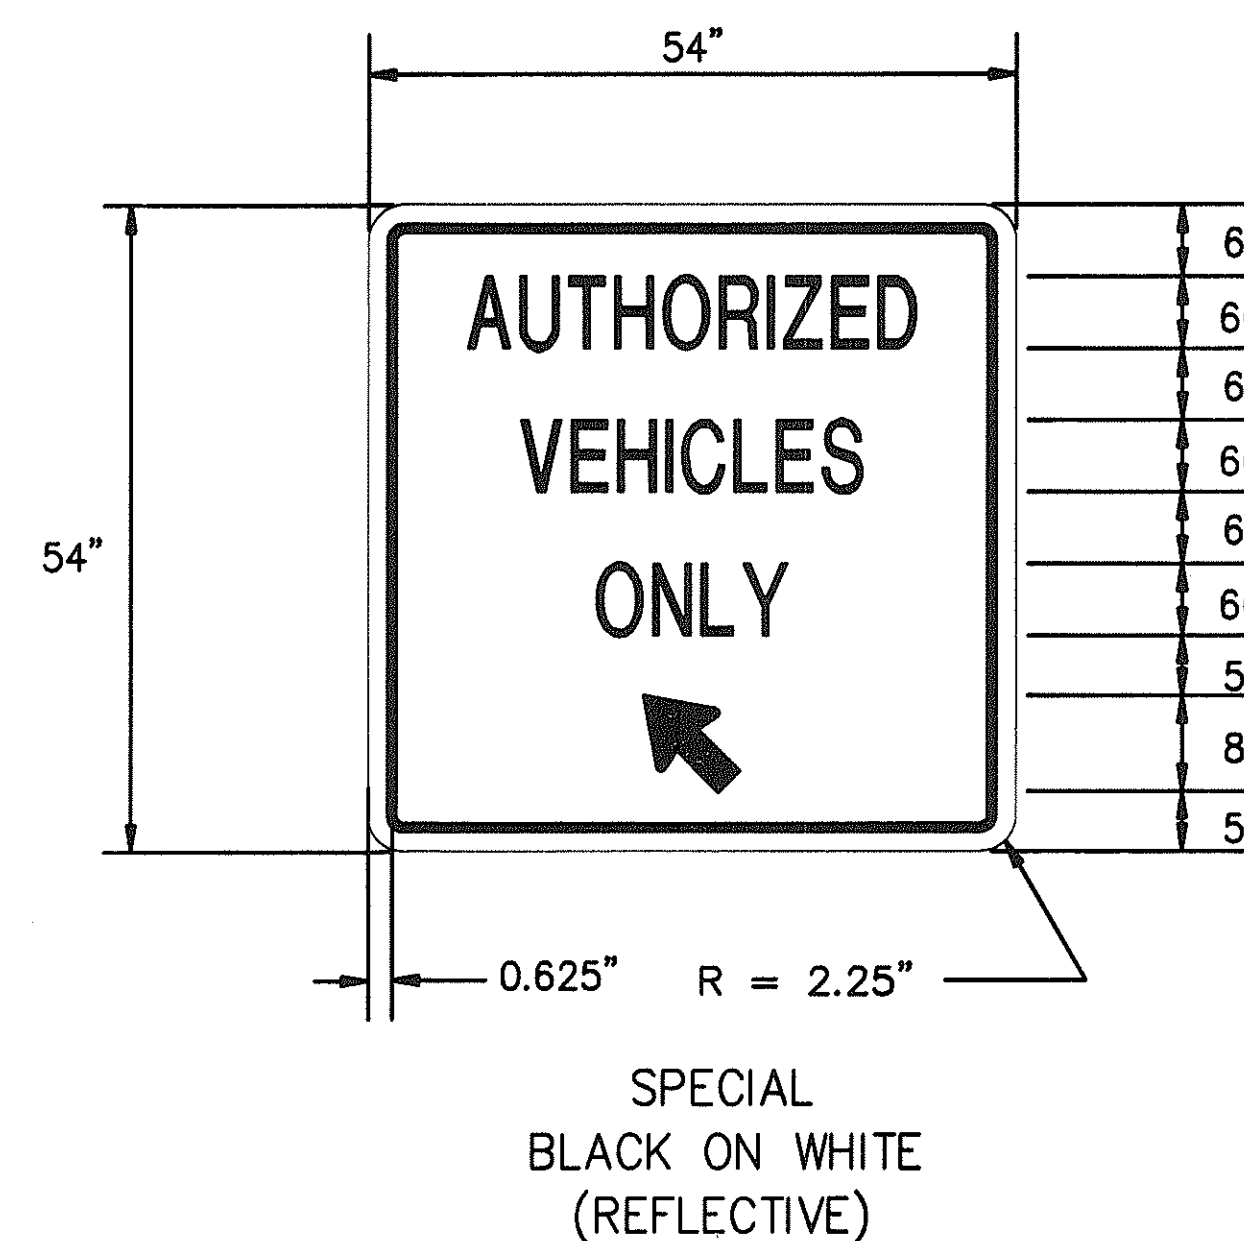

DETAIL 4

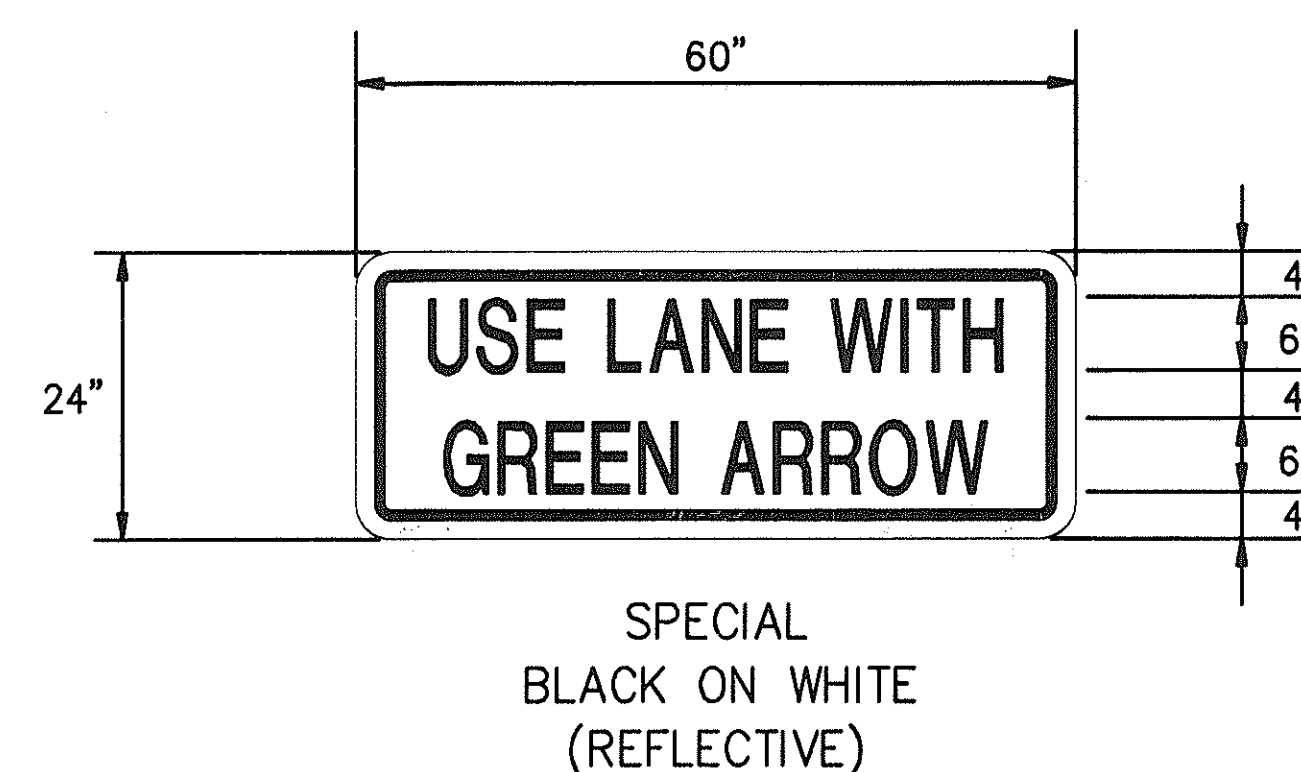


DETAIL 5

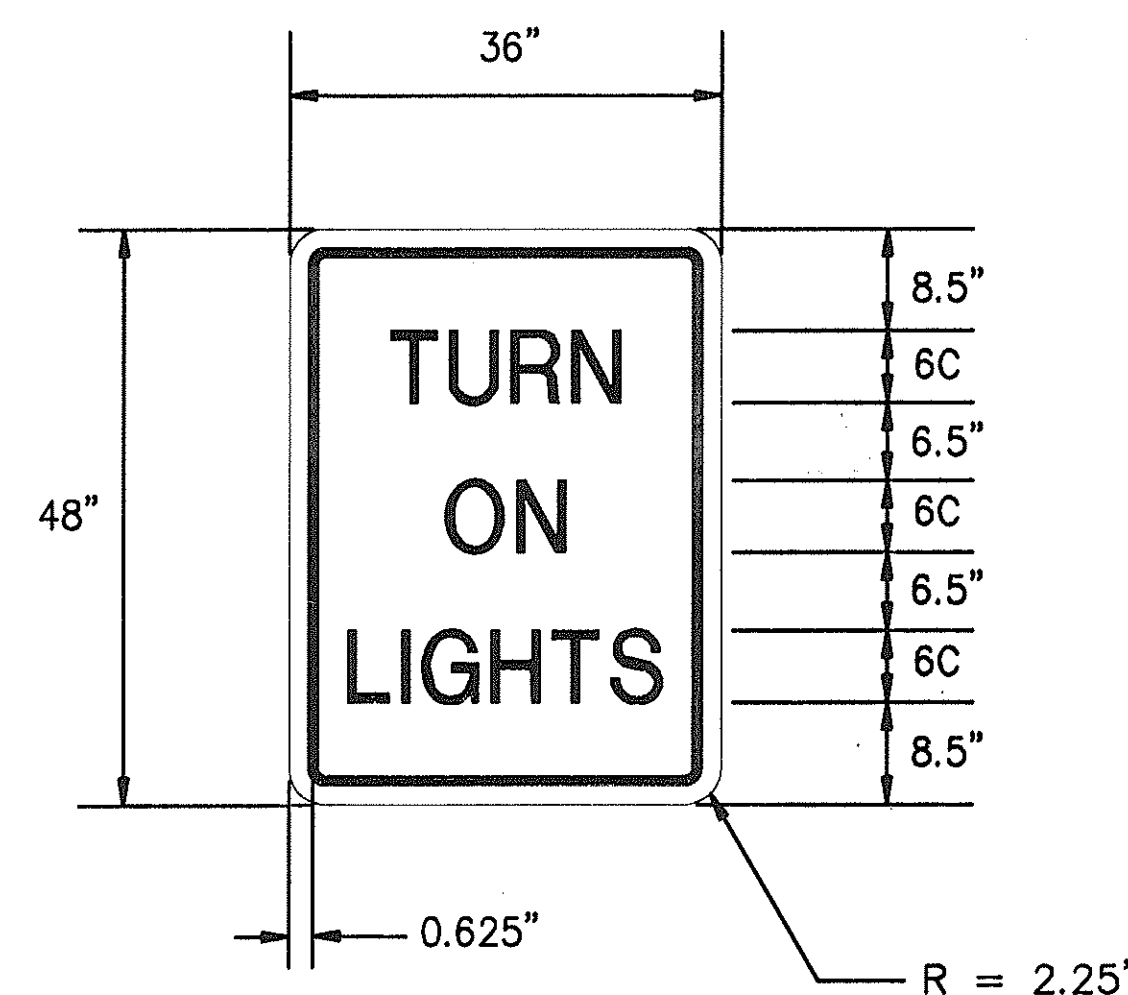


SPECIAL  
BLACK ON WHITE  
(REFLECTIVE)

DETAIL 6

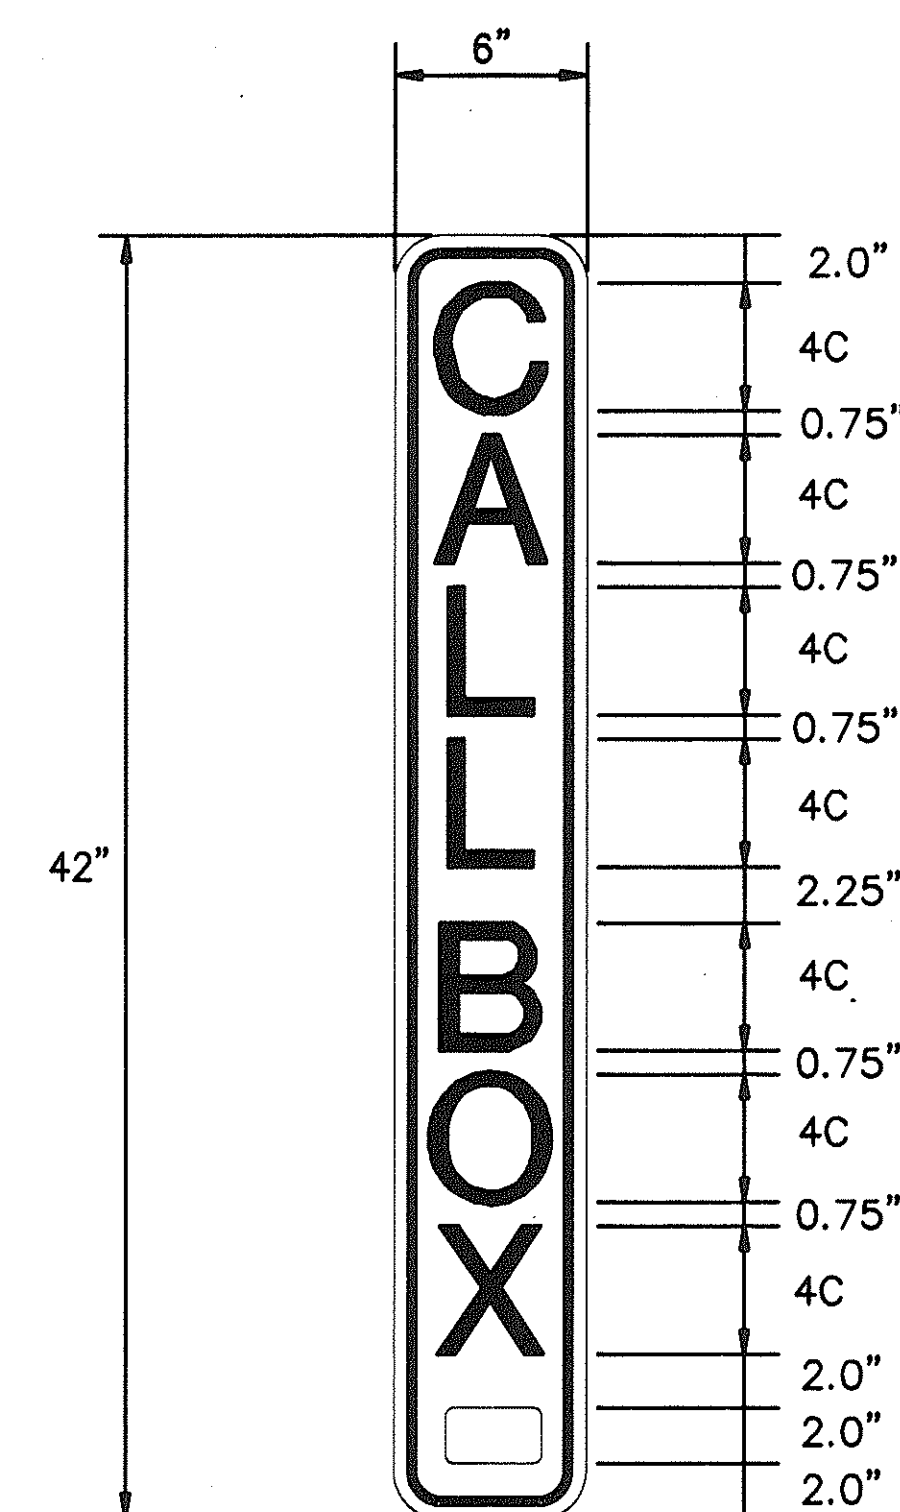


SPECIAL  
BLACK ON WHITE  
(REFLECTIVE)

DETAIL 7

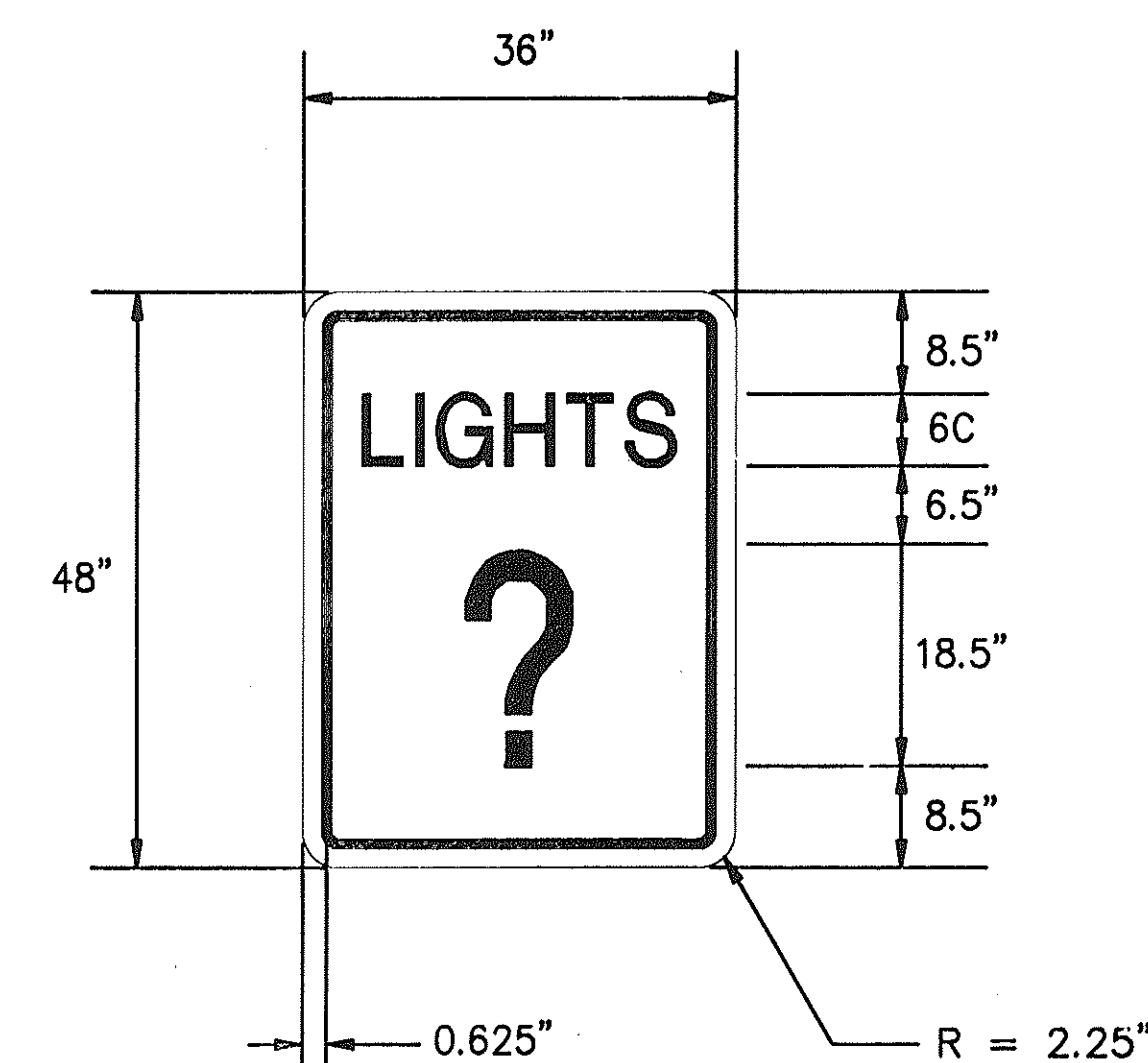


SPECIAL  
BLACK ON WHITE  
(REFLECTIVE)

DETAIL 8

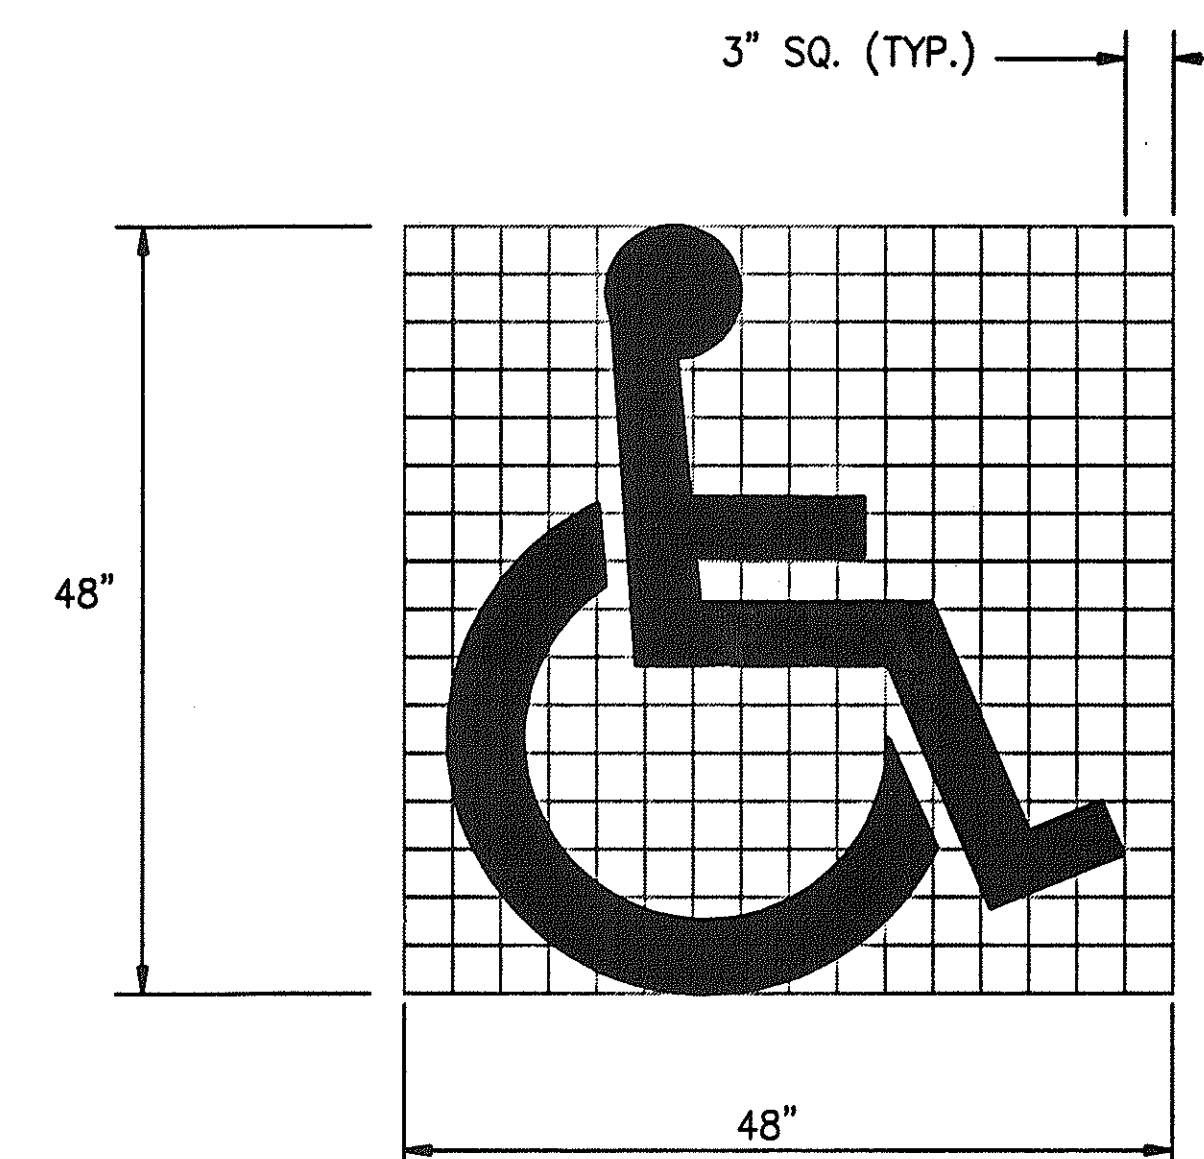

4" WHITE THERMOPLASTIC  
PAVEMENT MARKING

DETAIL 9

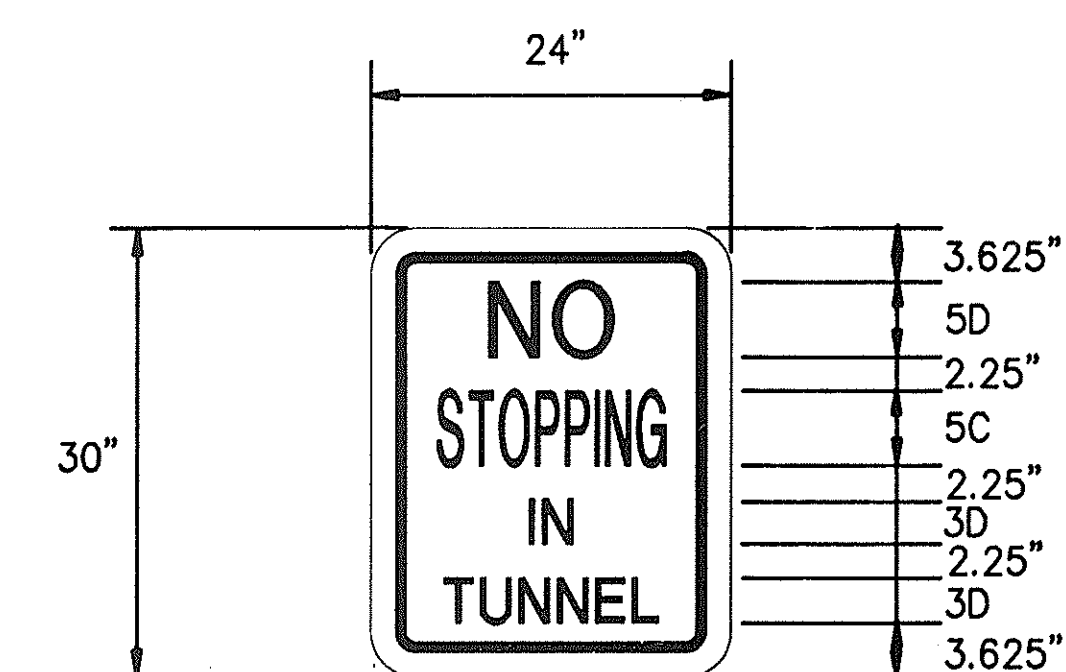

R8-5-A  
(MODIFIED)

DETAIL 10

|             |                 |
|-------------|-----------------|
|             |                 |
|             |                 |
| <b>DATE</b> | <b>REVISION</b> |

STATE OF HAWAII  
DEPARTMENT OF TRANSPORTATION  
HIGHWAYS DIVISION

SIGNING DETAILS — 1


SIGNING & STRIPING

INTERSTATE ROUTE H-3

F.A.I. PROJ. NO. I-H3-1(66 )

SCALE: NONE
DATE: APR 1992

SHEET NO. TX10 OF
12
SHEETS

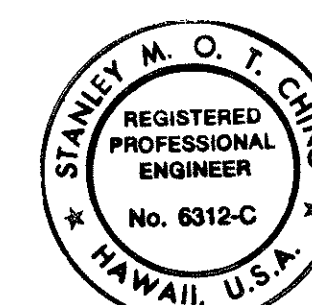


THIS WORK WAS PREPARED BY ME  
OR UNDER MY SUPERVISION


Stanley M. O. T. Chong




| FED. ROAD DIST. NO. | STATE | FED. AID PROJ. NO. | FISCAL YEAR | SHEET NO. | TOTAL SHEETS |
|---------------------|-------|--------------------|-------------|-----------|--------------|
| HAWAII              | HAW.  | I-H3-1(66)         | 1992        | 409       | 440          |

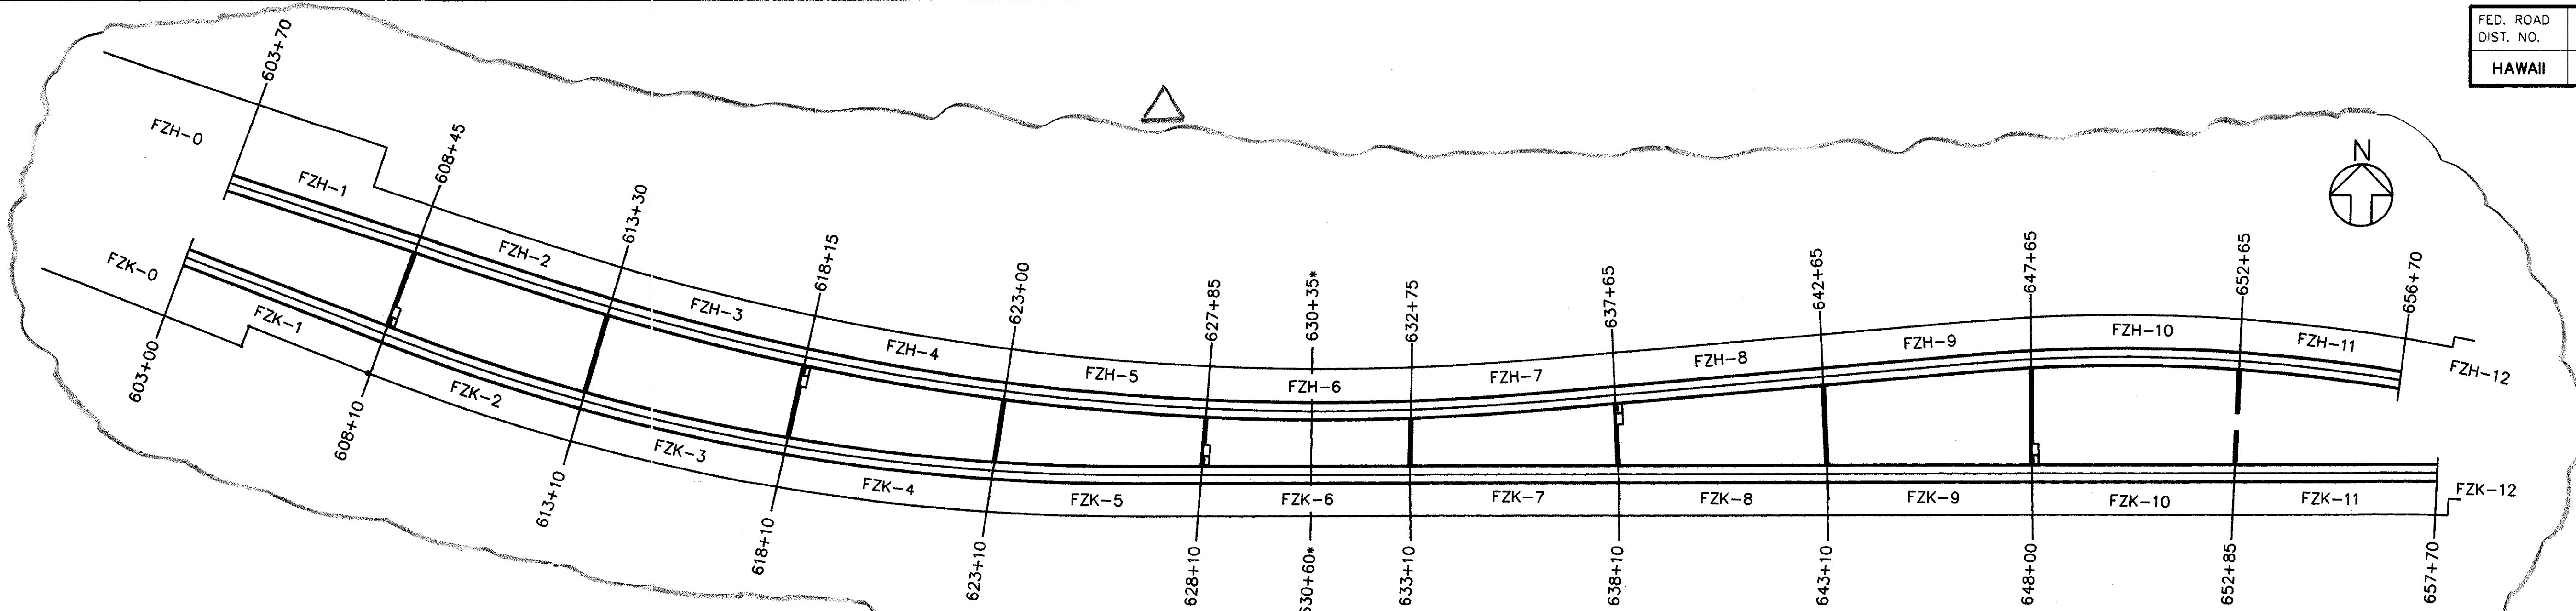


FIRE ZONE PLAN

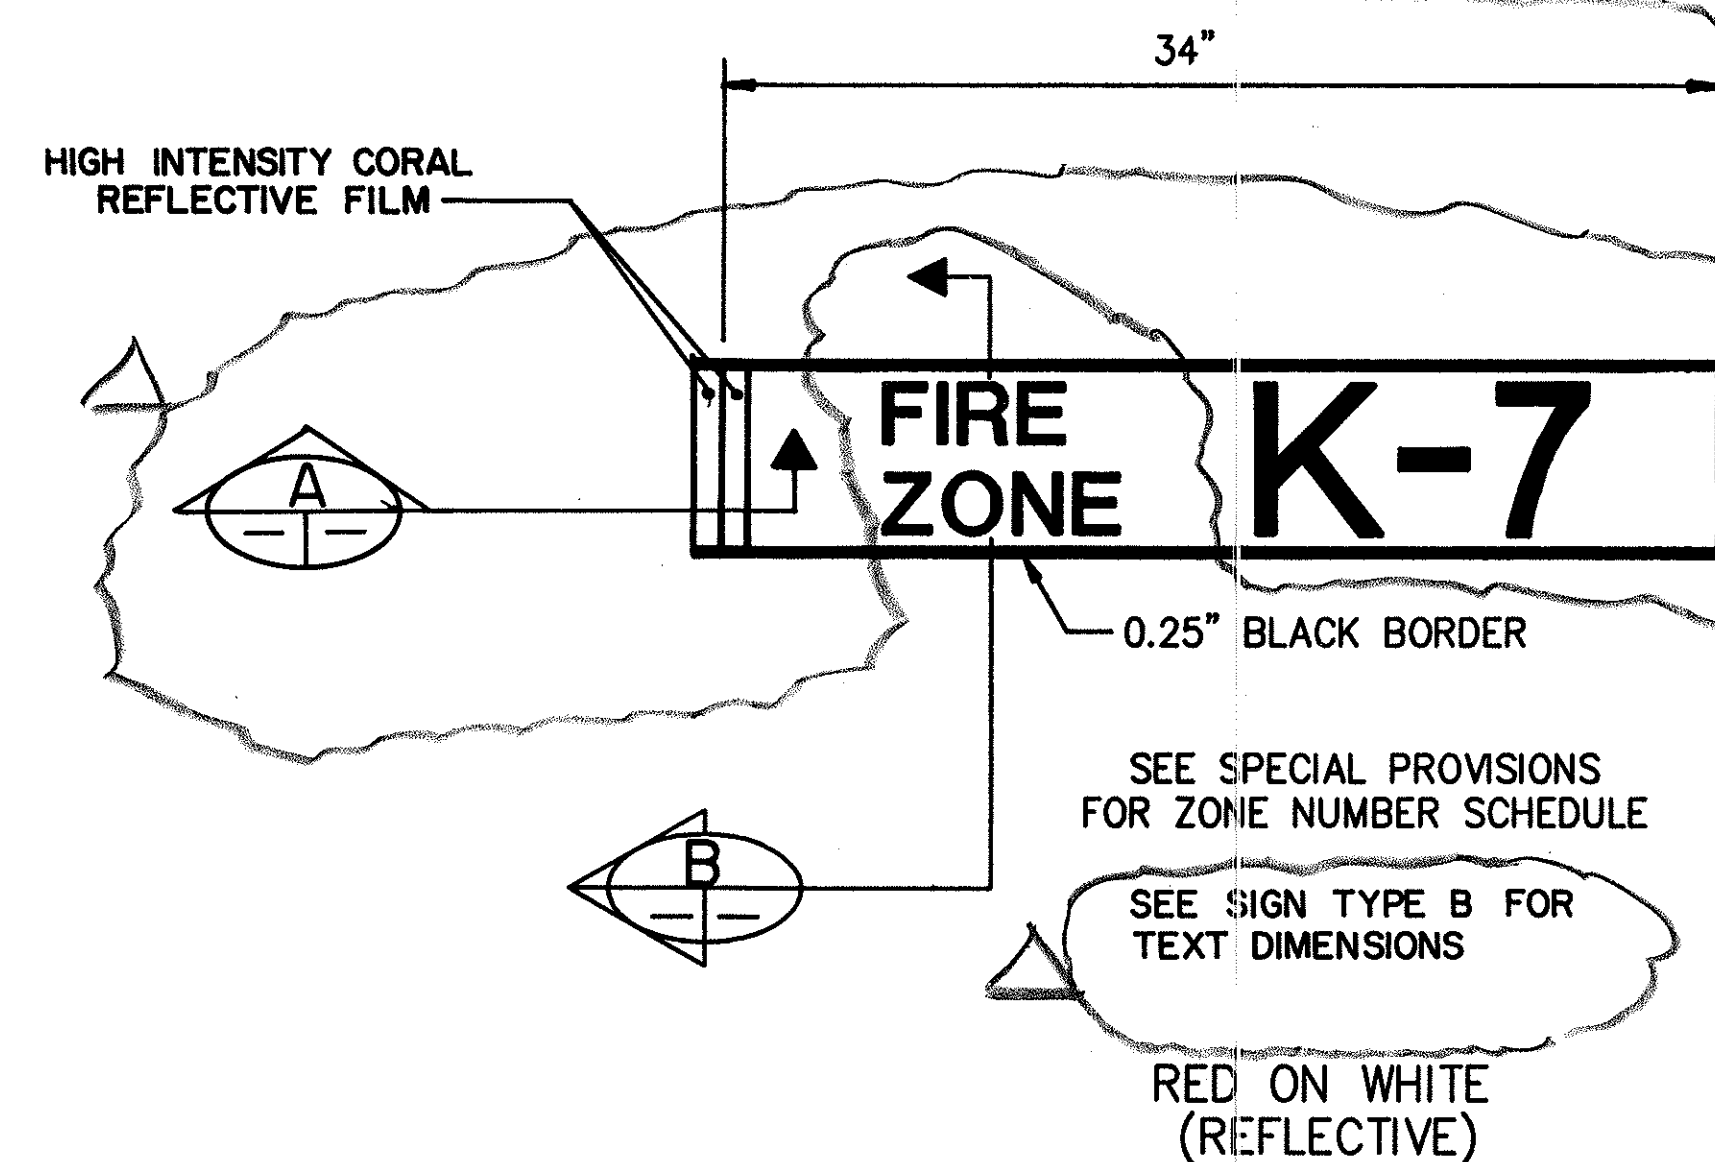


FIRE ZONE SIGN - TYPE A  
TX1 TO TX6 TX12

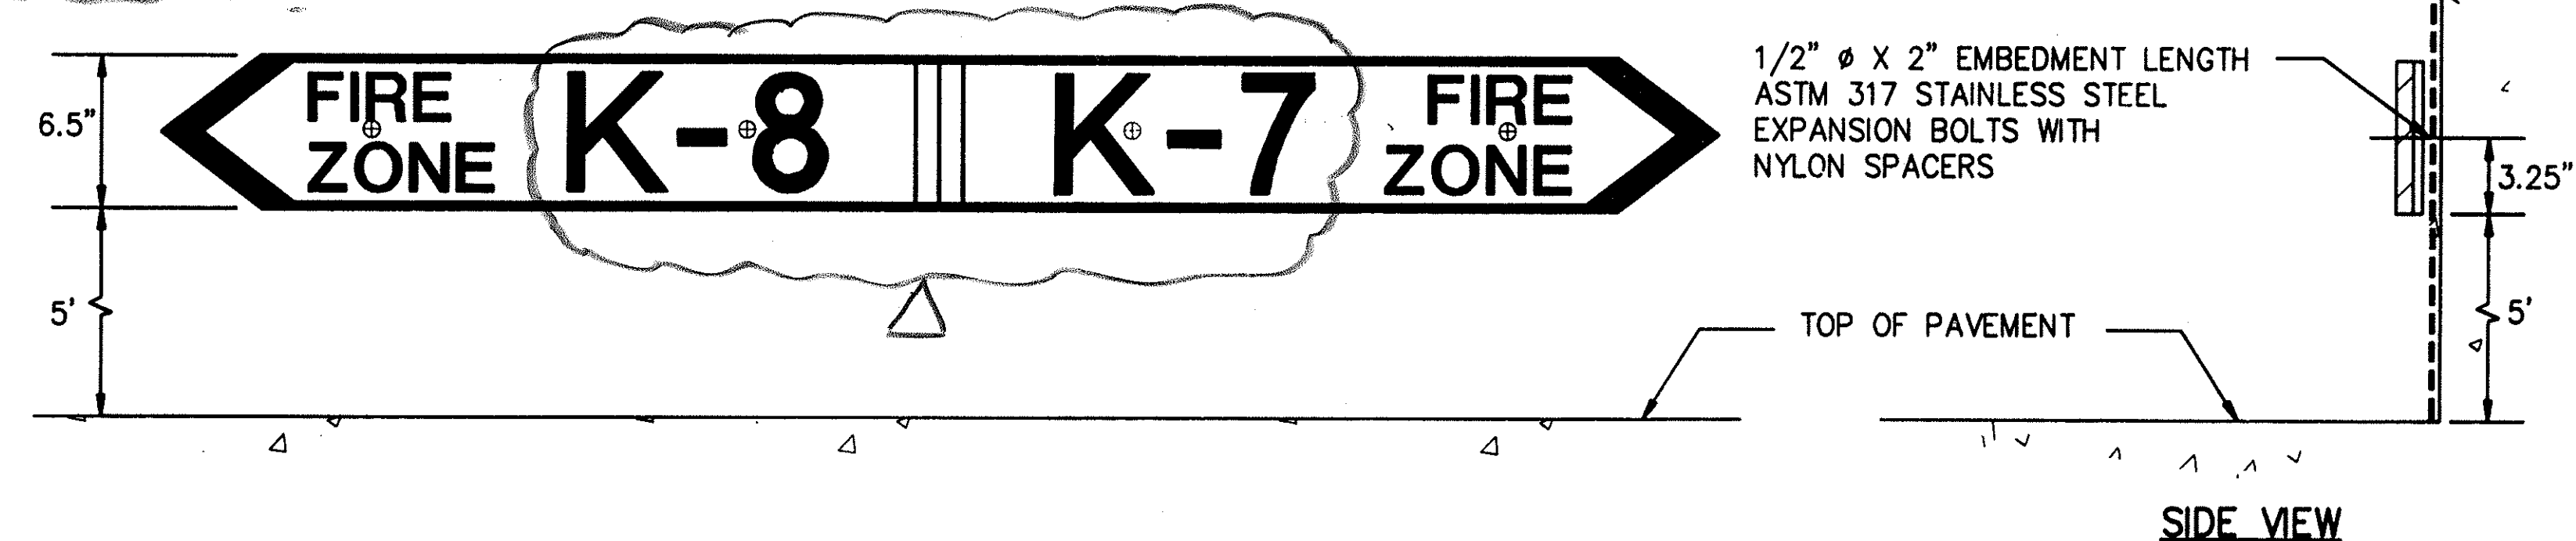


FIRE ZONE SIGN MOUNTING SECTION  
B

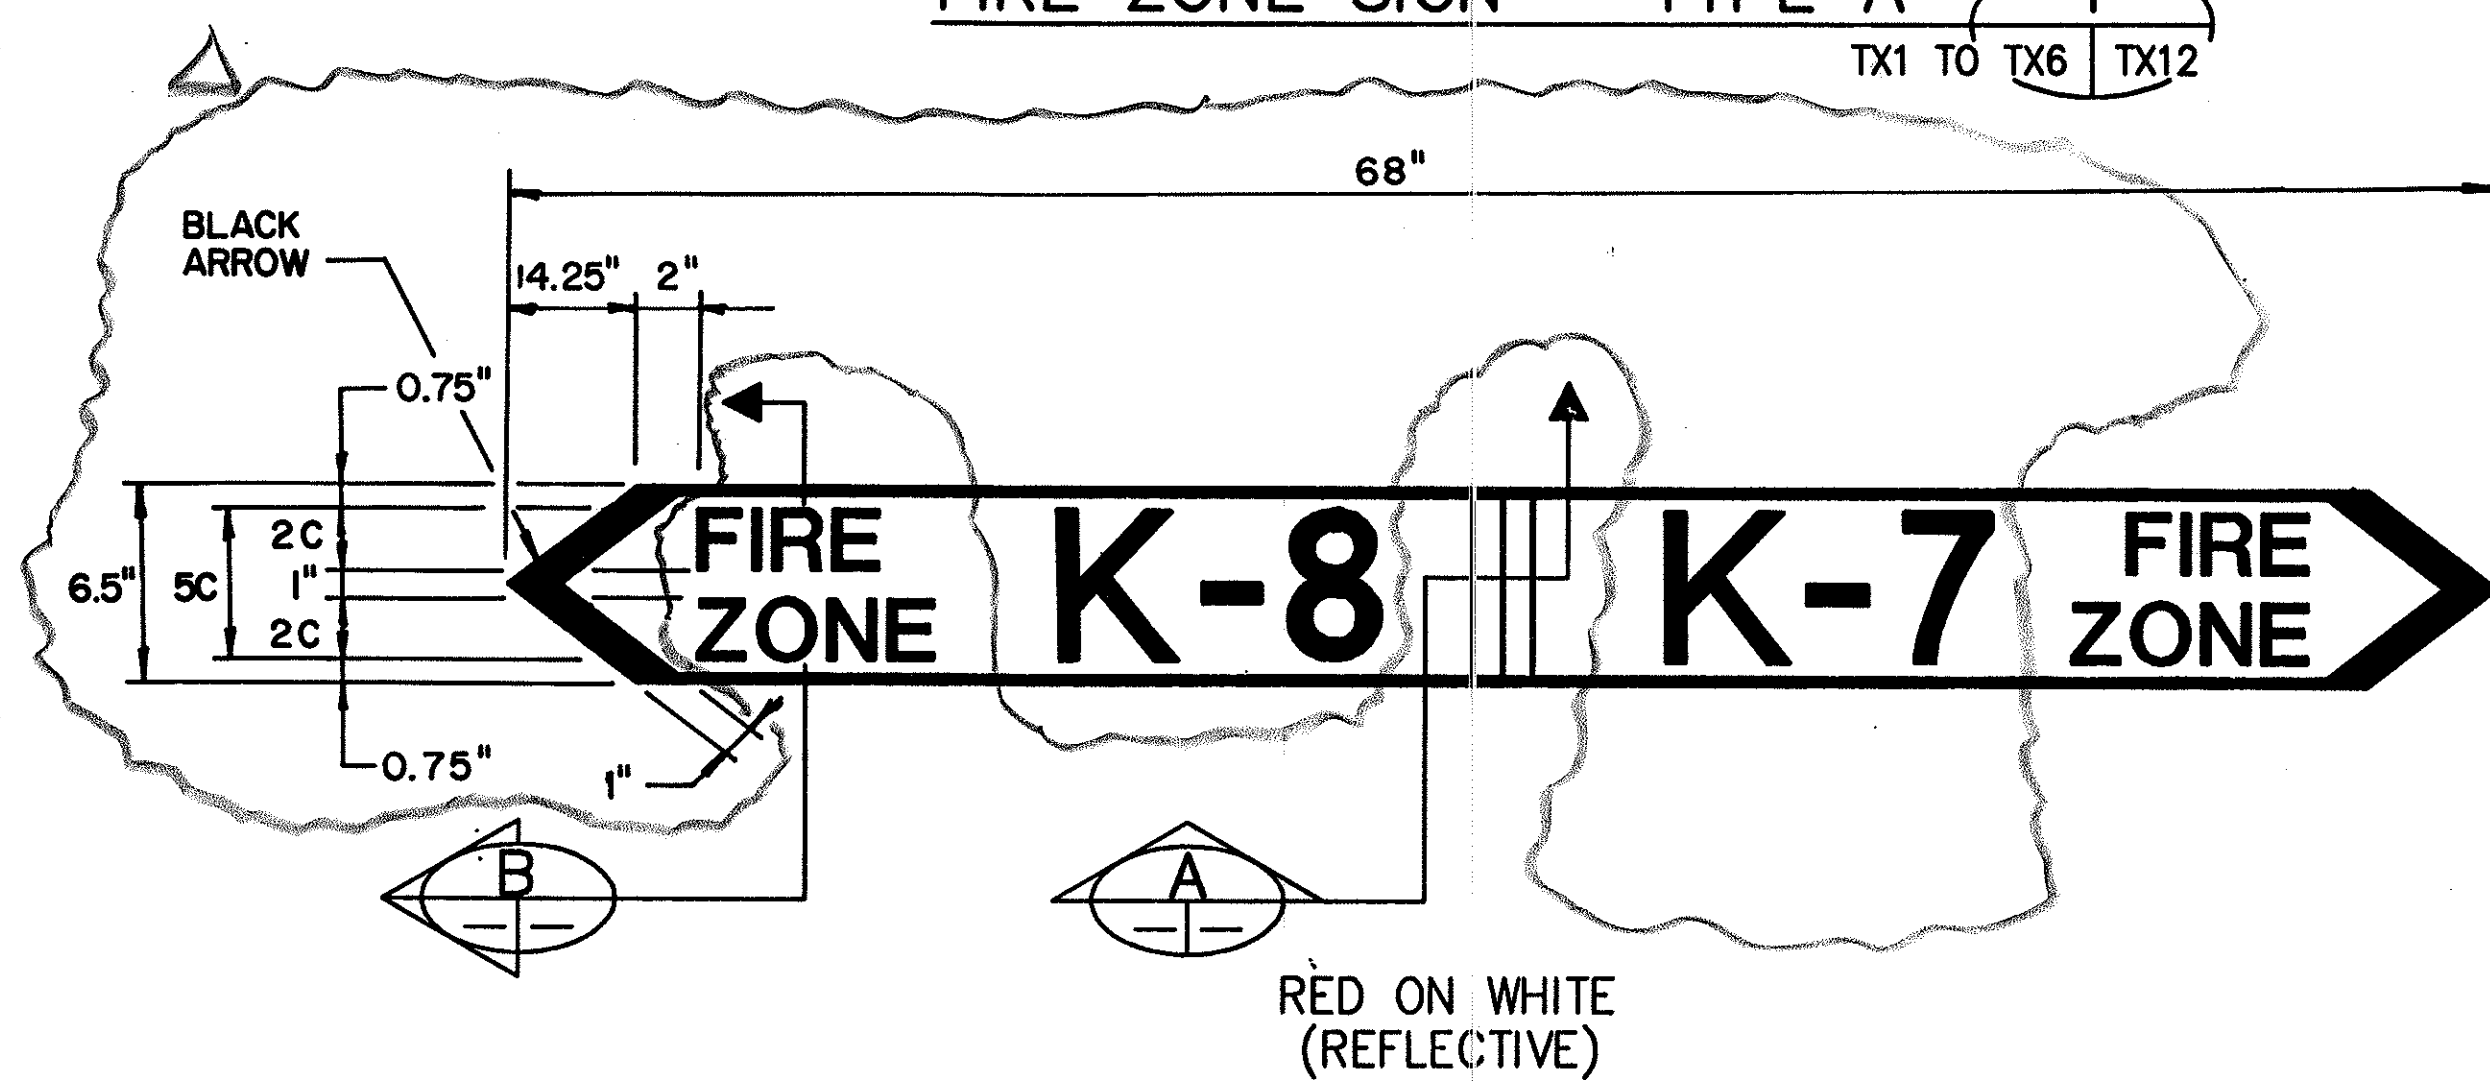

FIRE ZONE SIGN - TYPE B  
TX1 TO TX6 TX12

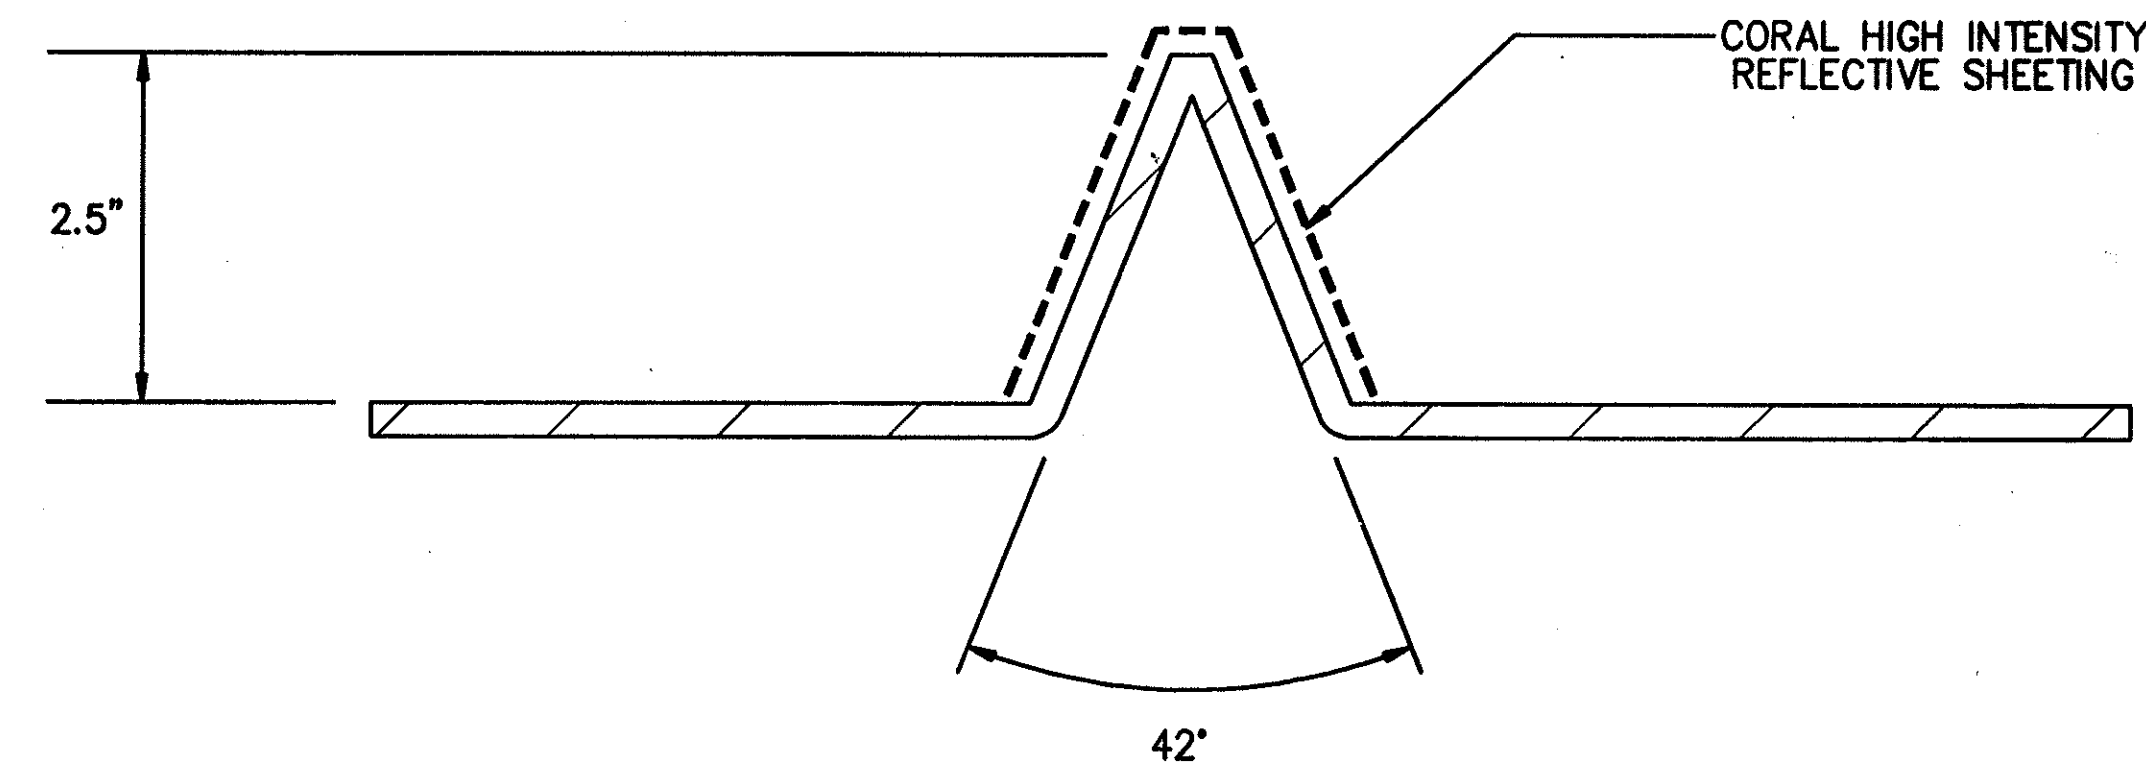

SIGN SECTION  
A

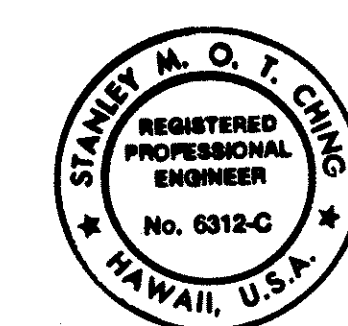


THIS WORK WAS PREPARED BY ME OR UNDER MY SUPERVISION  
*Stanley M. O. T. Ching*

| DATE                        | REVISION                                              |
|-----------------------------|-------------------------------------------------------|
| 1/4/94                      | ADDED FIRE ZONE PLAN AND REVISED SIGNS PER DCN 66-028 |
| SIGNING DETAILS - 2         |                                                       |
| SIGNING & STRIPING          |                                                       |
| INTERSTATE ROUTE H-3        |                                                       |
| F.A.I. PROJ. NO. I-H3-1(66) |                                                       |
| SCALE: NONE                 | DATE: APR 1992                                        |
| SHEET NO. TX11 OF 12 SHEETS |                                                       |


|                   |              |
|-------------------|--------------|
| DATE              | 12/13/91     |
| SURVEY PLOTTED BY | CADD         |
| DRAWN BY          | N. TRAN      |
| DESIGNED BY       | D. MCCORMICK |
| CHECKED BY        |              |
| ORIGINAL PLAN     |              |
| NO.               |              |




| FED. ROAD<br>DIST. NO. | STATE | FED. AID<br>PROJ. NO. | FISCAL<br>YEAR | SHEET<br>NO. | TOTAL<br>SHEETS |
|------------------------|-------|-----------------------|----------------|--------------|-----------------|
| HAWAII                 | HAW.  | I-H3-1(66)            | 1992           | 410          | 440             |

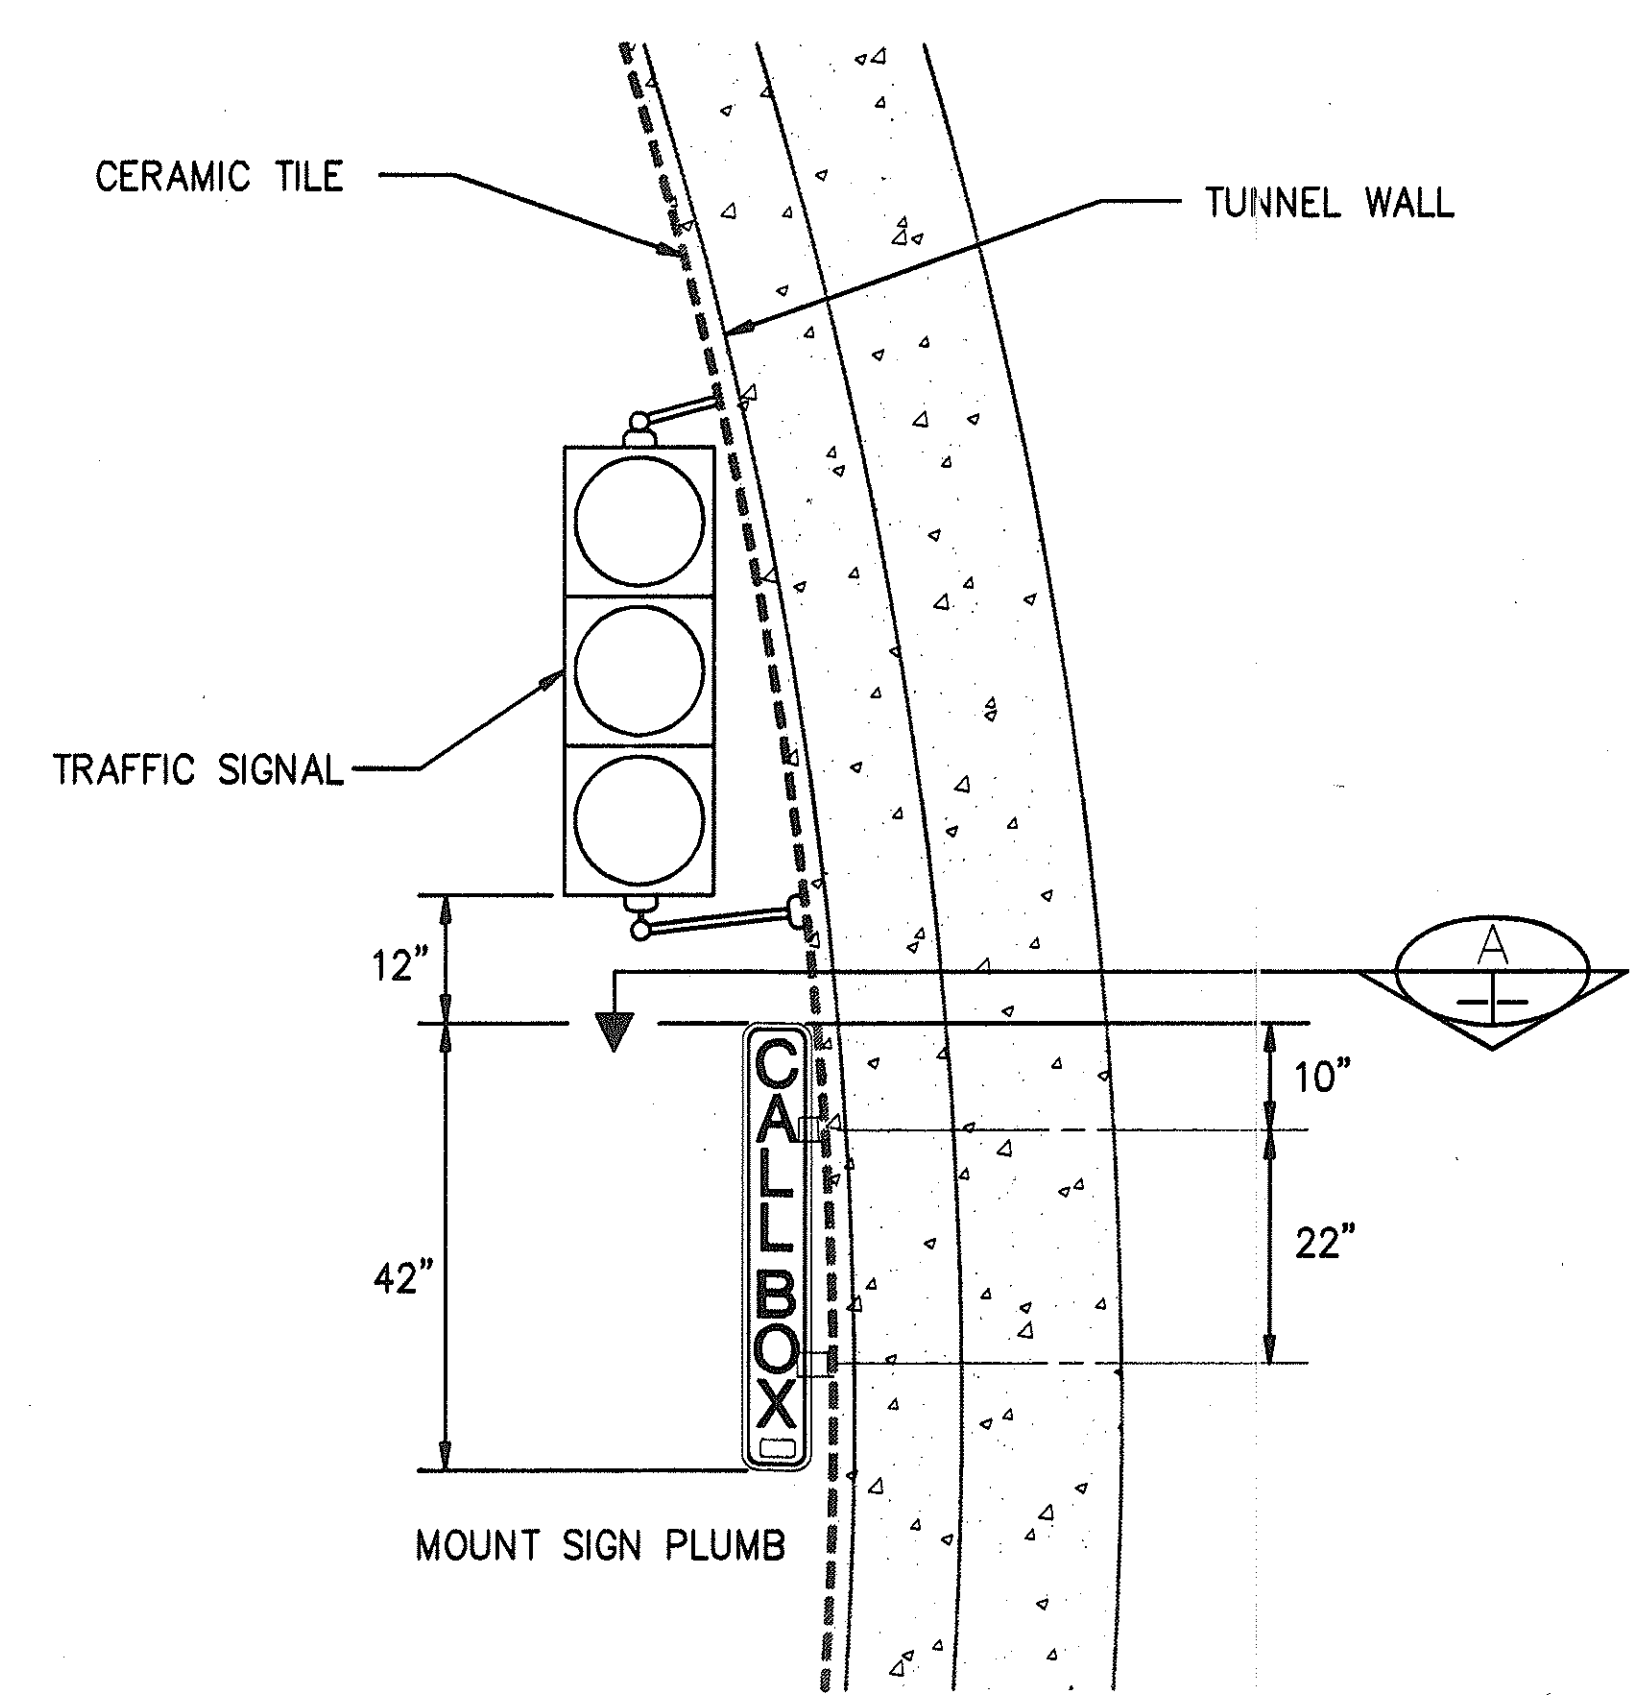



TUNNEL WALL MOUNTED SIGN DETAIL

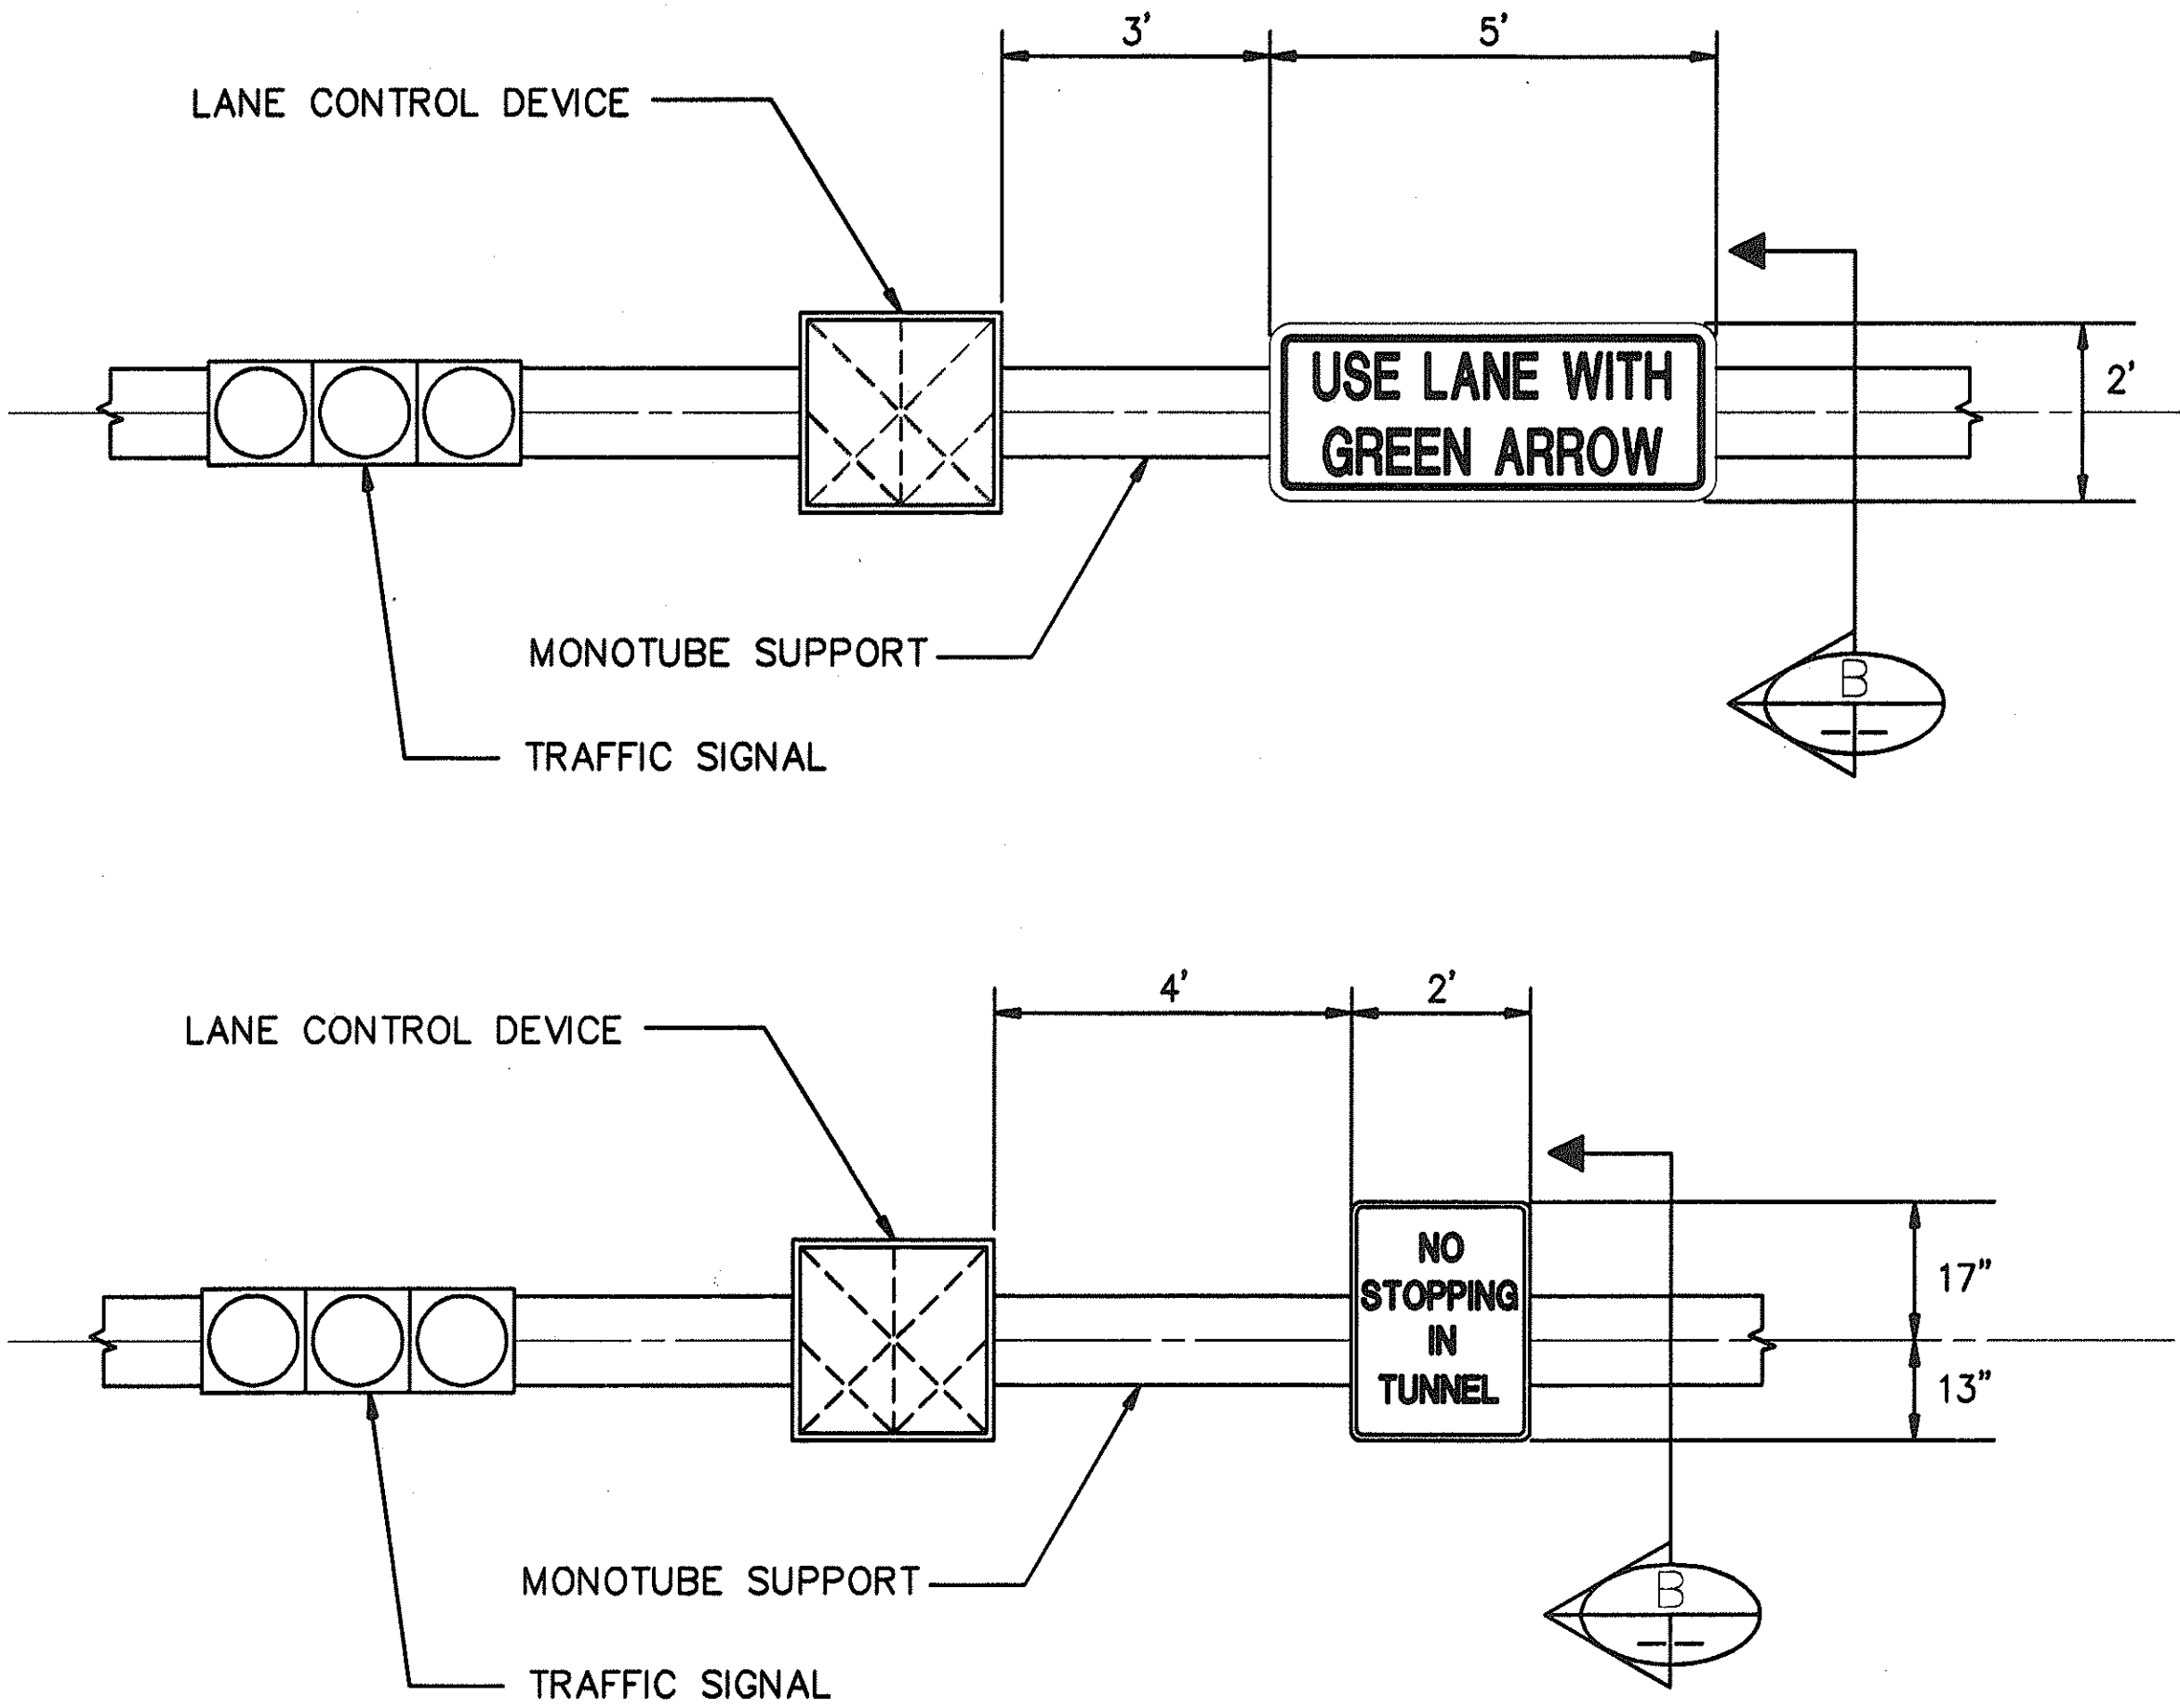



OVERHEAD SIGN MOUNTING DETAILS

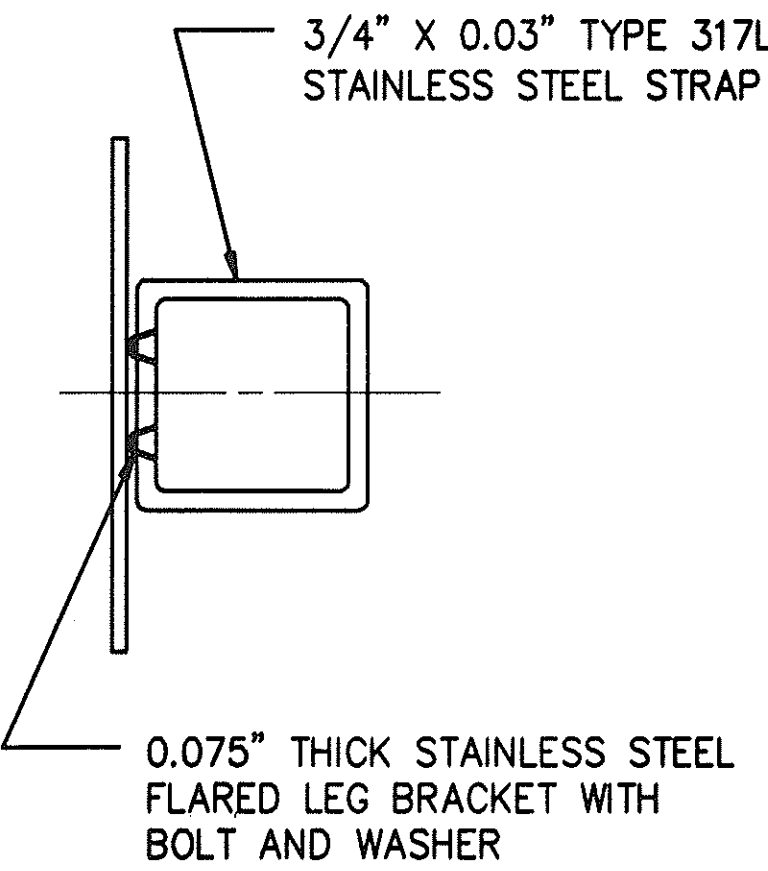

OVERHEAD SIGN MOUNTING SECTION

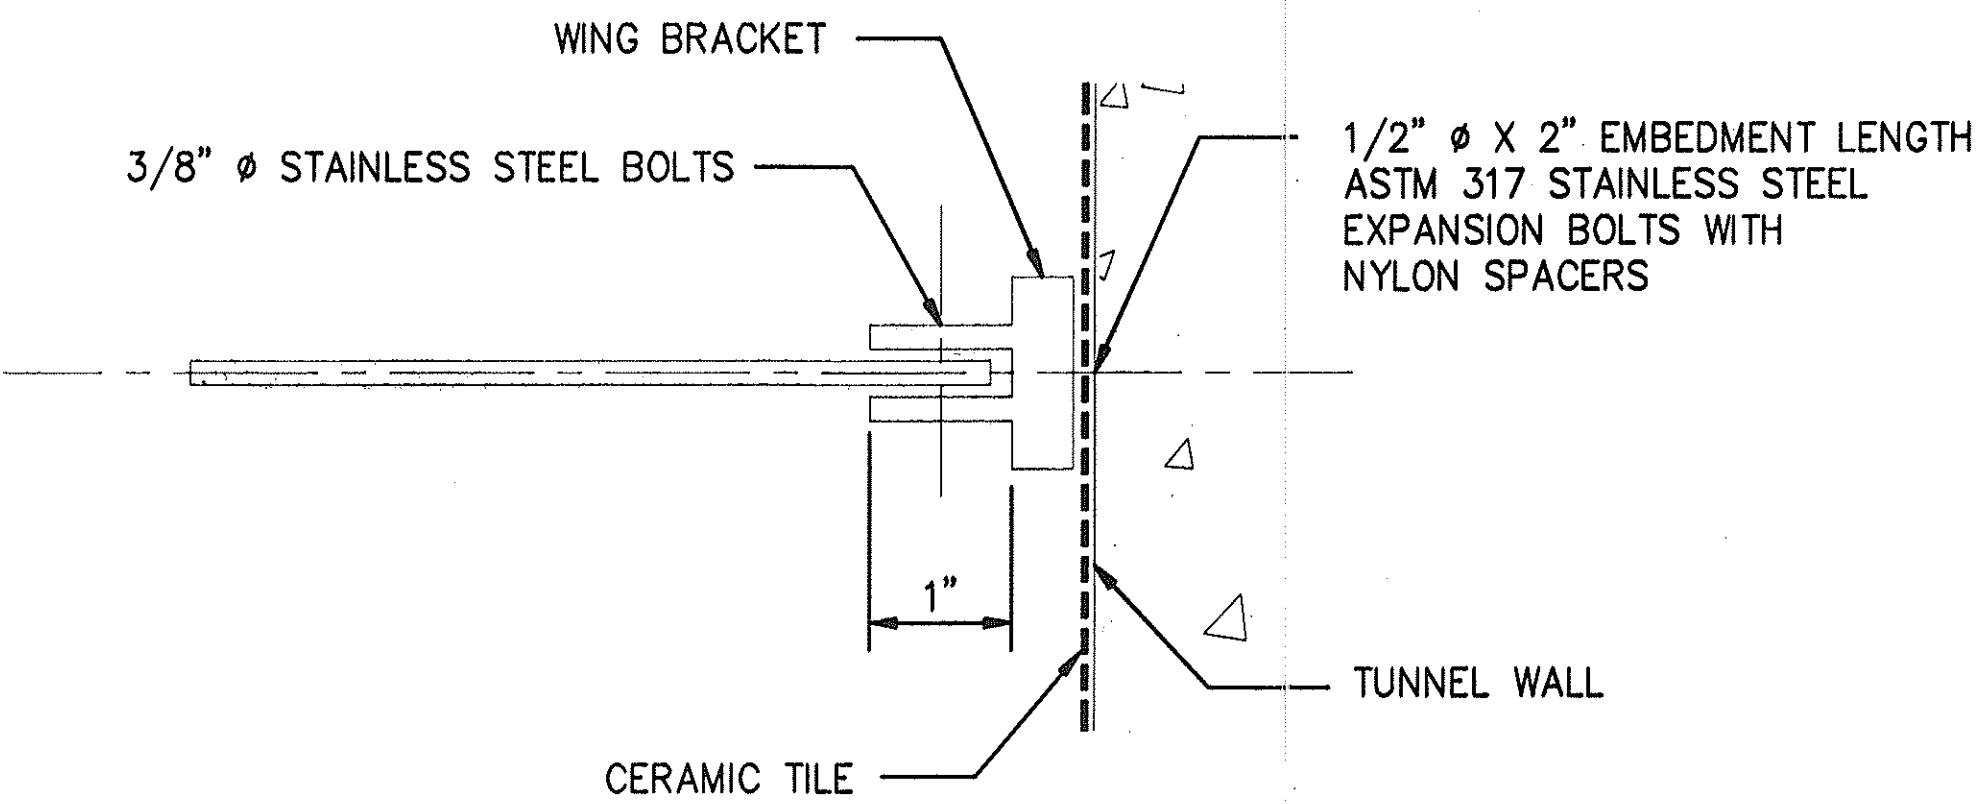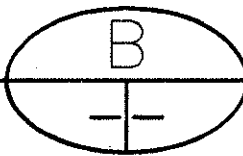

TUNNEL WALL MOUNTING SECTION

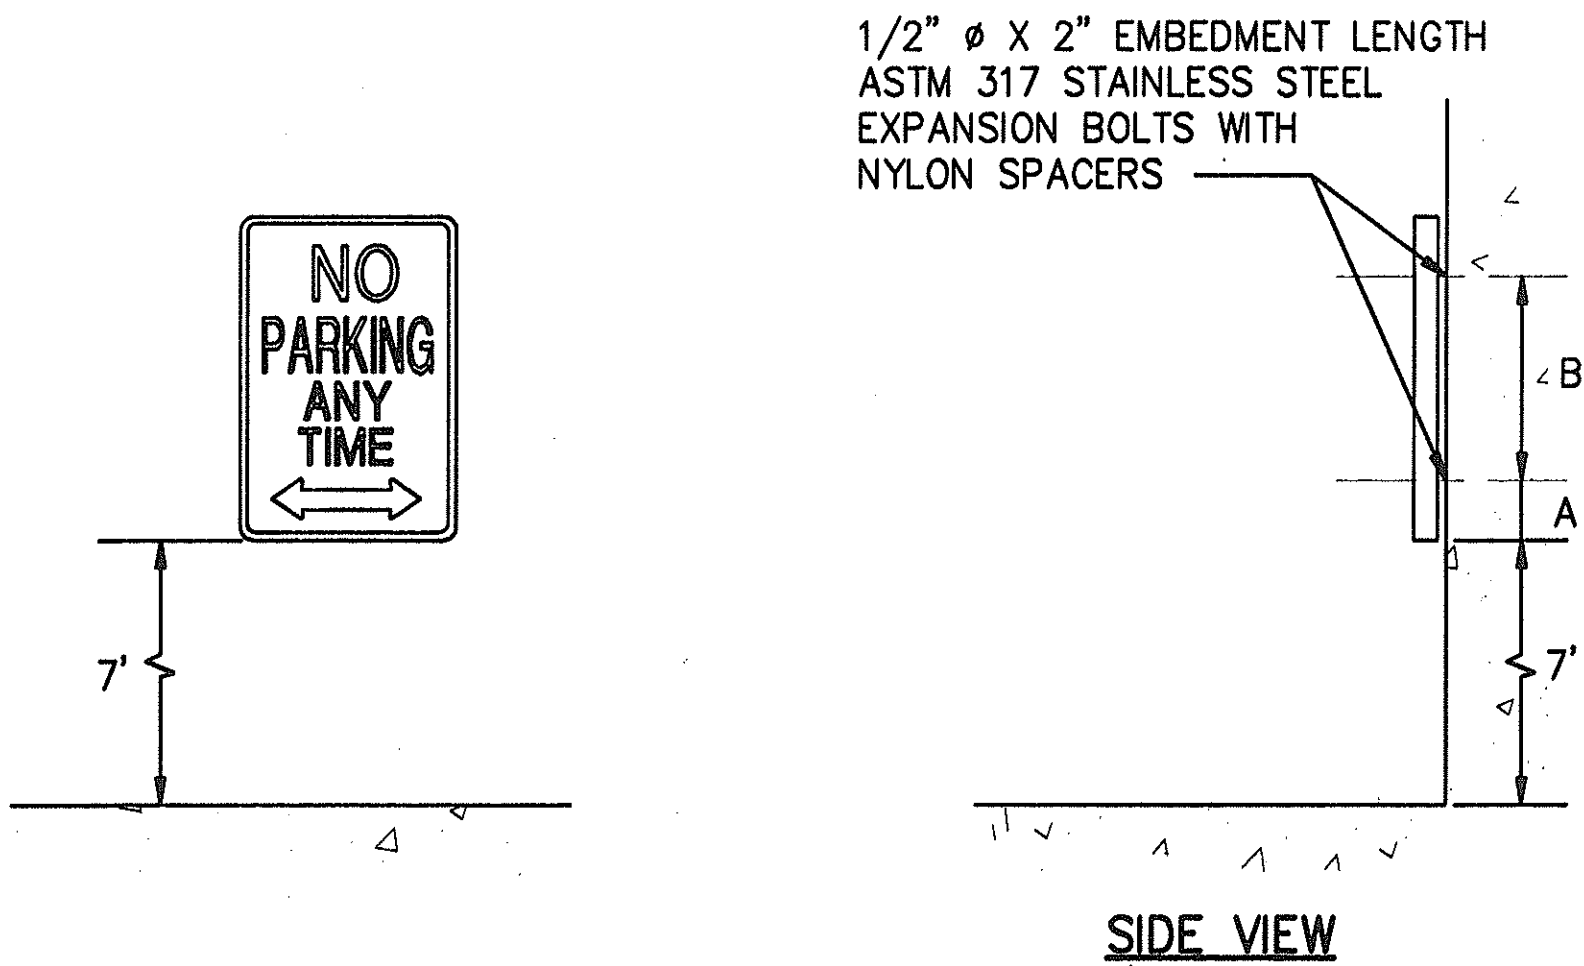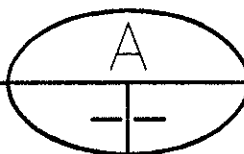

WALL MOUNTED SIGN DETAIL

| WALL MOUNTED SIGNS | DIM "A" | DIM "B" |
|--------------------|---------|---------|
| R7-1-A             | 6"      | 18"     |
| R7-6               | 4"      | 10"     |

NOTES:

1. WORK IN THIS CONTRACT IS SHOWN BY SOLID LINES.
2. WORK IN PREVIOUS CONTRACTS IS SHOWN BY SCREENED DELINEATION.
3. FOR SIGNING DETAILS, SEE SHEET NO. TX10 & TX11.

DATE REVISION

STATE OF HAWAII  
DEPARTMENT OF TRANSPORTATION  
HIGHWAYS DIVISION

MOUNTING DETAILS

SIGNING & STRIPING


INTERSTATE ROUTE H-3

F.A.I. PROJ. NO. I-H3-1(66)

SCALE: NONE

DATE: APR 1992

SHEET NO. TX12 OF 12 SHEETS

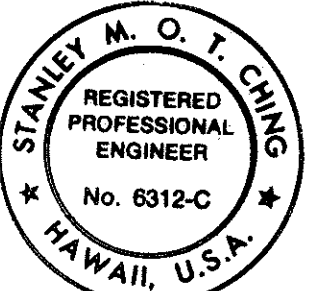

THIS WORK WAS PREPARED BY ME  
OR UNDER MY SUPERVISION

Stanley M. O. T. Chung

|                        |                           |
|------------------------|---------------------------|
| SURVEY PLOTTED BY: CAD | DATE: 12/13/91            |
| DRAWN BY: N. TRAN      | DESIGNED BY: D. MCCORMICK |
| NOTED BY: N. TRAN      | CHECKED BY: D. MCCORMICK  |
| NO.:                   |                           |