



FED. ROAD DIST. NO.	STATE	FED. AID PROJ. NO.	FISCAL YEAR	SHEET NO.	TOTAL SHEETS
HAWAII	HAW.	I-H3-1(69)	1992	38	325

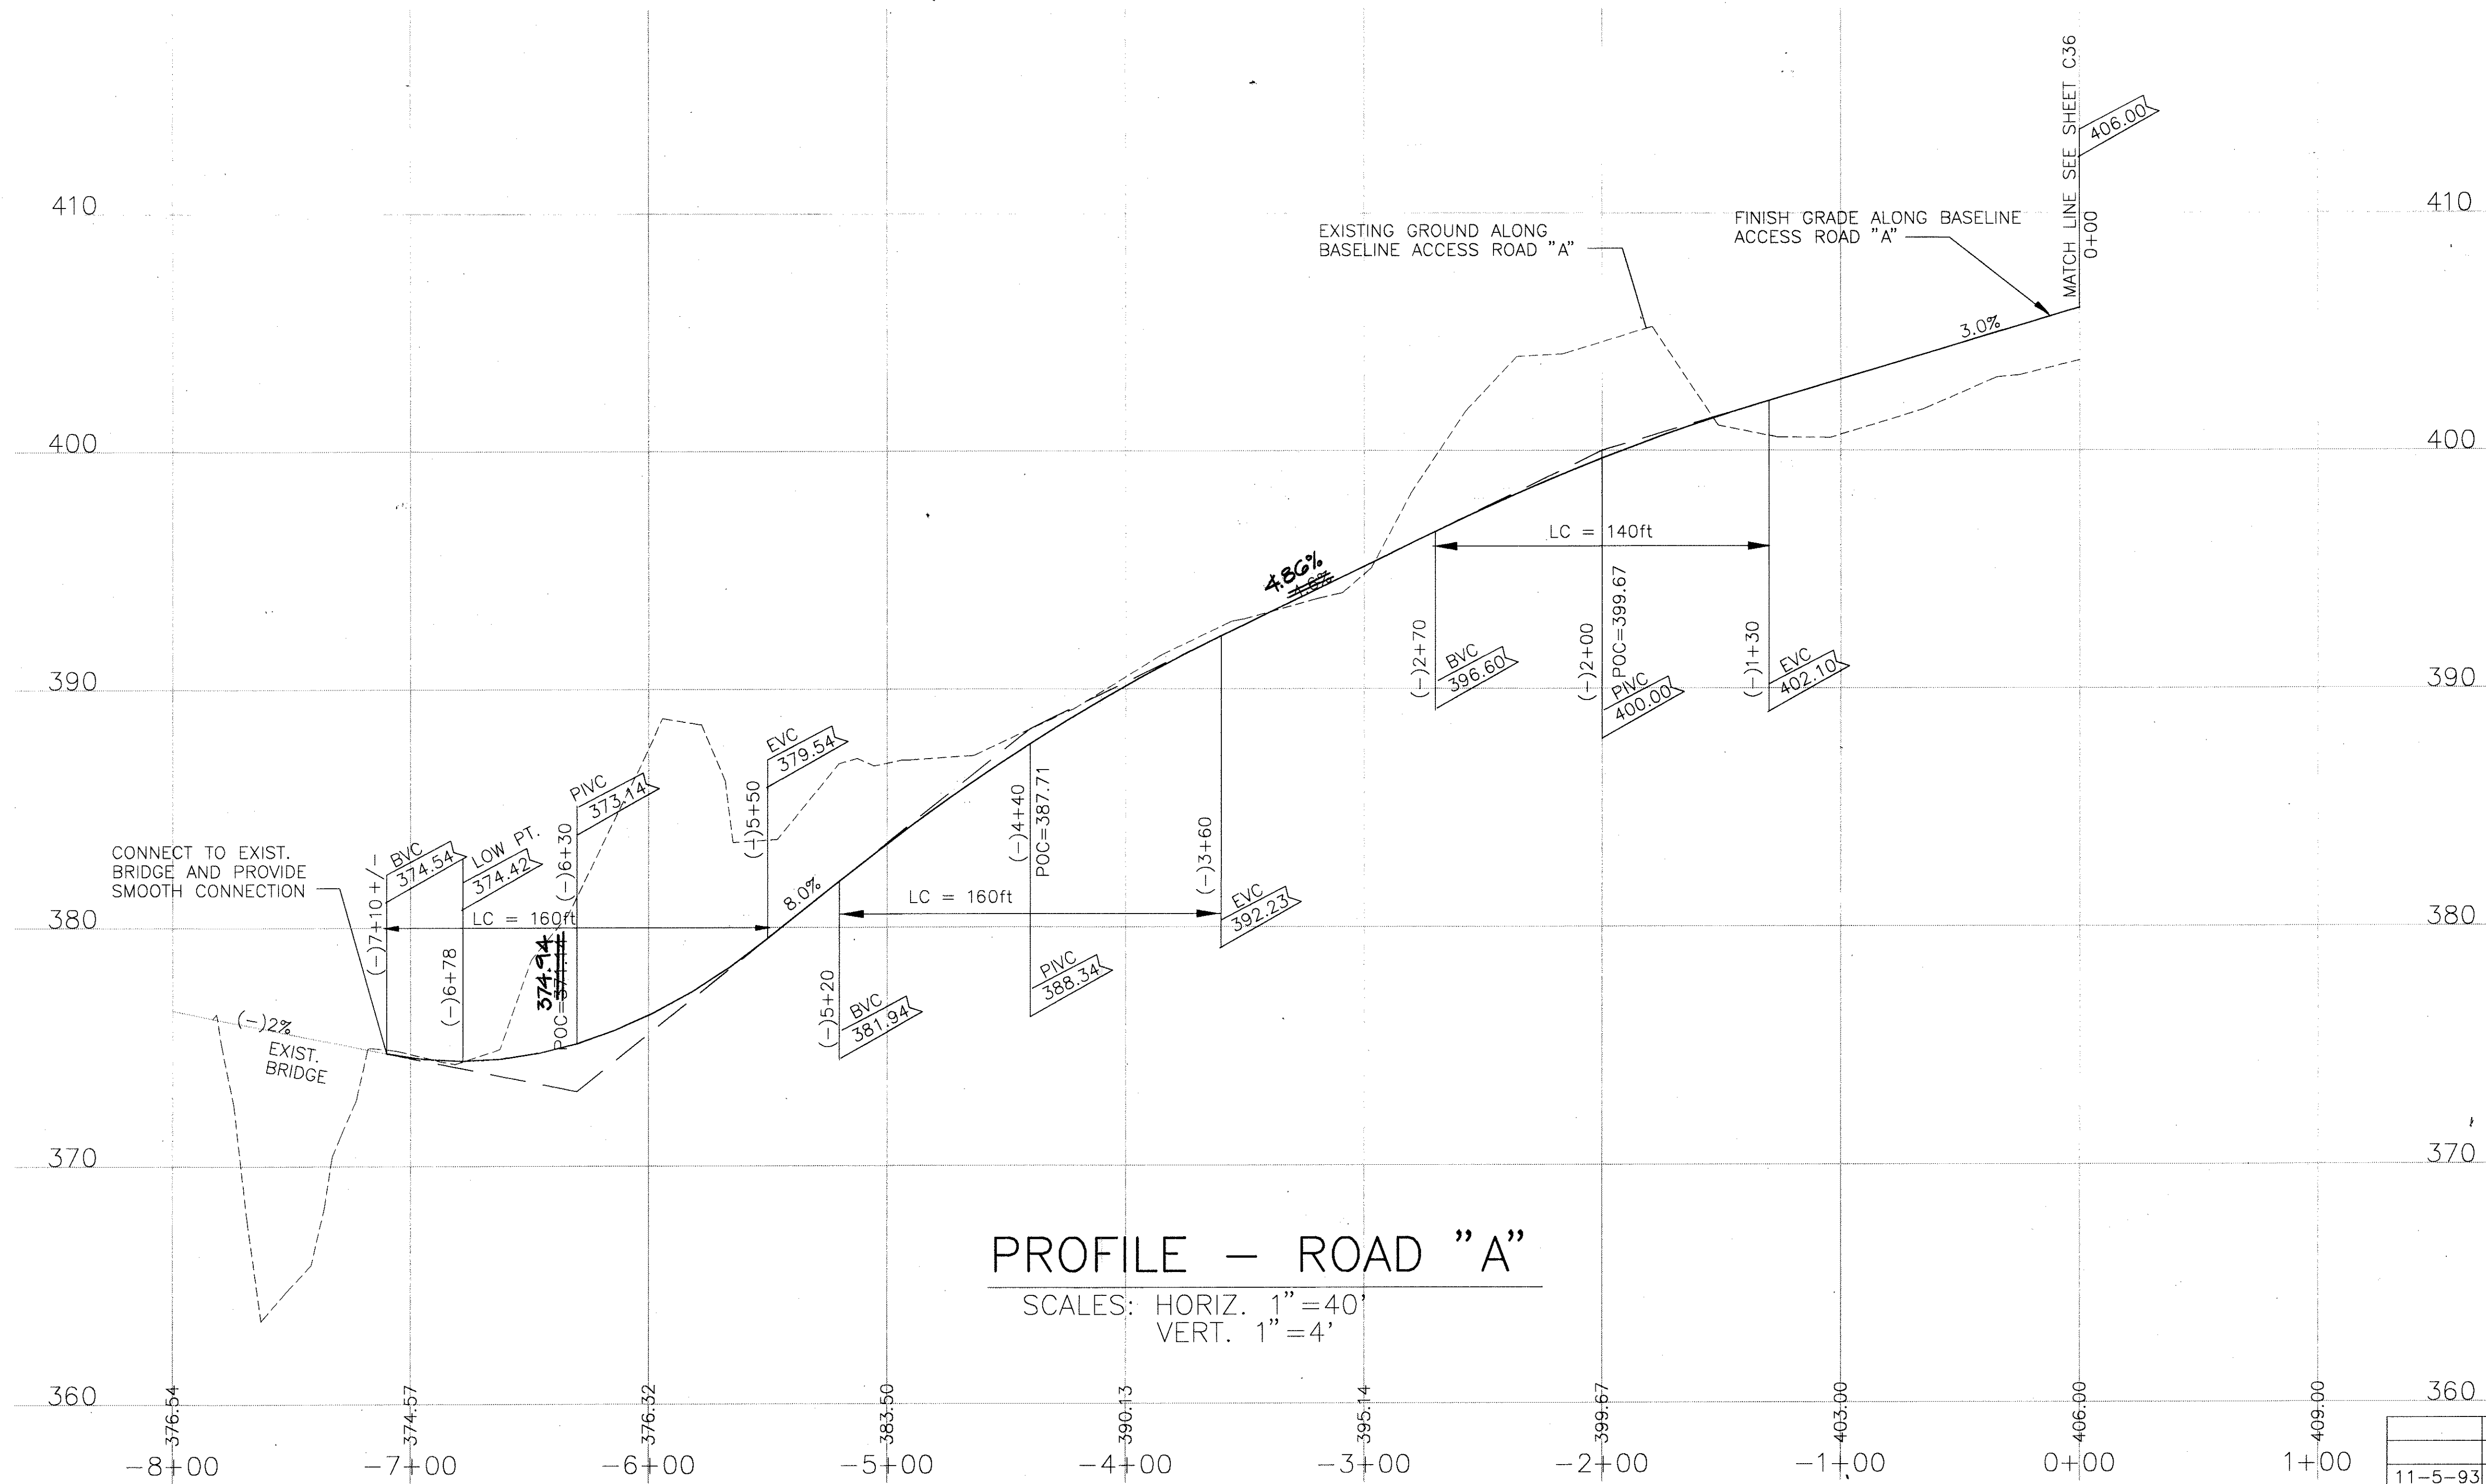

PROFILE — ROAD "A"
 SCALES: HORIZ. 1"=40'
 VERT. 1"=4'

SURVEY PLOTTED BY	DATE
DRAWN BY	
CHECKED BY	
DESIGNED BY	
QUANTITIES BY	
NO.	


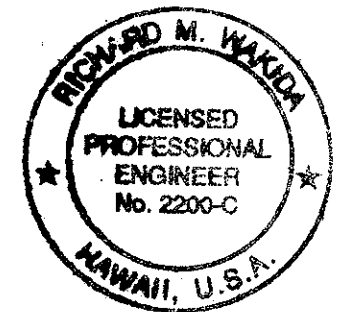


THIS WORK WAS PREPARED BY ME
 OR UNDER MY SUPERVISION.
 SIGNATURE DATE

11-5-93	Revised profile
DATE	REVISION

STATE OF HAWAII DEPARTMENT OF TRANSPORTATION HIGHWAYS DIVISION	
PROFILE ACCESS ROAD "A" STA 1+00 TO STA (-7+10+/-)	
INTERSTATE ROUTE H-3 F.A.I. PROJECT NO. I-H3-1(69) & (70)	
SCALE: AS NOTED	DATE: MARCH 1992
SHEET No. C35 OF 95 SHEETS	

FED. ROAD DIST. NO.	STATE	FED. AID PROJ. NO.	FISCAL YEAR	SHEET NO.	TOTAL SHEETS
HAWAII	HAW.	I-H3-1(69)	1992	39	325

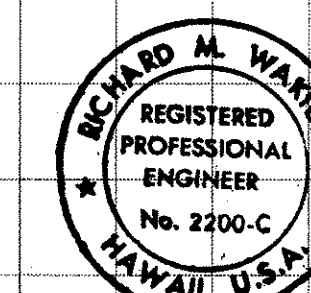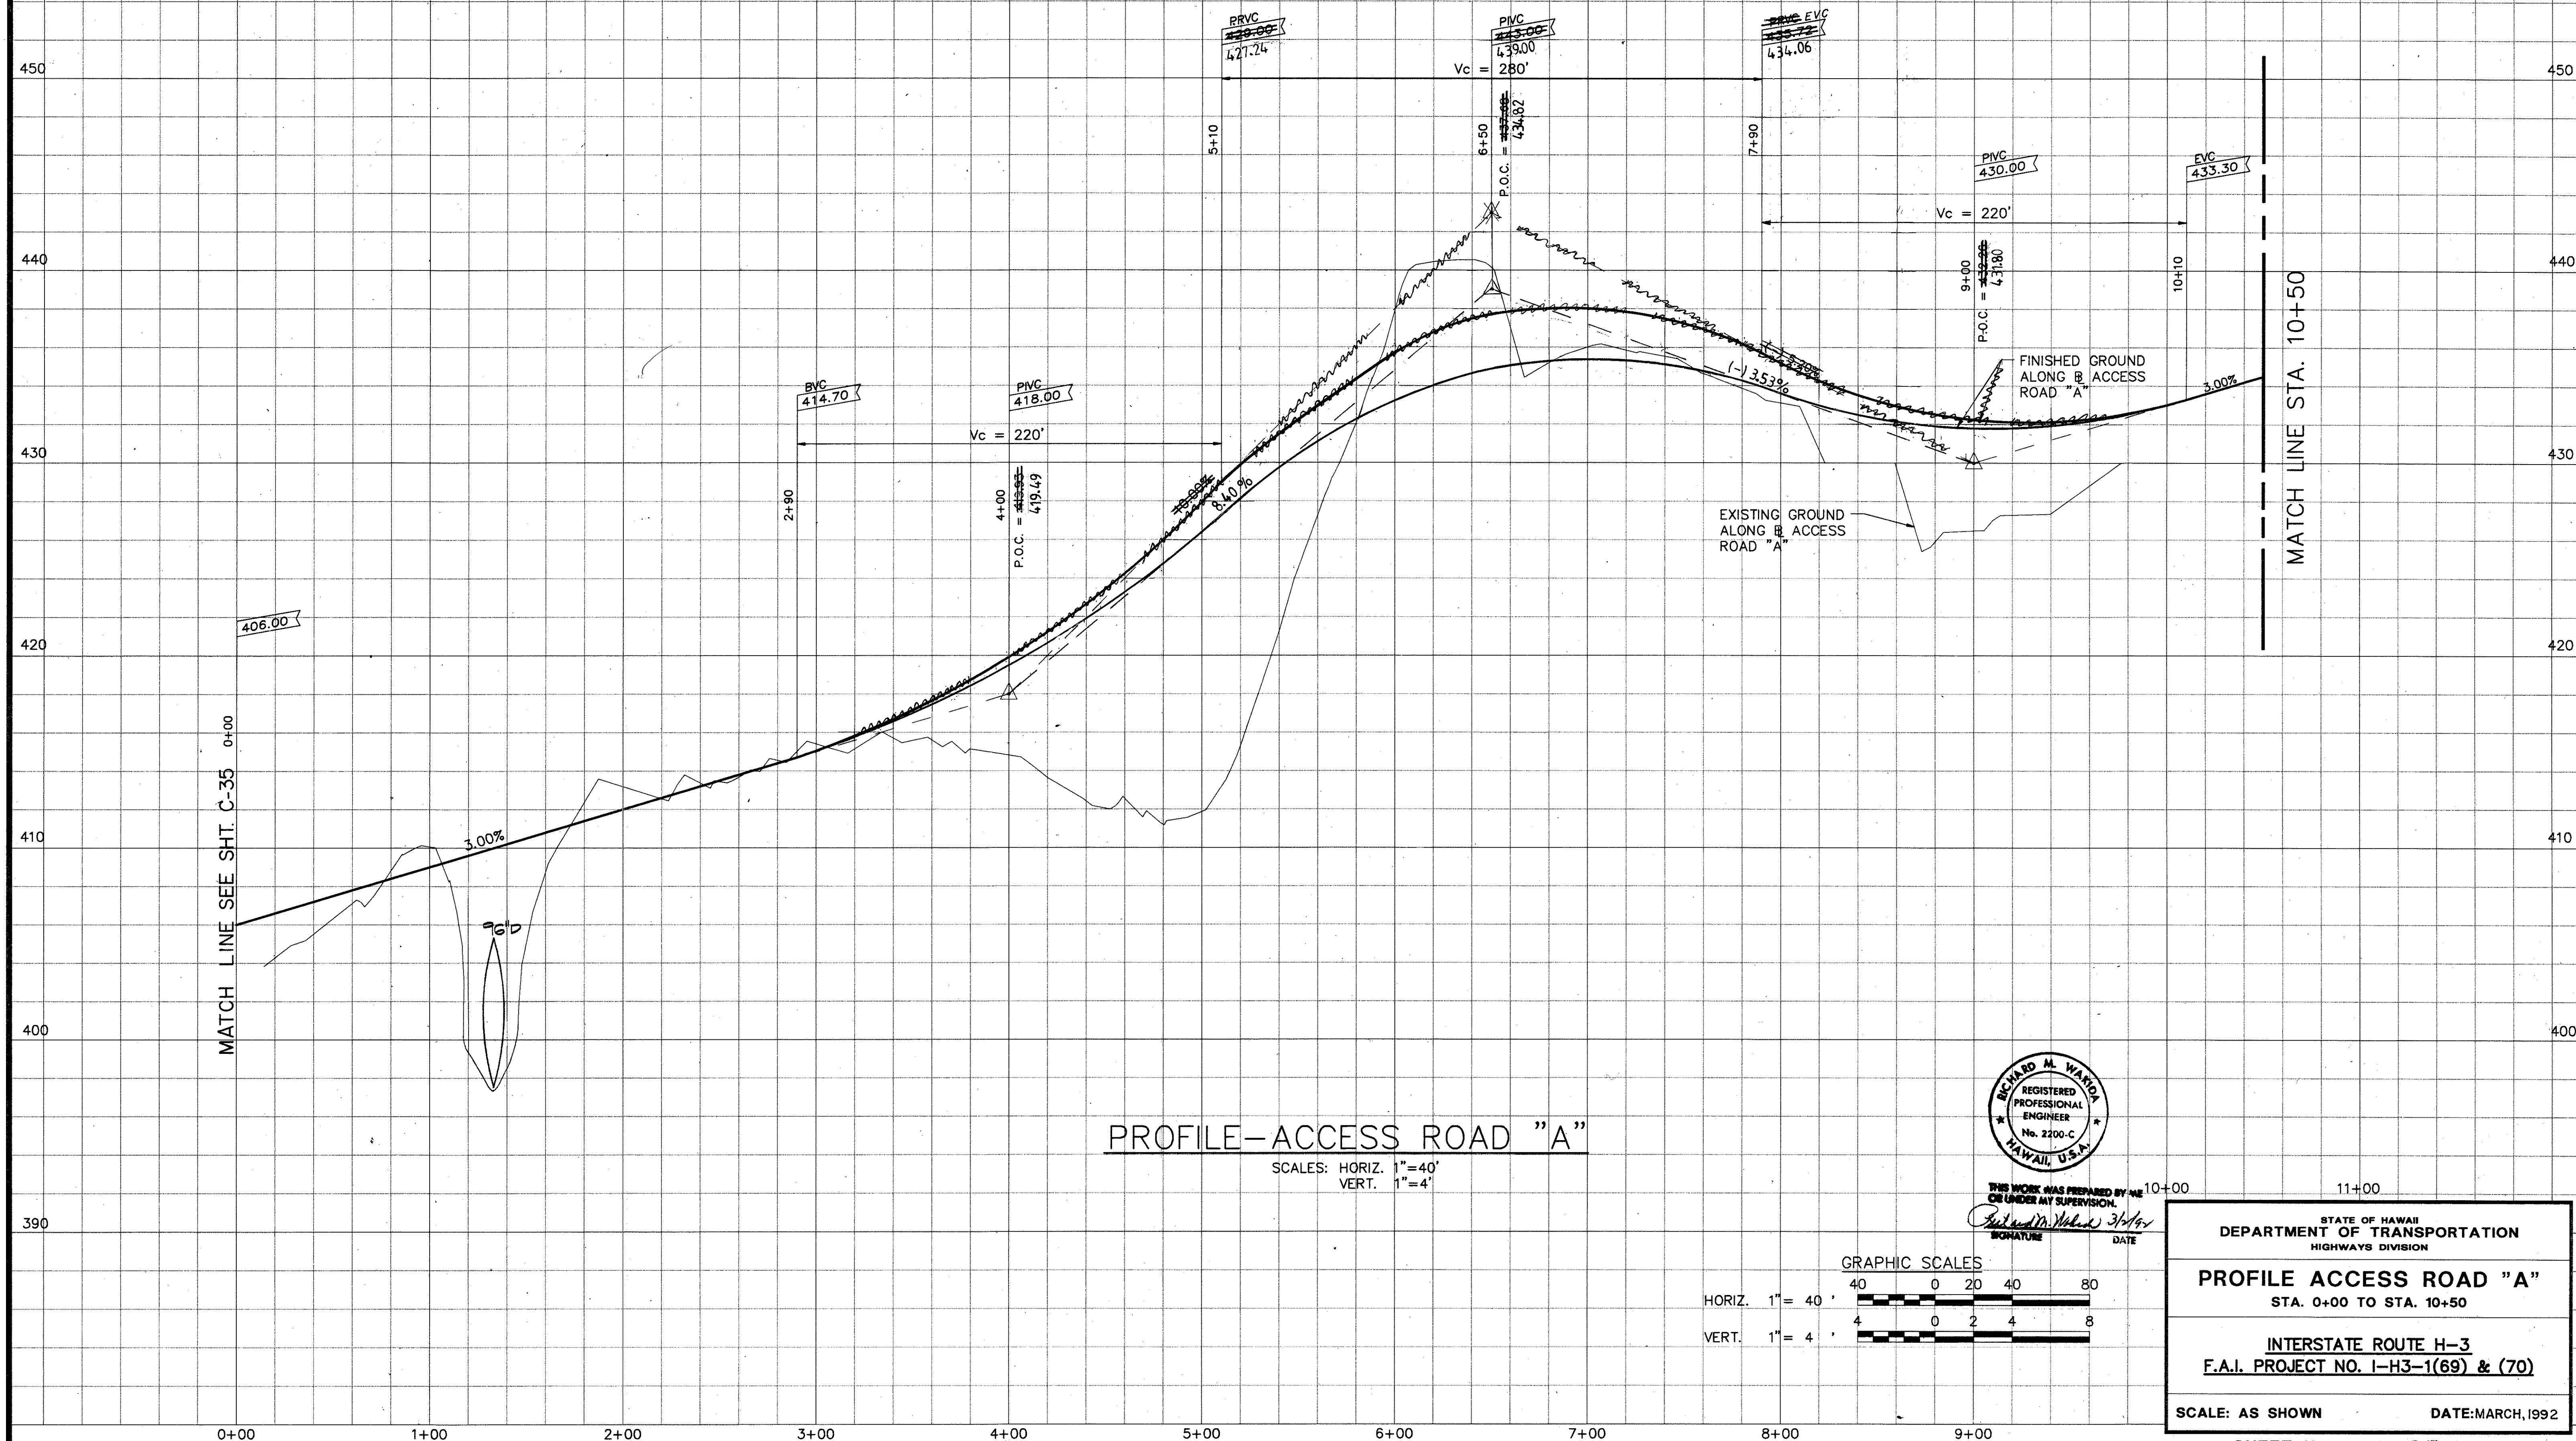

THIS WORK WAS PREPARED BY ME
 OR UNDER MY SUPERVISION.
 Signature: *Richard M. Ward*
 DATE: 3/1/92

STATE OF HAWAII
 DEPARTMENT OF TRANSPORTATION
 HIGHWAYS DIVISION


PROFILE ACCESS ROAD "A"
 STA. 0+00 TO STA. 10+50

INTERSTATE ROUTE H-3
 F.A.I. PROJECT NO. I-H3-1(69) & (70)

SCALE: AS SHOWN DATE: MARCH, 1992


SHEET No. 39 OF 95 SHEETS

FED. ROAD DIST. NO.	STATE	FED. AID PROJ. NO.	FISCAL YEAR	SHEET NO.	TOTAL SHEETS
HAWAII	HAW.	I-H3-1(69)	1992	40	325

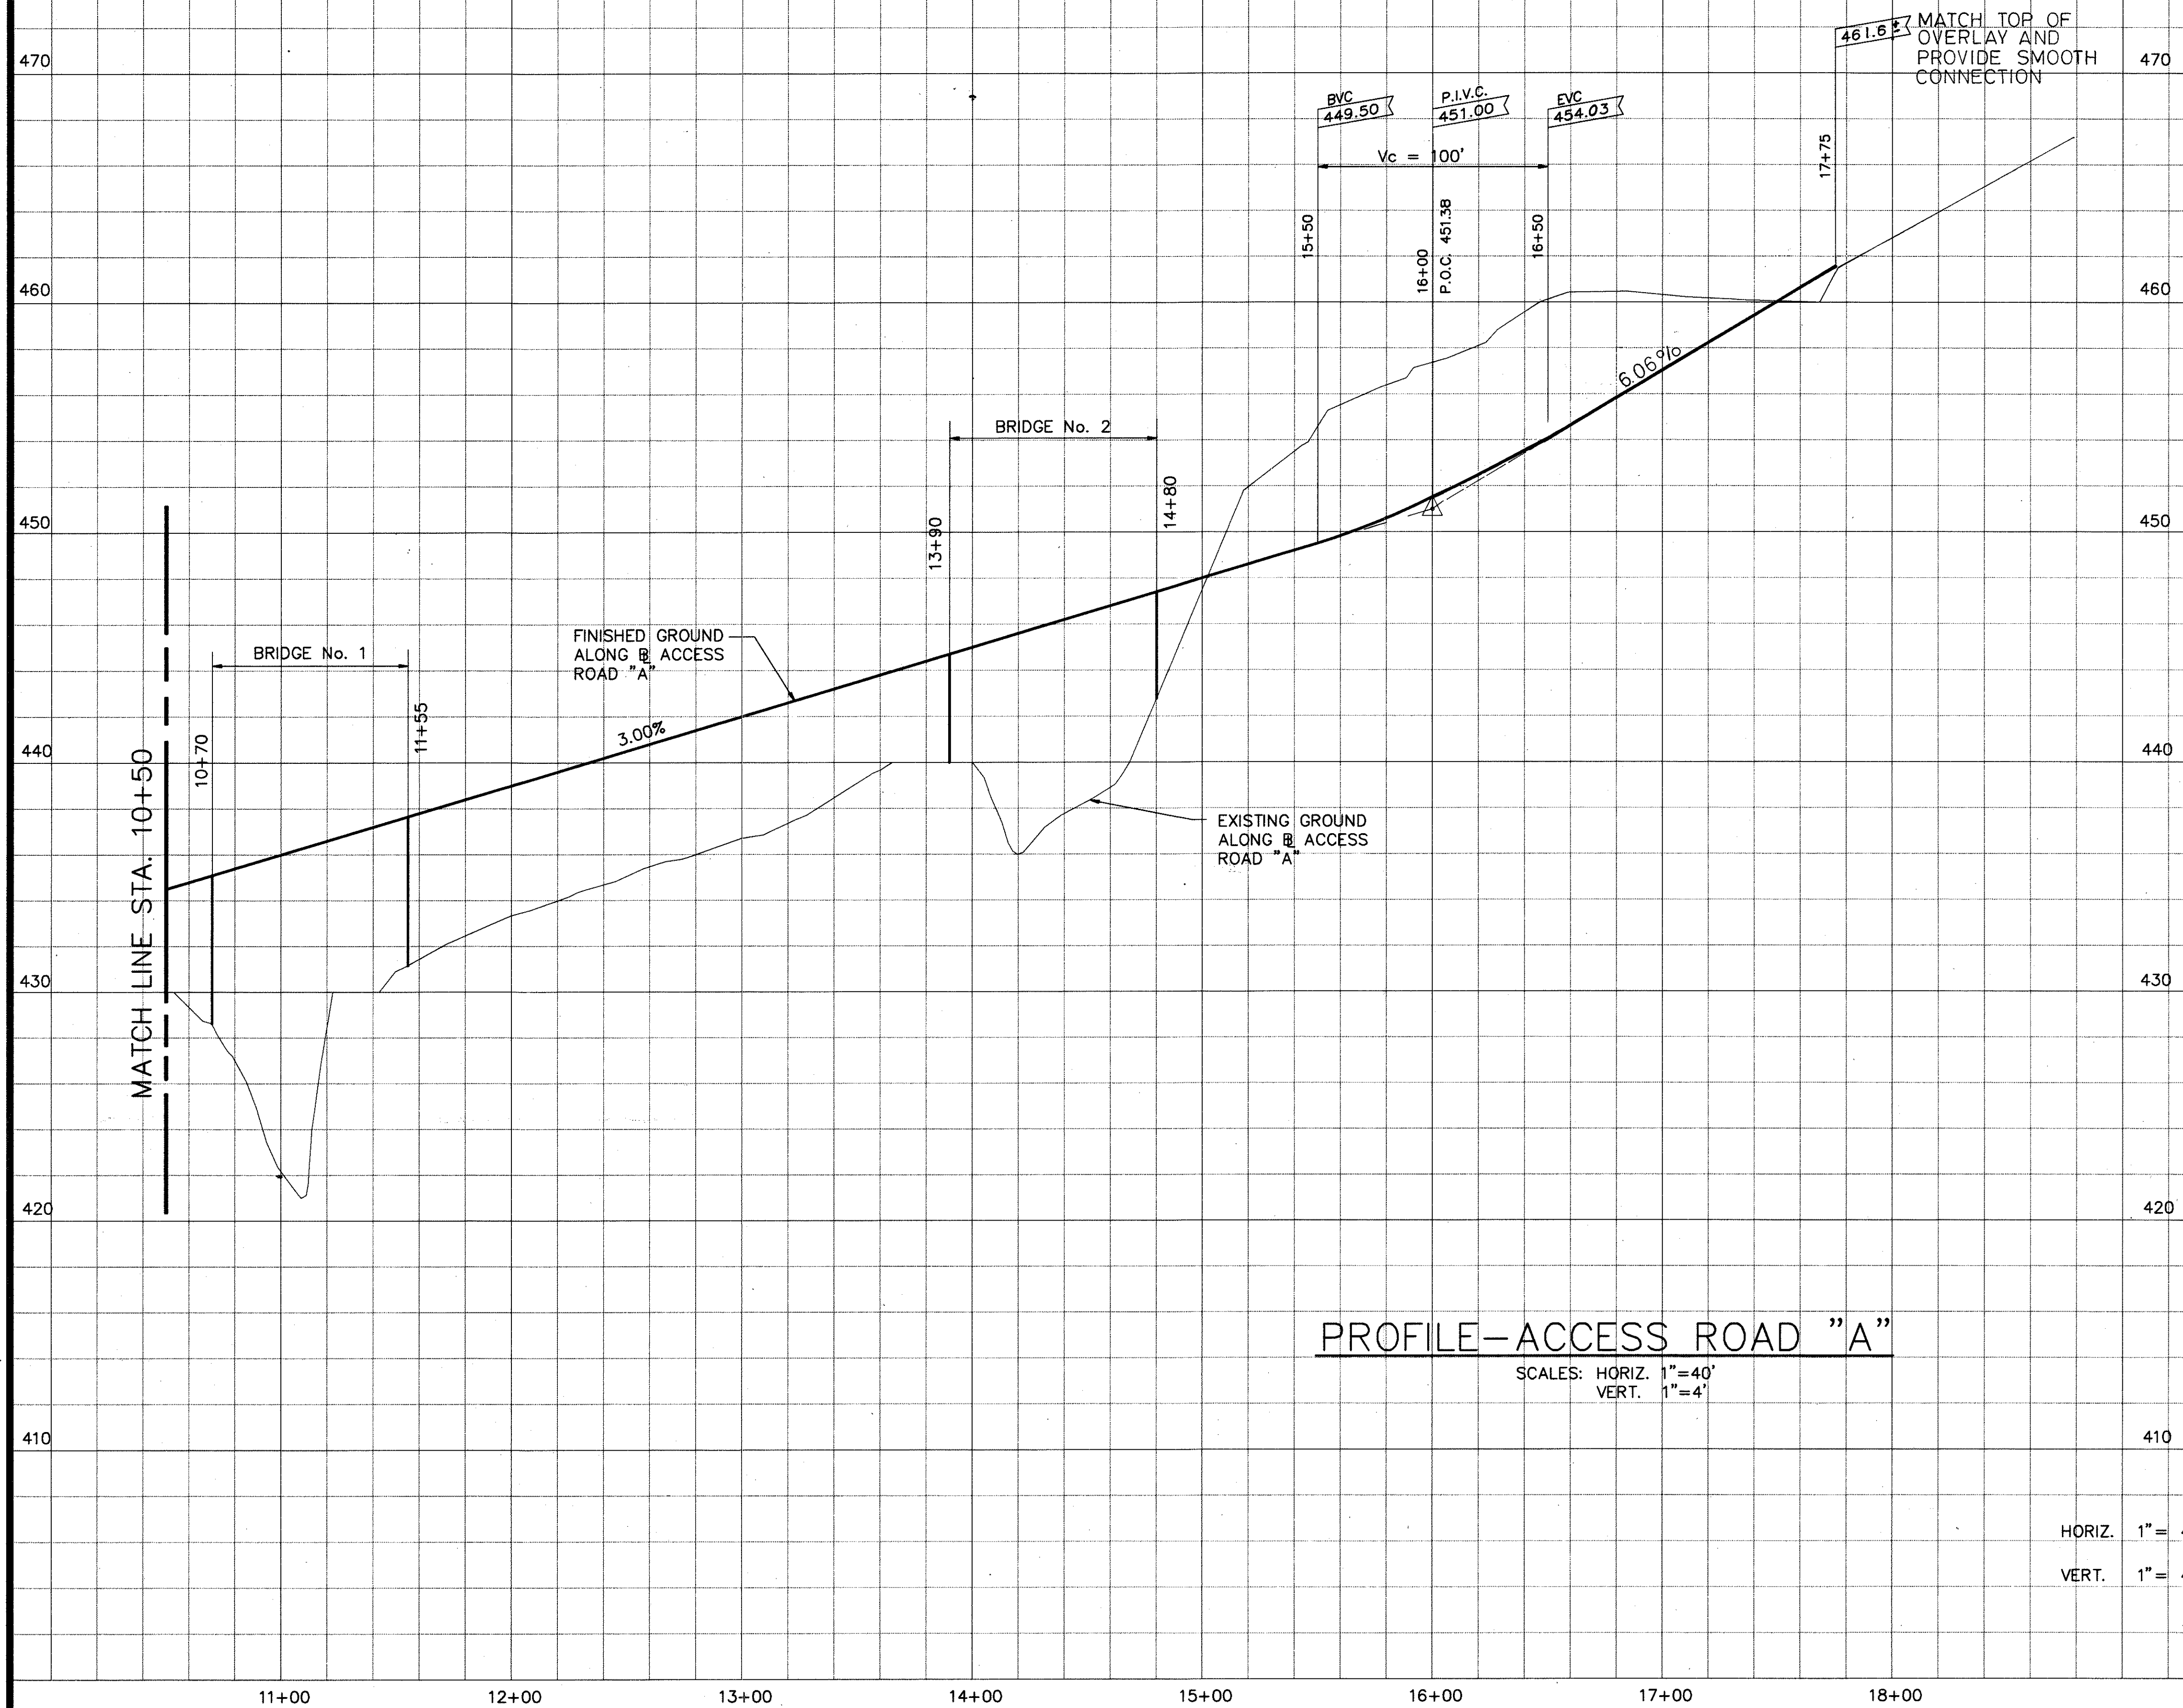


PROFILE-ACCESS ROAD "A"

SCALES: HORIZ. 1"=40'
VERT. 1"=4'

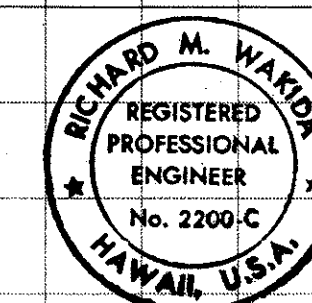

THIS WORK WAS PREPARED BY ME
OR UNDER MY SUPERVISION.
Richard M. Warden
SIGNATURE

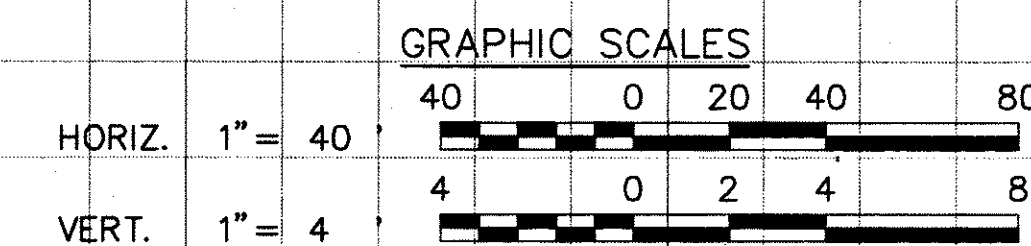



STATE OF HAWAII
DEPARTMENT OF TRANSPORTATION
HIGHWAYS DIVISION

PROFILE ACCESS ROAD "A"
STA. 10+50 TO STA. 17+75

INTERSTATE ROUTE H-3
F.A.I. PROJECT NO. I-H3-1(69) & (70)


SCALE: AS SHOWN
DATE: MARCH, 1992
SHEET No. C37 OF 95 SHEETS

FED. ROAD DIST. NO.	STATE	FED. AID PROJ. NO.	FISCAL YEAR	SHEET NO.	TOTAL SHEETS
HAWAII	HAW.	I-H3-1(69)	1992	41	225

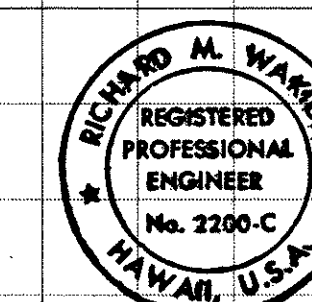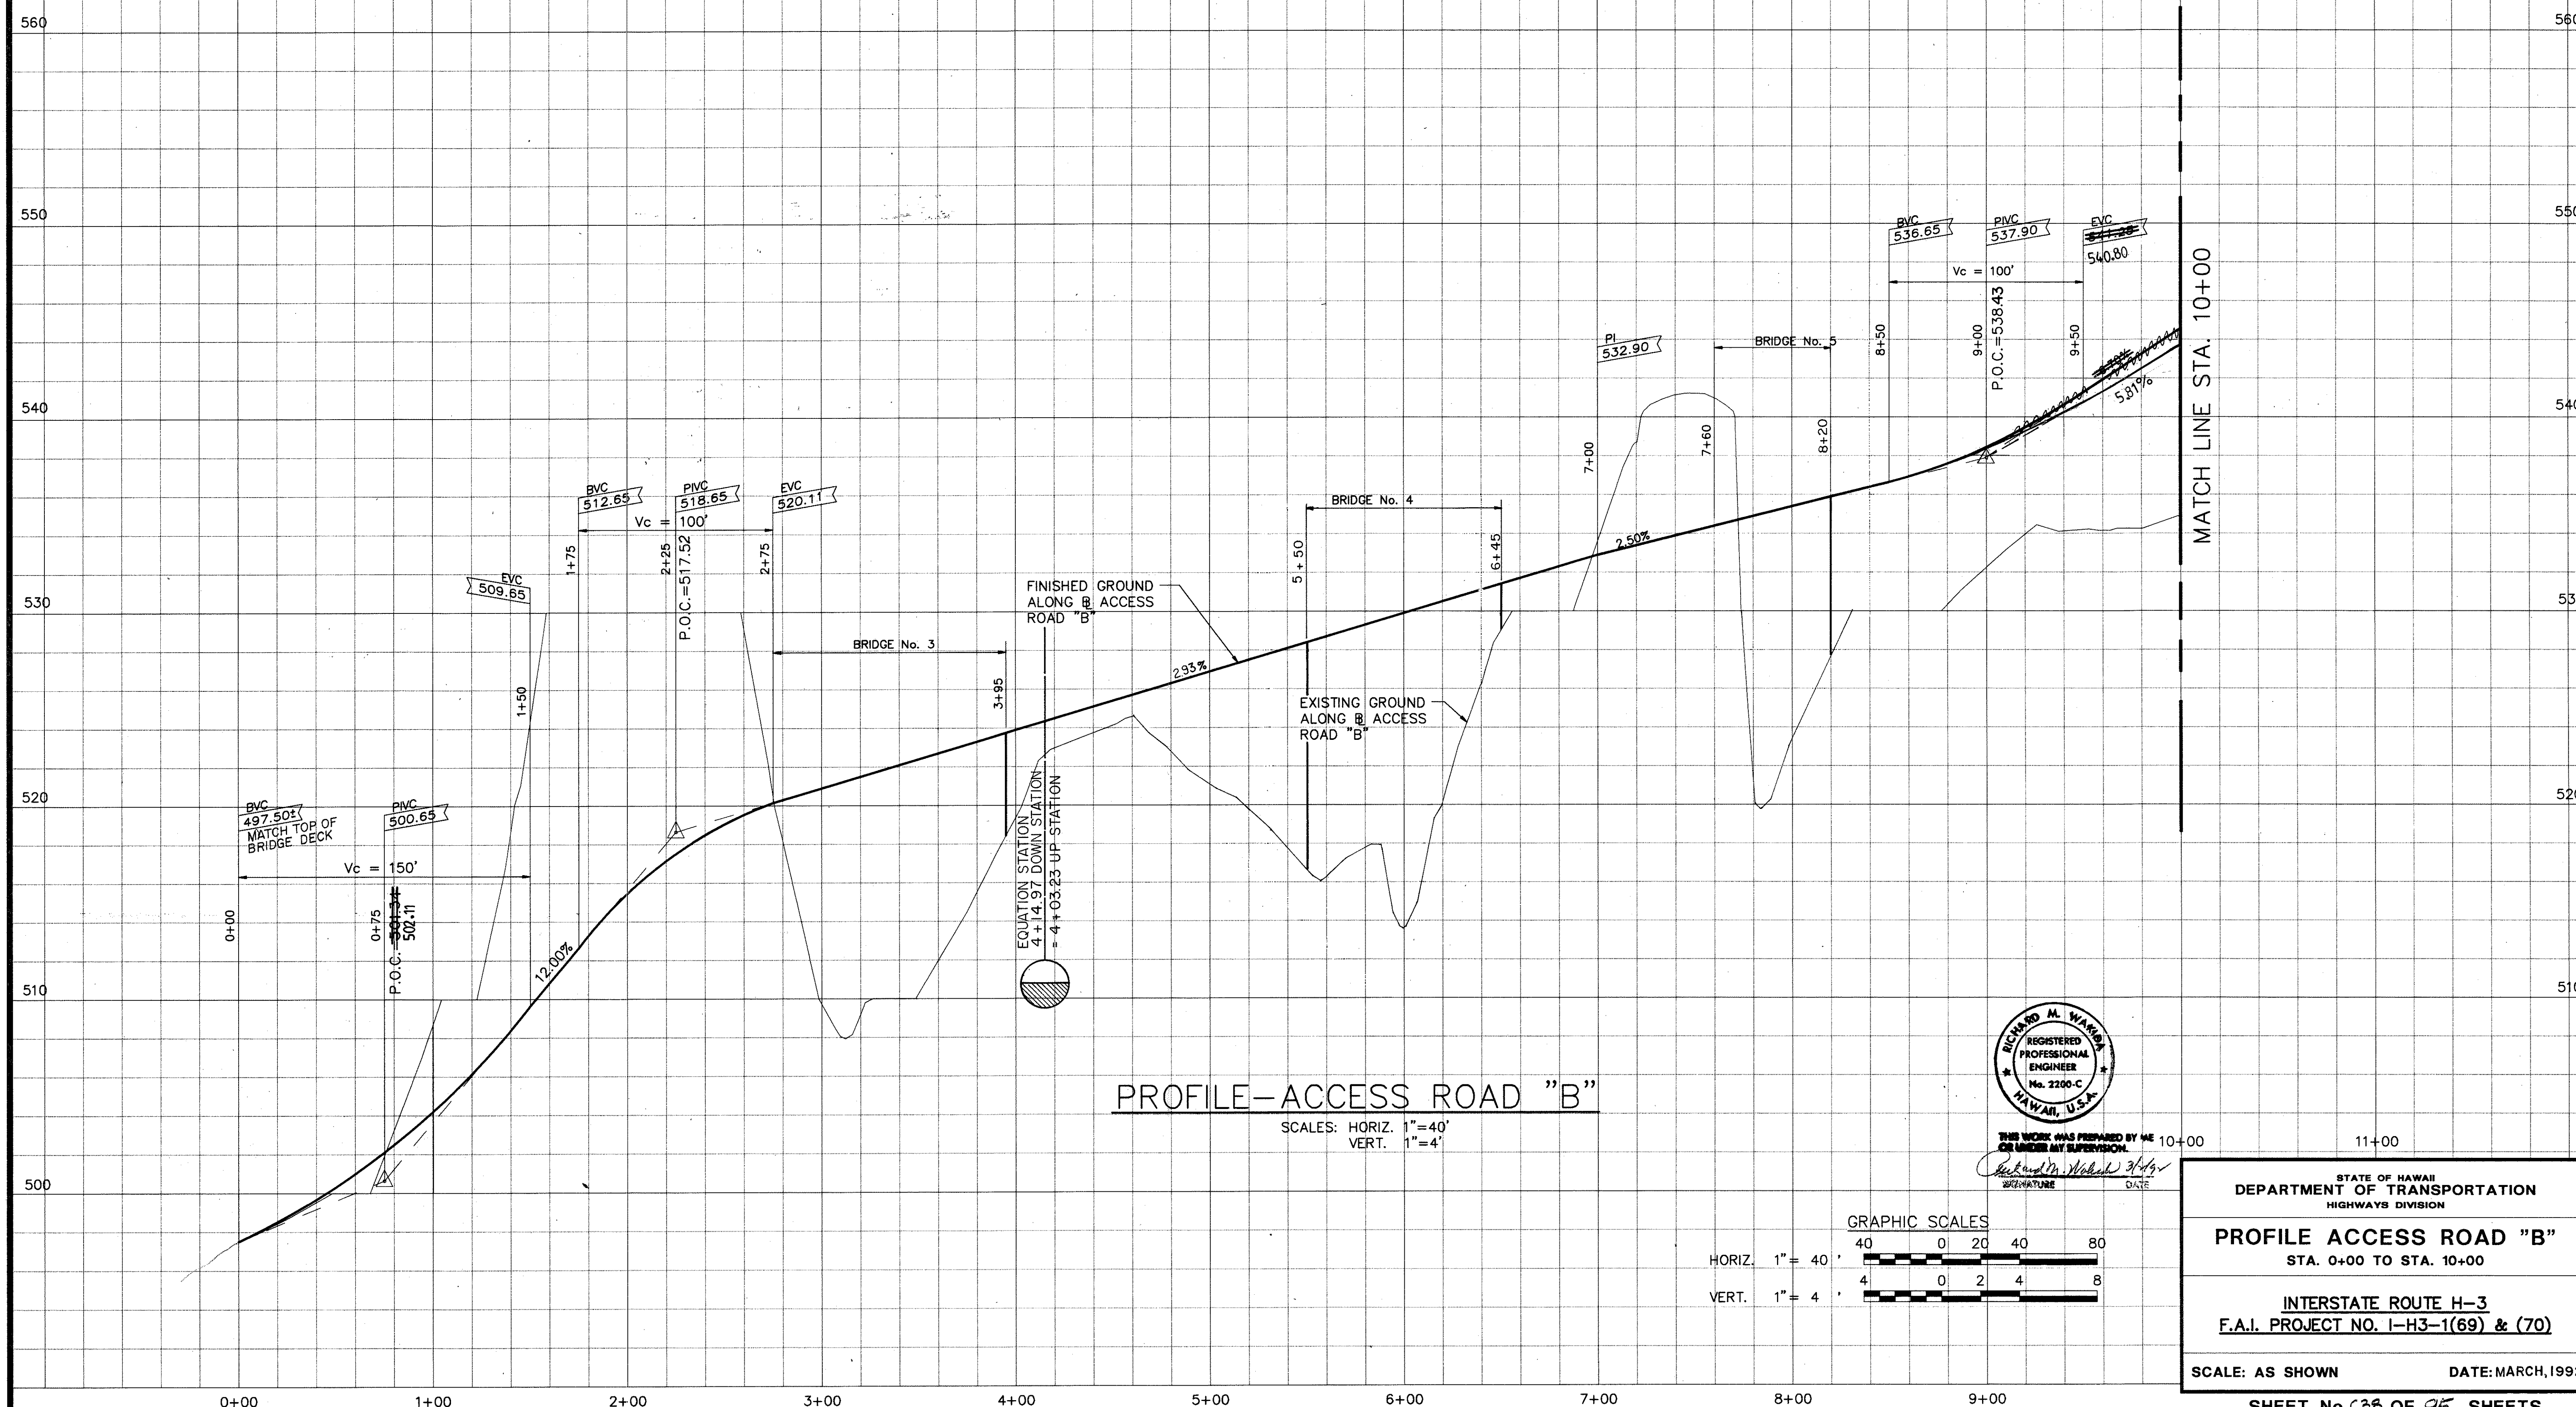


THIS WORK WAS PREPARED BY ME
OR UNDER MY SUPERVISION.
SIGNATURE DATE

FED. ROAD DIST. NO.	STATE	FED. AID PROJ. NO.	FISCAL YEAR	SHEET NO.	TOTAL SHEETS
HAWAII	HAW.	I-H3-1(69)	1992	42	225

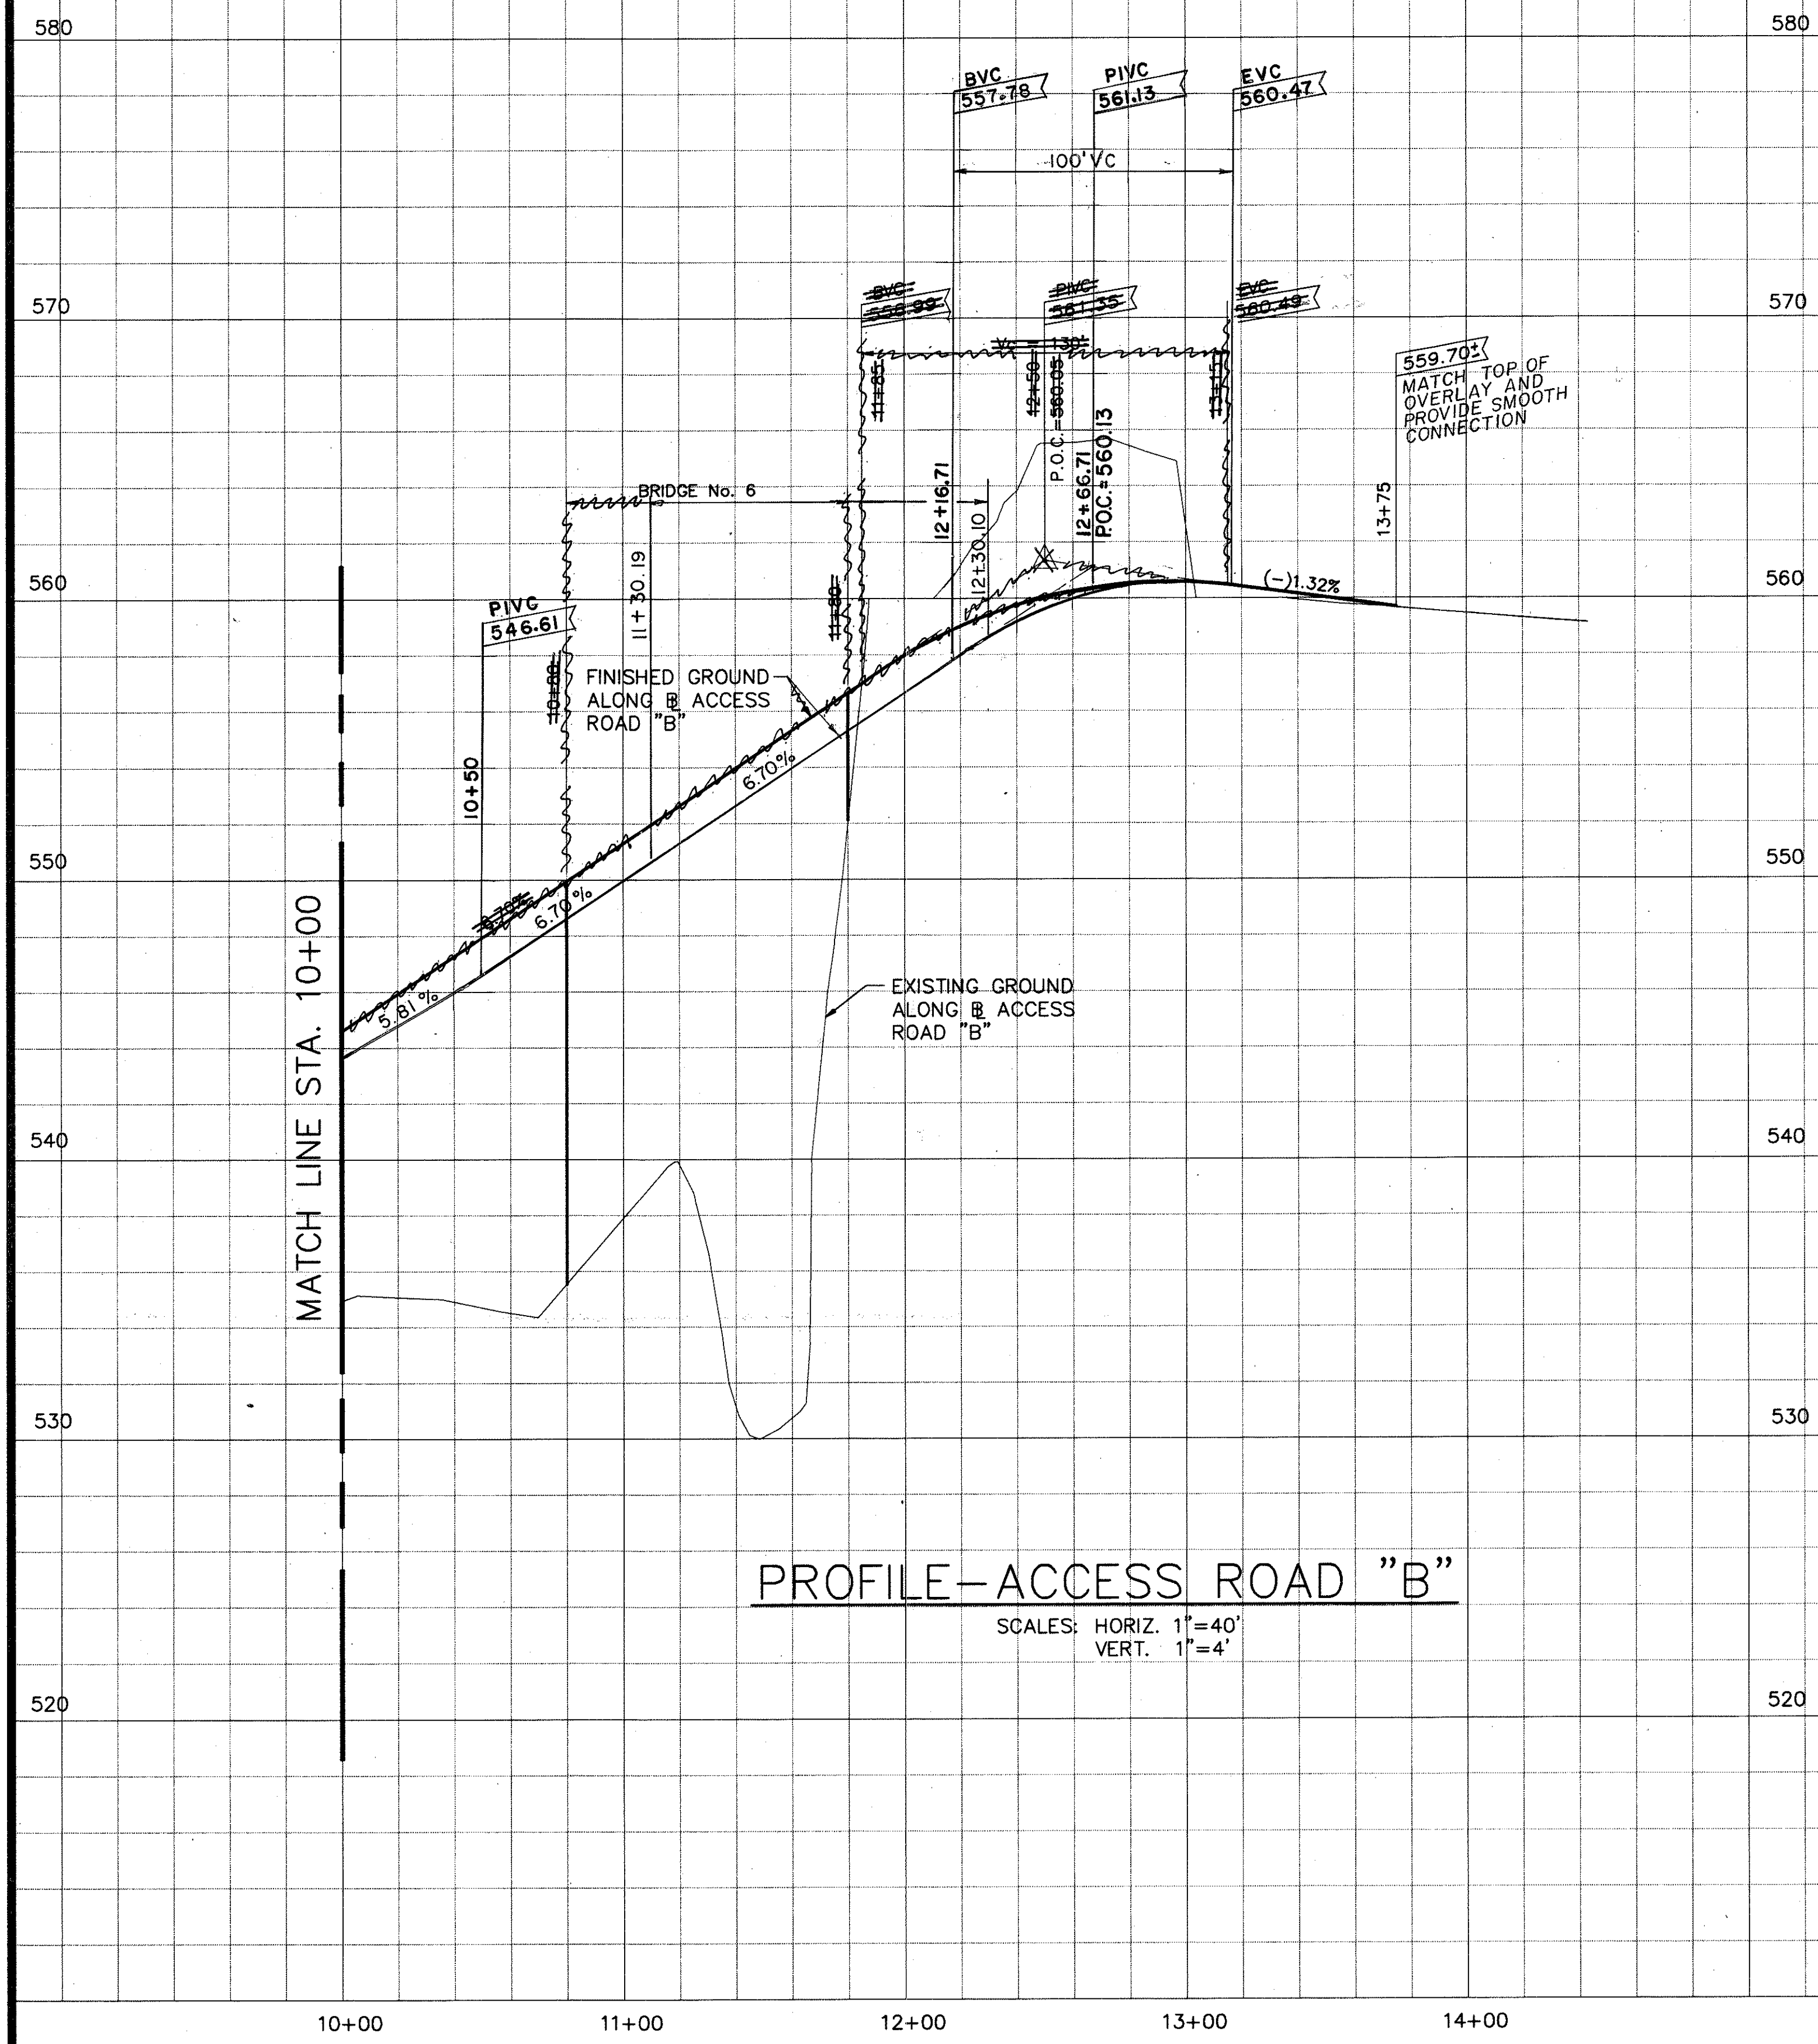

PROFILE-ACCESS ROAD "B"

SCALES: HORIZ. 1"=40'
VERT. 1"=4'

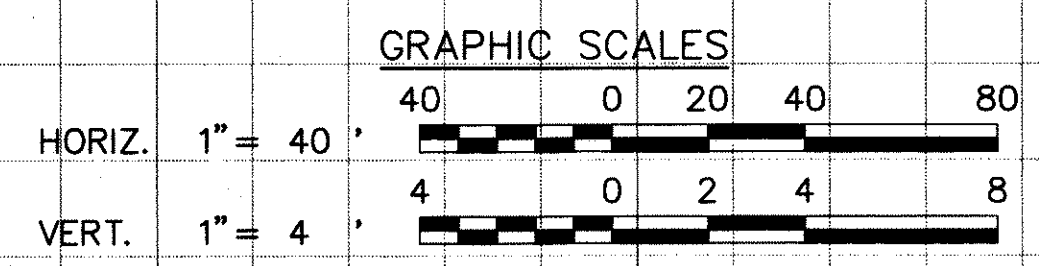

RICHARD M. WANDA
REGISTERED
PROFESSIONAL
ENGINEER
No. 2200-C
HAWAII, U.S.A.

THIS WORK WAS PREPARED BY ME
OR UNDER MY SUPERVISION.
SIGNATURE DATE

STATE OF HAWAII
DEPARTMENT OF TRANSPORTATION
HIGHWAYS DIVISION

PROFILE ACCESS ROAD "B"
STA. 10+00 TO STA. 13+75

INTERSTATE ROUTE H-3
F.A.I. PROJECT NO. I-H3-1(69) & (70)

SCALE: AS SHOWN DATE: MARCH, 1992


SHEET No. 039 OF 95 SHEETS

DESIGNED BY
CHECKED BY
DATE


ORIGINAL
PLAN
NO.

QUANTITIES BY
DESIGNED BY
CHECKED BY
DATE


FED. ROAD DIST. NO.	STATE	FED. AID PROJ. NO.	FISCAL YEAR	SHEET NO.	TOTAL SHEETS
HAWAII	HAW.	I-H3-1(69)	1992	43	325

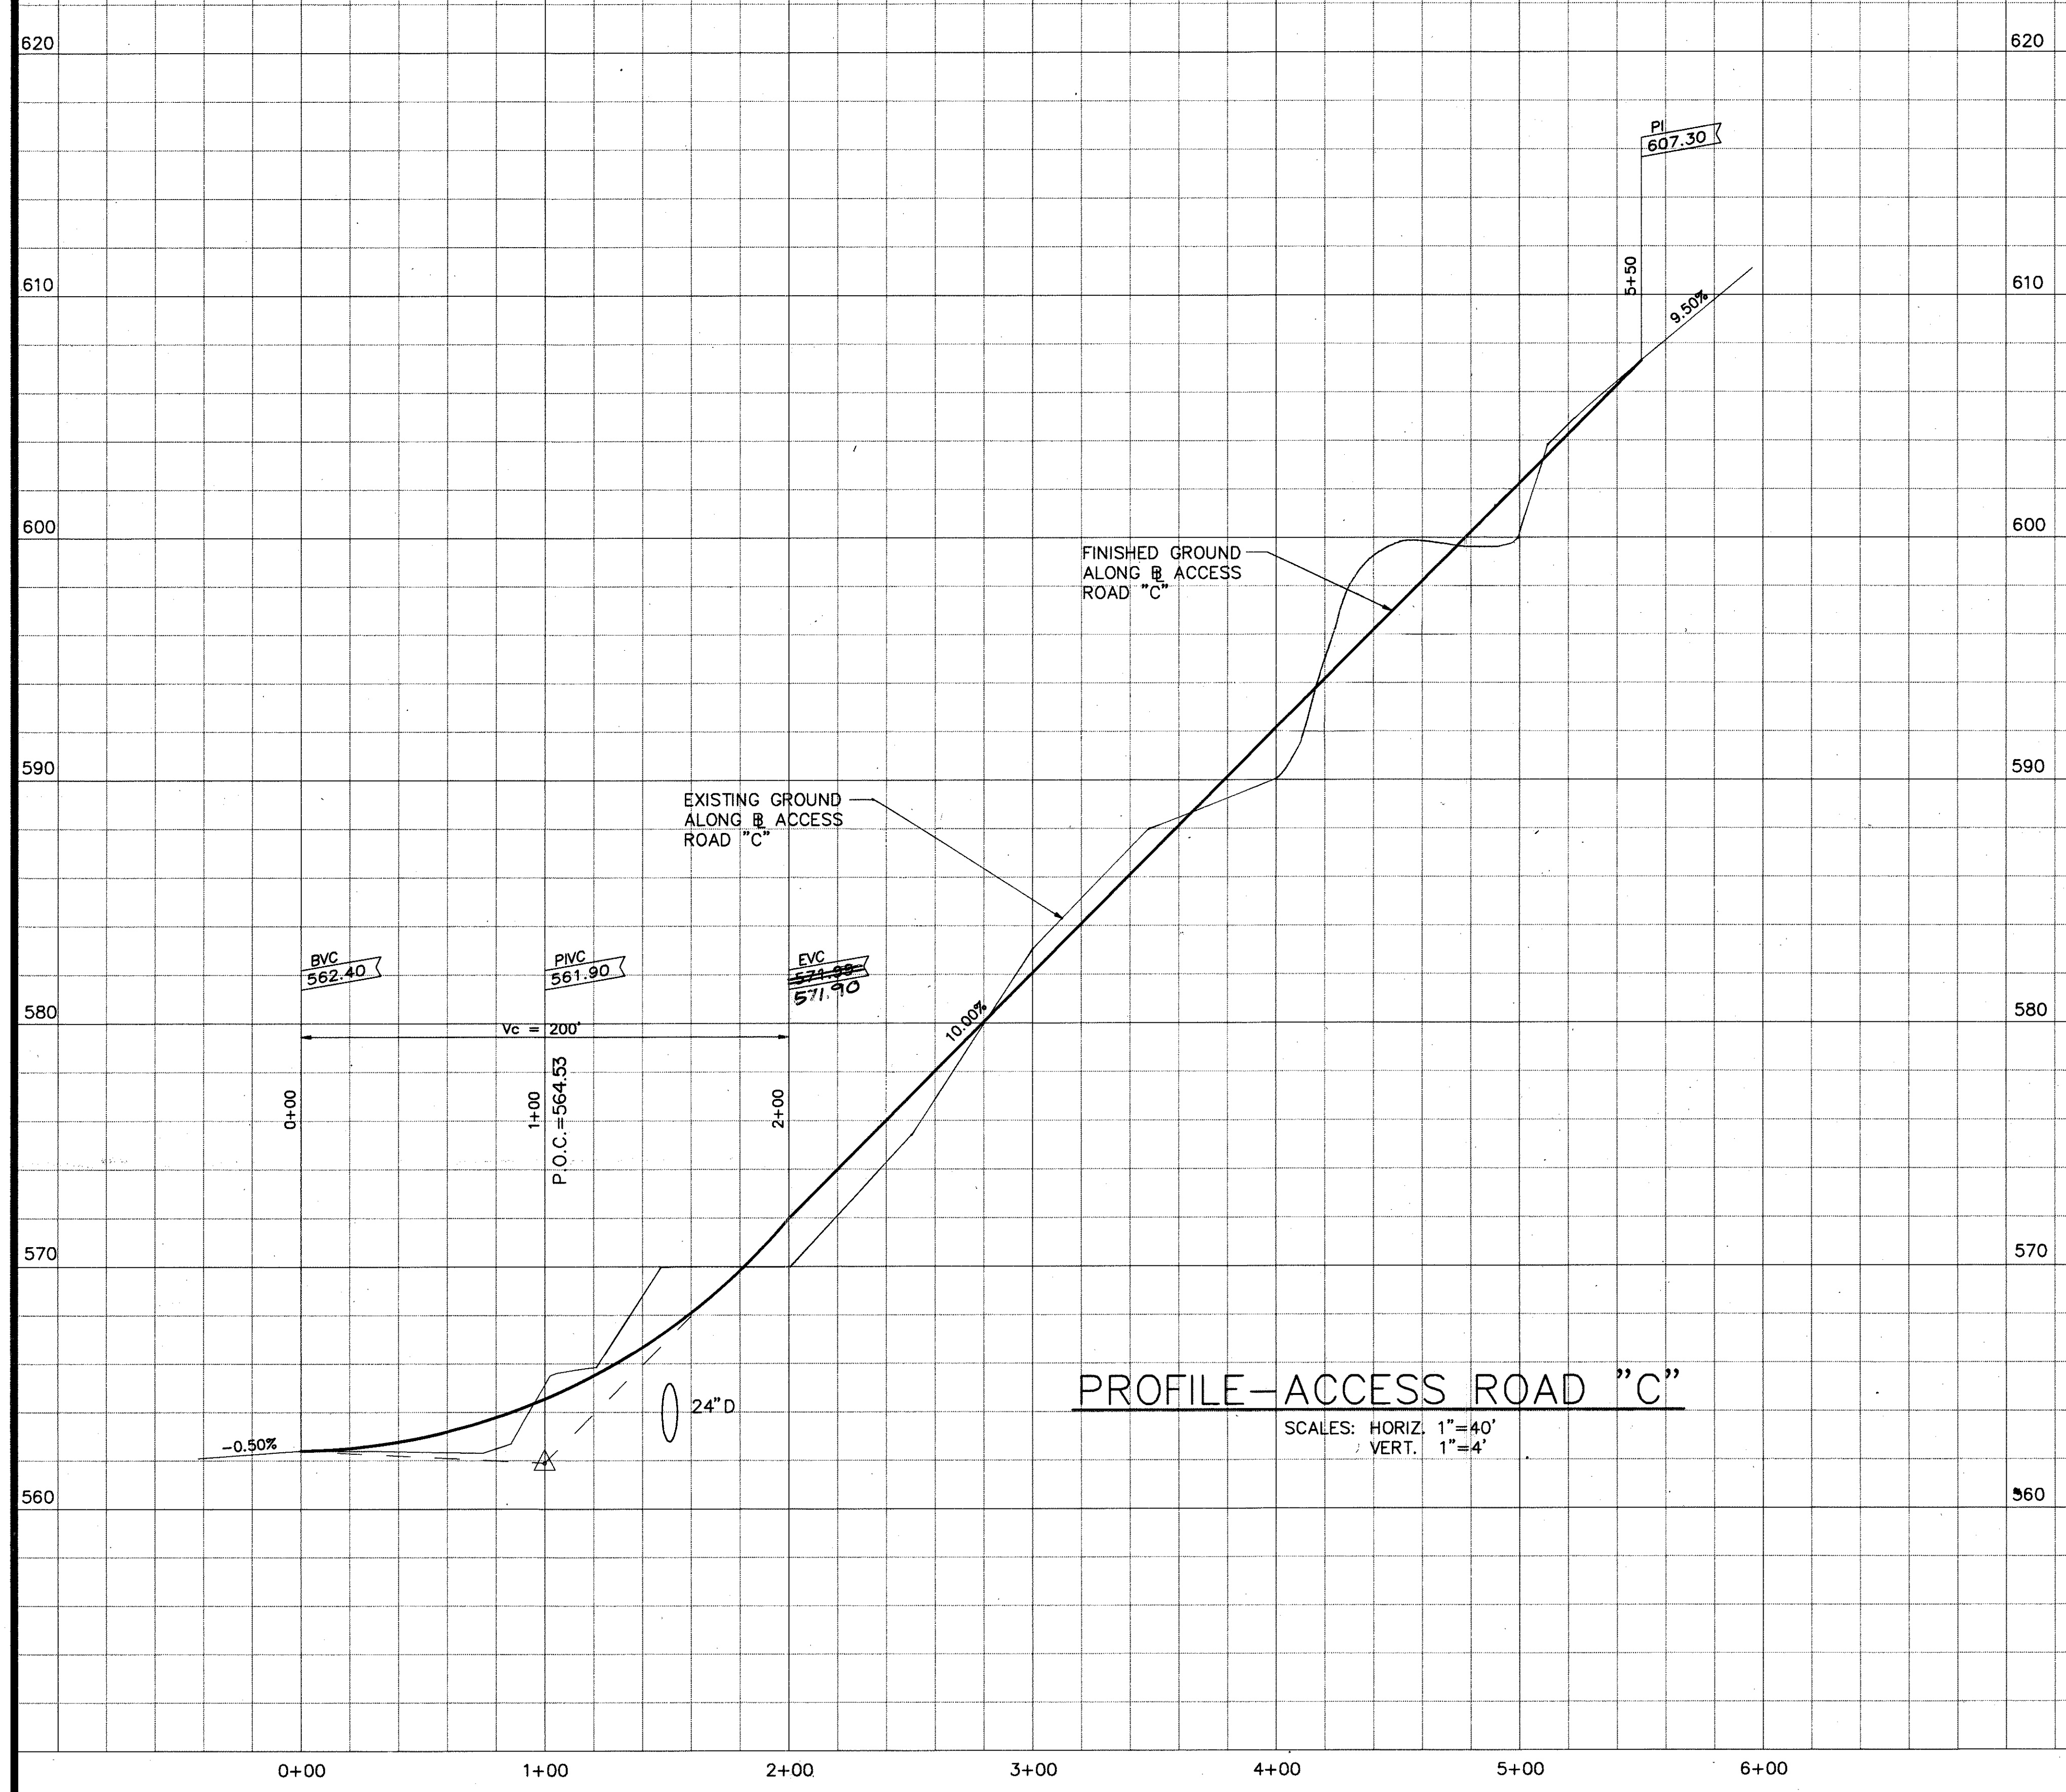

PROFILE-ACCESS ROAD "C"
 SCALES: HORIZ. 1"=40'
 VERT. 1"=4'

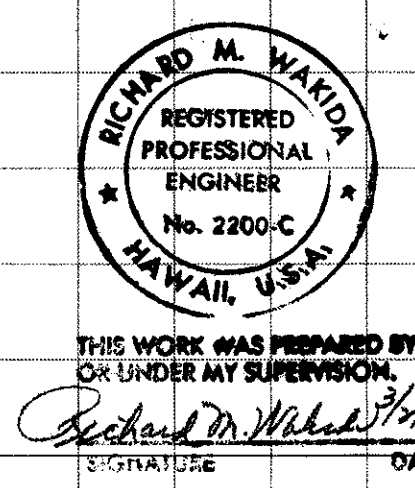

THIS WORK WAS PREPARED BY ME
 OR UNDER MY SUPERVISION.
 Richard M. Wai
 SIGNATURE DATE

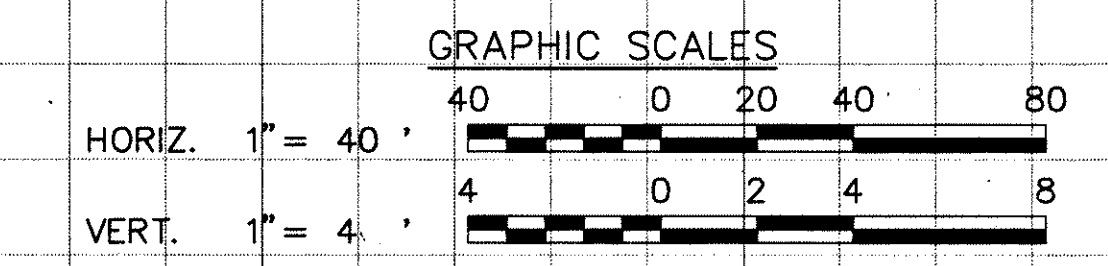

STATE OF HAWAII
DEPARTMENT OF TRANSPORTATION
HIGHWAYS DIVISION

PROFILE ACCESS ROAD "C"
STA. 0+00 TO STA. 5+50

INTERSTATE ROUTE H-3
F.A.I. PROJECT NO. I-H3-1(69) & (70)

SCALE: AS SHOWN DATE: MARCH, 1992

SHEET No. C40 OF 95 SHEETS

SURVEY PLOTTED BY	DATE
DESIGNED BY	
NOTED BY	
CHECKED BY	
ORIGINAL PLAN	
NOTE BOOK	
No.	