
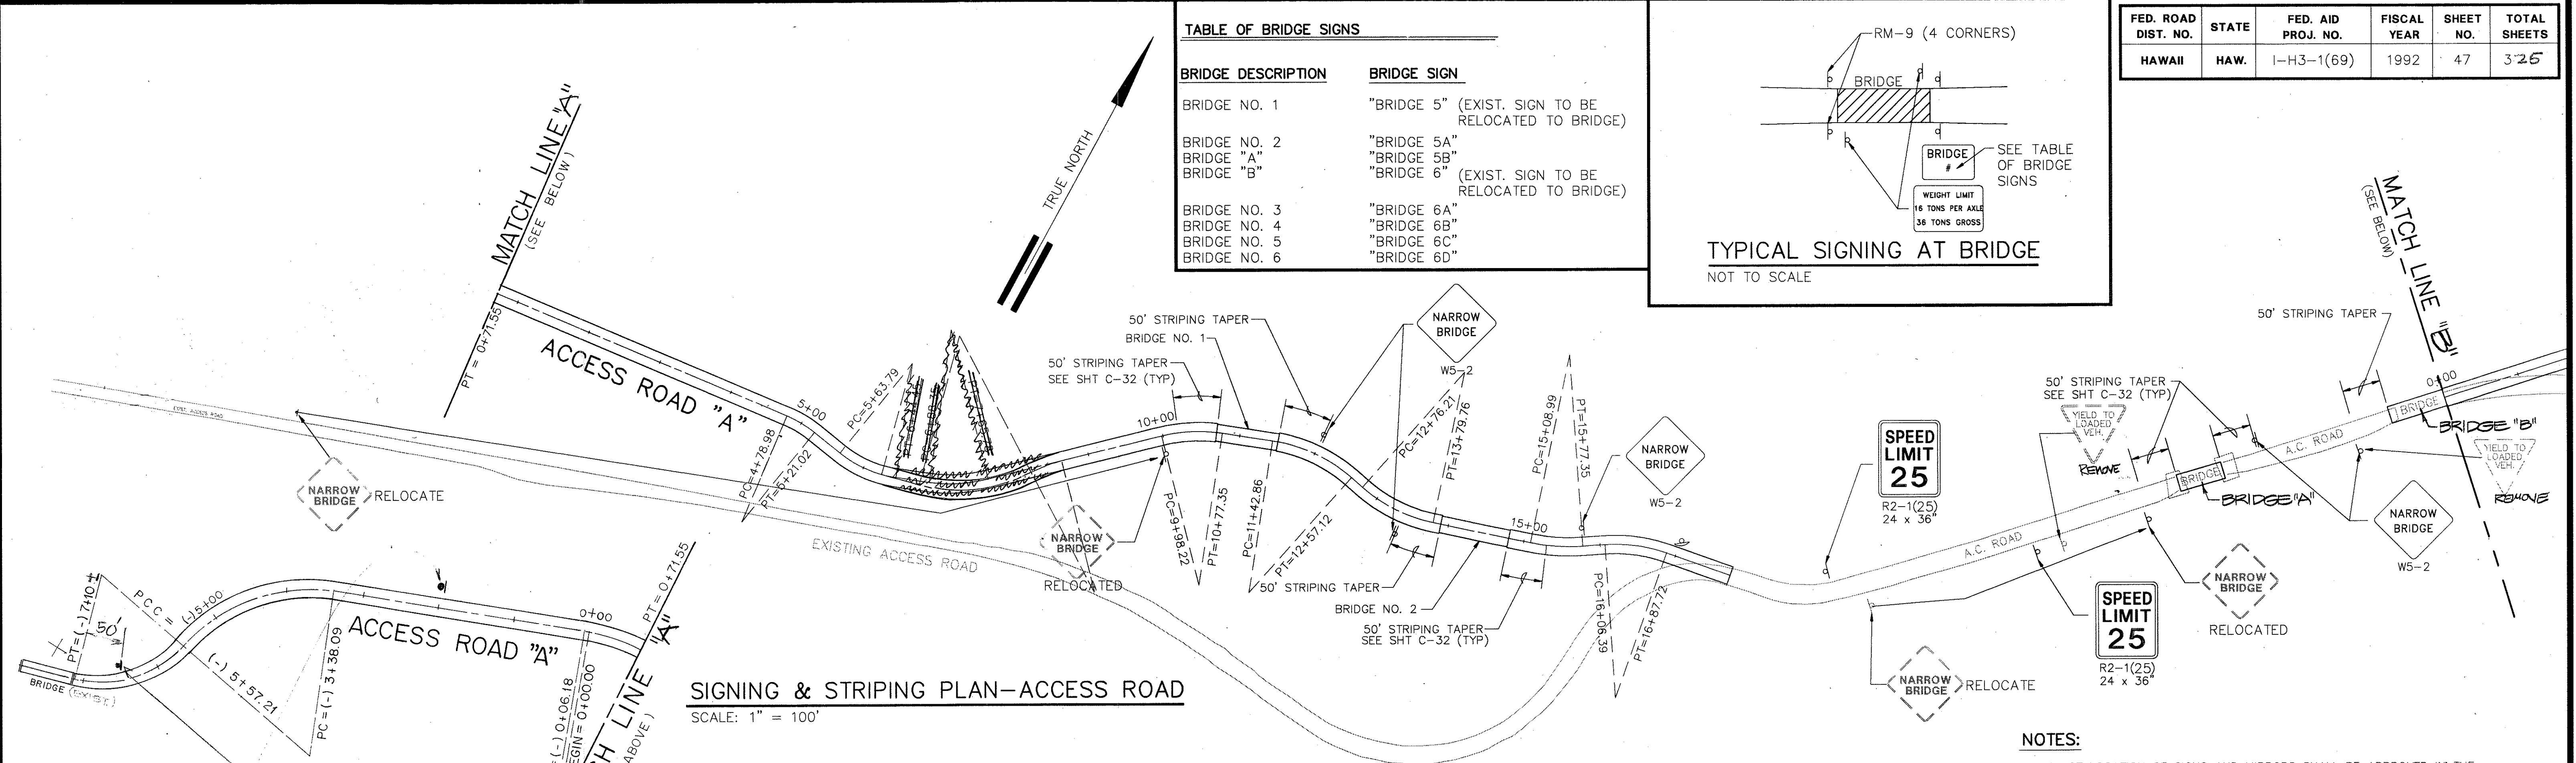




FED. ROAD DIST. NO.	STATE	FED. AID PROJ. NO.	FISCAL YEAR	SHEET NO.	TOTAL SHEETS
HAWAII	HAW.	I-H3-1(69)	1992	47	325

TABLE OF BRIDGE SIGNS	
BRIDGE DESCRIPTION	BRIDGE SIGN
BRIDGE NO. 1	"BRIDGE 5" (EXIST. SIGN TO BE RELOCATED TO BRIDGE)
BRIDGE NO. 2	"BRIDGE 5A"
BRIDGE "A"	"BRIDGE 5B"
BRIDGE "B"	"BRIDGE 6" (EXIST. SIGN TO BE RELOCATED TO BRIDGE)
BRIDGE NO. 3	"BRIDGE 6A"
BRIDGE NO. 4	"BRIDGE 6B"
BRIDGE NO. 5	"BRIDGE 6C"
BRIDGE NO. 6	"BRIDGE 6D"

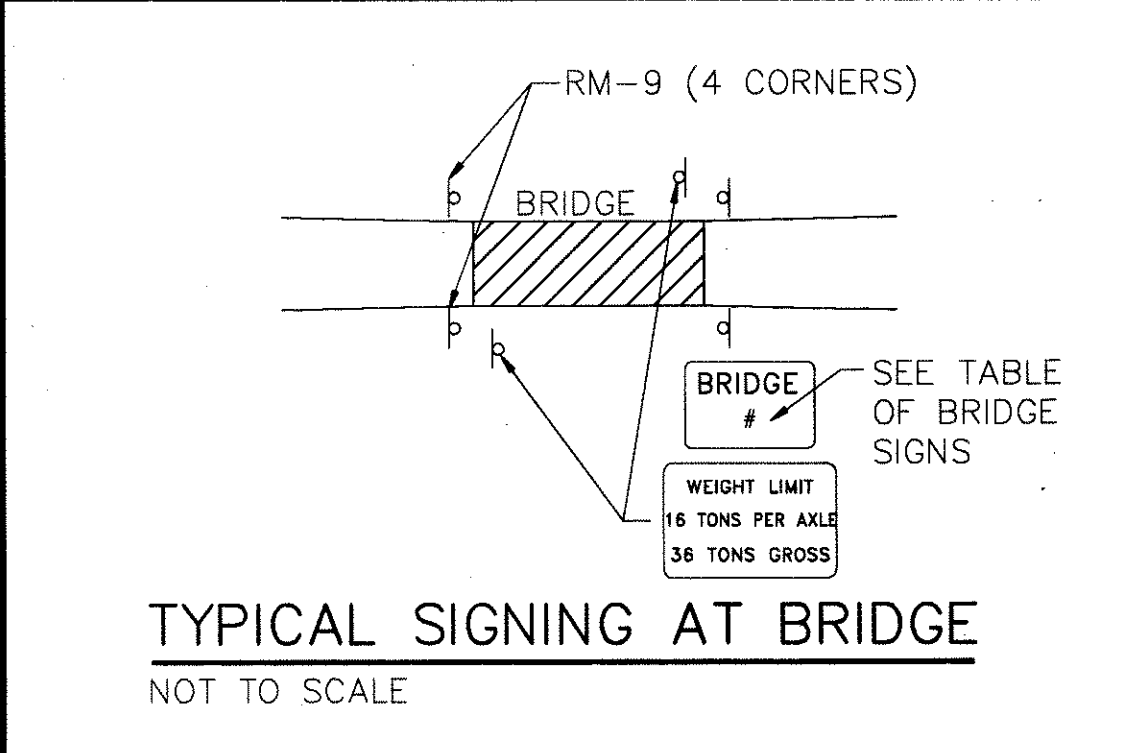

SIGNING & STRIPING PLAN-ACCESS ROAD
SCALE: 1" = 100'

- NOTES:
- EXACT LOCATION OF SIGNS AND MIRRORS SHALL BE APPROVED IN THE FIELD BY THE ENGINEER.
 - INSTALL RM-1(YELLOW) DELINEATORS AT EVERY 50 FEET ON CENTER, ON BOTH SIDES OF ROADWAY AS DIRECTED BY THE ENGINEER.
 - STRIPE CENTERLINE OF CONSTRUCTION ACCESS ROAD WITH 4" SOLID YELLOW STRIPE. PAVEMENT STRIPING SHALL BE TAPE TYPE I OR THERMOPLASTIC EXTRUSION.
 - FOR SIGN POST AND MOUNTING DETAILS, SEE STATE STANDARD PLAN TE-01.
 - REMOVAL OR RELOCATION OF SIGNS AND MIRRORS SHALL ALSO INCLUDE THE REMOVAL OR RELOCATION OF POST AND FOUNDATION. REMOVED POSTS AND FOUNDATIONS SHALL BECOME THE PROPERTY OF THE CONTRACTOR.
 - NEW MIRRORS AND REMOVAL OR RELOCATION OF SIGNS AND MIRRORS SHALL BE CONSIDERED INCIDENTAL TO THE VARIOUS CONTRACT ITEMS.
 - ALL WARNING SIGNS (W) SHALL BE CONSTRUCTION ORANGE AND BLACK.
 - BRIDGE SIGNS SHALL BE RELOCATED TO APPROPRIATE BRIDGE LOCATIONS.
 - BRIDGE NUMBERS ON BRIDGE SIGNS SHALL BE AS DIRECTED BY THE ENGINEER AND VERIFIED BEFORE FABRICATING SIGNS.

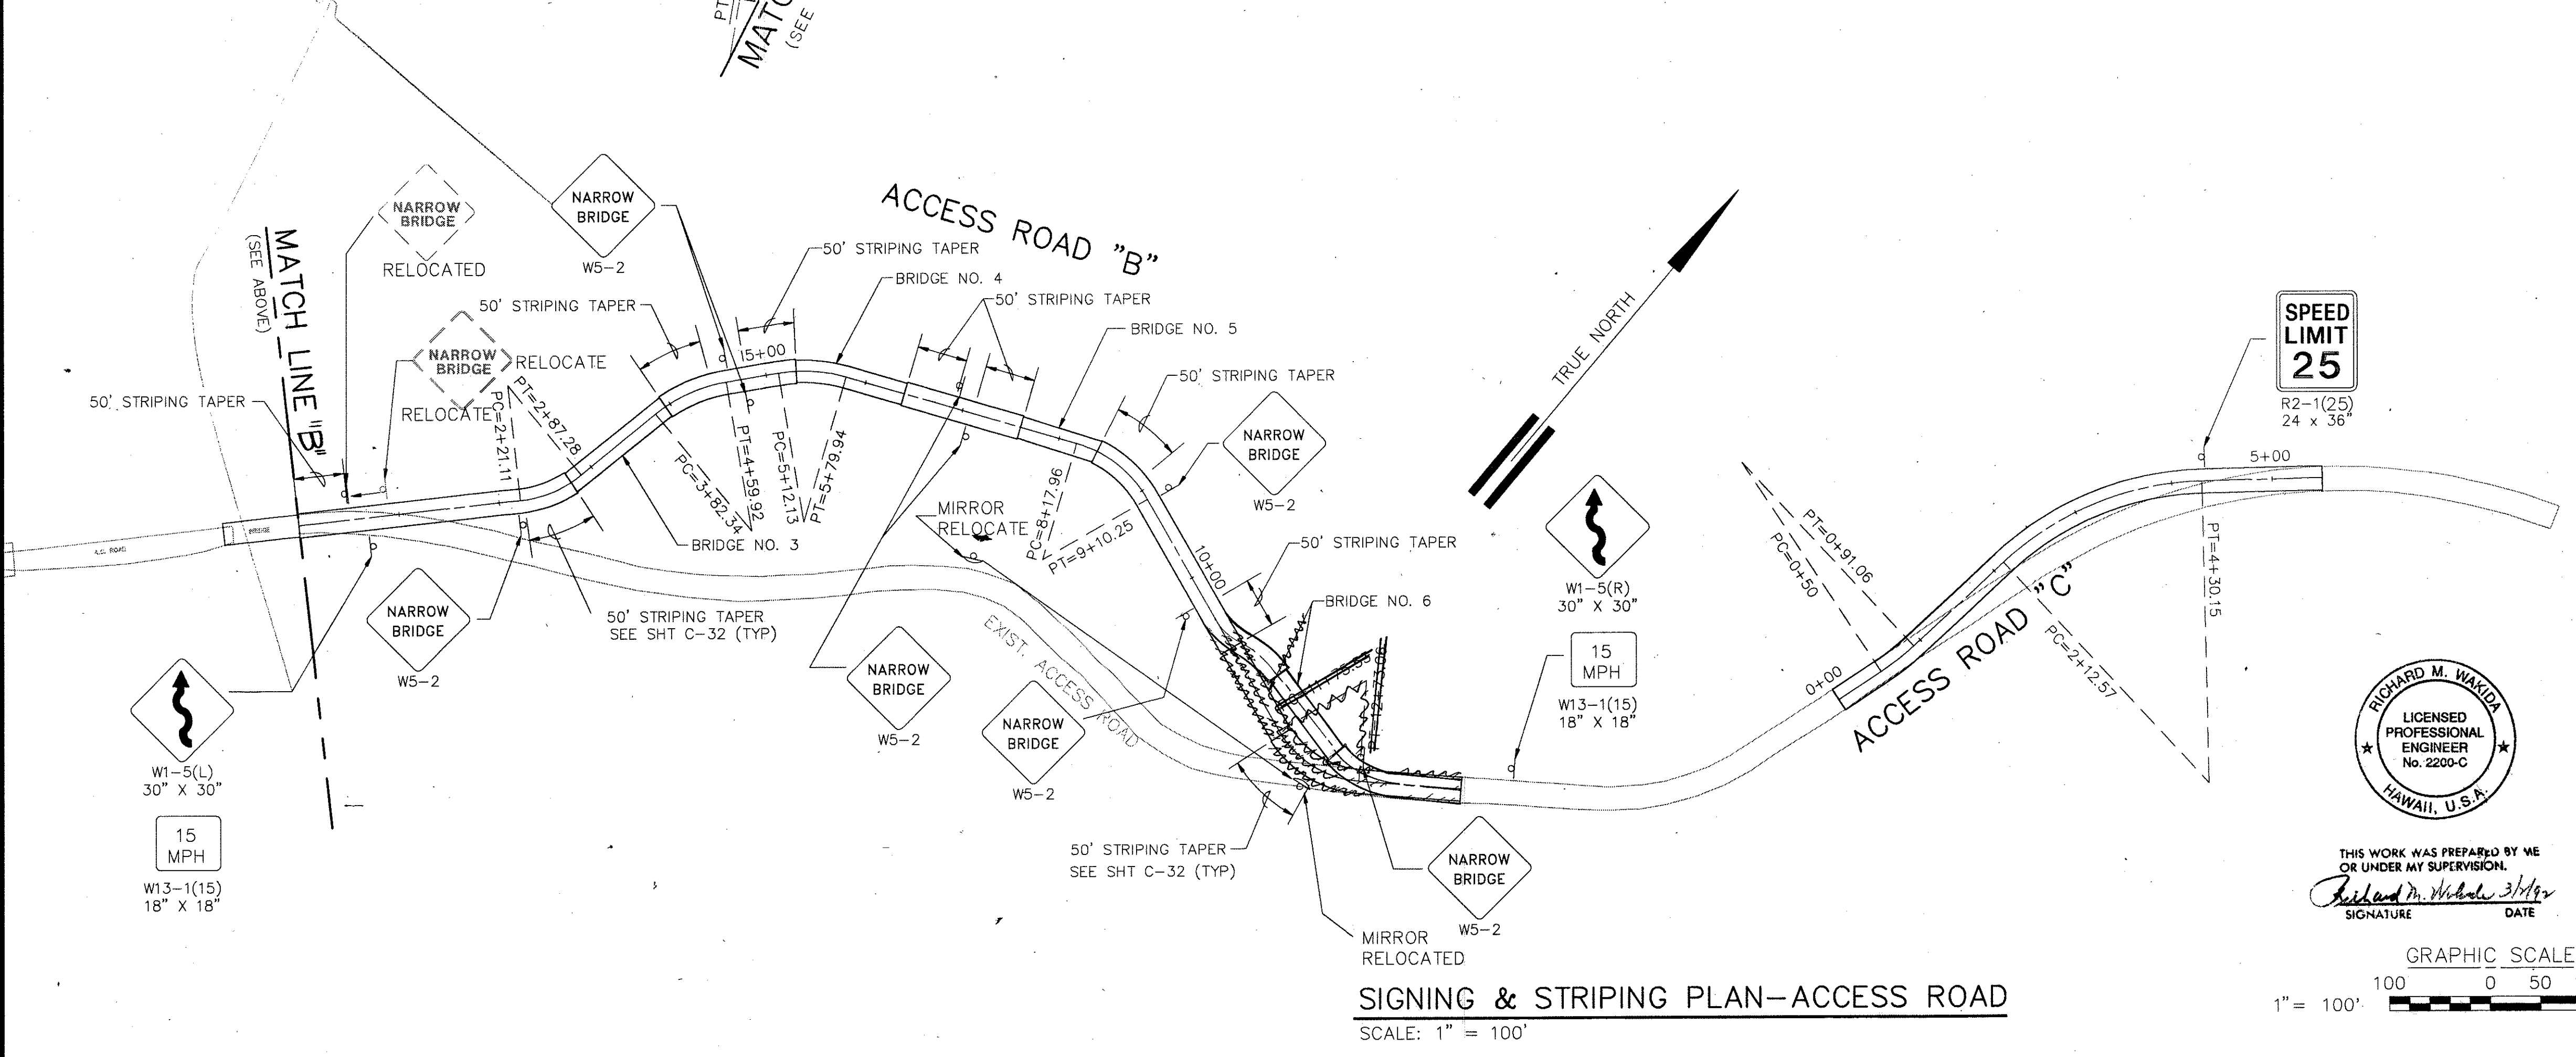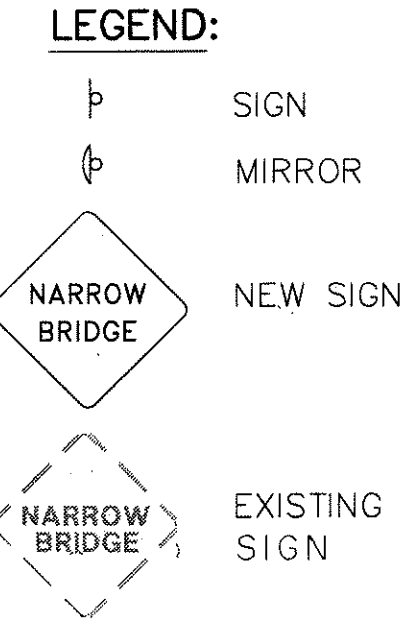

SIGNING & STRIPING PLAN-ACCESS ROAD
SCALE: 1" = 100'

RICHARD M. WAKIDA
LICENSED PROFESSIONAL ENGINEER
No. 2200-C
HAWAII, U.S.A.

THIS WORK WAS PREPARED BY ME OR UNDER MY SUPERVISION.
Richard M. Wakida 3/1/92
SIGNATURE DATE

GRAPHIC SCALE
1" = 100'
0 50 100 200

11-5-93 Revised Access Road "A" & "B" SIGNAGE
DATE REVISION

STATE OF HAWAII
DEPARTMENT OF TRANSPORTATION
HIGHWAYS DIVISION

**SIGNING & STRIPING PLAN
ACCESS ROAD**

INTERSTATE ROUTE H-3
F.A.I. PROJECT NO. I-H3-1(69) & (70)

SCALE: 1" = 100' DATE: MARCH 1992

SHEET No. C44 OF 95 SHEETS

DATE	
SURVEY PLOTTED BY	
DRAWN BY	
DESIGNED BY	
QUANTITIES BY	
CHECKED BY	
ORIGINAL PLAN No.	