


FED. ROAD DIST. NO.	STATE	FED. AID PROJ. NO.	FISCAL YEAR	SHEET NO.	TOTAL SHEETS
HAWAII	HAW.	I-H3-1(69)	1992	29	325

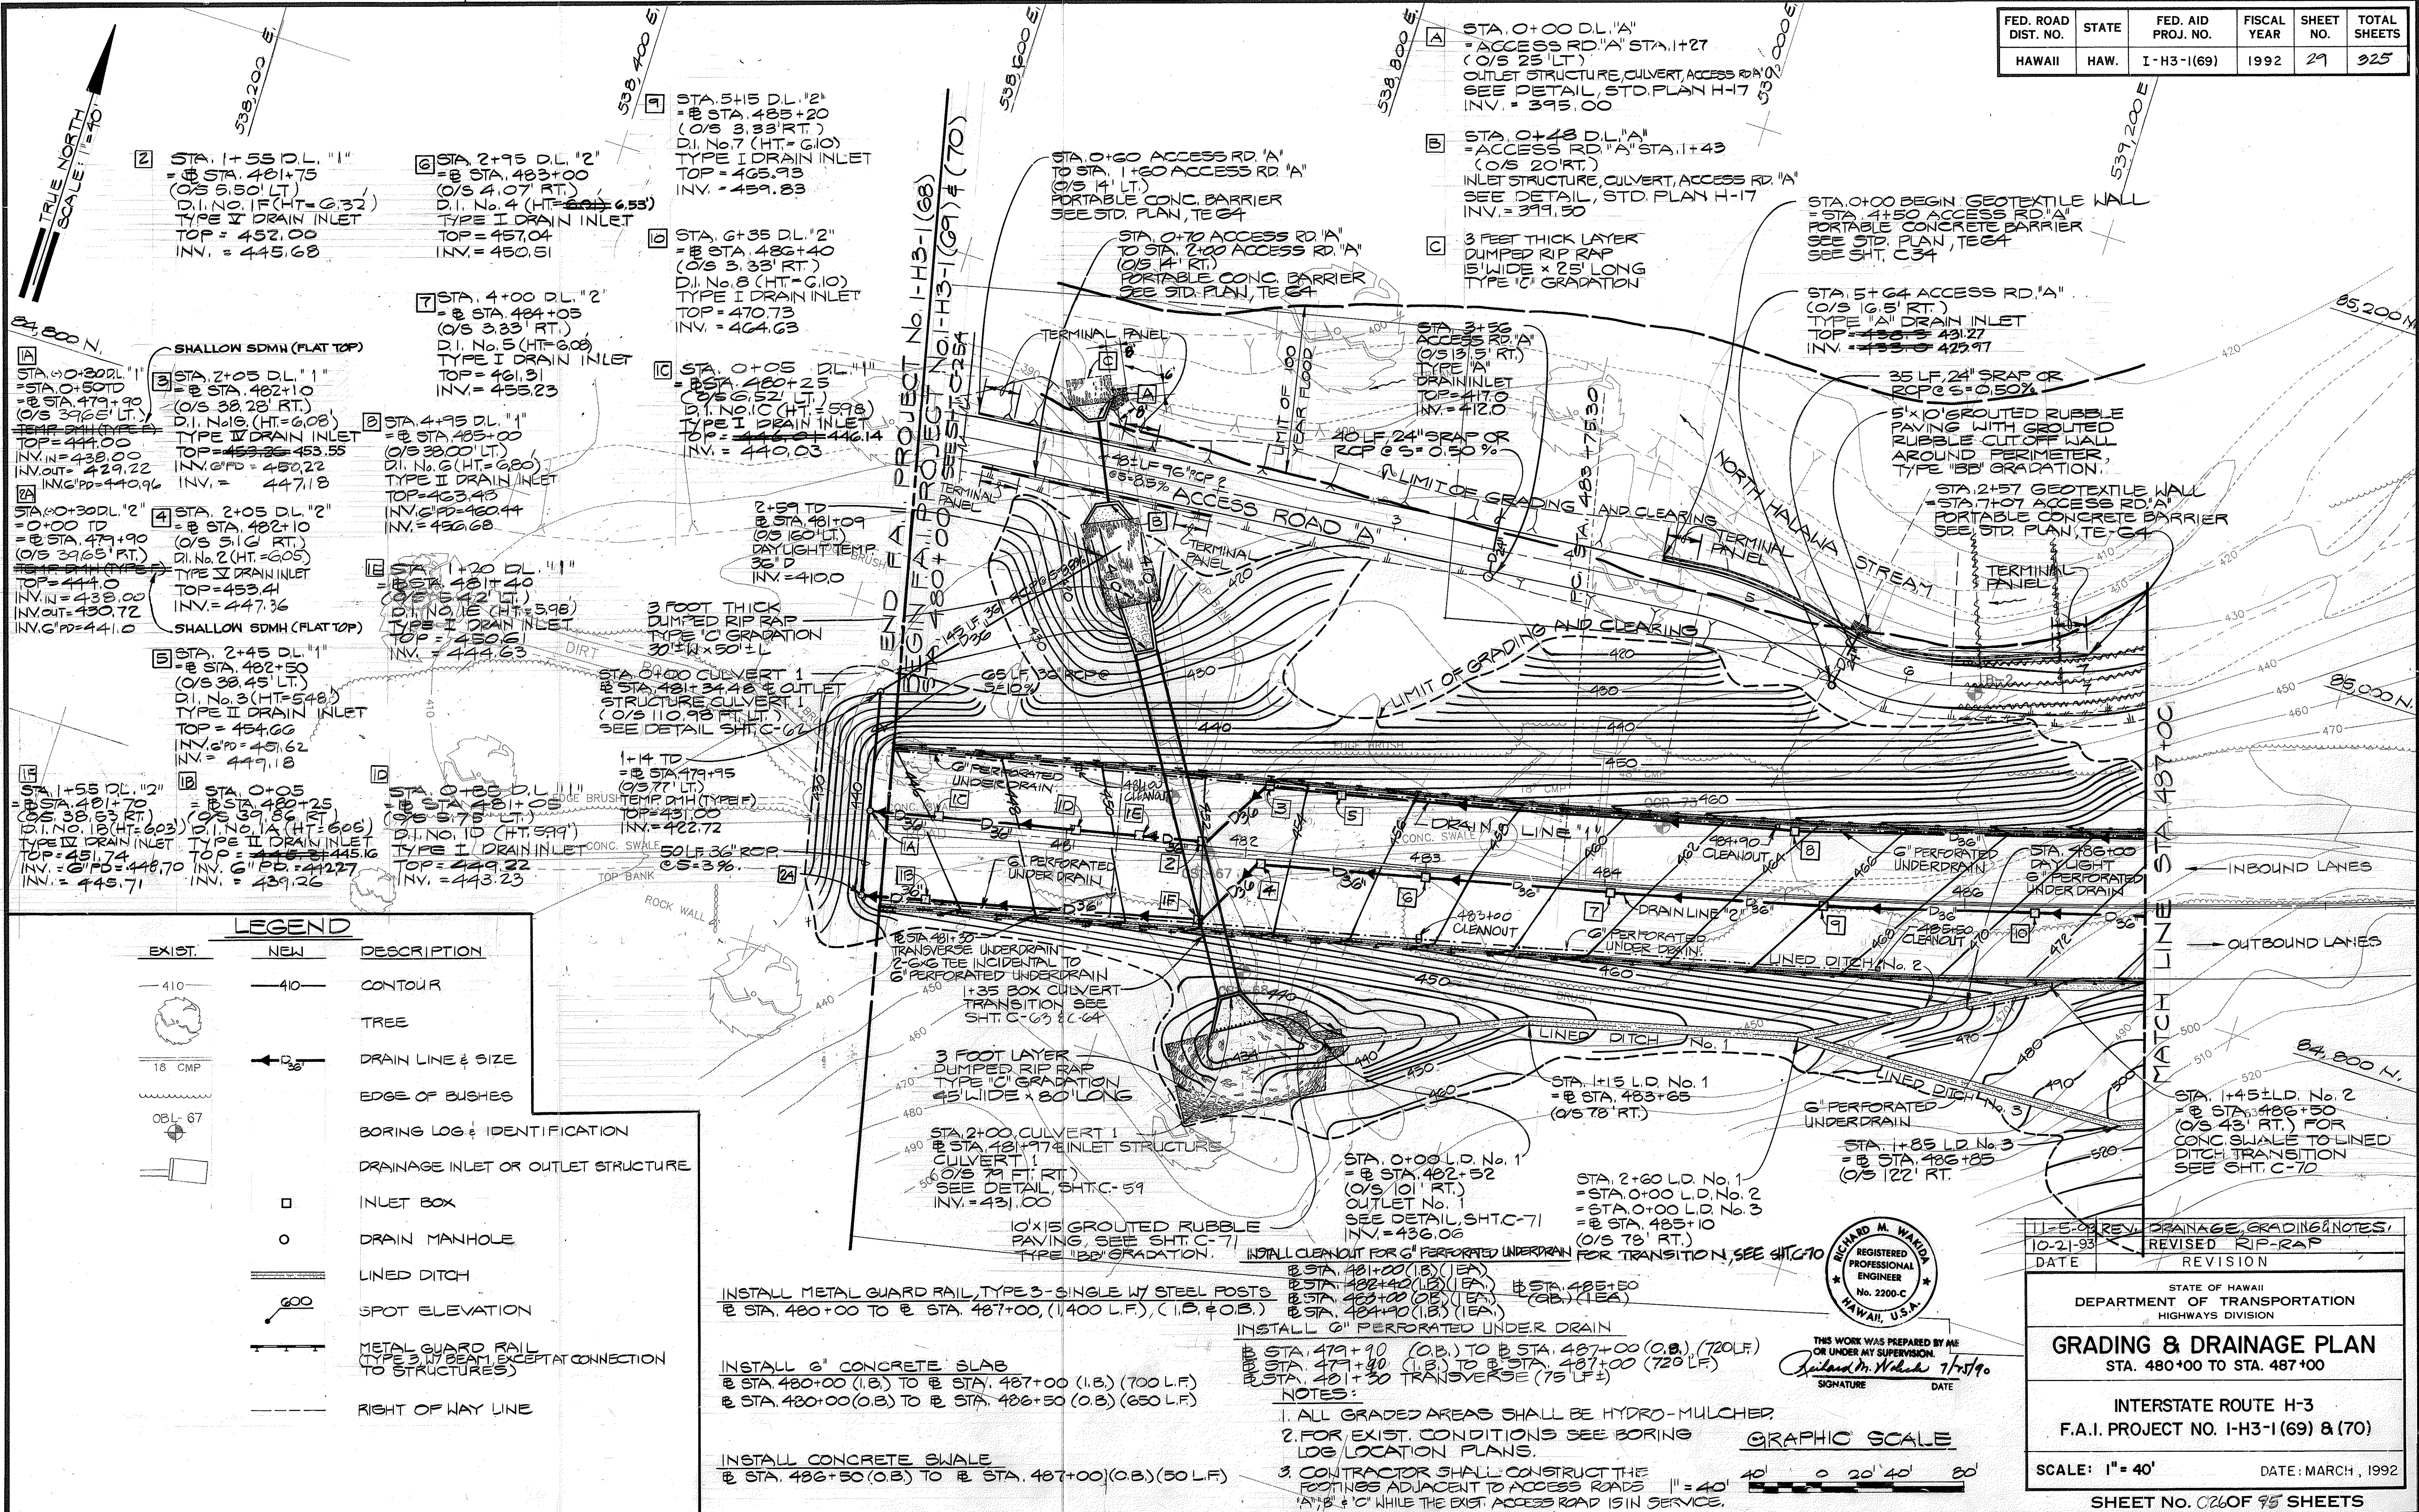

LEGEND

EXIST.	NEW	DESCRIPTION
410	410	CONTOUR
		TREE
		DRAIN LINE & SIZE
		EDGE OF BUSHES
		BORING LOG & IDENTIFICATION
		DRAINAGE INLET OR OUTLET STRUCTURE
		INLET BOX
		DRAIN MANHOLE
		LINED DITCH
		SPOT ELEVATION
		METAL GUARD RAIL (TYPE 3 W/ BEAM EXCEPT AT CONNECTION TO STRUCTURES)
		RIGHT OF WAY LINE

DATE: _____
 SURVEY PLOTTED BY: _____
 DRAWN BY: _____
 DESIGNED BY: _____
 CHECKED BY: _____
 ORIGINAL PLAN: _____
 NOTE BOOK: _____
 NO. _____

INSTALL METAL GUARD RAIL, TYPE 3-SINGLE W/ STEEL POSTS
 @ STA. 480+00 TO @ STA. 487+00, (1,400 L.F.), (1.5 @ 0.3.)

INSTALL 6" CONCRETE SLAB
 @ STA. 480+00 (I.B.) TO @ STA. 487+00 (I.B.) (700 L.F.)
 @ STA. 480+00 (O.B.) TO @ STA. 486+50 (O.B.) (650 L.F.)

INSTALL CONCRETE SWALE
 @ STA. 486+50 (O.B.) TO @ STA. 487+00 (O.B.) (50 L.F.)

NOTES:
 1. ALL GRADED AREAS SHALL BE HYDRO-MULCHED.
 2. FOR EXIST. CONDITIONS SEE BORING LOG/LOCATION PLANS.
 3. CONTRACTOR SHALL CONSTRUCT THE FOOTINGS ADJACENT TO ACCESS ROADS 1" = 40' 'A', 'B' & 'C' WHILE THE EXIST. ACCESS ROAD IS IN SERVICE.

RICHARD M. WAKO
 REGISTERED PROFESSIONAL ENGINEER
 No. 2200-C
 HAWAII, U.S.A.
 THIS WORK WAS PREPARED BY ME OR UNDER MY SUPERVISION
Richard M. Wako 7/15/90
 SIGNATURE DATE

DATE	REVISION
10-21-93	REVISED RIP-RAP
11-5-93	REVISED DRAINAGE, GRADING & NOTES

STATE OF HAWAII
 DEPARTMENT OF TRANSPORTATION
 HIGHWAYS DIVISION

GRADING & DRAINAGE PLAN
 STA. 480+00 TO STA. 487+00


INTERSTATE ROUTE H-3
 F.A.I. PROJECT NO. I-H3-1(69) & (70)

SCALE: 1" = 40' DATE: MARCH, 1992

SHEET No. 026 OF 95 SHEETS


FED. ROAD DIST. NO.	STATE	FED. AID PROJ. NO.	FISCAL YEAR	SHEET NO.	TOTAL SHEETS
HAWAII	HAW.	I-H3-1(69)	1992	30	925

DATE	_____
SURVEY PLOTTED BY	_____
DESIGNED BY	_____
QUANTITIES BY	_____
CHECKED BY	_____
ORIGINAL PLAN	_____
NOTE BOOK	_____

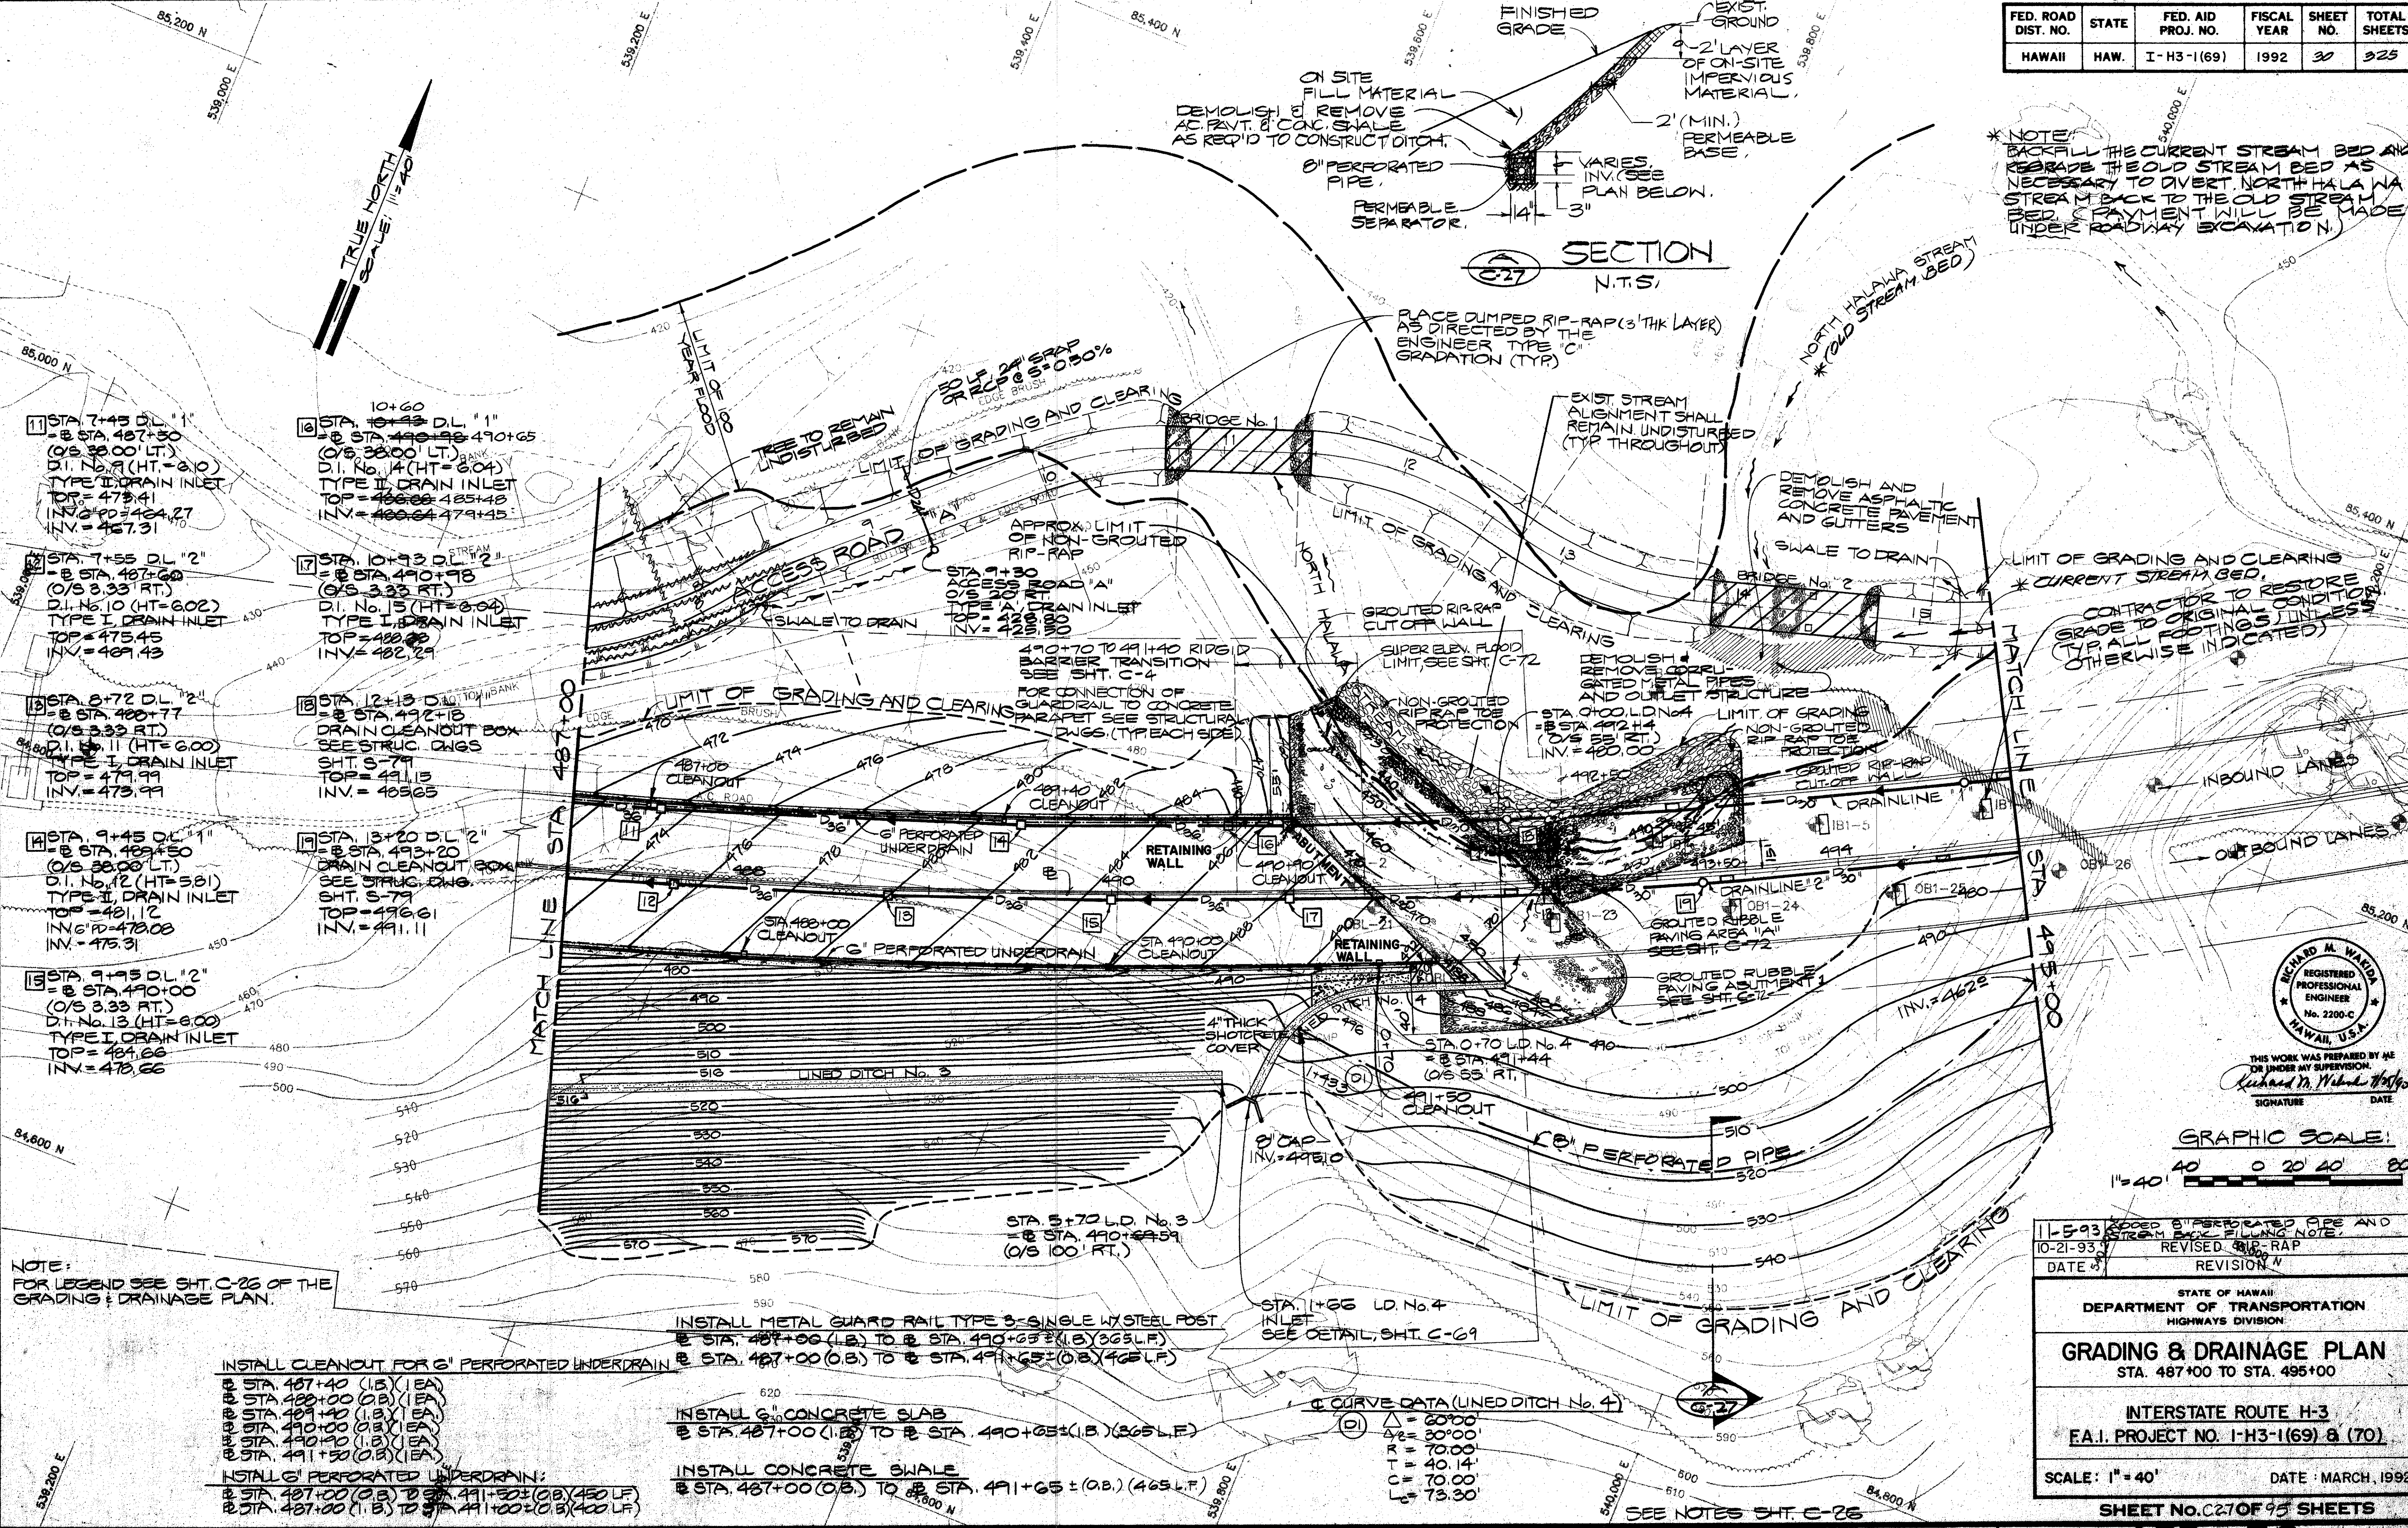

* NOTE: BACKFILL THE CURRENT STREAM BED AND REGRADE THE OLD STREAM BED AS NECESSARY TO DIVERT NORTH HALA WA STREAM BACK TO THE OLD STREAM BED. PAYMENT WILL BE MADE UNDER ROADWAY EXCAVATION.

REGISTERED PROFESSIONAL ENGINEER
No. 2200-C
HAWAII, U.S.A.
THIS WORK WAS PREPARED BY ME OR UNDER MY SUPERVISION
Richard M. Wilson
SIGNATURE DATE

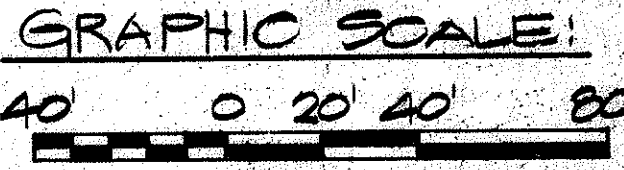

11-5-93	REVISION 1
10-21-93	REVISION 2
DATE	REVISION
STATE OF HAWAII DEPARTMENT OF TRANSPORTATION HIGHWAYS DIVISION	
GRADING & DRAINAGE PLAN STA. 487+00 TO STA. 495+00	
INTERSTATE ROUTE H-3 F.A.I. PROJECT NO. I-H3-1(69) & (70)	
SCALE: 1" = 40'	DATE: MARCH, 1992
SHEET No. 027 OF 95 SHEETS	

SURVEY PLOTTED BY	DATE
DRAWN BY	
DESIGNED BY	
QUANTITIES BY	
CHECKED BY	
ORIGINAL PLAN	
NOTE BOOK	
No.	

NOTE:
FOR LEGEND SEE SHEET C26 OF THE
GRADING AND DRAINAGE PLAN.

20 STA. 28+90 D.L. "1"
= B STA. 508+95±
DRAIN CLEANOUT BOX
SEE STRUC. DWGS.
SHT. S-79
TOP = 540.39
INV. = 542.39

21 STA. 29+07 D.L. "2"
= B STA. 509+12
DRAIN CLEANOUT BOX
SEE STRUC. DWGS.
SHT. S-79
TOP = 549.51
INV. = 543.51

23 STA. 30+65 D.L. "1"
= B STA. 510+70
(O/S 38.00 FT. RT.)
D.I. No. 18 (HT=5.89)
TYPE II DRAIN INLET
TOP = 554.14
INV. G.P.D. = 551.10
INV. = 546.25

29 STA. 33+35 D.L. "2"
= O.B. B STA. 513+40
(O/S 16.00 FT. RT.)
D.I. No. 22 (HT=6.17)
TYPE II DRAIN INLET
TOP = 563.08
INV. G.P.D. = 560.04
INV. = 556.91

28 STA. 32+25 D.L. "2"
= O.B. B STA. 512+30
(O/S 16.00 FT. RT.)
D.I. No. 21 (HT=6.03)
TYPE II DRAIN INLET
TOP = 559.42
INV. G.P.D. = 556.39
INV. = 553.39

22 STA. 27+20 D.L. "1"
= B STA. 509+25
(O/S 38.00 FT. LT.)
D.I. No. 16 (HT=5.90)
TYPE II DRAIN INLET
TOP = 549.36
INV. G.P.D. = 546.32
INV. = 543.46

26 STA. 30+85 D.L. "2"
= B STA. 510+90
(O/S 38.00 FT. RT.)
D.I. No. 19 (HT=5.93)
TYPE II DRAIN INLET
TOP = 554.84
INV. G.P.D. = 551.80
INV. = 548.91

23 STA. 27+25 D.L. "2"
= B STA. 509+30±
(O/S 4.79 FT. RT.)
D.M.H. No. 1 (HT=6.01)
TYPE D CHANNELIZED
INVERT, SEE DETAIL, SHT. C57
TOP = 550.53
INV. = 544.6±544.48

24 STA. 27+43 D.L. "2"
= B STA. 509+48±
(O/S 38.00 FT. RT.)
D.I. No. 17 (HT=5.99)
TYPE VI DRAIN INLET
TOP = 550.8±551.07
INV. G.P.D. = 547.99
INV. = 544.6±545.04

27 STA. 32+07 D.L. "1"
= I.B. B STA. 512+12
(O/S 16.00 FT. LT.)
D.I. No. 20 (HT=6.07)
TYPE II DRAIN INLET
TOP = 558.86
INV. G.P.D. = 555.82
INV. = 552.79

31 STA. 34+00 D.L. "1"
= STA. 0+00 D.L. "3"
= I.B. B STA. 514+05
(O/S 16.00 FT. LT.)
D.M.H. No. 2 (HT=6.02)
TYPE D D.M.H. CHANNELIZED
INVERT, SEE DETAIL, SHT. C57
TOP = 565.23
INV. = 559.21

32 STA. 34+30 D.L. "1"
= I.B. B STA. 514+35
(O/S 16.00 FT. RT.)
D.M.H. No. 3 (HT=6.01)
TYPE D D.M.H. CHANNELIZED
INVERT, SEE DETAIL, SHT. C57
TOP = 560.38
INV. = 560.38

33 STA. 34+40 D.L. "2"
= O.B. B STA. 514+45
(O/S 16.00 FT. RT.)
D.I. No. 24 (HT=6.06)
TYPE II DRAIN INLET
TOP = 566.23
INV. = 560.17

FED. ROAD DIST. NO.	STATE	FED. AID PROJ. NO.	FISCAL YEAR	SHEET NO.	TOTAL SHEETS
HAWAII	HAW.	I-H3-1(69)	1992	32	325

34 STA. 35+07 D.L. "1"
= I.B. B STA. 515+12
DRAIN CLEANOUT BOX
SEE STRUC. DWGS.
SHT. S-79
TOP = 569.18
INV. = 563.68

35 STA. 35+07 D.L. "1"
= I.B. B STA. 515+12
DRAIN CLEANOUT BOX
SEE STRUC. DWGS.
SHT. S-79
TOP = 569.18
INV. = 563.68

36 STA. 35+07 D.L. "1"
= I.B. B STA. 515+12
DRAIN CLEANOUT BOX
SEE STRUC. DWGS.
SHT. S-79
TOP = 569.18
INV. = 563.68

37 STA. 35+07 D.L. "1"
= I.B. B STA. 515+12
DRAIN CLEANOUT BOX
SEE STRUC. DWGS.
SHT. S-79
TOP = 569.18
INV. = 563.68

38 STA. 35+07 D.L. "1"
= I.B. B STA. 515+12
DRAIN CLEANOUT BOX
SEE STRUC. DWGS.
SHT. S-79
TOP = 569.18
INV. = 563.68

39 STA. 35+07 D.L. "1"
= I.B. B STA. 515+12
DRAIN CLEANOUT BOX
SEE STRUC. DWGS.
SHT. S-79
TOP = 569.18
INV. = 563.68

40 STA. 35+07 D.L. "1"
= I.B. B STA. 515+12
DRAIN CLEANOUT BOX
SEE STRUC. DWGS.
SHT. S-79
TOP = 569.18
INV. = 563.68

41 STA. 35+07 D.L. "1"
= I.B. B STA. 515+12
DRAIN CLEANOUT BOX
SEE STRUC. DWGS.
SHT. S-79
TOP = 569.18
INV. = 563.68

42 STA. 35+07 D.L. "1"
= I.B. B STA. 515+12
DRAIN CLEANOUT BOX
SEE STRUC. DWGS.
SHT. S-79
TOP = 569.18
INV. = 563.68

43 STA. 35+07 D.L. "1"
= I.B. B STA. 515+12
DRAIN CLEANOUT BOX
SEE STRUC. DWGS.
SHT. S-79
TOP = 569.18
INV. = 563.68



THIS WORK WAS PREPARED BY ME
OR UNDER MY SUPERVISION.
SIGNATURE DATE

GRAPHIC SCALE:





SEE NOTES SHT. C-26

11-5-93	REVISED	RI-RA 2
10-21-93	REVISED	RI-RA 1
DATE	REVISION	
STATE OF HAWAII DEPARTMENT OF TRANSPORTATION HIGHWAYS DIVISION		
GRADING & DRAINAGE PLAN STA. 506+00 TO STA. 516+00		
INTERSTATE ROUTE H-3 F.A.I. PROJECT NO. I-H3-1(69) & (70)		
SCALE: 1" = 40'		
DATE: MARCH, 1992		
SHEET NO. 029 OF 95 SHEETS		

ADD. 32

FED. ROAD DIST. NO.	STATE	FED. AID PROJ. NO.	FISCAL YEAR	SHEET NO.	TOTAL SHEETS
HAWAII	HAW.	I- H3-1(69)	1992	33	325

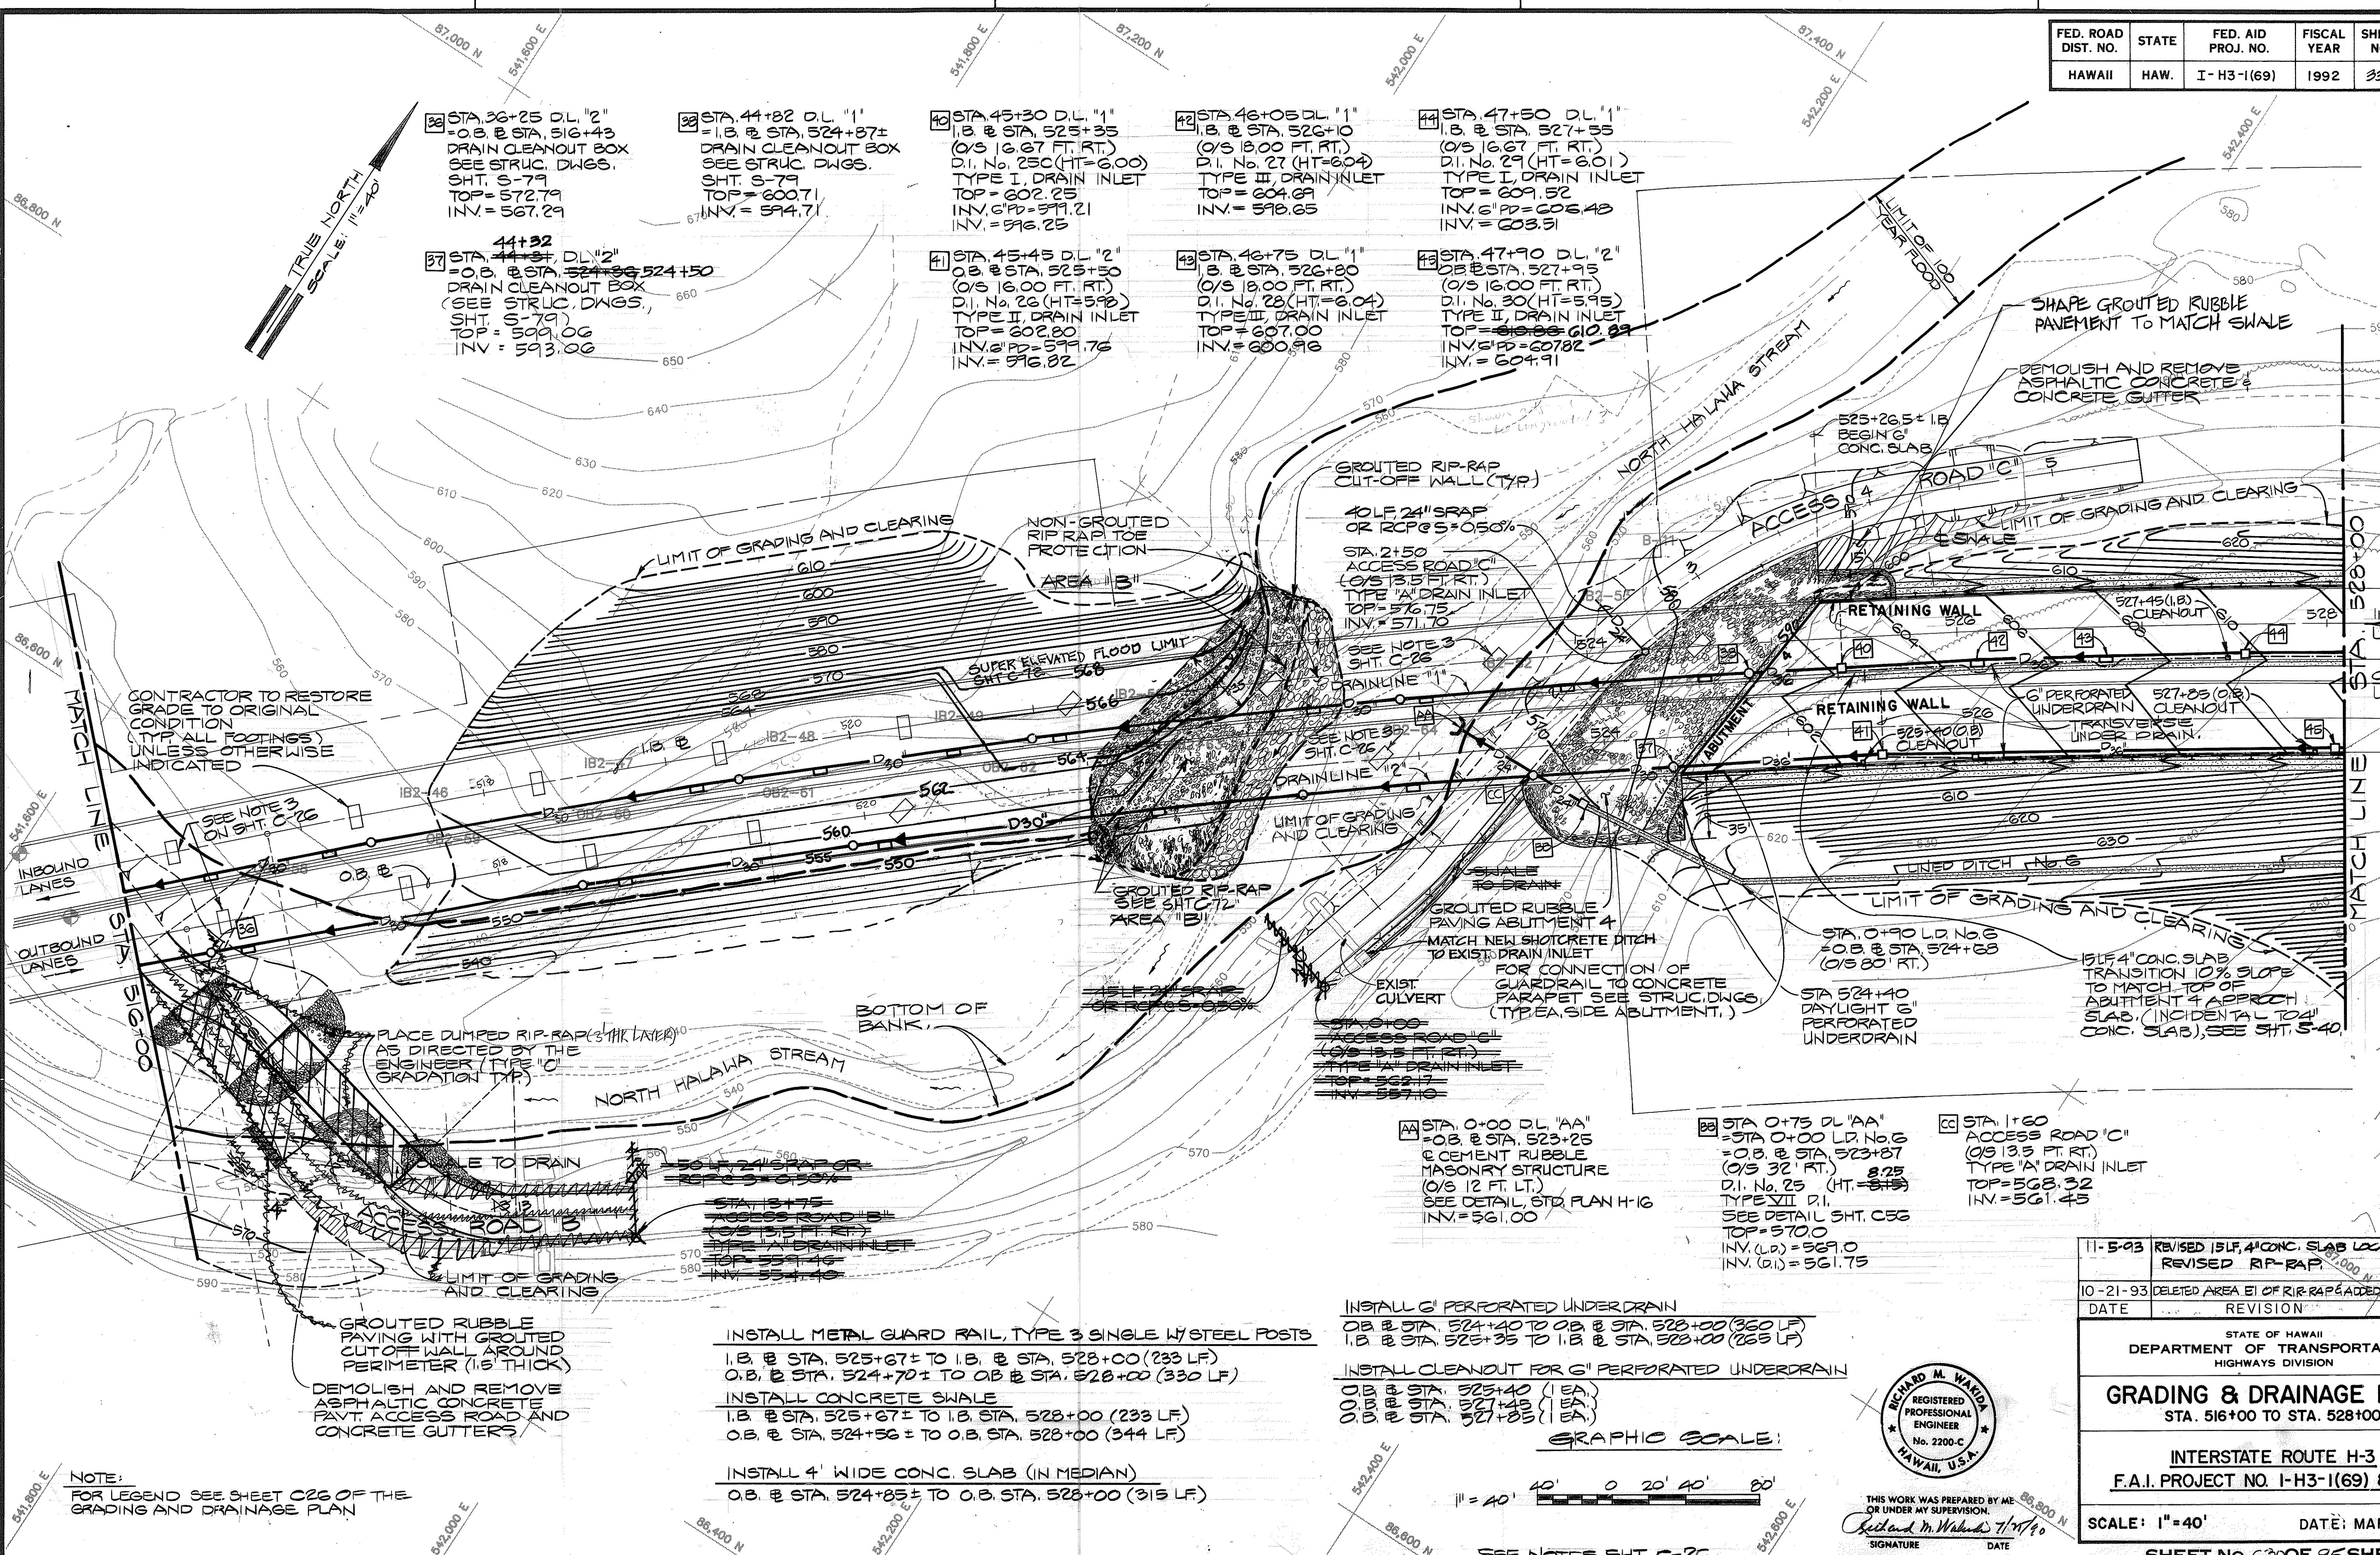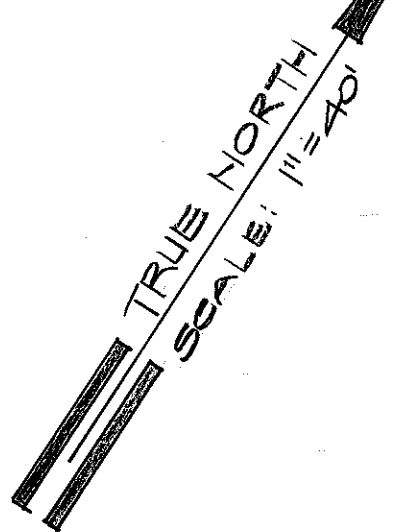

SURVEY PLOTTED BY	DATE
DRAWN BY	
DESIGNED BY	
QUANTITIES BY	
CHECKED BY	
ORIGINAL PLAN	
NOTE BOOK	
NO.	

NOTE:
FOR LEGEND SEE SHEET C26 OF THE
GRADING AND DRAINAGE PLAN

INSTALL METAL GUARD RAIL, TYPE 3 SINGLE W/ STEEL POSTS
I.B. @ STA. 525+67± TO I.B. @ STA. 528+00 (233 LF)
O.B. @ STA. 524+70± TO O.B. @ STA. 528+00 (330 LF)
INSTALL CONCRETE SWALE
I.B. @ STA. 525+67± TO I.B. @ STA. 528+00 (233 LF)
O.B. @ STA. 524+56± TO O.B. @ STA. 528+00 (344 LF)

INSTALL 4' WIDE CONC. SLAB (IN MEDIAN)
O.B. @ STA. 524+85± TO O.B. @ STA. 528+00 (315 LF)


INSTALL 6" PERFORATED UNDERDRAIN
O.B. @ STA. 524+40 TO O.B. @ STA. 528+00 (360 LF)
I.B. @ STA. 525+35 TO I.B. @ STA. 528+00 (265 LF)

INSTALL CLEANOUT FOR 6" PERFORATED UNDERDRAIN
O.B. @ STA. 523+40 (1 EA)
O.B. @ STA. 527+45 (1 EA)
O.B. @ STA. 527+85 (1 EA)

GRAPHIC SCALE:



SEE NOTES SHT. C-26

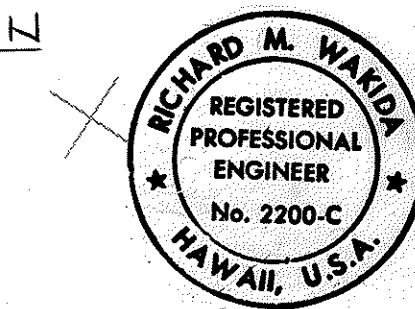

THIS WORK WAS PREPARED BY ME
OR UNDER MY SUPERVISION
Richard M. Waria 7/17/90
SIGNATURE DATE

11-5-93	REVISED 15L 4" CONC. SLAB LOCATION AND REVISED RIP-RAP
10-21-93	DELETED AREA B1 OF RIP-RAP ADDED UNDERDRAIN. DATE REVISION

STATE OF HAWAII
DEPARTMENT OF TRANSPORTATION
HIGHWAYS DIVISION

GRADING & DRAINAGE PLAN
STA. 516+00 TO STA. 528+00

INTERSTATE ROUTE H-3
F.A.I. PROJECT NO. I-H3-1(69) & (70)

SCALE: 1"=40' DATE: MARCH, 1992

SHEET NO. C30 OF 95 SHEETS

FED. ROAD DIST. NO.	STATE	FED. AID PROJ. NO.	FISCAL YEAR	SHEET NO.	TOTAL SHEETS
HAWAII	HAW	I-H3-1(69)	1992	34	325

DATE	
SURVEY PLOTTED BY	
DRAWN BY	
DESIGNED BY	
CHECKED BY	
NOTE BOOK	
QUANTITIES BY	
NO.	

NOTE:
FOR LEGEND SEE SHEET C-26
OF GRADING & DRAINAGE PLAN

INSTALL METAL GUARD RAIL, TYPE 3- SINGLE W/ STEEL POSTS
I.B. @ STA. 528+00 TO I.B. @ STA. 532+70 (470 L.F.)
O.B. @ STA. 528+00 TO O.B. @ STA. 535+00 (700 L.F.)

INSTALL G" CONCRETE SLAB
I.B. @ STA. 531+65 TO I.B. @ STA. 532+70 (105 L.F.)
O.B. @ STA. 532+20 TO O.B. @ STA. 535+00 (280 L.F.)

INSTALL CONCRETE SWALE
I.B. @ STA. 528+00 TO I.B. @ STA. 531+75 (375 L.F.)
O.B. @ STA. 528+00 TO O.B. @ STA. 532+20 (420 L.F.)

INSTALL 4' WIDE CONC. SLAB (IN MEDIAN)
O.B. @ STA. 528+00 TO O.B. @ STA. 535+00 (700 L.F.)


INSTALL G" PERFORATED UNDER DRAIN
O.B. @ STA. 528+00 TO O.B. @ STA. 534+90 (210 L.F.)
I.B. @ STA. 528+00 TO I.B. @ STA. 535+05 (705 L.F.)
O.B. @ STA. 530+10 (TRANSVERSE) (40 L.F.)
I.B. @ STA. 530+10 (TRANSVERSE) (40 L.F.)

INSTALL CLEANOUT FOR G" PERFORATED UNDER DRAIN
I.B. @ STA. 529+00 (1EA) O.B. @ STA. 532+90 (1EA)
O.B. @ STA. 530+40 (1EA) I.B. @ STA. 533+45 (1EA)
I.B. @ STA. 530+45 (1EA) O.B. @ STA. 534+90 (1EA)
I.B. @ STA. 531+95 (1EA) I.B. @ STA. 535+05 (1EA)

GRAPHIC SCALE:

1" = 40'

SEE NOTES SHT. C-26

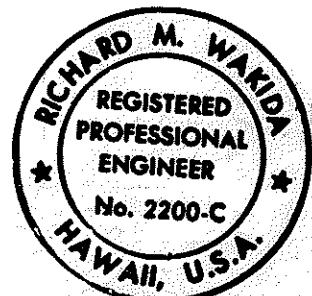

THIS WORK WAS PREPARED BY ME
OR UNDER MY SUPERVISION.
Richard M. Waiwai 7/1/92
SIGNATURE DATE

11-5-93	REVISED RIP-RAP TYPE AT LINED DITCH OUTLET
10-21-93	REVISED TYPE GRADATION
DATE	REVISION

STATE OF HAWAII
DEPARTMENT OF TRANSPORTATION
HIGHWAYS DIVISION

GRADING & DRAINAGE PLAN
STA. 528+00 TO STA. 534+99.90

INTERSTATE ROUTE H-3
F.A.I. PROJECT NO. I-H3-1(69) & (70)


SCALE: 1" = 40' DATE: MARCH, 1992

SHEET NO. 34 OF 95 SHEETS

ADD. 34


FED. ROAD DIST. NO.	STATE	FED. AID PROJ. NO.	FISCAL YEAR	SHEET NO.	TOTAL SHEETS
HAWAII	HAW.	I-H3-1(69)	1992	ADD 34 S-1	325

NOTE: THIS TRACING PREPARED DURING "AS BUILT" POSTING


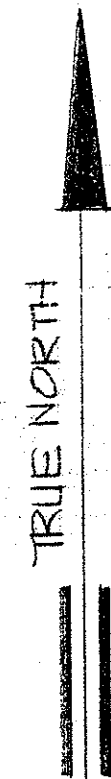


537,500 E
85,000 N

538,500 E

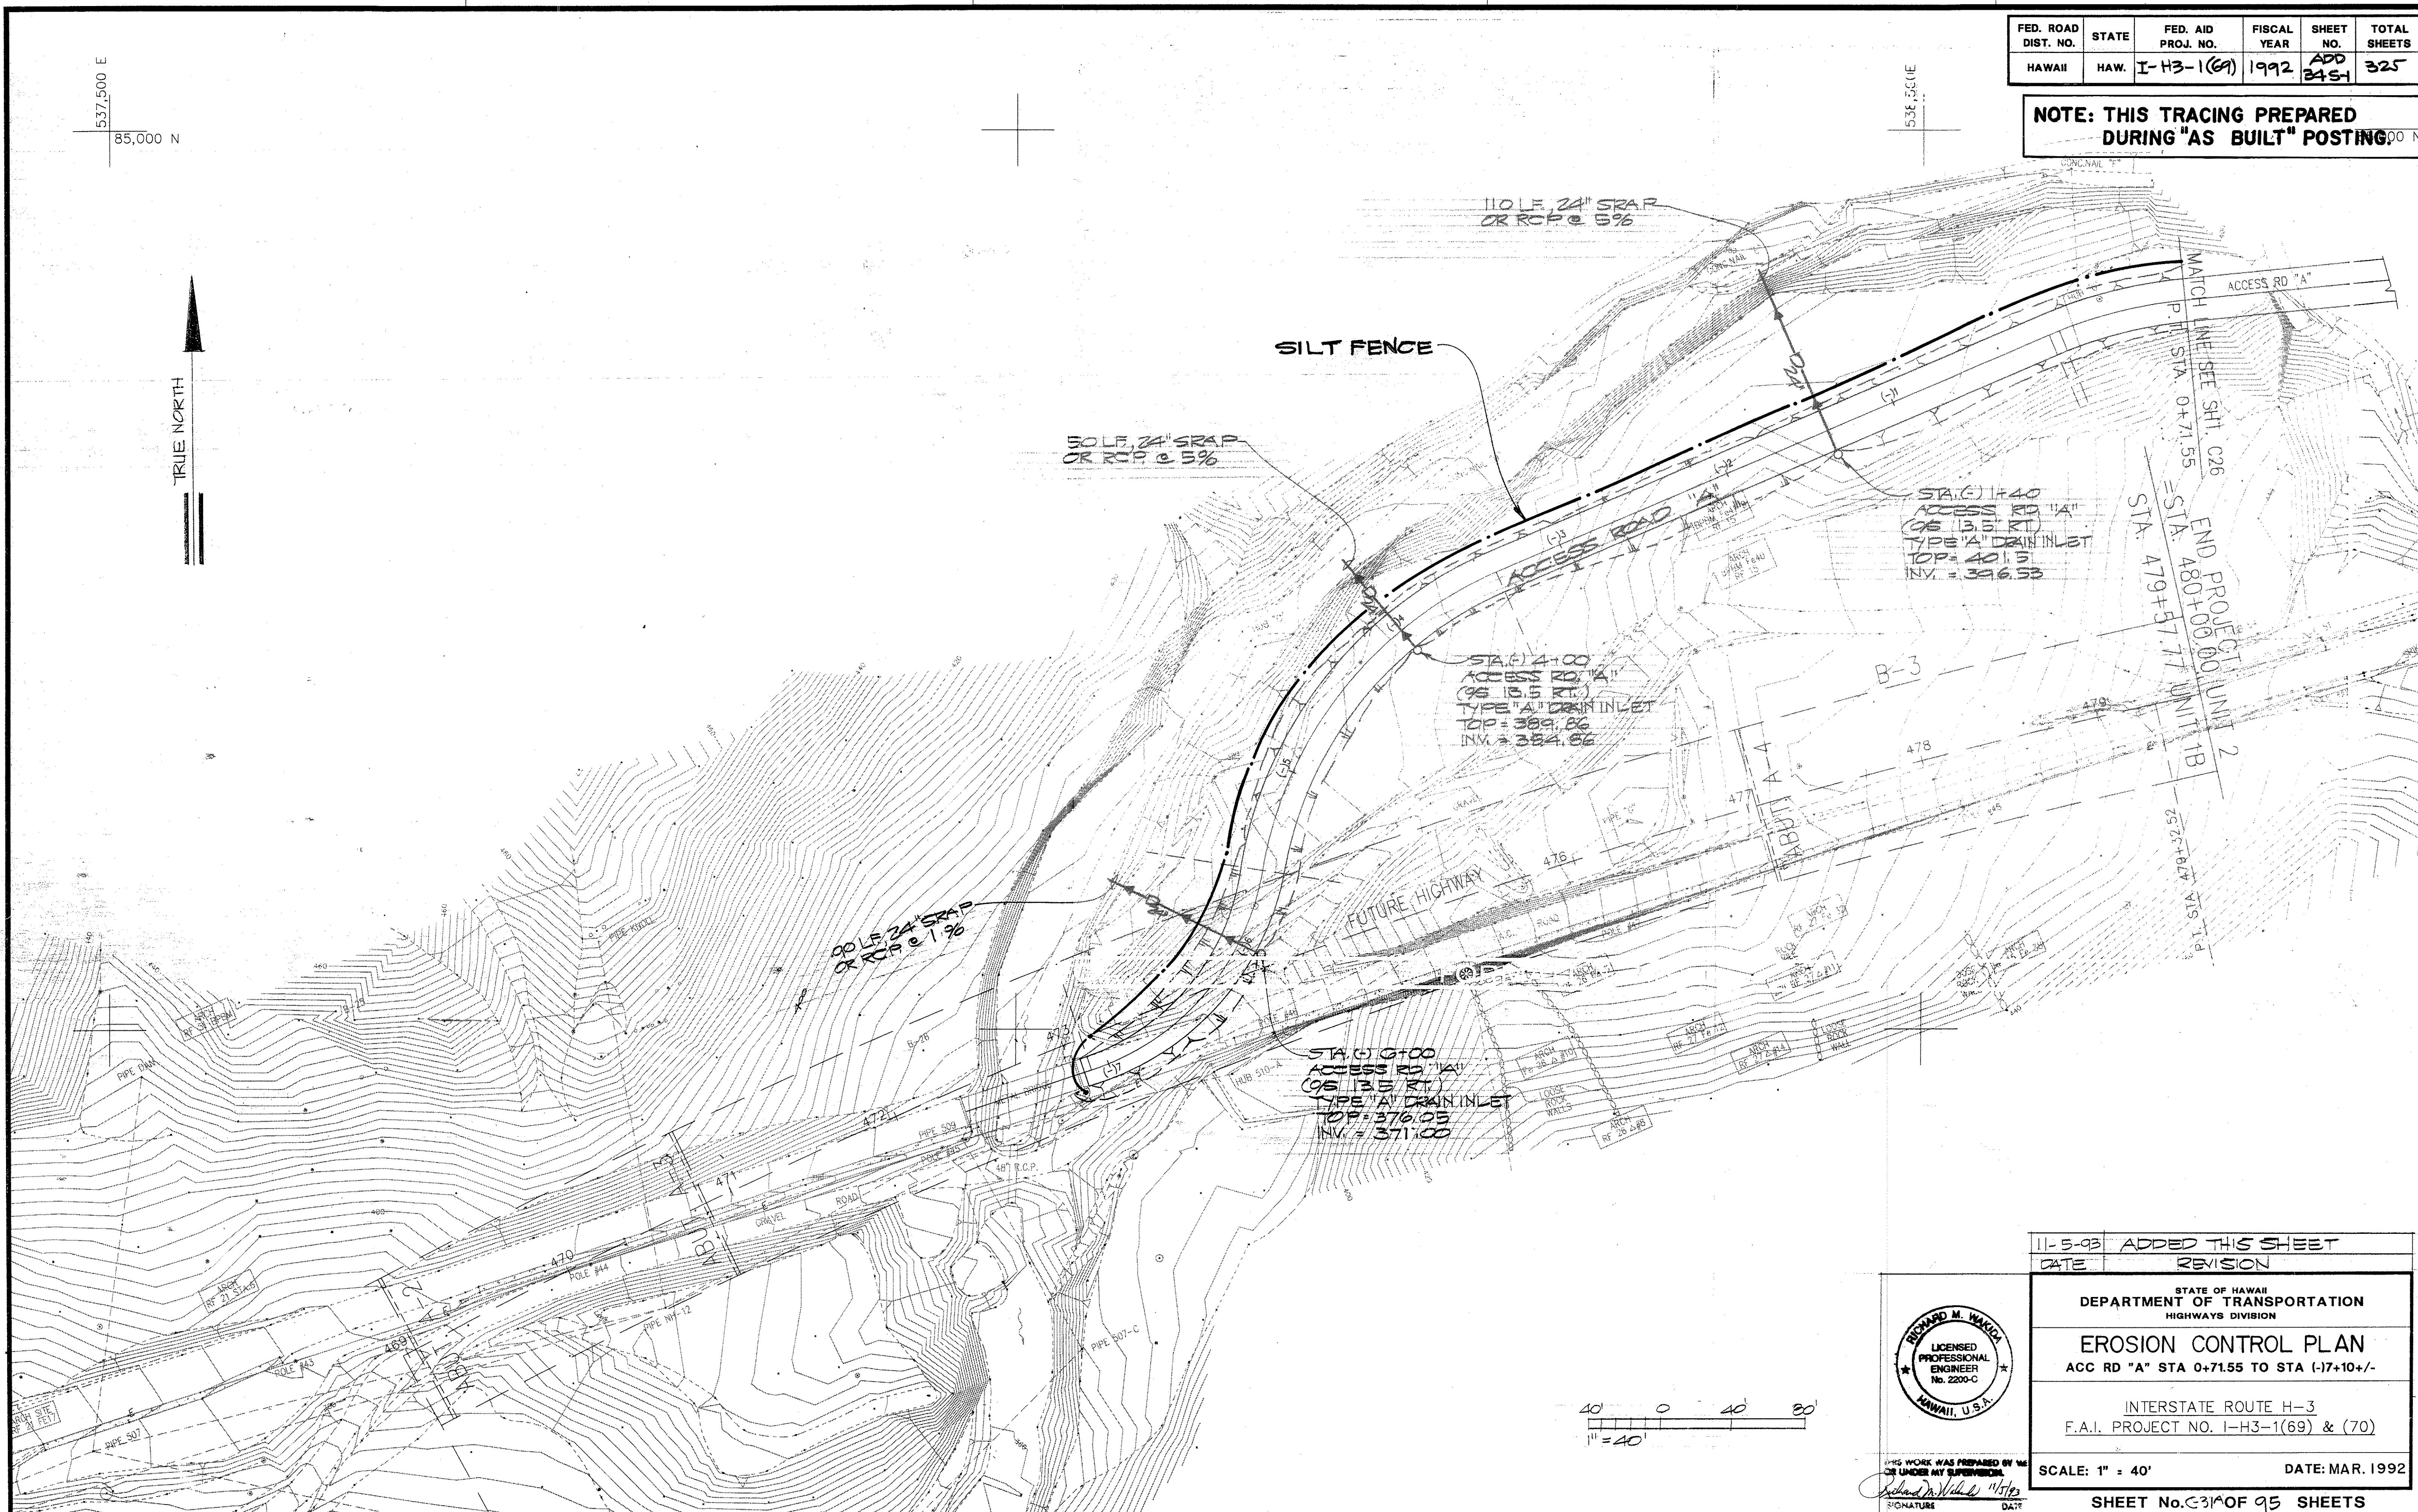

ORIGINAL PLAN	DATE
TRACED BY	
DESIGNED BY	
QUANTITIES BY	
CHECKED BY	

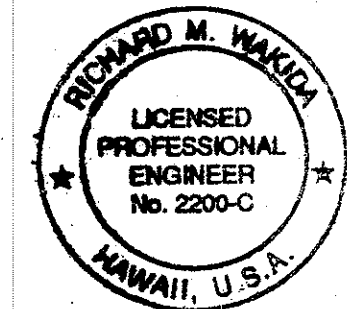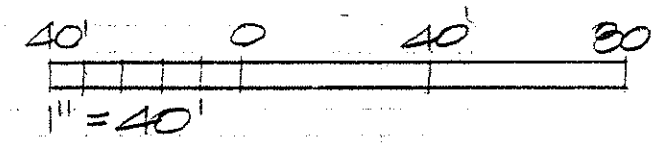


THIS WORK WAS PREPARED BY ME OR UNDER MY SUPERVISION.
Richard M. Wakita 11/1/92
SIGNATURE DATE

11-5-92	ADDED THIS SHEET
DATE	REVISION
STATE OF HAWAII DEPARTMENT OF TRANSPORTATION HIGHWAYS DIVISION	
EROSION CONTROL PLAN ACC RD "A" STA 0+71.55 TO STA 1+71.55	
INTERSTATE ROUTE H-3 F.A.I. PROJECT NO. I-H3-1(69) & (70)	
SCALE: 1" = 40'	DATE: MAR. 1992
SHEET No. 31 OF 95 SHEETS	

ADD.34 S-1

FED. ROAD DIST. NO.	STATE	FED. AID PROJ. NO.	FISCAL YEAR	SHEET NO.	TOTAL SHEETS
HAWAII	HAW.	I-H3-1(69)	1992	ADD 34S-2	325

NOTE: THIS TRACING PREPARED DURING "AS BUILT" POSTING.

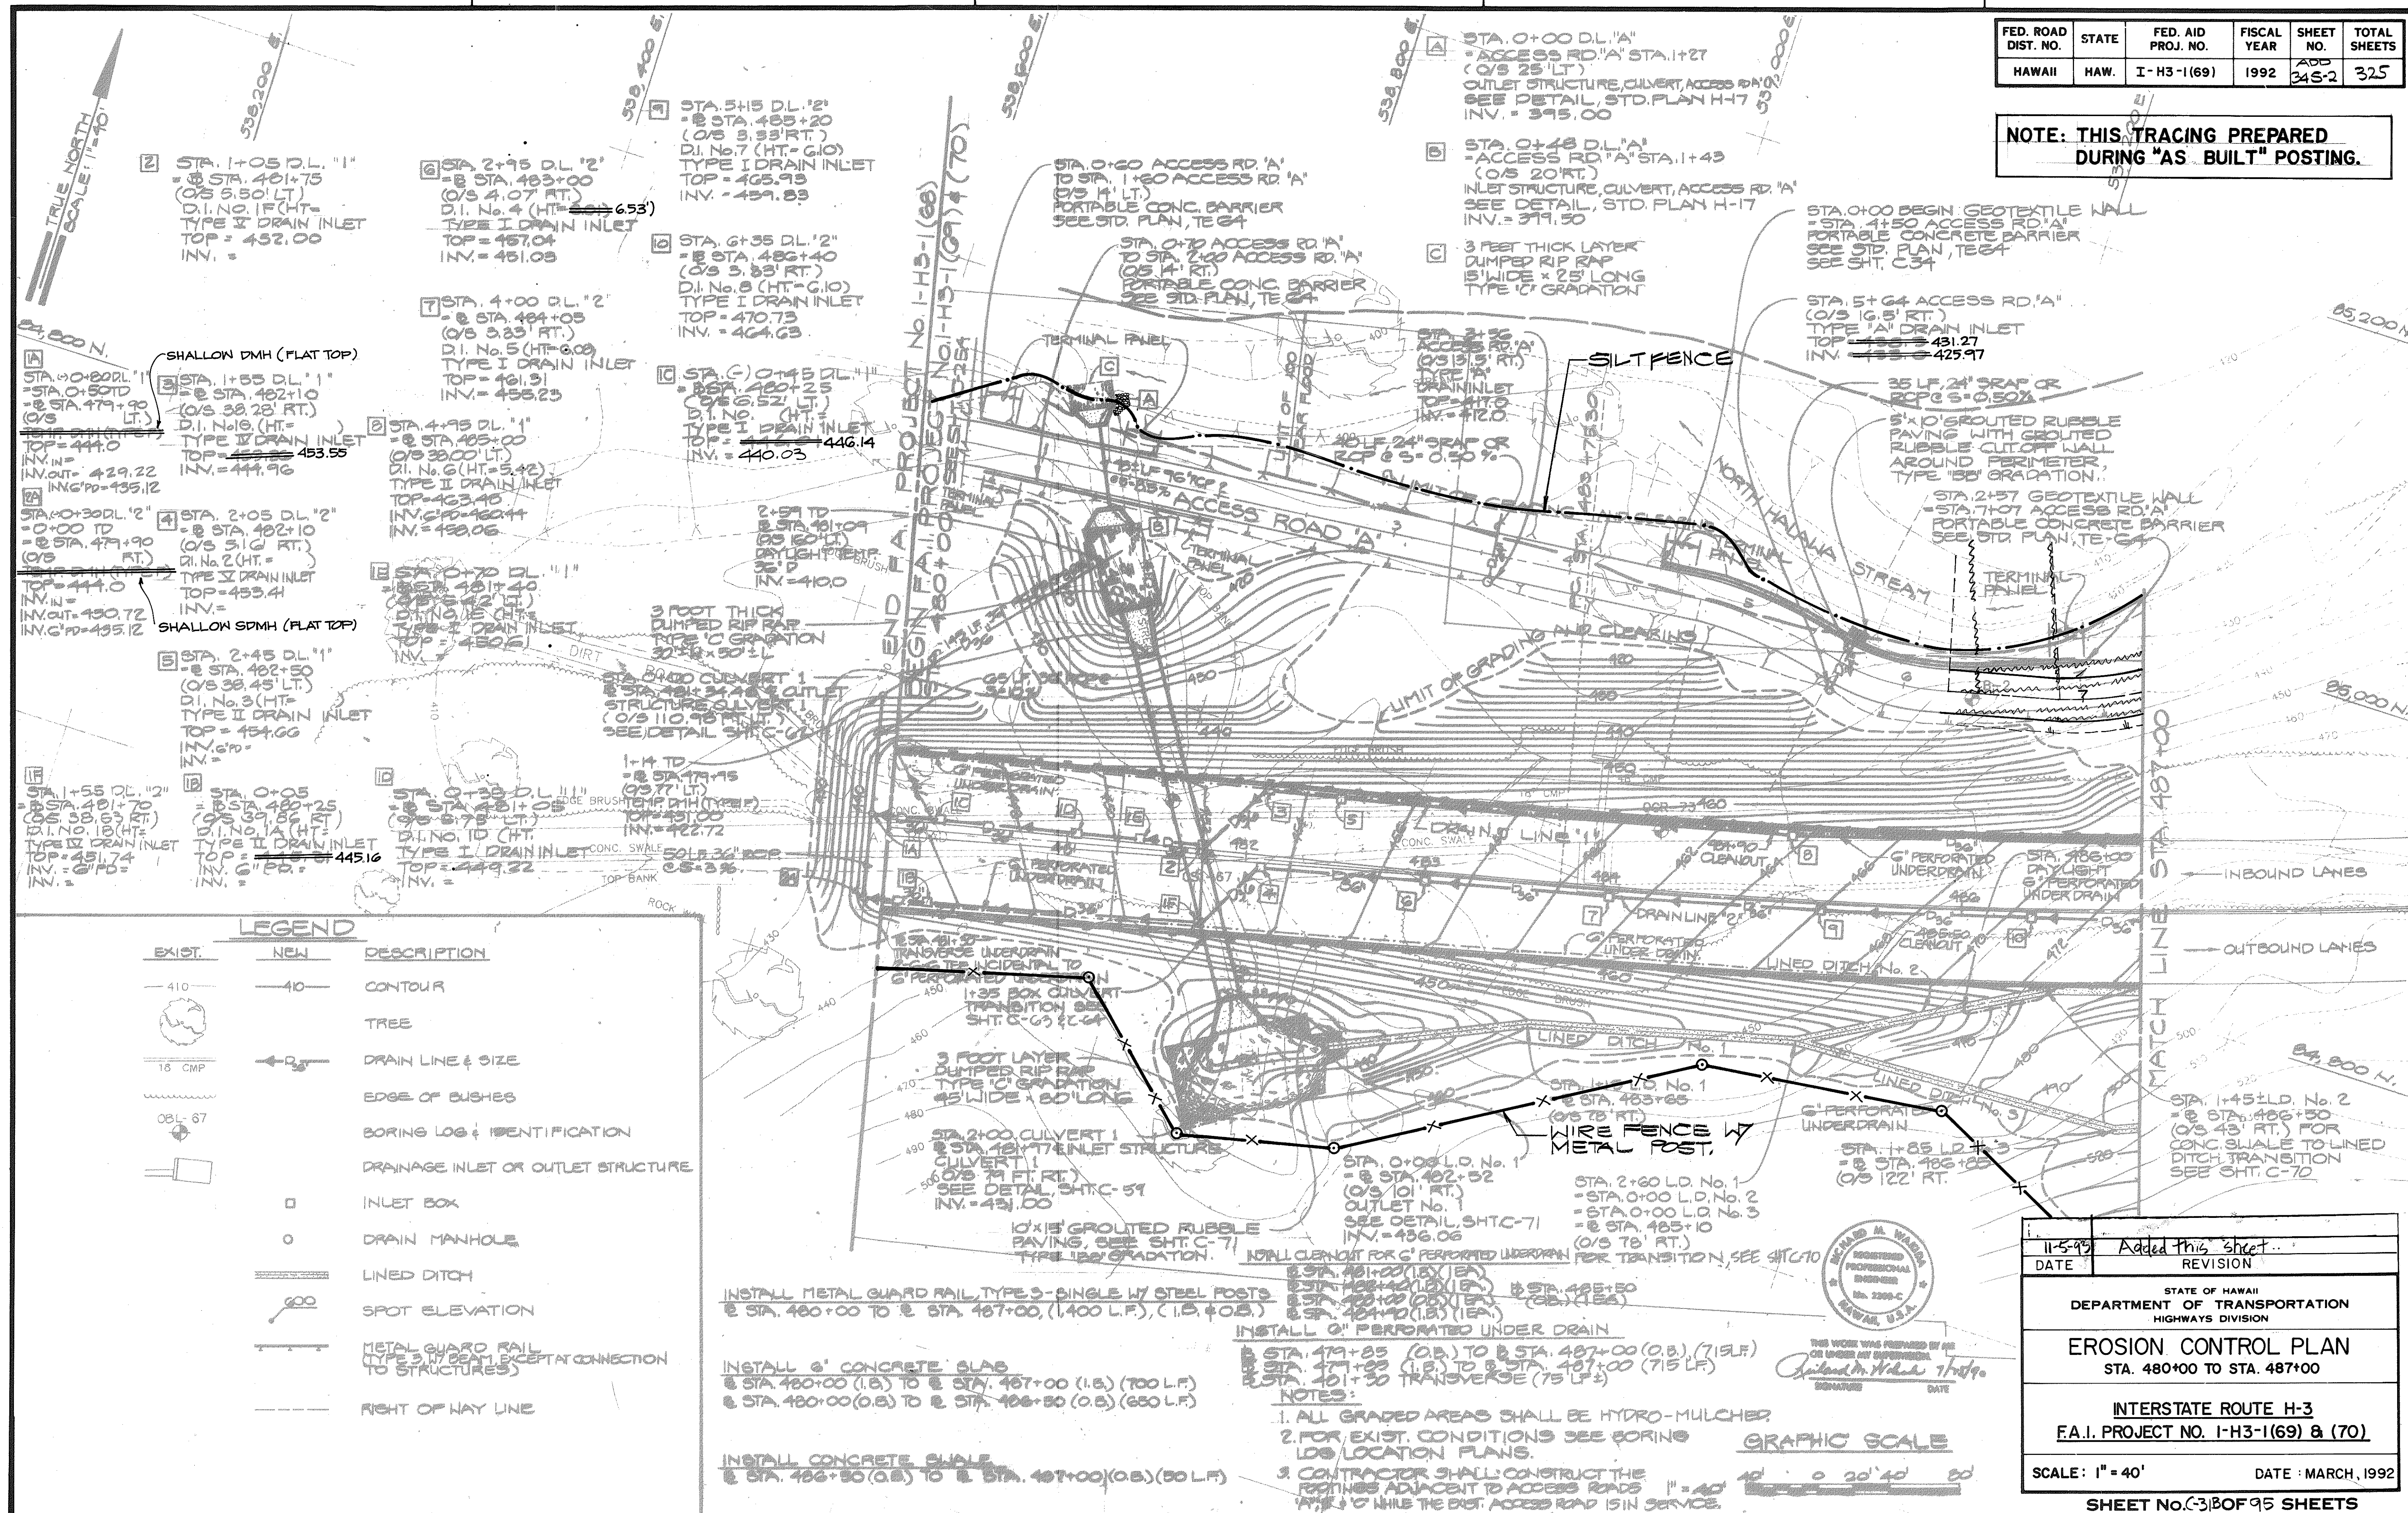


DATE	
DESIGNED BY	
CHECKED BY	
NO.	

11-5-93	Added this sheet
DATE	REVISION
STATE OF HAWAII DEPARTMENT OF TRANSPORTATION HIGHWAYS DIVISION	
EROSION CONTROL PLAN STA. 480+00 TO STA. 487+00	
INTERSTATE ROUTE H-3 F.A.I. PROJECT NO. I-H3-1(69) & (70)	
SCALE: 1" = 40'	DATE: MARCH, 1992
SHEET No. (3) OF 95 SHEETS	

ADD. 34S-2

NOTE: THIS TRACING PREPARED DURING "AS BUILT" POSTING.

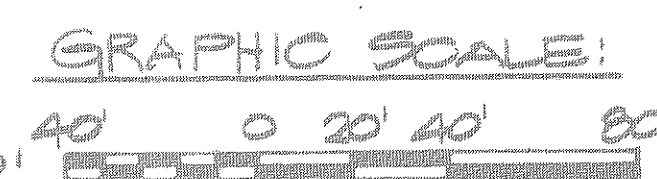

H-5-95	Added sheet
DATE	REVISION
STATE OF HAWAII DEPARTMENT OF TRANSPORTATION HIGHWAYS DIVISION	
EROSION CONTROL PLAN STA. 487+00 TO STA. 495+00	
<u>INTERSTATE ROUTE H-3</u> <u>F.A.I. PROJECT NO. I-H3-1(69) & (70)</u>	
SCALE: 1" = 40'	DATE : MARCH, 1992
SHEET No. 63 OF 95 SHEETS	



ADD. 34 S-3

ORIGINAL PLAN	SURVEY PLOTTED BY _____ DATE _____
NOTE BOOK	DRAWN BY _____
	TRACED BY _____
	DESIGNED BY _____
	QUANTITIES BY _____
No. _____	CHECKED BY _____

FED. ROAD DIST. NO.	STATE	FED. AID PROJ. NO.	FISCAL YEAR	SHEET NO.	TOTAL SHEETS
HAWAII	HAW.	I-H3-1(69)	1992	ADD 34 S-5	325

NOTE: THIS TRACING PREPARED DURING "AS BUILT" POSTING.

SURVEY PLOTTED BY	DATE
DRAWN BY	
DESIGNED BY	
QUANTITIES BY	
CHECKED BY	
ORIGINAL PLAN	
NOTE BOOK	
No.	

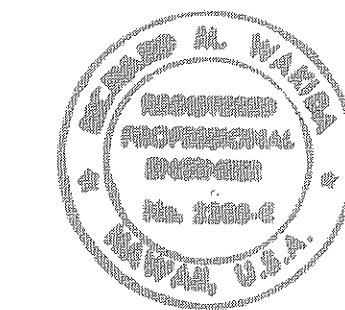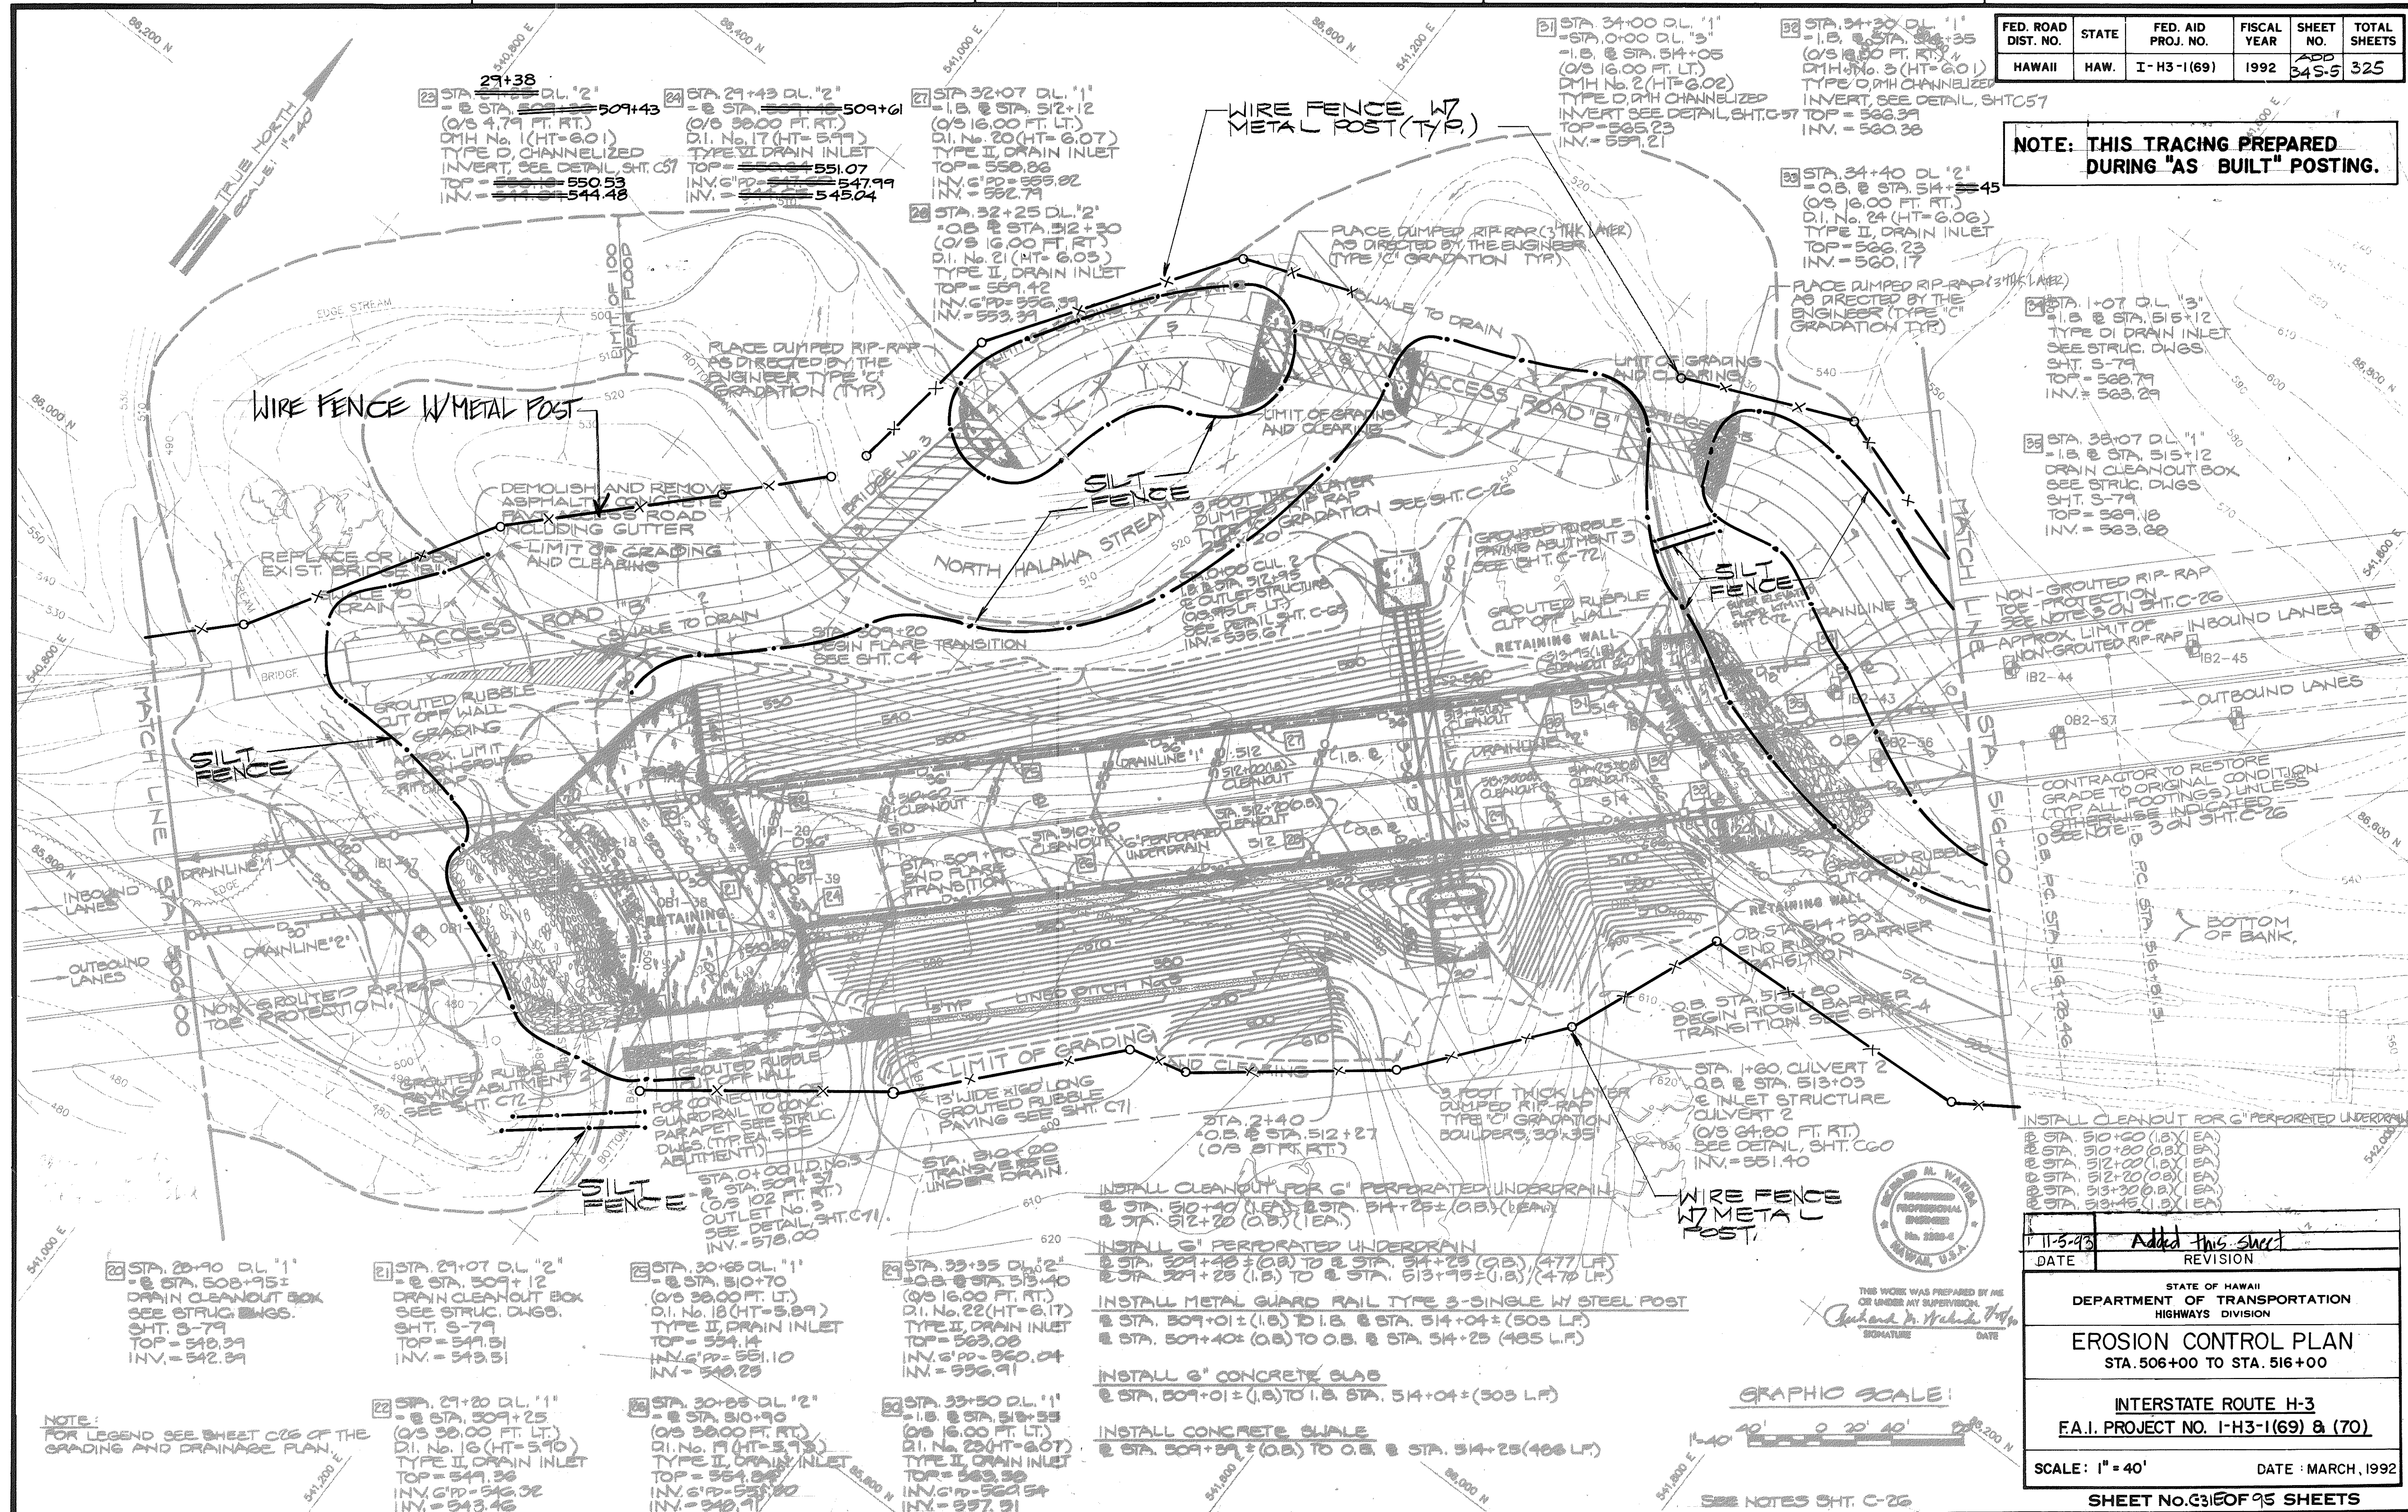


THIS WORK WAS PREPARED BY ME OR UNDER MY SUPERVISION.
 Signature: Michael A. Wai
 Date: 11-5-93

11-5-93	Added this sheet
DATE	REVISION
STATE OF HAWAII DEPARTMENT OF TRANSPORTATION HIGHWAYS DIVISION	
EROSION CONTROL PLAN STA. 506+00 TO STA. 516+00	
INTERSTATE ROUTE H-3 F.A.I. PROJECT NO. I-H3-1(69) & (70)	
SCALE: 1" = 40'	DATE: MARCH, 1992
SHEET No. 631 OF 95 SHEETS	

ADD. 34 S-5

FED. ROAD DIST. NO.	STATE	FED. AID PROJ. NO.	FISCAL YEAR	SHEET NO.	TOTAL SHEETS
HAWAII	HAW.	I-H3-1(69)	1992	ADD 34S-6	325

NOTE: THIS TRACING PREPARED DURING "AS BUILT" POSTING.

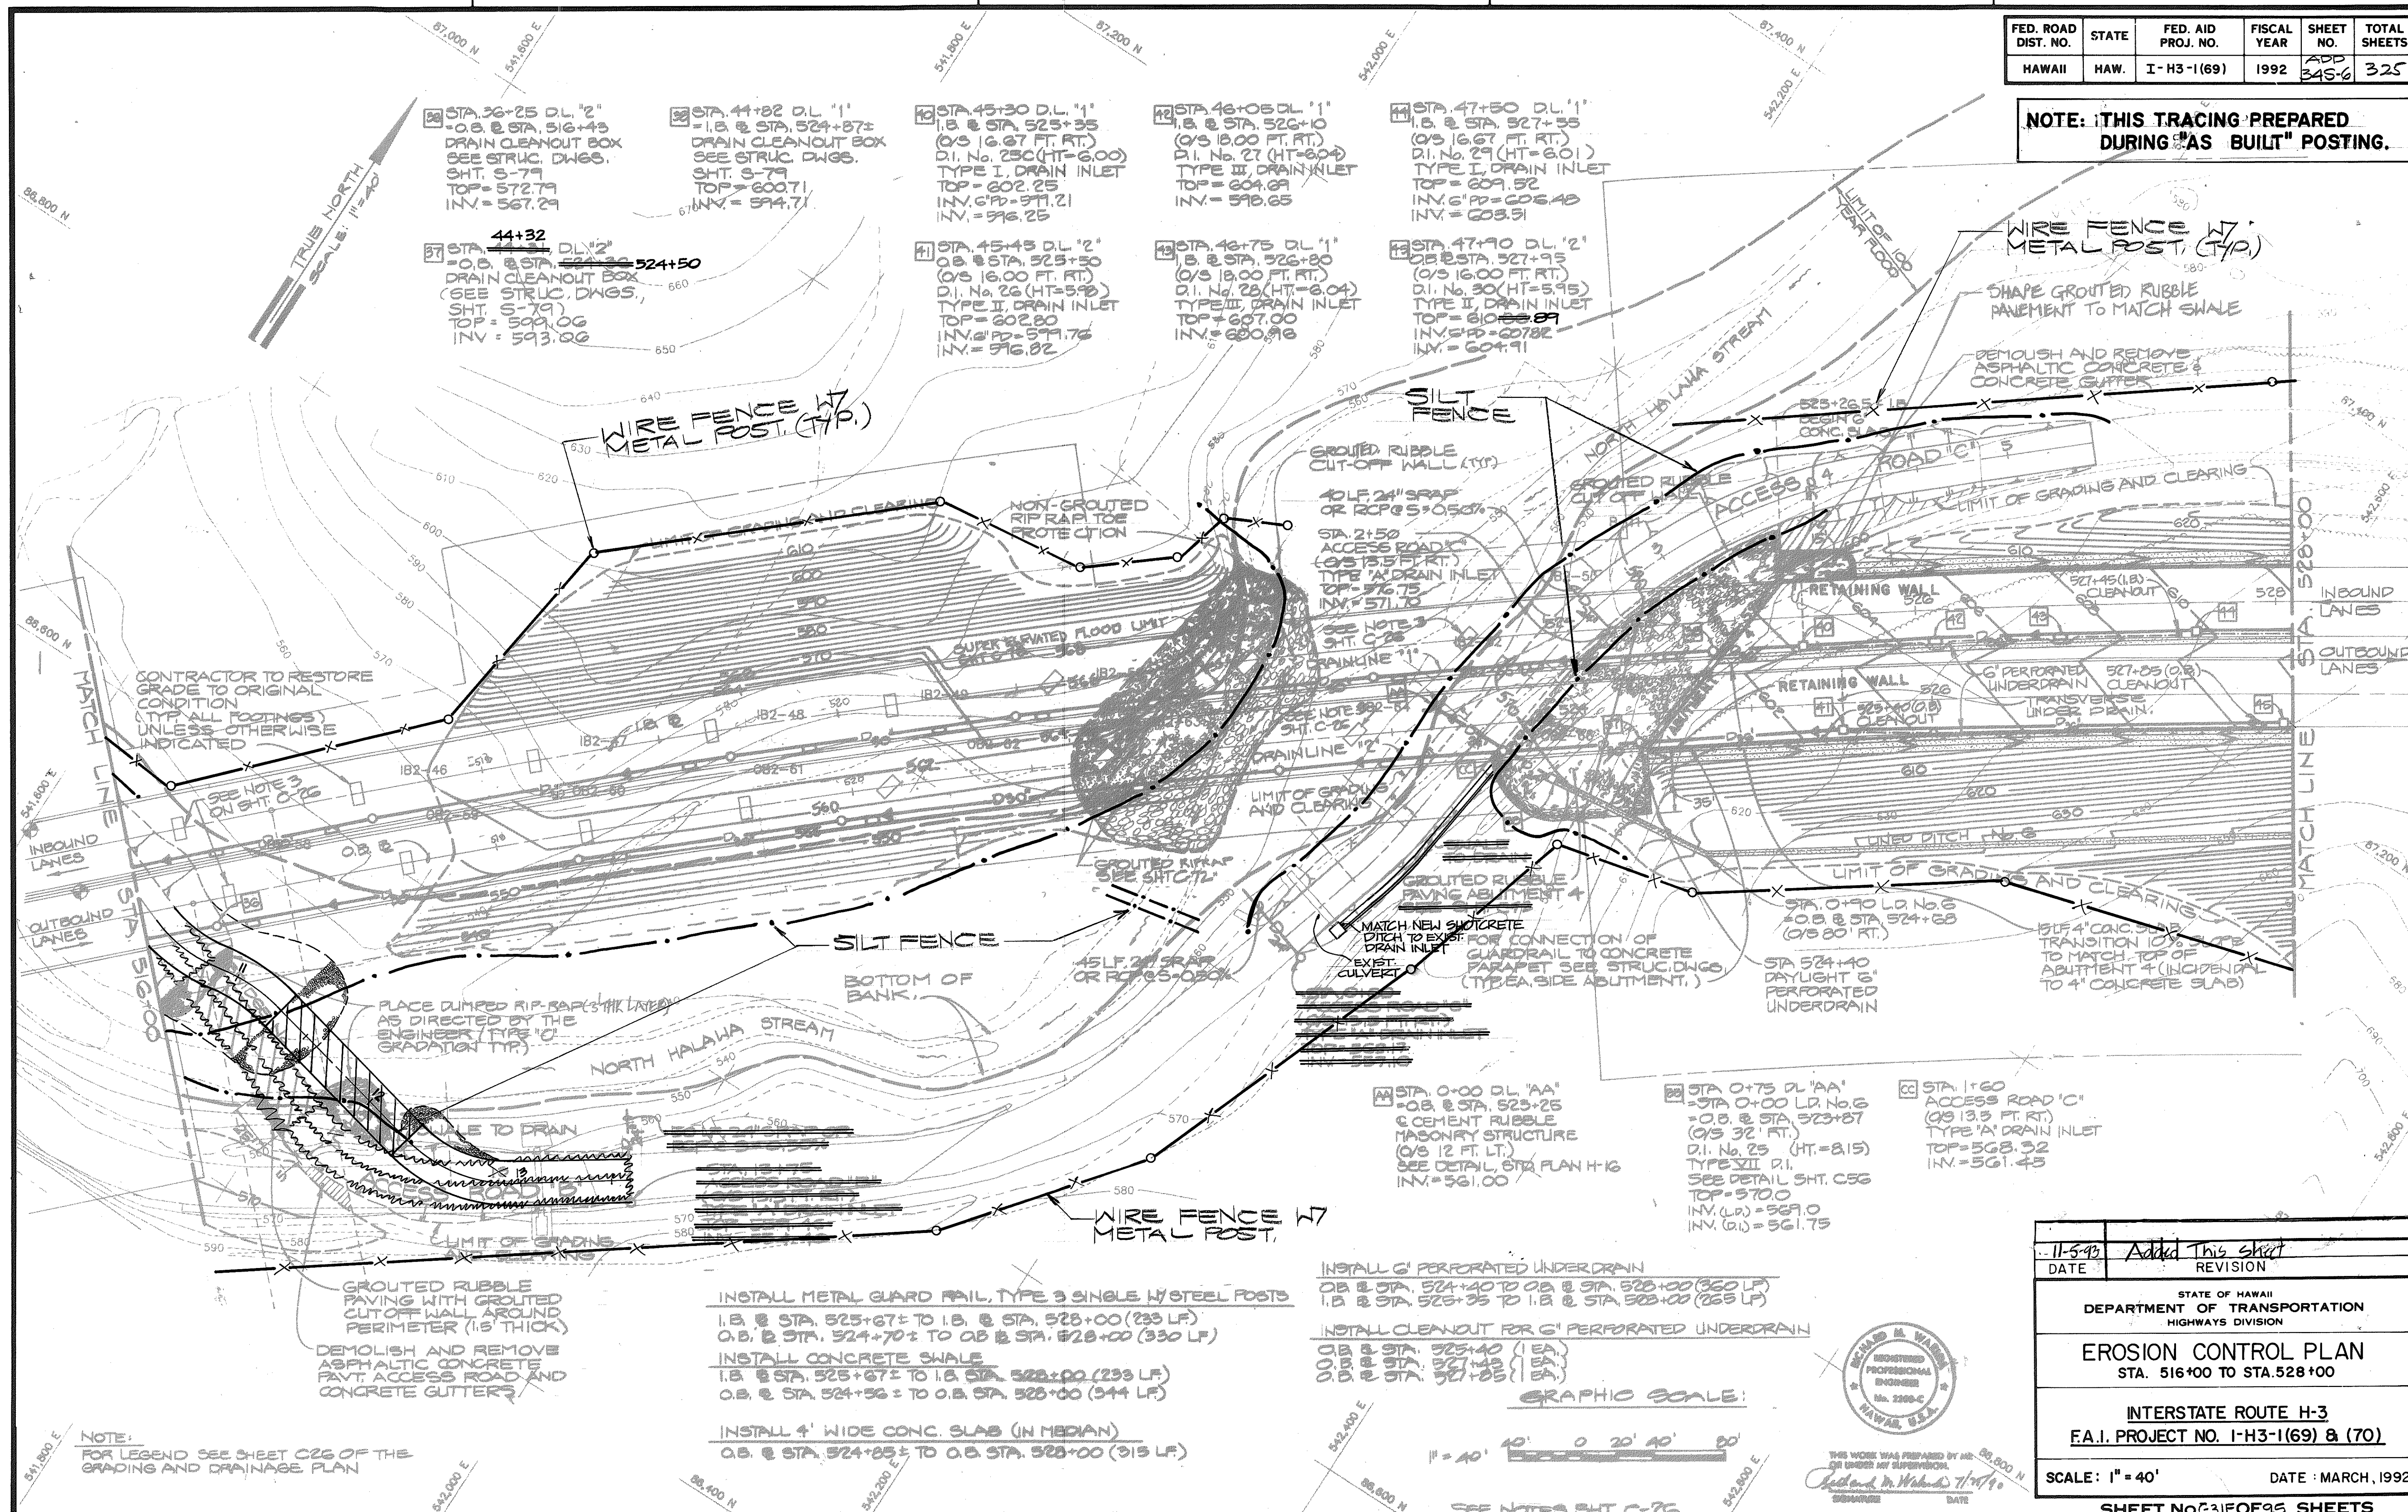


SURVEY PLOTTED BY	DATE
DRAWN BY	
DESIGNED BY	
QUANTITIES BY	
CHECKED BY	
ORIGINAL PLAN	
NOTE BOOK	
NO.	

11-5-92	Added This sheet
DATE	REVISION
STATE OF HAWAII DEPARTMENT OF TRANSPORTATION HIGHWAYS DIVISION	
EROSION CONTROL PLAN STA. 516+00 TO STA. 528+00	
INTERSTATE ROUTE H-3 F.A.I. PROJECT NO. I-H3-1(69) & (70)	
SCALE: 1" = 40'	DATE: MARCH, 1992
SHEET NO. 31 OF 95 SHEETS	

ADD. 34 S-6

FED. ROAD DIST. NO.	STATE	FED. AID PROJ. NO.	FISCAL YEAR	SHEET NO.	TOTAL SHEETS
HAWAII	HAW.	I-H3-1(69)	1992	ADD 34S-7	325

NOTE: THIS TRACING PREPARED DURING "AS-BUILT" POSTING.

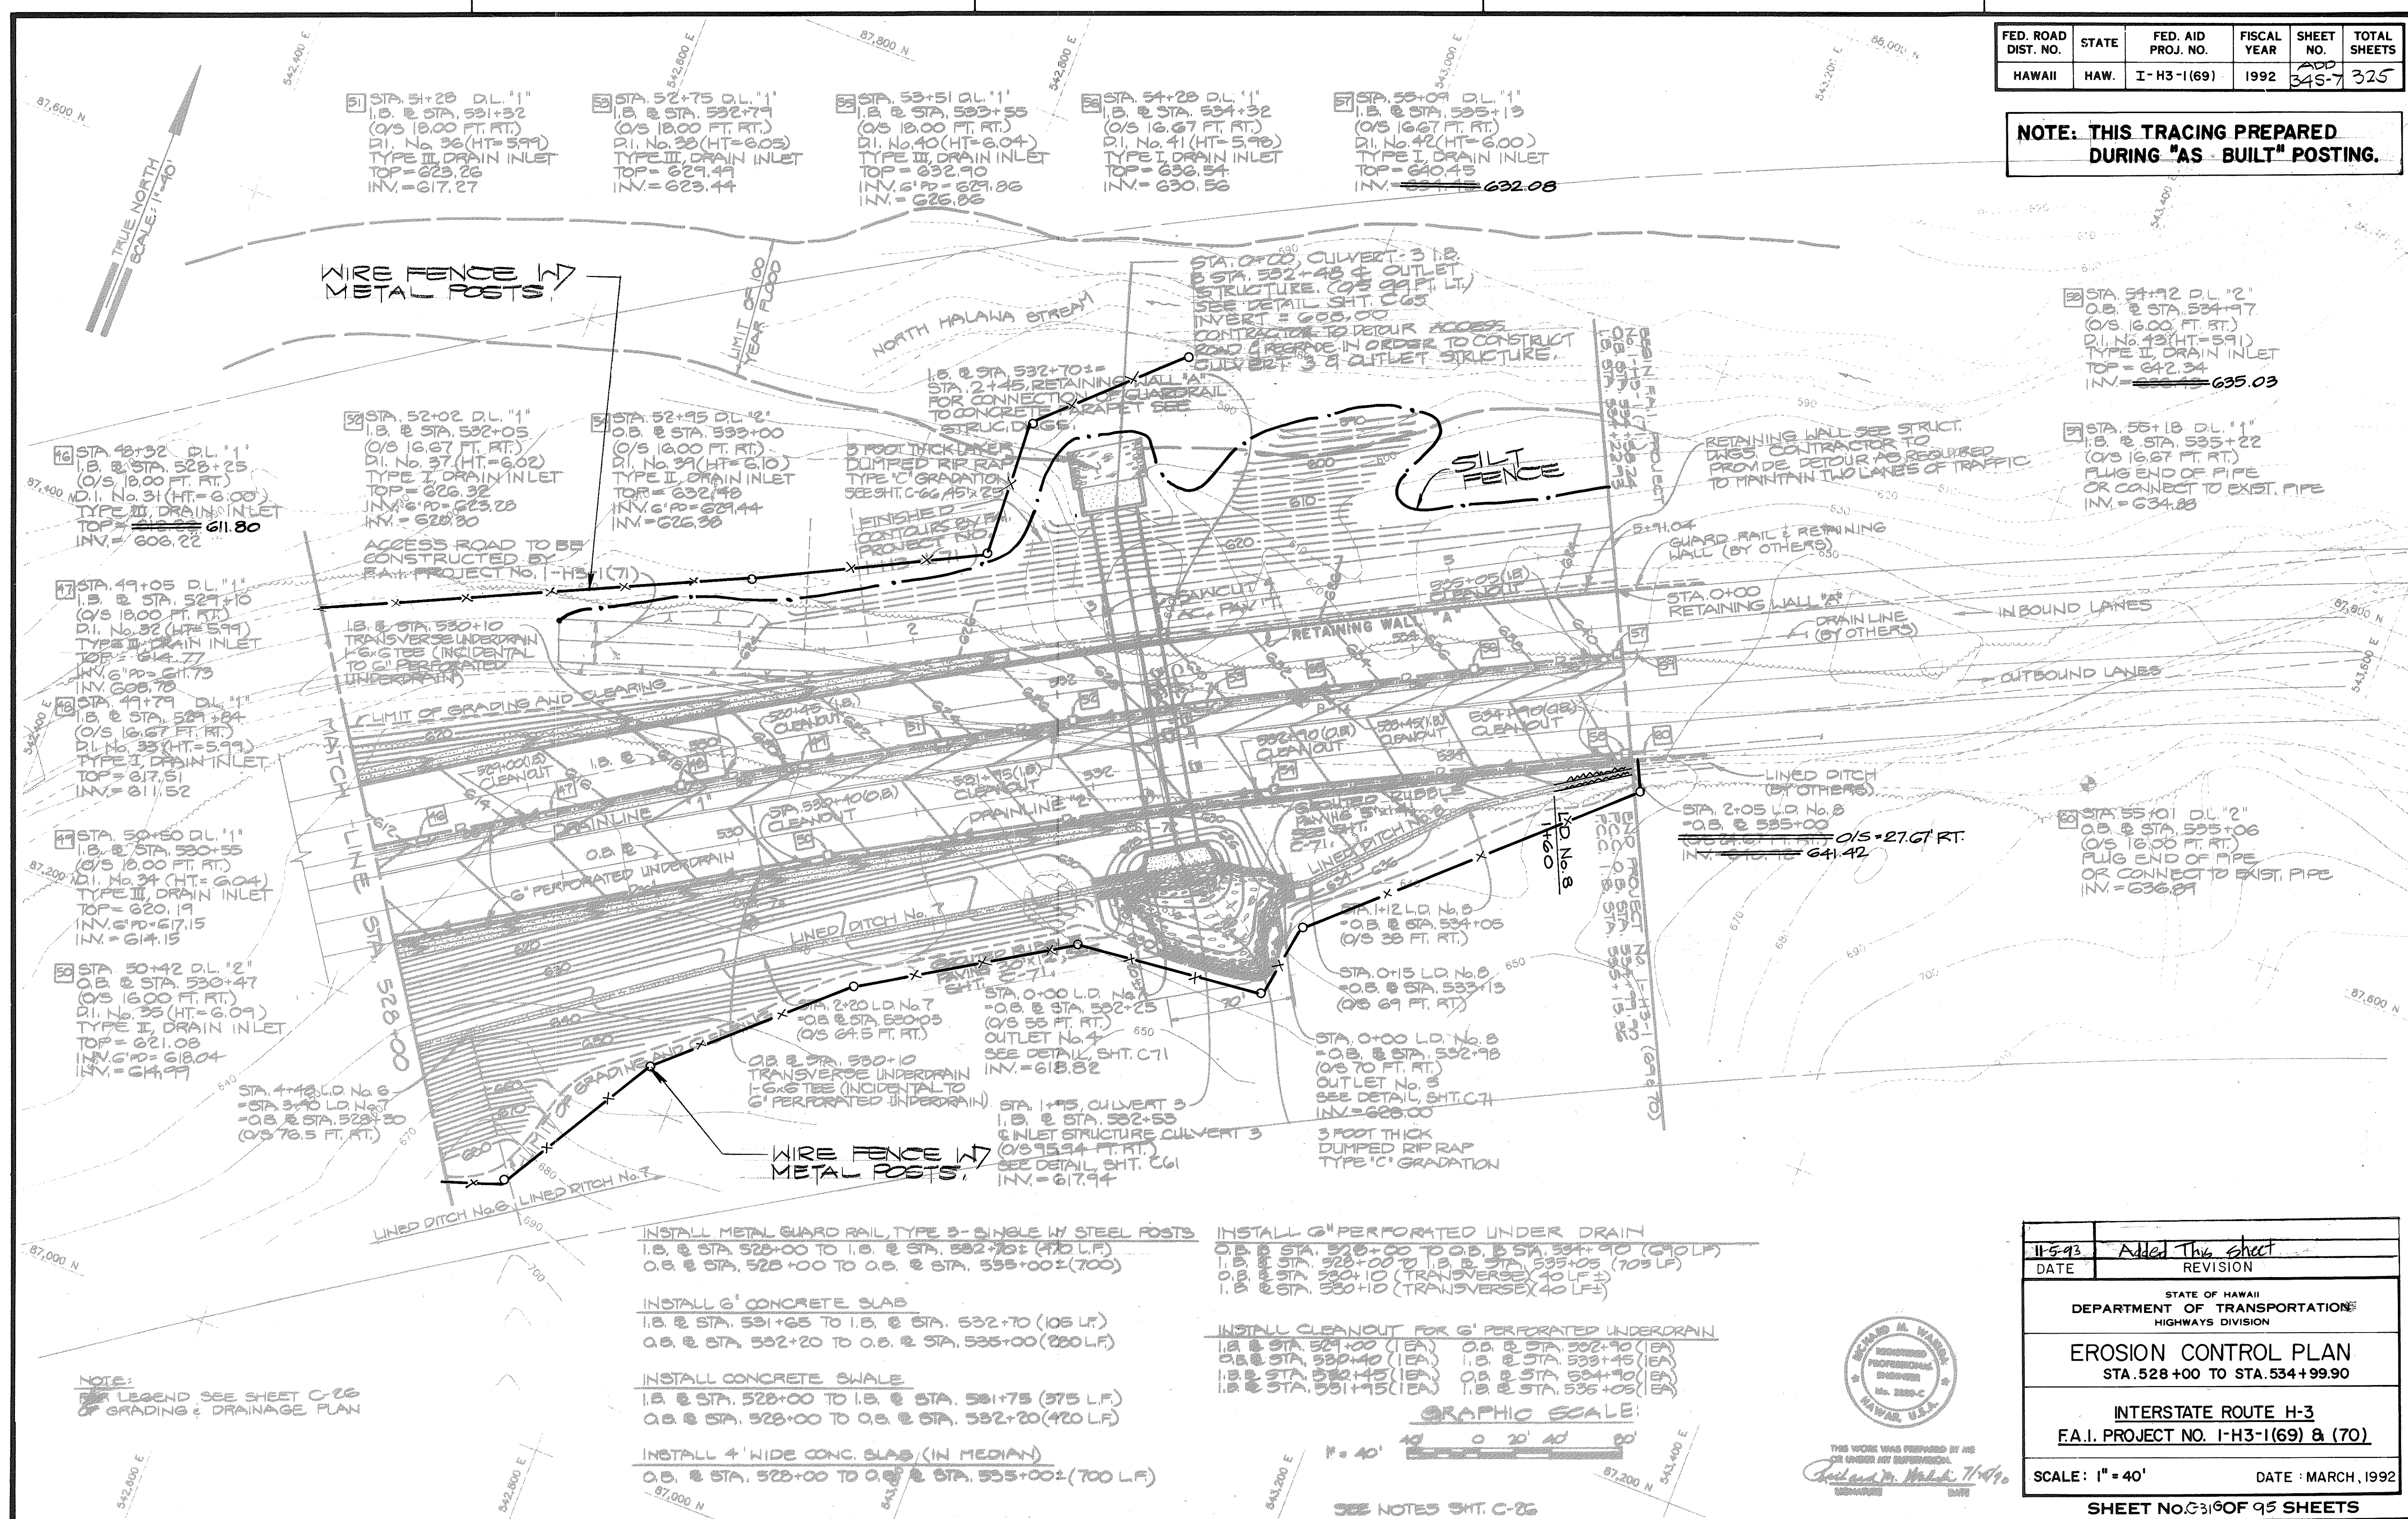

DATE	
DESIGNED BY	
CHECKED BY	
NOTED BY	
QUANTITIES BY	
CHECKED BY	

NOTE: SEE LEGEND SEE SHEET C-26 OF GRADING & DRAINAGE PLAN

- INSTALL METAL GUARD RAIL, TYPE 3-SINGLE W/ STEEL POSTS
I.B. & STA. 528+00 TO I.B. & STA. 532+75 (470 L.F.)
O.B. & STA. 528+00 TO O.B. & STA. 535+00 (700)
- INSTALL G⁴ CONCRETE SLAB
I.B. & STA. 531+65 TO I.B. & STA. 532+70 (105 L.F.)
O.B. & STA. 532+20 TO O.B. & STA. 535+00 (280 L.F.)
- INSTALL CONCRETE SWALE
I.B. & STA. 528+00 TO I.B. & STA. 531+75 (375 L.F.)
O.B. & STA. 528+00 TO O.B. & STA. 532+20 (420 L.F.)
- INSTALL 4' WIDE CONC. SLAB (IN MEDIAN)
O.B. & STA. 528+00 TO O.B. & STA. 535+00 (700 L.F.)


- INSTALL G⁴ PERFORATED UNDER DRAIN
O.B. & STA. 528+00 TO O.B. & STA. 534+90 (640 L.F.)
I.B. & STA. 528+00 TO I.B. & STA. 535+05 (705 L.F.)
O.B. & STA. 530+10 (TRANSVERSE) (40 L.F.)
I.B. & STA. 530+10 (TRANSVERSE) (40 L.F.)

- INSTALL CLEANOUT FOR G⁴ PERFORATED UNDERDRAIN
I.B. & STA. 529+00 (1EA) O.B. & STA. 532+90 (1EA)
O.B. & STA. 530+40 (1EA) I.B. & STA. 533+45 (1EA)
I.B. & STA. 532+45 (1EA) O.B. & STA. 534+90 (1EA)
I.B. & STA. 531+95 (1EA) I.B. & STA. 535+05 (1EA)

GRAPHIC SCALE:



SEE NOTES SHEET C-26

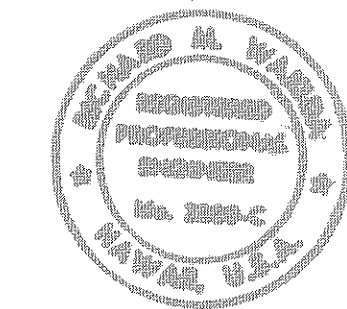

THIS WORK WAS PREPARED BY ME OR UNDER MY SUPERVISION.
Michael A. Walsh 7/1/92

11-5-93	Added This sheet
DATE	REVISION
STATE OF HAWAII DEPARTMENT OF TRANSPORTATION HIGHWAYS DIVISION	
EROSION CONTROL PLAN STA. 528+00 TO STA. 534+99.90	
INTERSTATE ROUTE H-3 F.A.I. PROJECT NO. I-H3-1(69) & (70)	
SCALE: 1" = 40'	DATE: MARCH, 1992
SHEET No. 63 OF 95 SHEETS	

ADD. 34S-7