


FED. ROAD DIST. NO.	STATE	FED. AID PROJ. NO.	FISCAL YEAR	SHEET NO.	TOTAL SHEETS
HAWAII	HAW.	I-H3-1(69)	1992	17	325

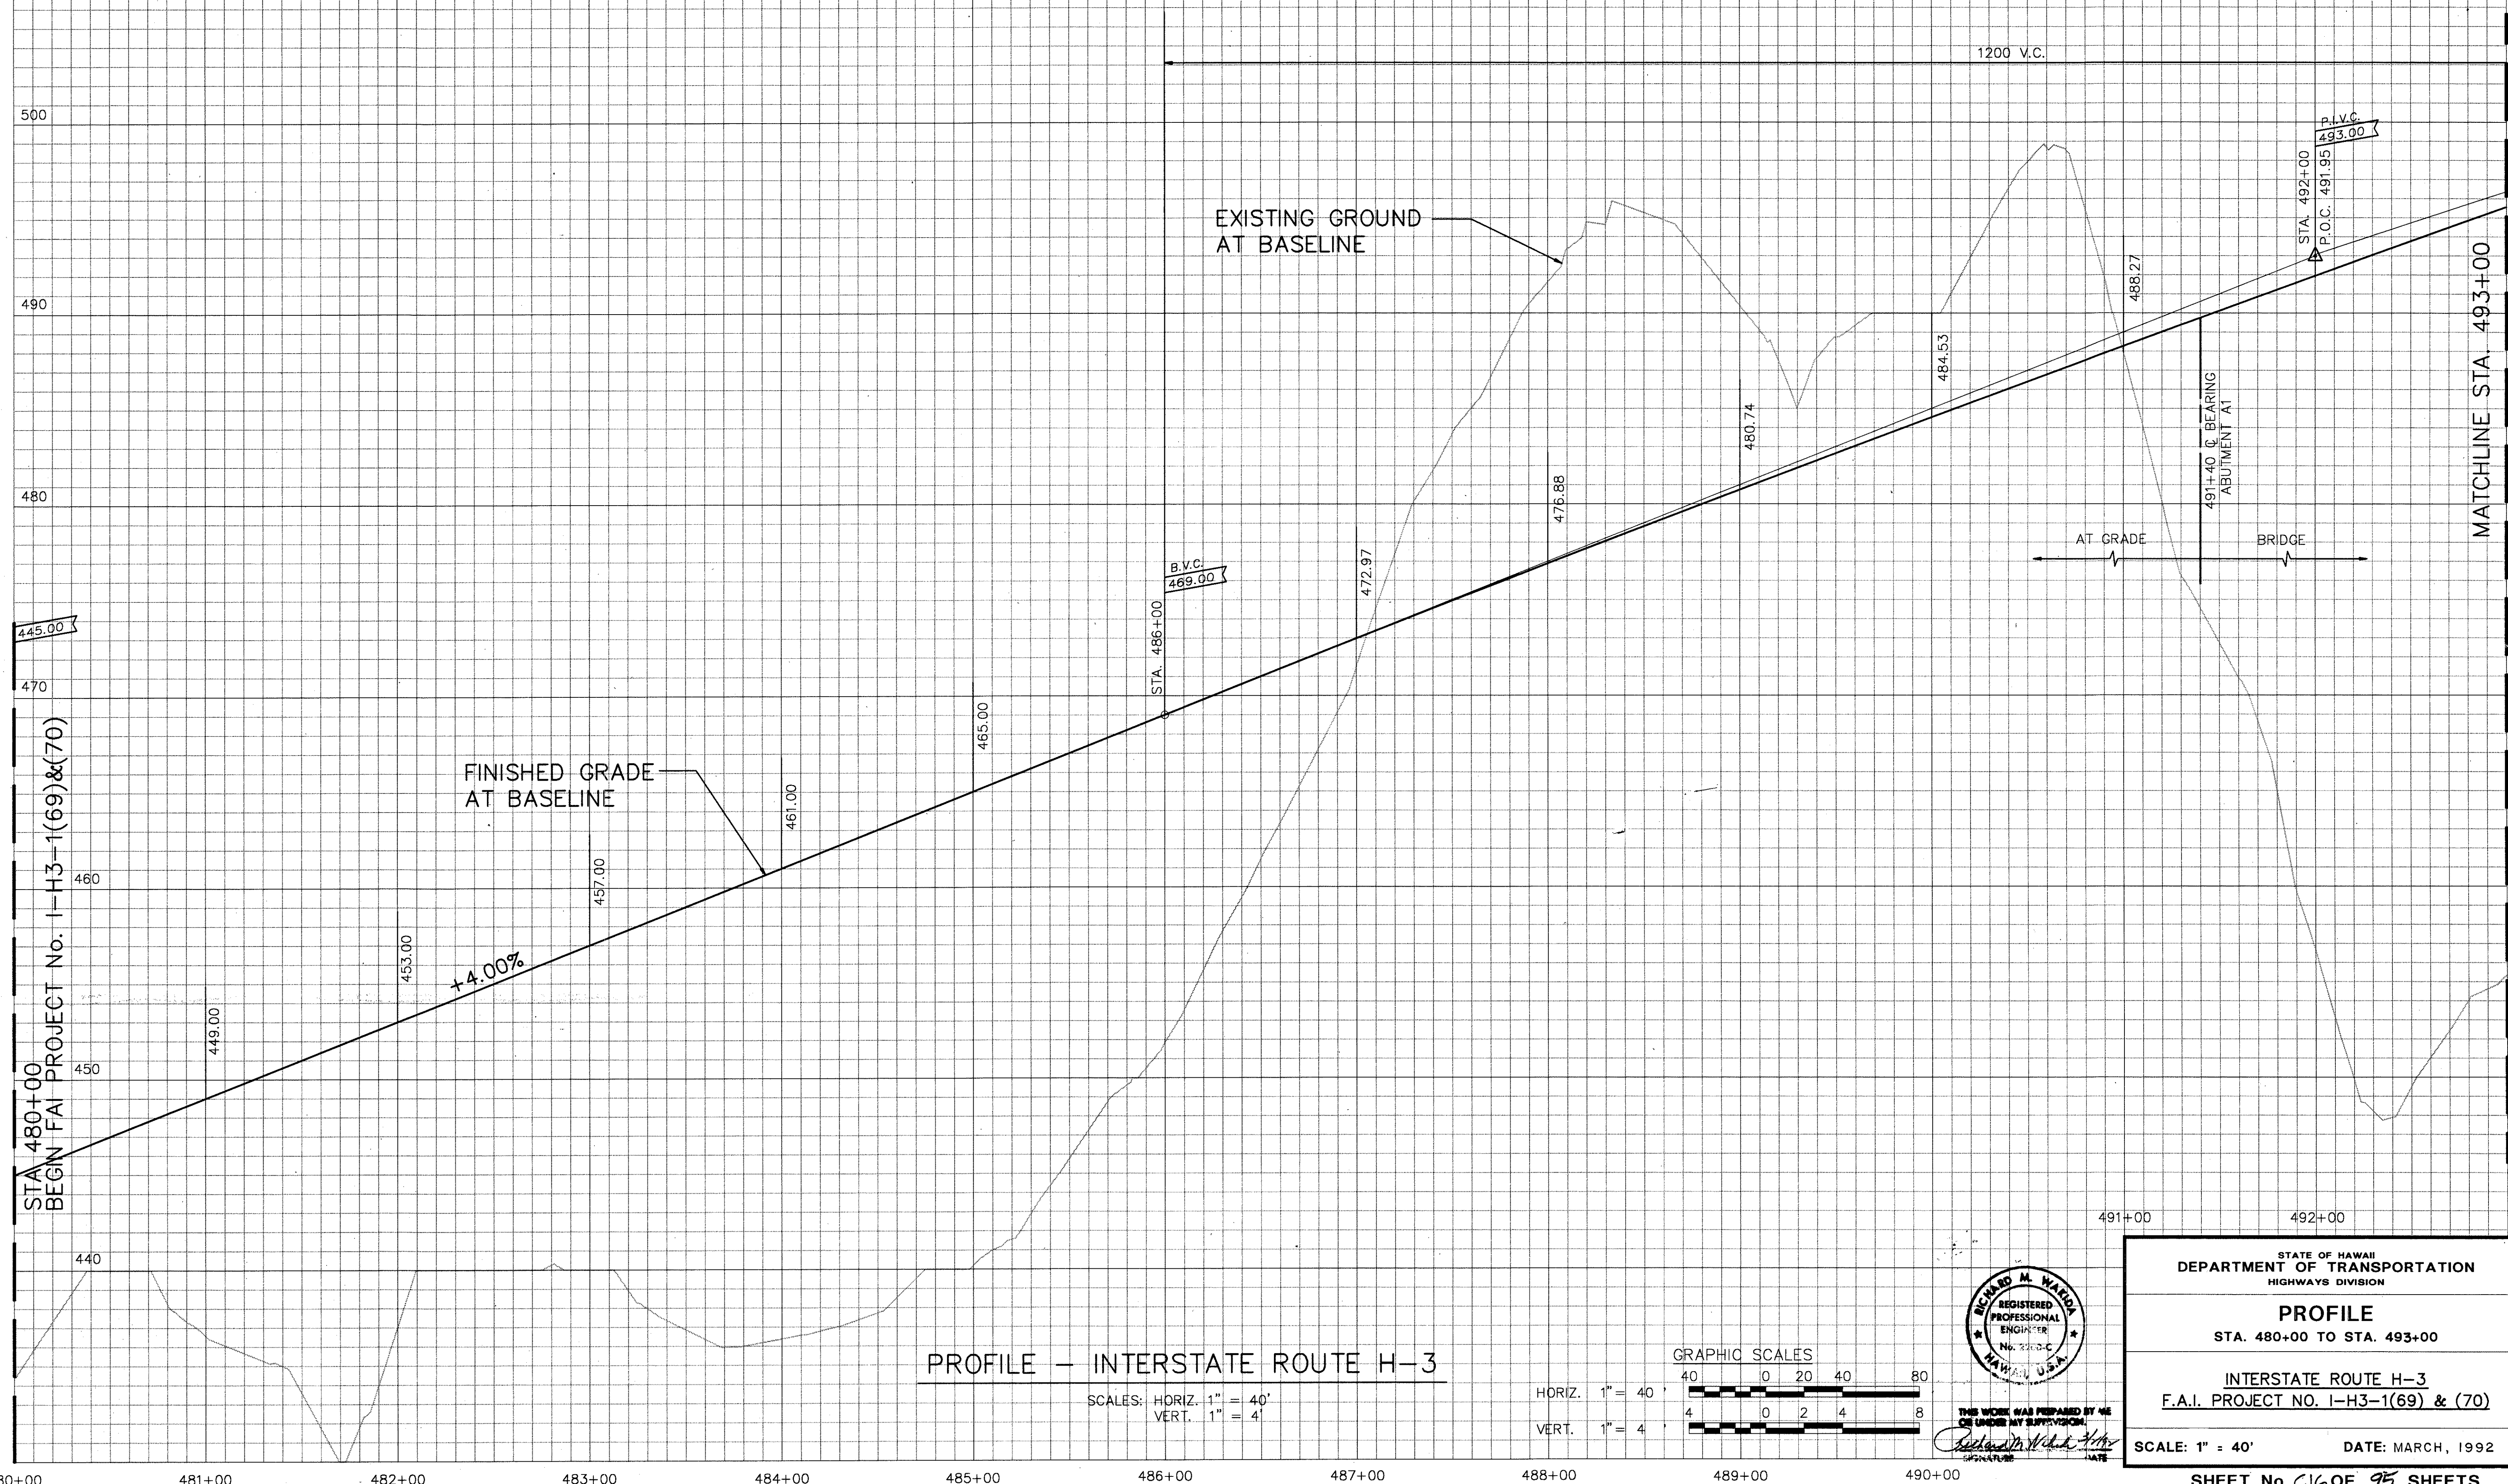



STA 480+00
BEGN F.A.I. PROJECT No. I-H3-1(69)&(70)

MATCHLINE STA. 493+00

PROFILE - INTERSTATE ROUTE H-3

SCALES: HORIZ. 1" = 40'
VERT. 1" = 4'

HORIZ. 1" = 40'
VERT. 1" = 4'

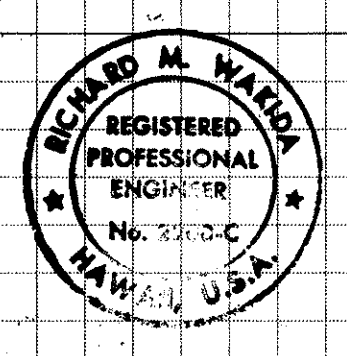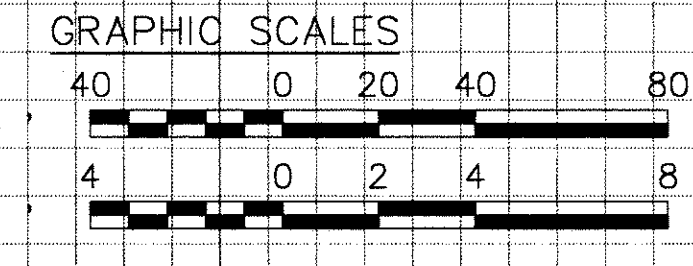

THIS WORK WAS PREPARED BY ME OR UNDER MY SUPERVISION
DATE

STATE OF HAWAII
DEPARTMENT OF TRANSPORTATION
HIGHWAYS DIVISION

PROFILE
STA. 480+00 TO STA. 493+00


INTERSTATE ROUTE H-3
F.A.I. PROJECT NO. I-H3-1(69) & (70)

SCALE: 1" = 40'
DATE: MARCH, 1992

SHEET No. 116 OF 95 SHEETS

DESIGNED BY	DATE
DRAWN BY	
NOTED BY	
CHECKED BY	
NO.	

FED. ROAD DIST. NO.	STATE	FED. AID PROJ. NO.	FISCAL YEAR	SHEET NO.	TOTAL SHEETS
HAWAII	HAW.	I-H3-1(69)	1992	20	325

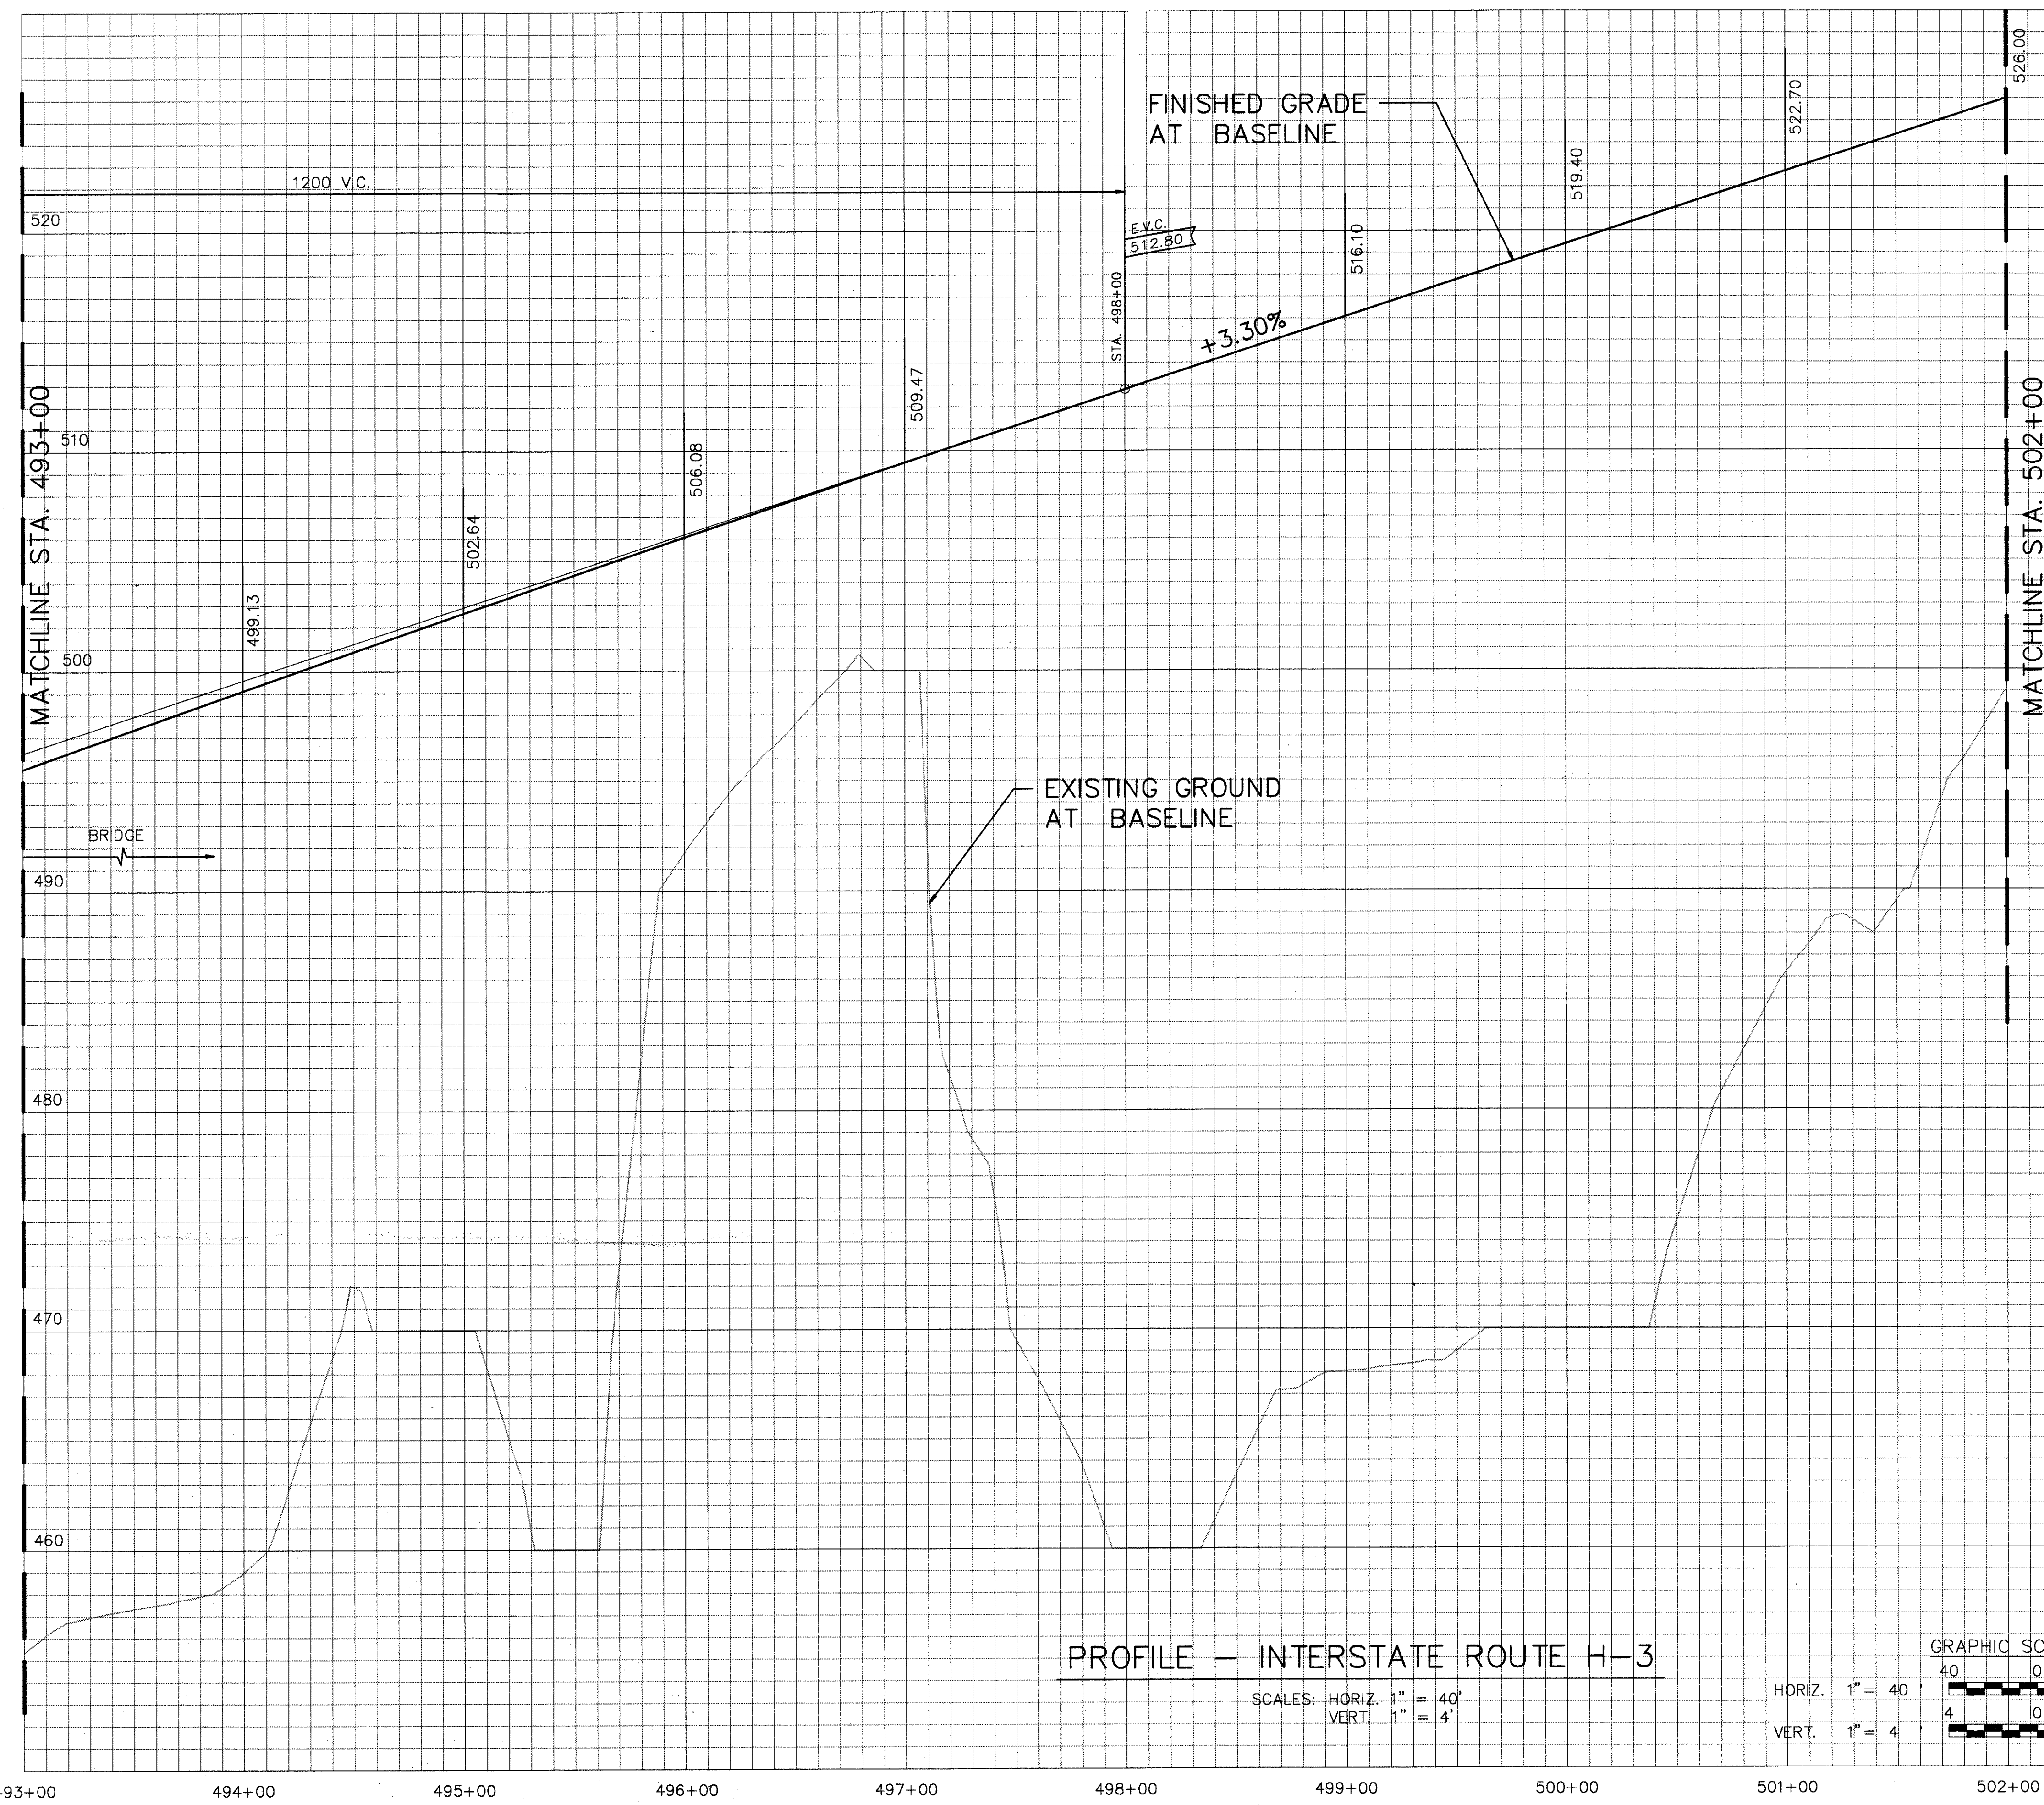

SURVEY PLOTTED BY	DATE
DRAWN BY	
TRACED BY	
CHECKED BY	
NOTE BOOK	
QUANTITIES BY	
CHECKED BY	
No.	

PROFILE — INTERSTATE ROUTE H-3

SCALES: HORIZ. 1" = 40'
VERT. 1" = 4'

GRAPHIC SCALES

HORIZ. 1" = 40'

VERT. 1" = 4'

THIS WORK WAS PREPARED BY ME OR UNDER MY SUPERVISION

Richard M. Wanda SIGNATURE DATE



STATE OF HAWAII
DEPARTMENT OF TRANSPORTATION
HIGHWAYS DIVISION


PROFILE
STA. 493+00 TO STA. 502+00

INTERSTATE ROUTE H-3
F.A.I. PROJECT NO. I-H3-1(69) & (70)

SCALE: 1" = 40' DATE: MARCH, 1992



SHEET No. 20 OF 95 SHEETS

FED. ROAD DIST. NO.	STATE	FED. AID PROJ. NO.	FISCAL YEAR	SHEET NO.	TOTAL SHEETS
HAWAII	HAW.	I-H3-1(69)	1992	21	325

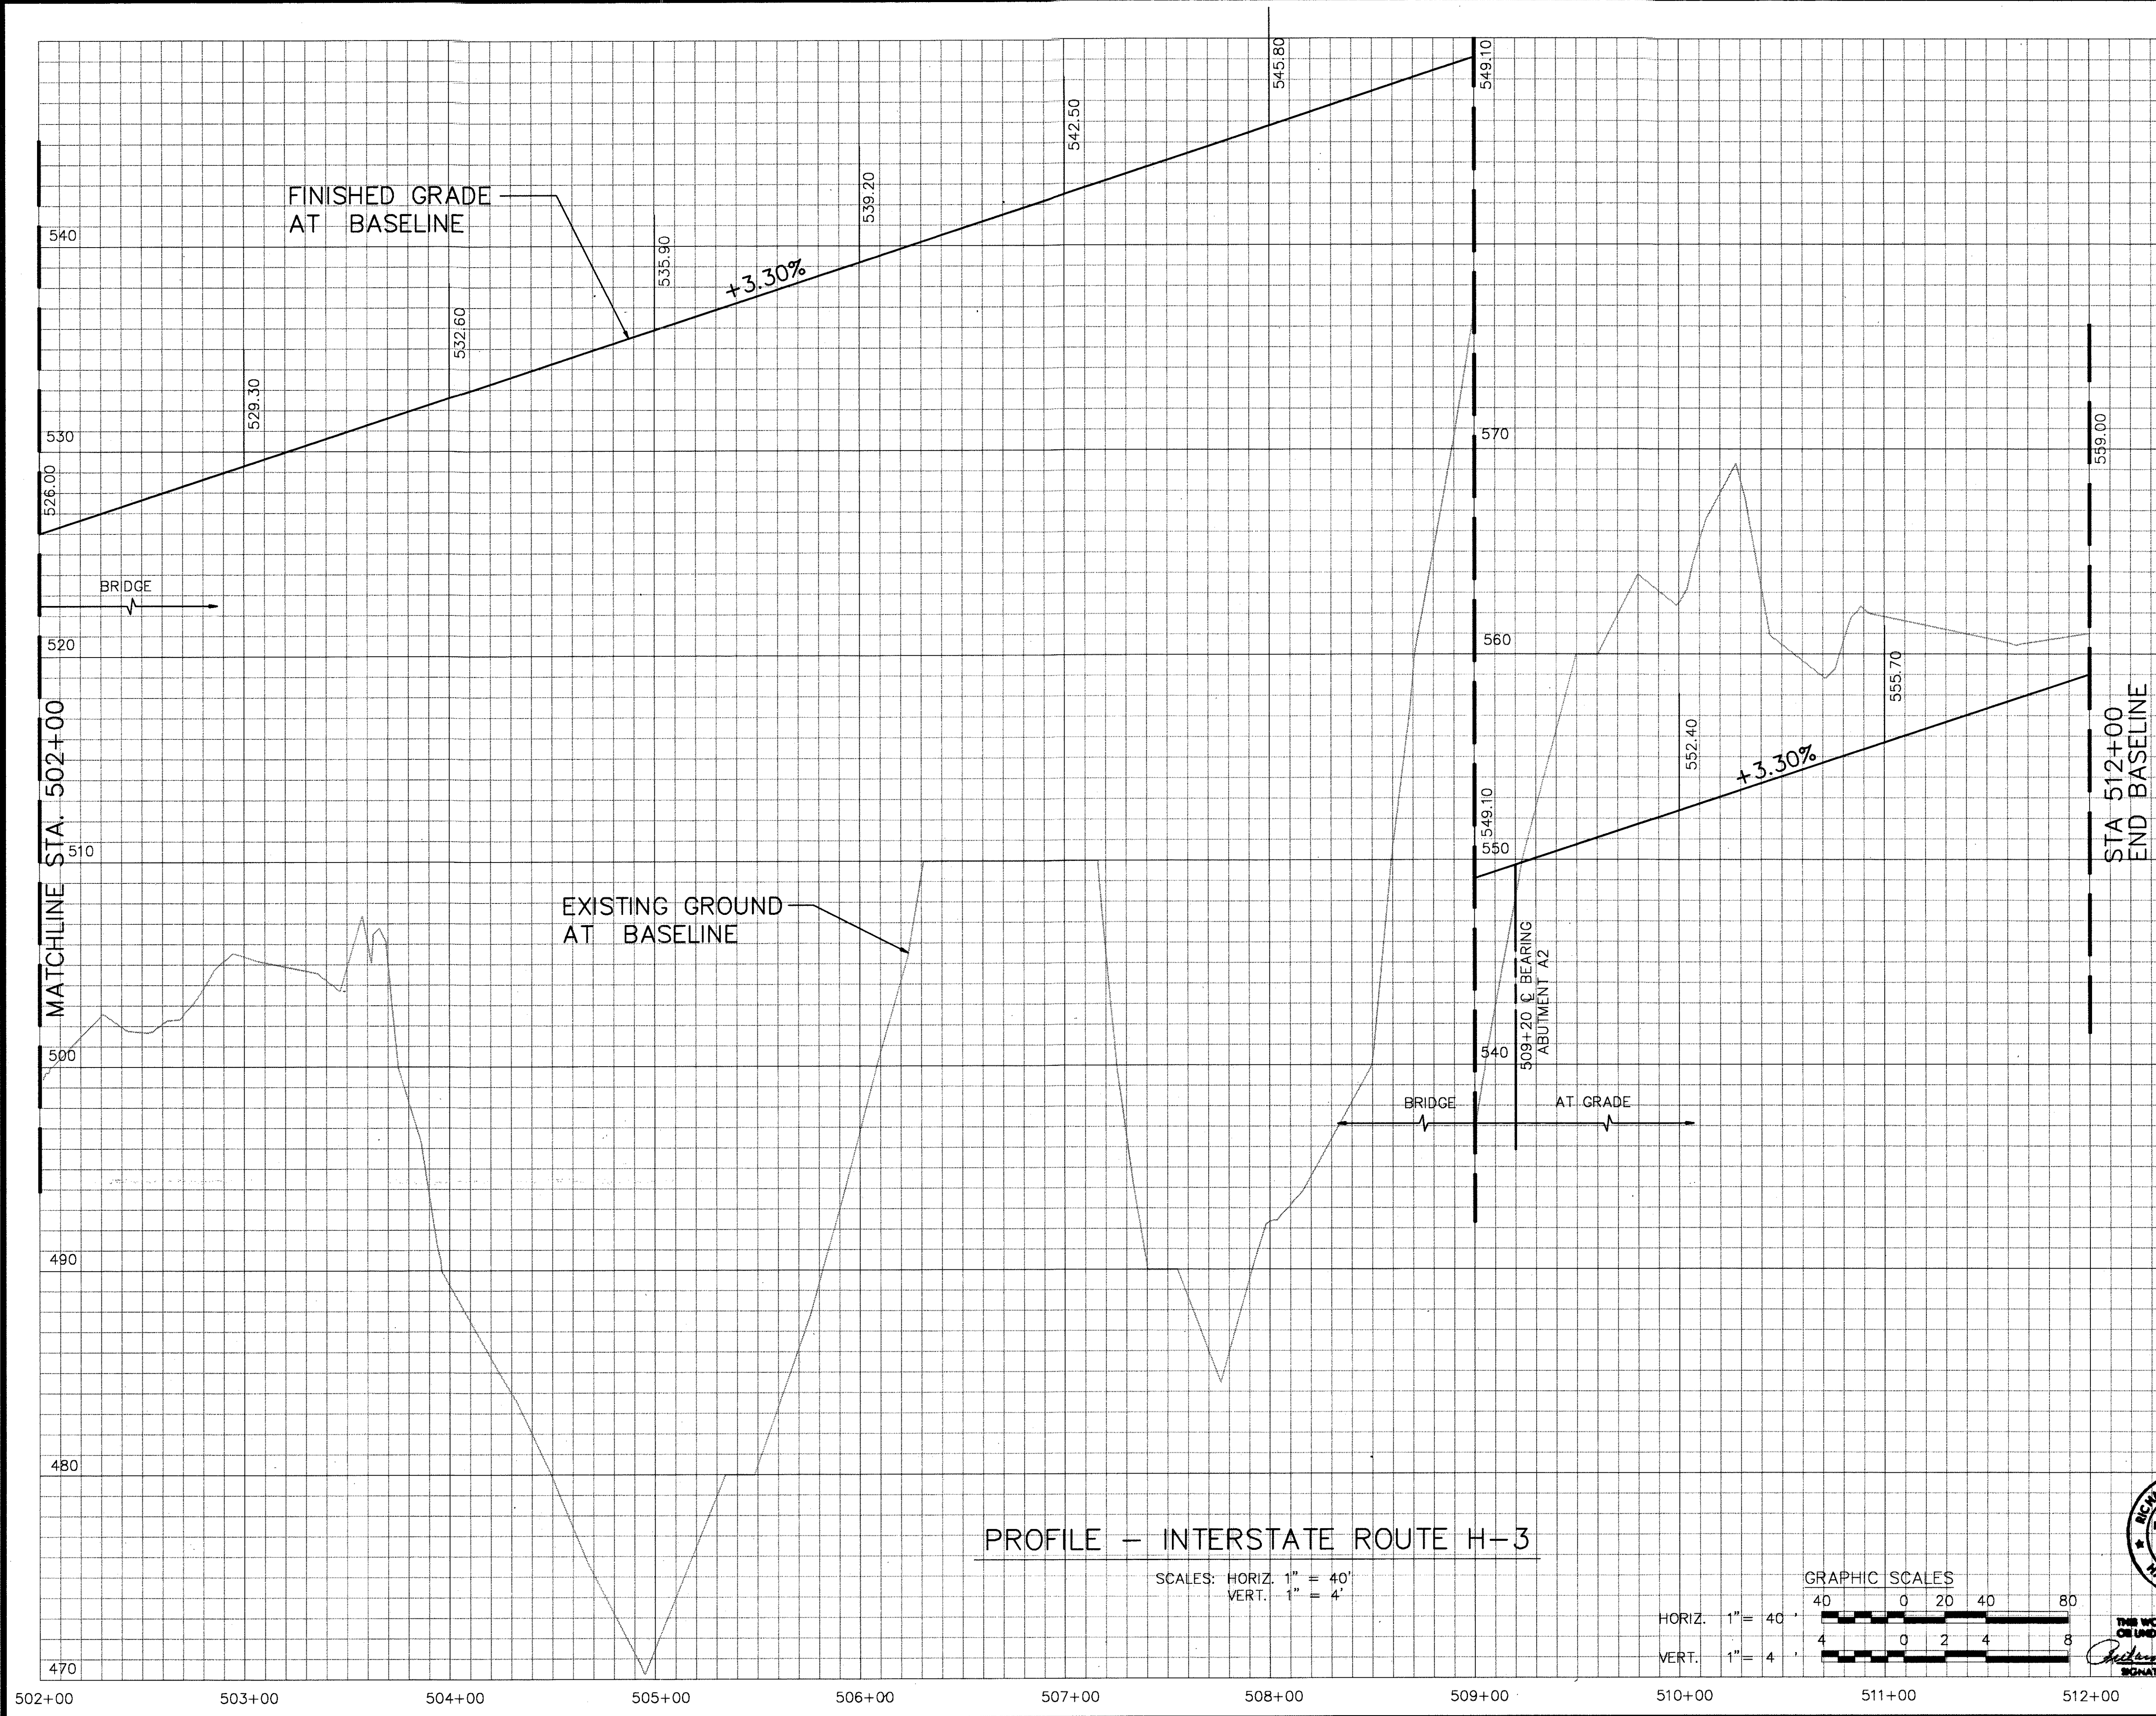

PROFILE - INTERSTATE ROUTE H-3

SCALES: HORIZ. 1" = 40'
VERT. 1" = 4'

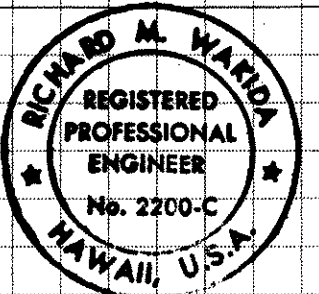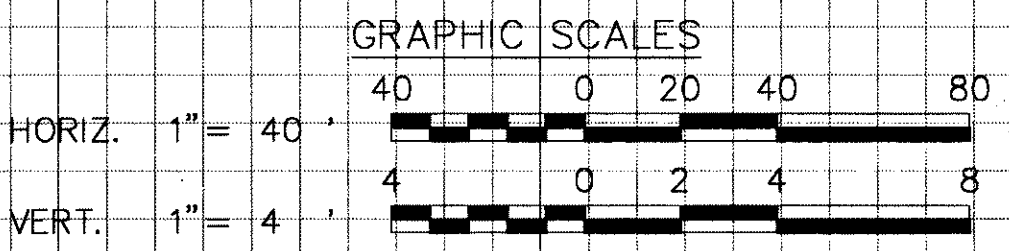

THIS WORK WAS PREPARED BY ME
OR UNDER MY SUPERVISION
DATE: MARCH, 1992

STATE OF HAWAII
DEPARTMENT OF TRANSPORTATION
HIGHWAYS DIVISION

PROFILE
STA. 502+00 TO STA. 512+00


INTERSTATE ROUTE H-3
F.A.I. PROJECT NO. I-H3-1(69) & (70)

SCALE: 1" = 40' DATE: MARCH, 1992


SHEET No. C18 OF 95 SHEETS

SURVEY PLOTTED BY	DATE
DRAWN BY	
CHECKED BY	
REVIEWED BY	
APPROVED BY	
NO.	

FED. ROAD DIST. NO.	STATE	FED. AID PROJ. NO.	FISCAL YEAR	SHEET NO.	TOTAL SHEETS
HAWAII	HAW.	I-H3-1(69)	1992	22	925

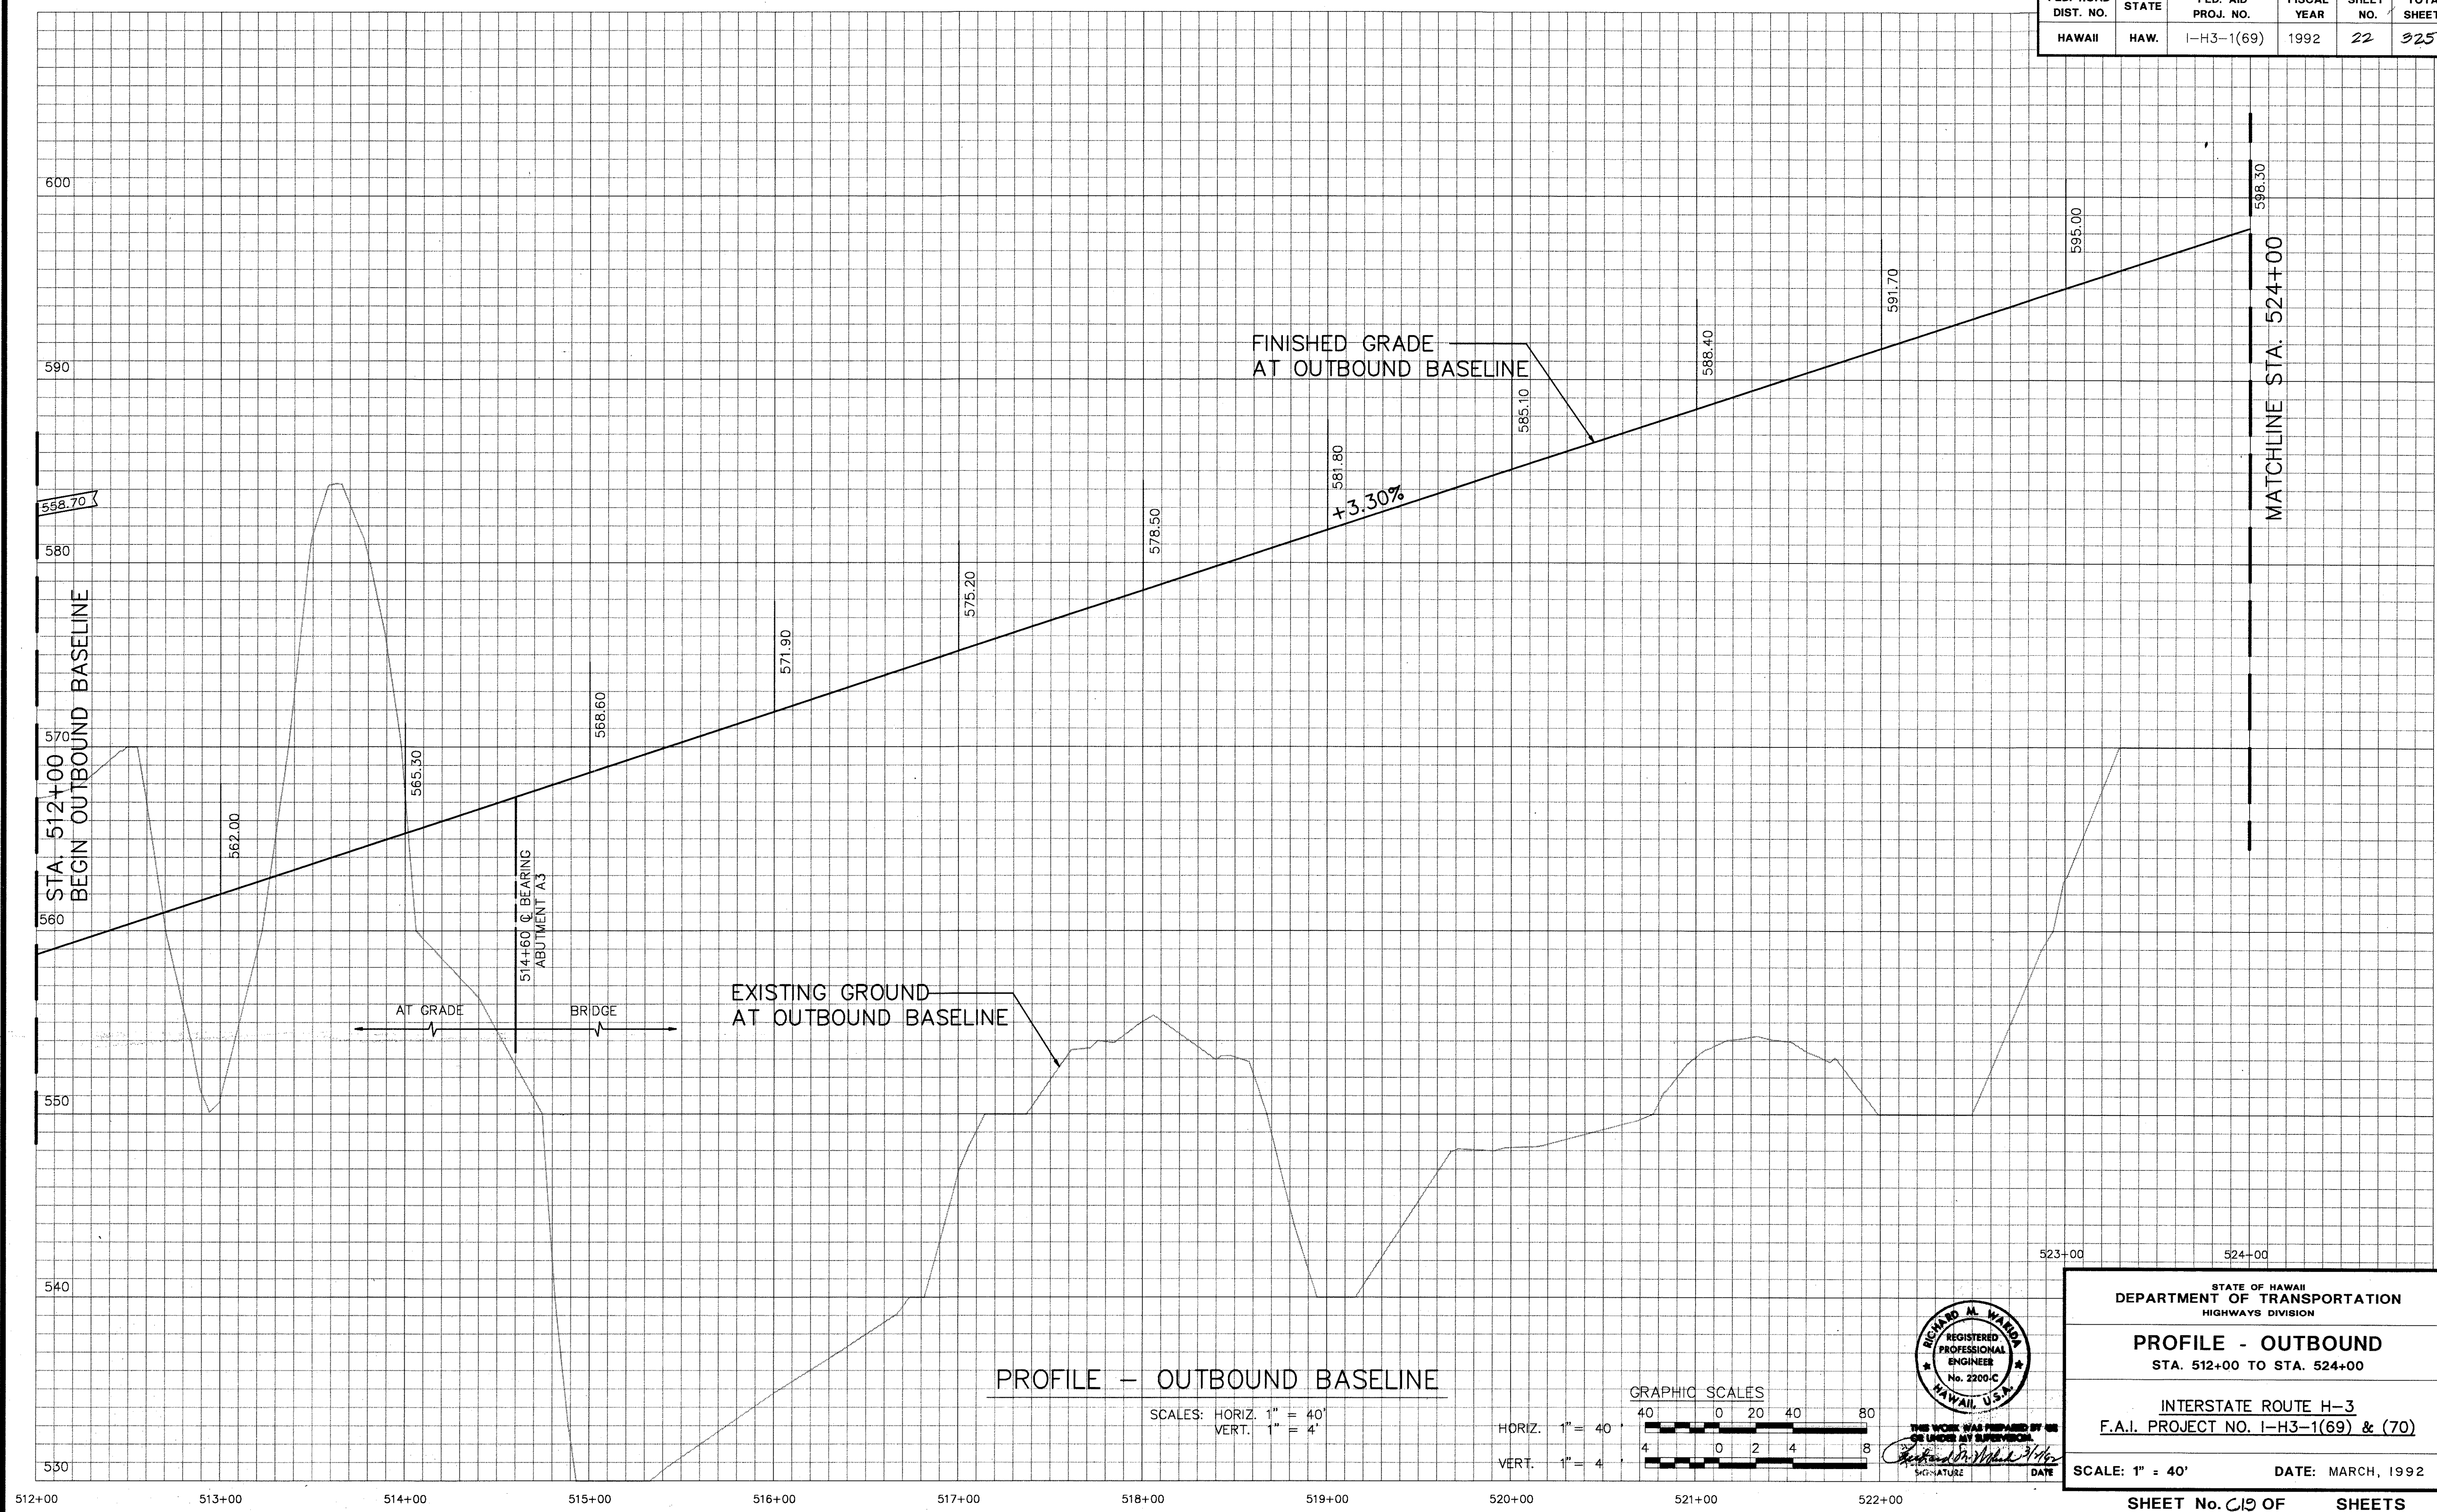


SURVEY PLOTTED BY	DATE
DRAWN BY	
TRACED BY	
CHECKED BY	
NOTE BOOK	
QUANTITIES BY	
CHECKED BY	
No.	

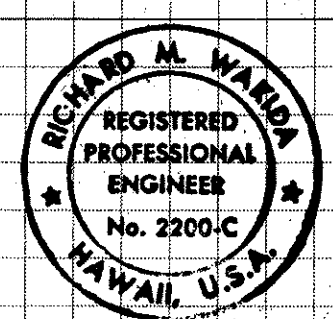



THIS WORK WAS PREPARED BY ME
OR UNDER MY SUPERVISION
SIGNATURE DATE

FED. ROAD DIST. NO.	STATE	FED. AID PROJ. NO.	FISCAL YEAR	SHEET NO.	TOTAL SHEETS
HAWAII	HAW.	I-H3-1(69)	1992	23	325

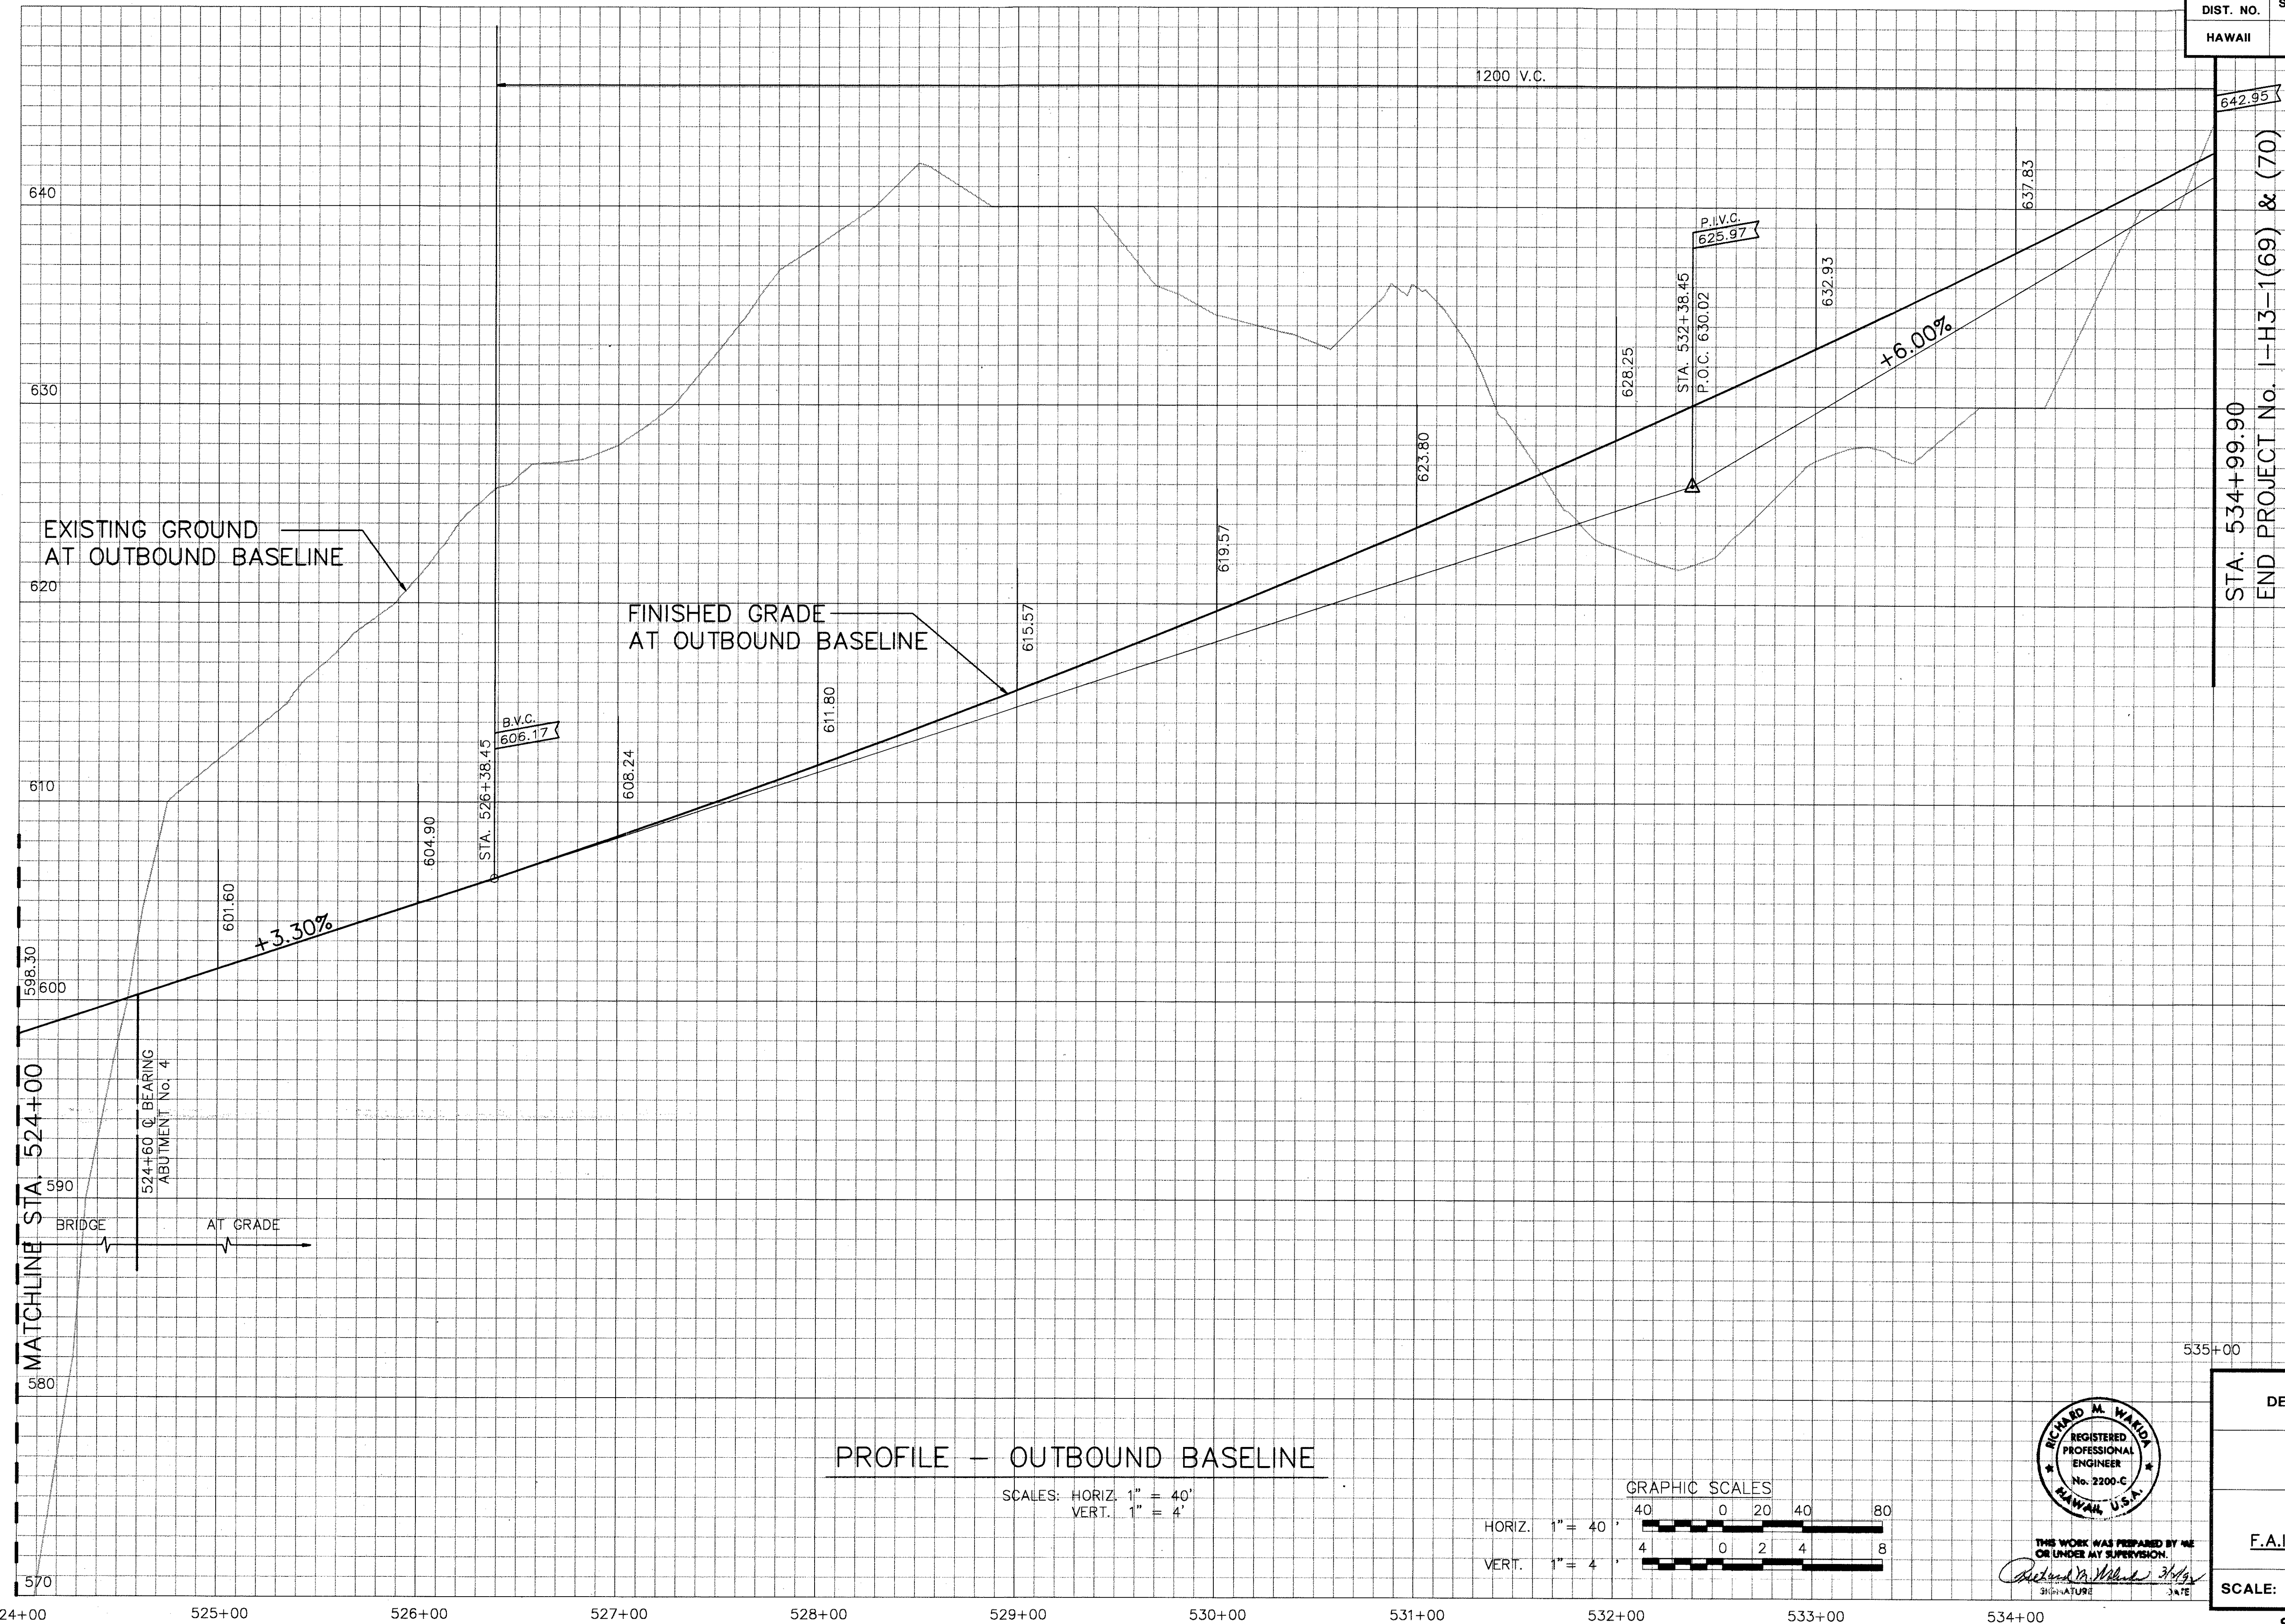

PROFILE - OUTBOUND BASELINE

SCALES: HORIZ. 1" = 40'
VERT. 1" = 4'

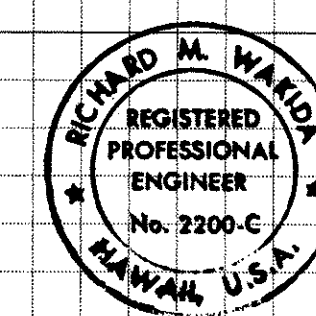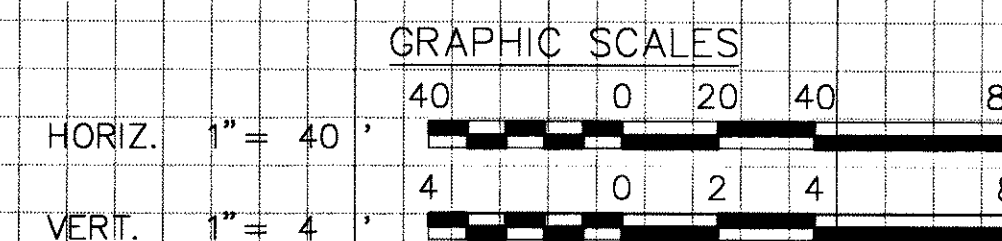


THIS WORK WAS PREPARED BY ME
OR UNDER MY SUPERVISION.

Richard M. Wilkins

SIGNATURE DATE

STATE OF HAWAII DEPARTMENT OF TRANSPORTATION HIGHWAYS DIVISION	
PROFILE - OUTBOUND STA. 524+00 TO STA. 534+99.90	
INTERSTATE ROUTE H-3 F.A.I. PROJECT NO. I-H3-1(69) & (70)	
SCALE: 1" = 40'	DATE: MARCH, 1992
SHEET No. 22 OF 95 SHEETS	


FED. ROAD DIST. NO.	STATE	FED. AID PROJ. NO.	FISCAL YEAR	SHEET NO.	TOTAL SHEETS
HAWAII	HAW.	I-H3-1(69)	1992	24	325

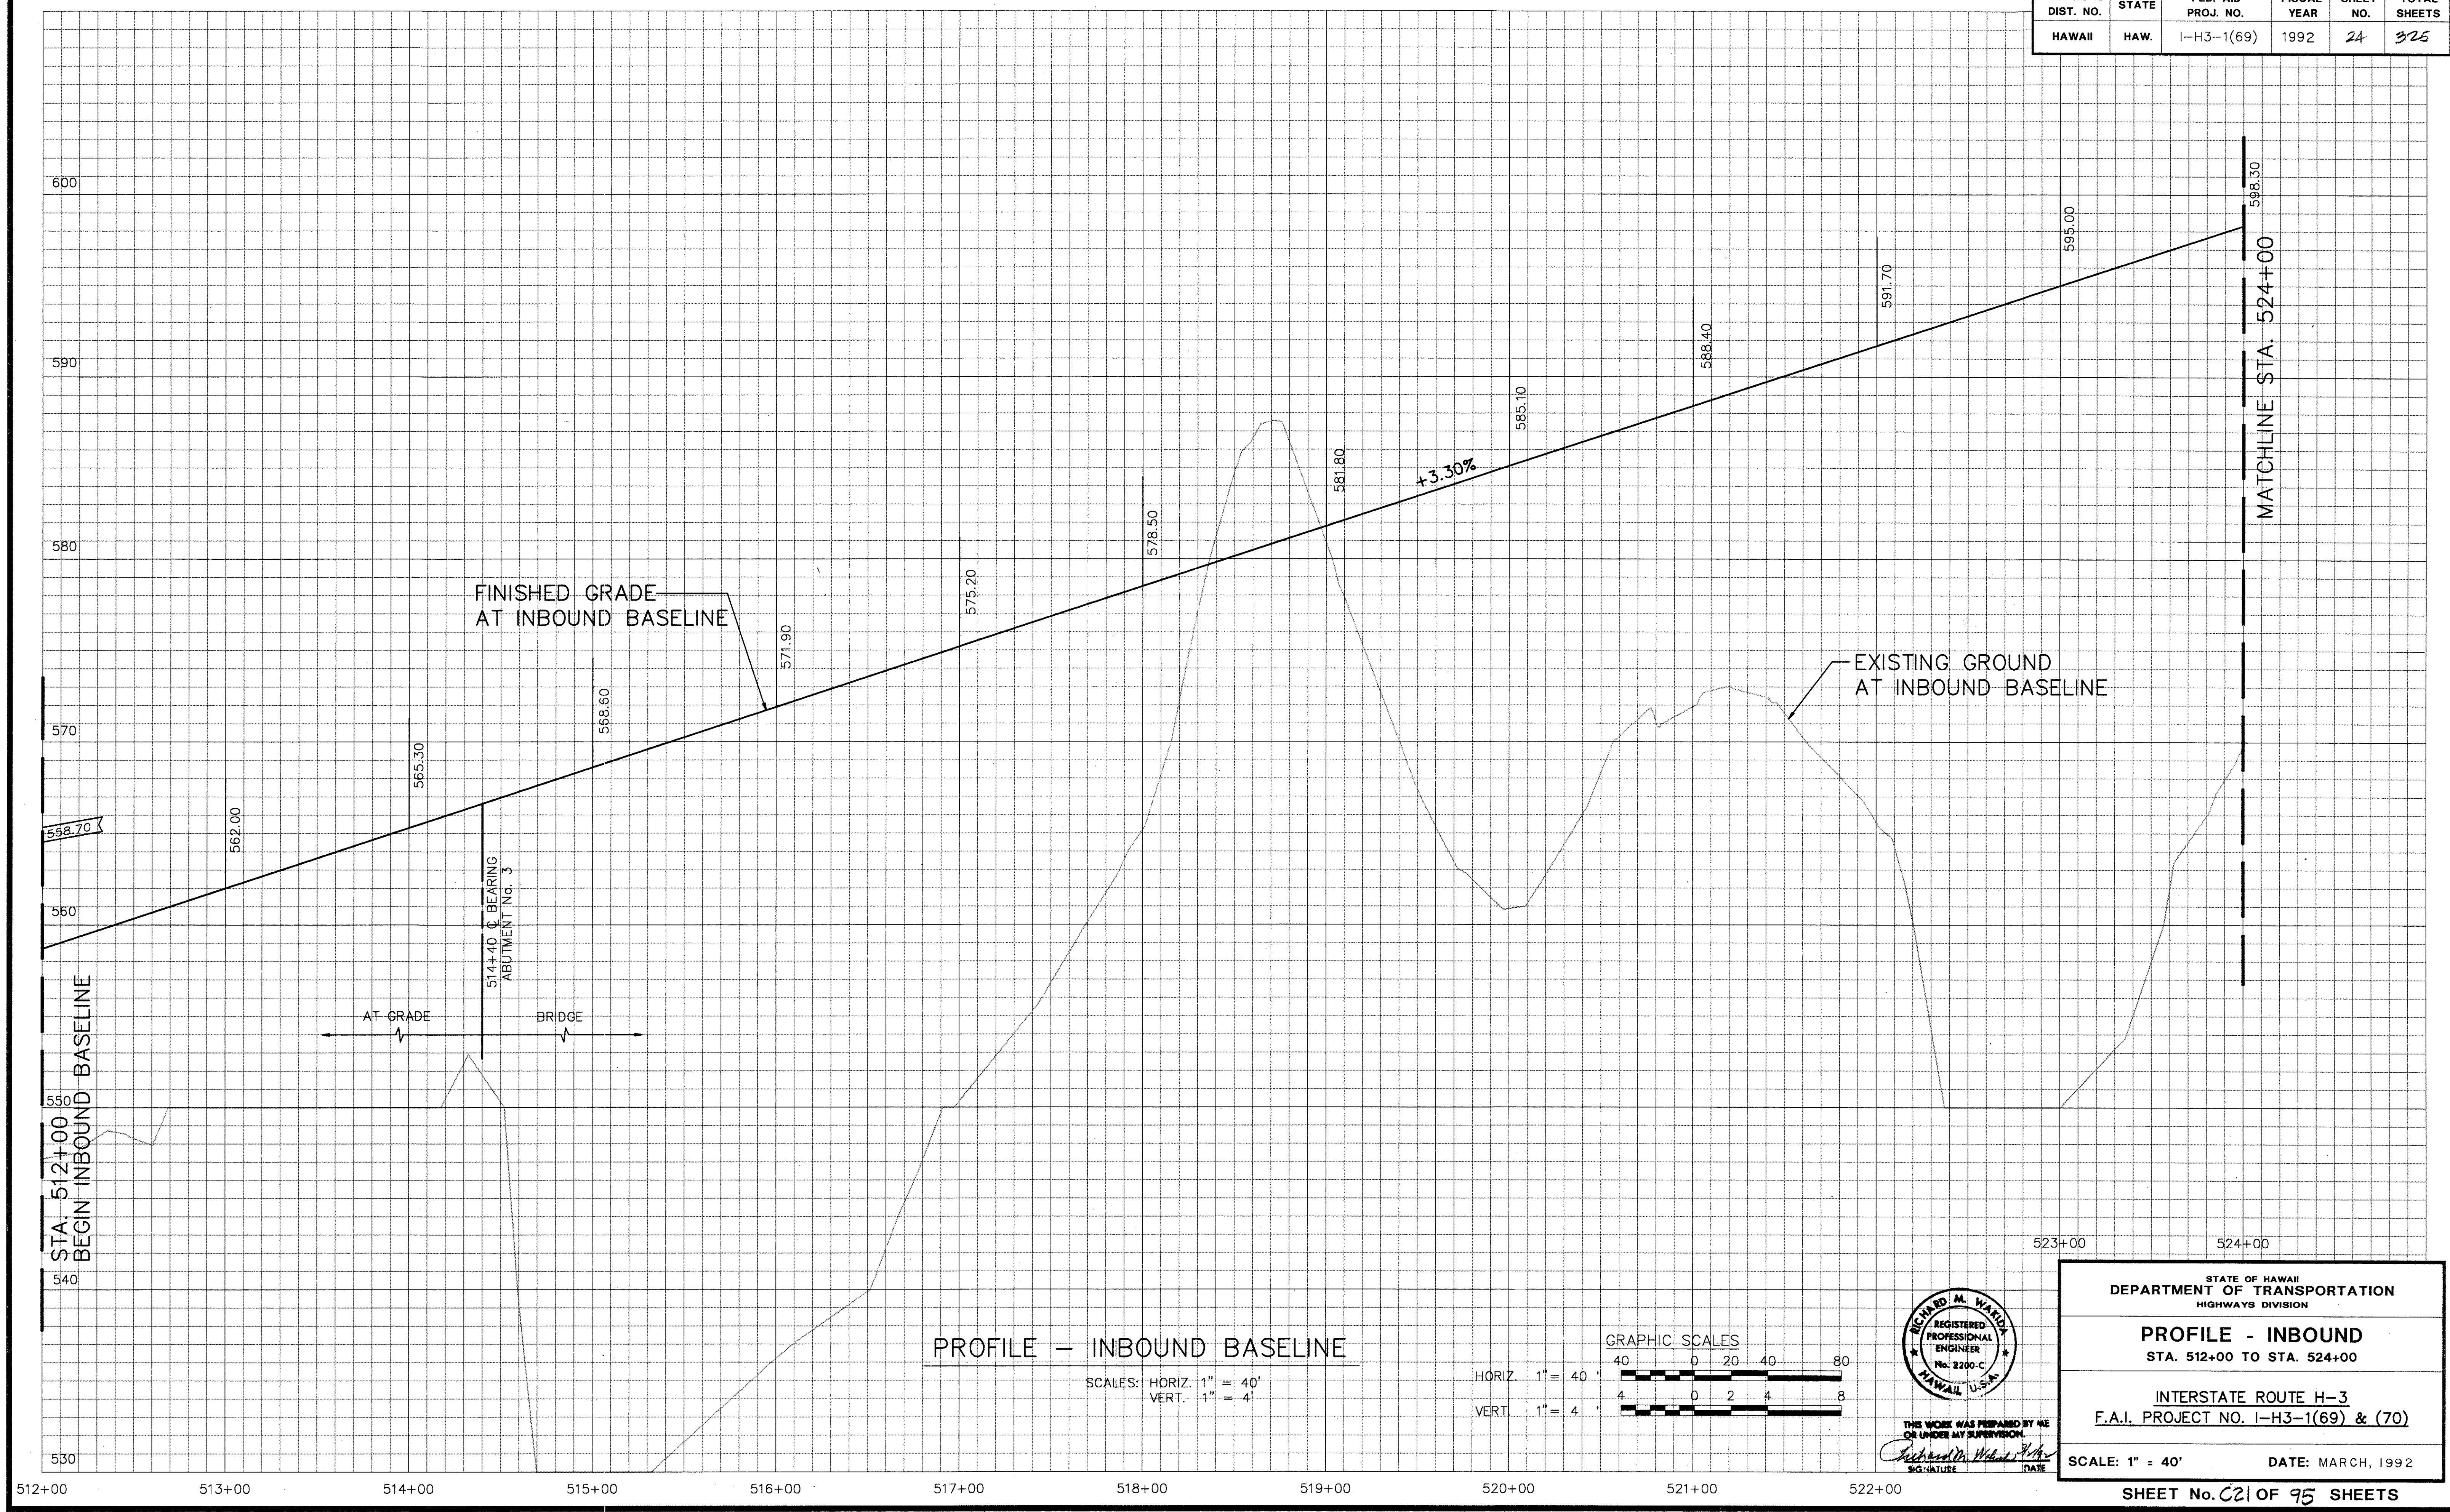

PROFILE - INBOUND BASELINE

SCALES: HORIZ. 1" = 40'
VERT. 1" = 4'

HORIZ. 1" = 40'
VERT. 1" = 4'

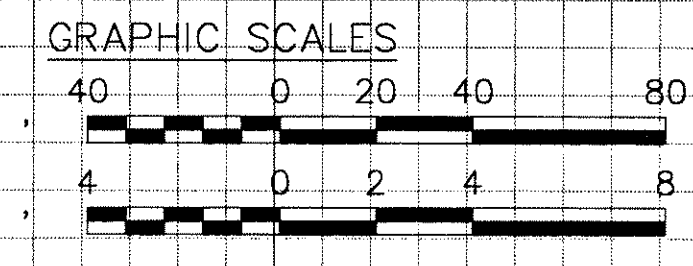

THIS WORK WAS PREPARED BY ME
OR UNDER MY SUPERVISION.
SIGNATURE: *Richard M. Waike* DATE: *March 1992*

STATE OF HAWAII
DEPARTMENT OF TRANSPORTATION
HIGHWAYS DIVISION


PROFILE - INBOUND
STA. 512+00 TO STA. 524+00

INTERSTATE ROUTE H-3
F.A.I. PROJECT NO. I-H3-1(69) & (70)

SCALE: 1" = 40'
DATE: MARCH, 1992


SURVEY PLOTTED BY	DATE
DESIGNED BY	
TRACED BY	
NOTE BOOK	
QUANTITIES BY	
CHECKED BY	
No.	

FED. ROAD DIST. NO.	STATE	FED. AID PROJ. NO.	FISCAL YEAR	SHEET NO.	TOTAL SHEETS
HAWAII	HAW.	I-H3-1(69)	1992	25	925

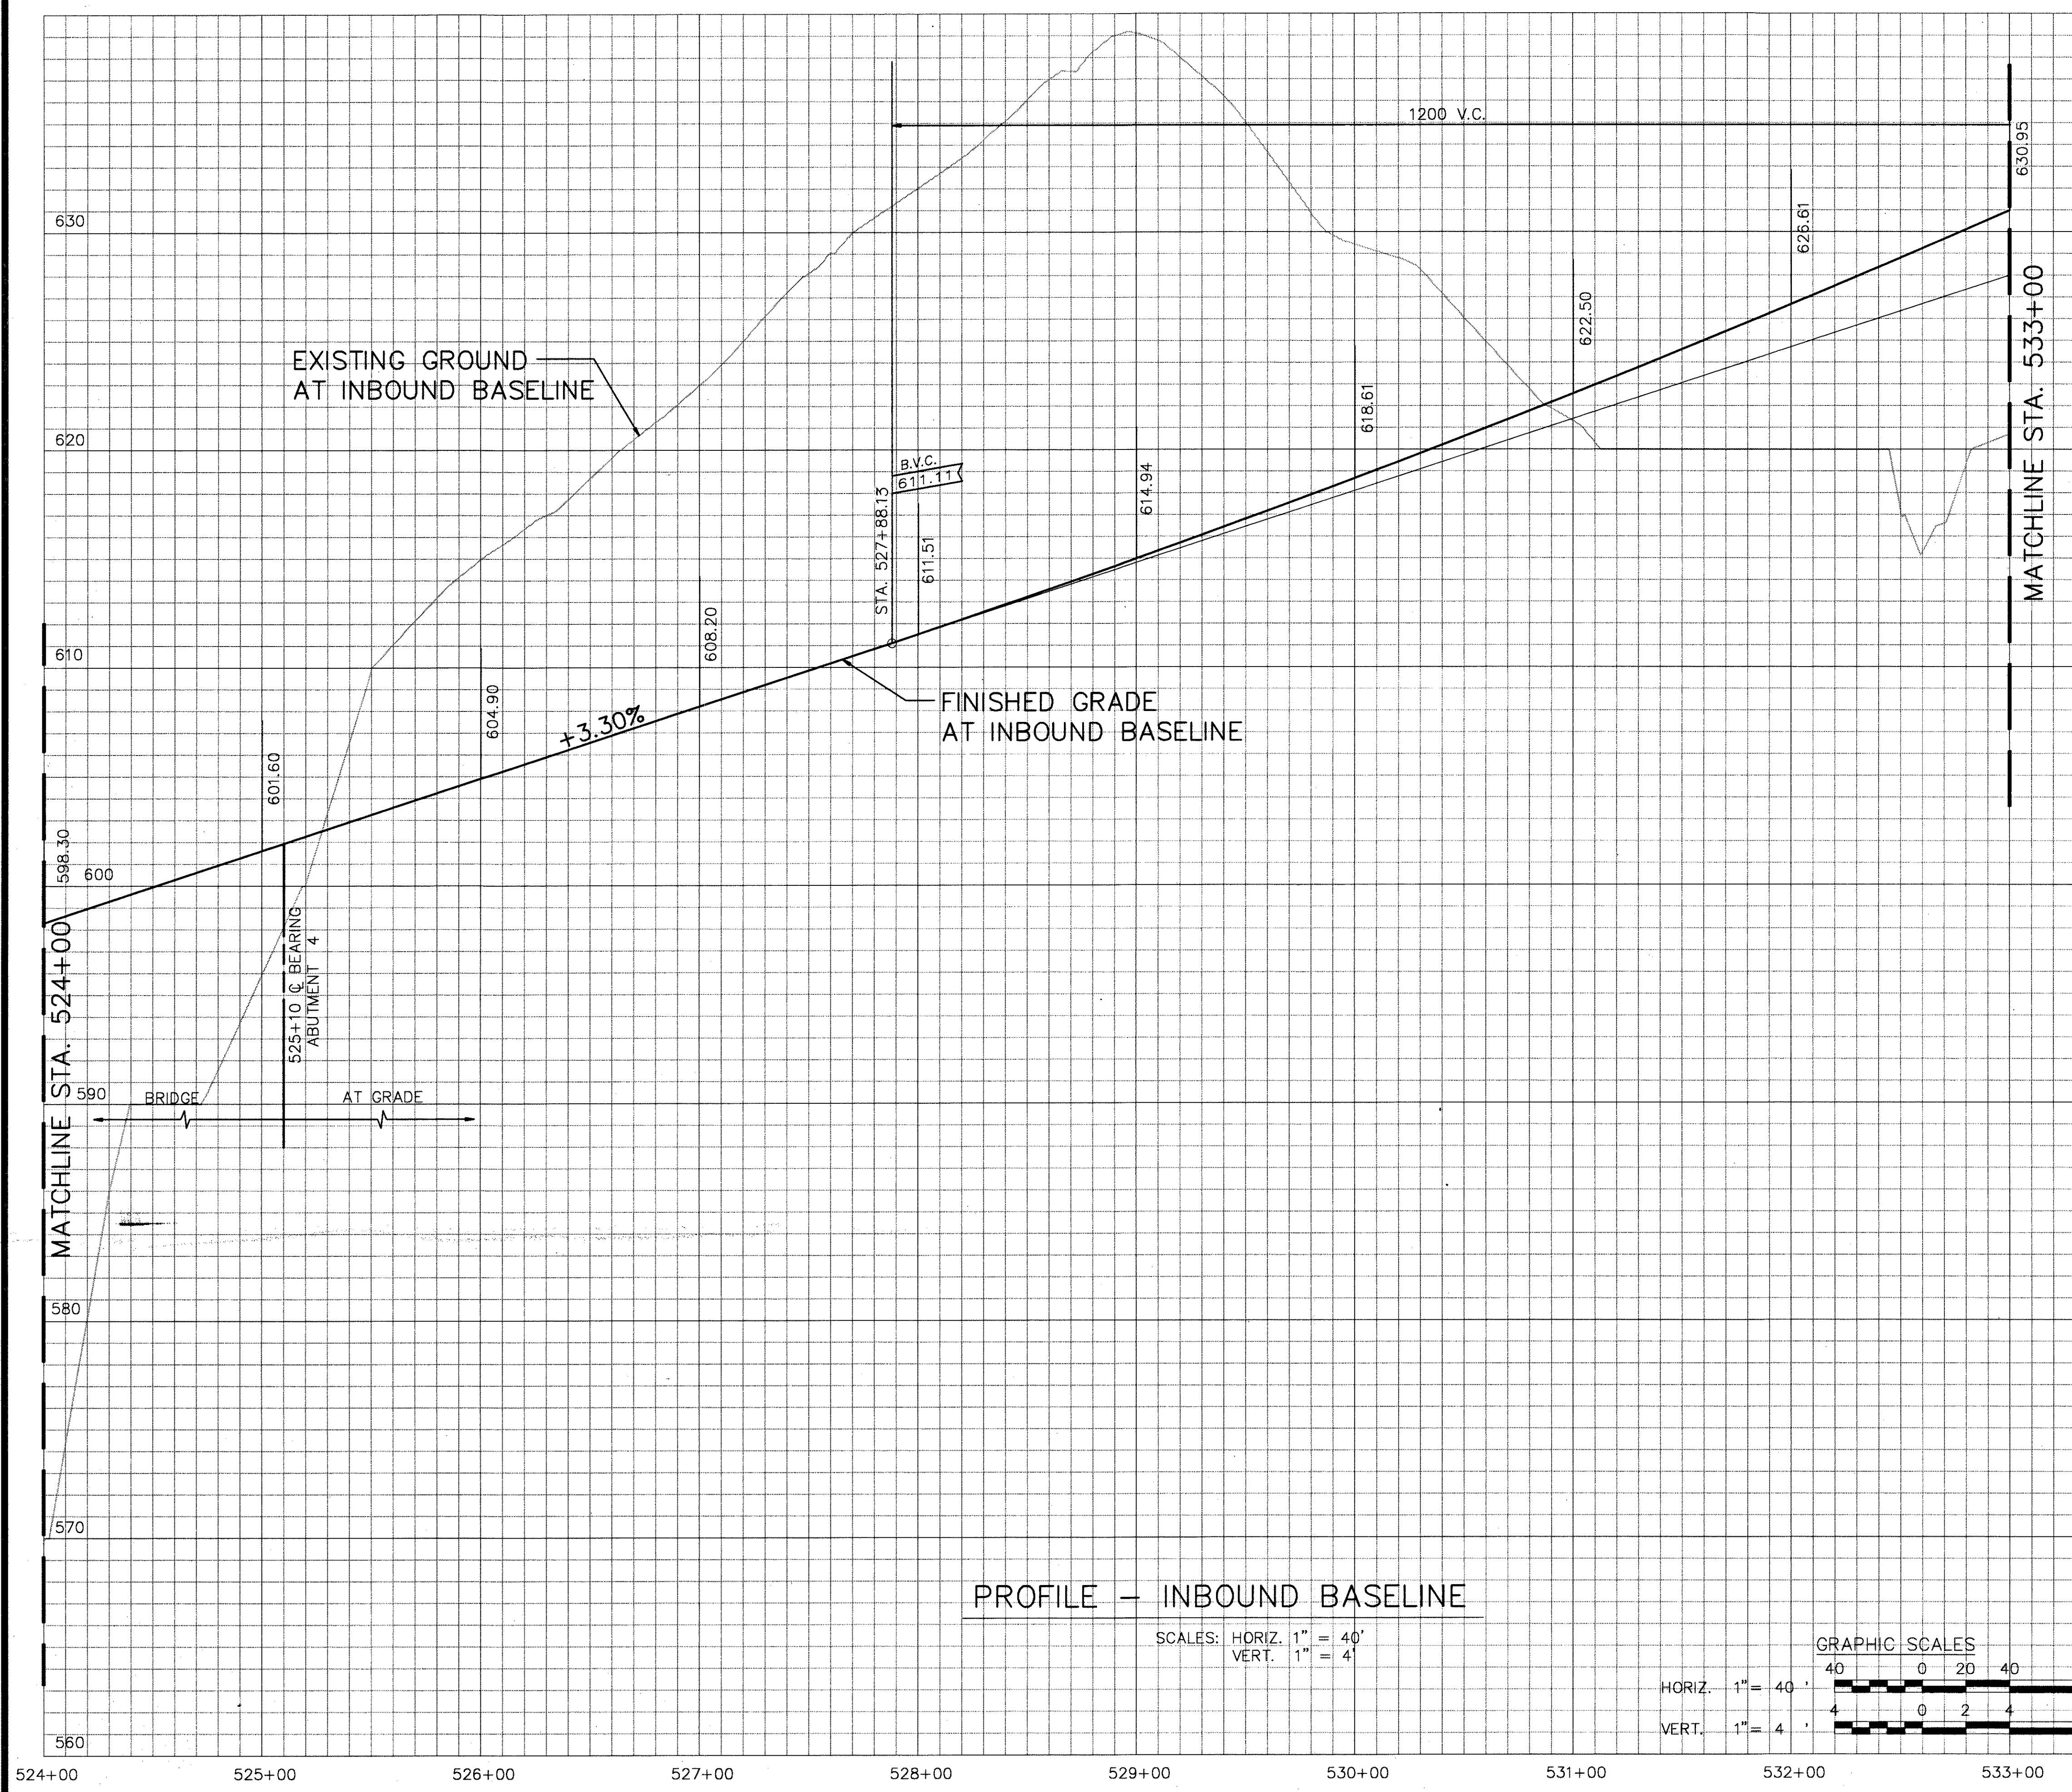

PROFILE - INBOUND BASELINE

SCALES: HORIZ. 1" = 40'
VERT. 1" = 4'

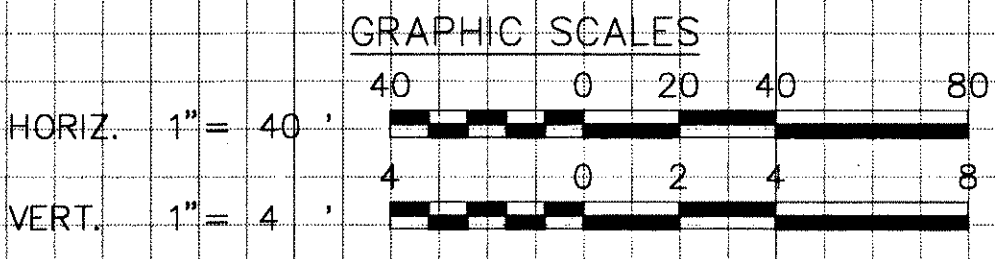

THIS WORK WAS PREPARED BY ME
OR UNDER MY SUPERVISION.
SIGNATURE: *Richard M. Wanda* DATE: *3/1/92*

STATE OF HAWAII
DEPARTMENT OF TRANSPORTATION
HIGHWAYS DIVISION

PROFILE - INBOUND
STA. 524+00 TO STA. 533+00

INTERSTATE ROUTE H-3
F.A.I. PROJECT NO. I-H3-1(69) & (70)


SCALE: 1" = 40'

DATE: MARCH, 1992

SHEET No. C22 OF 95 SHEETS



ORIGINAL PLAN	SURVEY PLOTTED BY	DATE
NOTE BOOK	DRAWN BY	
No.	DESIGNED BY	
	CHECKED BY	

FED. ROAD DIST. NO.	STATE	FED. AID PROJ. NO.	FISCAL YEAR	SHEET NO.	TOTAL SHEETS
HAWAII	HAW.	I-H3-1(69)	1992	26	325

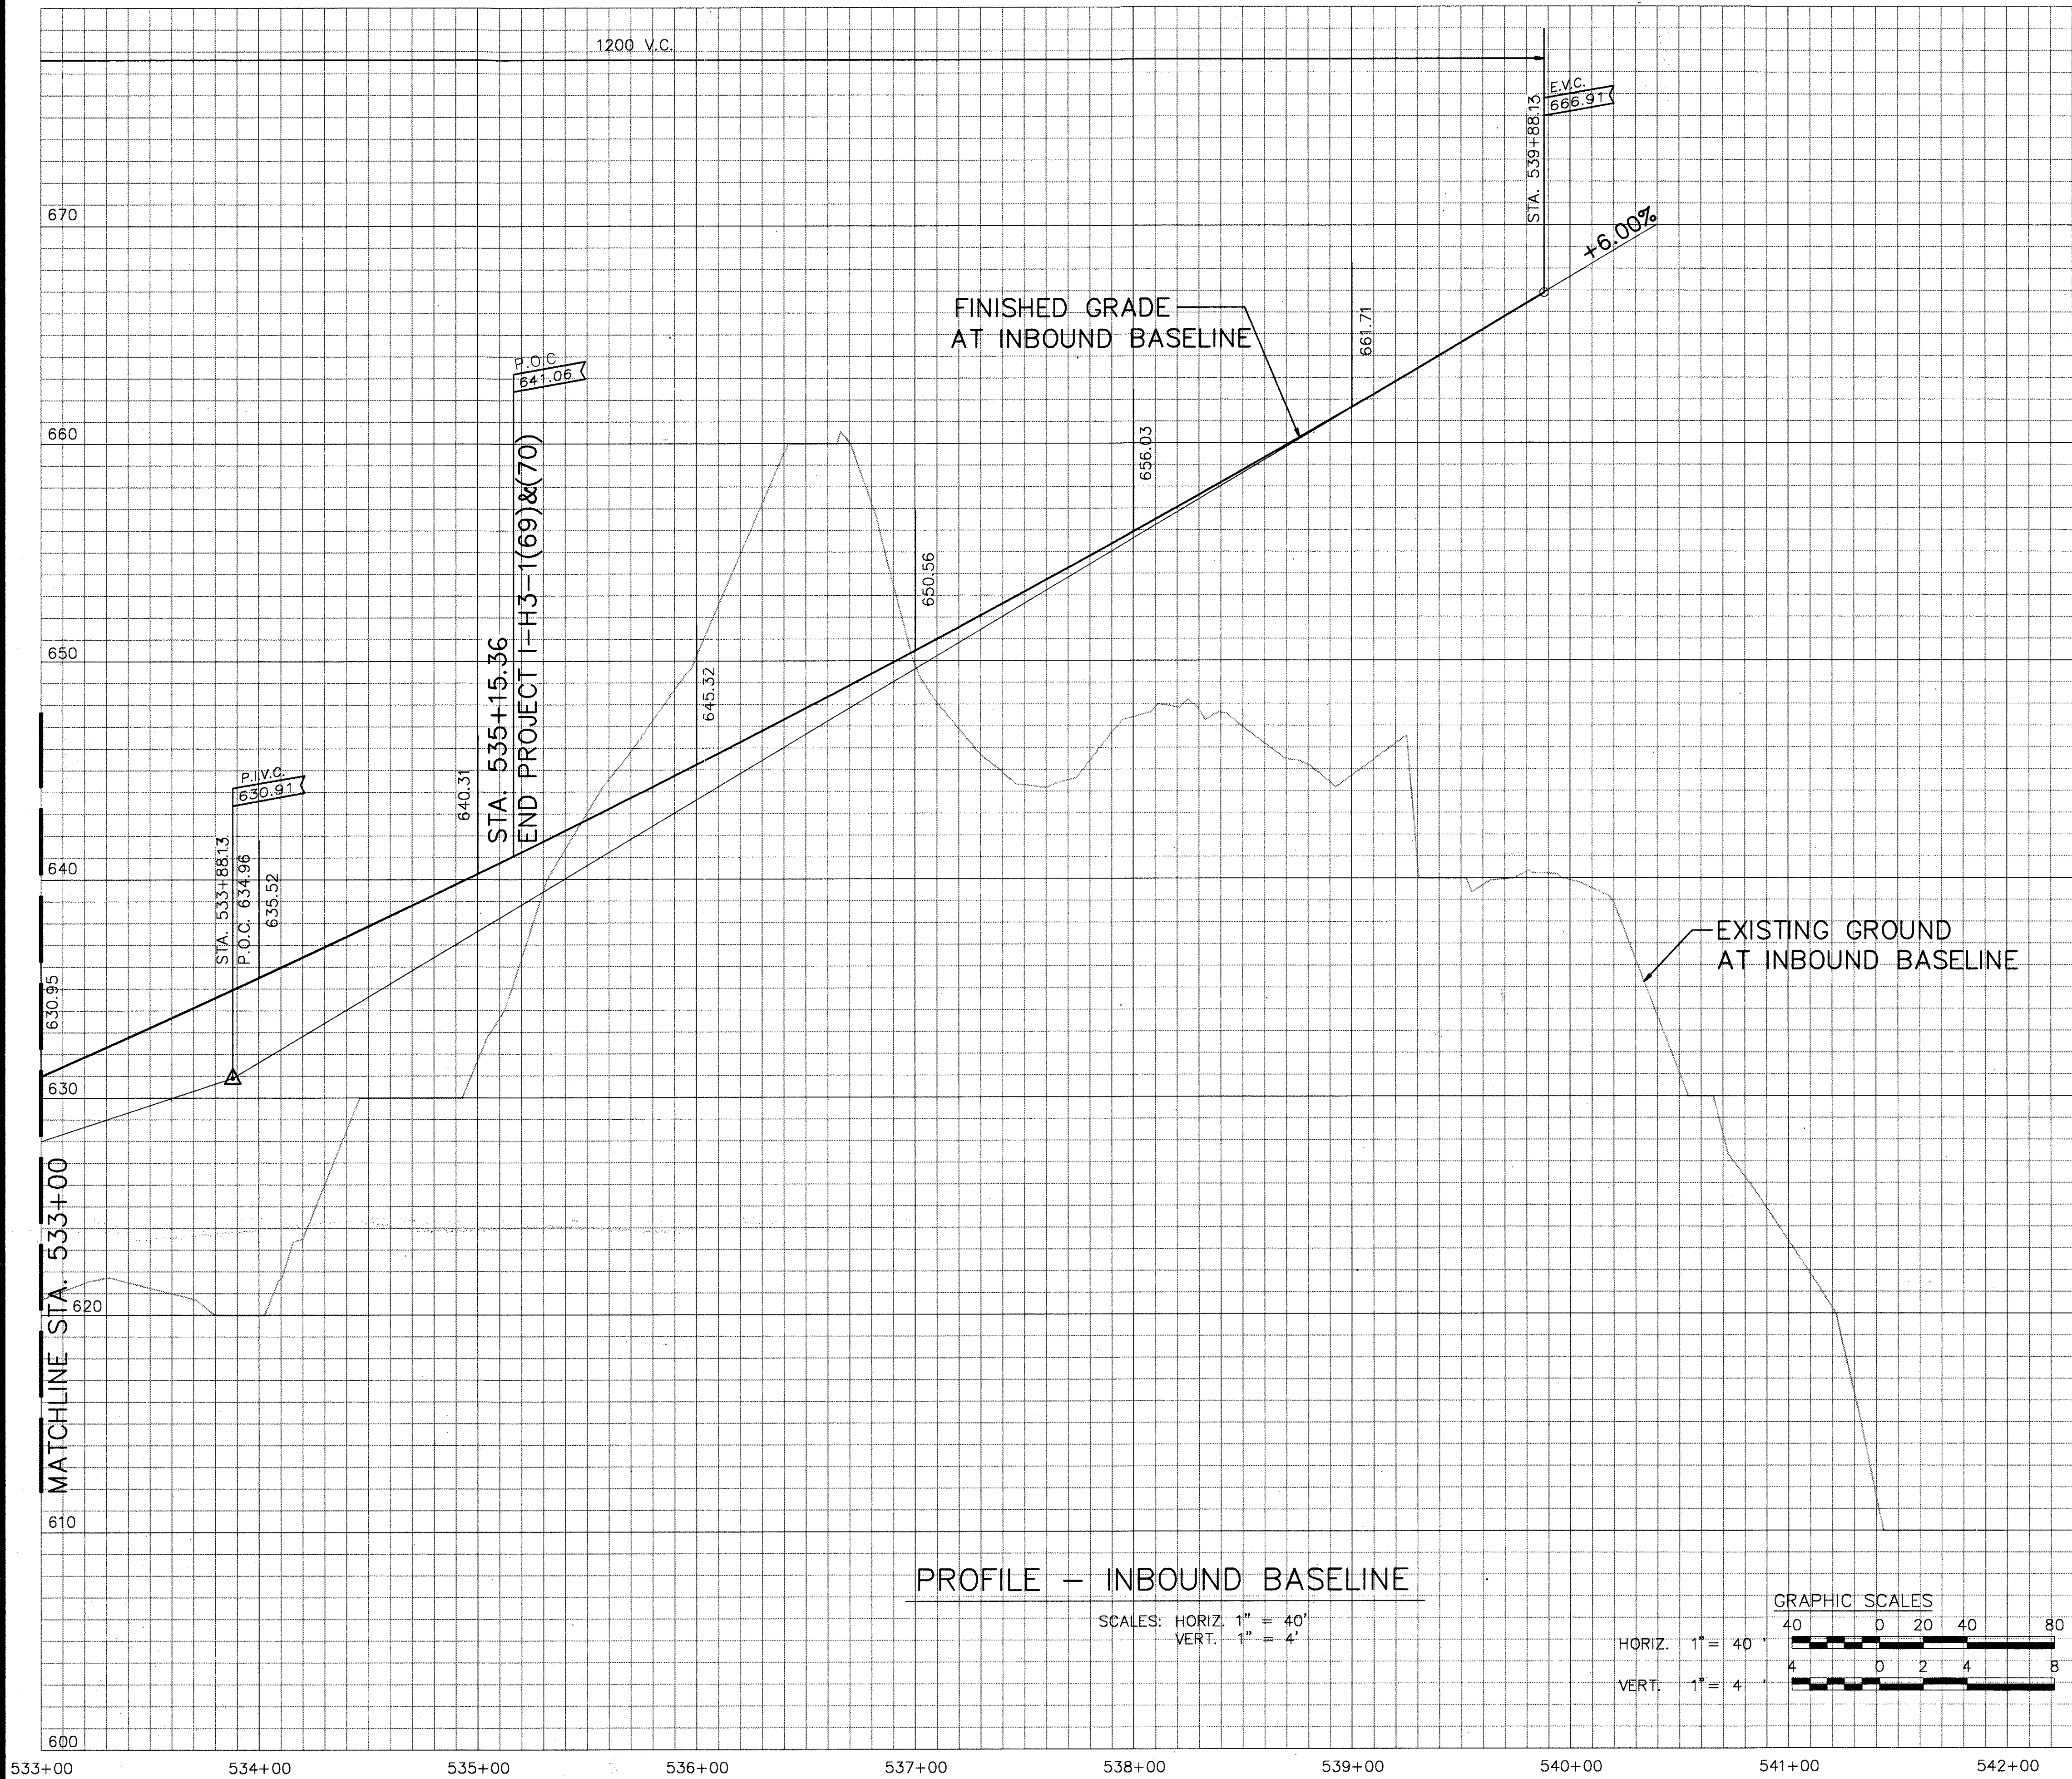

PROFILE - INBOUND BASELINE

SCALES: HORIZ. 1" = 40'
VERT. 1" = 4'

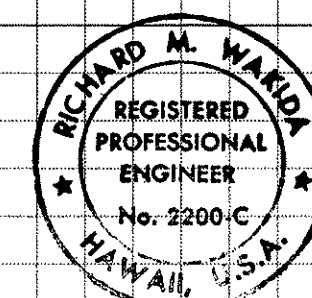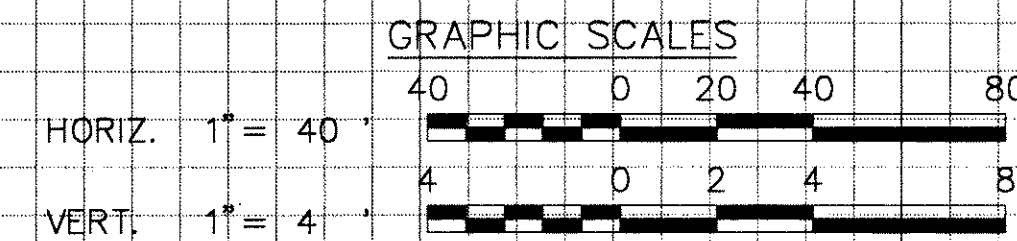

THIS WORK WAS PREPARED BY ME
OR UNDER MY SUPERVISION
Richard M. Warda
SIGNATURE DATE

STATE OF HAWAII DEPARTMENT OF TRANSPORTATION HIGHWAYS DIVISION	
PROFILE - INBOUND STA. 533+00 TO STA. 542+00	
INTERSTATE ROUTE H-3 F.A.I. PROJECT NO. I-H3-1(69) & (70)	
SCALE: 1" = 40'	DATE: MARCH, 1992
SHEET No. 023 OF 95 SHEETS	