
STANDARD PLANS SUMMARY

FED. ROAD	STATE	FED. AID	FISCAL	SHEET	TOTAL
DIST. NO.		PROJ. NO.	YEAR	NO.	SHEETS
HAWAII	HAW.	I-H3-I(69)	1992	2	325

STANDARD PLAN NO.	TITI	DATE
B-01 ●	Notes and Miscellaneous Details	07/01/86
B-02		
B-03 ••-	Typical Structure Excavation and Backfill Pay Limits	07/01/86
B-04		
B-05		
B-06 ●	Concrete Box Girder	07/01/86
B-07 ●	Concrete Box Girder	07/01/86
B-08 •	Concrete Box Girder	07/01/86
B-09		
B-10		
B-11		
B−12 •	Prestressed Concrete Piles	r07/16/90
B-13 🌑	Prestressed Concrete Piles	r07/16/90
D-01	Chain Link Fence With Toprail	r03/06/87
D-02	Chain Link Fence Without Toprail	r07/26/90
D-03 @	Wire Fence With Metal Posts	07/01/86
D-04 ●	Typical Details of Curbs and/or Gutters	07/01/86
D-05	Typical Details of Reinforced Concrete Drop Driveway	07/01/86
D-06	Centerline and Reference Survey Monument	07/01/86
D-07	Street Survey Monument	07/01/86
D-08	Landscaping Shrub and Tree Planting	07/01/86
D-09 •	Field Office	07/01/86
D-10 ●	Field Office	07/01/86
D-11 •	Project Site Laboratory	07/01/86
D-12 ●	Project Site Laboratory	07/01/86
D-13 ●	Field Office & Project Site Laboratory	07/01/86
	Troid office at Tojour one East-atory	
	T	
H-01	Type A, B, C and D Catch Basin	07/01/86
H-02	Type A1, B1, C1 and D1 Catch Basin	07/01/86 07/01/86 07/01/86
H-02 H-03	Type A1, B1, C1 and D1 Catch Basin Type A2, B2, C2 and D2 Catch Basin	07/01/86 07/01/86
H-02 H-03 H-04	Type A1, B1, C1 and D1 Catch Basin	07/01/86 07/01/86 07/01/86
H-02 H-03 H-04 H-05	Type A1, B1, C1 and D1 Catch Basin Type A2, B2, C2 and D2 Catch Basin Typical Reinforcing Details for Catch Basins	07/01/86 07/01/86 07/01/86 07/01/86
H-02 H-03 H-04 H-05 H-06 ●	Type A1, B1, C1 and D1 Catch Basin Type A2, B2, C2 and D2 Catch Basin Typical Reinforcing Details for Catch Basins Type A, B and C Storm Drain Manhole Type D and E Storm Drain Manhole	07/01/86 07/01/86 07/01/86 07/01/86 07/01/86
H-02 H-03 H-04 H-05 H-06 • H-07	Type A1, B1, C1 and D1 Catch Basin Type A2, B2, C2 and D2 Catch Basin Typical Reinforcing Details for Catch Basins Type A, B and C Storm Drain Manhole Type D and E Storm Drain Manhole	07/01/86 07/01/86 07/01/86 07/01/86 07/01/86 07/01/86
H-02 H-03 H-04 H-05 H-06 • H-07 •	Type A1, B1, C1 and D1 Catch Basin Type A2, B2, C2 and D2 Catch Basin Typical Reinforcing Details for Catch Basins Type A, B and C Storm Drain Manhole Type D and E Storm Drain Manhole Type F Storm Drain Manhole	07/01/86 07/01/86 07/01/86 07/01/86 07/01/86 07/01/86
H-02 H-03 H-04 H-05 H-06 H-07 H-08 H-09	Type A1, B1, C1 and D1 Catch Basin Type A2, B2, C2 and D2 Catch Basin Typical Reinforcing Details for Catch Basins Type A, B and C Storm Drain Manhole Type D and E Storm Drain Manhole Type F Storm Drain Manhole Catch Basin and Manhole Casting	07/01/86 07/01/86 07/01/86 07/01/86 07/01/86 07/01/86 07/01/86
H-02 H-03 H-04 H-05 H-06 • H-07 • H-08 H-09 •	Type A1, B1, C1 and D1 Catch Basin Type A2, B2, C2 and D2 Catch Basin Typical Reinforcing Details for Catch Basins Type A, B and C Storm Drain Manhole Type D and E Storm Drain Manhole Type F Storm Drain Manhole Catch Basin and Manhole Casting Type A-9 and A-9P Frames and Grates	07/01/86 07/01/86 07/01/86 07/01/86 07/01/86 07/01/86 07/01/86 07/01/86
H-02 H-03 H-04 H-05 H-06 • H-07 • H-08 H-09 • H-10	Type A1, B1, C1 and D1 Catch Basin Type A2, B2, C2 and D2 Catch Basins Typical Reinforcing Details for Catch Basins Type A, B and C Storm Drain Manhole Type D and E Storm Drain Manhole Type F Storm Drain Manhole Catch Basin and Manhole Casting Type A-9 and A-9P Frames and Grates Type A-9B Frames and Grates	07/01/86 07/01/86 07/01/86 07/01/86 07/01/86 07/01/86 07/01/86 07/01/86 07/01/86 07/01/86
H-02 H-03 H-04 H-05 H-06 H-07 H-08 H-09 H-10 H-11 H-12	Type A1, B1, C1 and D1 Catch Basin Type A2, B2, C2 and D2 Catch Basins Typical Reinforcing Details for Catch Basins Type A, B and C Storm Drain Manhole Type D and E Storm Drain Manhole Type F Storm Drain Manhole Catch Basin and Manhole Casting Type A-9 and A-9P Frames and Grates Type A-9B Frames and Grates Type 61614 and 61214 Grated Drop Inlet	07/01/86 07/01/86 07/01/86 07/01/86 07/01/86 07/01/86 07/01/86 07/01/86 07/01/86 07/01/86 07/01/86
H-02 H-03 H-04 H-05 H-06 H-07 H-08 H-09 H-10 H-11 H-12	Type A1, B1, C1 and D1 Catch Basin Type A2, B2, C2 and D2 Catch Basin Typical Reinforcing Details for Catch Basins Type A, B and C Storm Drain Manhole Type D and E Storm Drain Manhole Type F Storm Drain Manhole Catch Basin and Manhole Casting Type A-9 and A-9P Frames and Grates Type A-9B Frames and Grates Type 61614 and 61214 Grated Drop Inlet Type 61616 Grated Drop Inlet	07/01/86 07/01/86 07/01/86 07/01/86 07/01/86 07/01/86 07/01/86 07/01/86 07/01/86 07/01/86 07/01/86
H-02 H-03 H-04 H-05 H-06 H-07 H-08 H-09 H-10 H-11 H-12 H-13	Type A1, B1, C1 and D1 Catch Basin Type A2, B2, C2 and D2 Catch Basin Typical Reinforcing Details for Catch Basins Type A, B and C Storm Drain Manhole Type D and E Storm Drain Manhole Type F Storm Drain Manhole Catch Basin and Manhole Casting Type A-9 and A-9P Frames and Grates Type A-9B Frames and Grates Type 61614 and 61214 Grated Drop Inlet Type 61616 Grated Drop Inlet 61214, 61614 & 61616 Steel Frames and Grates	07/01/86 07/01/86 07/01/86 07/01/86 07/01/86 07/01/86 07/01/86 07/01/86 07/01/86 07/01/86 07/01/86 07/01/86
H-02 H-03 H-04 H-05 H-06 • H-07 • H-08 H-09 • H-10 H-11 H-12 H-13 H-14	Type A1, B1, C1 and D1 Catch Basin Type A2, B2, C2 and D2 Catch Basin Typical Reinforcing Details for Catch Basins Type A, B and C Storm Drain Manhole Type D and E Storm Drain Manhole Type F Storm Drain Manhole Catch Basin and Manhole Casting Type A-9 and A-9P Frames and Grates Type A-9B Frames and Grates Type 61614 and 61214 Grated Drop Inlet Type 61616 Grated Drop Inlet 61214, 61614 & 61616 Steel Frames and Grates 61214B Steel Frame and Grates	
H-07 H-08 H-09 H-10 H-11 H-12 H-13 H-14 H-15	Type A1, B1, C1 and D1 Catch Basin Type A2, B2, C2 and D2 Catch Basin Typical Reinforcing Details for Catch Basins Type A, B and C Storm Drain Manhole Type D and E Storm Drain Manhole Type F Storm Drain Manhole Catch Basin and Manhole Casting Type A-9 and A-9P Frames and Grates Type A-9B Frames and Grates Type 61614 and 61214 Grated Drop Inlet Type 61616 Grated Drop Inlet 61214, 61614 & 61616 Steel Frames and Grates 61214B Steel Frame and Grates	07/01/86 07/01/86 07/01/86 07/01/86 07/01/86 07/01/86 07/01/86 07/01/86 07/01/86 07/01/86 07/01/86 07/01/86 07/01/86 07/01/86 07/01/86
H-02 H-03 H-04 H-05 H-06 H-07 H-08 H-09 H-10 H-11 H-12 H-13 H-14 H-15 H-16	Type A1, B1, C1 and D1 Catch Basin Type A2, B2, C2 and D2 Catch Basins Typical Reinforcing Details for Catch Basins Type A, B and C Storm Drain Manhole Type D and E Storm Drain Manhole Type F Storm Drain Manhole Catch Basin and Manhole Casting Type A-9 and A-9P Frames and Grates Type A-9B Frames and Grates Type 61614 and 61214 Grated Drop Inlet Type 61616 Grated Drop Inlet 61214, 61614 & 61616 Steel Frames and Grates 61214B Steel Frame and Grates Concrete and Cement Rubble Masonry Structures	07/01/86 07/01/86 07/01/86 07/01/86 07/01/86 07/01/86 07/01/86 07/01/86 07/01/86 07/01/86 07/01/86 07/01/86 07/01/86
H-02 H-03 H-04 H-05 H-06 H-07 H-08 H-09 H-10 H-11 H-12 H-13 H-14 H-15 H-16 H-17 •	Type A1, B1, C1 and D1 Catch Basin Type A2, B2, C2 and D2 Catch Basins Typical Reinforcing Details for Catch Basins Type A, B and C Storm Drain Manhole Type D and E Storm Drain Manhole Type F Storm Drain Manhole Catch Basin and Manhole Casting Type A-9 and A-9P Frames and Grates Type A-9B Frames and Grates Type 61614 and 61214 Grated Drop Inlet Type 61616 Grated Drop Inlet 61214, 61614 & 61616 Steel Frames and Grates 61214B Steel Frame and Grates Concrete and Cement Rubble Masonry Structures Inlet Structures	07/01/86 07/01/86 07/01/86 07/01/86 07/01/86 07/01/86 07/01/86 07/01/86 07/01/86 07/01/86 07/01/86 07/01/86 07/01/86 07/01/86 07/01/86 07/01/86 07/01/86 07/01/86
H-02 H-03 H-04 H-05 H-06 H-07 H-08 H-09 H-10 H-11 H-12 H-13 H-14 H-15 H-16 H-17 H-18	Type A1, B1, C1 and D1 Catch Basin Type A2, B2, C2 and D2 Catch Basin Typical Reinforcing Details for Catch Basins Type A, B and C Storm Drain Manhole Type D and E Storm Drain Manhole Type F Storm Drain Manhole Catch Basin and Manhole Casting Type A-9 and A-9P Frames and Grates Type A-9B Frames and Grates Type 61614 and 61214 Grated Drop Inlet Type 61616 Grated Drop Inlet 61214, 61614 & 61616 Steel Frames and Grates 61214B Steel Frame and Grates Concrete and Cement Rubble Masonry Structures Inlet Structures Flared End Section for Culverts	07/01/86 07/01/86 07/01/86 07/01/86 07/01/86 07/01/86 07/01/86 07/01/86 07/01/86 07/01/86 07/01/86 07/01/86 07/01/86 07/01/86 07/01/86 07/01/86 07/01/86 07/01/86
H-02 H-03 H-04 H-05 H-06 H-07 H-08 H-09 H-10 H-11 H-12 H-13 H-14 H-15 H-16 H-17 H-18 H-19	Type A1, B1, C1 and D1 Catch Basin Type A2, B2, C2 and D2 Catch Basin Typical Reinforcing Details for Catch Basins Type A, B and C Storm Drain Manhole Type D and E Storm Drain Manhole Type F Storm Drain Manhole Catch Basin and Manhole Casting Type A-9 and A-9P Frames and Grates Type A-9B Frames and Grates Type 61614 and 61214 Grated Drop Inlet Type 61616 Grated Drop Inlet 61214, 61614 & 61616 Steel Frames and Grates 61214B Steel Frame and Grates Concrete and Cement Rubble Masonry Structures Inlet Structures Flared End Section for Culverts Outlet Structures	07/01/86 07/01/86 07/01/86 07/01/86 07/01/86 07/01/86 07/01/86 07/01/86 07/01/86 07/01/86 07/01/86 07/01/86 07/01/86 07/01/86 07/01/86 07/01/86 07/01/86 07/01/86 07/01/86 07/01/86
H-02 H-03 H-04 H-05 H-06 H-07 H-08 H-09 H-10 H-11 H-12 H-13 H-14 H-15 H-16 H-17 H-18 H-19 H-20	Type A1, B1, C1 and D1 Catch Basin Type A2, B2, C2 and D2 Catch Basin Typical Reinforcing Details for Catch Basins Type A, B and C Storm Drain Manhole Type D and E Storm Drain Manhole Type F Storm Drain Manhole Catch Basin and Manhole Casting Type A-9 and A-9P Frames and Grates Type A-9B Frames and Grates Type 61614 and 61214 Grated Drop Inlet Type 61616 Grated Drop Inlet 61214, 61614 & 61616 Steel Frames and Grates 61214B Steel Frame and Grates Concrete and Cement Rubble Masonry Structures Inlet Structures Flared End Section for Culverts Outlet Structures Concrete Spillway Inlet	07/01/86 07/01/86

STANDARD PLAN NO.	TITLE	DATE
TE-01 ●	Miscellaneous Sign Details	07/01/86
TE-02 ●	Galvanized Flanged Channel Sign Post Mounting	07/01/86
TE-03	Galvanized Square Tube Sign Post Mounting	07/01/86
TE-04 ●	Regulatory Signs	r09/01/87
TE-05 ●	Warning Signs	07/01/86
TE-06 ●	Miscellaneous Signs	r11/03/89
TE-07	Reserved	07/01/86
TE-08 ●	Construction Signs	r09/01/87
TE-09	Miscellaneous Intersection Signs	r03/06/87
TE-10	Reserved	07/01/86
TE-11	Bike Route Sign and Supplementary Plates	07/01/86
TE-12	State Route Marker and Auxiliary Markers	07/01/86
TE-13	Interstate Route Marker	07/01/86
TE-14	State Route Marker and Border Detail for Guide Signs	07/01/86
TE-15	Route Marker Assemblies	07/01/86
TE-16 ●	Miscellaneous Reflector Markers	07/01/86
TE-17	Type II Object Markers	07/01/86
TE-18 ●	Mileposts	07/01/86
TE-19	Reserved	07/01/86
TE-20	Overhead Sign Supports	07/01/86
TE-21	Overhead Sign Support, Box Truss Type, Aluminum	07/01/86
TE-22	Foundation Details and Schedules	07/01/86
TE-23	Supports for Ground Mounted Guide Sign	r11/03/89
TE-24	Breakaway Sign Supports for Ground Mounted Guide Signs	07/01/86
TE-25	Laminated Aluminum Sign Panels (Overhead)	07/01/86
TE-26	Laminated Aluminum Sign Panels (Ground Mounted)	07/01/86
TE-27	Solid Aluminum Extruded Sign Panel and Accessory Details	07/01/86
TE-28	Guide Signs Luminaire Mountings	07/01/86
TE-29	Reserved	07/01/86
TE-30 •	Raised Pavement Markers and Striping	r05/09/90
TE-31	Miscellaneous Pavement Markings	r05/09/90
TE-32	Miscellaneous Pavement Markings	r05/09/90
TE-33	Miscellaneous Pavement Markings	r11/03/89
TE-34	Reserved	07/01/86
TE-35	Pavement Alphabets, Numbers & Symbols	07/01/86
TE-36	Pavement Alphabets, Numbers & Symbols	07/01/86
TE-37	Reserved	07/01/86
TE-38	Traffic Signal System, Miscellaneous Details	r11/03/89
TE-39	Traffic Signal System, Miscellaneous Details	07/01/86
TE-40	Loop Detectors	r11/03/89
TE-41	Pullboxes	07/01/86
TE-42	Type III Traffic Signal Standard	07/01/86
TE-43	Concrete Pullbox (2' x 3')	07/01/86
TE-44	Reserved	07/01/86

STANDARD PLAN NO.	TITLE	DATE
TE-45	Reserved	07/01/86
TE-46	Reserved	07/01/86
TE-47	Reserved	07/01/86
TE-48	Reserved	07/01/86
TE-49	Reserved	07/01/86
TE-50 ◆	Metal Guardrail	r03/06/87
TE-51 ●	Metal Guardrail	r09/01/87
TE-52	Metal Guardrail with Rubrail	r11/03/89
TE-53	Metal Guardrail with Rubrail at Obstruction	r09/01/87
TE-54	Beam Type Guardrail with Rubrail at Obstruction (Shoulder Installation)	r11/03/89
TE-55 ●	Metal Guardrail Connection to Concrete Barrier	r11/03/89
TE-56	Concrete Barrier Transition	07/01/86
TE-57 ●	Guardrail Type 3, Thrie Beam	r11/03/89
TE-57A	Guardrail Type 3, Modified Thrie Beam	11/03/89
TE-58 ●	Approach End Flare, One & Two Way Roadway	07/01/86
TE-59	Trailing End Flare, One & Two Way Roadway	r11/03/89
TE-60 ●	Anchor Block Details	07/01/86
TE-61	Breakaway Cable Terminal (BCT)	r11/03/89
TE-62	Breakaway Cable Terminal (BCT)	r09/01/87
TE-63 ●	Guardrail Type 4 (Rigid Barrier)	r09/01/87
TE-64 ●	Portable Concrete Barrier	r11/03/89
TE-65	Guardrail Type 4, Miscellaneous	r09/01/87
TE-66	Barricades	07/01/86
TE-67 ●	Delineation & Pavement Markings at Bridges	07/01/86
TE-68	Wheelchair Ramps	r11/03/89
TE-69	Wheelchair Ramps	r11/03/89
		· · ·

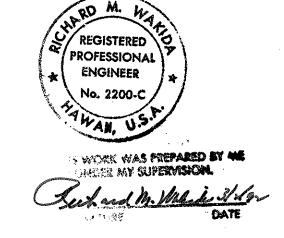

NOTE:

| 02/15/91 | REVISED STANDARD PLANS H-19

10/16/90 REVISED STANDARD PLANS H-16,H-17,

H-22 & H-23. 07/26/90 REVISED STANDARD PLANS D-02. 07/16/90 REVISED STANDARD PLANS B-12,B-13,

05/09/90 | REVISED STANDARD PLANS TE-30,TE-31, & TE-32.

11/03/89 REVISED STANDARD PLANS TE-06,TE-23,

09/01/87 REVISED STANDARD PLANS TE-04,TE-06,

03/06/87 REVISED STANDARD PLANS D-01, TE-09, TE-40, TE-50, TE-51, TE-57, TE-59, TE-61, TE-63 & TE-64.

TE-65 & TE-69.

TE-30, TE-31, TE-32, TE-33, TE-38, TE-40, TE-52, TE-54, TE-55, TE-57, TE-59, TE-61, TE-64, TE-68 & TE-69. ADDED TE-57A TO STANDARD PLANS

TE-08, TE-32, TE-51, TE-53, TE-54, TE-55, TE-57, TE-59, TE-62, TE-63,

REVISION

STANDARD PLANS APPLICABLE TO THIS PROJECT ARE INDICATED BY A " \bullet " NEXT TO THE STANDARD PLAN NO. (D-07 \bullet)


STATE OF HAWAII
DEPARTMENT OF TRANSPORTATION
HIGHWAYS DIVISION

STANDARD PLANS SUMMARY

INTERSTATE ROUTE H-3 F.A.I. PROJECT NO. I-H3-I(69) & (70)

DATE: MARCH, 1992

SHEET No. SPI OF I SHEETS

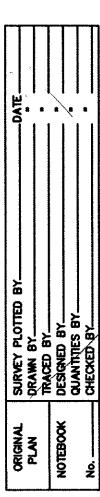

2