



FED. ROAD DIST. NO.	STATE	FED. AID PROJ. NO.	FISCAL YEAR	SHEET NO.	TOTAL SHEETS
HAWAII	HAW.	I-H3-1(69)	1992	27	325

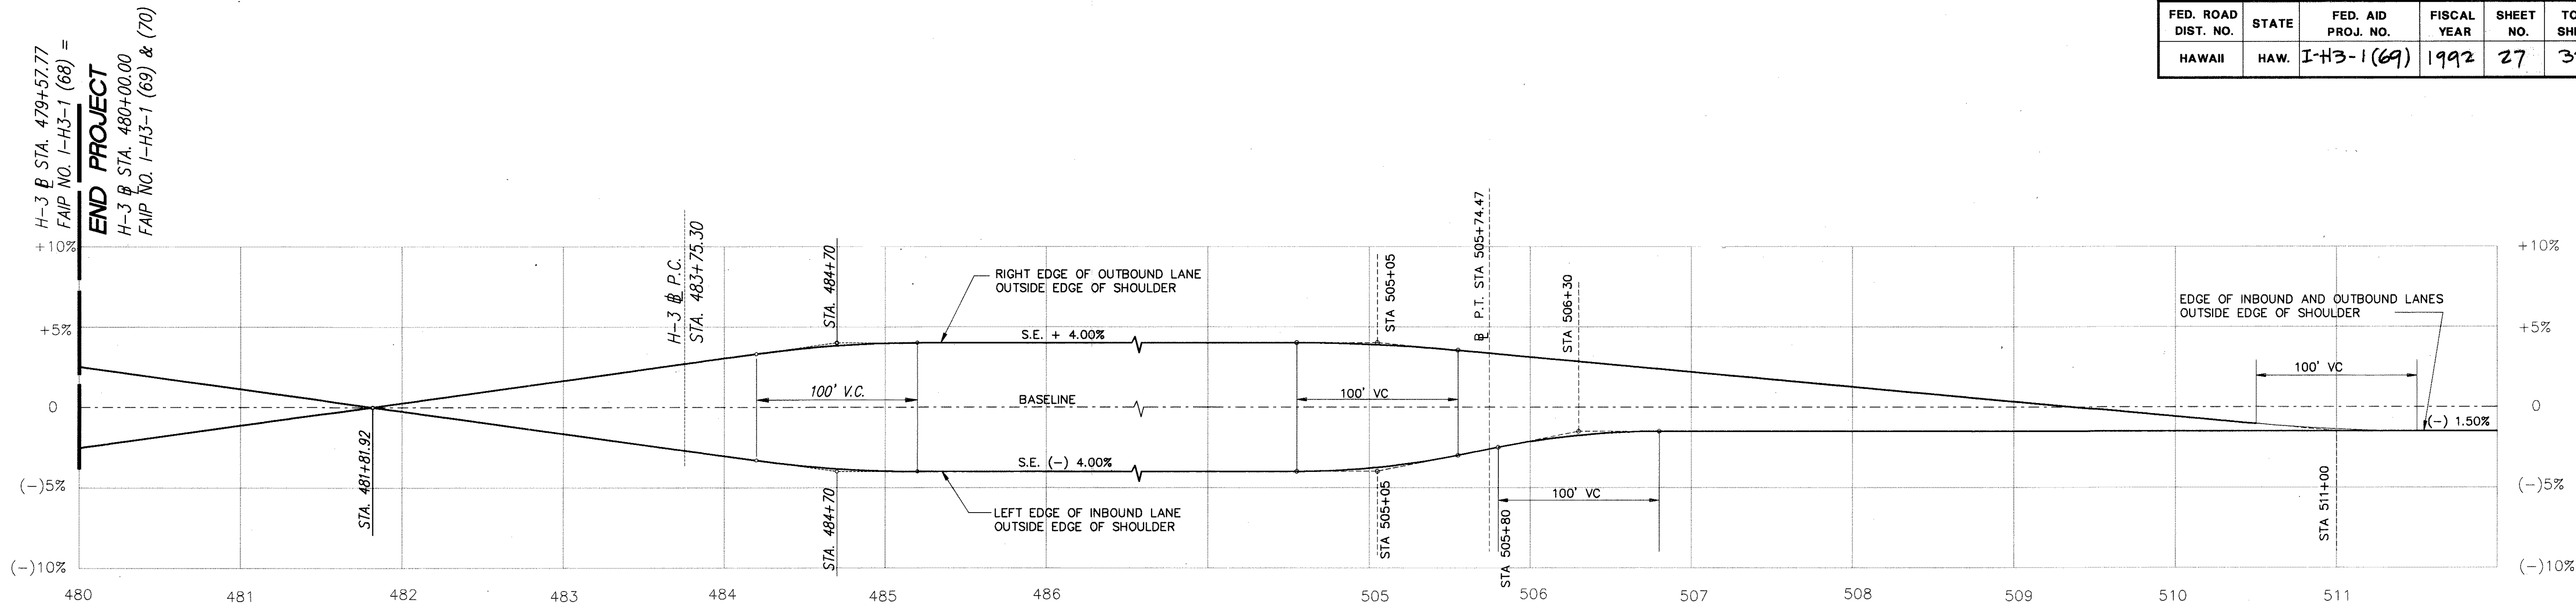

NOTE:
LEFT AND RIGHT EDGES DEFINED LOOKING UP STATION

SUPERELEVATION DIAGRAM BASELINE STA 480+00 TO BASELINE STA 511+50

SCALES: HORIZ. 1" = 50'
VERT. 1" = 5%

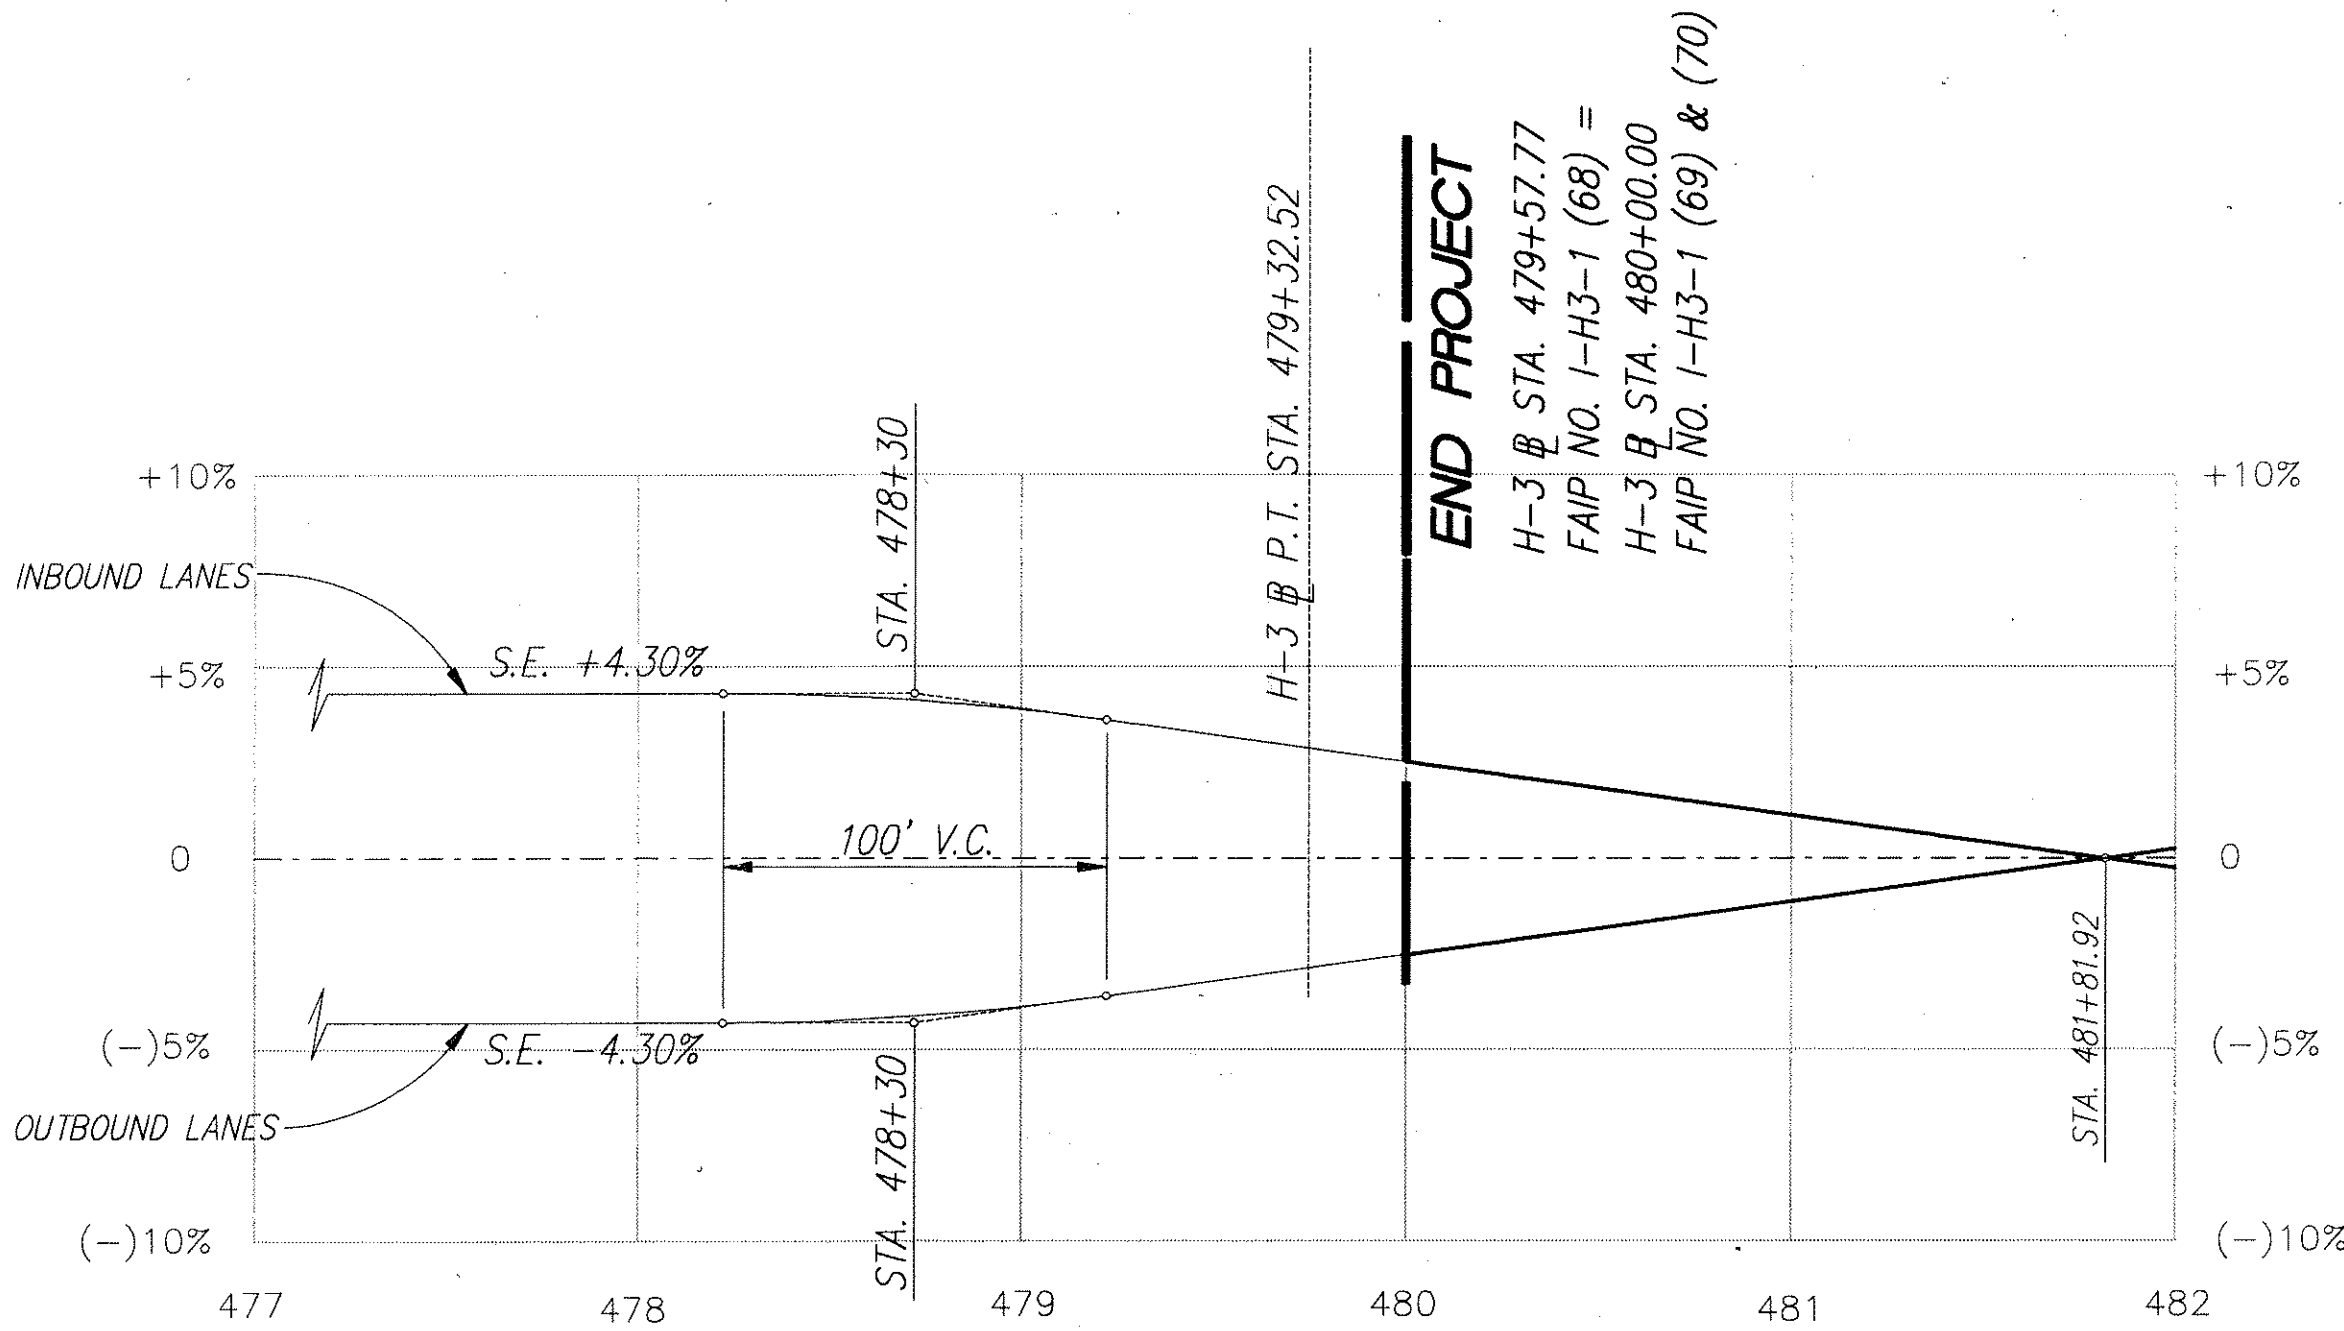


SUPERELEVATION DIAGRAM FAIP NO. I-H3-1(68)

SCALES: HORIZ. 1" = 50'
VERT. 1" = 5%

NOTE:
LEFT AND RIGHT EDGES DEFINED LOOKING UP STATION


ORIGINAL PLAN	DATE
NOTED BY	
DESIGNED BY	
QUANTITIES BY	
CHECKED BY	

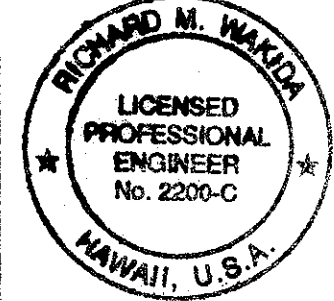

THIS WORK WAS PREPARED BY ME
OR UNDER MY SUPERVISION.
SIGNATURE DATE

11-5-93	REVISED SUPERELEVATION DIAGRAM
DATE	REVISION
STATE OF HAWAII DEPARTMENT OF TRANSPORTATION HIGHWAYS DIVISION SUPERELEVATION DIAGRAM INTERSTATE ROUTE H-3 F.A.I. PROJECT NO. I-H3-1(69) & (70) SCALE: AS NOTED DATE: MARCH, 1992 SHEET No. C24 OF 95 SHEETS	


FED. ROAD DIST. NO.	STATE	FED. AID PROJ. NO.	FISCAL YEAR	SHEET NO.	TOTAL SHEETS
HAWAII	HAW.	I-H3-1(69)	1992	28	325

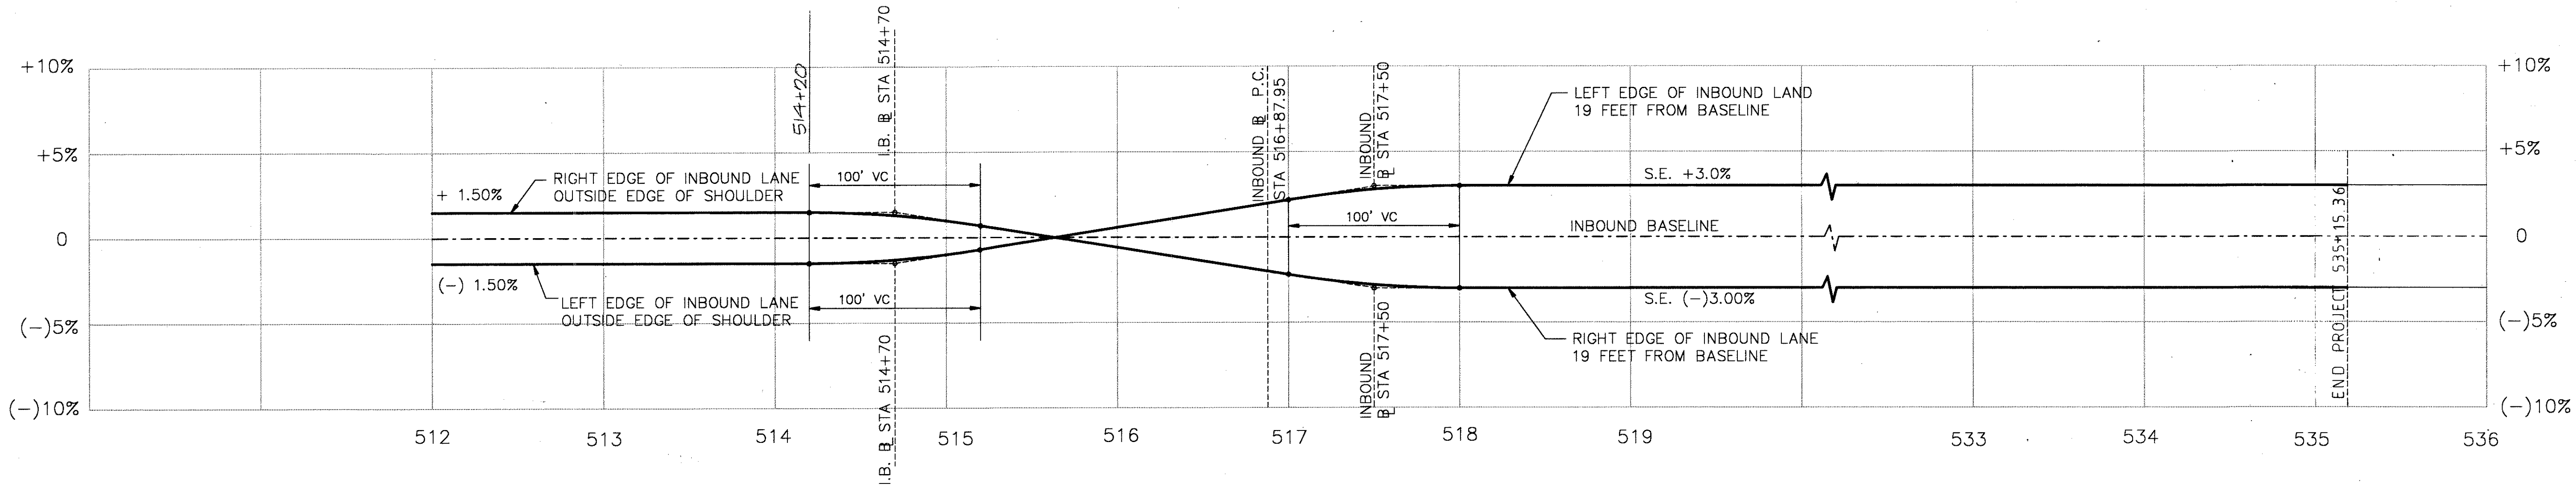

NOTE:
EDGES ARE DEFINED LOOKING UPSTATION

INBOUND SUPERELEVATION DIAGRAM
I.B. BASELINE STA 514+20 TO I.B. BASELINE STA 535+15.36


SCALES: HORIZ. 1" = 50'
VERT. 1" = 5%

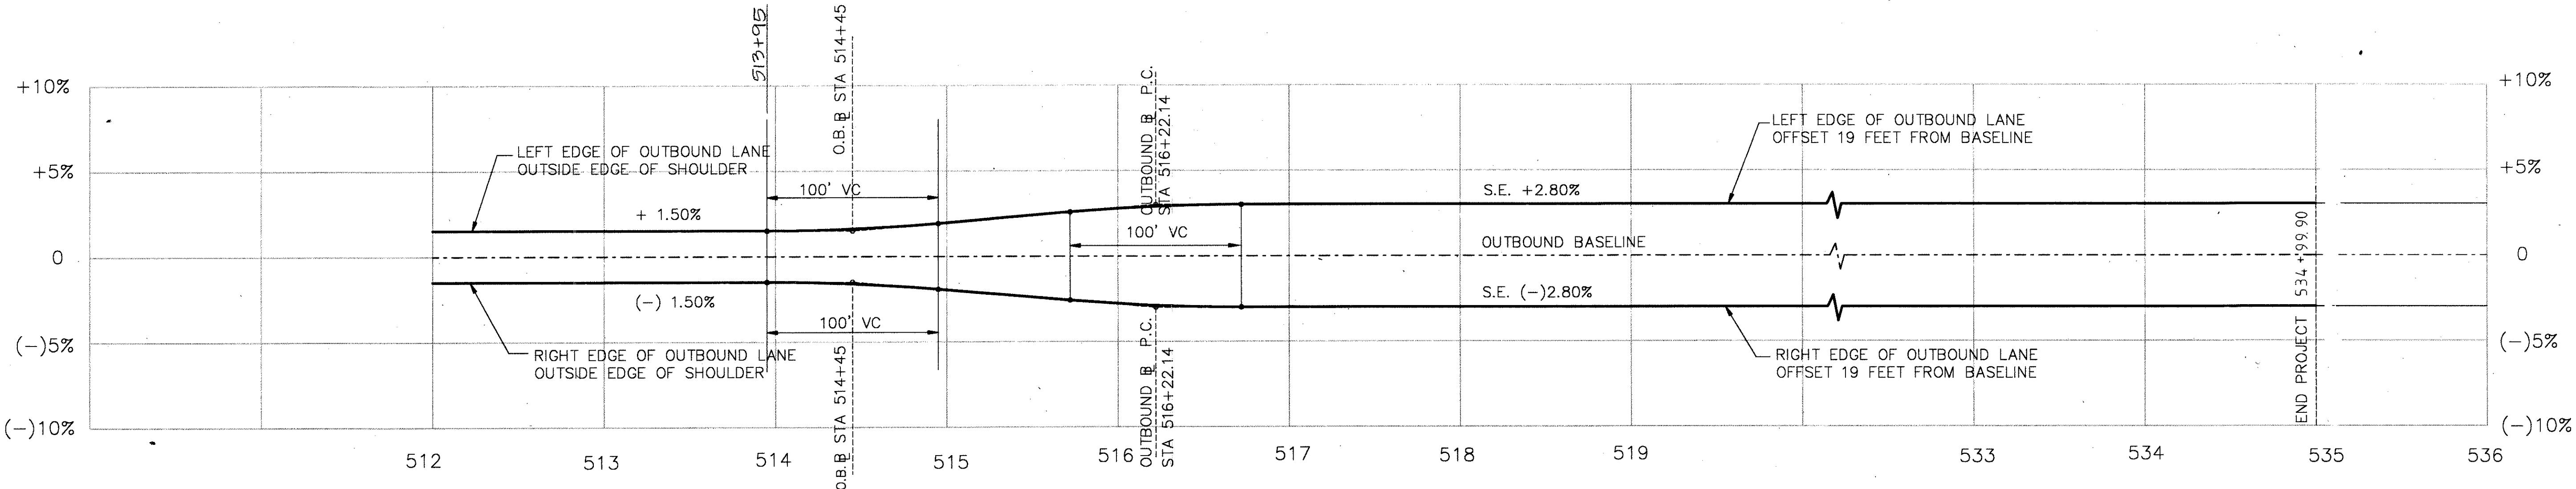

NOTE:
EDGES ARE DEFINED LOOKING UPSTATION

OUTBOUND SUPERELEVATION DIAGRAM
O.B. BASELINE STA 513+95 TO O.B. BASELINE STA 534+ 99.90

SCALES: HORIZ. 1" = 50'
VERT. 1" = 5%

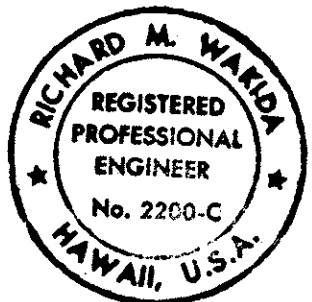

THIS WORK WAS PREPARED BY ME
OR UNDER MY SUPERVISION.
Richard M. Wagon
SIGNATURE DATE

STATE OF HAWAII
DEPARTMENT OF TRANSPORTATION
HIGHWAYS DIVISION

SUPER ELEVATION DIAGRAMS
STA 514+20 IB TO STA 535+15.36 IB
STA 513+95 OB TO STA 534+99.90 OB

INTERSTATE ROUTE H-3
F.A.I. PROJECT NO. I-H3-1(69) & (70)

SCALE: 1" = 40'


DATE: MARCH, 1992

SHEET No. 28 OF 95 SHEETS


SURVEY PLATTED BY	DATE
DESIGNED BY	
TRACED BY	
NOTE BOOK	
QUANTITIES BY	
CHECKED BY	

FED. ROAD DIST. NO.	STATE	FED. AID PROJ. NO.	FISCAL YEAR	SHEET NO.	TOTAL SHEETS
HAWAII	HAW.	I-H3-1(69)	1992	ADD 28 S-1	325

NOTE: THIS TRACING PREPARED DURING "AS BUILT" POSTING.

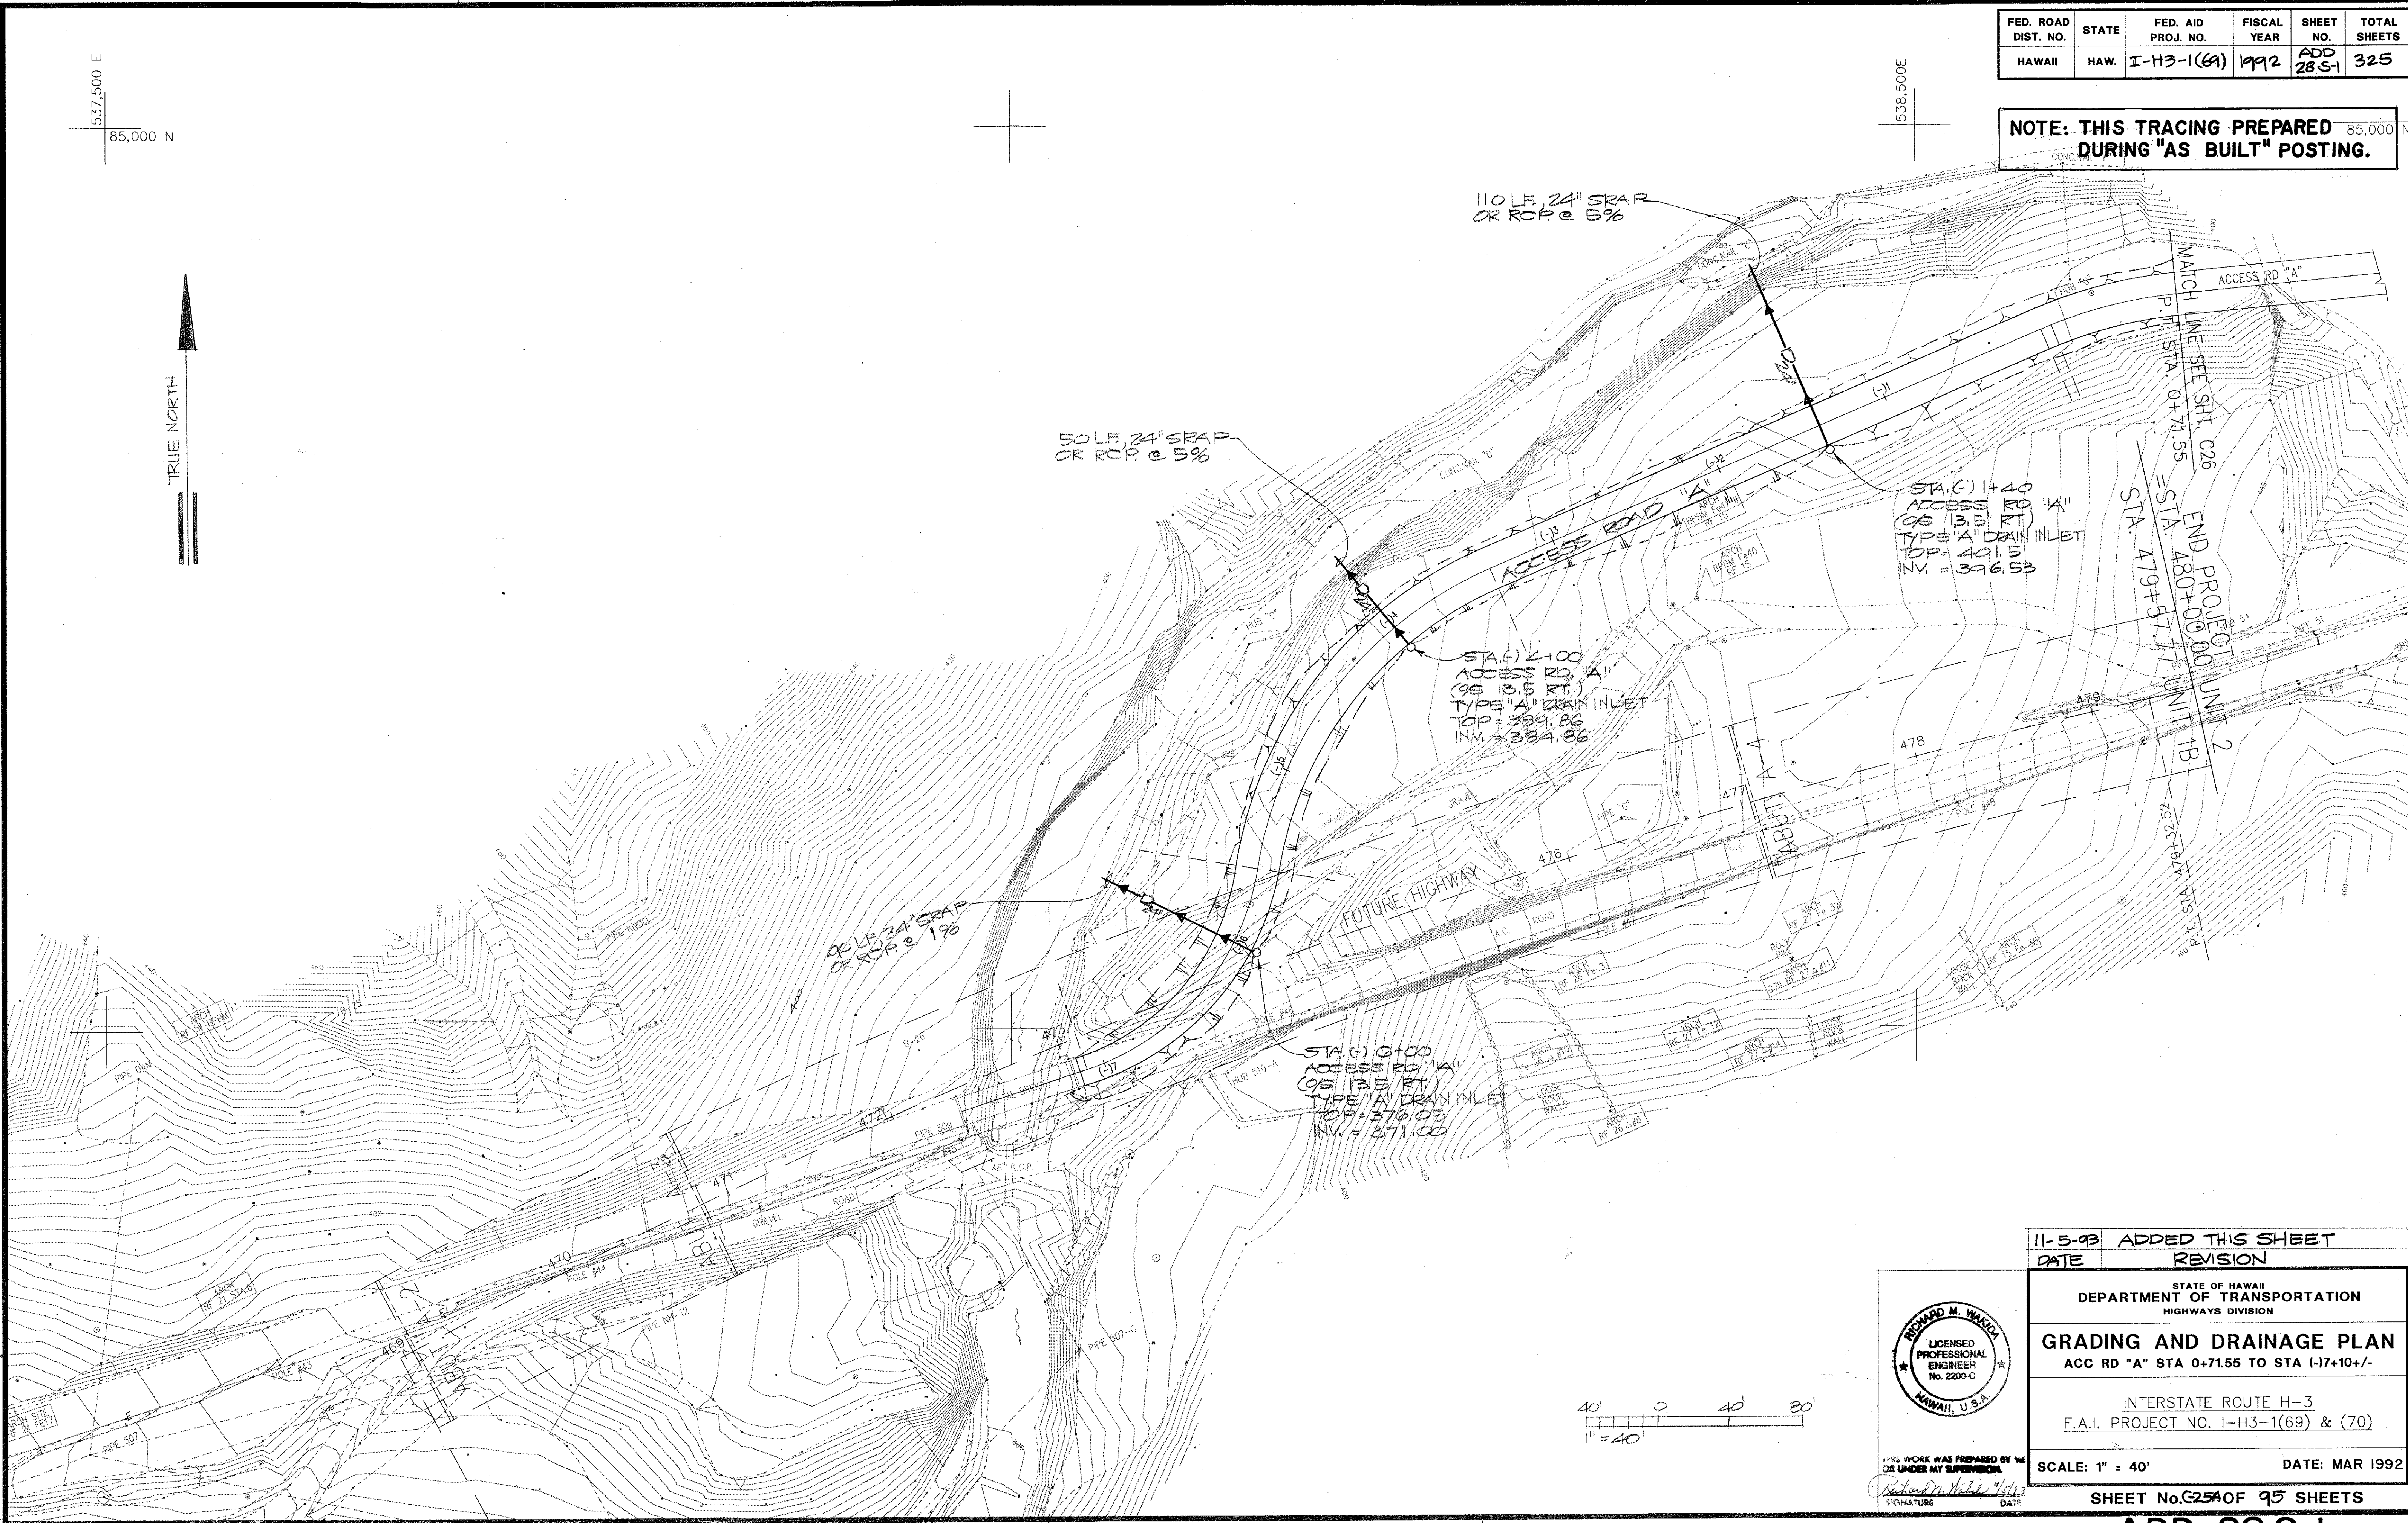

ORIGINAL PLAN	DATE
DRAWN BY	
TRACED BY	
DESIGNED BY	
CHECKED BY	
NO.	

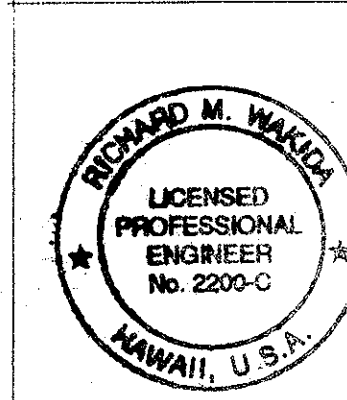

11-5-93	ADDED THIS SHEET
DATE	REVISION
STATE OF HAWAII DEPARTMENT OF TRANSPORTATION HIGHWAYS DIVISION	
GRADING AND DRAINAGE PLAN ACC RD "A" STA 0+71.55 TO STA 1+70+/-	
INTERSTATE ROUTE H-3 F.A.I. PROJECT NO. I-H3-1(69) & (70)	
SCALE: 1" = 40'	DATE: MAR 1992
SHEET No. C25A OF 95 SHEETS	

ADD. 28 S-1