



FED. ROAD DIST. NO.	STATE	FED. AID PROJ. NO.	FISCAL YEAR	SHEET NO.	TOTAL SHEETS
HAWAII	HAW.	I-H3-1(69)	1992	5	325

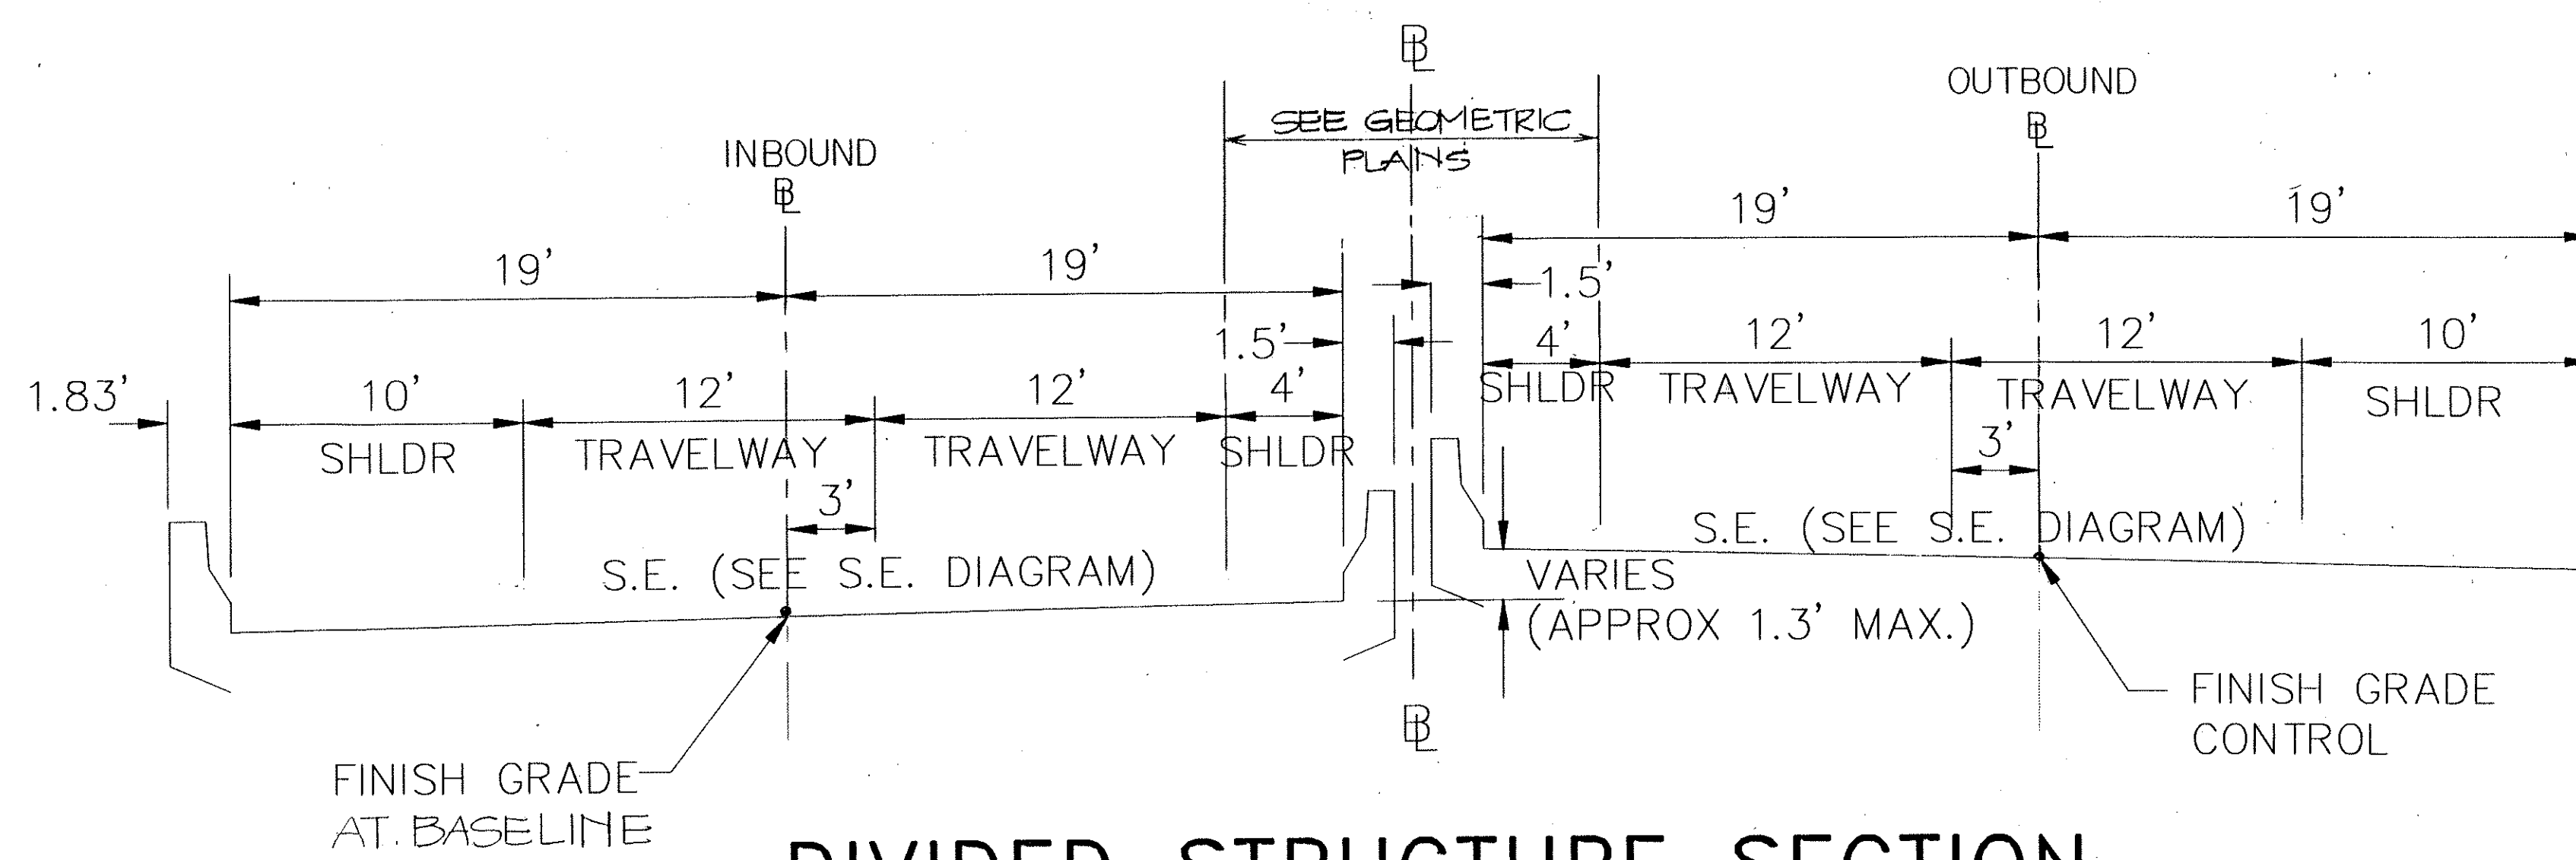

DIVIDED STRUCTURE SECTION

(STA 491+40 TO STA 509+20, STA 514+70 IB TO STA 524+30 IB, STA 514+70 OB TO STA 524+30 OB)

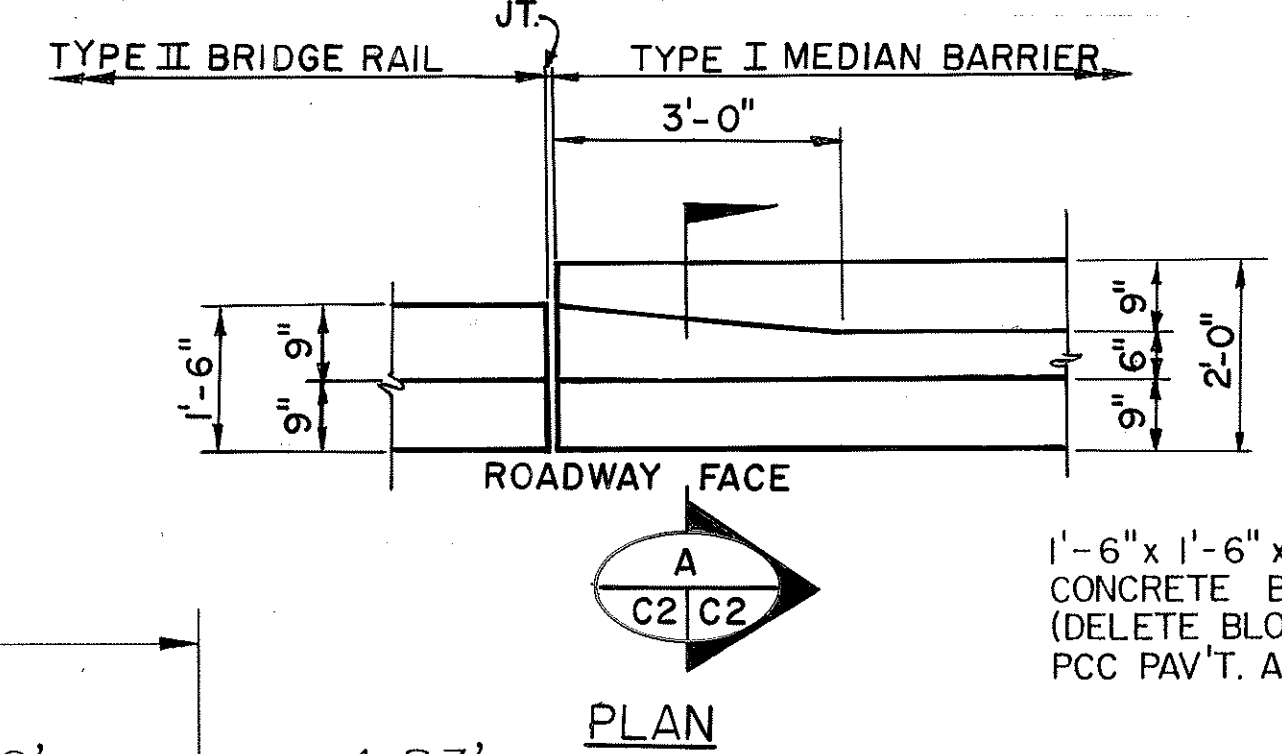


PLAN

REFER TO TYPE I MEDIAN BARRIER DIMENSIONS AND REINF.
TRANSITION FACE AS SHOWN ON PLAN
ADJUST REINF. AS SHOWN


SECTION

RAIL TO BARRIER TRANSITION

SCALE: 1/2" = 1'-0"

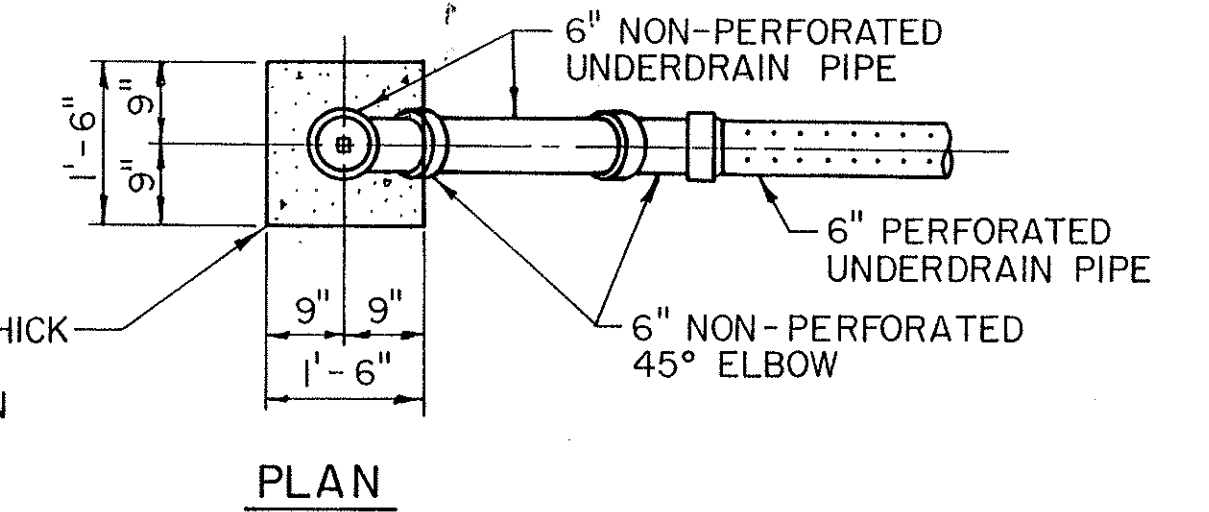


PLAN

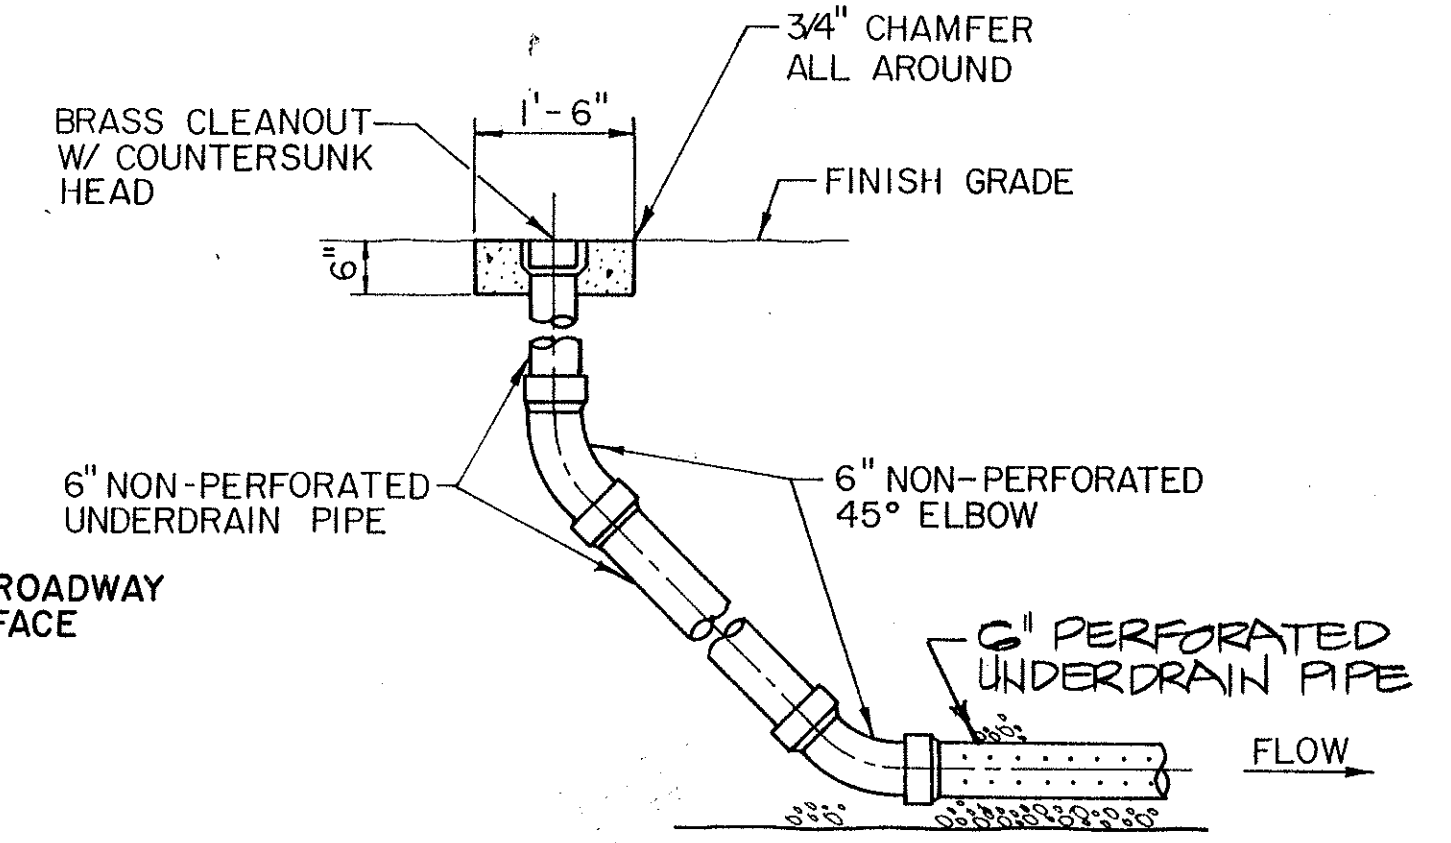


TYPICAL CLEANOUT DETAIL

SCALE: 3/4" = 1'-0"

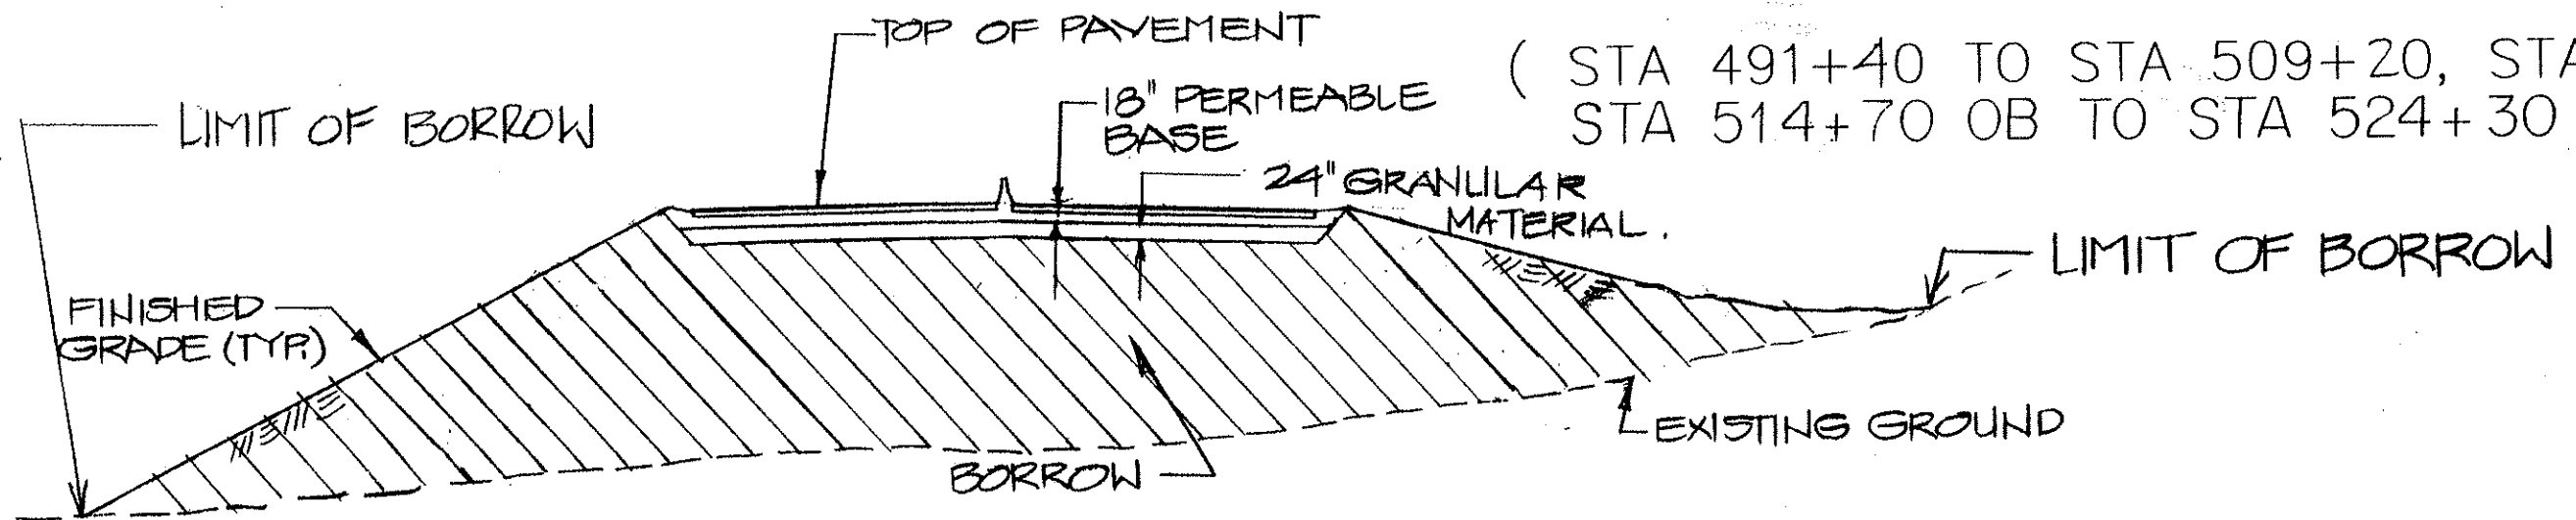

TYPICAL SECTION LIMITS OF BORROW MATERIAL FOR INTERSTATE ROUTE H-3 EMBANKMENTS


NOT TO SCALE

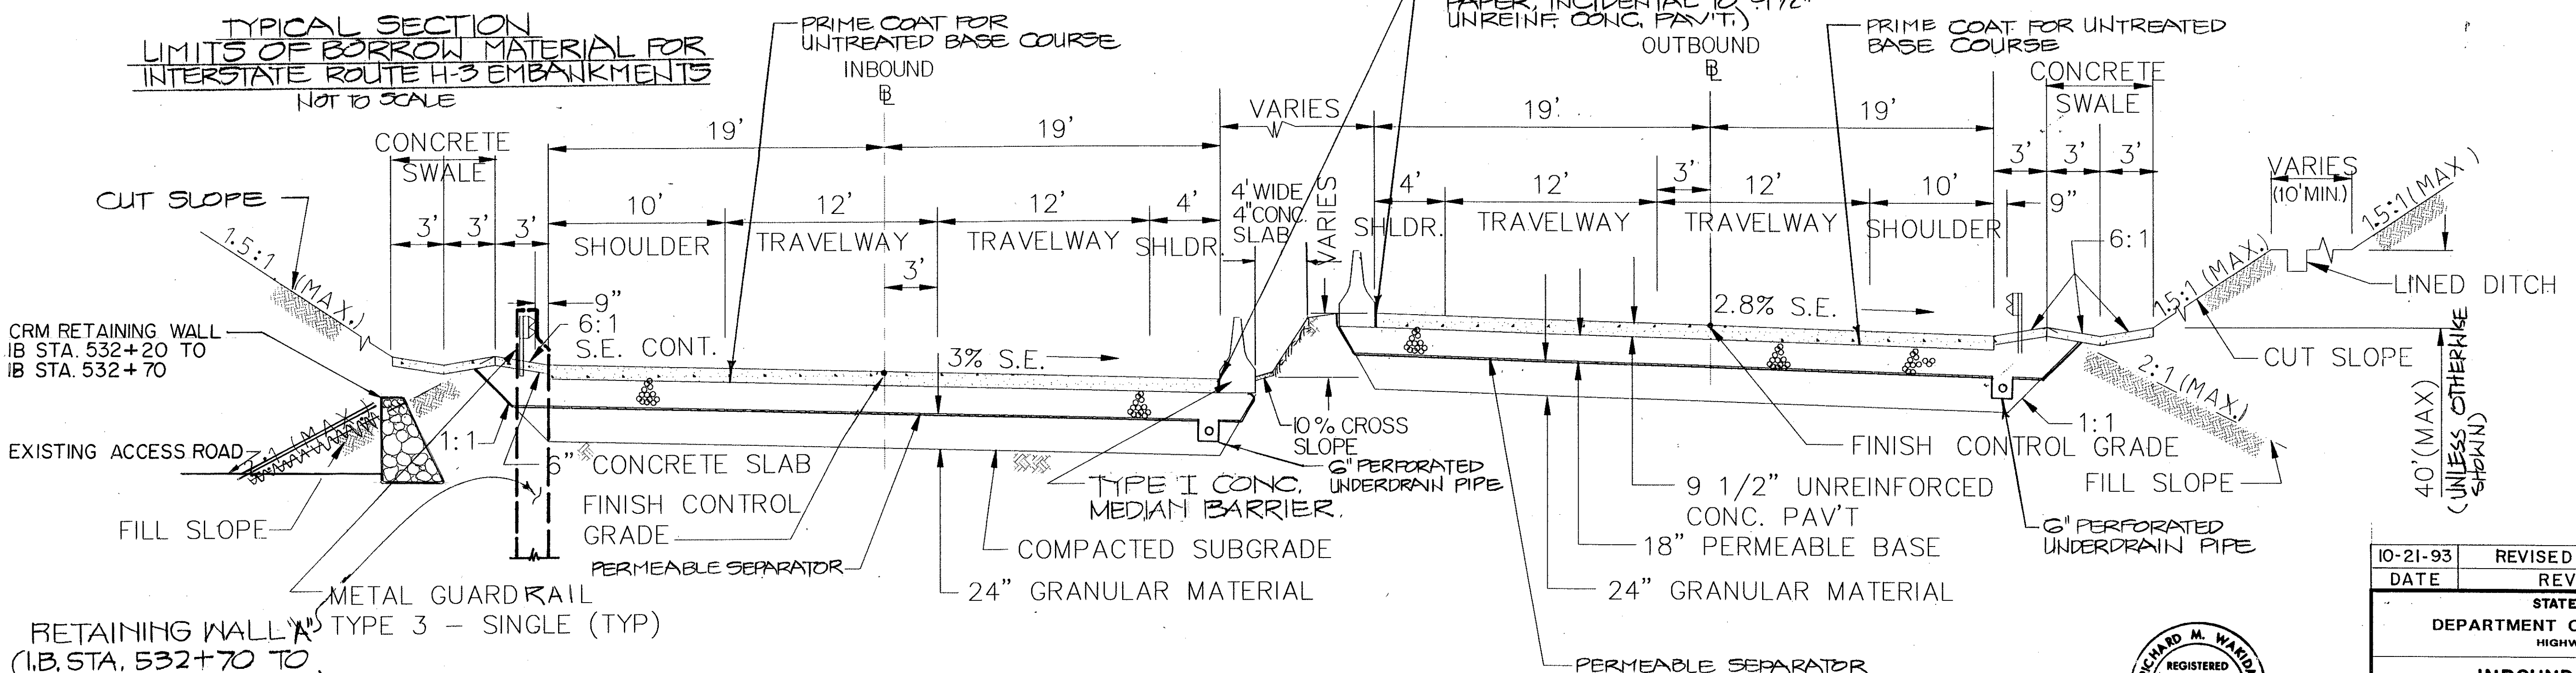

AT GRADE SUPER ELEVATION SECTION

(STA 525+30 IB TO STA 535+00 +/- IB, STA 525+20 OB TO STA 535+00 +/- OB)

DATE	
DESIGNED BY	
DRAWN BY	
CHECKED BY	
NOTED BY	
DATE	

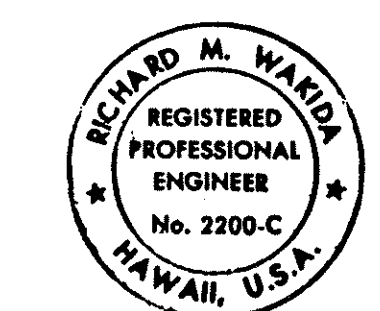

NOTE:
ALL GRADED AREAS
SHALL BE HYDRO-
MULCHED.

THIS WORK WAS PREPARED BY ME
OR UNDER MY SUPERVISION.
SIGNATURE DATE

10-21-93	REVISED SECTION
DATE	REVISION
STATE OF HAWAII DEPARTMENT OF TRANSPORTATION HIGHWAYS DIVISION	
INBOUND & OUTBOUND TYPICAL ROADWAY SECTIONS - 2	
INTERSTATE ROUTE H-3 F.A.I. PROJECT NO. I-H3-1(69) & (70)	
SCALE: NOT TO SCALE	DATE: MARCH, 1992
SHEET No. C2 OF 95 SHEETS	