


INDEX TO DRAWINGS	
SHEET NO.	DESCRIPTION
1	TITLE SHEET
2	STANDARD PLANS SUMMARY
3	PROJECT WORK AREA MAP
4 - 14	TYPICAL SECTIONS
15 - 67	ALIGNMENT
① 68 ② 122	ROADWAY CONSTRUCTION/DRAINAGE & GRADING
123 - 131	EROSION CONTROL
132 - 192	SIGNING & PAVEMENT MARKINGS
193 - 218	TRAFFIC CONTROL
219 - 229	SYSTEMS
230 - 255	HIGHWAY LIGHTING
256 - 290	STRUCTURAL
291 - 312	CROSS SECTIONS
313 - 325	REFERENCES

Plan Sht. Nos. ① 105-I, 105S-2, 105S-3 &  
 ② 114S-I are supplementary sheets to this  
 project, added during Addendum & "AS BUILT"  
 postings.

TOTAL SHEET COUNT after Addendum &  
 "AS BUILT" postings is 329 sheets.

STATE OF HAWAII  
 DEPARTMENT OF TRANSPORTATION  
 HIGHWAYS DIVISION  
 HONOLULU, HAWAII  
 "AS-BUILT"  
 PLANS FOR  
 CONSTRUCTION OF A PORTION OF  
 INTERSTATE ROUTE H-3  
 H-3 - HALAWA INTERCHANGE  
 FEDERAL AID INTERSTATE PROJECT NO. I-H3-I(74)


DISTRICT OF EWA  
 ISLAND OF OAHU

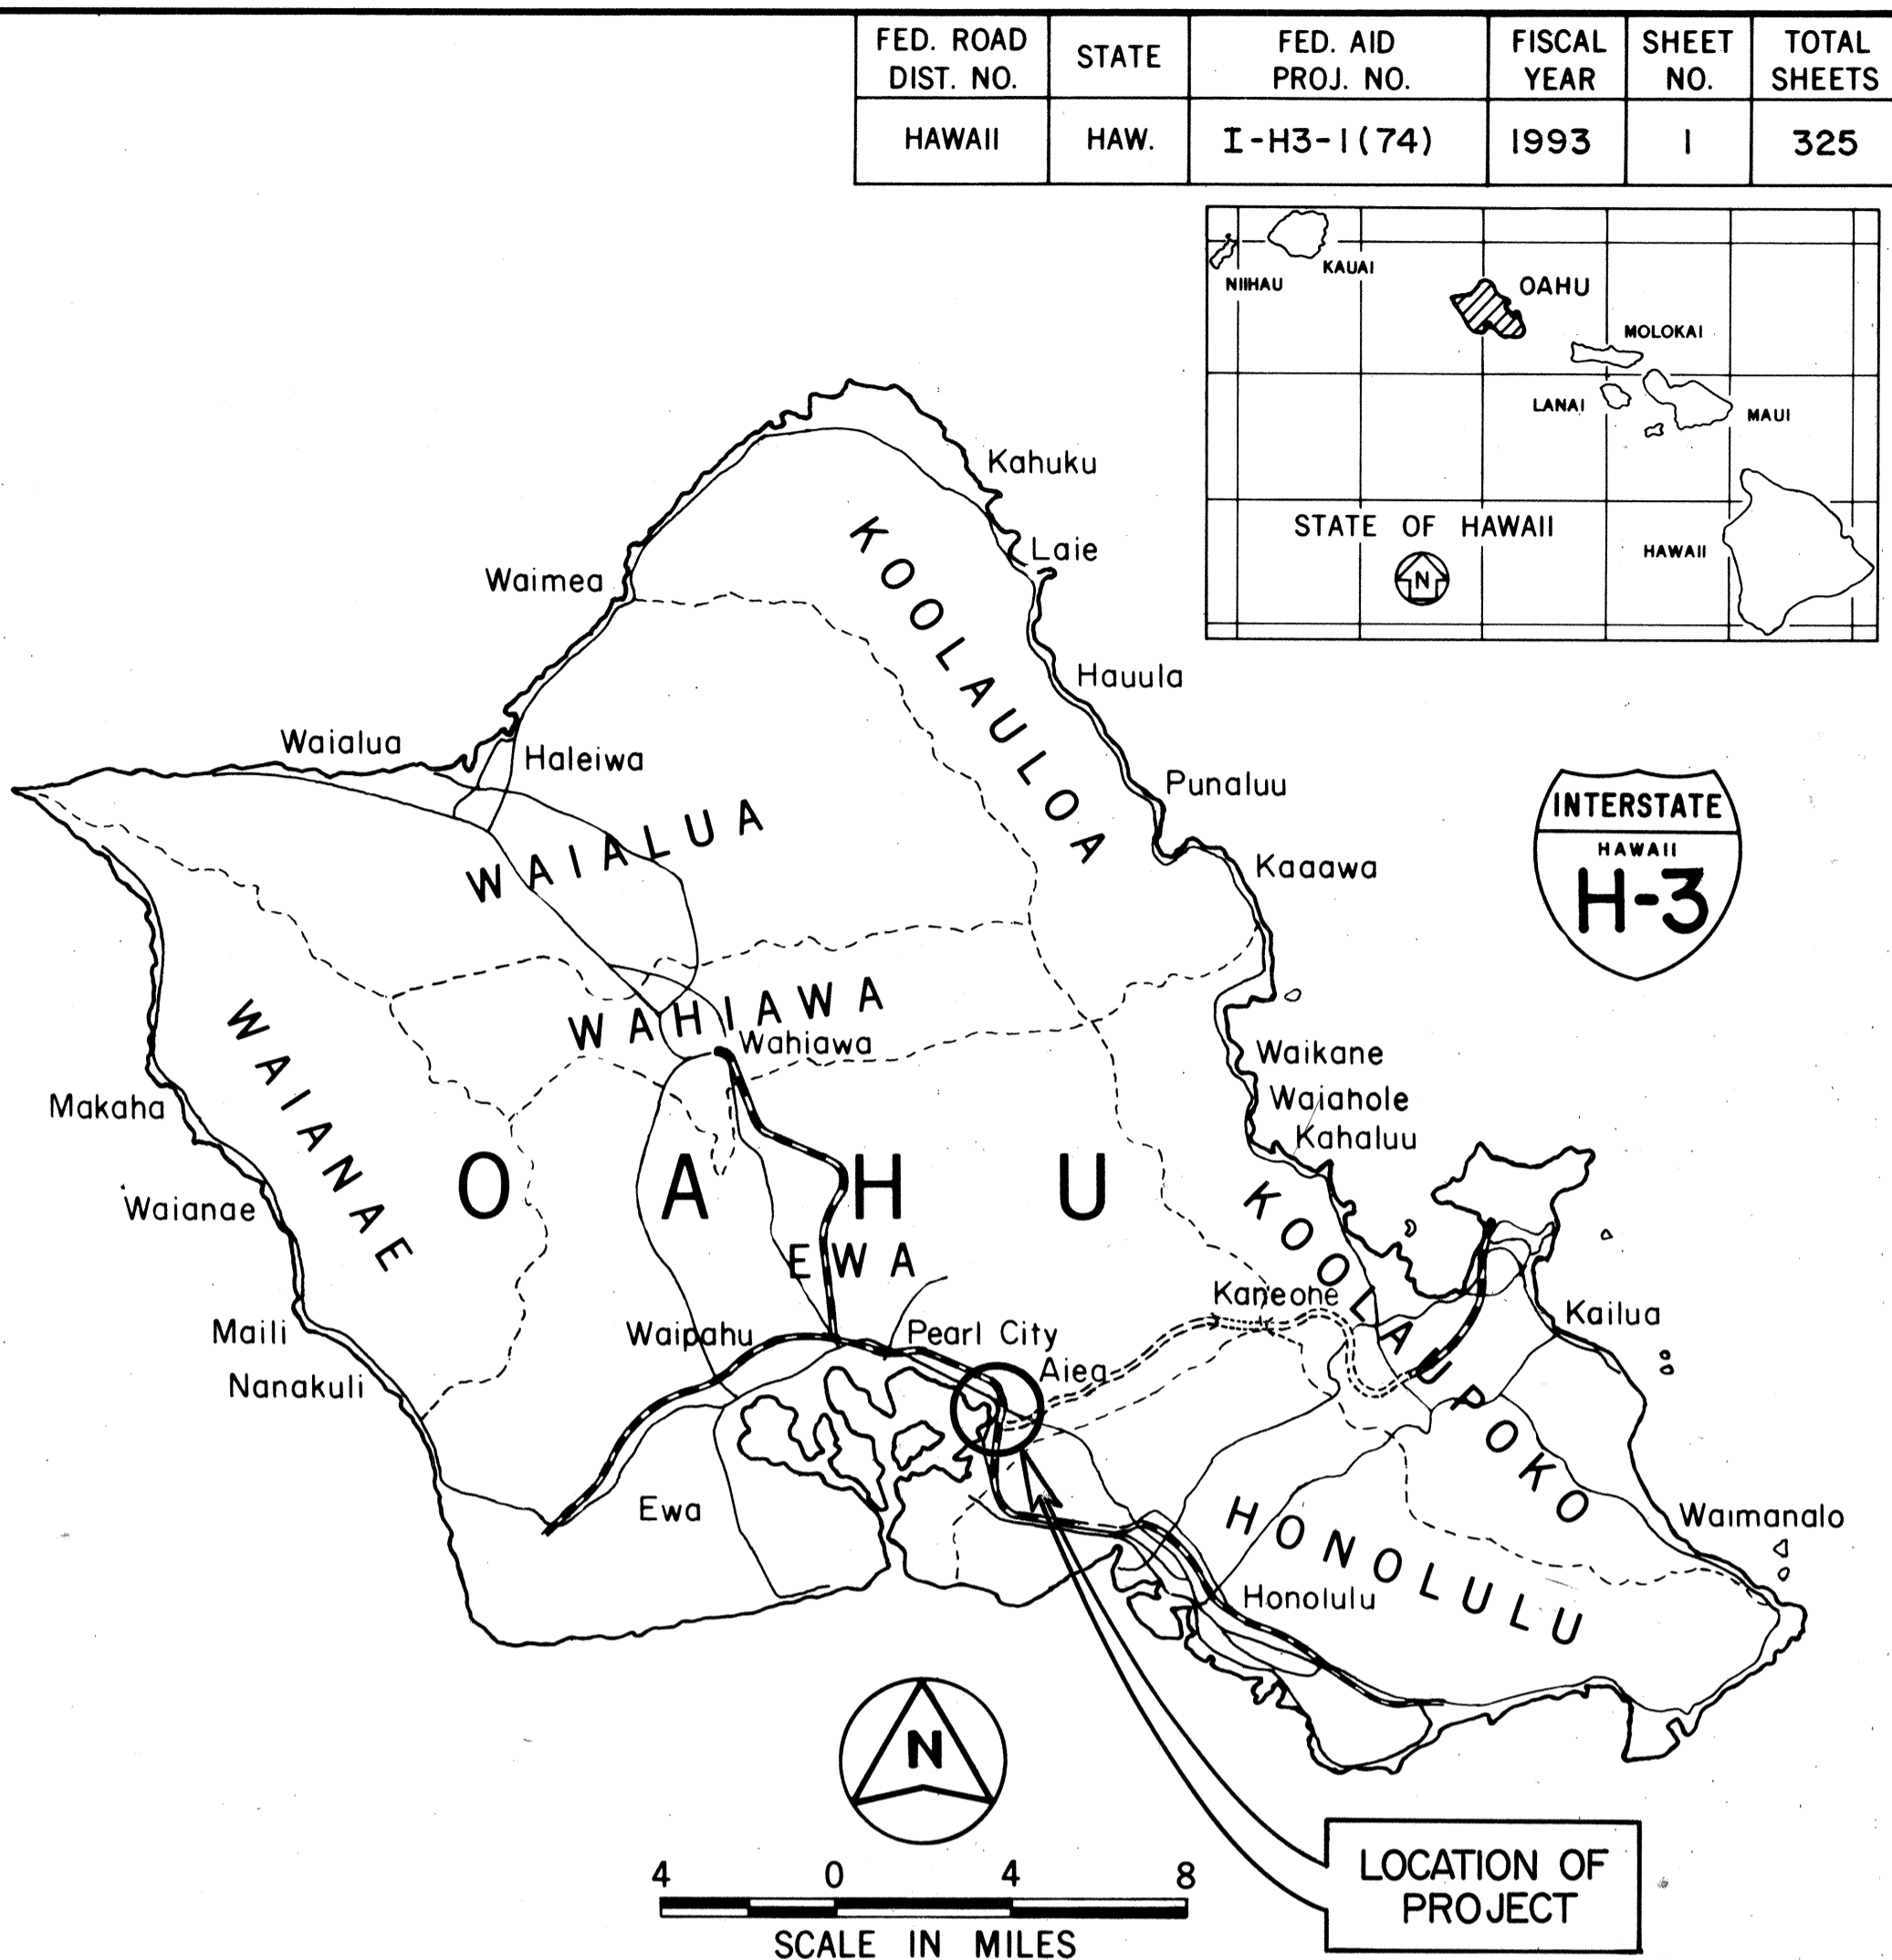

— FEDERAL AID INTERSTATE PROJECTS PREVIOUSLY CONSTRUCTED  
 OR UNDER CONSTRUCTION

DESIGN CLASSIFICATION

DESIGN ADT (2008)	45,220
DHV	4,282
D	76/24
T	2.1%
T24	4.1%
V	60 MPH

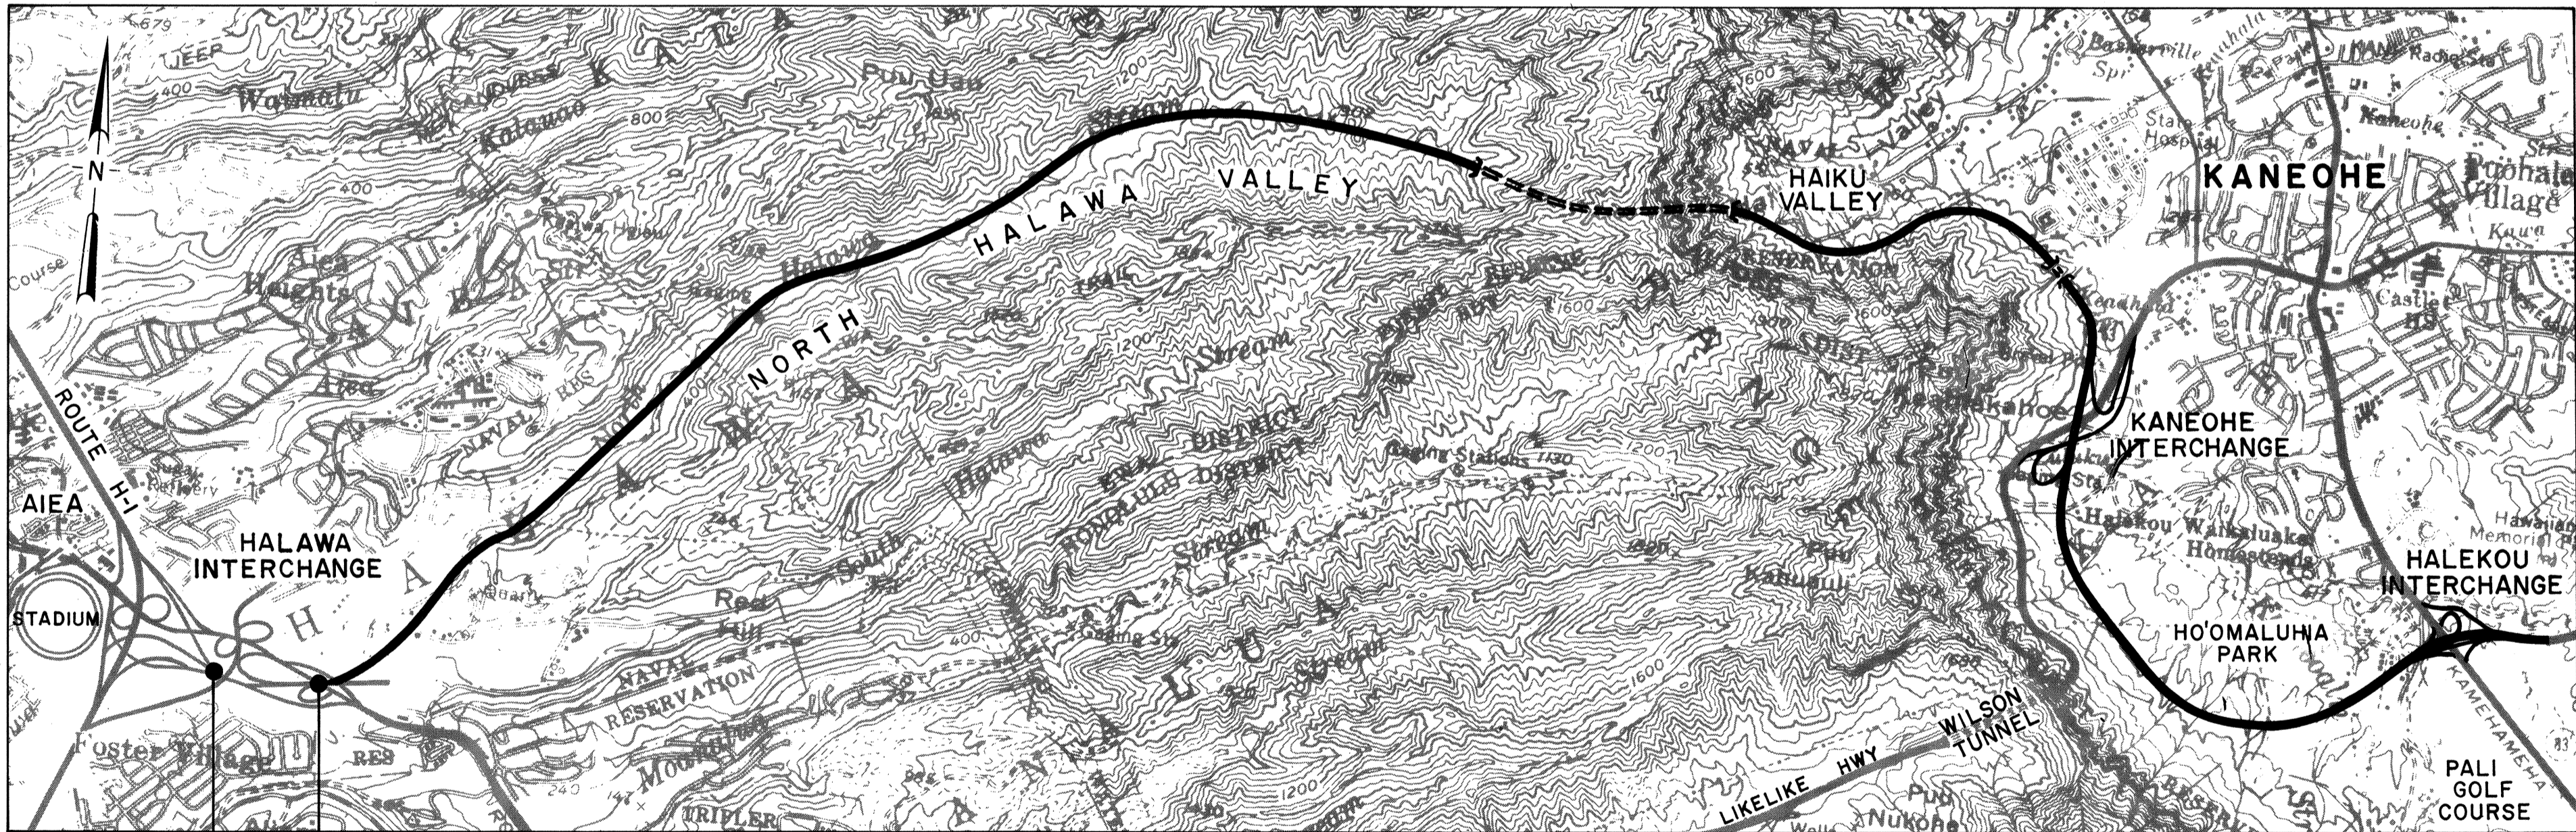

BEGIN PROJECT  
 H-3 STA. 252+33.06

END PROJECT  
 H-3 STA. 269+18.86 (HALAWA I/C)  
 = H-3 STA. 333+27.85  
 (HALAWA QUARRY VIADUCT)

LAYOUT PLAN

TOTAL LENGTH OF PROJECT = 0.319 MILE

CHANGES MADE DURING CONSTRUCTION HAVE  
 BEEN INCORPORATED ON THESE PLANS EXCEPT  
 CHANGES IN THE ORIGINAL THEORETICAL  
 QUANTITIES. FOR ACTUAL QUANTITIES, REFER TO  
 PROJECT LEDGER AND/OR COMPUTATION BOOK.

RESIDENT ENGINEER

DATE

DEPARTMENT OF TRANSPORTATION  
 FEDERAL HIGHWAY ADMINISTRATION

APPROVED:

DIVISION ADMINISTRATOR DATE

DEPARTMENT OF TRANSPORTATION  
 STATE OF HAWAII

APPROVED:

DIR. OF TRANSPORTATION DATE