

GENERAL NOTES FOR SIGN SUPPORT STRUCTURES

1. DESIGN SPECIFICATIONS:

AASHTO STANDARD SPECIFICATIONS FOR STRUCTURAL SUPPORTS FOR HIGHWAY SIGNS, LUMINAIRES AND TRAFFIC SIGNALS, CURRENT EDITION.

2. DESIGN DATA:

WIND LOADING: DESIGN WIND SPEED = 80 MPH. FOR WIND LOAD NORMAL TO FACE OF SIGN AND TRANSVERSE TO FACE OF SIGN, SEE DESIGN SPECIFICATIONS.

WALKWAYS: SEE NOTES ON SHEET NO. SS11.

ICE LOAD: NONE

STRUCTURAL STEEL: ASTM A36

HIGH STRENGTH BOLTS: ASTM A325 (FRICTION - TYPE CONNECTION)

ALUMINUM MEMBERS: ALUMINUM ALLOY 6061-T6

STEEL PIPE: ASTM A53 TYPE E GRADE B

3. WELDING:

ALL WELDING TO BE CONTINUOUS WELDS AND AS NOTED ON THE PLANS. ALL WELDING SHALL CONFORM TO THE REQUIREMENTS OF ANSI/AASHTO/AWS D1.5-88, "BRIDGE WELDING CODE".

4. MATERIALS:

- A. SIGN SUPPORT BOX TRUSS MEMBERS AND SUPPORTING POSTS; SHEET METAL SIDING AND EDGINGS; CONNECTION BOLTS; NUT AND WASHERS; TO BE STRUCTURAL STEEL. ALL SURFACES SHALL BE HOT-DIPPED GALVANIZED AFTER FABRICATION PRIOR TO PAINTING. SEE SPECIFICATIONS AND "RIBBED SHEET METAL NOTES" ON SHEET NO. SS13.
- B. GALVANIZED SURFACES OF OVERHEAD SIGN SUPPORT STRUCTURES (NOTE A. ABOVE) SHALL BE PAINTED TO WARM GRAY COLOR. SEE SPECIFICATIONS.
- C. CONTACT SURFACES IN HIGH STRENGTH (H.S.) BOLT CONNECTIONS SHALL NOT BE PAINTED. THE GALVANIZING ON THESE SURFACES SHALL BE LIGHTLY SCORED BY WIRE BRUSHING PRIOR TO ASSEMBLY.
- D. HIGH STRENGTH BOLTS SHALL BE GALVANIZED, FURNISHED AND INSTALLED IN CONFORMANCE WITH CURRENT ASTM A325 WITH LUBRICATED NUTS.
- E. LEVELING GROUT SHALL BE NON-SHRINK AND NON-METALLIC.
- F. ANCHOR BOLTS TO BE ASTM A449, GALVANIZED.
- G. ALUMINUM MEMBERS AND SURFACES IN CONTACT WITH STRUCTURAL STEEL SEE NOTE 3 ON SHEET NO. SS3.

5. CONSTRUCTION METHOD:

SEE HAWAII STANDARD SPECIFICATIONS FOR ROAD AND BRIDGE CONSTRUCTION, 1985 EDITION, AASHTO STANDARD SPECIFICATIONS FOR STRUCTURAL SUPPORTS FOR HIGHWAY SIGNS, LUMINAIRES AND TRAFFIC SIGNALS, CURRENT EDITION AND SPECIAL PROVISIONS FOR THIS PROJECT.

6. GENERAL:

- A. PRIOR TO FABRICATION OF THE SIGN SUPPORT STRUCTURES, THE CONTRACTOR SHALL VERIFY IN THE FIELD THE EXACT LOCATION OF EACH OF THE ANCHOR BOLTS INSTALLED AND THE POST ELEVATION AT THE TOP OF THE SUPPORTING CONCRETE.
- B. PAYMENT FOR THE OVERHEAD SIGN SUPPORT STRUCTURES SHALL BE MADE AS DESCRIBED IN THE SPECIAL PROVISIONS.
- C. ALL SIGN SUPPORT STRUCTURES ARE VIEWED IN THE DIRECTION OF TRAFFIC, UNLESS NOTED OTHERWISE.
- D. THE CONTRACTOR SHALL PROBE TO LOCATE THE EXISTING UTILITIES AND SHALL NOTIFY THE RESPECTIVE OWNERS PRIOR TO COMMENCING WITH FOUNDATION WORK.

7. LEGEND AND ABBREVIATIONS:

&	- AND	KAL.	- KALANIANAOLE
@	- AT	KAM.	- KAMEHAMEHA
ALUM.	- ALUMINUM	LT.	- LEFT
B	- BASELINE	MIN.	- MINIMUM
BOT.	- BOTTOM	O.C.	- ON CENTER
BRG.	- BEARING	O.D.	- OUTSIDE DIAMETER
C	- CENTERLINE	OPNG.	- OPENING
CL.,CLR.	- CLEAR	O/S	- OFFSET
CM	- CHANGEABLE MESSAGE	P	- PLATE
CMS	- CHANGEABLE MESSAGE SIGN	PT	- POINT OF TANGENT
CONC.	- CONCRETE	PVMT.	- PAVEMENT
CONN.	- CONNECTION	RECT.	- RECTANGULAR
CONT.	- CONTINUOUS	RELOC.	- RELOCATED
DIA.	- DIAMETER	REQ'D.	- REQUIRED
DIAG.	- DIAGONAL	RT.	- RIGHT
DO.	- DITTO	SECT.	- SECTION
E.F.	- EACH FACE	SHT.	- SHEET
EQ.	- EQUAL	S.S.	- STAINLESS STEEL
EQ. SPC.	- EQUAL SPACES	STD.	- STANDARD
EXIST.	- EXISTING	STIFF.	- STIFFENER
FLEX.	- FLEXIBLE	SYMM.	- SYMMETRICAL
FM	- FIXED MESSAGE	t., THK.	- THICK
FMS	- FIXED MESSAGE SIGN	TYP.	- TYPICAL
GALV.	- GALVANIZED	ULT.	- ULTIMATE
GR.	- GROUND	VERT.	- VERTICAL
HEX.	- HEXAGONAL	VM	- VARIABLE MESSAGE
H.S.	- HIGH STRENGTH	VMS	- VARIABLE MESSAGE SIGN
JT.	- JOINT	WP	- WEATHERPROOF
		W/	- WITH

FOR LEGEND AND ABBREVIATIONS NOT SHOWN, SEE SHEET NO. G14 & G15.

8. FOUNDATION:

- A. THE WORKING CAPACITY OF 16 1/2" OCTAGONAL PRECAST PILE AT VMS 39 IS 95 KIPS, THE ULTIMATE CAPACITY IS 285 KIPS.
- B. THE ALLOWABLE SOIL BEARING PRESSURE FOR SPREAD FOOTING AT VMS 34 IS 2 KSF.
- C. THE CAPACITIES OF 5'-0" DIAMETER DRILLED SHAFTS ARE AS FOLLOWS:

LOCATION	WORKING CAPACITY (KIPS)	ULTIMATE CAPACITY (KIPS)
CMS 29	85	255
CMS 30	150	450
VMS 33	70	210
VMS 35	105	315
VMS 36	85	255
VMS 37	40	120
VMS 40	60	180
VMS 43	100	300

FOR DETAIL AS-BUILT INFORMATION
REFER TO CONSTRUCTION SUBMITTALS

4/10/92	REVISED NOTE 4B.
DATE	REVISION
STATE OF HAWAII DEPARTMENT OF TRANSPORTATION HIGHWAYS DIVISION	
GENERAL NOTES	
SUPPORT STRUCTURES	
INTERSTATE ROUTE H-3	
F.A.I. PROJECT NO. I-H3-1(65)	
SCALE:	DATE: DEC. 1991
SHEET No. SS1 OF 19 SHEETS	



THIS WORK WAS PREPARED BY ME
OR UNDER MY SUPERVISION.
Hui Pang Chen

DATE	10/24/91
DESIGNED BY	S. KIMURA
TRACED BY	K. WADA
QUANTITIES BY	H.P. CHEN
CHECKED BY	
ORIGINAL PLAN	
NOTEBOOK	
No.	


FED. ROAD DIST. NO.	STATE	FED. AID PROJ. NO.	FISCAL YEAR	SHEET NO.	TOTAL SHEETS
HAWAII	HAW.	I-H3-1(65)	1992	288	309

SIGN NUMBER	STATION & OFFSET	A	D	POST SIZE	POST HT.	TOP OF FOOTING EL.	REMARK **
CMS 34	LIKELIKE HWY. STA. 113+00, O/S=48' LT.	5'-0"	7'-9"	W8 x 31	12'-6"	126.60	NIC
CMS 35	KALANIANA'OLE HWY. STA. 215+00, O/S=0'	7'-0"	8'-6"	W8 x 31	14'-0"	353.71	NIC
CMS 36	KAMEHAMEHA HWY. STA. 143+85, O/S=49' LT.	5'-0"	8'-6"	W8 x 31	14'-0"	294.40	NIC
CMS 37	HALONA ST. STA. 9+60, O/S=38' LT.	5'-0"	7'-9"	W8 x 31	12'-6"	15.50	NIC


REMARK ** - FABRICATION OF SIGN & INSTALLATION OF POST NIC

- NOTES:
- CONCRETE FOR FOOTING SHALL BE CLASS A.
 - REINFORCING STEEL SHALL BE ASTM A615 GRADE 60.

3/8/96	REV. PER DCN 65-044
DATE	REVISION
STATE OF HAWAII DEPARTMENT OF TRANSPORTATION HIGHWAYS DIVISION	
DETAILS FOR CMS 34 TO 37	
SUPPORT STRUCTURES INTERSTATE ROUTE H-3 F.A.I. PROJ. NO. I-H3-1(65)	
SCALE: AS SHOWN	DATE: DEC. 1991
SHEET No. SS2 OF 19 SHEETS	

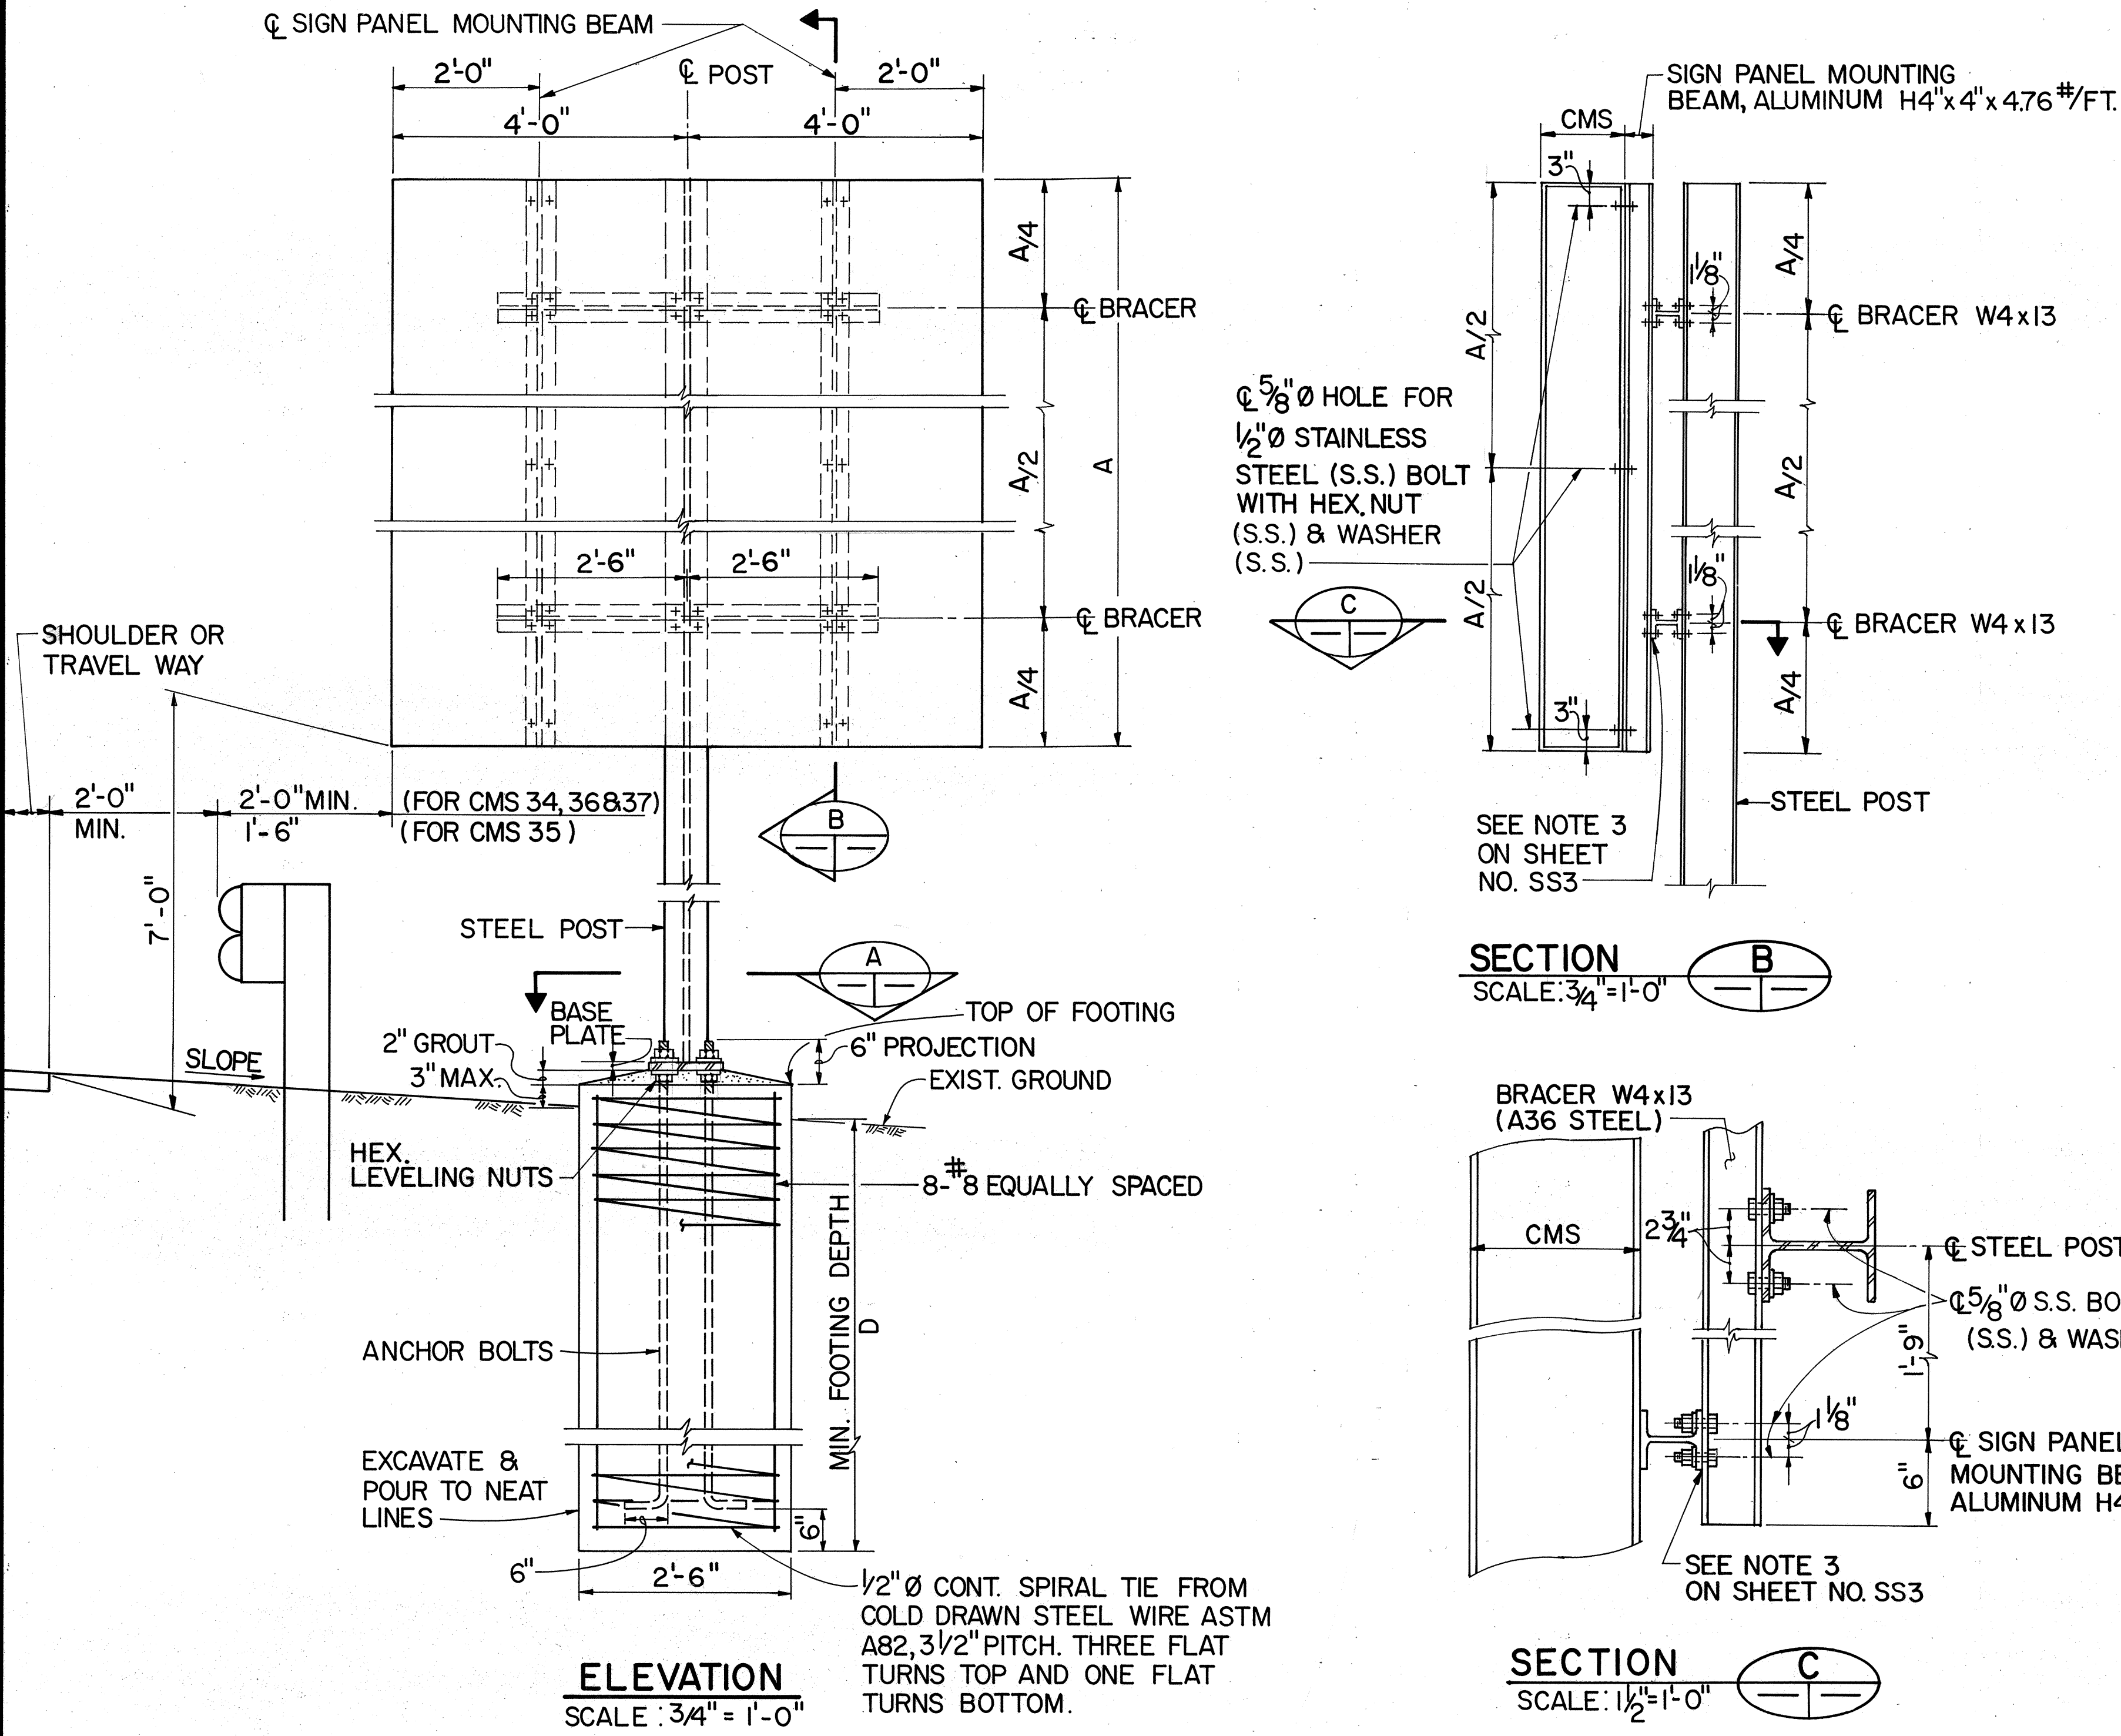

CMS 34 THROUGH CMS 37 AND ASSOCIATED SUPPORT STRUCTURES NOT INSTALLED BY THIS CONTRACT

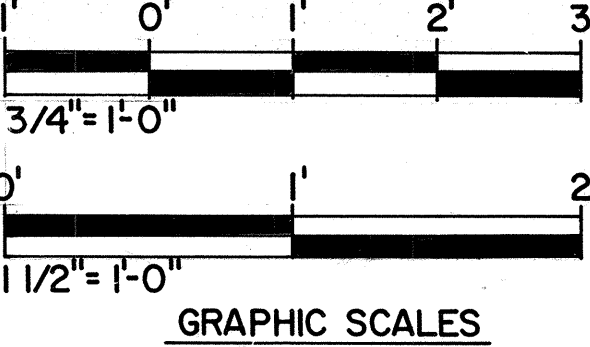

HUI PANG CHEN
REGISTERED PROFESSIONAL ENGINEER
No. 3865-S
HAWAII, U.S.A.
THIS WORK WAS PREPARED BY ME OR UNDER MY SUPERVISION.
Hui Pang Chen











ORIGINAL PLAN	DATE
DRAWN BY	DATE
TRACED BY	DATE
NOTED BY	DATE
CHECKED BY	DATE

POST MOUNTED SIGN DETAIL

FED. ROAD DIST. NO.	STATE	FED. AID PROJ. NO.	FISCAL YEAR	SHEET NO.	TOTAL SHEETS
HAWAII	HAW.	I-H3-1(65)	1992	289	309

NOTES:

- ALL EXISTING SIGN PANEL MOUNTING BRACKETS AT THE DESIGNATED CMS LOCATIONS, IF ANY, SHALL BE REMOVED AND REPLACED BY CMS PANEL MOUNTING BRACKETS AS SHOWN.
- THE DIMENSIONS FOR HEIGHT OF EXISTING TRUSS AND LOCATIONS OF CMS PANEL MOUNTING BRACKETS SHALL BE VERIFIED IN FIELD PRIOR TO FABRICATION OF CMS PANEL & MOUNTING BRACKET.
- CONTACT SURFACE BETWEEN STRUCTURAL STEEL AND ALUMINUM SHALL BE SEPARATED WITH MIN. 1/16" THICK NEOPRENE GASKET.
- FOR CMS PANEL PROVISION, SEE NOTE 'B' ON SHEET NO.SS14.

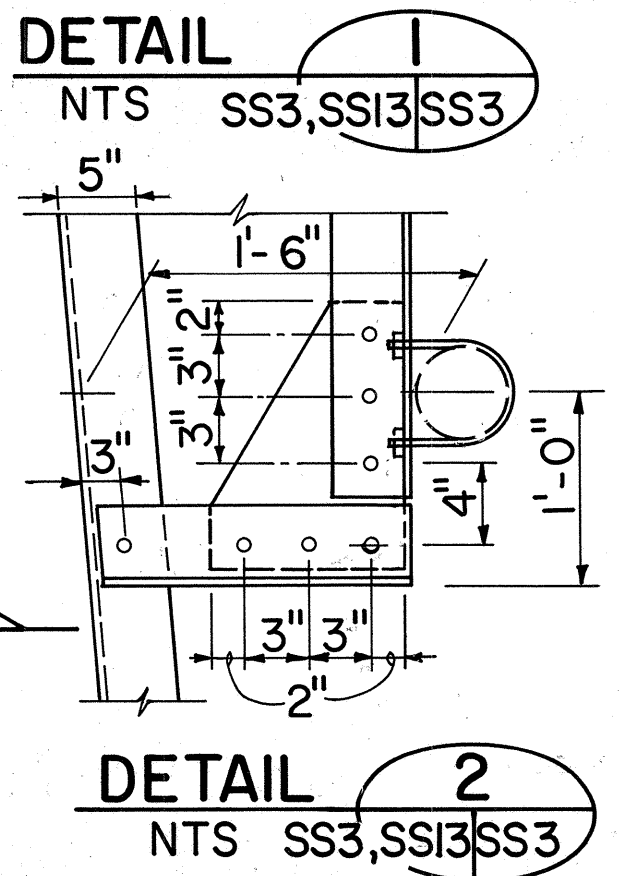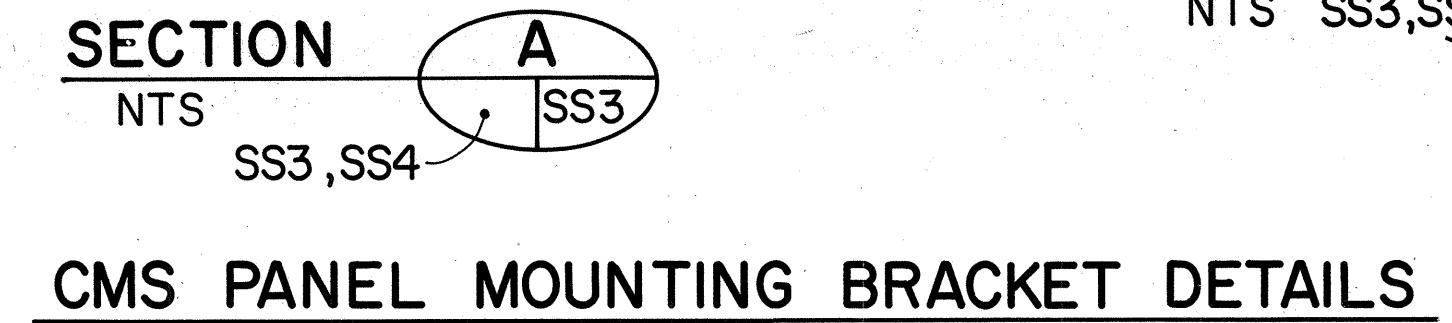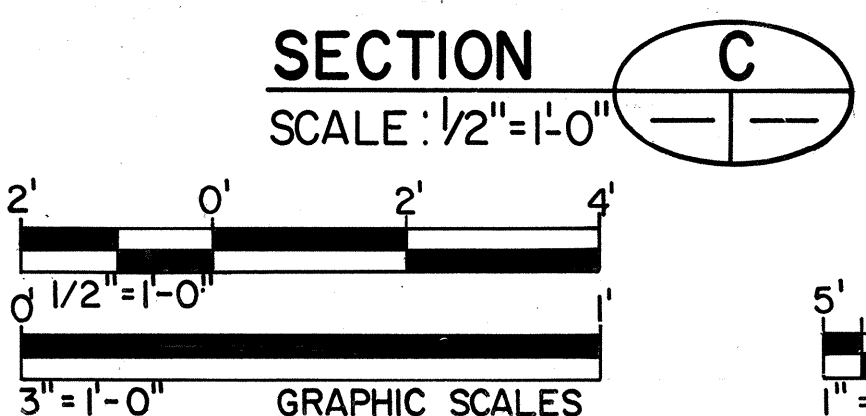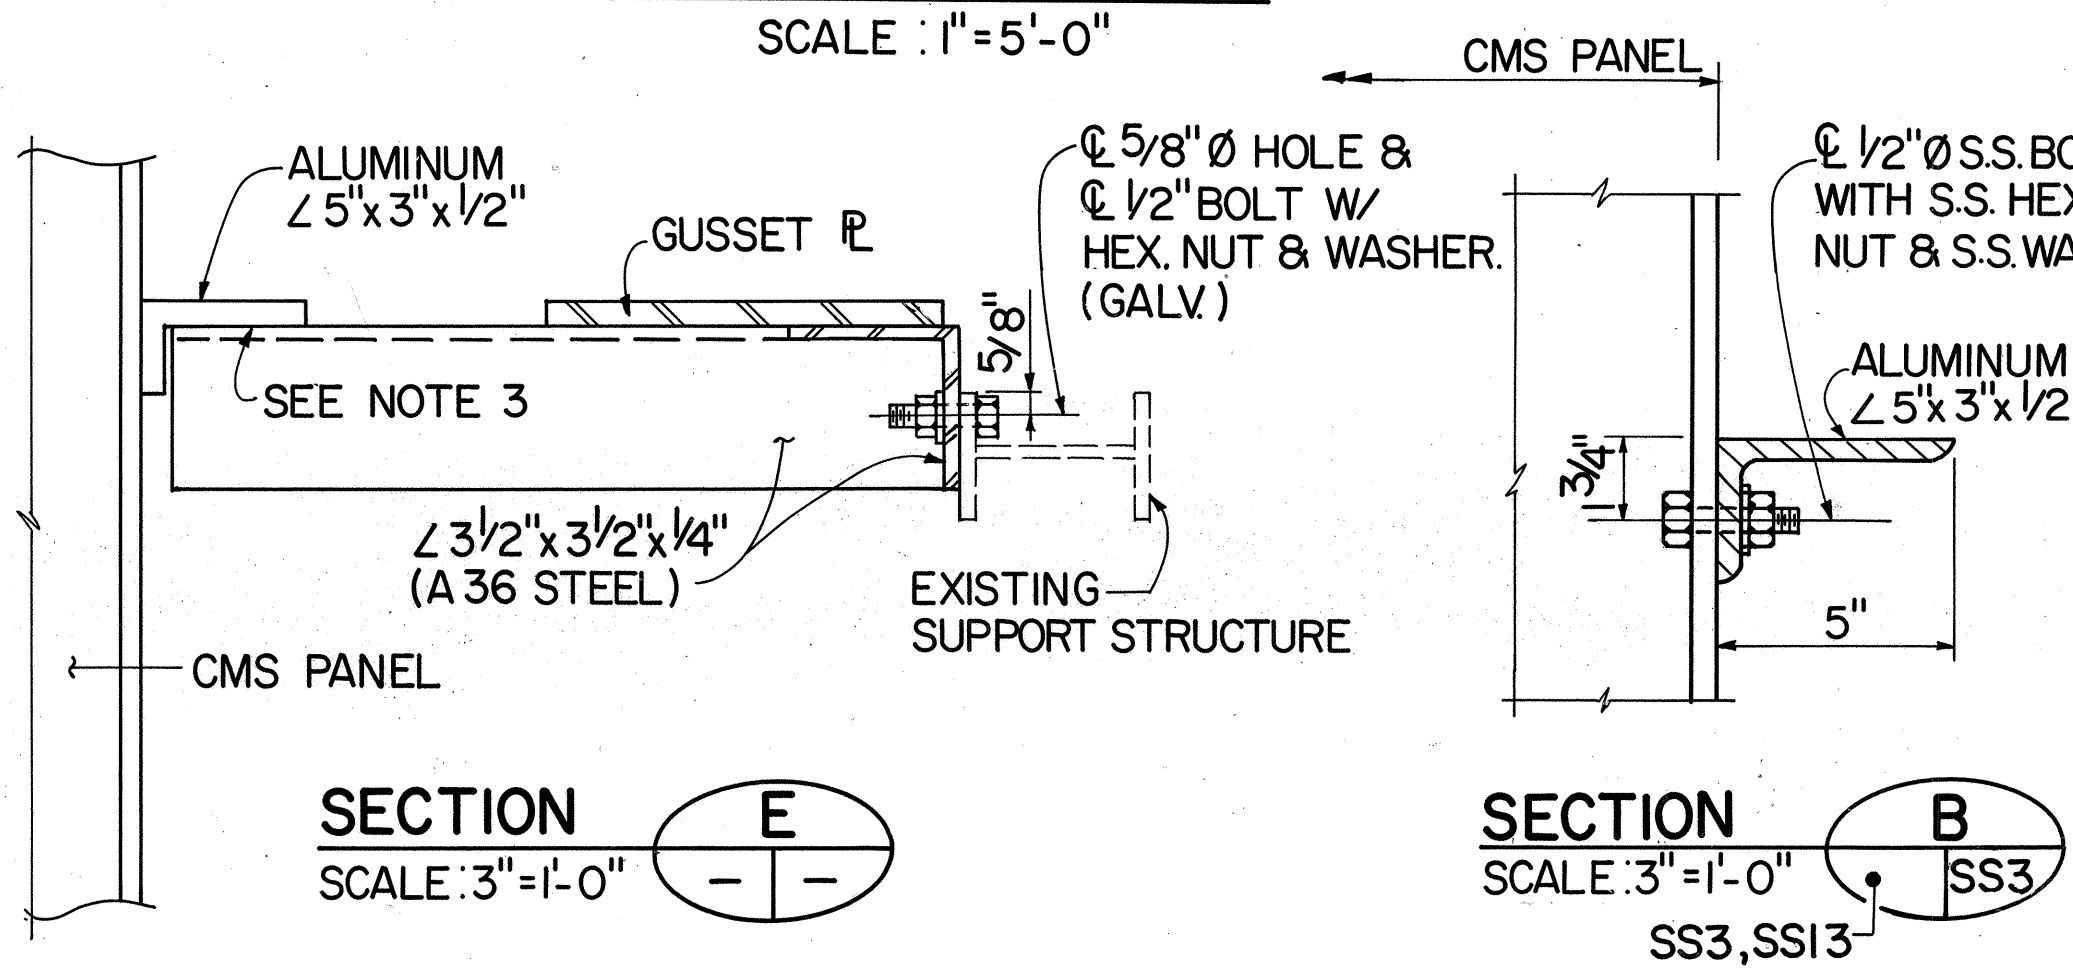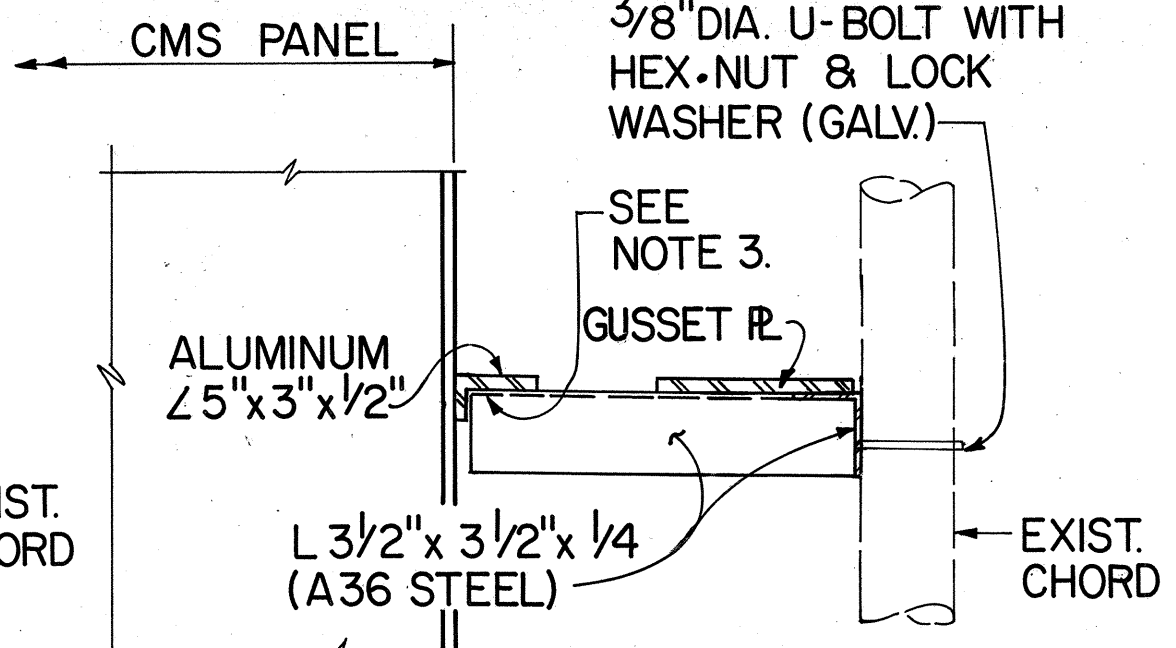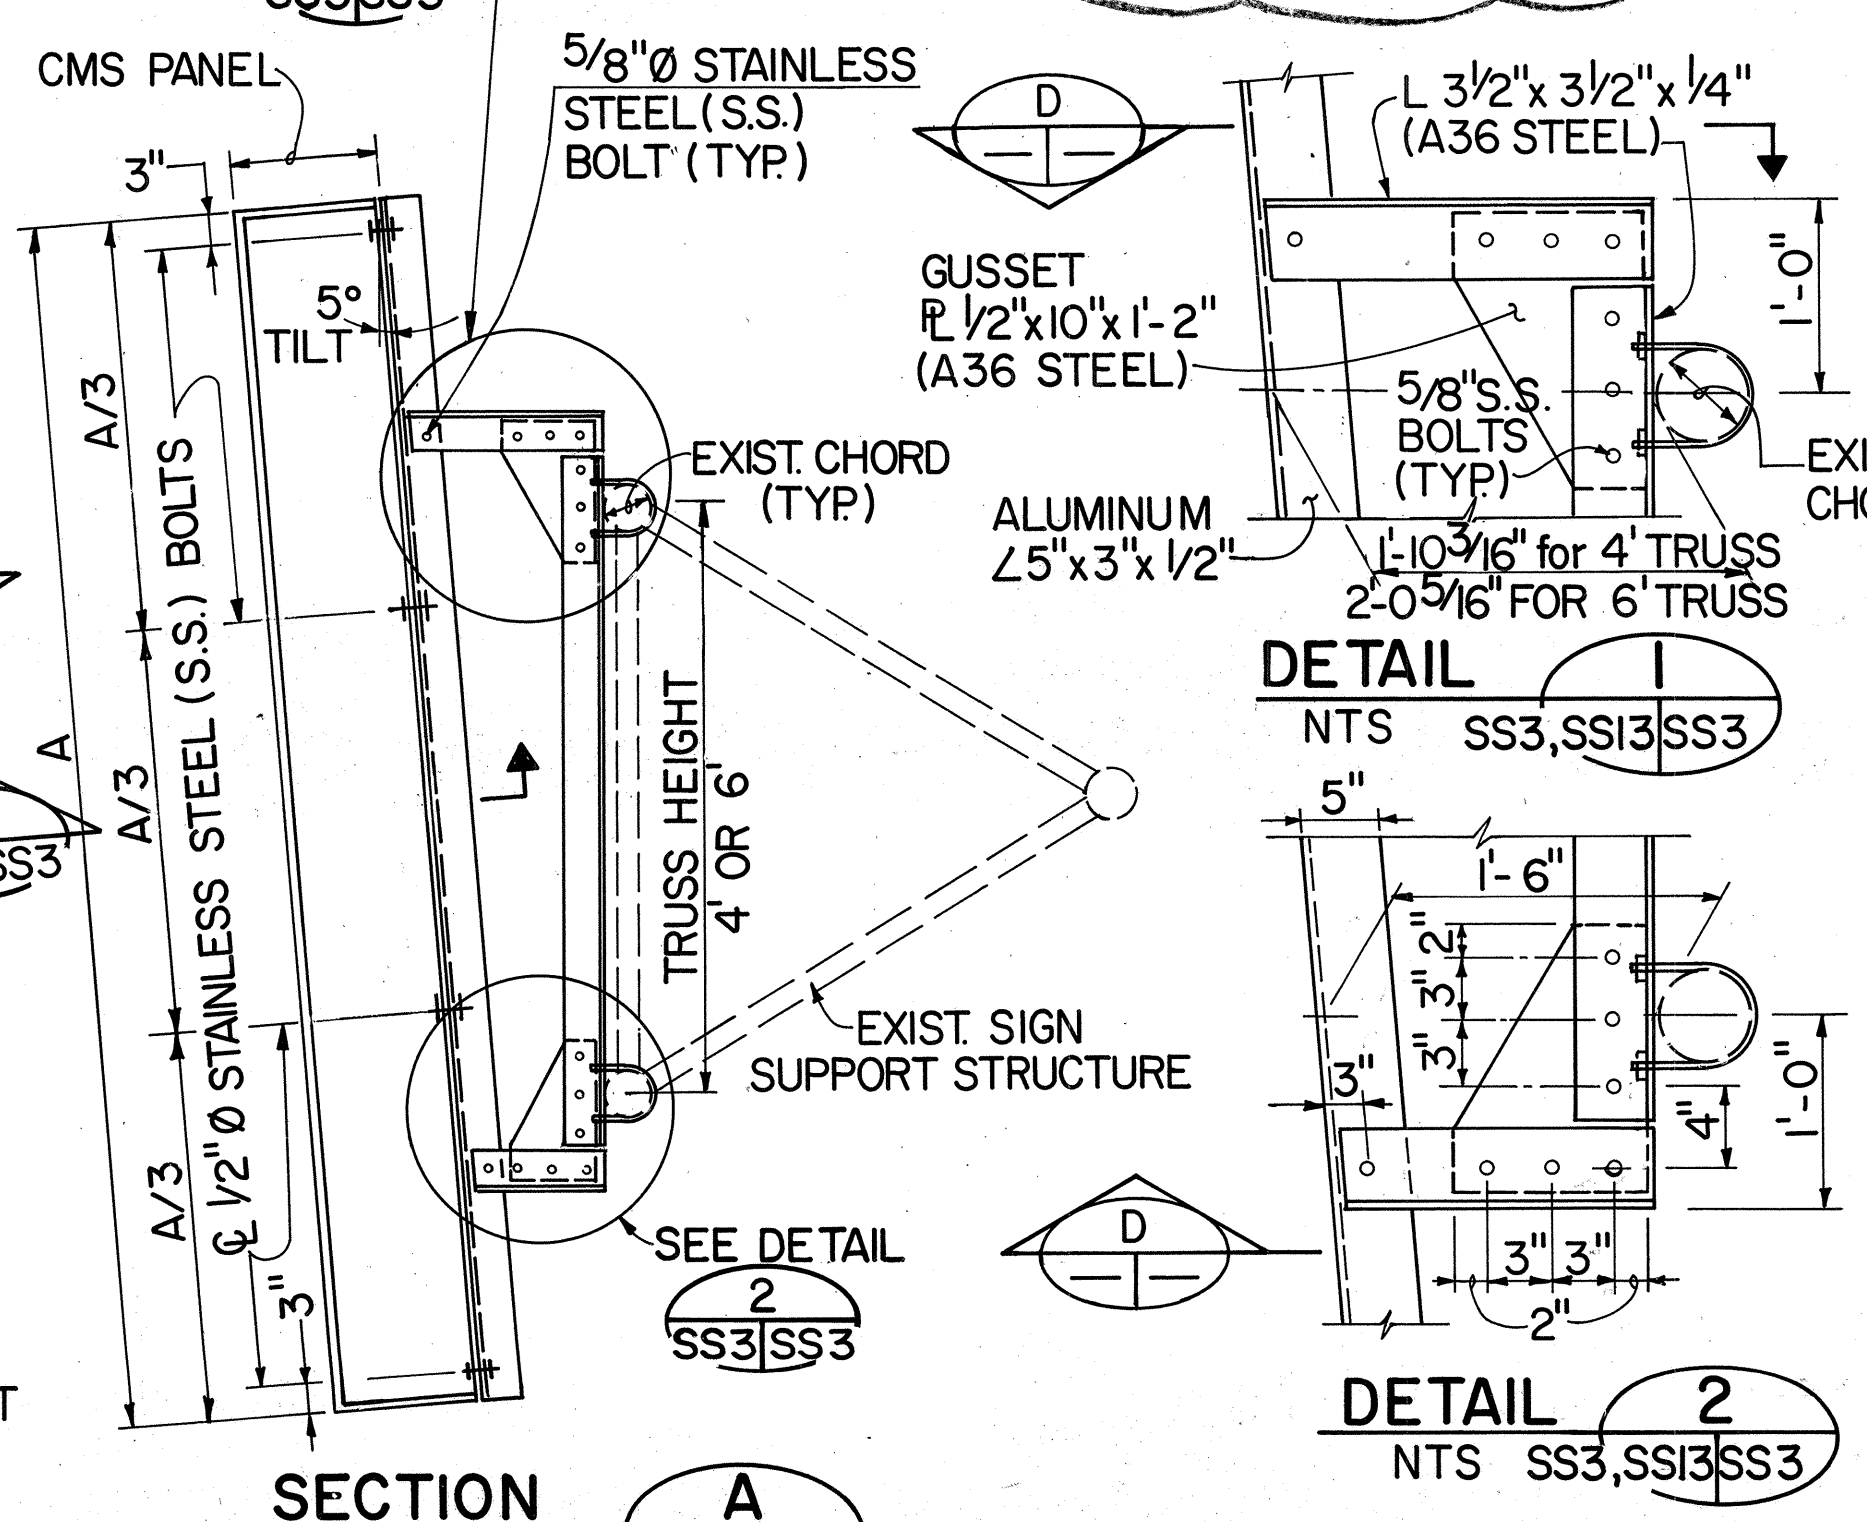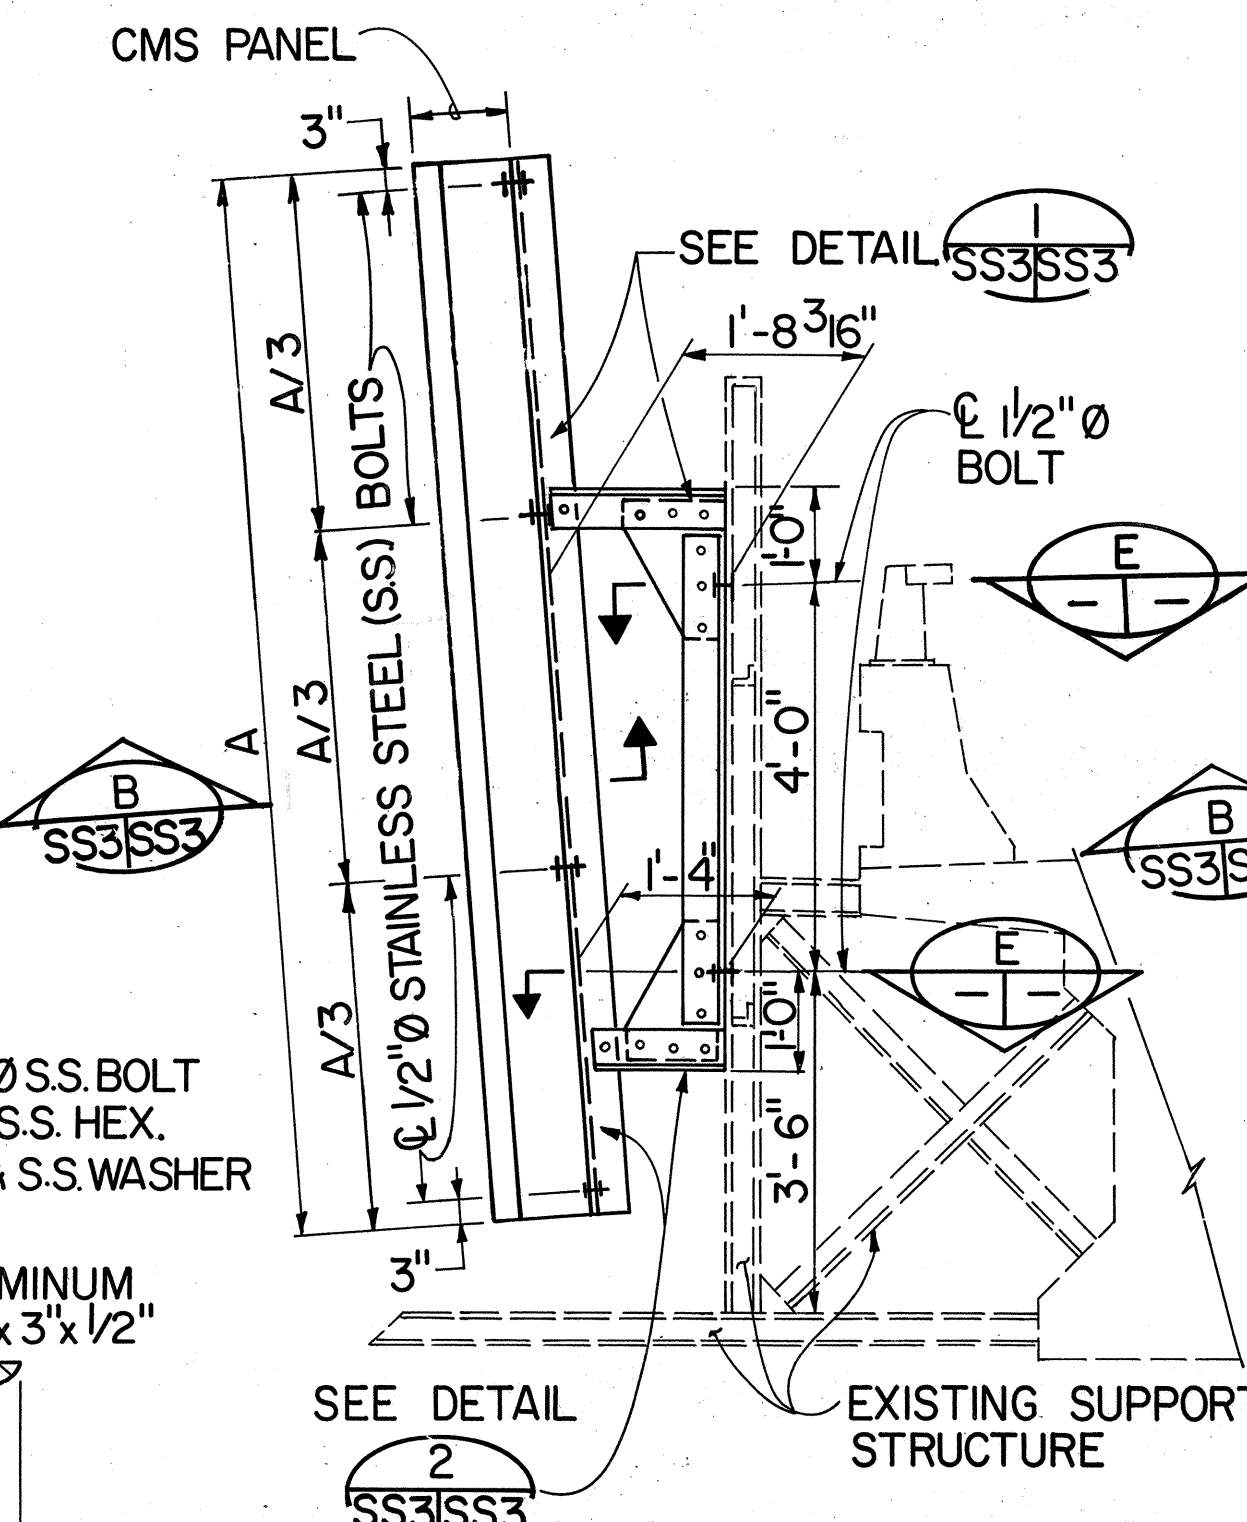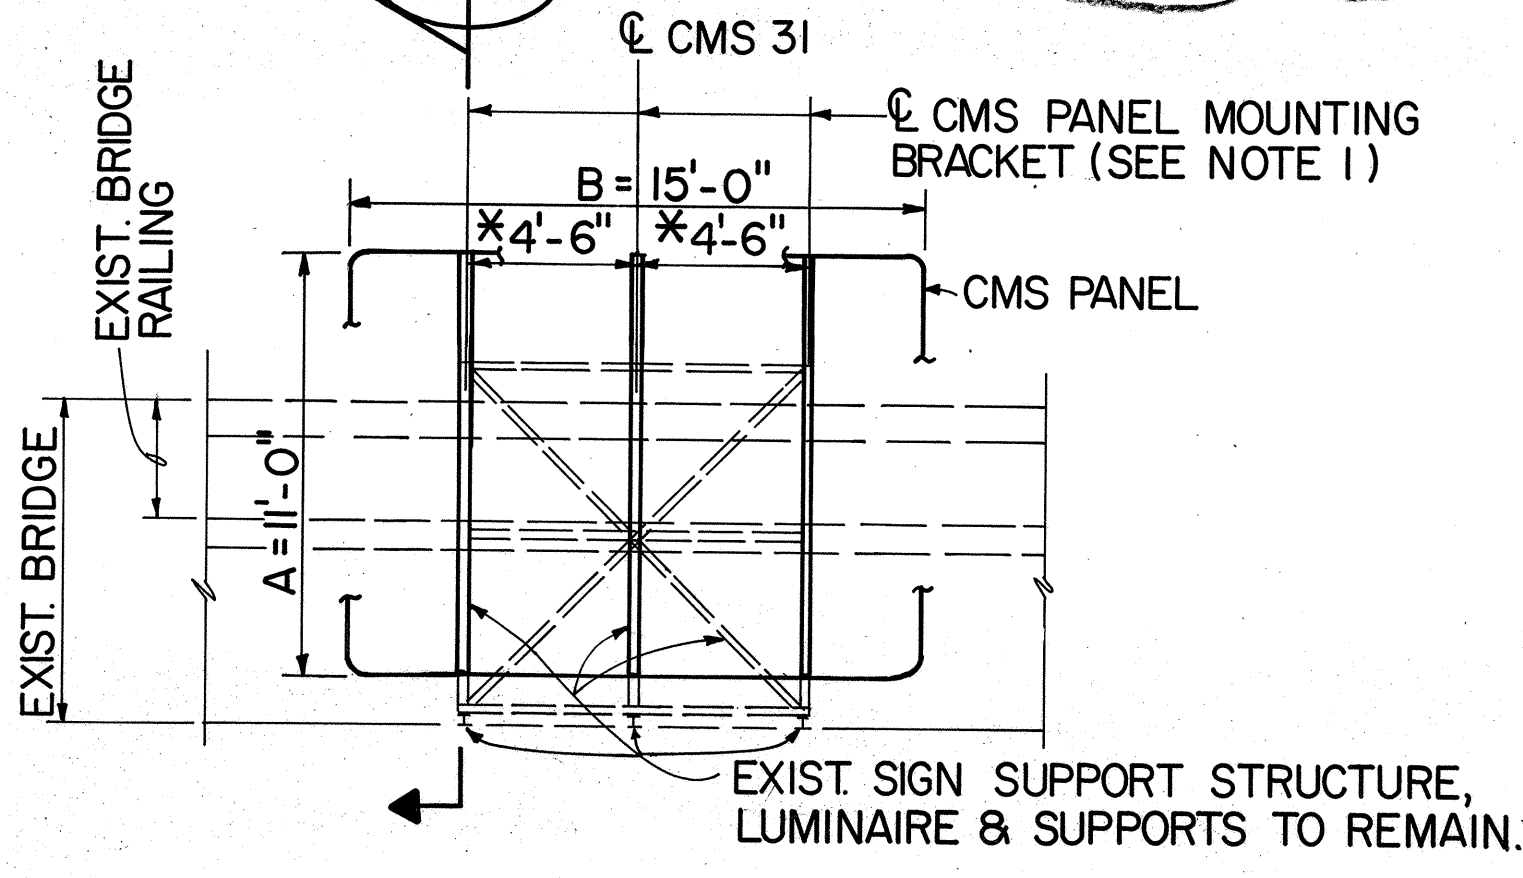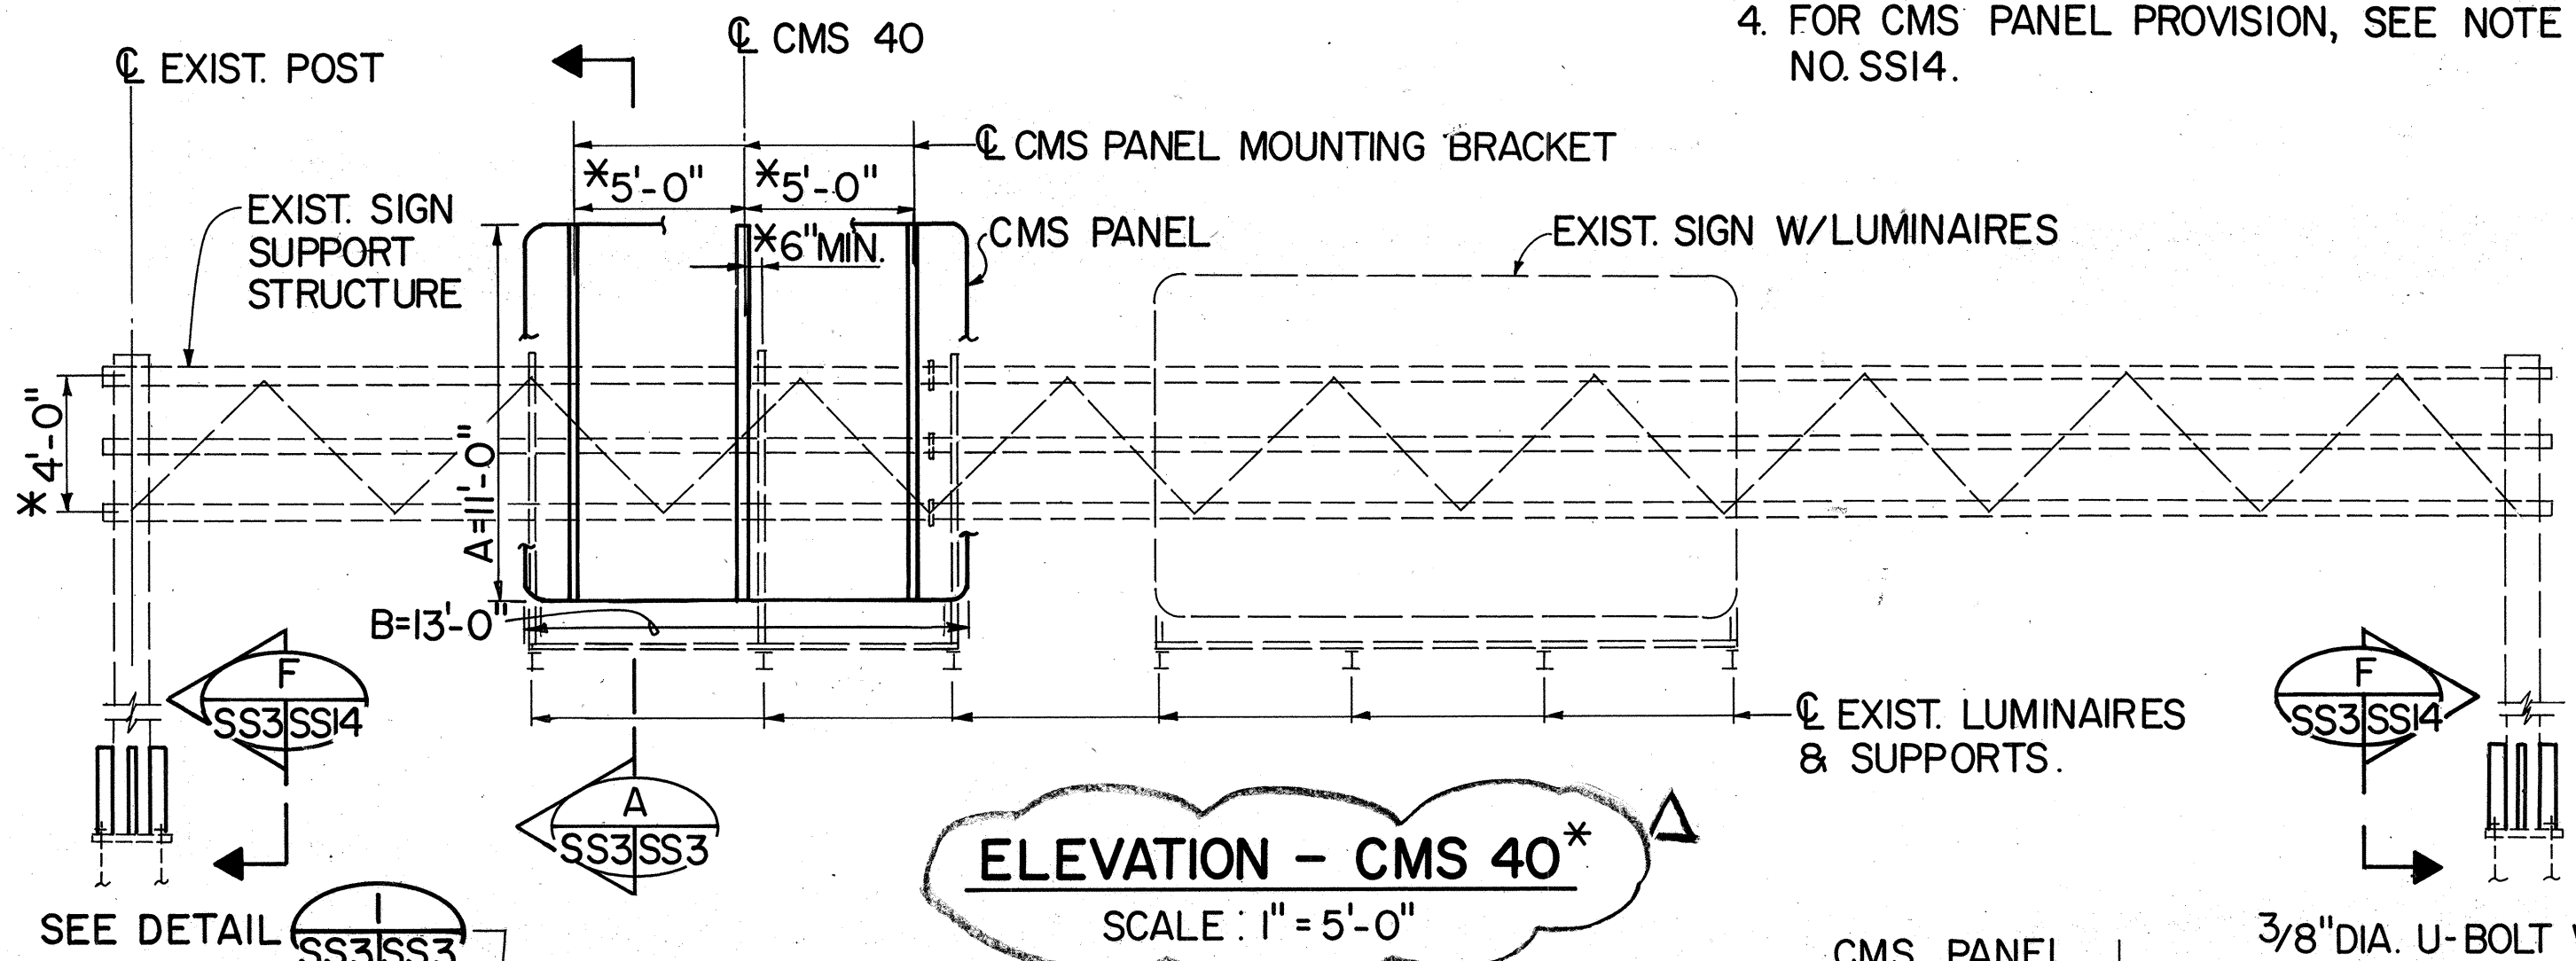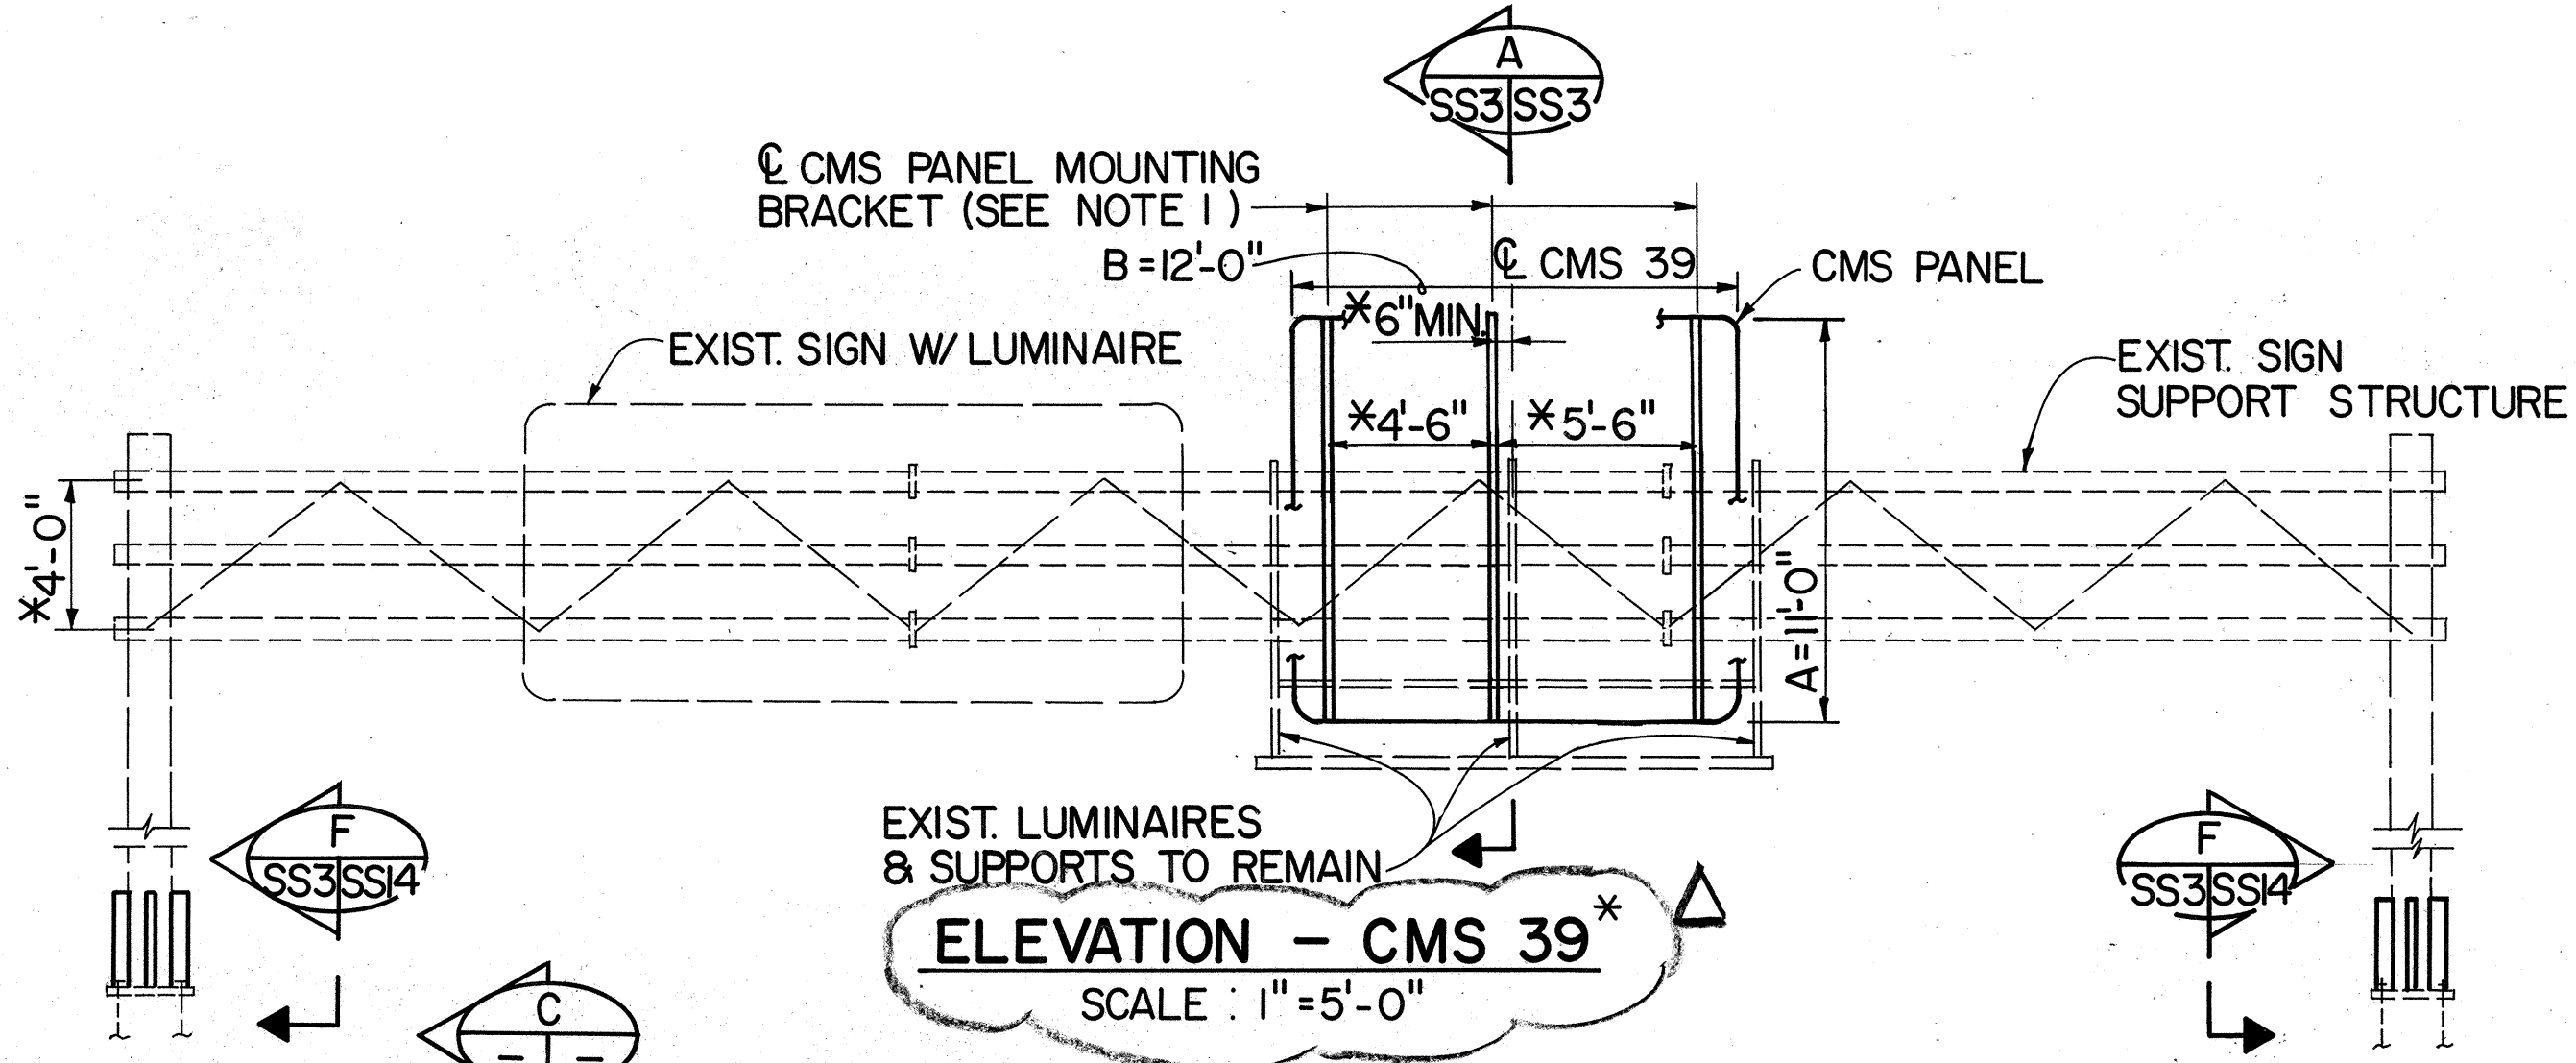

* INSTALLATION OF CMS AND PANEL MOUNTING BRACKET NIC

3/8/96	REV. PER DCN 65-044
3/31/94	DELETED CMS 38 ELEVATION PER DCN 65-027
DATE	REVISION


STATE OF HAWAII
DEPARTMENT OF TRANSPORTATION
HIGHWAYS DIVISION

DETAILS FOR CMS 31, 38 TO 40

SUPPORT STRUCTURES
INTERSTATE ROUTE H-3
F.A.I. PROJ. NO. I-H3-1(65)

SCALE: AS SHOWN DATE: DEC. 1991

SHEET NO.SS3 OF 19 SHEETS








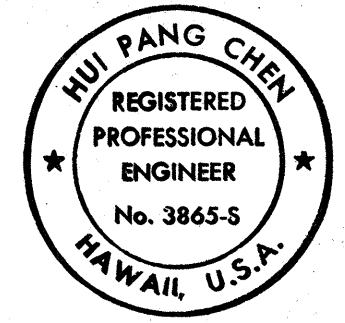


THIS WORK WAS PREPARED BY ME OR UNDER MY SUPERVISION.
Hui Pang Chen


DATE	5/92
SURVEY PLOTTED BY	G.D. TELONG
DRAWN BY	G.D. TELONG
DESIGNED BY	L. ABE
CHECKED BY	H.P. CHEN
NO.	

FED. ROAD DIST. NO.	STATE	FED. AID PROJ. NO.	FISCAL YEAR	SHEET NO.	TOTAL SHEETS
HAWAII	HAW.	I-H3-1 (65)	1992	290	309


NOTES:
 1. SEE NOTES 1,3 & 4 ON SHEET NO. SS3.
 *2: SEE NOTE 2 ON SHEET NOSS3

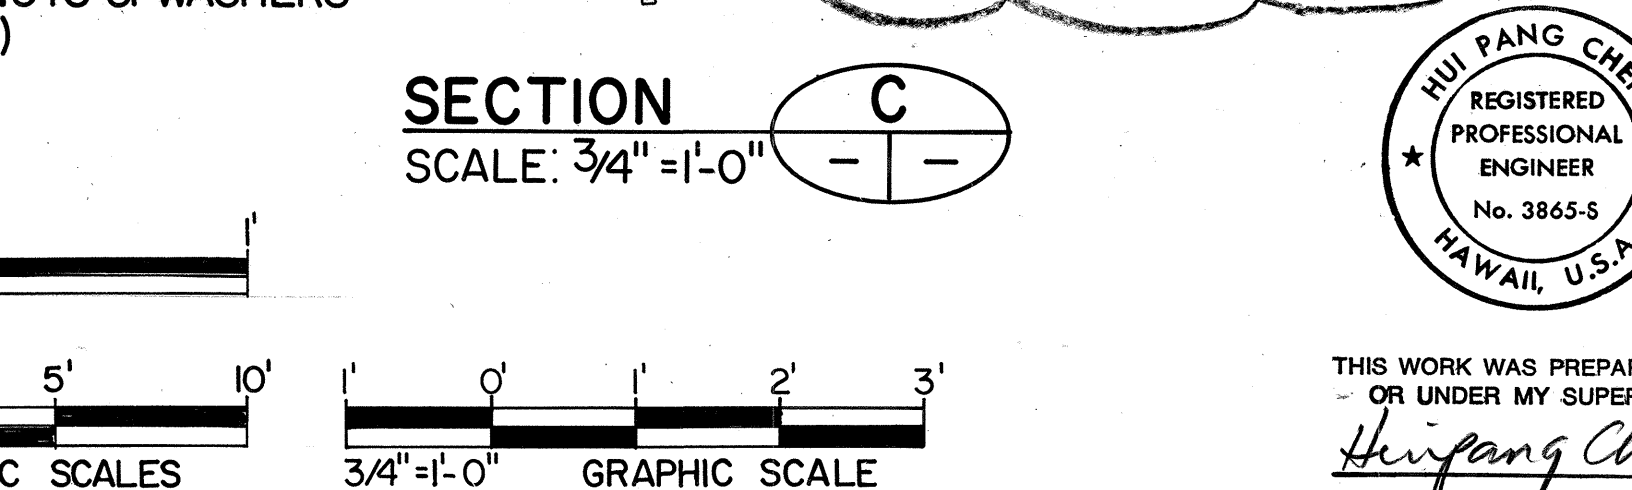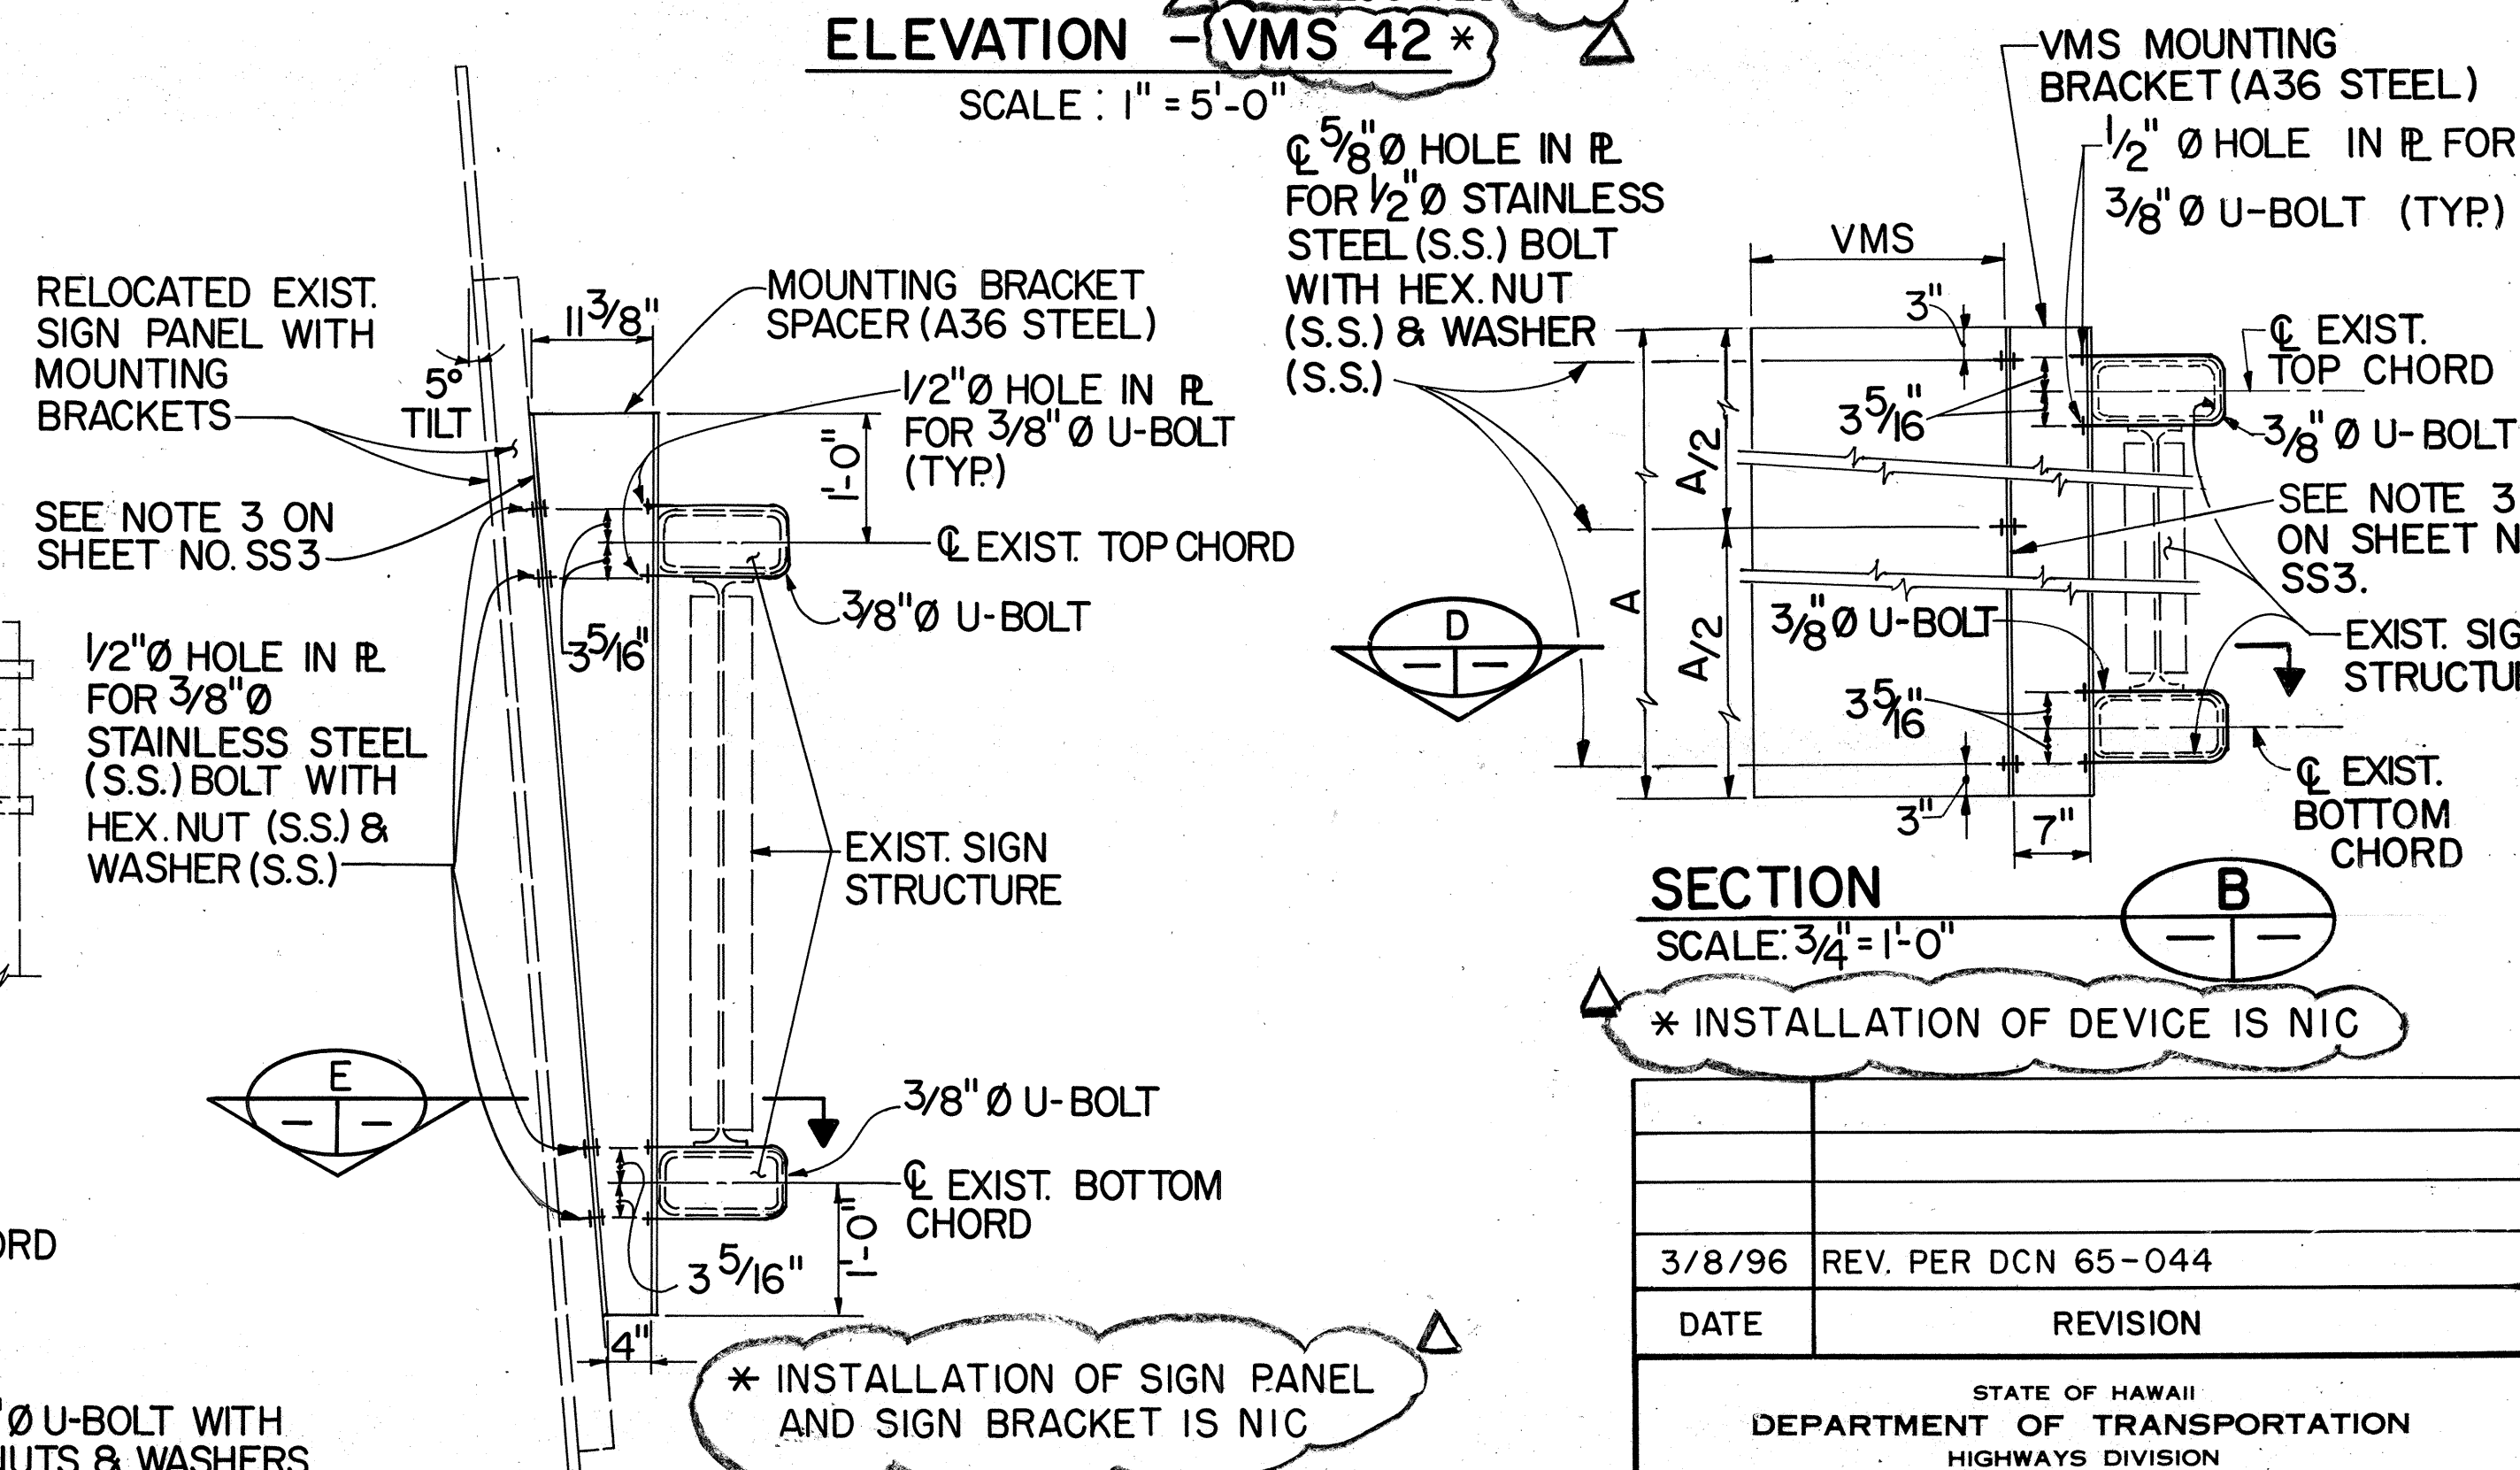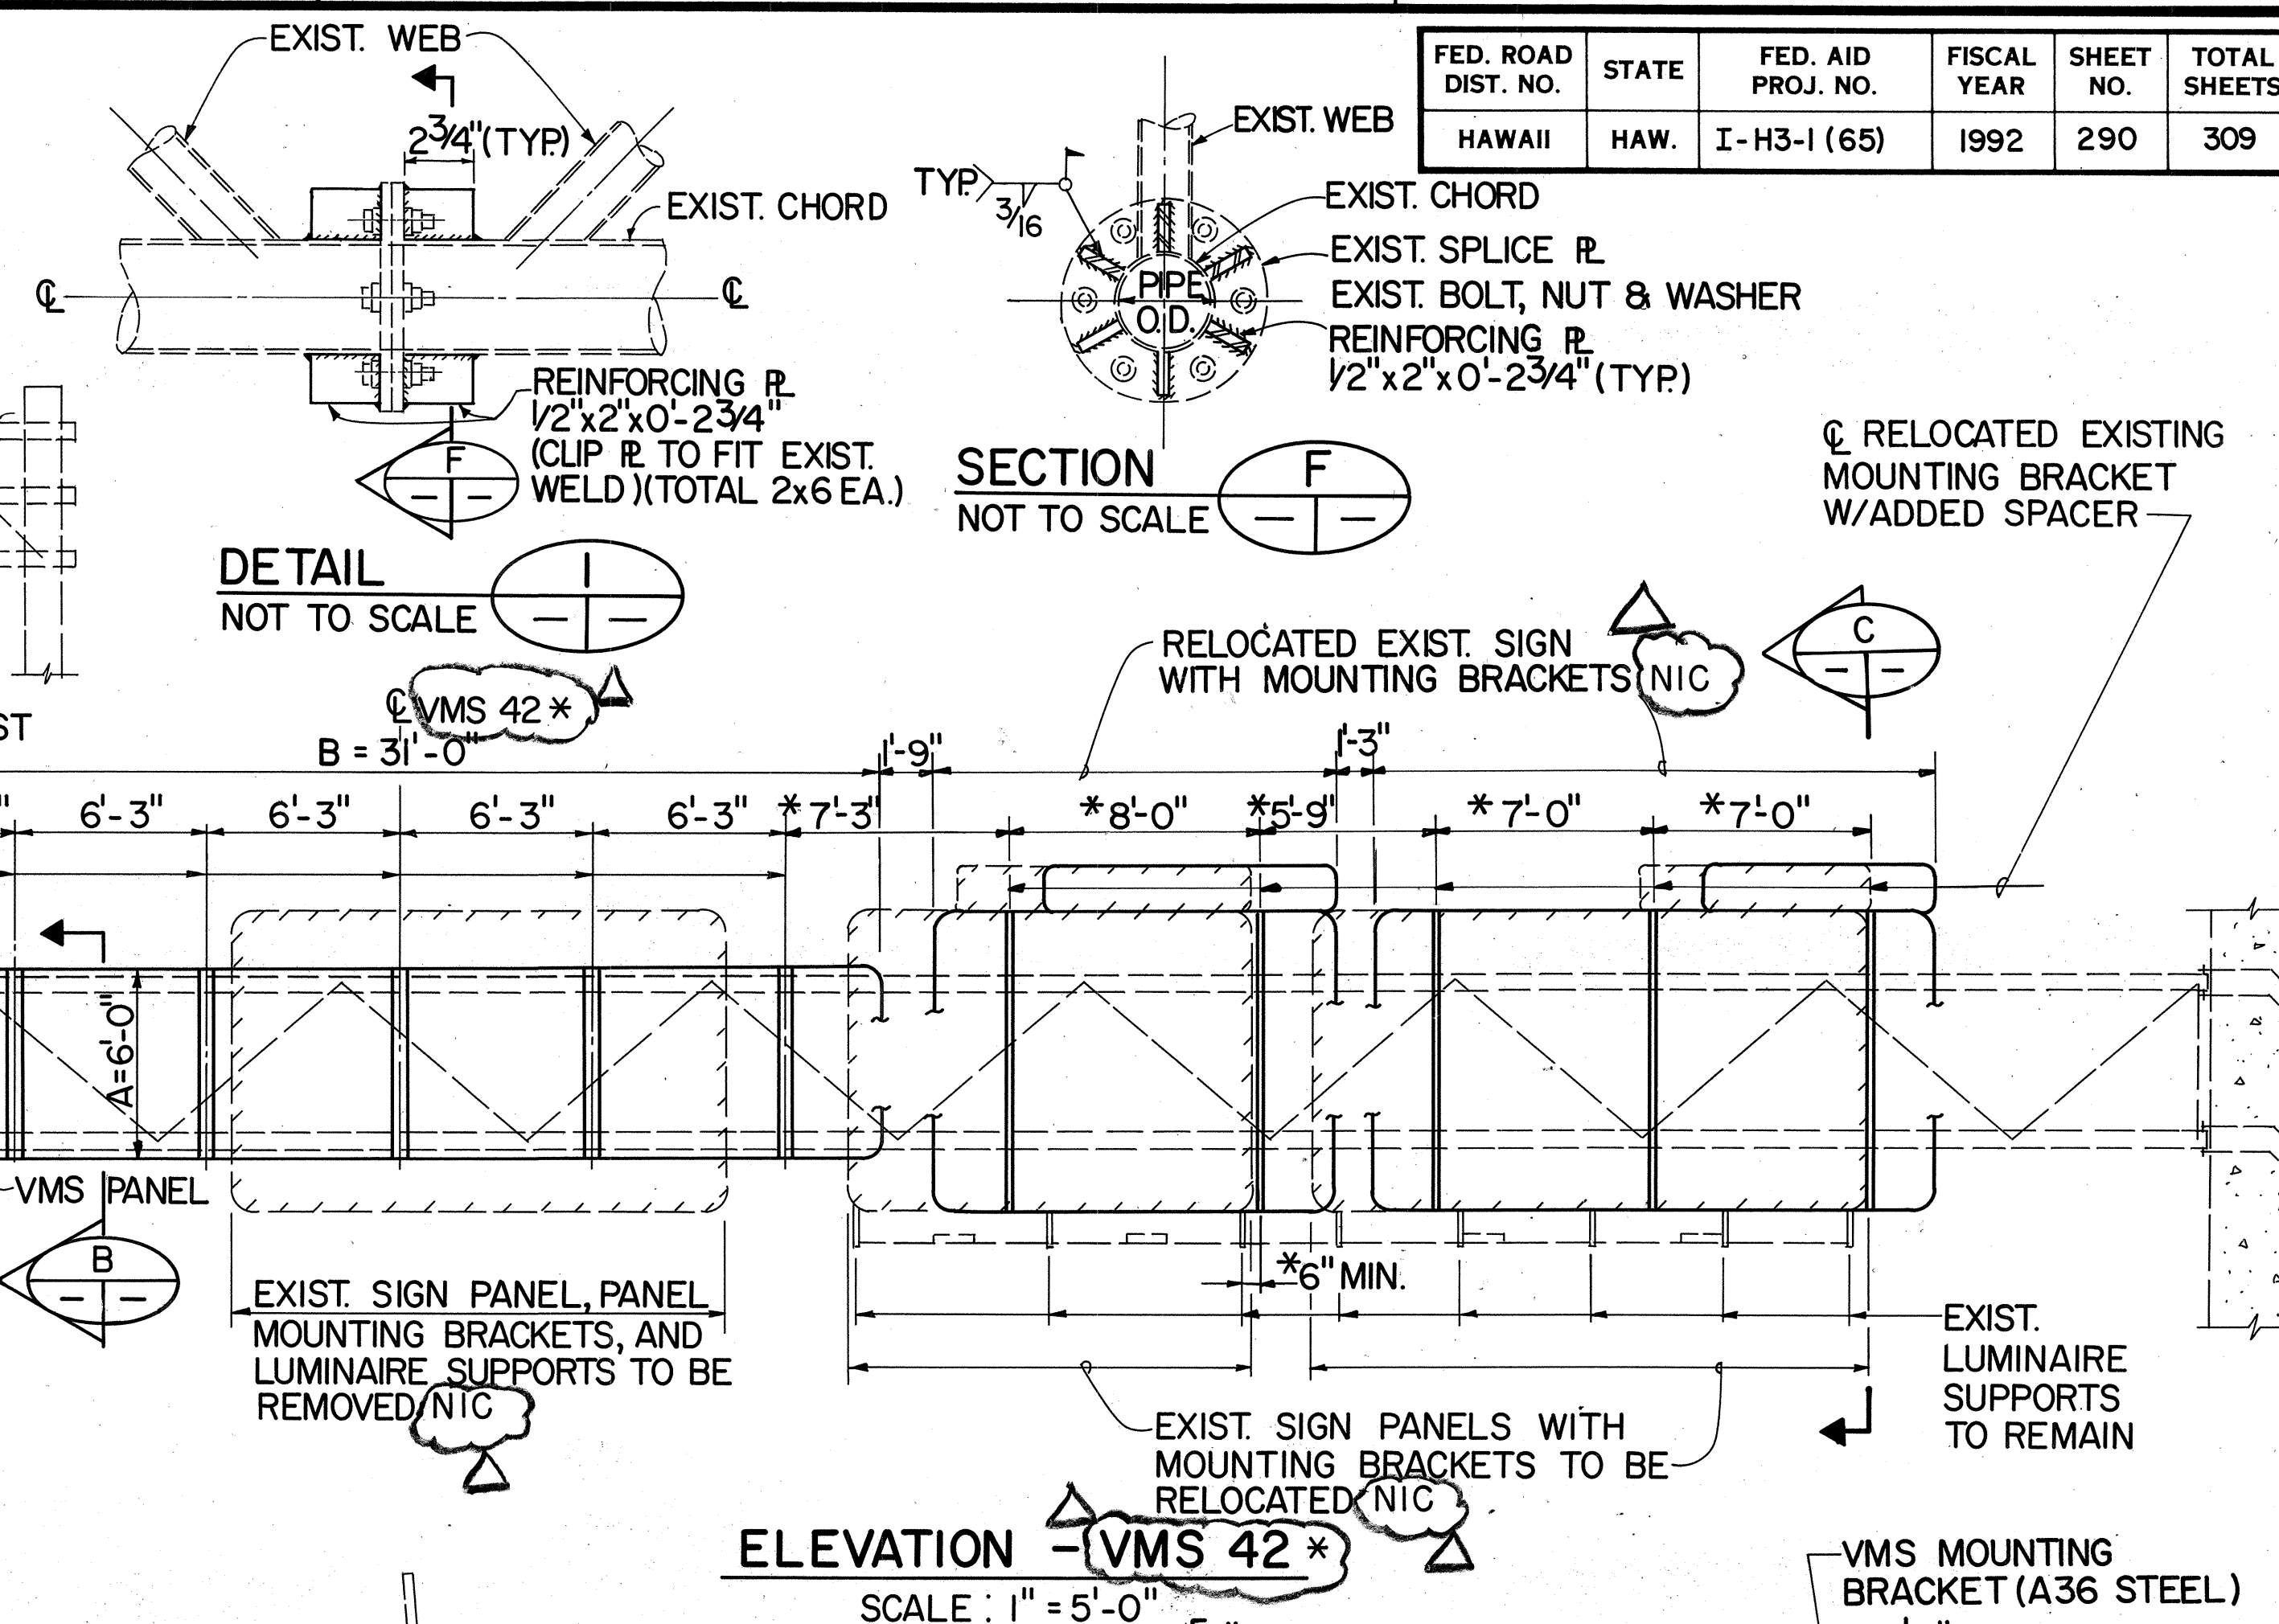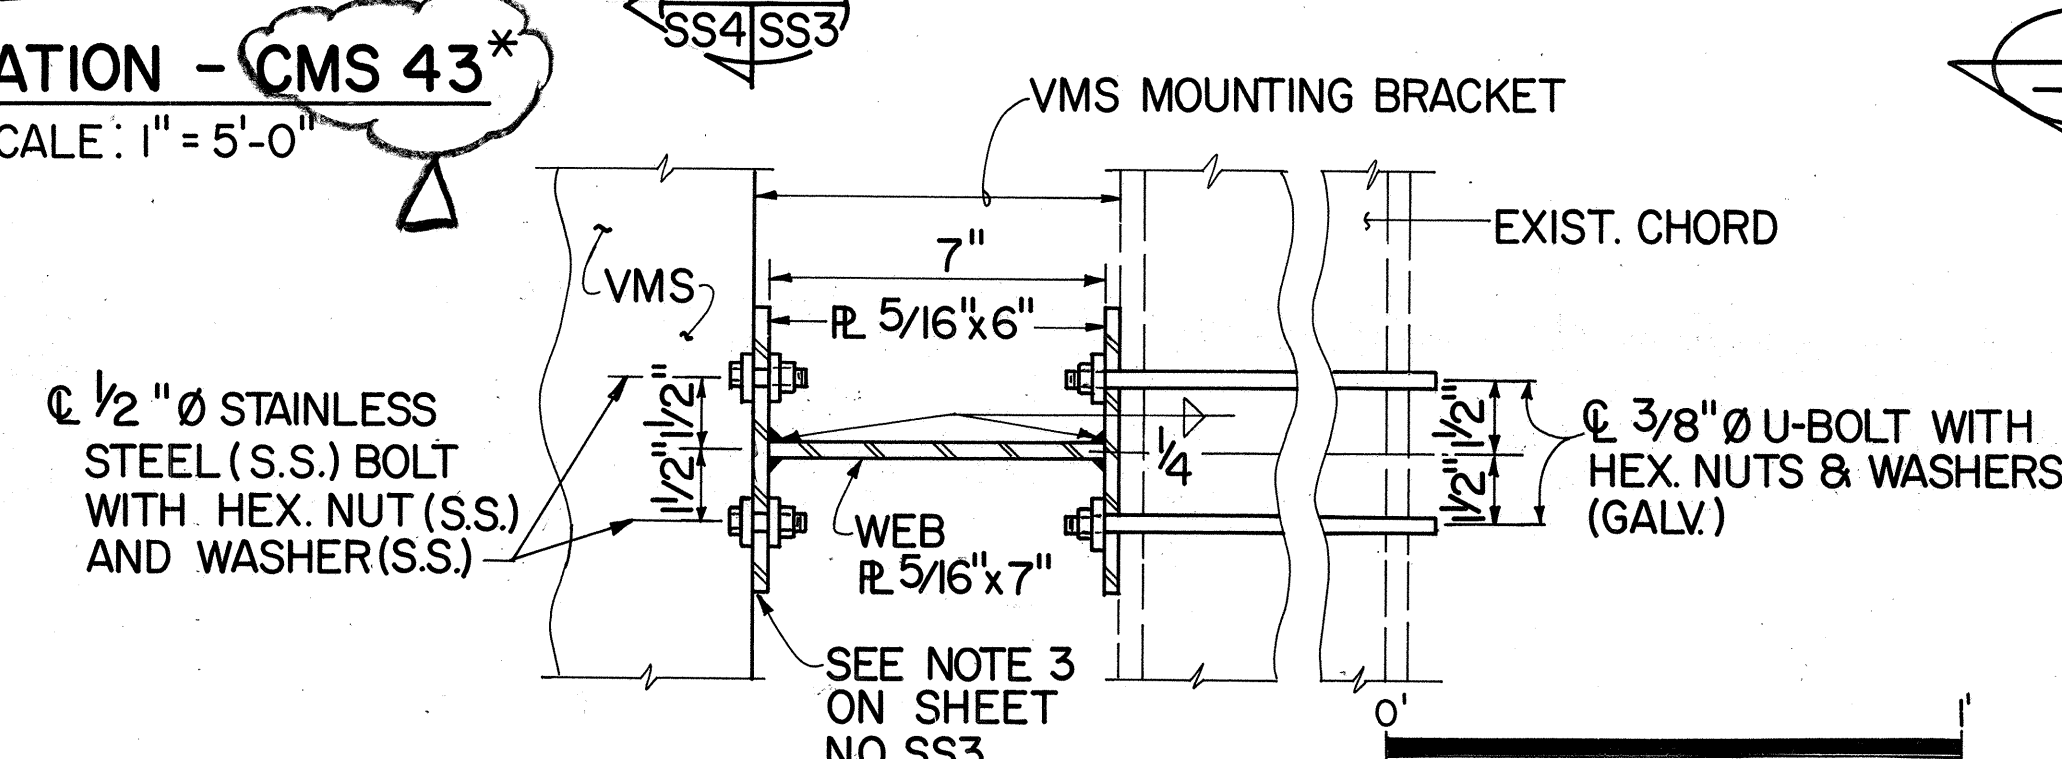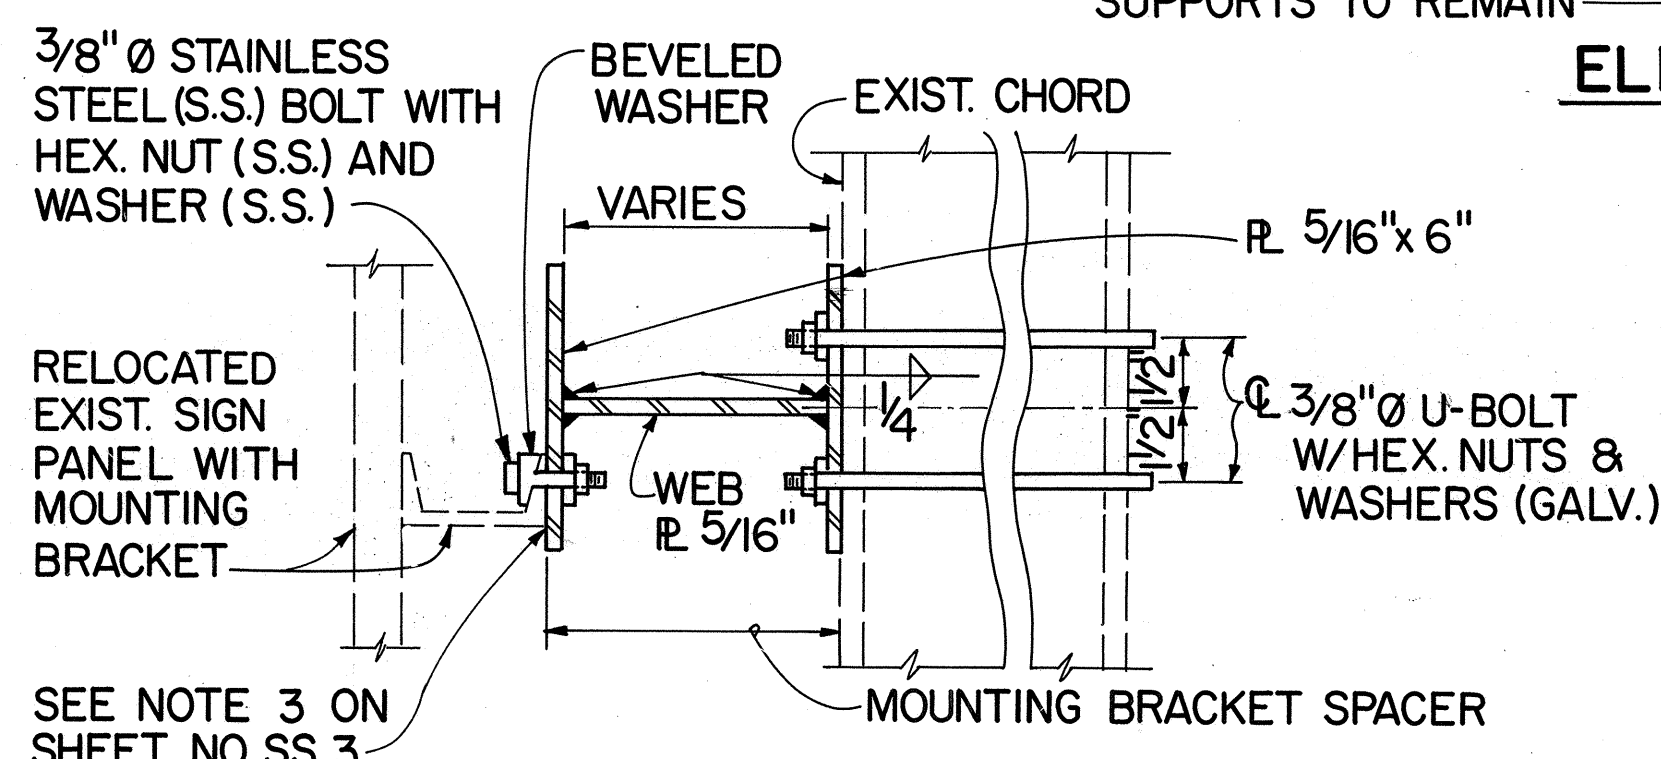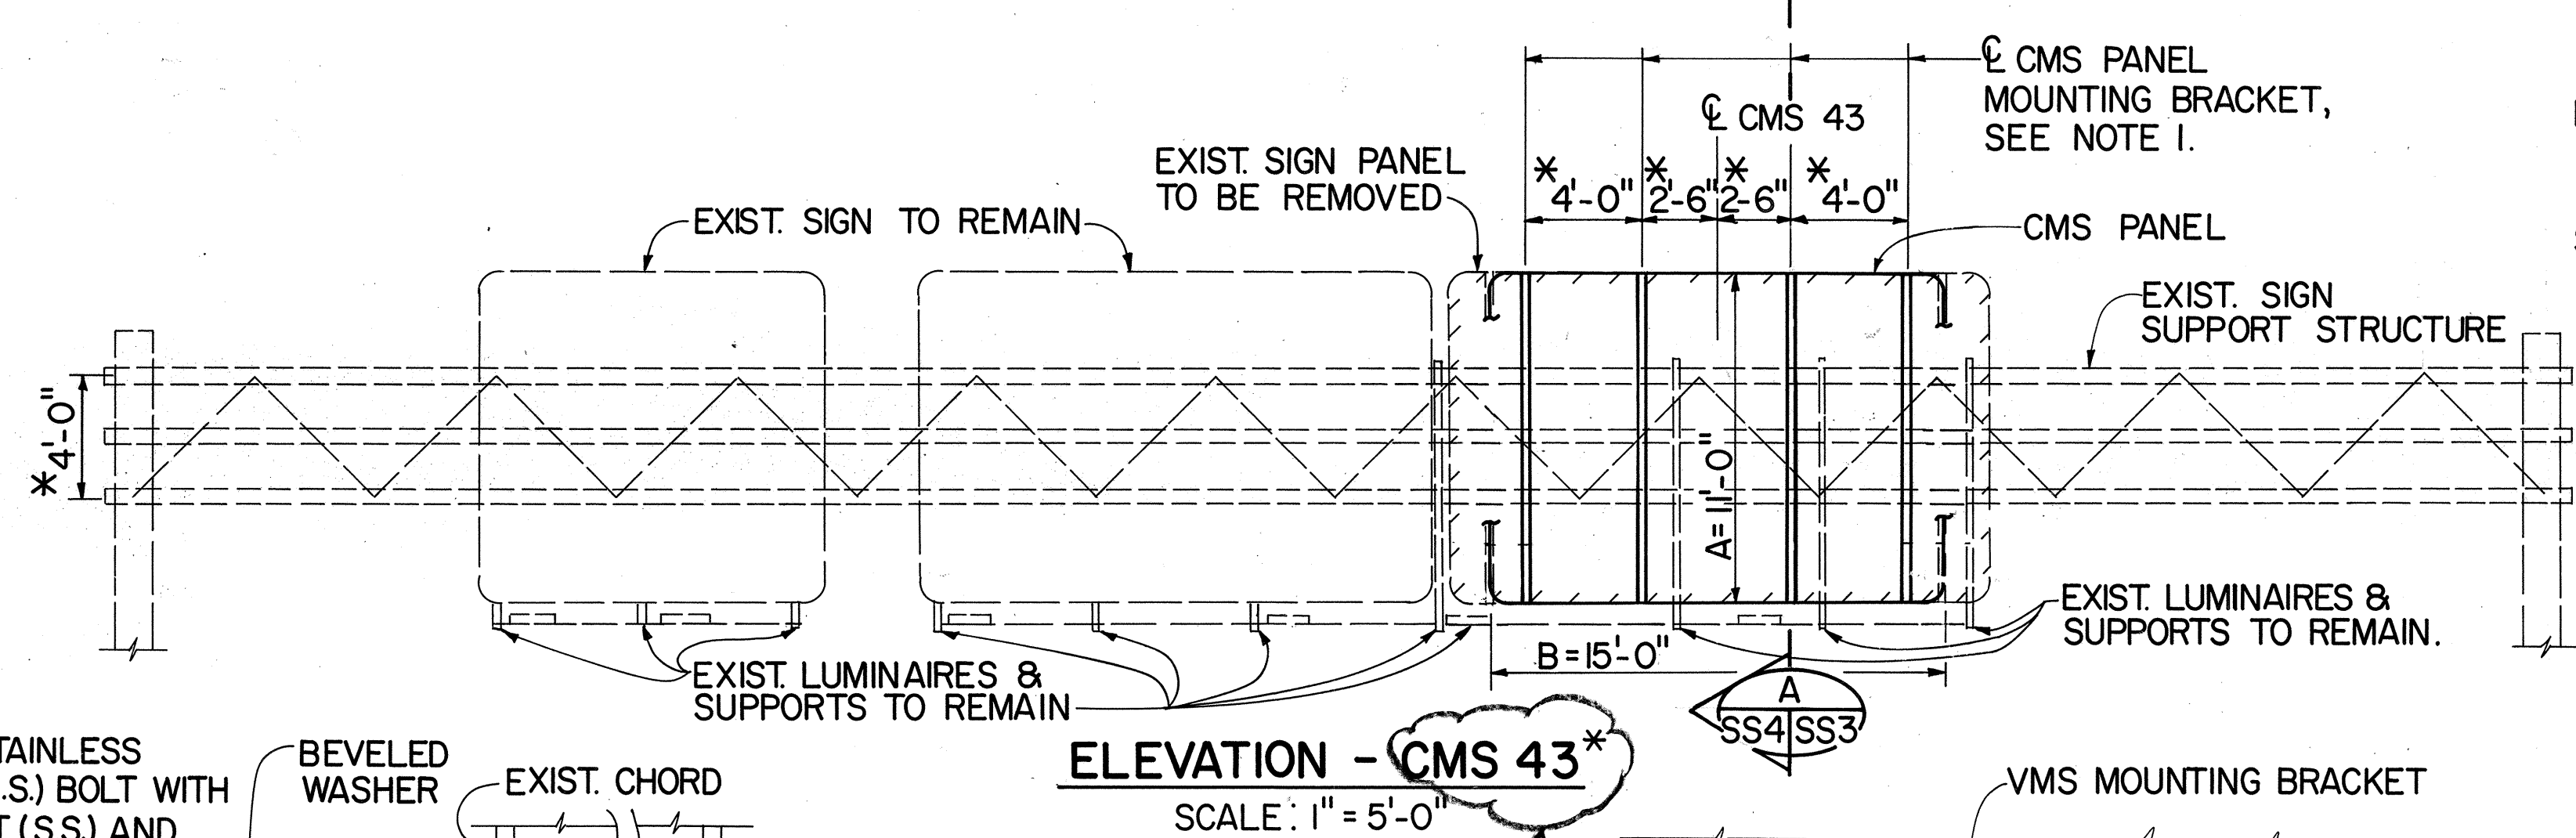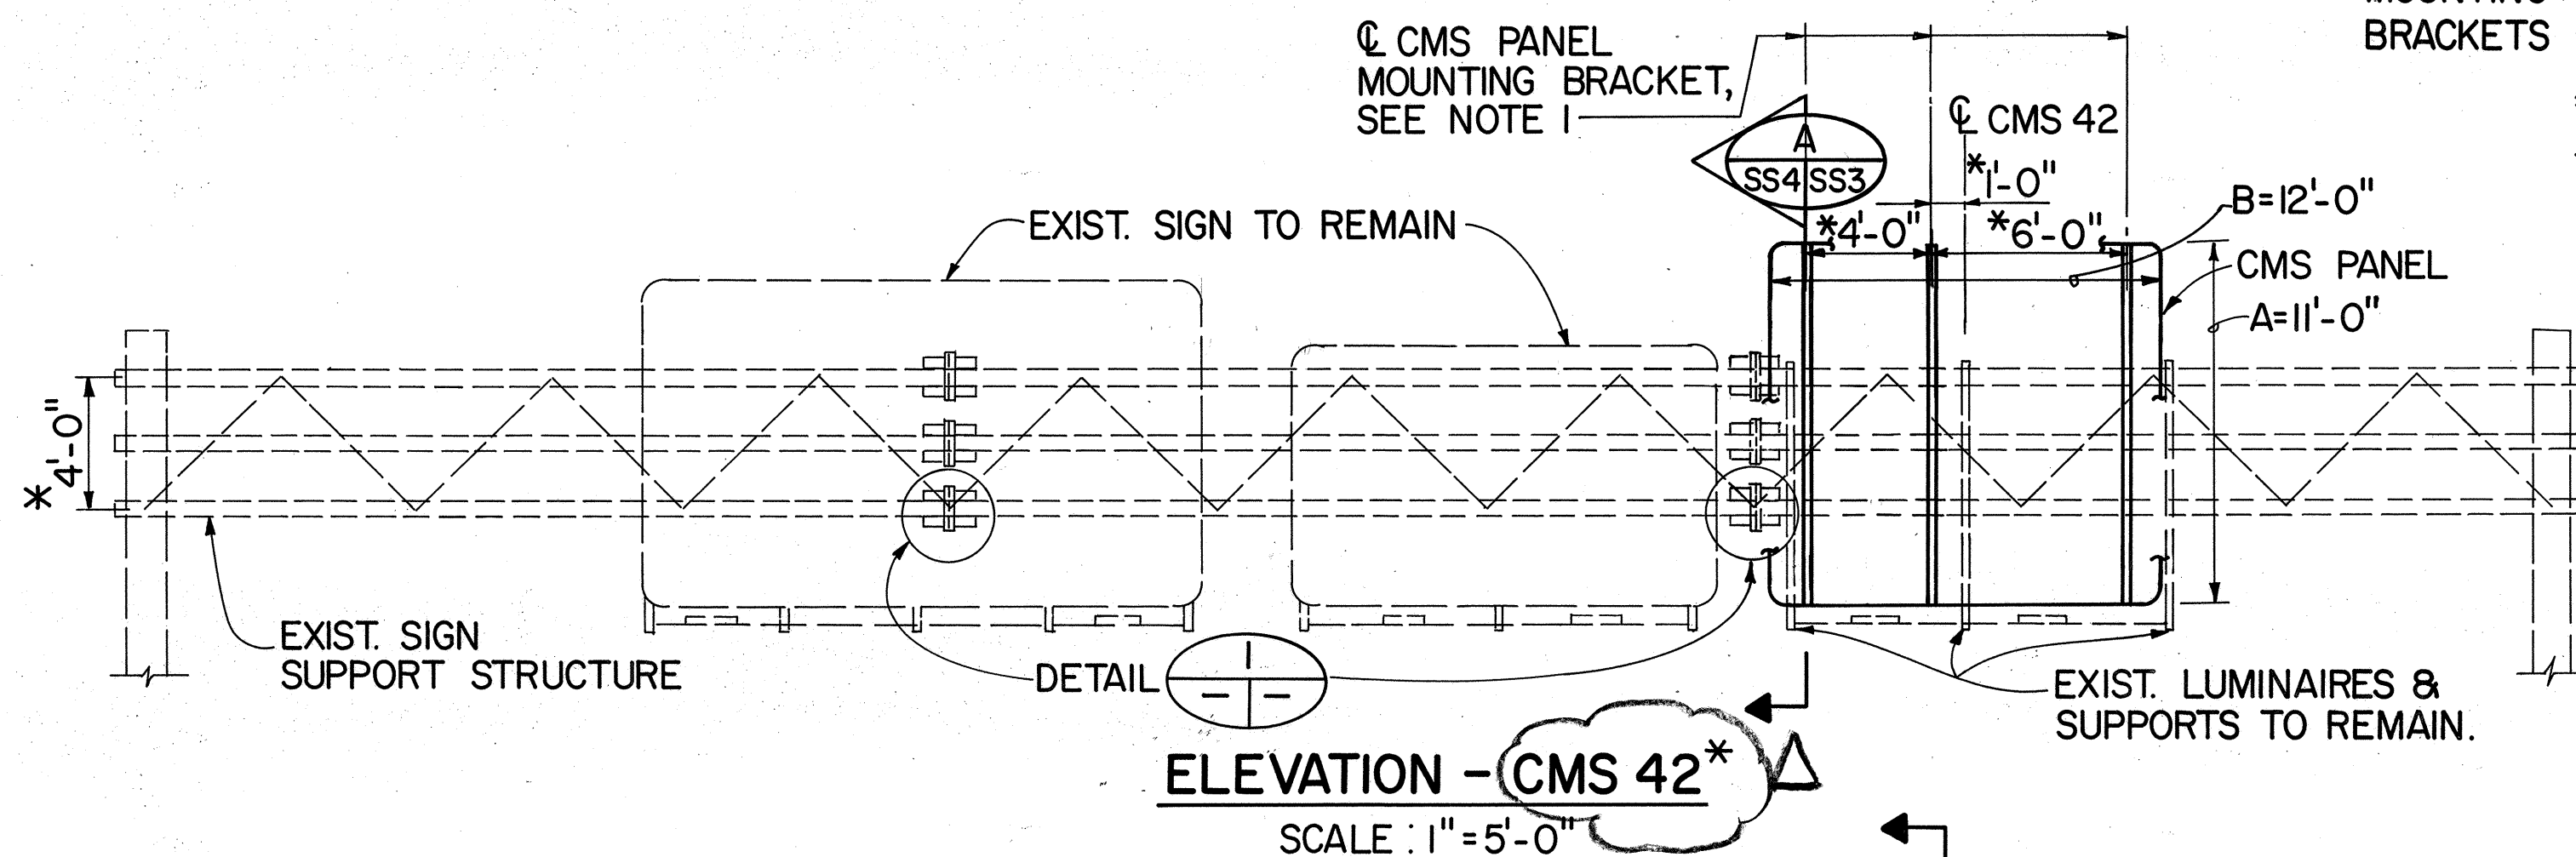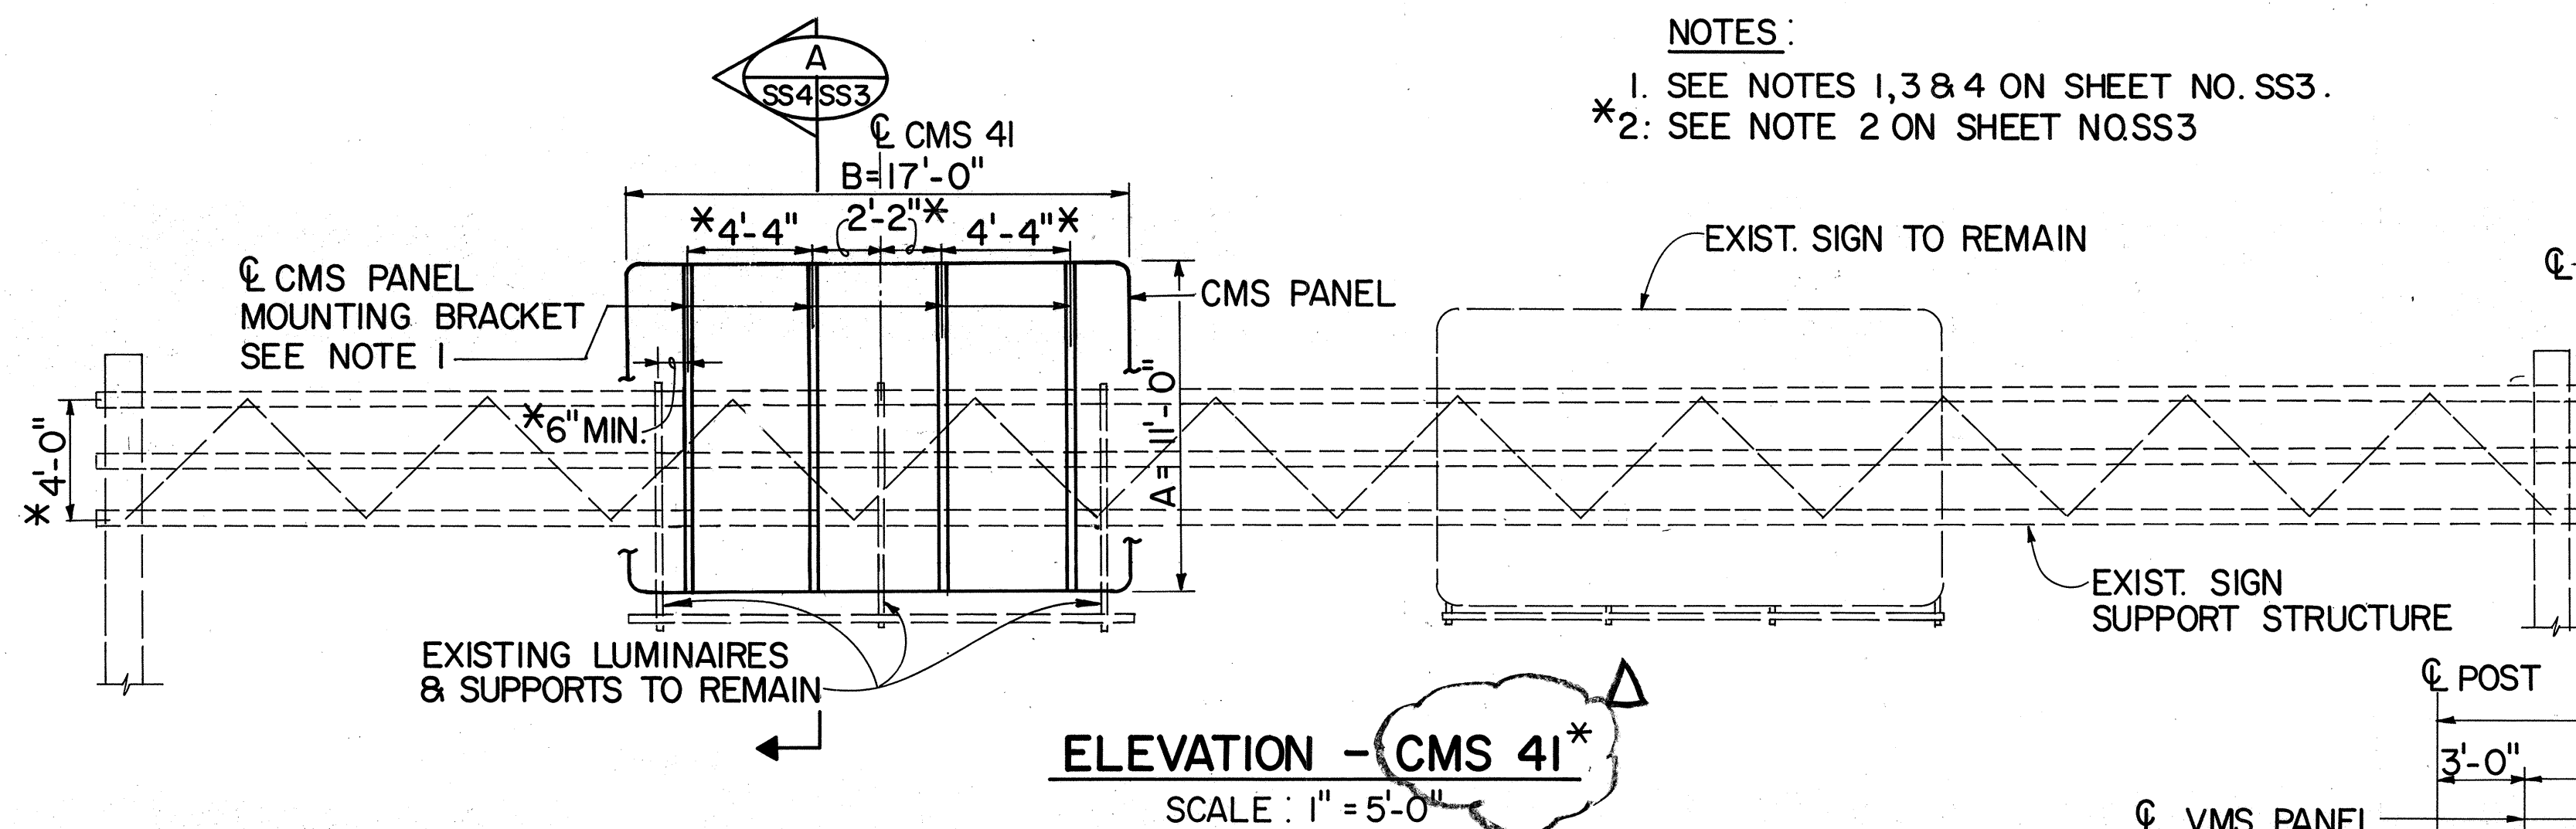

DATE	REVISION
3/8/96	REV. PER DCN 65-044
DATE	REVISION
STATE OF HAWAII DEPARTMENT OF TRANSPORTATION HIGHWAYS DIVISION	
DETAILS FOR CMS 41 TO 43 AND VMS 42	
SUPPORT STRUCTURES INTERSTATE ROUTE H-3 F.A.I. PROJ. NO. I-H3-1(65)	
SCALE: AS SHOWN	DATE: DEC. 1991
SHEET NO. SS4 OF 19 SHEETS	

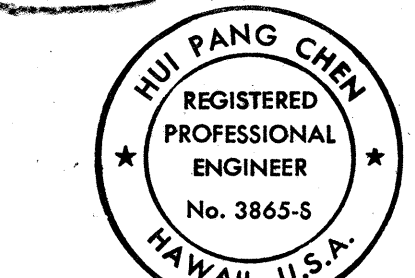


THIS WORK WAS PREPARED BY ME
 OR UNDER MY SUPERVISION.
Hui Pang Chen

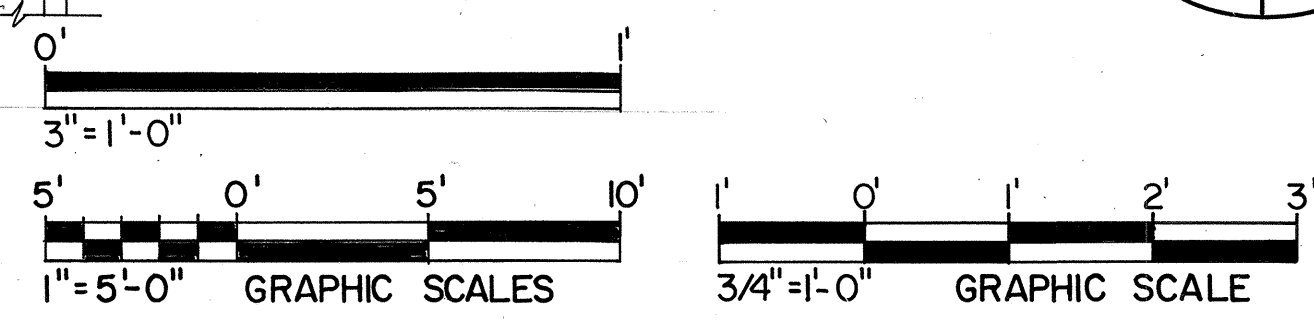


ORIGINAL PLAN	DATE
DRAWN BY: G.D. TRUONG	4/91
TRACED BY: I. ABE	4/91
NOTED BY: H.P. CHEN	4/91
CHECKED BY: H.P. CHEN	4/91

FED. ROAD DIST. NO.	STATE	FED. AID PROJ. NO.	FISCAL YEAR	SHEET NO.	TOTAL SHEETS
HAWAII	HAW.	I - H3-1 (65)	1992	291	309

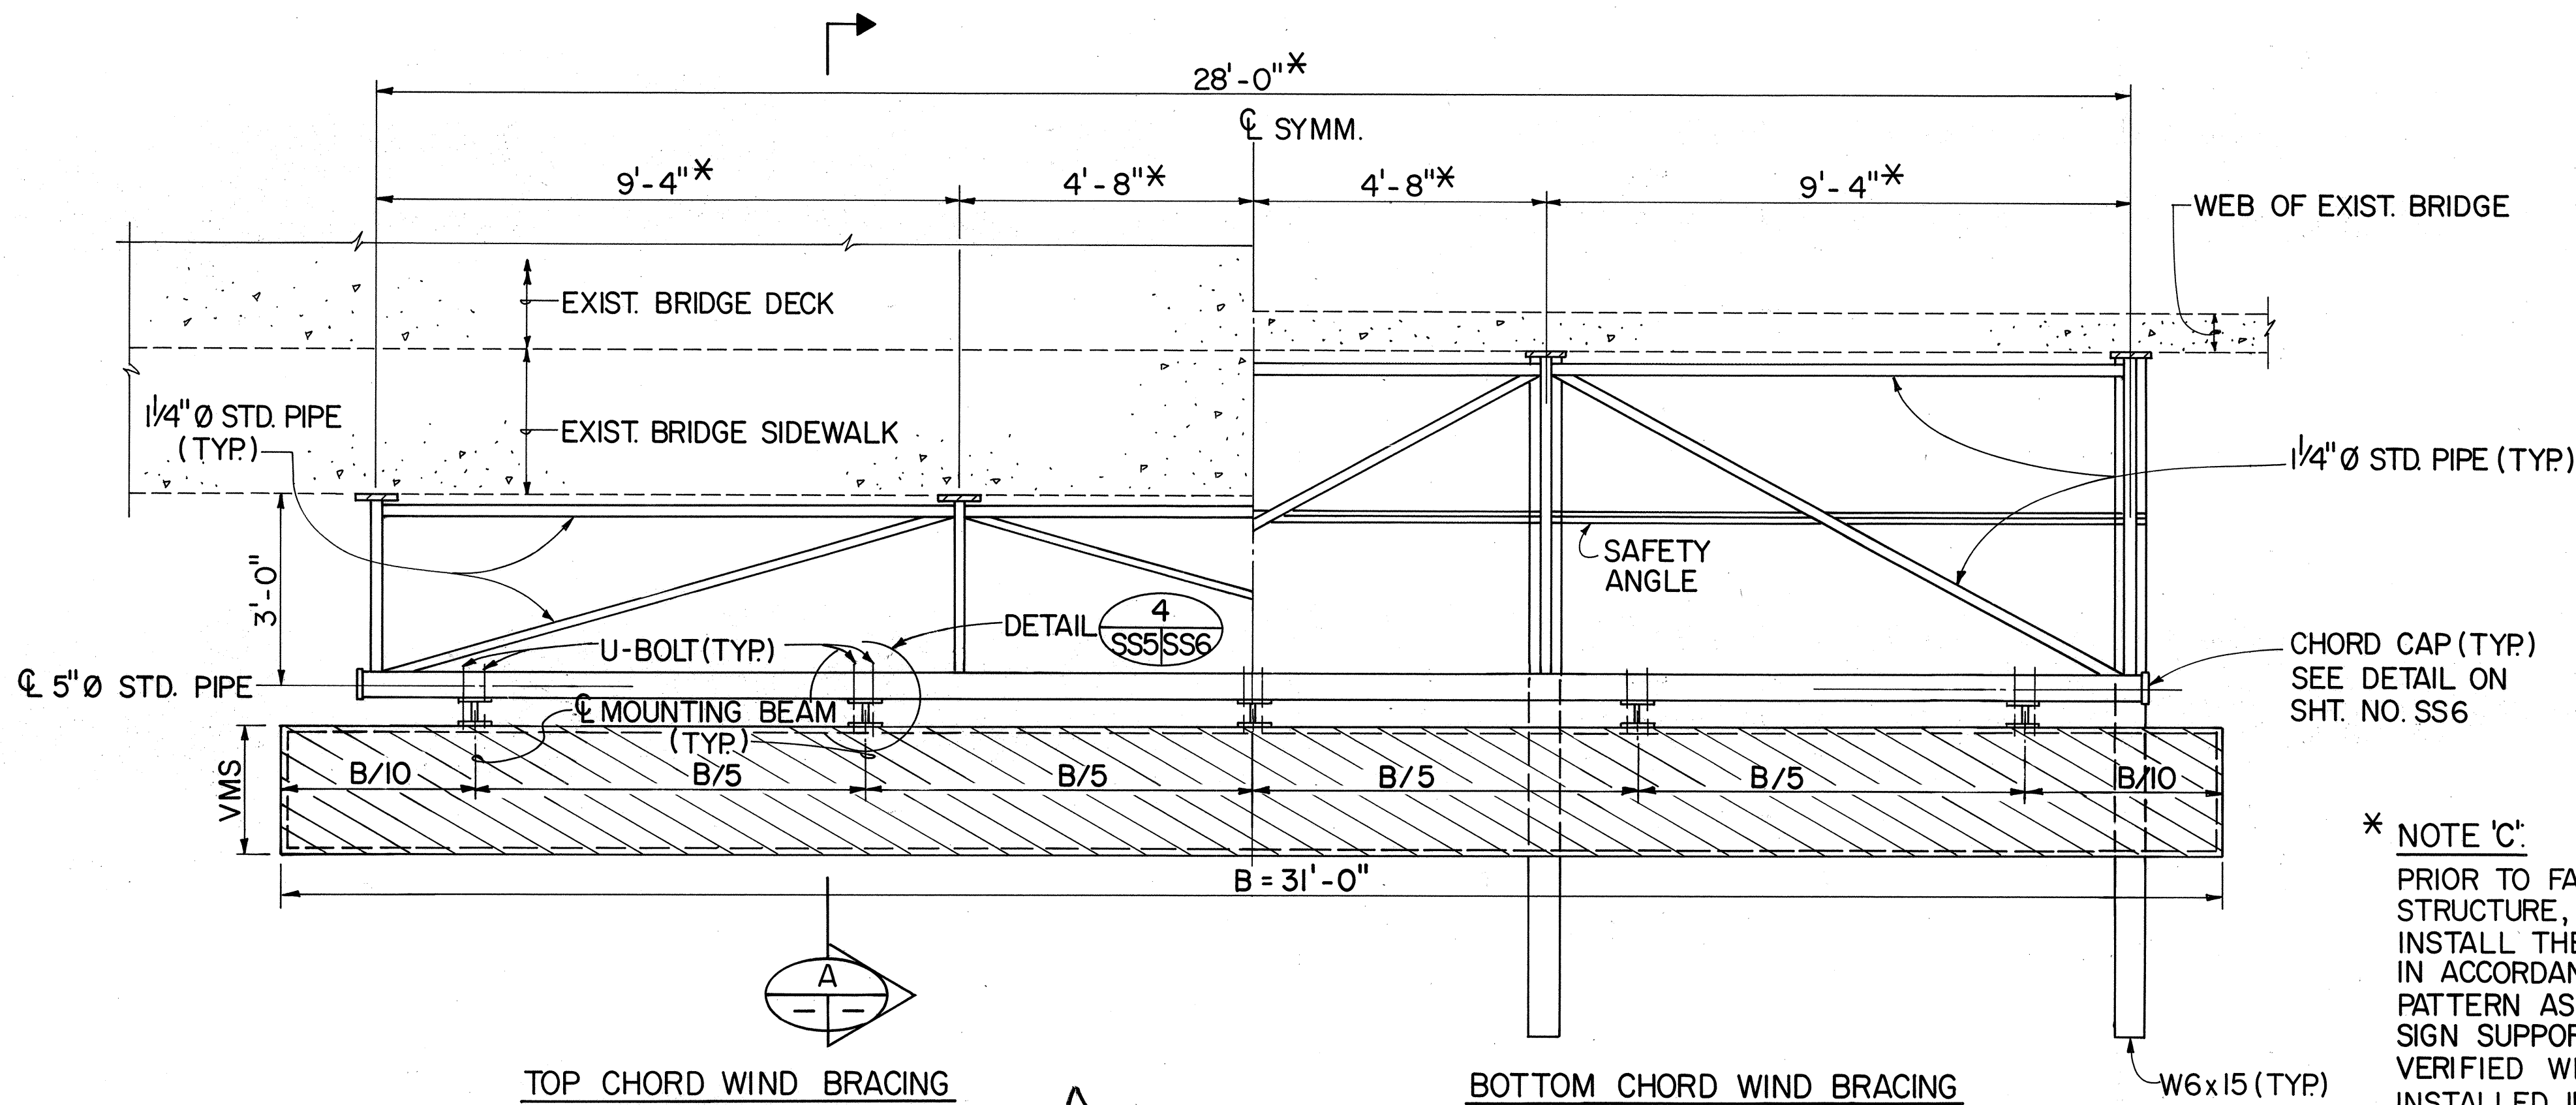


PLAN - VMS 38** MOUNTED ON EXISTING BRIDGE
SCALE: 1/2"=1'-0"

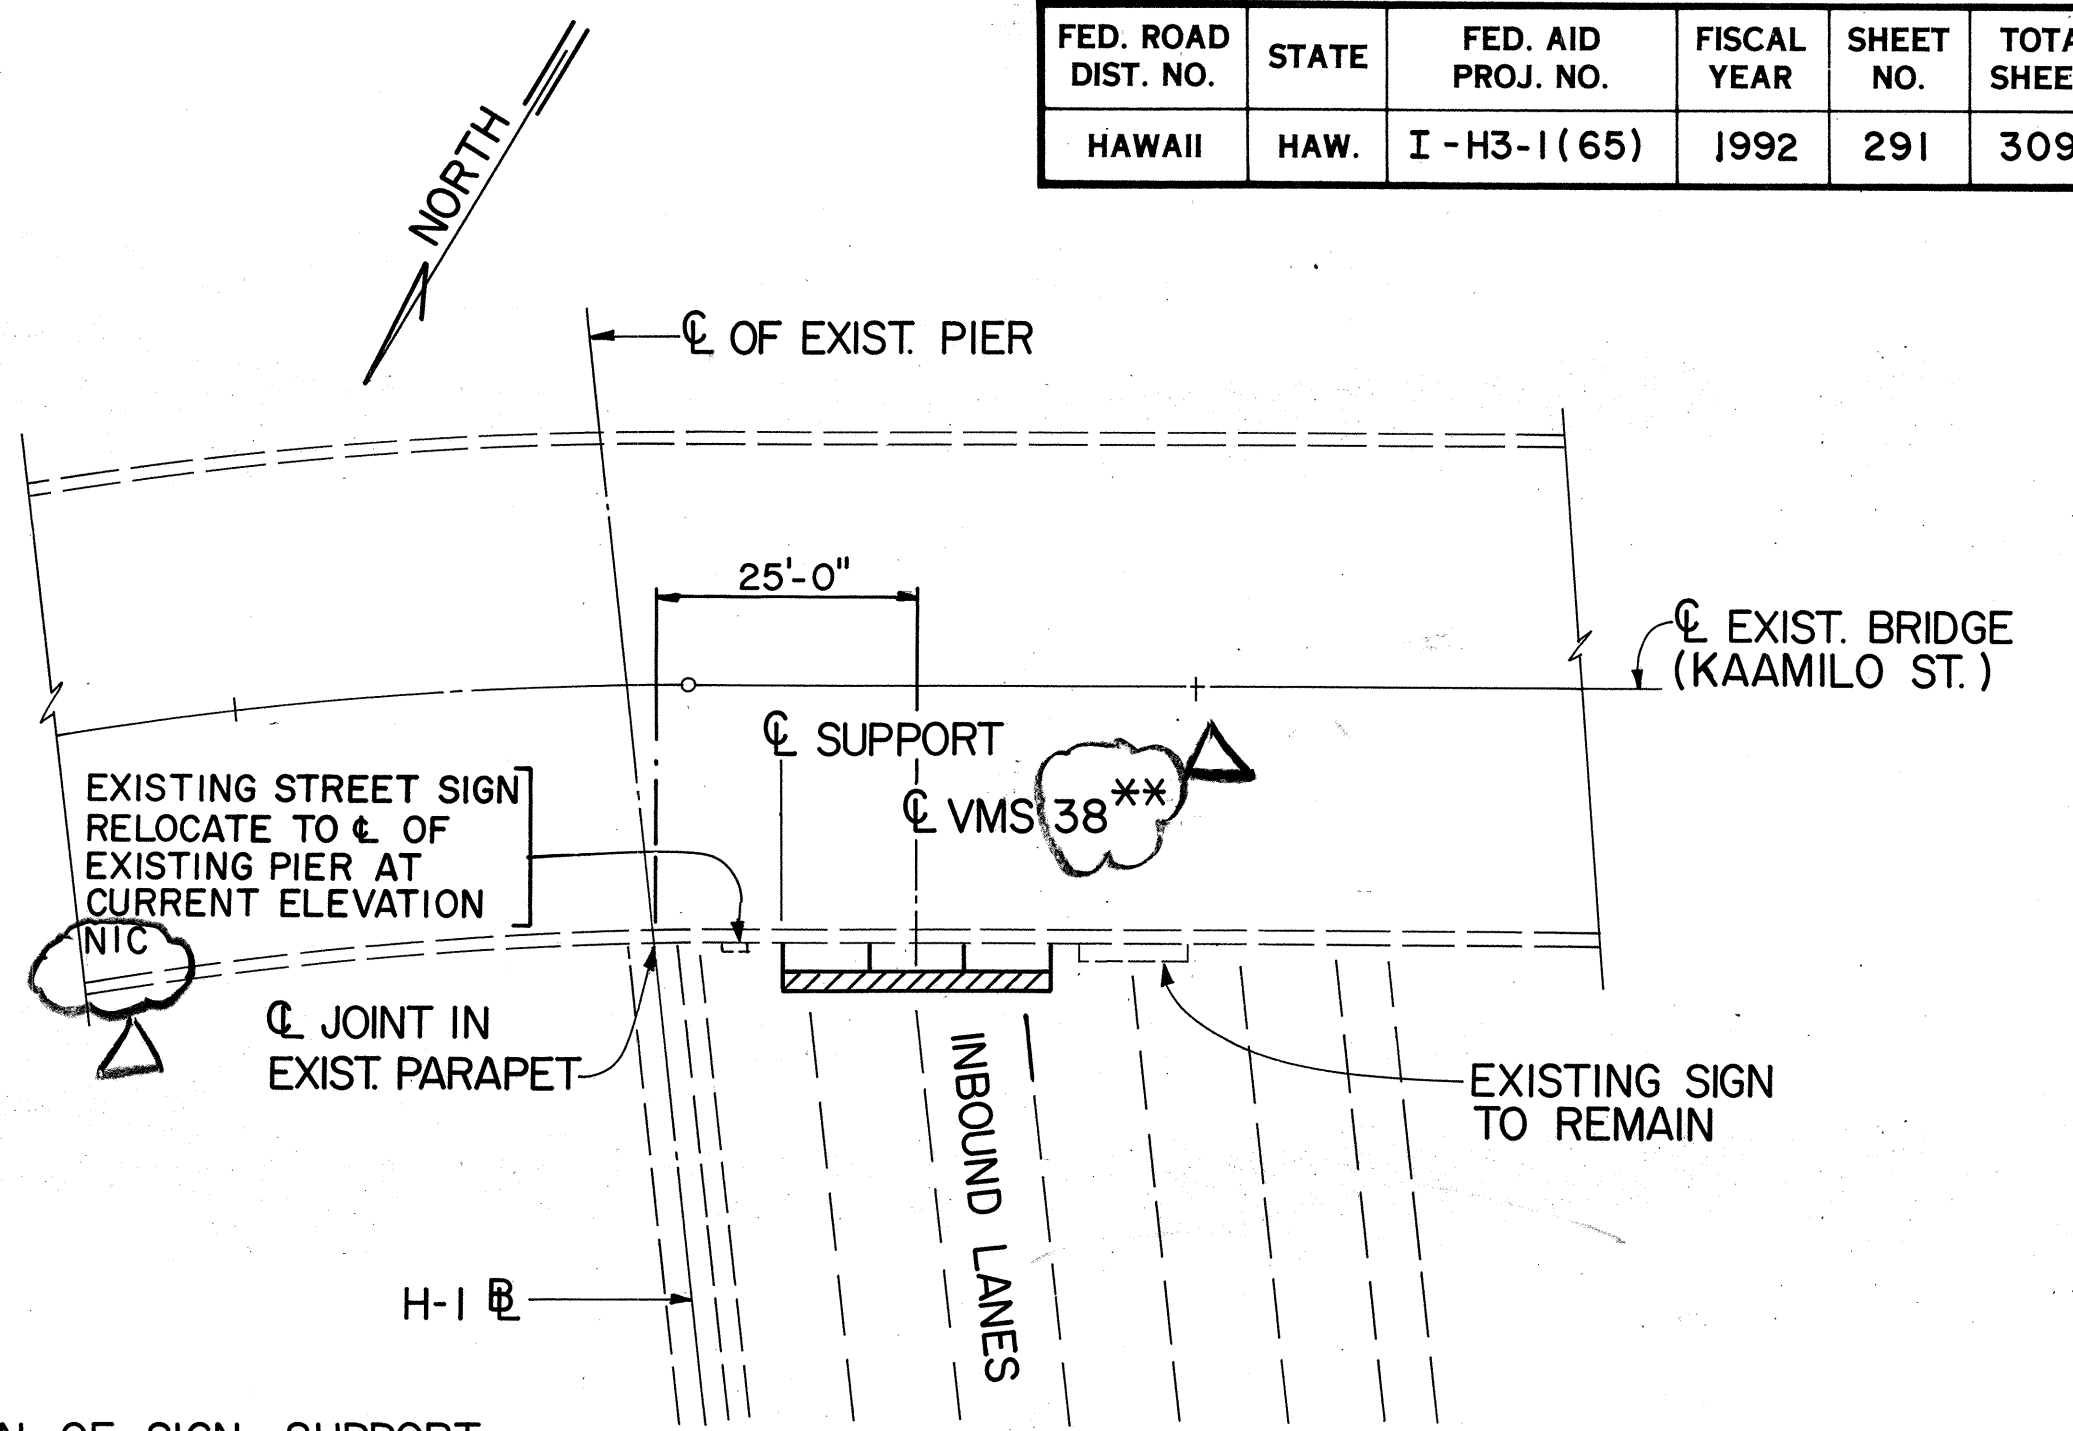


LOCATION PLAN
SCALE: 1"=20'

** INSTALLATION OF SIGN AND ASSOCIATED MOUNTING HARDWARE NIC


* NOTE 'C':
PRIOR TO FABRICATION OF SIGN SUPPORT STRUCTURE, THE CONTRACTOR SHALL INSTALL THE EXPANSION ANCHOR BOLTS IN ACCORDANCE WITH NOTE 'A' AND BOLT PATTERN AS SHOWN. THE DIMENSIONS OF SIGN SUPPORT STRUCTURE SHALL BE VERIFIED WITH THE ANCHOR BOLT INSTALLED IN FIELD (NIC)

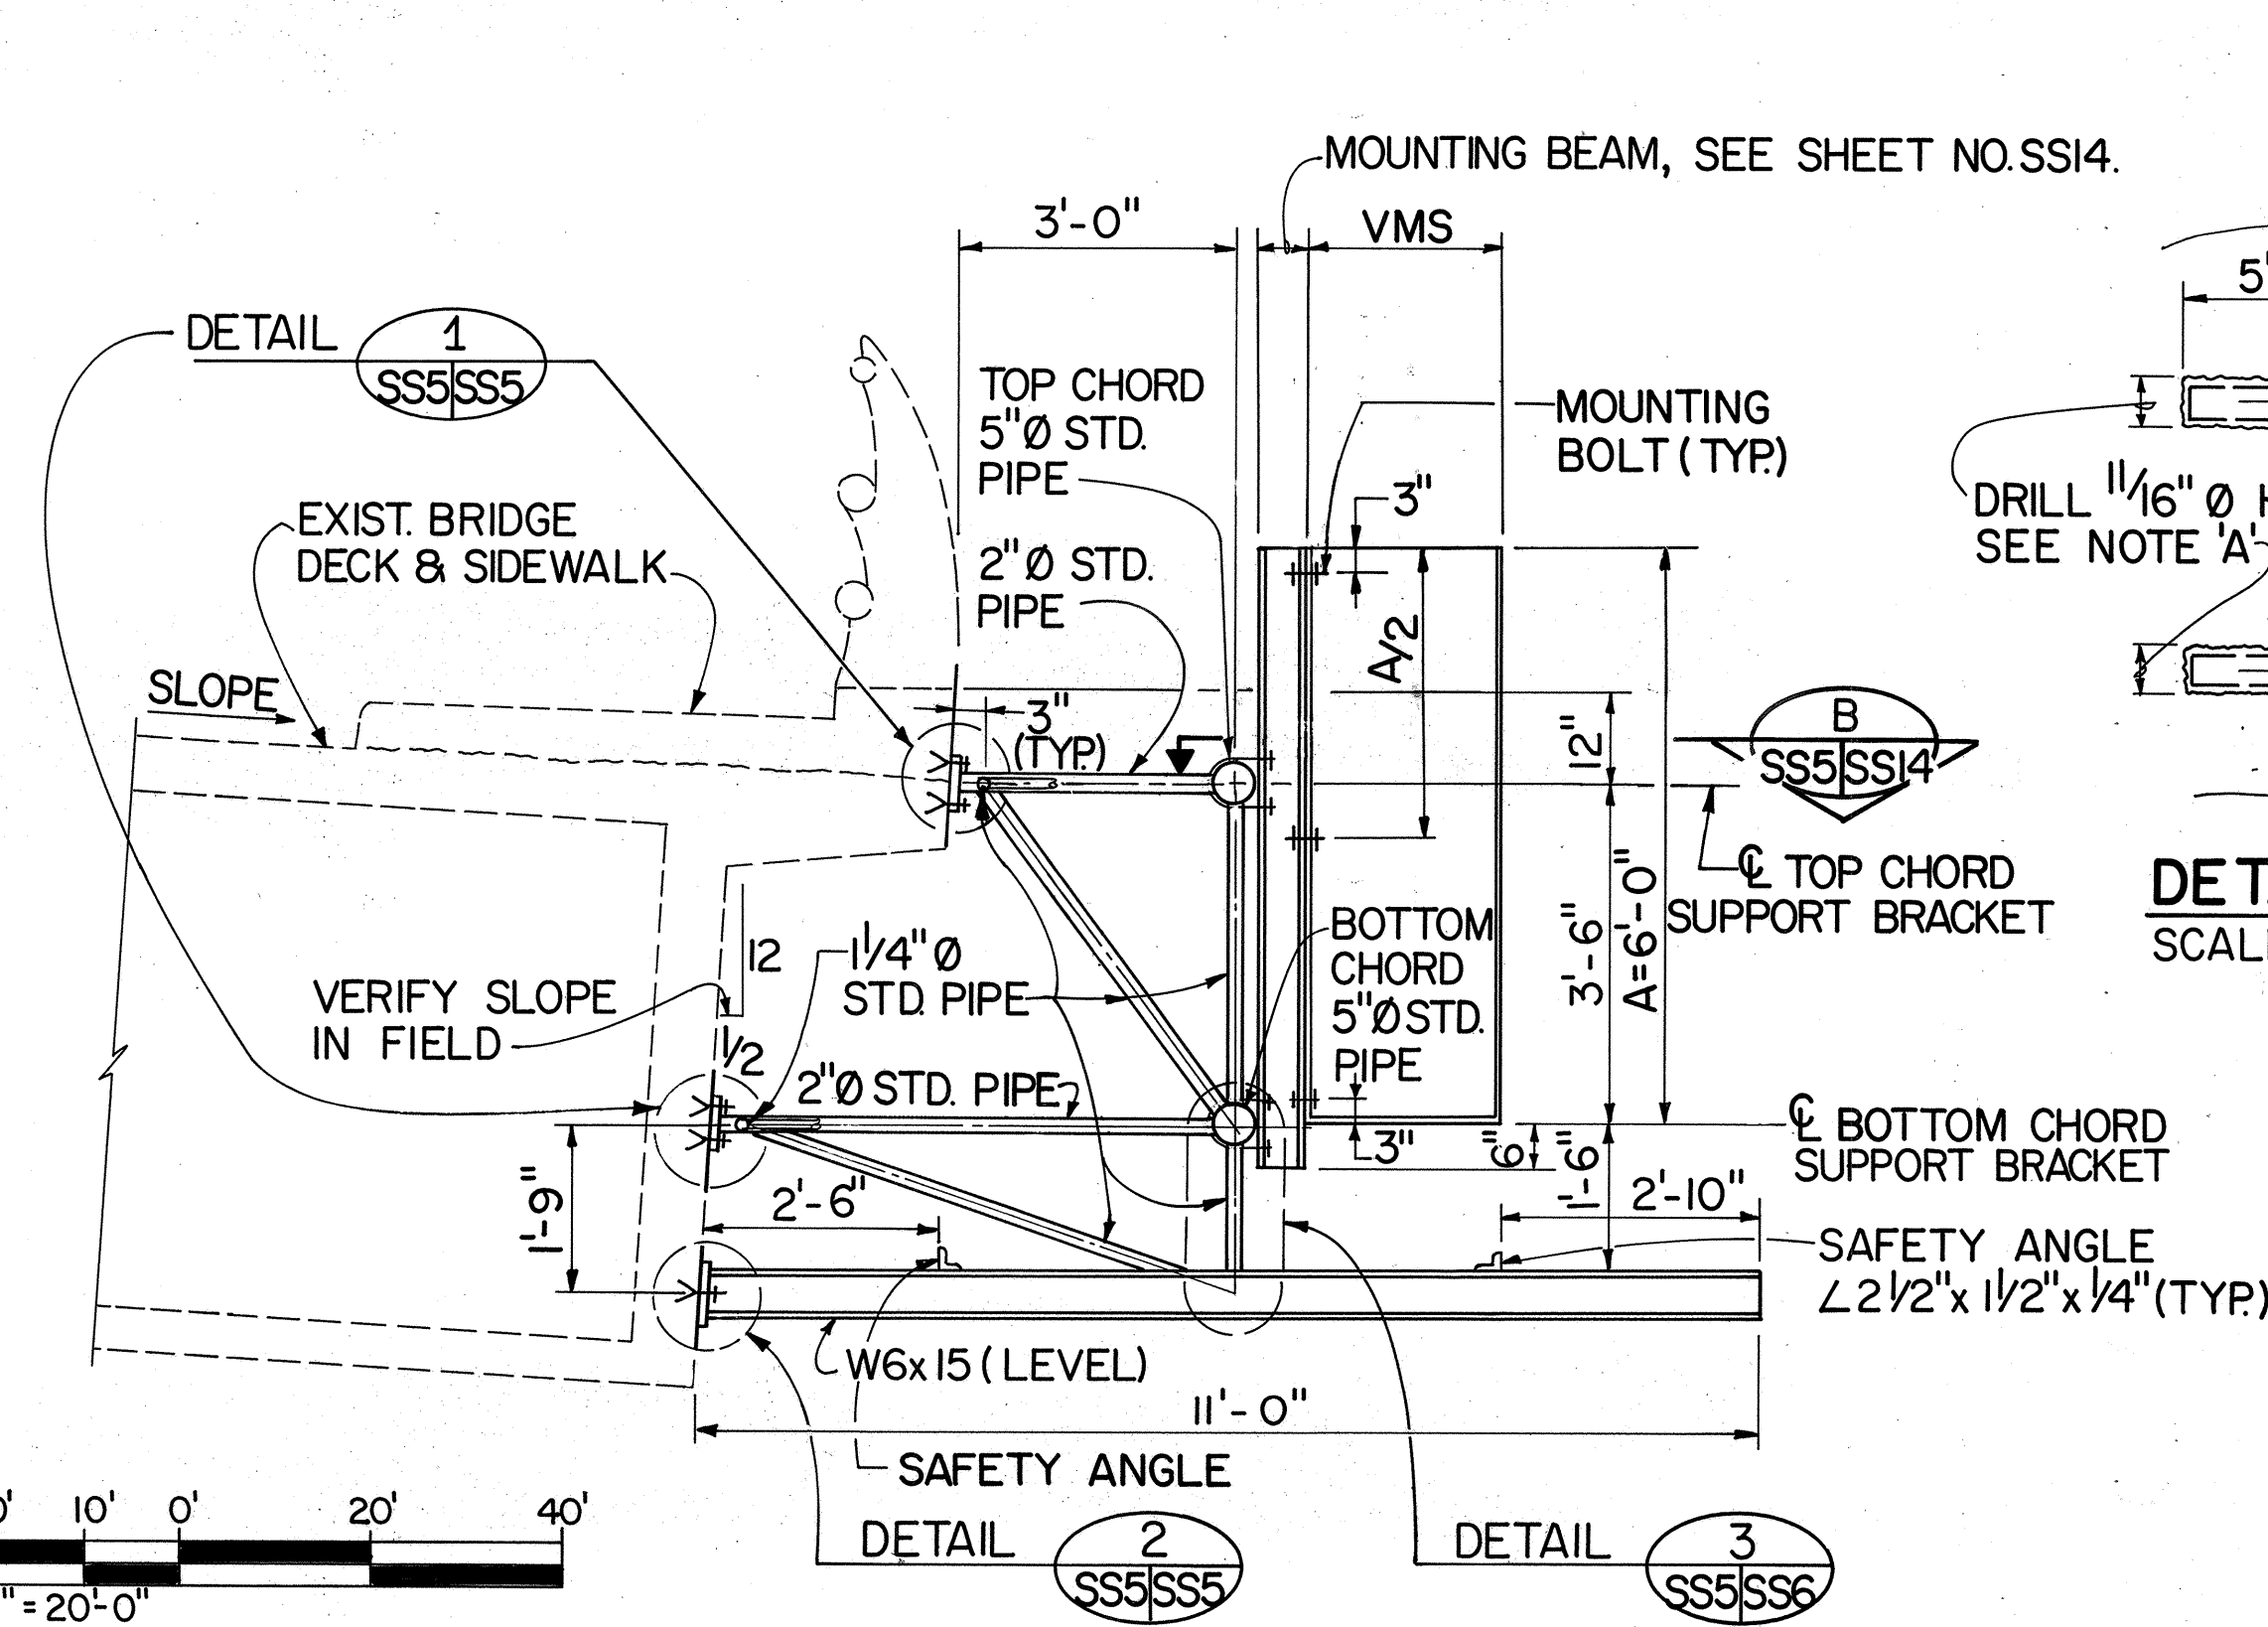

SECTION A
SCALE: 1/2"=1'-0"

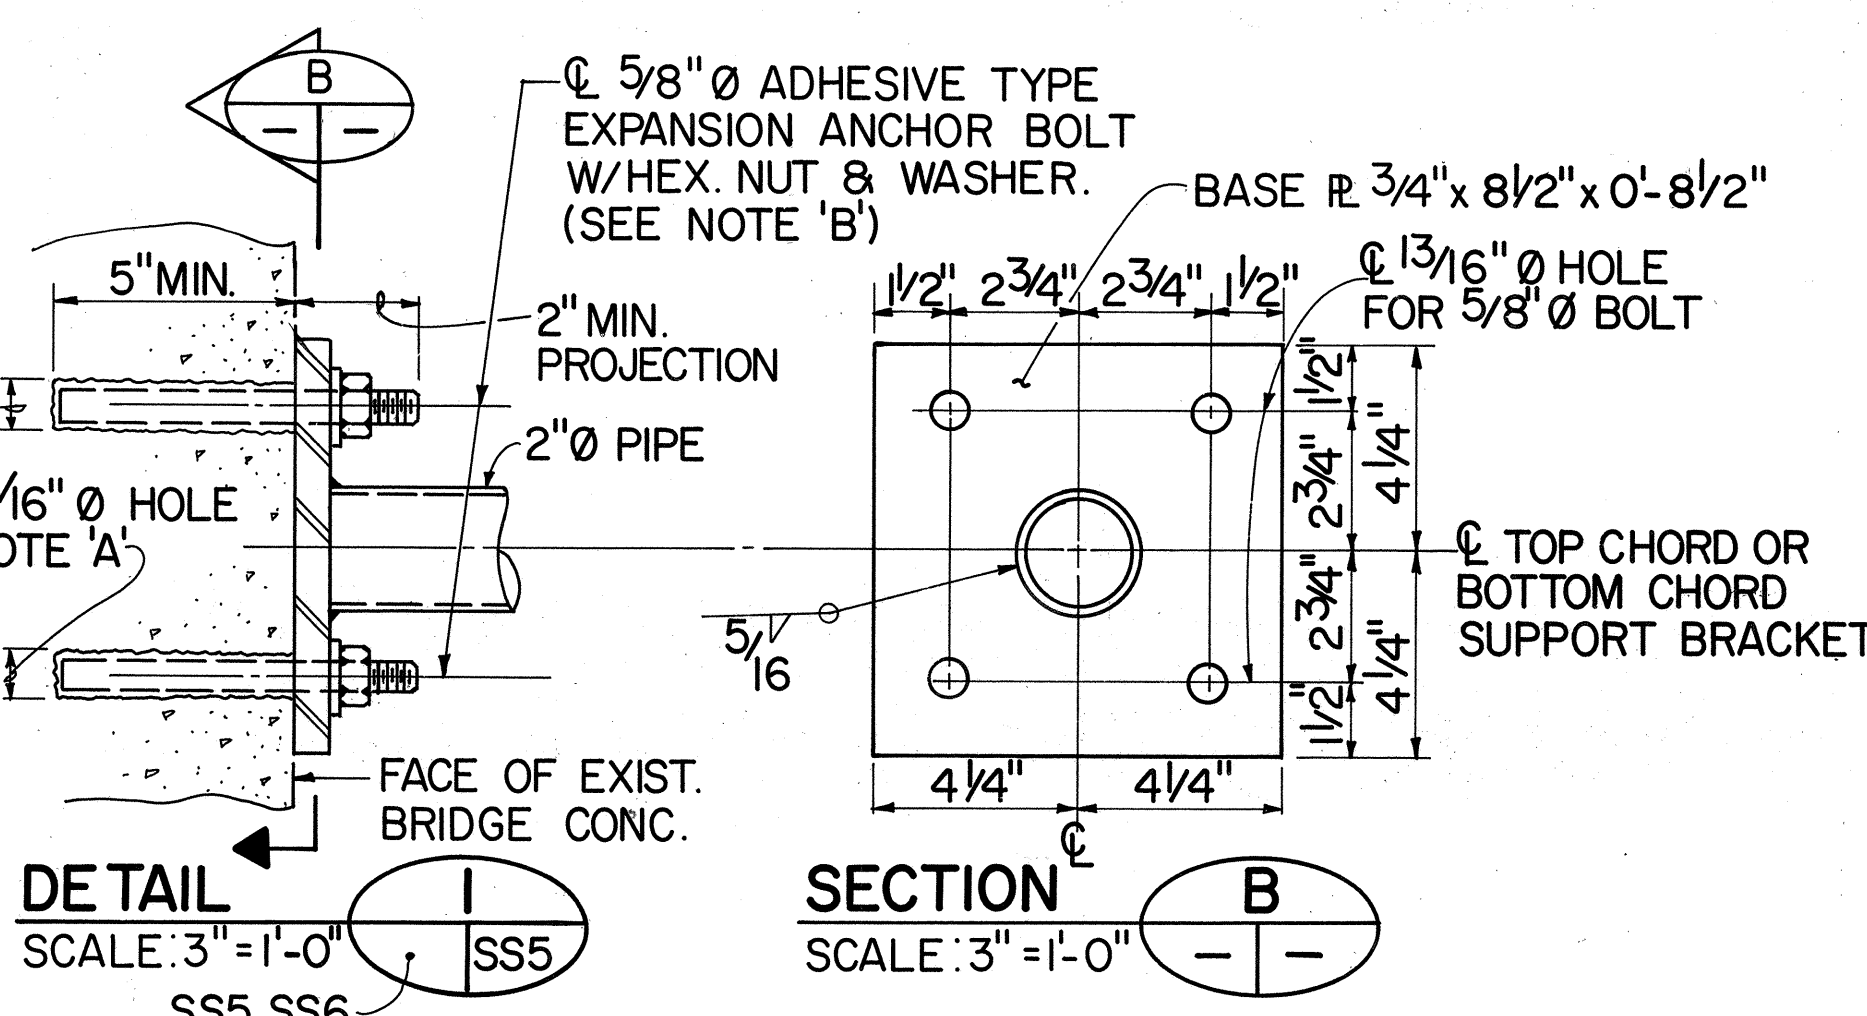


SECTION B
SCALE: 3/4"=1'-0"

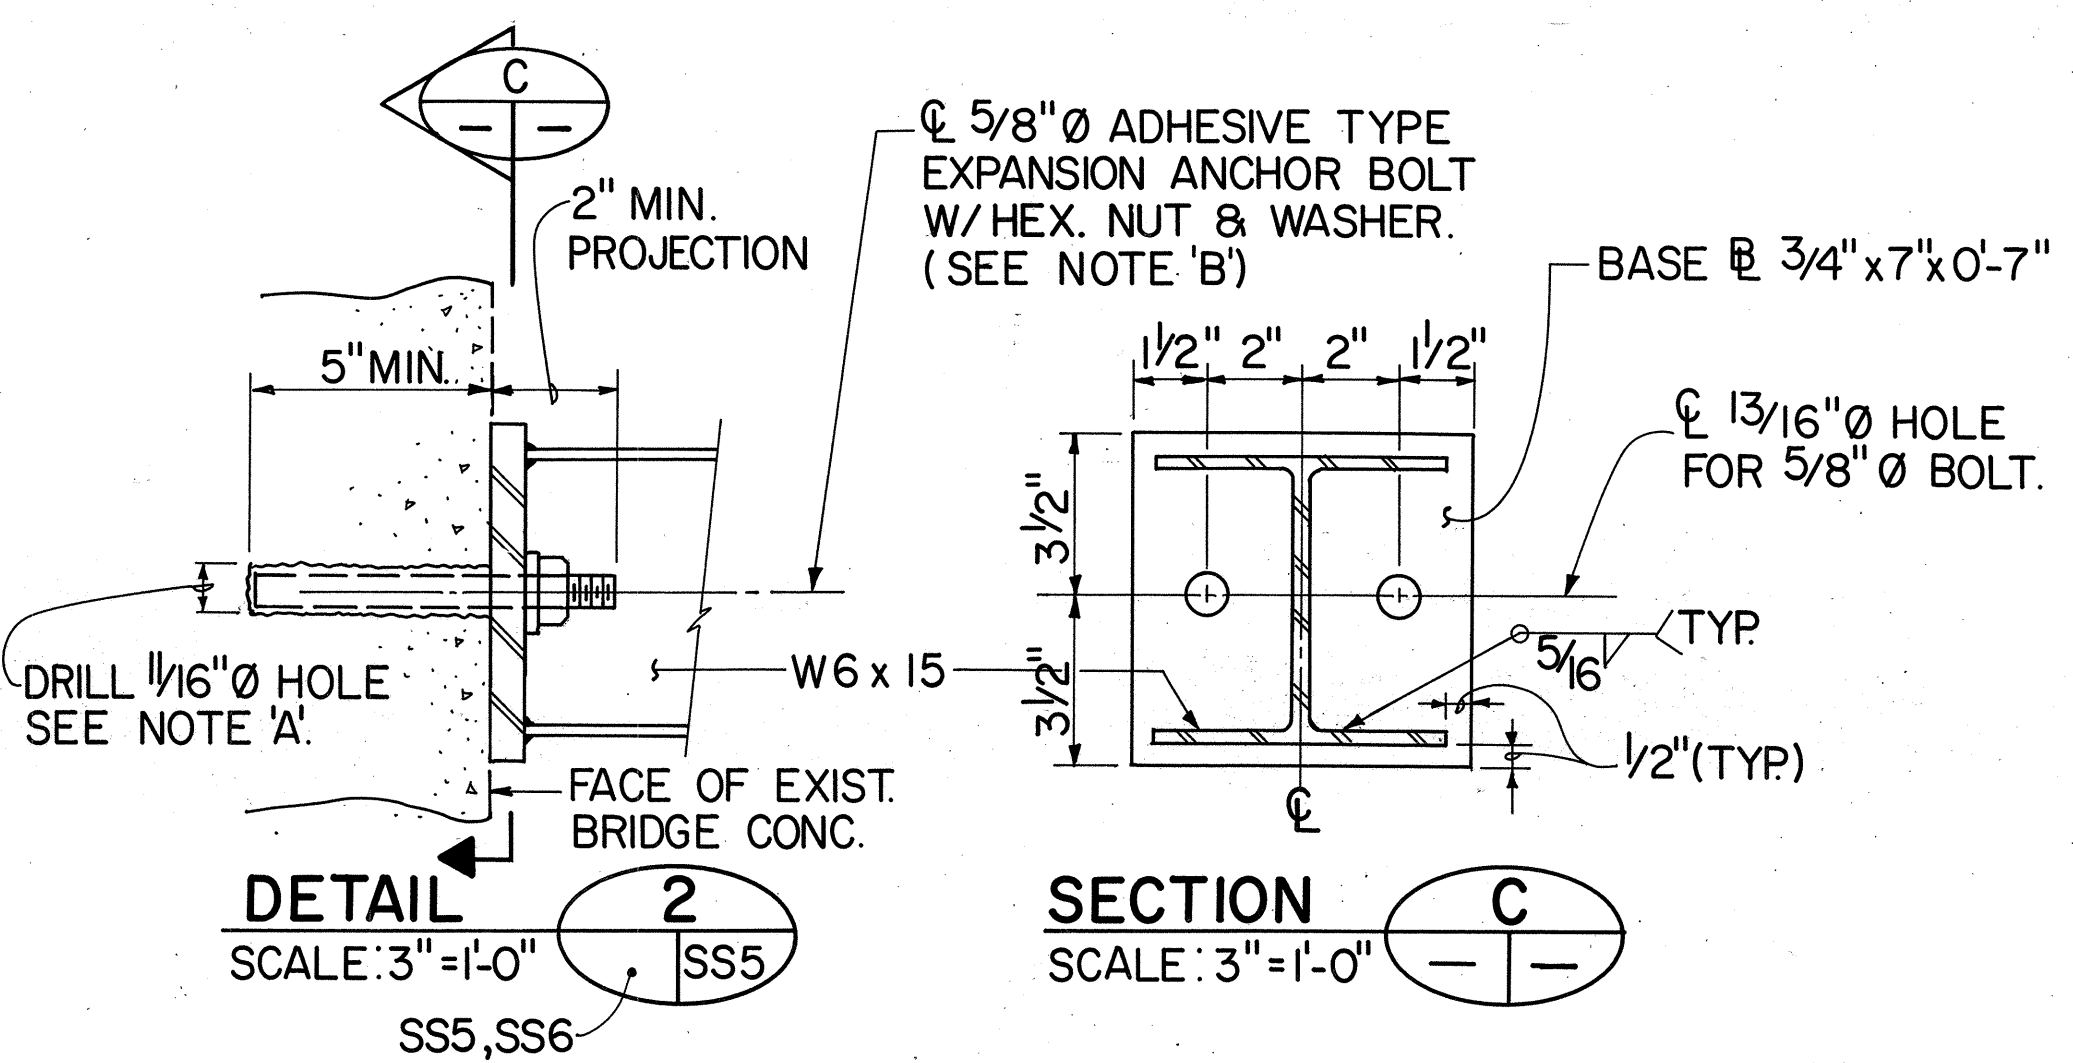

SECTION C
SCALE: 3/4"=1'-0"

NOTE 'A':
DRILL 1/16" Ø HOLE INTO EXISTING BRIDGE CONCRETE AND INSTALL 5/8" Ø ADHESIVE TYPE EXPANSION ANCHOR BOLT. THE HOLES FOR EXPANSION ANCHOR BOLTS SHALL BE DRILLED PERPENDICULAR TO THE EXISTING CONCRETE SURFACES. WHEN THE DRILL CONTACTS ANY EXISTING RE-BAR, THE HOLE SHALL BE FILLED WITH EPOXY GROUT AND A REPLACEMENT HOLE SHALL BE DRILLED SO THAT THE ANCHOR BOLT PATTERN IS MAINTAINED. THE CONTRACTOR SHALL AVOID CUTTING EXISTING RE-BARS. THE ADHESIVE TYPE EXPANSION ANCHOR BOLT SHALL BE INSTALLED AS PER REQUIREMENT OF MANUFACTURER (NIC)

NOTE 'B':
5/8" Ø ADHESIVE TYPE EXPANSION ANCHOR BOLT SHALL BE GALVANIZED & DEVELOP A MINIMUM ULTIMATE PULLING FORCE OF 13,500 LBS AND A MINIMUM ULTIMATE SHEAR FORCE OF 11,200 LBS.

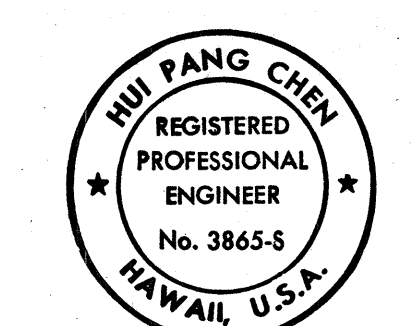

THIS WORK WAS PREPARED BY ME OR UNDER MY SUPERVISION.
Hui Pang Chen

3/8/96	REV. PER DCN 65-044
12/14/93	REVISED 'LOCATION PLAN' TO INDICATE NEW LOCATION OF VMS 38 AND RELOCATION OF EXISTING STREET SIGN PER DCN65-022
DATE	REVISION


STATE OF HAWAII
DEPARTMENT OF TRANSPORTATION
HIGHWAYS DIVISION

DETAILS FOR VMS 38


SUPPORT STRUCTURES
INTERSTATE ROUTE H-3
F.A.I. PROJ. NO. I-H3-1 (65)

SCALE: AS SHOWN DATE: DEC. 1991
SHEET No. SS5 OF 19 SHEETS


ORIGINAL PLAN	DATE
DRAWN BY	DATE
NOTED BY	DATE
CHECKED BY	DATE

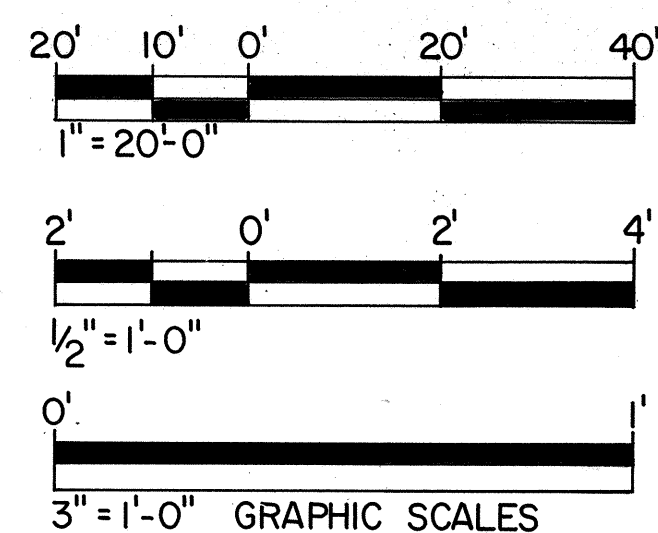


FED. ROAD DIST. NO.	STATE	FED. AID PROJ. NO.	FISCAL YEAR	SHEET NO.	TOTAL SHEETS
HAWAII	HAW.	I-H3-1(65)	1992	292	309

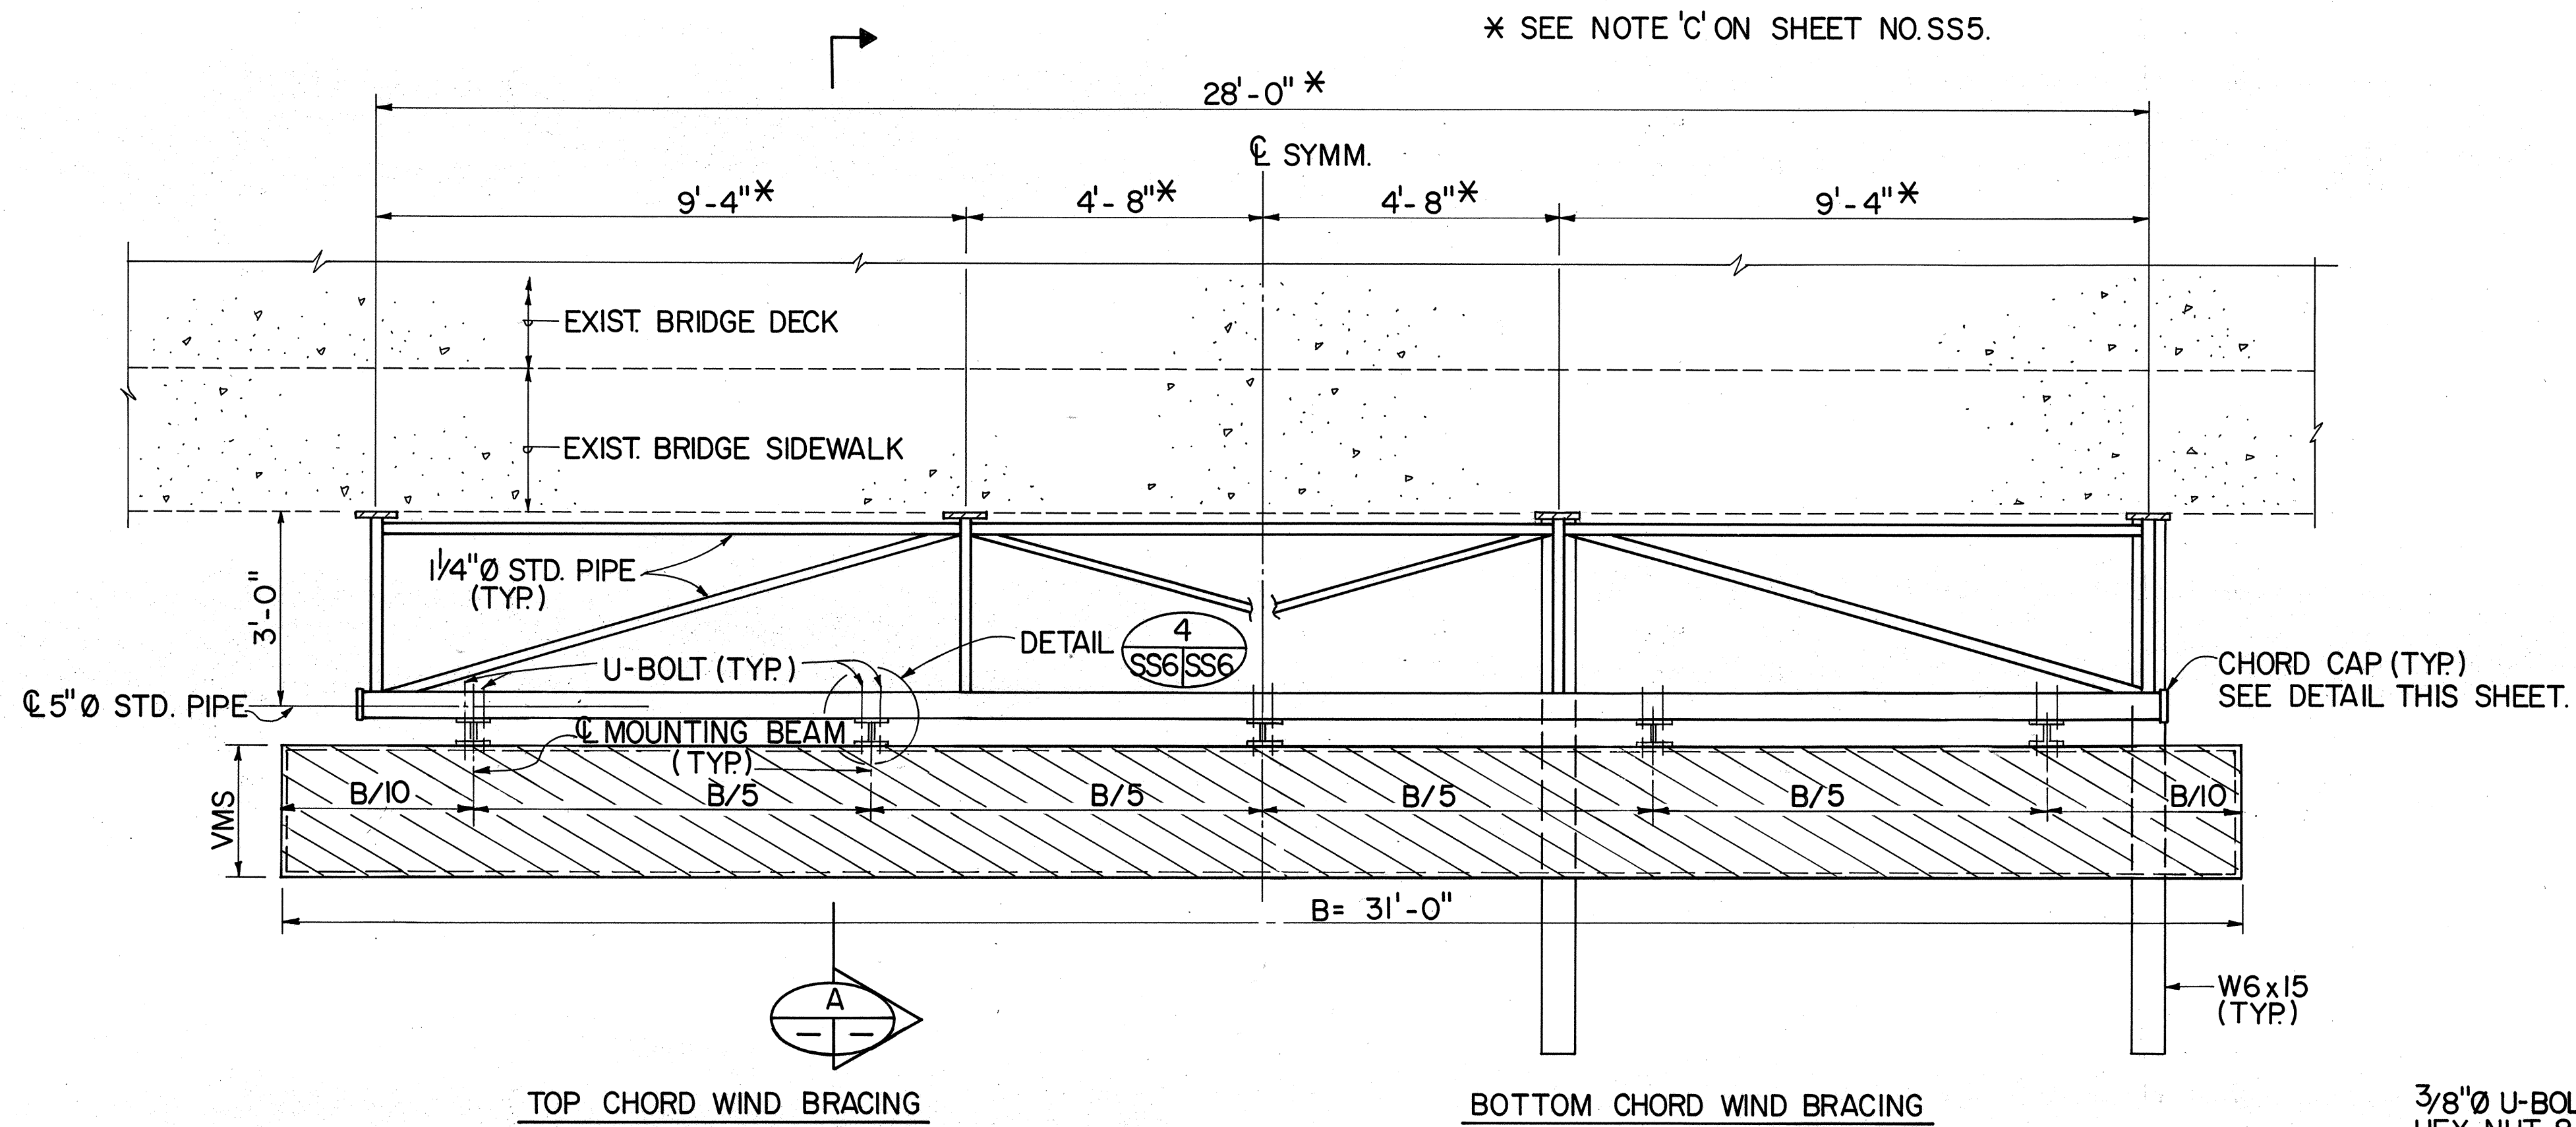


PLAN - VMS 41 MOUNTED ON EXISTING BRIDGE
SCALE: 1/2" = 1'-0"

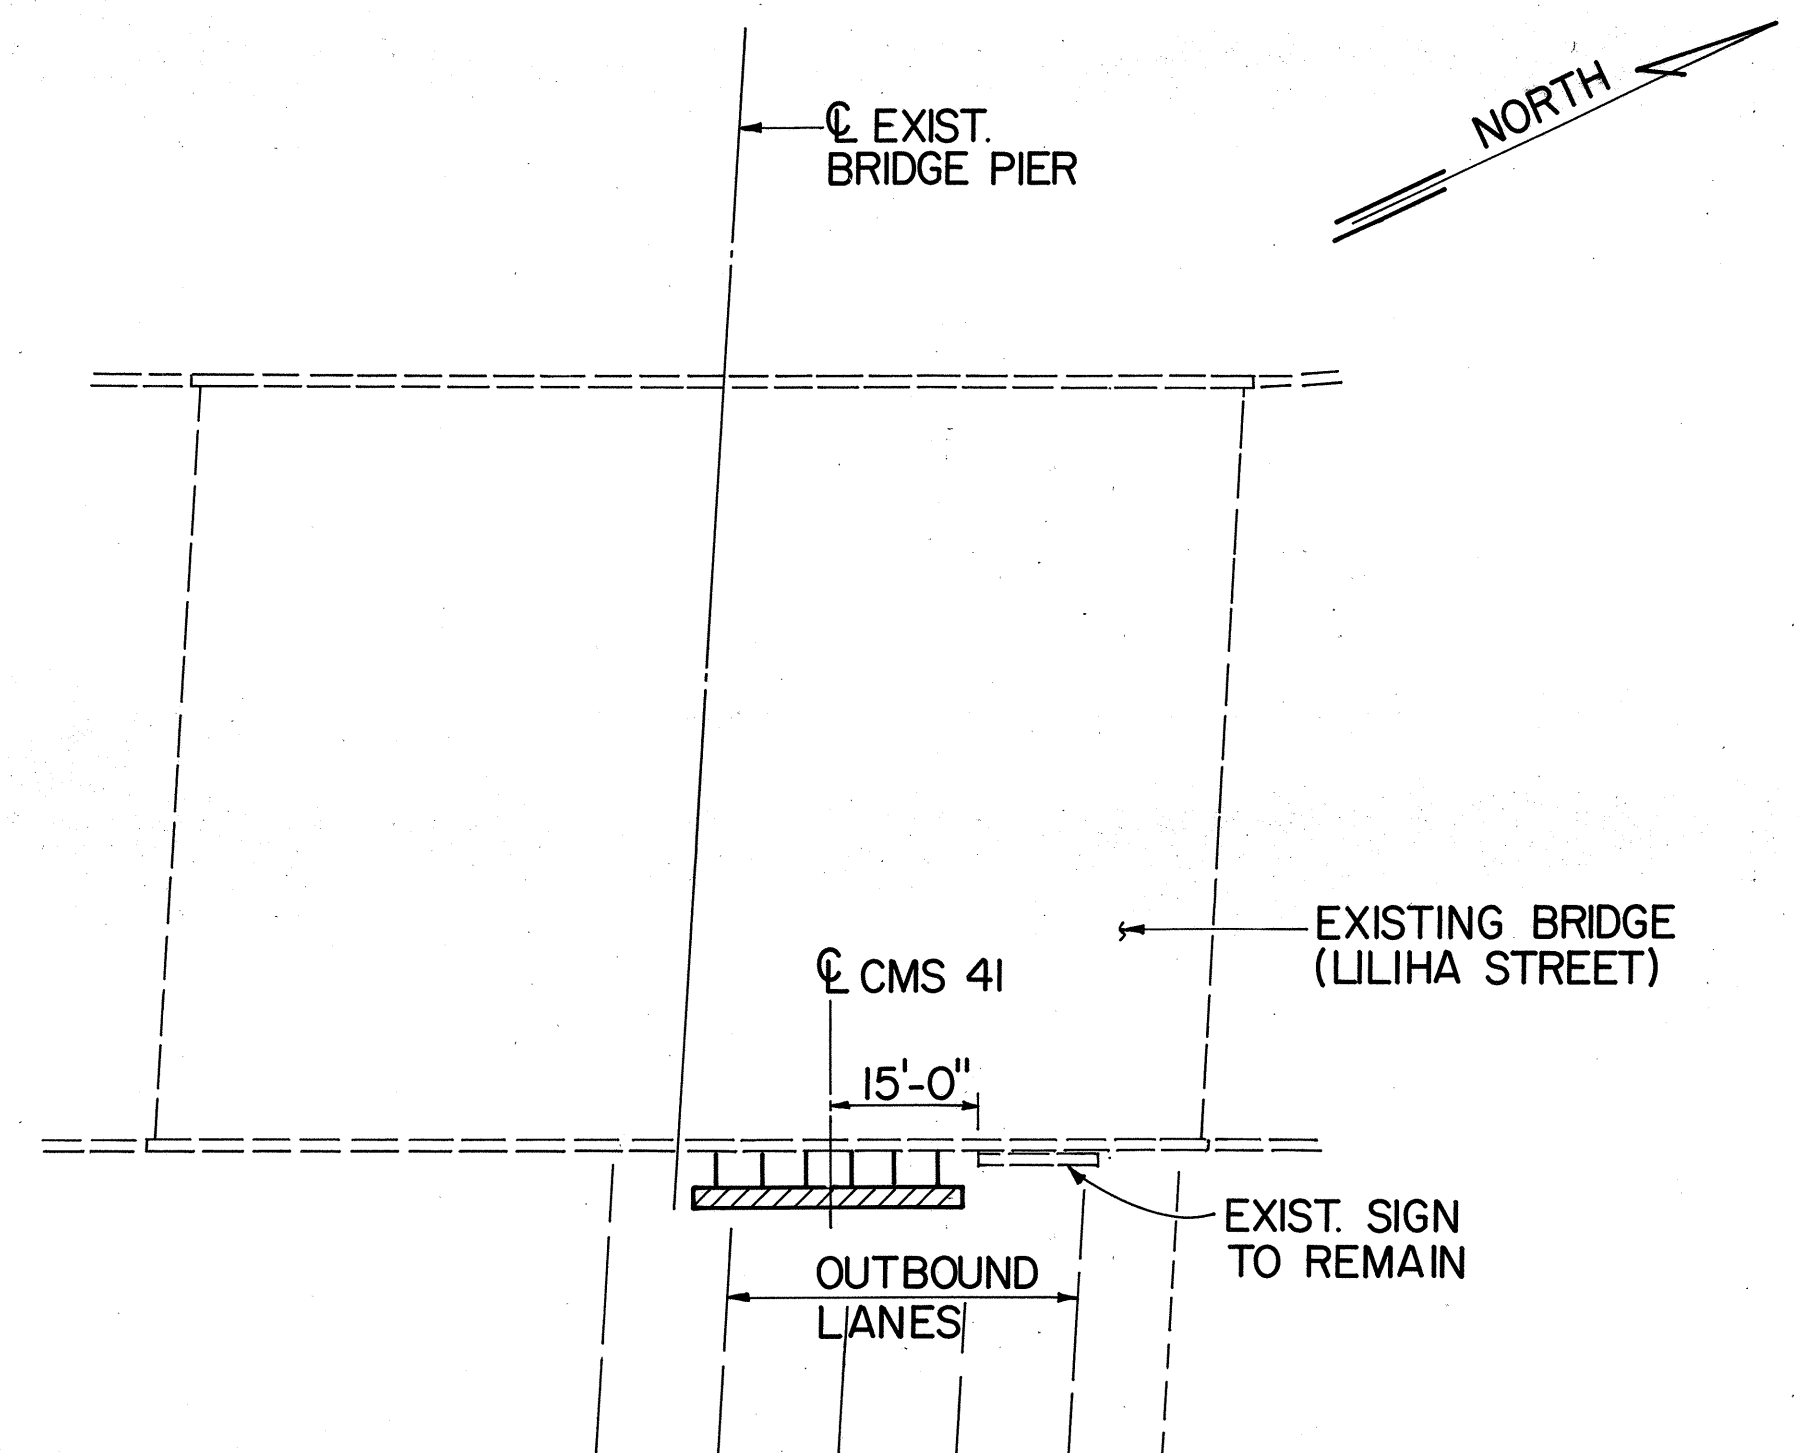


LOCATION PLAN
SCALE: 1" = 20'

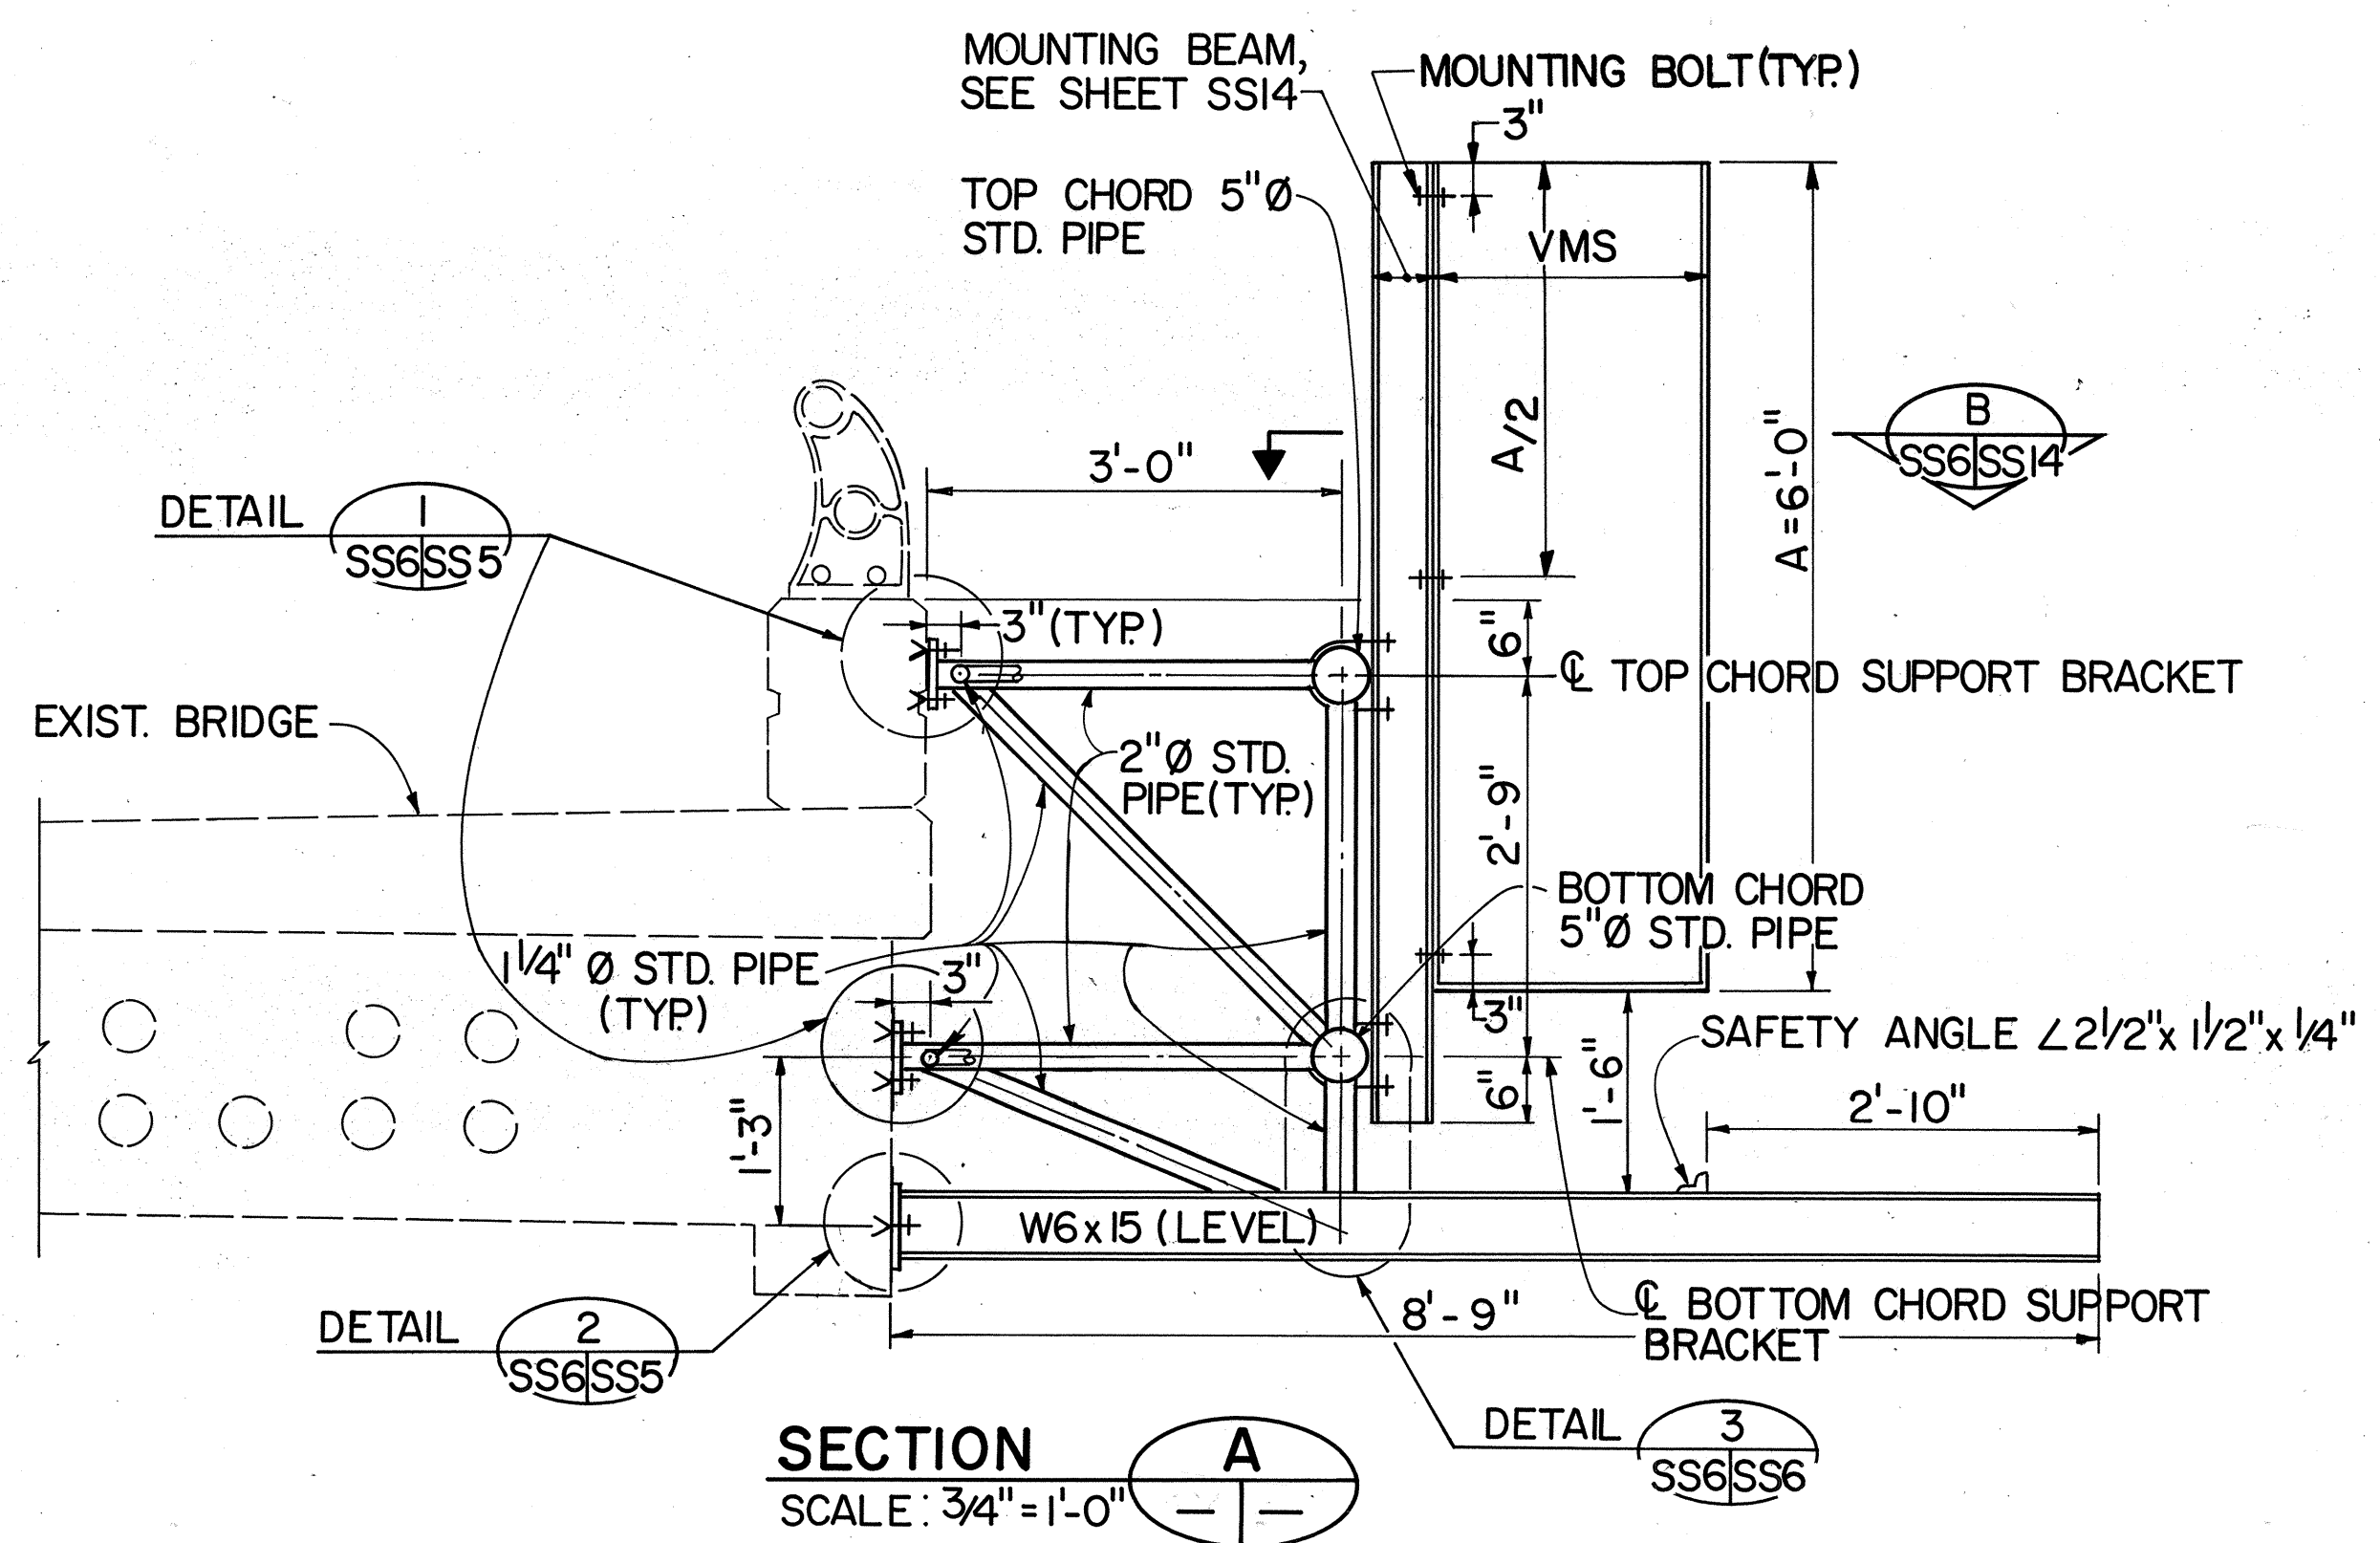


SECTION A
SCALE: 3/4" = 1'-0"

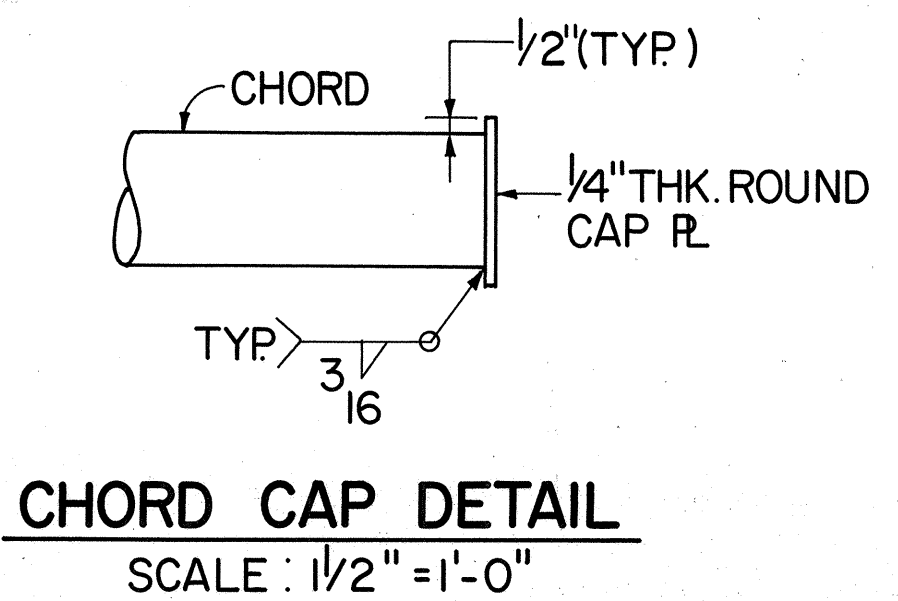


CHORD CAP DETAIL
SCALE: 1/2" = 1'-0"

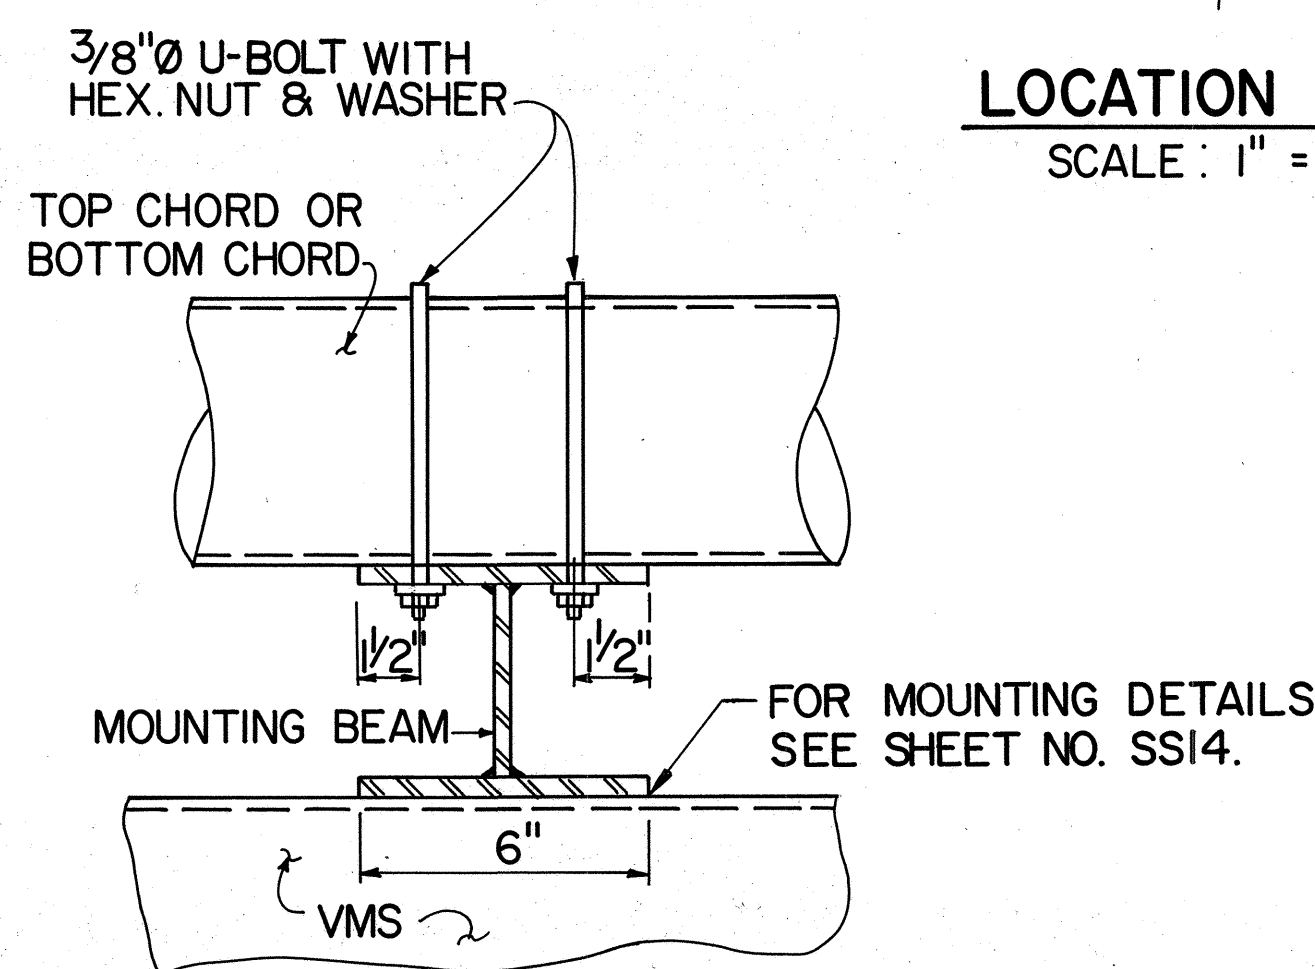

DETAIL 4
SCALE: 3" = 1'-0"
SS5, SS6

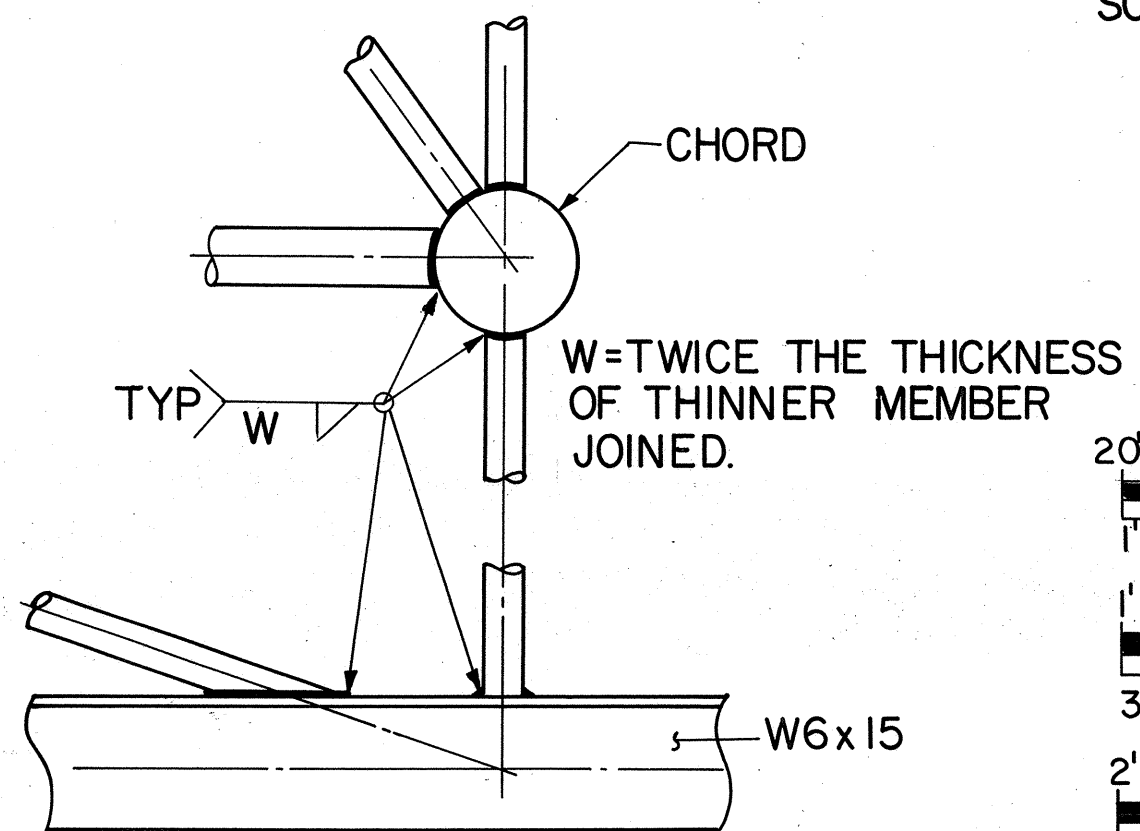

DETAIL 3
SCALE: 1/2" = 1'-0"
SS5, SS6

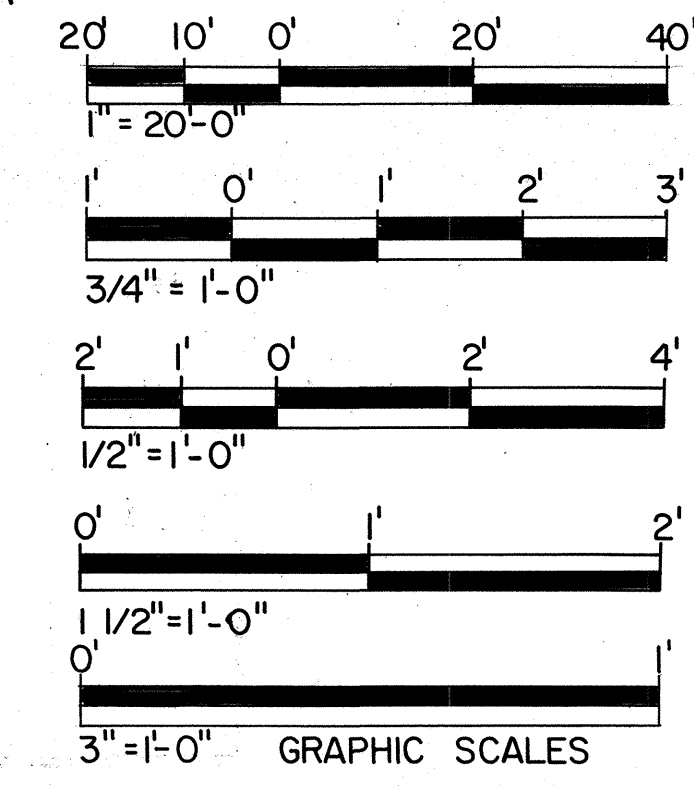


**** INSTALLATION OF SIGN AND ASSOCIATE MOUNTING HARDWARE NIC**

ORIGINAL PLAN	DATE
DRAWN BY	5/91
CHECKED BY	5/91
NOTED BY	5/91
QUANTITIES BY	5/91
CHECKED BY	5/91

HUI PANG CHEN
REGISTERED PROFESSIONAL ENGINEER
No. 28654
HAWAII, U.S.A.

3/8/96	REV. PER DCN 65-044
DATE	REVISION
STATE OF HAWAII DEPARTMENT OF TRANSPORTATION HIGHWAYS DIVISION	
DETAILS FOR VMS 41	
SUPPORT STRUCTURES INTERSTATE ROUTE H-3 F.A.I. PROJ. NO. I-H3-1(65)	
SCALE: AS SHOWN	DATE: DEC. 1991
SHEET No. SS6 OF 19 SHEETS	

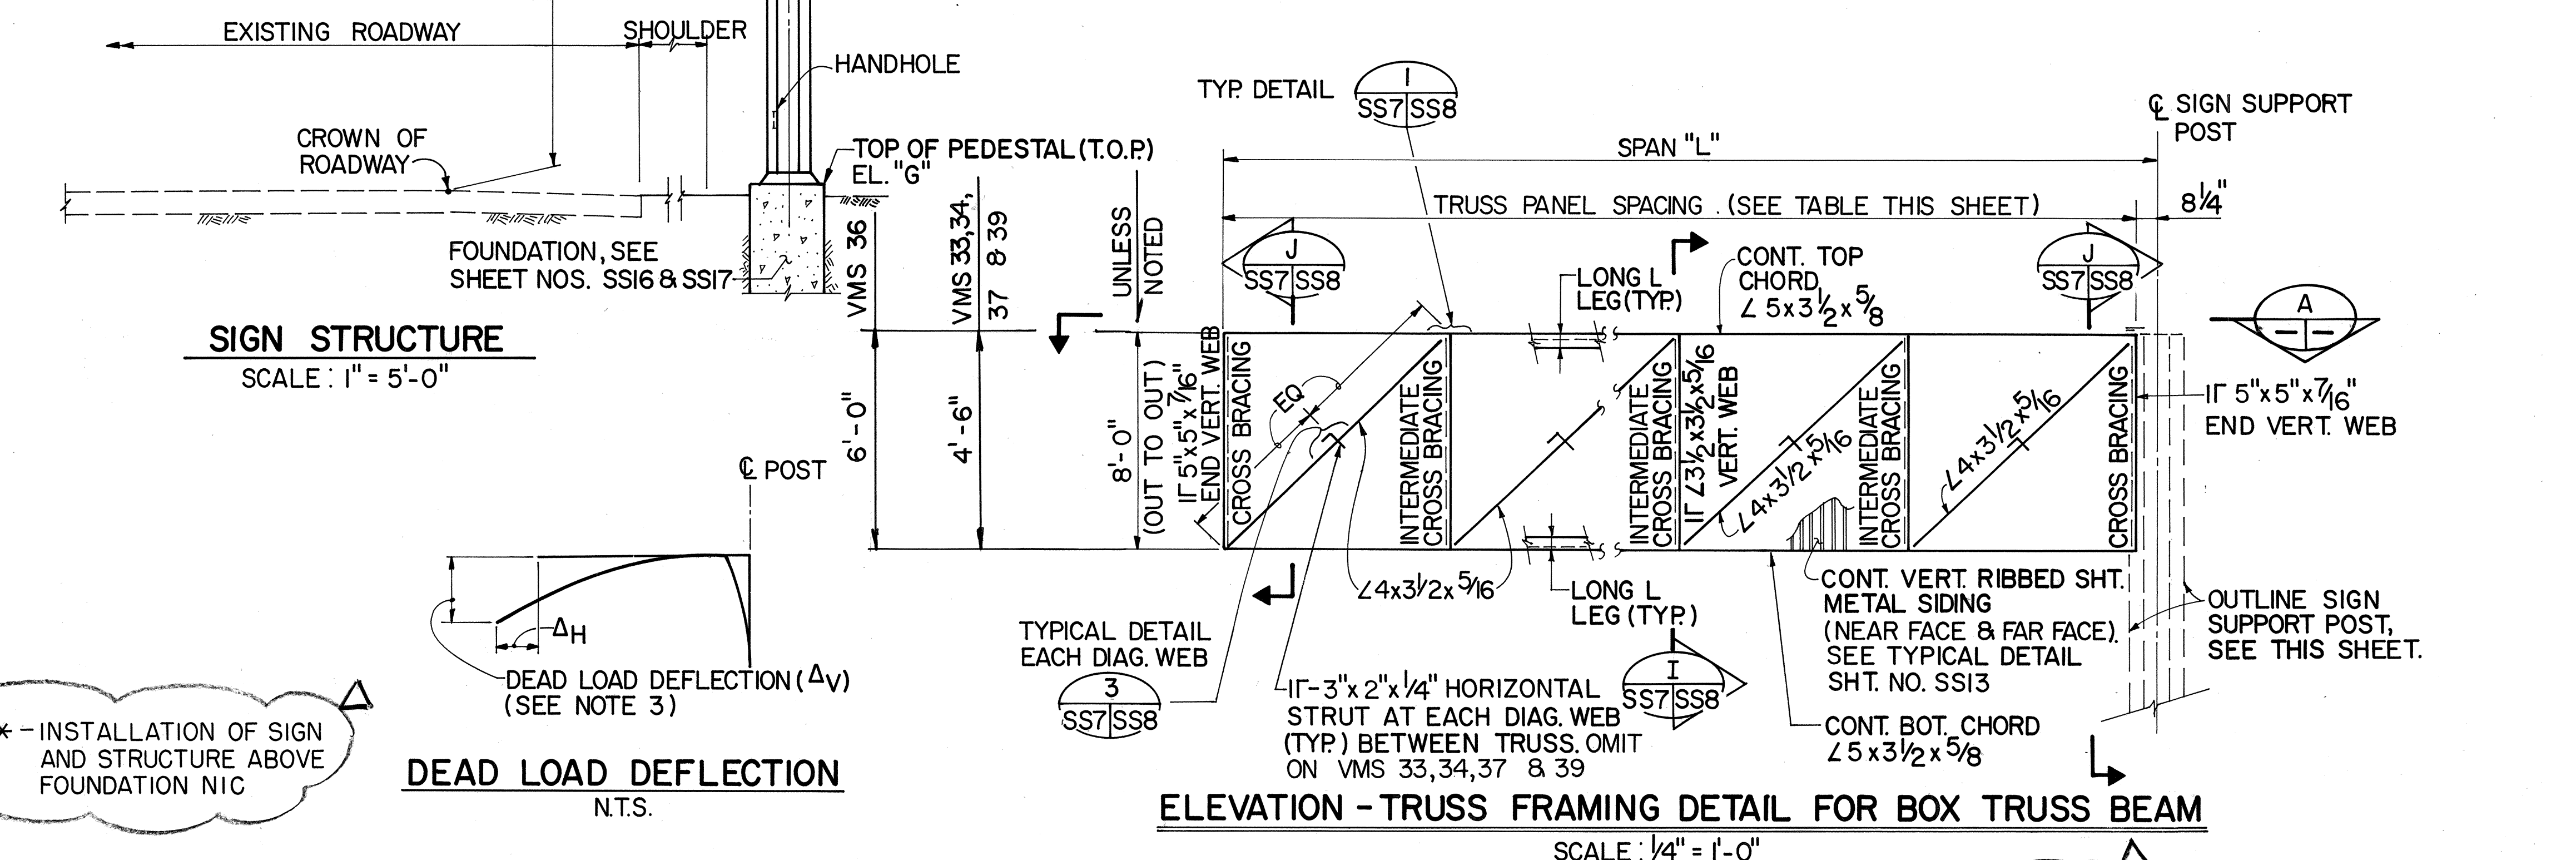

NOTES:

1. FOR LOCATIONS OF SIGNS AND WALKWAY SUPPORTS, SEE SHEET NO. SS10.
2. FOR BOX TRUSS CONNECTION DETAILS, SEE SHEET NOS. SS8 & SS9.
3. THE DEAD LOAD DEFLECTION INCLUDES THE EFFECT OF THE WEIGHT OF THE TRUSS. A CAMBER SHALL BE PROVIDED TO ACCOMMODATE THIS DEFLECTION.
4. FOR POST & BASE PLATE TYPES, SEE SHEET NO. SS12.
- *5. SEE NOTE 17 ON SHEET NO. SS16.

5' 0' 5' 10'

1" = 5'-0"

4' 0' 4' 8'

1/4" = 1'-0"

2' 0' 2' 4'

1/2" = 1'-0" GRAPHIC SCALES

HUI PANG CHEN
REGISTERED
PROFESSIONAL
ENGINEER
No. 3865-S
HAWAII, U.S.A.

**THIS WORK WAS PREPARED BY ME
OR UNDER MY SUPERVISION**

Hui Pang Chen

STATE OF HAWAII
DEPARTMENT OF TRANSPORTATION
HIGHWAYS DIVISION


DETAILS FOR VMS 33 TO 37, 39, 40
43, 44, CMS 29 AND CMS 30

SUPPORT STRUCTURES
INTERSTATE ROUTE H-3
F.A.I. PROJ. NO. I-H3-1 (65)


SCALE: AS SHOWN DATE: DEC. 1991

SHEET NO. 557 OF 18 SHEETS

FED. ROAD DIST. NO.	STATE	FED. AID PROJ. NO.	FISCAL YEAR	SHEET NO.	TOTAL SHEETS
HAWAII	HAW.	I-H3-1(65)	1992	294	309

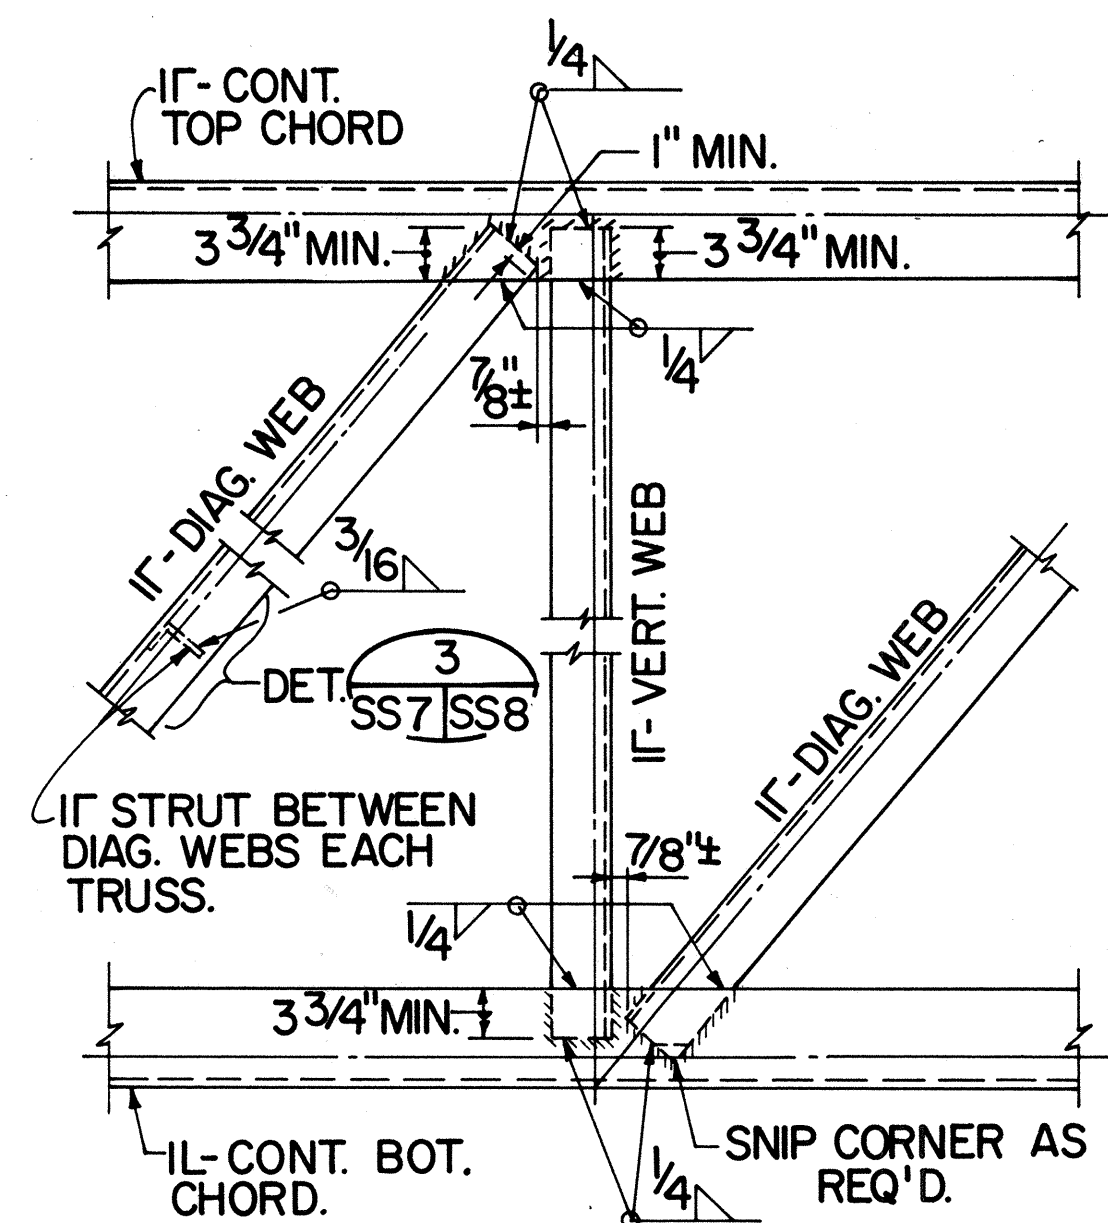


TYPICAL DETAIL 1
SCALE: 1" = 1'-0"
SS7 SS8

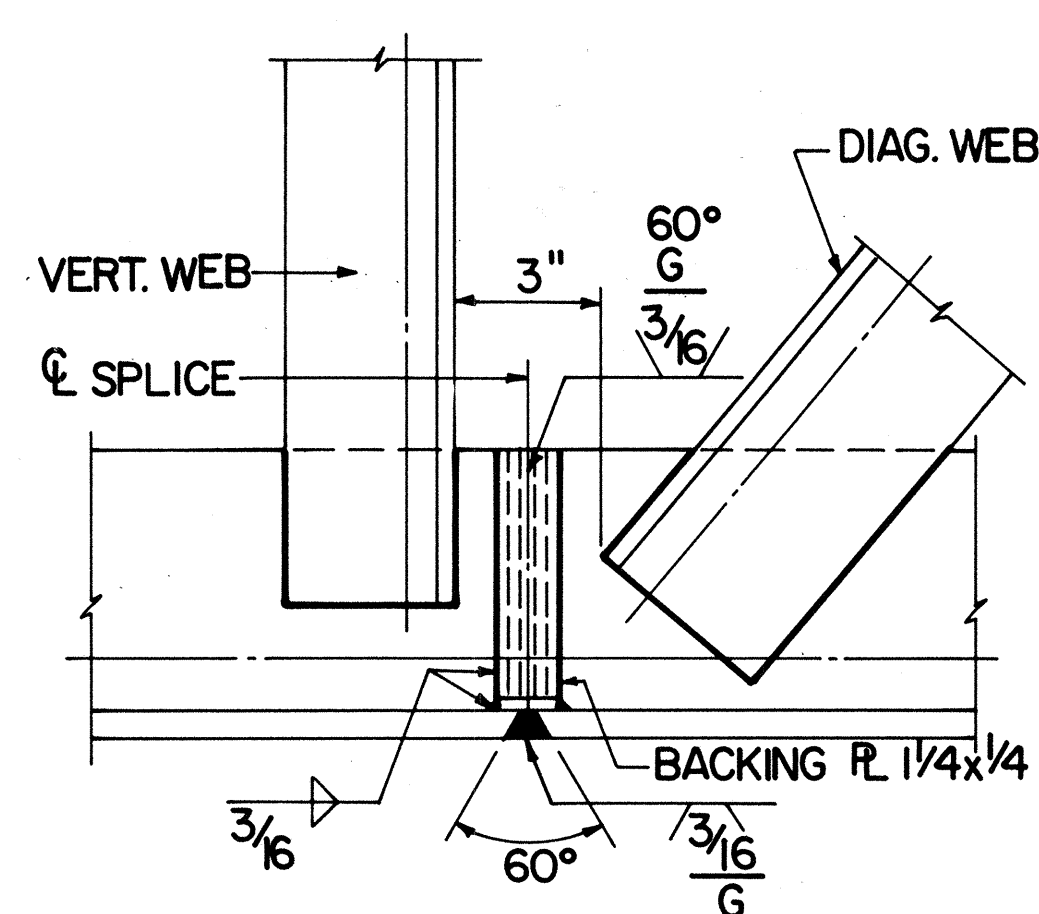


INTERIOR ELEVATION
TYPICAL TOP OR BOTTOM
TRUSS CHORD SHOP SPLICE DETAILS
SCALE: 3" = 1'-0"

NOTE: SHOP OR FIELD SPLICE LOCATIONS OF TOP & BOTTOM CHORDS AT EACH TRUSS SHALL BE STAGGERED & AT ALTERNATE LOCATIONS. INDICATE SPLICE LOCATIONS ON SHOP FABRICATION DRAWINGS FOR APPROVAL. THE SPLICE SHALL BE LOCATED SO AS NOT TO INTERFERE WITH THE MOUNTING OF THE WALKWAY BRACKETS.

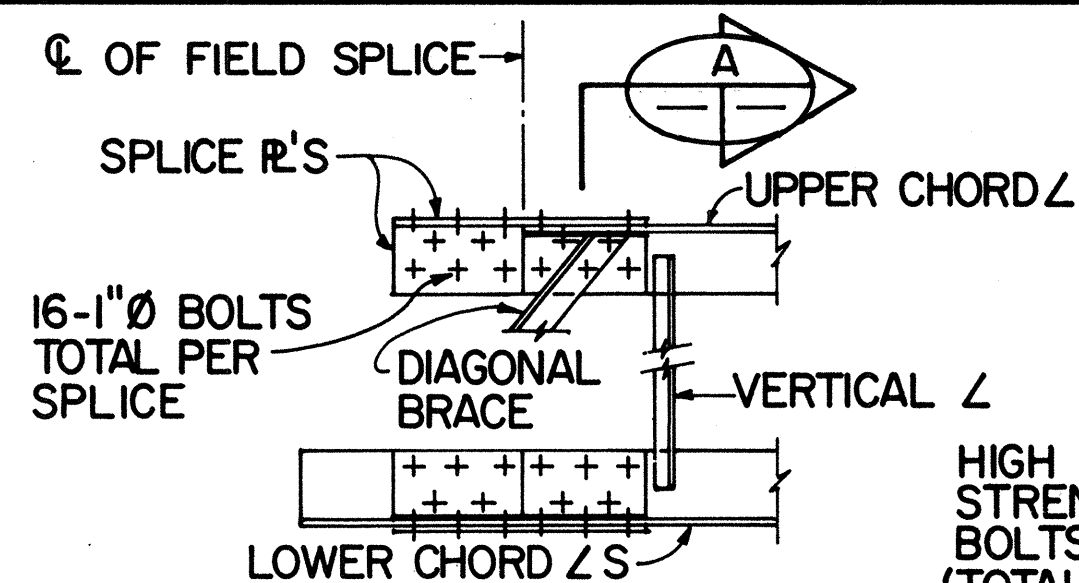


FIELD SPLICE DETAIL
N.T.S.

BUILD UP PLATE:
THE PLATES WELDED TO THE ANGLE LEGS ON THE INSIDE SHALL BE WELDED BEFORE PUNCHING THE BOLT HOLES. THEY SHALL BE THE SAME LENGTH AS THE SPLICE PLATES.

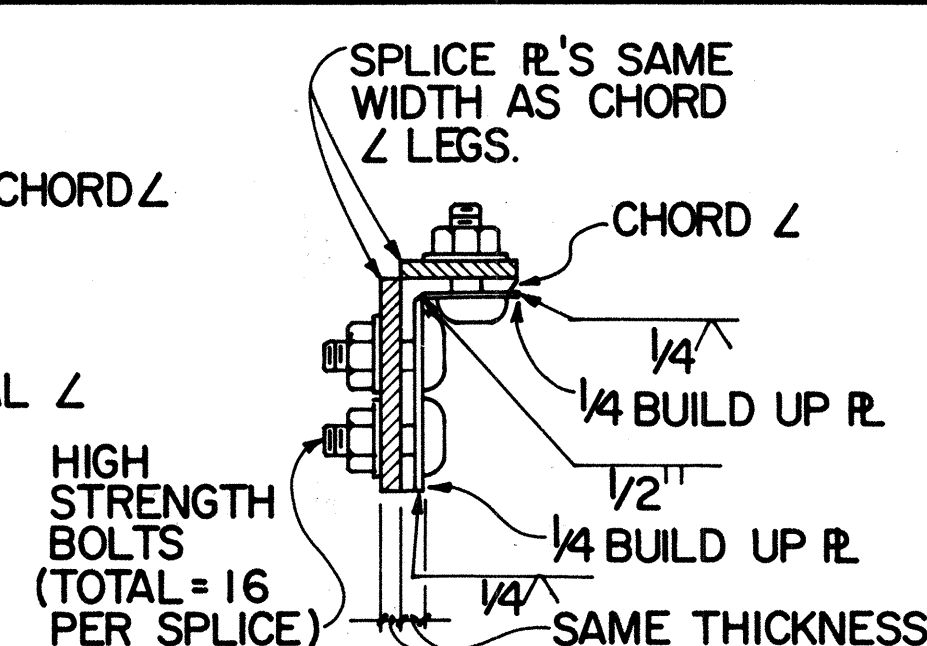


SECTION A
N.T.S.

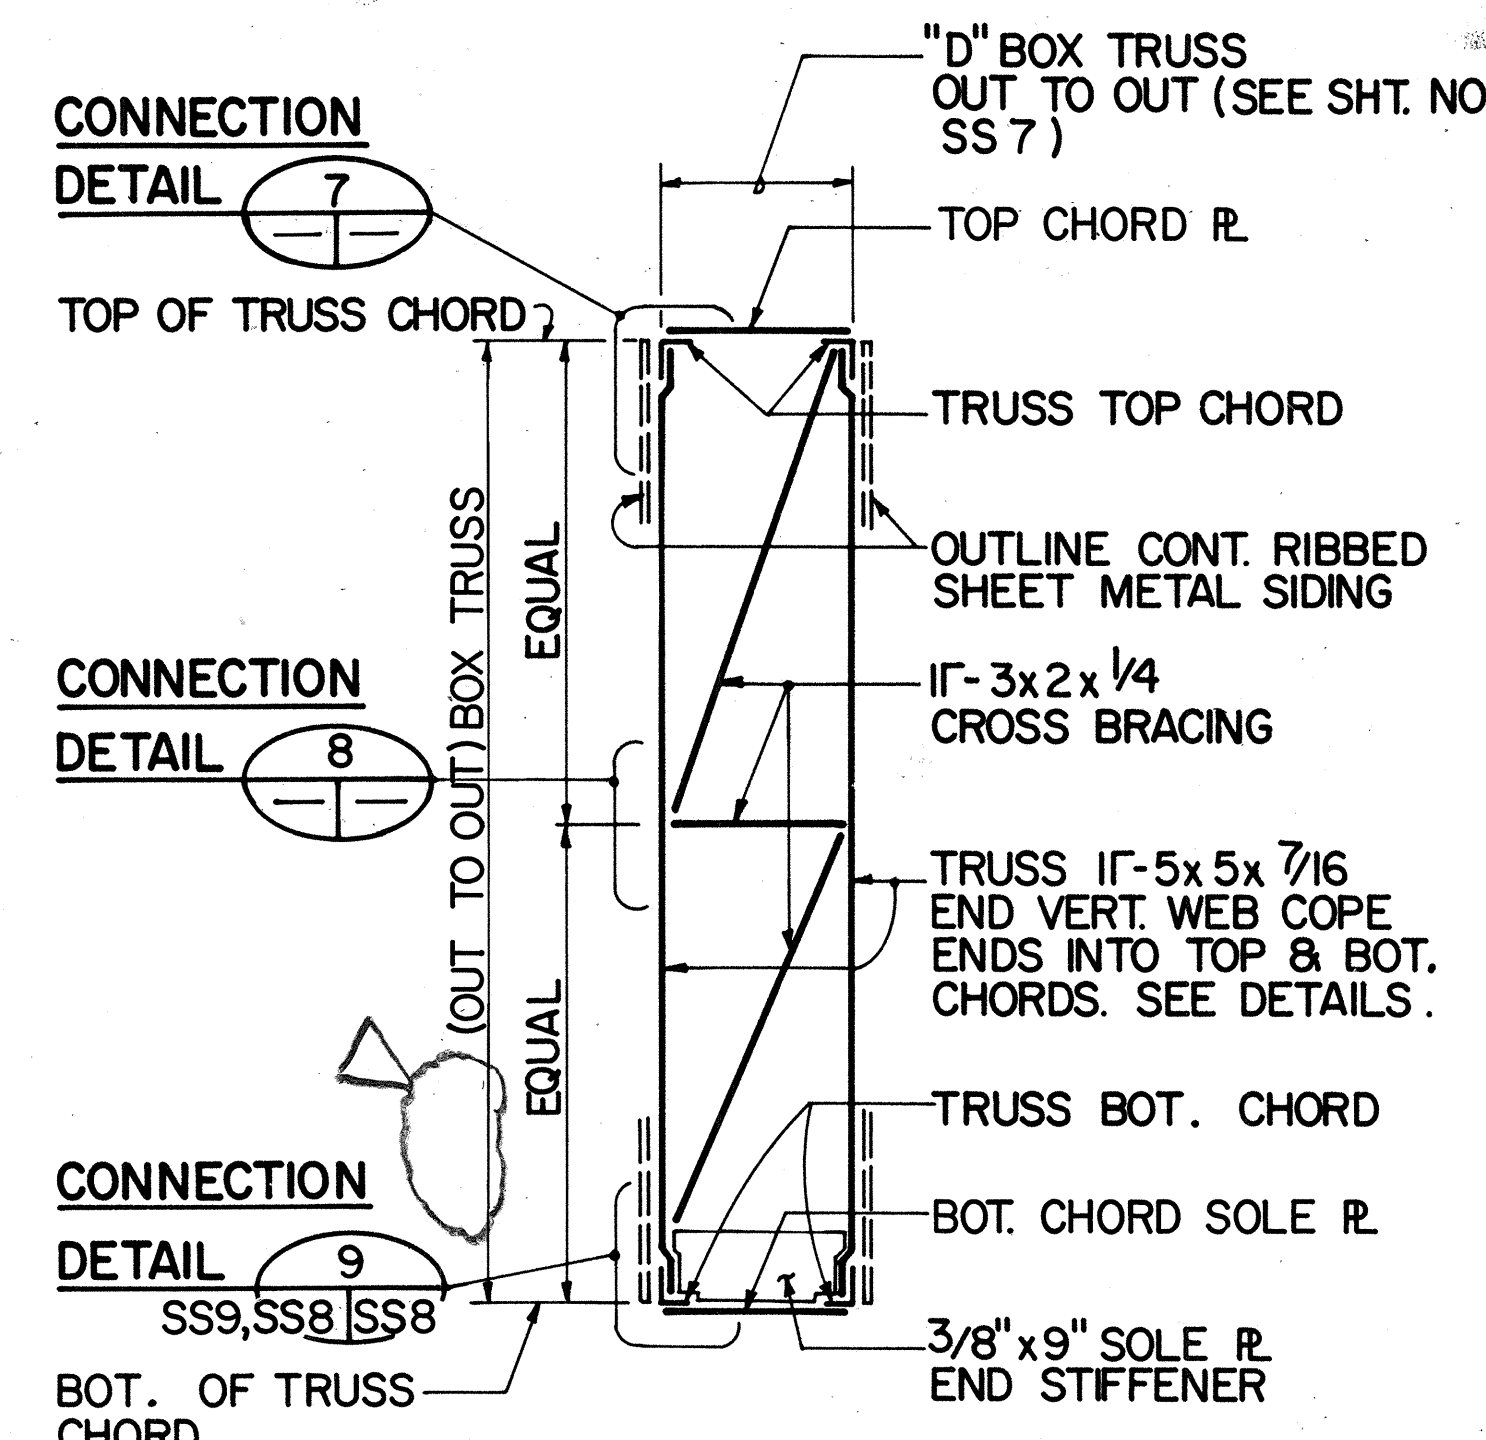

TYP. BOX TRUSS END SECTION J AS SHOWN
SCALE: 1/2" = 1'-0"
(FOR 6' & 8' DEEP TRUSS, OTHERWISE SEE NOTE A)


NOTE A: FOR DETAILS OF 4'-6" DEEP TRUSS FOR VMS 33, 34, 37 & 39 SEE SHEET NO. SS9.

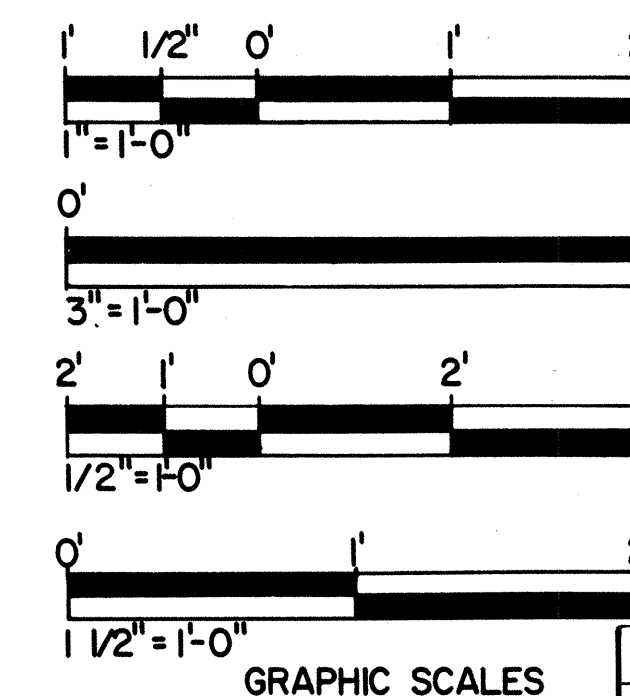


12/8/93	ADDED NOTE 'A' AND REFERENCE NOTE TO 'TYPICAL BOX TRUSS DETAILS', 'SECTION I' & 'SECTION J' PER DCN 65-019
DATE	REVISION

STATE OF HAWAII
DEPARTMENT OF TRANSPORTATION
HIGHWAYS DIVISION
BOX TRUSS CONNECTION
DETAILS-I
SUPPORT STRUCTURES
INTERSTATE ROUTE H-3
F.A.I. PROJ. NO. I-H3-1 (65)


SCALE: AS SHOWN DATE: DEC. 1991
SHEET No. SS8 OF 19 SHEETS

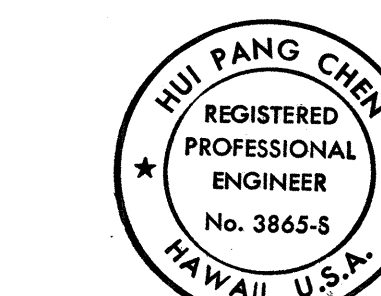


THIS WORK WAS PREPARED BY ME OR UNDER MY SUPERVISION.
Hui Pang Chen

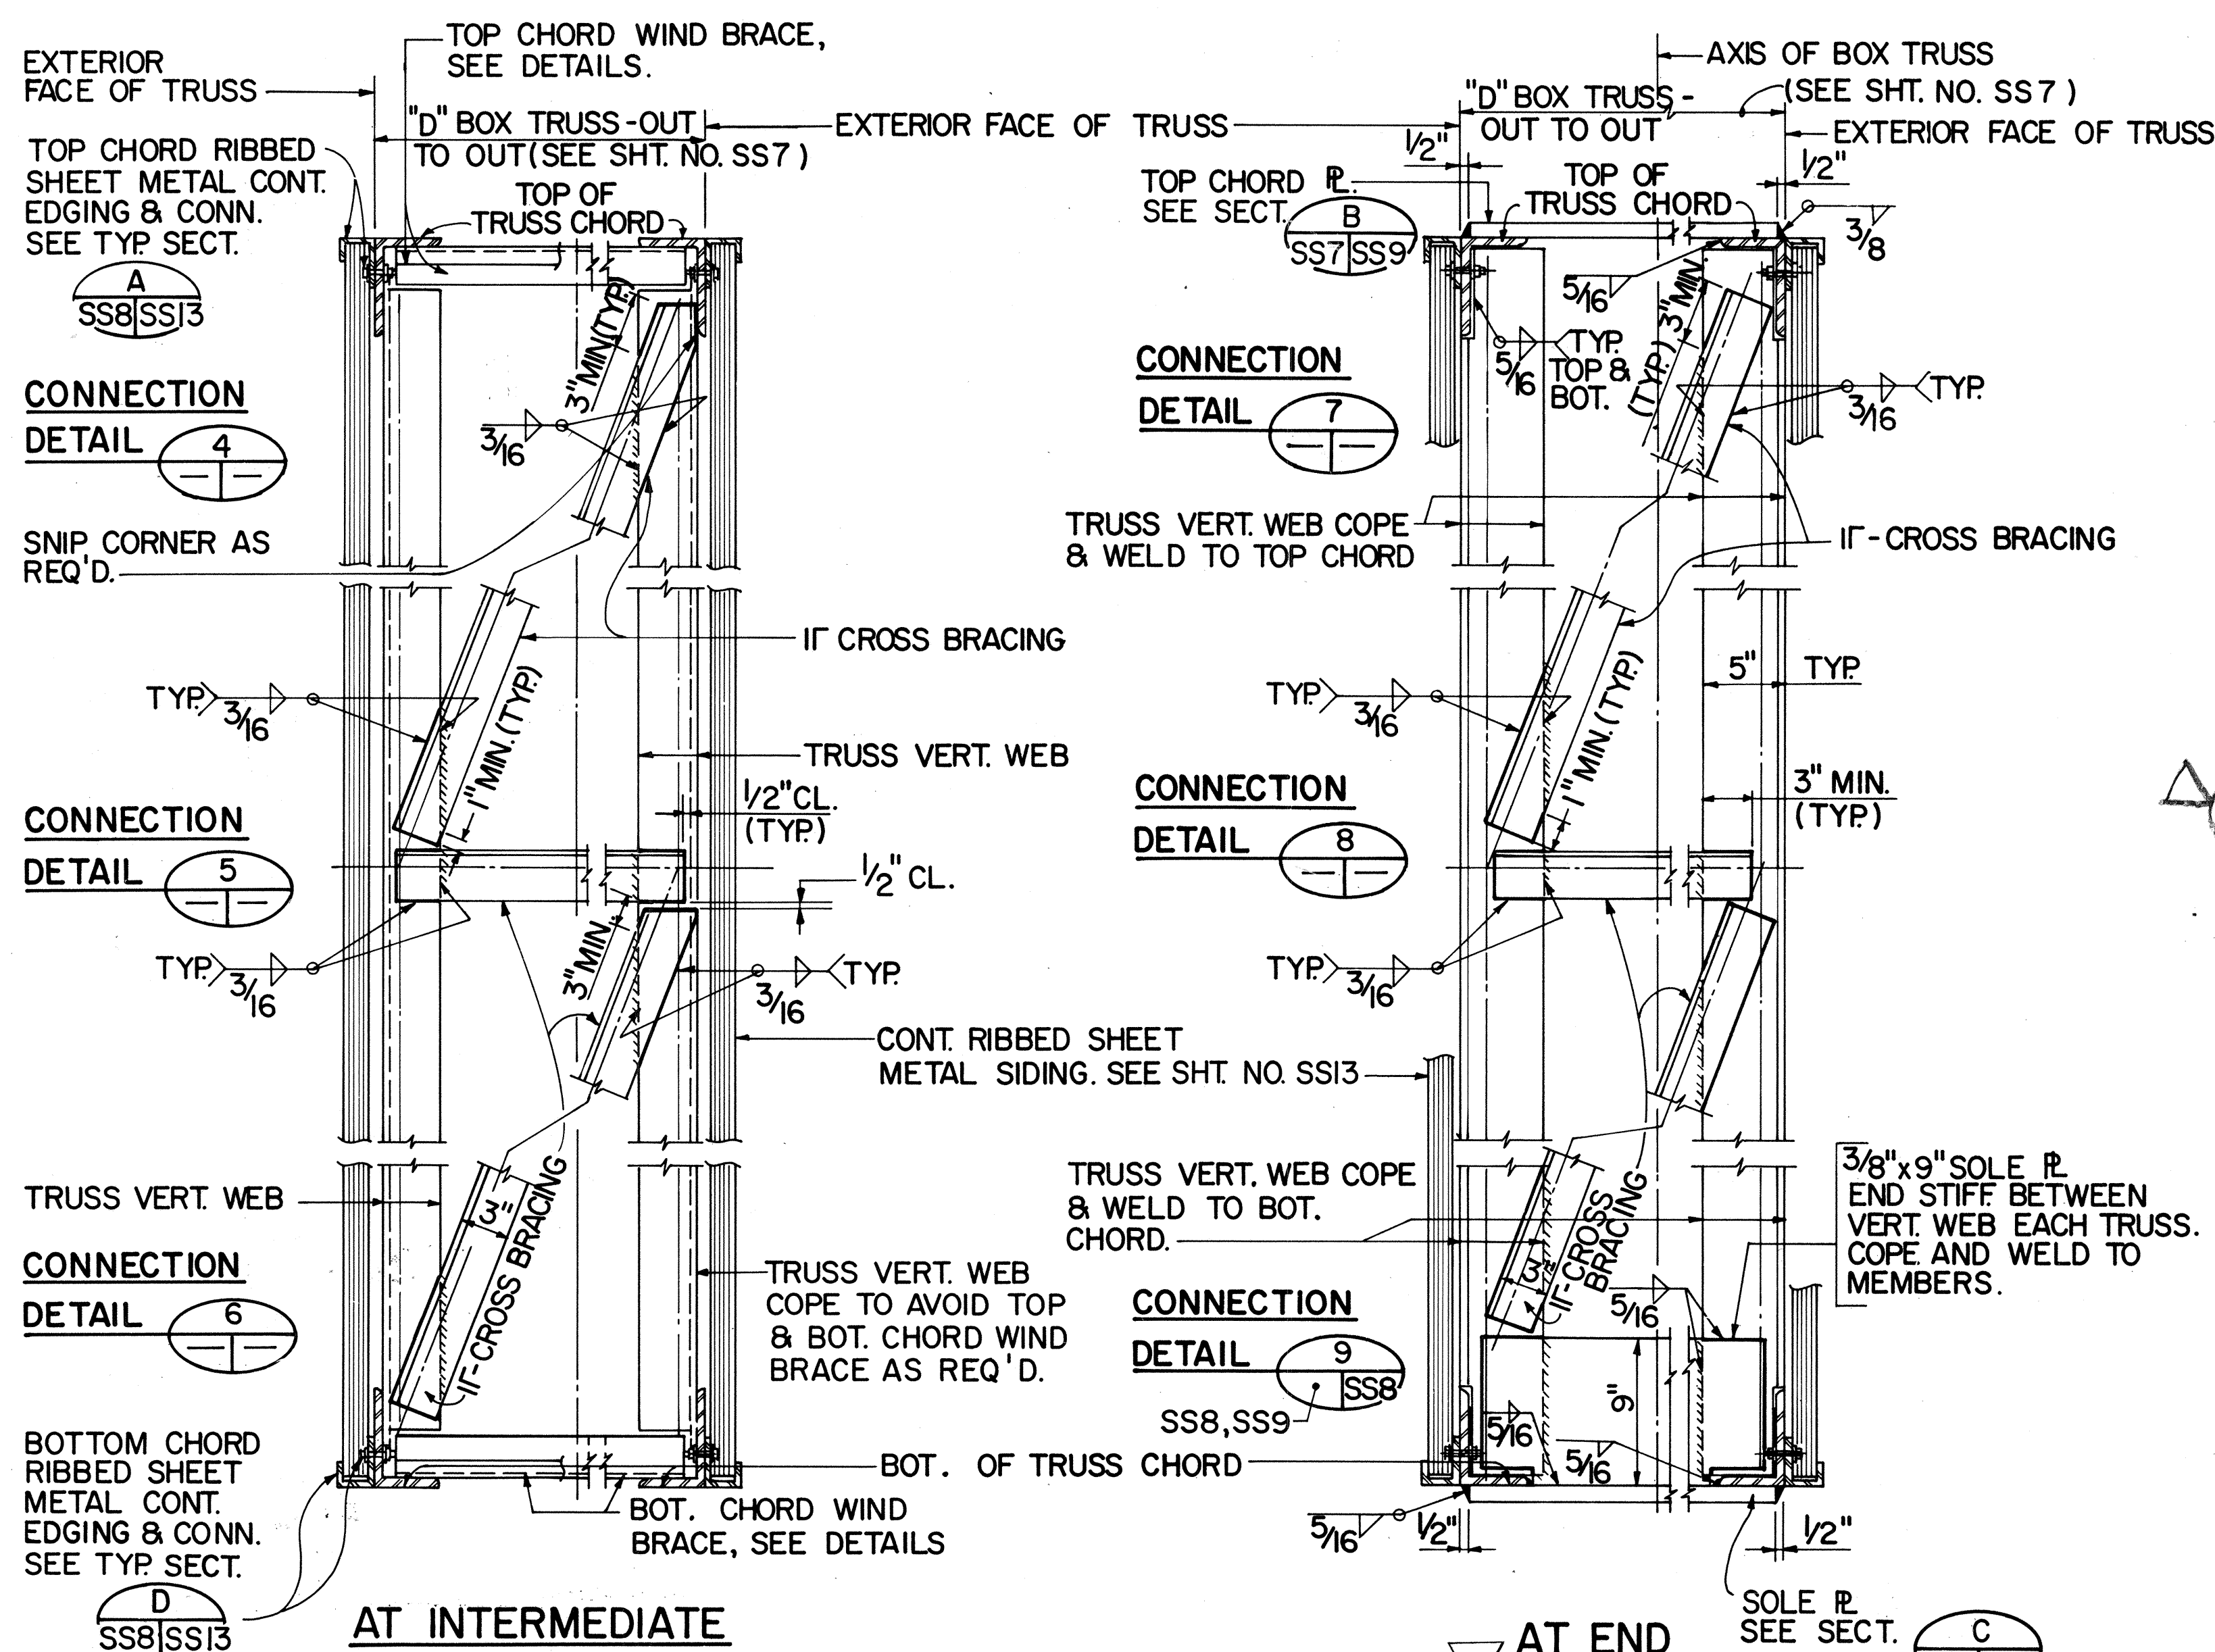

TYPICAL BOX TRUSS DETAILS
SCALE: 1/2" = 1'-0" (FOR 6' & 8' DEEP TRUSS, OTHERWISE SEE NOTE A)

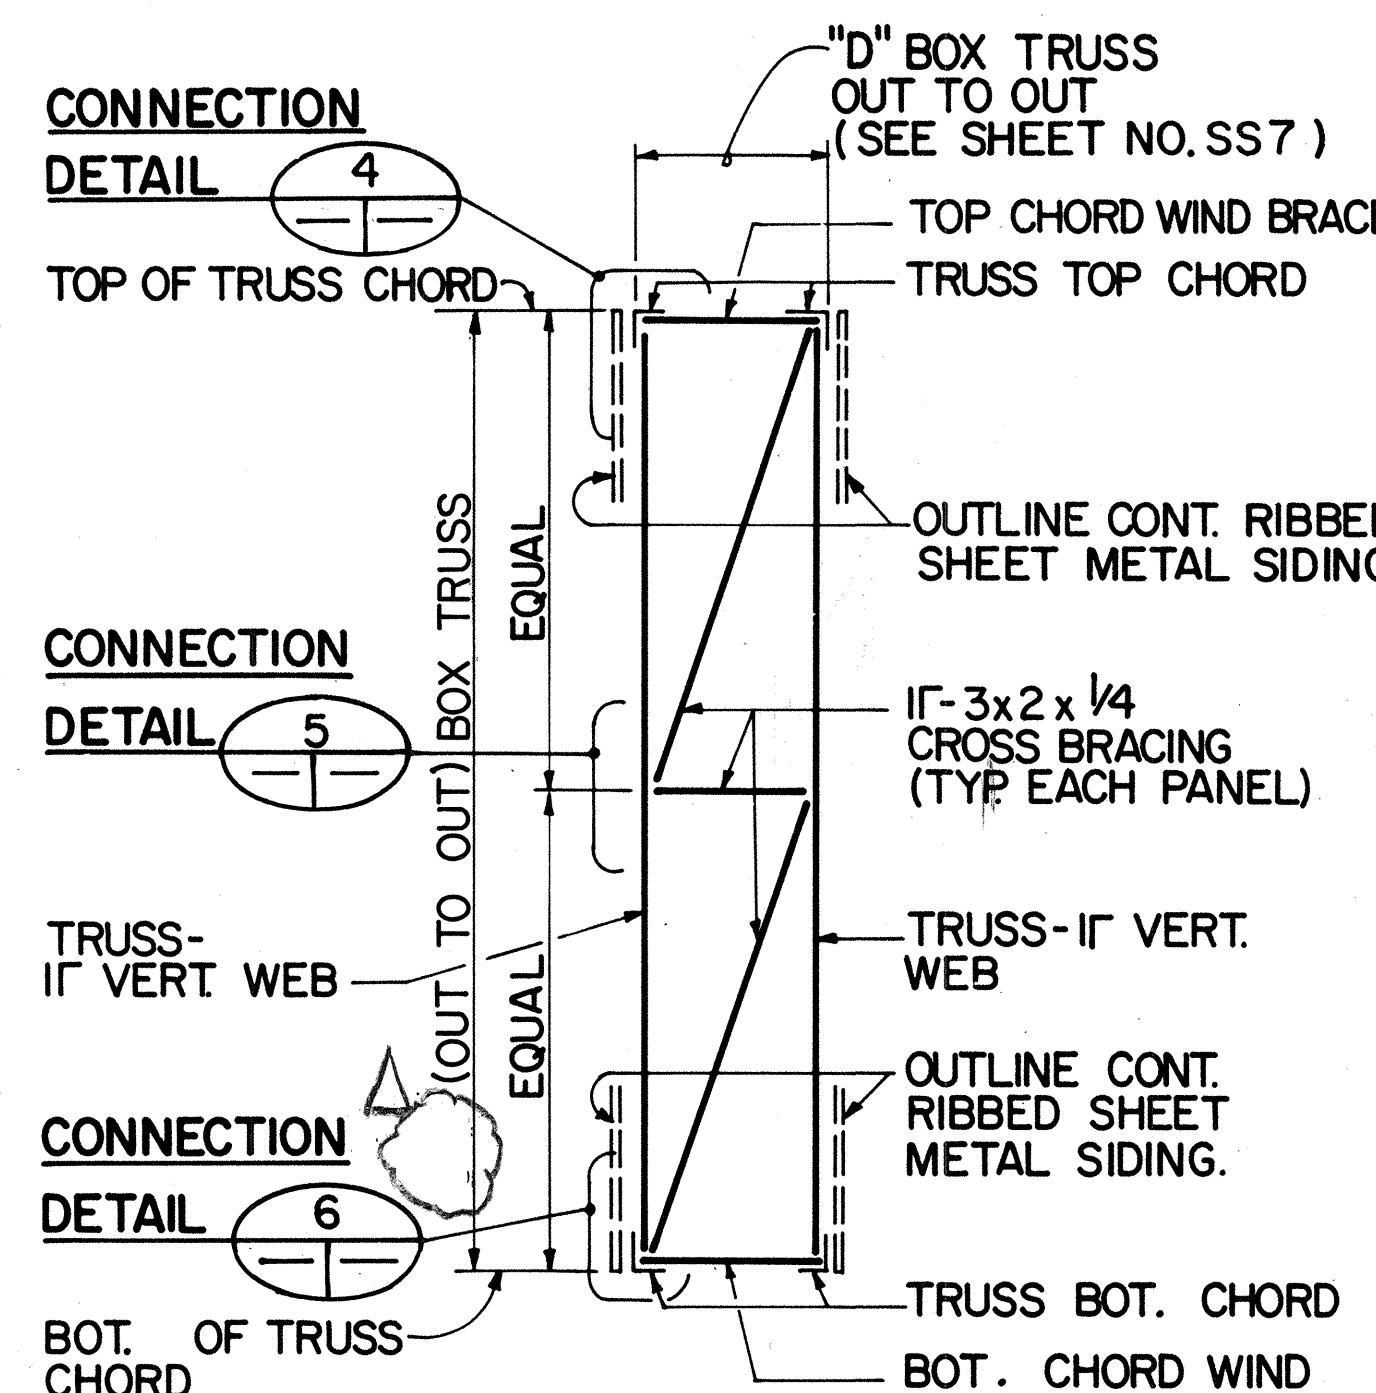







TYP. BOX TRUSS SECTION I
(INTERMEDIATE CROSS BRACING DETAILS)
SCALE: 1/2" = 1'-0"
(FOR 6' & 8' DEEP TRUSS, OTHERWISE SEE NOTE A)

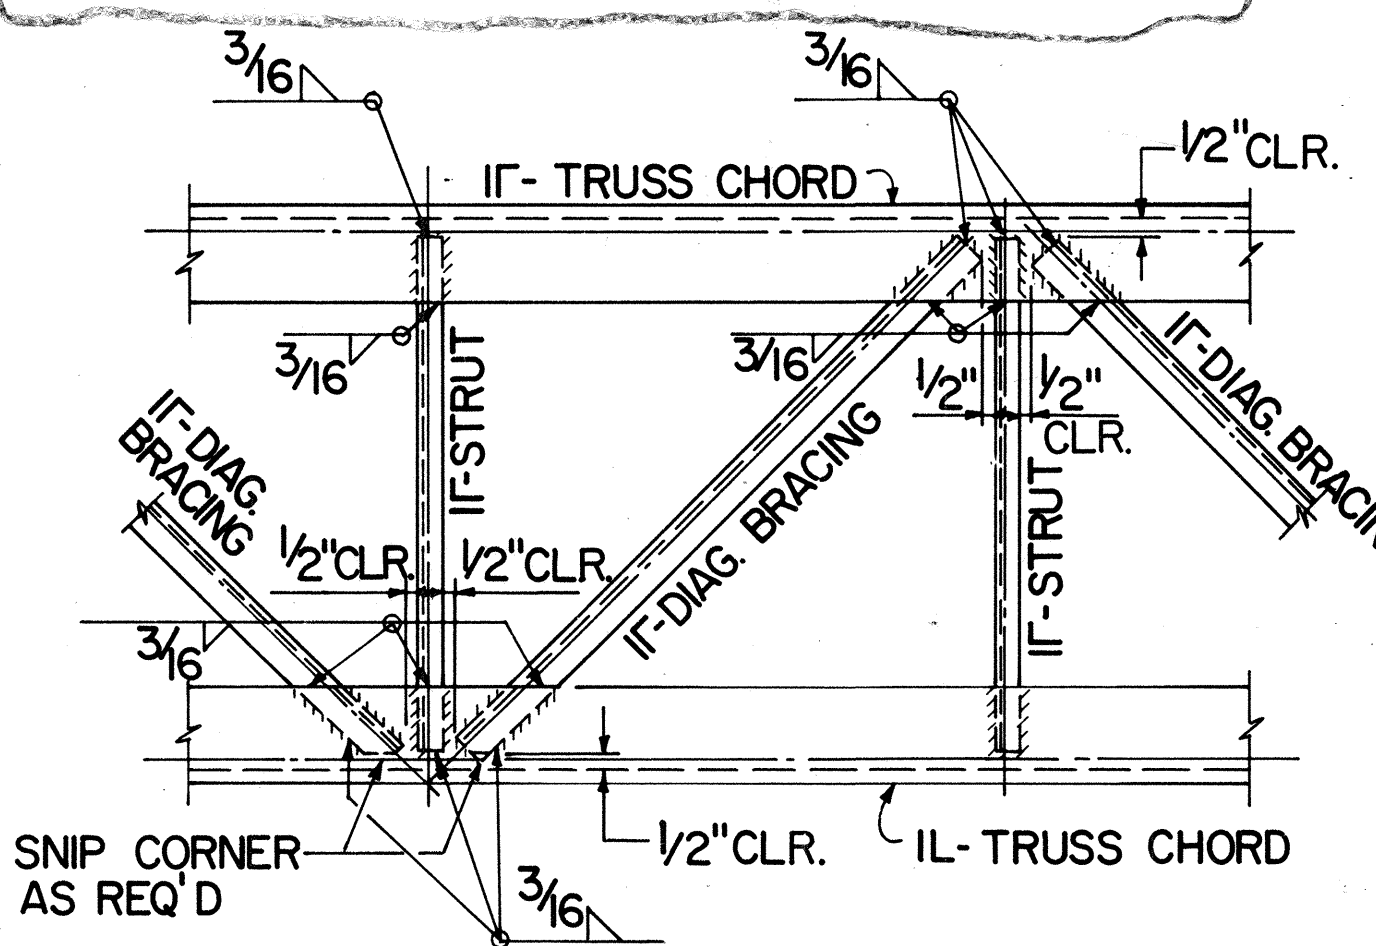

TYPICAL DETAIL 2
SS7 SS8
WIND BRACE CONNECTION
(TOP CHORD SHOWN - BOT. CHORD SIMILAR)
SCALE: 1/2" = 1'-0"

DATE	1/90
DESIGNED BY	GLD TRUONG
CHECKED BY	K. WADA
NOTED BY	H.P. CHEN
QUANTITIES BY	
ORIGINAL PLAN	

FED. ROAD DIST. NO.	STATE	FED. AID PROJ. NO.	FISCAL YEAR	SHEET NO.	TOTAL SHEETS
HAWAII	HAW.	I-H3-1(65)	1992	295	309

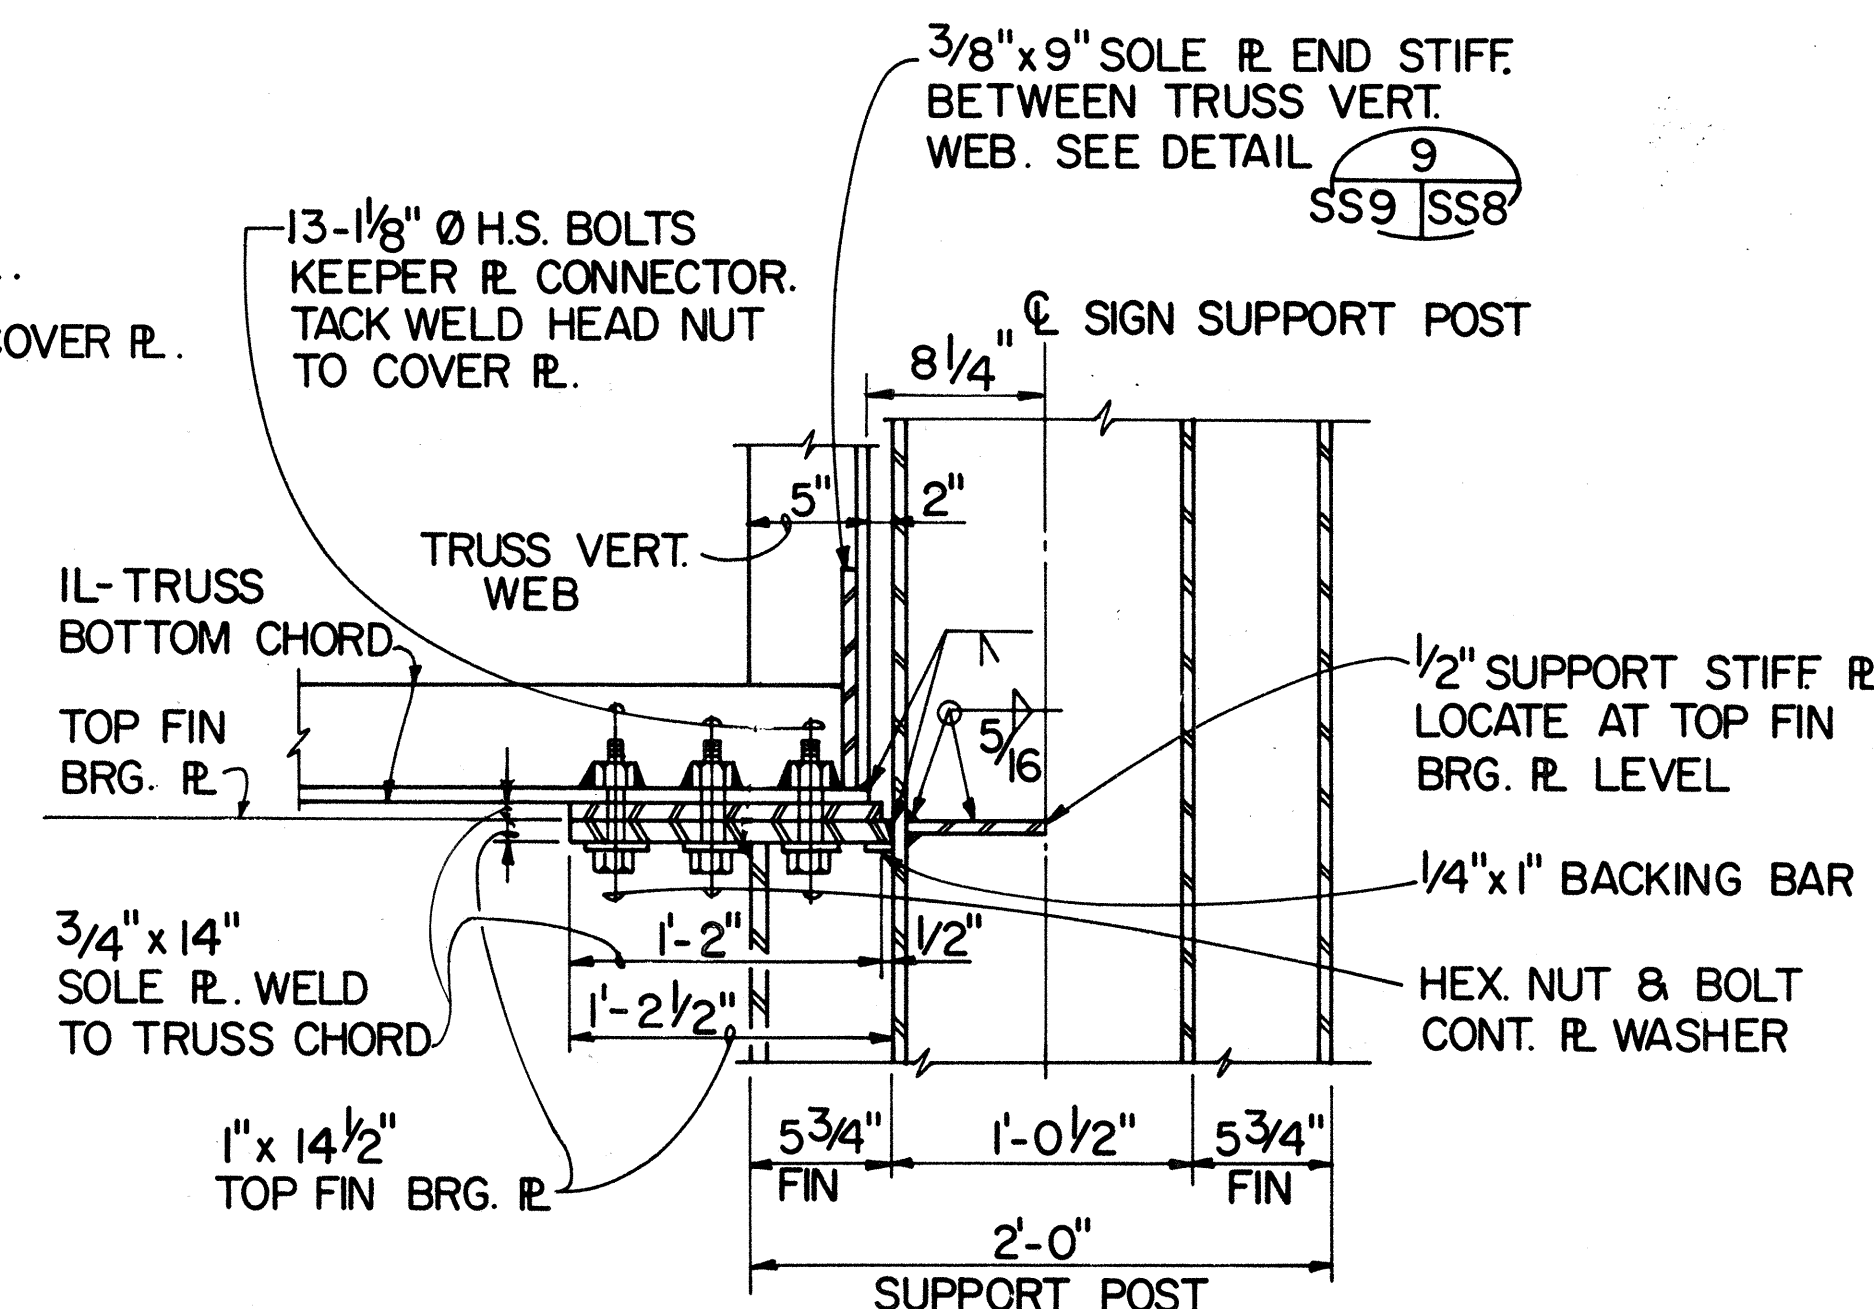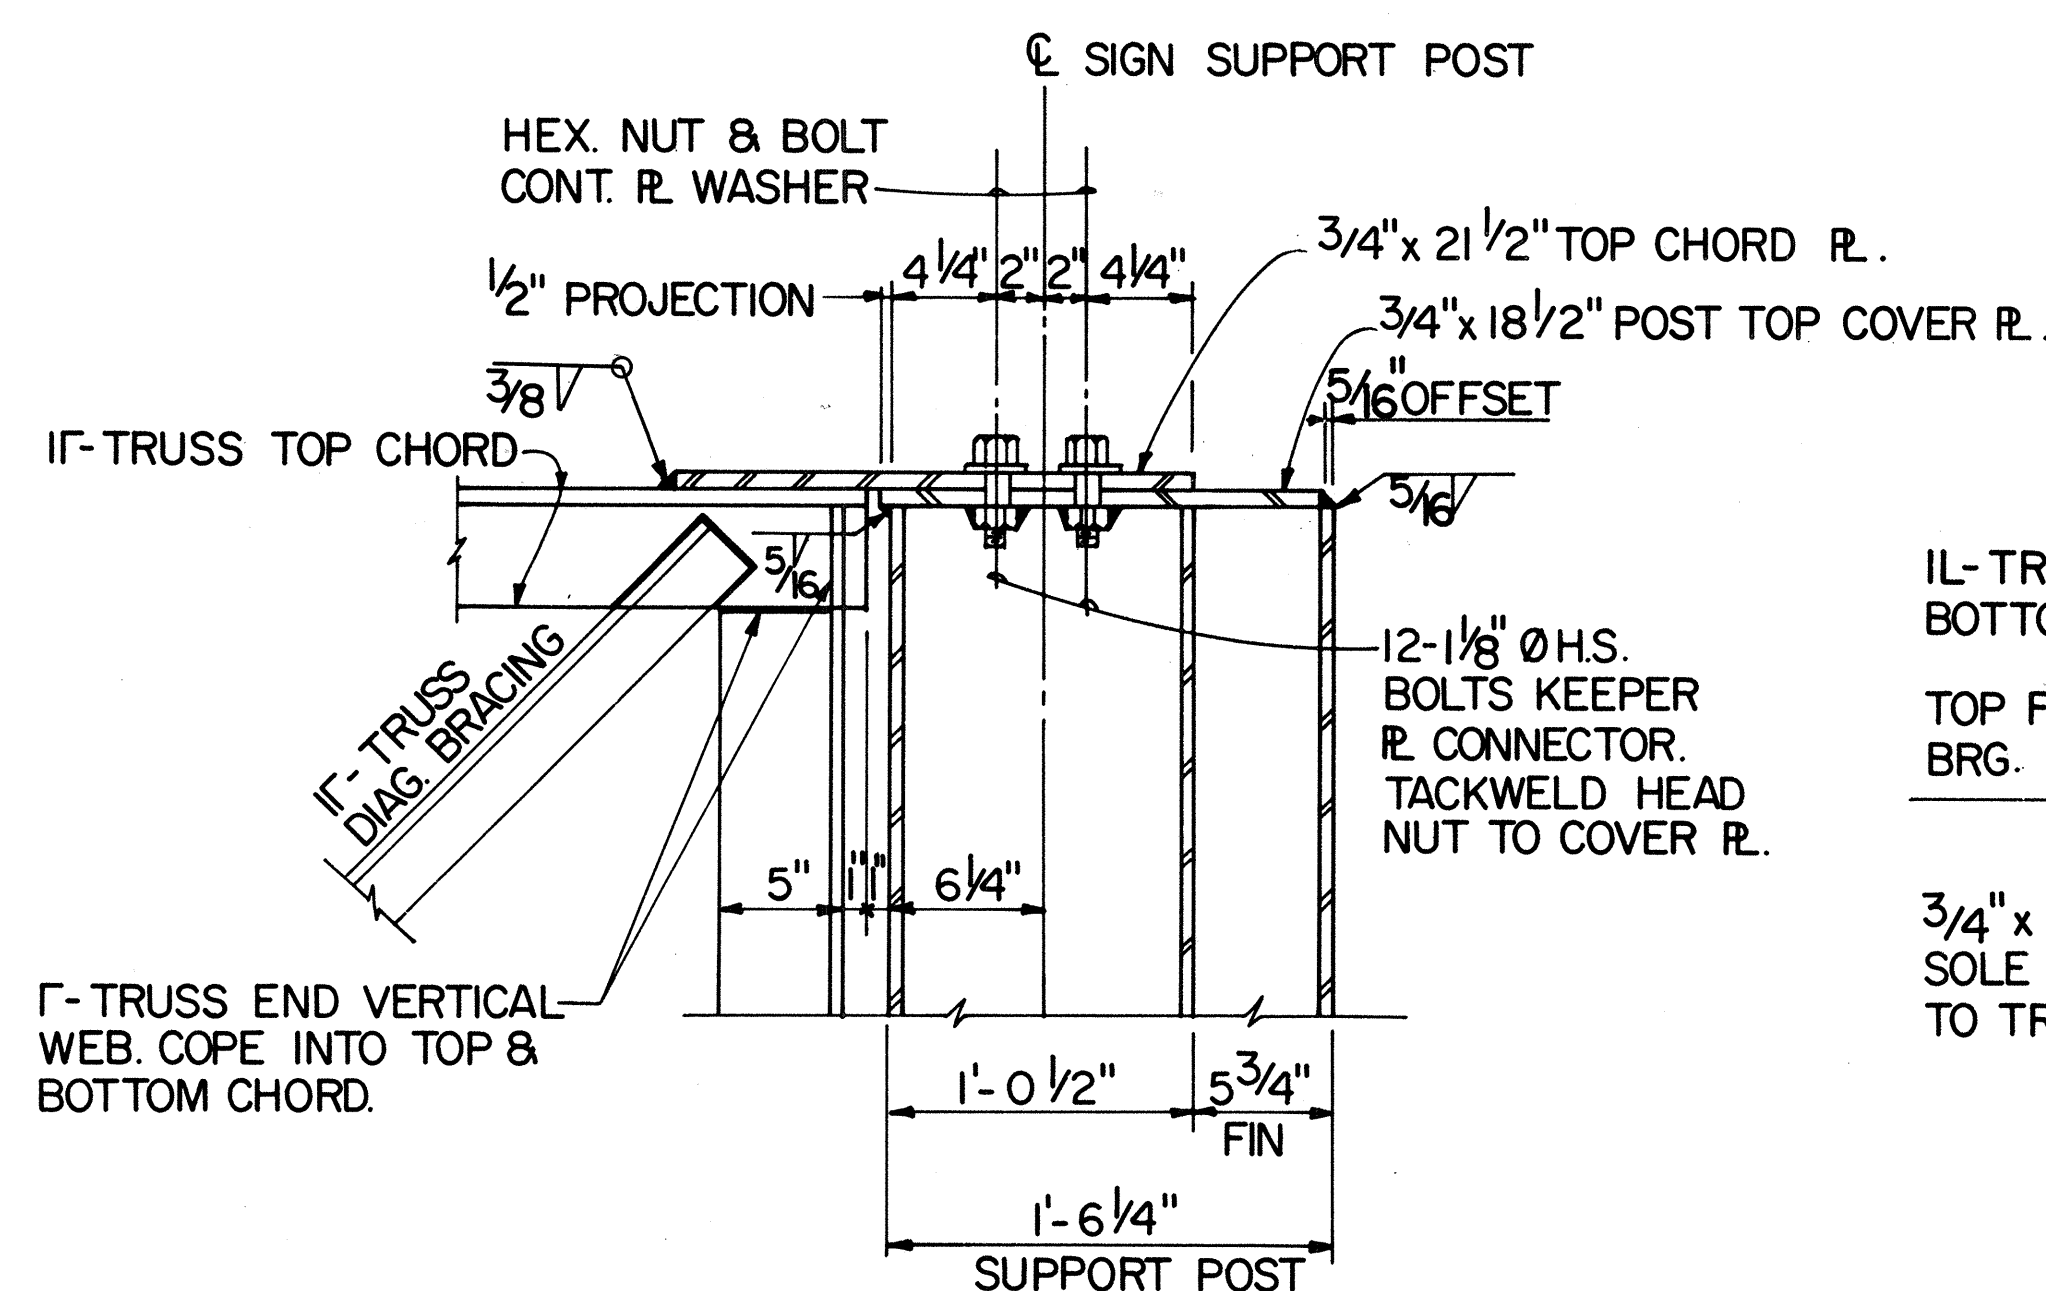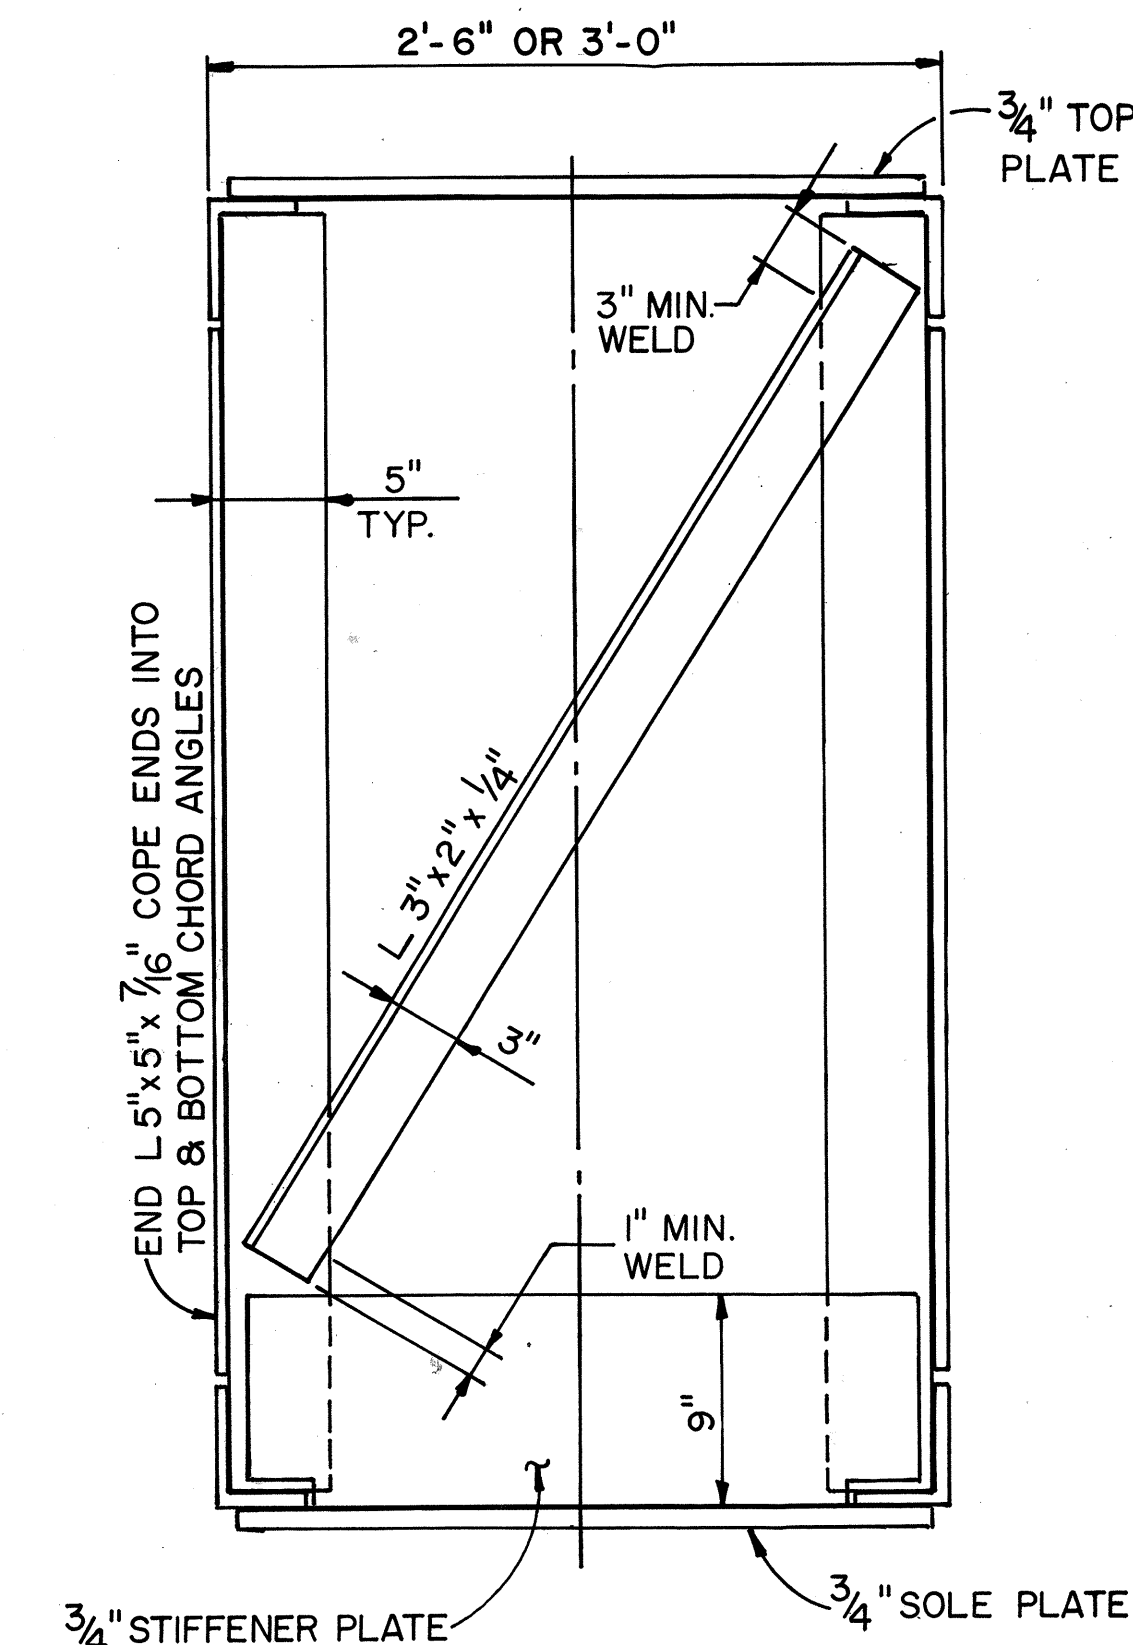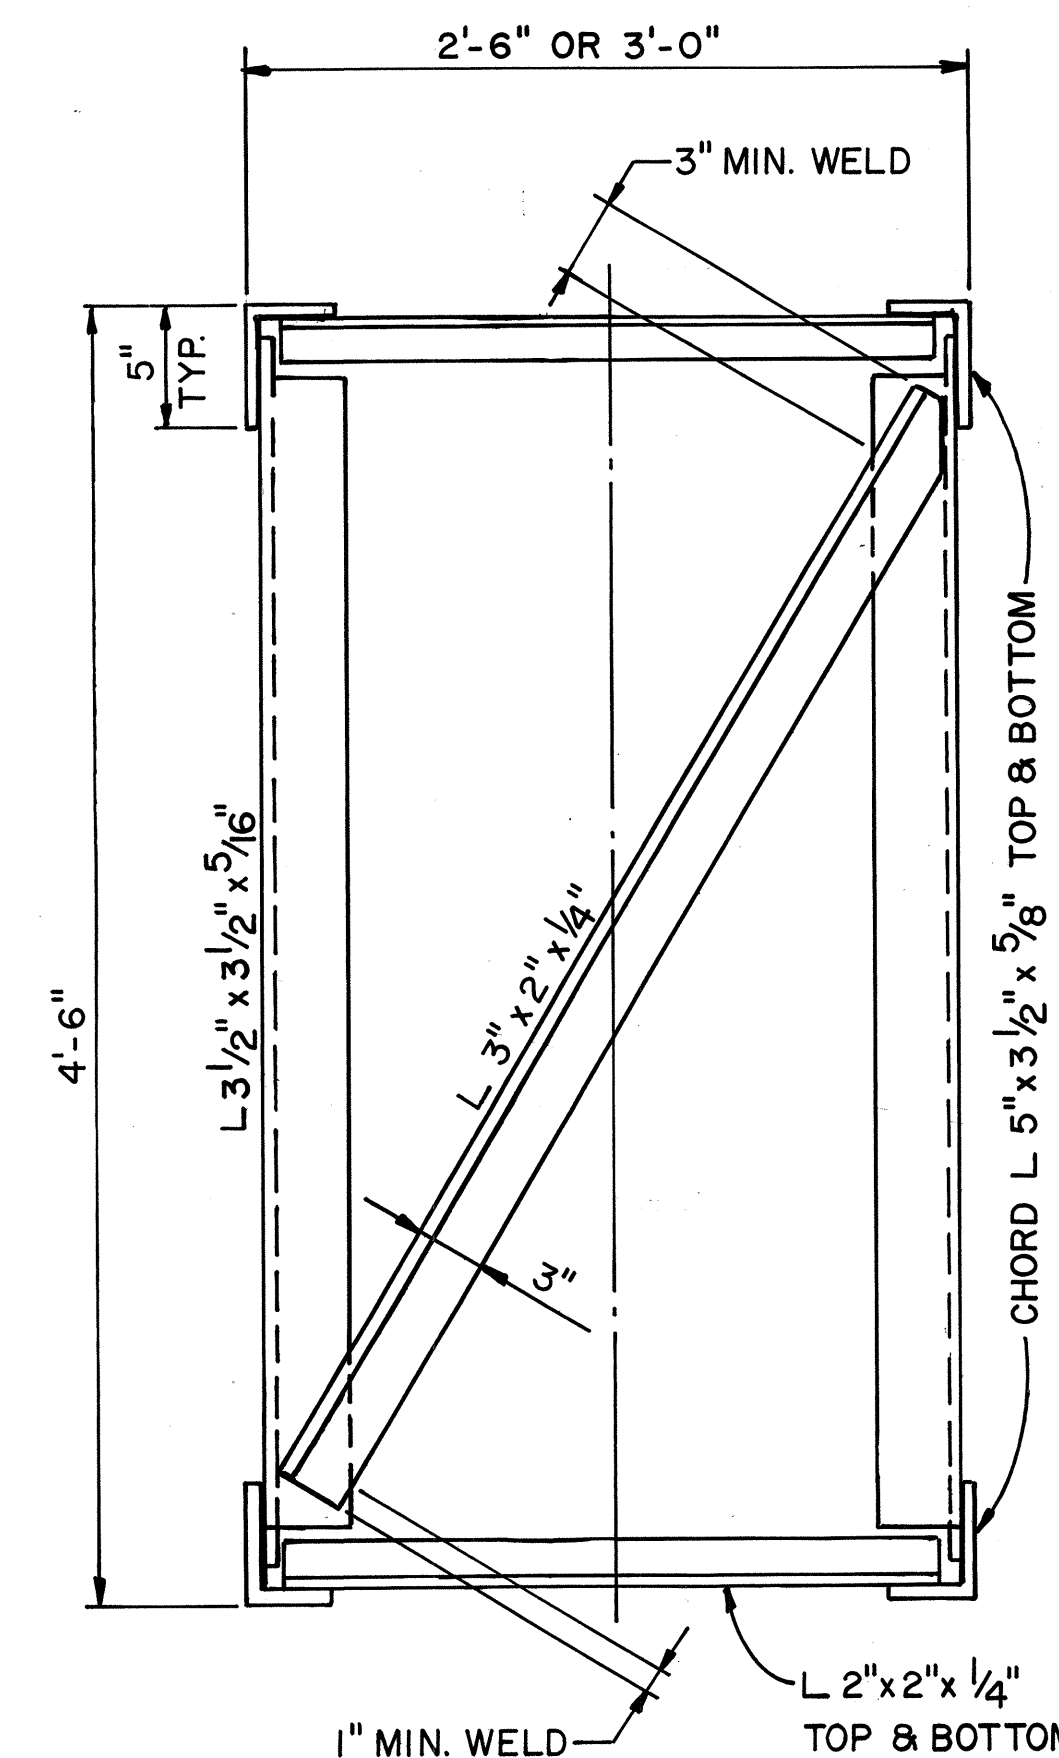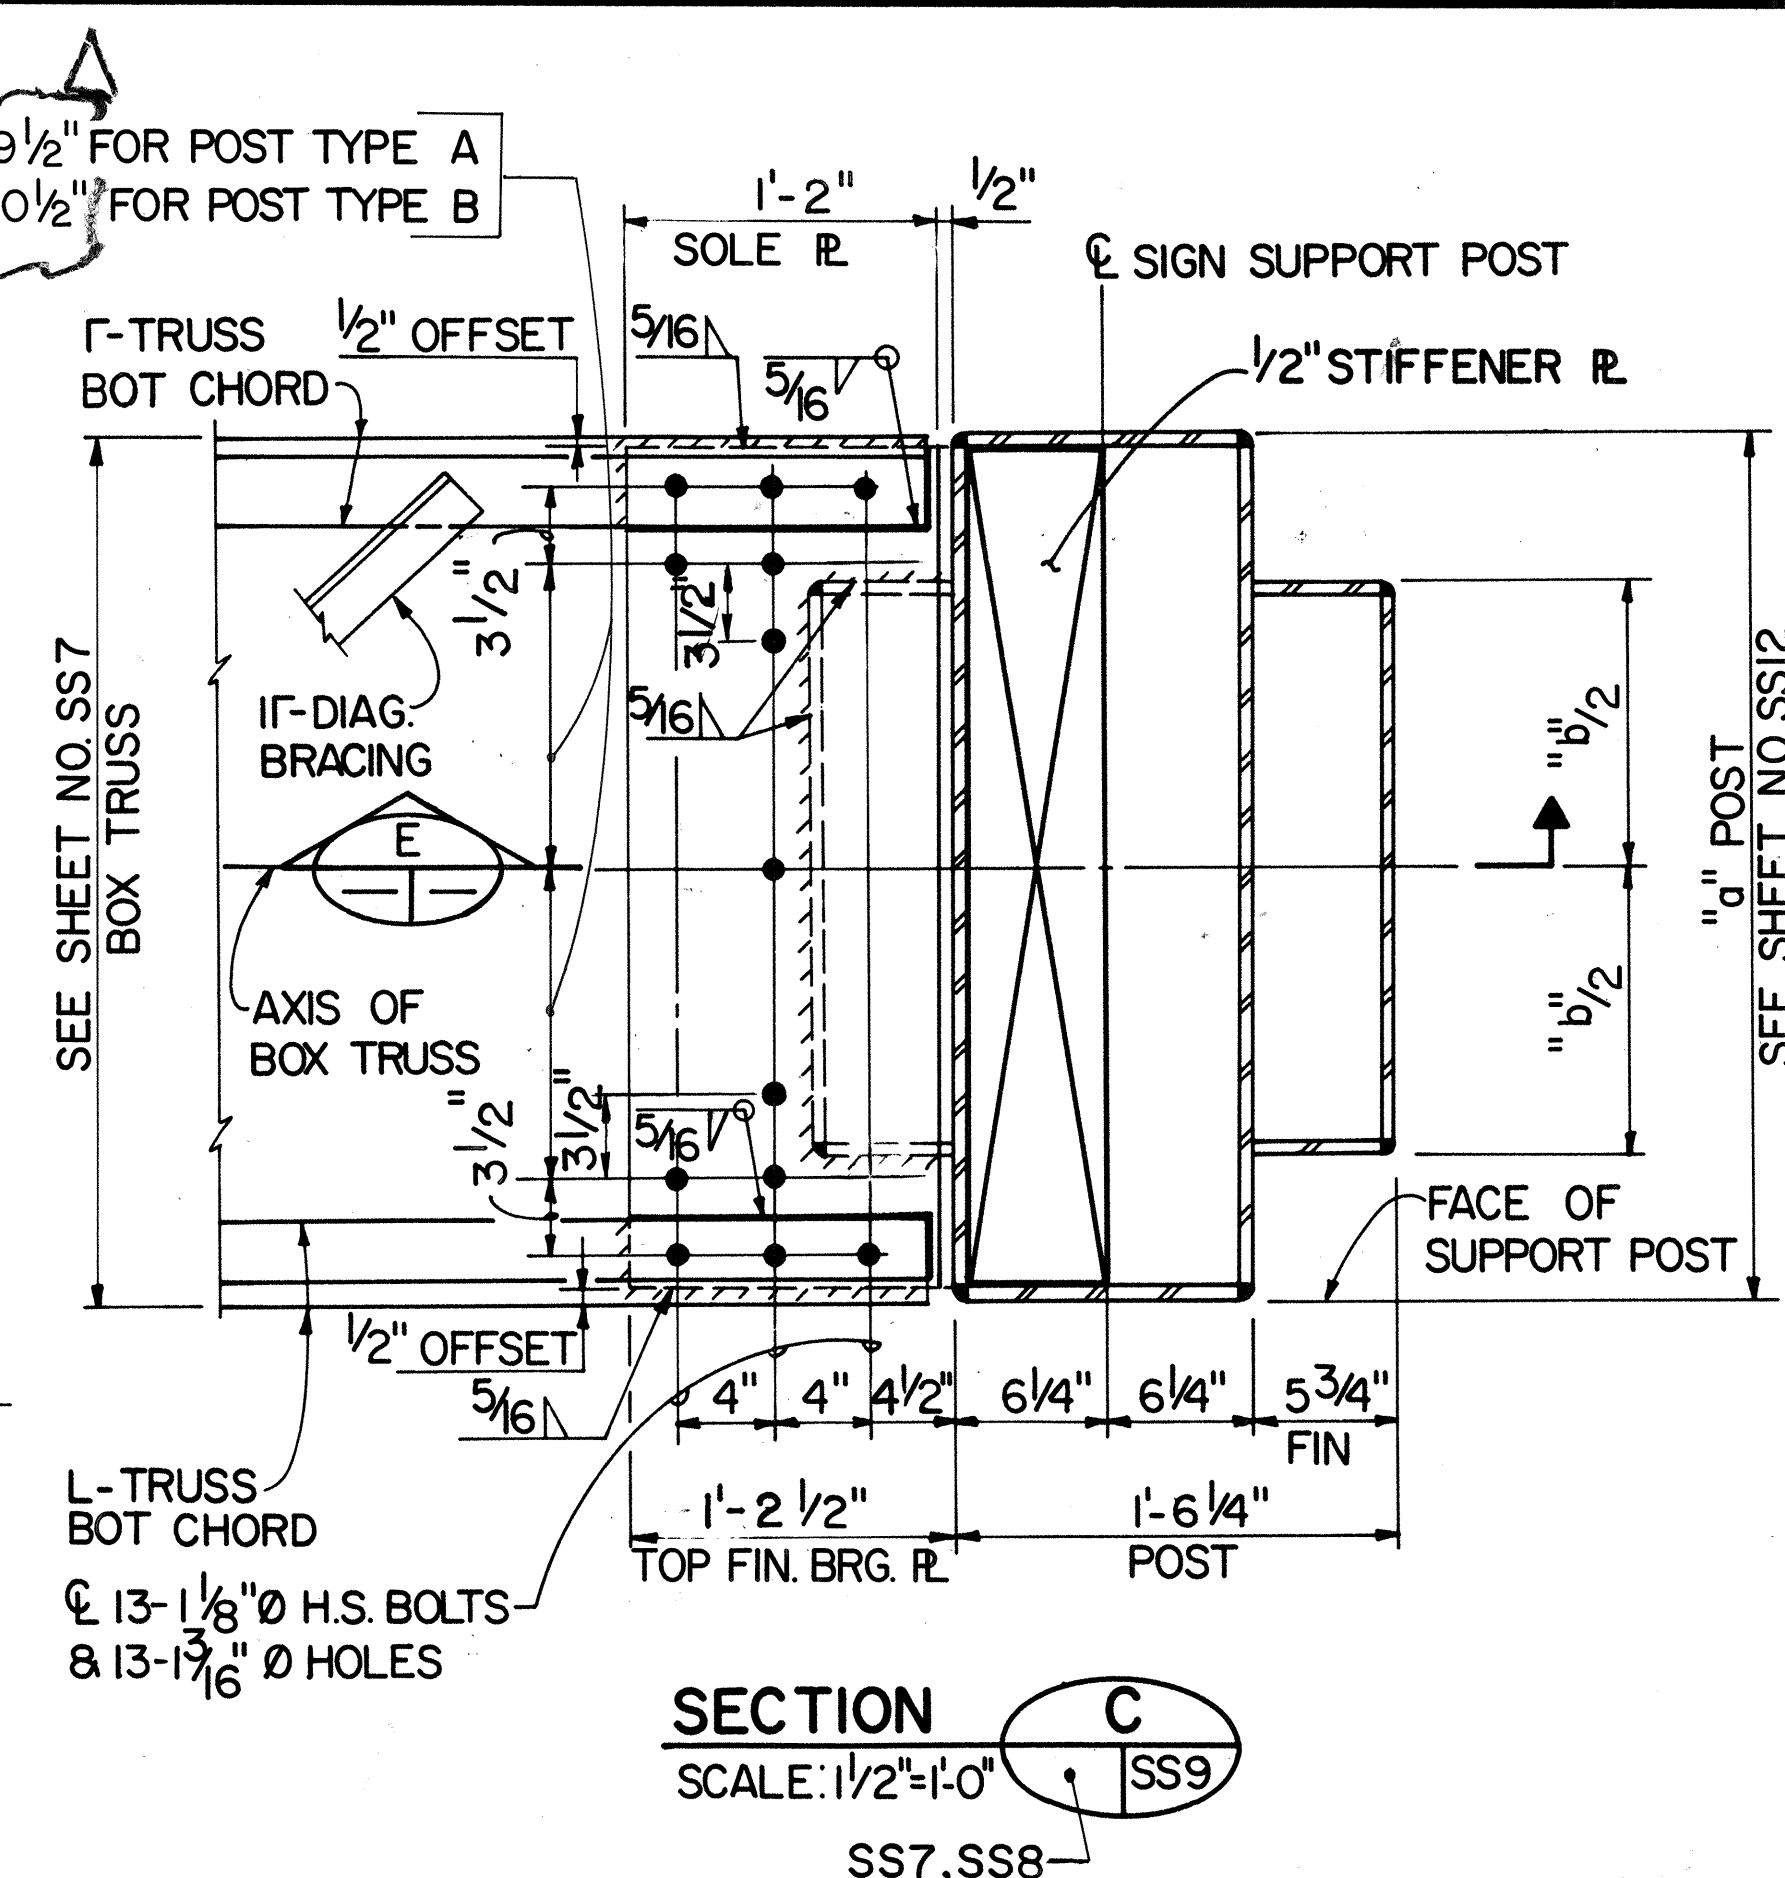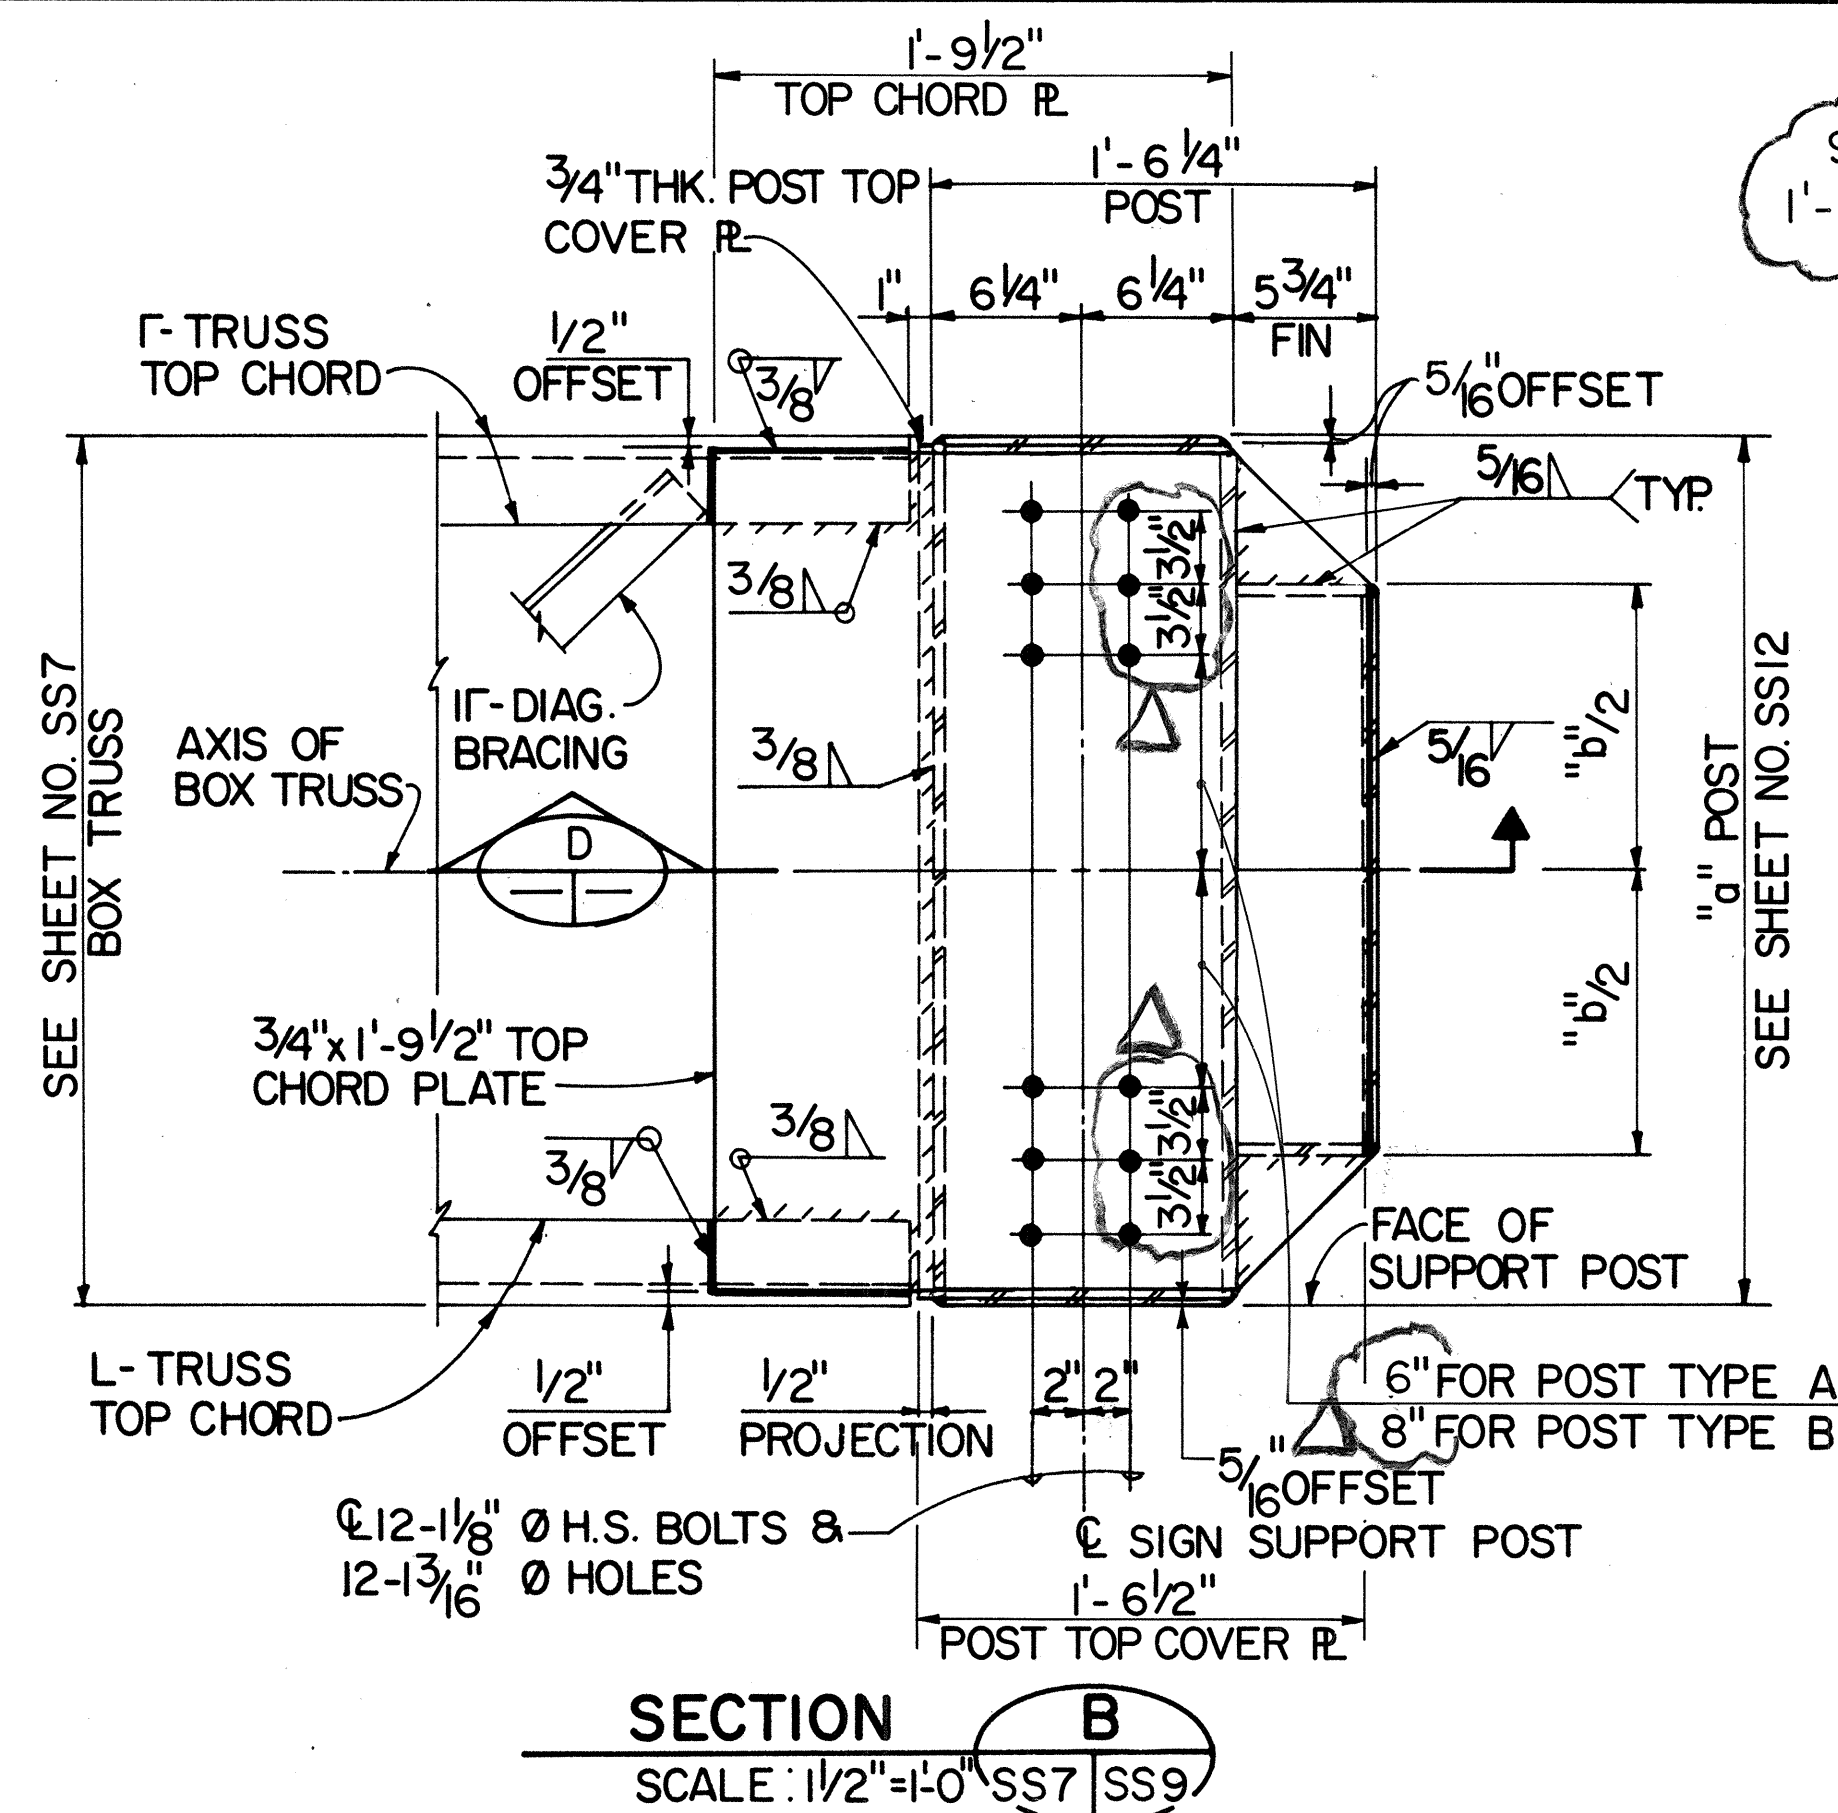



INTERMEDIATE BOX TRUSS SECTION
SCALE: 1/2" = 1'-0"

POST END BOX TRUSS SECTION
SCALE: 1/2" = 1'-0"

NOTE: WELDED CONNECTION SIZES AND DETAILS SIMILAR TO THOSE SHOWN FOR THE 8'-0" DEEP BOX TRUSS ON SHT. NO. SS8

SECTION D
SCALE: 1/2" = 1'-0"

SECTION E
SCALE: 1/2" = 1'-0"

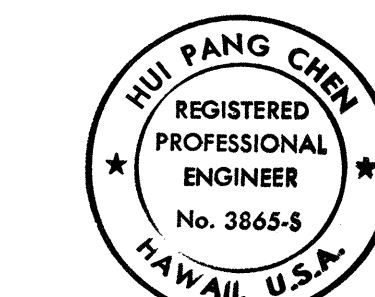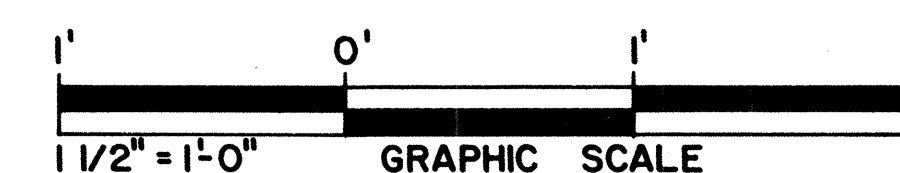

THIS WORK WAS PREPARED BY ME OR UNDER MY SUPERVISION.
Hui Pang Chen

DATE	REVISION
1/12/94	REV. SECTION 'B' & 'C' PER DCN 65-024
12/8/93	ADD INTERMEDIATE BOX TRUSS SECTION AND POST END BOX TRUSS SECTION PER DCN 65-019
9/28/93	REVISED PER DCN 65-012
DATE	REVISION

STATE OF HAWAII
DEPARTMENT OF TRANSPORTATION
HIGHWAYS DIVISION


BOX TRUSS CONNECTION DETAILS-2

SUPPORT STRUCTURES
INTERSTATE ROUTE H-3


F.A.I. PROJ. NO. I-H3-1 (65)

SCALE: AS SHOWN DATE: DEC. 1991
SHEET NO. SS9 OF 19 SHEETS


FED. ROAD DIST. NO.	STATE	FED. AID PROJ. NO.	FISCAL YEAR	SHEET NO.	TOTAL SHEETS
HAWAII	HAW.	I-H3-1(65)	1992	296	309

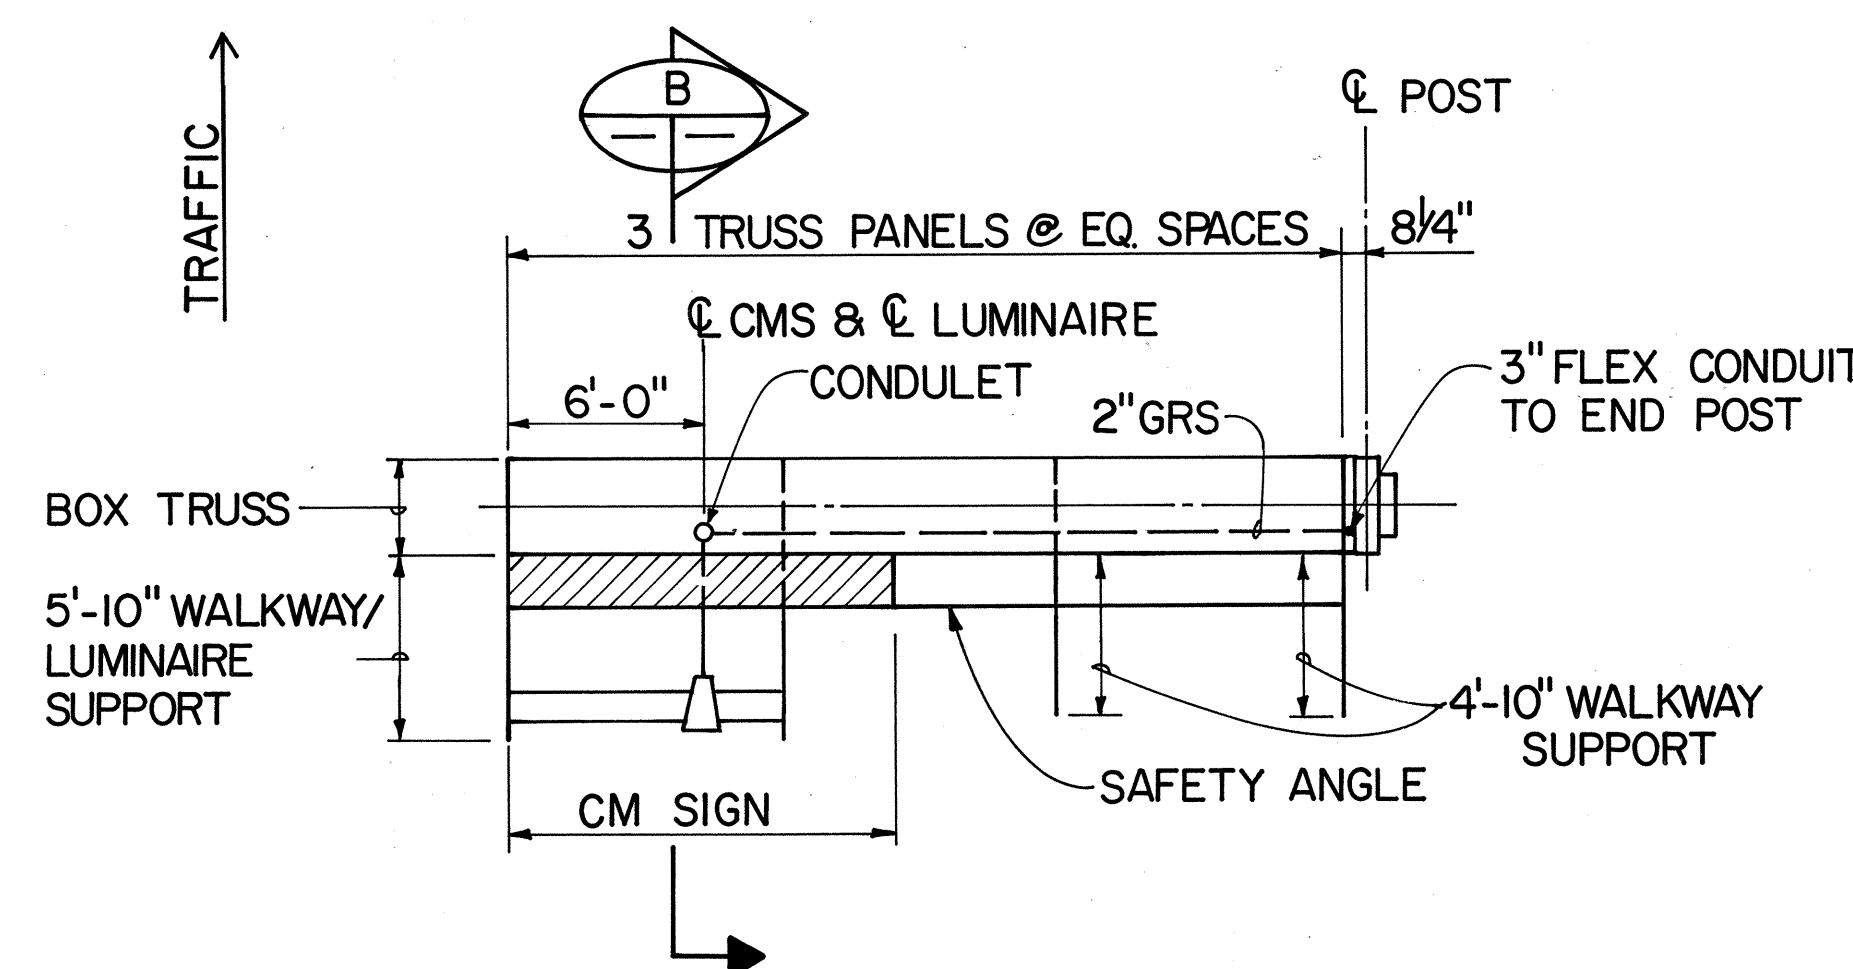


TRUSS PLAN AT CMS 29
SCALE: 1" = 6'-0"

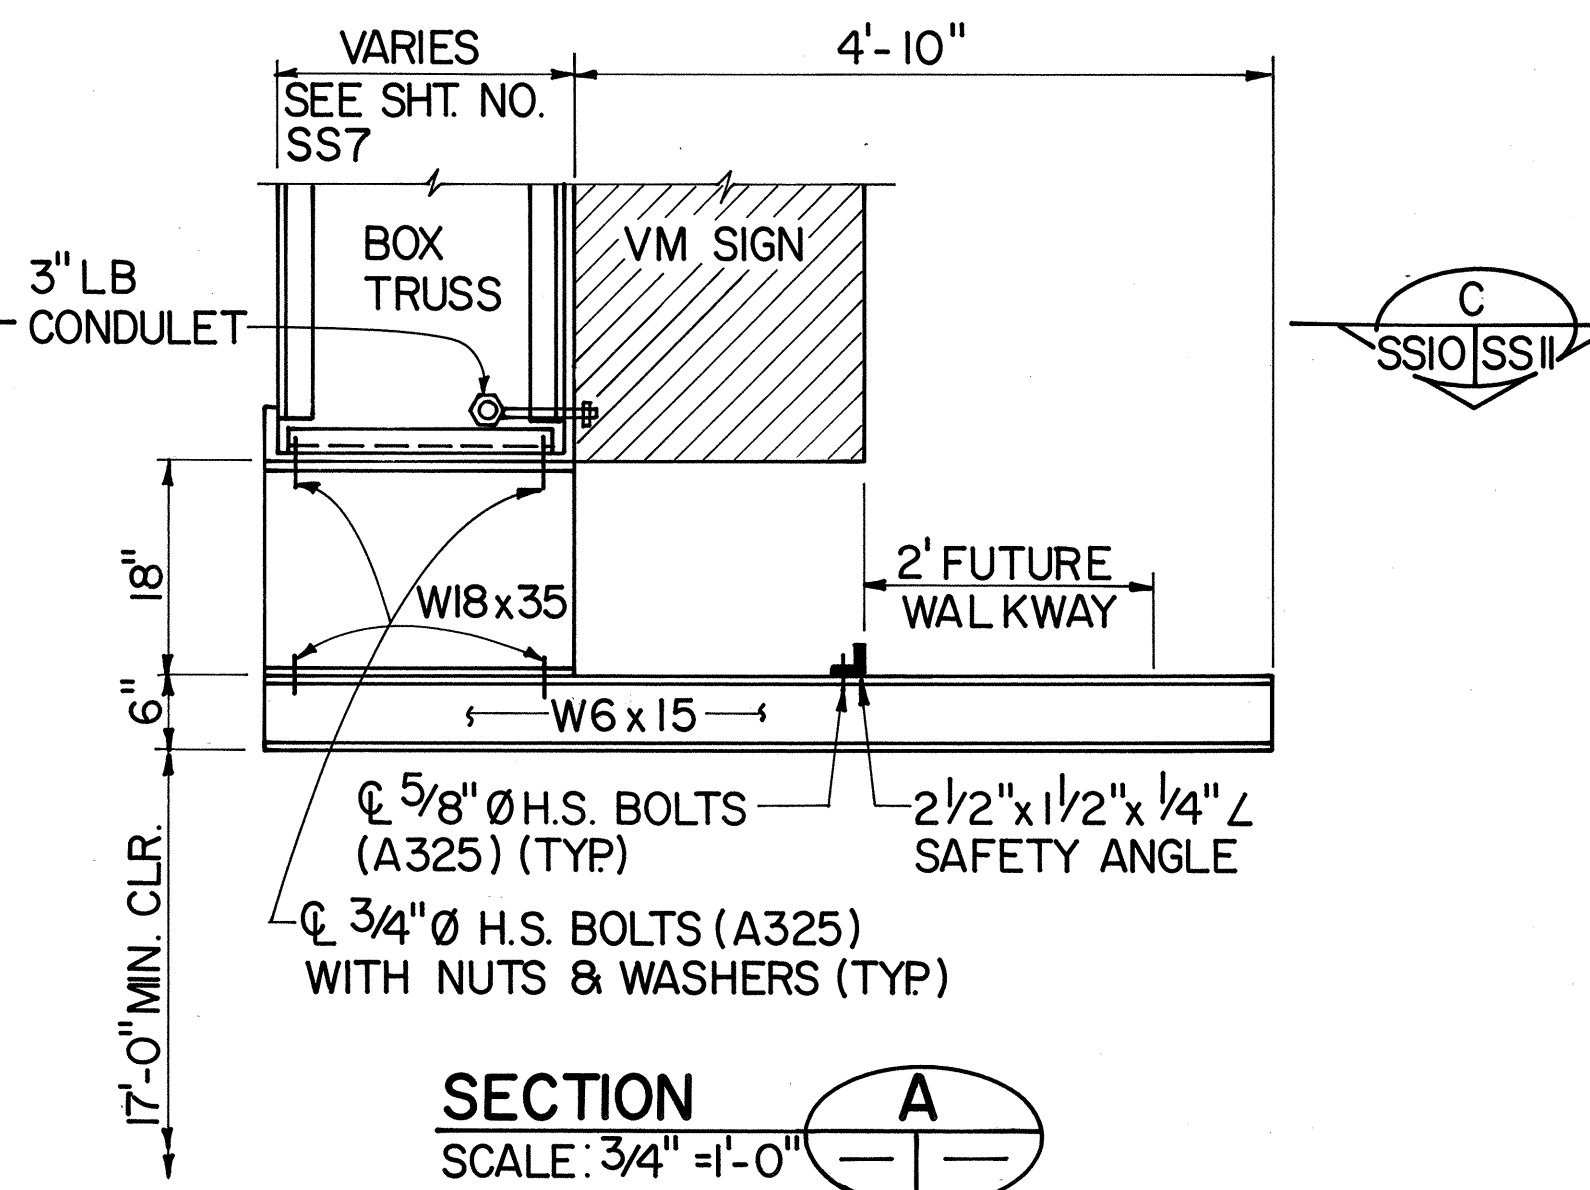


SECTION A
SCALE: 3/4" = 1'-0"

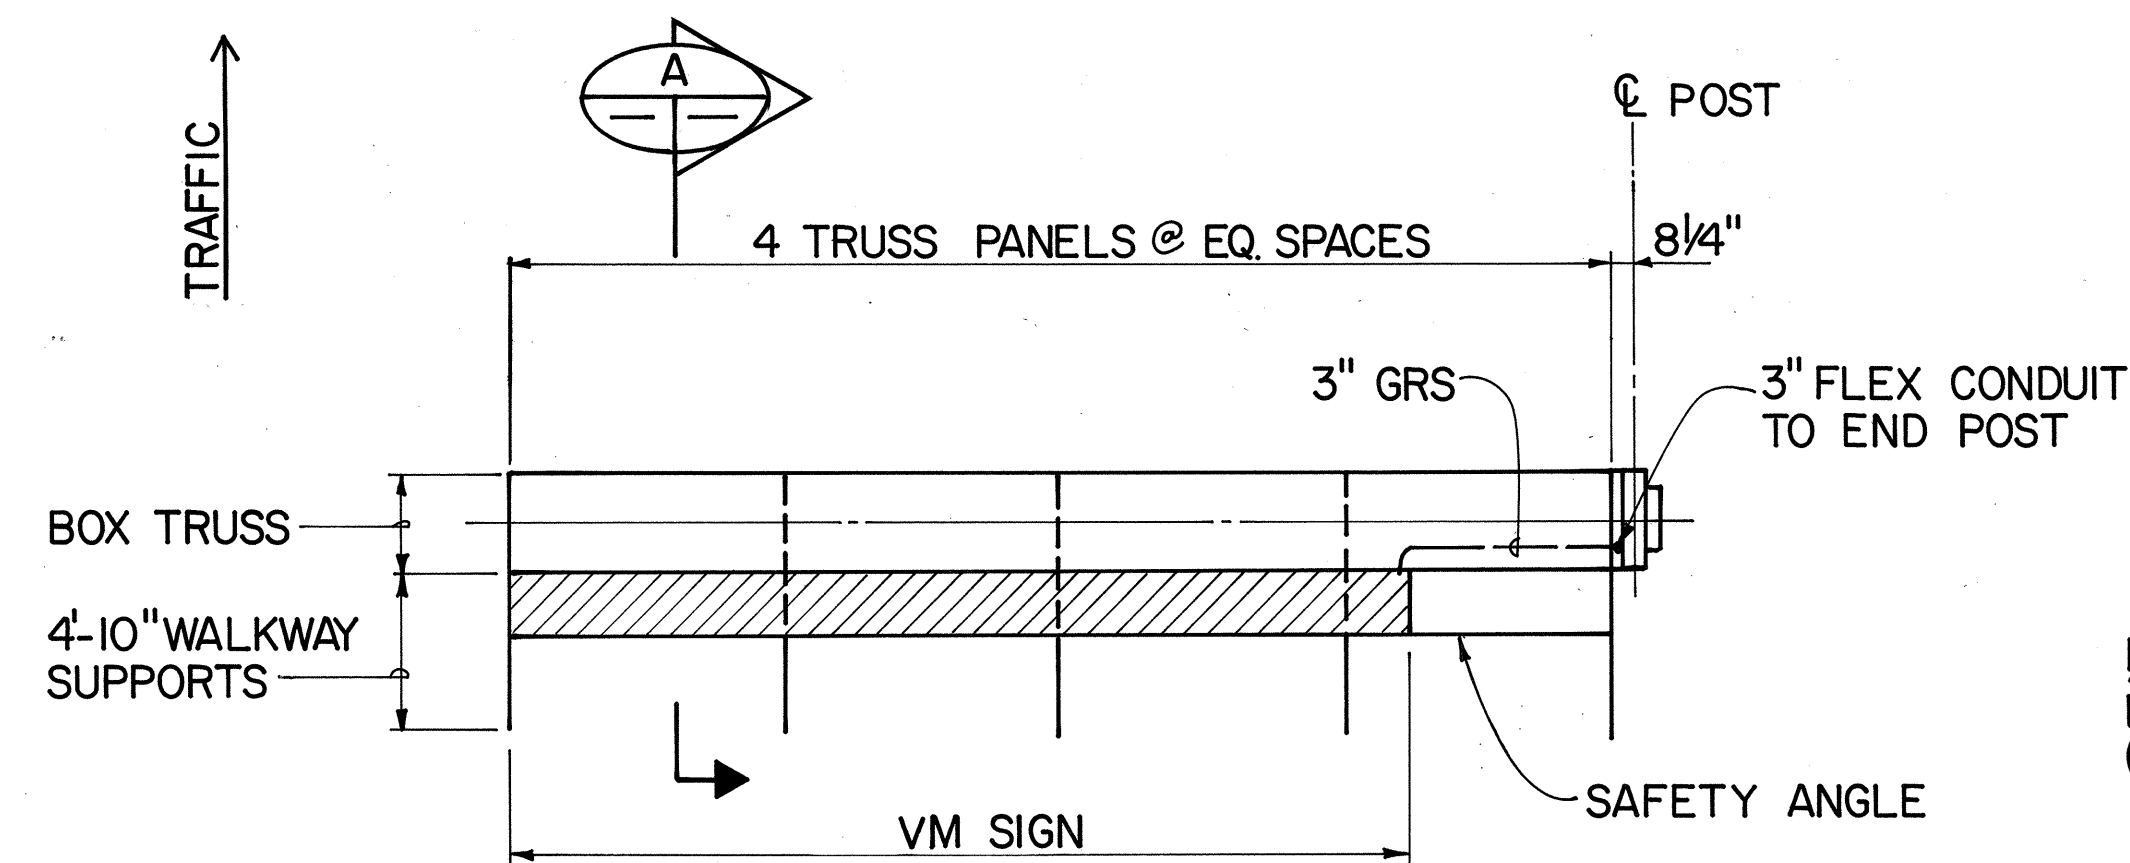

TRUSS PLAN AT VMS 35, 36 & 44 (AS SHOWN)
TRUSS PLAN AT VMS 33, 34, 37, 39, 40 & 43 (SIMILAR EXCEPT OPPOSITE HAND)
SCALE: 1" = 6'-0"


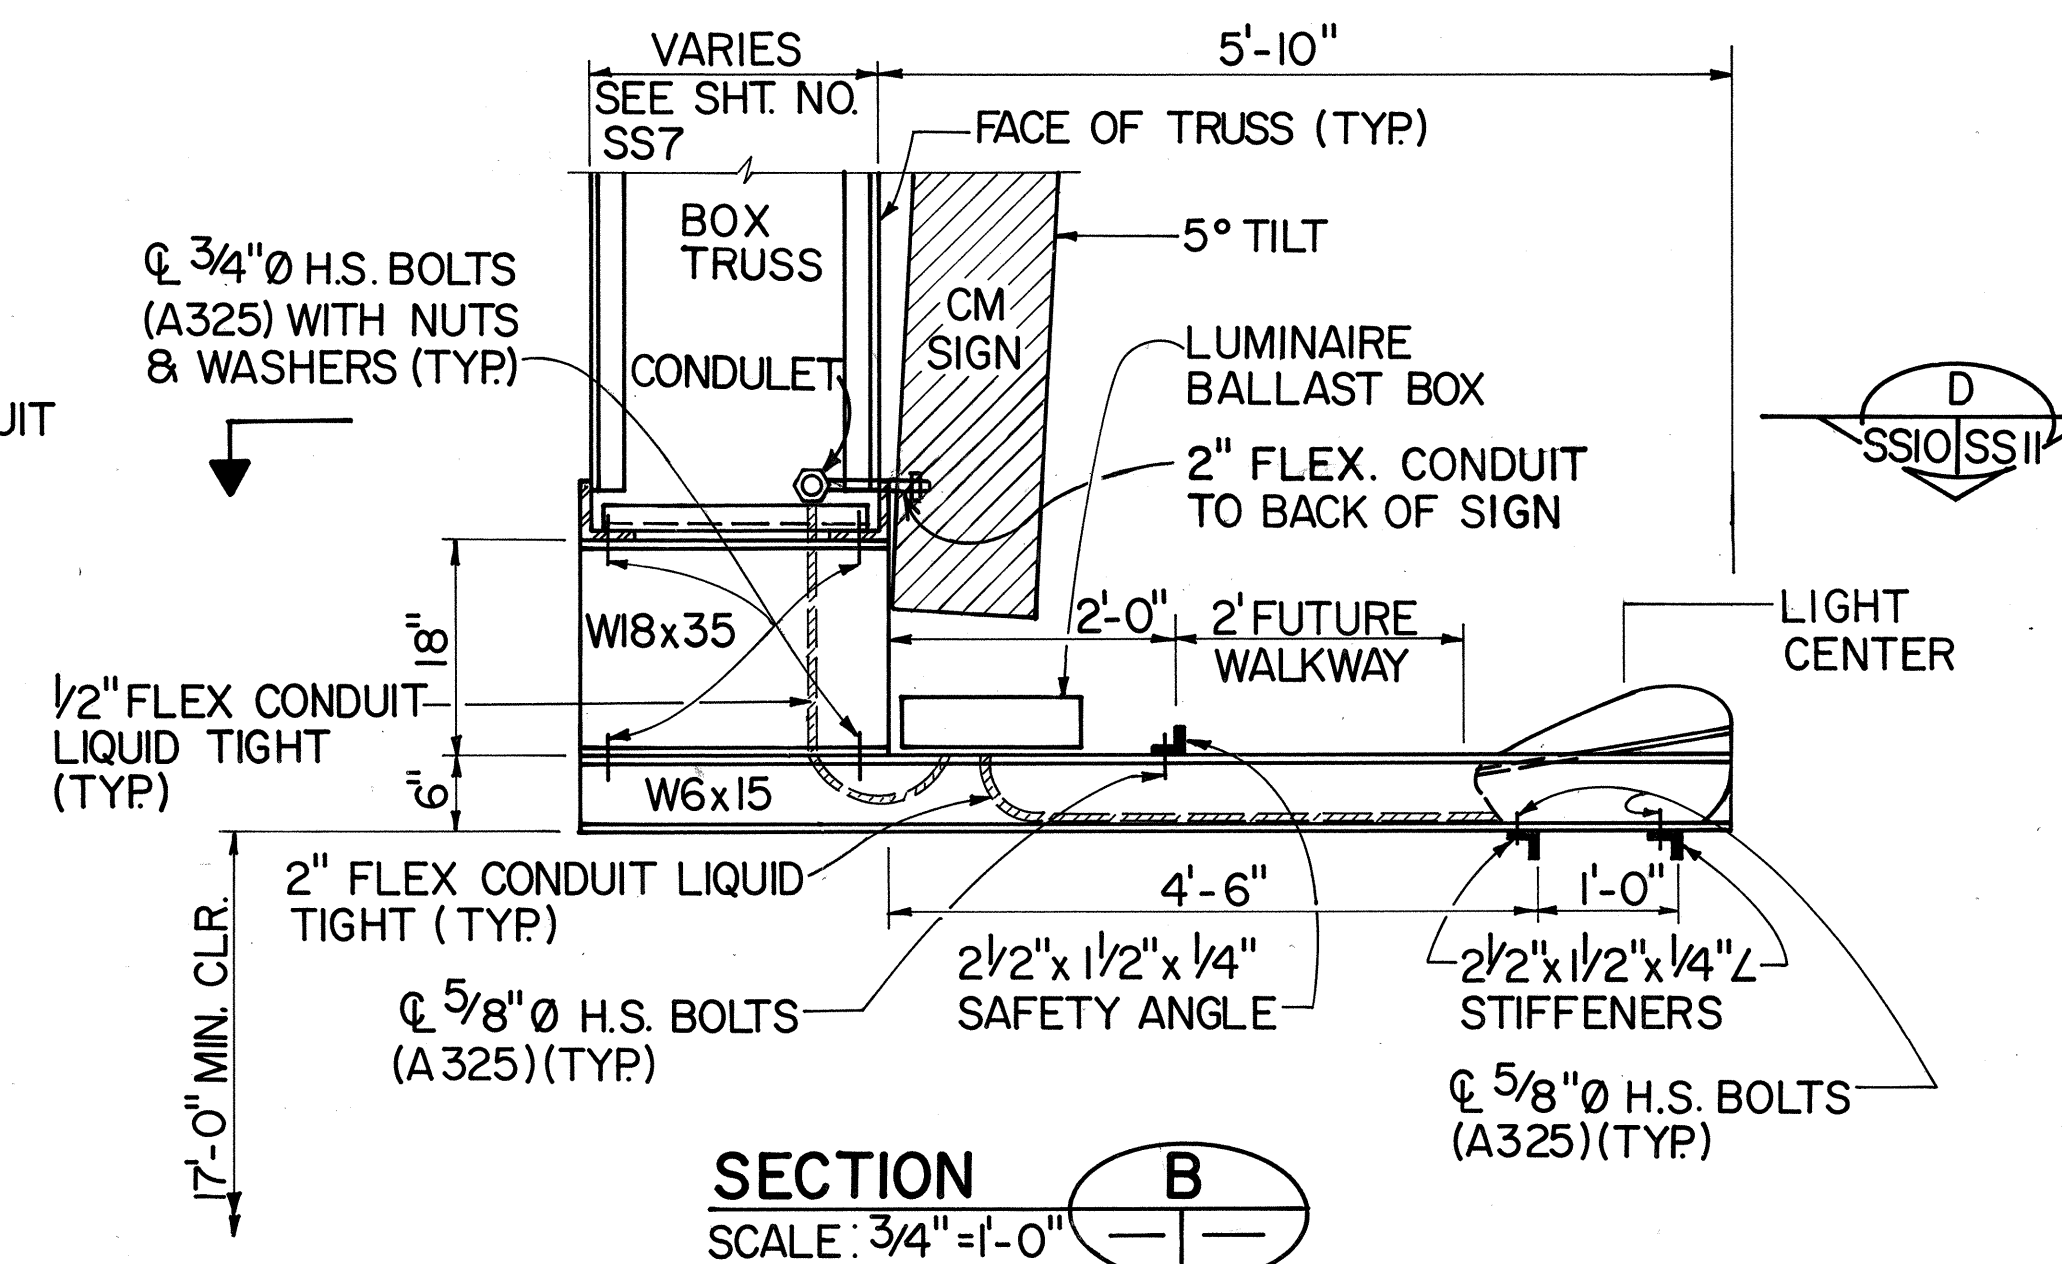


SECTION B
SCALE: 3/4" = 1'-0"

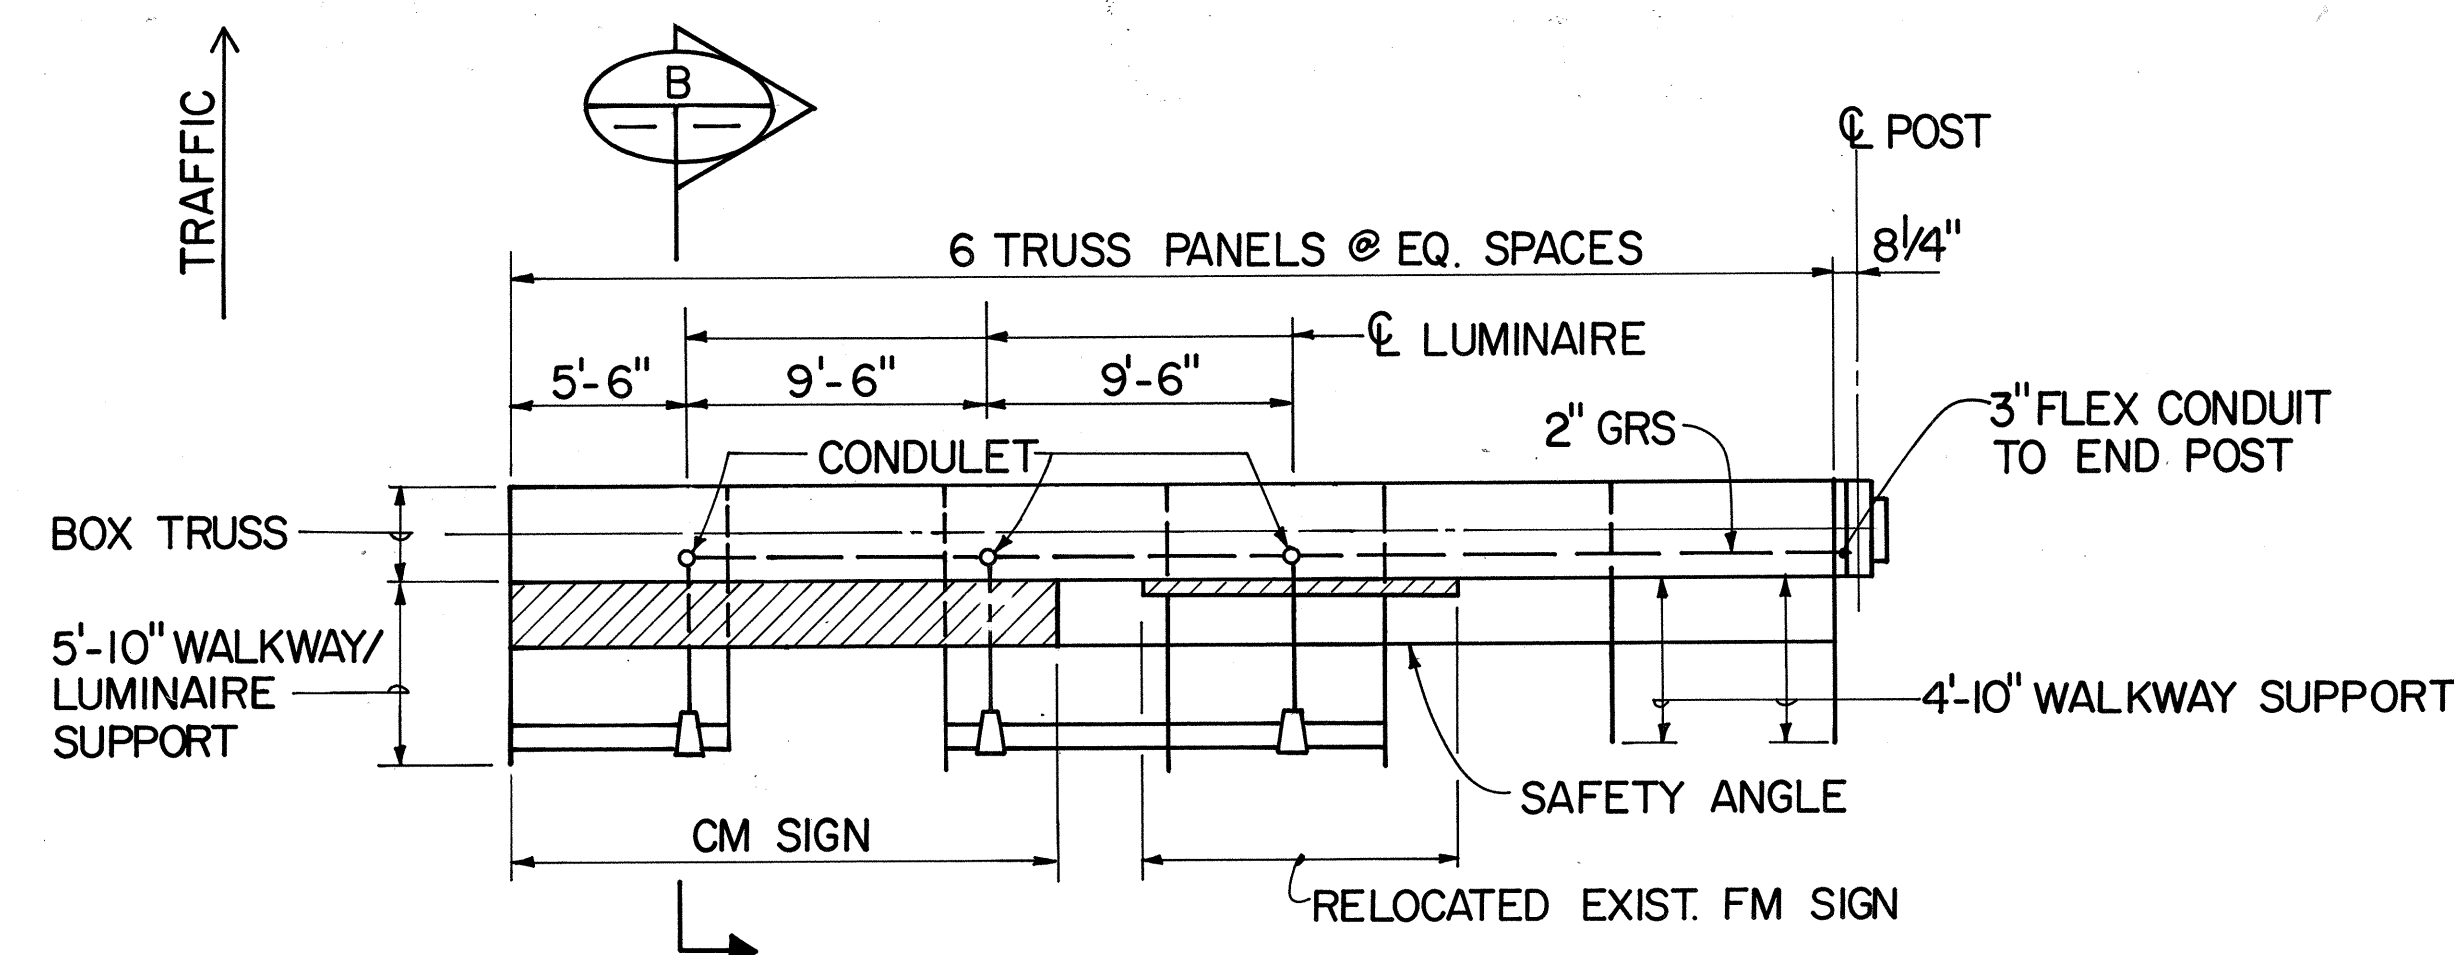

TRUSS PLAN AT CMS 30
SCALE: 1" = 6'-0"

NOTE: INSTALLATION OF ALL SIGNS SHOWN ON THIS SHEET ARE NIC

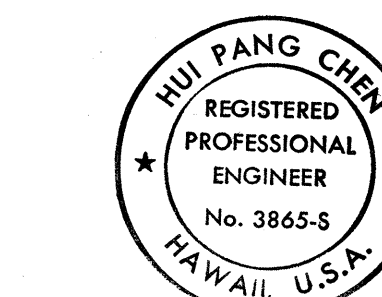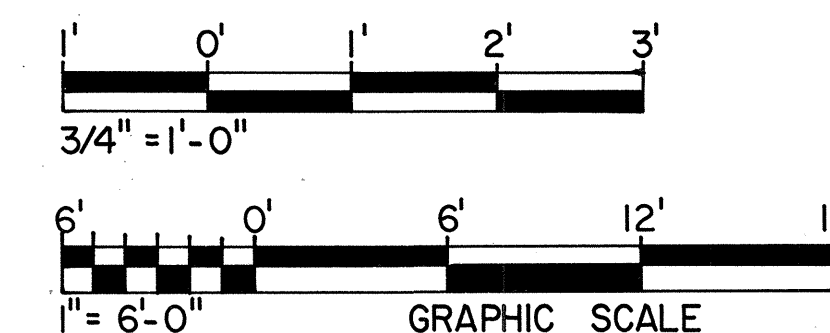

THIS WORK WAS PREPARED BY ME OR UNDER MY SUPERVISION

Hui Pang Chen

DATE	REVISION
3/8/96	REV. PER DCN 65-044
12/8/93	REVISED TITLE OF TRUSS PLAN AT VMS 33 THRU 37, 39, 40, 43 & 44 PER DCN 65-019
7/20/93	REVISED SECTION B PER DCN 65-006
DATE	REVISION

STATE OF HAWAII
DEPARTMENT OF TRANSPORTATION
HIGHWAYS DIVISION





BOX TRUSS WALKWAY DETAILS-I

SUPPORT STRUCTURES
INTERSTATE ROUTE H-3
F.A.I. PROJ. NO. I-H3-1 (65)

SCALE: AS SHOWN DATE: DEC. 1991
SHEET NO. SS10 OF 19 SHEETS

FED. ROAD DIST. NO.	STATE	FED. AID PROJ. NO.	FISCAL YEAR	SHEET NO.	TOTAL SHEETS
HAWAII	HAW.	I-H3-1(65)	1992	297	309

- NOTES:
- FOR GENERAL NOTES SEE SHEET NO.SS1.
 - LOCATIONS OF BOTTOM WIND BRACING MAY BE ADJUSTED TO AVOID ANY INTERFERENCE WITH SIGN LUMINAIRES & WALKWAY BRACKETS SUBJECT TO THE APPROVAL OF THE ENGINEER.
 - LOAD OF WALKWAY AND RAILING ON EACH BRACKET SHALL NOT EXCEED 375 LBS.
 - LIVE LOAD ON EACH BRACKET = 500 LBS.
 - FOR LOCATIONS OF SIGN LUMINAIRES AND WALKWAY BRACKETS, SEE SHEET NO.SS10.
 - ALL STRUCTURAL STEEL, STEEL PIPE, STEEL STRAP, CONNECTION BOLTS, WASHERS & NUTS IN WALKWAY/LUMINAIRE SUPPORTS SHALL BE HOT DIP GALVANIZED AFTER FABRICATION.

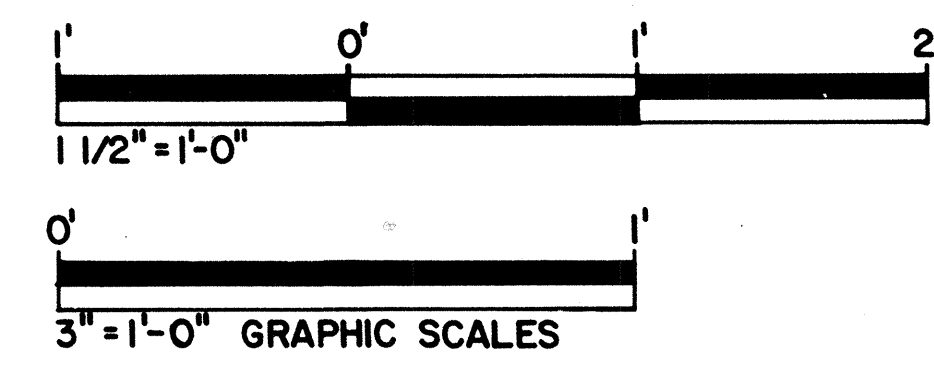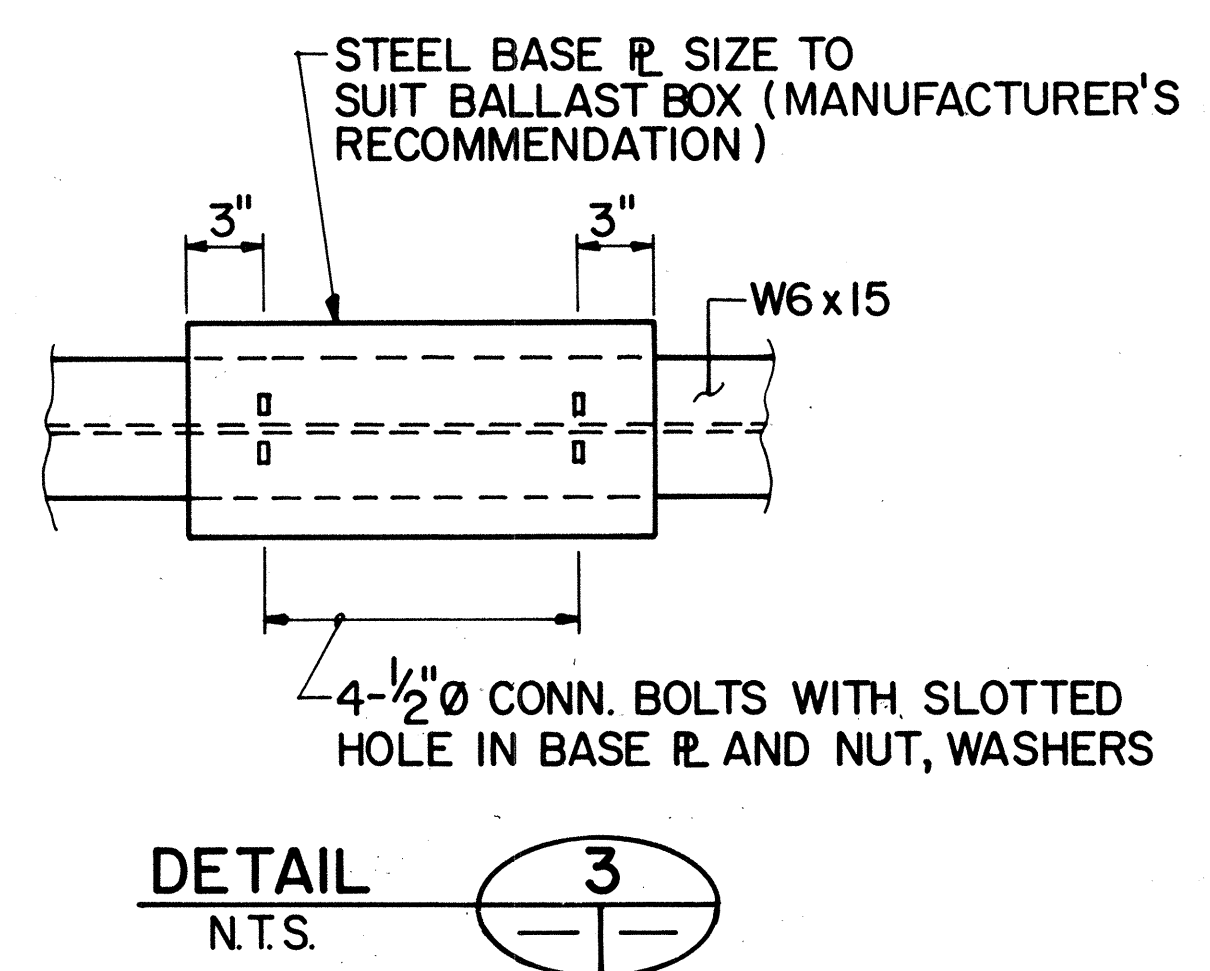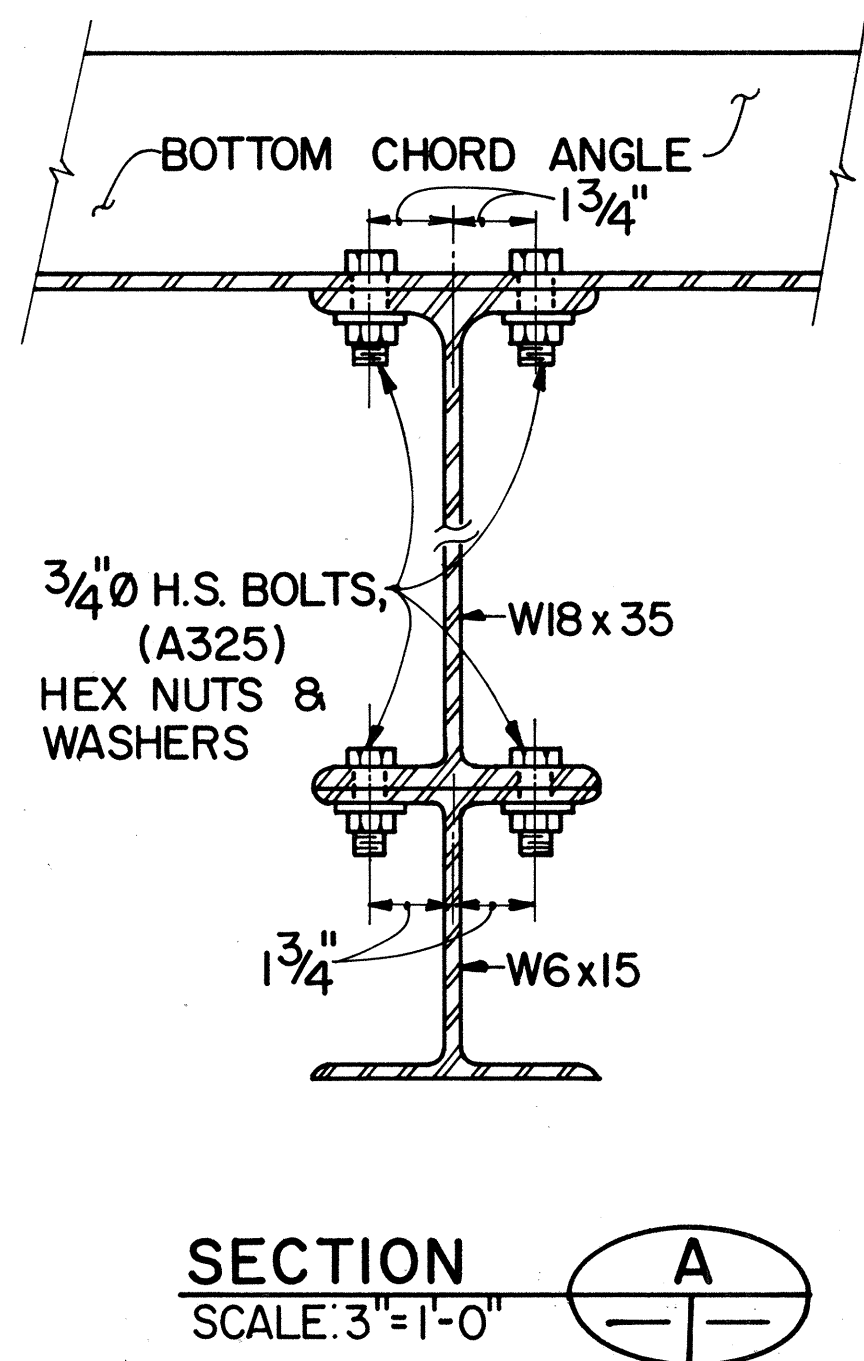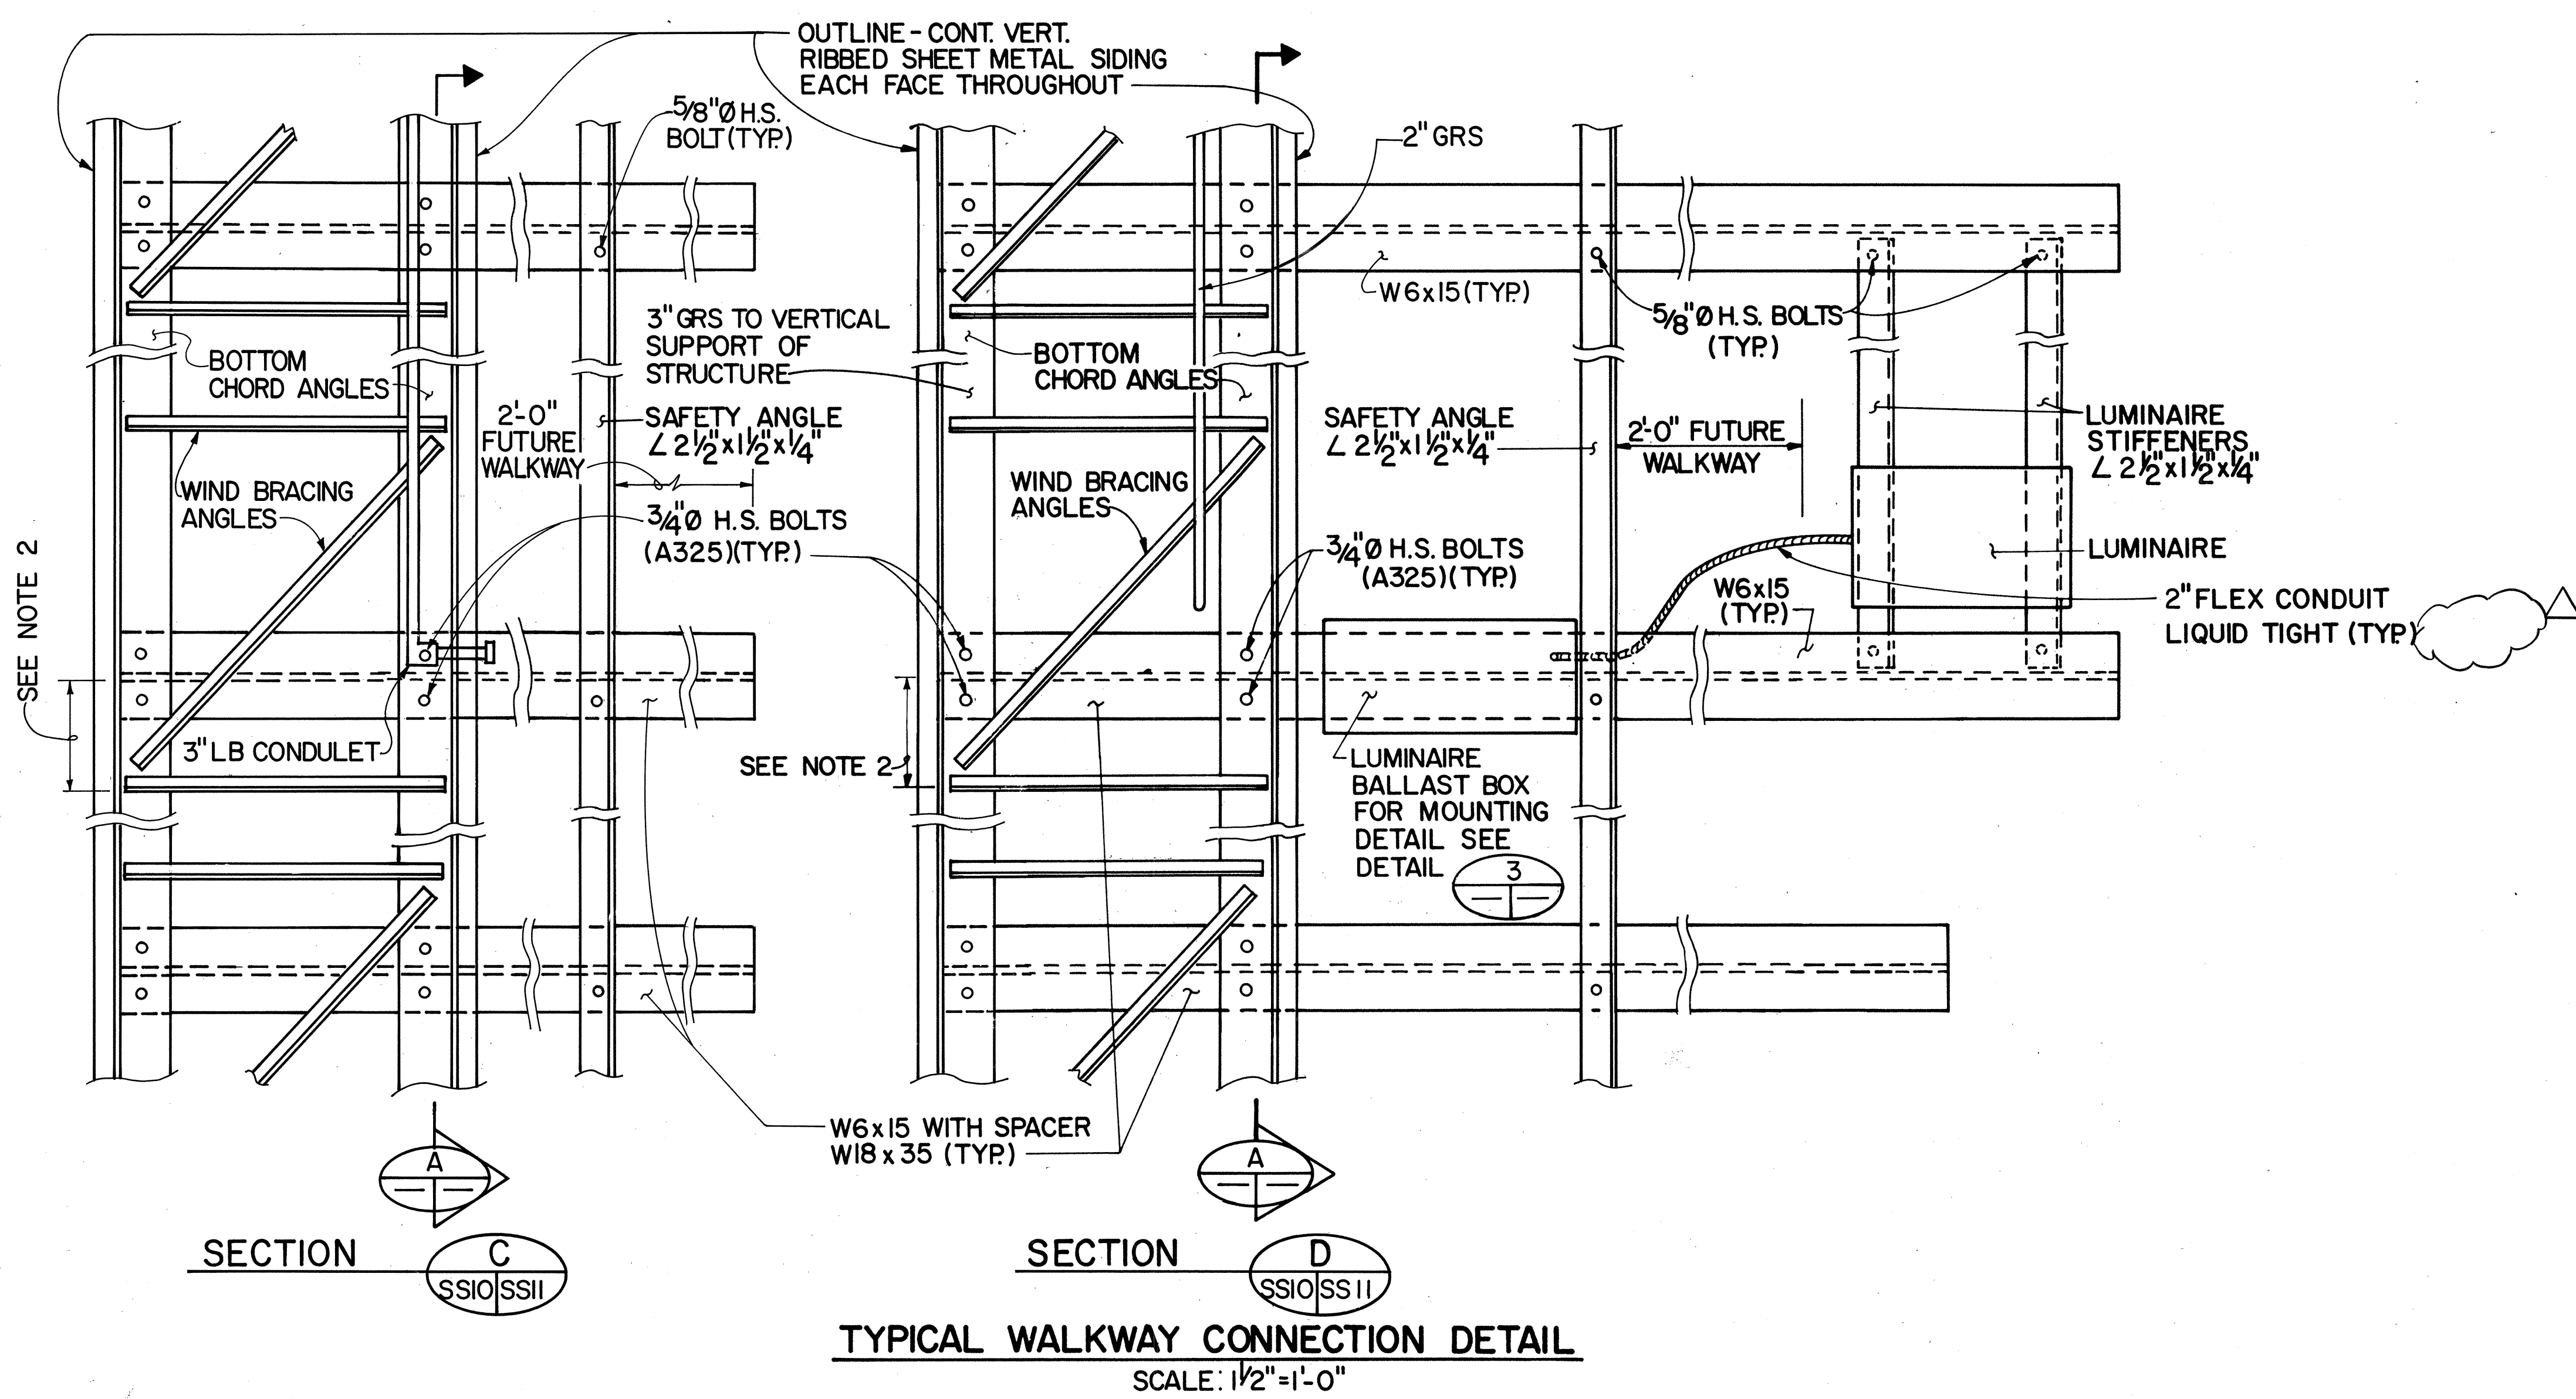

HUI PANG CHEN
REGISTERED PROFESSIONAL ENGINEER
No. 3865-S
HAWAII, U.S.A.

THIS WORK WAS PREPARED BY ME OR UNDER MY SUPERVISION.


Hui Pang Chen

7/20/93	REVISED (N.I.C.) FROM FLEX CONDUIT PER DCN 65-006
DATE	REVISION
STATE OF HAWAII DEPARTMENT OF TRANSPORTATION HIGHWAYS DIVISION	
BOX TRUSS WALKWAY DETAILS-2	
SUPPORT STRUCTURES INTERSTATE ROUTE H-3 F.A.I. PROJ. NO. I-H3-1(65)	
SCALE: AS SHOWN	DATE: DEC. 1991
SHEET NO.SSII OF 19 SHEETS	

TABLE A			
POST TYPE	"a"	"b"	"t"
A	2'-6"	1'-5 ³ / ₄ "	1/2"
B	3'-0"	1'-11 ³ / ₄ "	1/2"


TABLE B					
BASE PLATE				BOLT HOLE SIZE	BOLT SIZE
TYPE	"D"	THICKNESS	"E"		
I	3' - 6"	2 3/4"	1' - 0"	2 5/8"	2 1/4"
II	4' - 0"	3"	1' - 3"	2 5/8"	2 1/4"
III	4' - 0"	3 1/2"	1' - 3"	2 5/8"	2 1/4"

PLACE HANDHOLE IN SUPPORT POSTS WHERE CONDUIT
STUBOUTS ARE PROVIDED. LOCATE HANDHOLE SO THAT
BOTTOM OF HANDHOLE COVER $\varnothing$ IS 1'-2" ABOVE BOTTOM
OF BOX BEAM & CENTERED ABOUT $\varnothing$ SUPPORT POST.

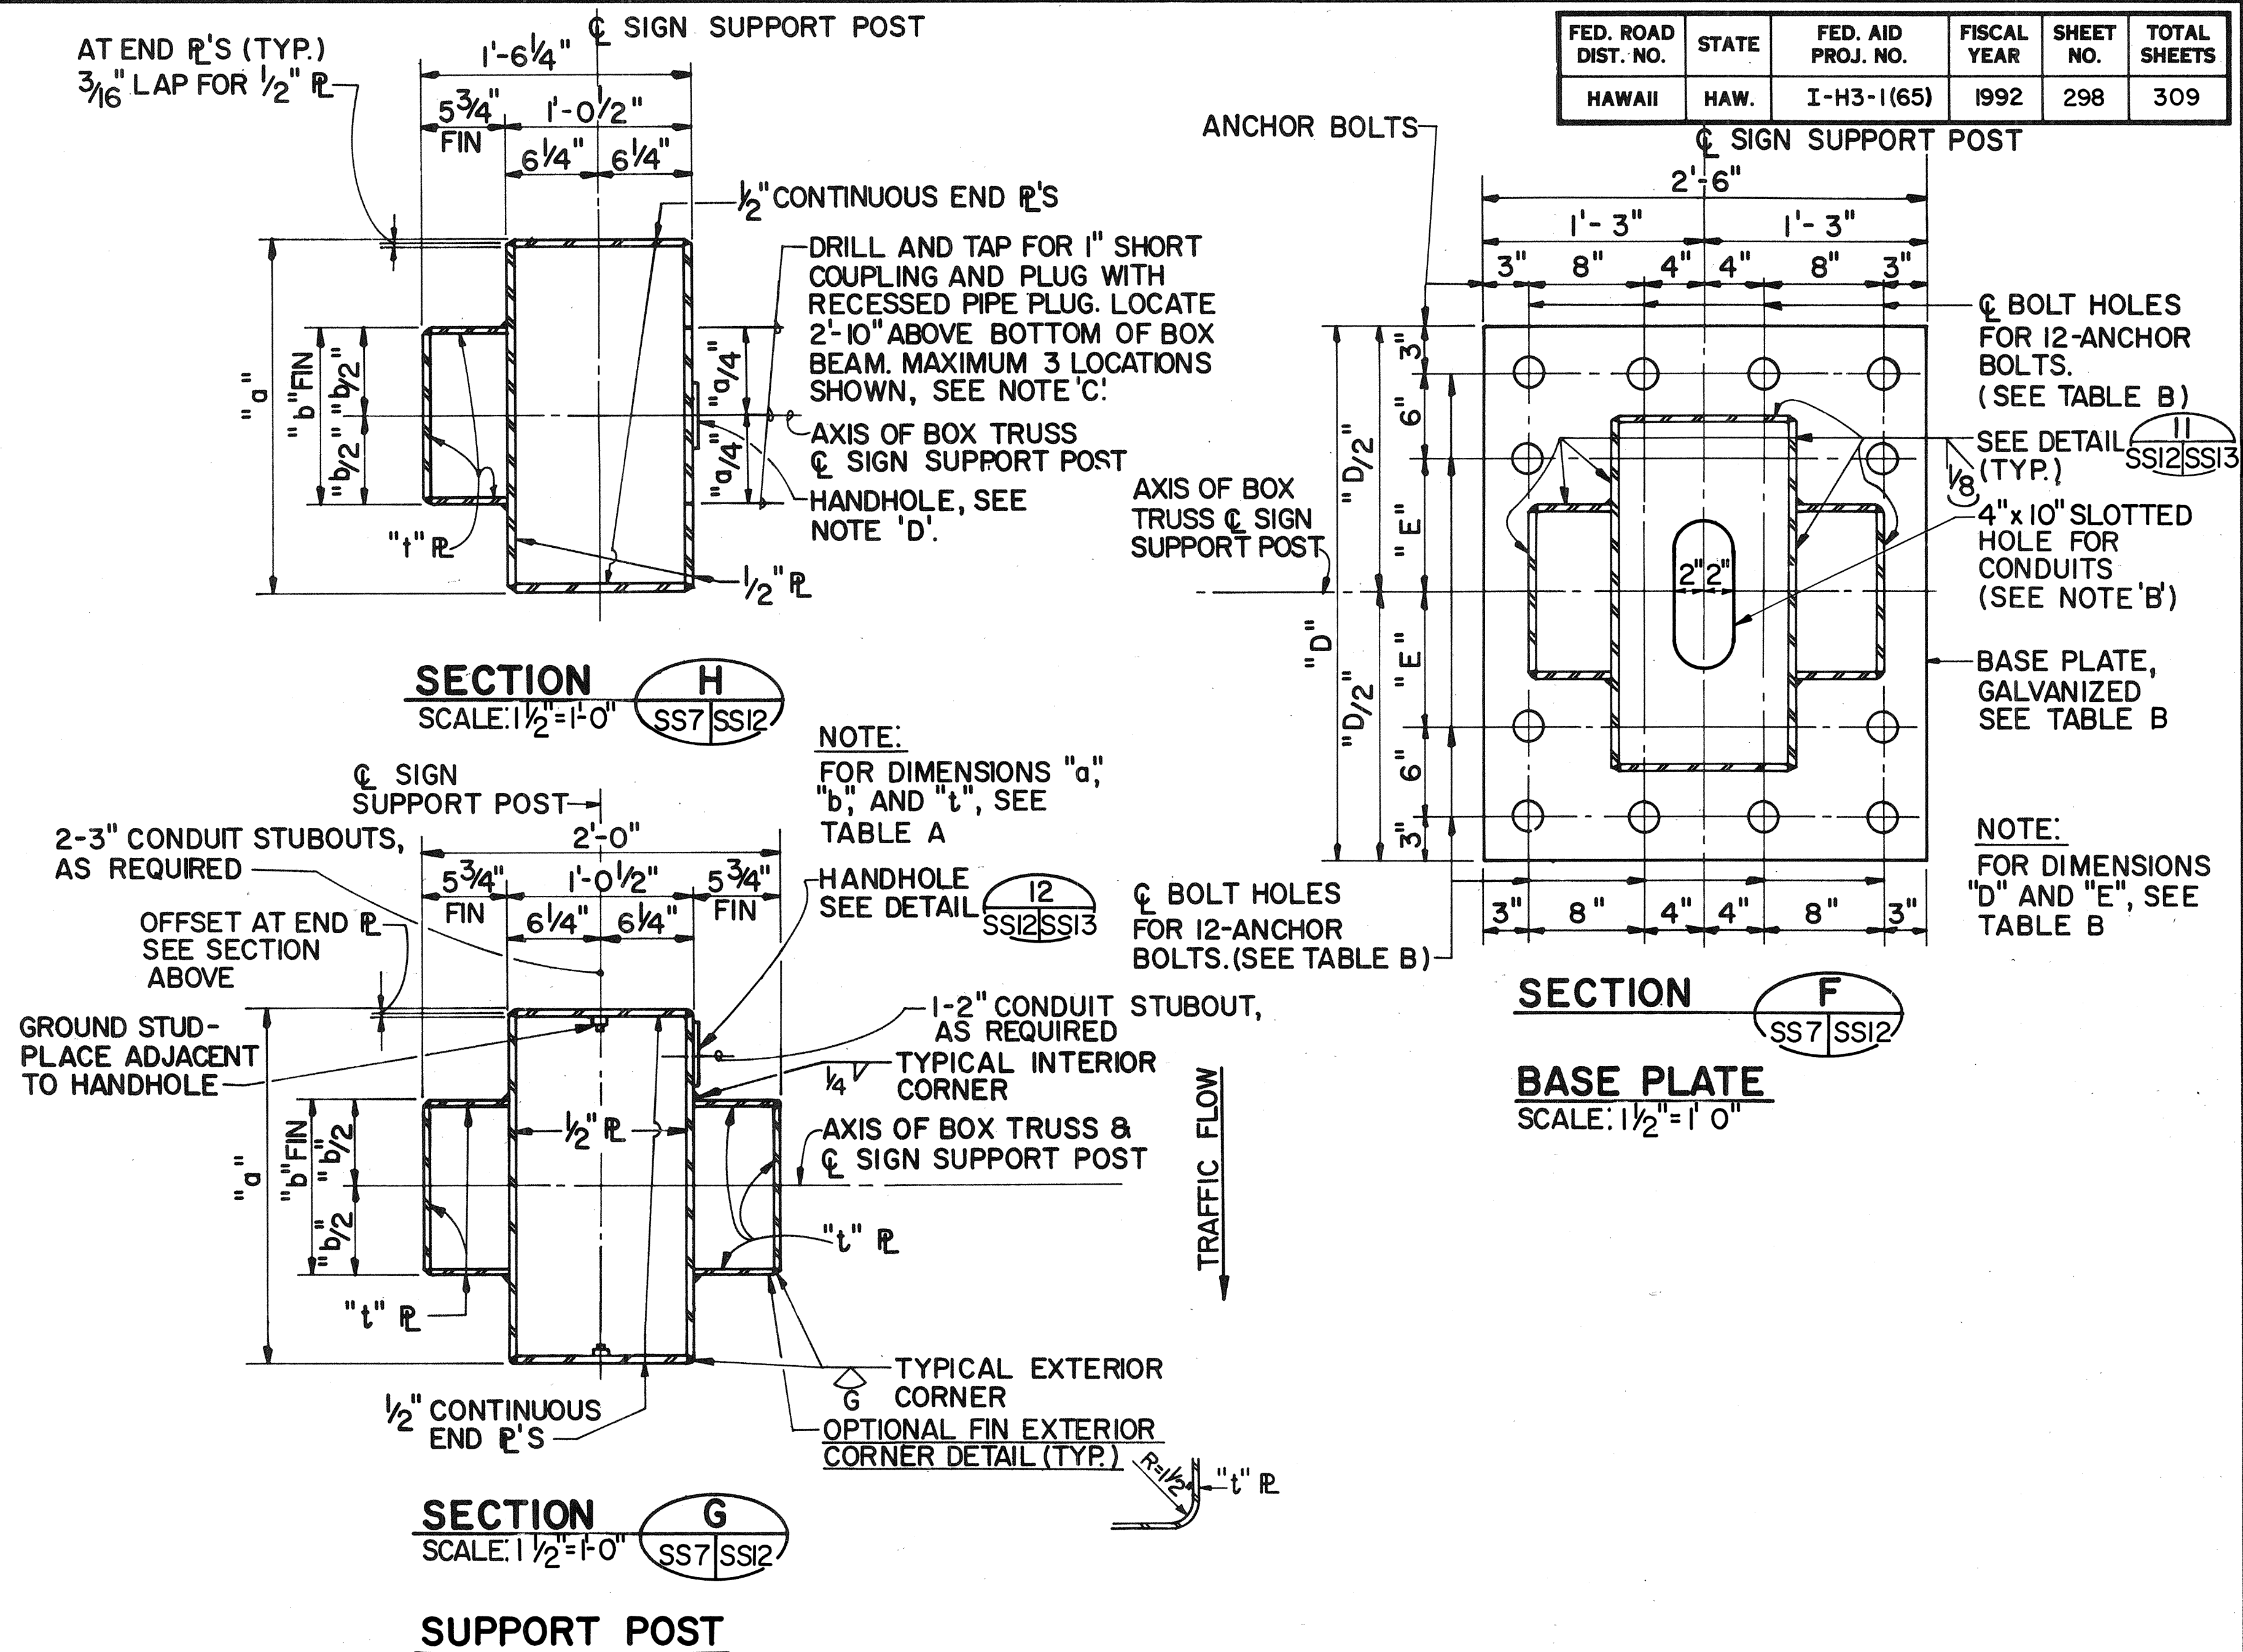
[illegible]

ORIGINAL PLAN	SURVEY PLOTTED BY _____	DATE _____
	DRAWN BY <u>R. MALAMIAN</u>	<u>1/90</u>
	TRACED BY _____	*
NOTE BOOK	DESIGNED BY <u>K. WADA</u>	<u>1/90</u>
	QUANTITIES BY _____	*
No. _____	CHECKED BY <u>S. CHUN</u>	<u>1/90</u>


FED. ROAD DIST. NO.	STATE	FED. AID PROJ. NO.	FISCAL YEAR	SHEET NO.	TOTAL SHEETS
HAWAII	HAW.	I-H3-1(65)	1992	299	309

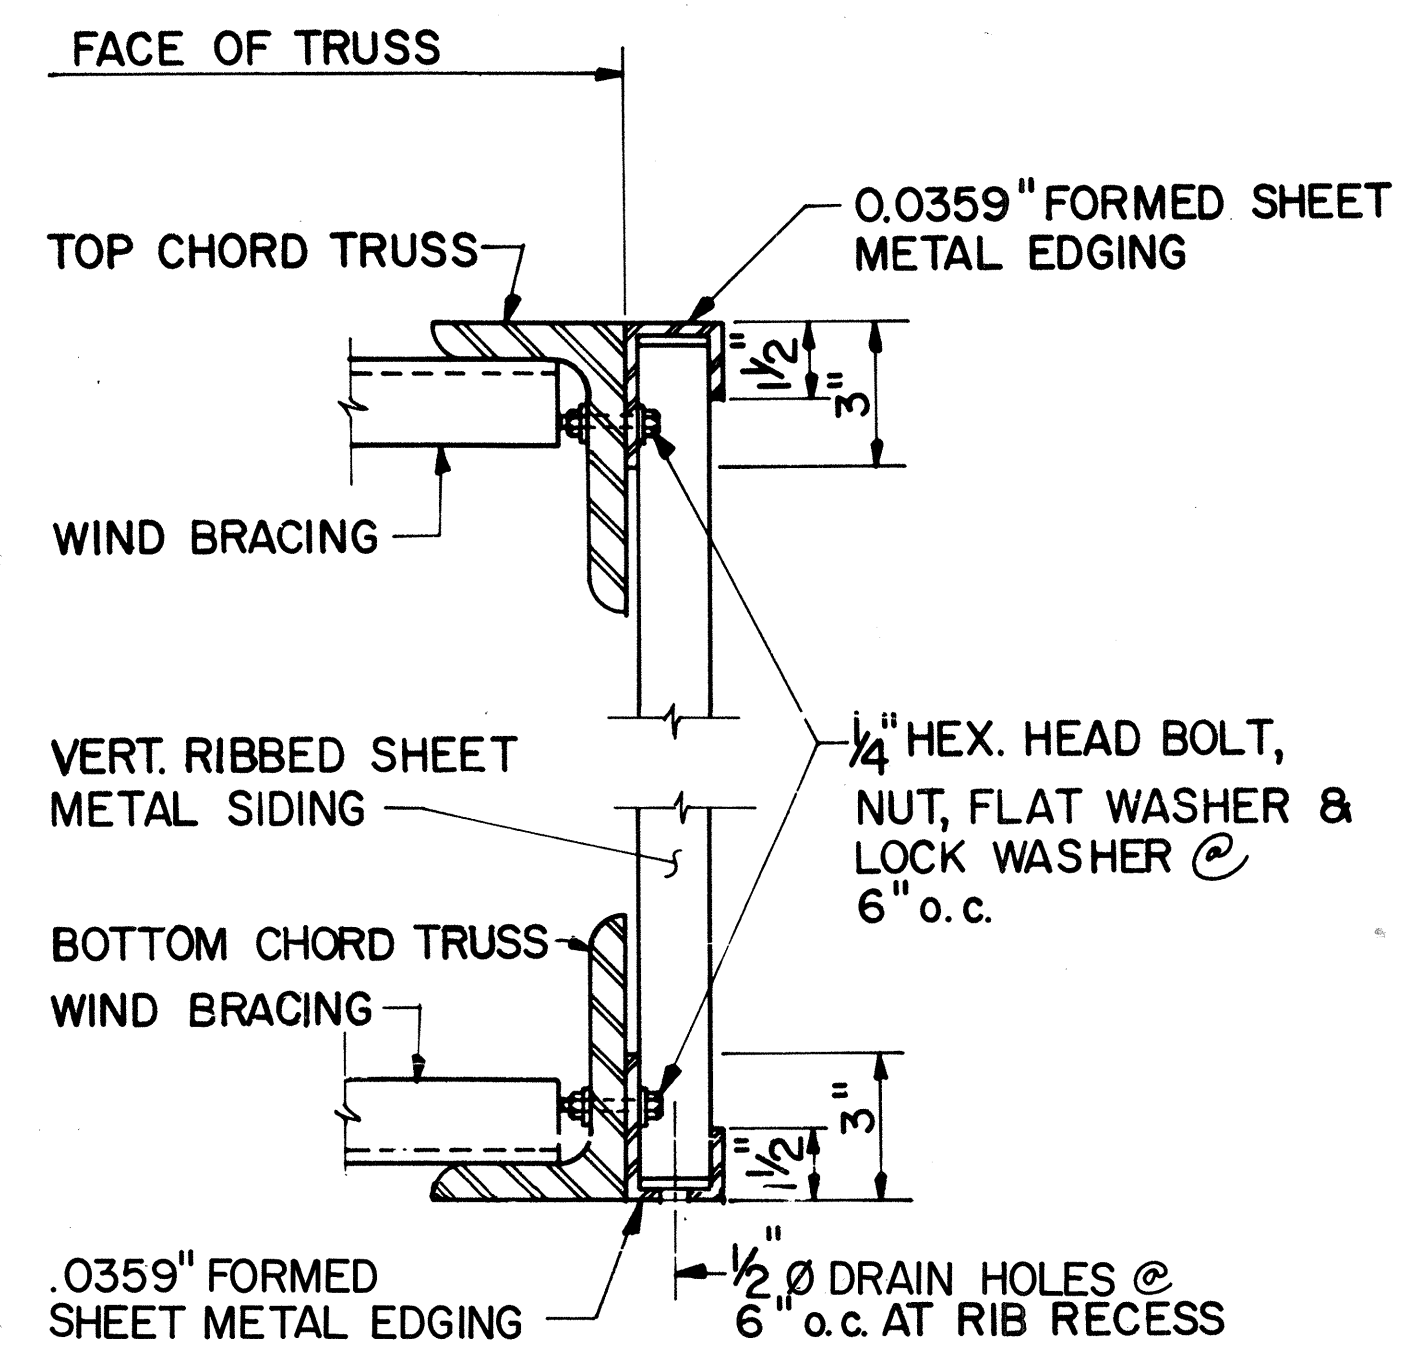

SECTION D
SCALE: 3"=1'-0" SS8, SS13, SS13

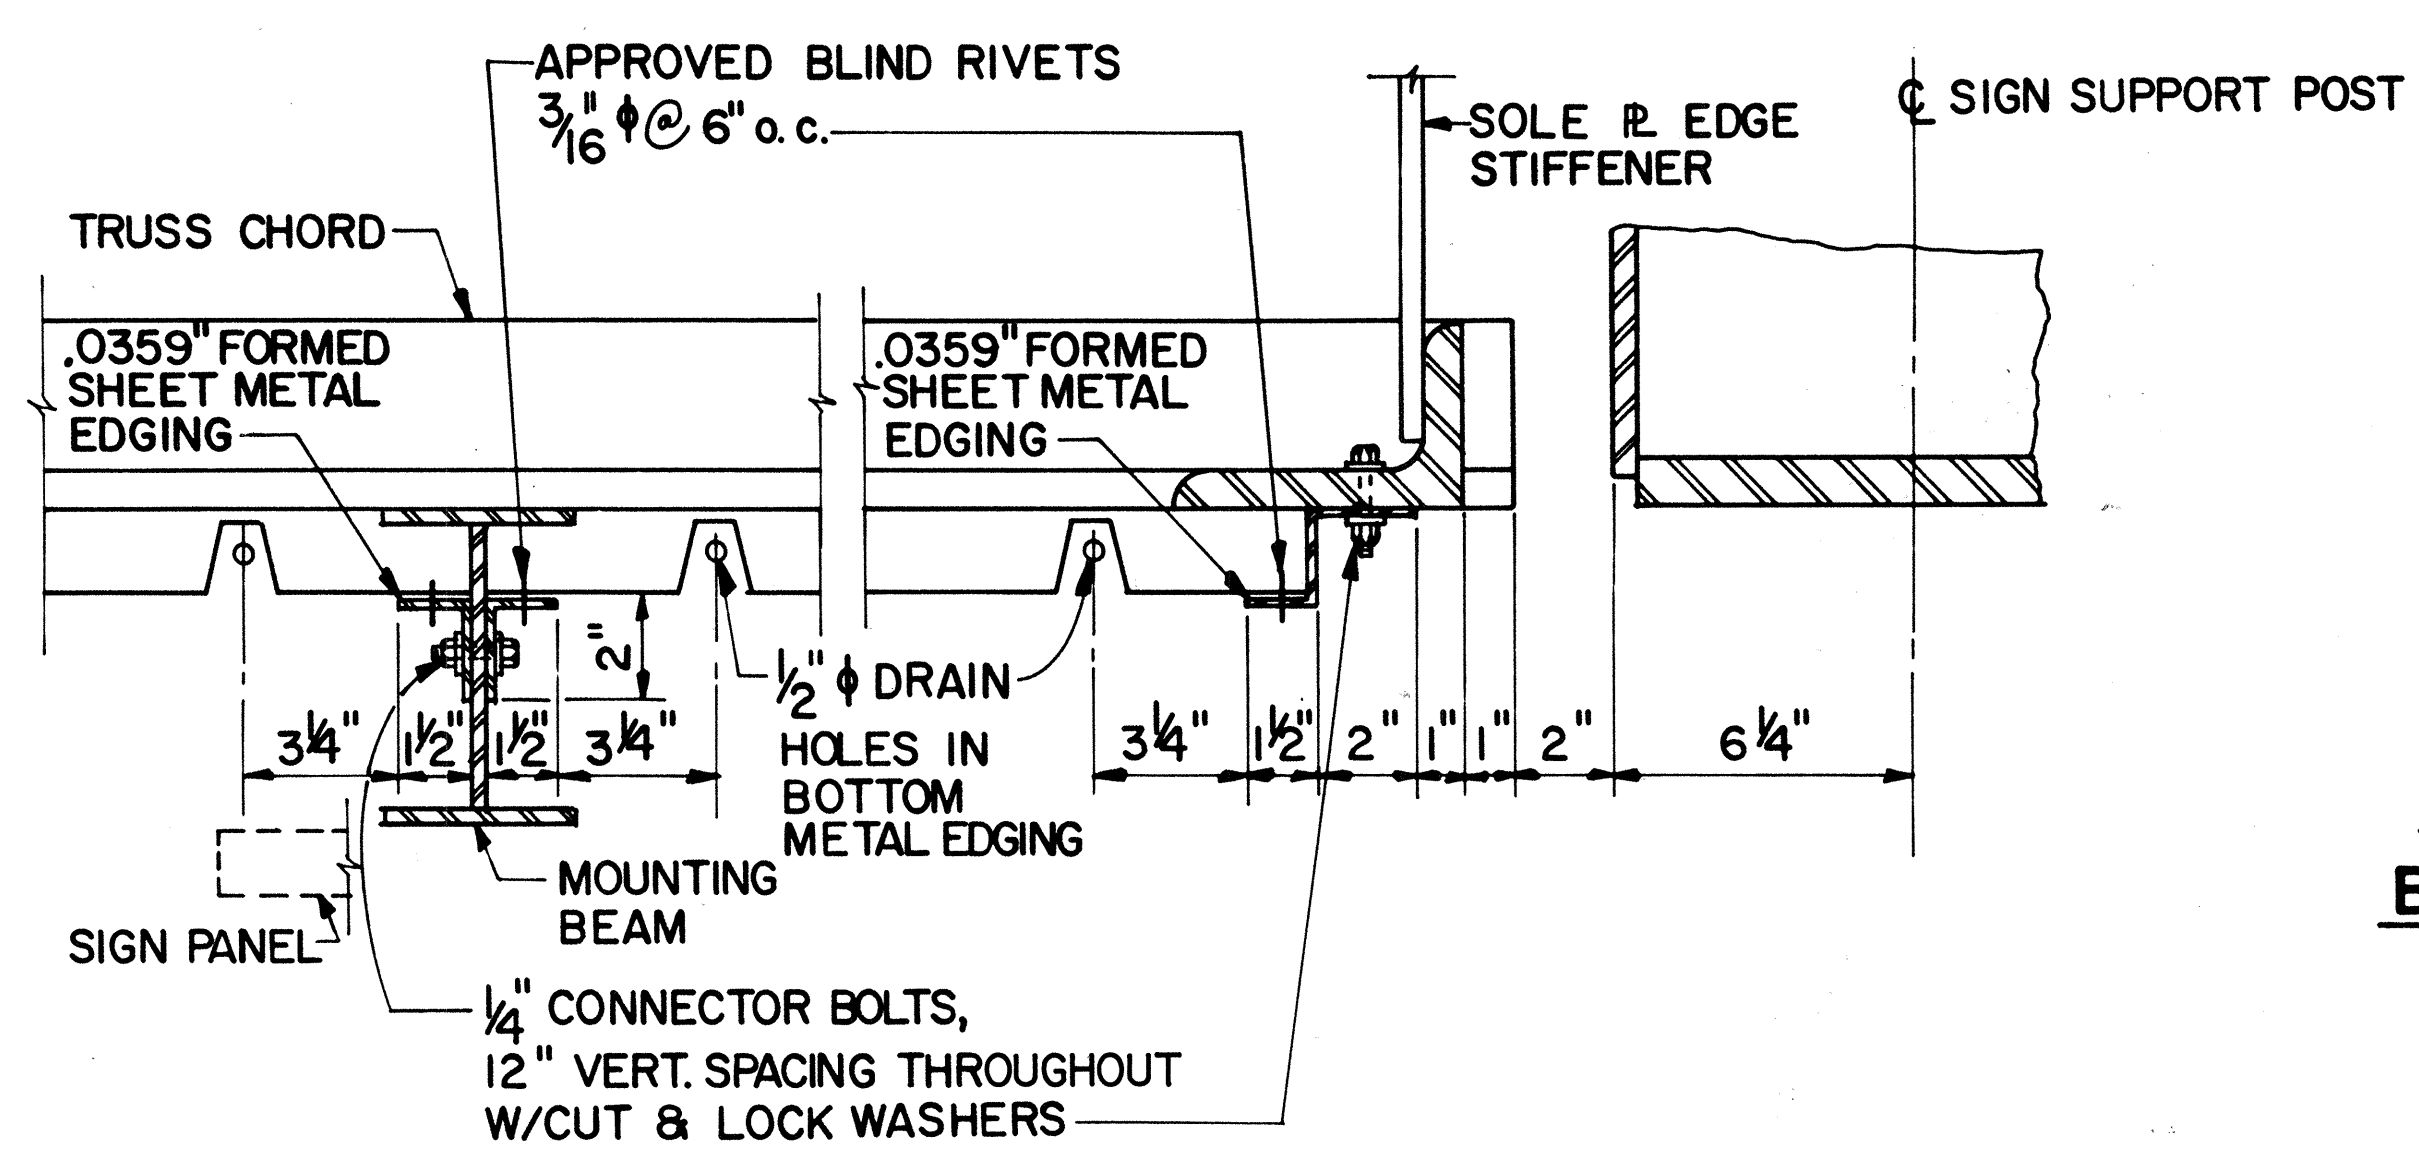

SECTION E
SCALE: 3"=1'-0"

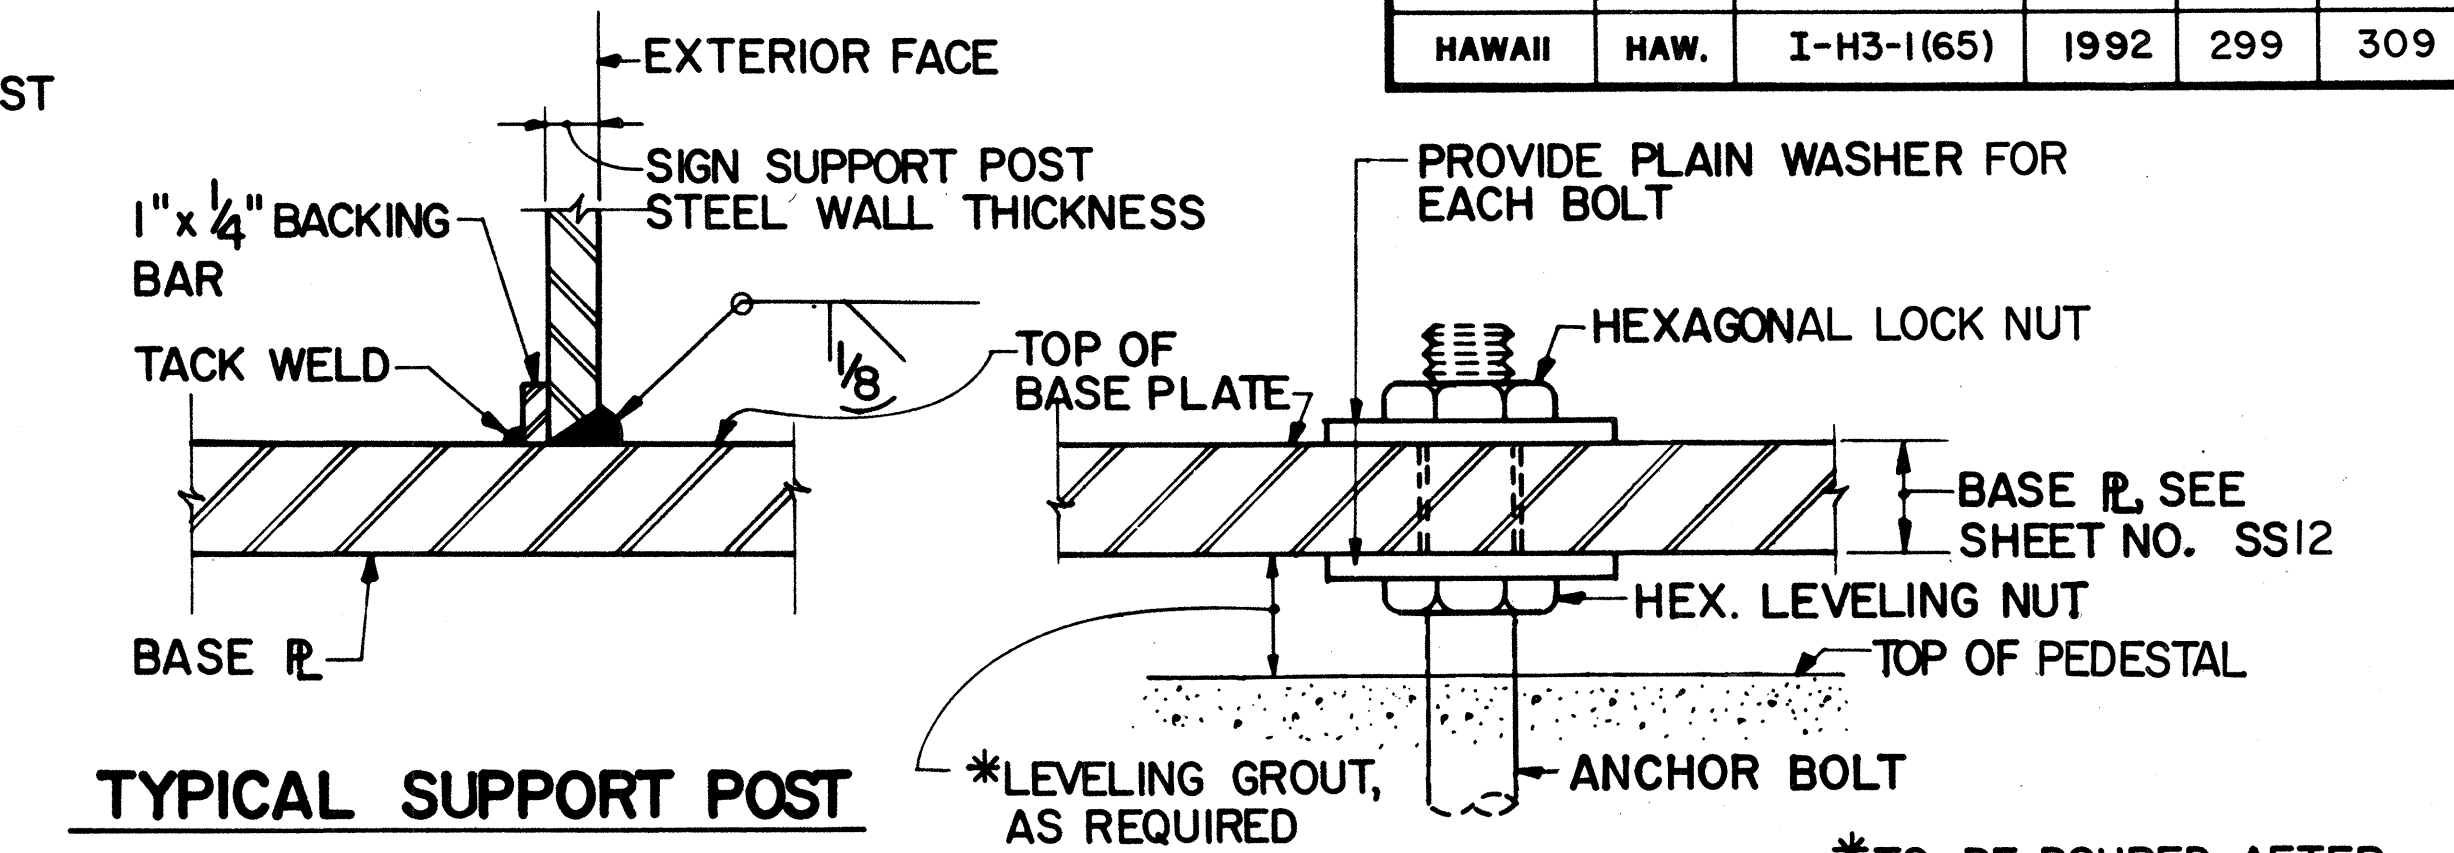


TYPICAL SUPPORT POST BASE CONNECTION DETAILS


DETAIL 11
N.T.S. SS12, SS13

TYPICAL BASE PLATE ANCHOR BOLT CONNECTION DETAIL

DETAIL 10
SCALE: 3"=1'-0" SS7, SS13

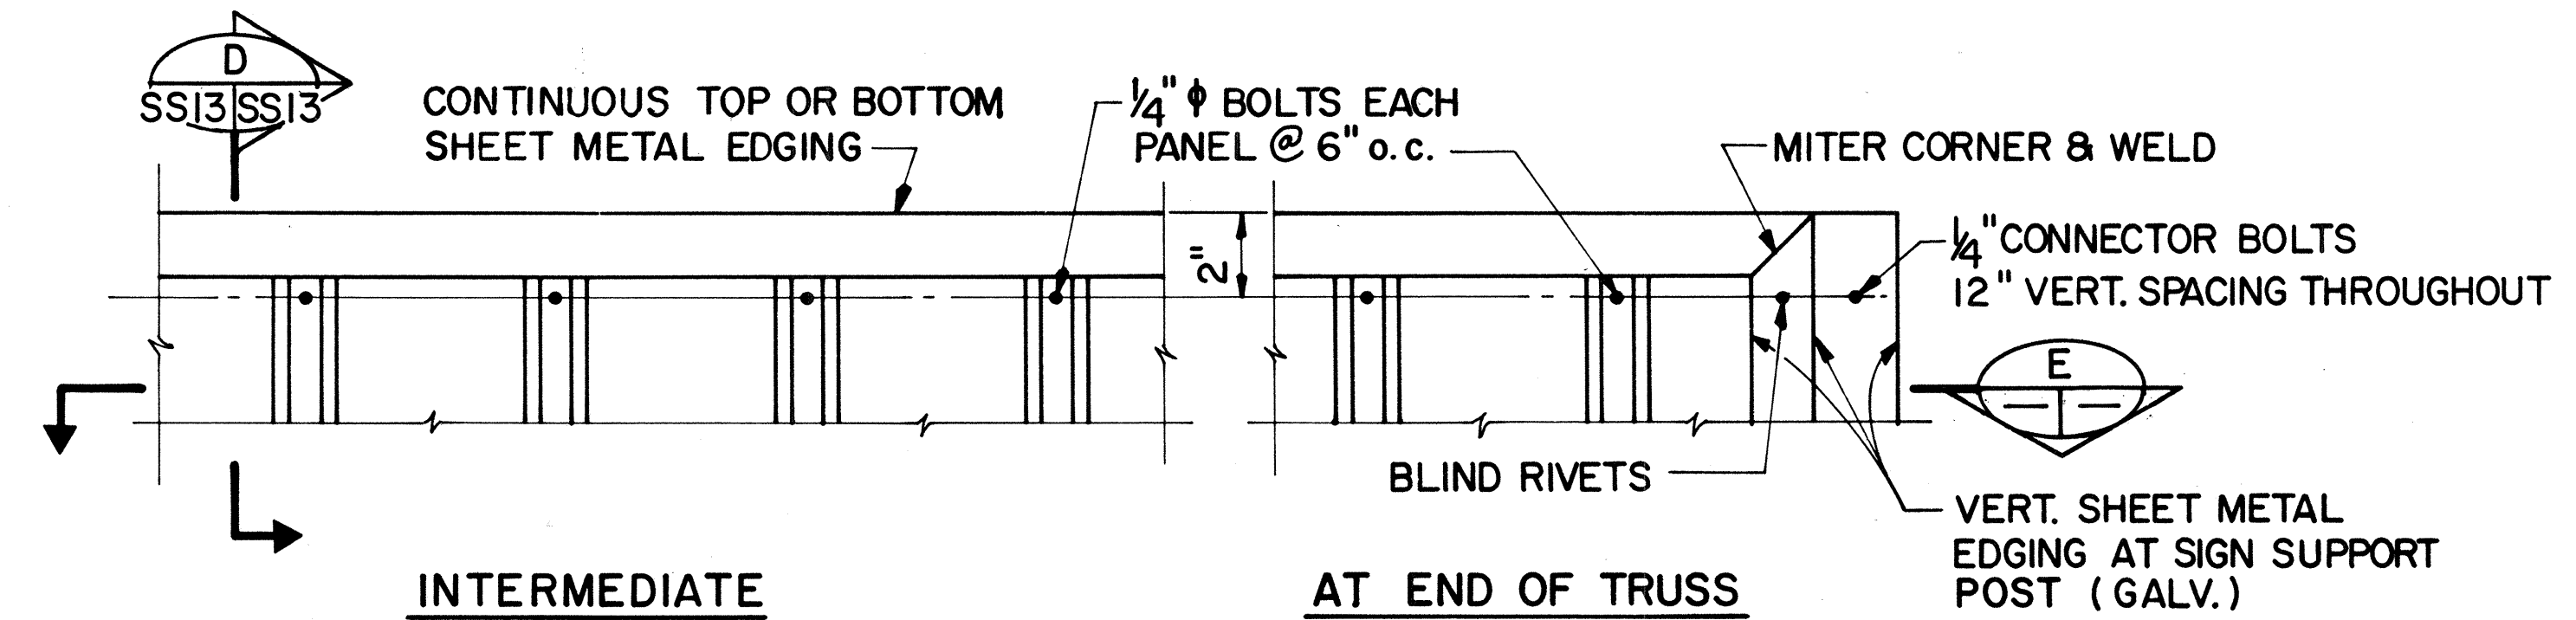


EXTERIOR ELEVATION
SCALE: 3"=1'-0"

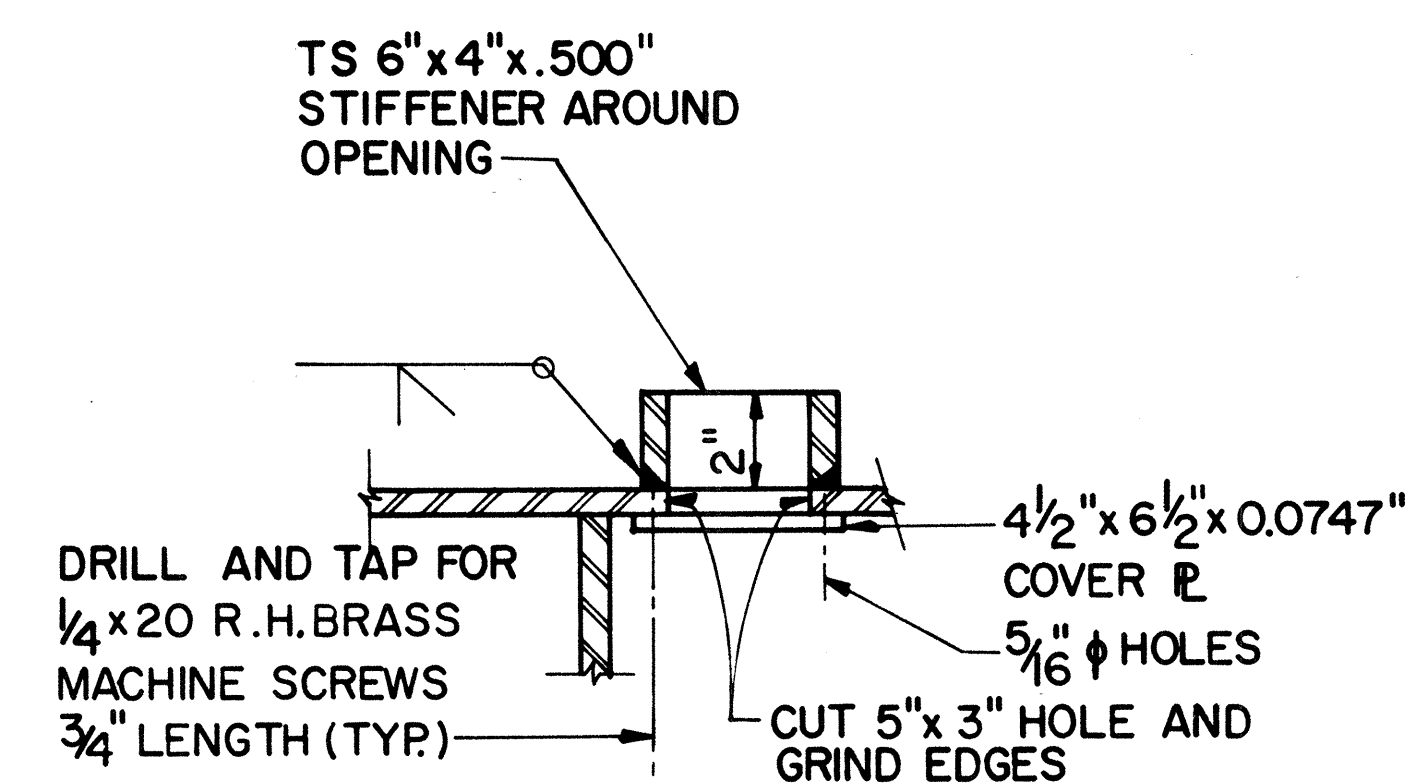


SECTION C
SCALE: 3"=1'-0"


NOTE:
PLACE HANDHOLES IN ALL POSTS.

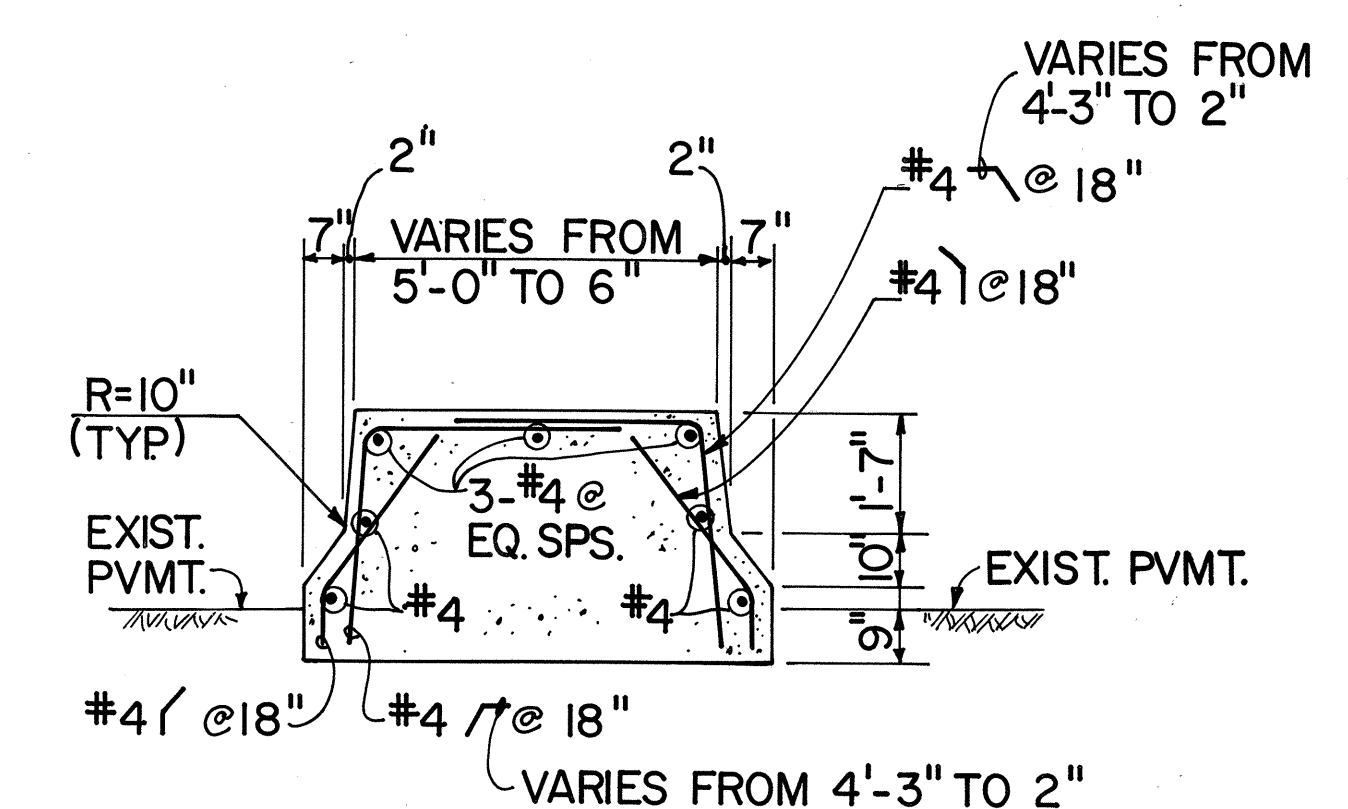

SECTION G
SCALE: 3/8"=1'-0" SS13


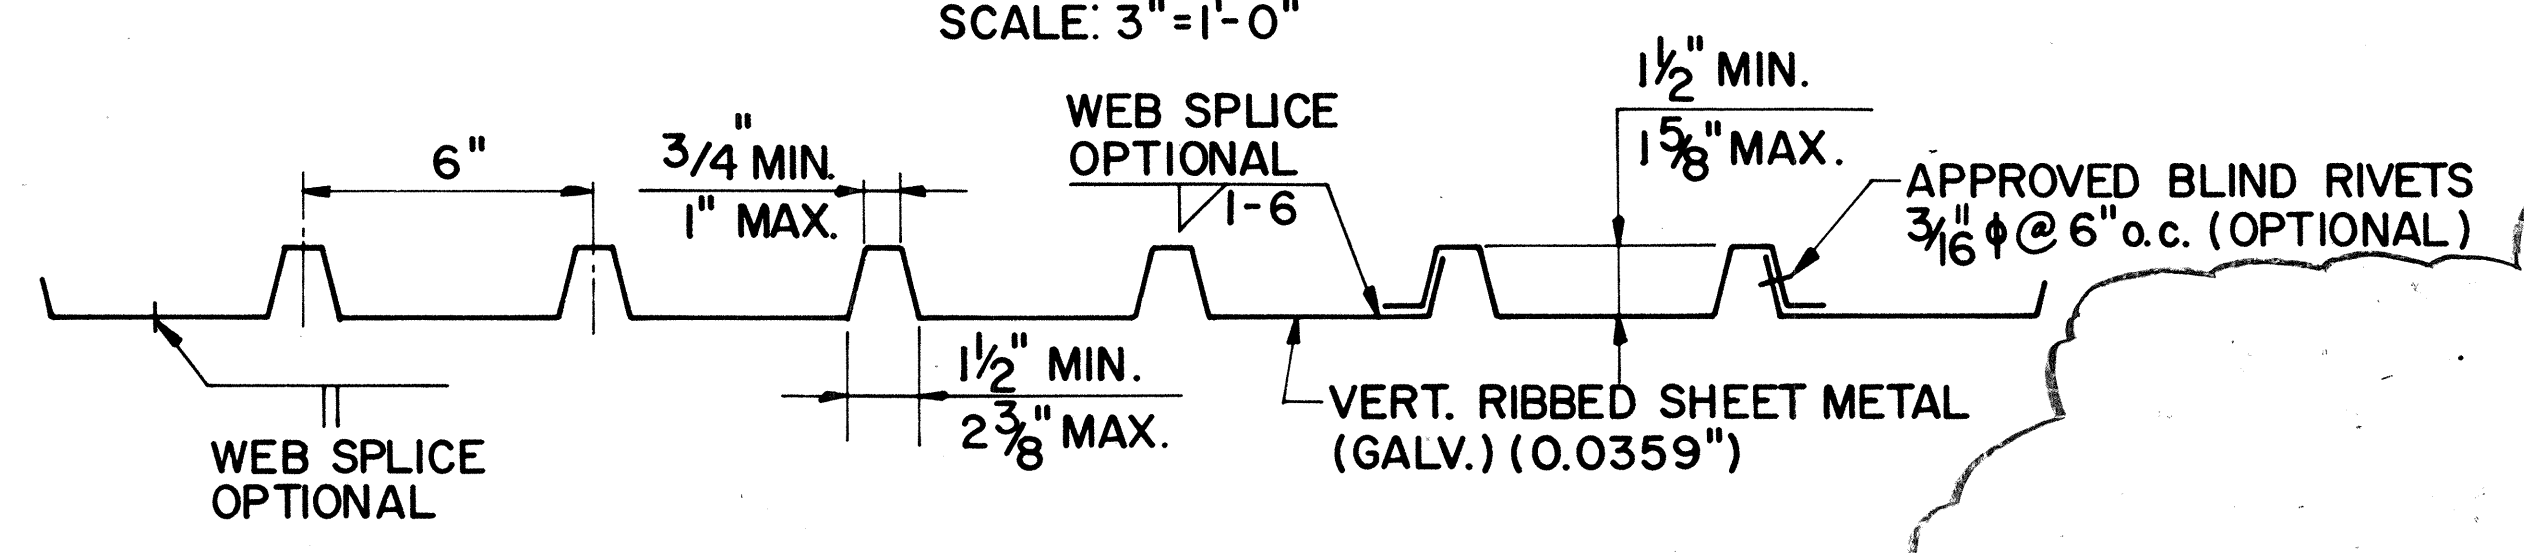


TYPICAL RIBBED SHEET METAL SECTIONS
SCALE: 3"=1'-0"

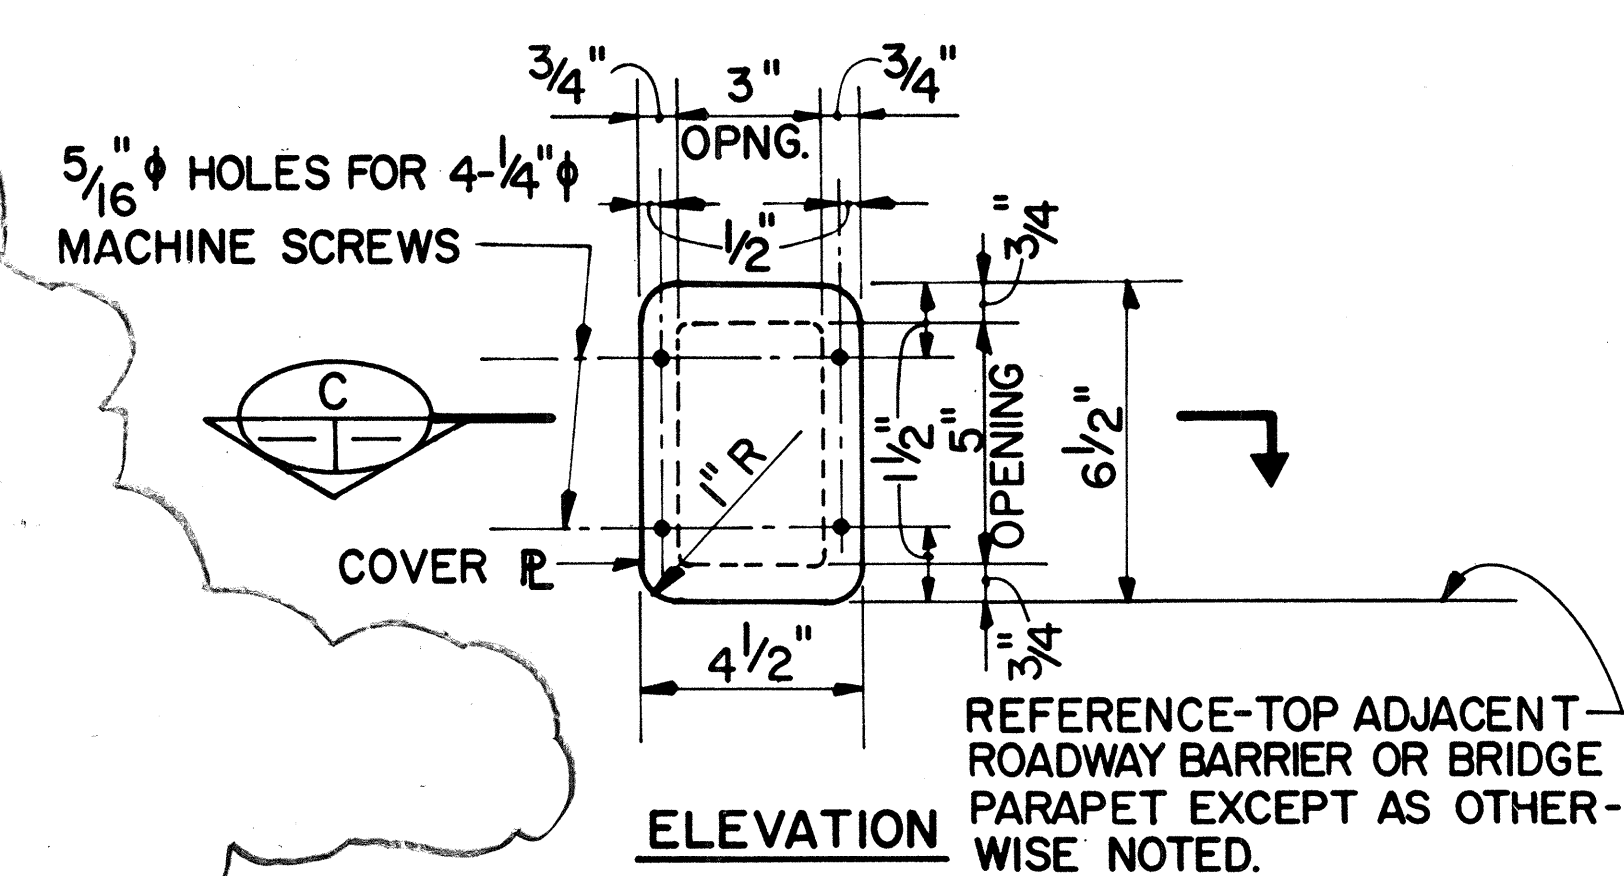

HANDHOLE & COVER PLATE DETAIL

DETAIL 12
SCALE: 3"=1'-0" SS12, SS13

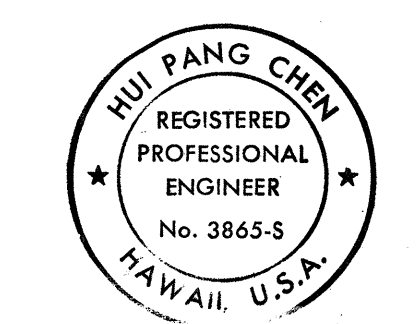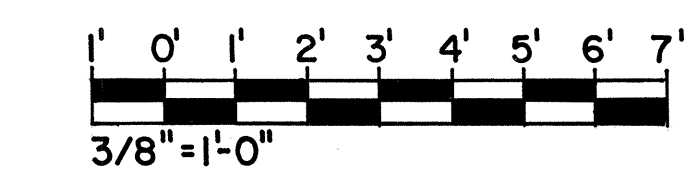


THIS WORK WAS PREPARED BY ME OR UNDER MY SUPERVISION.
Hui Pang Chen

- RIBBED SHEET METAL NOTES:**
- ALL RIBBED SHEET METAL AND FORMED EDGING SHALL BE GALVANIZED STEEL CONFORMING TO ASTM DESIGNATION: A446, GRADE A; G165 COATING DESIGNATION IN CONFORMANCE WITH ASTM DESIGNATION: A525.
 - CONNECTION BOLTS, NUTS AND WASHERS TO BE GALVANIZED STEEL ASTM A307.


DATE	REVISION
3/31/94	DELETED SECT. 'A' PER DCN 65-027
STATE OF HAWAII DEPARTMENT OF TRANSPORTATION HIGHWAYS DIVISION	
MISCELLANEOUS DETAILS-1	
SUPPORT STRUCTURES INTERSTATE ROUTE H-3 F.A.I. PROJ. NO. I-H3-1(65)	
SCALE: AS SHOWN	DATE: DEC. 1991
SHEET No. SS13 OF 19 SHEETS	

DATE	1/90
DESIGNED BY	H.P. CHEN
CHECKED BY	K. WADA
ORIGINAL PLAN	
NOTE BOOK	
No.	


FED. ROAD DIST. NO.	STATE	FED. AID PROJ. NO.	FISCAL YEAR	SHEET NO.	TOTAL SHEETS
HAWAII	HAW.	I-H3-1(65)	1992	300	309

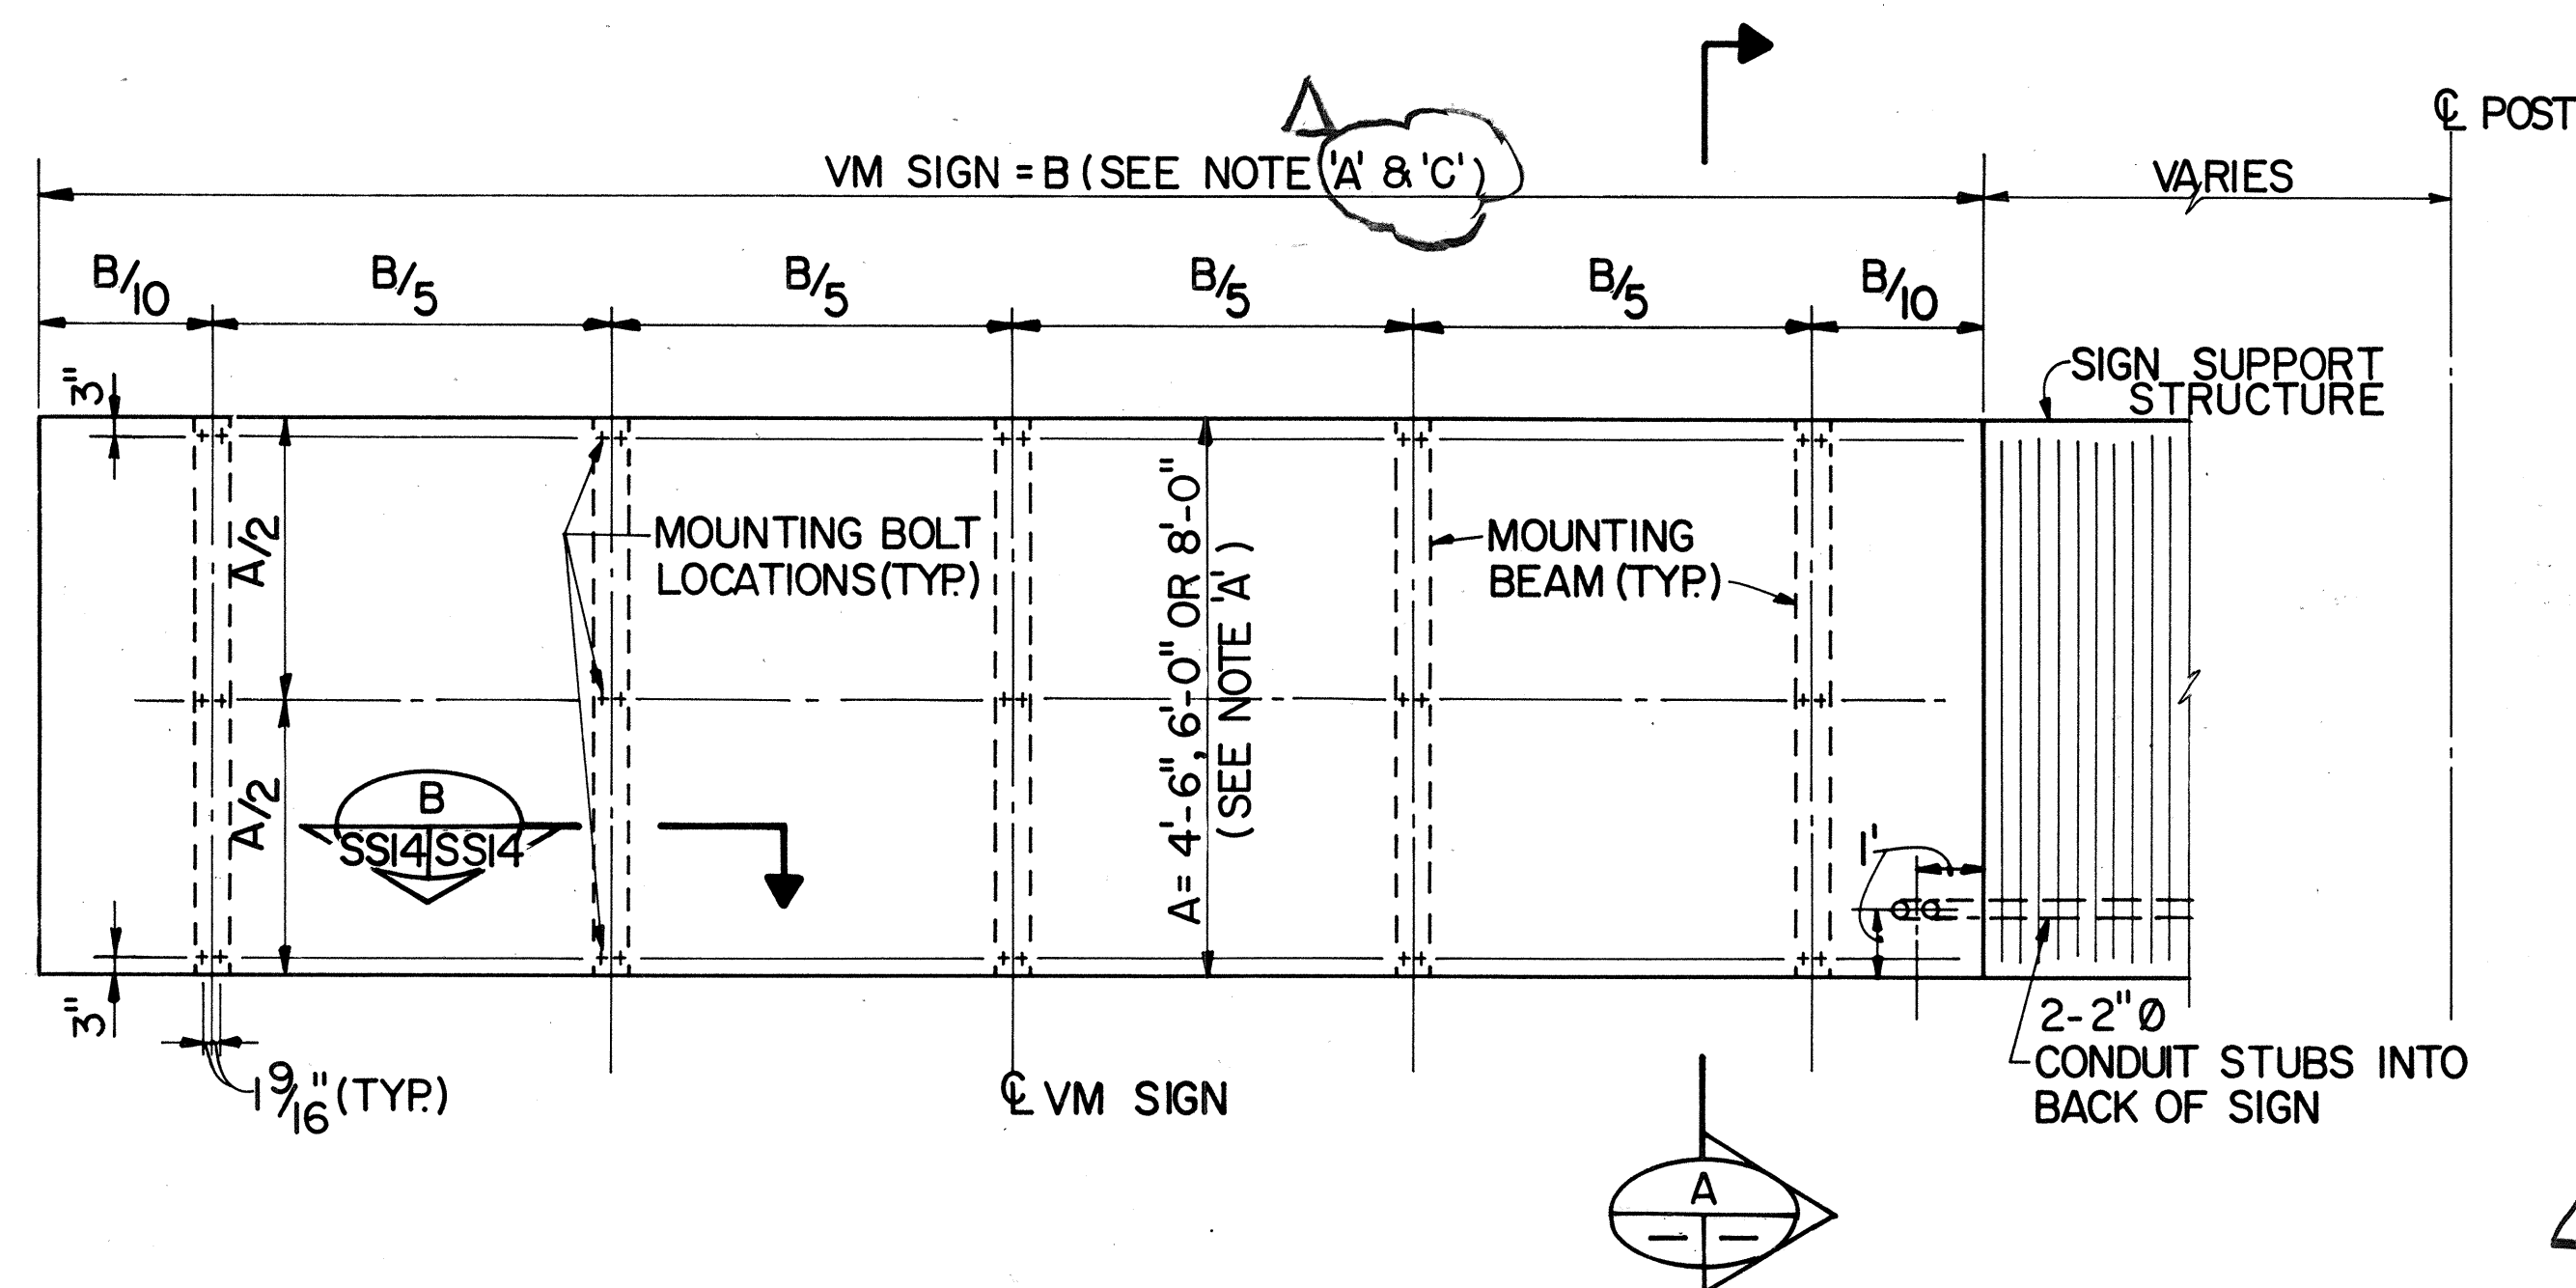

ELEVATION FOR VMS 35, 36 & 44 (AS SHOWN)
ELEVATION FOR VMS 33, 34, 37, 39, 40 & 43 (SIMILAR EXCEPT OPPOSITE HAND)
 SCALE: 3/8" = 1'-0"

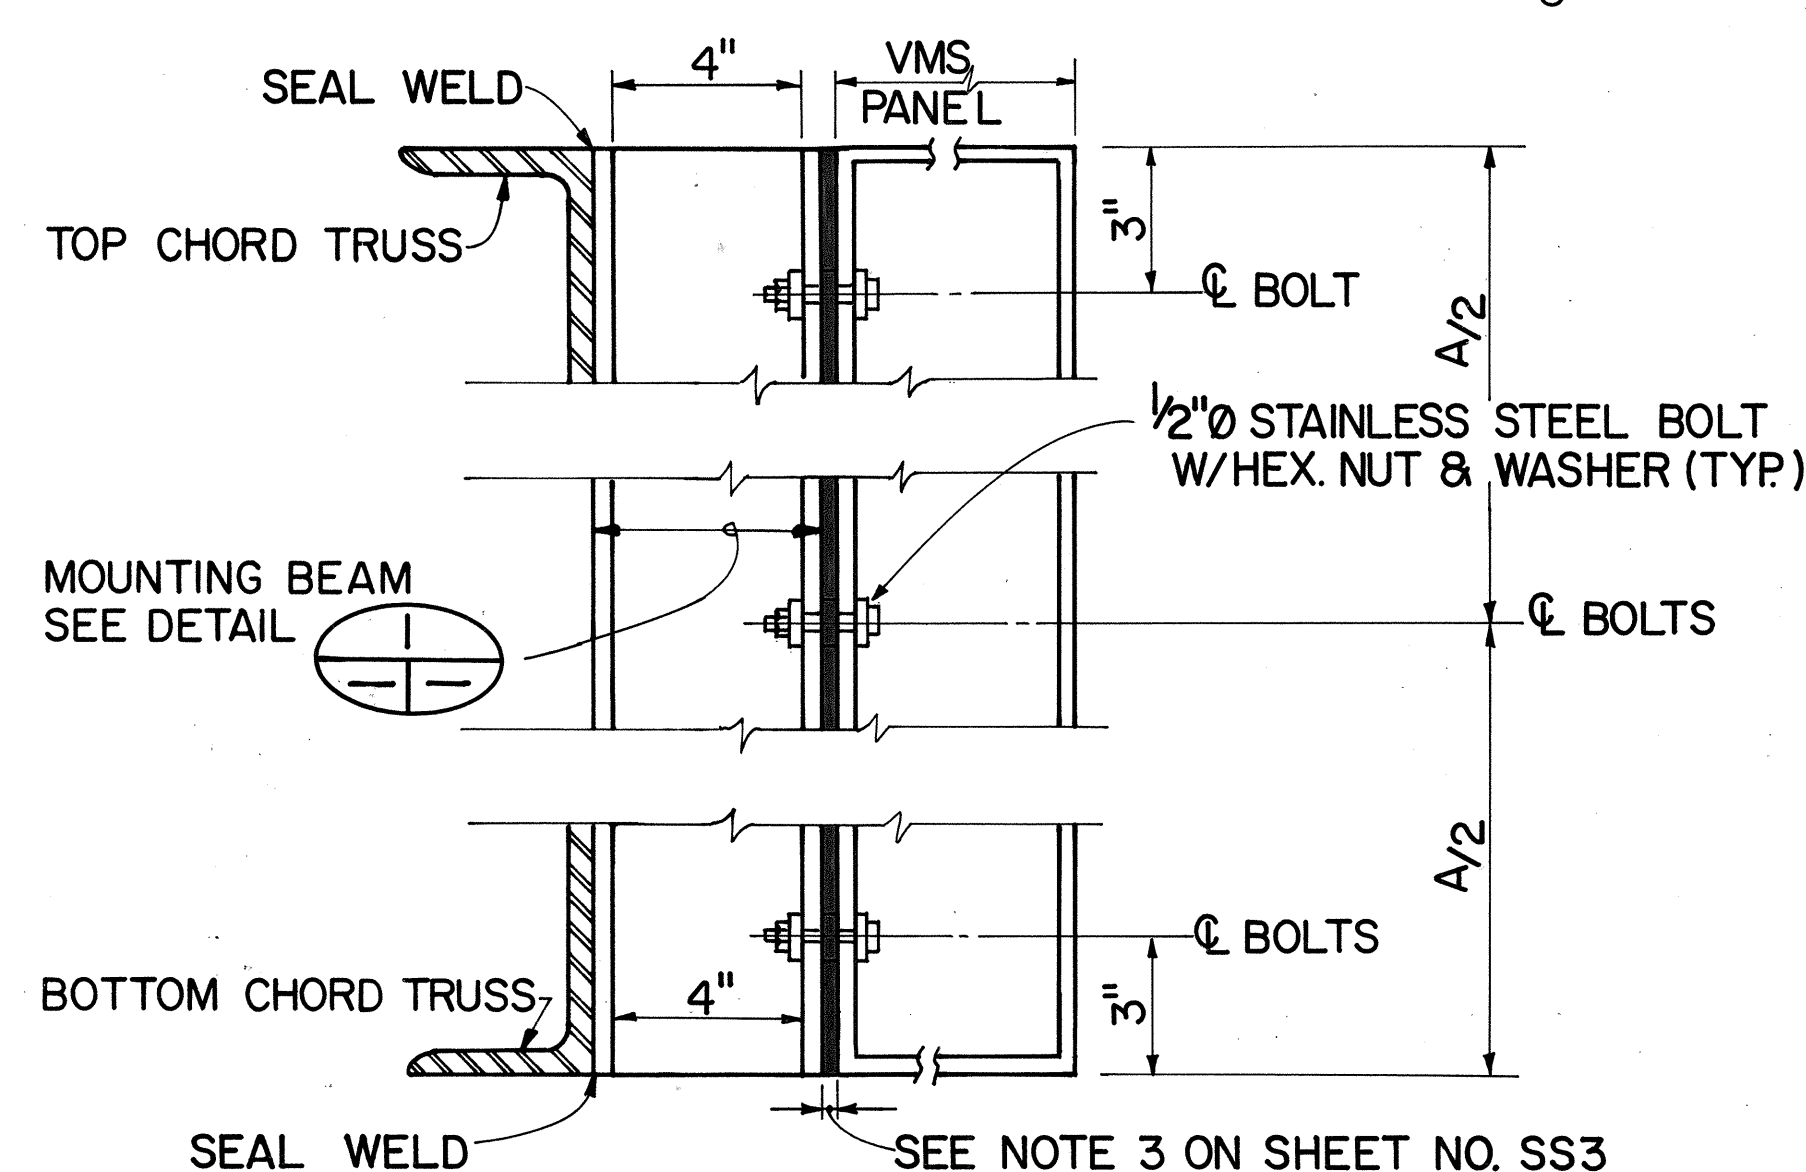


SECTION A
 SCALE: 3" = 1'-0"

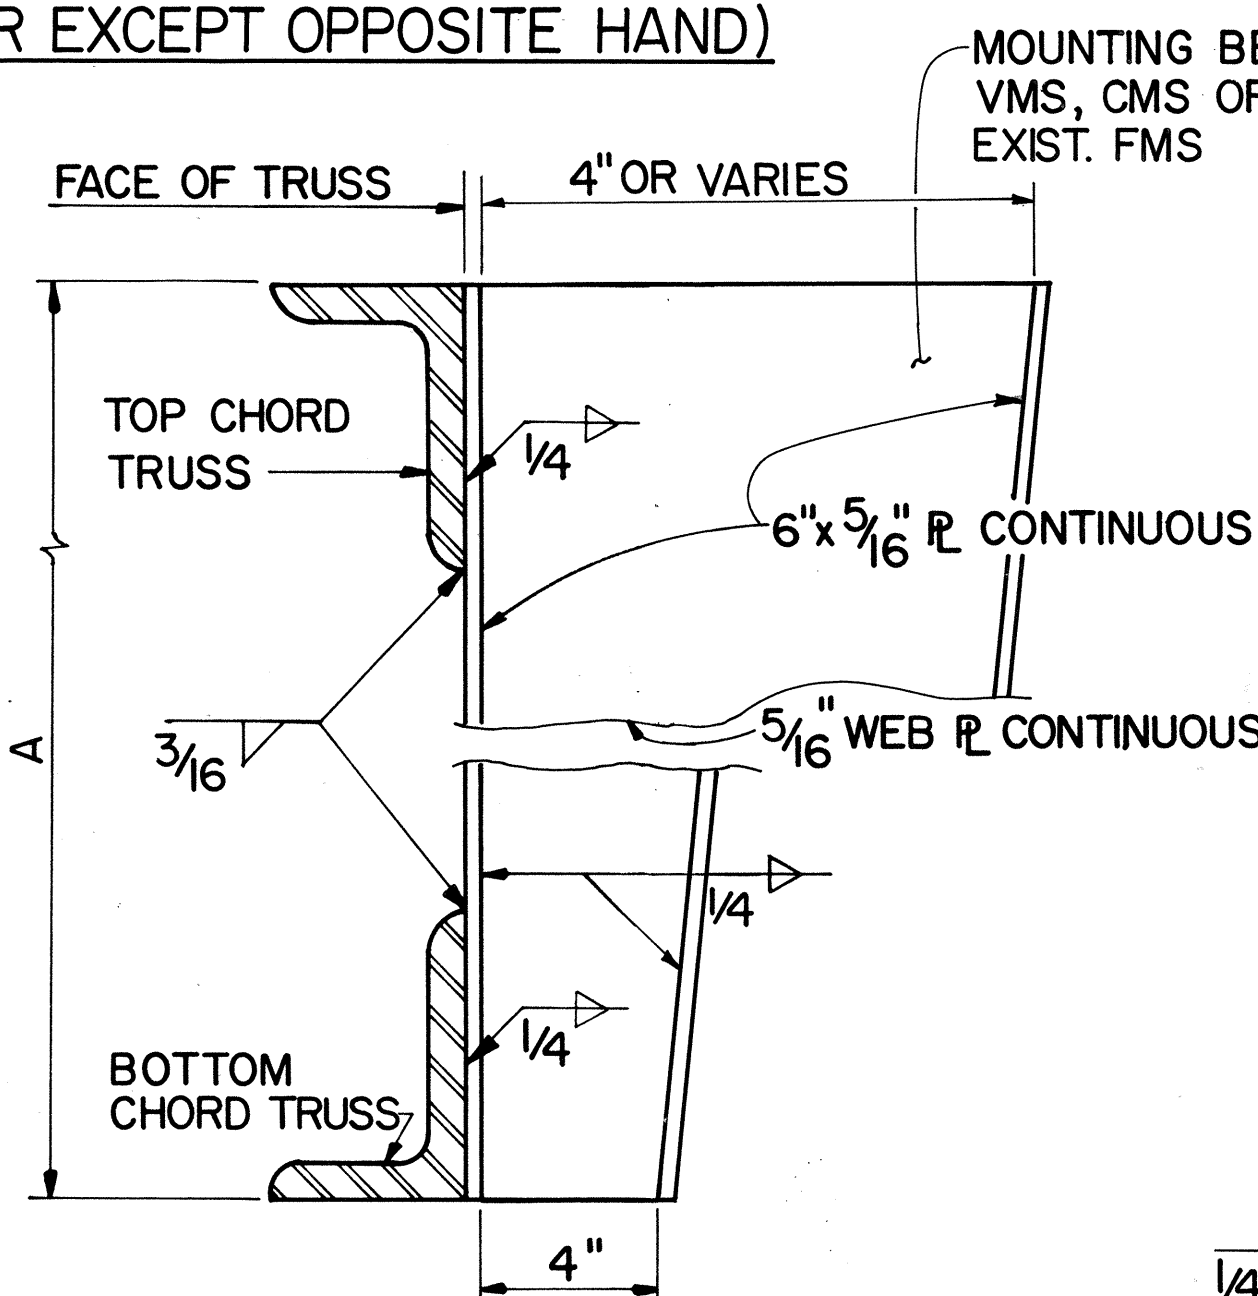

TYPICAL BUILT-UP GALVANIZED STEEL MOUNTING BEAM

DETAIL
 SCALE: 3" = 1'-0"

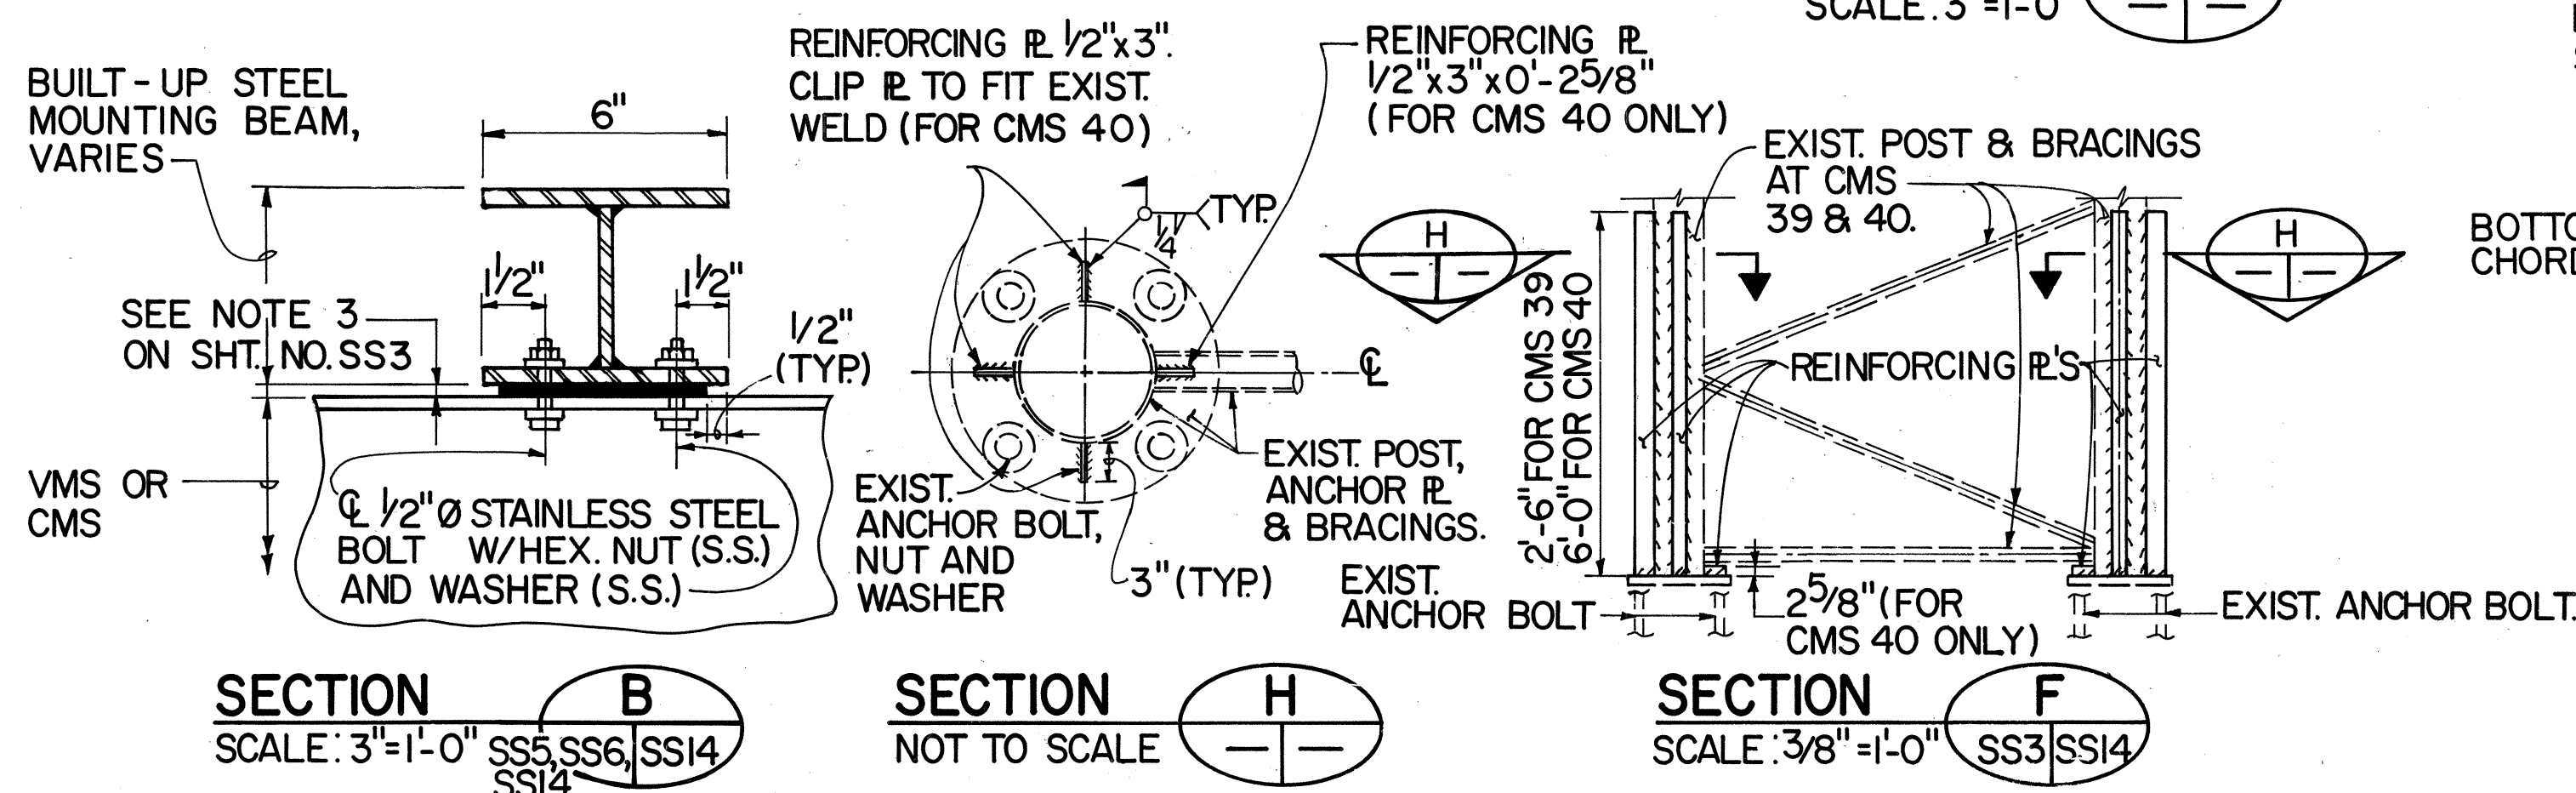

SECTION B
 SCALE: 3" = 1'-0"


SECTION H
 NOT TO SCALE

SECTION F
 SCALE: 3/8" = 1'-0"


NOTE 'A': THE CONTRACTOR SHALL DESIGN THE VMS PANEL THICKNESS TO ACCOMMODATE THE DIMENSIONS & MOUNTING SPACINGS AS SHOWN AND THE REQUIREMENTS OF THE MANUFACTURER.
 B = 18'-0" FOR VMS 33, 34, 37 & 39
 B = 21'-0" FOR VMS 36
 B = 31'-0" FOR VMS 35, 38, 40-44
 A = 4'-6" FOR VMS 33, 34, 37 & 39
 A = 6'-0" FOR VMS 36, 38, 41 & 42
 A = 8'-0" FOR VMS 35, 40, 43 & 44

NOTE 'B': THE CONTRACTOR SHALL DESIGN THE CMS PANEL THICKNESS TO ACCOMMODATE THE DIMENSIONS & MOUNTING SPACINGS AS SHOWN AND THE REQUIREMENTS OF THE MANUFACTURER.


NOTE 'C': INSTALLATION OF ALL SIGNS SHOWN ON THIS SHEET ARE NIC.

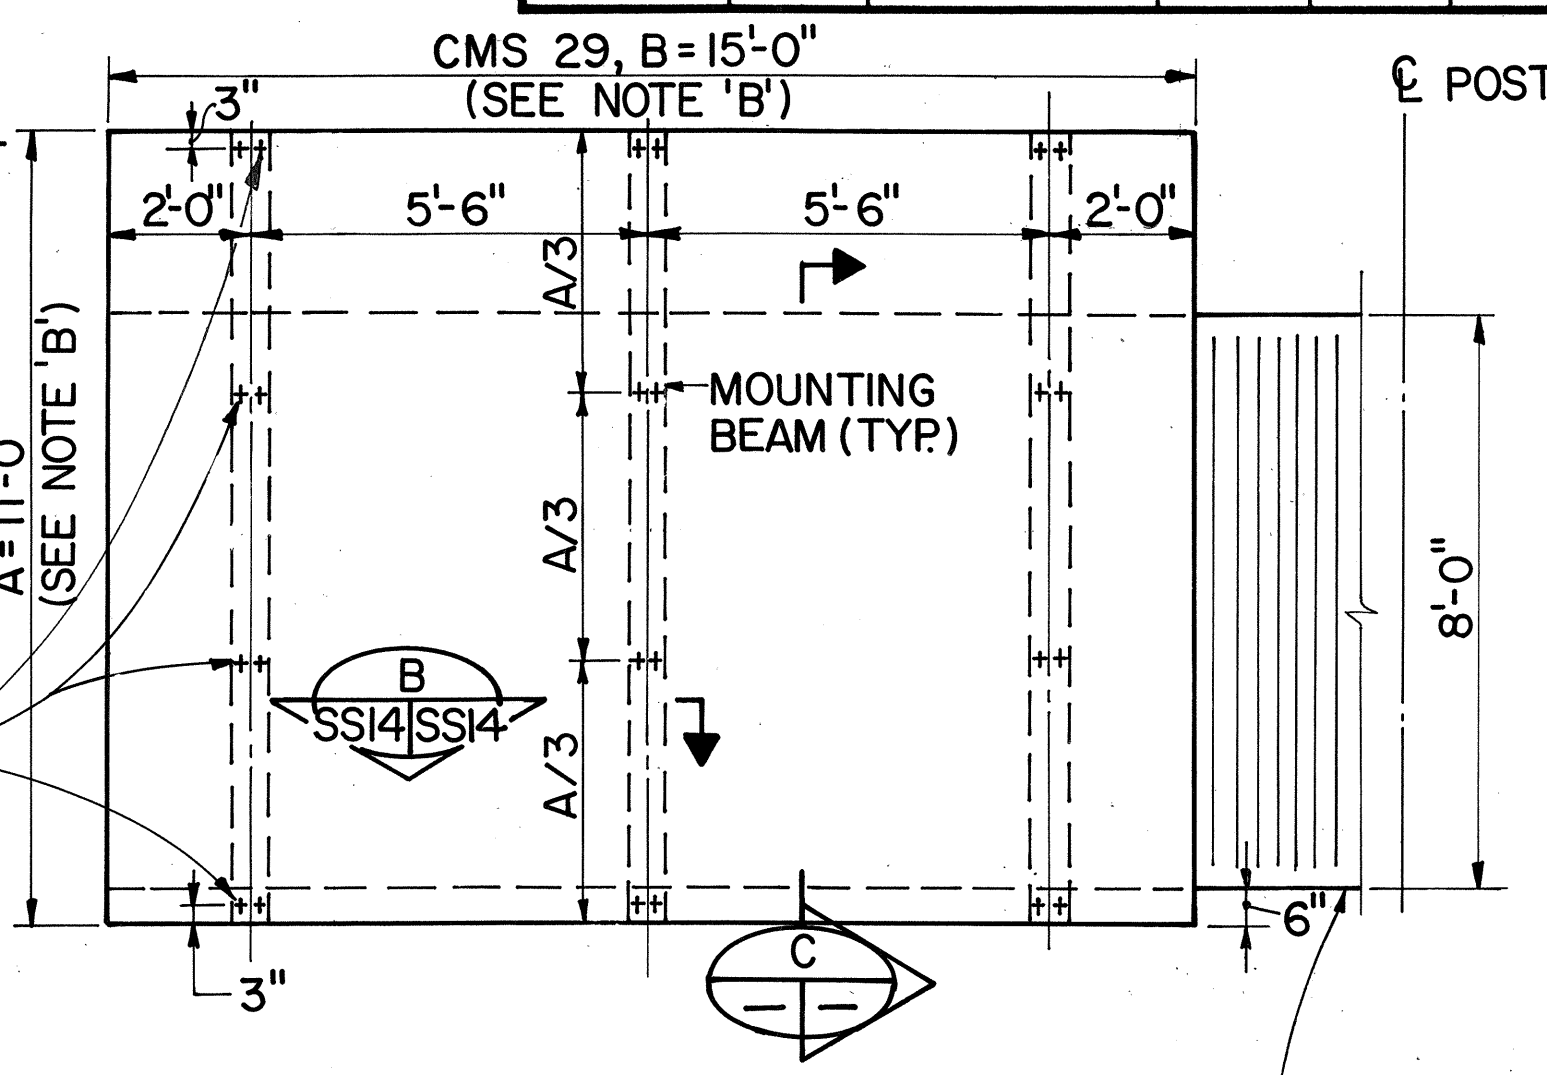

ELEVATION FOR CMS 29
 SCALE: 3/8" = 1'-0"


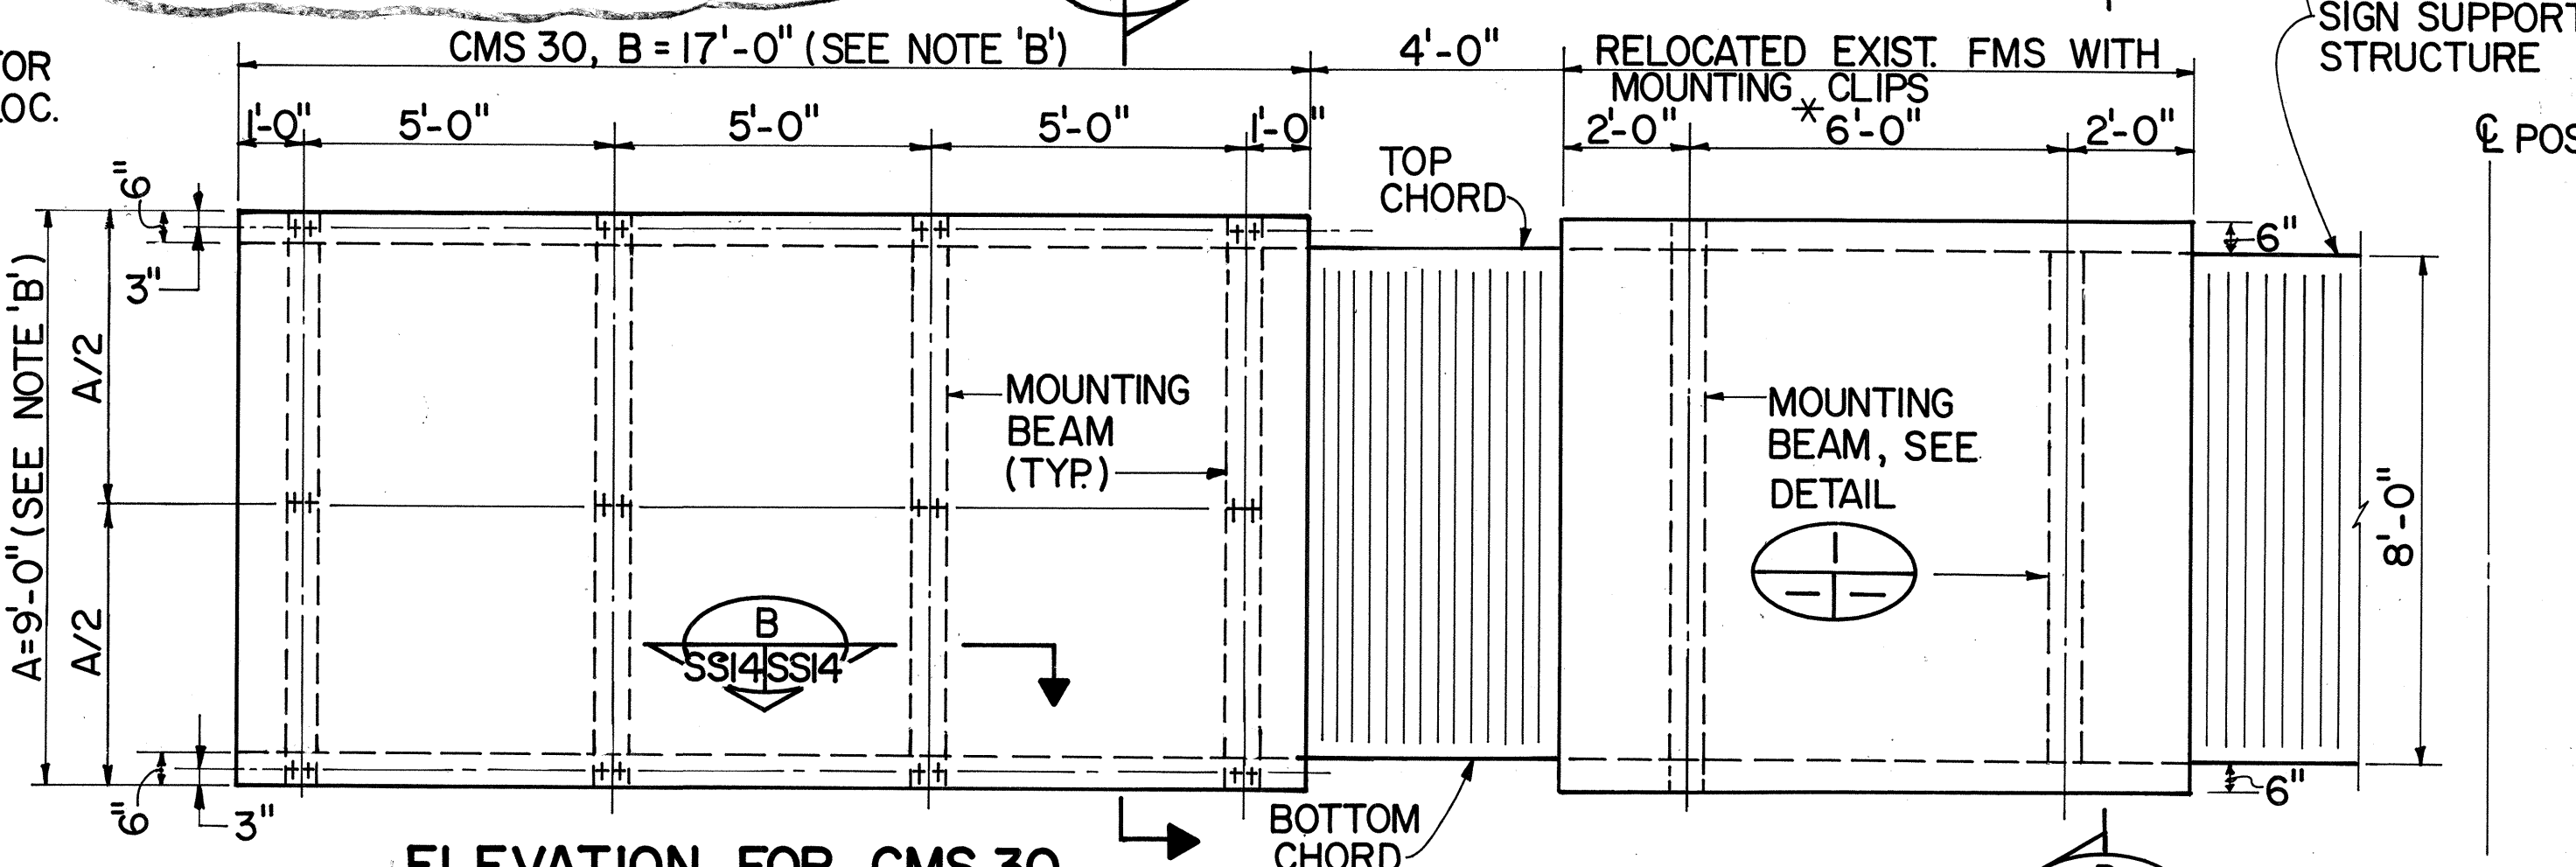


ELEVATION FOR CMS 30
 SCALE: 3/8" = 1'-0"

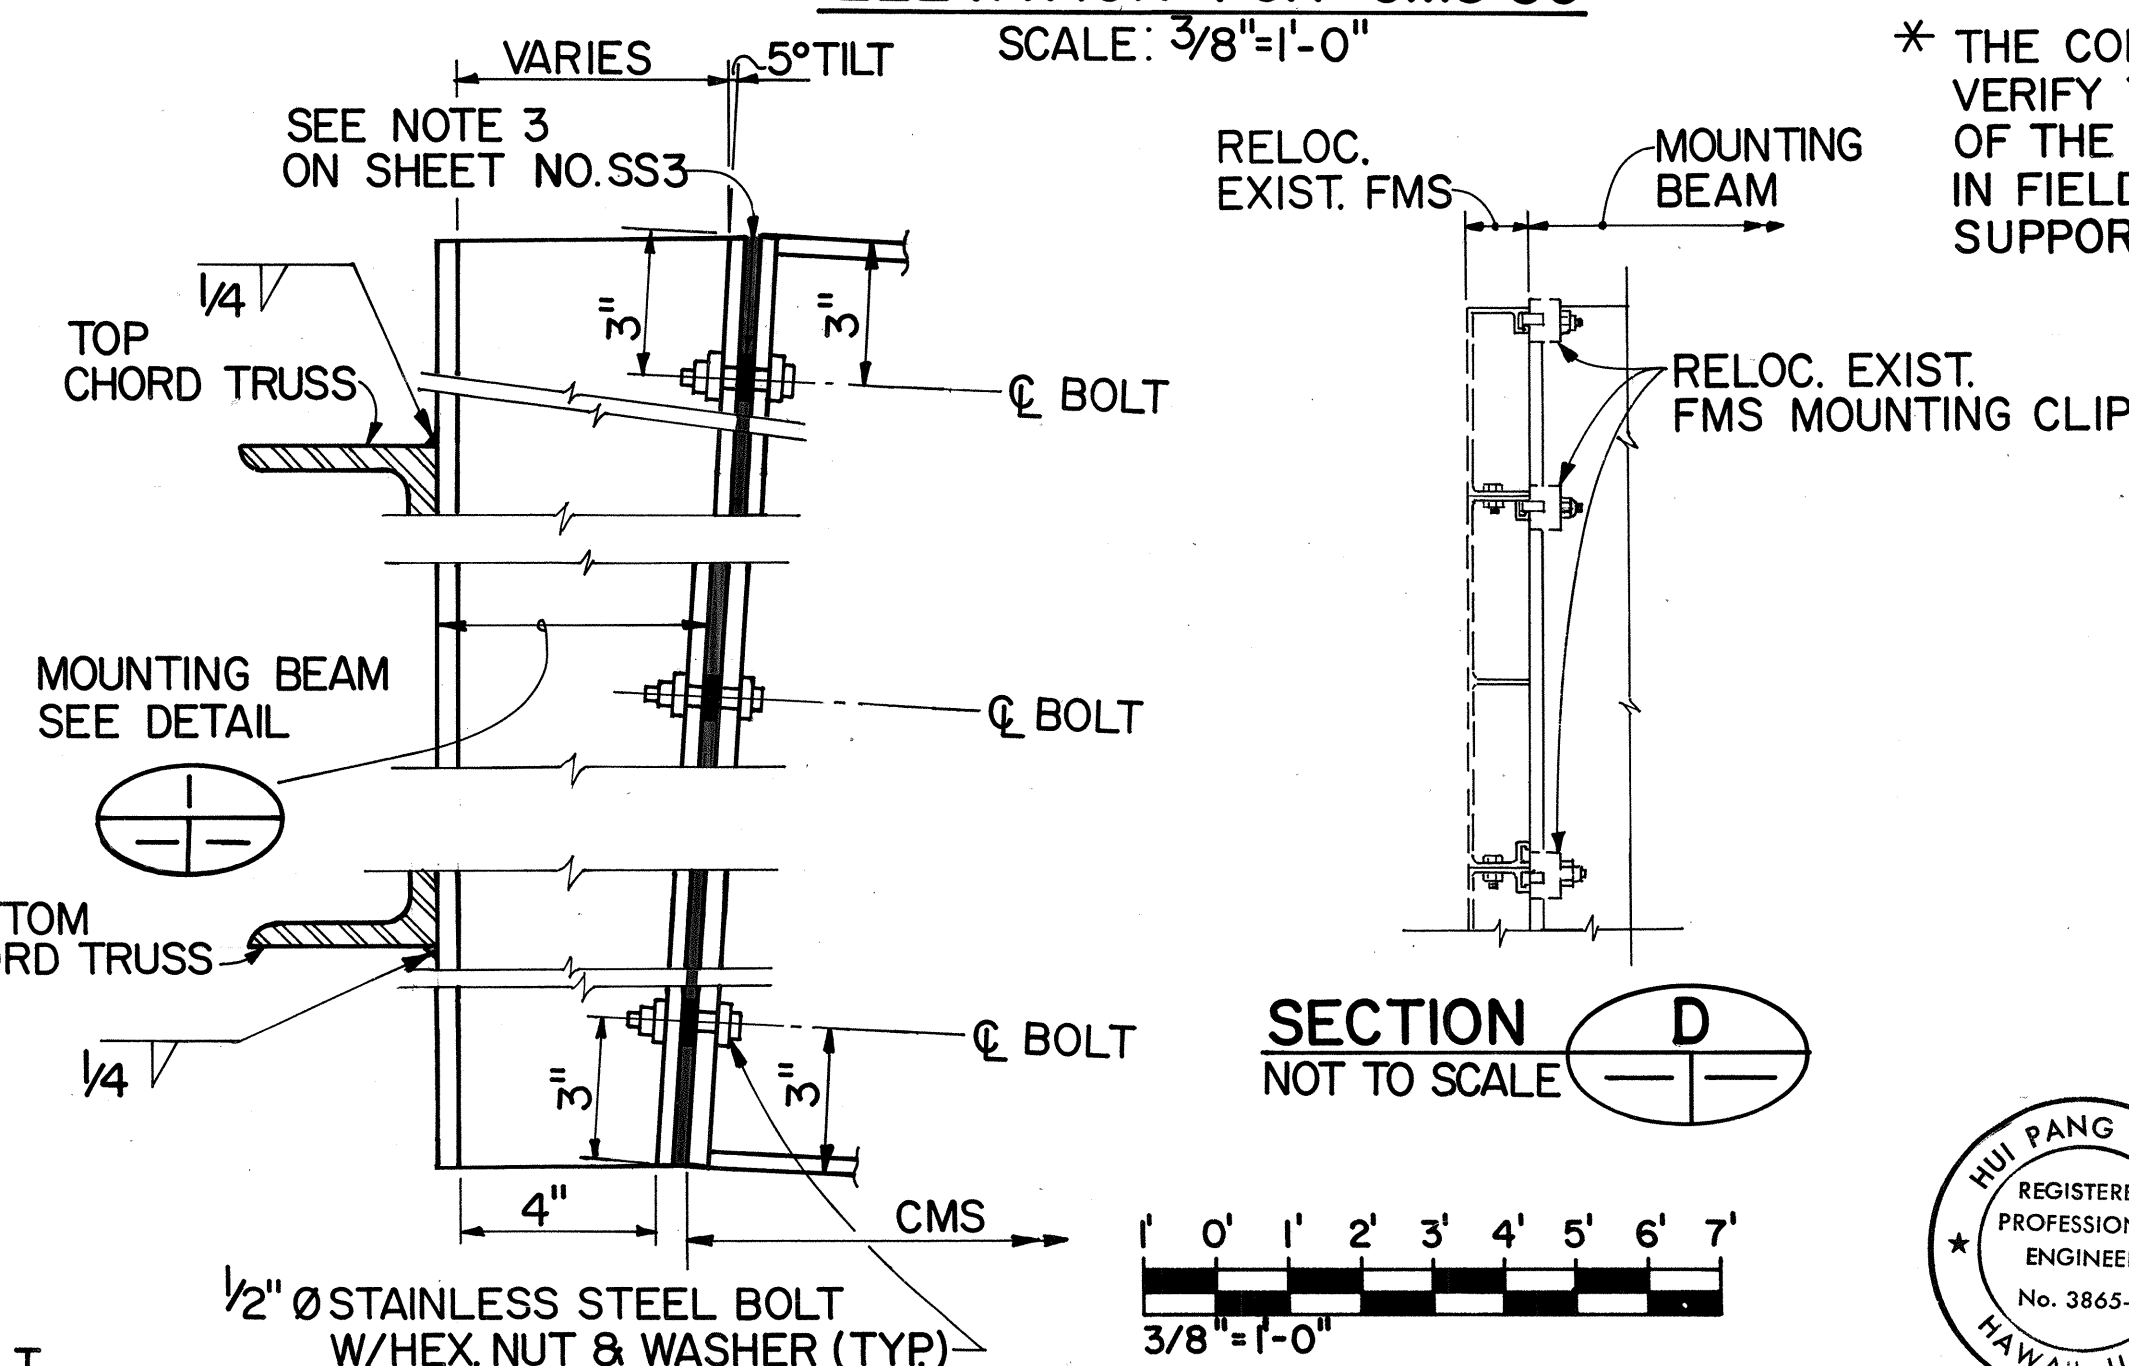

SECTION C
 SCALE: 3" = 1'-0"

SECTION D
 NOT TO SCALE

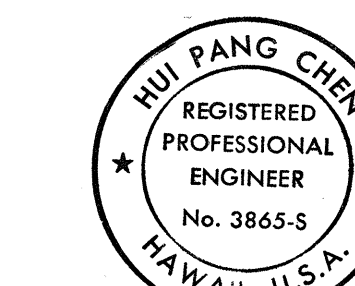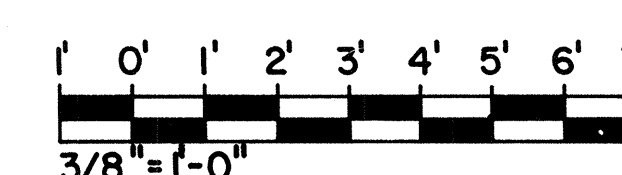


THIS WORK WAS PREPARED BY ME OR UNDER MY SUPERVISION.
 Hui Pang Chen

3/8/96	REV. PER DCN 65-044
3/31/94	DELETED REF. TO CMS 38 IN SECTIONS 'H' & 'F' PER DCN 65-027
12/8/93	REVISED NOTE 'A', ELEVATION FOR VMS 33 THRU 37, 39, 40, 43 & 44, AND DETAIL I PER DCN 65-019
DATE	REVISION

STATE OF HAWAII
 DEPARTMENT OF TRANSPORTATION
 HIGHWAYS DIVISION
MISCELLANEOUS DETAILS - 2
 SUPPORT STRUCTURES
 INTERSTATE ROUTE H-3
 F.A.I. PROJ. NO. I-H3-1 (65)
 SCALE: AS SHOWN
 DATE: DEC. 1991
 SHEET No. SS14 OF 19 SHEETS


FED. ROAD DIST. NO.	STATE	FED. AID PROJ. NO.	FISCAL YEAR	SHEET NO.	TOTAL SHEETS
HAWAII	HAW.	I - H3 - I (65)	1992	301	309

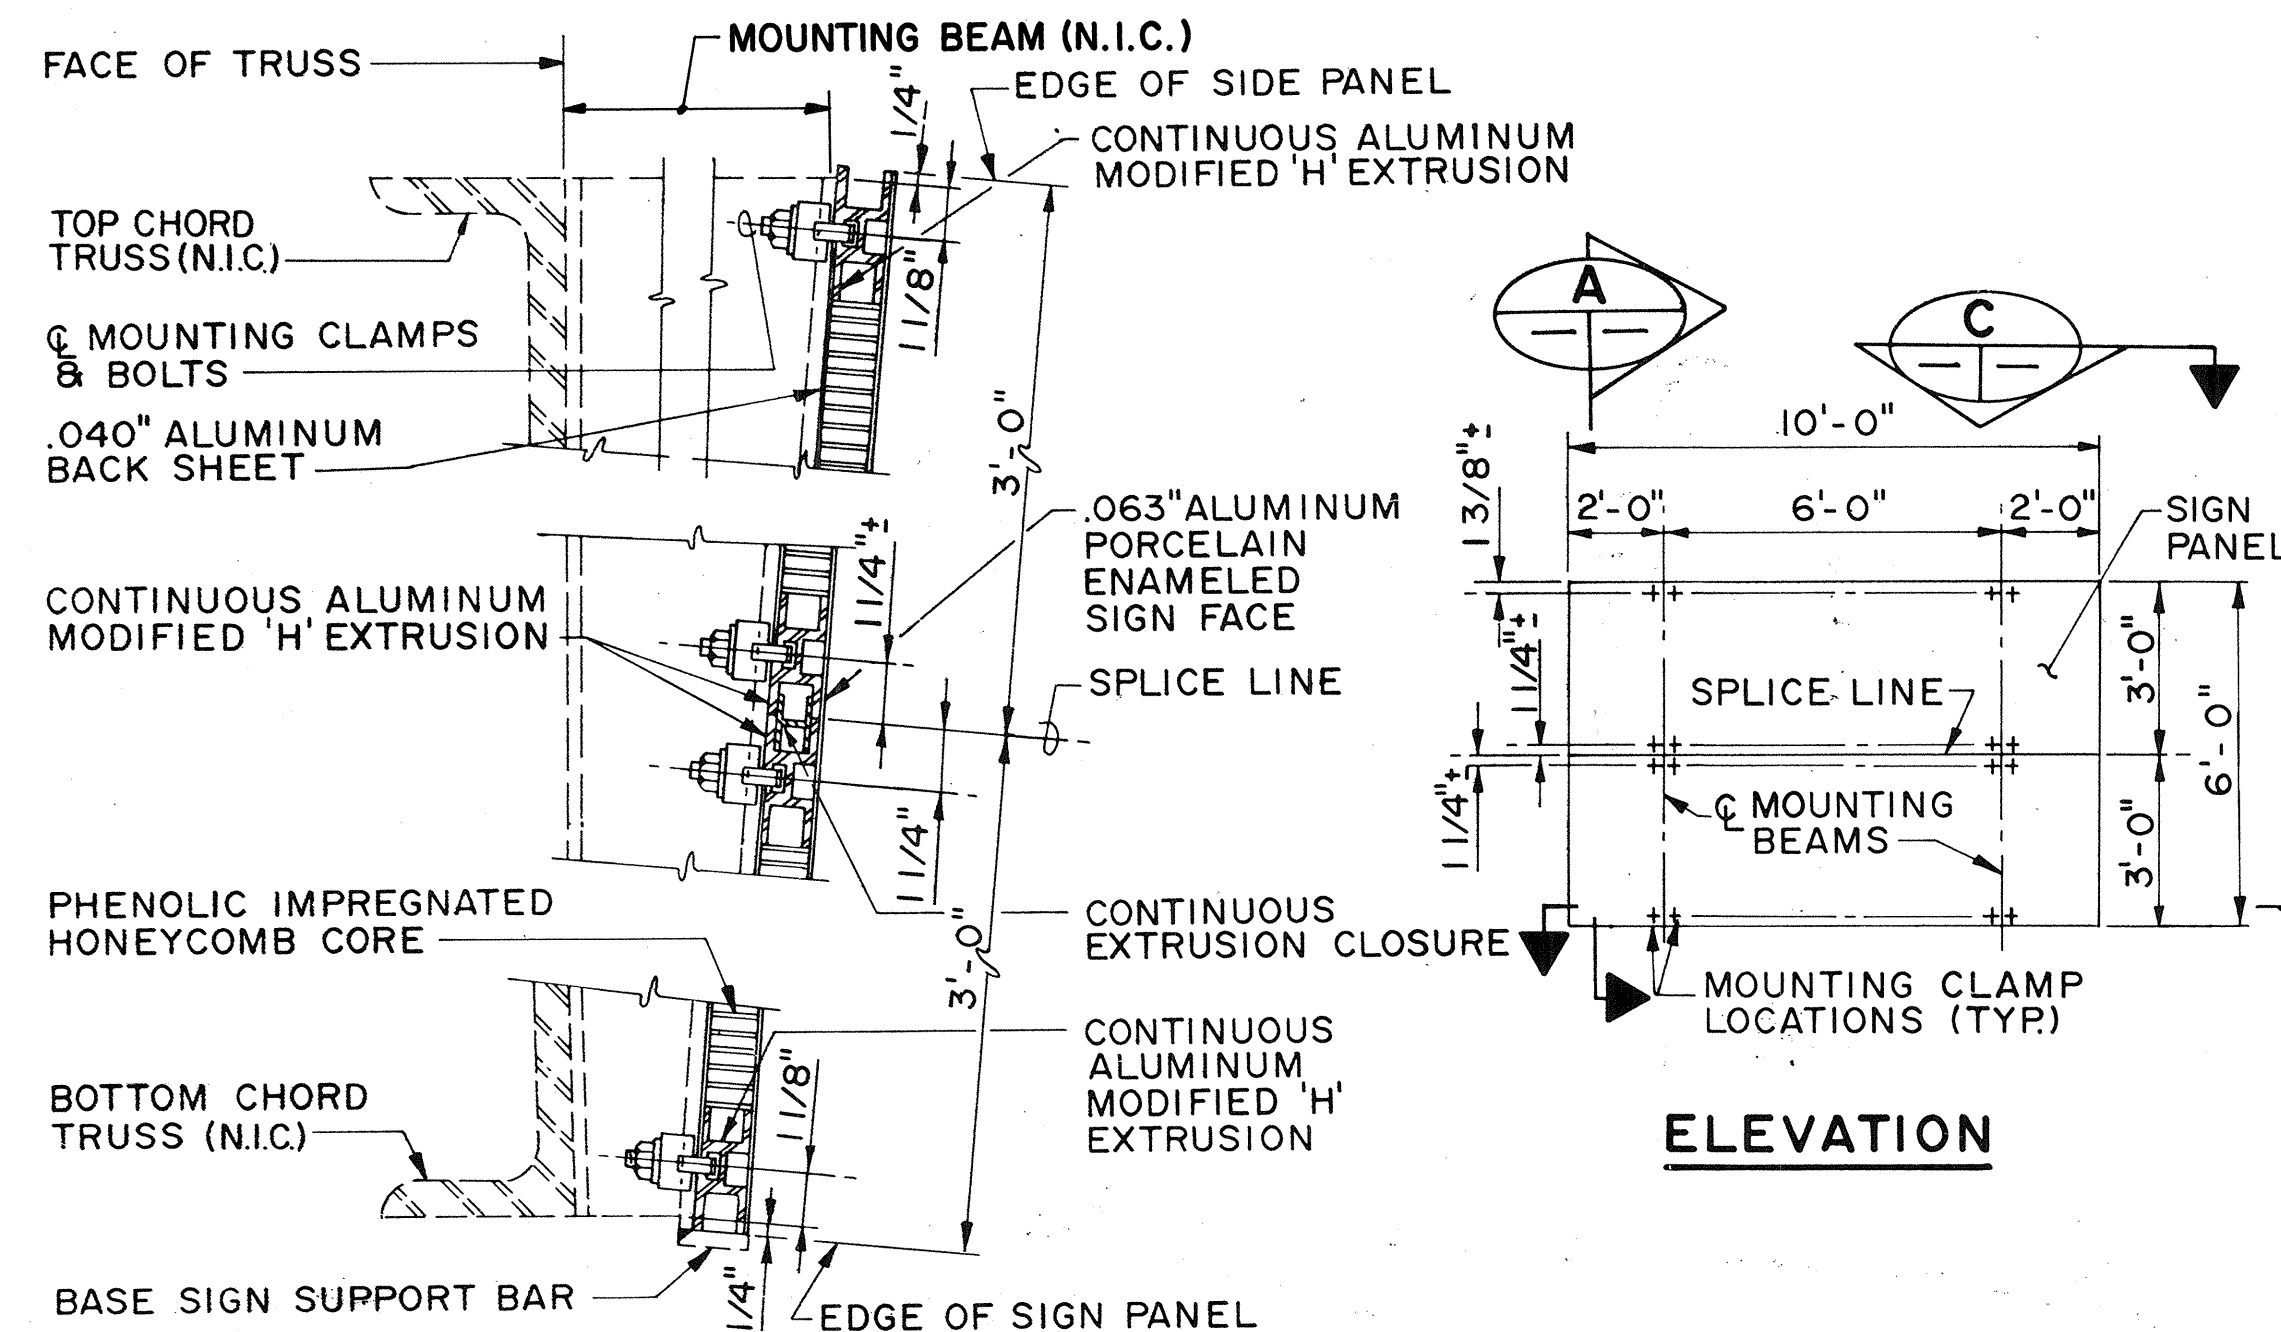

SECTION

TYPICAL CONNECTION

SECTION

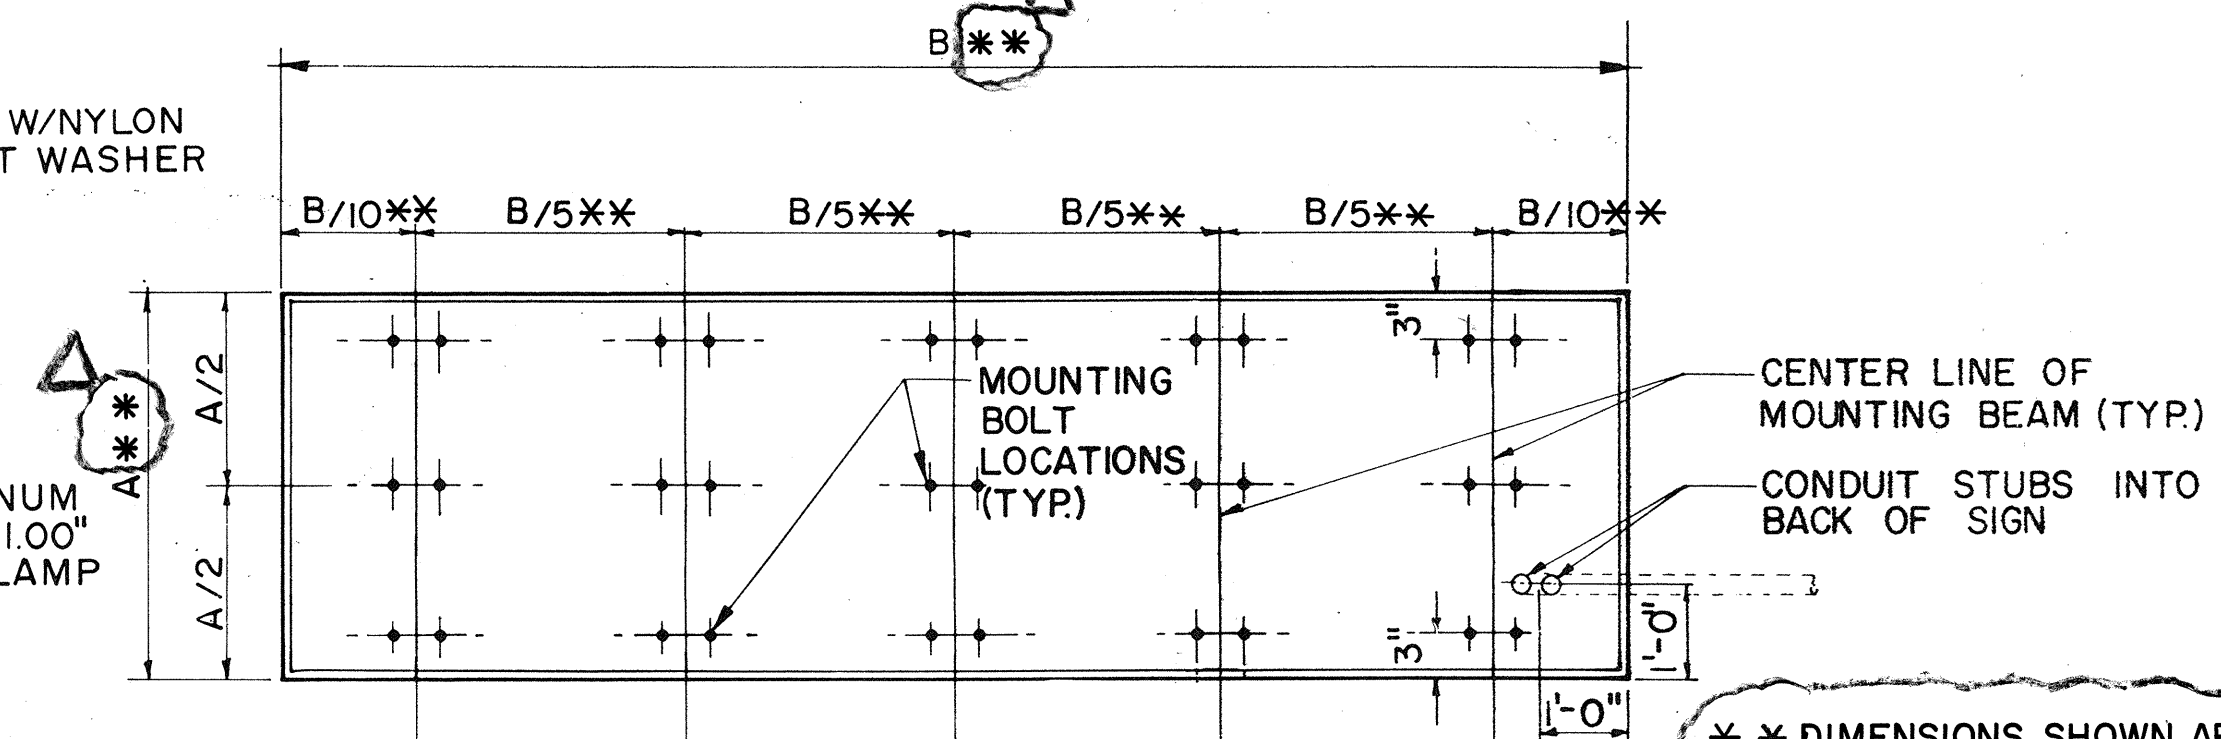

* * DIMENSIONS SHOWN ARE
NOMINAL AND SHALL BE
VERIFIED IN FIELD. SEE
NOTE 'A' ON SHT. NO. SS14


TYPICAL VMS
MOUNTING BEAM SPACING LAYOUT

SCALE: NONE


FIXED MESSAGE SIGN (FMS) PANEL DETAIL

SCALE . NONE


TF 11, TF 15	SS 16
--------------	-------

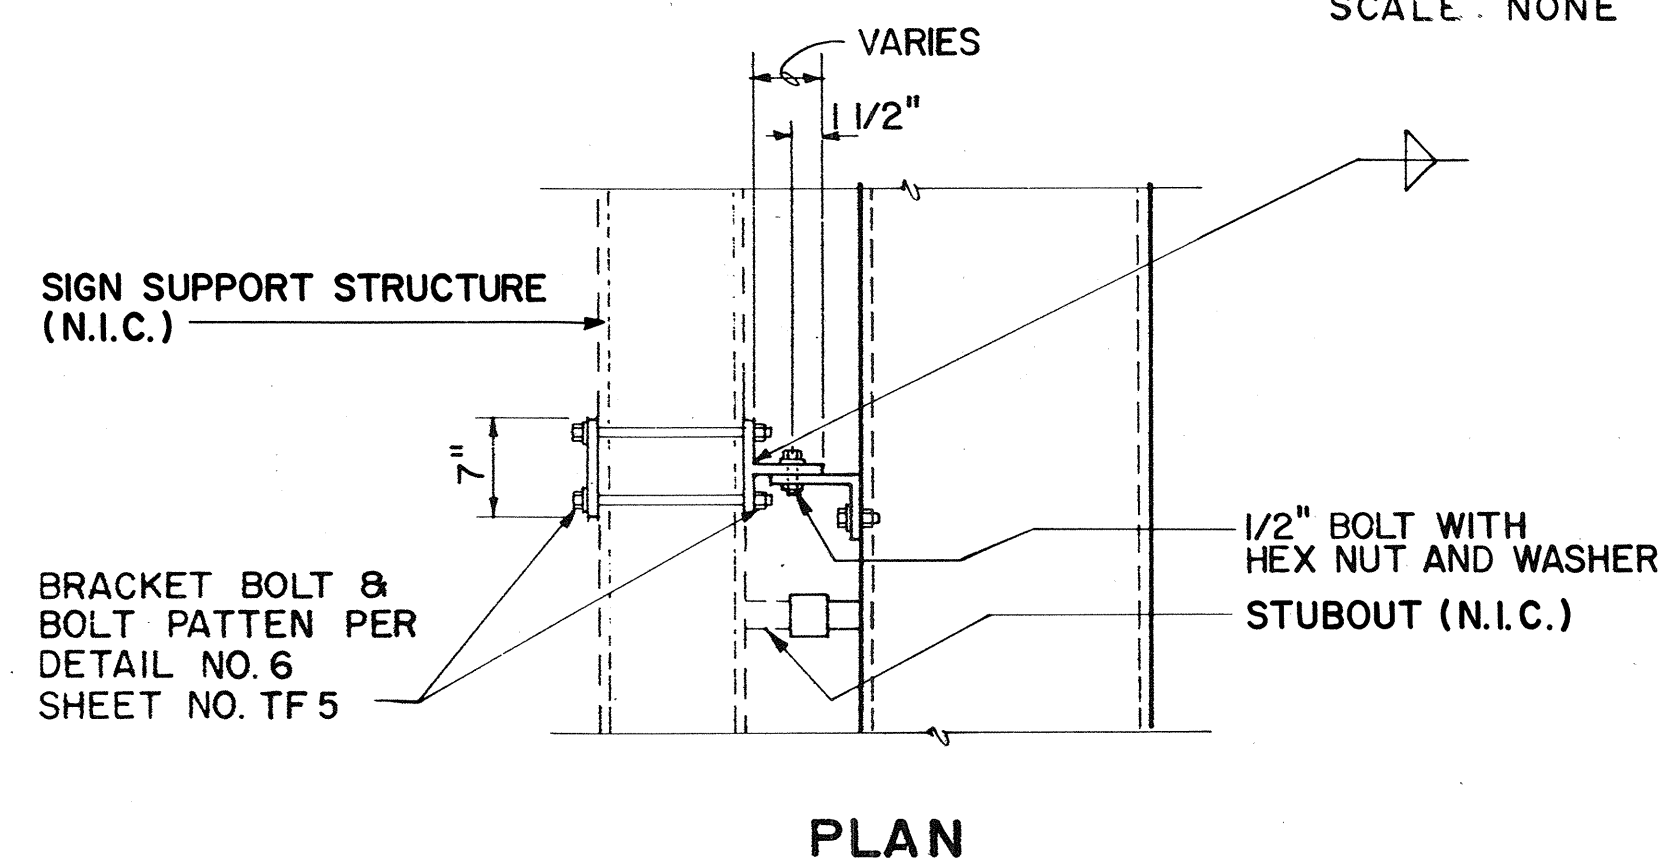

PLAN

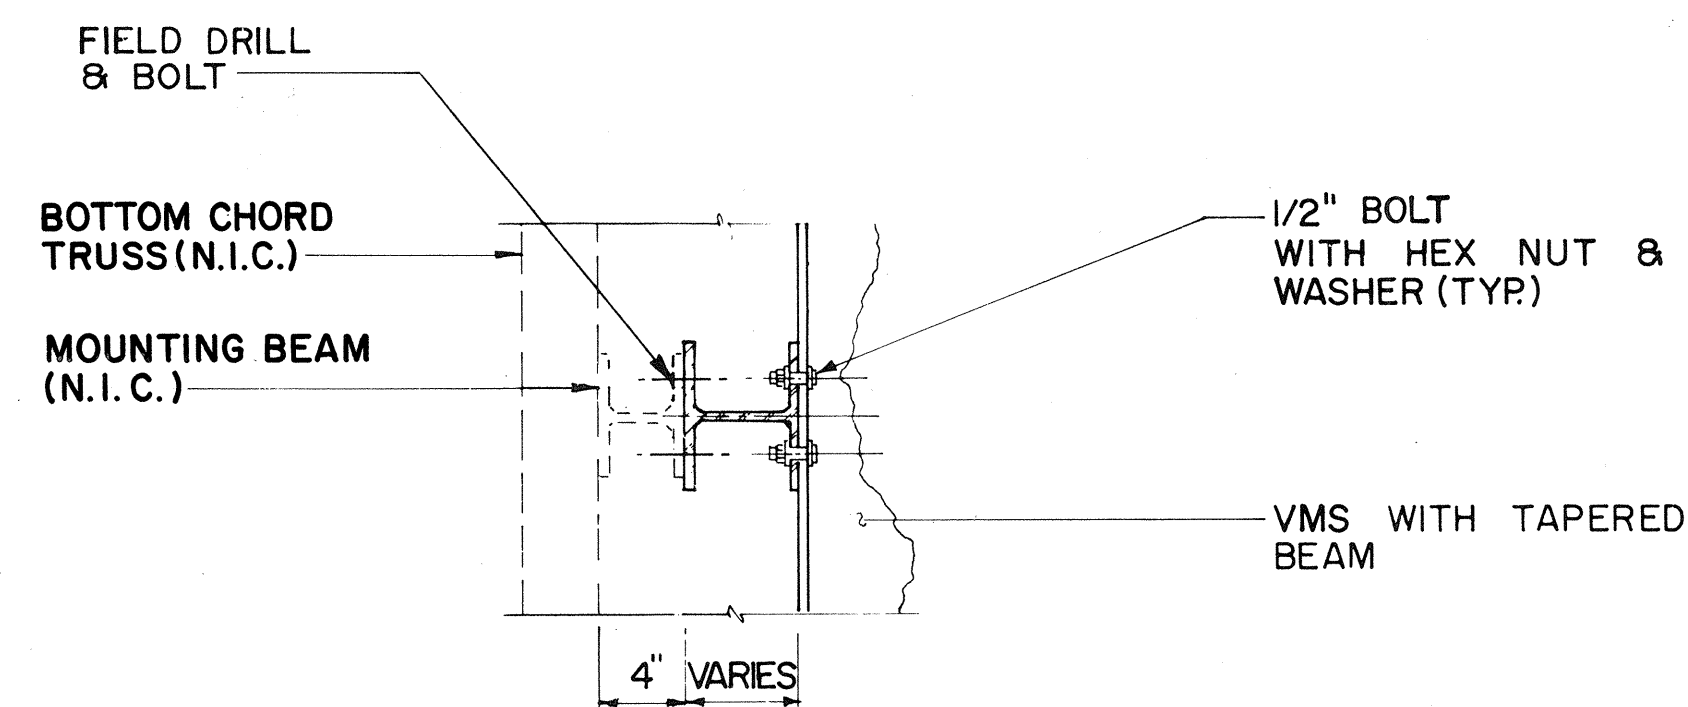

PLAN

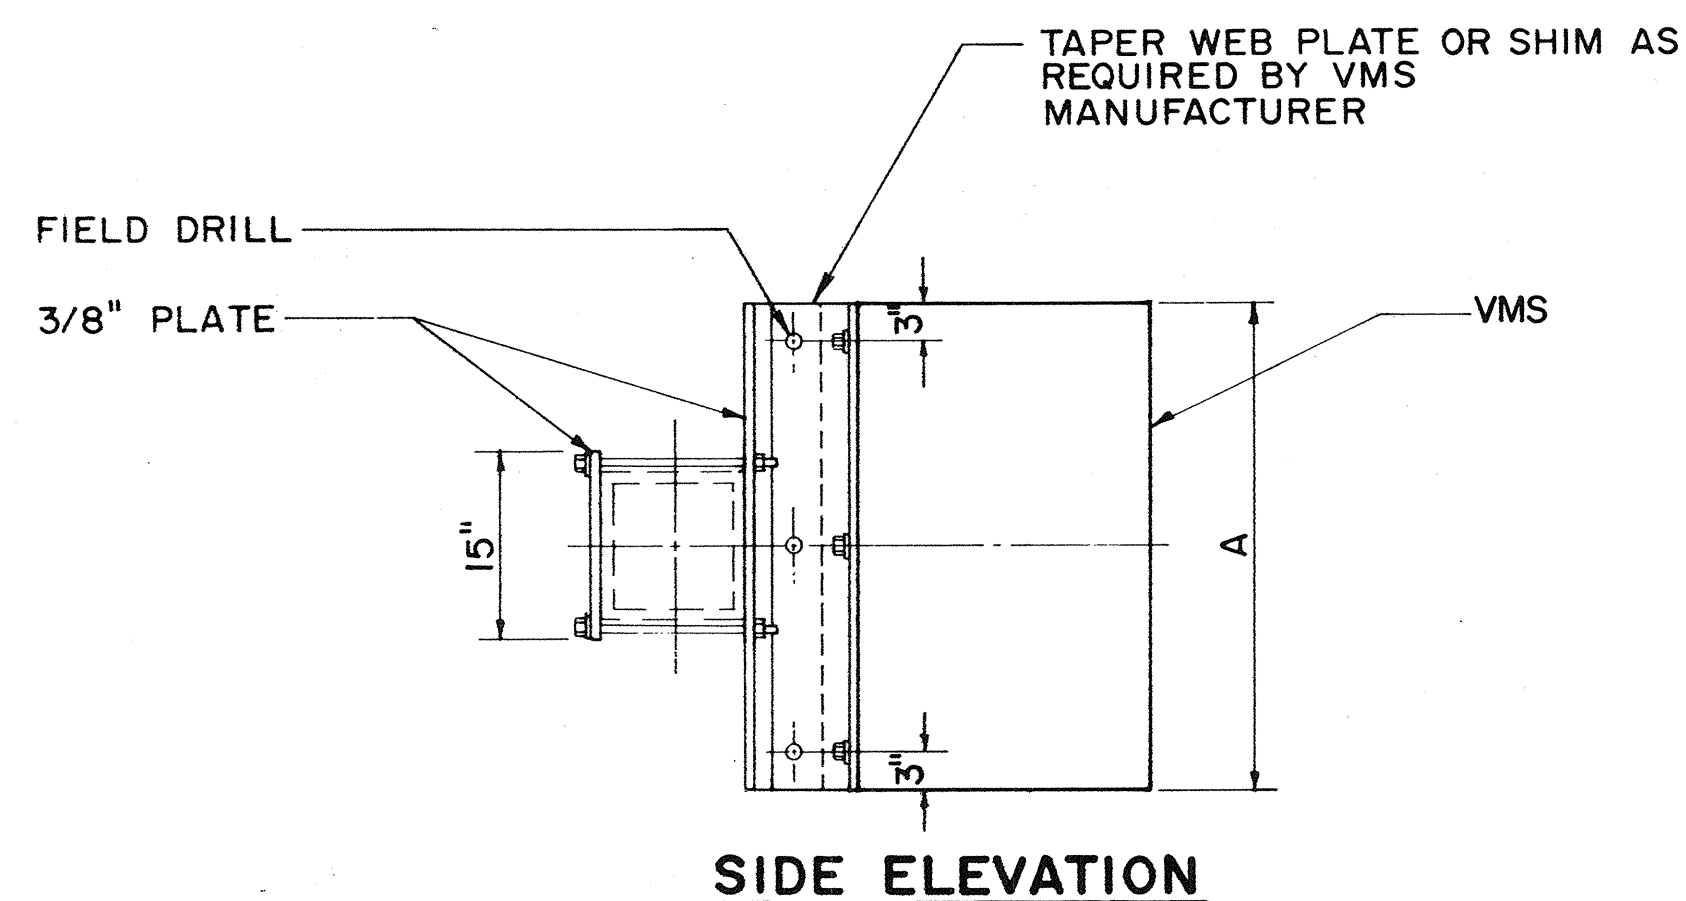


SIDE ELEVATION

TUNNEL VMS MOUNTING BRACKET ASSEMBLY DETAIL

SCALE: 3/4" = 1'-0"

TF 1, TF 13	SSI6
-------------	------

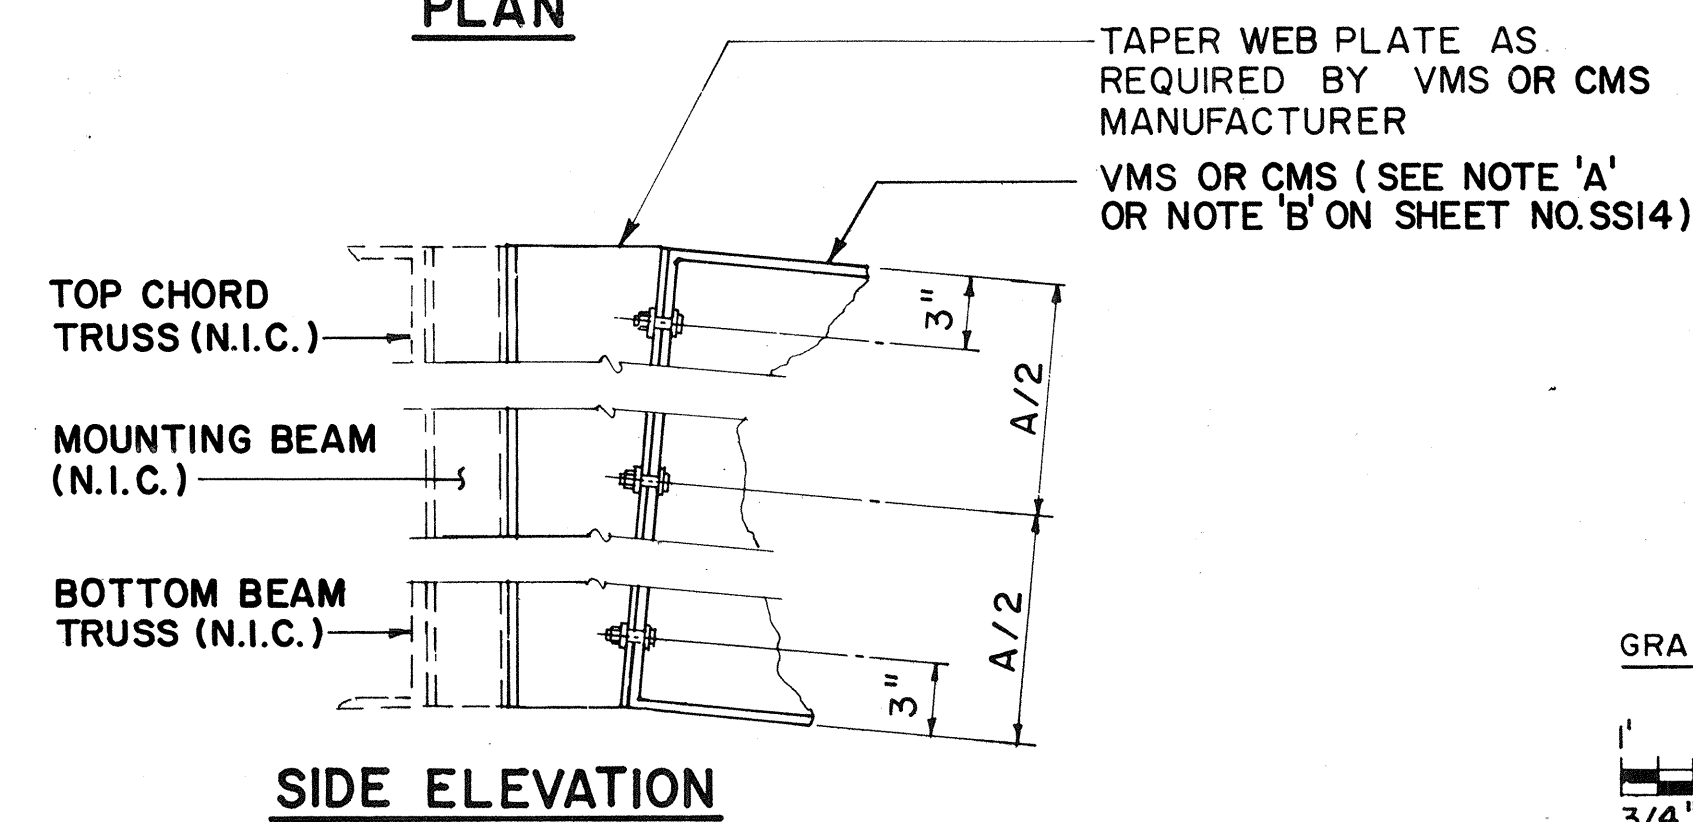

SIDE ELEVATION




TRUSS MOUNTED VMS OR CMS
MOUNTING BRACKET ASSEMBLY DETAIL

SCALE: 1 1/2" = 1' - 0"

(FOR VMS 02,03,16,17,30 & 31; CMS 32 & 33)

TR22	TF	11	12	14	15	SS16
------	----	----	----	----	----	------

GRAPHIC SCALE

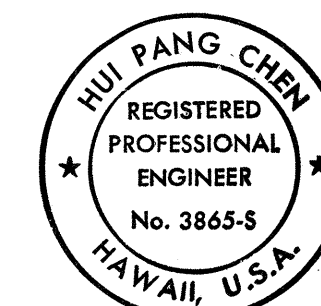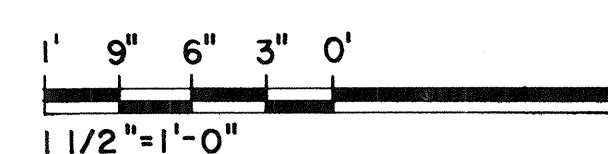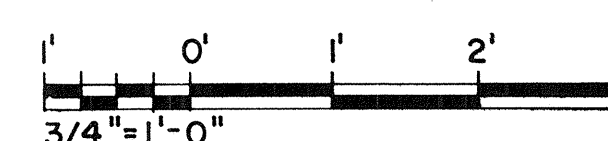

THIS WORK WAS PREPARED BY ME
OR UNDER MY SUPERVISION

Shirong Chen

12/8/93	REVISED NOTE ON TYPICAL VMS MOUNTING BEAM SPACING LAYOUT, AND REVISED VMS DETAILS PER DCN 65-019
DATE	REVISION

MISCELLANEOUS DETAILS -3

SECTIONS AND DETAILS

INTERSTATE ROUTE H-3
F.A.I. PROJ. NO. I-H3-1 (65)

SCALE : AS NOTED

DATE : DEC. 1991

SHEET NO. SS15 OF 19 SHEETS

FED. ROAD DIST. NO.	STATE	FED. AID PROJ. NO.	FISCAL YEAR	SHEET NO.	TOTAL SHEETS
HAWAII	HAW.	I-H3-1(65)	1992	302	309

DRILLED SHAFT NOTES:

1. PROVIDE SIZING HOOPS AS A GUIDE FOR THE FABRICATION OF THE REBAR CAGE.
2. PROVIDE CENTERING DEVICES AS A GUIDE FOR THE PLACEMENT OF THE REBAR CAGE IN THE DRILLED HOLE.
3. PROVIDE TEMPORARY STIFFENERS TO STRENGTHEN THE REBAR CAGE DURING LIFTING. STIFFENERS ARE TO BE REMOVED PRIOR TO POURING OF CONCRETE.
4. SPLICES IN THE LONGITUDINAL STEEL, IF REQUIRED, SHOULD BE STAGGERED SO AS NOT TO OCCUR AT THE SAME HORIZONTAL PLANE ALONG THE REBAR CAGE. THE STAGGER SHALL BE 1'-0" MIN.
5. USE #4 CIRCULAR SPIRAL FOR REBAR CAGE. CIRCULAR TIES SHALL NOT BE USED IN DRILLED SHAFTS EXCEPT OTHERWISE AS NOTED.
6. THE REBAR CAGE SHALL BE FABRICATED AND STORED SO AS TO AVOID DISTORTION DURING TRANSPORTATION TO THE JOB SITE AND TO AVOID CONTAMINATION WITH MUD OR OTHER DELETERIOUS MATERIAL.
7. FOR SLUMP OF CONCRETE SEE SPECIAL PROVISIONS.
8. PLACEMENT OF THE CONCRETE SHALL BE MADE BY USE OF A TREMIE OR PUMP LINE.
9. THE SPIRAL PITCH MAY BE OPENED WIDER AT THE LOCATION WHERE THE CONDUIT STUB-OUT IS REQUIRED IN THE SHAFT. DURING THE CONSTRUCTION OF THE SHAFT, THE CONTRACTOR SHALL SEAL THE END OF THE CONDUIT STUB-OUT AND PROVIDE A DEVICE TO IDENTIFY ITS LOCATION IN THE SHAFT FOR LATER CONDUIT CONNECTION.
10. FOR INSTALLATION OF ANCHOR BOLTS, THE CONTRACTOR SHALL PROVIDE RIGID TEMPLATES TO MAINTAIN THE ANCHOR BOLTS IN PROPER LOCATIONS.
11. THE ANCHOR BOLTS AND CONDUIT SHALL BE INSTALLED PRIOR TO POURING SHAFT CONCRETE AND SHALL BE PROTECTED AT ALL TIMES DURING CONSTRUCTION.
12. CONCRETE FOR DRILLED SHAFTS AND PEDESTALS SHALL HAVE A MINIMUM 28 DAYS COMPRESSIVE STRENGTH OF 4000 PSI.
13. ALL REINFORCING STEEL SHALL BE ASTM A615 GRADE 60.
14. FOR TOP OF PEDESTAL ELEVATION SEE SHEET NO. SS7.
15. FOR ALL DRILLED SHAFTS, THE CONTRACTOR SHALL PROVIDE A MINIMUM 5'-0" LONG TEMPORARY CASING TO CONTROL THE UPPER DRILLED HOLE SIZE.
16. FOR LOCATIONS OF CONDUIT STUB-OUTS, SEE SHEET NOS. TAI TO TAI3, TAI7, TAI8, TAI21, TBI9, TB20, TB22 & TB24 TO TB29.
17. FOR VMS 33 AND CMS 29, THE SQUARE PEDESTALS ARE NOT REQUIRED & THE DRILLED SHAFTS SHALL BE CONSTRUCTED TO THE ELEVATIONS AS SHOWN. THE SHAFT ABOVE GROUND SHALL BE FORMED & TOP OF DRILLED SHAFT SHALL BE FINISHED AS REQUIRED FOR PEDESTAL.

FOR CMS 29, VMS 33
VMS 35/8 VMS 36

FOR CMS 30

SECTION D
SCALE: 3/8"=1'-0"


SECTION E
SCALE: 3/8"=1'-0"

SECTION F
SCALE: 3/8"=1'-0"

ANCHOR BOLT DETAIL
NOT TO SCALE

TABLE C					
SIGN NUMBER	SHAFT TYPE	BASE TYPE	SHAFT LENGTH	TOP OF SHAFT ELEV.	HT. OF PEDESTAL "H"
MTS	Z	—	30'-0"	18.80	SEE NOTE 18
VMS 33	Z	TYPE I	15'-0"	91.23	SEE NOTE 17
VMS 35	Z	TYPE II	20'-0"	53.90	2'-6"
VMS 36	Z	TYPE II	20'-0"	305.95	3'-0"
VMS 40	Y	TYPE II	18'-0"	18.80	4'-2"
VMS 43	Y	TYPE II	15'-0"	39.70	4'-2"
CMS 29	Z	TYPE I	20'-0"	231.20	SEE NOTE 17
CMS 30	Z	TYPE III	20'-0"	318.00	5'-9"

NOTE 18:
MTS (METHOD TEST SHAFT) SHALL BE CONSTRUCTED AND ACCEPTED AT THE LOCATION SHOWN ON SHEET NO. CA4 OR AS DIRECTED BY THE ENGINEER PRIOR TO ANY DRILLED SHAFT INSTALLATION. NO SQUARE PEDESTAL, ANCHOR BOLTS & CONDUITS ARE REQUIRED FOR MTS.

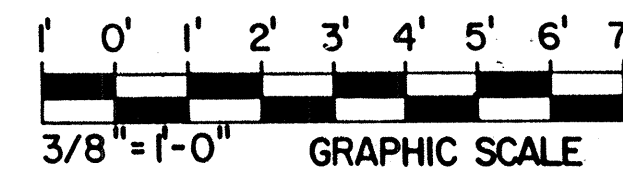

THIS WORK WAS PREPARED BY ME OR UNDER MY SUPERVISION.
Hui Pang Chen

10/31/94
DATE

DELETED VMS 37 PER DCN 65-037
REVISION


STATE OF HAWAII
DEPARTMENT OF TRANSPORTATION
HIGHWAYS DIVISION

BOX TRUSS FOUNDATION
DETAILS-1

SUPPORT STRUCTURES
INTERSTATE ROUTE H-3
F.A.I. PROJ. NO. I-H3-1(65)

SCALE: AS SHOWN
DATE: DEC. 1991

SHEET NO. SS16 OF 19 SHEETS

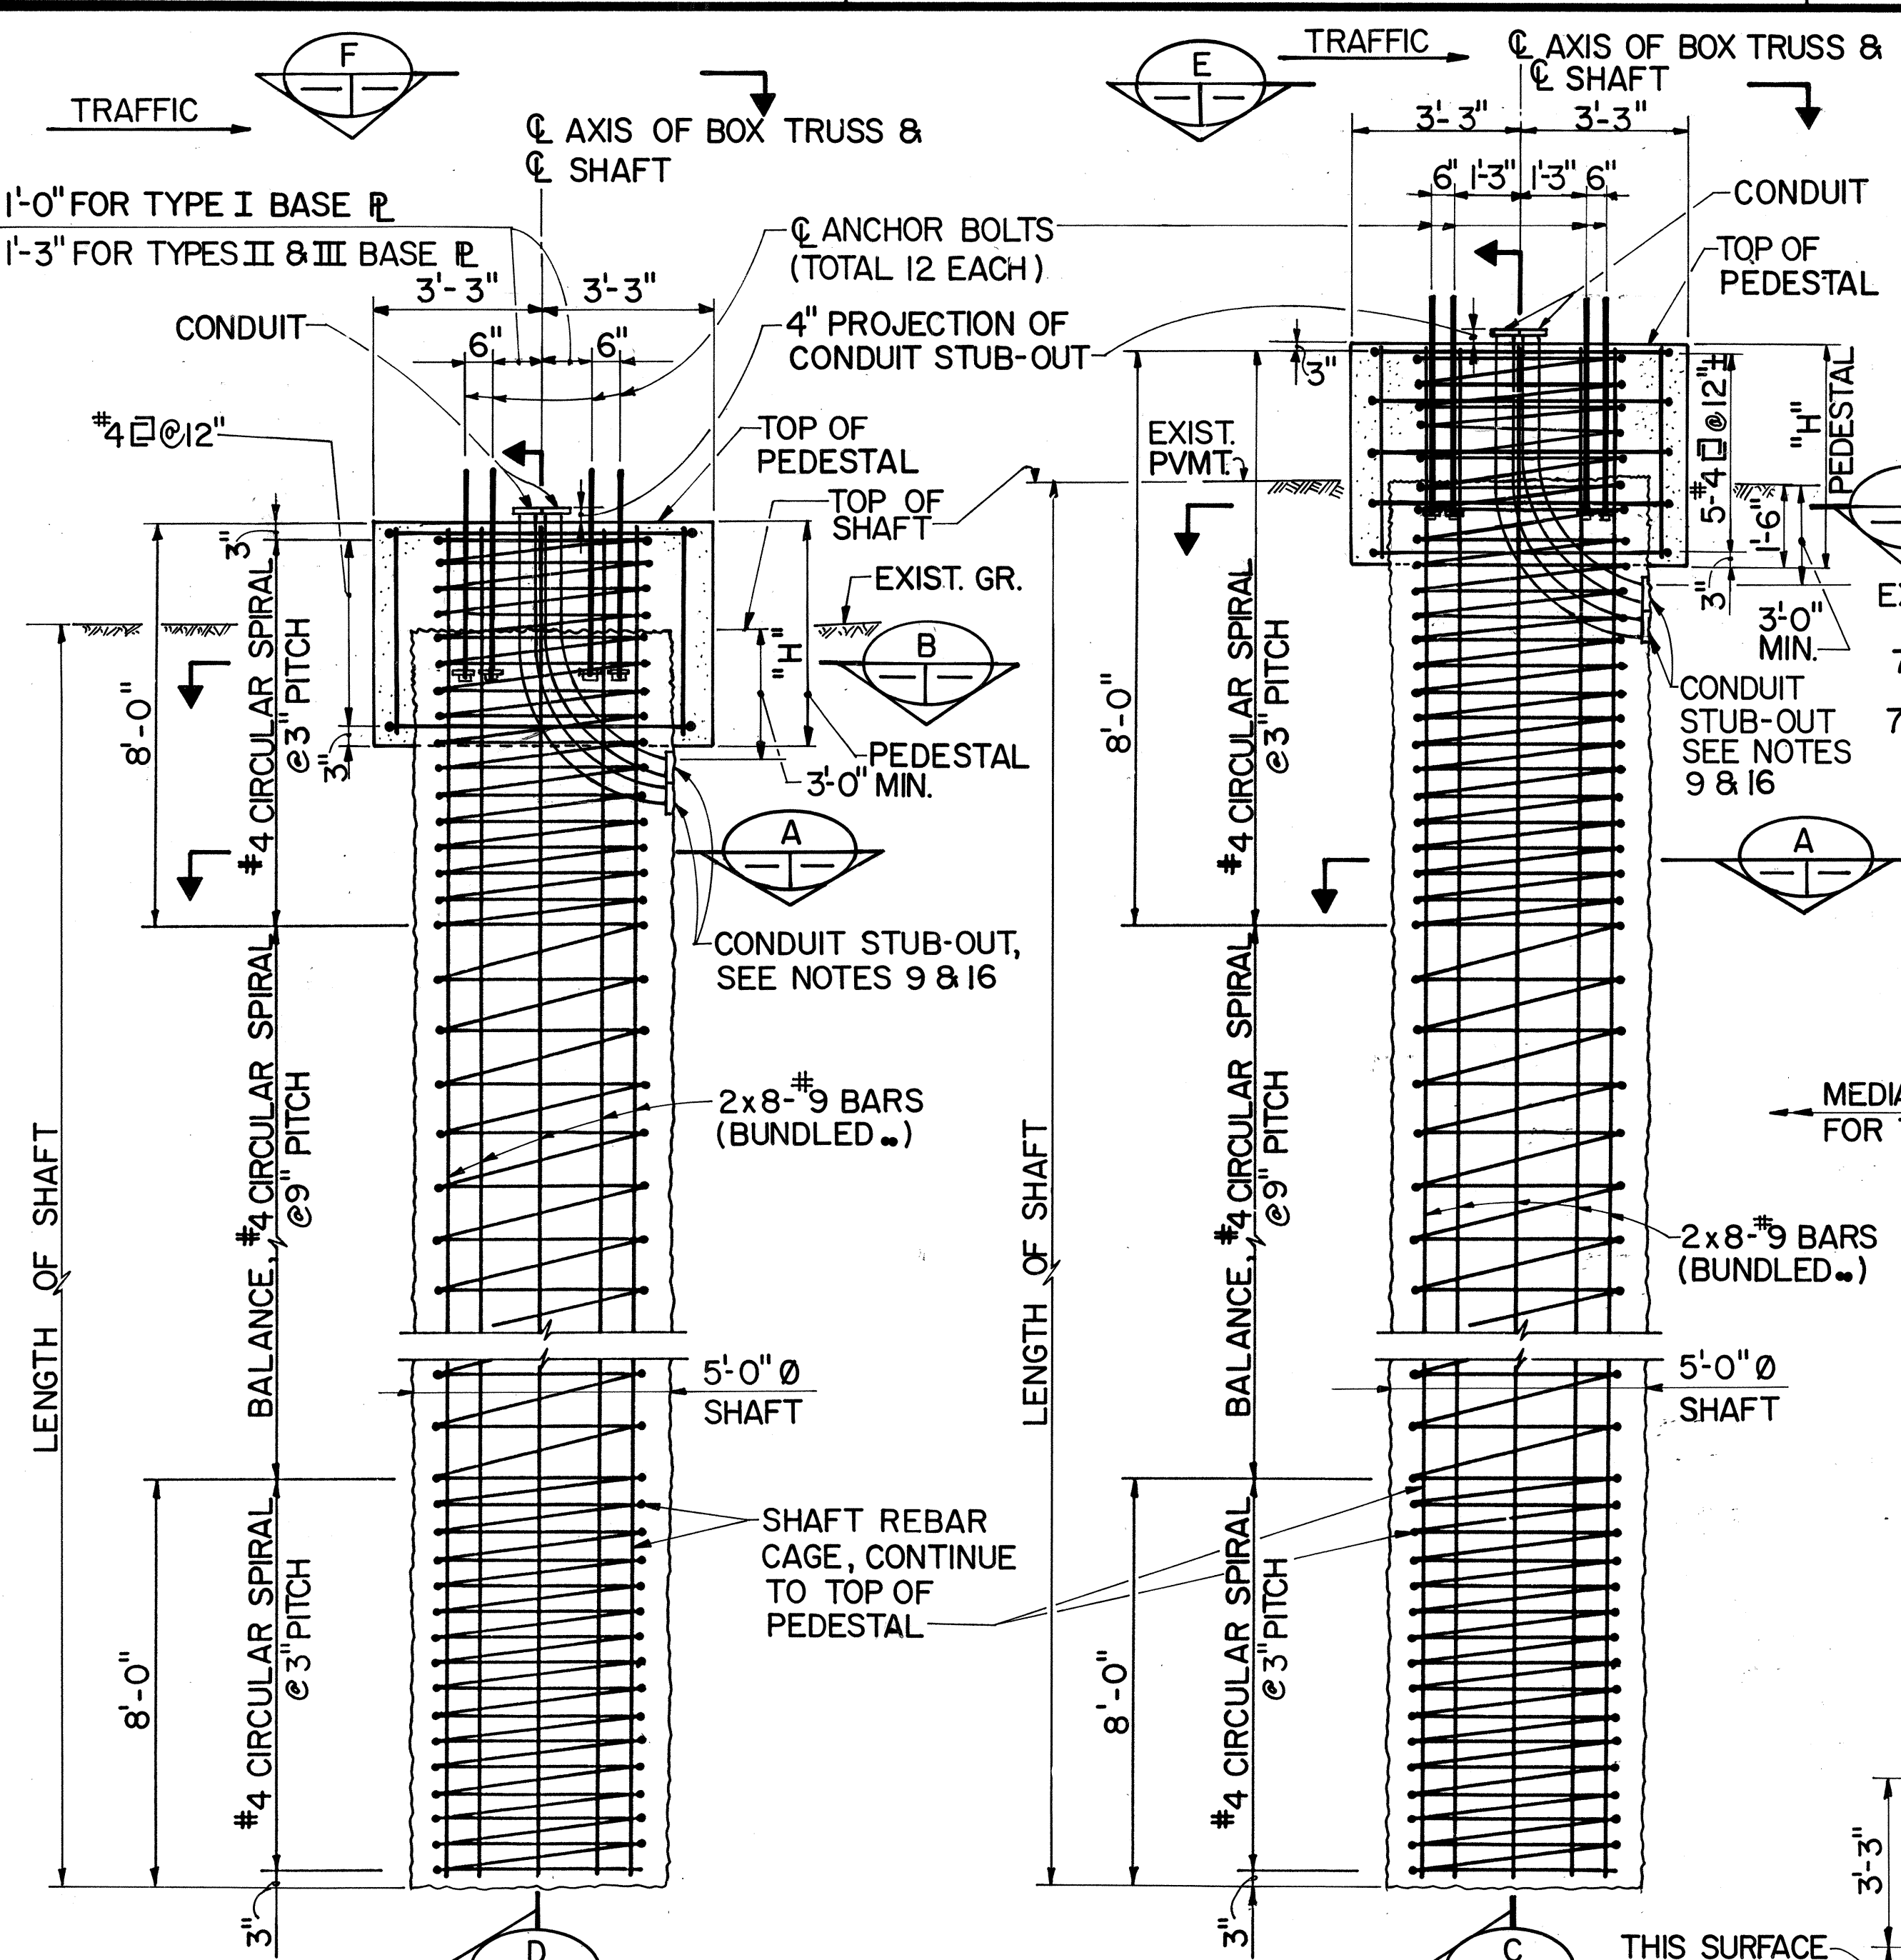

TYPE 'Z' SHAFT ELEVATION
NOT TO SCALE

TYPE 'Y' SHAFT ELEVATION
NOT TO SCALE

SECTION A
SCALE: 3/8"=1'-0"

SECTION B
SCALE: 3/8"=1'-0"

DATE: 10/31/94
DESIGNED BY: S. KIMURA
CHECKED BY: H.P. CHEN
ORIGINAL PLAN: 10/31/94
NOTE BOOK: 10/31/94

ANCHOR BOLTS FOR METAL GUARD RAIL. SEE DETAILS ON SHT. NO. CD.3.

TRUE NORTH

PEDESTAL/FOOTING & AXIS OF BOX TRUSS

2" Ø HOLE FOR IMPACT ATTENUATOR CABLE

IMPACT ATTENUATOR & LEVELING PAD. SEE DETAILS ON SHEET NO. CD.3.

3" CONDUIT

METAL GUARD RAIL. SEE SHEET NO. CD.3.

TEST PILE

3" CONDUIT. SEE NOTE 1.

ANCHOR P 1/2" x 5" x 2'-5"




ANCHOR P 1/2" x 5" x 0'-5"

ANCHOR BOLTS FOR METAL GUARD RAIL. SEE DETAILS ON SHEET NO. CD.3.

SECTION G

VARY FROM 2'-7" TO 3'-0"

FED. ROAD DIST. NO.	STATE	FED. AID PROJ. NO.	FISCAL YEAR	SHEET NO.	TOTAL SHEETS
HAWAII	HAW.	1-H3-1(65)	1992	303	309

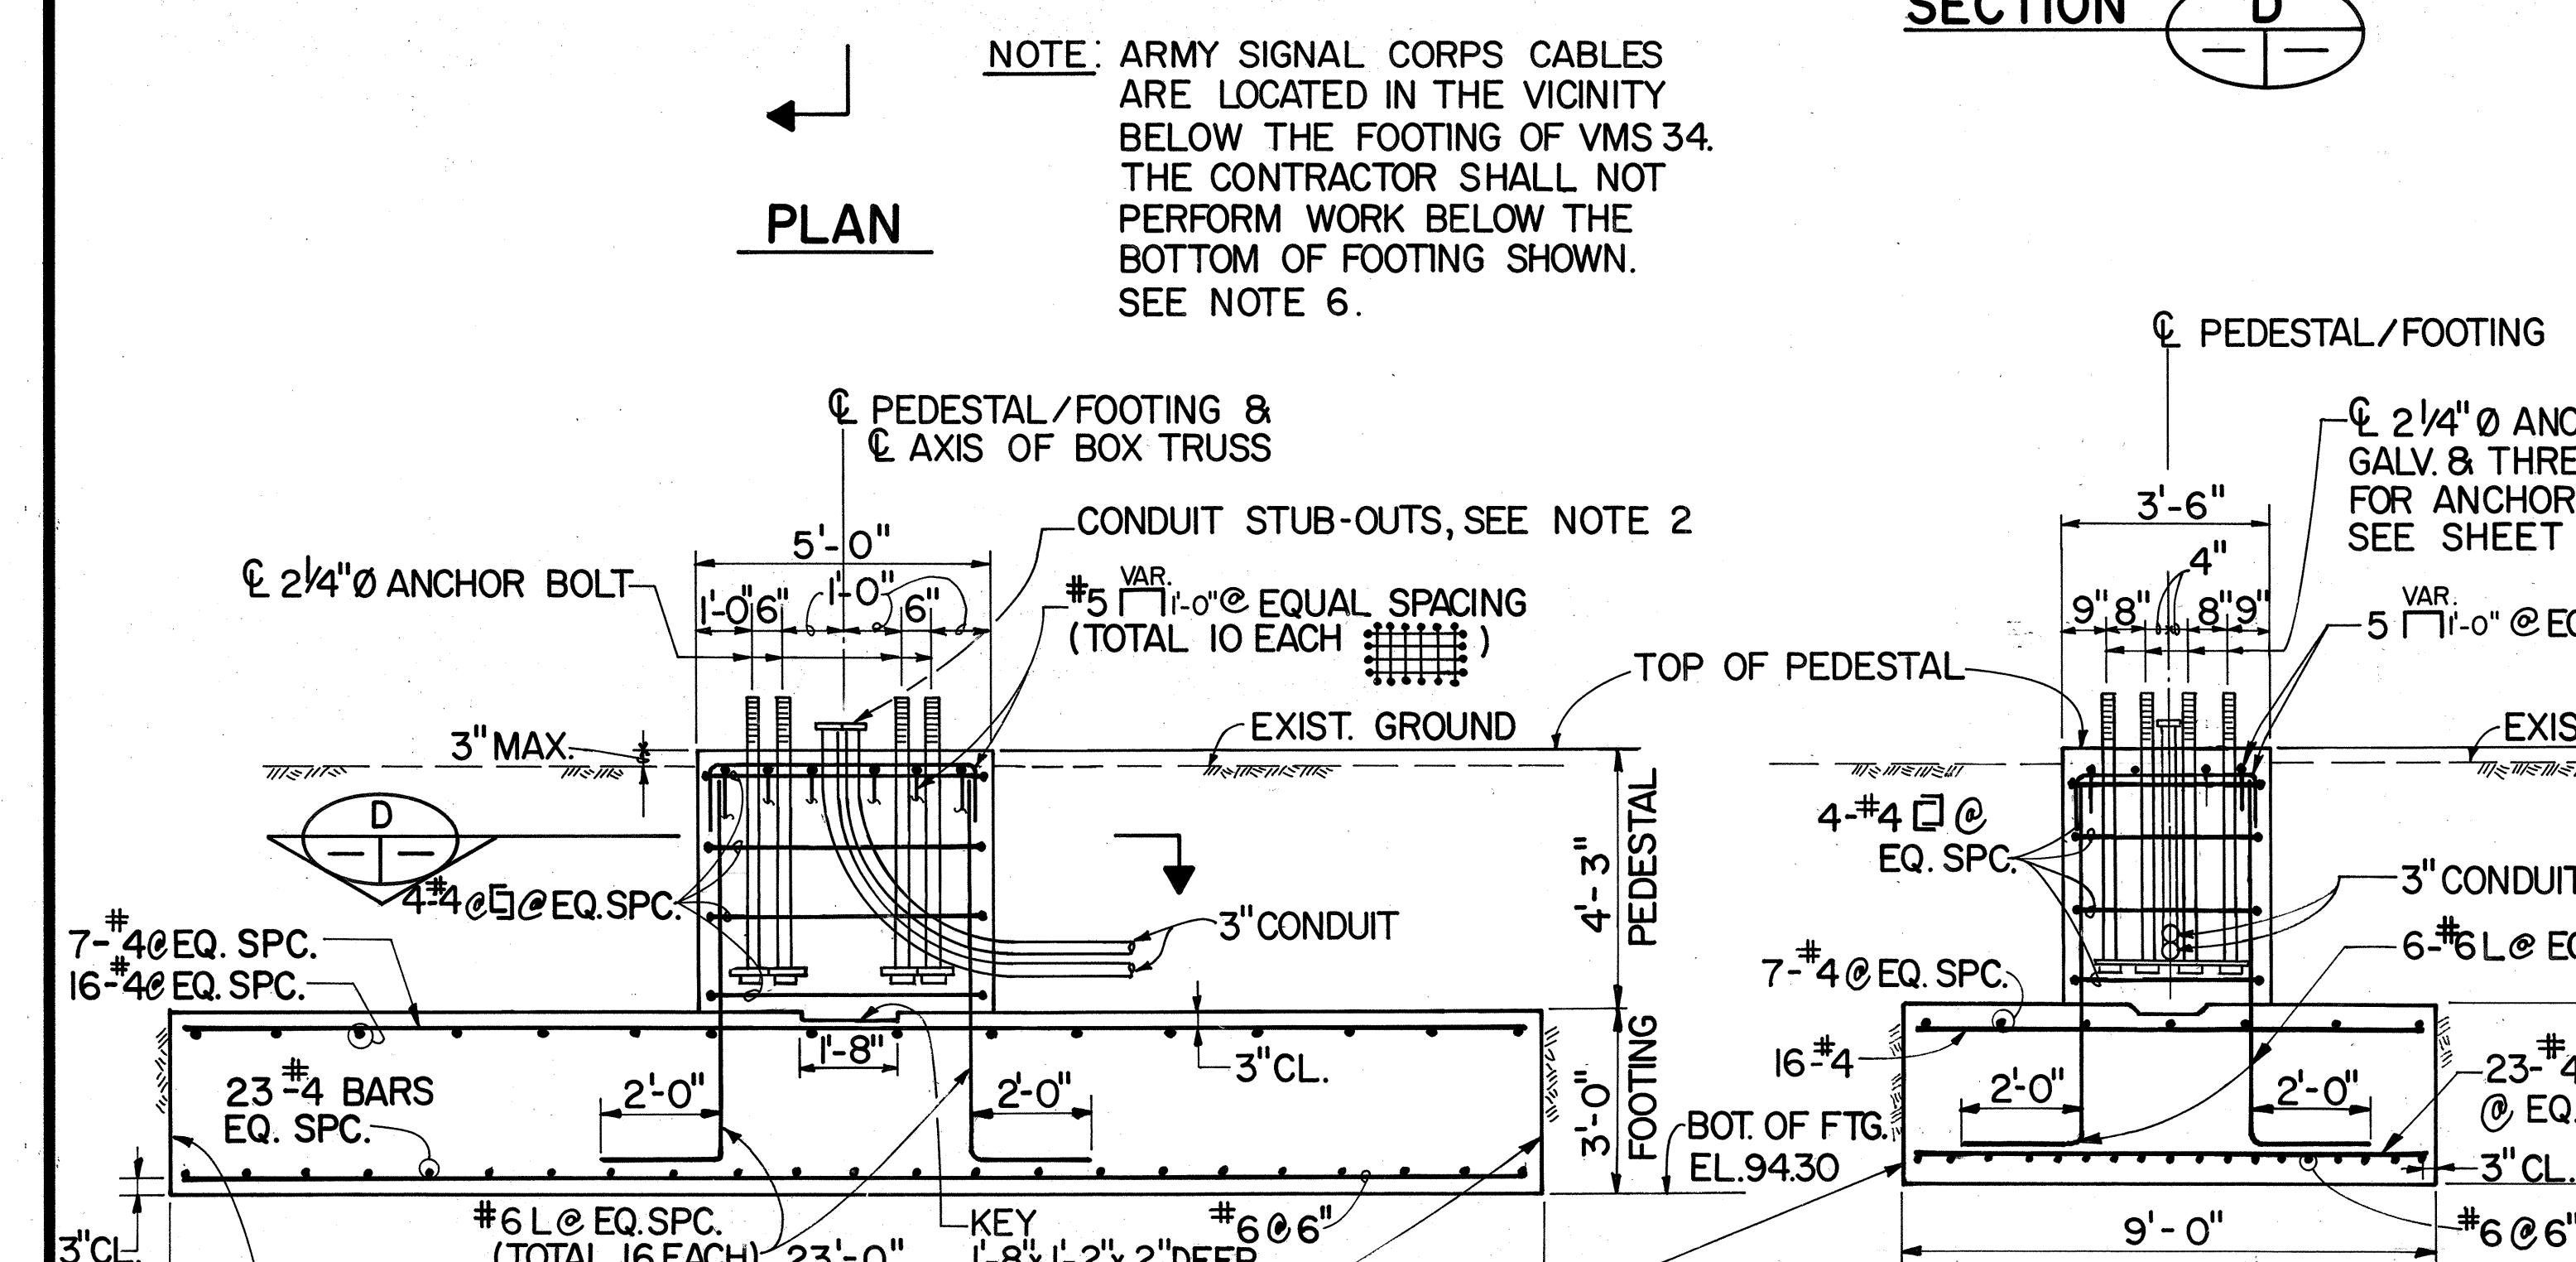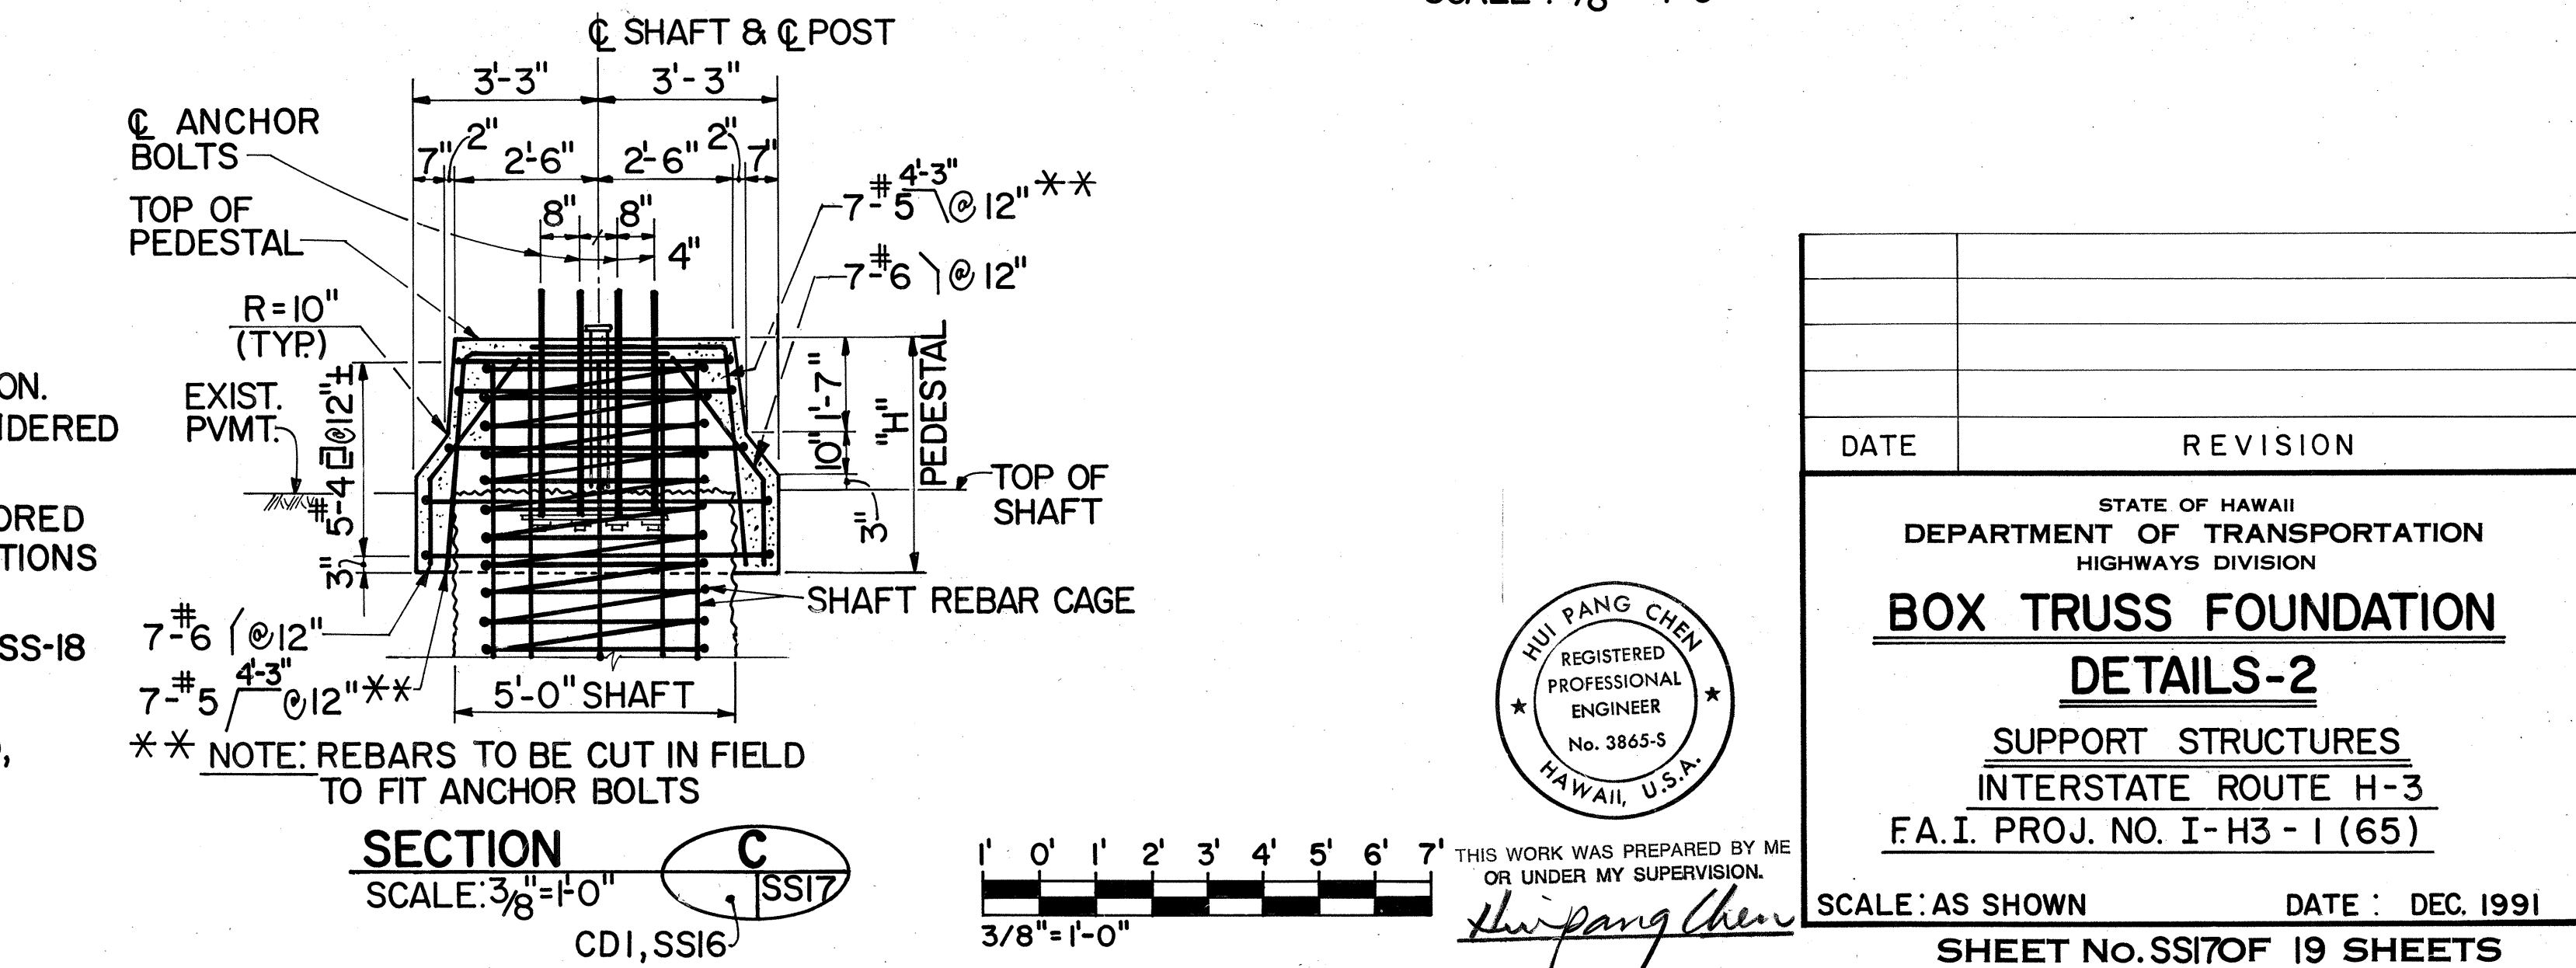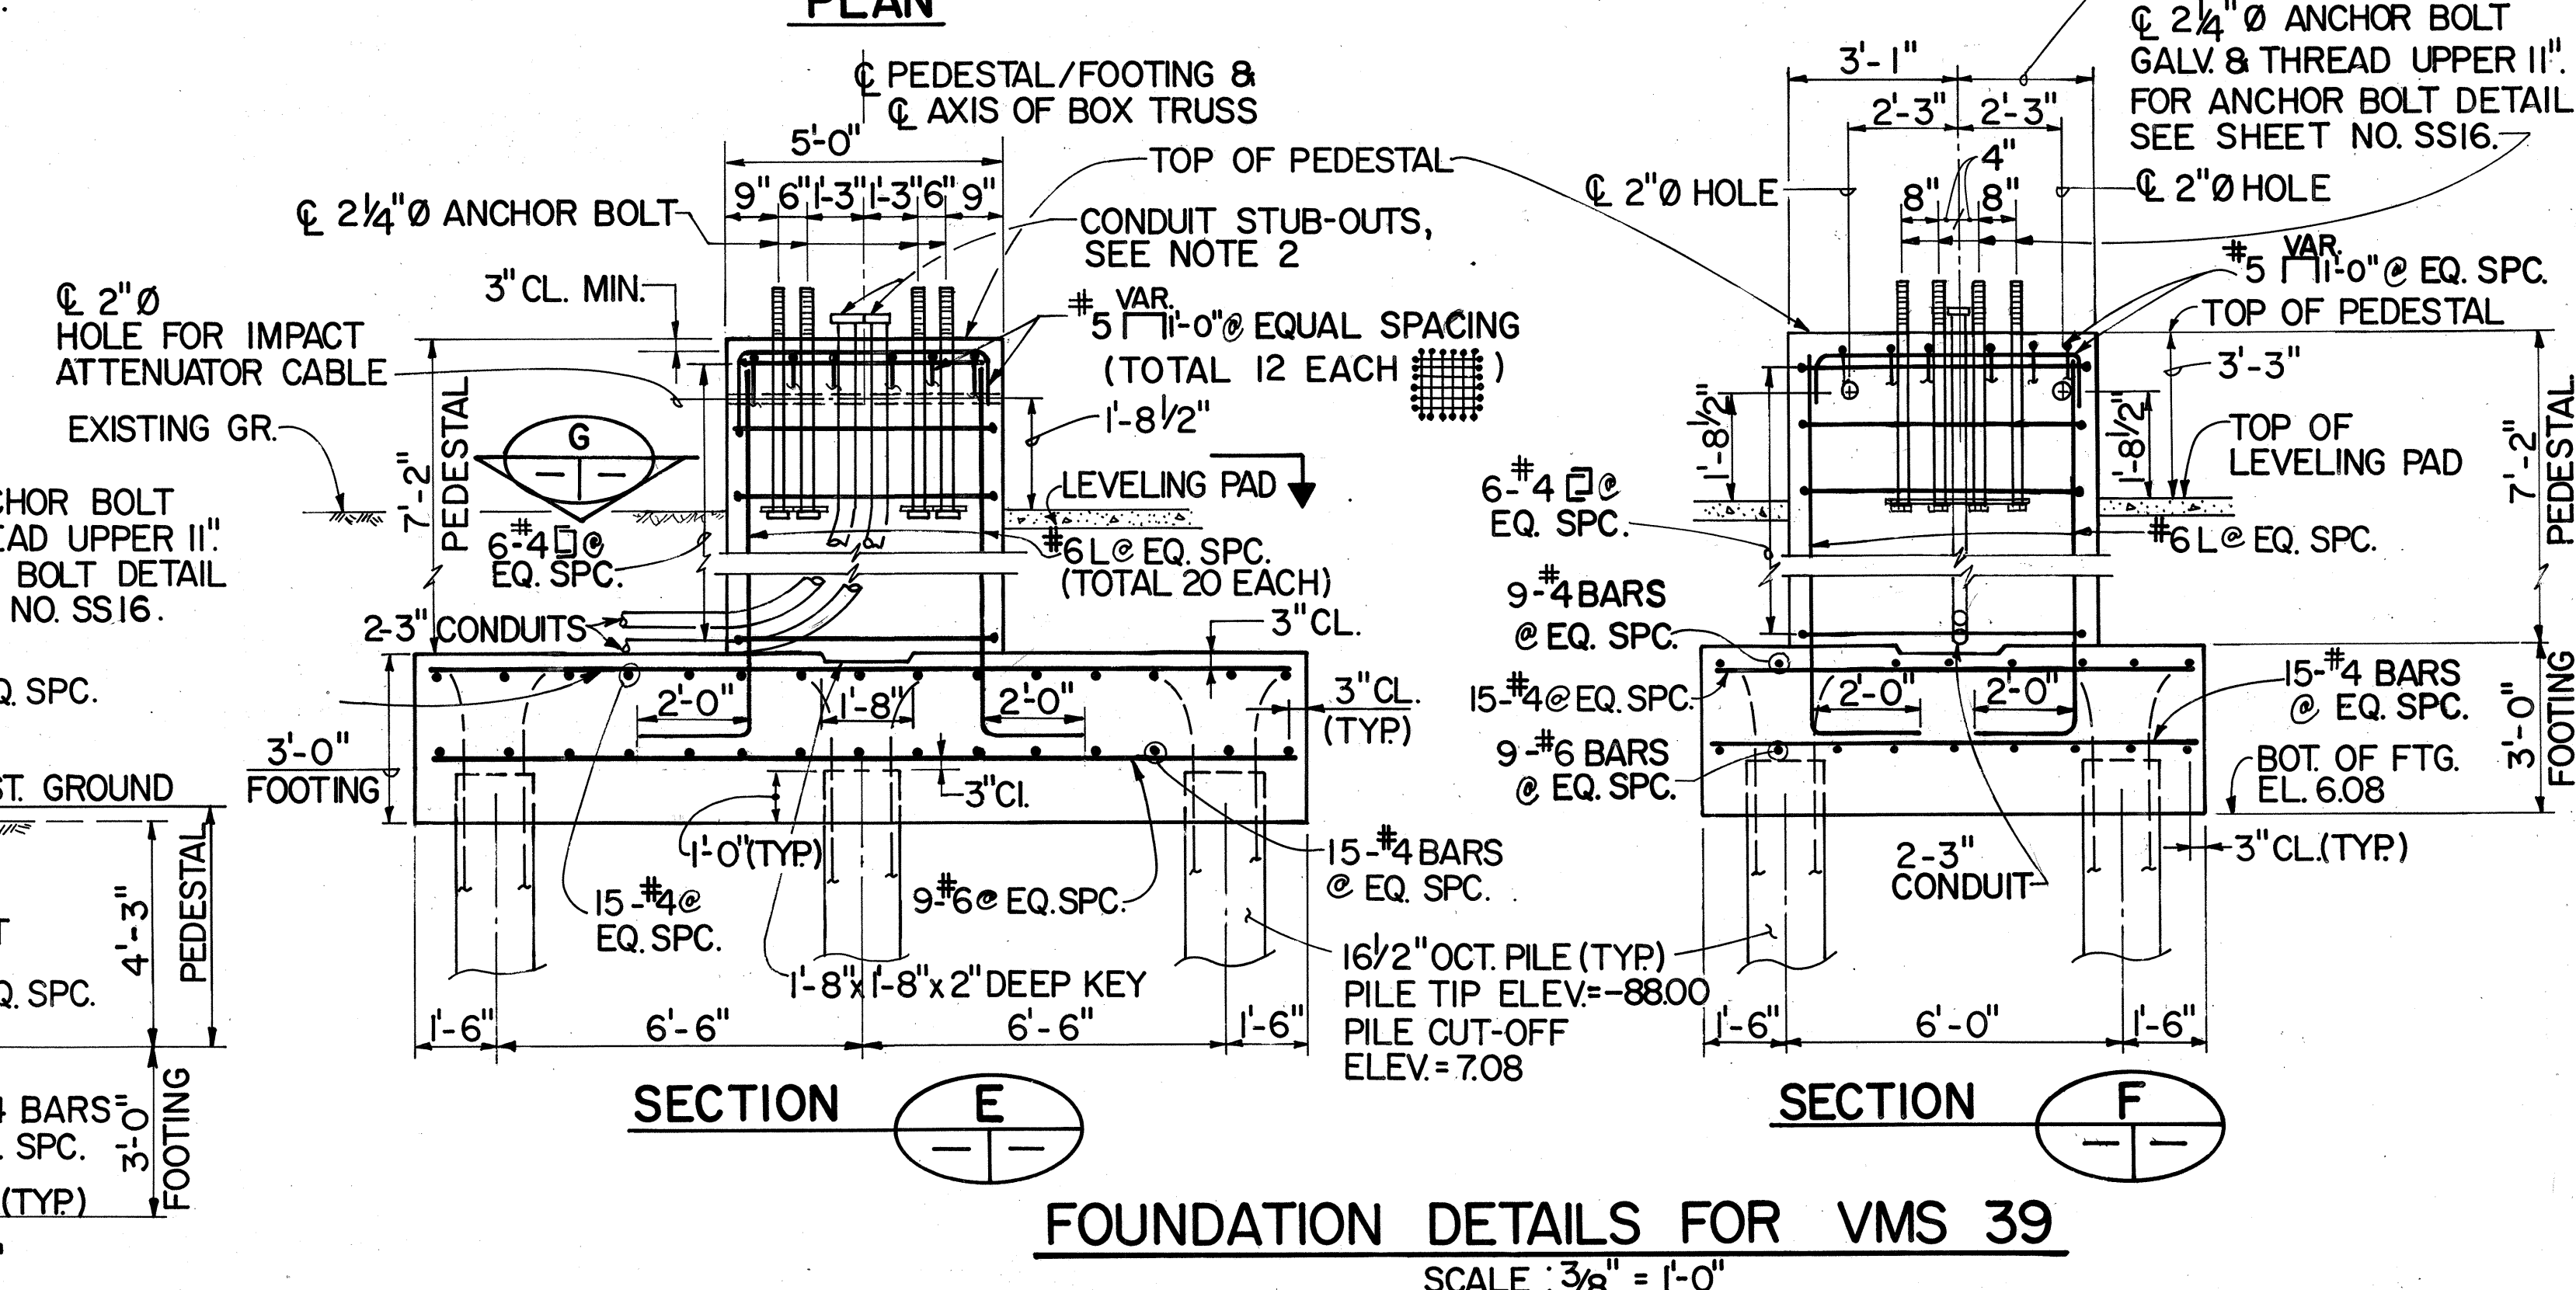

NOTES

1. THE REBAR IN THE PEDESTAL SHALL BE ADJUSTED IN THE FIELD TO AVOID CONFLICT WITH THE CONDUIT STUB-OUT, AND ANCHOR BOLTS.
2. THE CONDUIT STUB-OUT SHALL PROJECT 4 INCHES ABOVE THE TOP OF THE PEDESTAL.
3. CONCRETE IN FOOTING AND PEDESTAL SHALL BE CLASS A.
4. ALL REINFORCING STEEL SHALL BE ASTM A615 GRADE 60.
5. FOR ANCHOR BOLT INSTALLATION SEE NOTE 10 ON SHEET NO.SS16.
6. THE CONTRACTOR SHALL PROVIDE TEMPORARY BRACED SHORING DURING CONSTRUCTION OF VMS 34 FOUNDATION. TEMPORARY BRACED SHORING SHALL NOT BE EXTENDED BELOW THE BOTTOM OF FOOTING SHOWN. TEMPORARY BRACED SHORING SHALL BE CONSIDERED INCIDENTAL TO VARIOUS PAY ITEMS.
7. THE CONTRACTOR SHALL PROVIDE TEMPORARY SHEETING OR SHORING DURING CONSTRUCTION OF VMS 39 FOUNDATION. THE TEMPORARY SHEETING OR SHORING SHALL BE CONSIDERED INCIDENTAL TO VARIOUS PAY ITEMS.
8. THE MEDIANS AT VMS 34 AND VMS 39 SHALL BE RESTORED TO ORIGINAL CONDITION AFTER COMPLETION OF FOUNDATIONS CONSTRUCTION.
9. FOR DETAILS OF 16 1/2" OCTAGONAL PILES, SEE SHEET NO. SS-18 AND SS19.
10. FOR LOCATIONS OF EXISTING WATER LINES AROUND VMS 39, SEE SHEET NOS.CA3 & CU3.



THIS WORK WAS PREPARED BY ME
OR UNDER MY SUPERVISION

DATE	REVISION
STATE OF HAWAII DEPARTMENT OF TRANSPORTATION HIGHWAYS DIVISION	
<u>BOX TRUSS FOUNDATION</u>	
<u>DETAILS-2</u>	
<u>SUPPORT STRUCTURES</u>	
<u>INTERSTATE ROUTE H-3</u>	
<u>F.A.I. PROJ. NO. I-H3 - I (65)</u>	
SCALE: AS SHOWN	DATE: DEC. 1991
SHEET No. SS17 OF 19 SHEETS	


Diagram illustrating the cross-section of a square pile cap with dimensions and reinforcement details:

- Overall dimensions: 3'-0" (width) x 3'-0" (height).
- Internal dimensions: 1'-6" (width) x 1'-6" (height) for the central square area.
- Reinforcement details:
 - Continuous vertical: 8-#8
 - Closed ties: #4 @ 3"
 - 2" clear (distance from reinforcement to concrete edge)
 - Symm. about C pile (symmetry about the centerline of the pile)


Diagram illustrating the reinforcement details for a circular slab with a central void. The slab has an outer diameter of 36" and a central void with an octagonal shape. The reinforcement includes:

- Closed ties: #4 @ 3"
- Continuous vertical: 8-#8
- 2" clear (space between ties and void)
- 36" diameter (outer slab diameter)
- 8" (spacing of closed ties)

CIRCULAR BUILD-UP
SECTION 

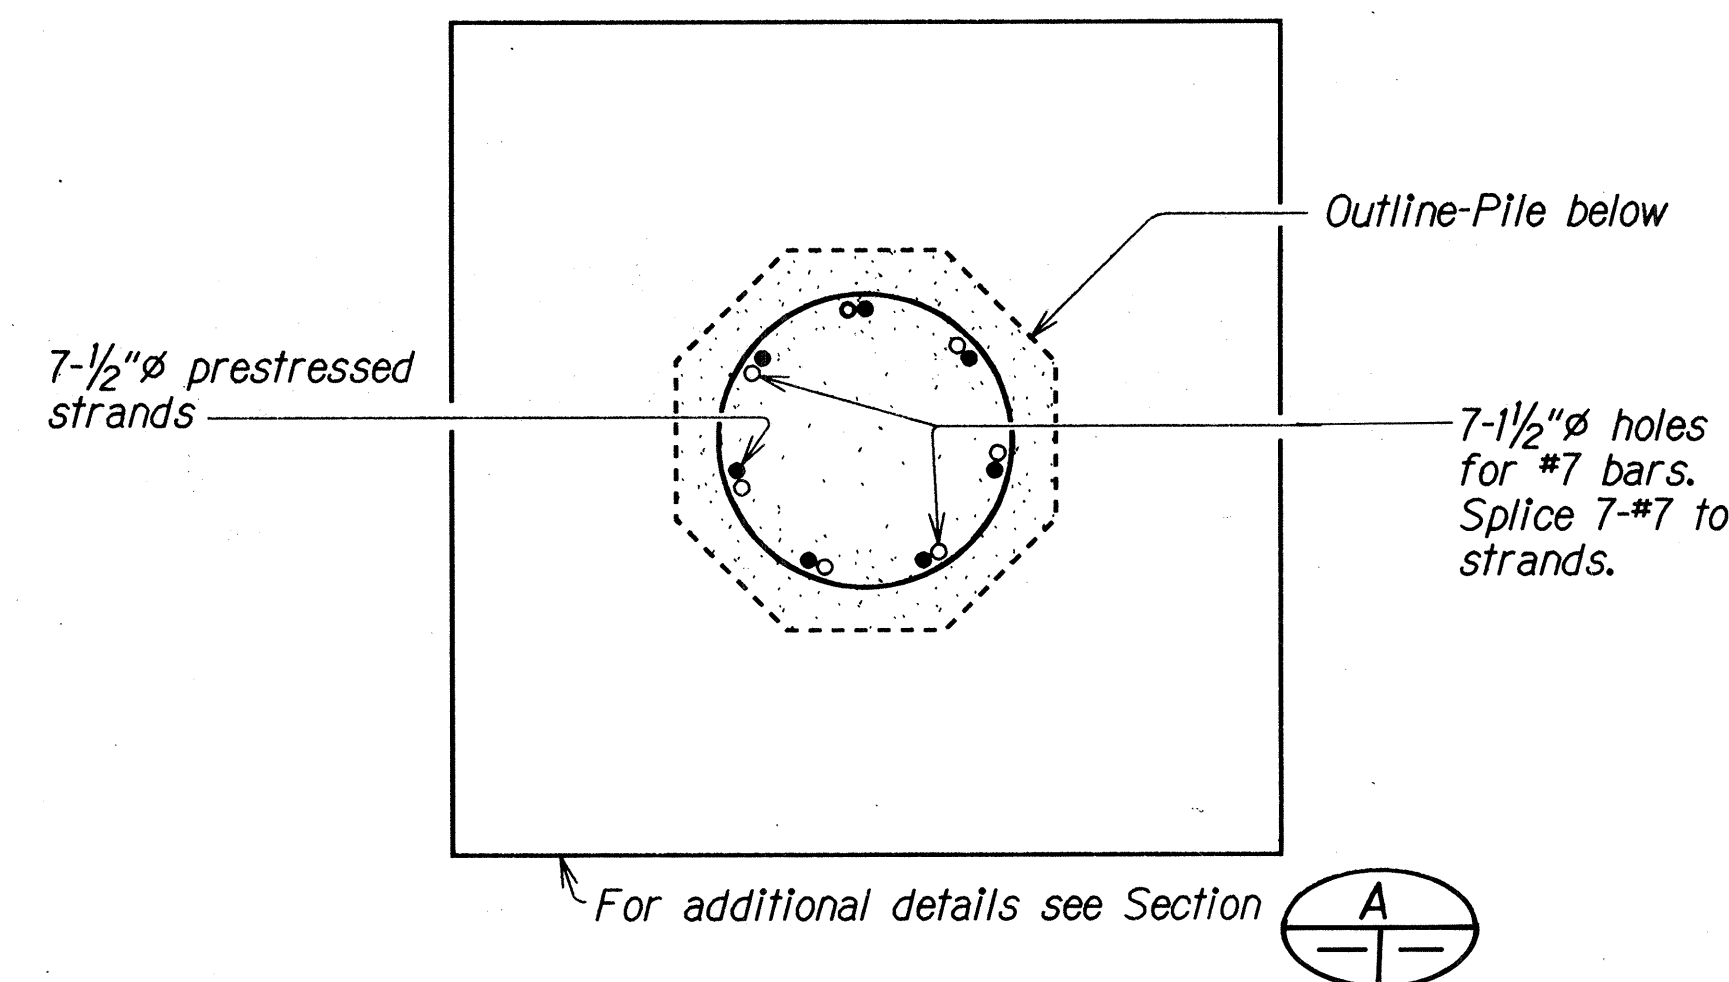


SECTION 

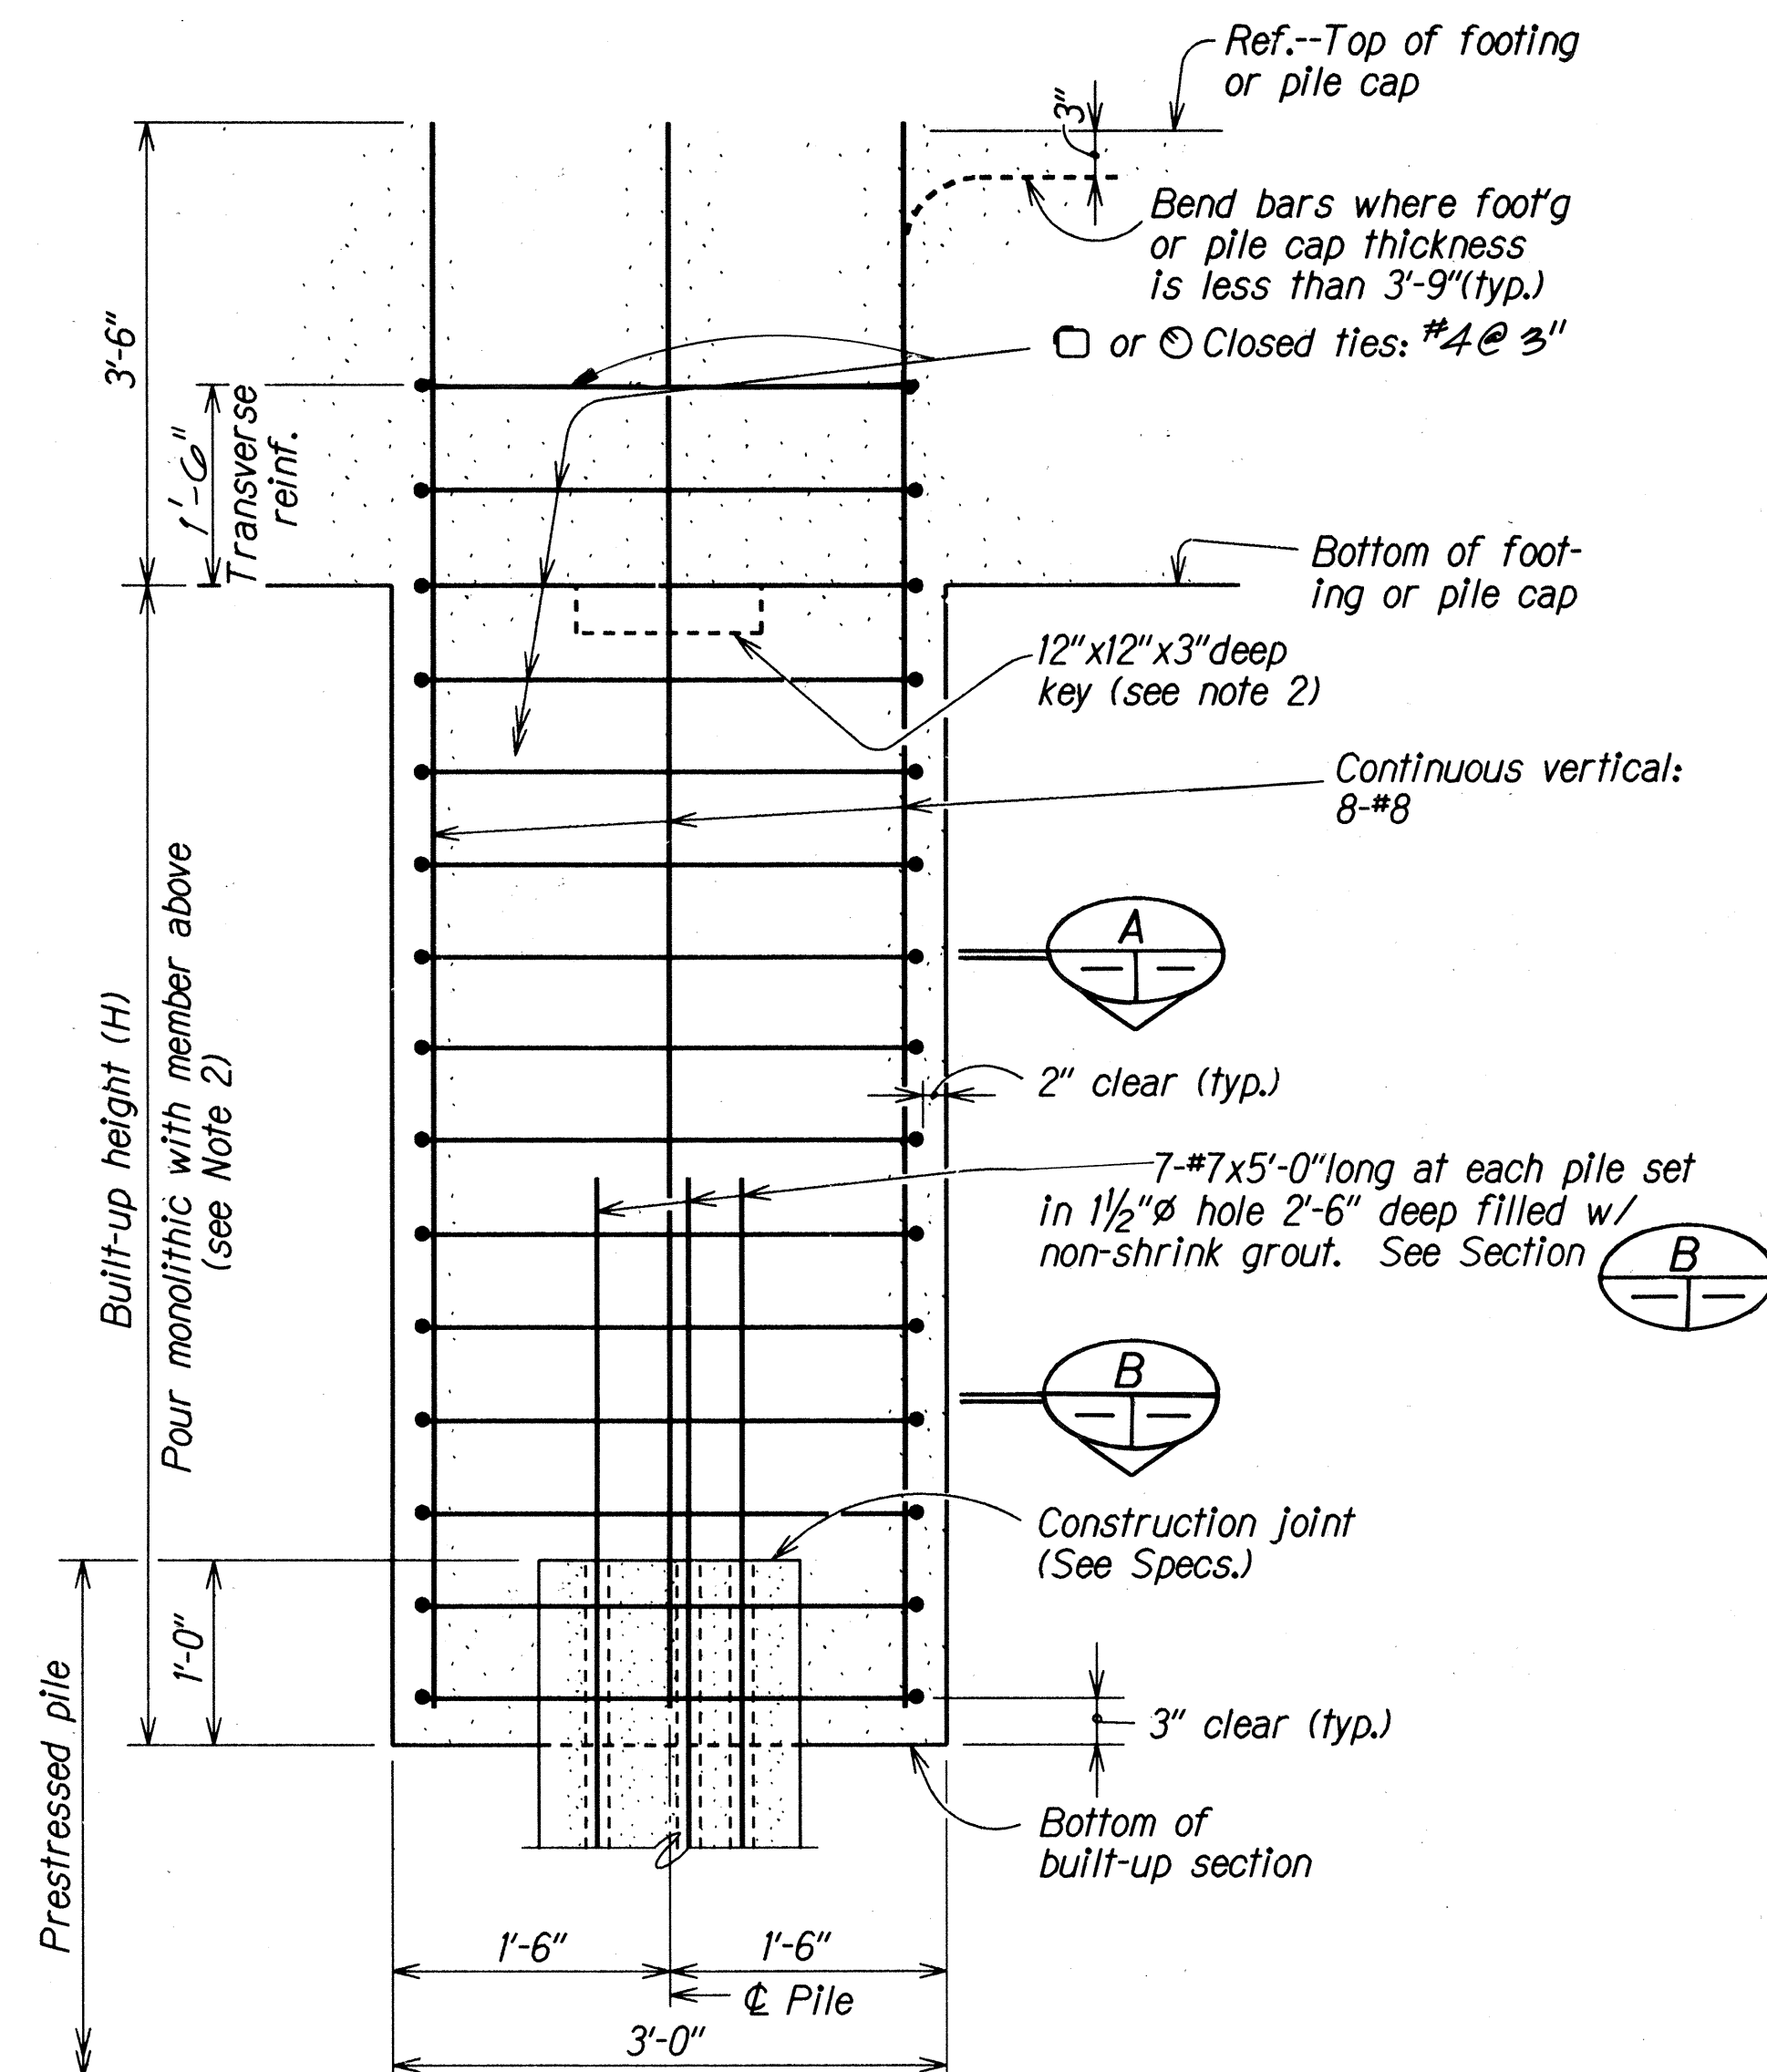

ALTERNATE PILE BUILD-UP DETAIL

1. Selection of pile build-up type without driving to be determined by the Engineer.
2. When the built-up height (H) exceeds 4'-0", the built-up section shall be poured separately from the main body of the footing or pile cap.
3. Pile build-ups may be omitted for pile heads embedded at least 4" into footing, provided at least 90 percent of the pile in each footing have the minimum embedment into footing as shown in contract plans and #7 bars are spliced to strands as shown in Section
4. For built-up pile with driving, remove concrete after driving, leaving reinforcement exposed. See General Note 6 on Sht. No. SS-18.
5. Circular build-up section may be used only when approved by the Engineer.
6. Alternate pile build-up detail shall apply only to pile build-up without driving.

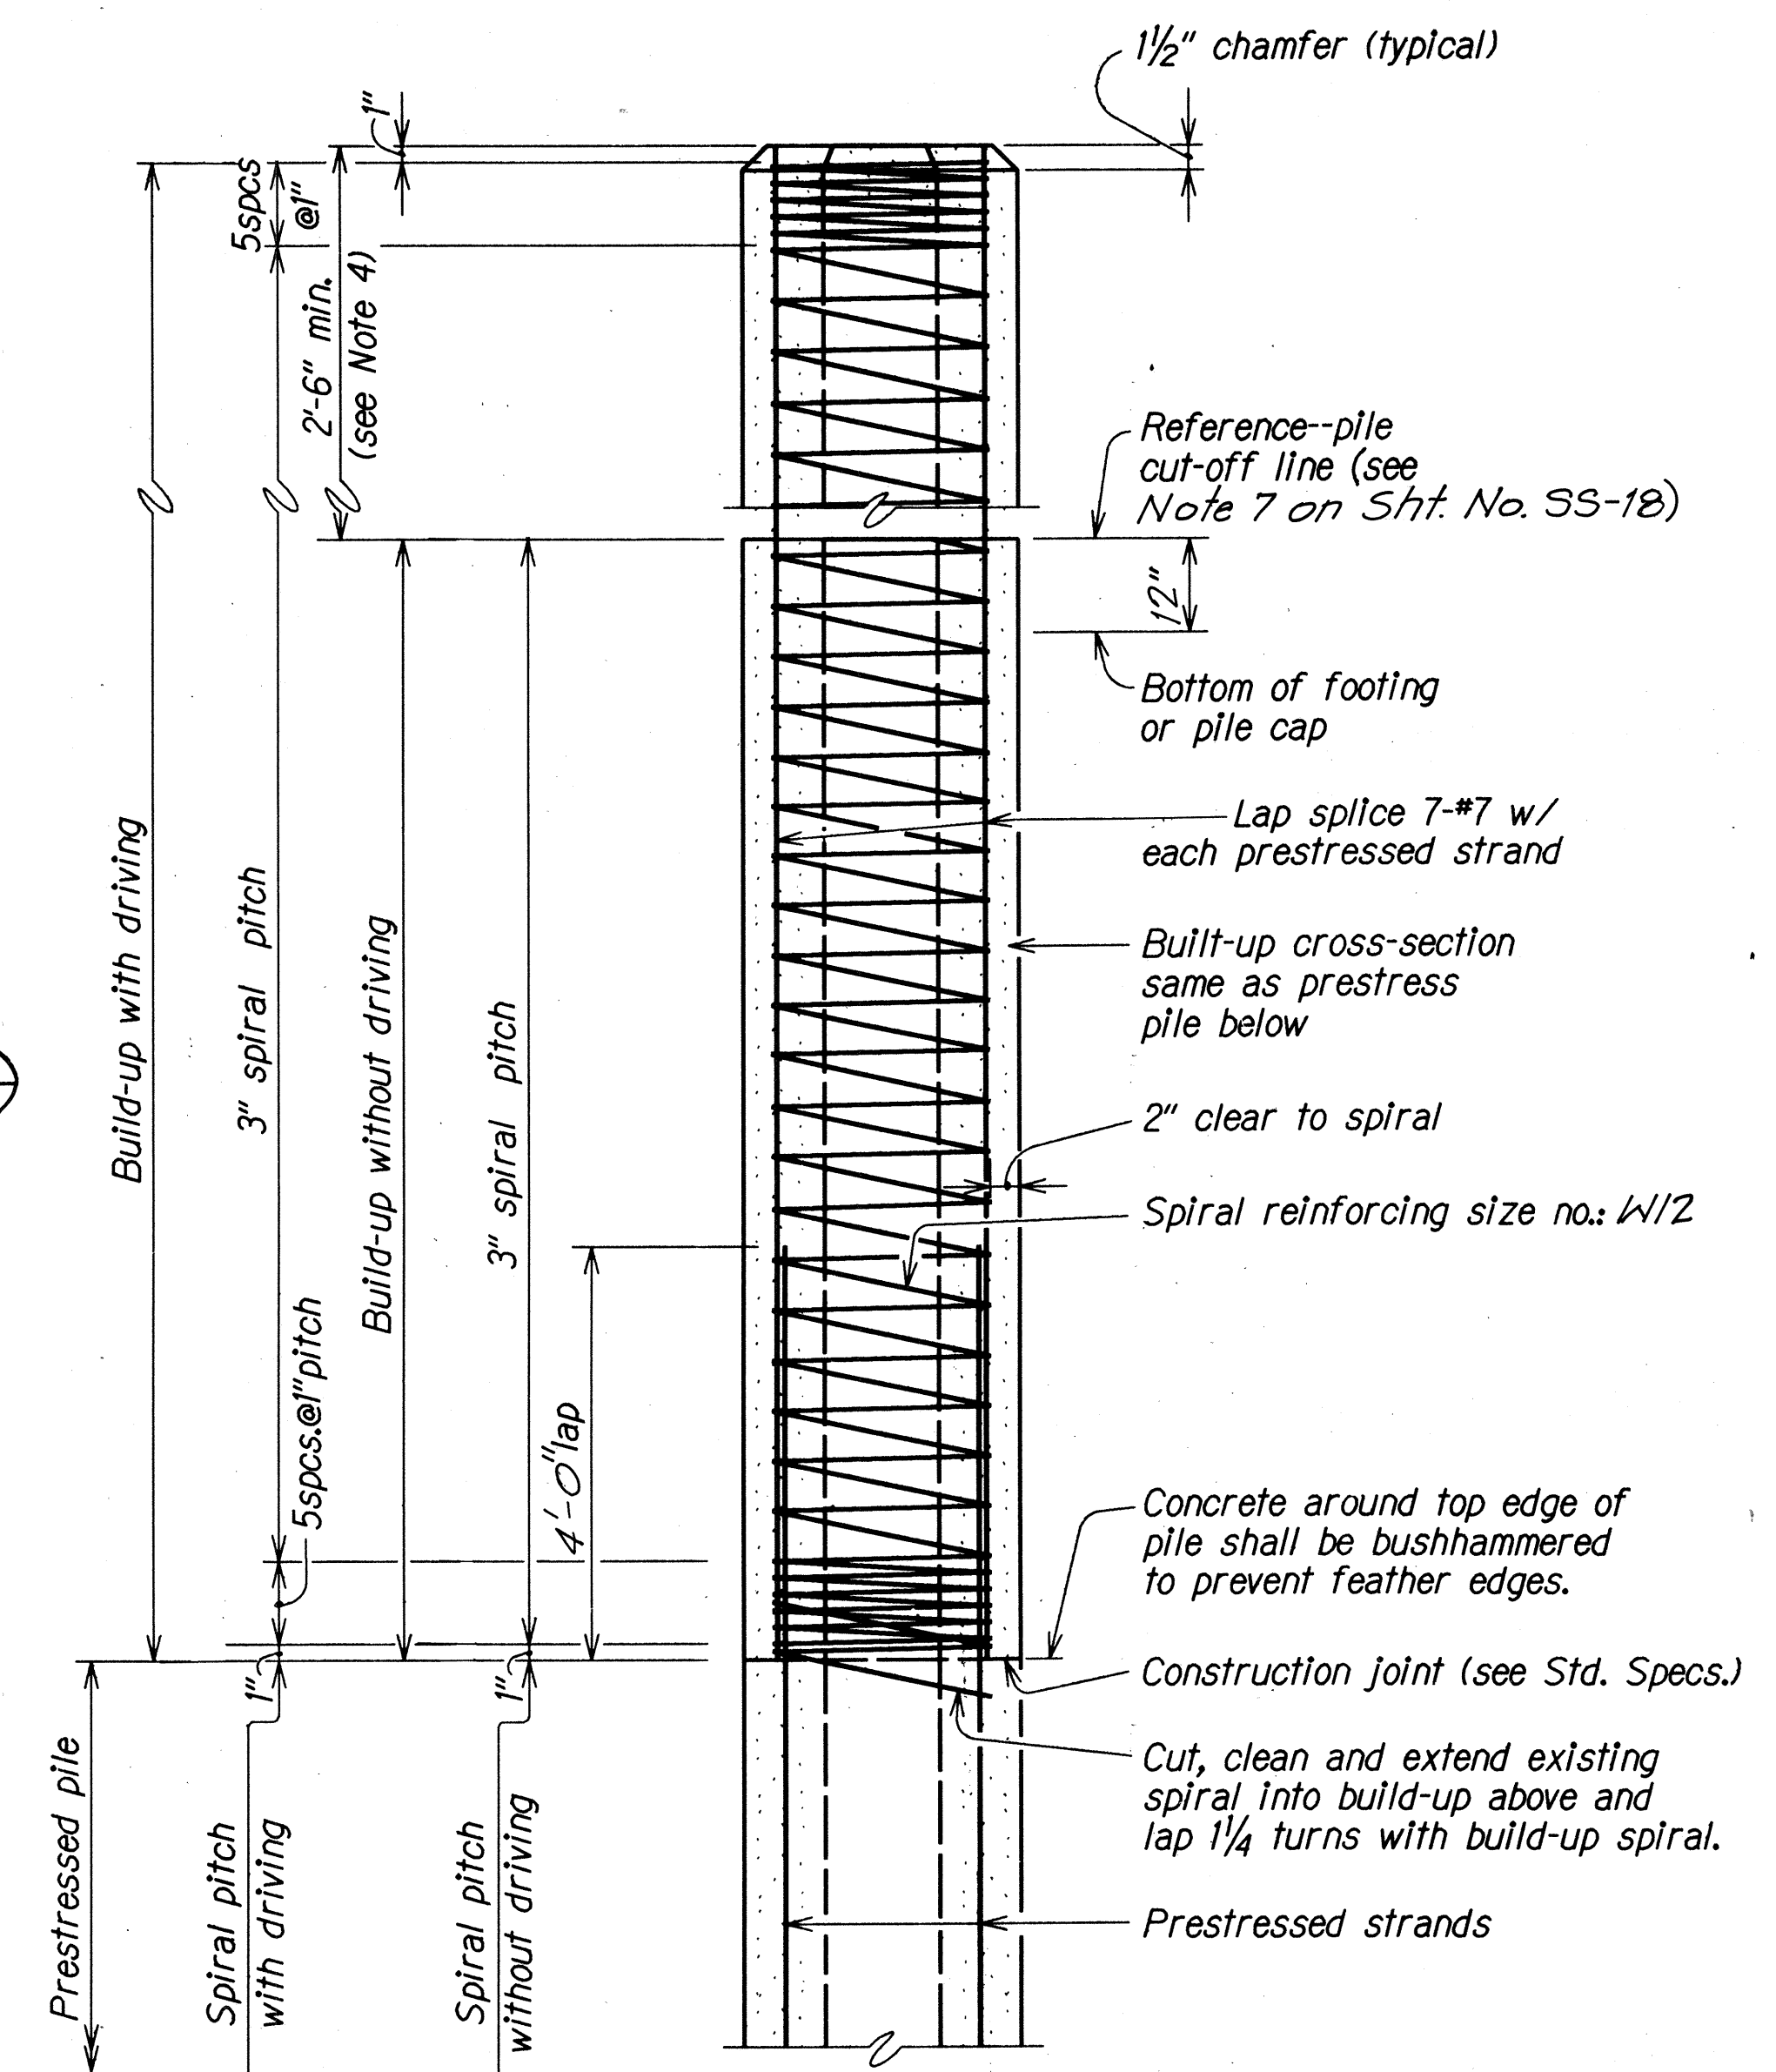

TYPICAL PILE BUILD-UP DETAIL

SCALE : NOT TO SCALE DATE : DEC. 1991

SHEET No.SS/9 OF 19 SHEETS

Shi pang Chen