M.	INDEX TO PLANS	
	SHEET NO.	DESCRIPTION
	1 - 20	GENERAL
	21 - 246	SYSTEMS(1)2(3)4(5)6(7)8
	247 - 286	CIVIL 9
	287 - 305	SUPPORT STRUCTURES GEOTECHNICAL
	306 - 309	GEOTECHNICAL
	- j j j	
	· ·	
ļ	*	
	* '¥,	

Plan Sht. Nos. C.O. 46S-J, C.O. 65S-I, C.O. 87S-I, C.O. 107S-1, 107S-2, C.O. 180S-I, C.O. 181S-I, C.O. 182S-I, 8200S-I & C.O. 270S-I are supplementary sheets to this project, added during C.O., Addendum & "AS BUILT" postings.

TOTAL SHEET COUNT after C.O., Addendum & "AS BUILT" postings is 319 sheets.

STATE OF HAWAII

DEPARTMENT OF TRANSPORTATION

HIGHWAYS, DIVISION

HONOLULU, HAWAII


"AS-BUILT"
PLANS FOR


CONSTRUCTION OF A PORTION OF

INTERSTATE ROUTE H-3

FURNISHING AND INSTALLING SYSTEMS COMPONENTS FEDERAL AID INTERSTATE PROJECT NO. I-H3-I(65)

DISTRICTS OF KOOLAUPOKO, EWA AND HONOLULU ISLAND OF OAHU

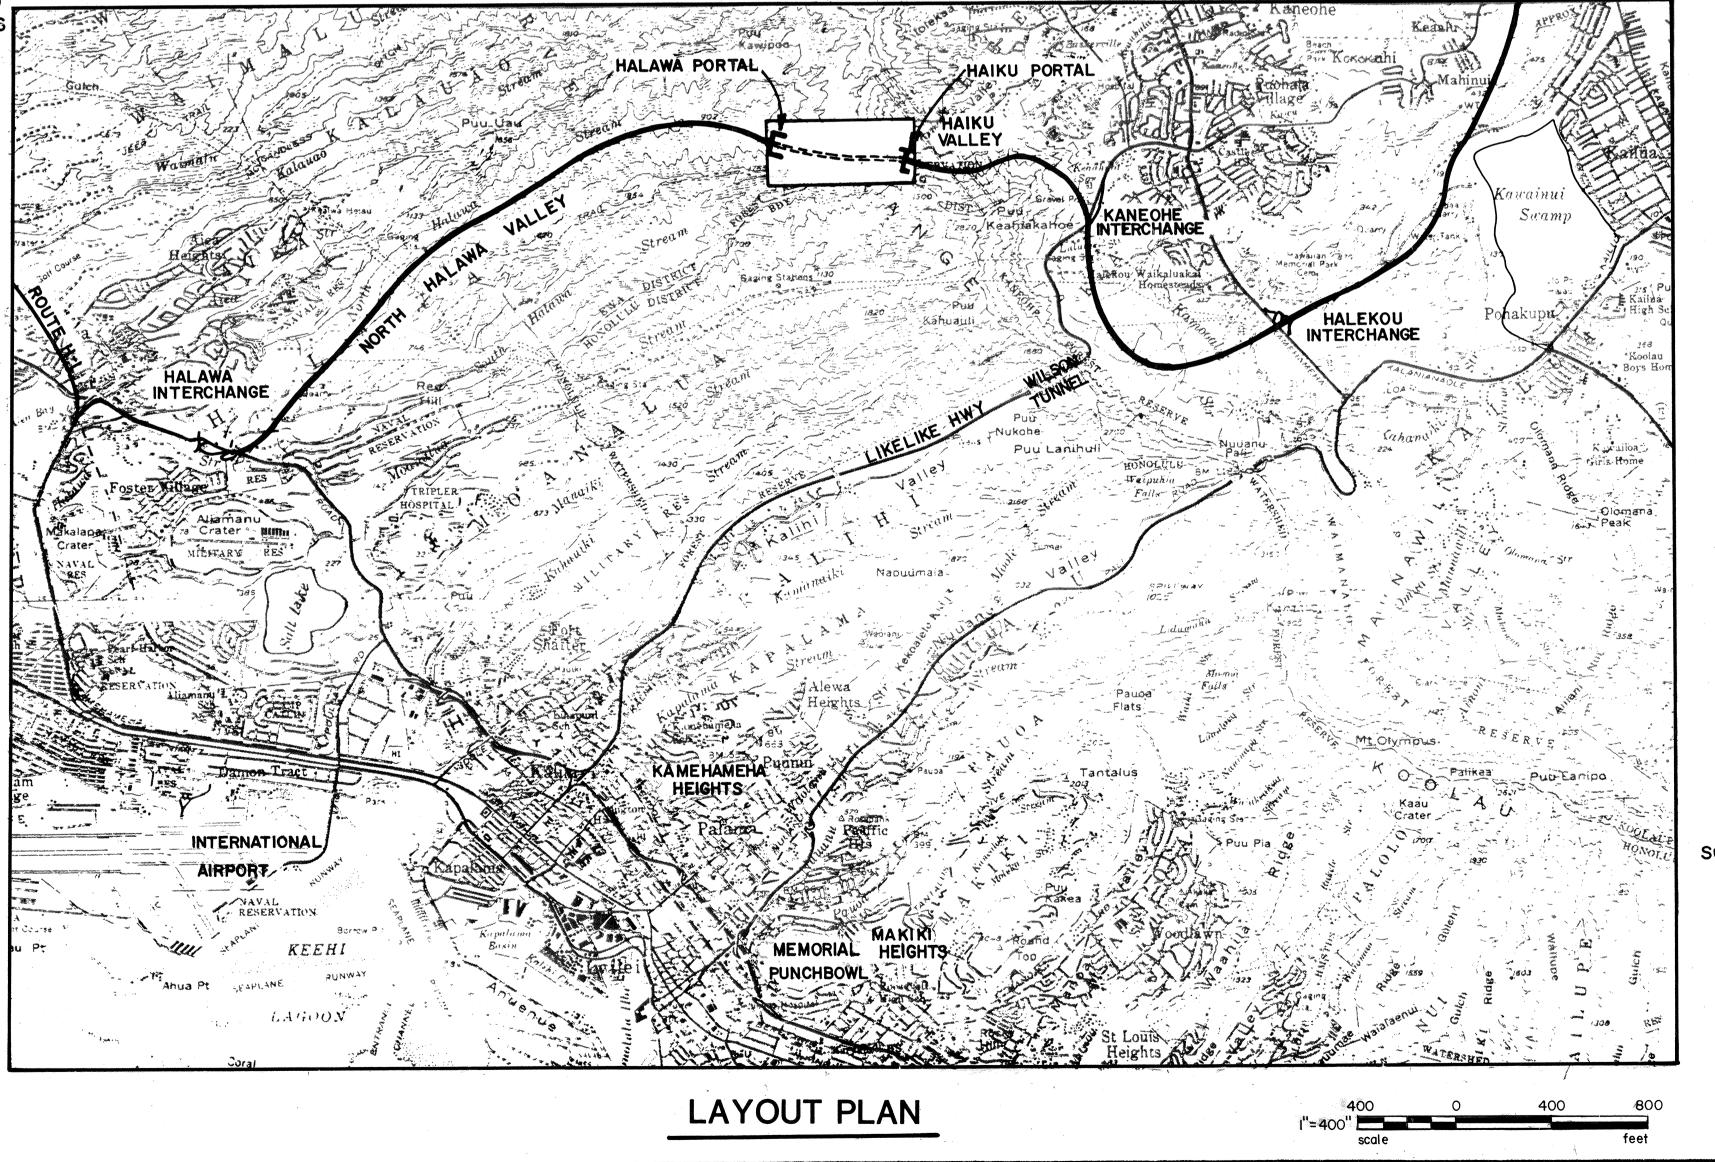

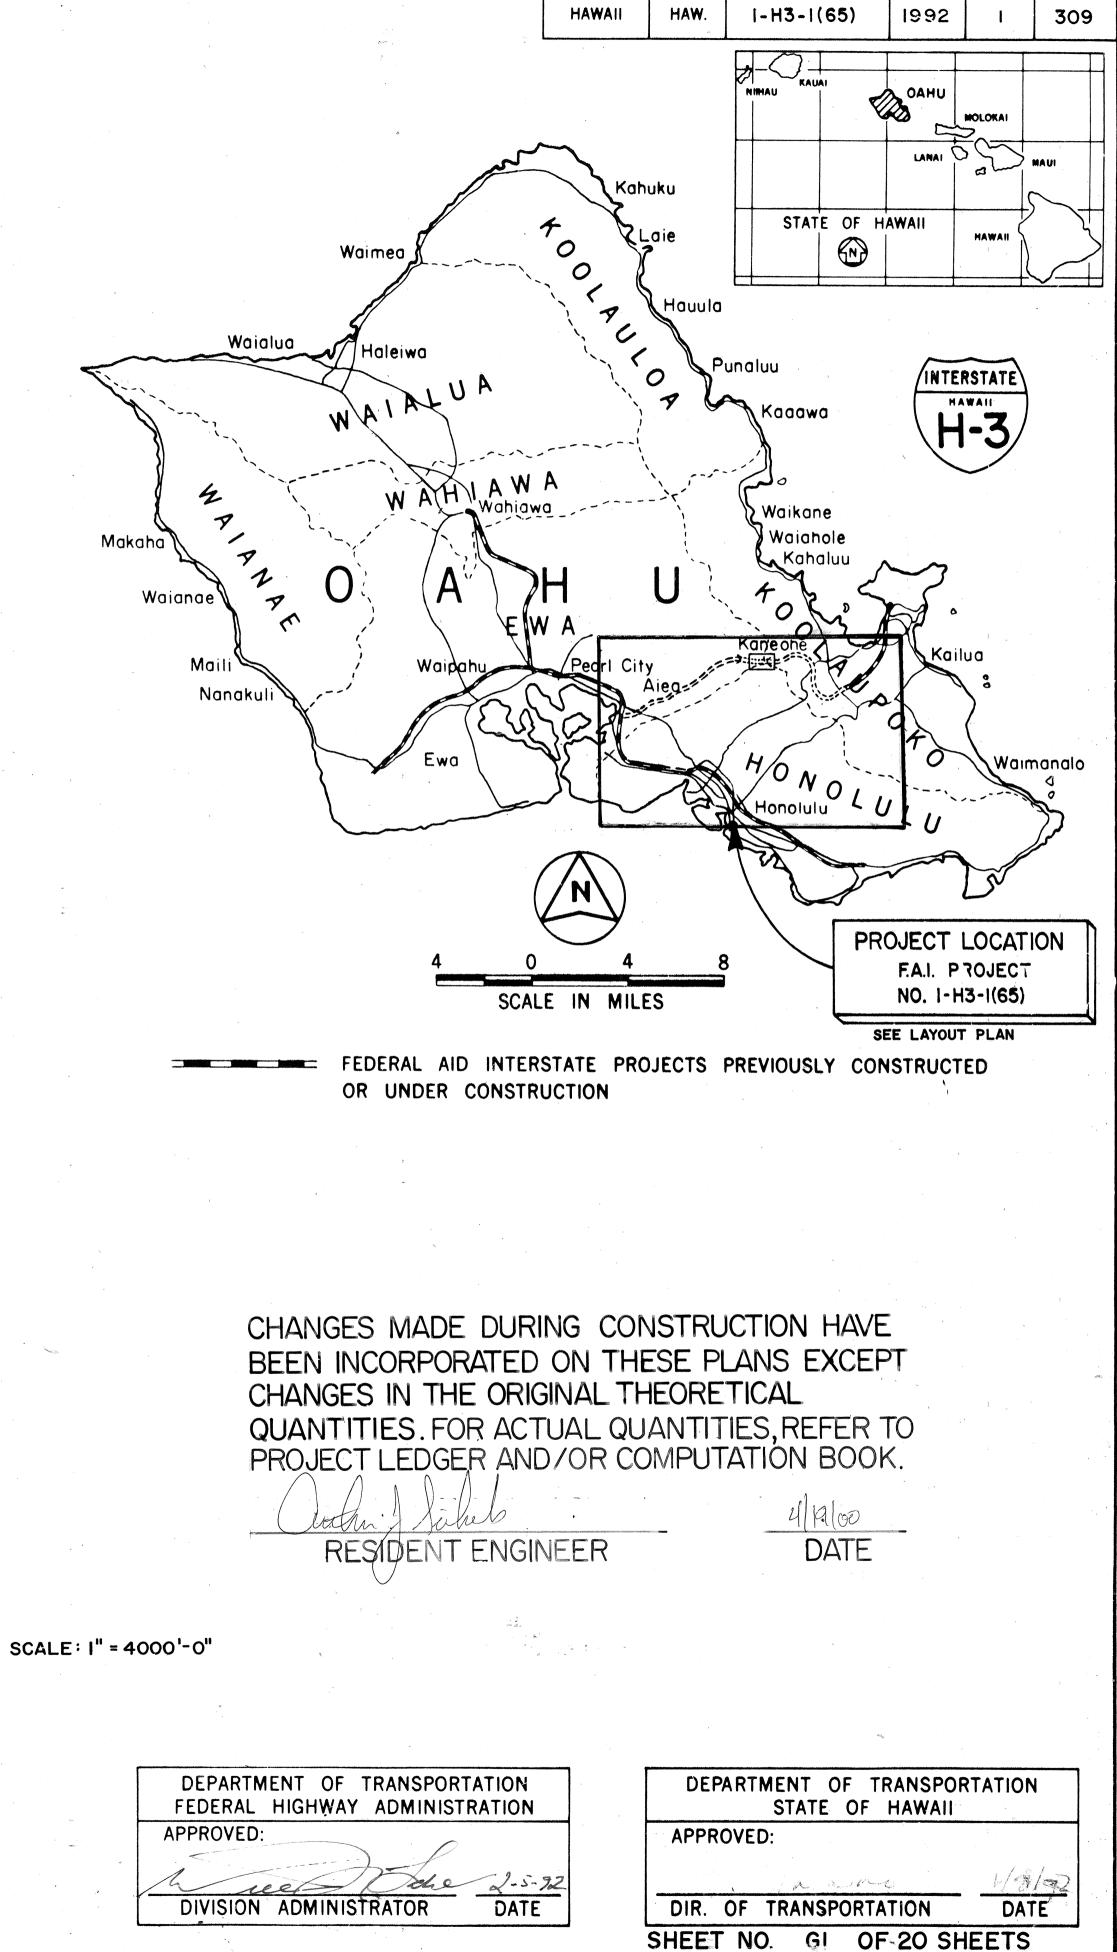

FED. ROAD DIST. NO. FISCAL SHEET TOTAL YEAR NO. SHEETS

FED. AID PROJ. NO.