

INDEX TO DRAWINGS	
SHT. NO.	DESCRIPTION
1	TITLE SHEET
2	STANDARD PLANS SUMMARY
① 3 TO 10	TYPICAL ROADWAY SECTIONS AND DETAILS
② 11 TO 14	GEOMETRIC PLANS, H-3
15 TO 18	PROFILE, H-3
19	SE DIAGRAM, H-3
20 & 21	PROFILE, EMERGENCY ESCAPE RAMP
22	PROFILE, HECO ACCESS ROAD
23	GENERAL LAYOUT PLAN - CONSTRUCTION ACCESS ROAD
③ 24 TO 27	PROFILE - CONSTRUCTION ACCESS ROAD
28	SE DIAGRAM, CONSTRUCTION ACCESS ROAD
④ 29 & 30	RELOCATED STREAM NO. 1
31	GRADING NOTES, EROSION AND SEDIMENT CONTROL MEASURES
⑤ 32 TO 35	GRADING AND DRAINAGE PLANS
36 & 37	GRADING AND DRAINAGE PLANS, EMERGENCY ESCAPE RAMP
38 TO 42	PROFILE - DRAINLINES
43	PROFILE - DITCH
⑥ 44 TO 50	DRAINAGE DETAILS
51 & 52	DITCH DETAILS
⑦ 53 TO 62	DRAINAGE ESTIMATED QUANTITIES
63 TO 67	11.5 KV POWER & TEL. LINE REL.
68	POLE LINE MATERIAL
69 & 71	WOOD POLE FRAMING
⑧ 72 TO 83	H.E. CO. / H.T. CO.
84 TO 95	HIGHWAY LIGHTING AND COMMUNICATION
96	HIGHWAY LIGHTING SLIP BASE
97	TYPICAL DETECTOR LOOP LOCATIONS
98 & 99	SIGNING AND STRIPING PLAN
100 TO 102	NORTH HALAWA STREAM BRIDGES: INDEX TO DRAWINGS, LOCATION MAP, GENERAL STRUCTURAL NOTES AND ESTIMATED QUANTITIES
⑨ 103 TO 136	NORTH HALAWA STREAM BRIDGES: NO. 1 & NO. 2
⑩ 137 & 138	NORTH HALAWA STREAM BRIDGES: DETAILS
⑪ 139 TO 145	MSERW
⑫ 146 TO 149	LOG OF BORINGS
⑬ 150 TO 192	CROSS-SECTIONS, H-3
193 TO 195	CROSS-SECTIONS, RELOCATED STREAM NO. 1
196 TO 199	STREAM CROSS SECTIONS AT BRIDGE NO. 2
200 TO 211	CROSS-SECTIONS, CONSTRUCTION ACCESS ROAD

Plan Sht. Nos. ① ADD. 10S-1, ② C.O. ADD. 14S-1, ③ ADD. 27S-1 & ADD. 27S-2, ④ ADD. 30S-1, ADD. 30S-2, ADD. 30S-3 & ADD. 30S-4, ⑤ C.O. ADD. 32S-1, ⑥ ADD. 47S-1, ⑦ ADD. 62S-1, ⑧ ADD. 77S-1, C.O. 83S-1 & C.O. 83S-2, ⑨ C.O. 123S-1, ⑩ ADD. 138S-1, ADD. 138S-2 & ADD. 138S-3, ⑪ 139S-1, ⑫ ADD. 149S-1 & ADD. 149S-2 and ⑬ ADD. 152S-1, ADD. 153S-1, ADD. 159S-1,

DESIGN CLASSIFICATION

DESIGN ADT (2008)... 45,220
 DHV..... 4,282
 D..... 76/24
 T..... 2.1%
 T24..... 4.1%
 V..... 60 MPH

C.O. ADD. 164S-1, C.O. ADD. 165S-1, C.O. ADD. 166S-1 & C.O. ADD. 167S-1 are Supplementary Sheets to this Project.



Total sheet count after "AS BUILT" postings is 239 sheets.

STATE OF HAWAII
 DEPARTMENT OF TRANSPORTATION
 HIGHWAYS DIVISION
 HONOLULU, HAWAII
"AS BUILT"
 PLANS FOR
 CONSTRUCTION OF A PORTION OF
INTERSTATE ROUTE H-3
 NORTH HALAWA VALLEY HIGHWAY
 UNIT I PHASE 1A
 FEDERAL AID INTERSTATE PROJECT NO. I-H3-1 (59)

DISTRICT OF EWA
 ISLAND OF OAHU

Changes made during construction have been incorporated on these plans except changes in the original Theoretical Quantities. For actual quantities, refer to Project Ledger and/or Computation Book.

Robert Shin 7-09-97
 RESIDENT ENGINEER DATE

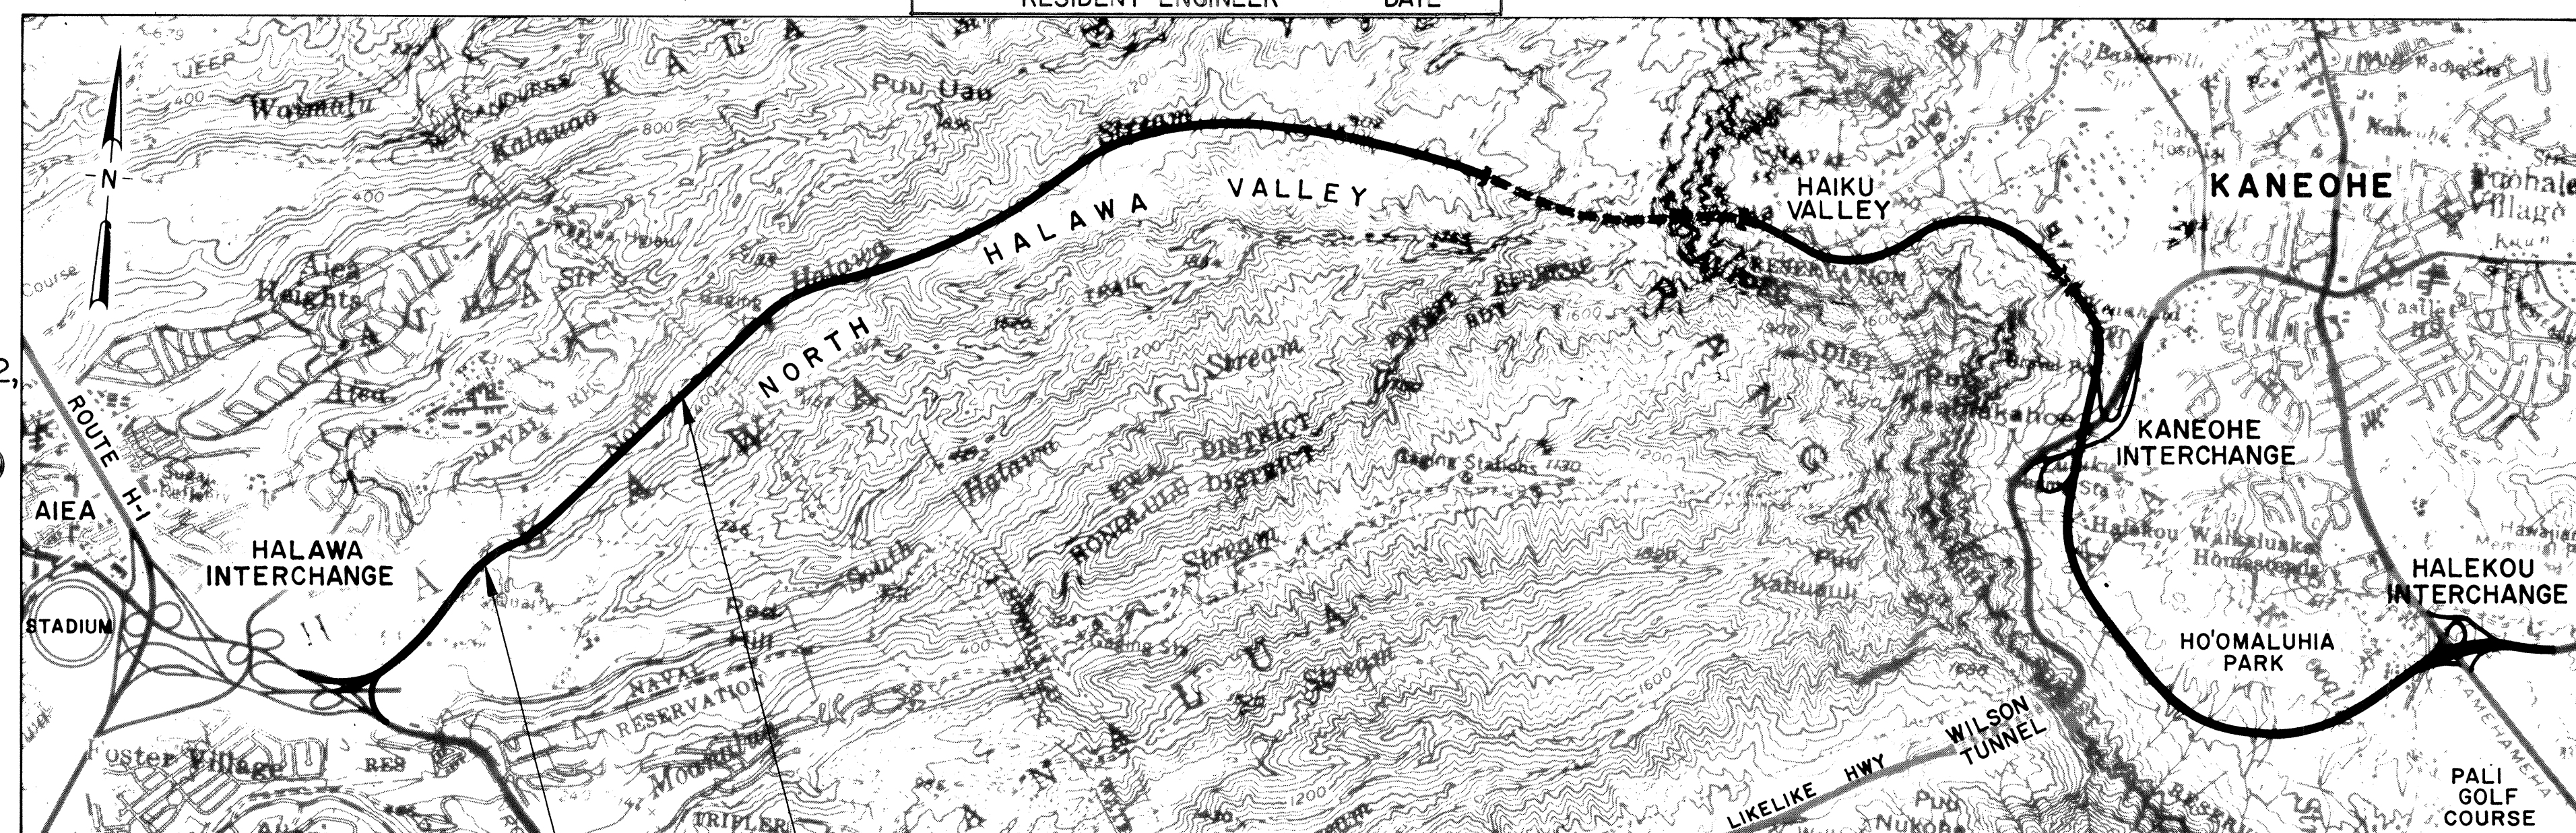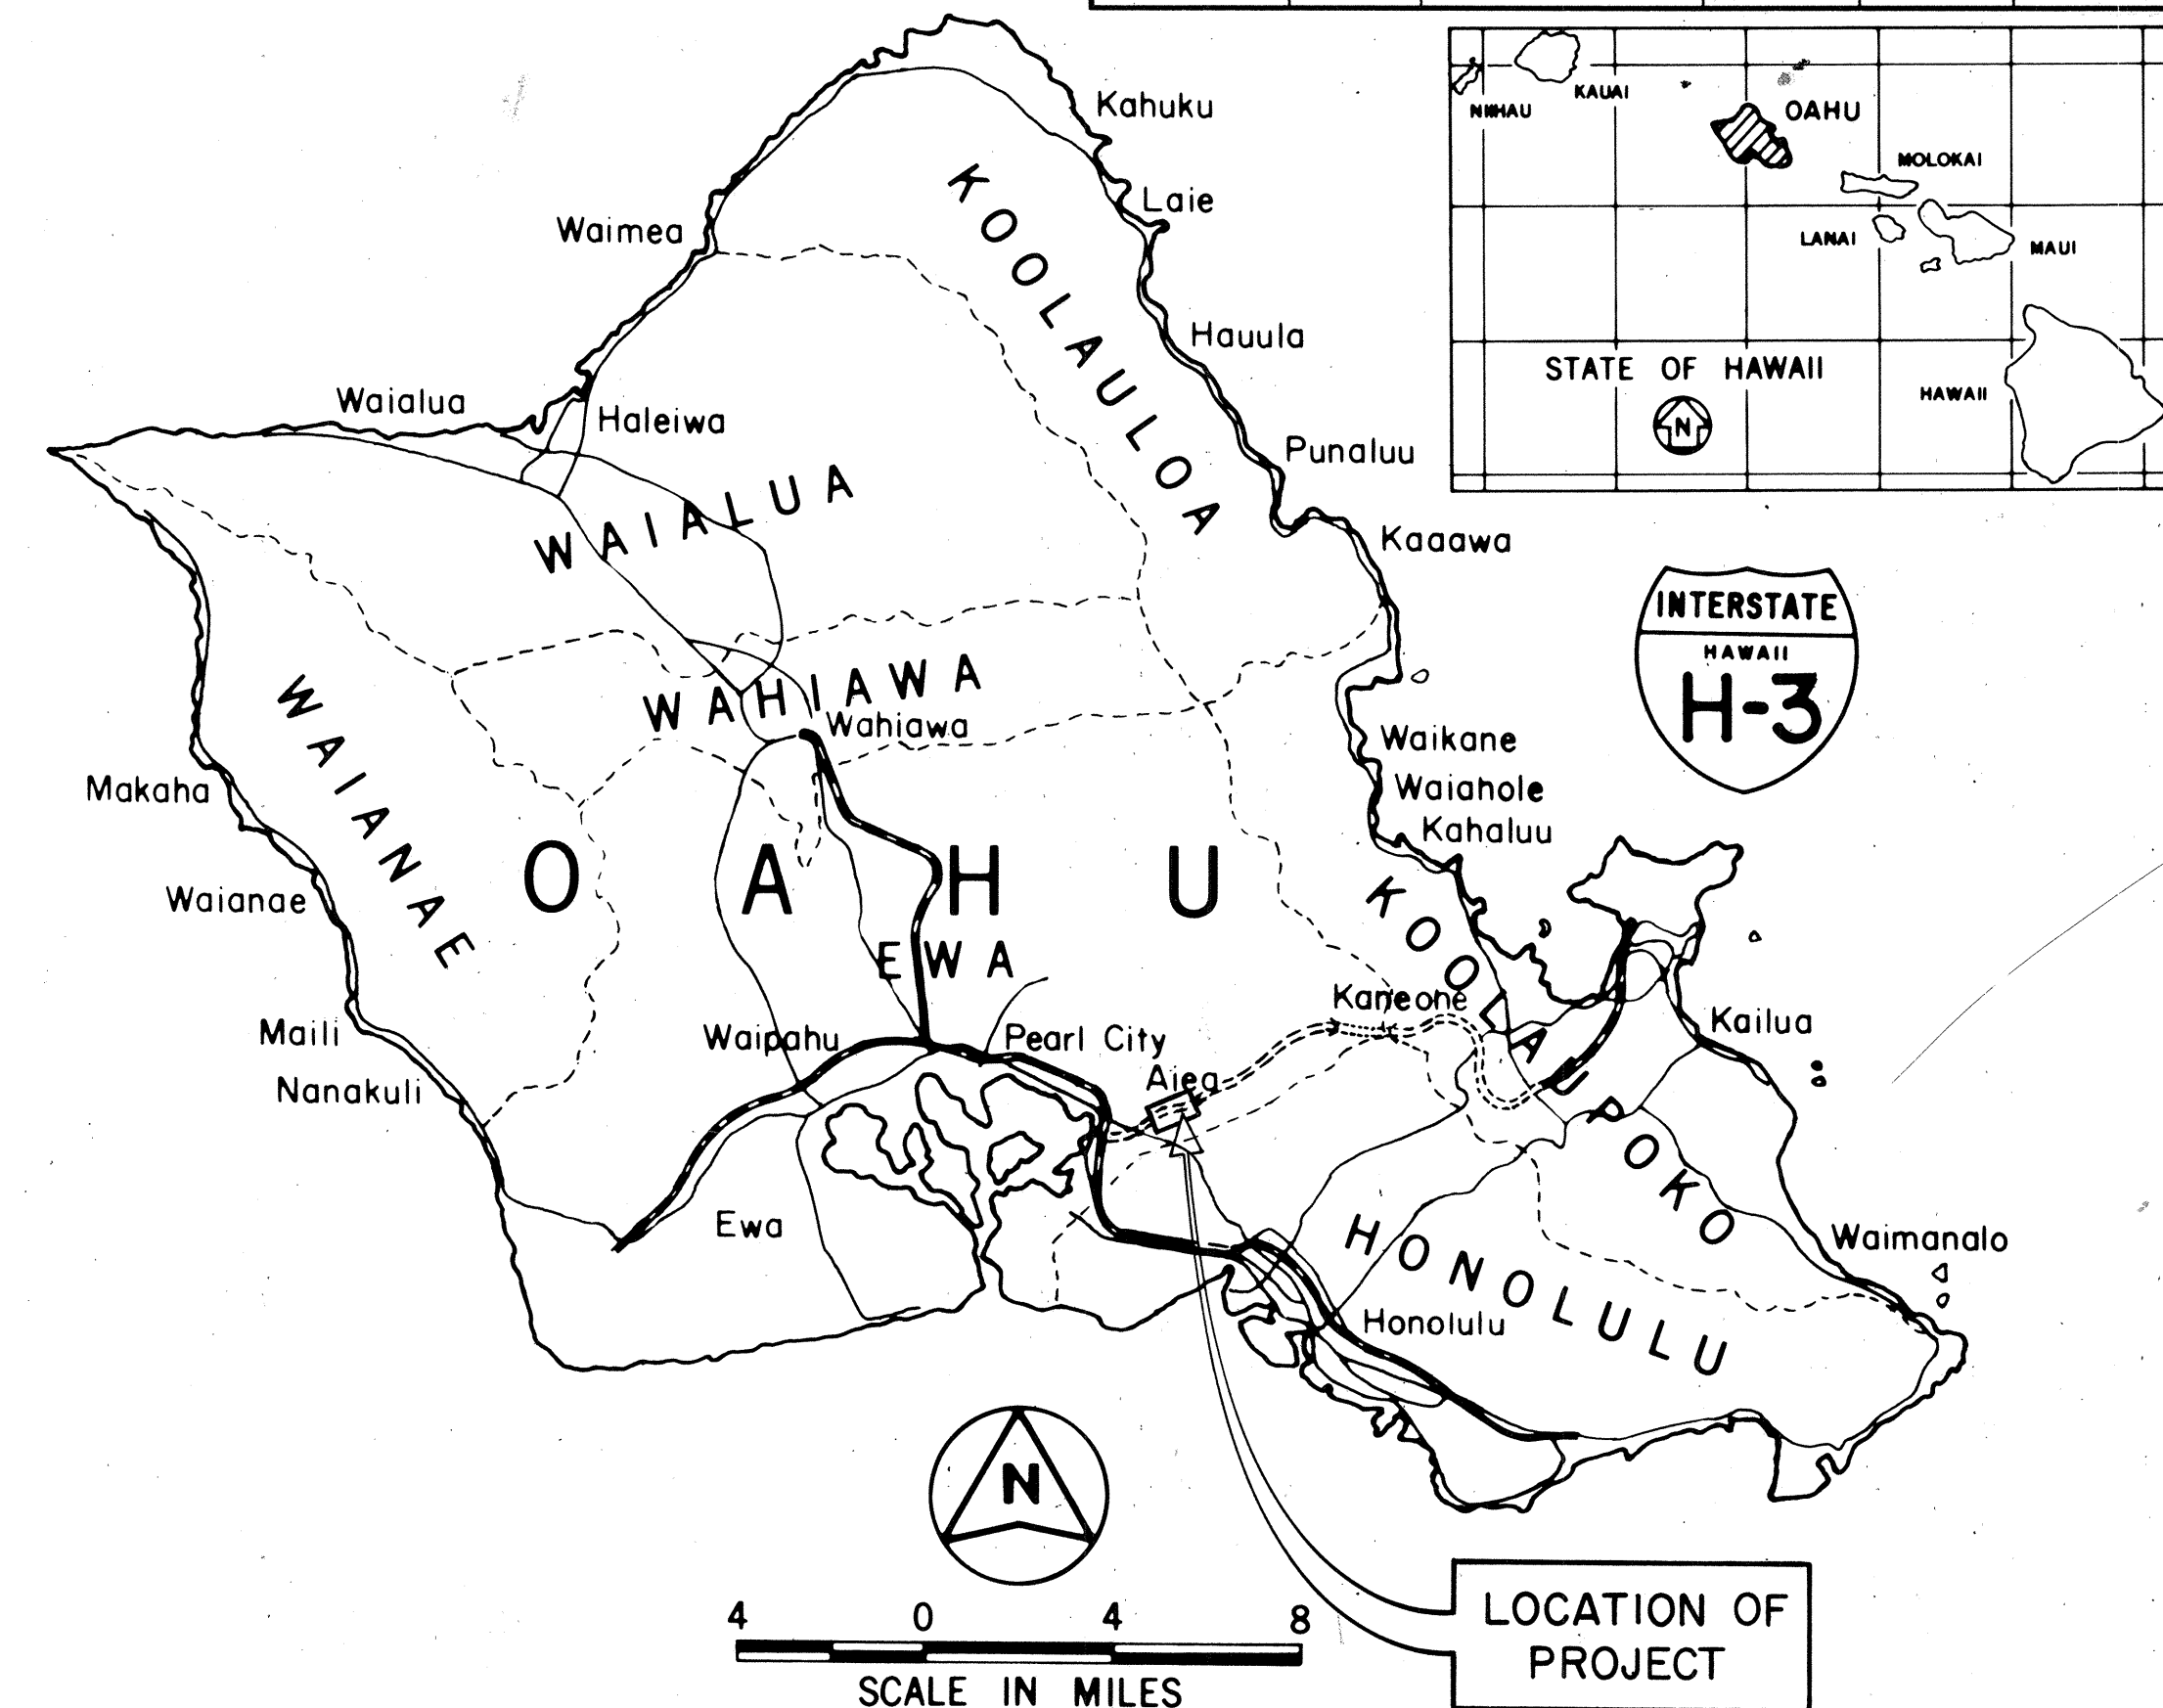

LAYOUT PLAN

END PROJECT
 STA. 415 + 00

BEGIN PROJECT
 STA. 374 + 25

LENGTH OF PROJECT = 0.77 MILE

1/2 0 1/2 1
 SCALE IN MILES

DEPARTMENT OF TRANSPORTATION
 FEDERAL HIGHWAY ADMINISTRATION
 APPROVED:
W. H. H. H. 6/15/93
 DIVISION ADMINISTRATOR DATE

DEPARTMENT OF TRANSPORTATION
 STATE OF HAWAII
 APPROVED:
H. H. H. 4/9/93
 DIR. OF TRANSPORTATION DATE