



FED. ROAD DIST. NO.	STATE	PROJ. NO.	FISCAL YEAR	SHEET NO.	TOTAL SHEETS
HAWAII	HAW.	I-H3-1(68)	1994	39	470

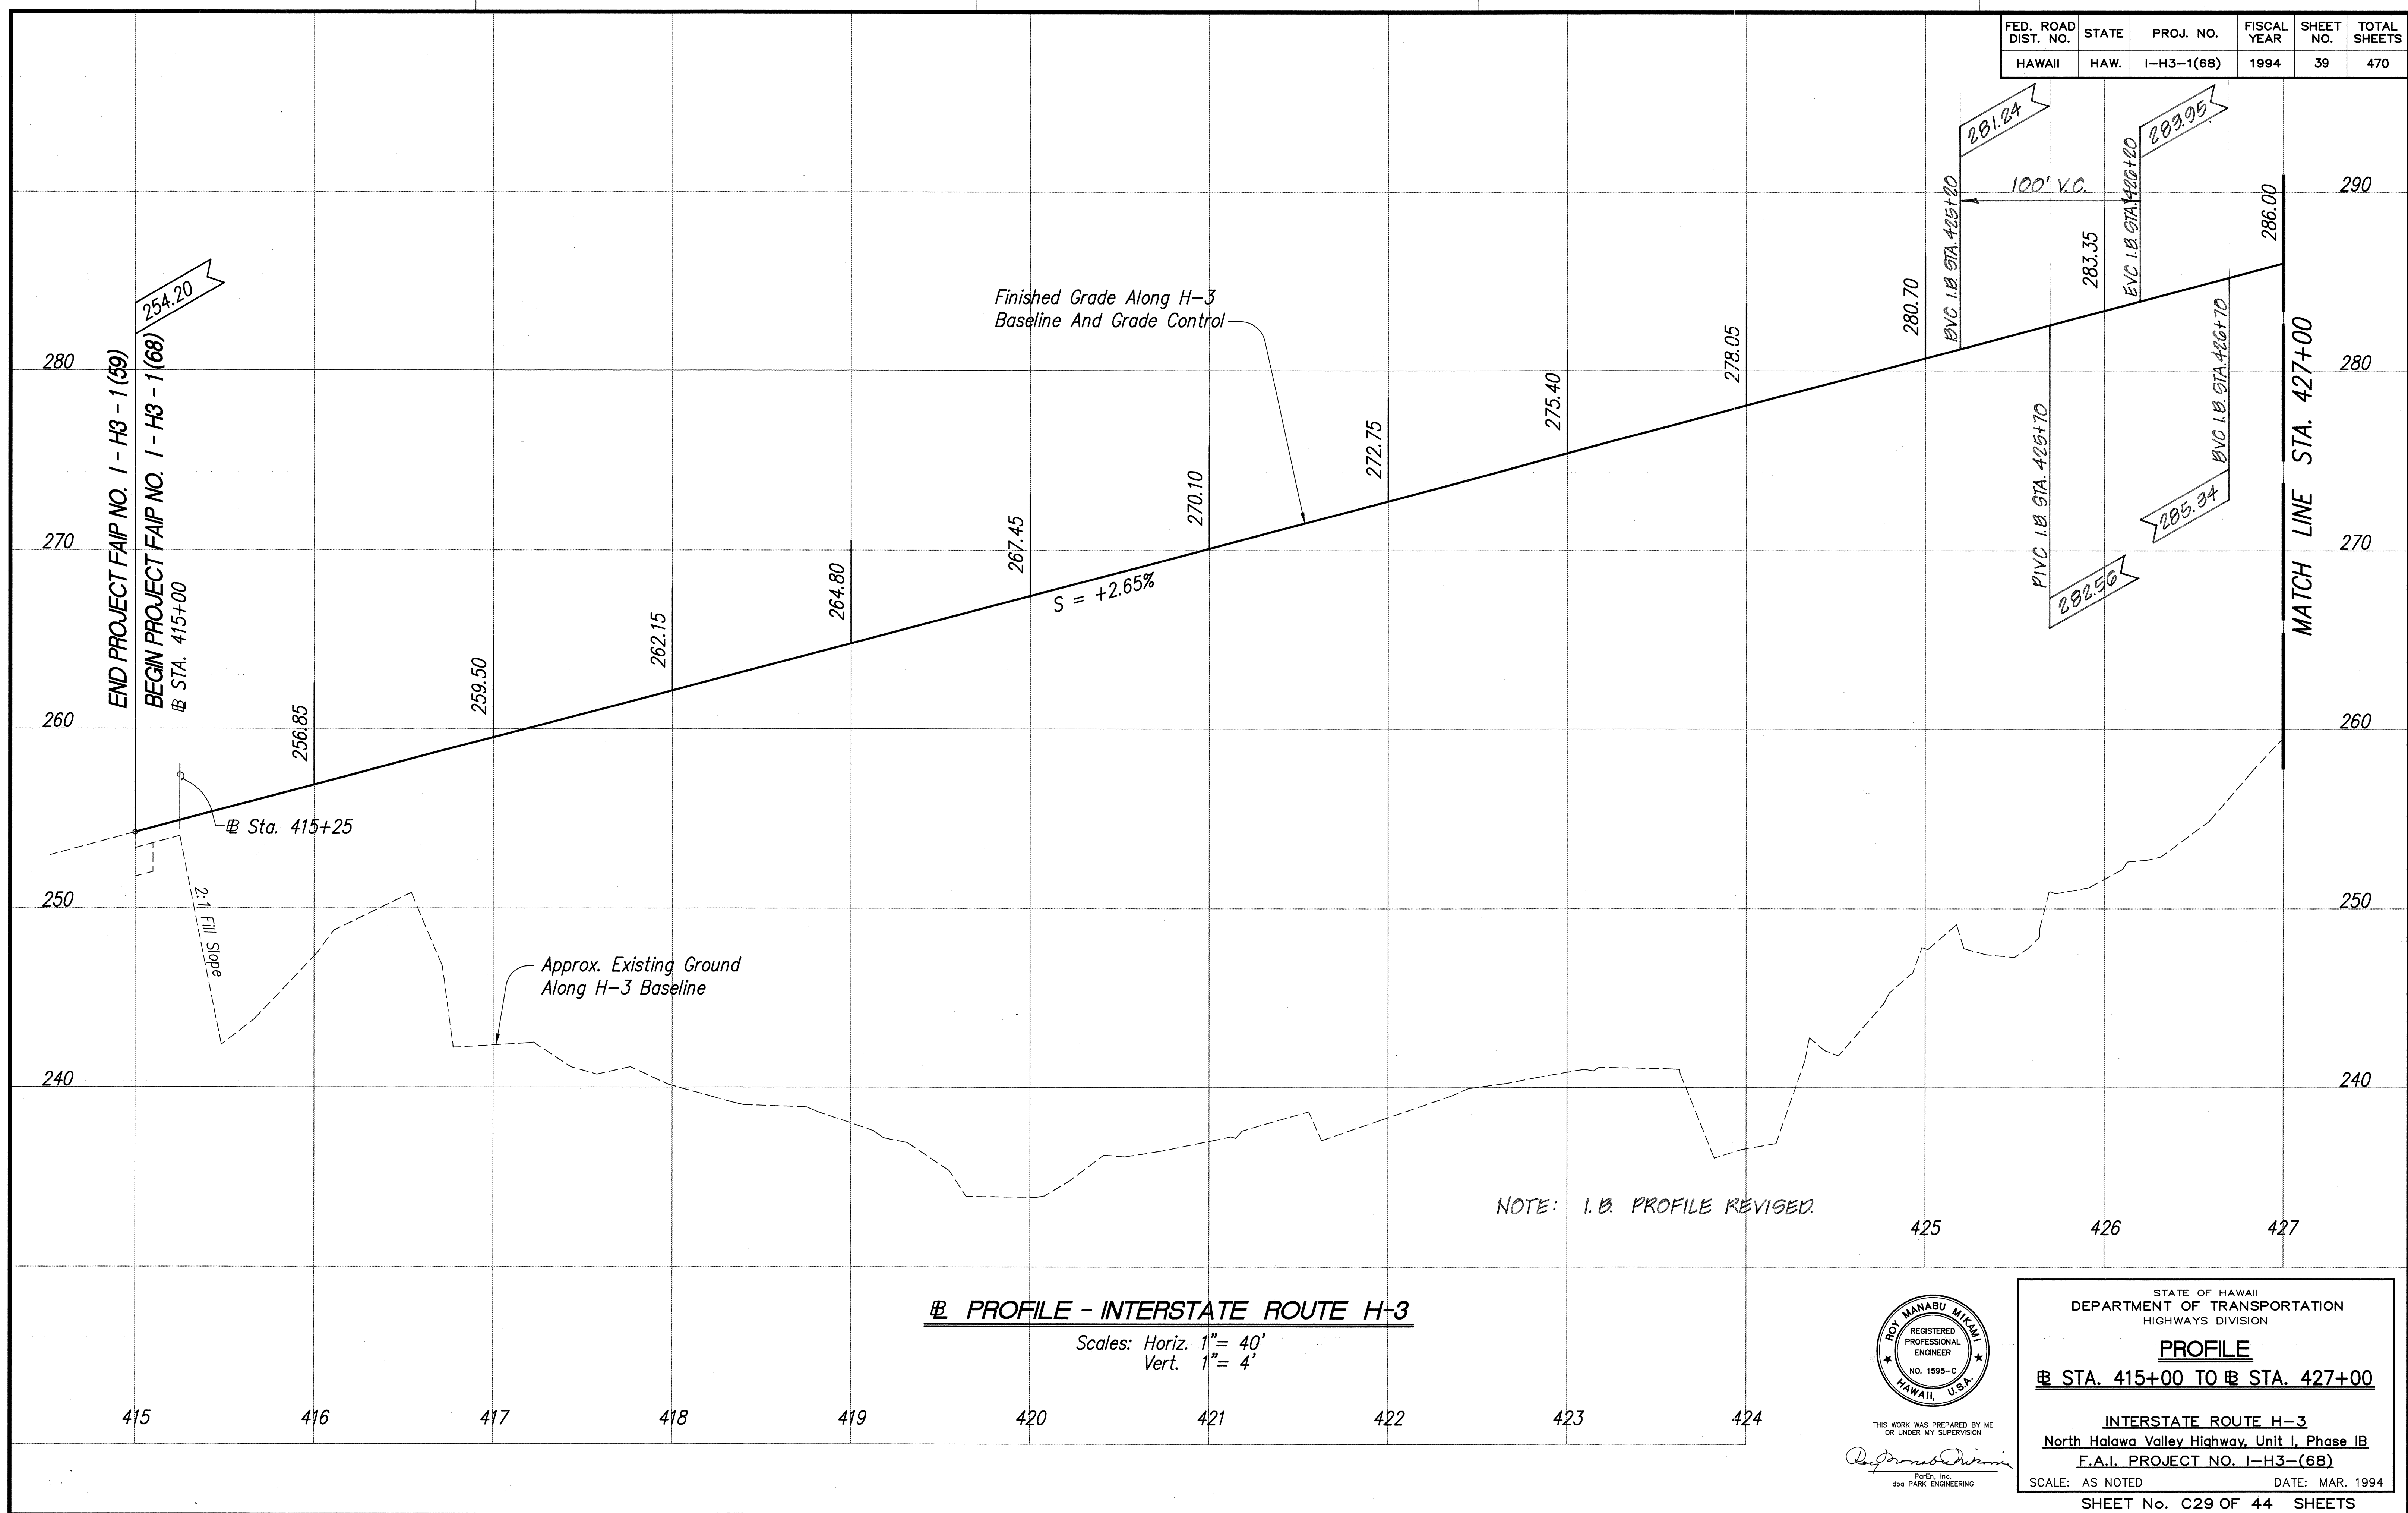

SURVEY PLOTTED BY	DATE
DESIGNED BY	
TRACED BY	
NOTE BOOK	
QUANTITIES BY	
CHECKED BY	

PROFILE - INTERSTATE ROUTE H-3

Scales: Horiz. 1" = 40'
 Vert. 1" = 4'

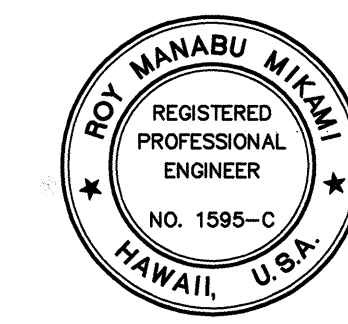

THIS WORK WAS PREPARED BY ME
 OR UNDER MY SUPERVISION
 Roy Manabu Mikami
 Poreh, Inc.
 480 PARK ENGINEERING

STATE OF HAWAII
 DEPARTMENT OF TRANSPORTATION
 HIGHWAYS DIVISION


PROFILE
 STA. 415+00 TO STA. 427+00

INTERSTATE ROUTE H-3
 North Halawa Valley Highway, Unit I, Phase IB
 F.A.I. PROJECT NO. I-H3-(68)


SCALE: AS NOTED DATE: MAR. 1994

SHEET No. C29 OF 44 SHEETS

FED. ROAD DIST. NO.	STATE	PROJ. NO.	FISCAL YEAR	SHEET NO.	TOTAL SHEETS
HAWAII	HAW.	I-H3-1(68)	1994	40	470

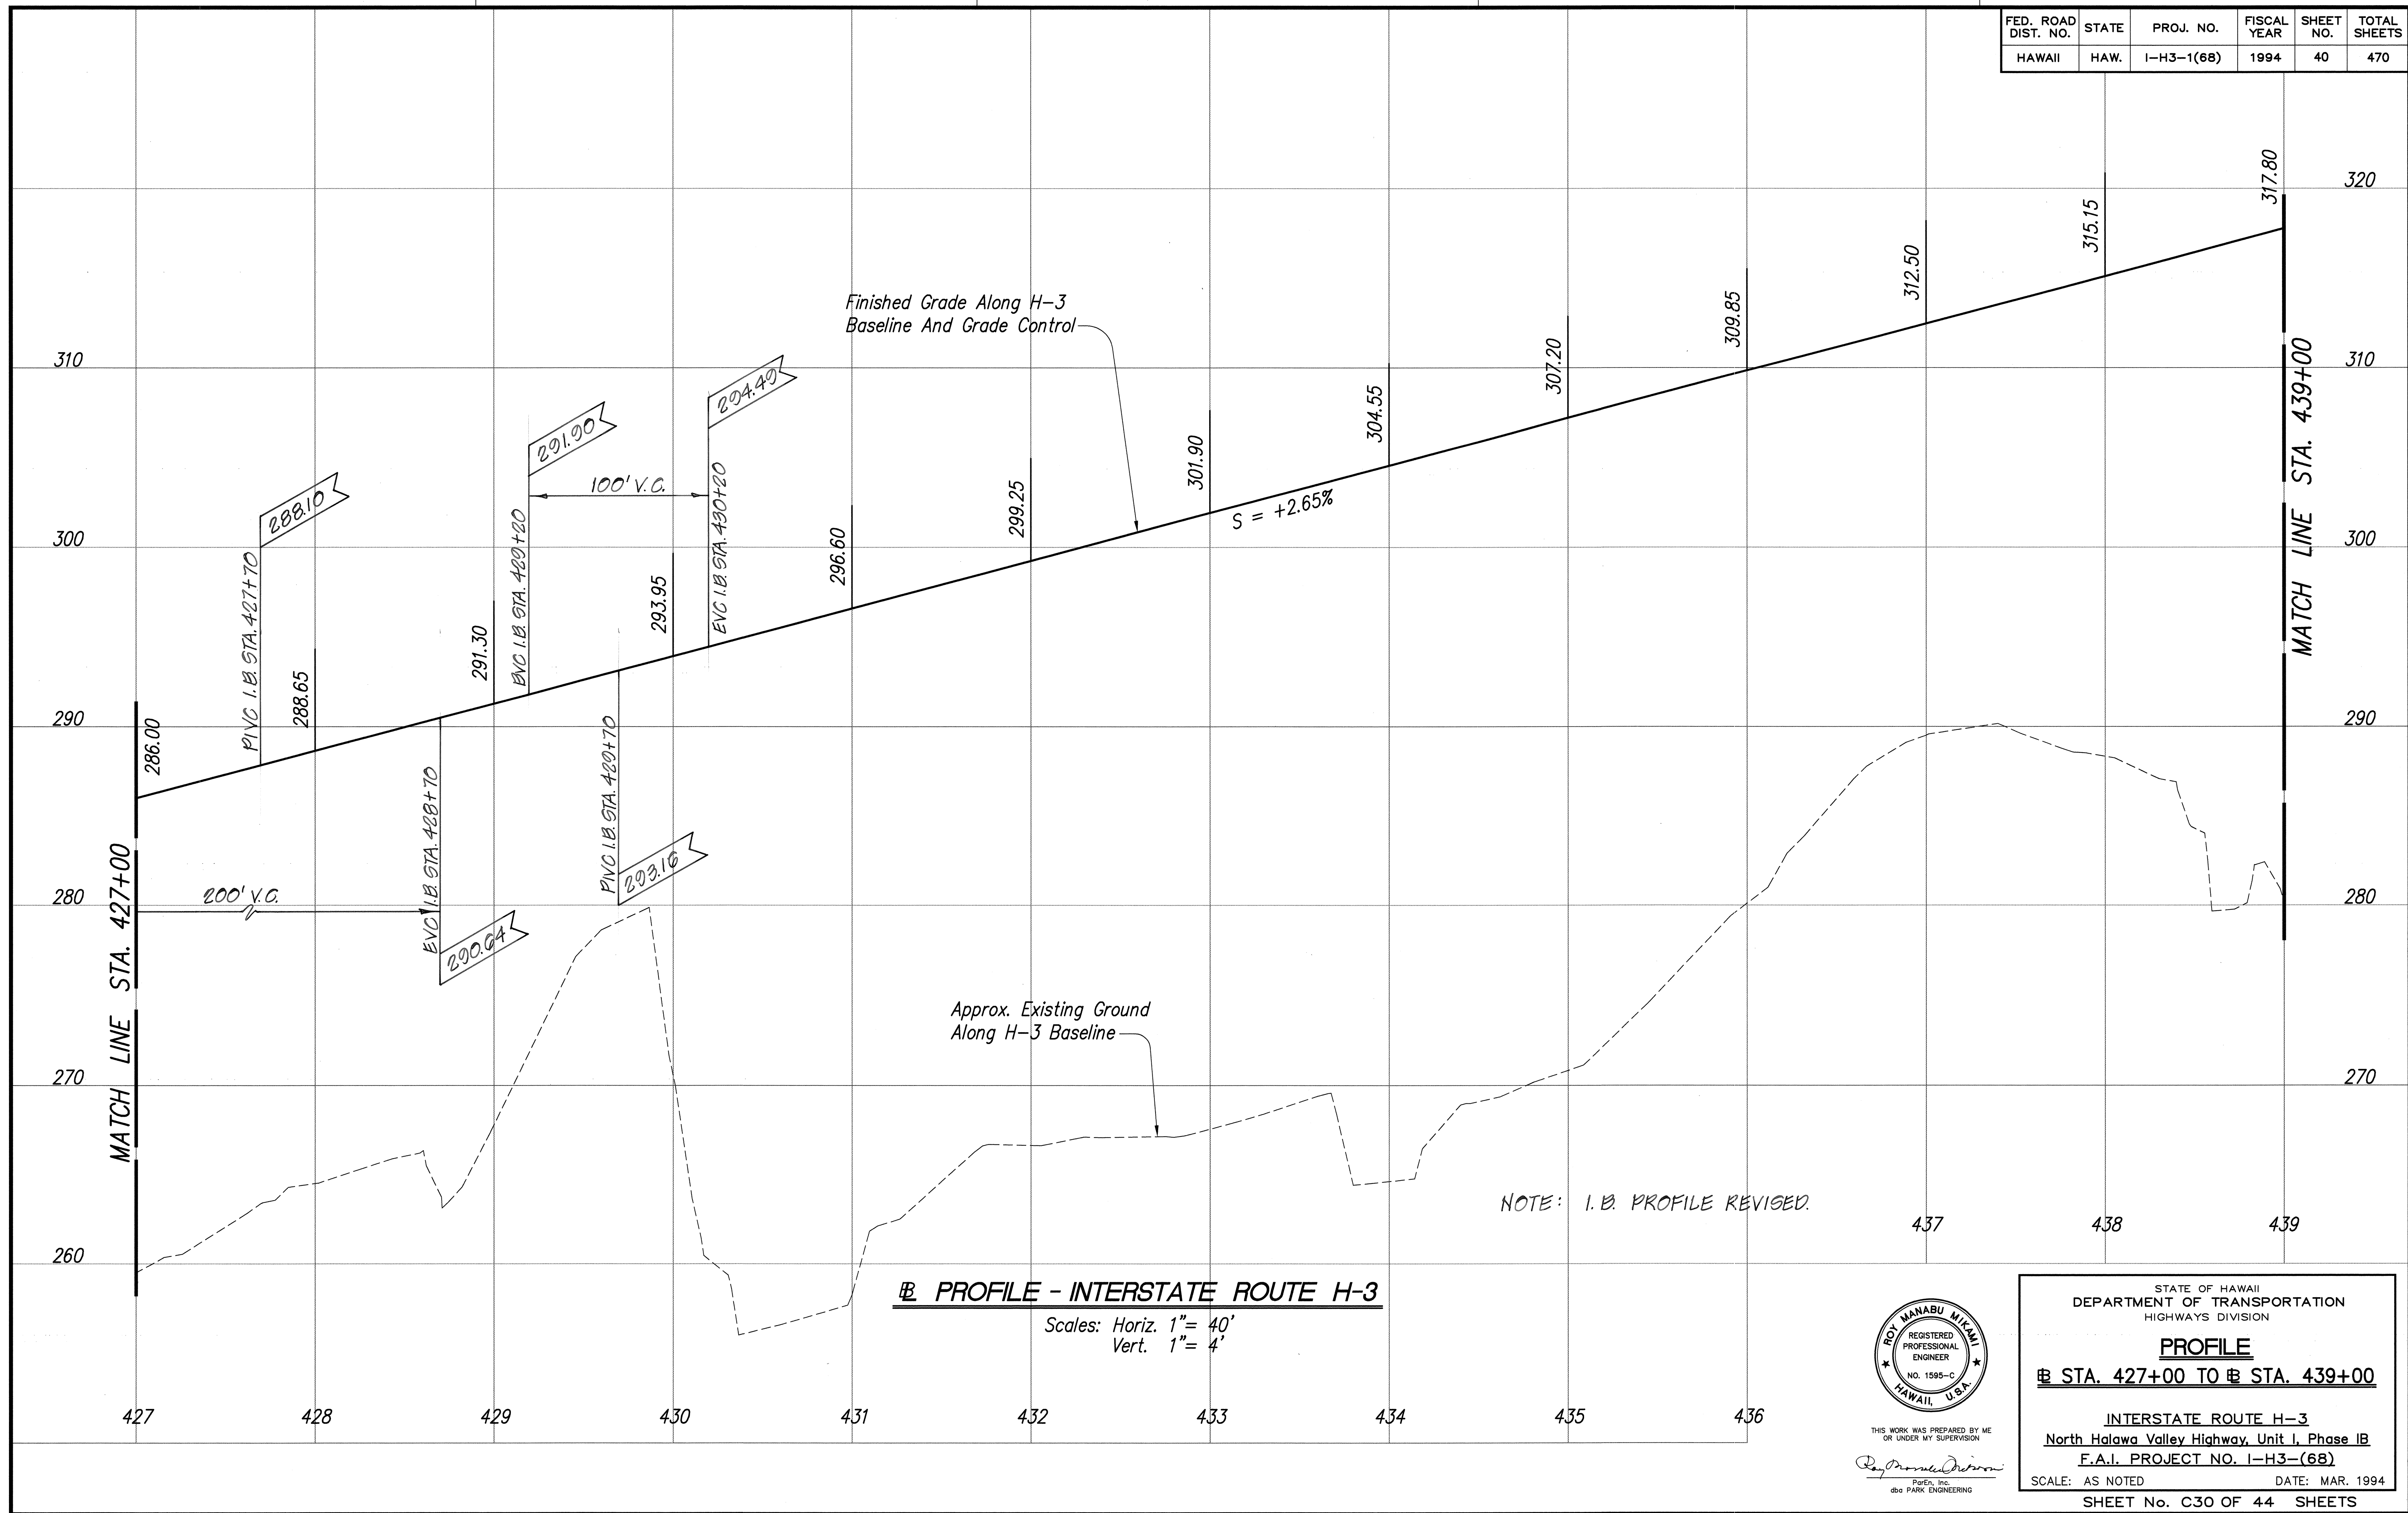


ORIGINAL PLAN	DATE
DESIGNED BY	
NOTED BY	
CHECKED BY	
QUANTITIES BY	
NO.	

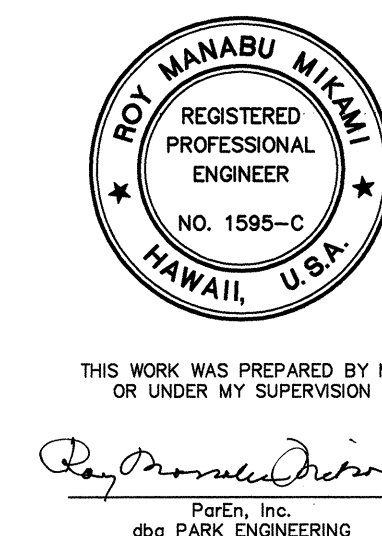

STATE OF HAWAII
DEPARTMENT OF TRANSPORTATION
HIGHWAYS DIVISION
PROFILE
STA. 427+00 TO STA. 439+00
INTERSTATE ROUTE H-3
North Halawa Valley Highway, Unit I, Phase IB
F.A.I. PROJECT NO. I-H3-(68)
SCALE: AS NOTED
DATE: MAR. 1994
SHEET No. C30 OF 44 SHEETS

FED. ROAD DIST. NO.	STATE	PROJ. NO.	FISCAL YEAR	SHEET NO.	TOTAL SHEETS
HAWAII	HAW.	I-H3-1(68)	1994	41	470

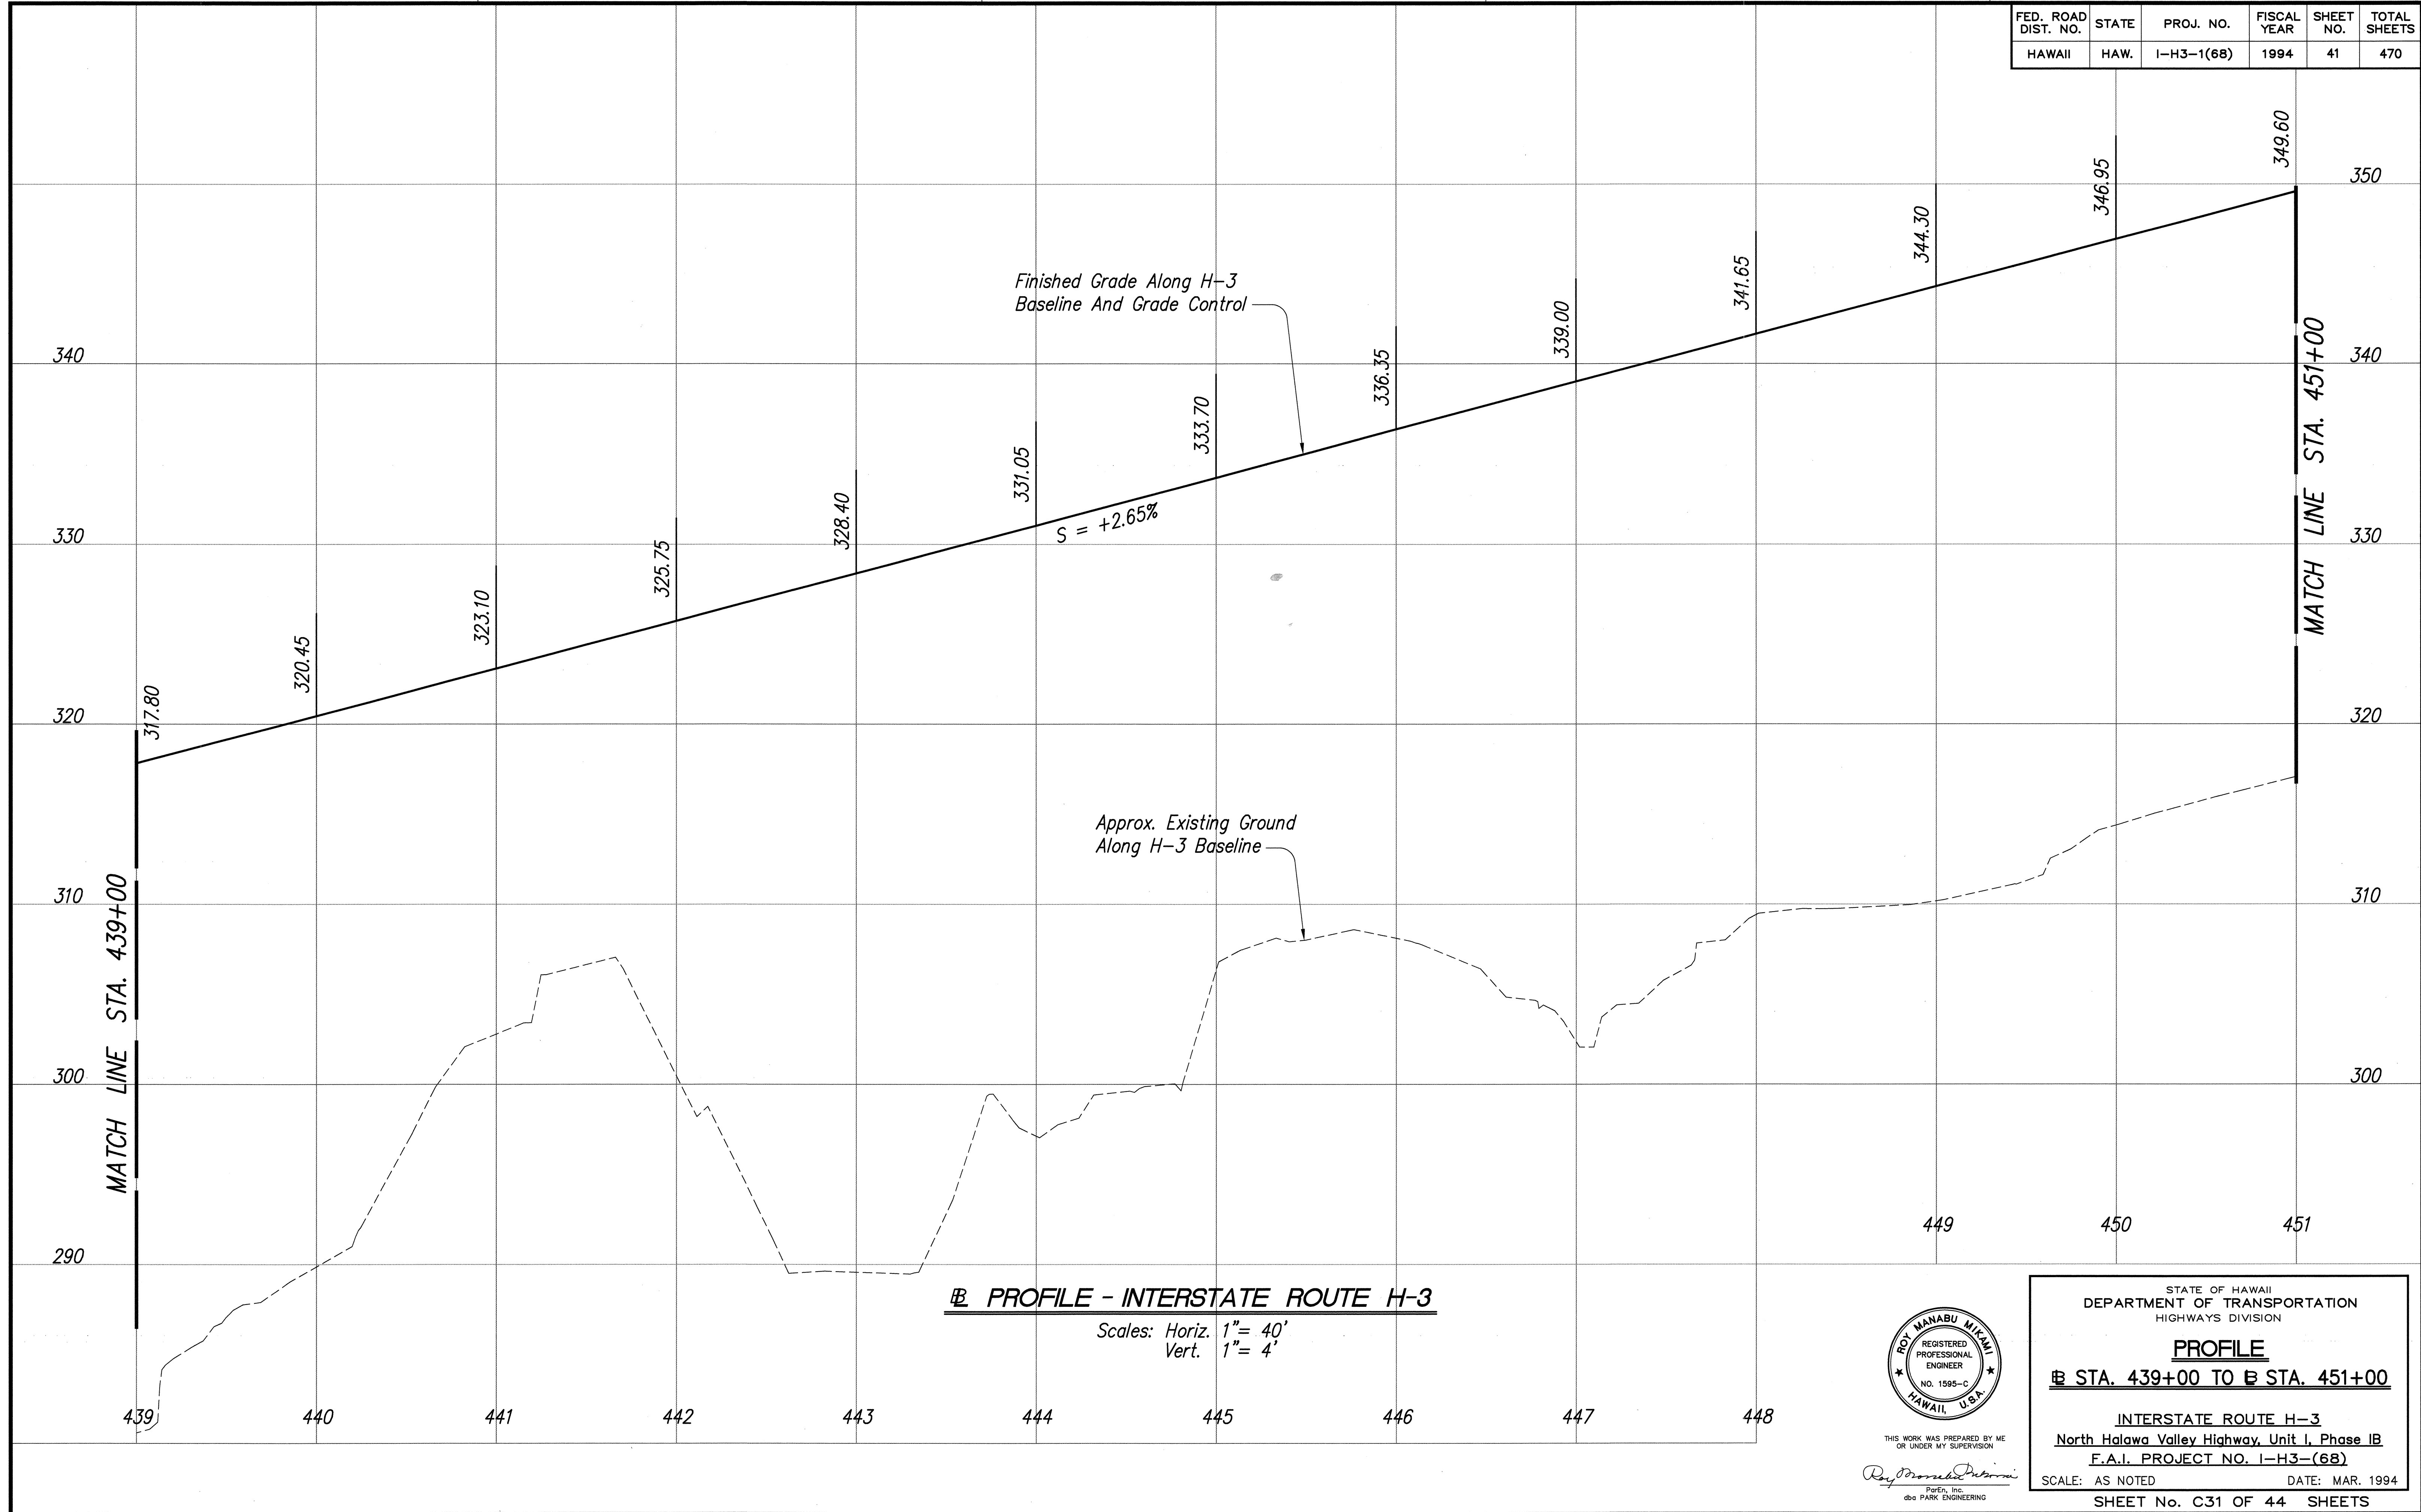

SURVEY PLOTTED BY	DATE
DESIGNED BY	
NOTED BY	
CHECKED BY	
NO.	

PROFILE - INTERSTATE ROUTE H-3

Scales: Horiz. 1"= 40'
Vert. 1"= 4'



THIS WORK WAS PREPARED BY ME
OR UNDER MY SUPERVISION
Roy Manabu Mikami
P.E., Inc.
dba PARK ENGINEERING


STATE OF HAWAII
DEPARTMENT OF TRANSPORTATION
HIGHWAYS DIVISION

PROFILE
STA. 439+00 TO STA. 451+00
INTERSTATE ROUTE H-3
North Halawa Valley Highway, Unit I, Phase IB
F.A.I. PROJECT NO. I-H3-(68)
SCALE: AS NOTED DATE: MAR. 1994
SHEET No. C31 OF 44 SHEETS

NOTED: BASE PT. 0.0

LIB: STATE/007-V-3V-0301
PROG-3 3/19/94 RSO

FED. ROAD DIST. NO.	STATE	PROJ. NO.	FISCAL YEAR	SHEET NO.	TOTAL SHEETS
HAWAII	HAW.	I-H3-1(68)	1994	42	470

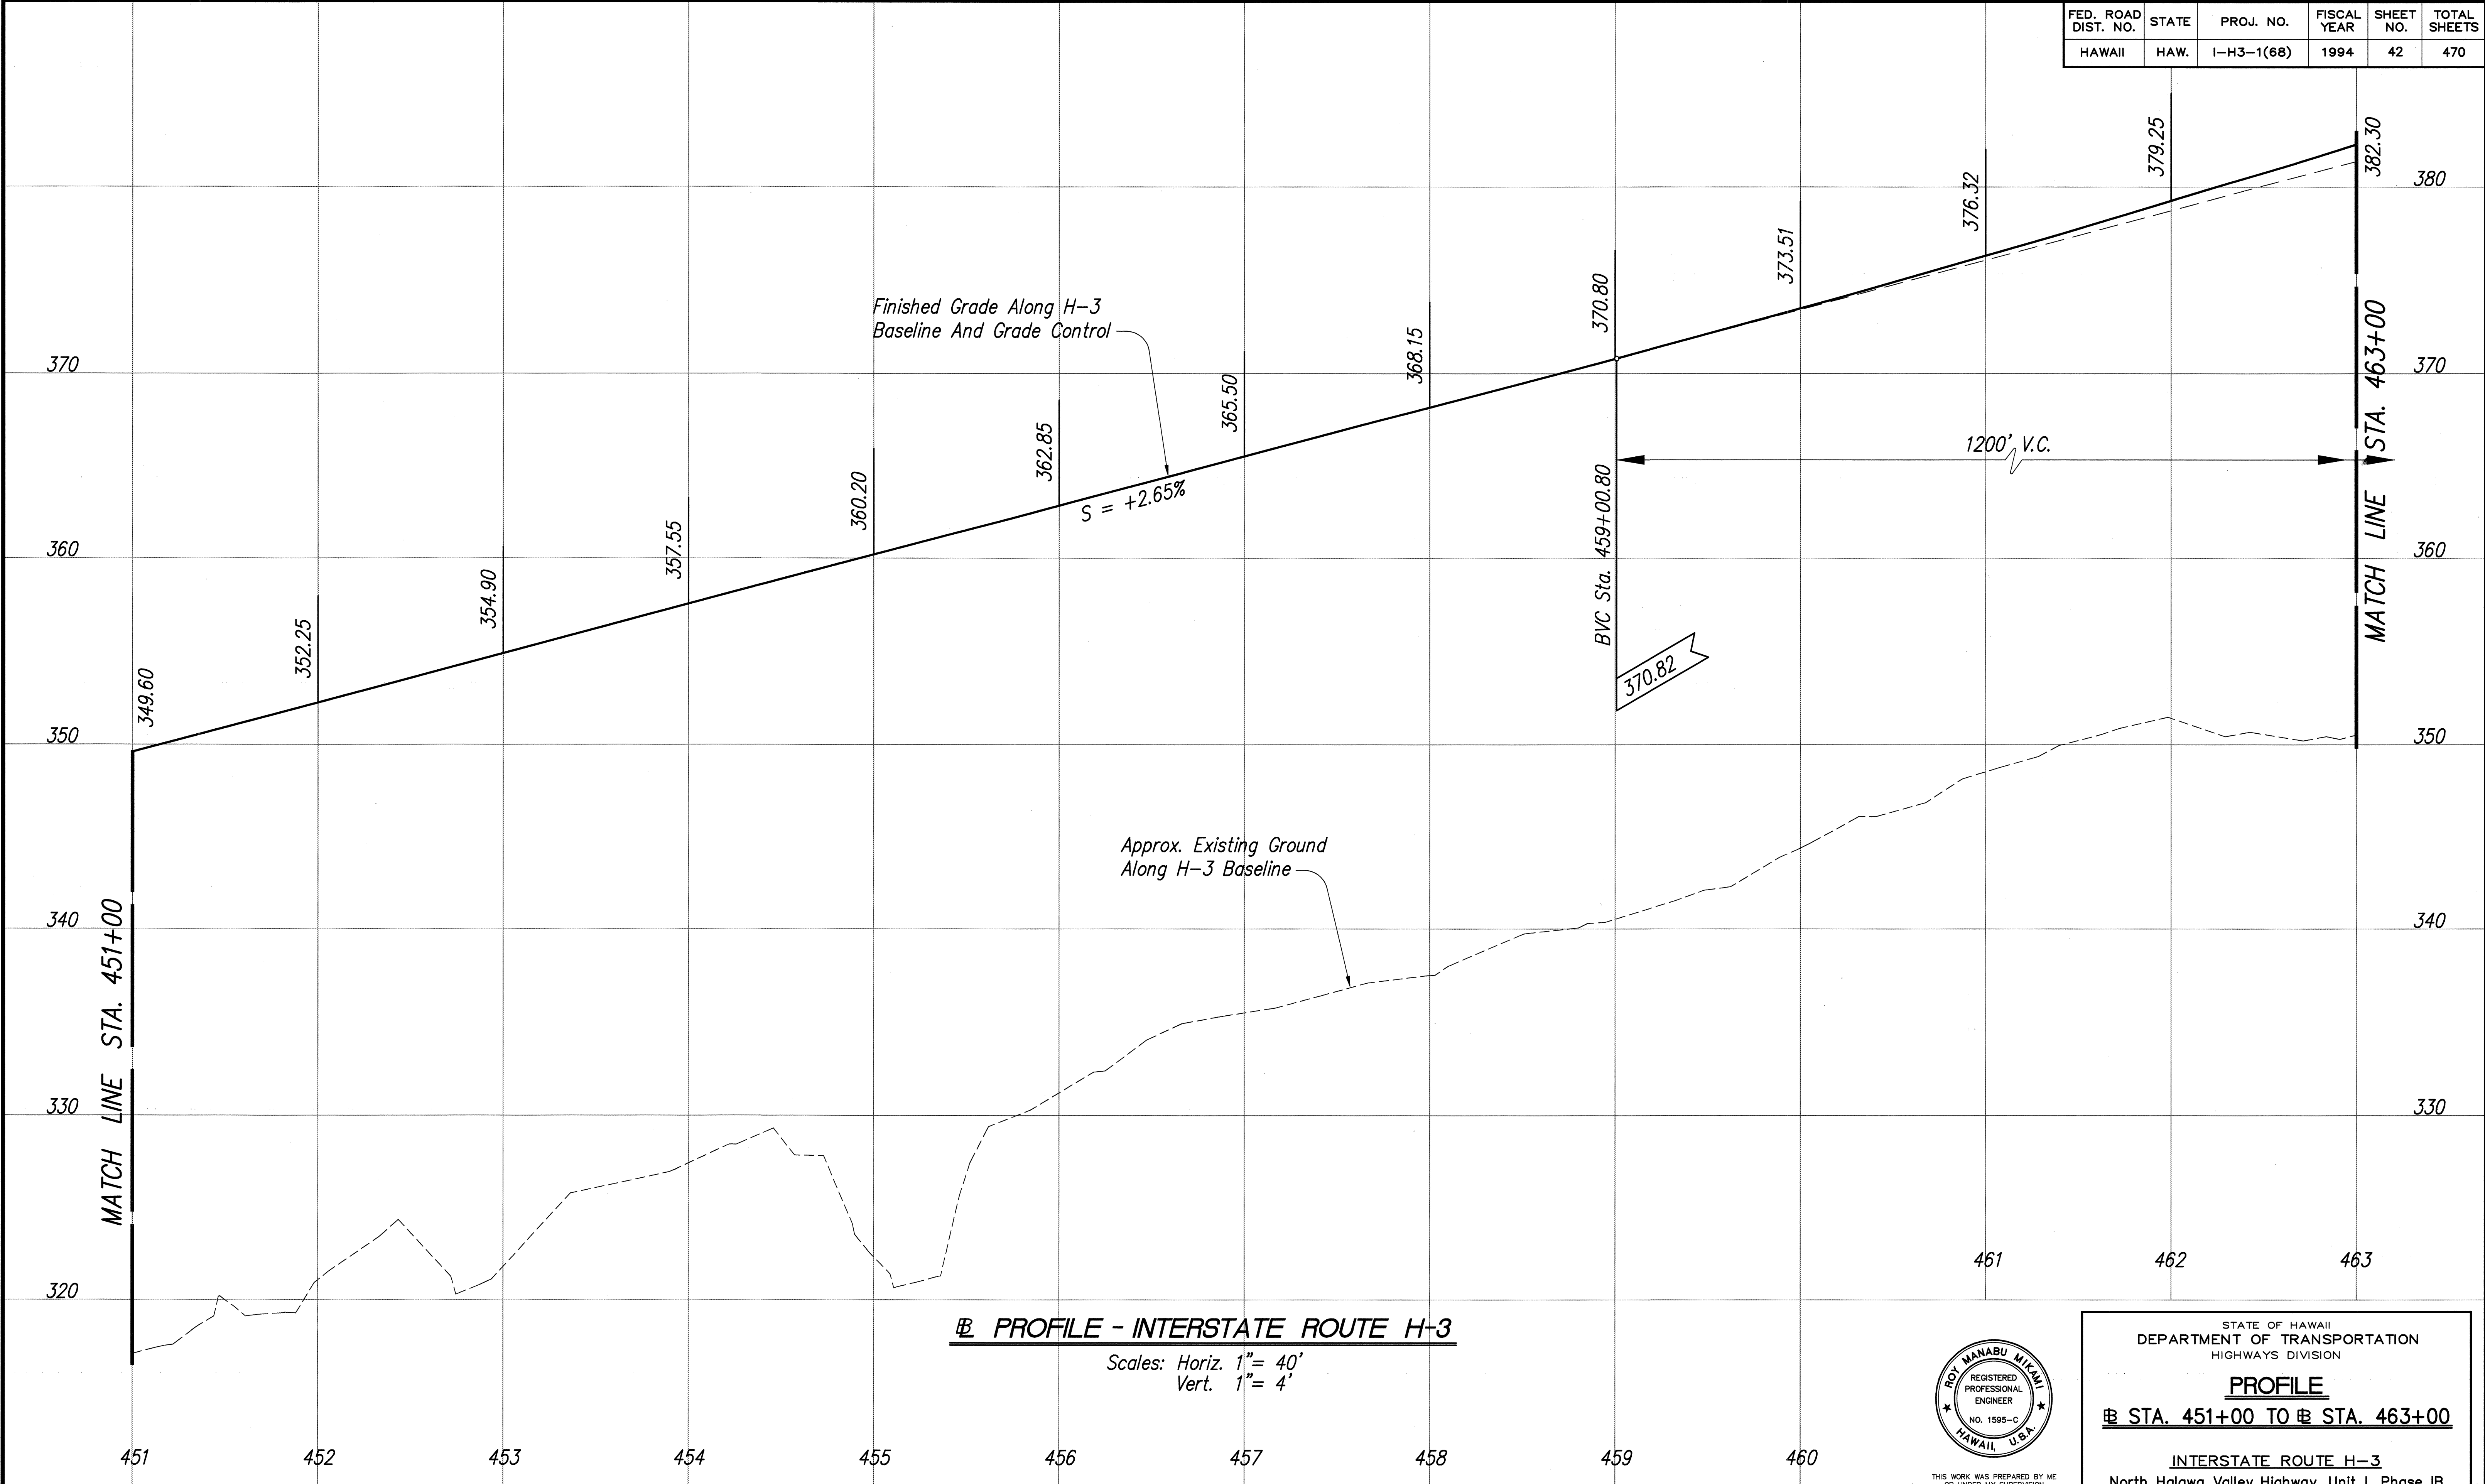

SURVEY PLOTTED BY	DATE
DESIGNED BY	
NOTED BY	
CHECKED BY	
NO.	

PROFILE - INTERSTATE ROUTE H-3

Scales: Horiz. 1" = 40'
Vert. 1" = 4'

ROY MANABU MIKAMI
REGISTERED PROFESSIONAL ENGINEER
NO. 1595-C
HAWAII, U.S.A.


THIS WORK WAS PREPARED BY ME OR UNDER MY SUPERVISION

[Signature]
P&E, Inc.
dbs PARK ENGINEERING

STATE OF HAWAII
DEPARTMENT OF TRANSPORTATION
HIGHWAYS DIVISION
PROFILE
STA. 451+00 TO STA. 463+00
INTERSTATE ROUTE H-3
North Halawa Valley Highway, Unit I, Phase IB
F.A.I. PROJECT NO. I-H3-(68)
SCALE: AS NOTED
DATE: MAR. 1994
SHEET No. C32 OF 44 SHEETS


LIB. STATE/DOOT/VL-344030V
PROJ-4 3/19/94 R30

FED. ROAD DIST. NO.	STATE	PROJ. NO.	FISCAL YEAR	SHEET NO.	TOTAL SHEETS
HAWAII	HAW.	I-H3-1(68)	1994	43	470

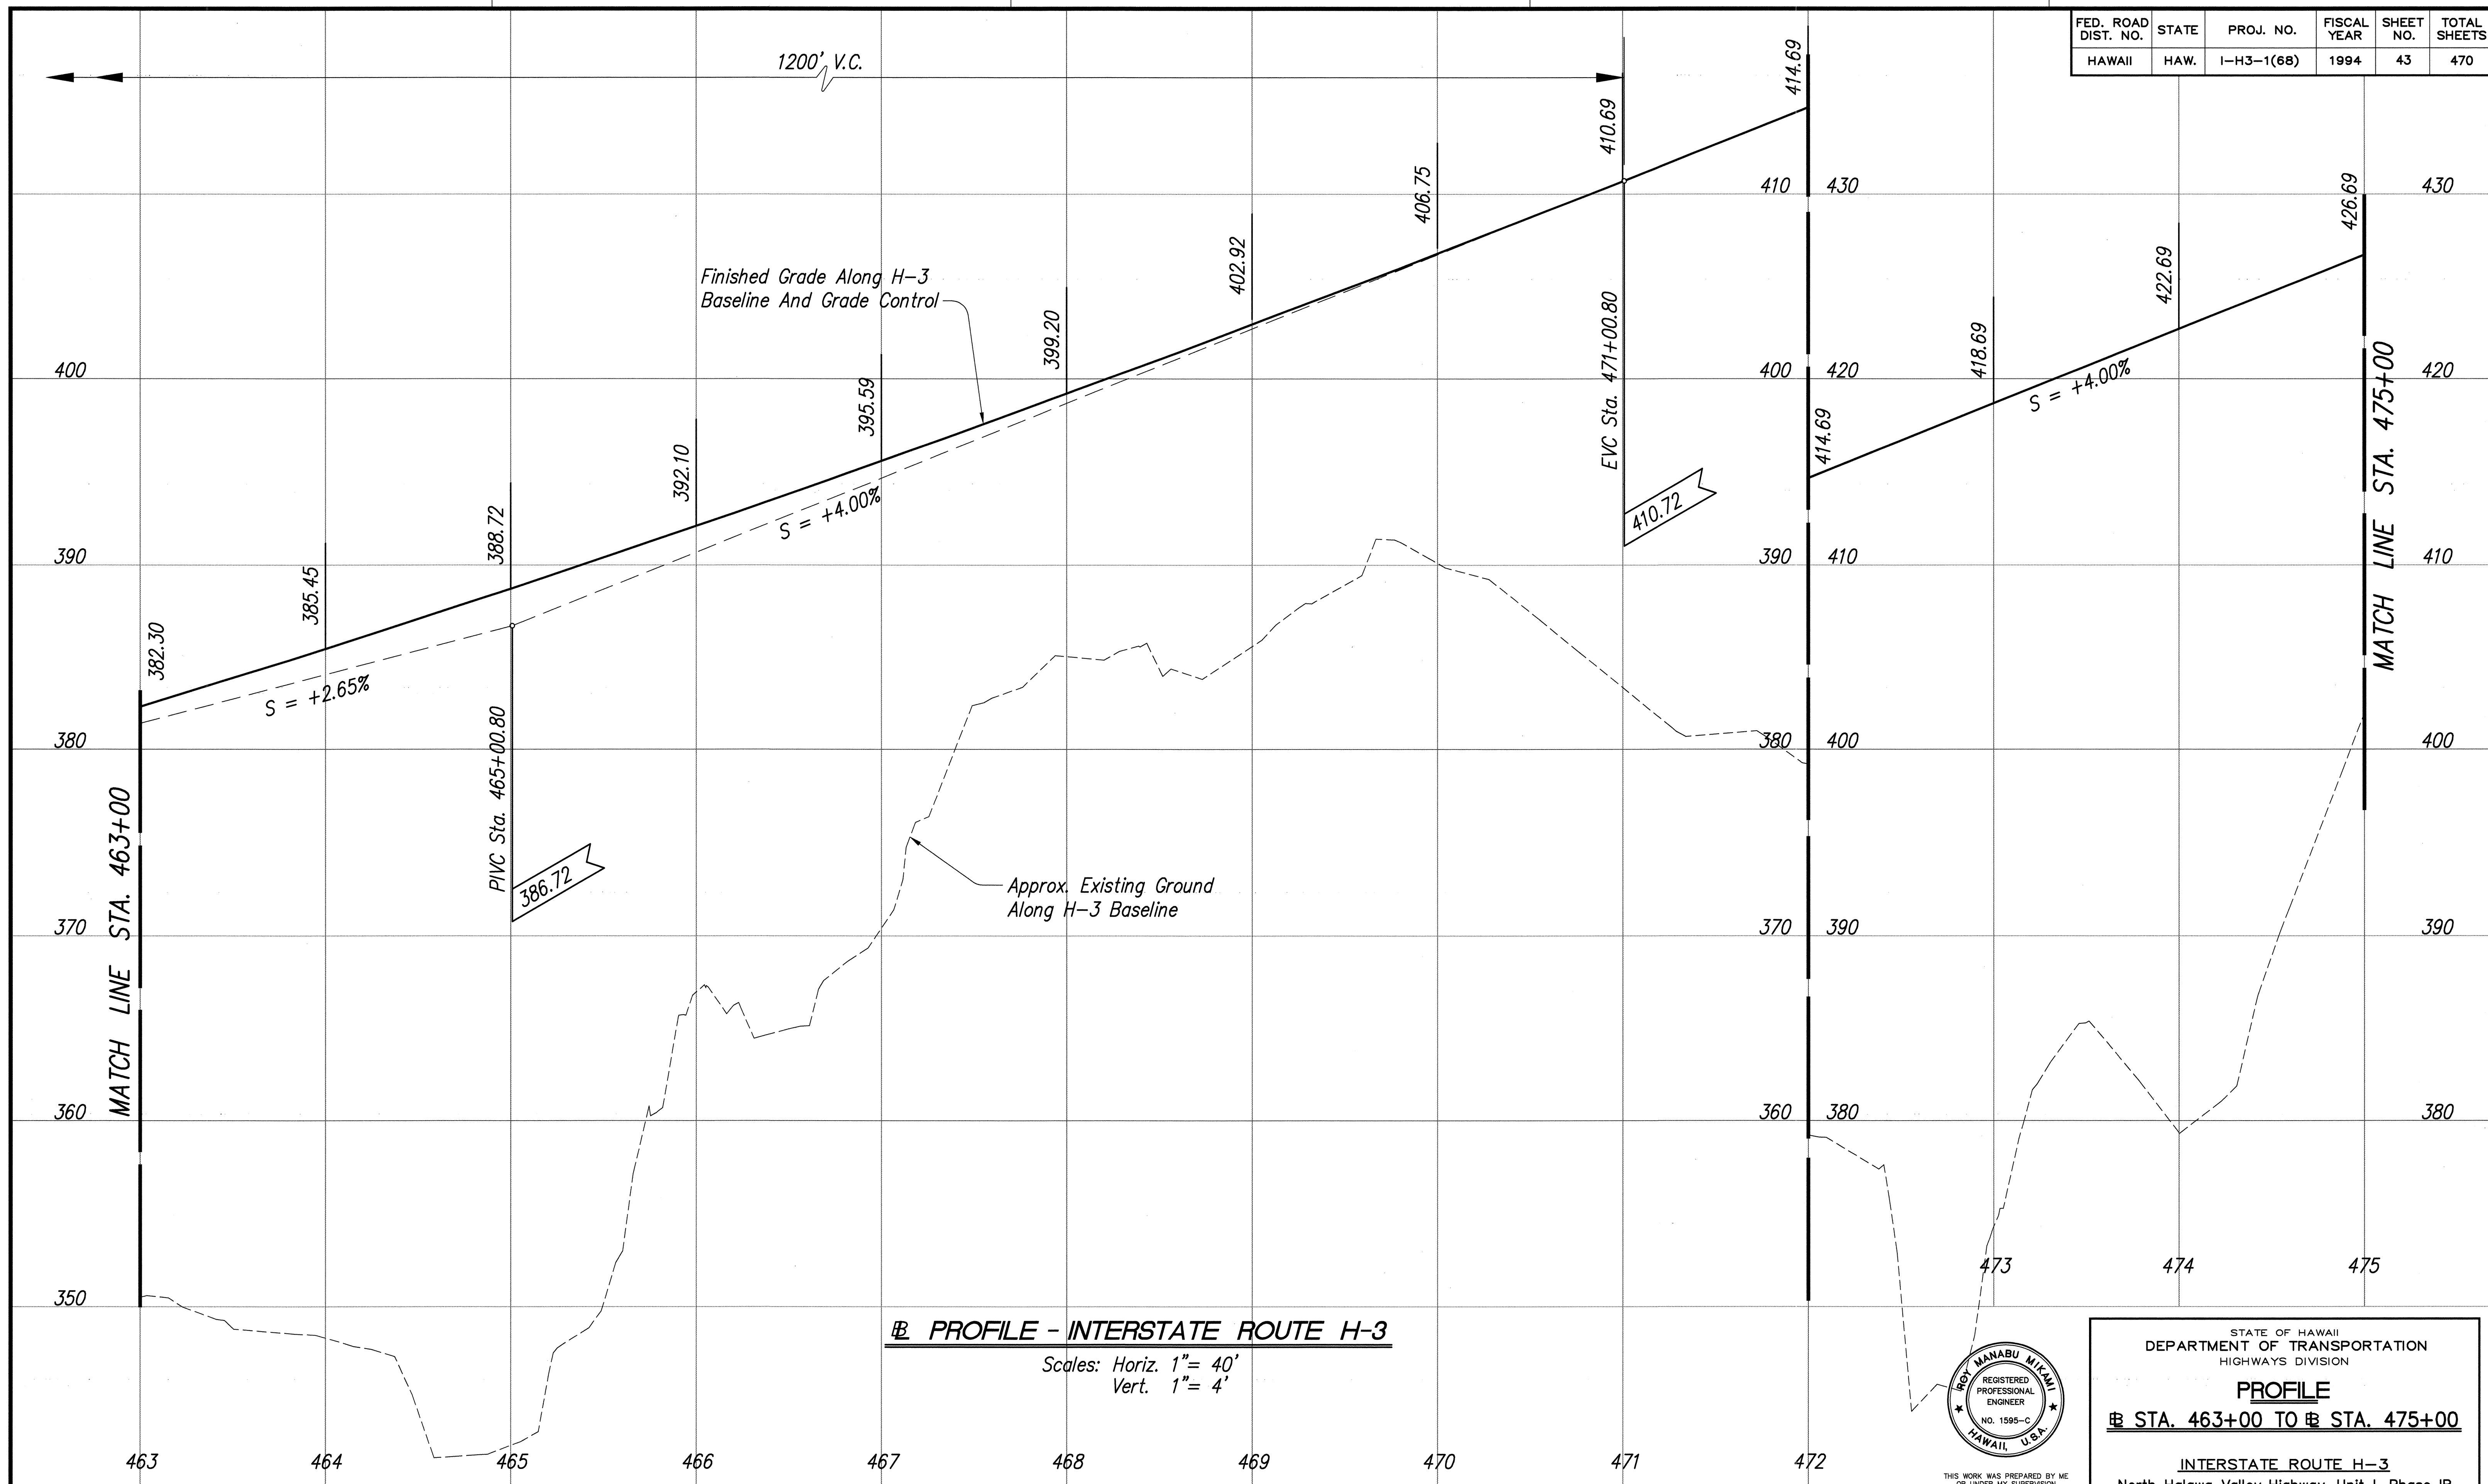

PROFILE - INTERSTATE ROUTE H-3

Scales: Horiz. 1" = 40'
Vert. 1" = 4'

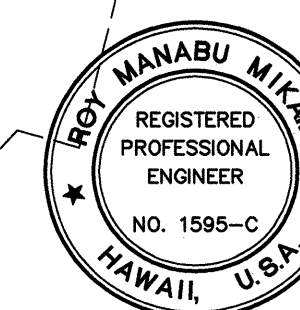

THIS WORK WAS PREPARED BY ME OR UNDER MY SUPERVISION


Roy Manabu Miyami
PerEn, Inc.
dba PARK ENGINEERING

STATE OF HAWAII
DEPARTMENT OF TRANSPORTATION
HIGHWAYS DIVISION

PROFILE
STA. 463+00 TO STA. 475+00

INTERSTATE ROUTE H-3
North Halawa Valley Highway, Unit I, Phase IB
F.A.I. PROJECT NO. I-H3-(68)
SCALE: AS NOTED DATE: MAR. 1994
SHEET No. C33 OF 44 SHEETS


FED. ROAD DIST. NO.	STATE	PROJ. NO.	FISCAL YEAR	SHEET NO.	TOTAL SHEETS
HAWAII	HAW.	I-H3-1(68)	1994	44	470

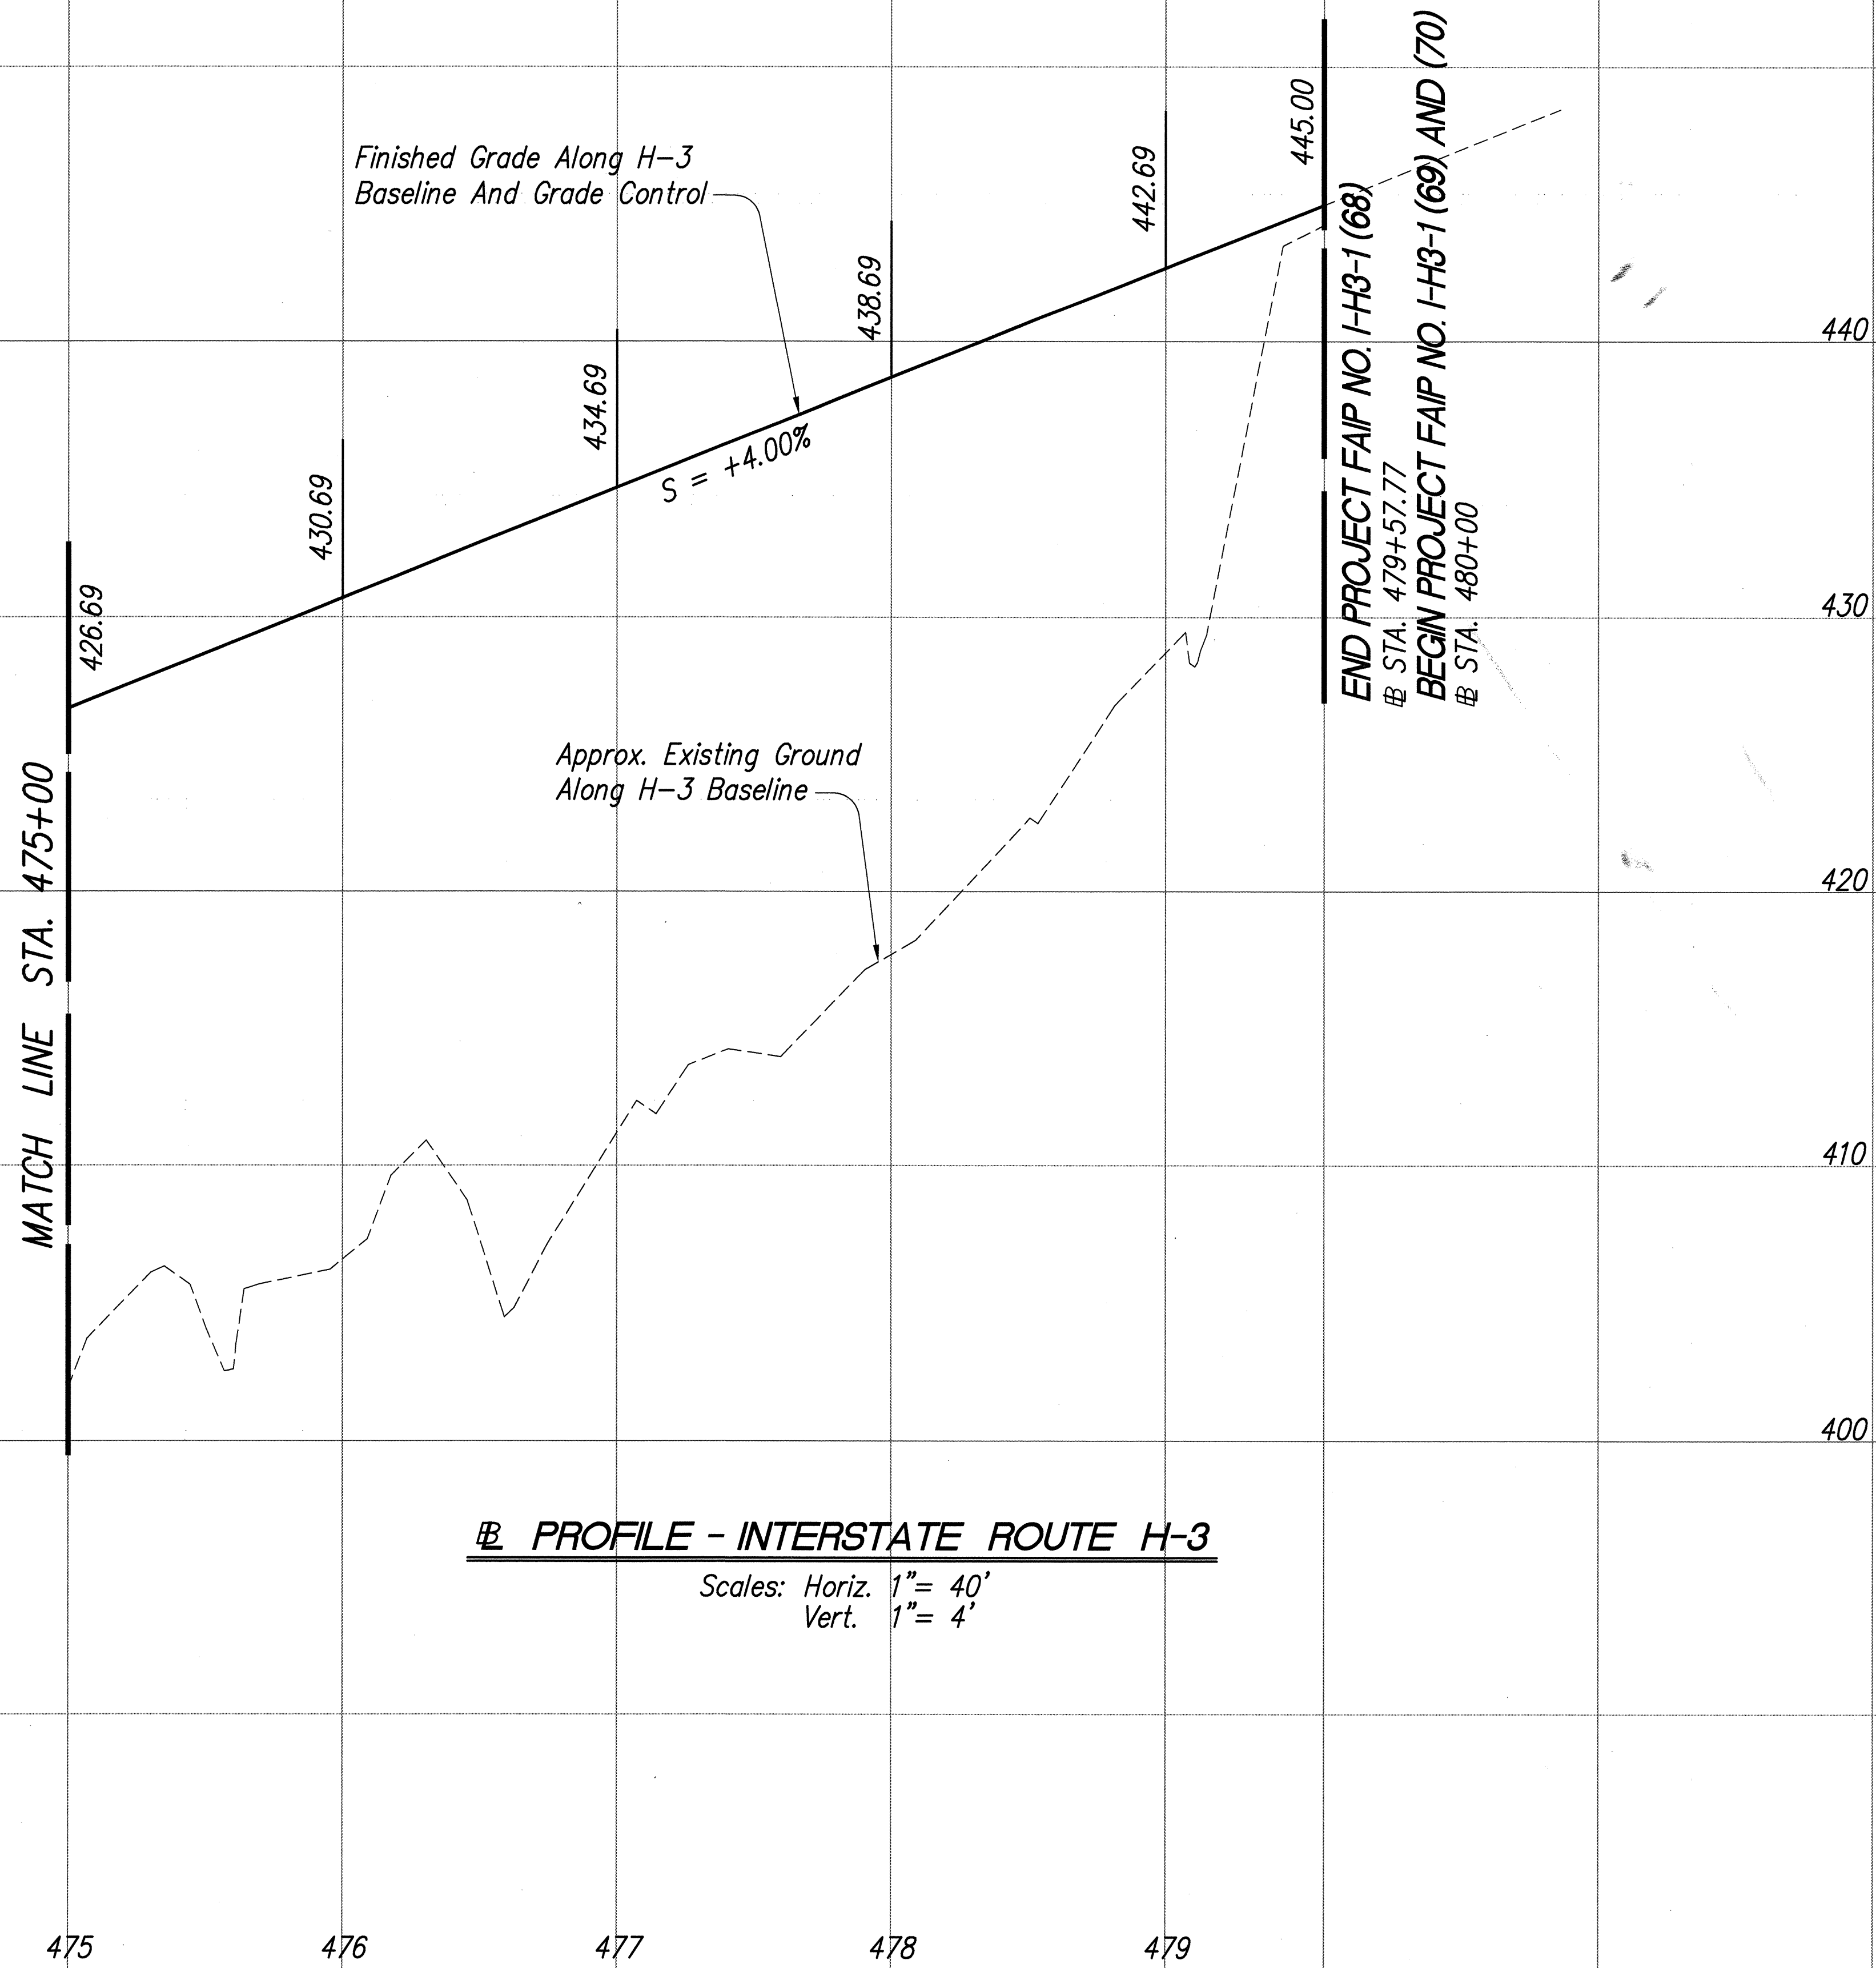

PROFILE - INTERSTATE ROUTE H-3

Scales: Horiz. 1" = 40'
Vert. 1" = 4'

DATE	____
SURVEY PLOTTED BY	____
DESIGNED BY	____
TRACED BY	____
NOTE BOOK	____
QUANTITIES BY	____
CHECKED BY	____
No.	____

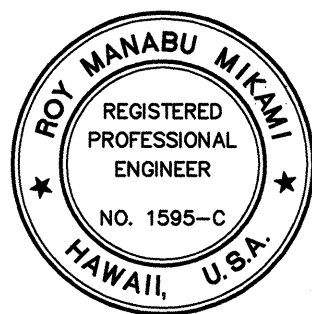

THIS WORK WAS PREPARED BY ME
OR UNDER MY SUPERVISION

Roy Manabu Mikami

Park, Inc.
200 PARK ENGINEERING


STATE OF HAWAII
DEPARTMENT OF TRANSPORTATION
HIGHWAYS DIVISION

PROFILE
B STA. 475+00 TO B STA. 479+57.77


INTERSTATE ROUTE H-3
North Halawa Valley Highway, Unit I, Phase IB
F.A.I. PROJECT NO. I-H3-(68)
SCALE: AS NOTED DATE: MAR. 1994
SHEET No. C34 OF 44 SHEETS

SEE STATEMENT OF WORK FOR
PROJECT 6 3/19/94 R20

FED. ROAD DIST. NO.	STATE	PROJ. NO.	FISCAL YEAR	SHEET NO.	TOTAL SHEETS
HAWAII	HAW.	I-H3-1(68)	1994	45	470

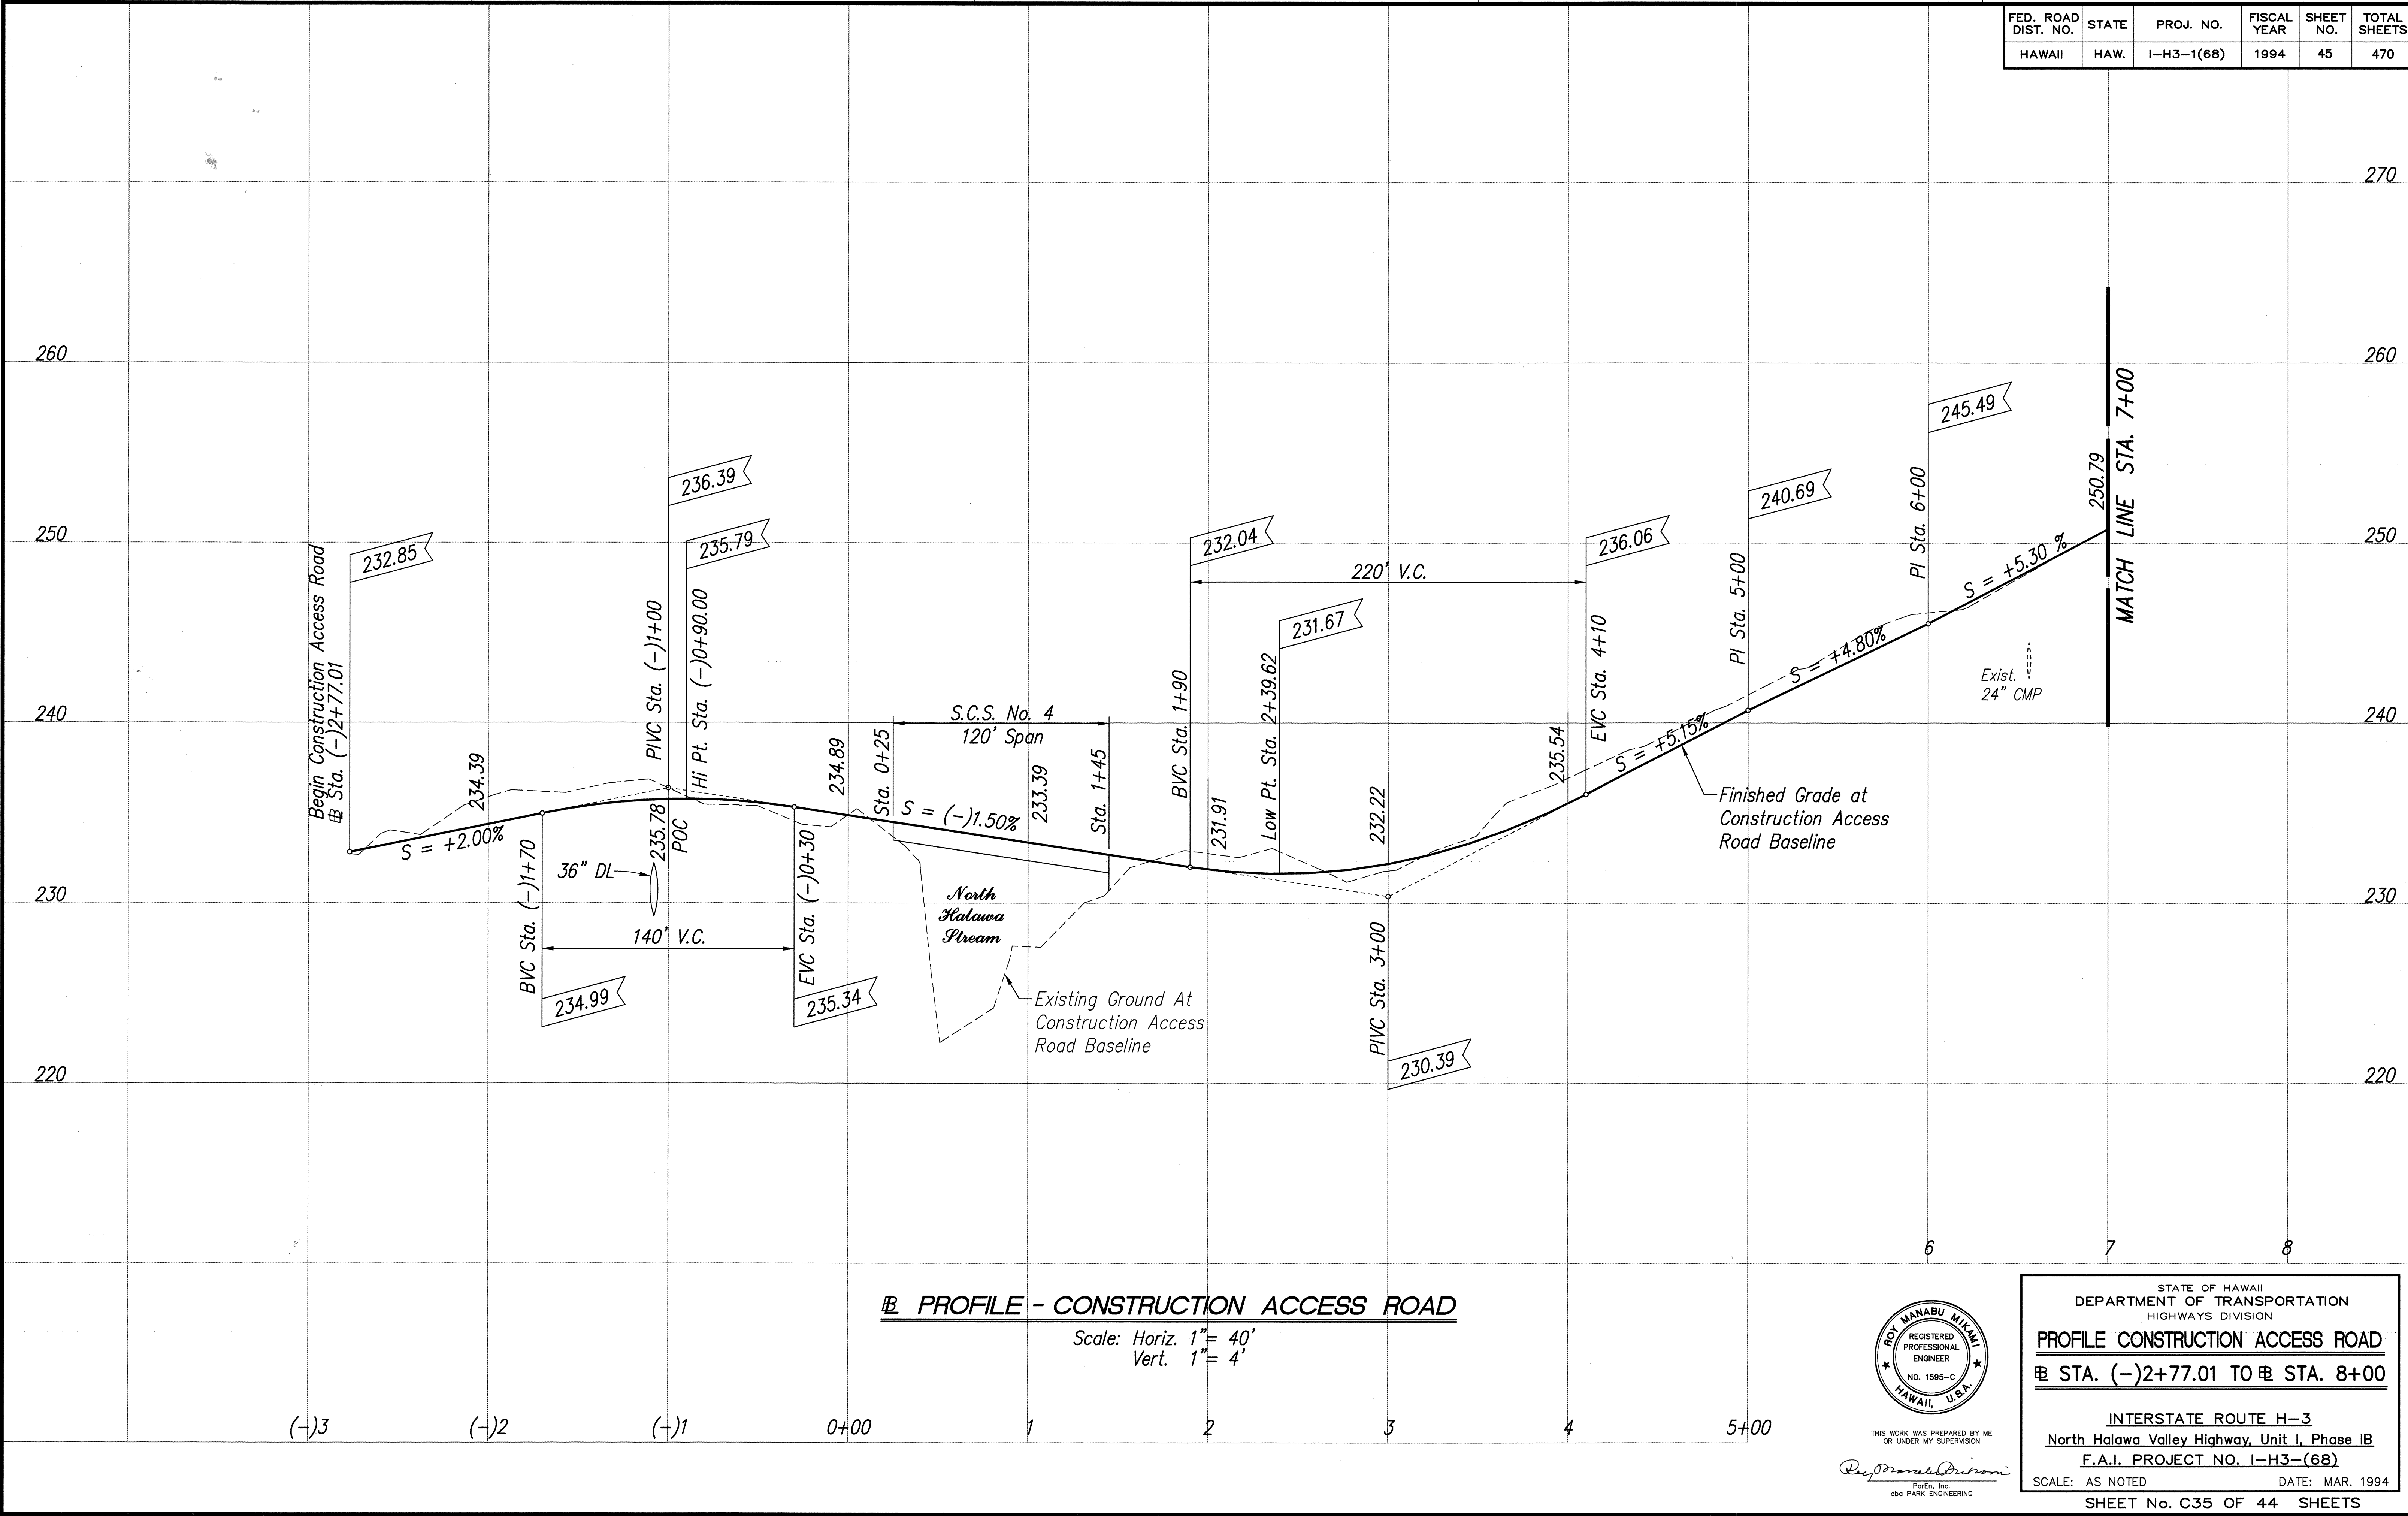

DESIGNED BY	DATE
DRAWN BY	
CHECKED BY	
IN CHARGE	
NO.	

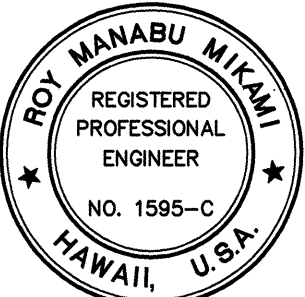

THIS WORK WAS PREPARED BY ME
OR UNDER MY SUPERVISION

Roy Manabu Mikami

DATE: MAR. 1994

STATE OF HAWAII
DEPARTMENT OF TRANSPORTATION
HIGHWAYS DIVISION


PROFILE CONSTRUCTION ACCESS ROAD
STA. (-)2+77.01 TO STA. 8+00

INTERSTATE ROUTE H-3
North Halawa Valley Highway, Unit I, Phase IB
F.A.I. PROJECT NO. I-H3-(68)

SCALE: AS NOTED
DATE: MAR. 1994

SHEET No. C35 OF 44 SHEETS

FED. ROAD DIST. NO.	STATE	PROJ. NO.	FISCAL YEAR	SHEET NO.	TOTAL SHEETS
HAWAII	HAW.	I-H3-1(68)	1994	46	470

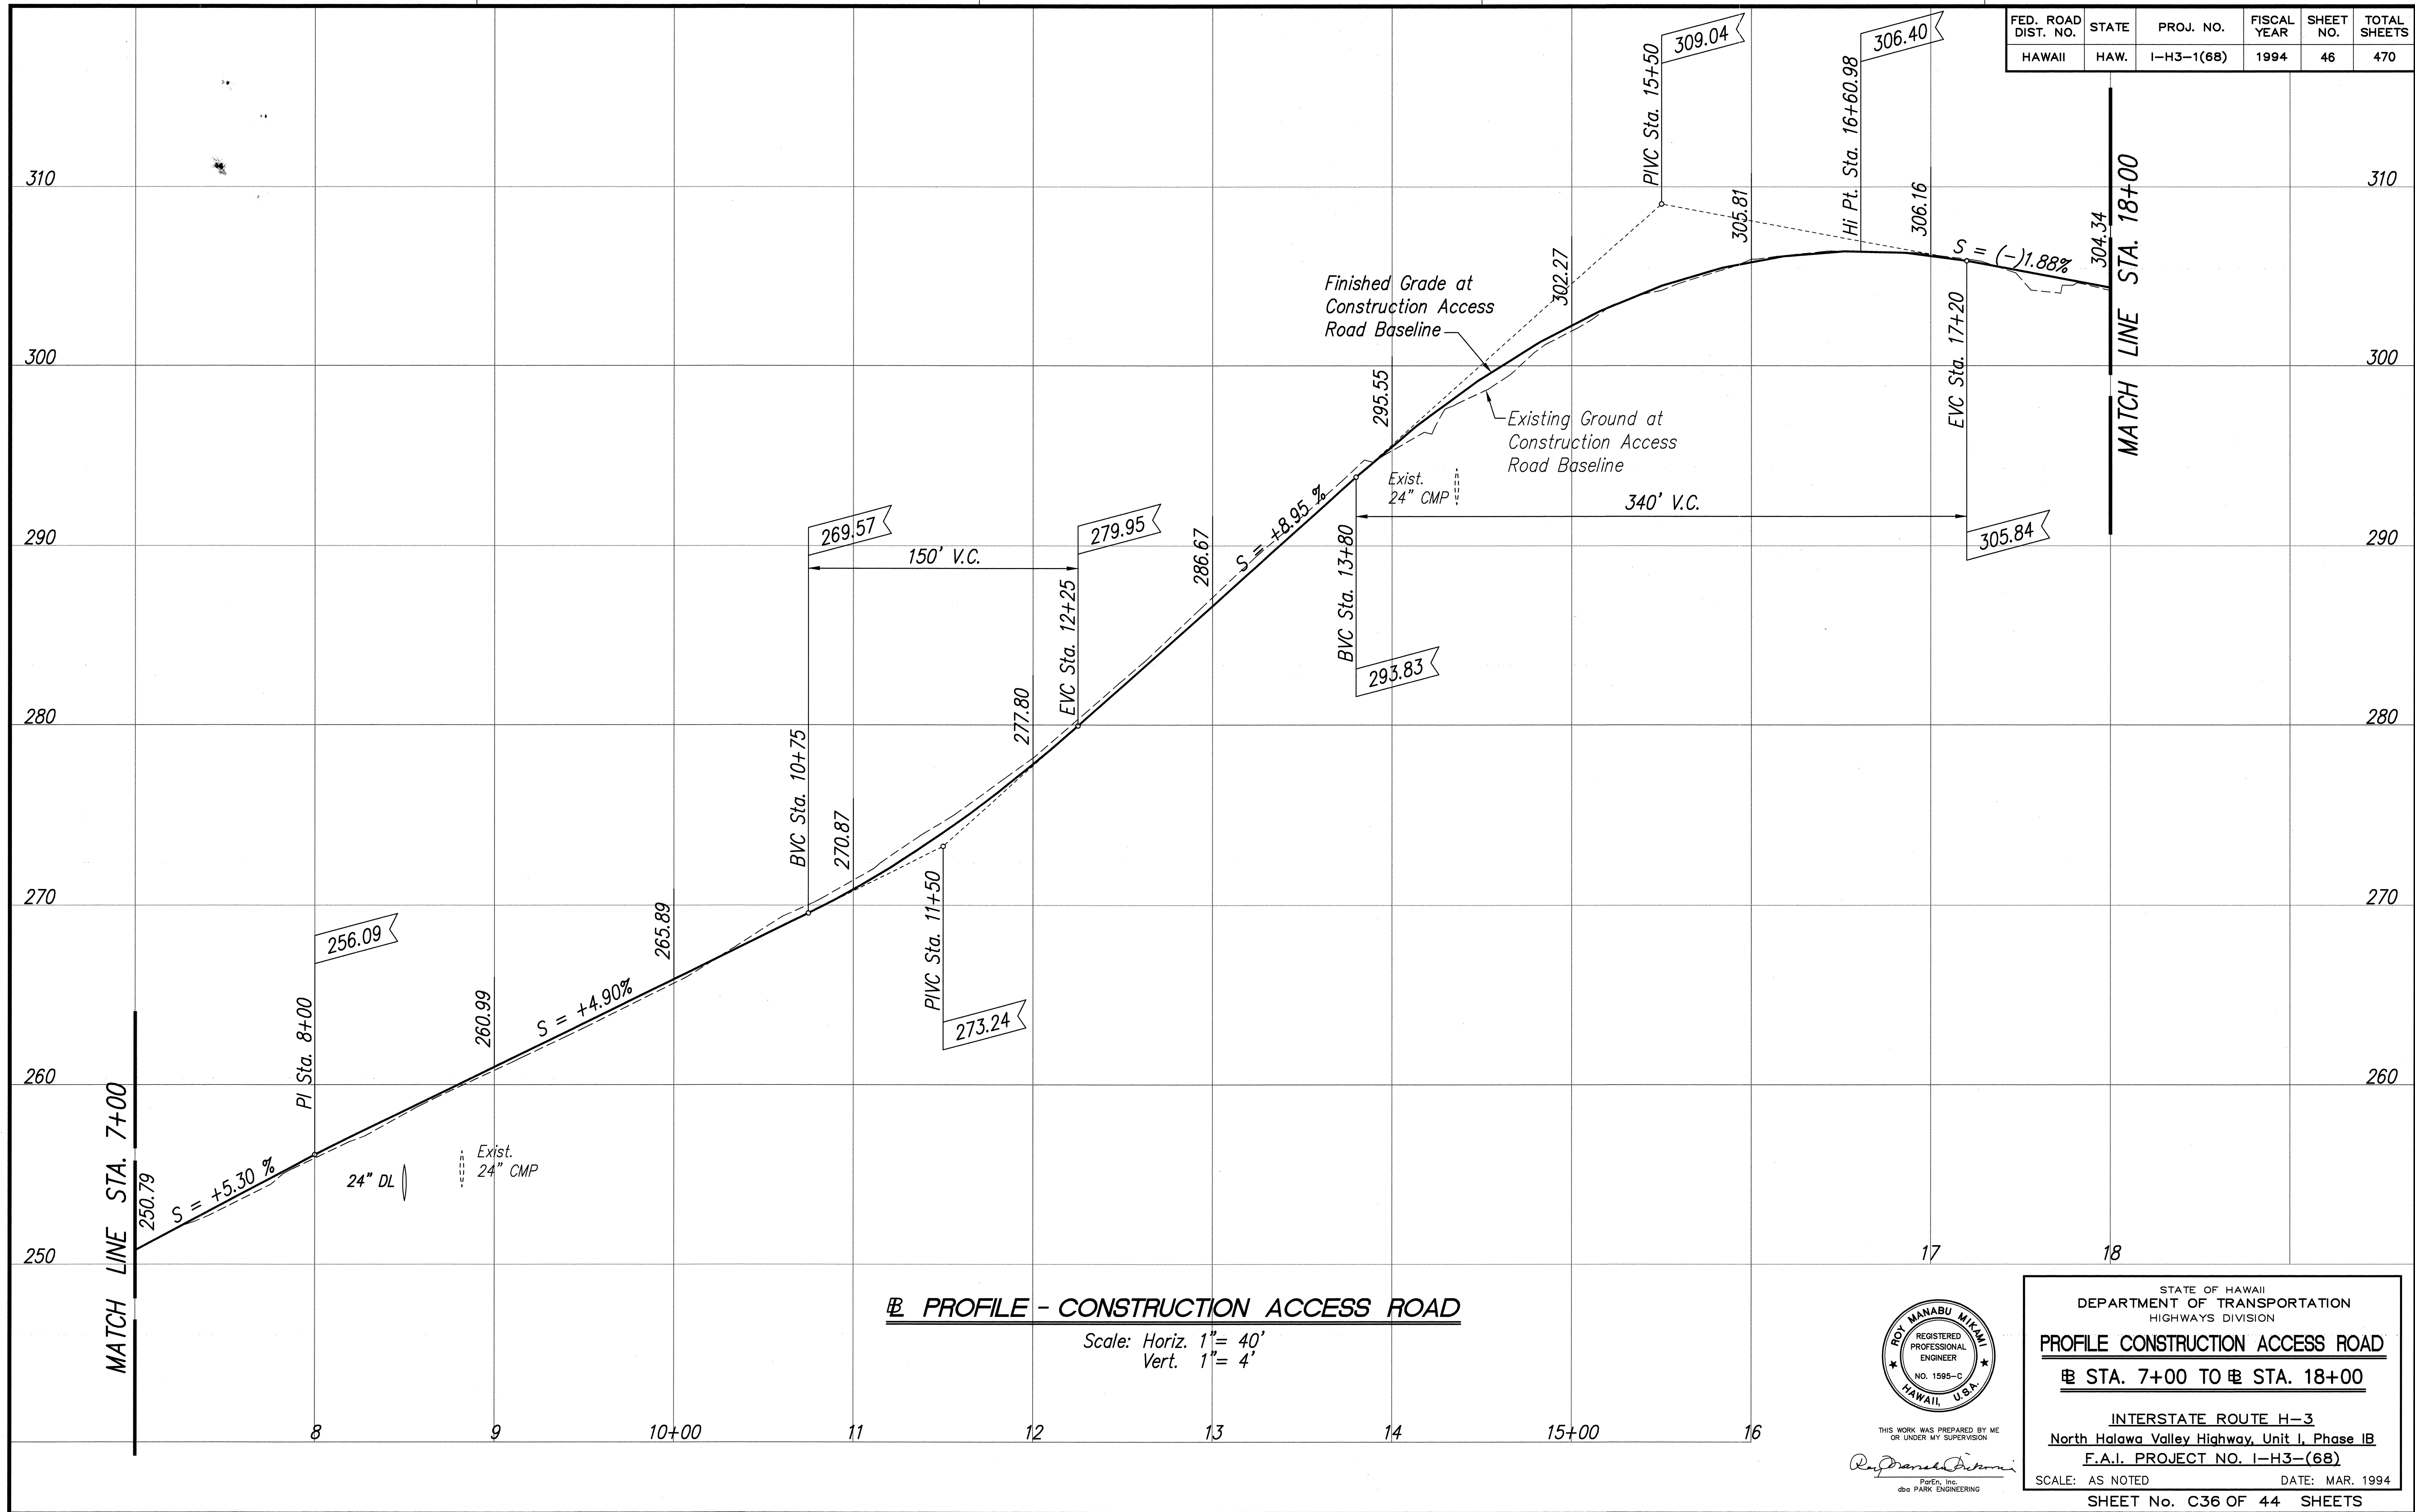

SURVEY PLOTTED BY	DATE
DESIGNED BY	
TRACED BY	
DESIGNED BY	
QUANTITIES BY	
CHECKED BY	

THIS WORK WAS PREPARED BY ME OR UNDER MY SUPERVISION

Roy Manabu Mikami

Park Engineering, Inc.
dba PARK ENGINEERING

STATE OF HAWAII
DEPARTMENT OF TRANSPORTATION
HIGHWAYS DIVISION

PROFILE CONSTRUCTION ACCESS ROAD


STA. 7+00 TO STA. 18+00

INTERSTATE ROUTE H-3
North Halawa Valley Highway, Unit I, Phase IB
F.A.I. PROJECT NO. I-H3-(68)

SCALE: AS NOTED DATE: MAR. 1994

SHEET No. C36 OF 44 SHEETS

FED. ROAD DIST. NO.	STATE	PROJ. NO.	FISCAL YEAR	SHEET NO.	TOTAL SHEETS
HAWAII	HAW.	I-H3-1(68)	1994	47	470

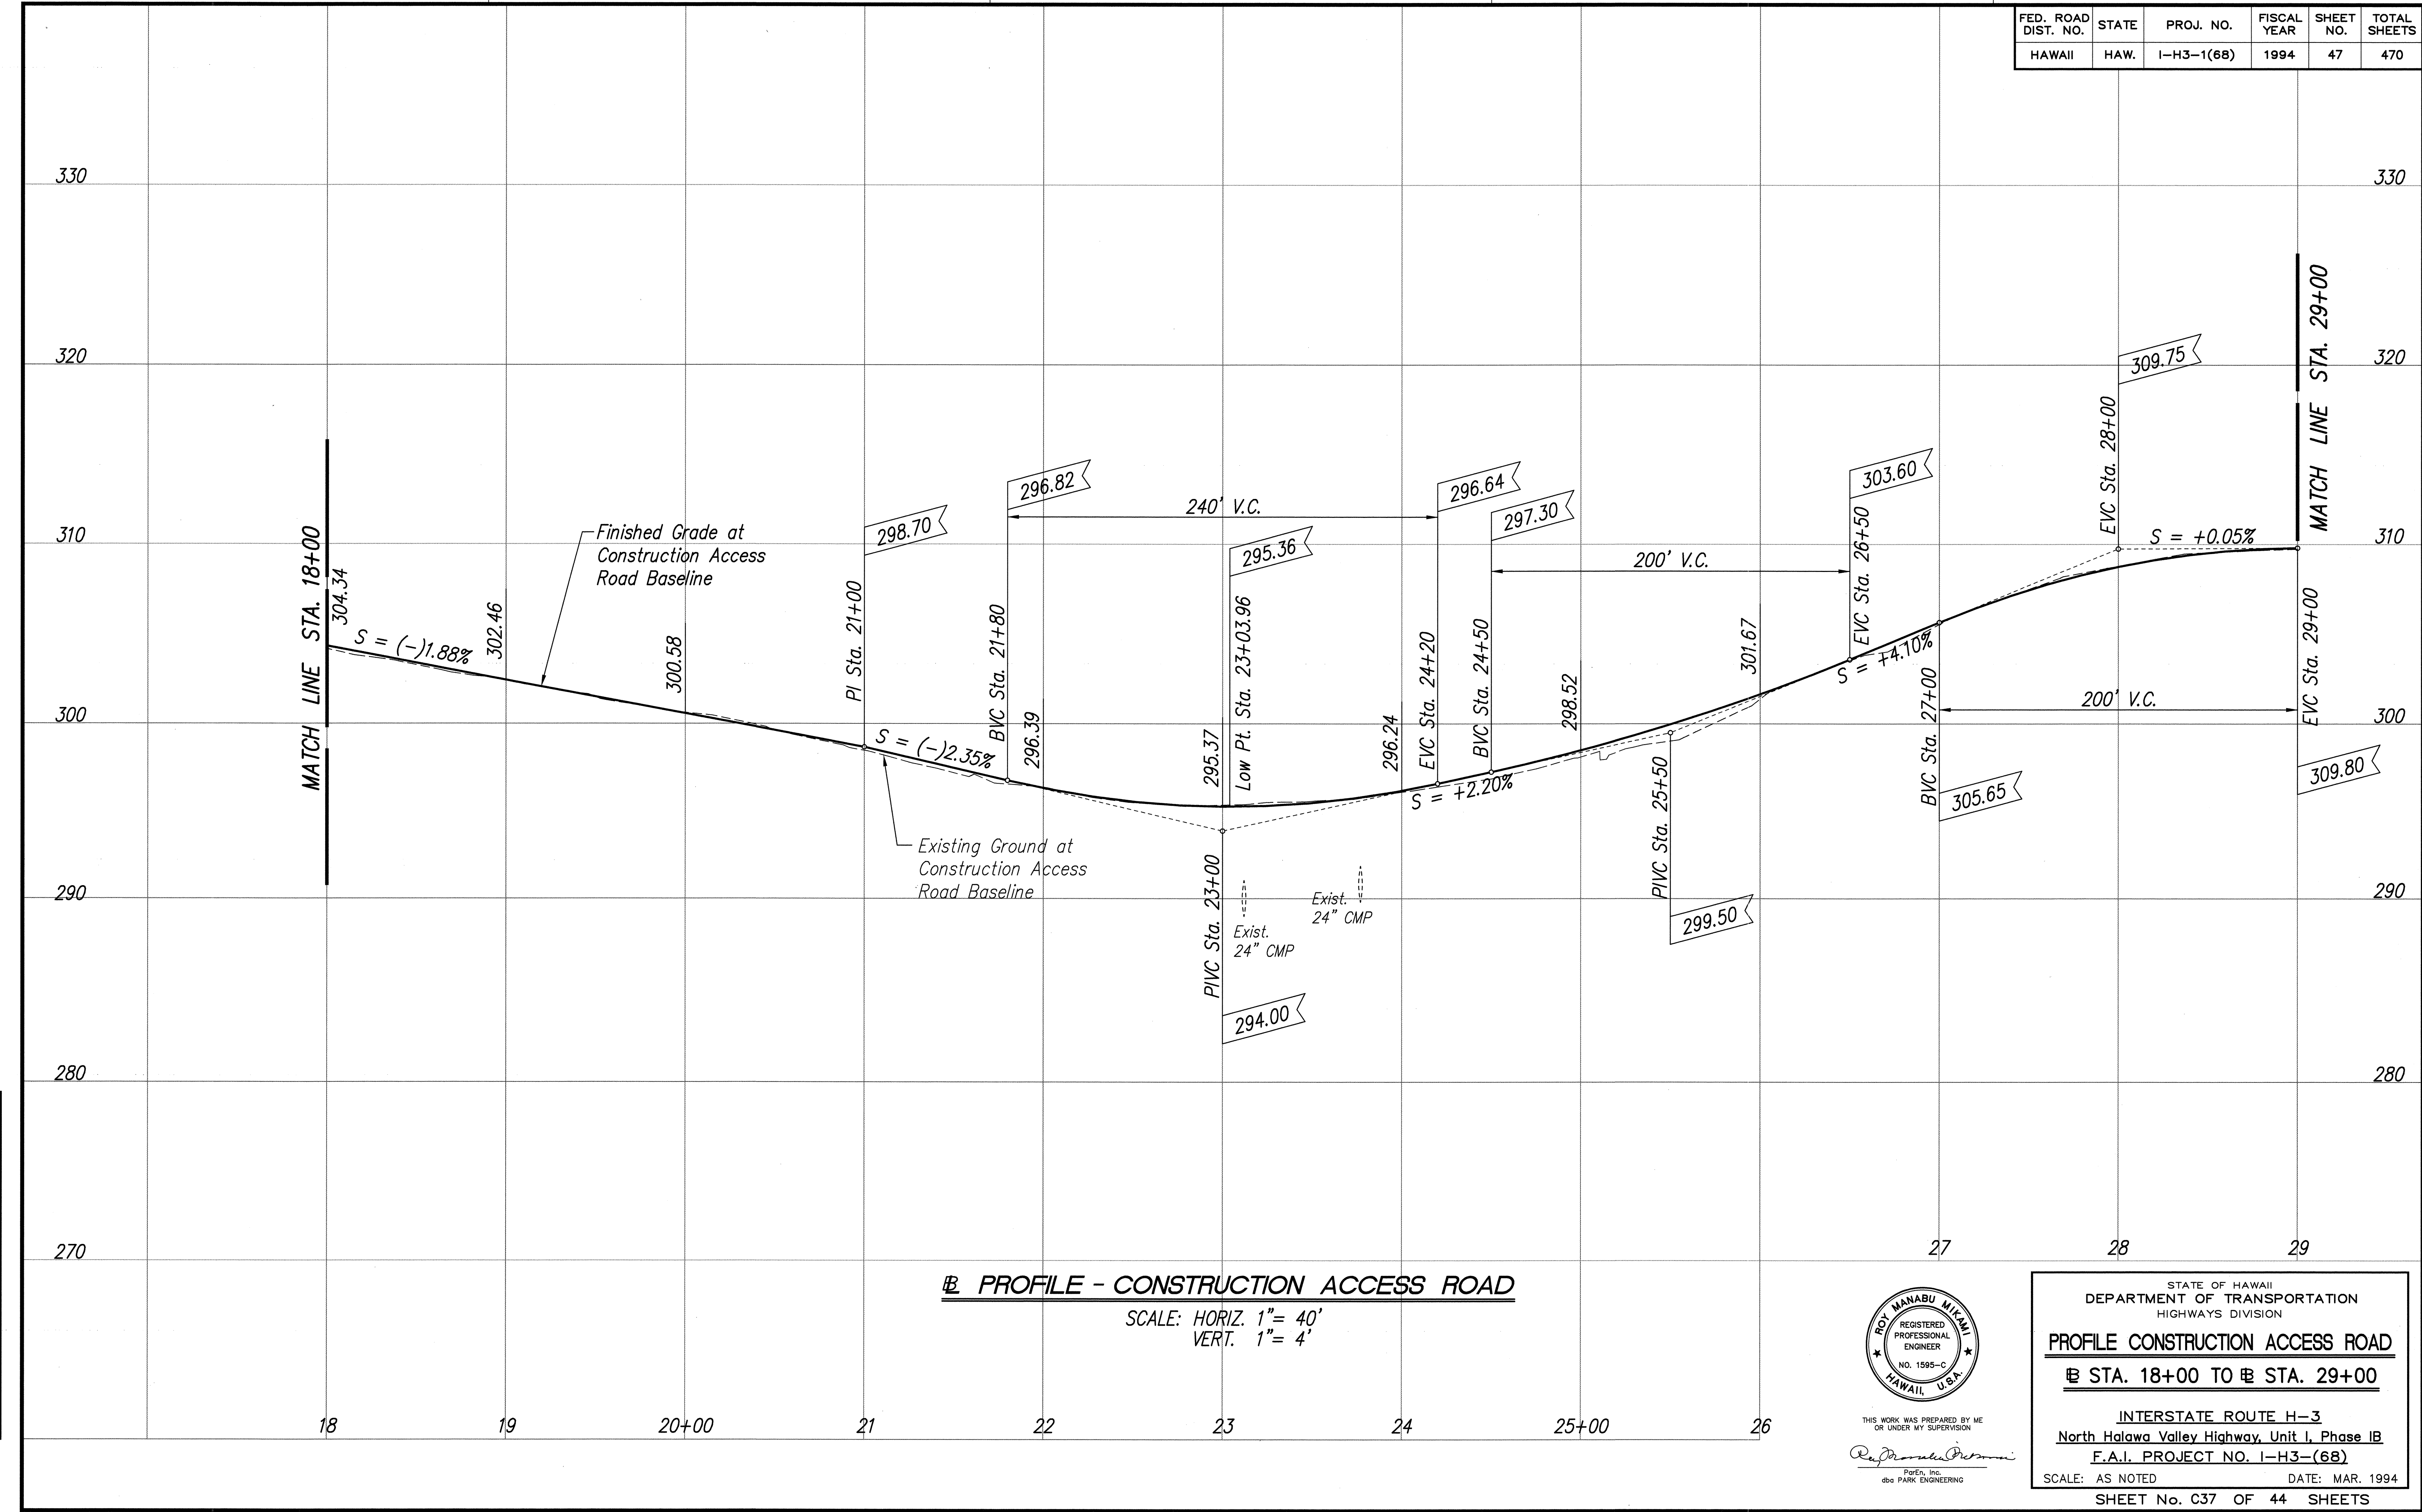


DESIGNED BY	DATE
TRACED BY	
DESIGNED BY	
QUANTITIES BY	
CHECKED BY	
NO.	

ROTATED:
BASE: PT. 0.0


UB: STATE\DOT\Y-3\H-3030\1
C:\P\3030 3/2/94 13:30

FED. ROAD DIST. NO.	STATE	PROJ. NO.	FISCAL YEAR	SHEET NO.	TOTAL SHEETS
HAWAII	HAW.	I-H3-1(68)	1994	48	470

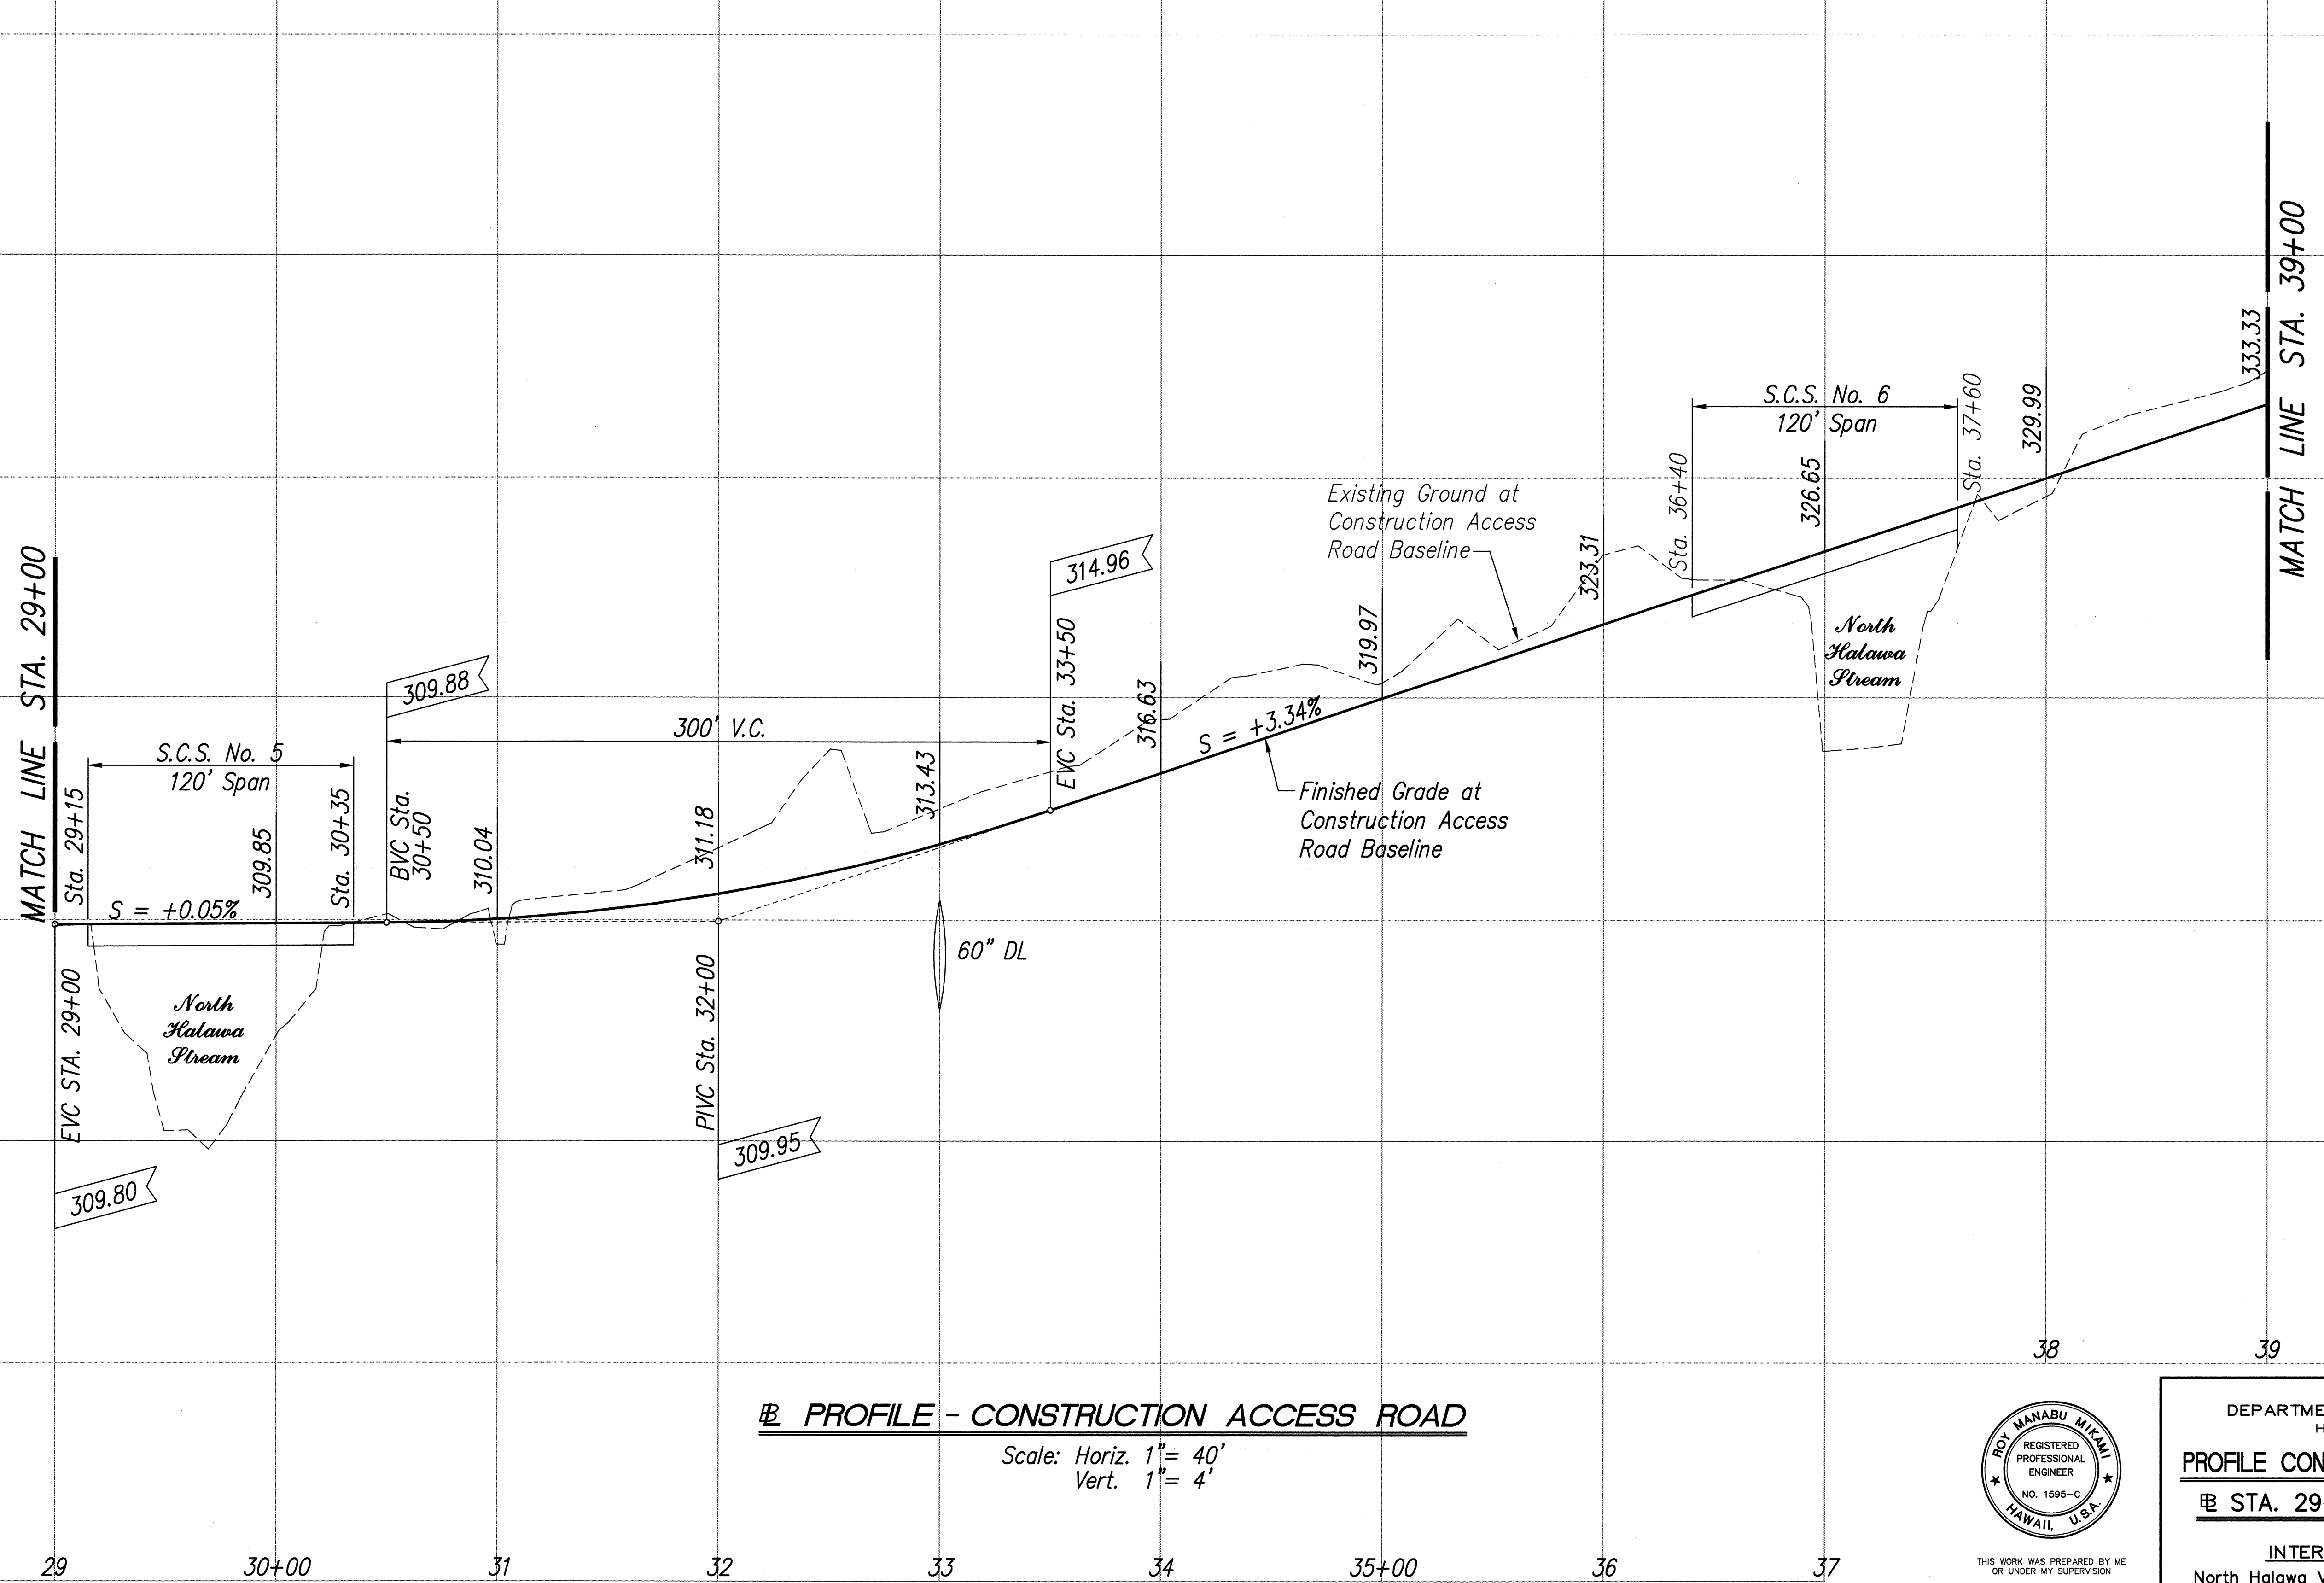

GENERAL	SURVEY PLOTTED BY	DATE
PLAN	DESIGNED BY	
NOTE BOOK	QUANTITIES BY	
No.	CHECKED BY	

PROFILE - CONSTRUCTION ACCESS ROAD
 Scale: Horiz. 1" = 40'
 Vert. 1" = 4'

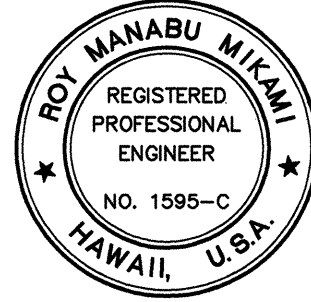

THIS WORK WAS PREPARED BY ME
OR UNDER MY SUPERVISION

Roy Manabu Mikami
 Roy Manabu Mikami
 P.E., Inc.
 dba PARK ENGINEERING

STATE OF HAWAII
 DEPARTMENT OF TRANSPORTATION
 HIGHWAYS DIVISION

PROFILE CONSTRUCTION ACCESS ROAD
 STA. 29+00 TO STA. 39+00


INTERSTATE ROUTE H-3
 North Halawa Valley Highway, Unit I, Phase IB
 F.A.I. PROJECT NO. I-H3-(68)

SCALE: AS NOTED DATE: MAR. 1994


SHEET No. C38 OF 44 SHEETS

DB STATE\DOT\94-34\3030\ C38.DWG 5/27/94 R30

FED. ROAD DIST. NO.	STATE	PROJ. NO.	FISCAL YEAR	SHEET NO.	TOTAL SHEETS
HAWAII	HAW.	I-H3-1(68)	1994	49	470

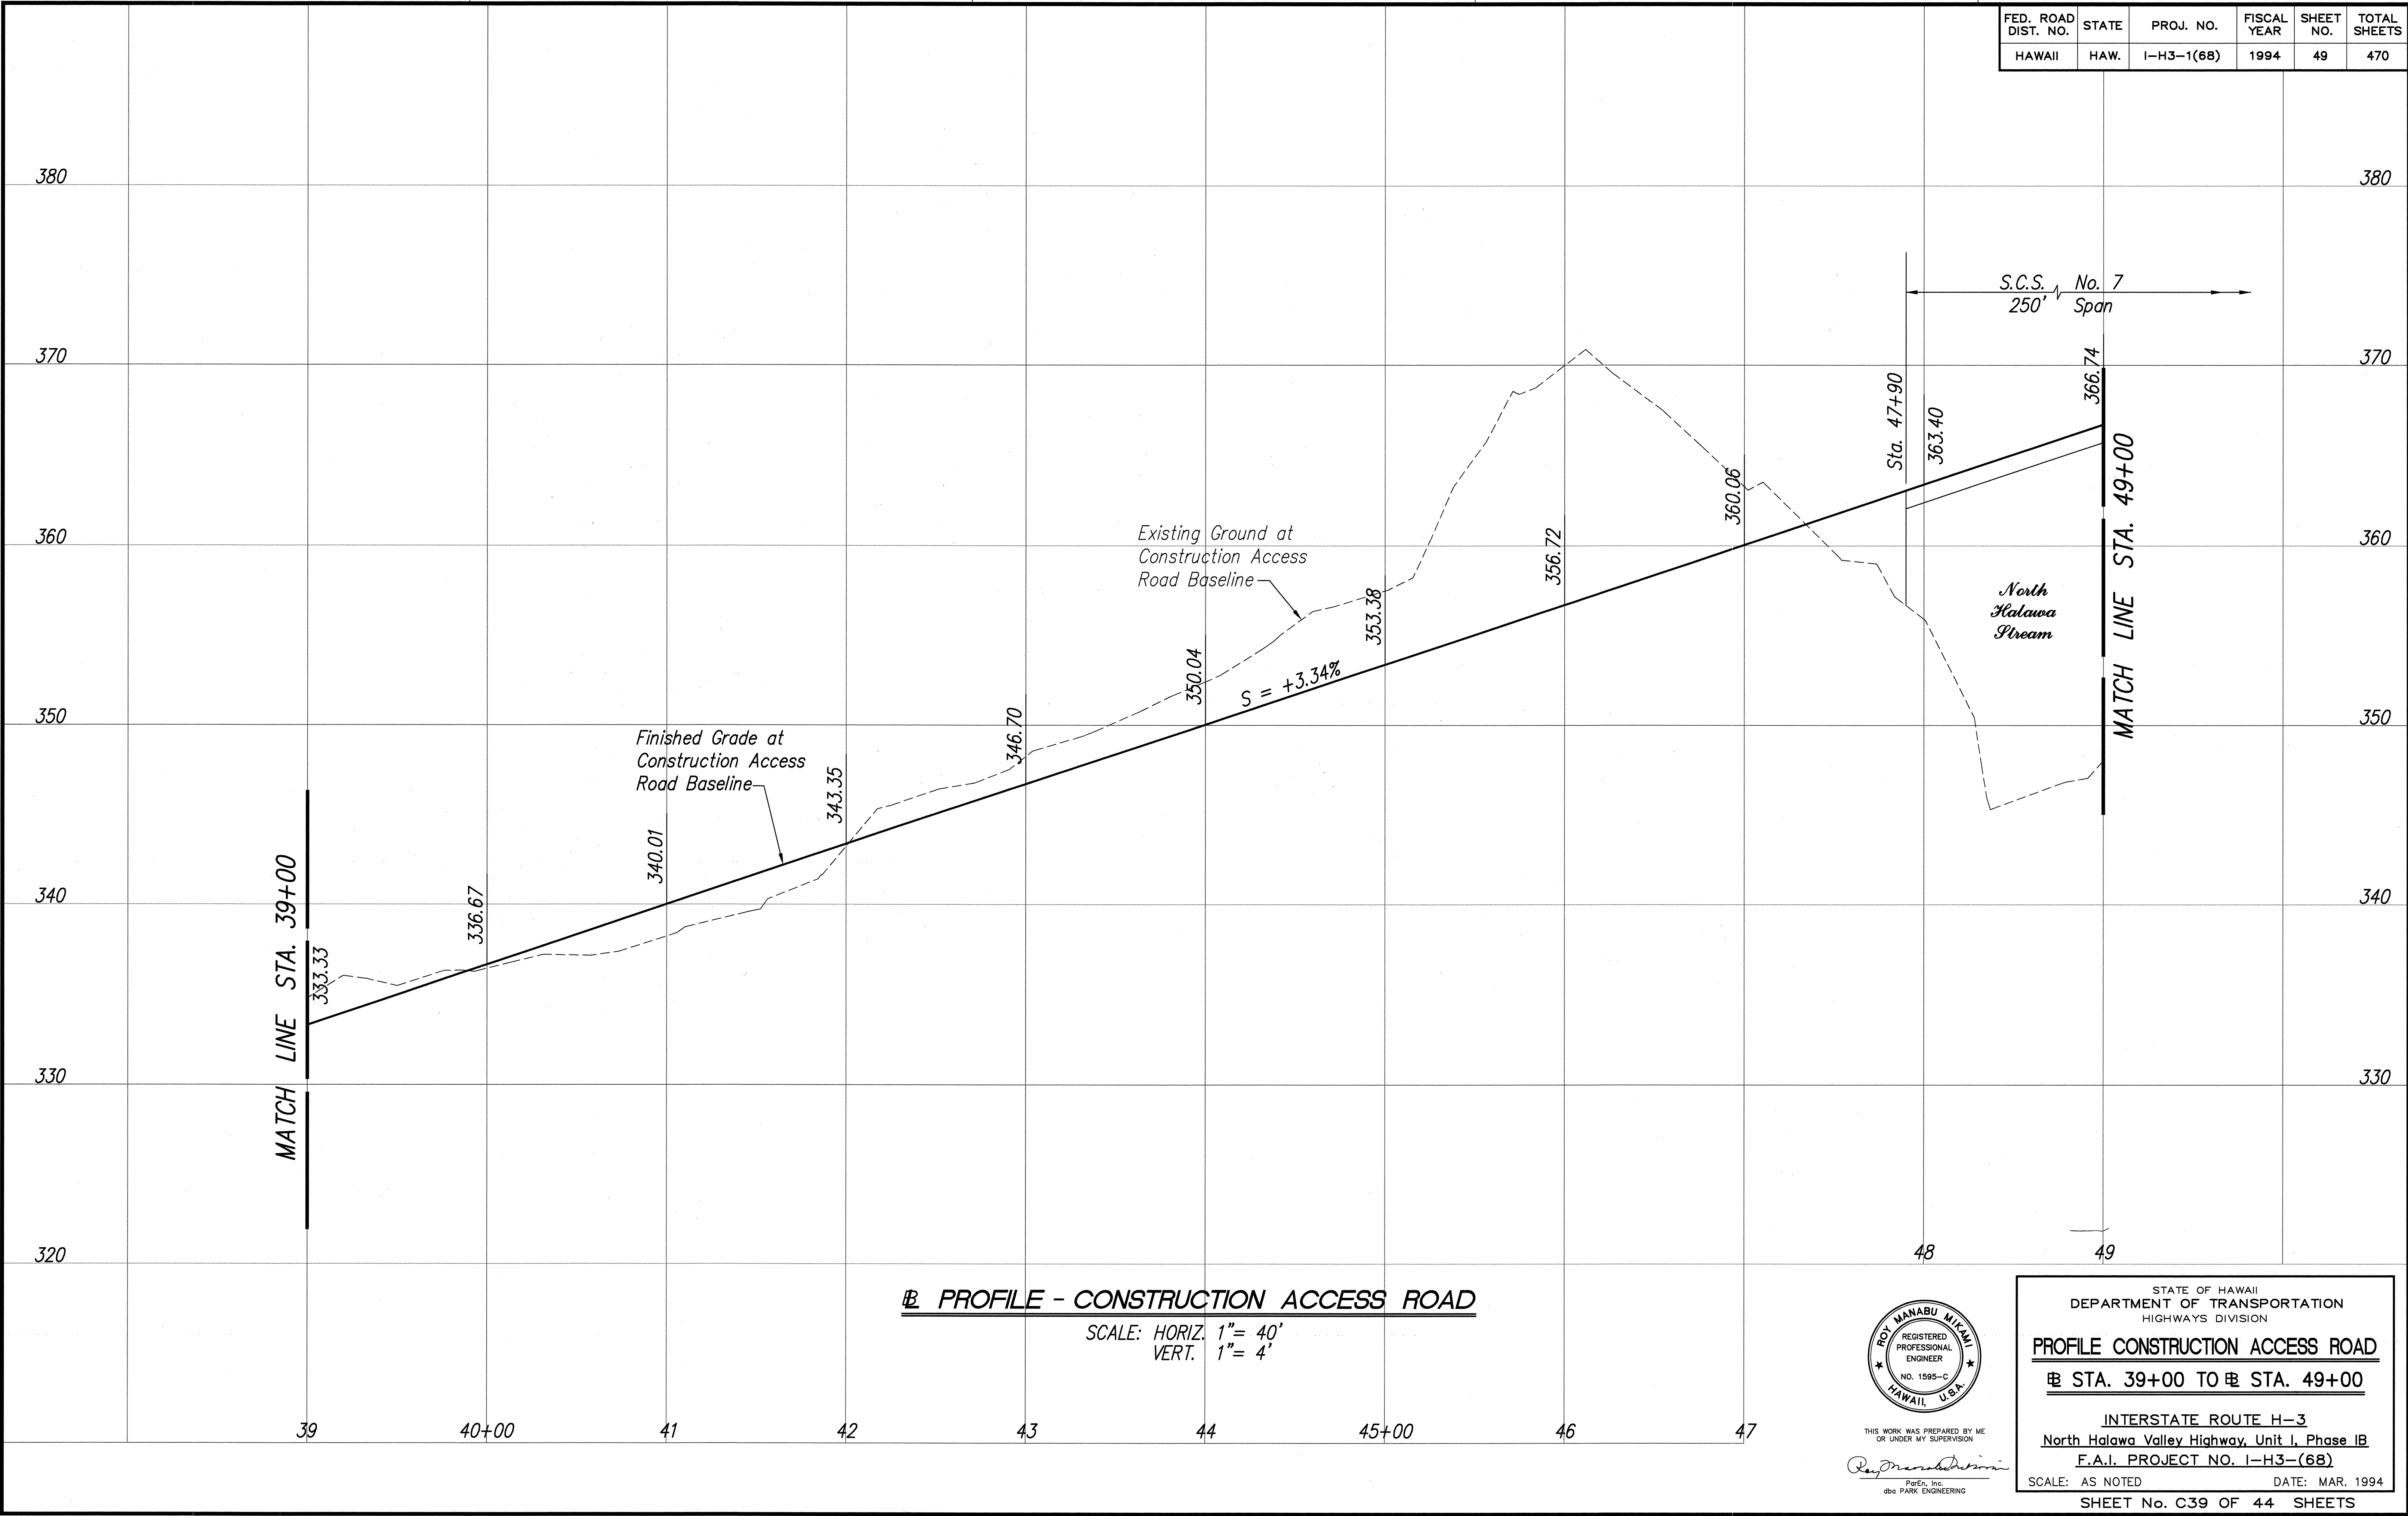

DESIGNED BY	DATE
DRAWN BY	
CHECKED BY	
IN CHARGE	
NO.	

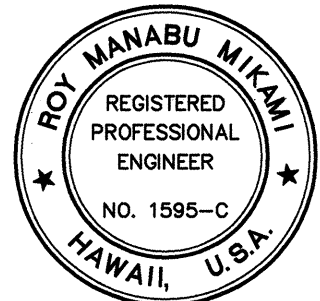

THIS WORK WAS PREPARED BY ME
OR UNDER MY SUPERVISION


Roy Manabu Miyaki

Park, Inc.
dba PARK ENGINEERING

STATE OF HAWAII
DEPARTMENT OF TRANSPORTATION
HIGHWAYS DIVISION
PROFILE CONSTRUCTION ACCESS ROAD
STA. 39+00 TO STA. 49+00
INTERSTATE ROUTE H-3
North Halawa Valley Highway, Unit I, Phase IB
F.A.I. PROJECT NO. I-H3-(68)
SCALE: AS NOTED
DATE: MAR. 1994
SHEET No. C39 OF 44 SHEETS


LIB STATE DOT 11-31-9300
CARTERS 5/2/94 1350

FED. ROAD DIST. NO.	STATE	PROJ. NO.	FISCAL YEAR	SHEET NO.	TOTAL SHEETS
HAWAII	HAW.	I-H3-1(68)	1994	50	470

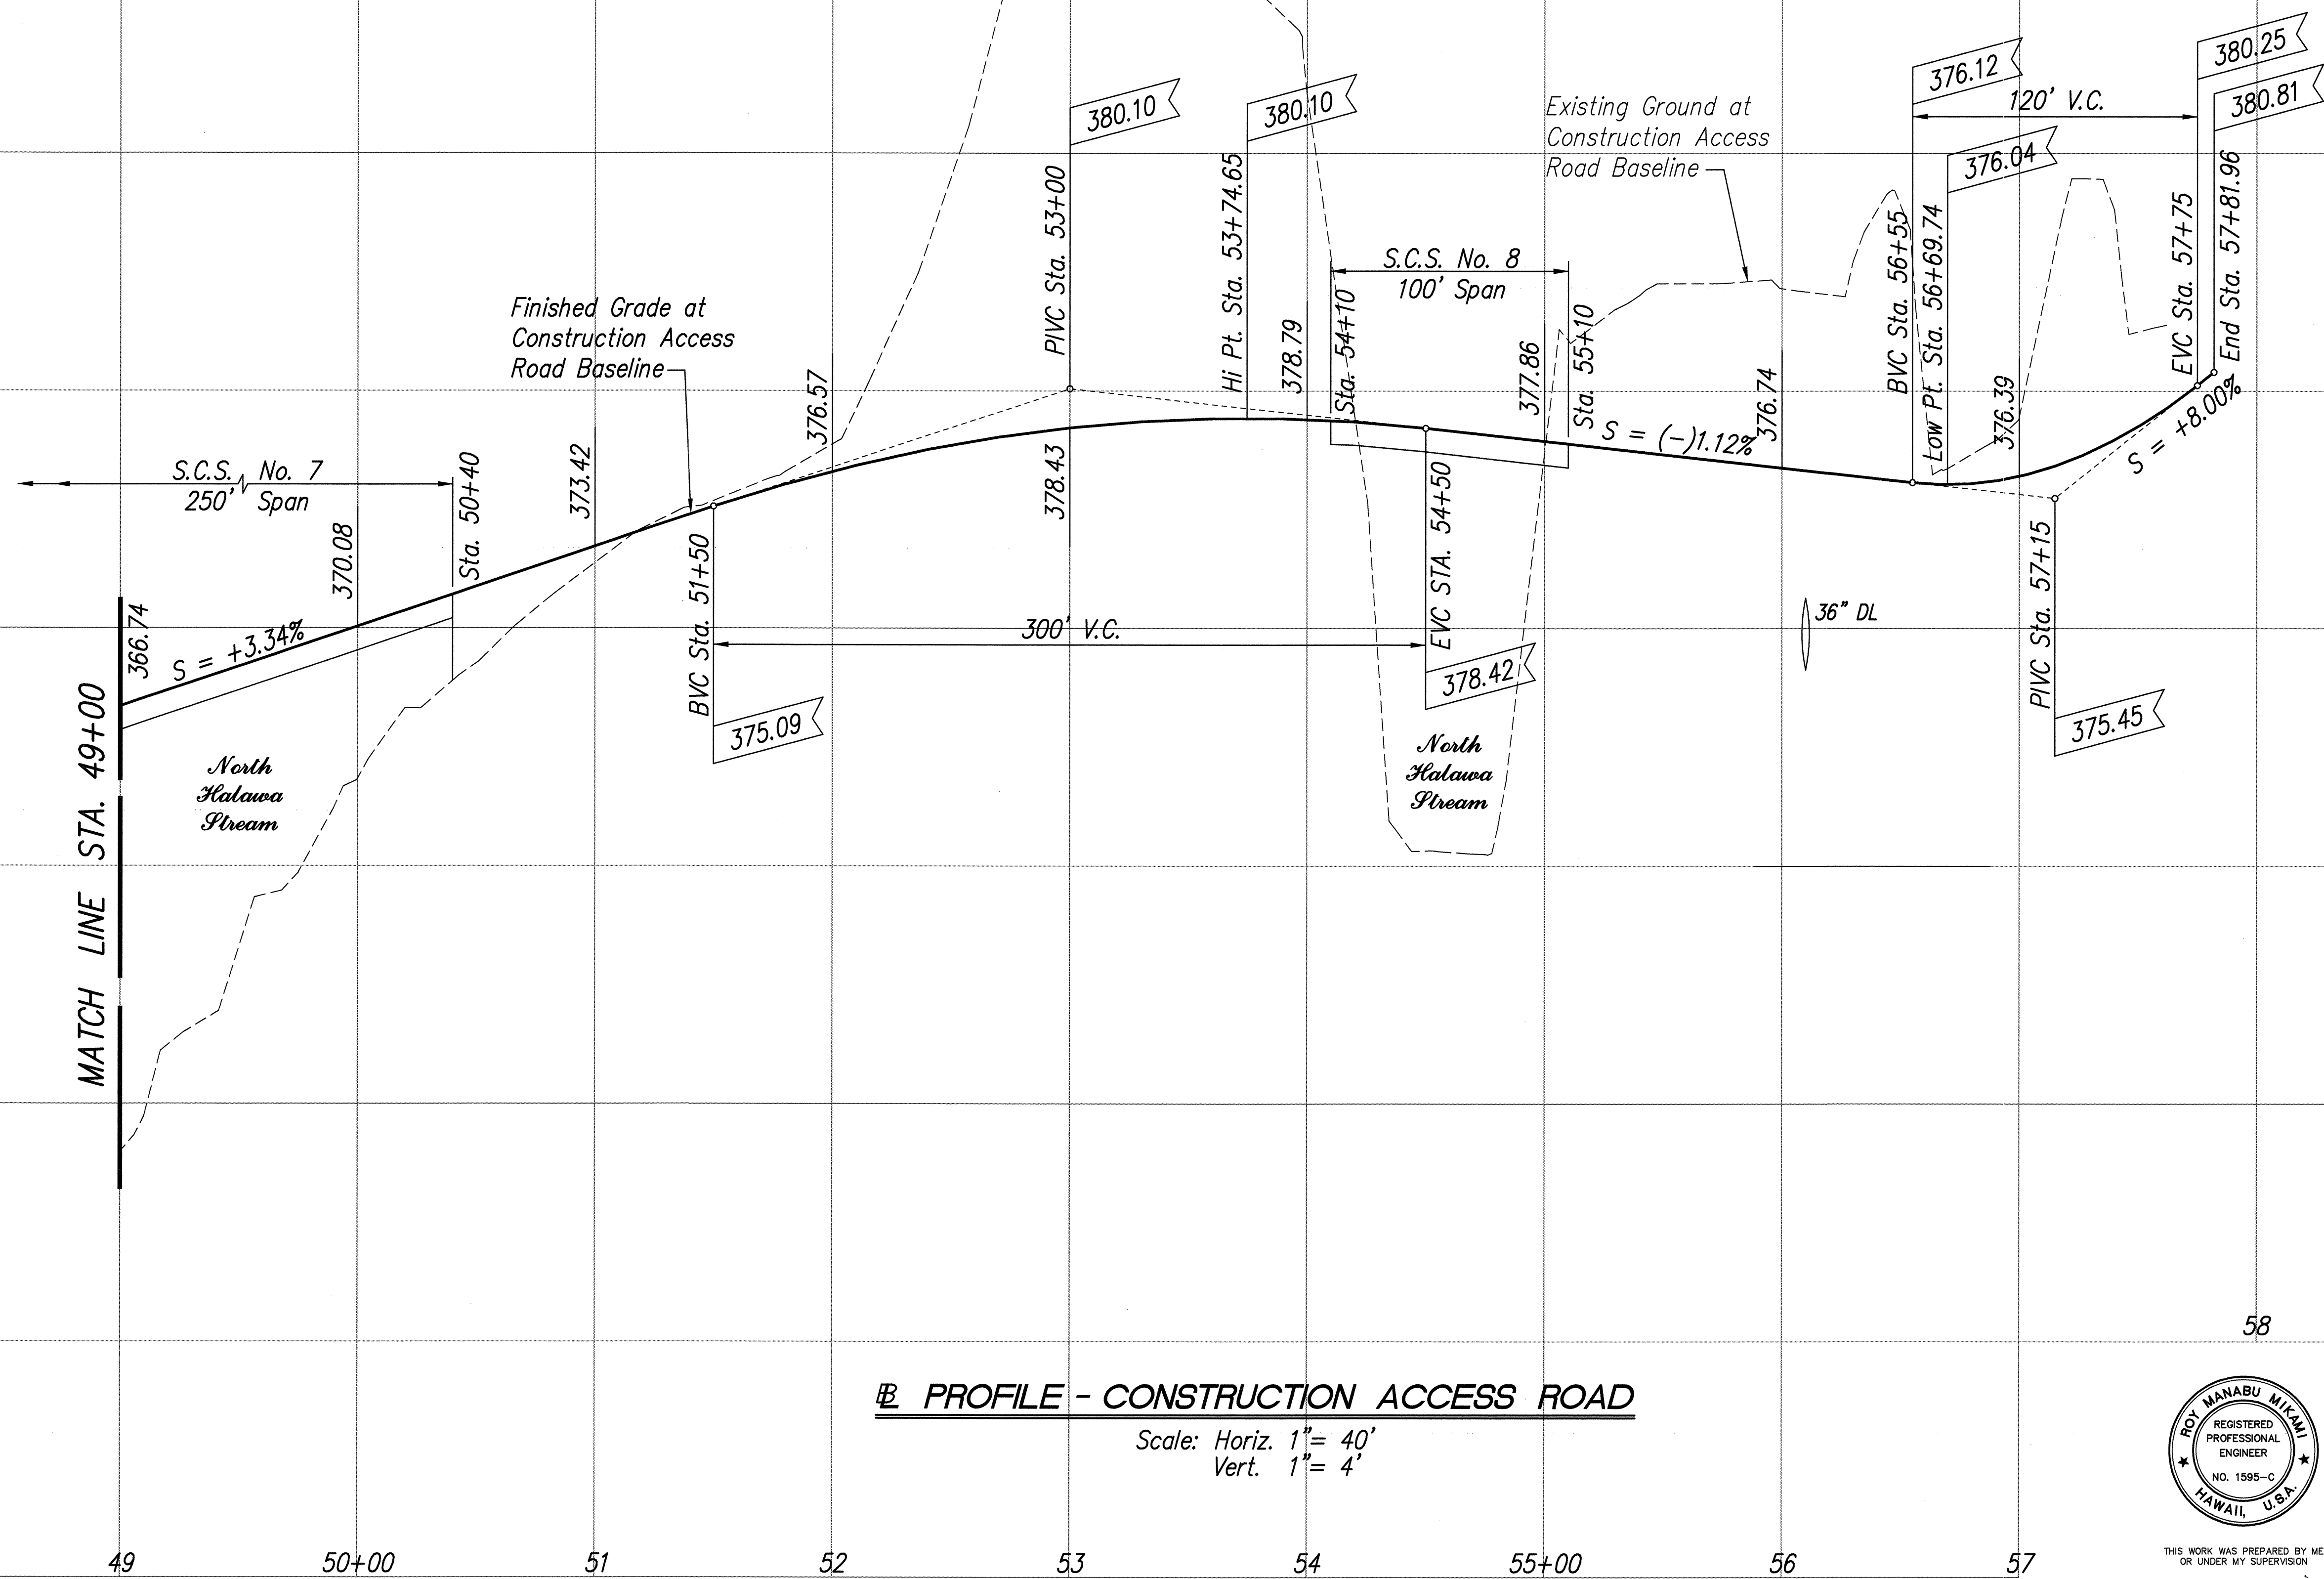

PROFILE - CONSTRUCTION ACCESS ROAD

Scale: Horiz. 1" = 40'
Vert. 1" = 4'

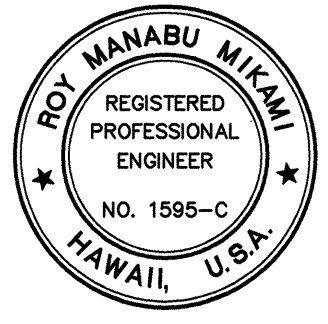

THIS WORK WAS PREPARED BY ME
OR UNDER MY SUPERVISION
Roy Hanabu Mikami
PAREN, INC.
600 PARK ENGINEERING

STATE OF HAWAII
DEPARTMENT OF TRANSPORTATION
HIGHWAYS DIVISION

PROFILE CONSTRUCTION ACCESS ROAD
STA. 49+00 TO STA. 57+81.96

INTERSTATE ROUTE H-3
North Halawa Valley Highway, Unit I, Phase IB
F.A.I. PROJECT NO. I-H3-(68)


SCALE: AS NOTED DATE: MAR. 1994

SHEET No. C40 OF 44 SHEETS

DESIGNED BY	DATE
DRAWN BY	
CHECKED BY	
NOTED BY	
QUANTITIES BY	
NO.	

STATE DOT 10-31(300)
CARRIAGE 5/2/74 R30


FED. ROAD DIST. NO.	STATE	PROJ. NO.	FISCAL YEAR	SHEET NO.	TOTAL SHEETS
HAWAII	HAW.	I-H3-1(68)	1994	51	470

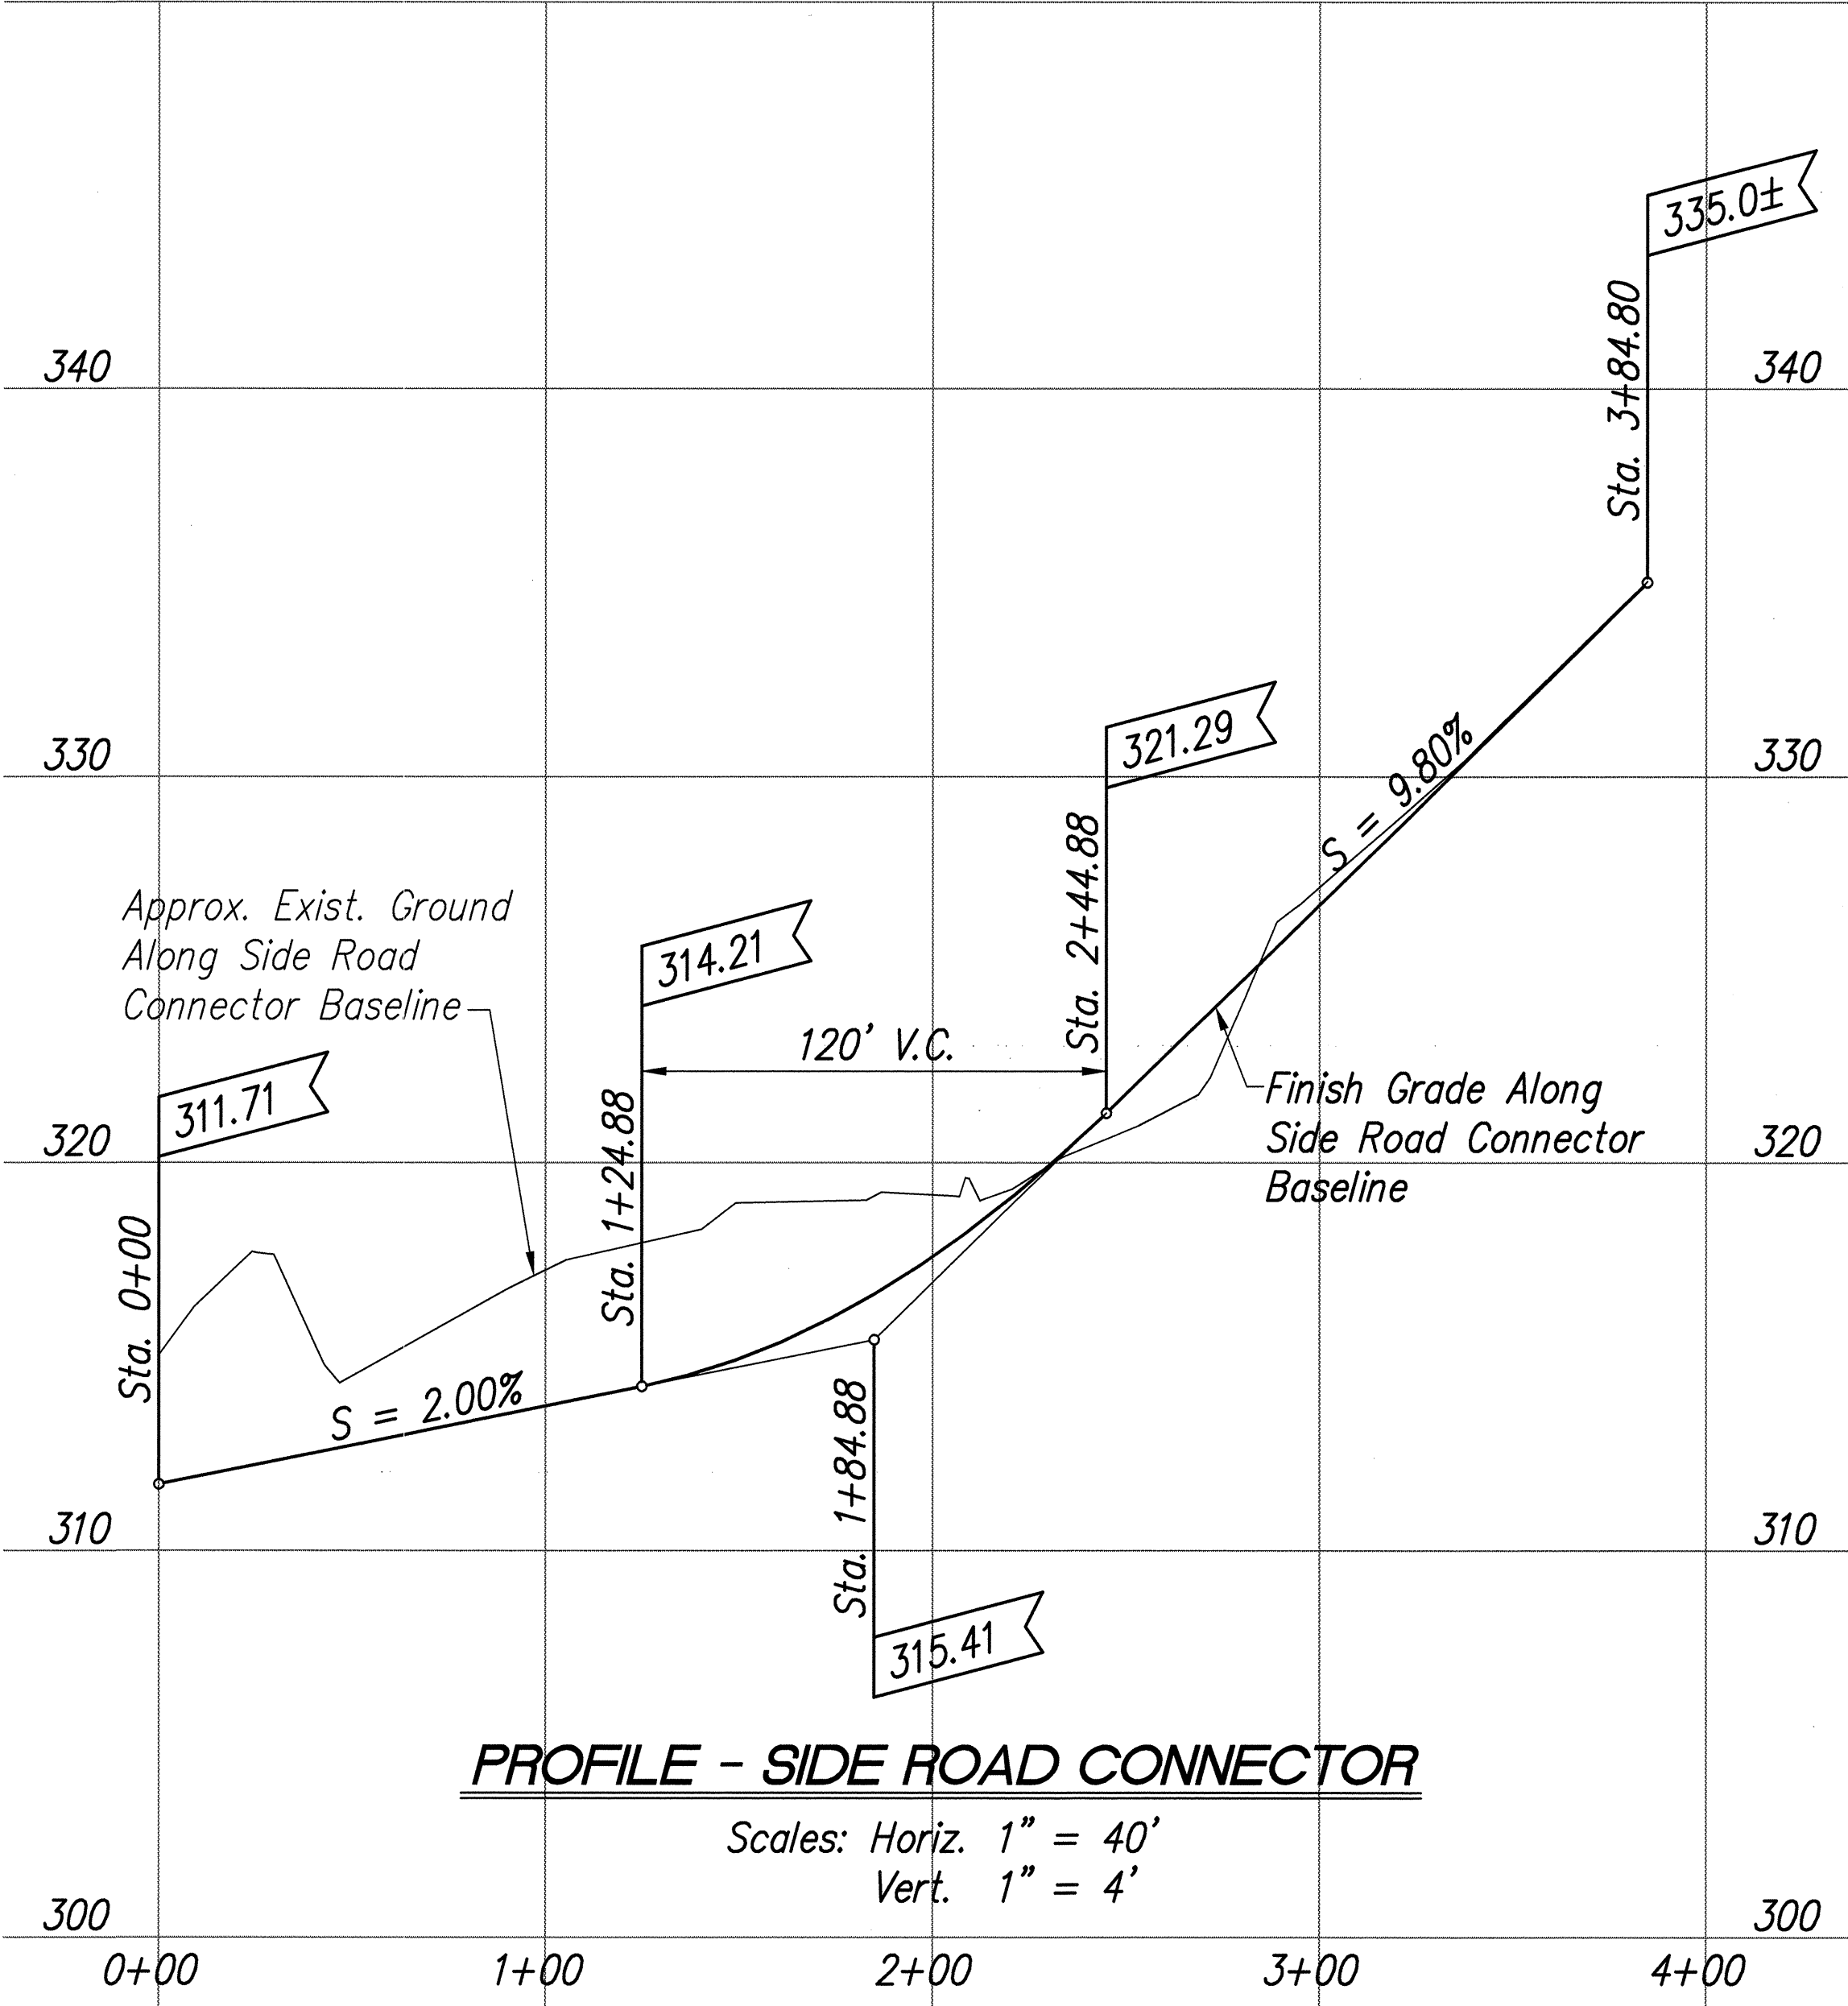

PROFILE - SIDE ROAD CONNECTOR

Scales: Horiz. 1" = 40'
Vert. 1" = 4'

ORIGINAL PLAN	SURVEY PLOTTED BY	DATE
NOTE BOOK	DESIGNED BY	
QUANTITIES BY	CHECKED BY	
No.		

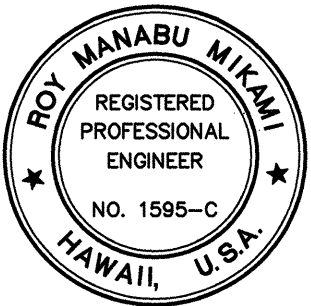

THIS WORK WAS PREPARED BY ME
OR UNDER MY SUPERVISION
Roy Manabu Mikami
Roy Mikami, Inc.
dba PARK ENGINEERING

STATE OF HAWAII
DEPARTMENT OF TRANSPORTATION
HIGHWAYS DIVISION

SIDE ROAD CONNECTOR
PLAN AND PROFILE

INTERSTATE ROUTE H-3
North Halawa Valley Highway, Unit I, Phase IB
F.A.I. PROJECT NO. I-H3-(68)

SCALE: AS NOTED DATE: MAR. 1994

SHEET No. C41 OF 44 SHEETS