





FED. ROAD DIST. NO.	STATE	PROJ. NO.	FISCAL YEAR	SHEET NO.	TOTAL SHEETS
HAWAII	HAW.	I-H3-1(72)	1991	ADD. 12	521

True North

Scale: 1" = 40'

GENERAL NOTES:

1. Azimuth and coordinates are based on Hawaiian Plane Coordinate Grid System Zone 1, referred to "Kailua" Δ , 80,135.23 N & 575,640.57 E
2. Bench Marks are referred to mean sea level datum and shall be furnished and established by State Department of Transportation, Highways Division.
3. Referenced information on all sheets pertains to roadway listed in Title Block, unless otherwise noted.
4. "©" denotes installation of reference survey monuments at locations shown on plans. For detail see Standard Plan D-06.
5. For Metal Guardrail Detail, see Standard Plan TE-50 & 51.
6. For Metal Guardrail Flare Detail, Types C, F and BCT, see Standard Plan TE-58, 59, 60, 61 & 62.
7. For Metal Guardrail Flare Detail, Types C-1 & F-1, see sht. 54
8. For Concrete Guardrail Type A Detail, see sht. 7
9. For Concrete Guardrail Type 4G & 4H Detail, see sht. 54
10. For Metal Guardrail connection to Concrete Guardrail and Retaining Wall Detail, see Standard Plan, TE-55.
11. Where the structure interferes with the placement of metal guardrail post, the Contractor shall provide additional posts as necessary to accommodate Structure. Cost for additional post will not be measured and paid for separately, but will be considered incidental to the metal guardrail.

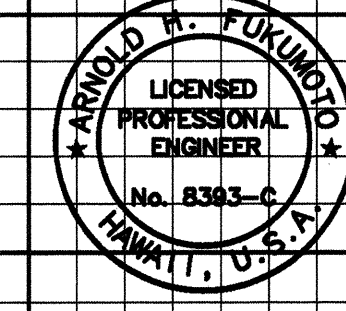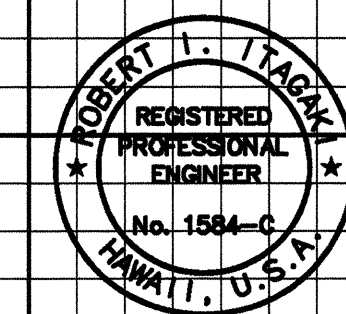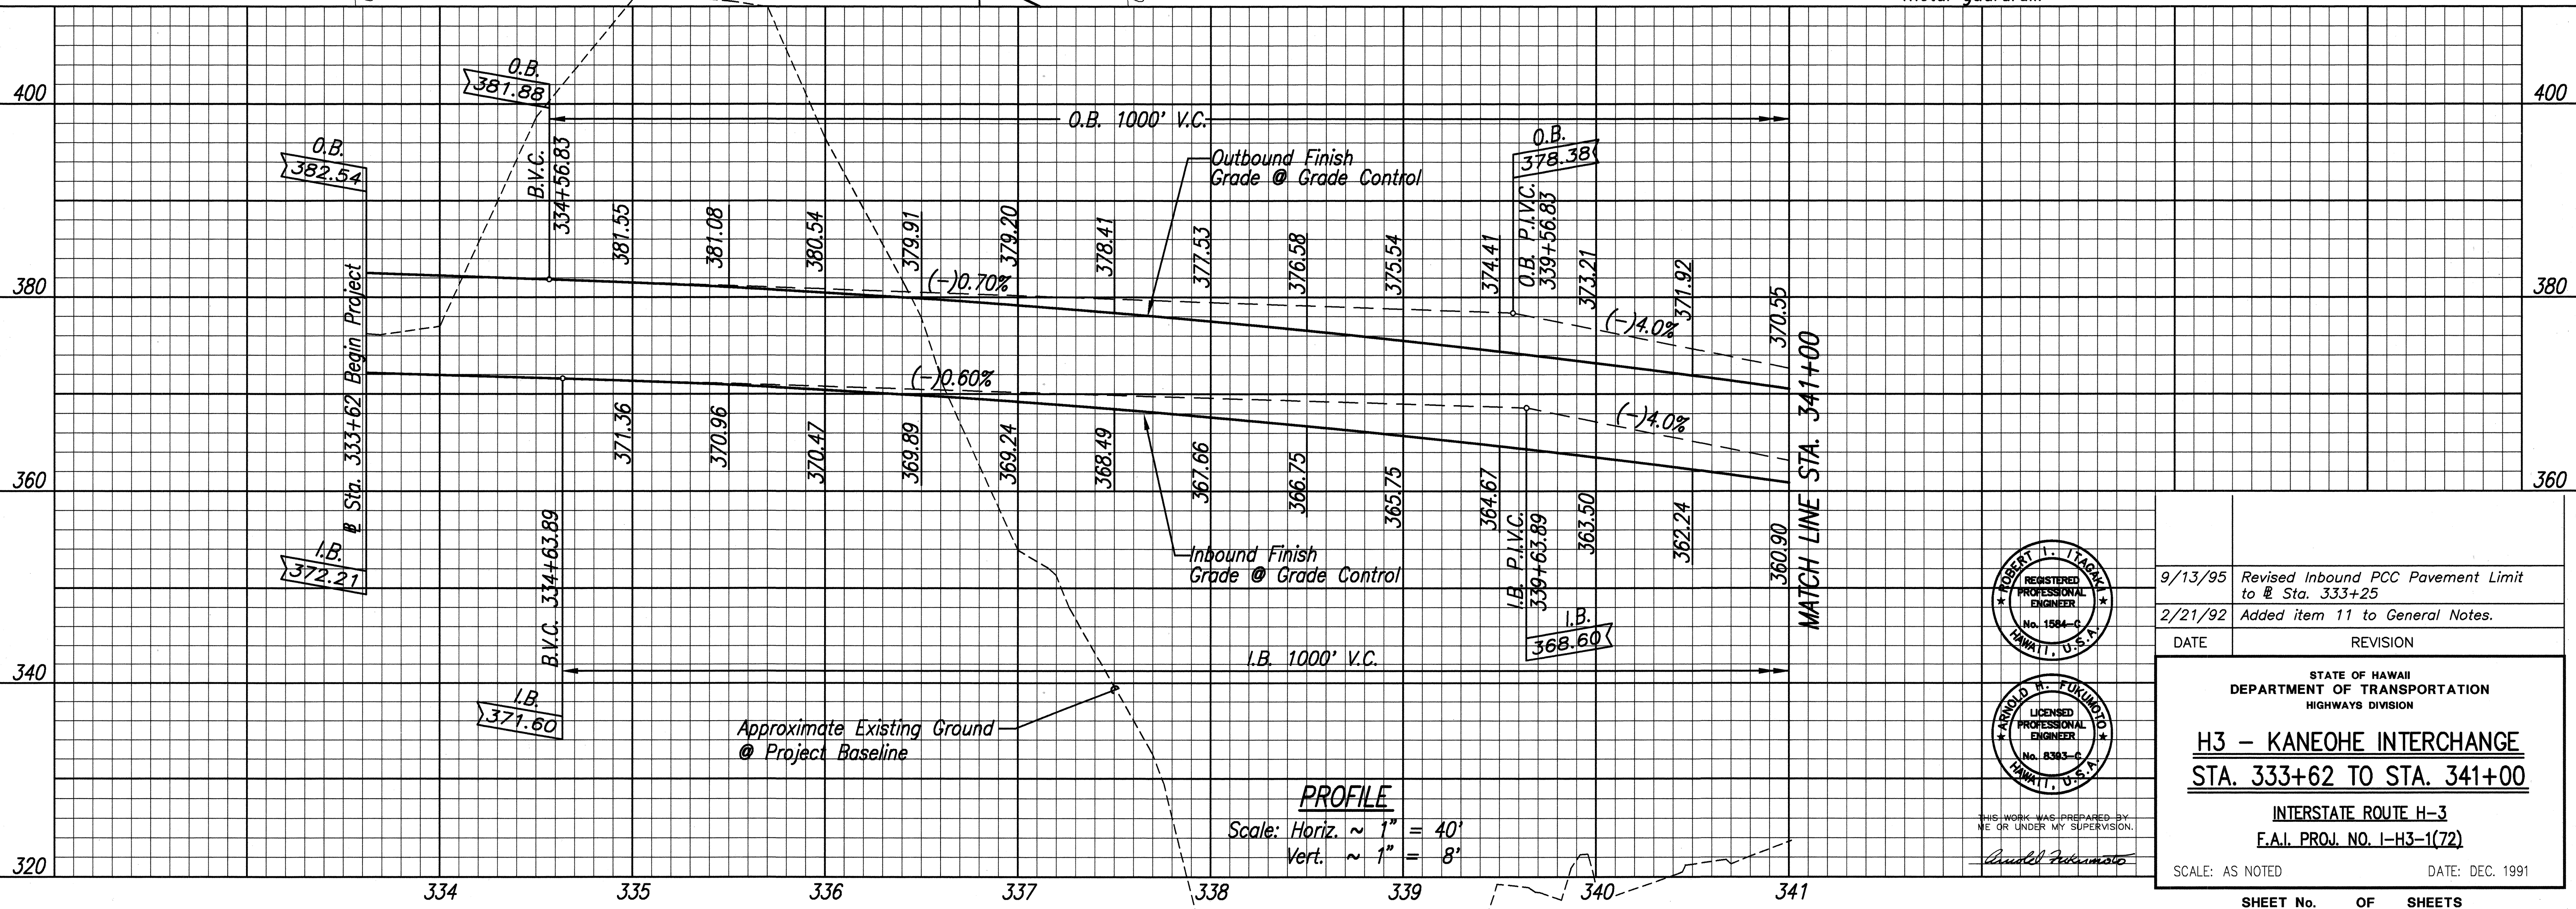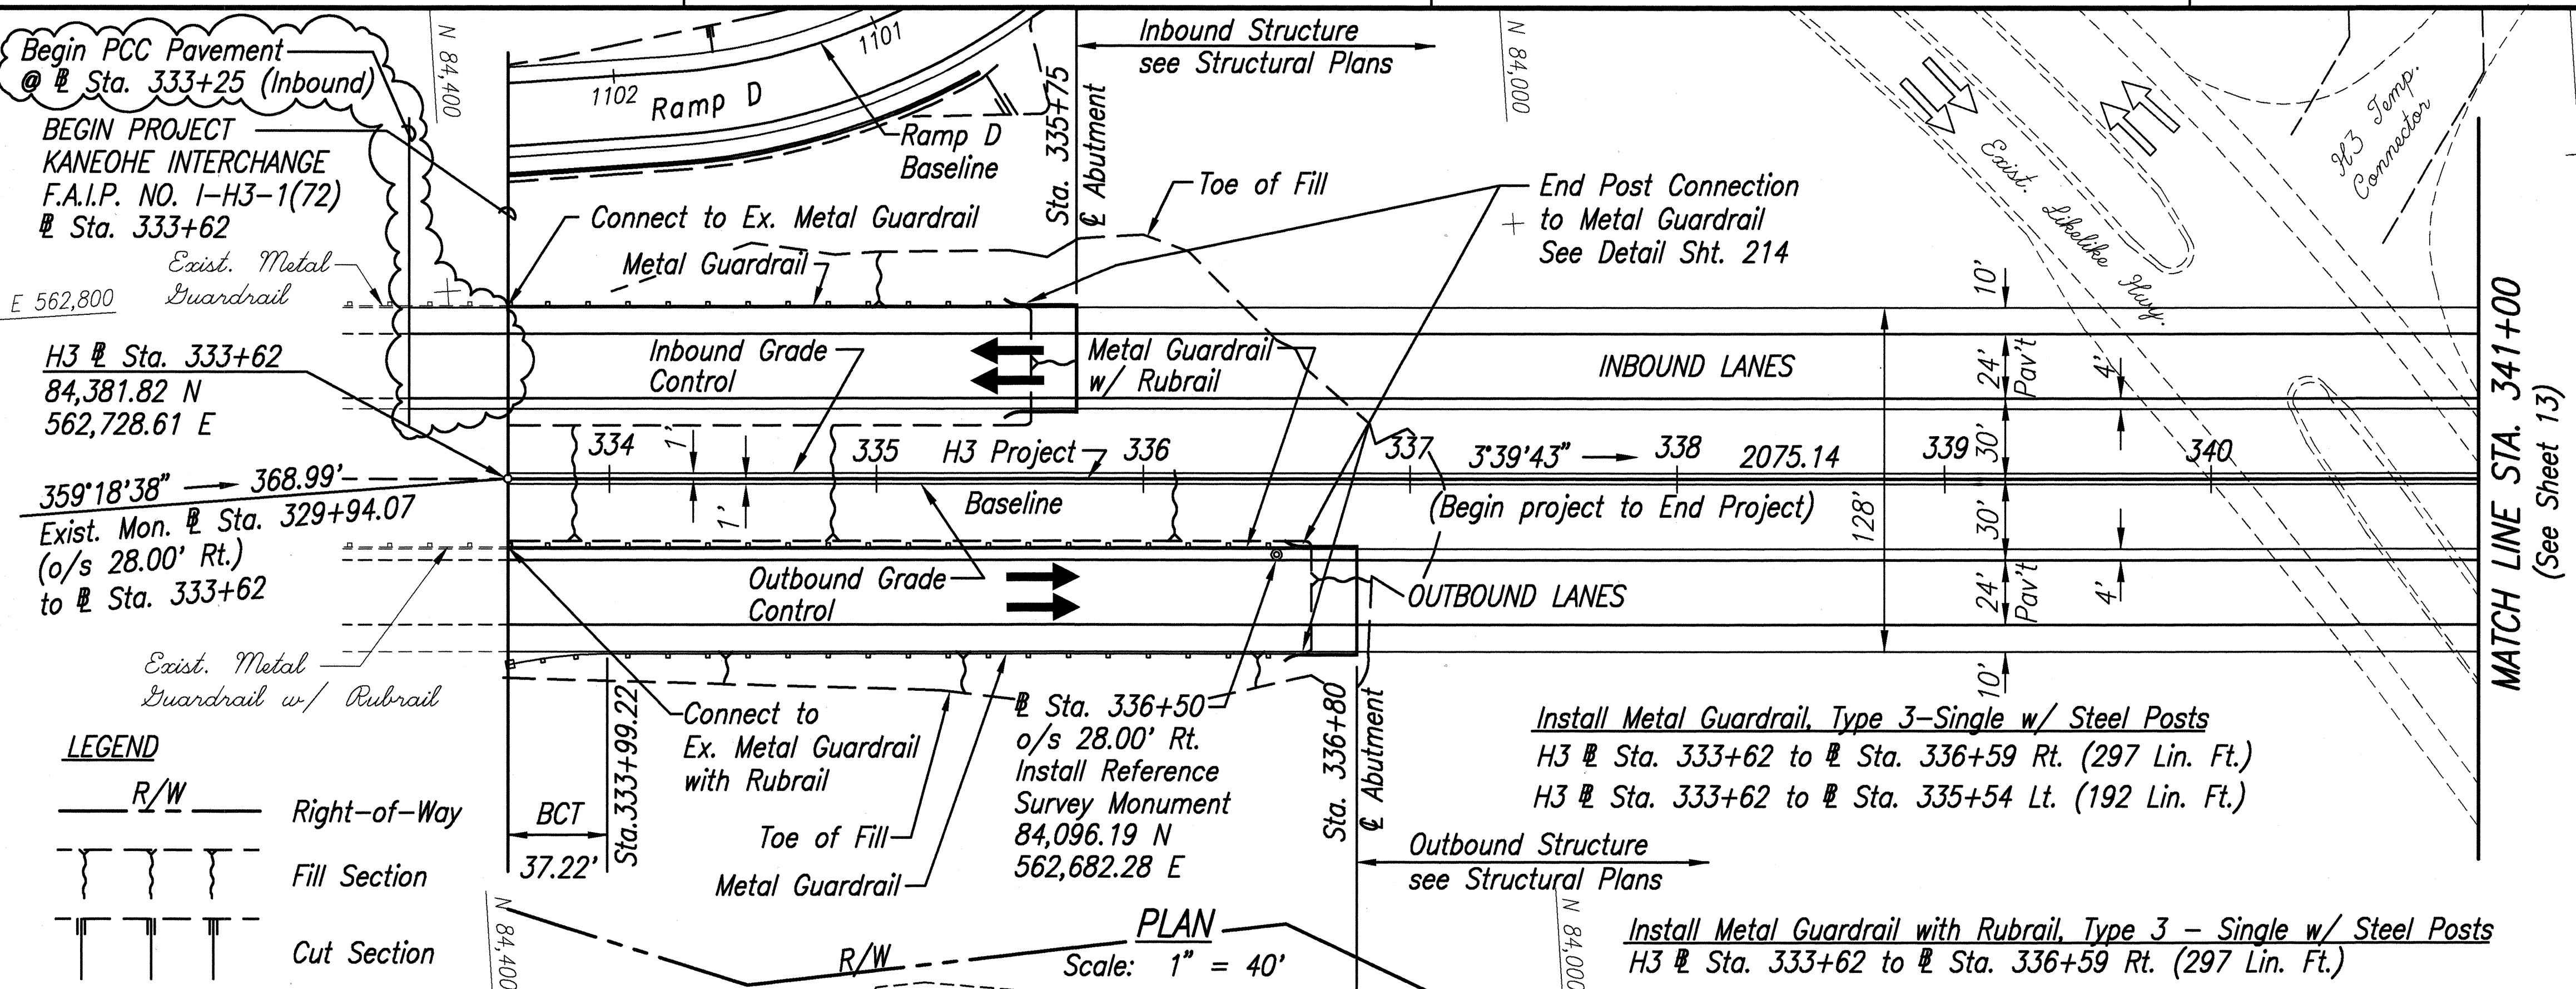

9/13/95	Revised Inbound PCC Pavement Limit to Sta. 333+25
2/21/92	Added item 11 to General Notes.

DATE	REVISION
------	----------

STATE OF HAWAII
DEPARTMENT OF TRANSPORTATION
HIGHWAYS DIVISION

H3 - KANEOHE INTERCHANGE
STA. 333+62 TO STA. 341+00




INTERSTATE ROUTE H-3
F.A.I. PROJ. NO. I-H3-1(72)

SCALE: AS NOTED DATE: DEC. 1991


SURVEY PLOTTED BY	DATE
DRAWN BY	
DESIGNED BY	
QUANTITIES BY	
NO.	

83-462 (Rev. 1-72) - L.W. Dwyer - H3 Proj. - 10/12/95 JY

FED. ROAD DIST. NO.	STATE	PROJ. NO.	FISCAL YEAR	SHEET NO.	TOTAL SHEETS
HAWAII	HAW.	I-H3-1(72)	1991	13	521

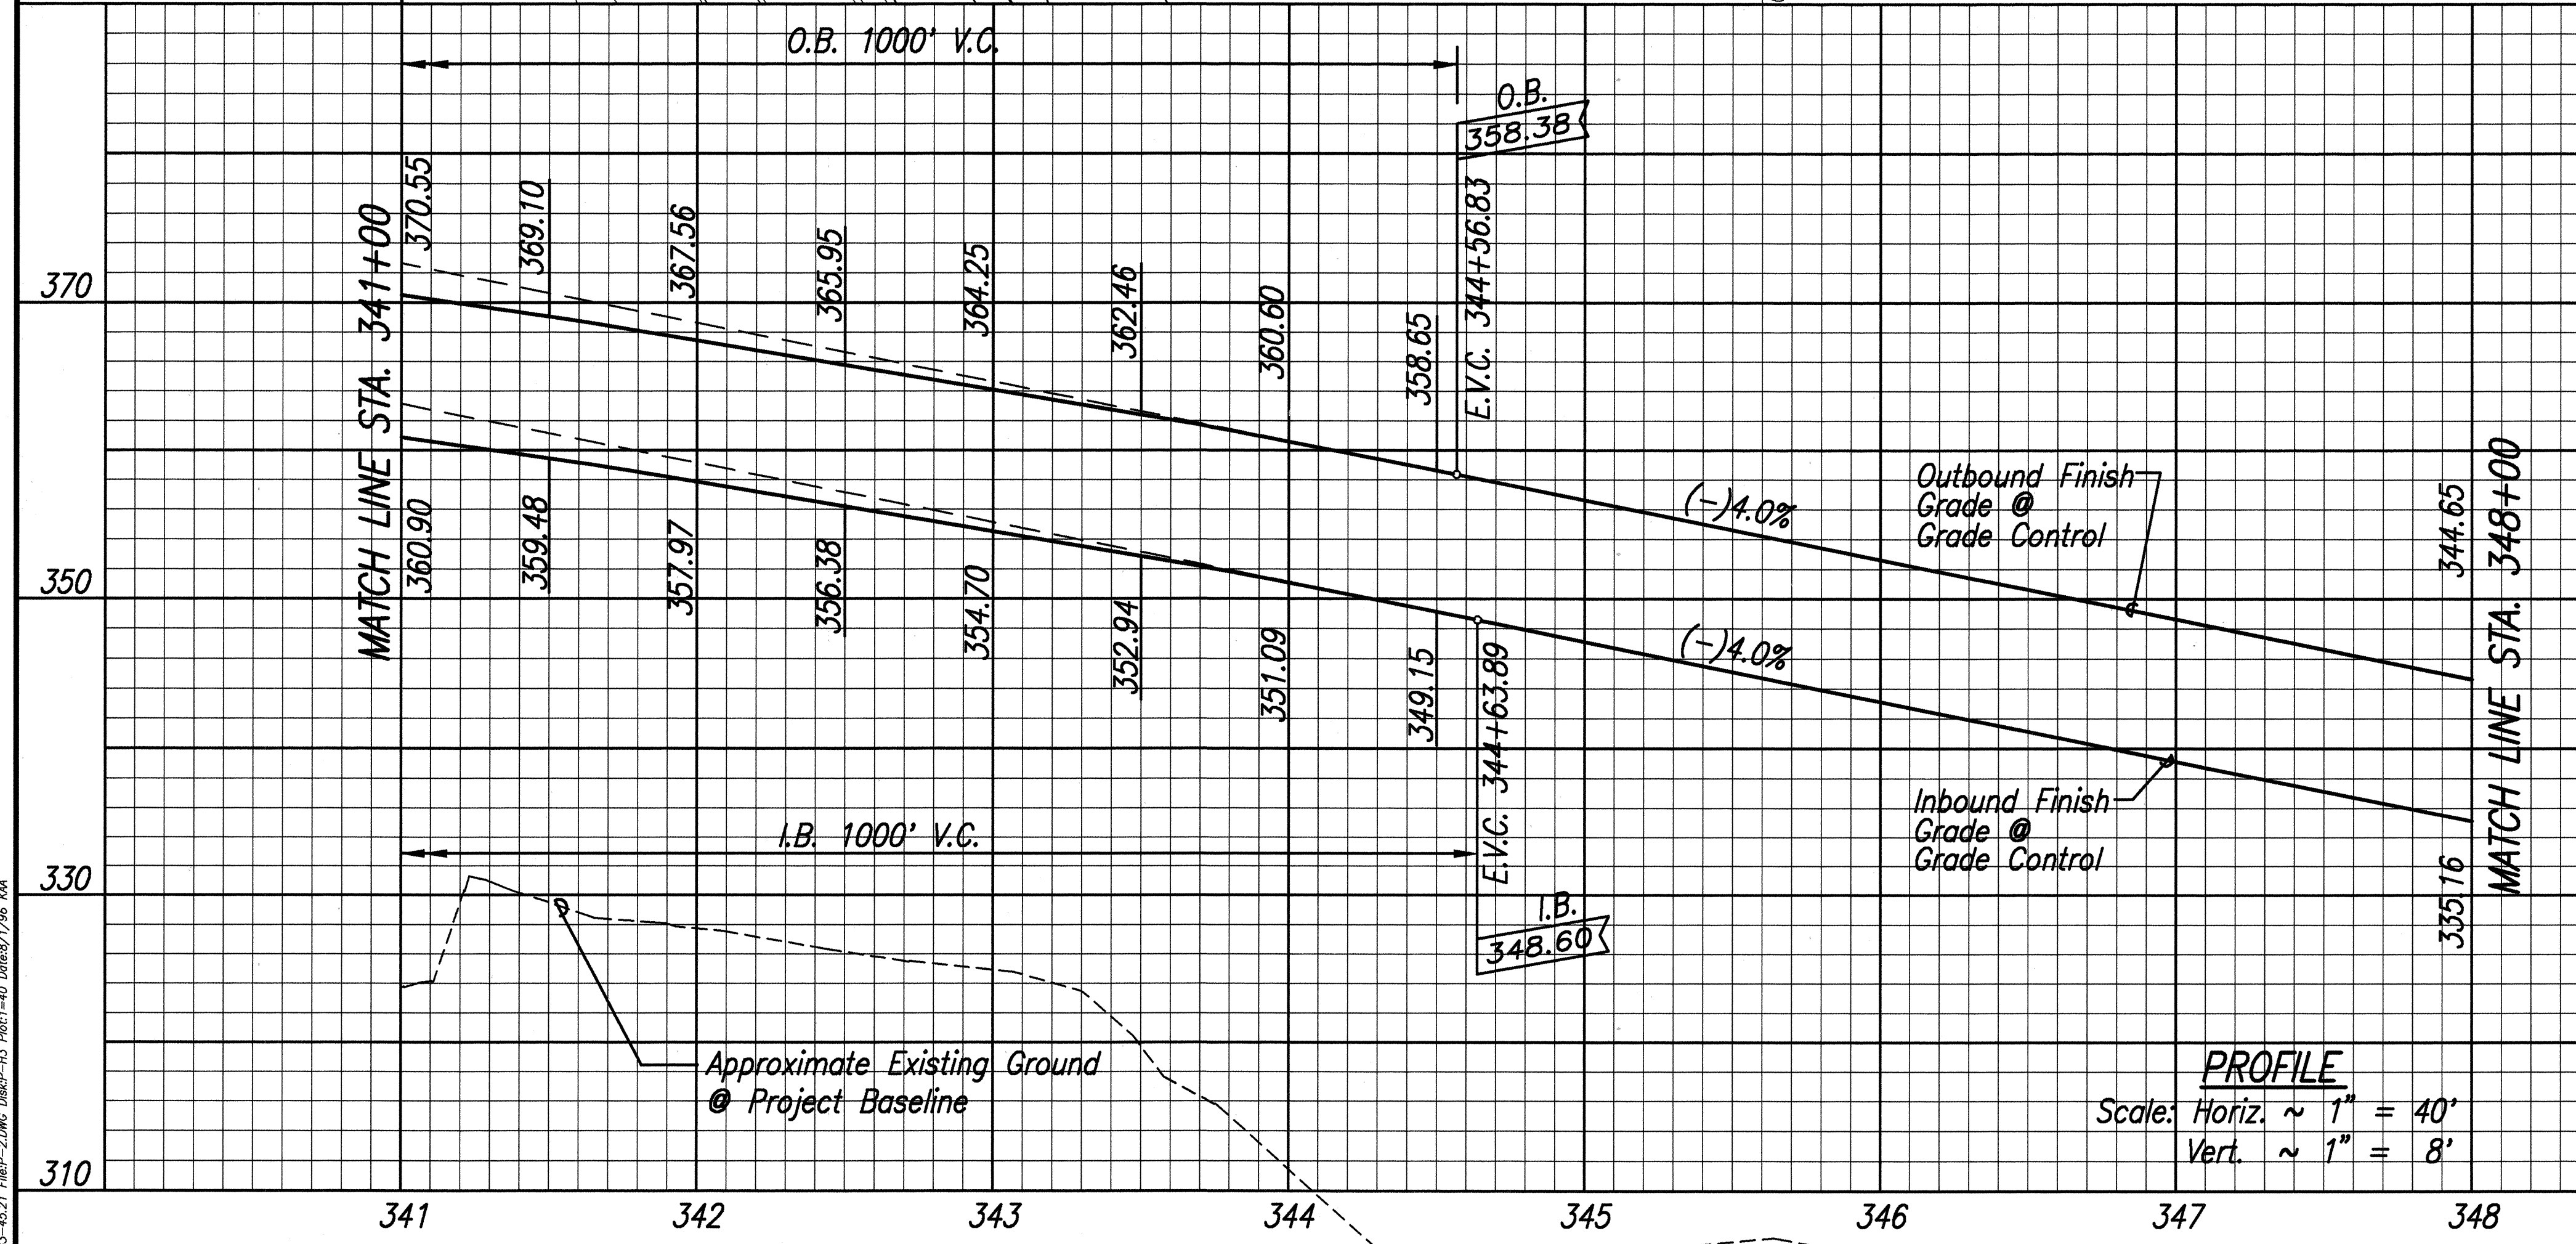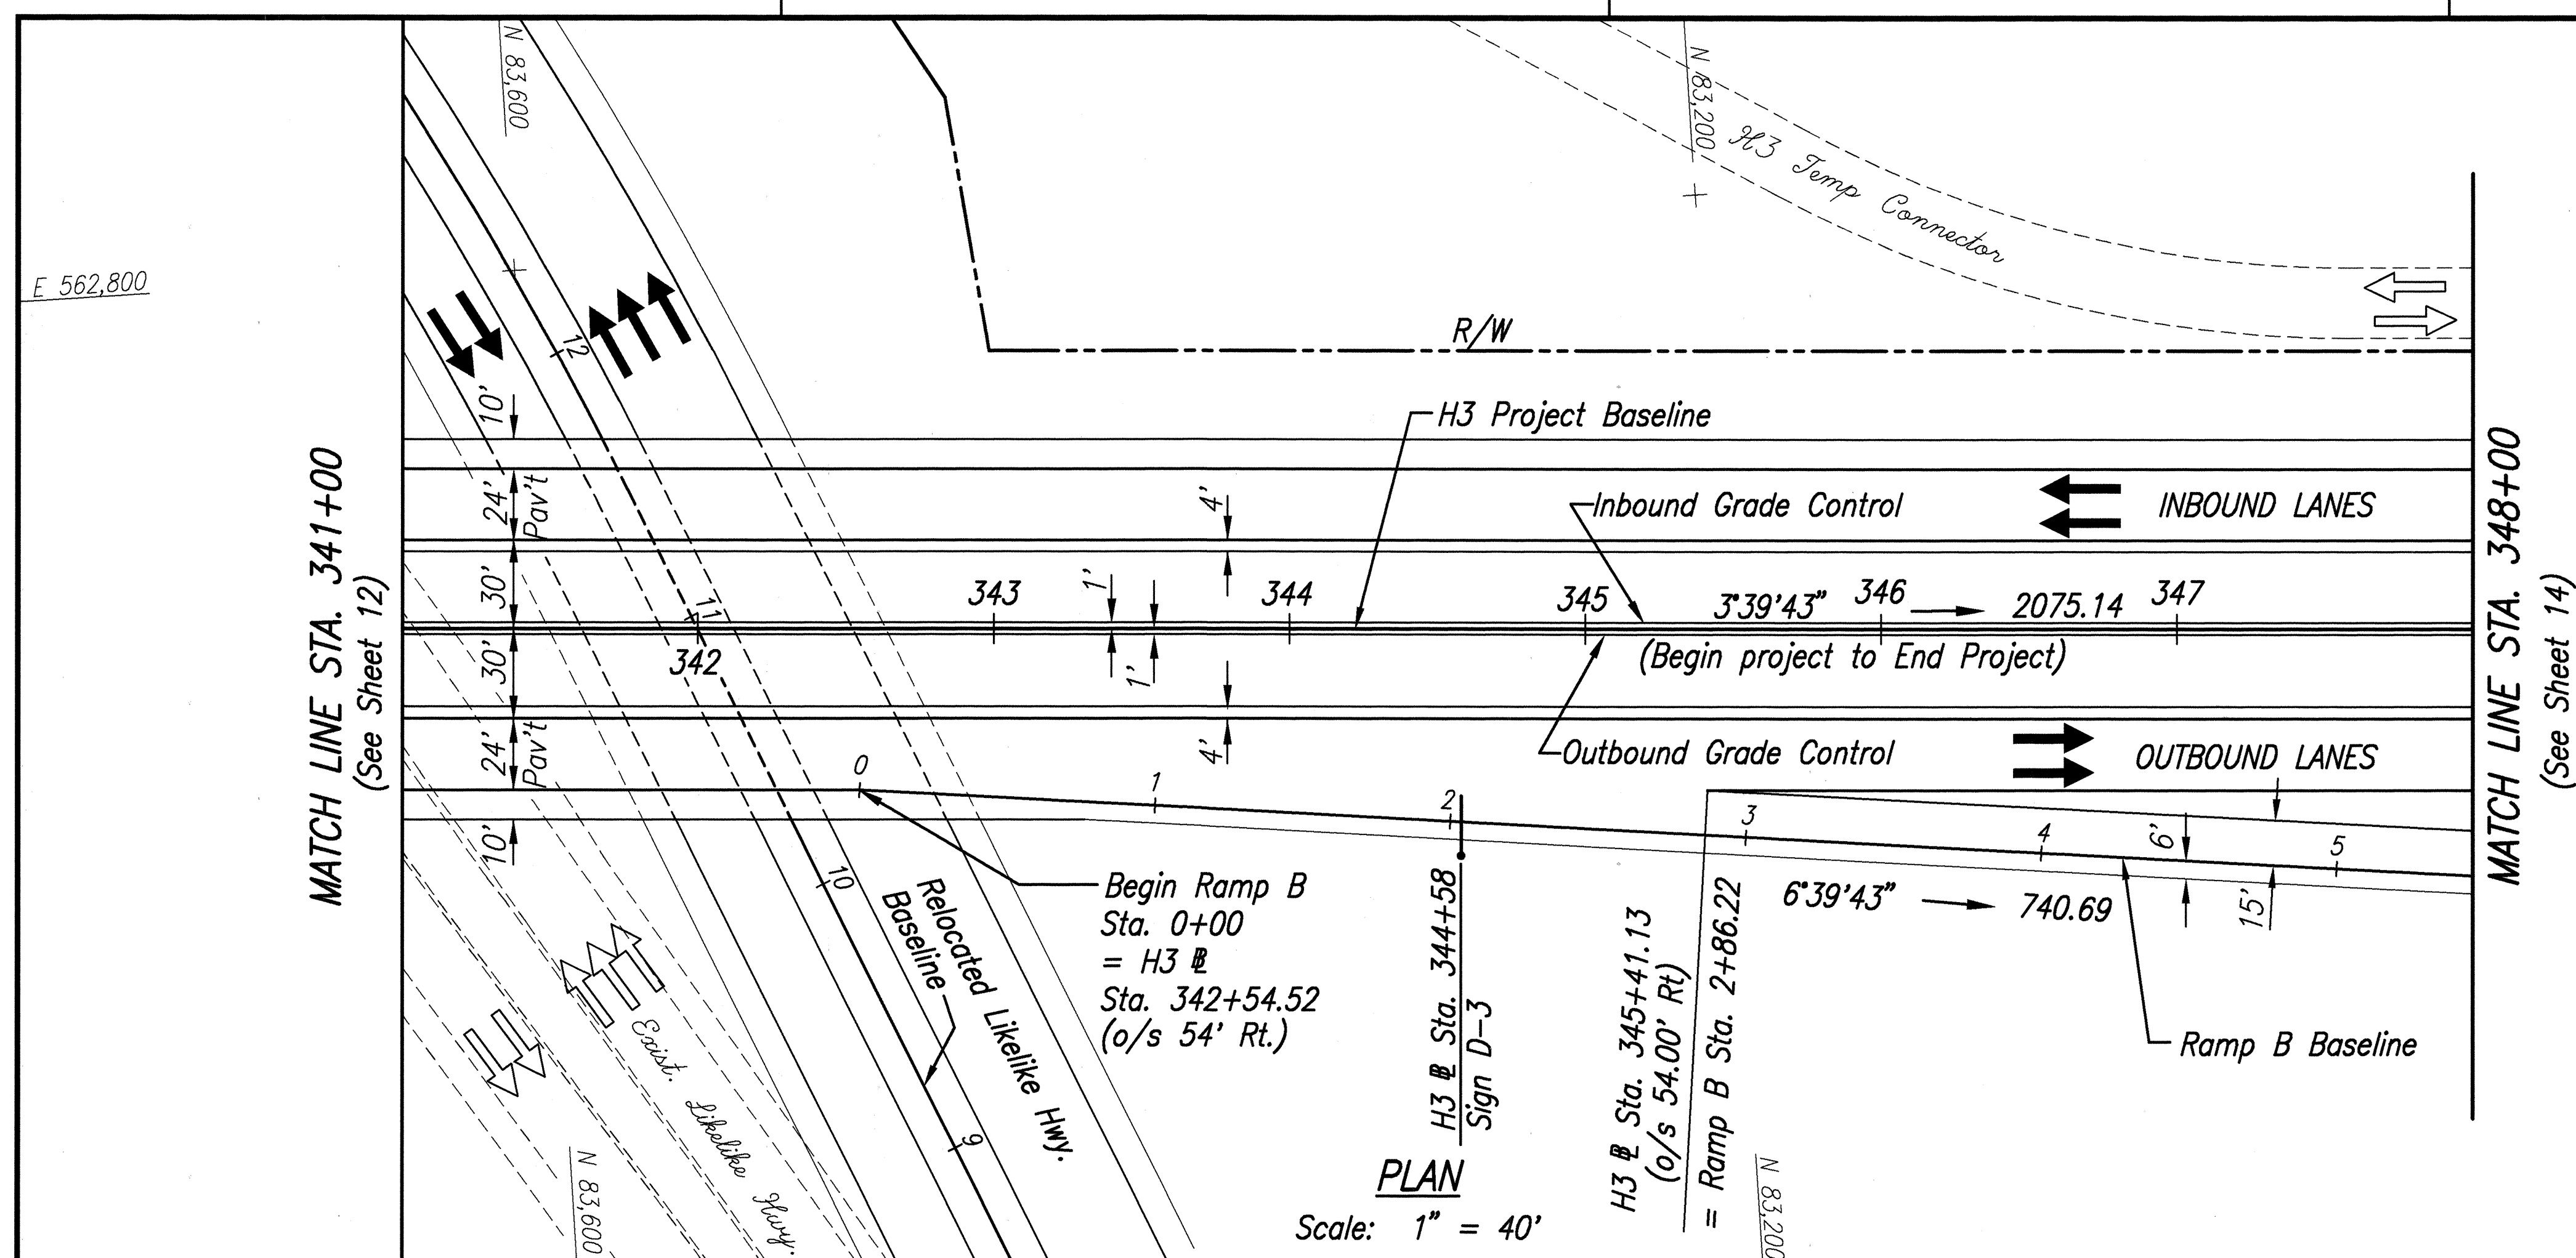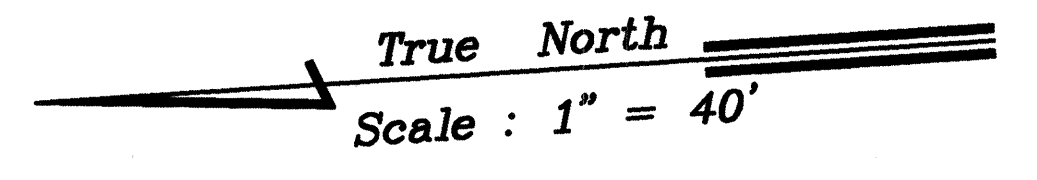

ORIGINAL PLAN	DATE
TRACED BY	
DESIGNED BY	
QUANTITIES BY	
No.	

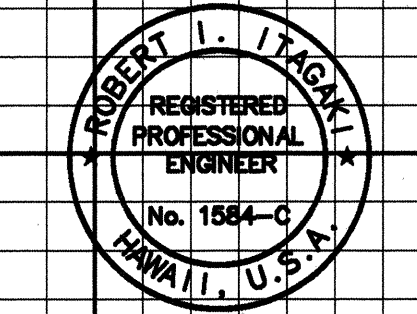

STATE OF HAWAII
DEPARTMENT OF TRANSPORTATION
HIGHWAYS DIVISION



H3 - KANEOHE INTERCHANGE
STA. 341+00 TO STA. 348+00

INTERSTATE ROUTE H-3
F.A.I. PROJ. NO. I-H3-1(72)

SCALE: AS NOTED
DATE:


SHEET No. 13 OF 521 SHEETS

E 562,800

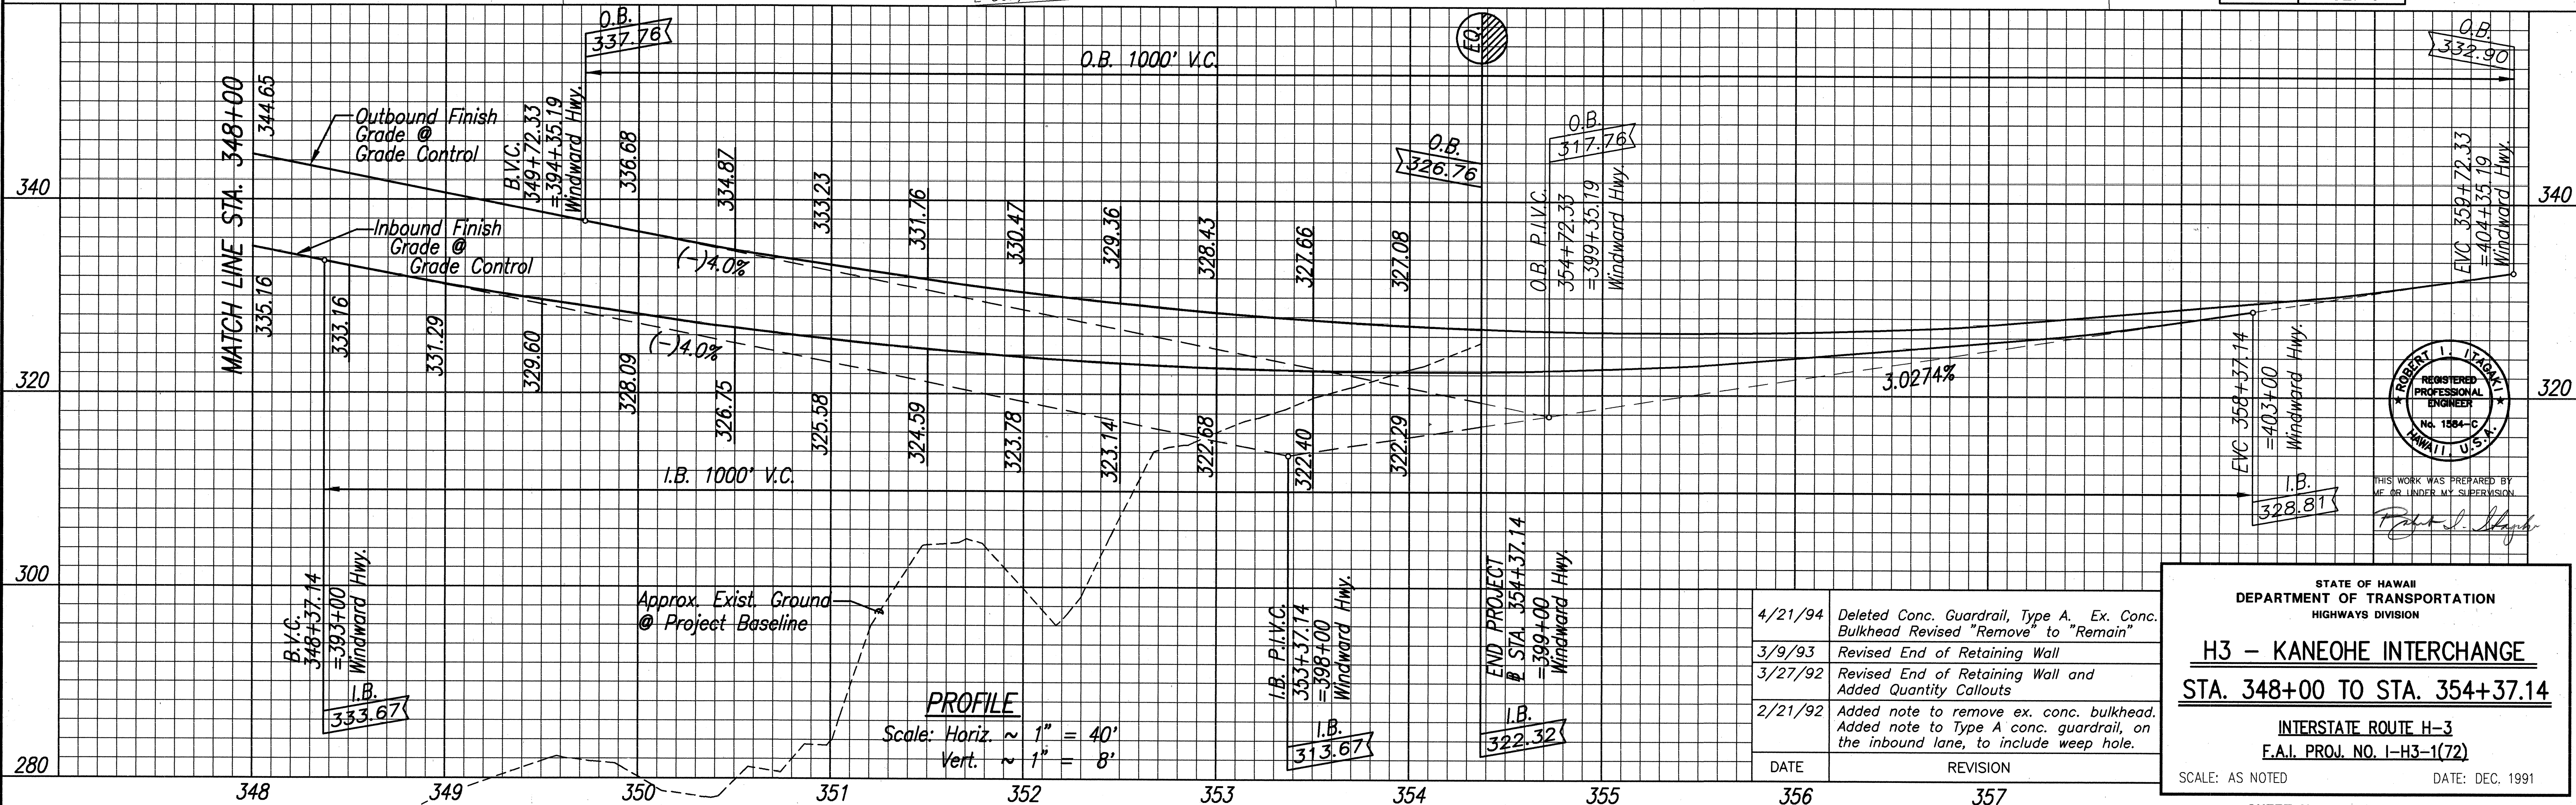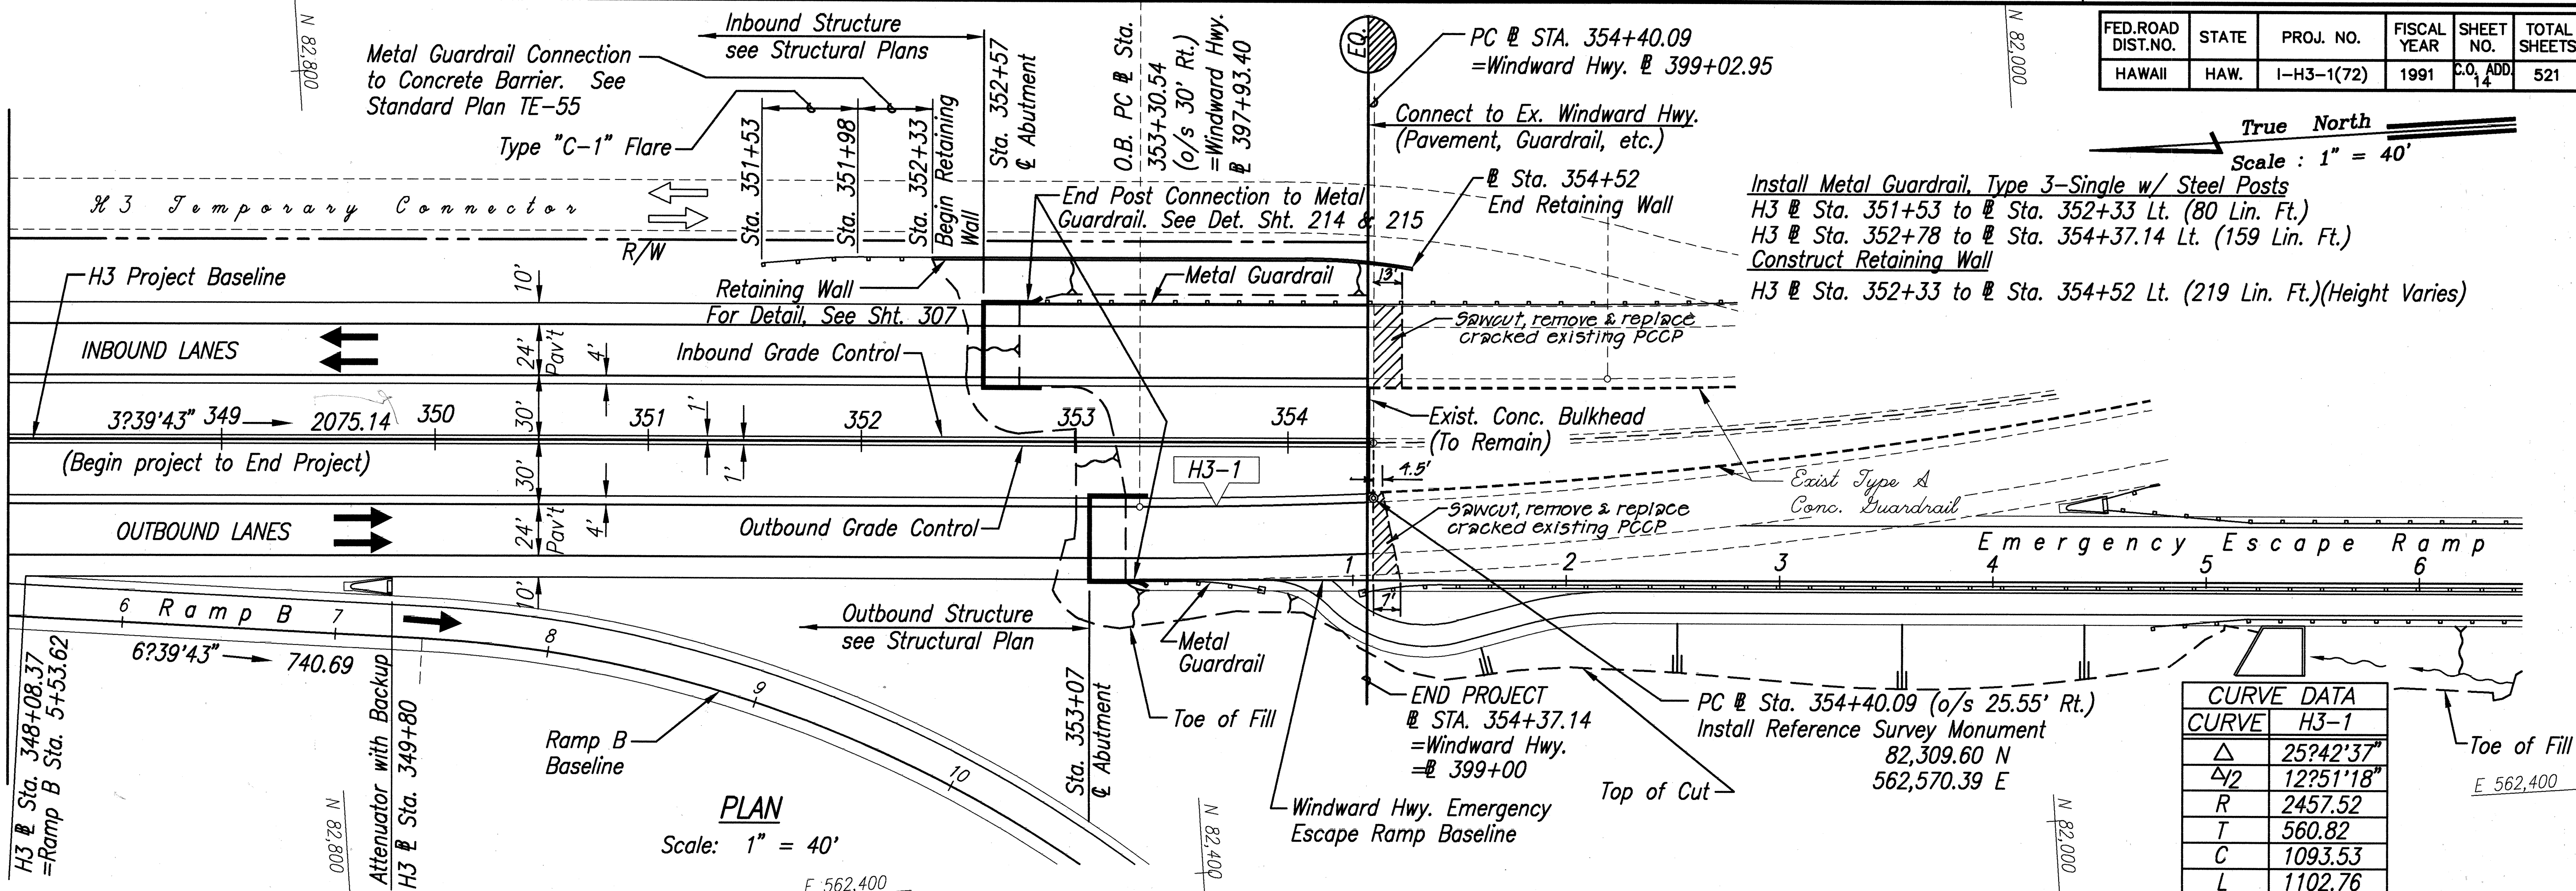MATCH LINE STA. 348+00
(See Sheet 13)

FED. ROAD DIST. NO.	STATE	PROJ. NO.	FISCAL YEAR	SHEET NO.	TOTAL SHEETS
HAWAII	HAW.	I-H3-1(72)	1991	ADD. 15	521


True North
Scale: 1" = 40'

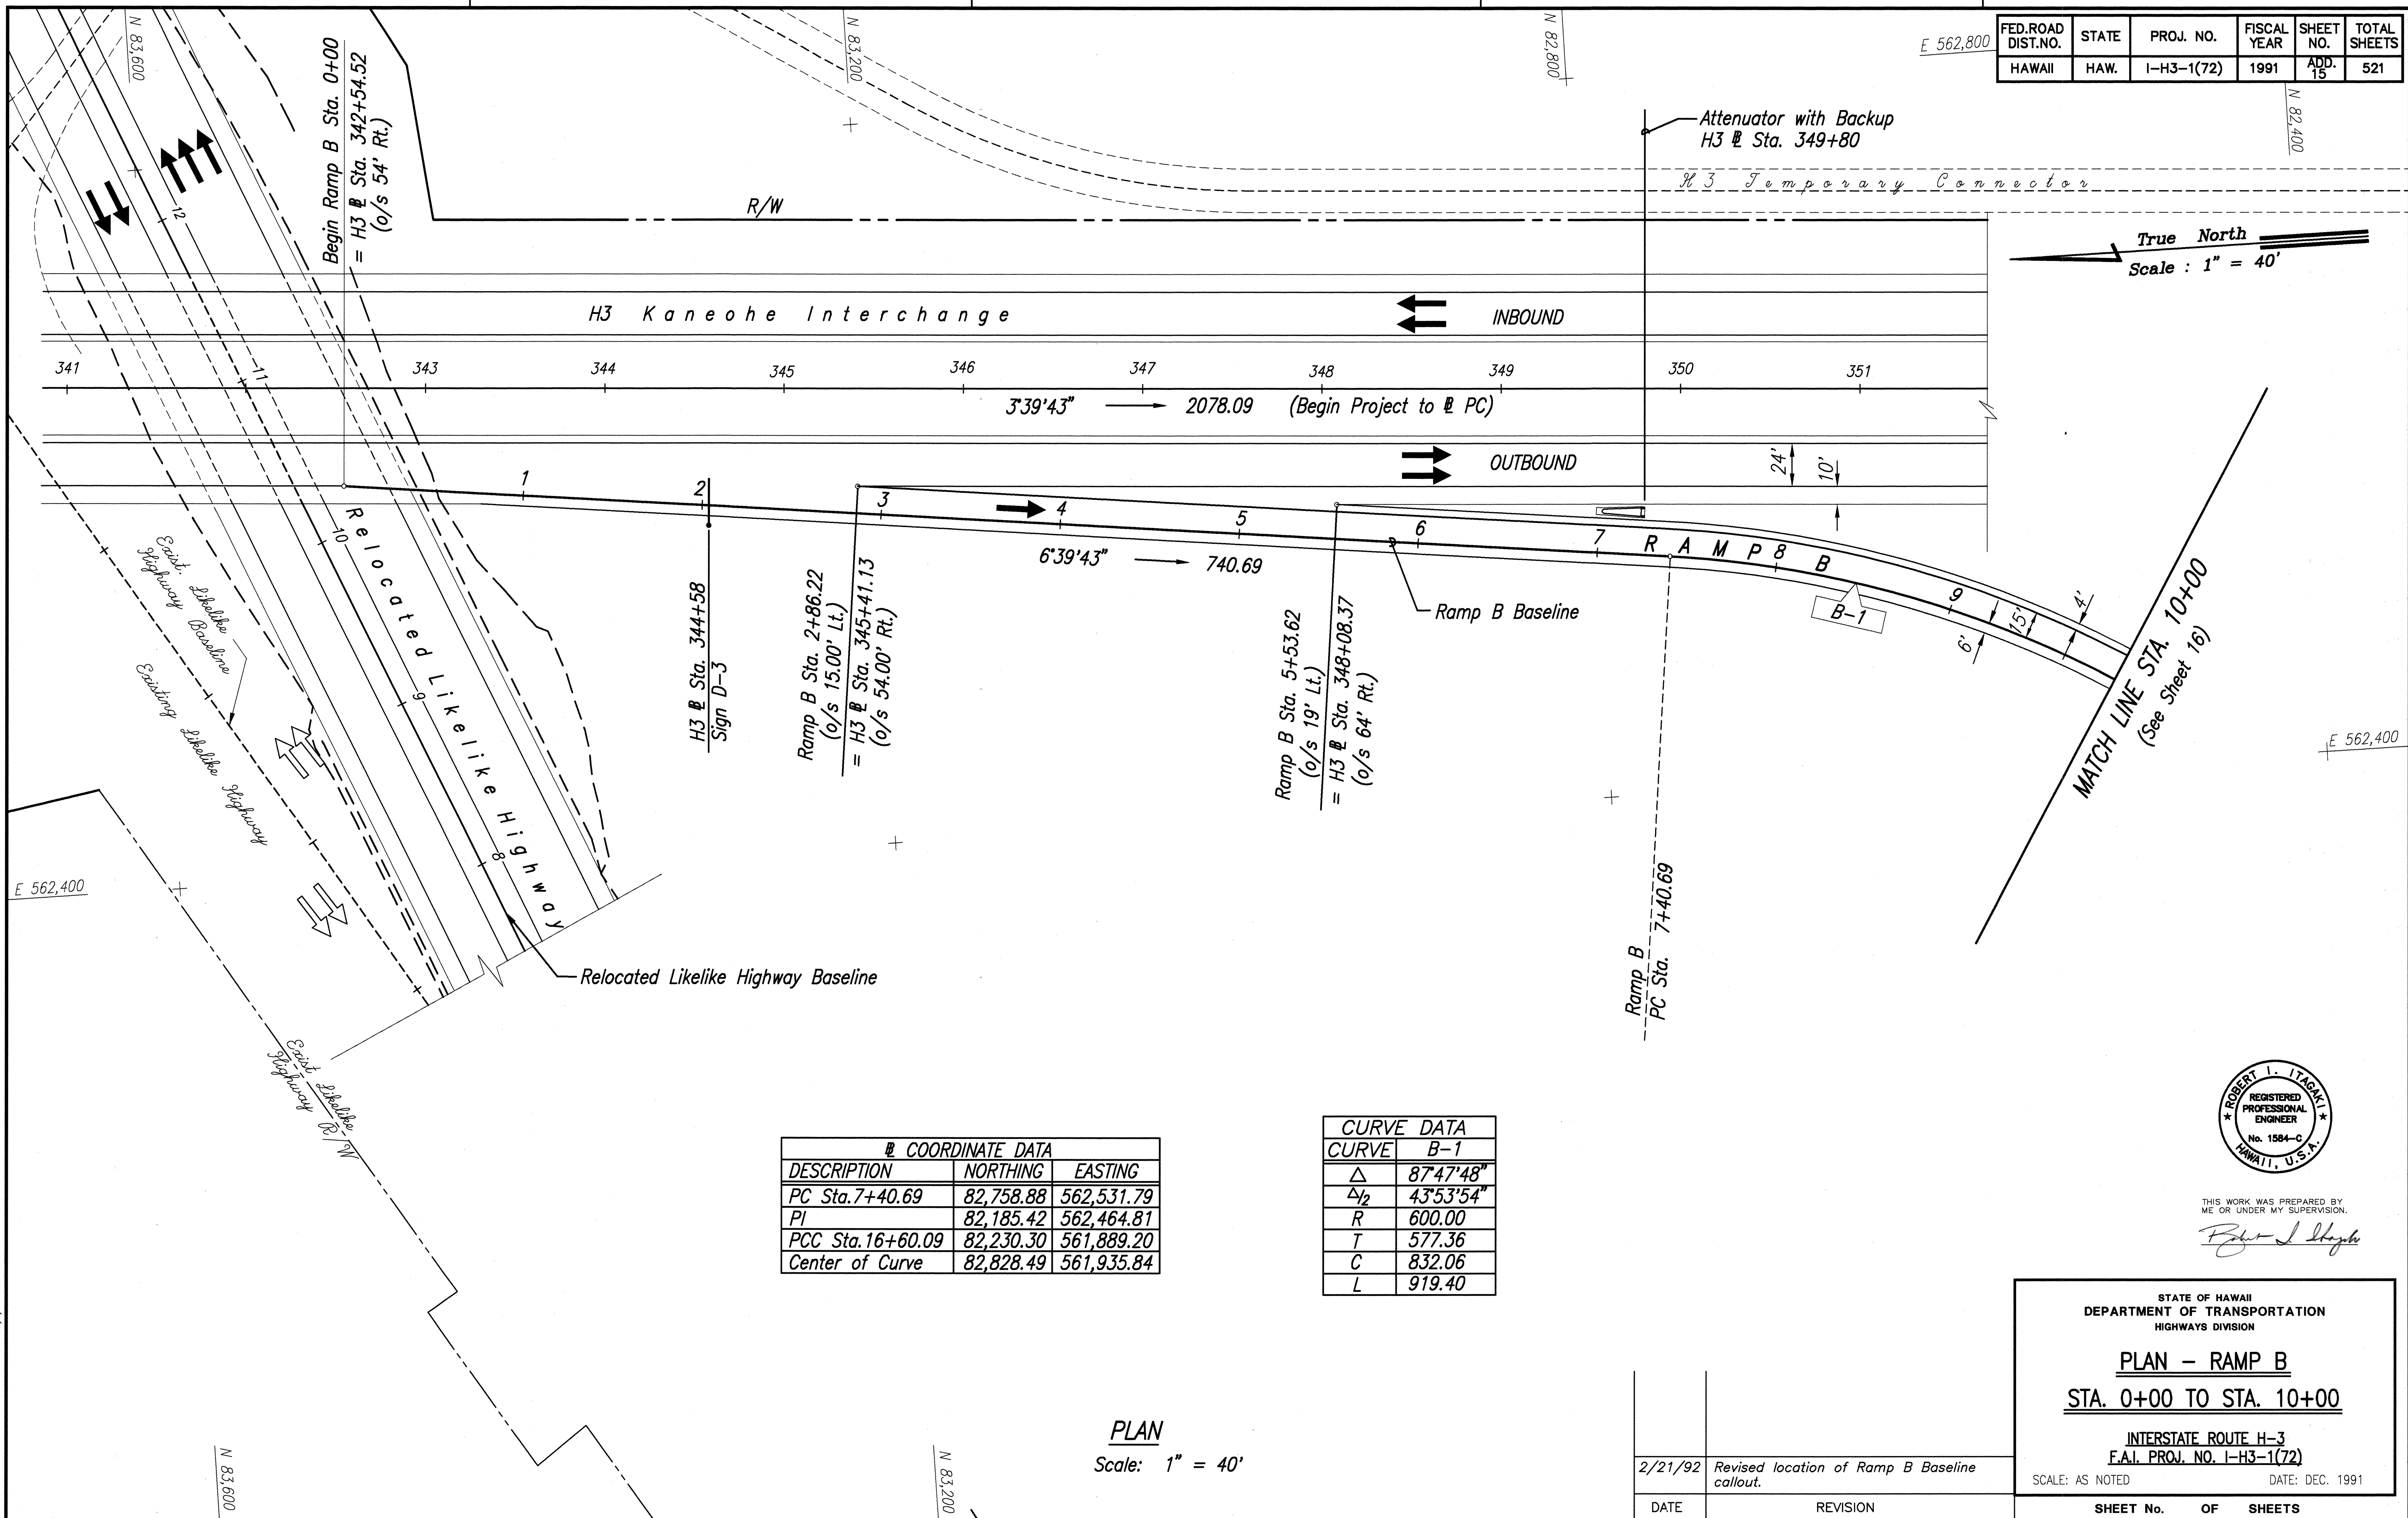

COORDINATE DATA		
DESCRIPTION	NORTHING	EASTING
PC Sta. 7+40.69	82,758.88	562,531.79
PI	82,185.42	562,464.81
PCC Sta. 16+60.09	82,230.30	561,889.20
Center of Curve	82,828.49	561,935.84

CURVE DATA	
CURVE	B-1
Δ	87°47'48"
$\Delta/2$	43°53'54"
R	600.00
T	577.36
C	832.06
L	919.40

PLAN
Scale: 1" = 40'

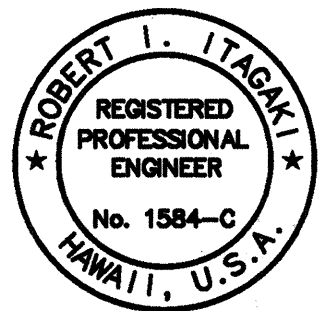

THIS WORK WAS PREPARED BY ME OR UNDER MY SUPERVISION.

Robert I. Itasca

STATE OF HAWAII
DEPARTMENT OF TRANSPORTATION
HIGHWAYS DIVISION

PLAN - RAMP B
STA. 0+00 TO STA. 10+00

INTERSTATE ROUTE H-3
F.A.I. PROJ. NO. I-H3-1(72)


SCALE: AS NOTED DATE: DEC. 1991

SHEET No. OF SHEETS

ADD. 15

ORIGINAL PLAN	DATE
DESIGNED BY	
DRAWN BY	
CHECKED BY	
NO.	


83-462 P&E-LONG DIST-3 RAMP 100 P&E-40 DATE: 8/96 KAA

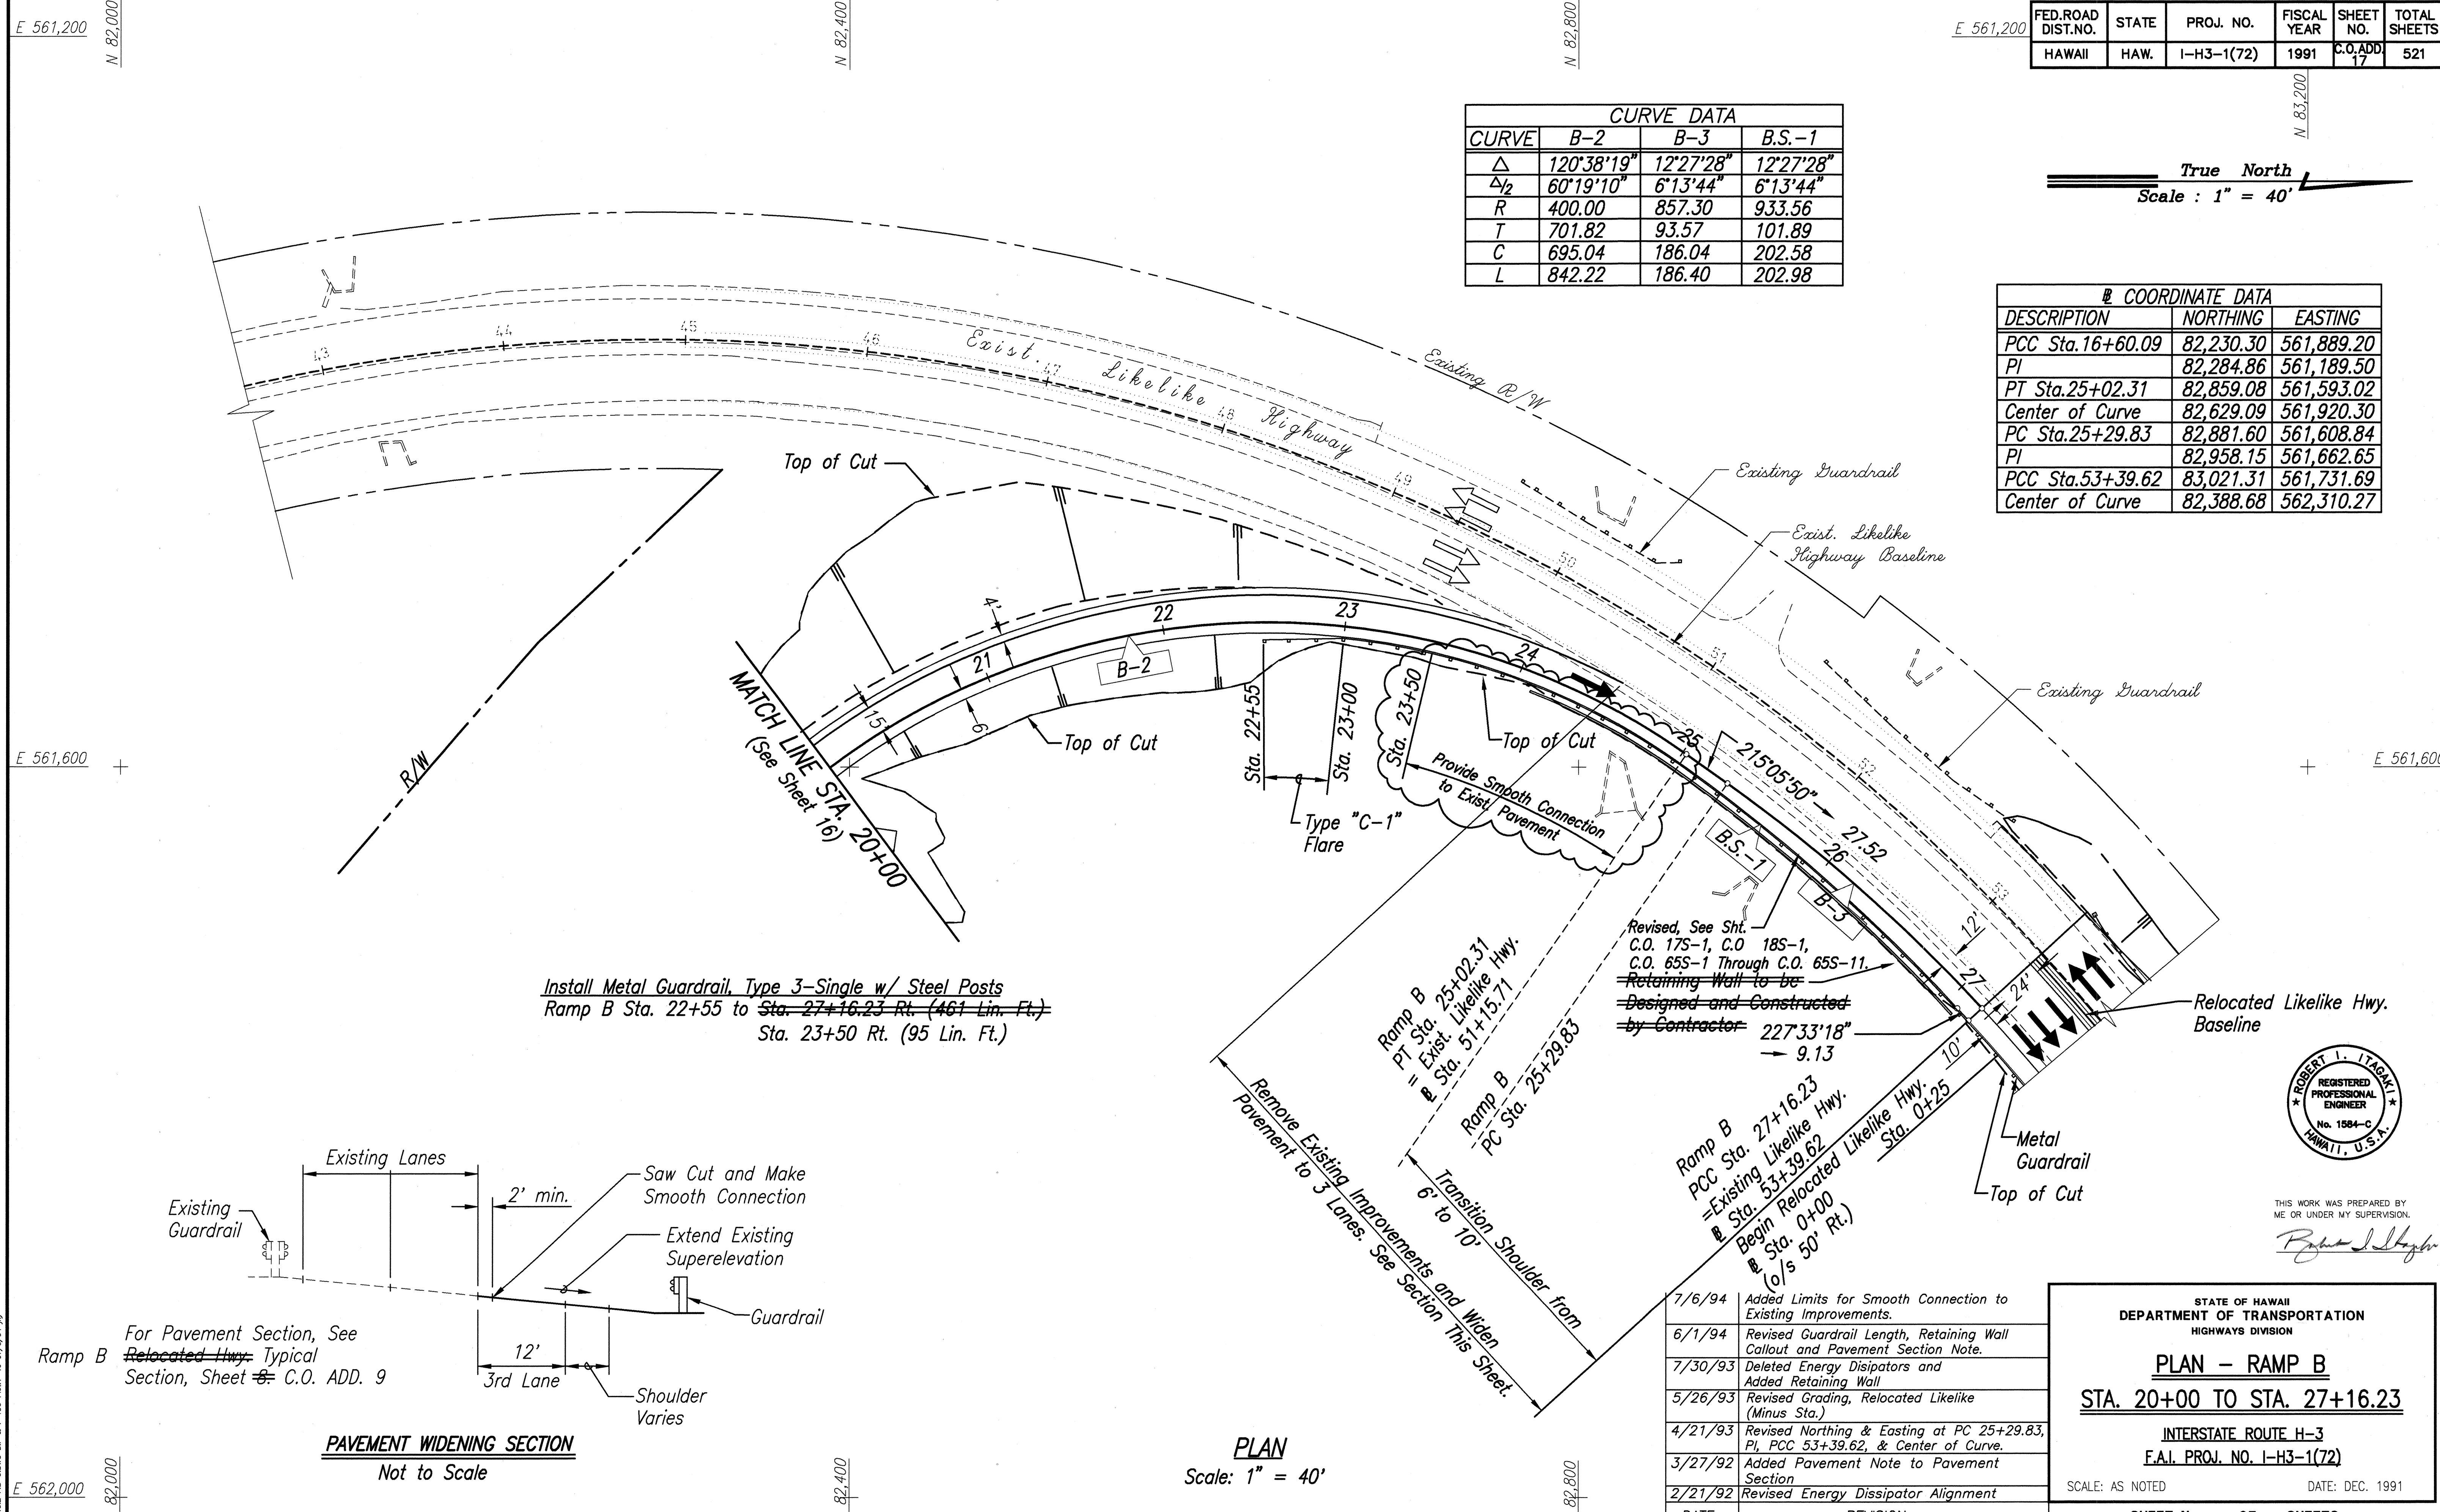

CURVE DATA			
CURVE	B-2	B-3	B.S.-1
Δ	120°38'19"	12°27'28"	12°27'28"
$\Delta/2$	60°19'10"	6°13'44"	6°13'44"
R	400.00	857.30	933.56
T	701.82	93.57	101.89
C	695.04	186.04	202.58
L	842.22	186.40	202.98

COORDINATE DATA		
DESCRIPTION	NORTHING	EASTING
PCC Sta.16+60.09	82,230.30	561,889.20
PI	82,284.86	561,189.50
PT Sta.25+02.31	82,859.08	561,593.02
Center of Curve	82,629.09	561,920.30
PC Sta.25+29.83	82,881.60	561,608.84
PI	82,958.15	561,662.65
PCC Sta.53+39.62	83,021.31	561,731.69
Center of Curve	82,388.68	562,310.27

ORIGINAL PLAN	DATE
DESIGNED BY	
DRAWN BY	
CHECKED BY	
NO.	

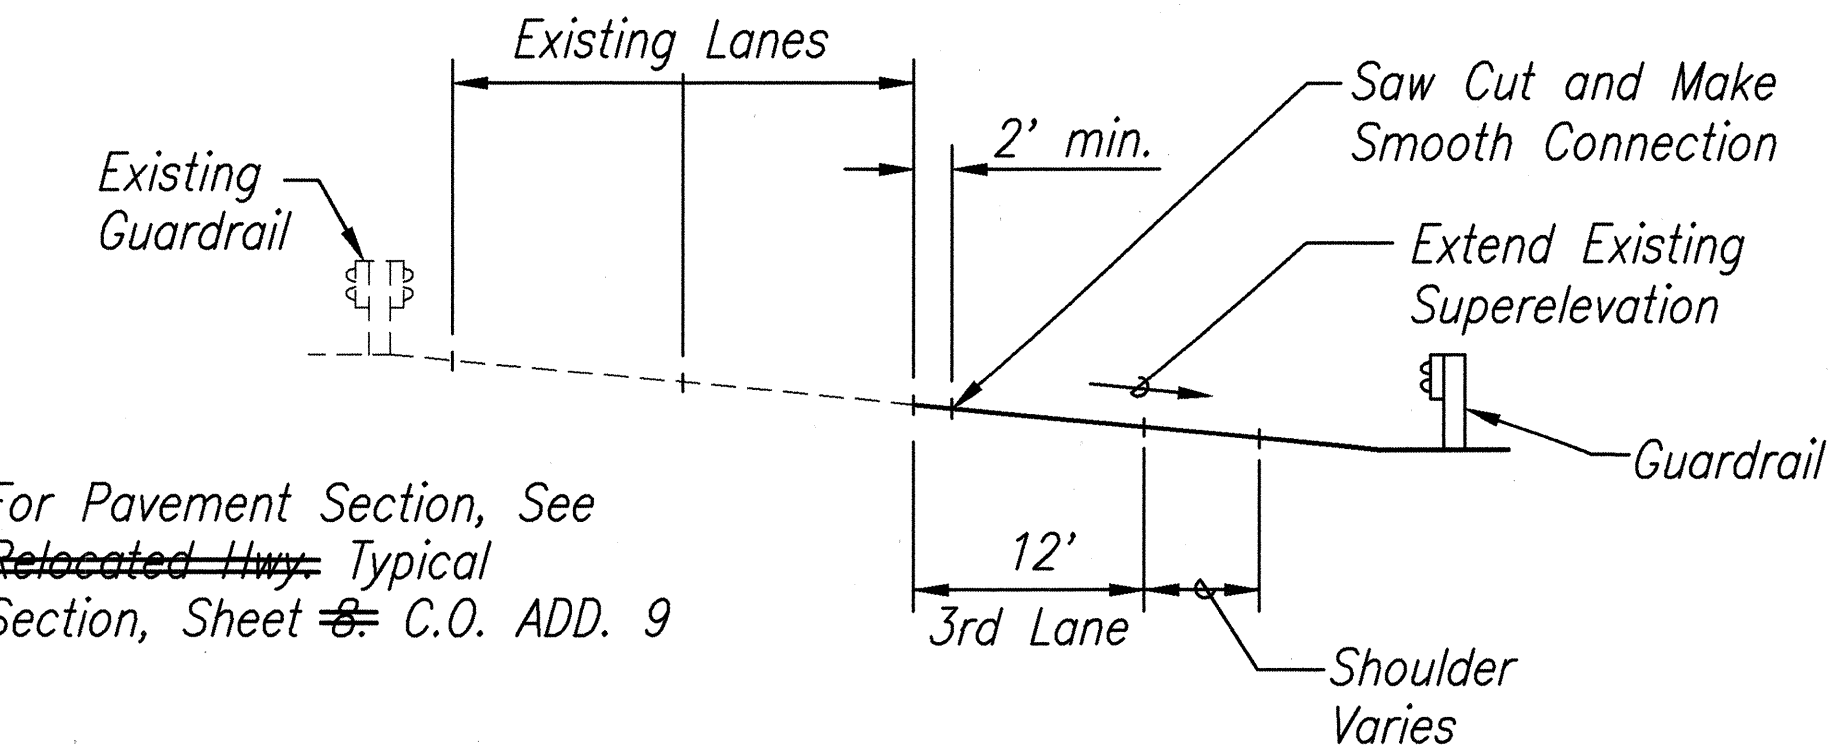

DATE	REVISION
7/6/94	Added Limits for Smooth Connection to Existing Improvements.
6/1/94	Revised Guardrail Length, Retaining Wall Callout and Pavement Section Note.
7/30/93	Deleted Energy Dissipators and Added Retaining Wall
5/26/93	Revised Grading, Relocated Likelike (Minus Sta.)
4/21/93	Revised Northing & Easting at PC 25+29.83, PI, PCC 53+39.62, & Center of Curve.
3/27/92	Added Pavement Note to Pavement Section
2/21/92	Revised Energy Dissipator Alignment


STATE OF HAWAII
DEPARTMENT OF TRANSPORTATION
HIGHWAYS DIVISION

PLAN - RAMP B
STA. 20+00 TO STA. 27+16.23

INTERSTATE ROUTE H-3
F.A.I. PROJ. NO. I-H3-1(72)

SCALE: AS NOTED DATE: DEC. 1991

SHEET No. OF SHEETS

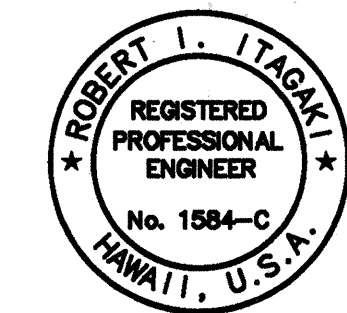


THIS WORK WAS PREPARED BY ME OR UNDER MY SUPERVISION.
Robert L. Itagaki

PLAN
Scale: 1" = 40'

PAVEMENT WIDENING SECTION
Not to Scale

FED. ROAD DIST. NO.	STATE	FED. AID PROJ. NO.	FISCAL YEAR	SHEET NO.	TOTAL SHEETS
HAWAII	HAW.	I-H3-1 (72)	1991	C.O. 17 S-1	521

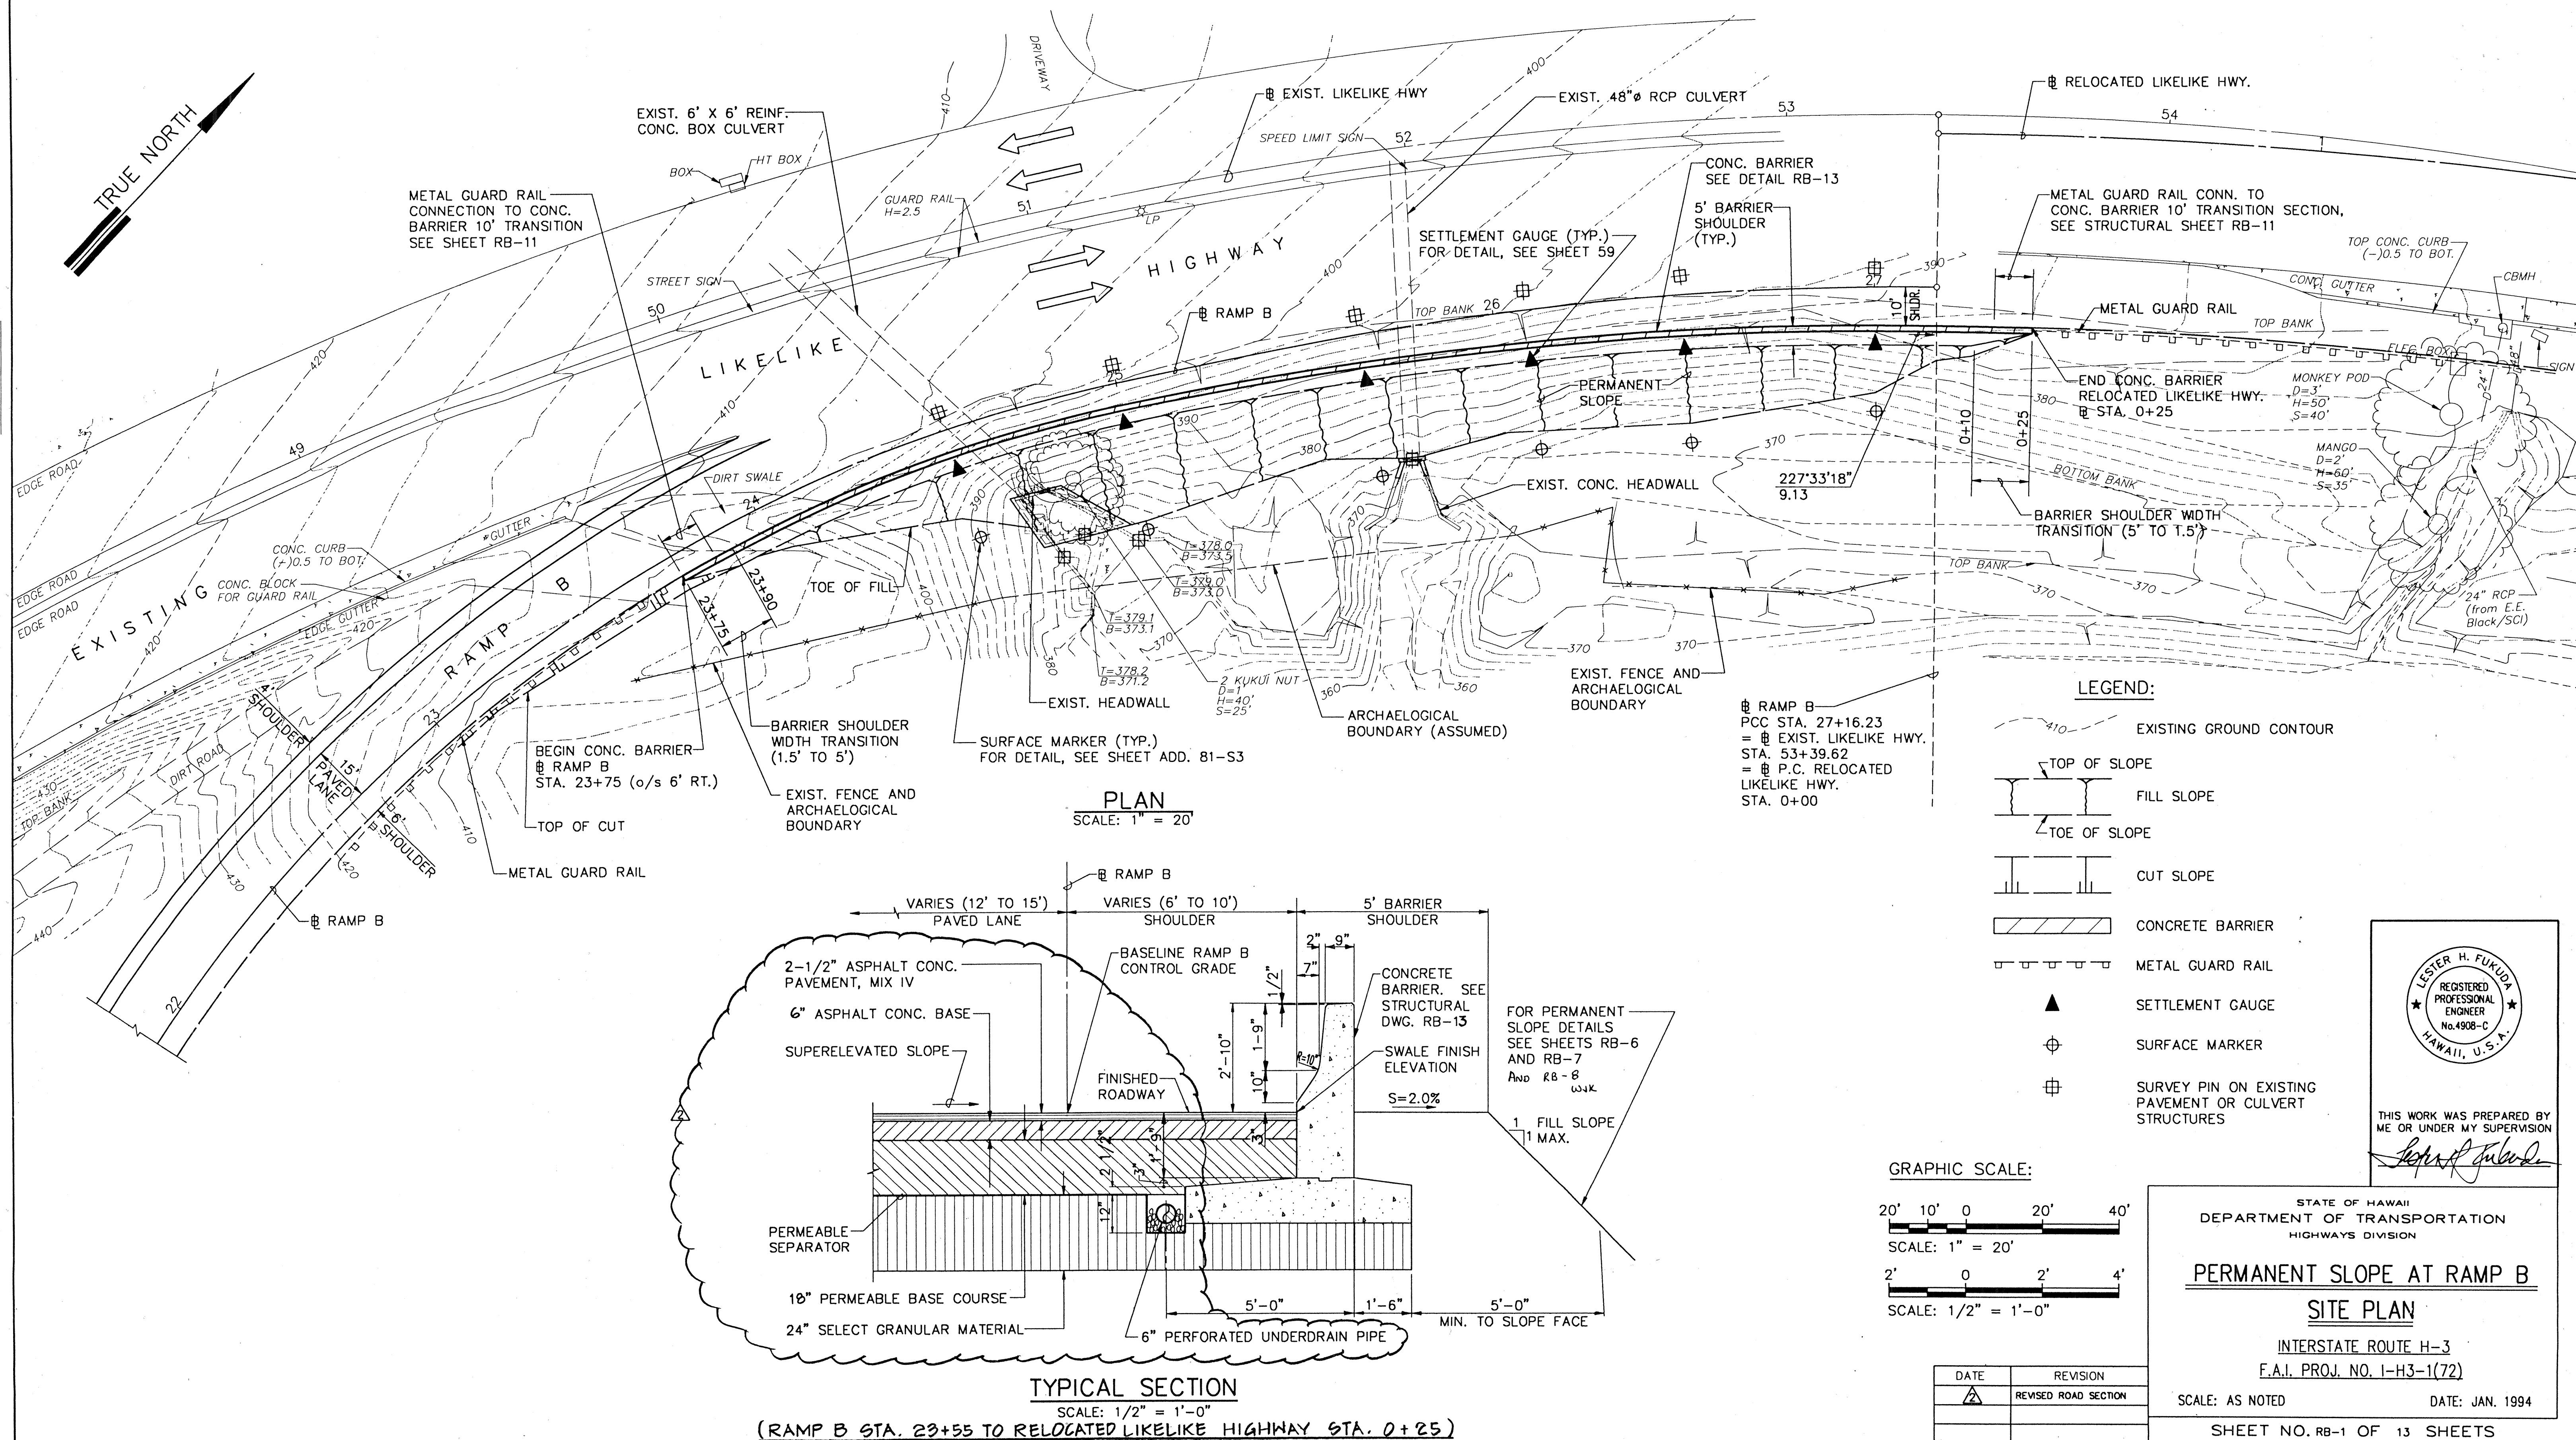

LESTER H. FUKUDA
REGISTERED
PROFESSIONAL
ENGINEER
No. 4908-C
HAWAII, U.S.A.

THIS WORK WAS PREPARED BY
ME OR UNDER MY SUPERVISION

Lester H. Fukuda

STATE OF HAWAII
DEPARTMENT OF TRANSPORTATION
HIGHWAYS DIVISION

PERMANENT SLOPE AT RAMP B

SITE PLAN

INTERSTATE ROUTE H-3
F.A.I. PROJ. NO. I-H3-1(72)

SCALE: AS NOTED DATE: JAN. 1994


SHEET NO. RB-1 OF 13 SHEETS

C.O. 17 S-1


ORIGINAL
 PLAN
 DATE
 DESIGNED BY
 TRACED BY
 NOTED BY
 QUANTITIES BY
 No.

83-482 F.P.-B.O.M.C. DAKANE INTERCHANGE H-3(1) Proj. 1-40 11/27/91

FED. ROAD DIST. NO.	STATE	PROJ. NO.	FISCAL YEAR	SHEET NO.	TOTAL SHEETS
HAWAII	HAW.	I-H3-1(72)	1991	18	521

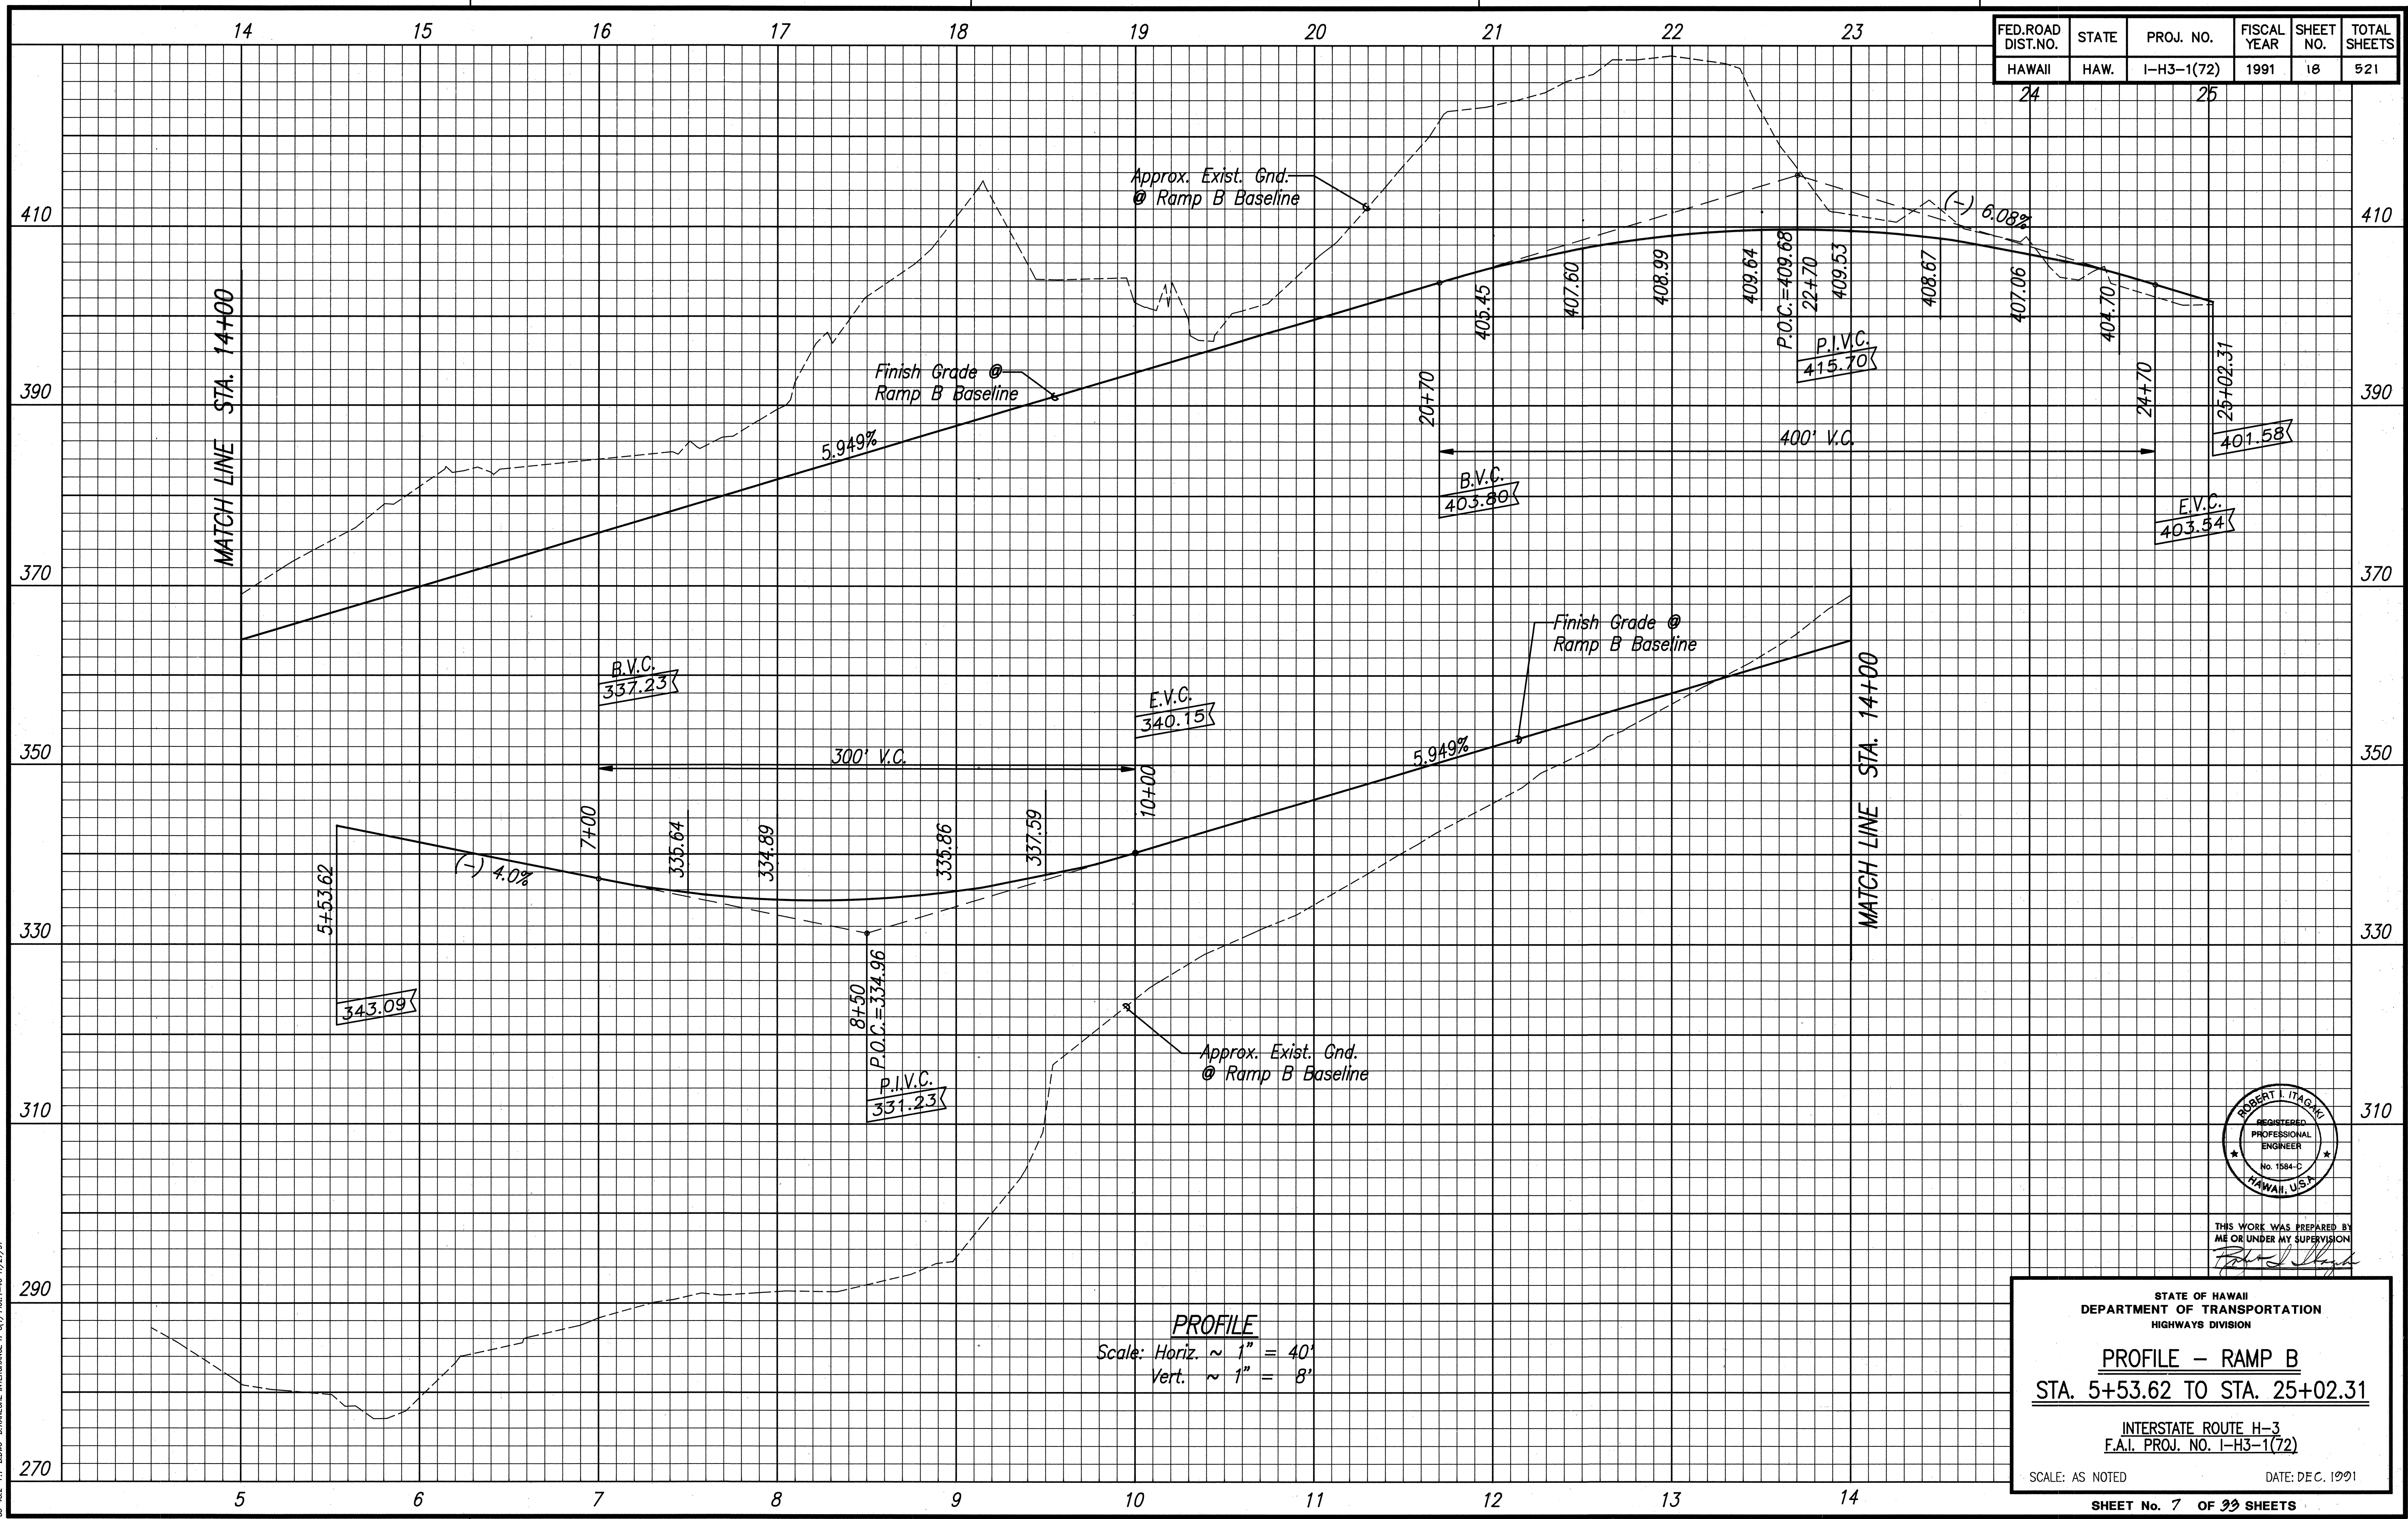

PROFILE
 Scale: Horiz. ~ 1" = 40'
 Vert. ~ 1" = 8'

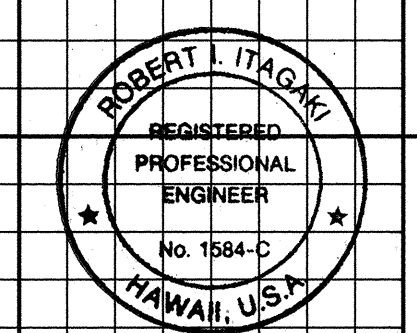

THIS WORK WAS PREPARED BY
 ME OR UNDER MY SUPERVISION
[Signature]

STATE OF HAWAII
 DEPARTMENT OF TRANSPORTATION
 HIGHWAYS DIVISION

PROFILE — RAMP B
STA. 5+53.62 TO STA. 25+02.31
 INTERSTATE ROUTE H-3
 F.A.I. PROJ. NO. I-H3-1(72)

SCALE: AS NOTED
 DATE: DEC. 1991

ORIGINAL PLAN	SURVEY PLOTTED BY _____		DATE _____
	DRAWN BY _____		_____
NOTEBOOK	TRACED BY _____		_____
	DESIGNED BY _____		_____
	QUANTITIES BY _____		_____
No. _____	CHECKED BY _____		_____

PROFILES - RAMP B

STATIONING: 22+00 to 27+00

ELEVATIONS: 370 to 410

NOTES:

- FOR RAMP B SUPERELEVATIONS, REFER TO INTERSTATE ROUTE H-3, KANEHOE INTERCHANGE, FAIP NO. I-H3-1(72), SHEET 46. (BASE DESIGN)
- FOR GEOGRID REINFORCEMENT DETAILS, SEE SHEETS RB-6, RB-7 AND RB-8.

*FOR TYPE 1, TYPE 2, AND TYPE 3 SLOPES, REFER TO SHEET RB-6, GEOGRID REINFORCEMENT DETAILS.

GRAPHIC SCALES:

HORIZ.: 1" = 20'

VERT.: 1" = 4'

PERMANENT RAMP

DATE: _____

REVISION: _____

SCALE: AS NOTED

SHEET NO. _____

PROFILE - RAMP B			
SCALES:	HORIZ.:	1" = 20'	
	VERT.:	1" = 4'	




THIS WORK WAS PREPARED BY
ME OR UNDER MY SUPERVISION

Super K. J. J. J.


INTERSTATE ROUTE H-3
F.A.I. PROJ. NO. I-H3-1(72)

SCALE: AS NOTED	DATE: MAY, 1994
<u>SHEET NO. RB-3 OF 13 SHEETS</u>	


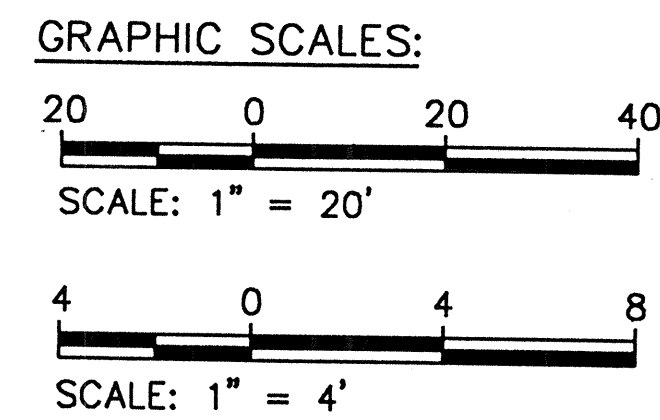


FED. ROAD DIST. NO.	STATE	PROJ. NO.	FISCAL YEAR	SHEET NO.	TOTAL SHEETS
HAWAII	HAW.	I-H3-1(72)	1991	C.O. ADD 19	521

True North
Scale: 1" = 40'

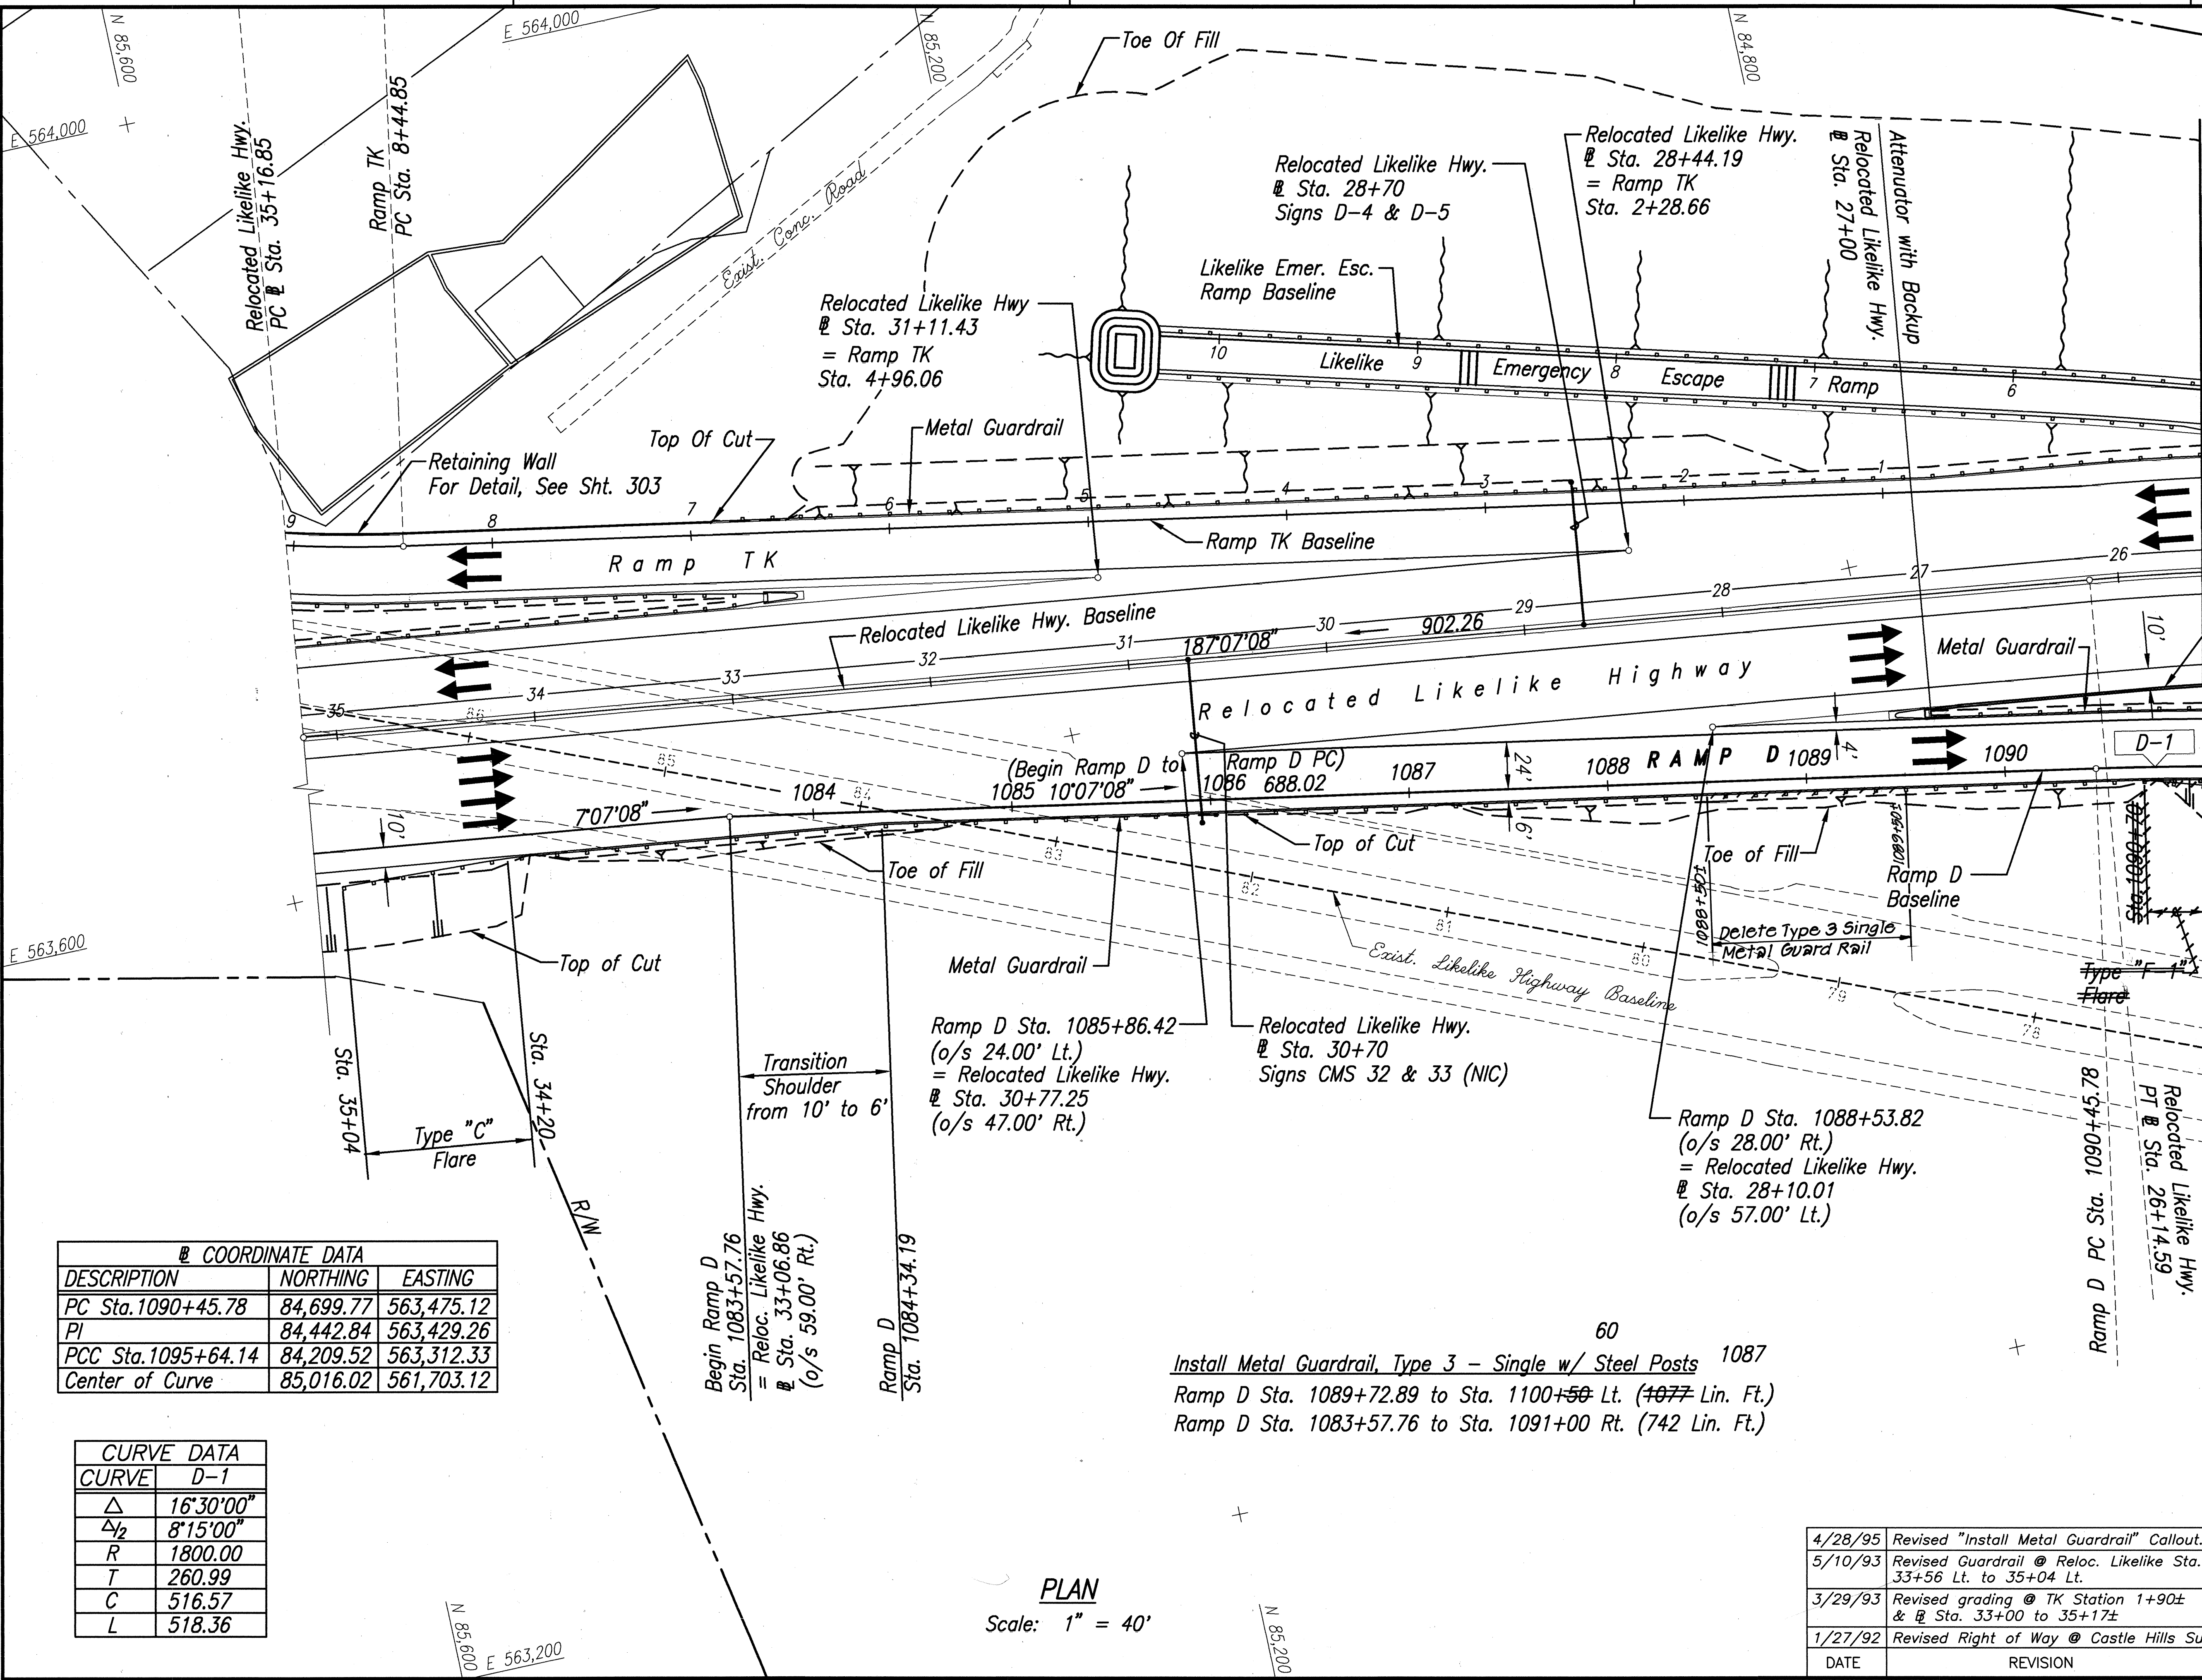

MATCH LINE STA. 1091+00
(See Sheet 20)

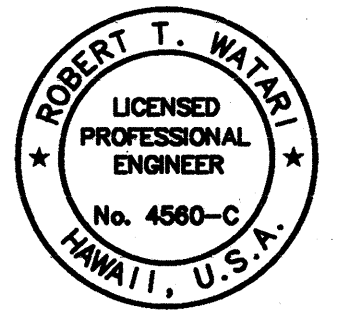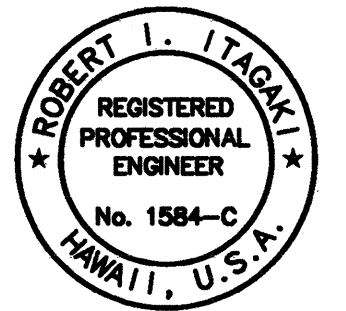

THIS WORK WAS PREPARED BY ME OR UNDER MY SUPERVISION.
Robert Waiwai
7/14/95

STATE OF HAWAII
DEPARTMENT OF TRANSPORTATION
HIGHWAYS DIVISION

PLAN - RAMP D
STA. 1083+57.76 TO STA. 1091+00

INTERSTATE ROUTE H-3
F.A.I. PROJ. NO. I-H3-1(72)

SCALE: AS NOTED DATE: DEC. 1991

SHEET No. OF SHEETS

DATE	REVISION
4/28/95	Revised "Install Metal Guardrail" Callout.
5/10/93	Revised Guardrail @ Reloc. Likelike Sta. 33+56 Lt. to 35+04 Lt.
3/29/93	Revised grading @ TK Station 1+90± & Sta. 33+00 to 35+17±
1/27/92	Revised Right of Way @ Castle Hills Subd.

Install Metal Guardrail, Type 3 - Single w/ Steel Posts 1087
Ramp D Sta. 1089+72.89 to Sta. 1100+50 Lt. (1077 Lin. Ft.)
Ramp D Sta. 1083+57.76 to Sta. 1091+00 Rt. (742 Lin. Ft.)

PLAN
Scale: 1" = 40'


COORDINATE DATA		
DESCRIPTION	NORTHING	EASTING
PC Sta. 1090+45.78	84,699.77	563,475.12
PI	84,442.84	563,429.26
PCC Sta. 1095+64.14	84,209.52	563,312.33
Center of Curve	85,016.02	561,703.12

CURVE DATA	
CURVE	D-1
Δ	16°30'00"
Δ ₂	8°15'00"
R	1800.00
T	260.99
C	516.57
L	518.36

DATE: _____
SURVEY PLOTTED BY: _____
DRAWN BY: _____
DESIGNED BY: _____
CHECKED BY: _____
NOTE BOOK: _____
No. _____

83-4621 FD-1086 (2-7-79) Rep. 100 (Rev. 4-60) Date: 4/28/95 by

FED. ROAD DIST. NO.	STATE	PROJ. NO.	FISCAL YEAR	SHEET NO.	TOTAL SHEETS
HAWAII	HAW.	I-H3-1(72)	1991	C.O. ADD. 20	521

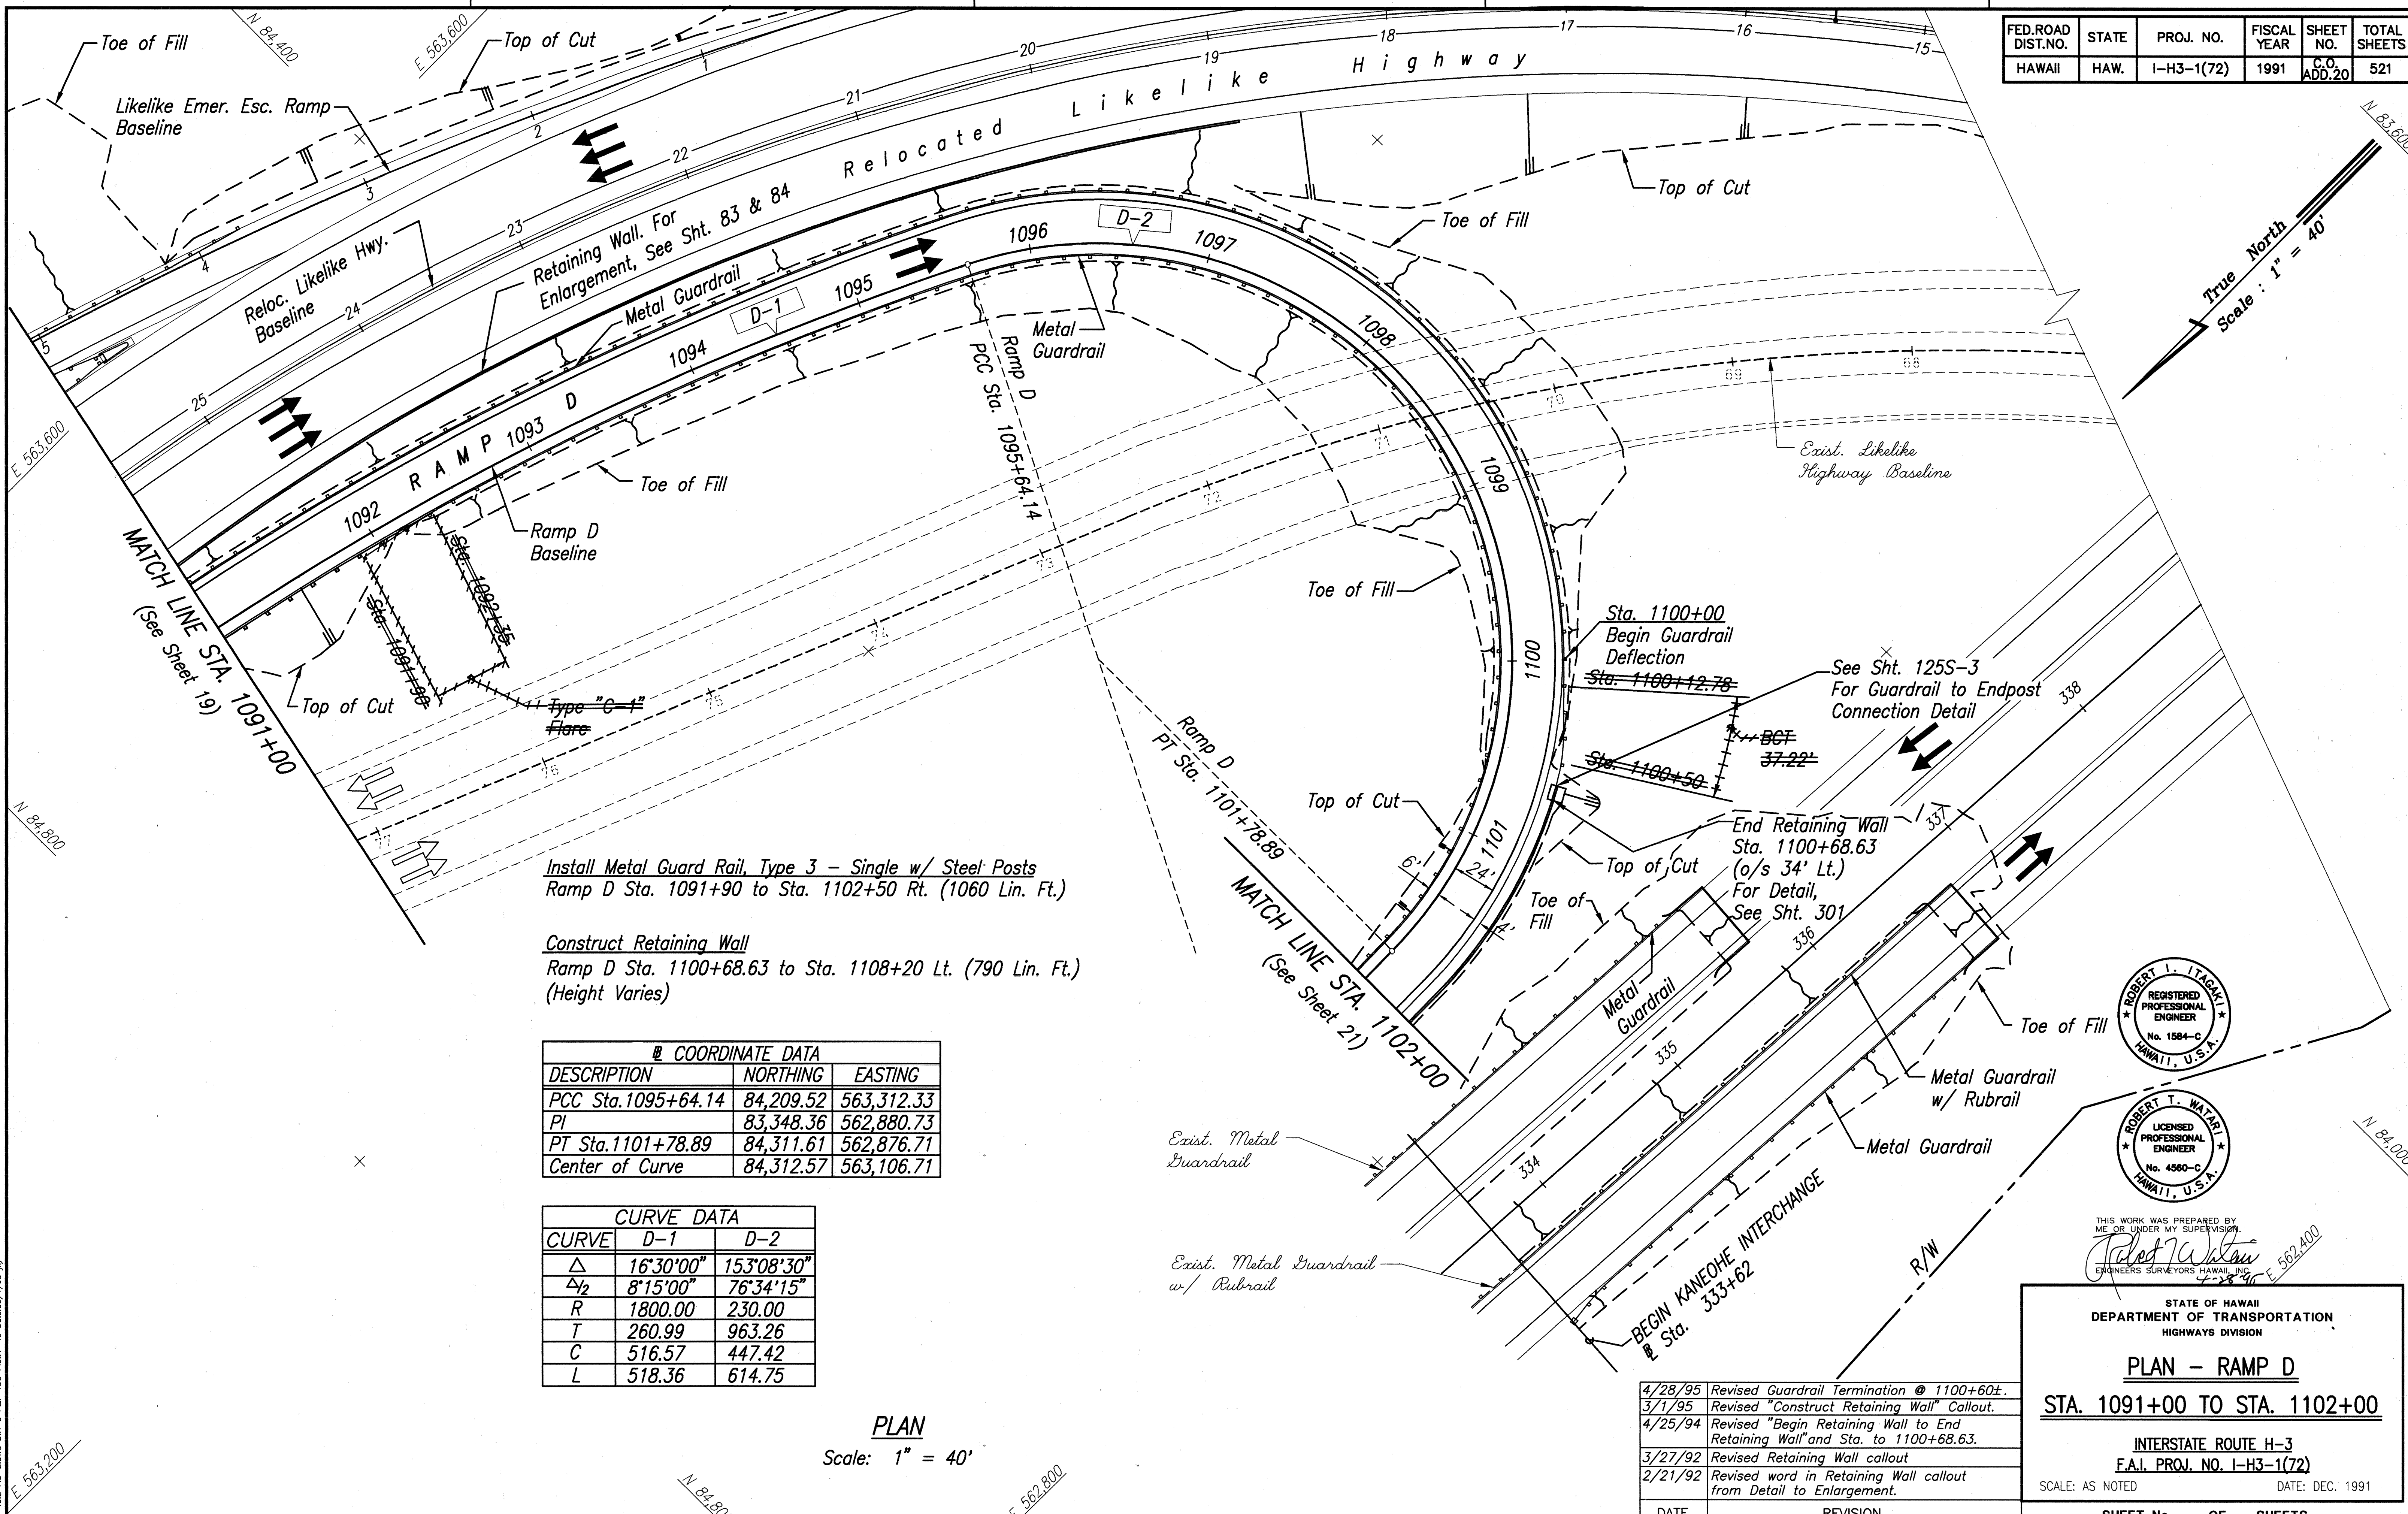

Install Metal Guard Rail, Type 3 - Single w/ Steel Posts
Ramp D Sta. 1091+90 to Sta. 1102+50 Rt. (1060 Lin. Ft.)

Construct Retaining Wall
Ramp D Sta. 1100+68.63 to Sta. 1108+20 Lt. (790 Lin. Ft.)
(Height Varies)

COORDINATE DATA		
DESCRIPTION	NORTHING	EASTING
PCC Sta. 1095+64.14	84,209.52	563,312.33
PI	83,348.36	562,880.73
PT Sta. 1101+78.89	84,311.61	562,876.71
Center of Curve	84,312.57	563,106.71

CURVE DATA		
CURVE	D-1	D-2
Δ	16°30'00"	15°08'30"
$\Delta/2$	8°15'00"	7°34'15"
R	1800.00	230.00
T	260.99	963.26
C	516.57	447.42
L	518.36	614.75

PLAN
Scale: 1" = 40'

DATE	REVISION
4/28/95	Revised Guardrail Termination @ 1100+60±.
3/1/95	Revised "Construct Retaining Wall" Callout.
4/25/94	Revised "Begin Retaining Wall to End Retaining Wall" and Sta. to 1100+68.63.
3/27/92	Revised Retaining Wall callout
2/21/92	Revised word in Retaining Wall callout from Detail to Enlargement.



STATE OF HAWAII
DEPARTMENT OF TRANSPORTATION
HIGHWAYS DIVISION

PLAN - RAMP D
STA. 1091+00 TO STA. 1102+00

INTERSTATE ROUTE H-3
F.A.I. PROJ. NO. I-H3-1(72)

SCALE: AS NOTED DATE: DEC. 1991


SHEET No. OF SHEETS

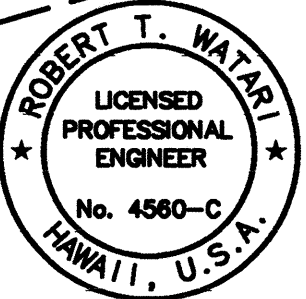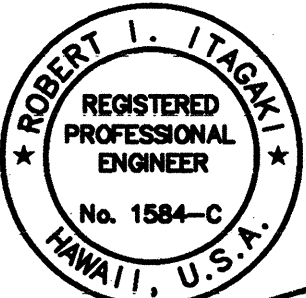

THIS WORK WAS PREPARED BY ME OR UNDER MY SUPERVISION
Robert T. Watari
ENGINEERS SURVEYORS HAWAII, INC.

FED. ROAD DIST. NO.	STATE	PROJ. NO.	FISCAL YEAR	SHEET NO.	TOTAL SHEETS
HAWAII	HAW.	I-H3-1(72)	1991	C.O. 21	521

True North
Scale: 1" = 40'

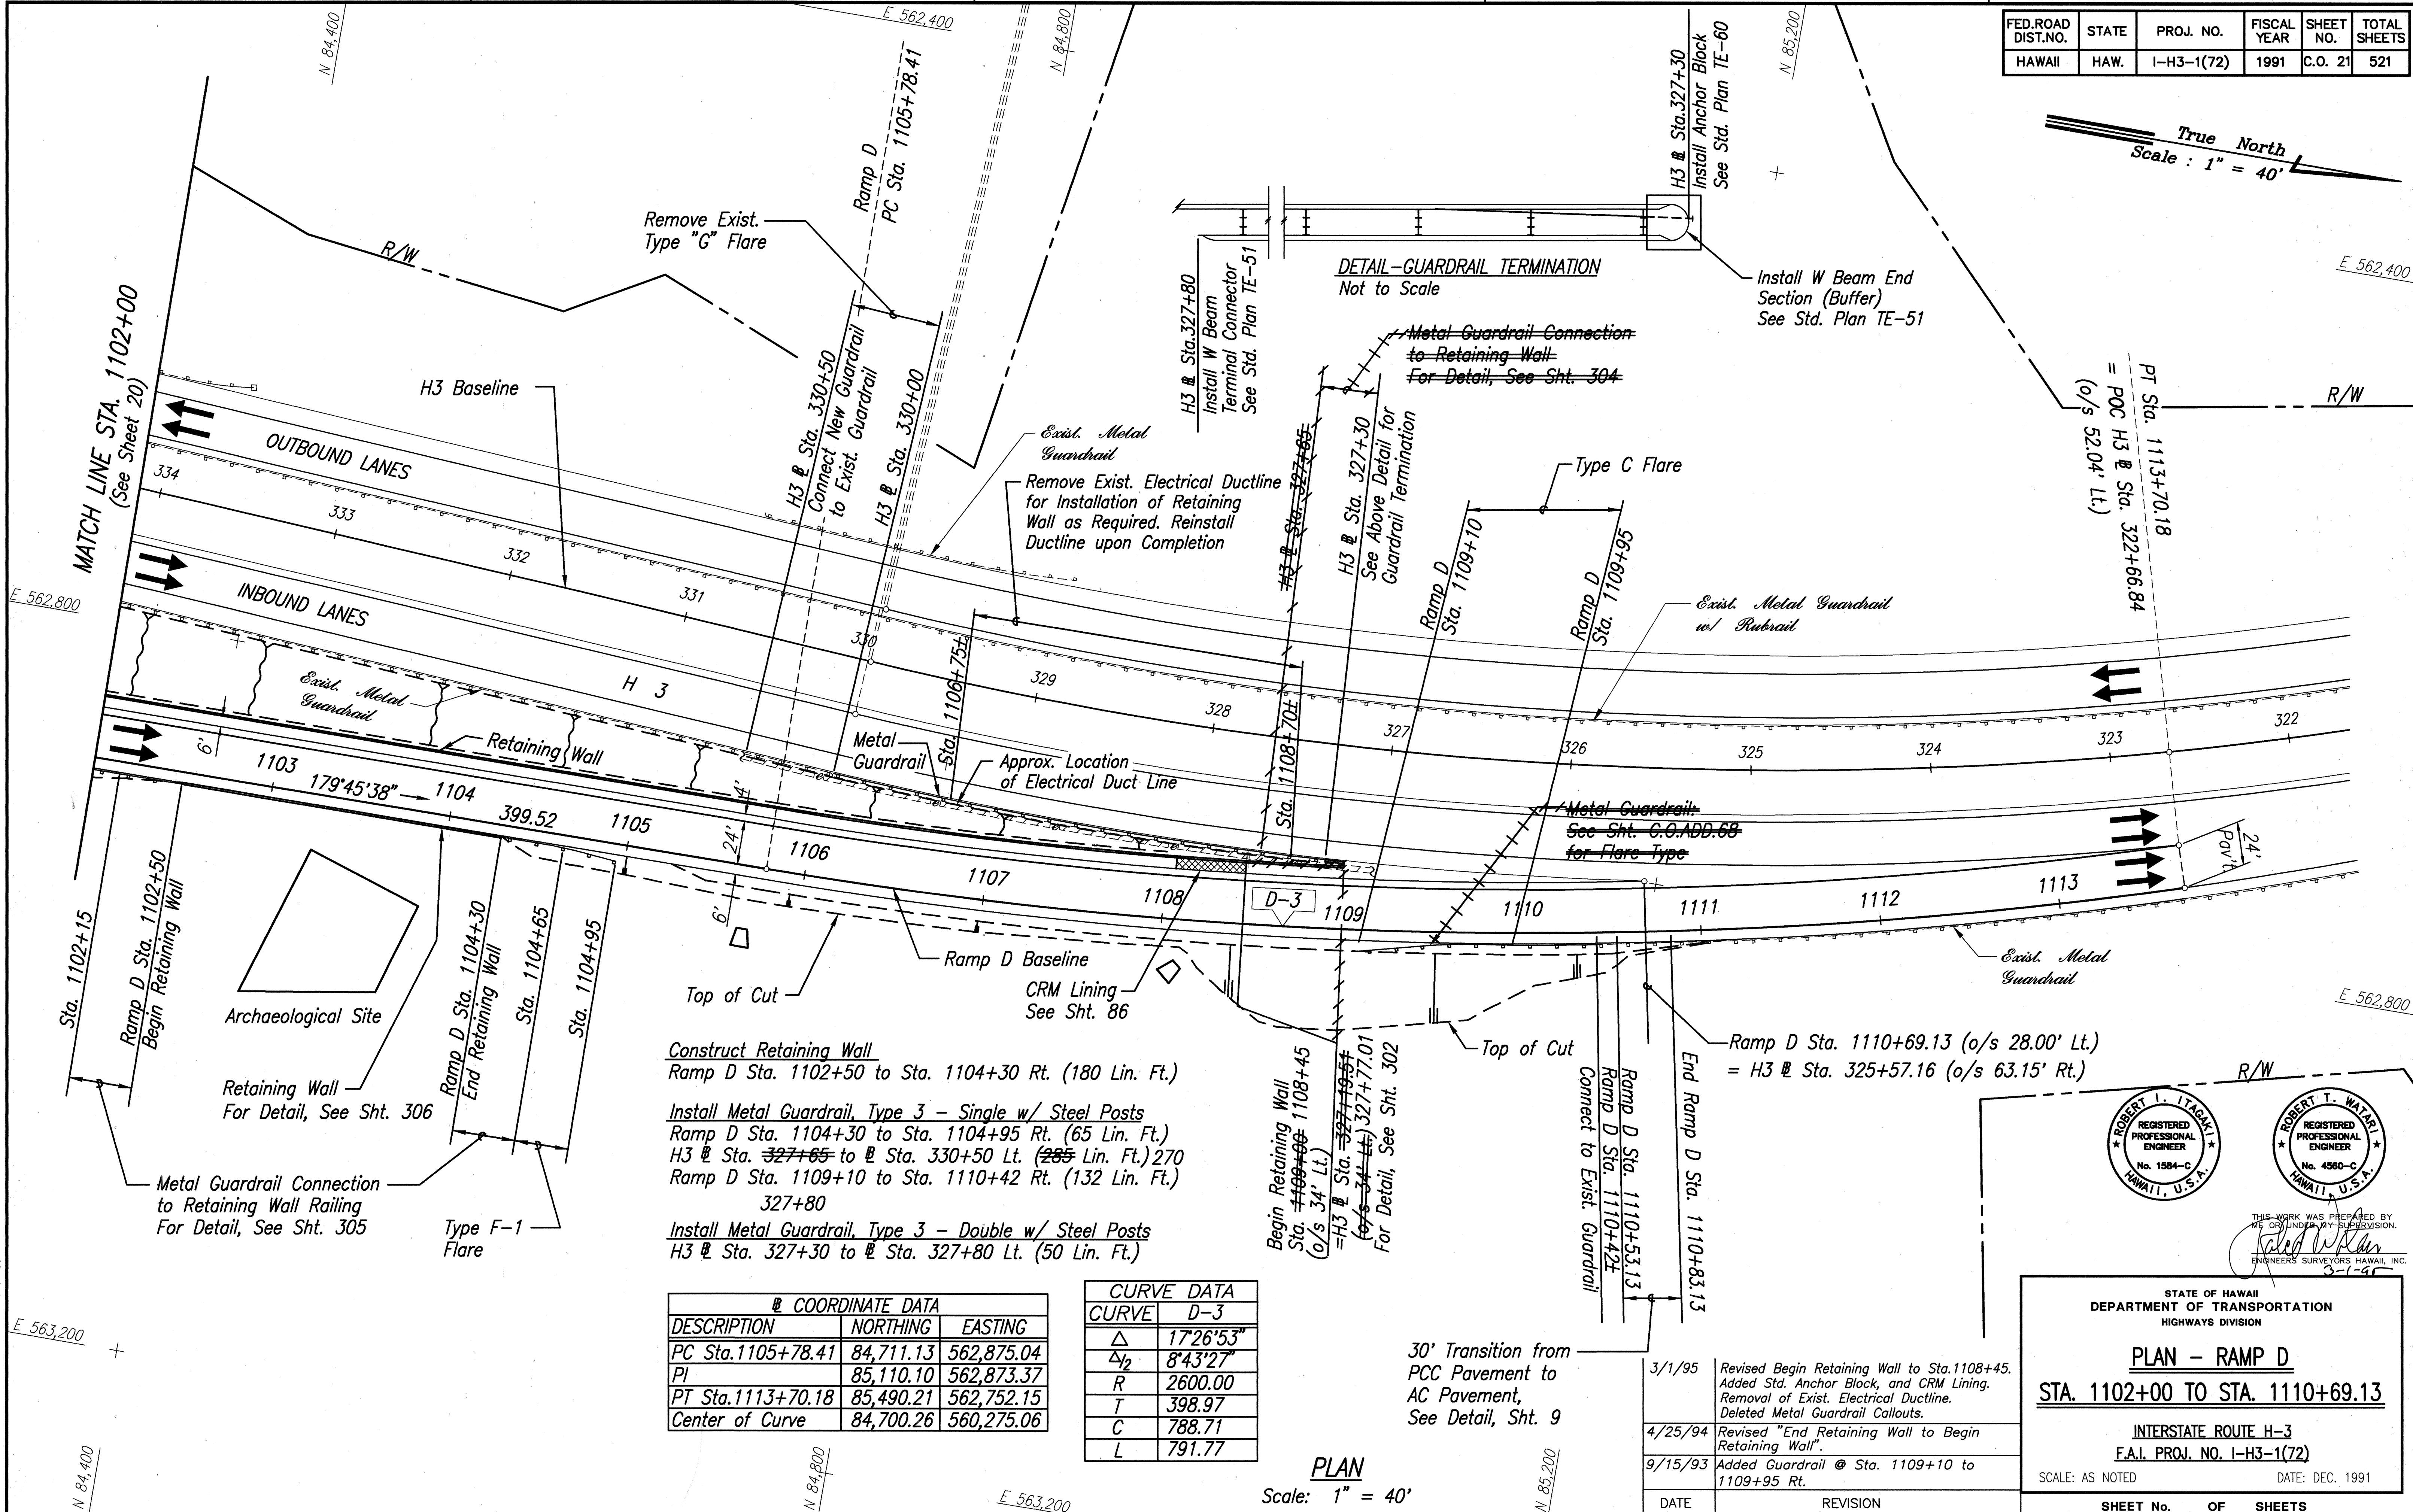

Construct Retaining Wall
Ramp D Sta. 1102+50 to Sta. 1104+30 Rt. (180 Lin. Ft.)

Install Metal Guardrail, Type 3 - Single w/ Steel Posts
Ramp D Sta. 1104+30 to Sta. 1104+95 Rt. (65 Lin. Ft.)
H3 @ Sta. 327+85 to @ Sta. 330+50 Lt. (285 Lin. Ft.) 270
Ramp D Sta. 1109+10 to Sta. 1110+42 Rt. (132 Lin. Ft.)
327+80

Install Metal Guardrail, Type 3 - Double w/ Steel Posts
H3 @ Sta. 327+30 to @ Sta. 327+80 Lt. (50 Lin. Ft.)



@ COORDINATE DATA		
DESCRIPTION	NORTHING	EASTING
PC Sta. 1105+78.41	84,711.13	562,875.04
PI	85,110.10	562,873.37
PT Sta. 1113+70.18	85,490.21	562,752.15
Center of Curve	84,700.26	560,275.06

CURVE DATA	
CURVE	D-3
Δ	17°26'53"
Δ_2	8°43'27"
R	2600.00
T	398.97
C	788.71
L	791.77

PLAN
Scale: 1" = 40'

30' Transition from
PCC Pavement to
AC Pavement,
See Detail, Sht. 9

DATE	REVISION
3/1/95	Revised Begin Retaining Wall to Sta. 1108+45. Added Std. Anchor Block, and CRM Lining. Removal of Exist. Electrical Ductline. Deleted Metal Guardrail Callouts.
4/25/94	Revised "End Retaining Wall to Begin Retaining Wall".
9/15/93	Added Guardrail @ Sta. 1109+10 to 1109+95 Rt.

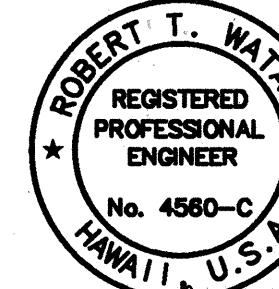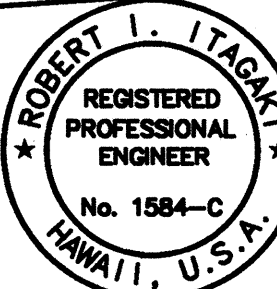

STATE OF HAWAII
DEPARTMENT OF TRANSPORTATION
HIGHWAYS DIVISION


PLAN - RAMP D
STA. 1102+00 TO STA. 1110+69.13

INTERSTATE ROUTE H-3
F.A.I. PROJ. NO. I-H3-1(72)

SCALE: AS NOTED DATE: DEC. 1991


SHEET No. OF SHEETS

FED. ROAD DIST. NO.	STATE	PROJ. NO.	FISCAL YEAR	SHEET NO.	TOTAL SHEETS
HAWAII	HAW.	I-H3-1(72)	1991	22	521

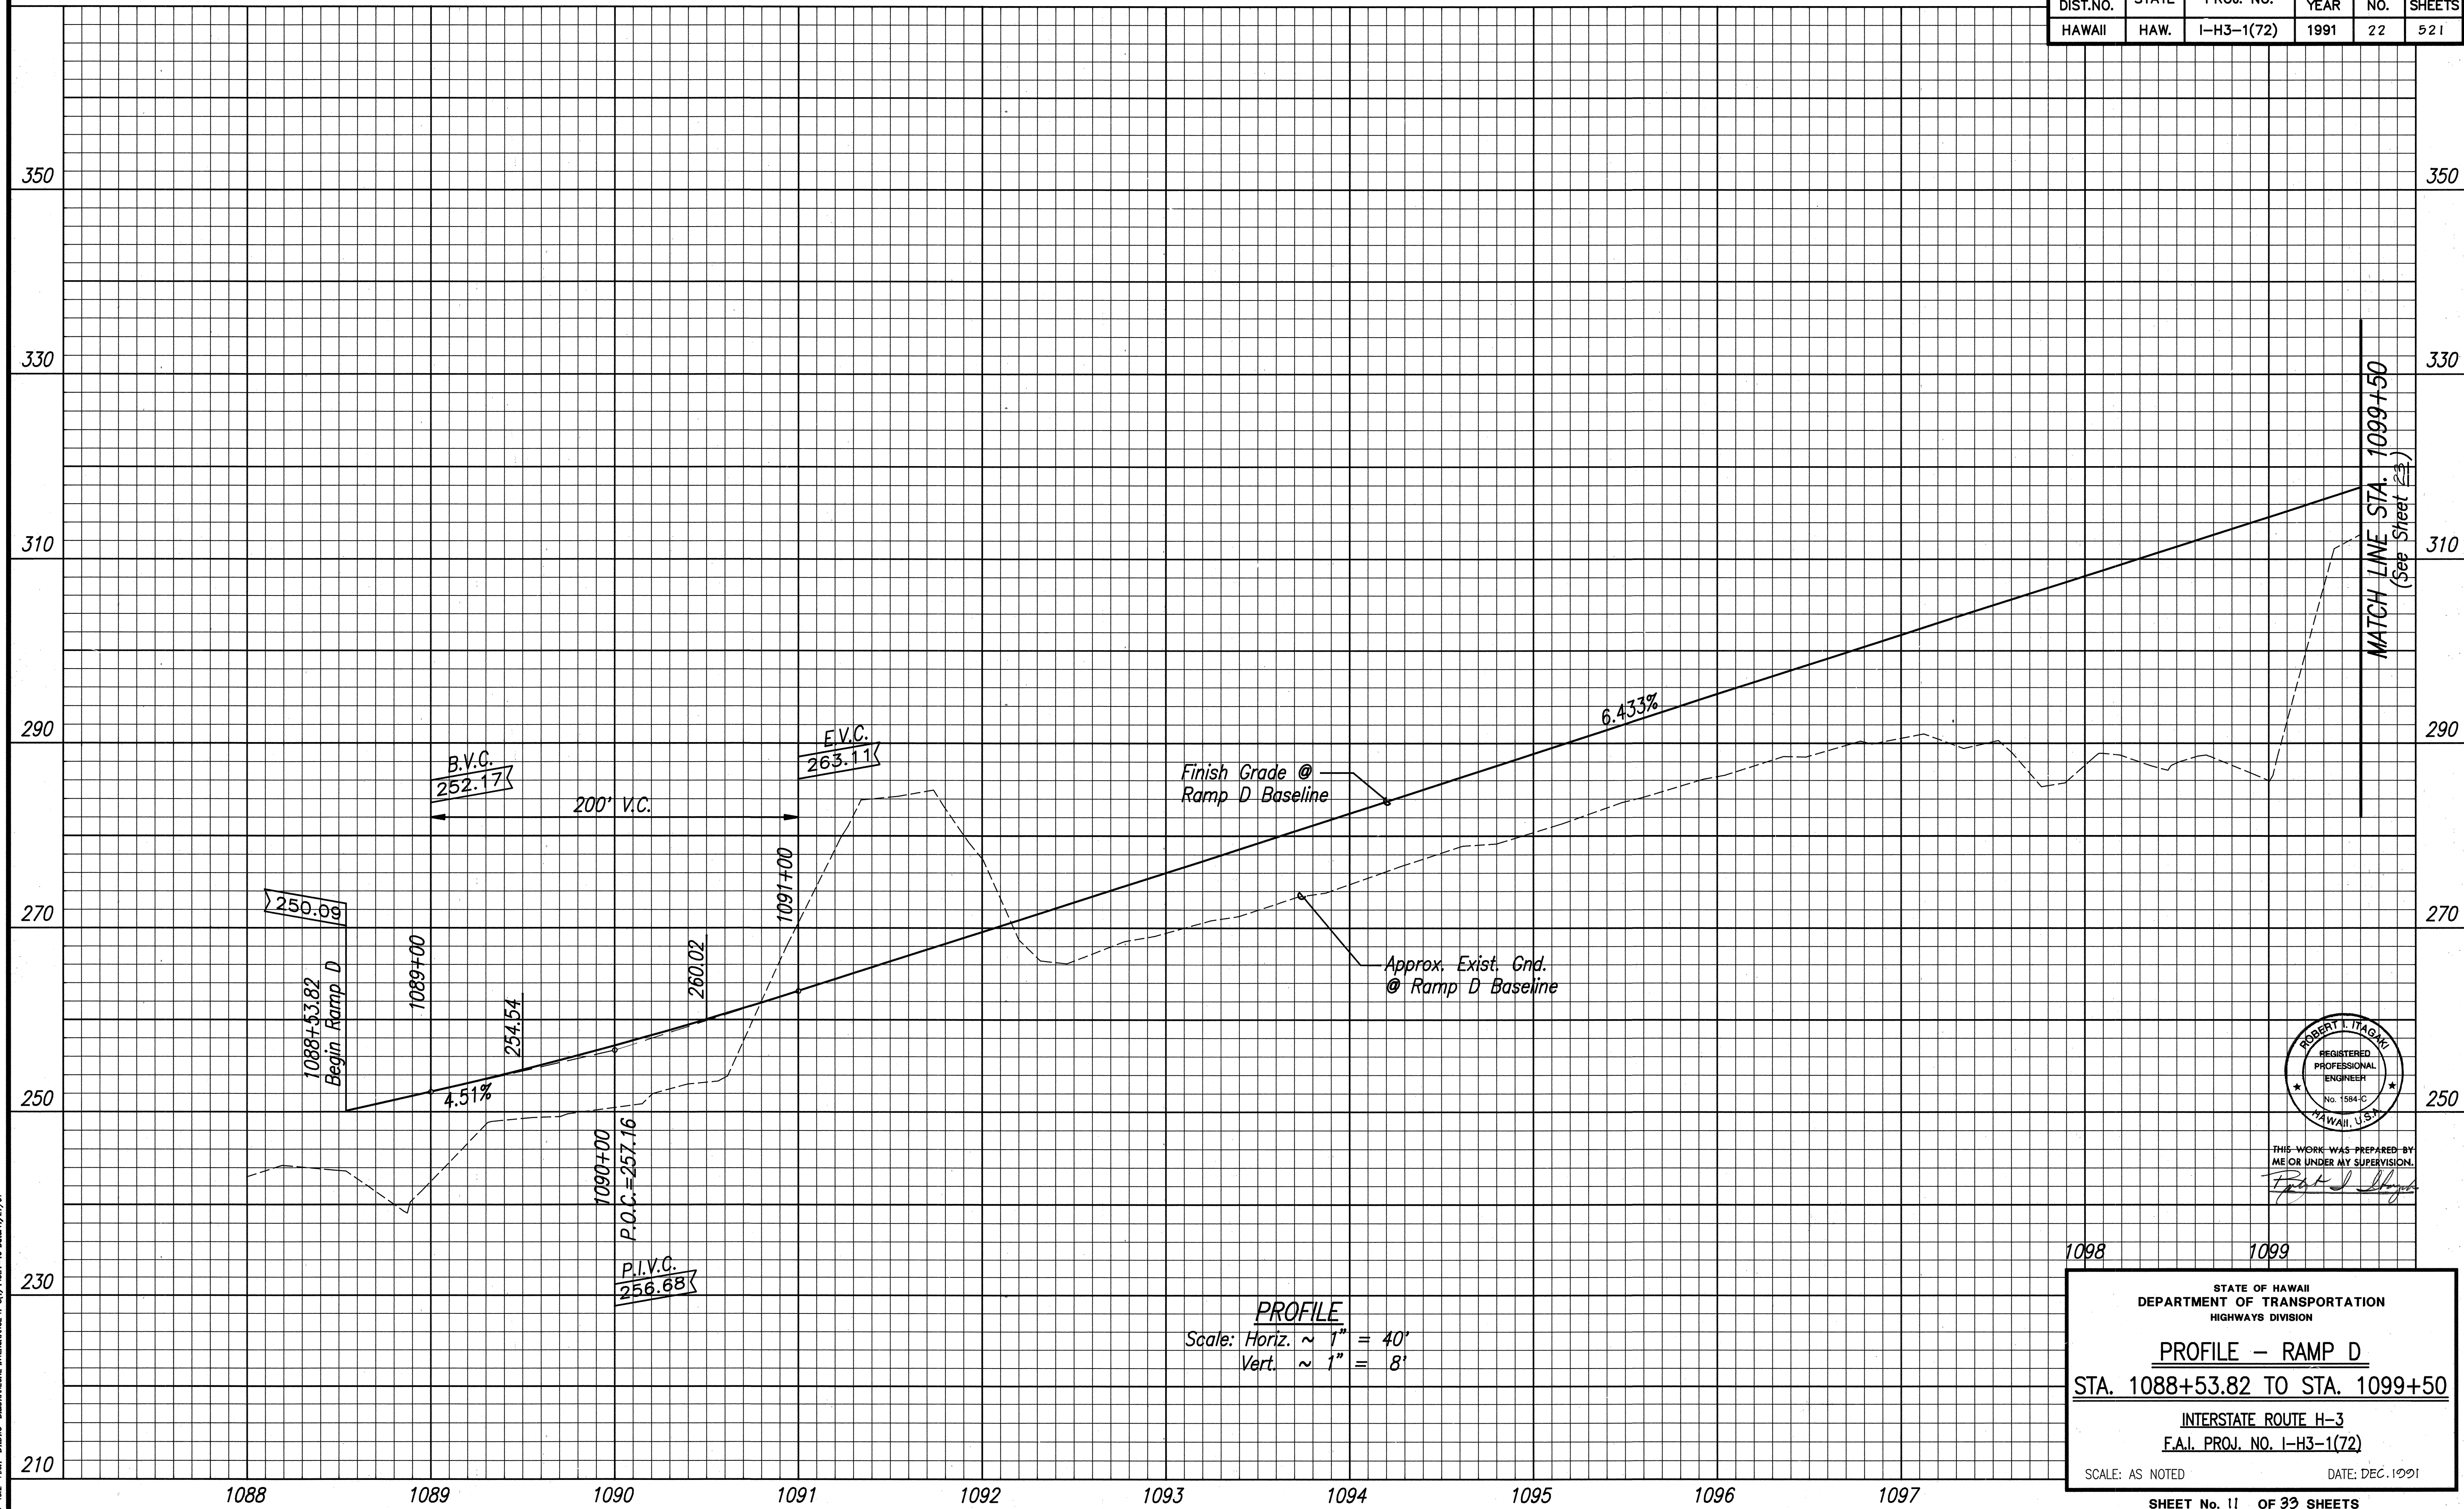

ORIGINAL PLAN	DATE
NOTED BOOK	DESIGNED BY
No.	QUANTITIES BY

83-43.2 THE P-BUILDING DASH-KANEHE INTERCHANGE (H-30) Part 1-40 Date: 11/27/91

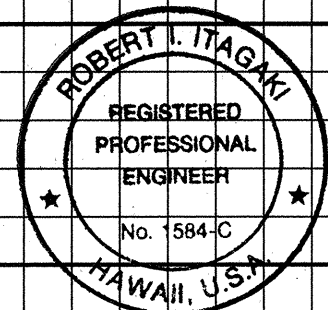

THIS WORK WAS PREPARED BY ME OR UNDER MY SUPERVISION.
[Signature]

PROFILE
Scale: Horiz. ~ 1" = 40'
Vert. ~ 1" = 8'

STATE OF HAWAII
DEPARTMENT OF TRANSPORTATION
HIGHWAYS DIVISION


PROFILE - RAMP D
STA. 1088+53.82 TO STA. 1099+50

INTERSTATE ROUTE H-3
F.A.I. PROJ. NO. I-H3-1(72)

SCALE: AS NOTED DATE: DEC. 1991

SHEET No. 11 OF 33 SHEETS


FED. ROAD DIST. NO.	STATE	PROJ. NO.	FISCAL YEAR	SHEET NO.	TOTAL SHEETS
HAWAII	HAW.	I-H3-1(72)	1991	23	521

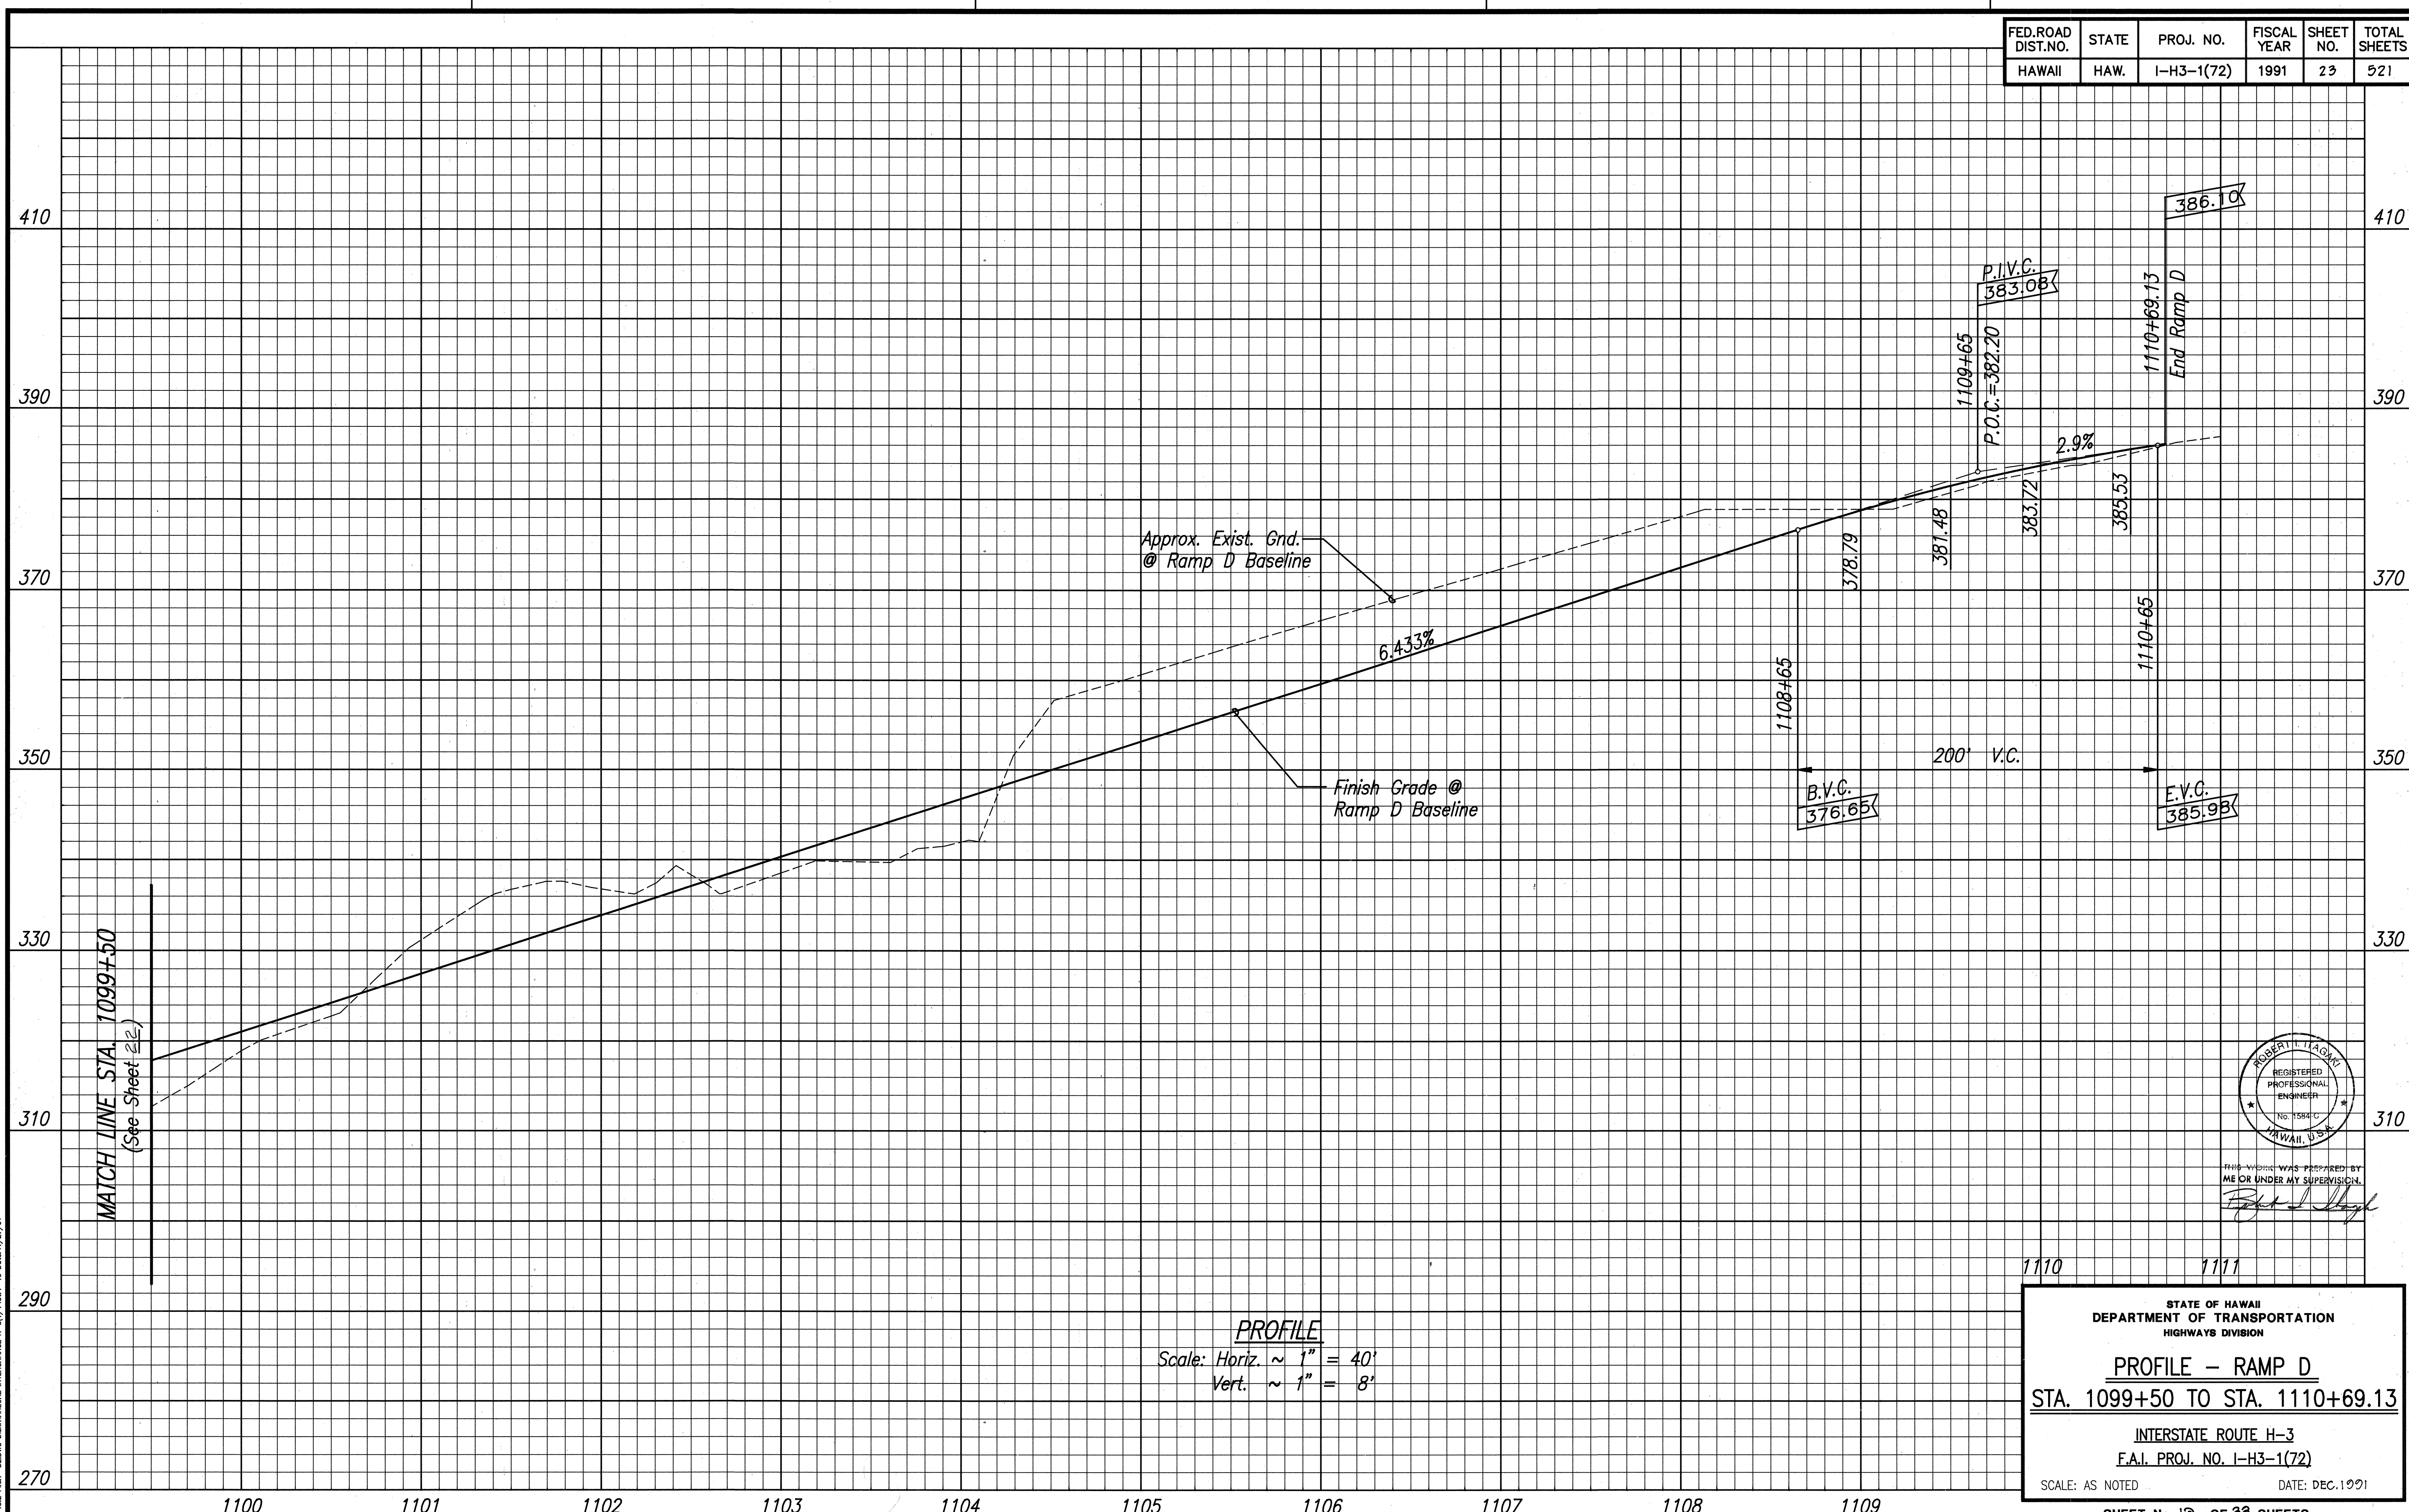

ORIGINAL PLAN	DATE
DESIGNED BY	
NOTED BY	
QUANTITIES BY	
NO.	

83-462 THE P-102/DWG DISK-KANEHE INTERCHANGE (I-30) Proj. 1-40 Date: 11/27/91

PROFILE
 Scale: Horiz. ~ 1" = 40'
 Vert. ~ 1" = 8'

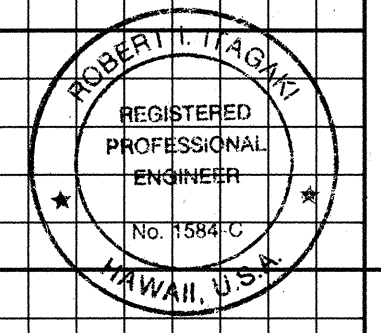


THIS WORK WAS PREPARED BY
 ME OR UNDER MY SUPERVISION
Robert T. Lagimodiere

STATE OF HAWAII
DEPARTMENT OF TRANSPORTATION
HIGHWAYS DIVISION


PROFILE — RAMP D
STA. 1099+50 TO STA. 1110+69.13
INTERSTATE ROUTE H-3
F.A.I. PROJ. NO. I-H3-1(72)
SCALE: AS NOTED
DATE: DEC. 1991

FED. ROAD DIST. NO.	STATE	PROJ. NO.	FISCAL YEAR	SHEET NO.	TOTAL SHEETS
HAWAII	HAW.	I-H3-1(72)	1991	C.O. ADD. 24	521

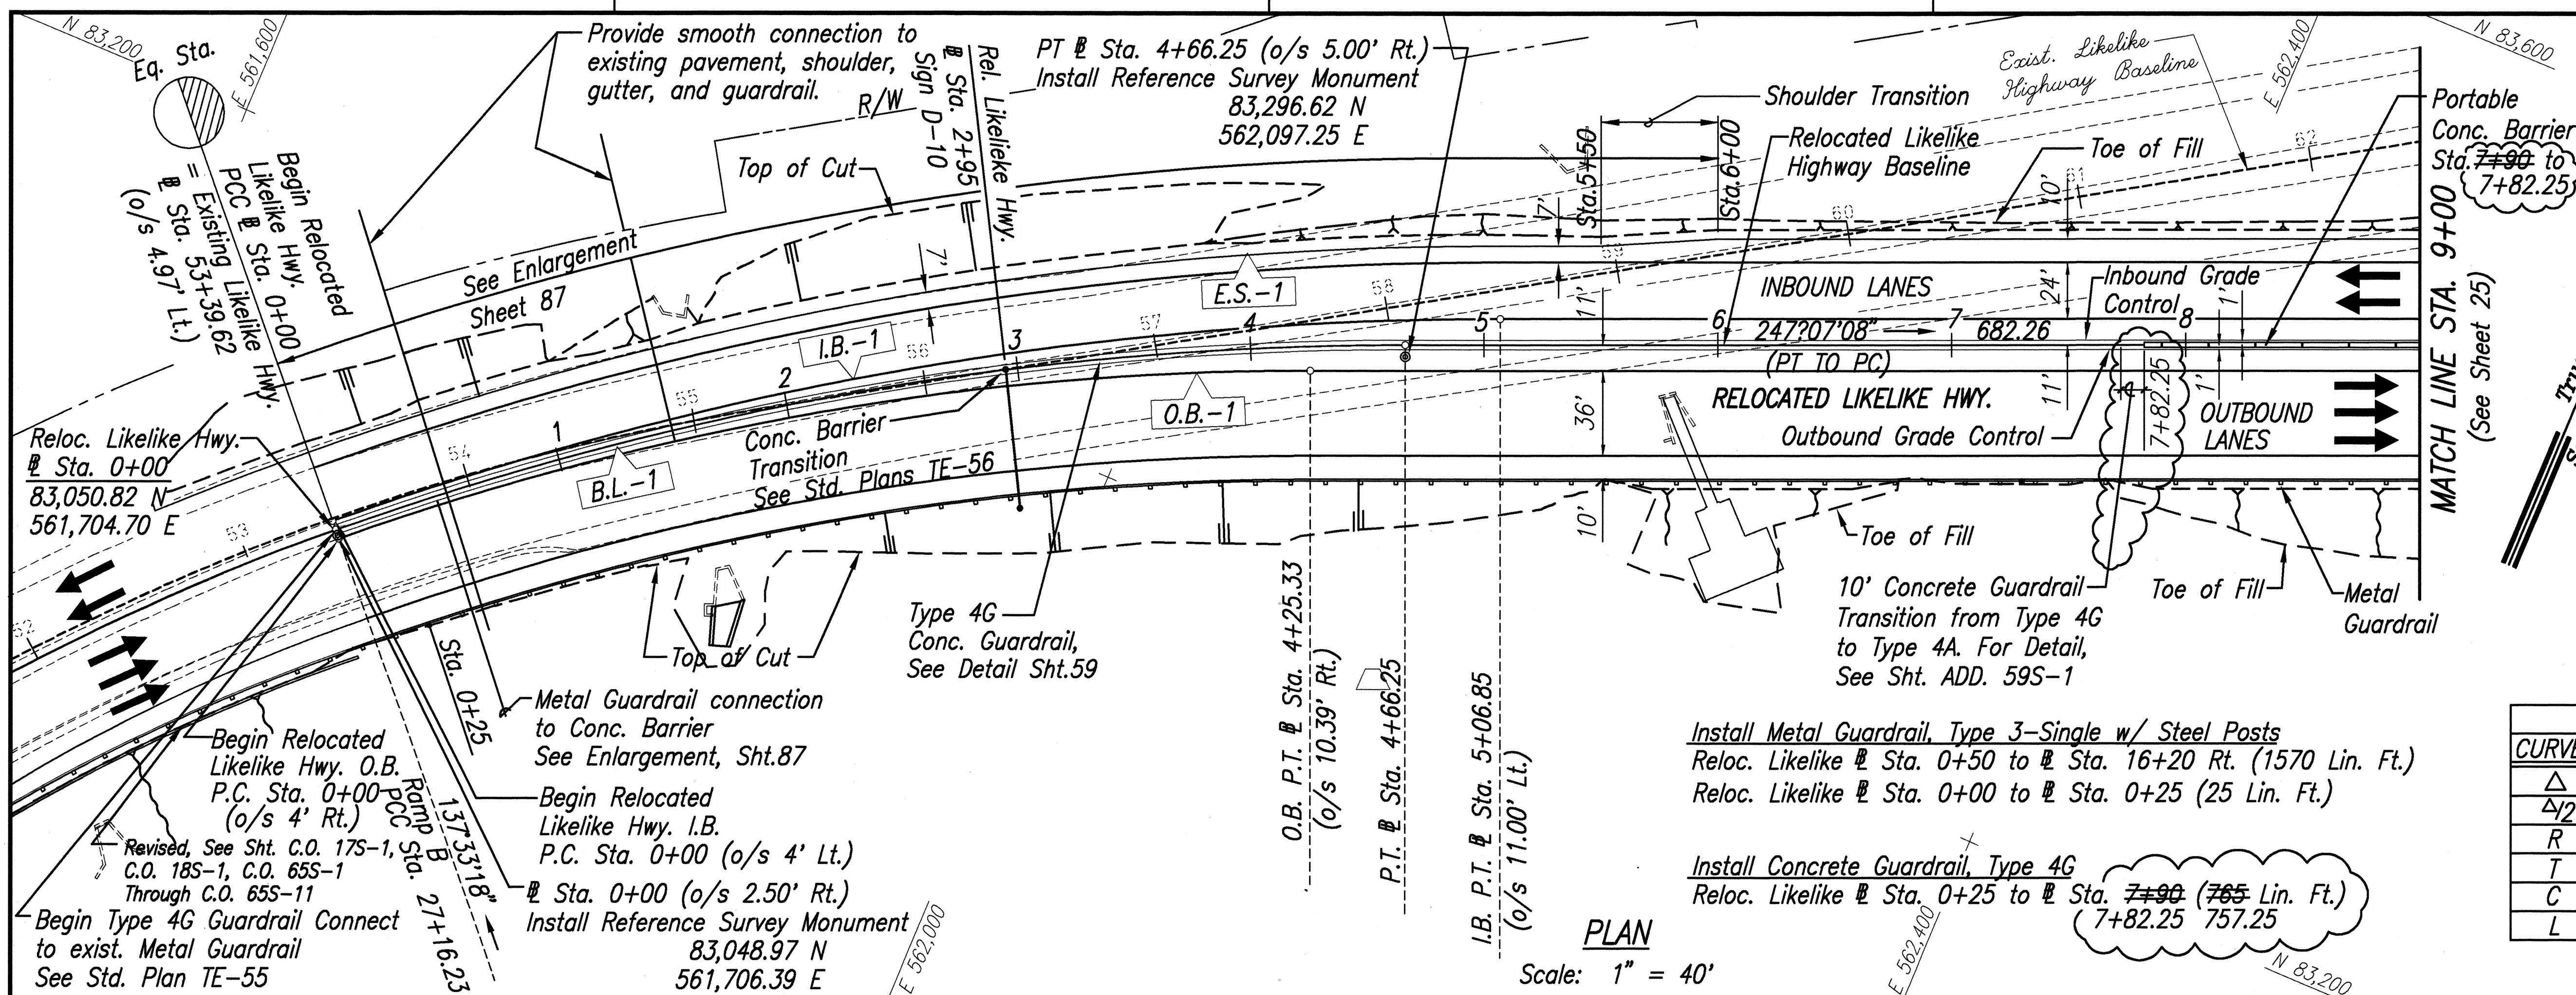

COORDINATE DATA		
DESCRIPTION	NORTHING	EASTING
PC Sta. 0+00	83,050.82	561,704.70
PI	83,209.70	561,878.42
PT Sta. 4+66.25	83,301.23	562,095.31
Center of Curve	82,043.20	562,626.23

CURVE DATA				
CURVE	B.L.-1	I.B.-1	O.B.-1	E.S.-1
Δ	19°33'50"	19°33'50"	19°33'50"	6°01'59"
Δ/2	9°46'55"	9°46'55"	9°46'55"	3°00'59"
R	1365.47	1490.72	1240.22	1200.00
T	235.41	257.01	213.82	63.24
C	463.98	506.54	421.42	126.30
L	466.25	509.01	423.48	126.35

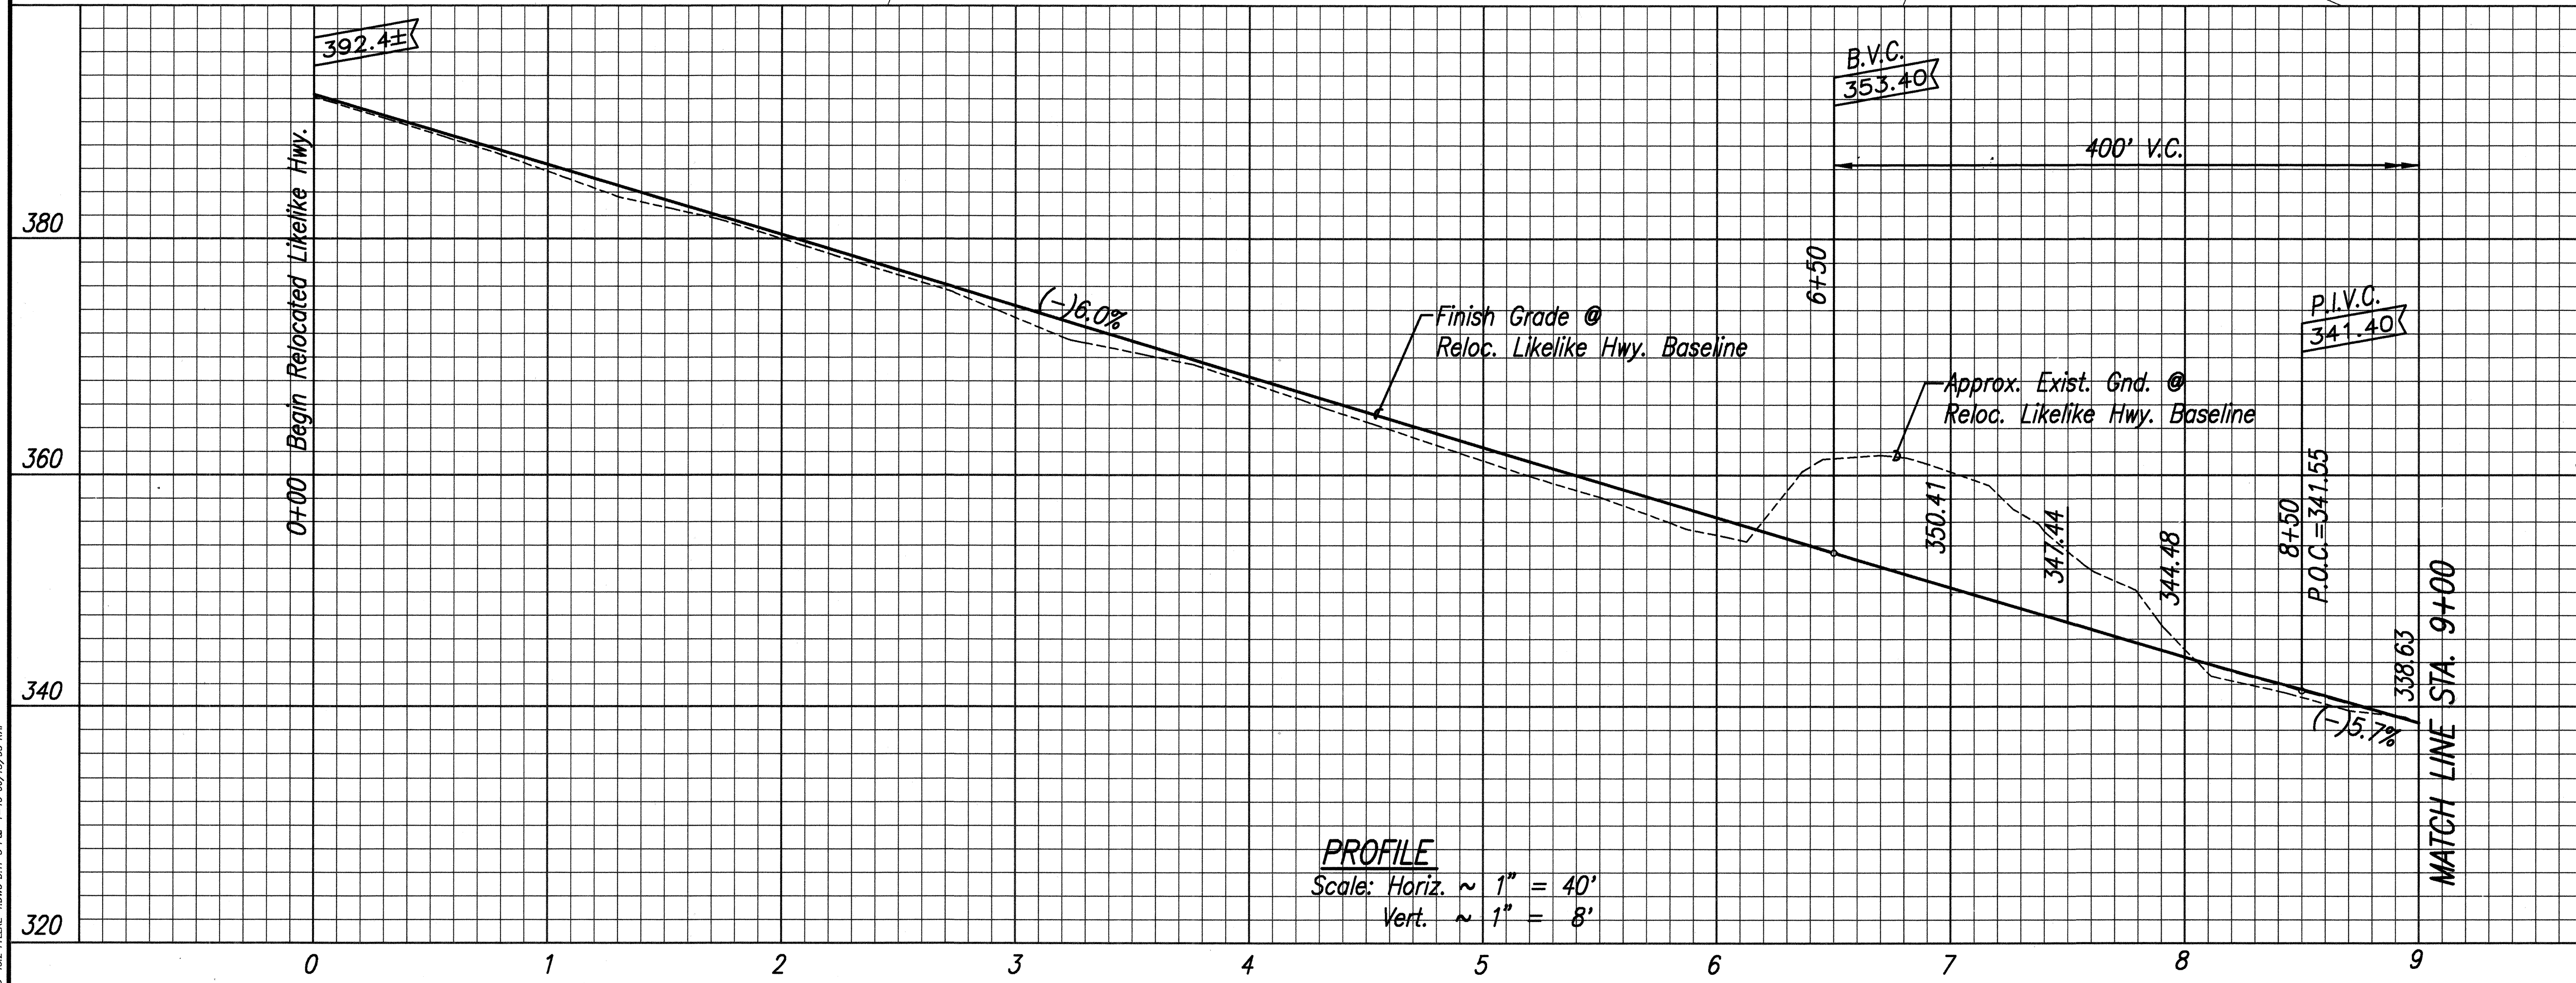

6/15/95 Revised End Station for Type 4G Guardrail

4/10/95 Deleted Energy Dissipator, Added Headwall and Relocated Shoulder Transition.

7/6/94 Revised Limits for Smooth Connection to Exist. Improvements.

6/1/94 Revised Guardrail Length and Retaining Wall Callout.

4/21/94 Replace Type 4G Concrete Guardrail w/ Portable Concrete Barrier From Sta. 7+90 to Sta. 9+10. Added Conc. Guardrail Transition

7/30/93 Deleted Energy Dissipators and Grading and Added Retaining Wall

5/26/93 Revised Grading & Top of Cut, (Minus Sta.)

3/27/92 Revised Grading & R/W from Sta. 0+00 to 4+00± Lt. Deleted Metal Guardrail and Retaining Wall quantity callout.

2/21/92 Revised Energy Dissipator Location

DATE REVISION

STATE OF HAWAII
DEPARTMENT OF TRANSPORTATION
HIGHWAYS DIVISION

RELOCATED LIKELIKE HIGHWAY
STA. 0+00 TO STA. 9+00

INTERSTATE ROUTE H-3
F.A.I. PROJ. NO. I-H3-1(72)

SCALE: AS NOTED DATE: DEC 1991


SHEET No. OF SHEETS

DATE _____
DESIGNED BY _____
CHECKED BY _____
IN CHARGE _____
NO. _____

83-46.2 FILED-LONG ISLAND-3 Page 1-40 06/15/95 KM

FED. ROAD DIST. NO.	STATE	PROJ. NO.	FISCAL YEAR	SHEET NO.	TOTAL SHEETS
HAWAII	HAW.	I-H3-1(72)	1991	C.O. 25	521




CURVE DATA		
CURVE	B.L.-2	EP-1
Δ	60°00'00"	60°00'00"
$\Delta/2$	30°00'00"	30°00'00"
R	1400.00	1341.00
T	808.29	774.23
C	1400.00	1341.00
L	1466.08	1404.29

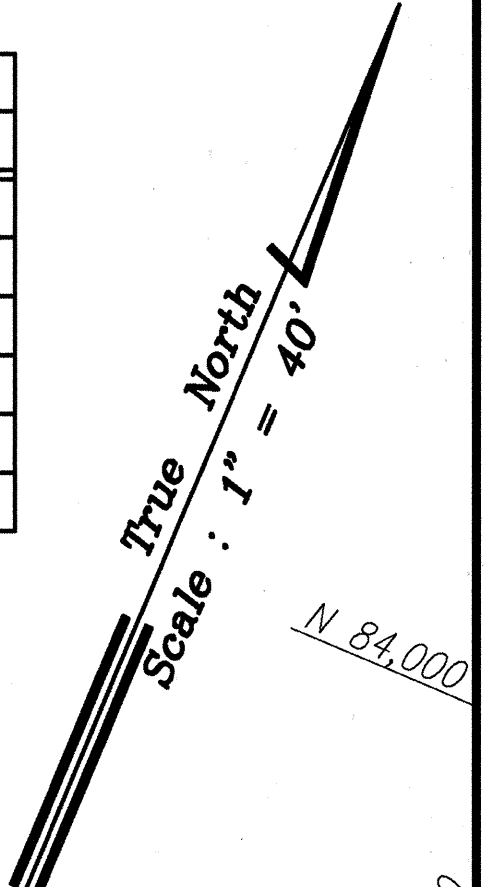

Install Concrete Guardrail, Type 4G
Reloc. Likelike @ Sta. 9+10 to @ Sta. 53+40
(4430 Lin. Ft.)

Install Metal Guardrail, Type 3-Single w/ Steel Posts
Reloc. Likelike @ Sta. 10+40 to @ Sta. 13+40 Lt. (300 Lin. Ft.)

COORDINATE DATA		
DESCRIPTION	NORTHING	EASTING
PC Sta. 11+48.51	83,566.51	562,723.89
PI	83,880.79	563,468.58
PT Sta. 26+14.59	84,682.85	563,568.75
Center of Curve	84,856.35	562,179.54

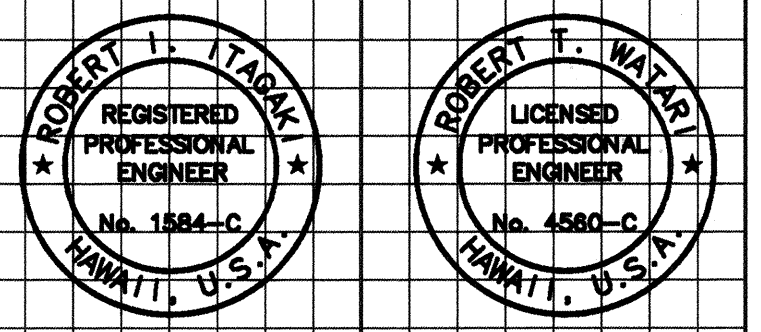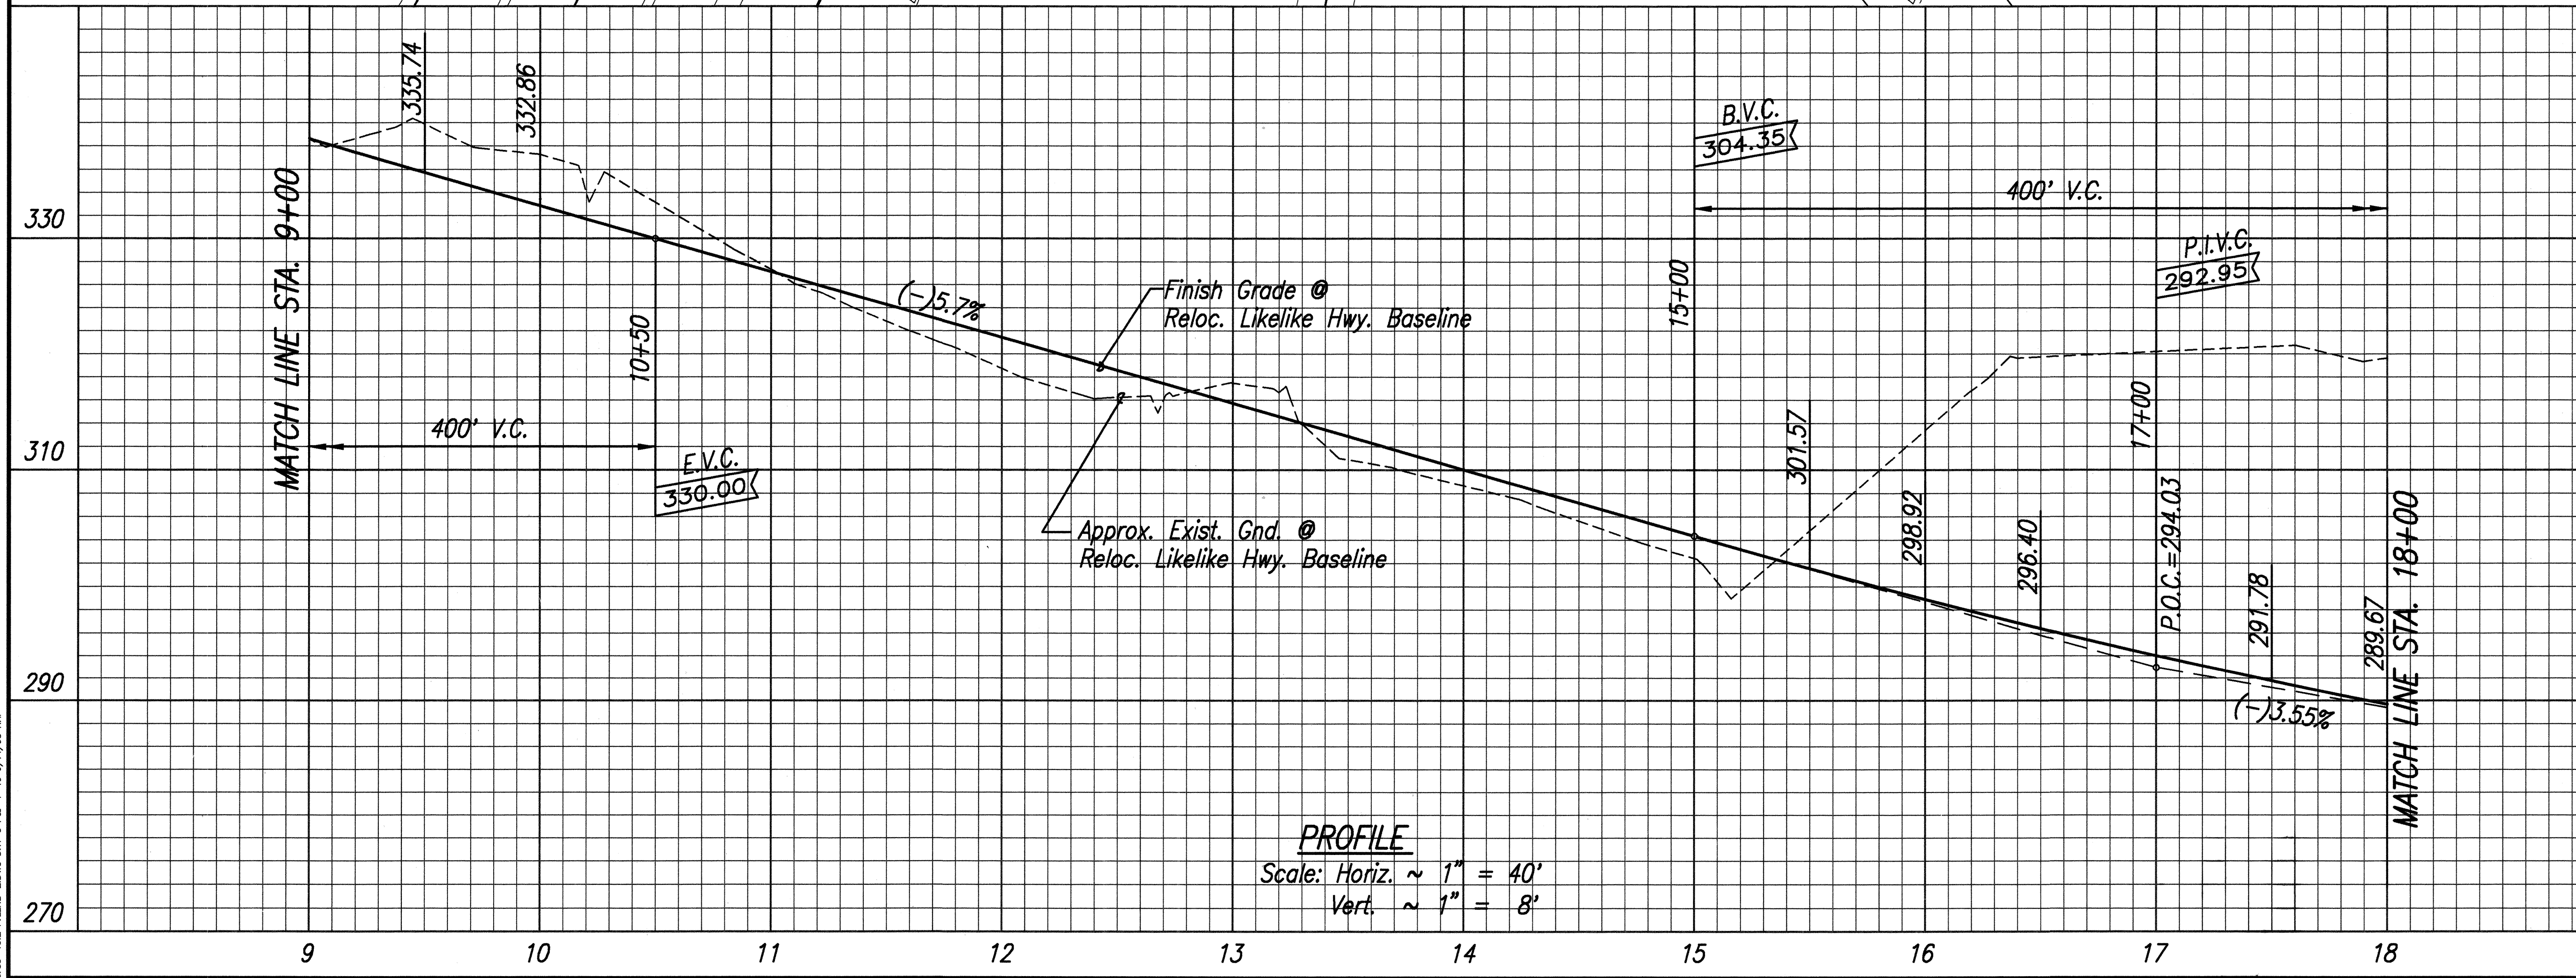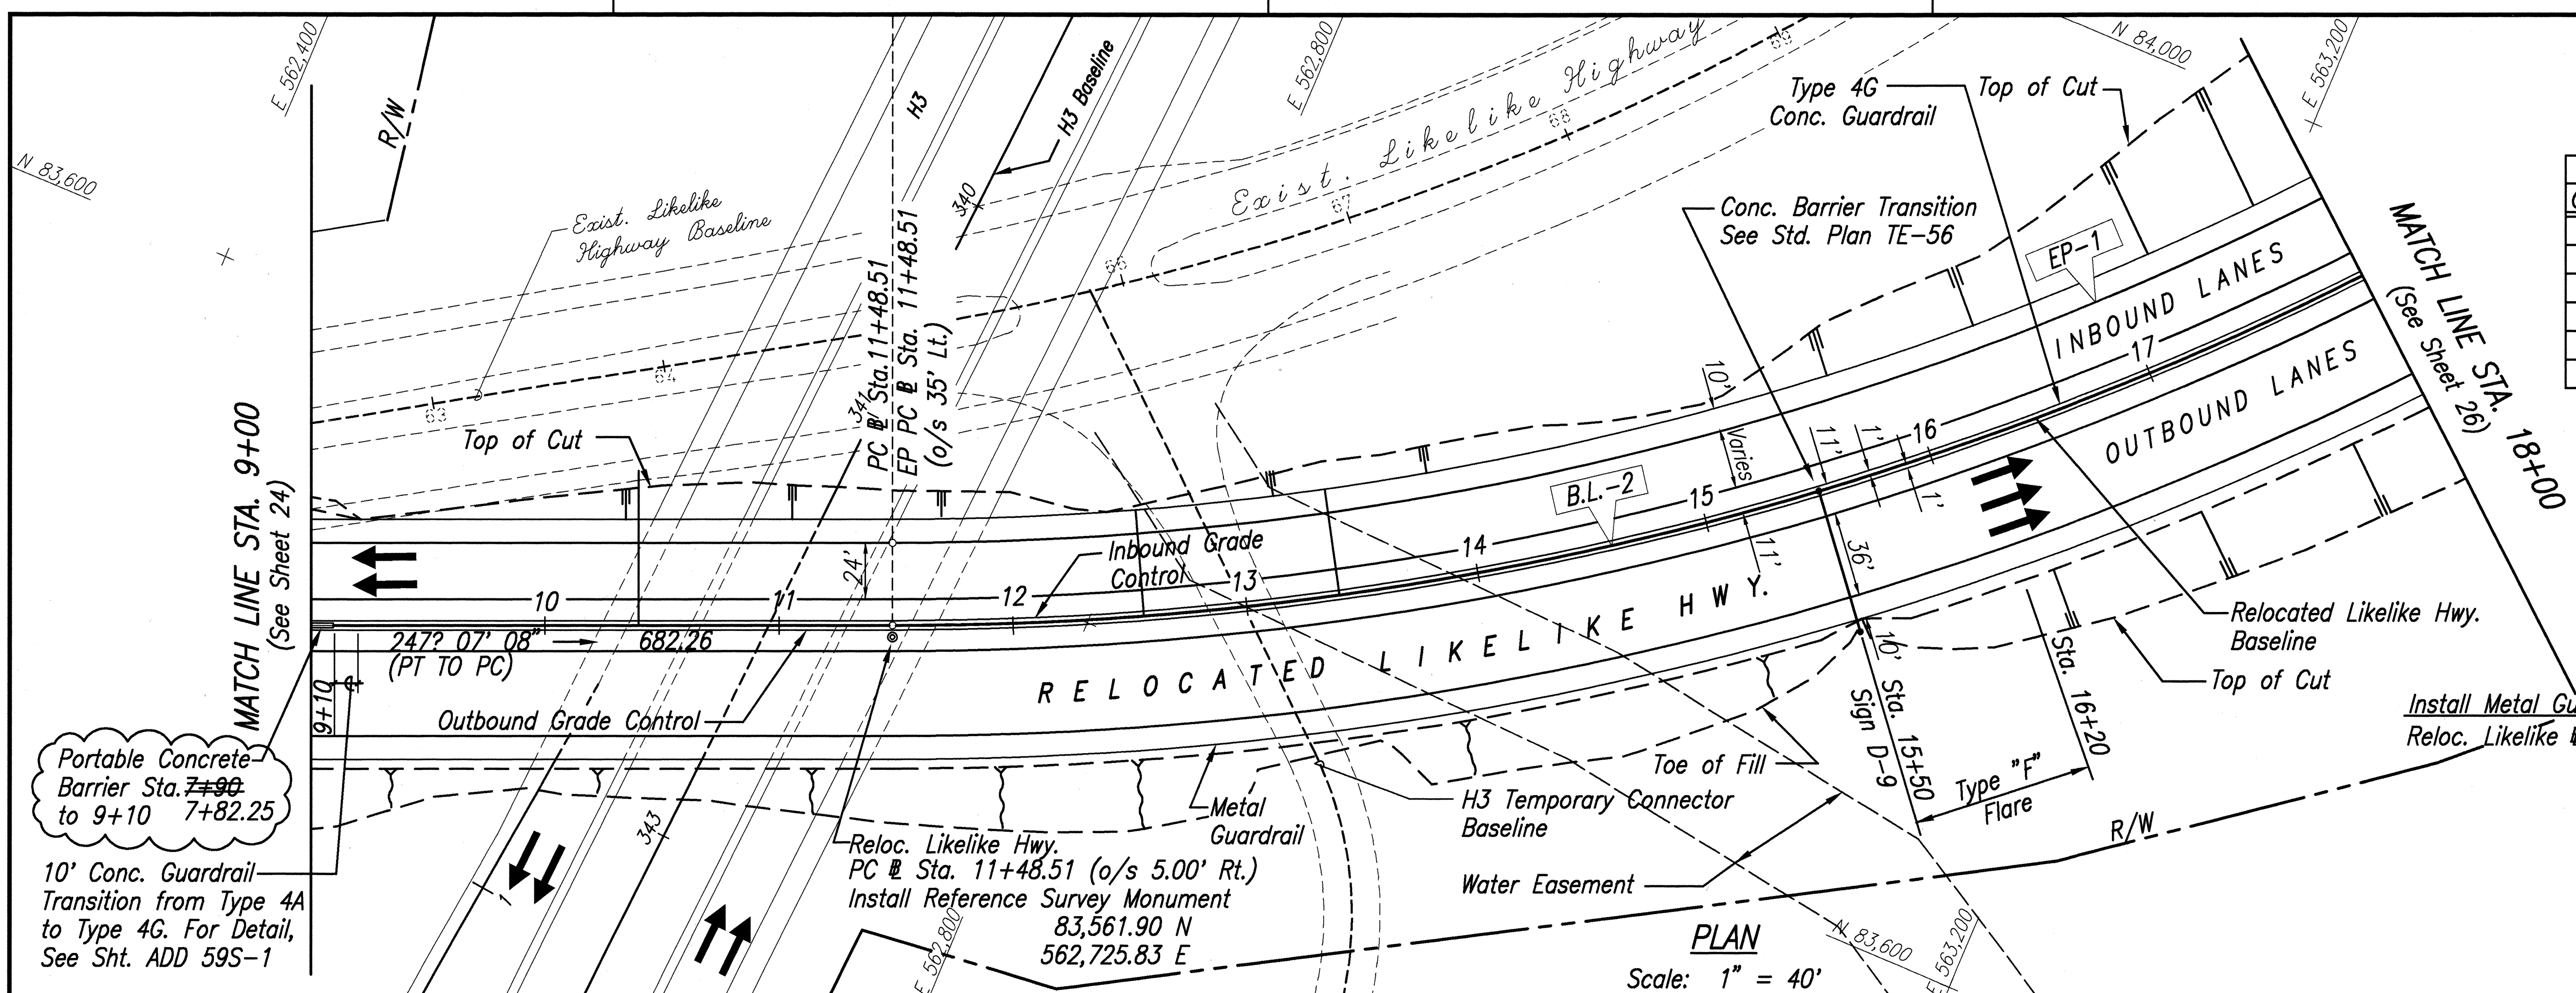

6/15/95	Revised Begin Station for Portable Conc. Barrier
4/21/94	Replaced Type 4G Concrete Guardrail w/ Portable Concrete Barrier from Sta. 7+90 to Sta. 9+10. Added Conc. Guardrail Transition

DATE: _____ REVISION: _____

STATE OF HAWAII
DEPARTMENT OF TRANSPORTATION
HIGHWAYS DIVISION

RELOCATED LIKELIKE HIGHWAY
STA. 9+00 TO STA. 18+00

INTERSTATE ROUTE H-3
F.A.I. PROJ. NO. I-H3-1(72)

SCALE: AS NOTED DATE: DEC. 1991

SHEET No. _____ OF _____ SHEETS



ORIGINAL PLAN	DATE
NO. _____	_____
DESIGNED BY	_____
TRACED BY	_____
QUANTITIES BY	_____

4.85-46.2 FILED-2 DMC D-11-3 P&P I-40 6/14/96 KAI

FED.ROAD DIST.NO.	STATE	PROJ. NO.	FISCAL YEAR	SHEET NO.	TOTAL SHEETS
HAWAII	HAW.	1-H3-1(72)	1991	ADD. 26	521

True North
Scale : 1" = 40'

CURVE DATA		
CURVE	BL-2	EP-1
Δ	60°00'00"	60°00'00"
$\Delta/2$	30°00'00"	30°00'00"
R	1400.00	1341.00
T	808.29	774.23
C	1400.00	1341.00
L	1466.08	1404.29

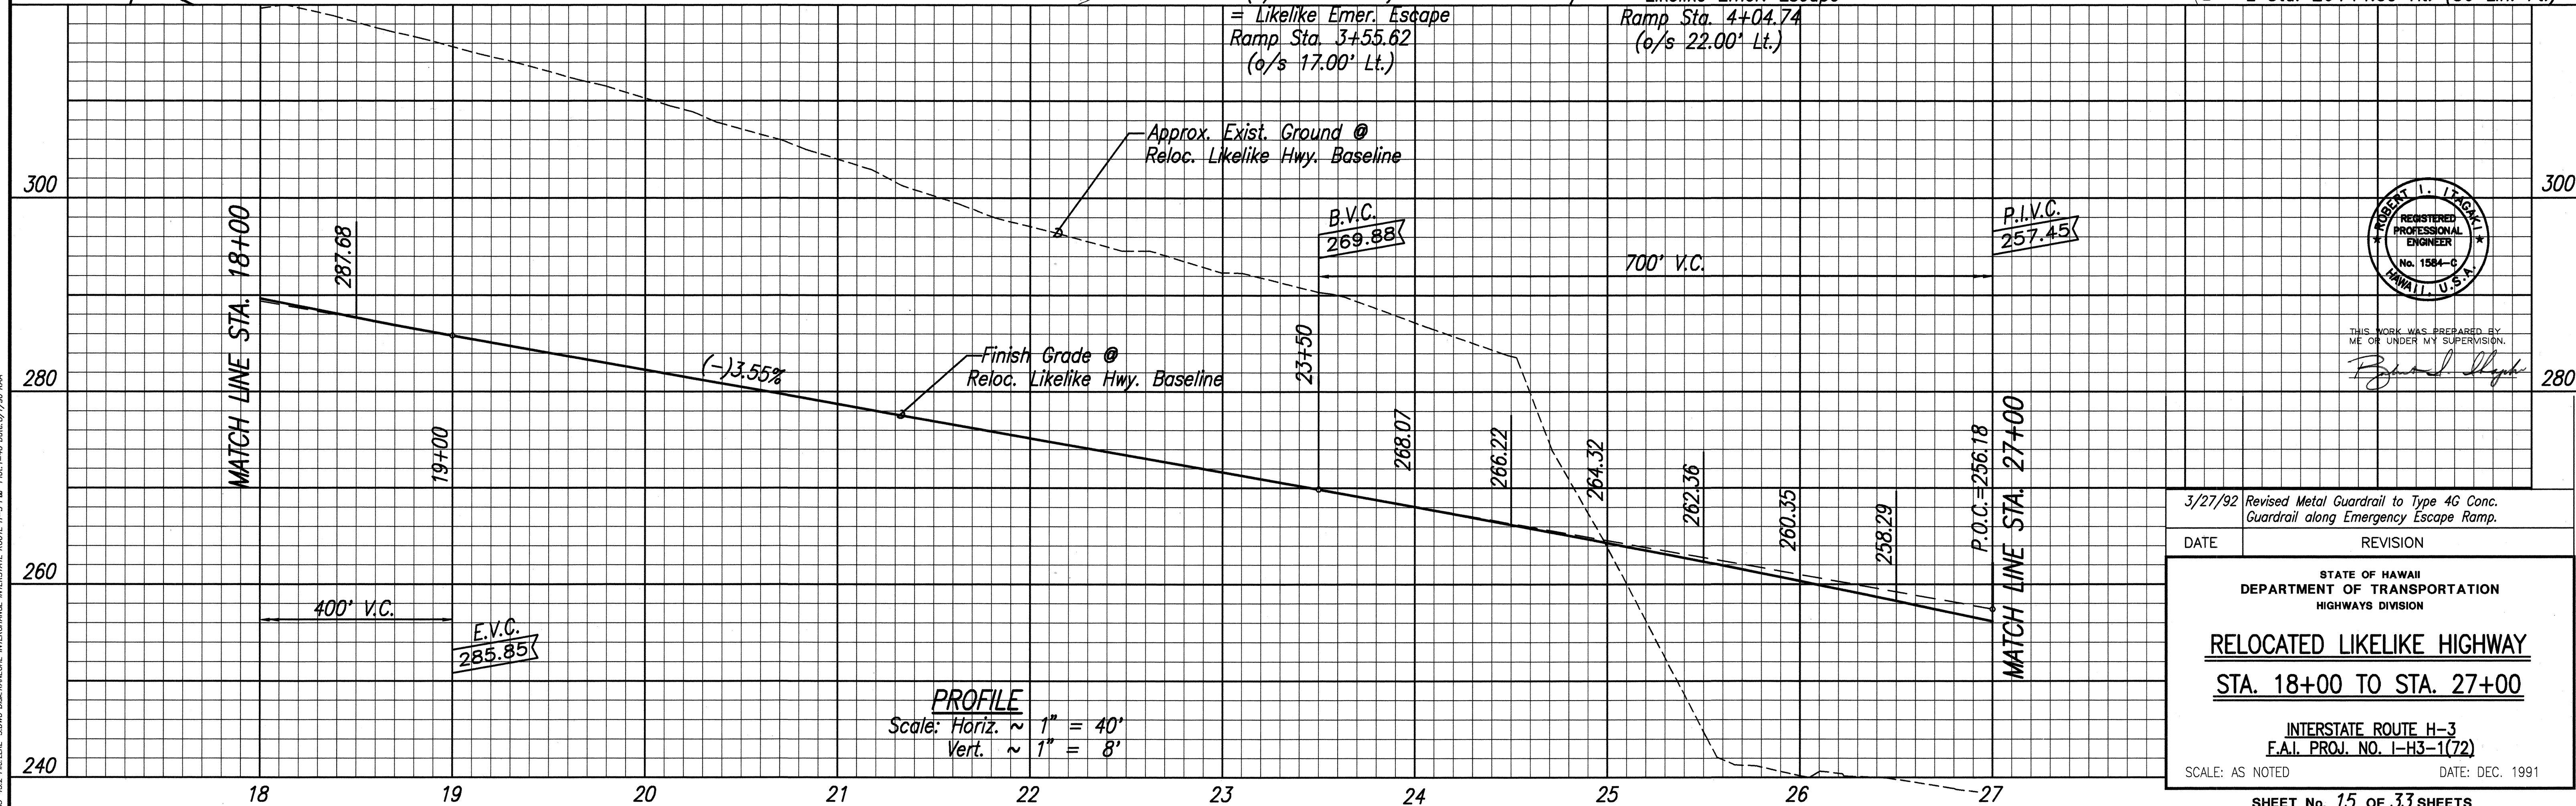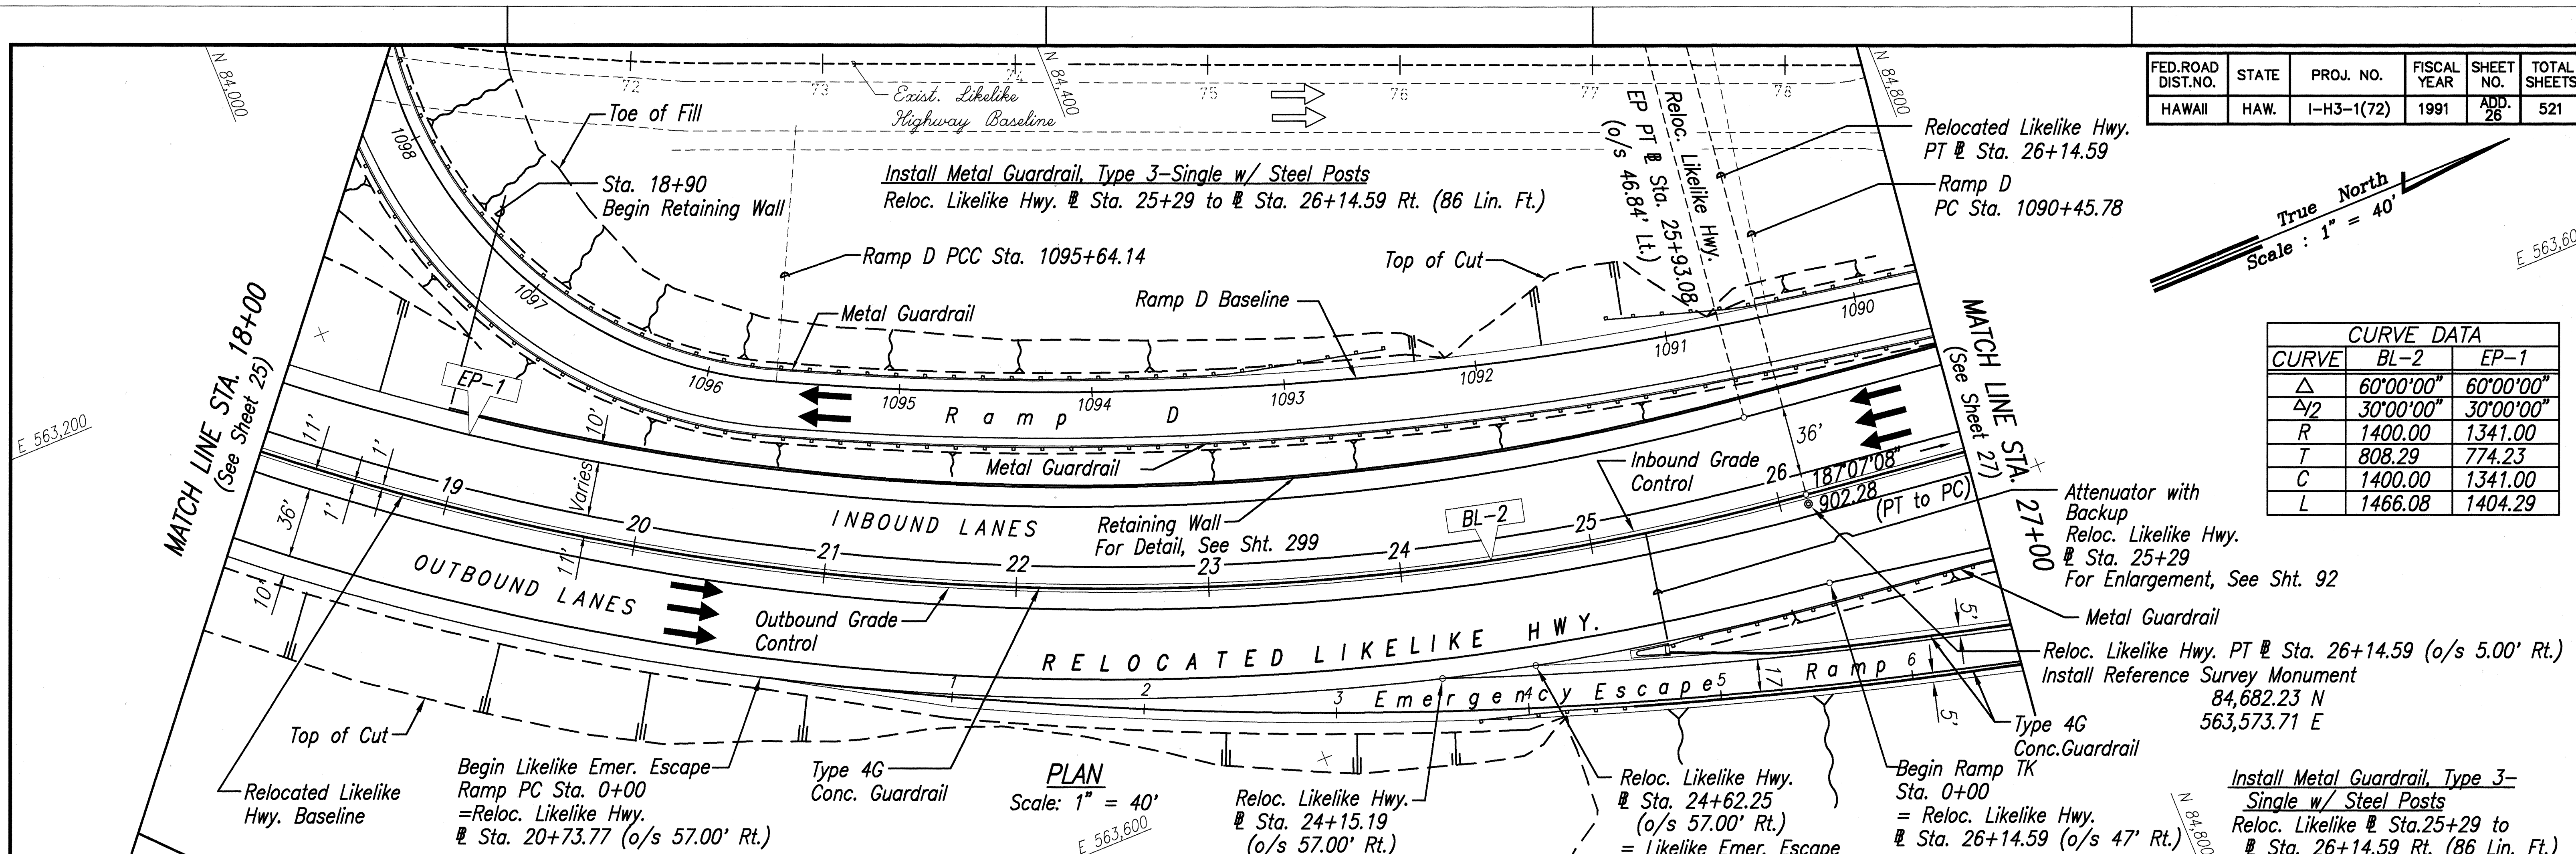

THIS WORK WAS PREPARED
ME OR UNDER MY SUPERVISION

Bund

3/27/92	Revised Metal Guardrail to Type 4G Concrete Guardrail along Emergency Escape Ramp
---------	---

DATE	REVISION
------	----------

STATE OF HAWAII
DEPARTMENT OF TRANSPORTATION
HIGHWAYS DIVISION

RELOCATED LIKELIKE HIGHWAY
STA. 18+00 TO STA. 27+00

INTERSTATE ROUTE H-3
F.A.I. PROJ. NO. I-H3-1(72)

SCALE: AS NOTED DATE: DEC. 1999

SHEET No. 15 OF 33 SHEETS


ADD. 26

ORIGINAL PLAN	SURVEY PLOTTED BY _____	DATE _____
NOTE BOOK	DRAWN BY _____	" "
	TRACED BY _____	" "
	DESIGNED BY _____	" "
	QUANTITIES BY _____	" "
No. _____	CHECKED BY _____	" "


83-452 FILED - 3 DWS DIST. KANEONE INTERCHANGING INTERSTATE ROUTE 4-3 P&P DIST. 1-40 DATE: 8/1/96 KAA

FED. ROAD DIST. NO.	STATE	PROJ. NO.	FISCAL YEAR	SHEET NO.	TOTAL SHEETS
HAWAII	HAW.	I-H3-1(72)	1991	C.O. ADD. 27	521


E 563,600

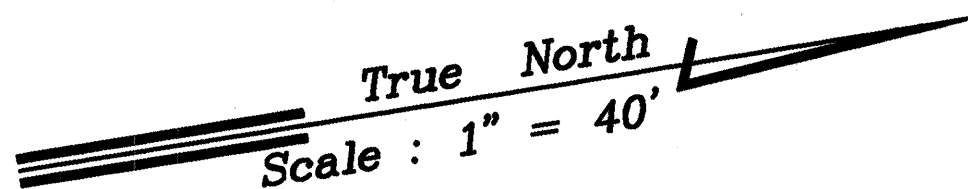


COORDINATE DATA		
DESCRIPTION	NORTHING	EASTING
PC Sta. 35+16.85	85,578.16	563,680.57
PI	86,103.32	563,746.15
PCC Sta. 45+49.16	86,518.94	564,073.80
Center of Curve	85,342.69	565,565.92

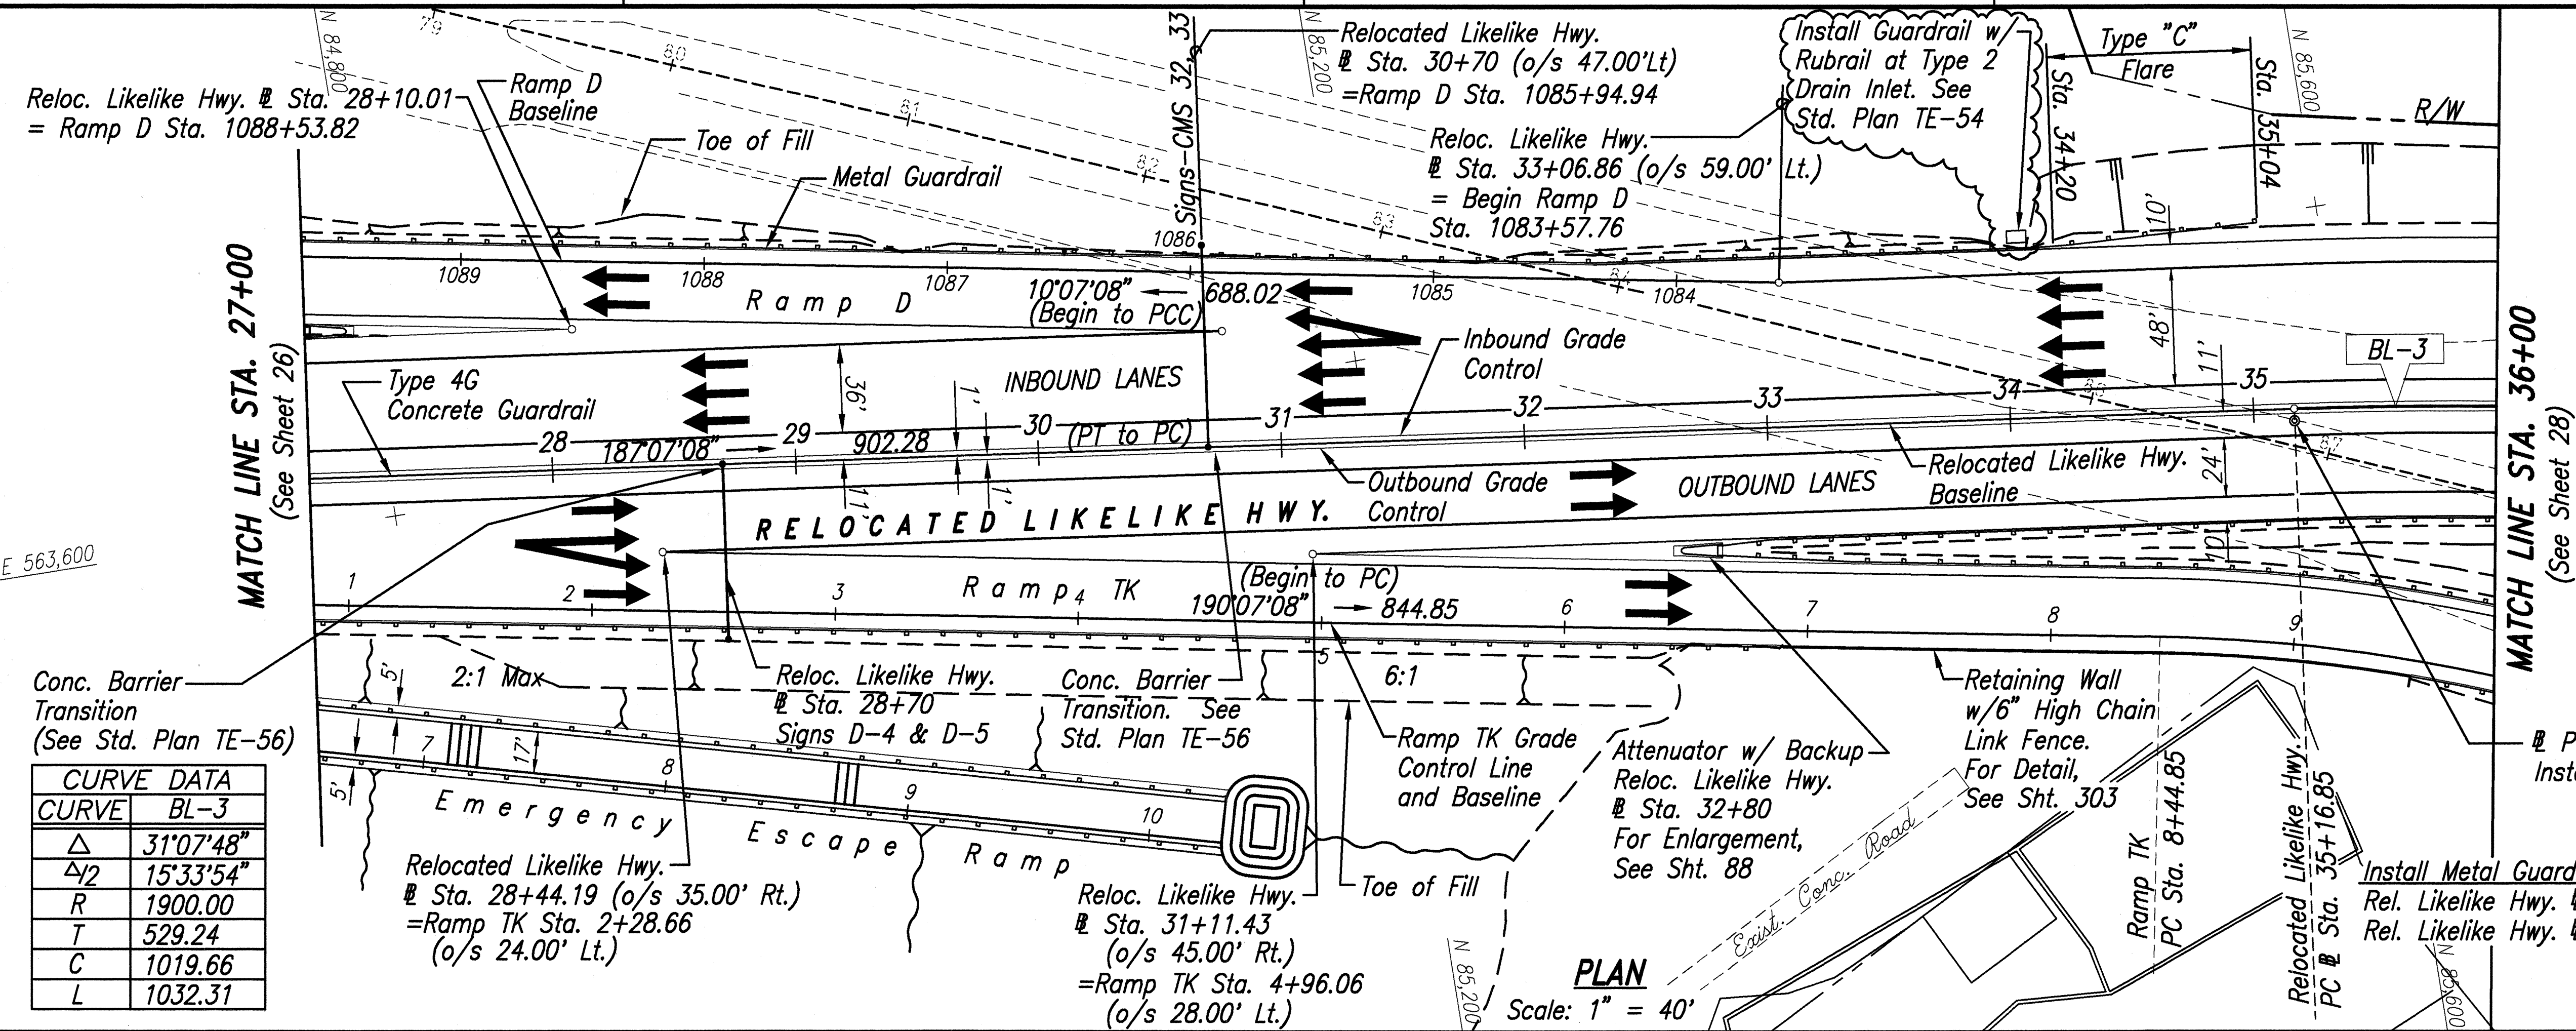

CURVE DATA	
CURVE	BL-3
Δ	31°07'48"
$\Delta/2$	15°33'54"
R	1900.00
T	529.24
C	1019.66
L	1032.31

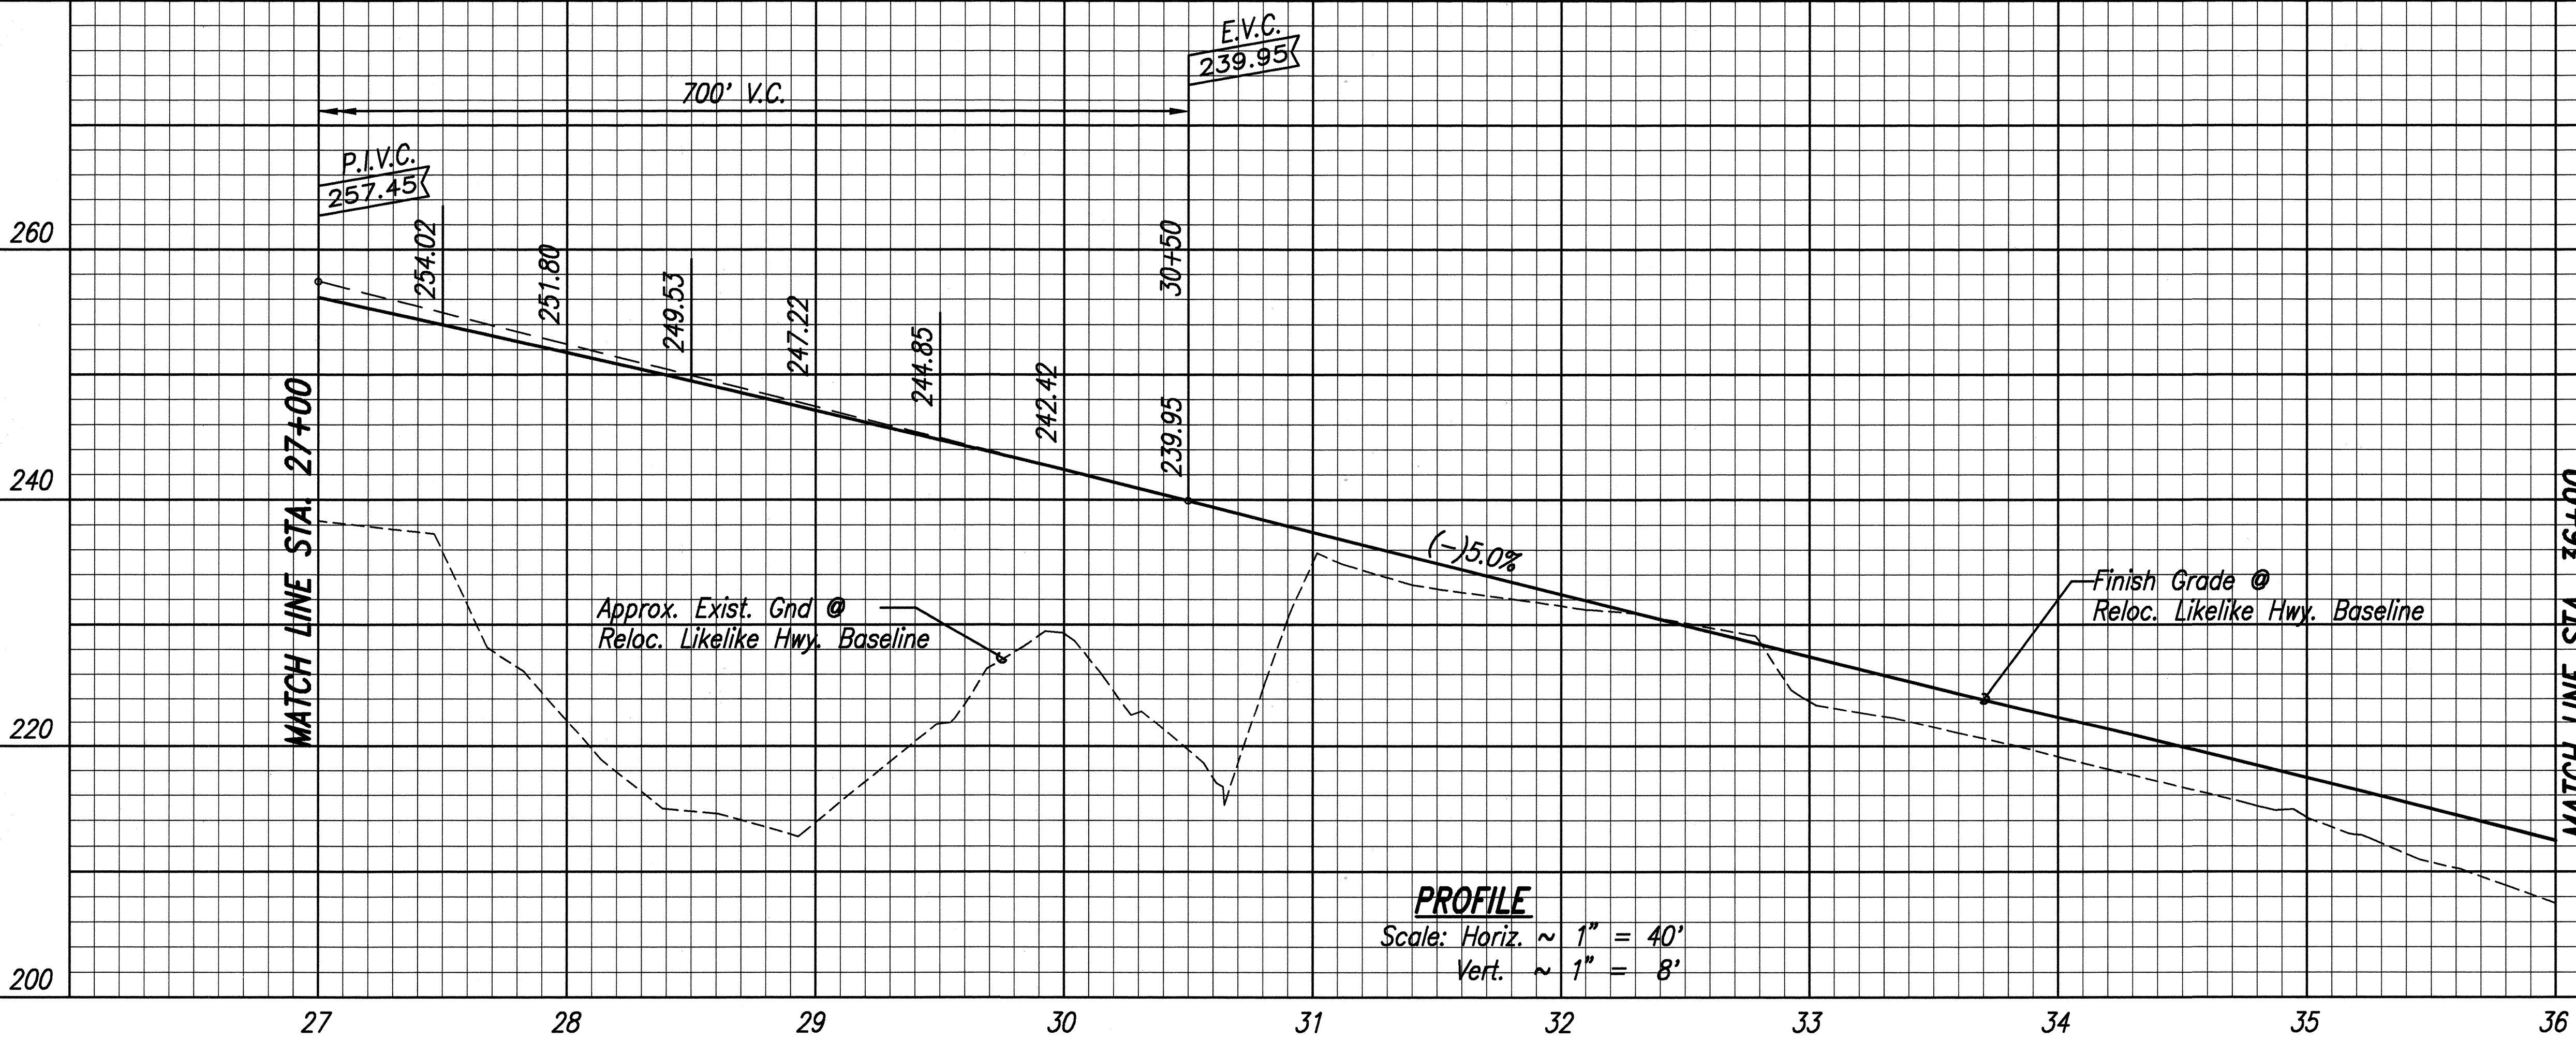

DATE	REVISION
1/27/92	Revised Right of Way @ Castle Hills Subd.
3/29/93	Revised grading @ TK Station 1+90± & Sta. 33+00 to 36+00
5/10/93	Revised Guardrail @ Reloc. Likelike Sta. 33+56 Lt. to 35+04 Lt.
9/5/95	Added Installation of Guardrail w/ Rubrail at Type 2 Drain Inlet, Sta. 34+05 Lt.

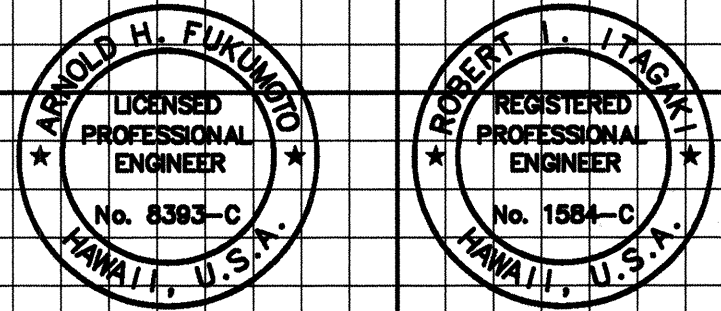

THIS WORK WAS PREPARED BY ME OR UNDER MY SUPERVISION.
Arnold H. Fukumoto

STATE OF HAWAII
DEPARTMENT OF TRANSPORTATION
HIGHWAYS DIVISION
RELOCATED LIKELIKE HIGHWAY
STA. 27+00 TO STA. 36+00
INTERSTATE ROUTE H-3
F.A.I. PROJ. NO. I-H3-1(72)

SCALE: AS NOTED DATE: DEC. 1991


SHEET No. OF SHEETS

C.O. ADD. 27

SURVEY PLANNED BY	DATE
DRAWN BY	
DESIGNED BY	
QUANTITIES BY	
NO.	

1-83-45.2 FILL-40MG KANEHE INTERCHANGE ROUTE H-3 MAP Proj. 1-40 Date 9/25/95 of

FED. ROAD DIST. NO.	STATE	PROJ. NO.	FISCAL YEAR	SHEET NO.	TOTAL SHEETS
HAWAII	HAW.	I-H3-1(72)	1991	ADD. 28	521

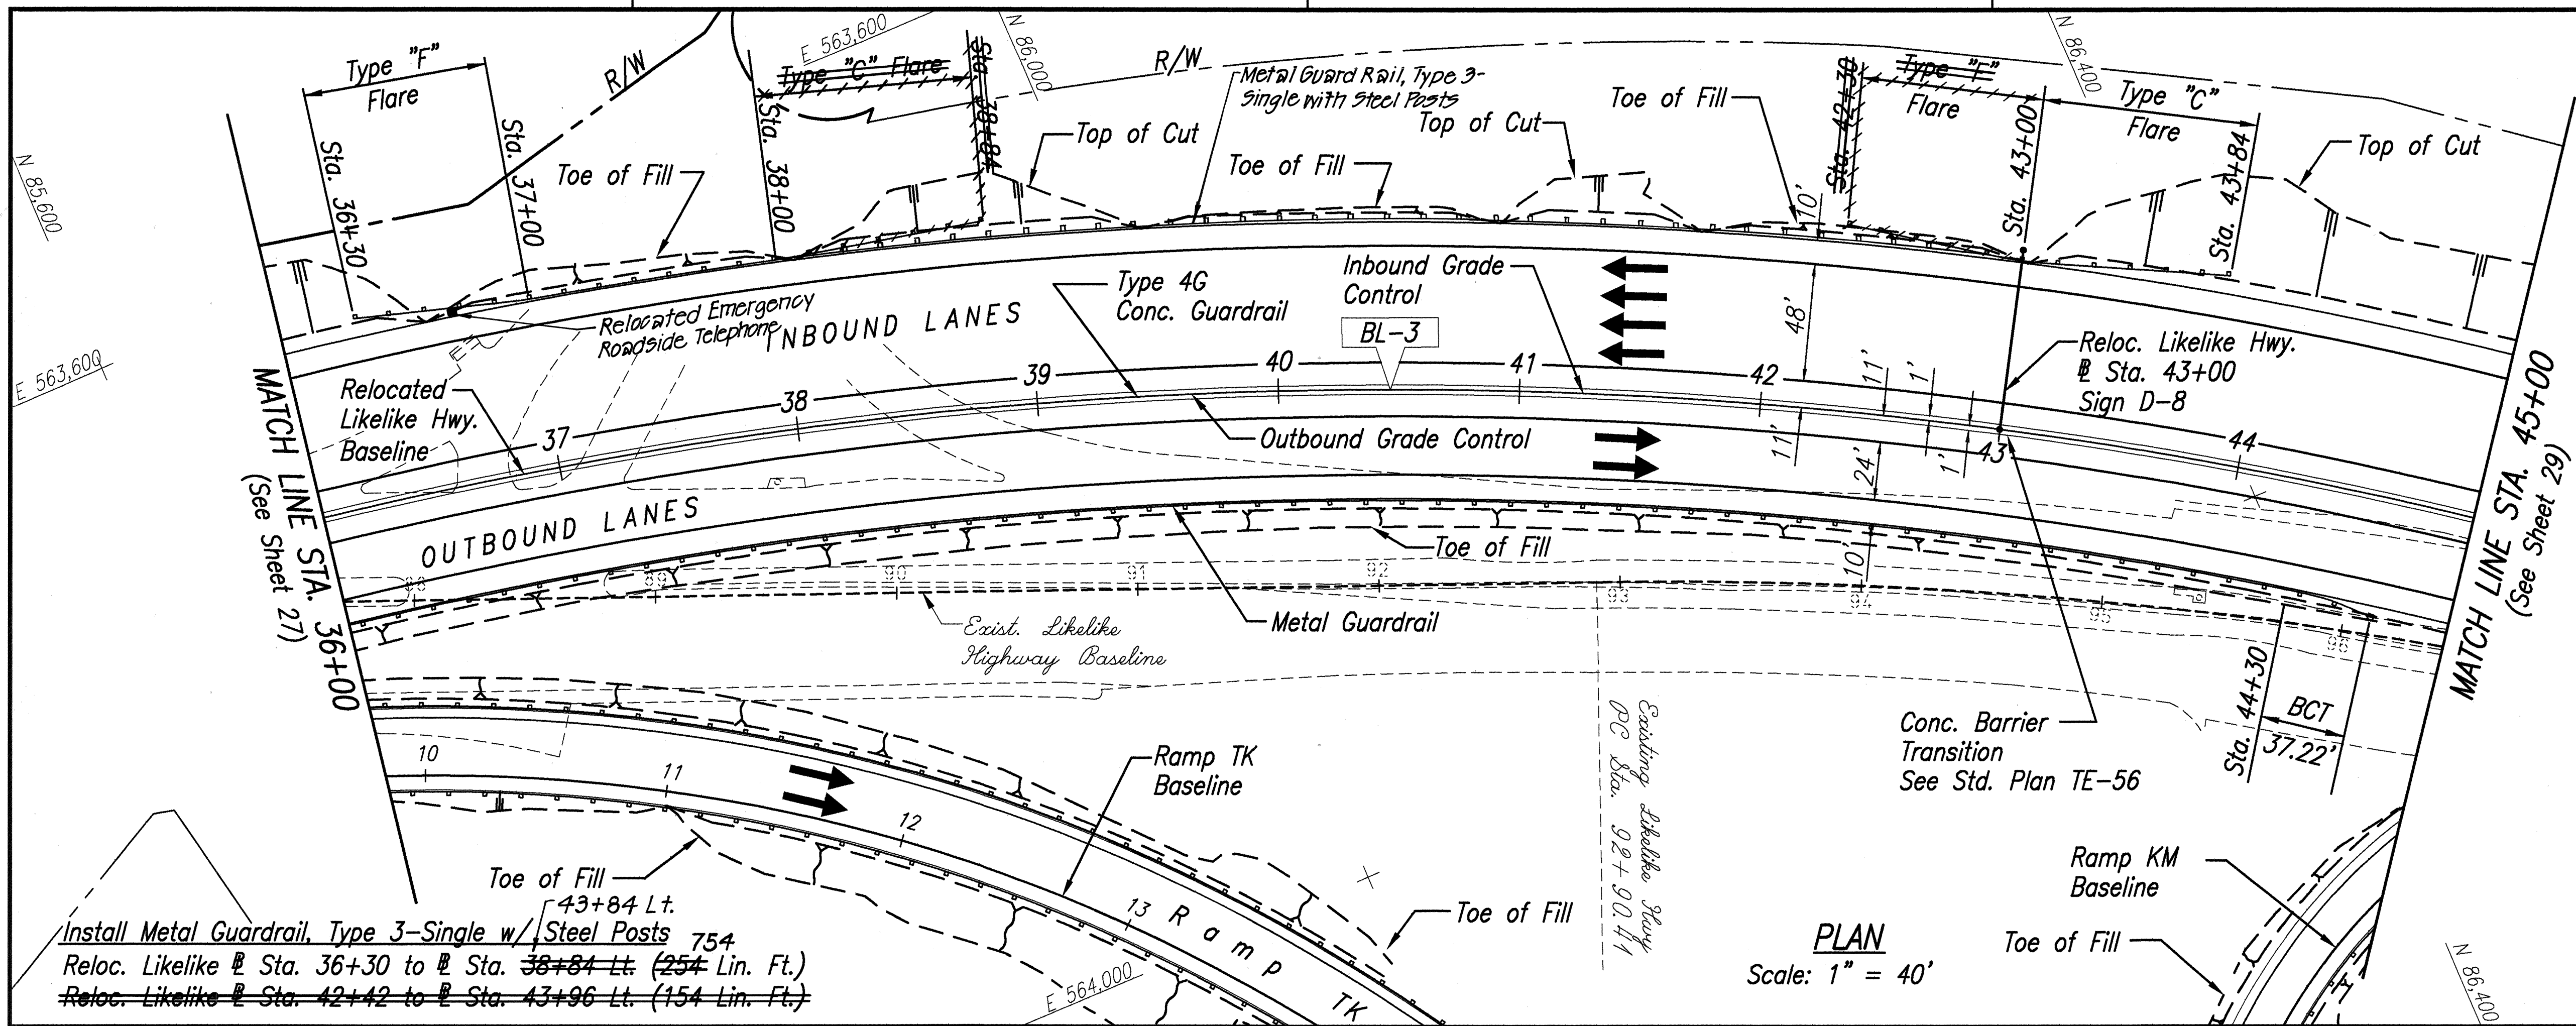


True North
Scale: 1" = 40'

CURVE DATA	
CURVE	BL-3
Δ	31°07'48"
Δ/2	15°33'54"
R	1900.00
T	529.24
C	1019.66
L	1032.31


PLAN
Scale: 1" = 40'

Install Metal Guardrail, Type 3-Single w/ Steel Posts 754
Reloc. Likelike @ Sta. 36+30 to Sta. 38+84 Lt. (254 Lin. Ft.)
Reloc. Likelike @ Sta. 42+42 to Sta. 43+96 Lt. (154 Lin. Ft.)

DATE	REVISION
1/27/92	Revised Right of Way @ Castle Hills Subd.

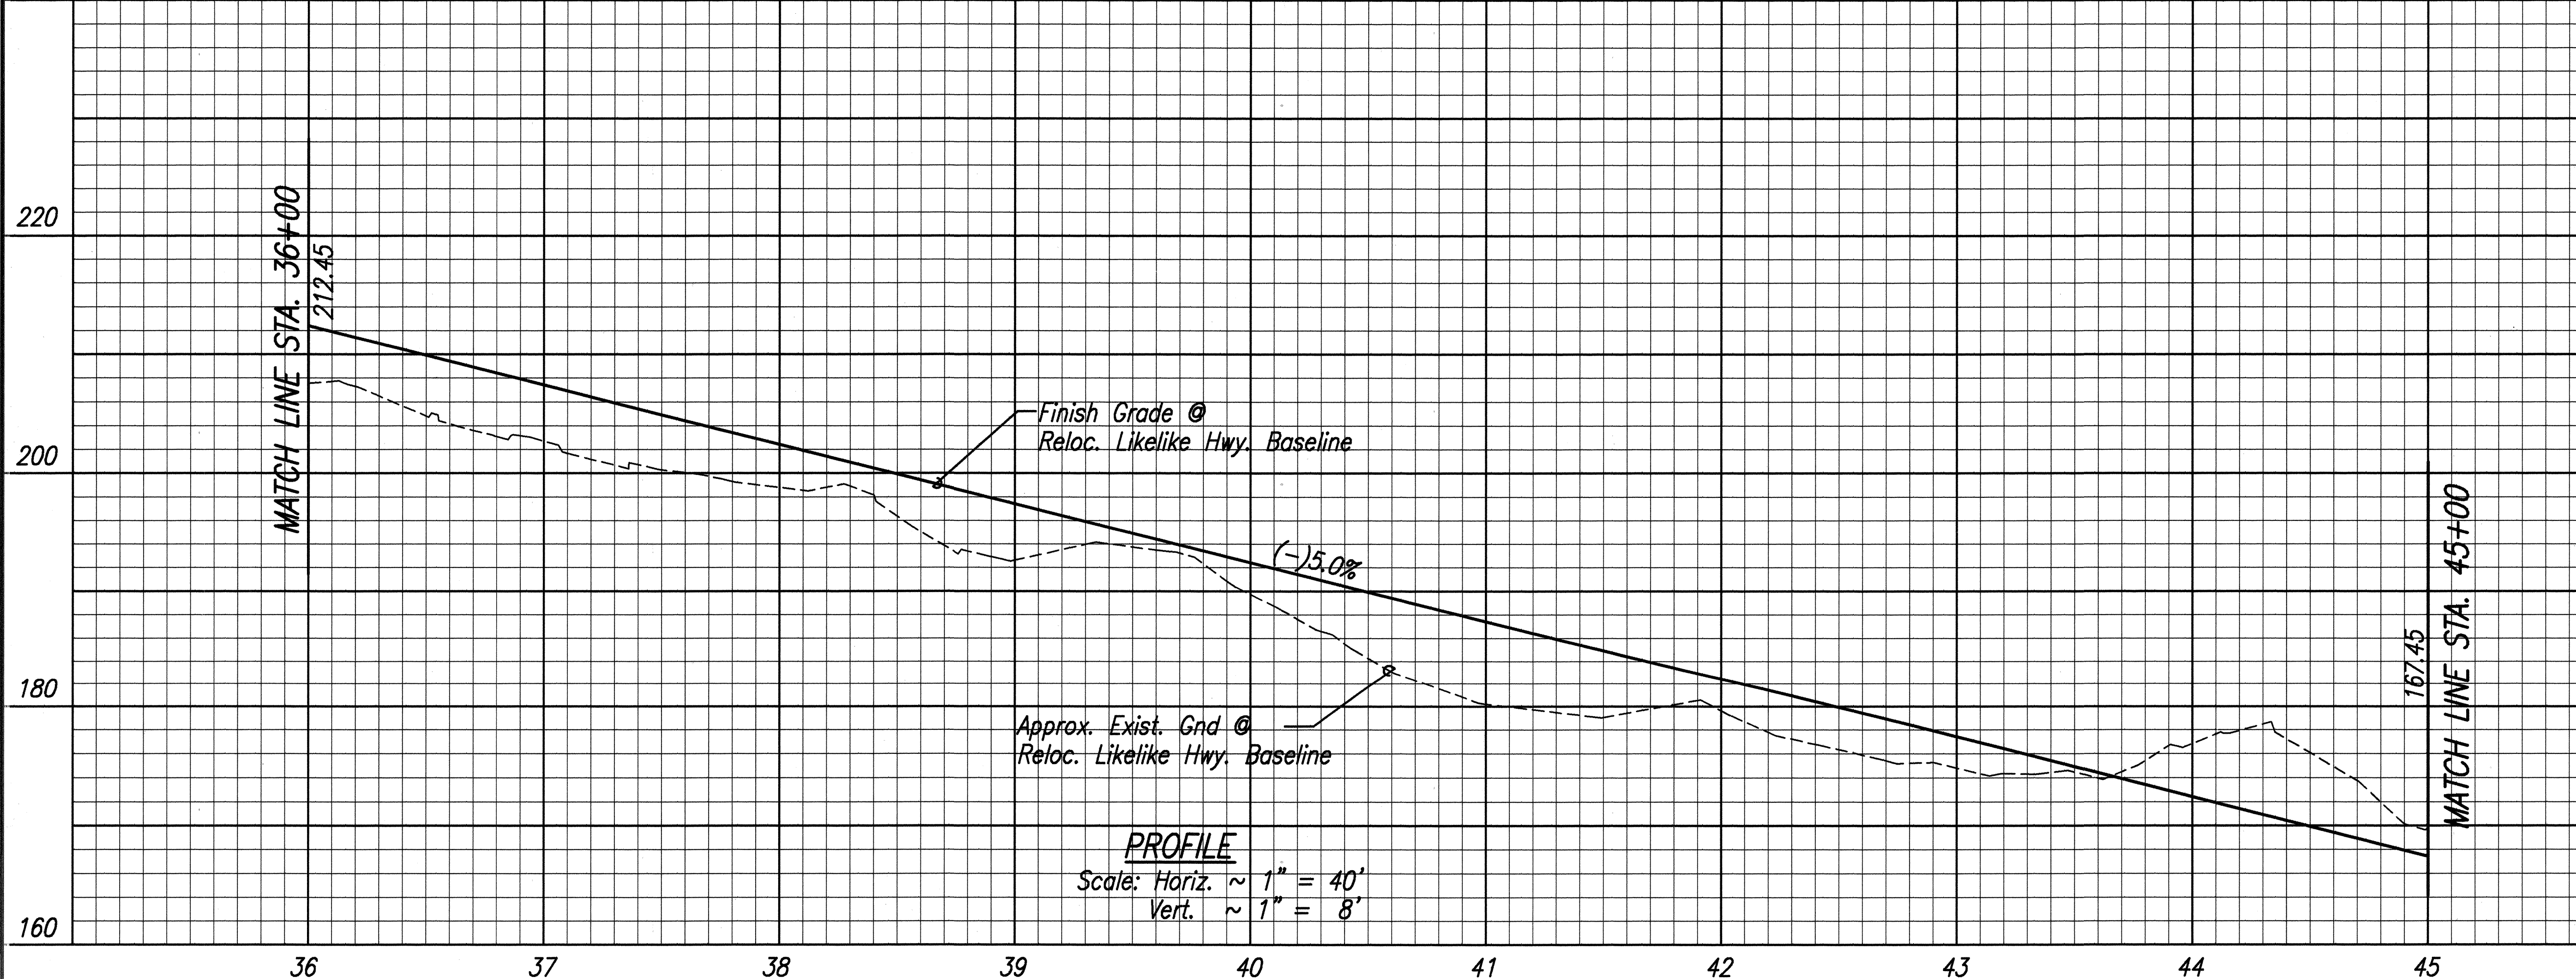

PROFILE
Scale: Horiz. ~ 1" = 40'
Vert. ~ 1" = 8'

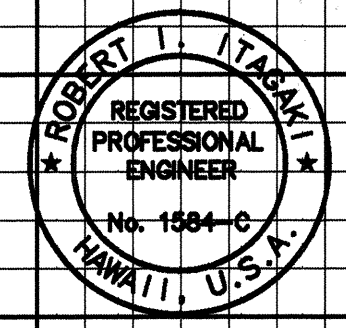

THIS WORK WAS PREPARED BY
ME OR UNDER MY SUPERVISION.
Robert L. Atkinson

STATE OF HAWAII
DEPARTMENT OF TRANSPORTATION
HIGHWAYS DIVISION
RELOCATED LIKELIKE HIGHWAY
STA. 36+00 TO STA. 45+00

INTERSTATE ROUTE H-3
F.A.I. PROJ. NO. I-H3-1(72)
SCALE: AS NOTED DATE: DEC. 1991

SHEET No. OF SHEETS

ADD. 28

ORIGINAL PLAN	DATE
SURVEYED BY	
DRAWN BY	
DESIGNED BY	
NOTED BY	
QUANTITIES BY	
NO.	


483-452 F.L.R.E.-5016 INTERCHANGE INTERSTATE ROUTE H-3 PAP. PROJ. 1-40 DATE: 1/24/92

Reloc. Likelike Hwy.
PCC @ Sta. 45+49.16 (o/s 5.00' Rt.)
Install Reference Survey Monument
86,515.85 N
564,077.72 E

Install Metal Guardrail, Type 3-Single w/ Steel Posts
Reloc. Likelike Hwy. @ Sta. 49+80 to @ Sta. 53+96.40 Lt. (446 Lin. Ft.)

See Intersection
Plan, Sht. 30

FED. ROAD DIST. NO.	STATE	PROJ. NO.	FISCAL YEAR	SHEET NO.	TOTAL SHEETS
HAWAII	HAW.	I-H3-1(72)	1991	C.O. ADD. 29	521

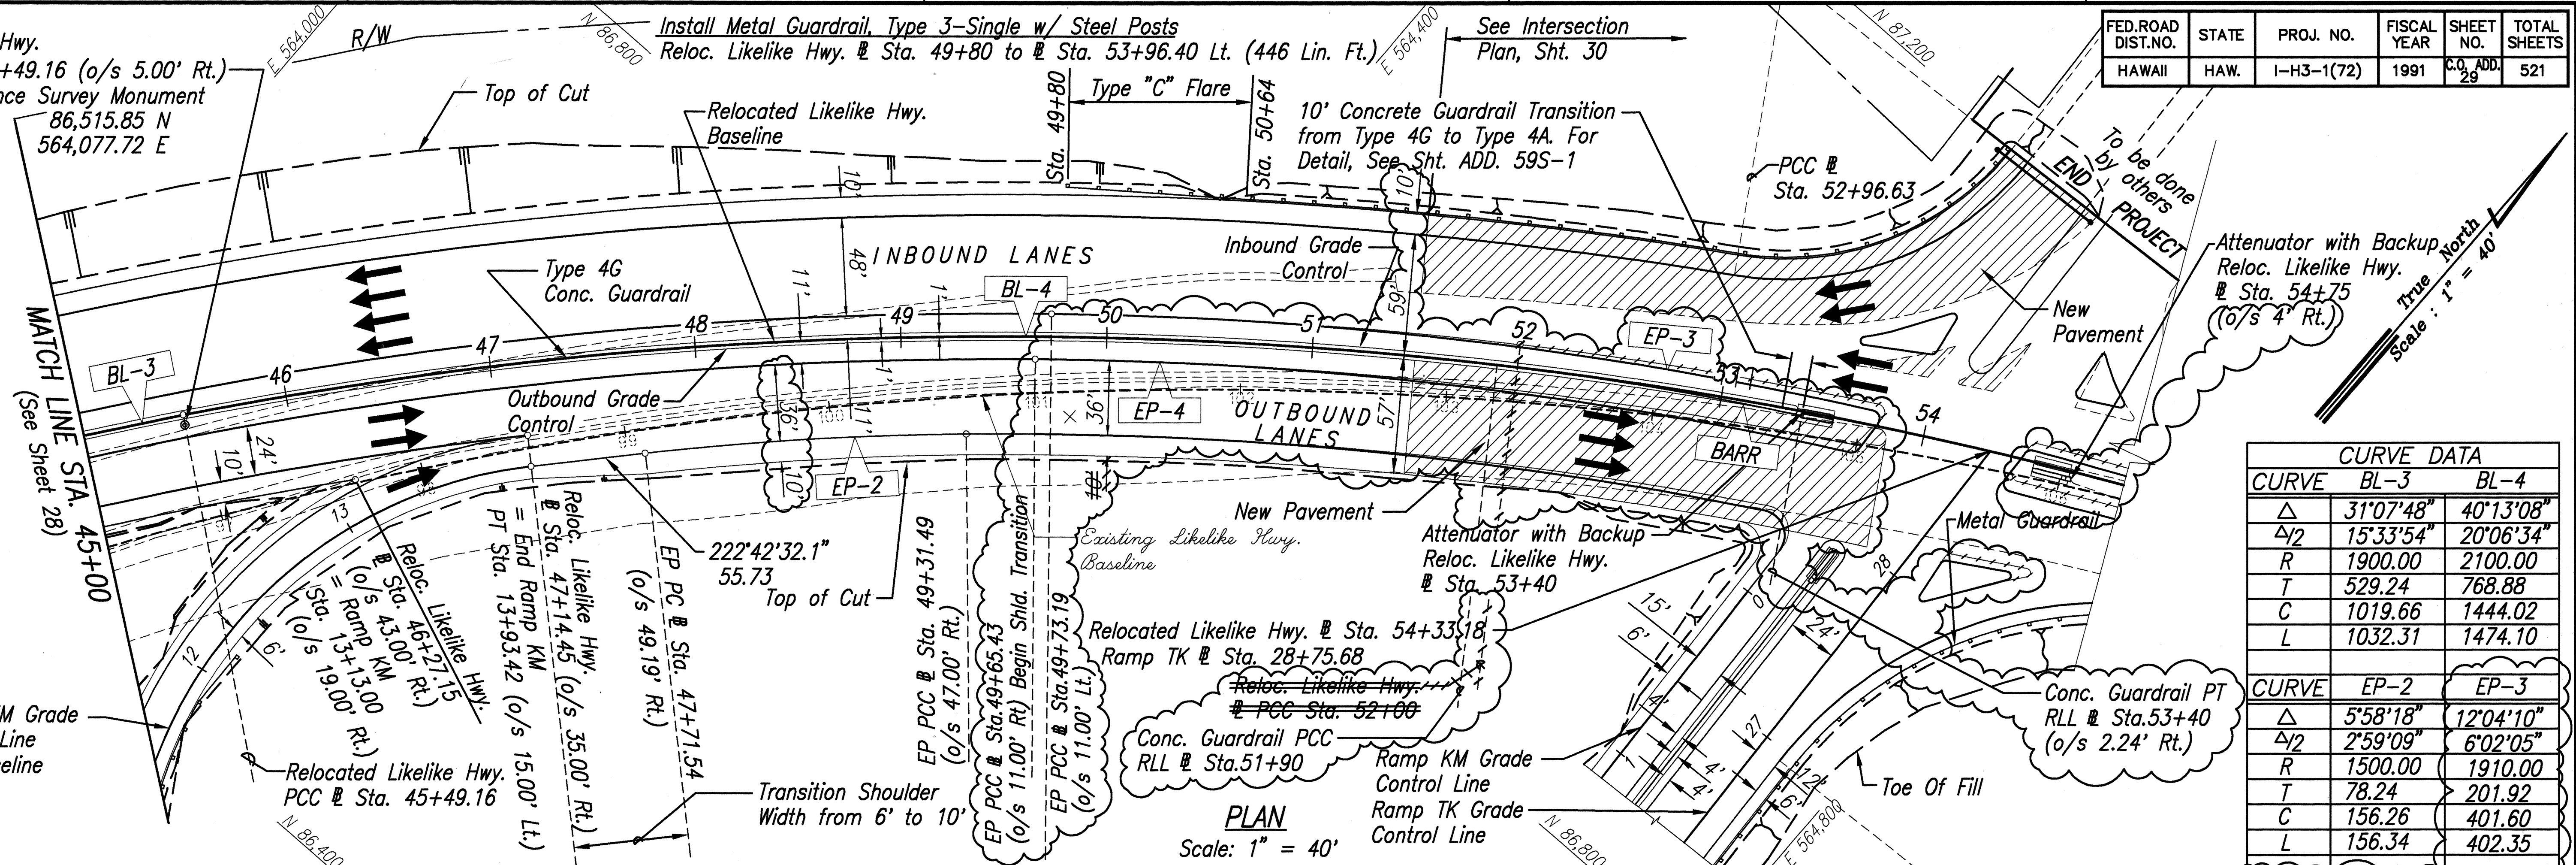


CURVE DATA		
CURVE	BL-3	BL-4
Δ	31°07'48"	40°13'08"
Δ/2	15°33'54"	20°06'34"
R	1900.00	2100.00
T	529.24	768.88
C	1019.66	1444.02
L	1032.31	1474.10

CURVE	EP-2	EP-3
Δ	5°58'18"	12°04'10"
Δ/2	2°59'09"	6°02'05"
R	1500.00	1910.00
T	78.24	201.92
C	156.26	401.60
L	156.34	402.35


CURVE	EP-4	BARR
Δ	12°05'15"	5°48'21"
Δ/2	6°02'38"	2°54'10"
R	1890.00	1480.00
T	200.11	75.05
C	397.99	149.90
L	398.73	149.97

COORDINATE DATA		
DESCRIPTION	NORTHING	EASTING
PCC Sta. 45+49.16	86,518.94	564,073.80
PI	87,122.77	564,549.80
PT Sta. 60+23.26	87,276.48	565,303.16
Center of Curve	85,218.88	565,722.99

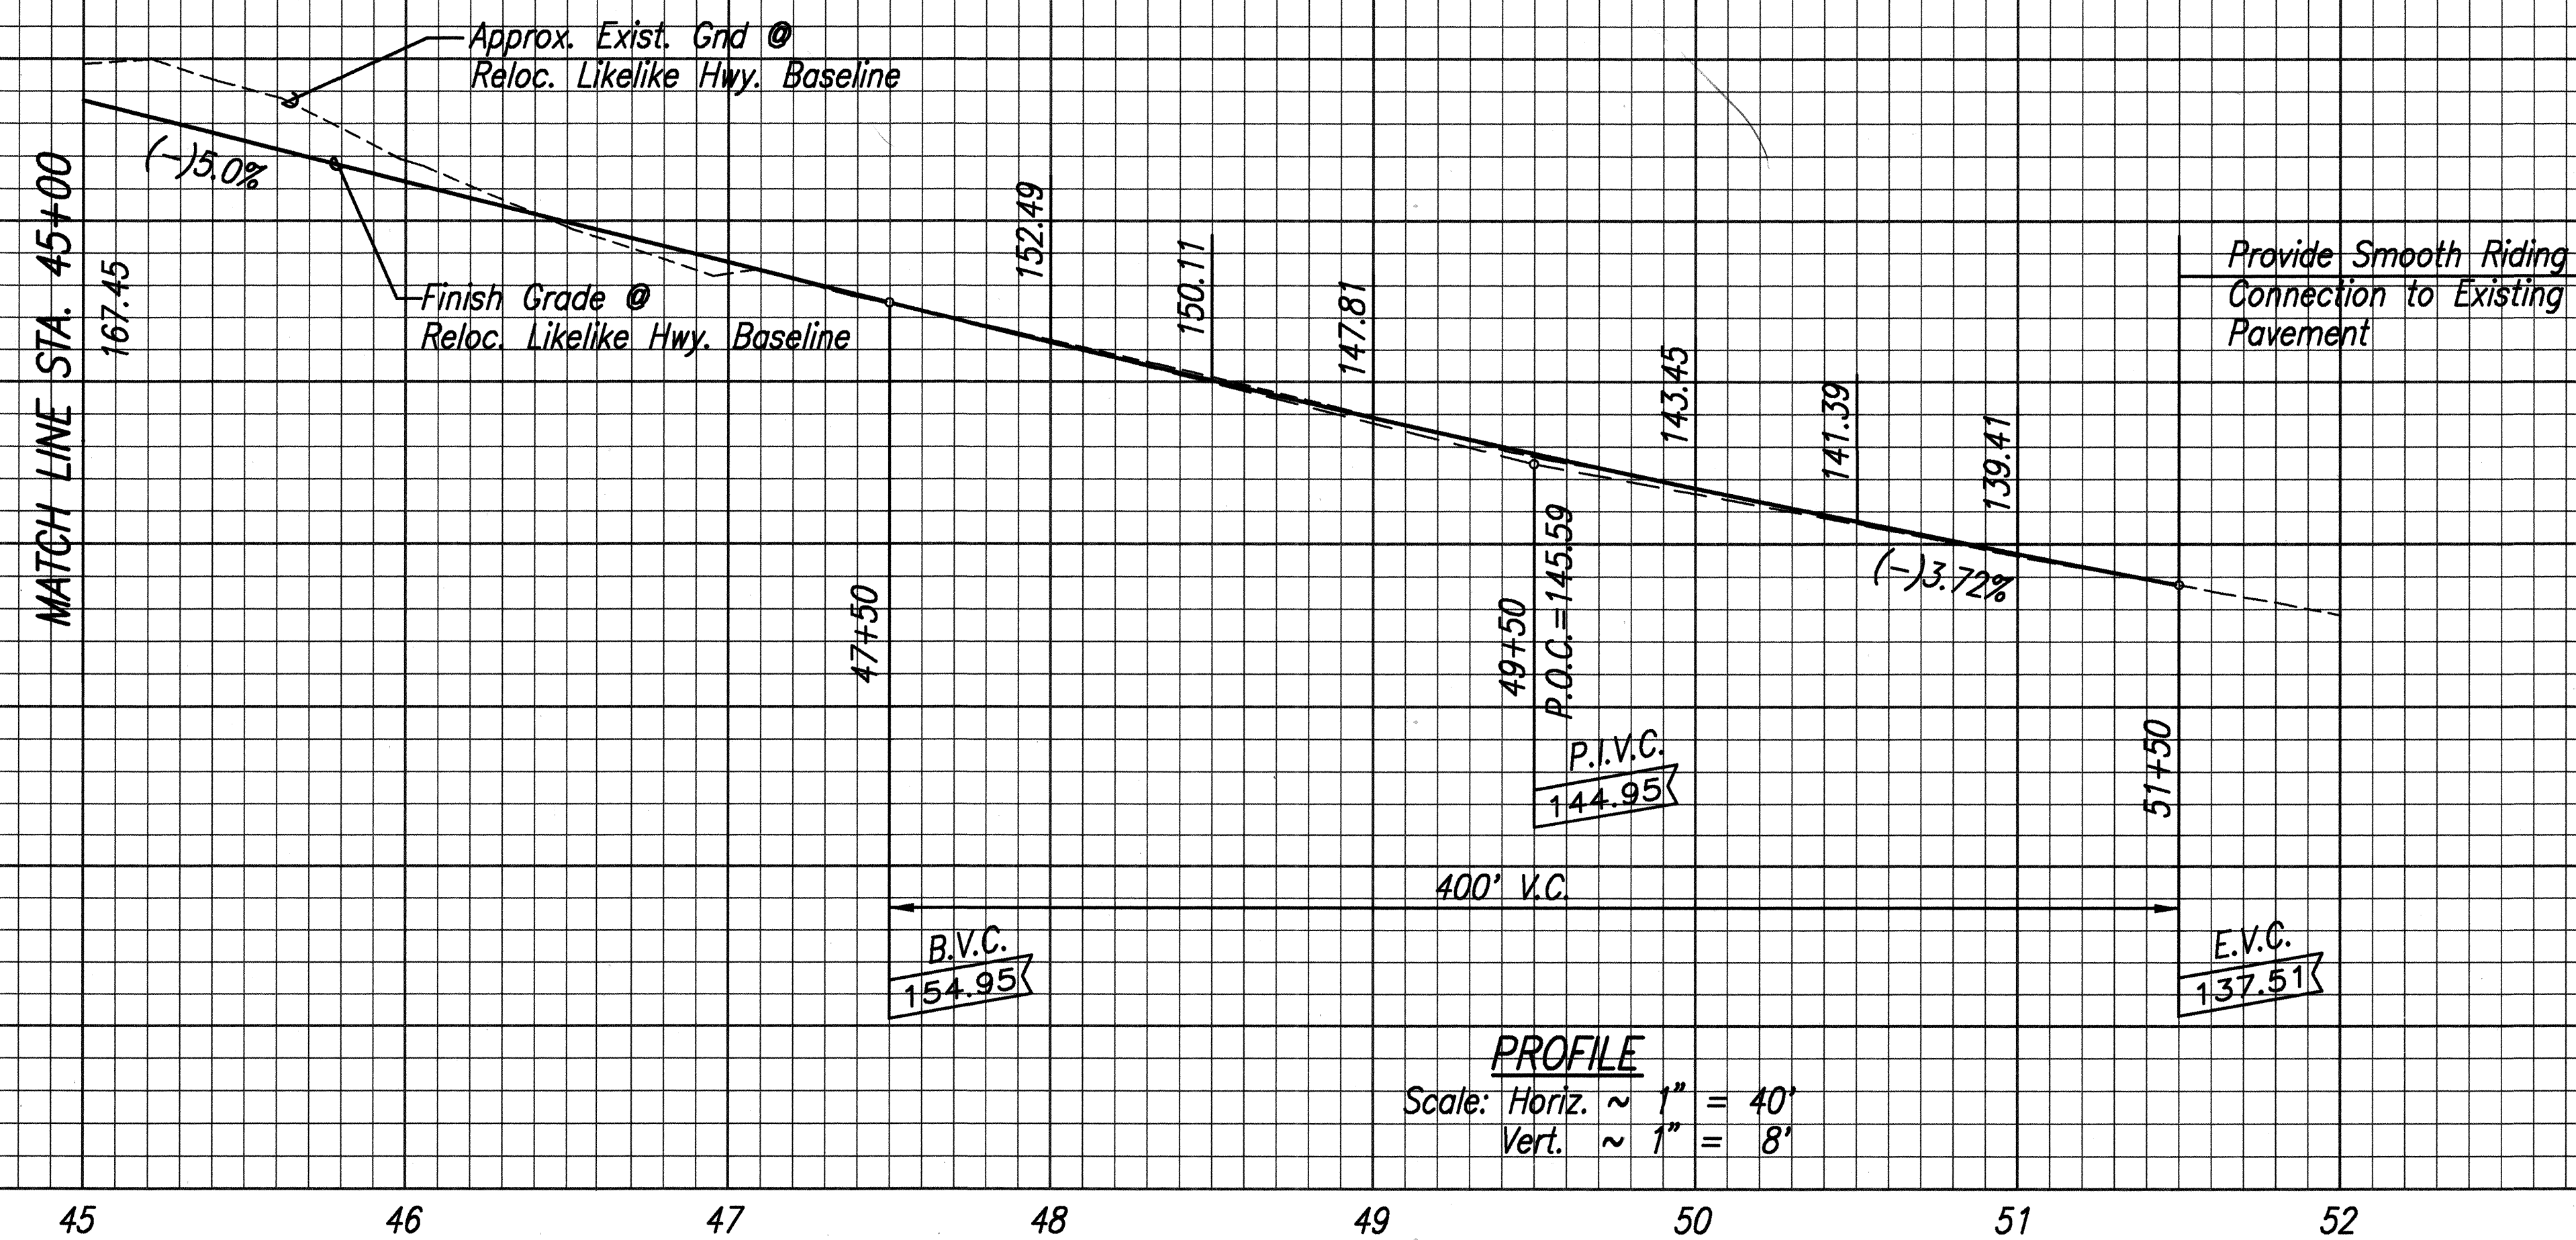

PROFILE
Scale: Horiz. ~ 1" = 40'
Vert. ~ 1" = 8'

- | DATE | REVISION |
|----------|--|
| 4/12/95 | Revised Median Edge Pavement, Island at Ramp TK/Likelike Hwy. Intersection and Location of Conc. Guardrail at Intersection. |
| 12/20/93 | Revised Right-of-Way. Deleted Attenuator and Temporary Geotextile Wall. |
| 2/17/93 | Revised Edge Pav't Radius and Added Channelizing Island at Ramp TK/Reloc. Likelike Intersection. |
| 2/21/92 | Revised retaining wall callout to Temporary Geotextile Wall & continued wall across End of Project to exist. Kahekili Hwy. Revised o/s @ Sta. 49+31.49 to 47' Rt. Added Sta. callout for Type "C" Flare. |
| 1/27/92 | Revised retaining wall callout. Deleted attenuator outside of project. Added callout for guardrail transition. |

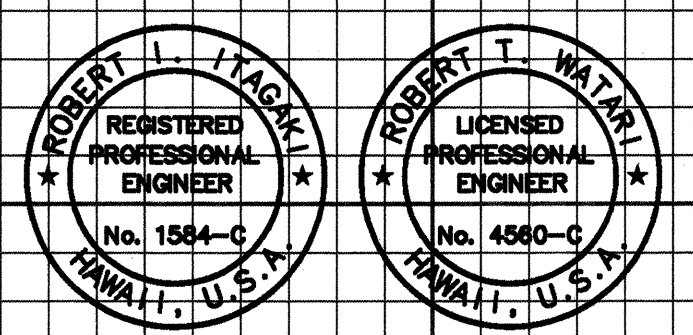

STATE OF HAWAII
DEPARTMENT OF TRANSPORTATION
HIGHWAYS DIVISION

RELOCATED LIKELIKE HIGHWAY
STA. 45+00 TO STA. 51+50

INTERSTATE ROUTE H-3
F.A.I. PROJ. NO. I-H3-1(72)

SCALE: AS NOTED DATE: DEC. 1991




SHEET No. OF SHEETS

FED. ROAD DIST. NO.	STATE	PROJ. NO.	FISCAL YEAR	SHEET NO.	TOTAL SHEETS
HAWAII	HAW.	I-H3-1(72)	1991	C.O. ADD 30	521

CURVE DATA									
CURVE	1	2	3	4	5	6	7	8	9
Δ	117°39'14"	116°36'08"	180°00'	180°00'	69°27'57"	8°35'36"	163°57'16"	66°05'31"	138°32'49"
$\Delta/2$	58°49'37"	58°18'04"	90°00'	90°00'	34°43'58"	4°17'48"	81°58'38"	33°02'45"	69°16'24"
R	12.00	12.00	2.00	6.00	200.00	125.88	2.00	3.00	2.00
T	19.84	19.43	∞	∞	138.66	9.46	14.19	1.95	5.29
C	20.53	20.42	4.00	12.00	227.90	18.86	3.96	3.27	3.74
L	24.64	24.42	6.28	18.85	242.48	18.88	5.72	3.46	4.84

CURVE DATA									
CURVE	10	11	12	13	14	15	16	17	18
Δ	115°21'19"	64°27'05"	180°00'	2°10'35"	113°42'51"	66°59'19"	1°28'26"	130°33'28"	113°07'33"
$\Delta/2$	57°40'40"	32°13'32"	90°00'	1°5'18"	56°51'25"	33°29'39"	0°44'13"	65°16'44"	56°33'46"
R	4.00	4.00	6.00	4000.00	4.00	4.00	5700.00	1.00	3.00
T	6.32	2.52	∞	75.98	6.13	2.65	73.32	2.17	4.54
C	6.76	4.27	12.00	151.94	6.70	4.41	146.62	1.82	5.01
L	8.05	4.50	18.85	151.95	7.94	4.68	146.62	2.28	5.92

CURVE DATA									
CURVE	19	20	21	EP-3	EP-4	24	25	26	27
Δ	131°58'54"	15°39'55"	61°23'26"	12°04'10"	12°05'15"	137°24'02"	67°26'52"	155°09'06"	4°28'01"
$\Delta/2$	65°59'27"	7°49'57"	30°41'43"	6°02'05"	6°02'38"	68°42'01"	33°43'26"	77°34'33"	2°14'00"
R	2.00	87.85	150.00	1910.00	1890.00	2.00	3.00	2.00	216.00
T	4.49	12.08	89.05	201.92	200.11	5.13	2.00	9.08	8.42
C	3.65	23.94	153.14	401.60	397.99	3.73	3.33	3.91	76.84
L	4.61	24.02	160.72	402.35	398.73	4.80	3.53	5.42	16.84

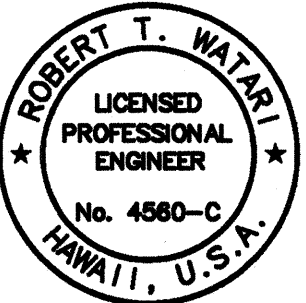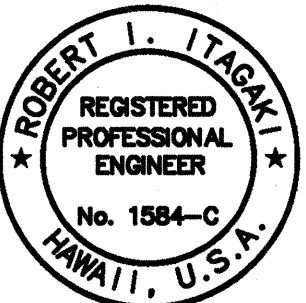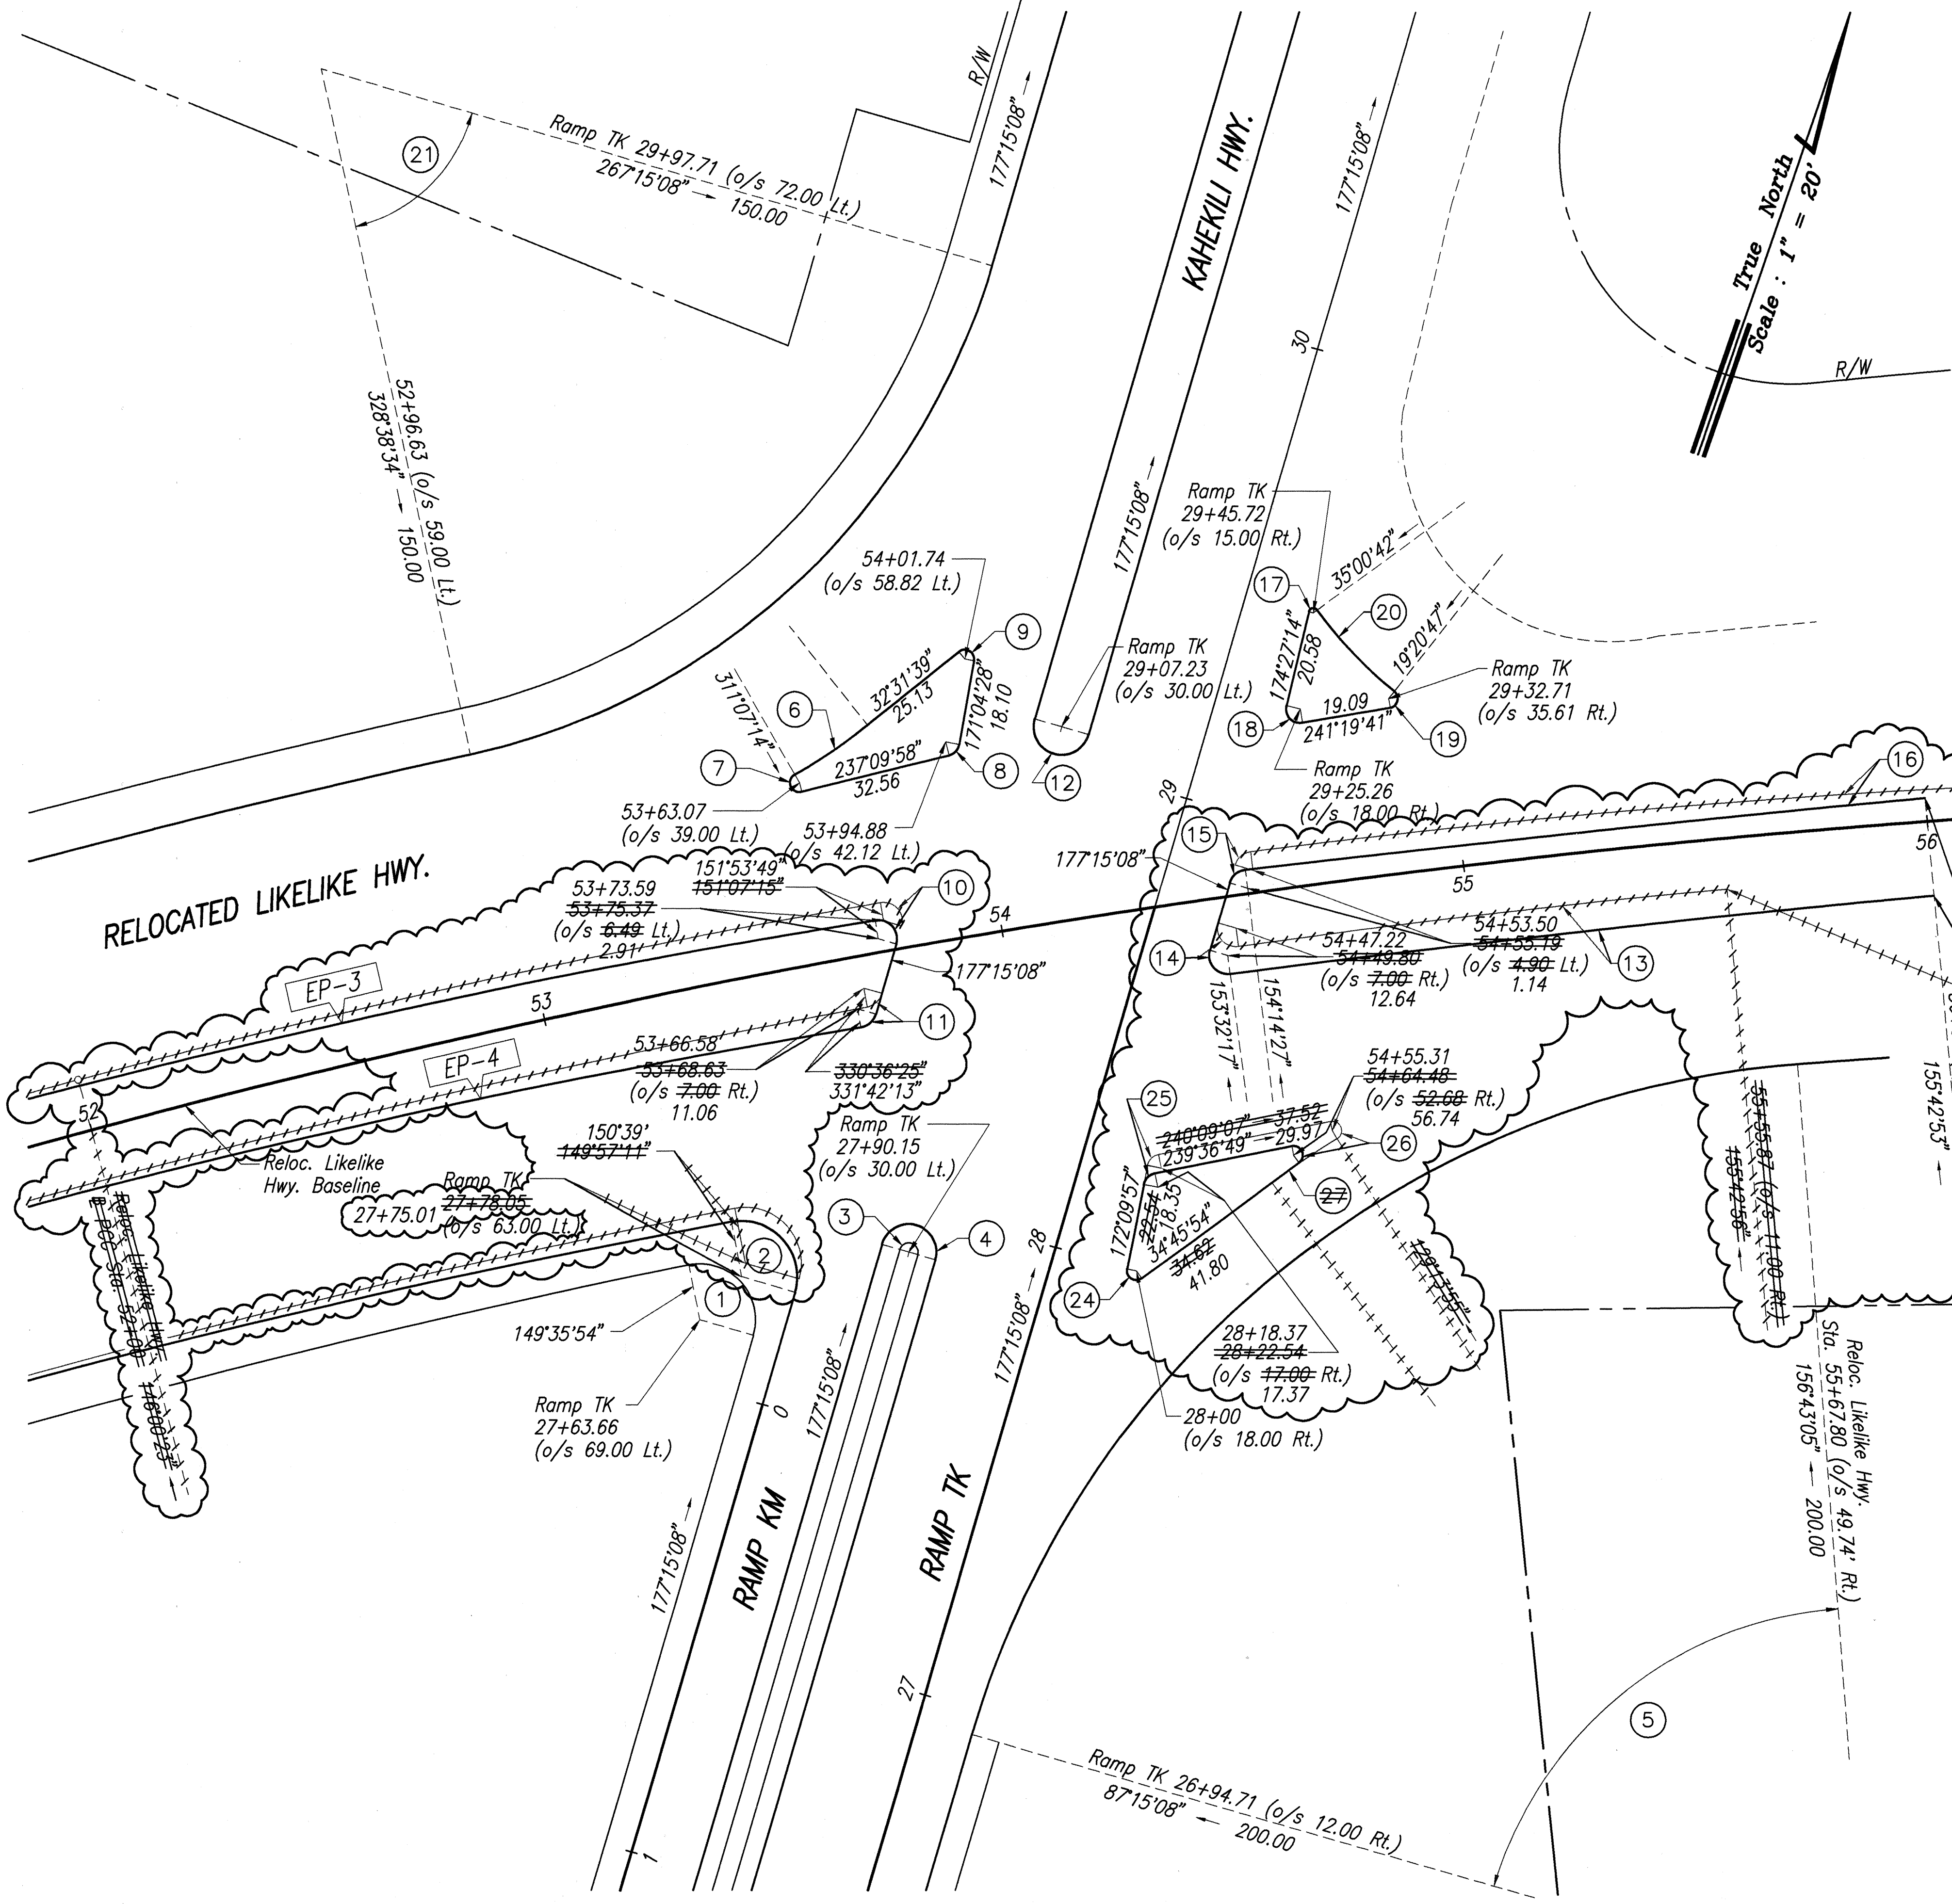

THIS WORK WAS PREPARED BY ME OR UNDER MY SUPERVISION.
Robert T. Watari
4-12-95

4/12/95	Revised Median, Island & associated Curve Data #2,10,11,13,14,15,16,25,26 & EP-3. Added Curve EP-4. Deleted Curve # 27.
12/20/93	Revised Right of Way & Shoulder at the North West Corner of Likelike/Kahekili. Deleted Curve Data #22 & #23.
2/17/93	Revised Edge Pav't Radius and Added Channelizing Island at Ramp TK/Reloc. Likelike Intersection. Revised Curve Data #5 and added #24 thru #27.
1/27/92	Revised curve data. Added Right of Way.
DATE	REVISION

STATE OF HAWAII
DEPARTMENT OF TRANSPORTATION
HIGHWAYS DIVISION

INTERSECTION GEOMETRIC LAYOUT
RELOCATED LIKELIKE HIGHWAY

INTERSTATE ROUTE H-3
F.A.I. PROJ. NO. I-H3-1(72)

SCALE: 1" = 20' DATE: DEC. 1991

SHEET No. OF SHEETS

C.O. ADD. 30

ORIGINAL PLAN	DATE
DRAWN BY	
DESIGNED BY	
NOTED BY	
QUANTITIES BY	
No.	


85-456 FILL-INTENDING D.H.-3 Plan Plot-1-20 04/12/95 By

FED. ROAD DIST. NO.	STATE	PROJ. NO.	FISCAL YEAR	SHEET NO.	TOTAL SHEETS
HAWAII	HAW.	I-H3-1(72)	1991	C.O. ADD 31	521

COORDINATE DATA		
DESCRIPTION	NORTHING	EASTING
PC Sta. 8+44.85	85,508.73	563,763.82
PI	85,833.74	563,821.82
PT Sta. 14+61.82	85,995.71	564,109.50
Center of Curve	85,385.75	564,452.93

True North
Scale : 1" = 40'

Castle Hills Subdivision

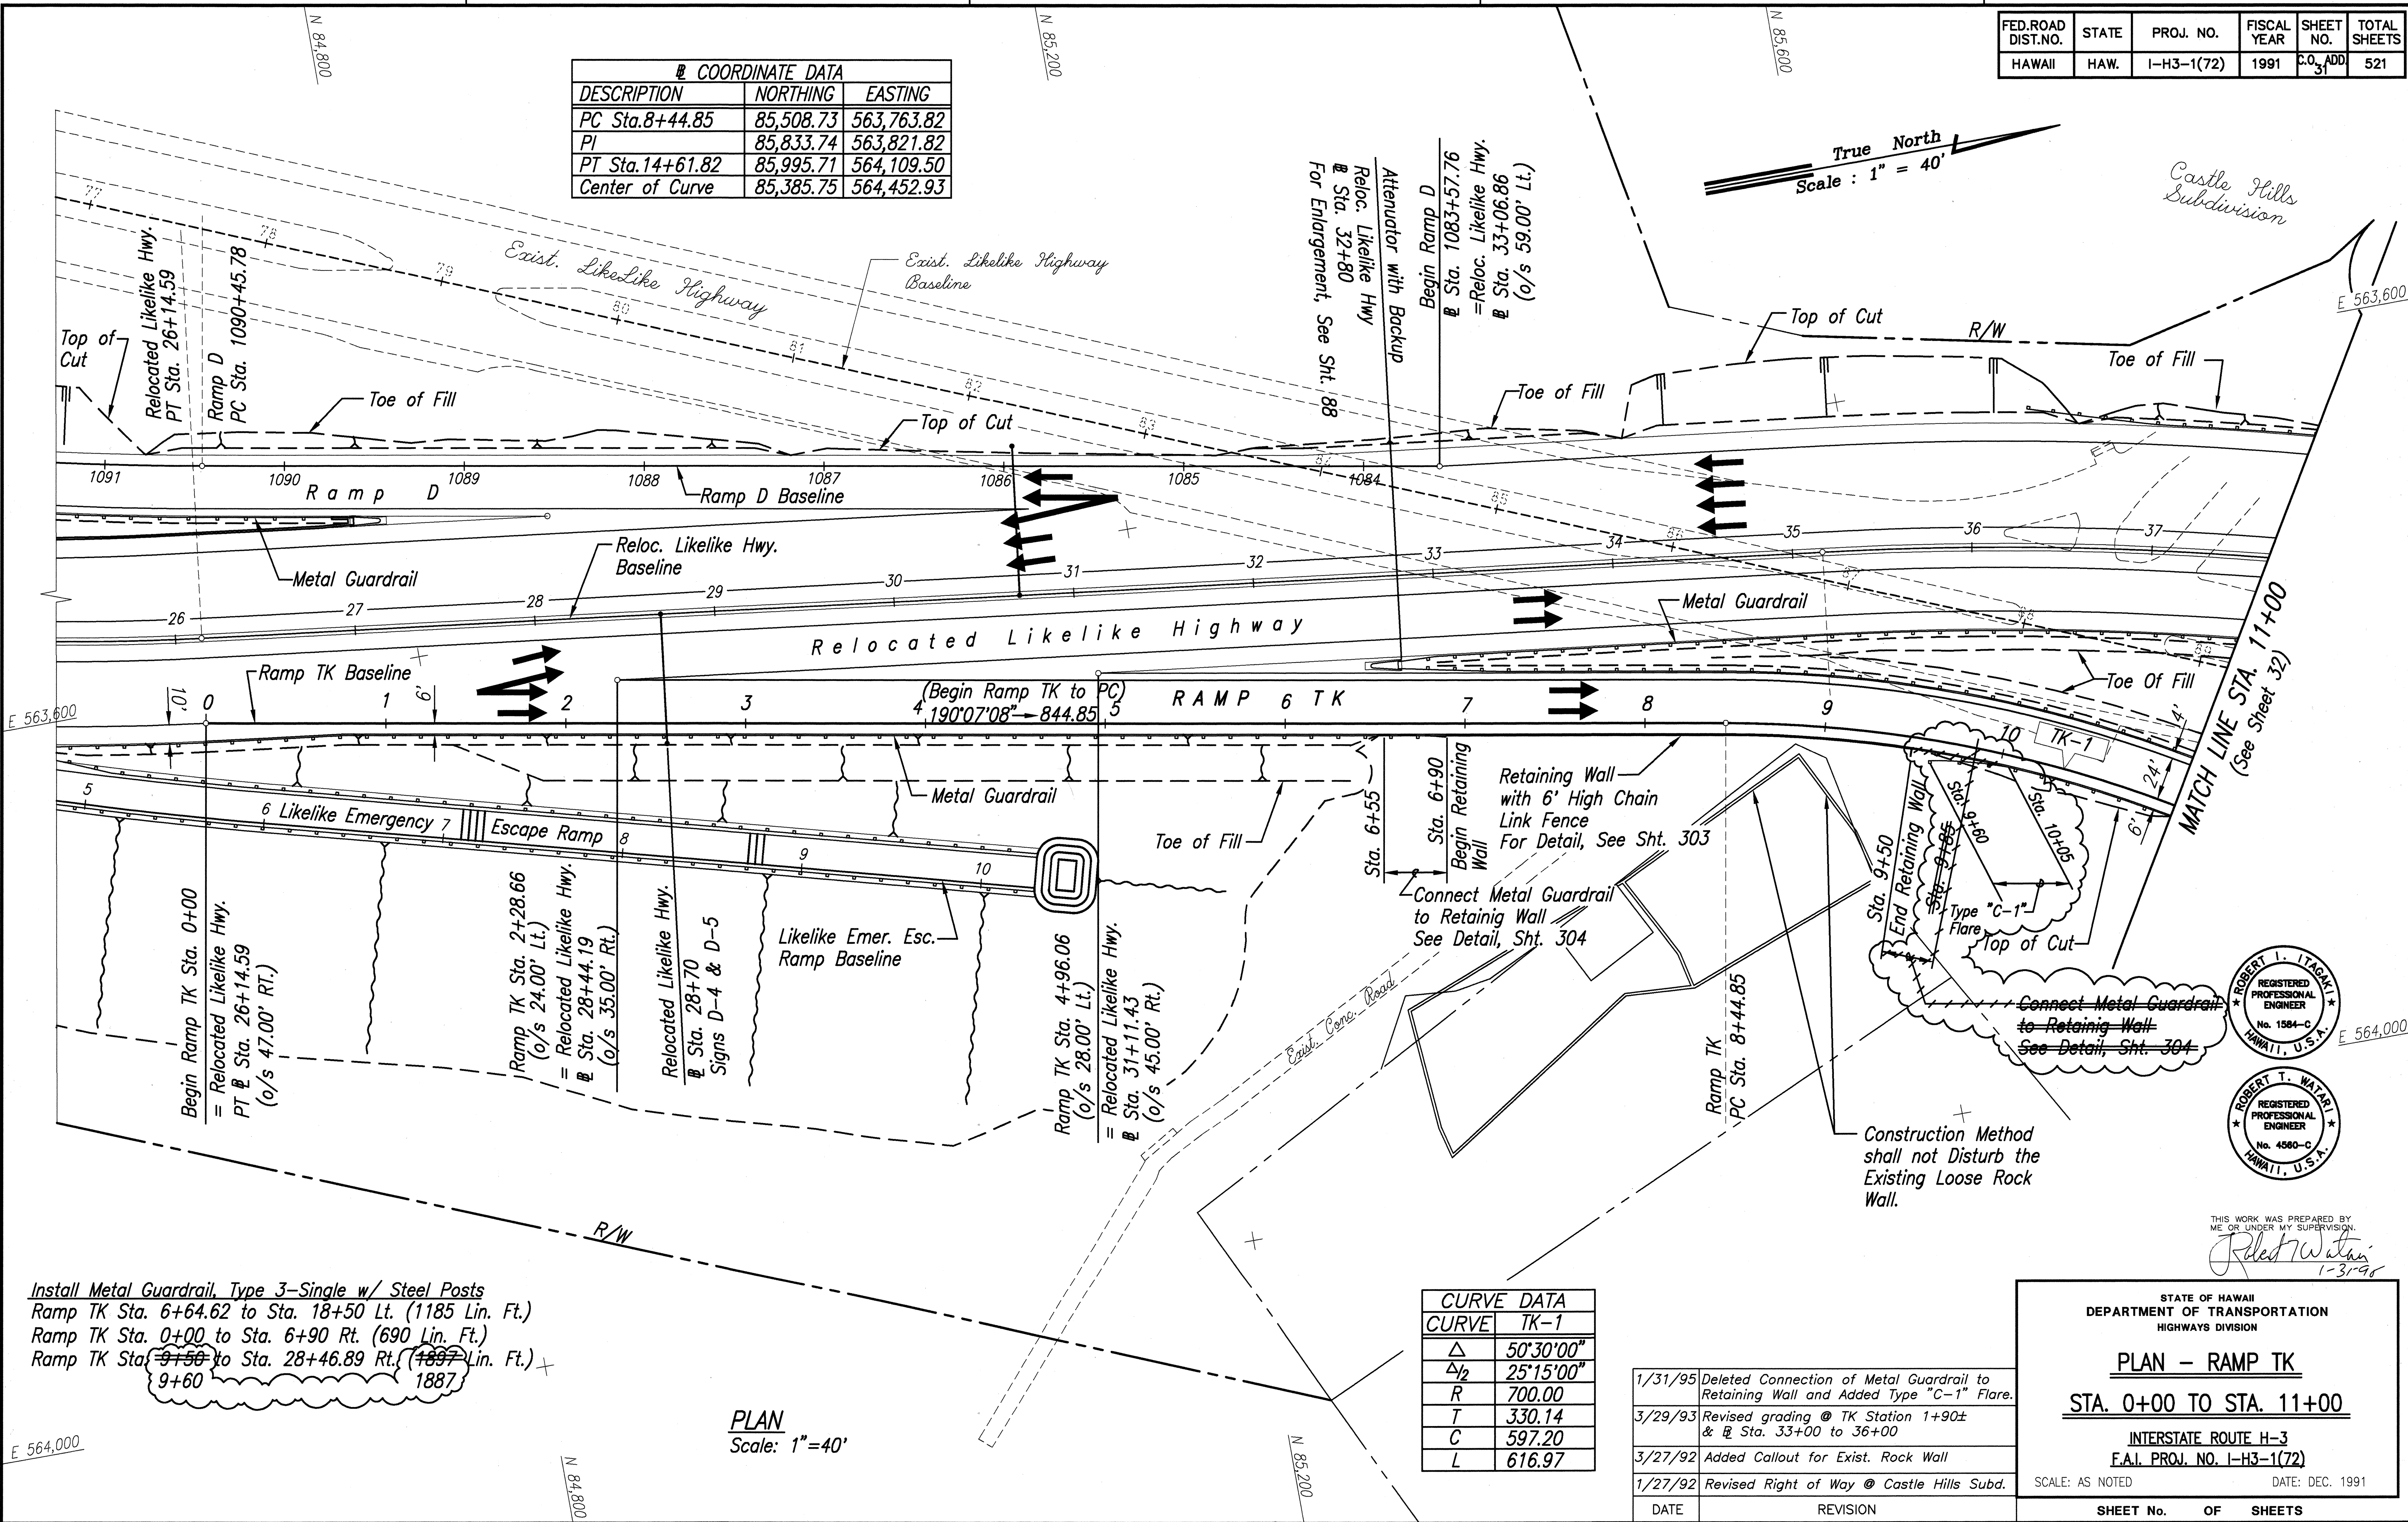

Install Metal Guardrail, Type 3-Single w/ Steel Posts
Ramp TK Sta. 6+64.62 to Sta. 18+50 Lt. (1185 Lin. Ft.)
Ramp TK Sta. 0+00 to Sta. 6+90 Rt. (690 Lin. Ft.)
Ramp TK Sta. 9+56 to Sta. 28+46.89 Rt. (1890 Lin. Ft.)

PLAN
Scale: 1"=40'

CURVE DATA	
CURVE	TK-1
Δ	50°30'00"
Δ ₂	25°15'00"
R	700.00
T	330.14
C	597.20
L	616.97

DATE	REVISION
1/31/95	Deleted Connection of Metal Guardrail to Retaining Wall and Added Type "C-1" Flare.
3/29/93	Revised grading @ TK Station 1+90± & Sta. 33+00 to 36+00
3/27/92	Added Callout for Exist. Rock Wall
1/27/92	Revised Right of Way @ Castle Hills Subd.

STATE OF HAWAII
DEPARTMENT OF TRANSPORTATION
HIGHWAYS DIVISION

PLAN - RAMP TK
STA. 0+00 TO STA. 11+00
INTERSTATE ROUTE H-3
F.A.I. PROJ. NO. I-H3-1(72)

SCALE: AS NOTED
DATE: DEC. 1991

SHEET No. 31 OF 31 SHEETS

DATE	_____
DESIGNED BY	_____
CHECKED BY	_____
NO.	_____

83-46.2 FTR-LINE DWS Map Top Pict=40 Date: 12/95 By


ROBERT L. ITAKI
REGISTERED PROFESSIONAL ENGINEER
No. 1584-C
HAWAII, U.S.A.

ROBERT T. WATANI
REGISTERED PROFESSIONAL ENGINEER
No. 4580-C
HAWAII, U.S.A.

THIS WORK WAS PREPARED BY ME OR UNDER MY SUPERVISION.
Robert T. Watani
1-31-96

C.O. ADD. 31

FED. ROAD DIST. NO.	STATE	PROJ. NO.	FISCAL YEAR	SHEET NO.	TOTAL SHEETS
HAWAII	HAW.	I-H3-1(72)	1991	C.O. ADD. 32	521

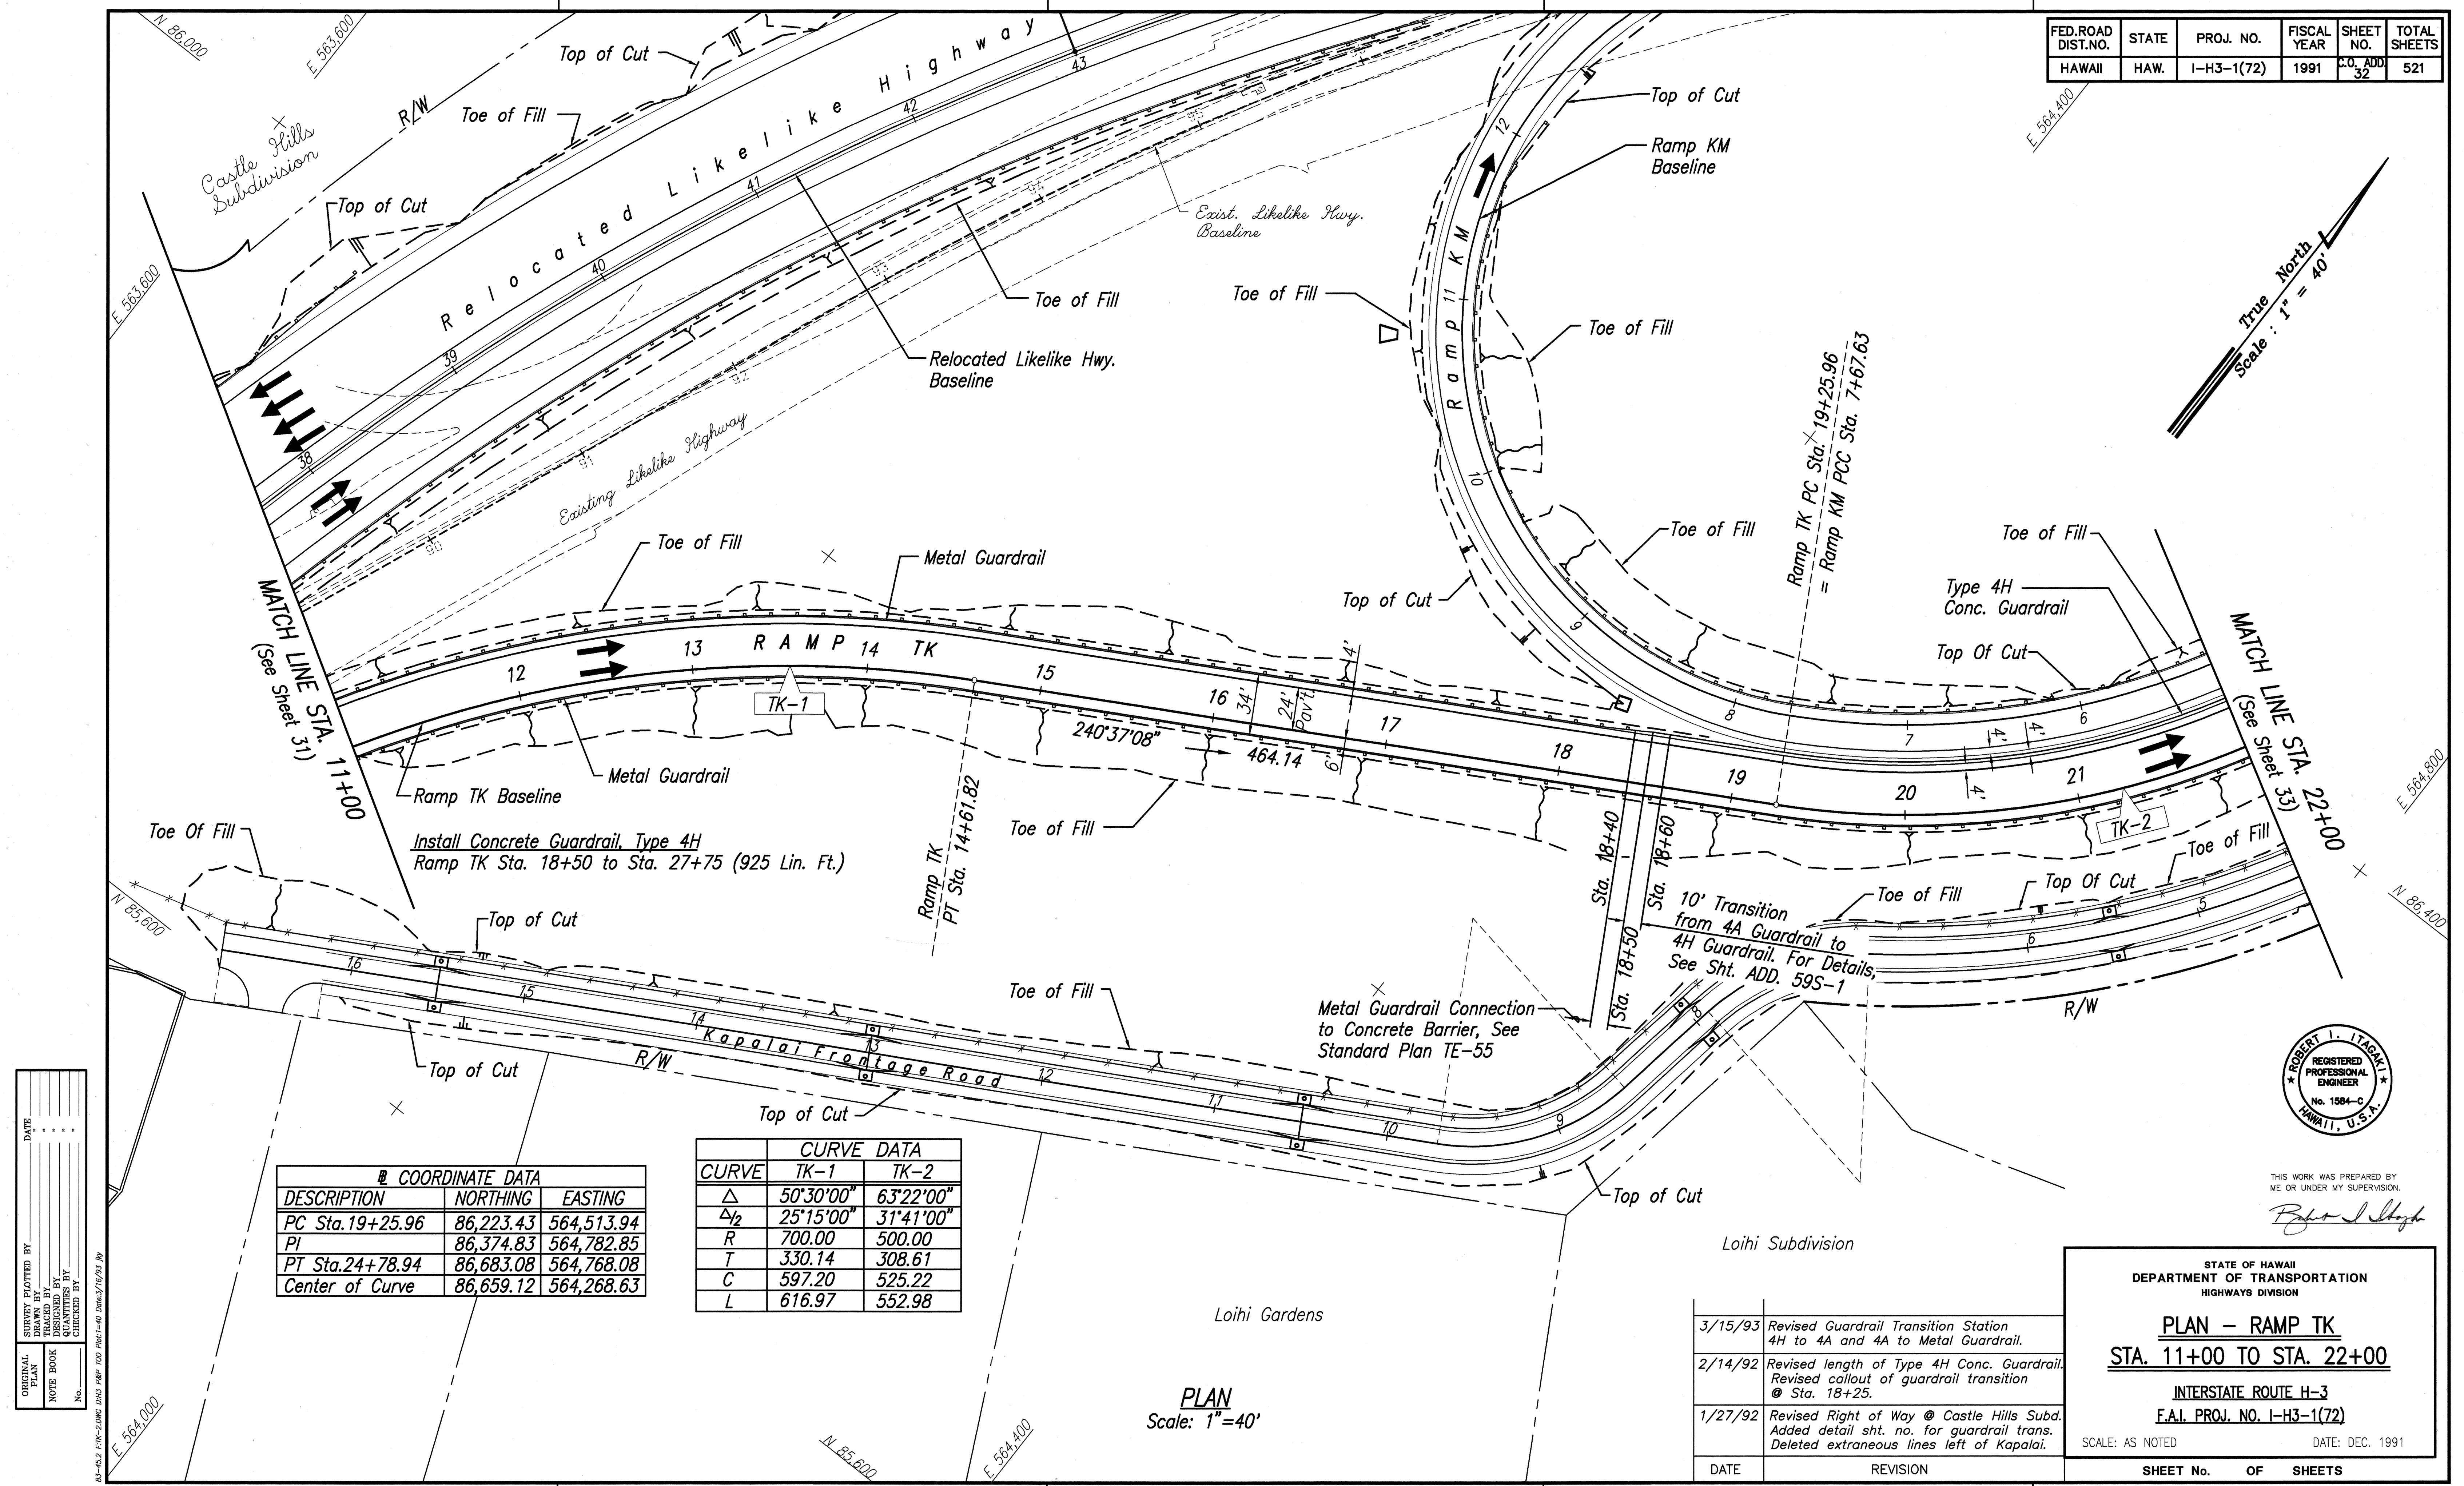

COORDINATE DATA		
DESCRIPTION	NORTHING	EASTING
PC Sta. 19+25.96	86,223.43	564,513.94
PI	86,374.83	564,782.85
PT Sta. 24+78.94	86,683.08	564,768.08
Center of Curve	86,659.12	564,268.63

CURVE DATA		
CURVE	TK-1	TK-2
Δ	50°30'00"	63°22'00"
$\Delta/2$	25°15'00"	31°41'00"
R	700.00	500.00
T	330.14	308.61
C	597.20	525.22
L	616.97	552.98

PLAN
Scale: 1"=40'

DATE	REVISION
3/15/93	Revised Guardrail Transition Station 4H to 4A and 4A to Metal Guardrail.
2/14/92	Revised length of Type 4H Conc. Guardrail. Revised callout of guardrail transition @ Sta. 18+25.
1/27/92	Revised Right of Way @ Castle Hills Subd. Added detail sht. no. for guardrail trans. Deleted extraneous lines left of Kapalai.


STATE OF HAWAII
DEPARTMENT OF TRANSPORTATION
HIGHWAYS DIVISION

PLAN - RAMP TK
STA. 11+00 TO STA. 22+00
INTERSTATE ROUTE H-3
F.A.I. PROJ. NO. I-H3-1(72)

SCALE: AS NOTED
DATE: DEC. 1991

SHEET No. OF SHEETS
C.O. ADD. 32


SURVEY PLANNED BY _____
 DATE _____
 ORIGINAL PLAN _____
 DRAWN BY _____
 NOTE BOOK _____
 DESIGNED BY _____
 CHECKED BY _____
 No. _____

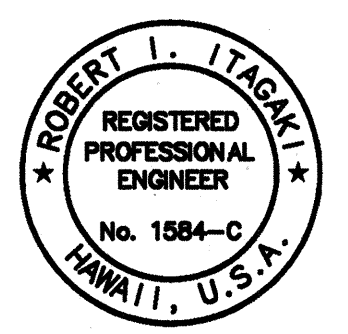

THIS WORK WAS PREPARED BY
 ME OR UNDER MY SUPERVISION.
Robert L. Itagaki


FED. ROAD DIST. NO.	STATE	PROJ. NO.	FISCAL YEAR	SHEET NO.	TOTAL SHEETS
HAWAII	HAW.	I-H3-1(72)	1991	C.O. ADD. 33	521

DATE	_____
SURVEY PLOTTED BY	_____
DRAWN BY	_____
DESIGNED BY	_____
CHECKED BY	_____
NO.	_____

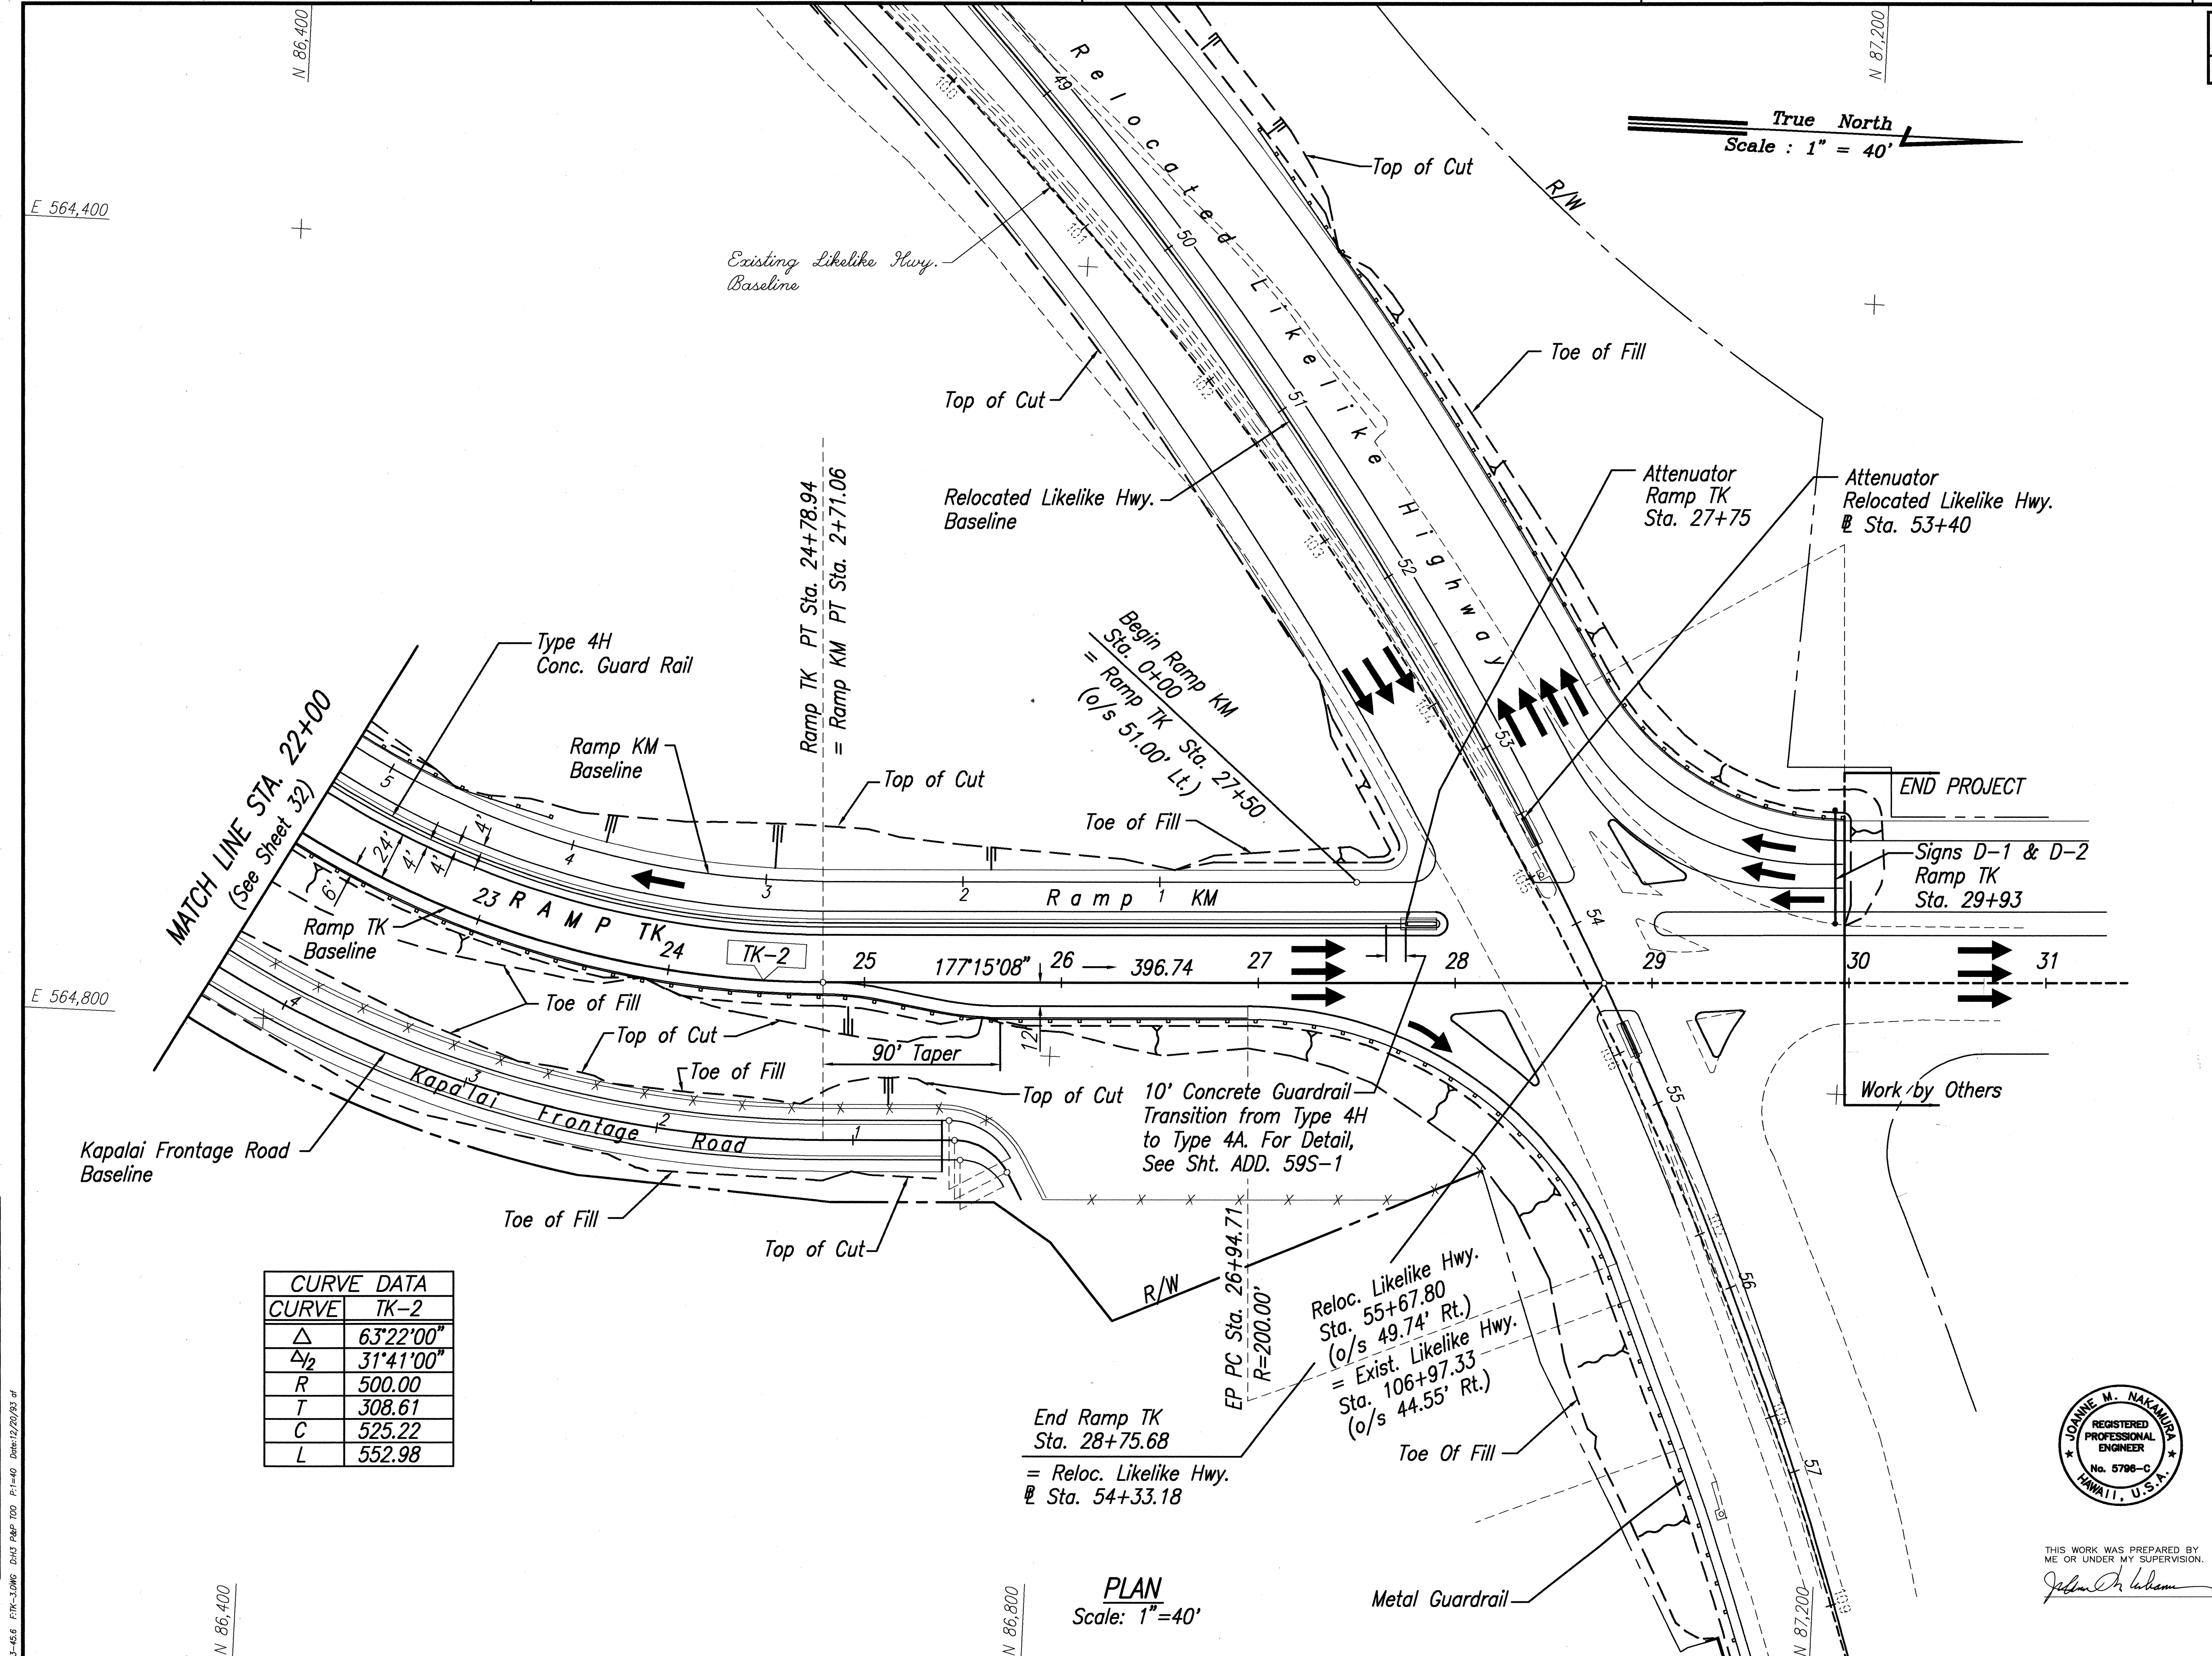

CURVE DATA	
CURVE	TK-2
Δ	63°22'00"
$\Delta/2$	31°41'00"
R	500.00
T	308.61
C	525.22
L	552.98

PLAN
Scale: 1"=40'

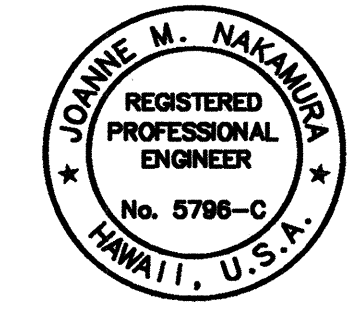

THIS WORK WAS PREPARED BY
ME OR UNDER MY SUPERVISION.
Joanne M. Nakamura

12/15/93	Revised Sign D-1 & D-2 and Right-of-Way & Shoulder at the corner of Kahekili/Likelike. Deleted Attenuator and Temp Geotextile Wall.
2/17/93	Revised Edge Pav't Radius and Added Channelizing Island at Ramp TK/Reloc. Likelike Intersection.
3/27/92	Deleted Quantity callout
2/21/92	Revised retaining wall callout to Temporary Geotextile Wall. Revised Notes.
1/27/92	Revised retaining wall callout and added corresponding note. Deleted attenuator outside of project. Added callout for guardrail transition.
DATE	REVISION

STATE OF HAWAII
DEPARTMENT OF TRANSPORTATION
HIGHWAYS DIVISION

PLAN - RAMP TK
STA. 22+00 TO STA. 28+75.68

INTERSTATE ROUTE H-3
F.A.I. PROJ. NO. I-H3-1(72)


SCALE: AS NOTED DATE: DEC. 1991

SHEET No. OF SHEETS


C.O. ADD. 33

FED. ROAD DIST. NO.	STATE	PROJ. NO.	FISCAL YEAR	SHEET NO.	TOTAL SHEETS
HAWAII	HAW.	I-H3-1(72)	1991	34	521

15 16

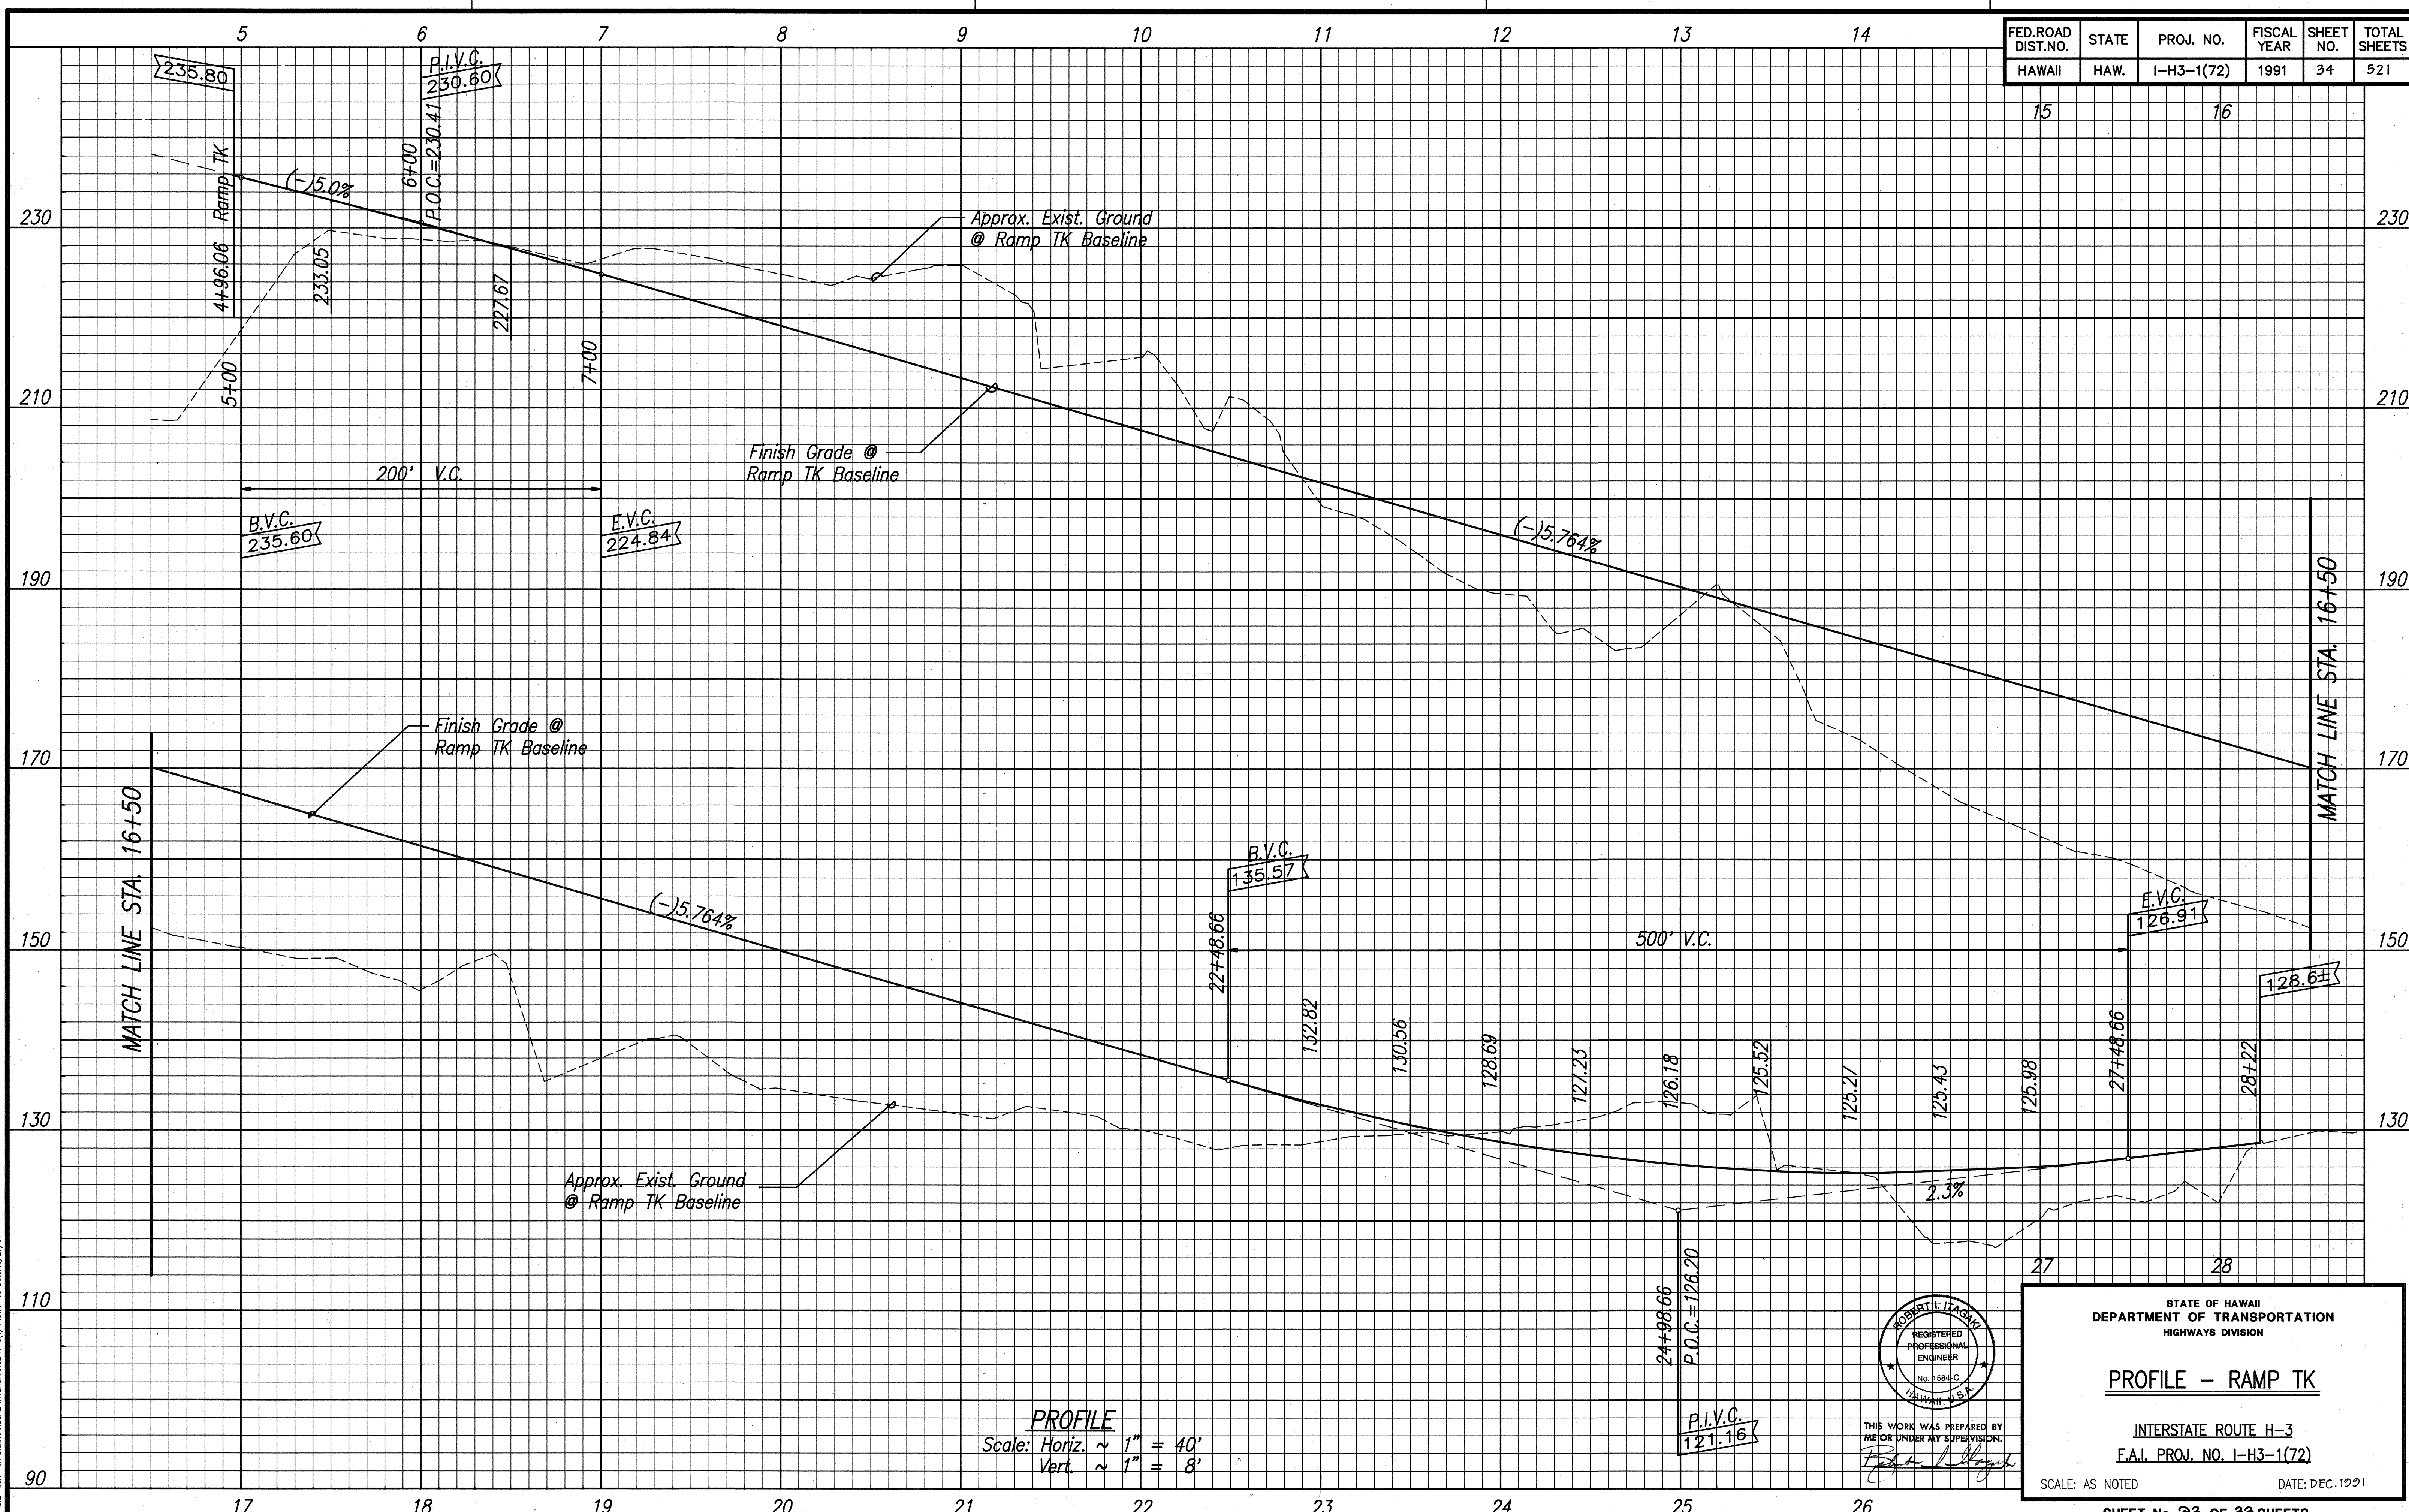

PROFILE
 Scale: Horiz. ~ 1" = 40'
 Vert. ~ 1" = 8'

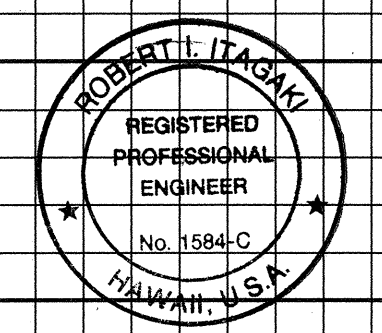

THIS WORK WAS PREPARED BY
 ME OR UNDER MY SUPERVISION.
 [Signature]

STATE OF HAWAII
 DEPARTMENT OF TRANSPORTATION
 HIGHWAYS DIVISION

PROFILE - RAMP TK

INTERSTATE ROUTE H-3
 F.A.I. PROJ. NO. I-H3-1(72)

SCALE: AS NOTED DATE: DEC. 1991

SHEET No. 34 OF 39 SHEETS

ORIGINAL PLAN
 SURVEY PLOTTED BY
 DRAWN BY
 DESIGNED BY
 CHECKED BY
 No.

63-482 The P-TK (aka) KANEHE INTERCHANGE I-301 Plot 1-40 Date 11/27/91



FED.ROAD DIST.NO.	STATE	PROJ. NO.	FISCAL YEAR	SHEET NO.	TOTAL SHEETS
HAWAII	HAW.	I-H3-1(72)	1991	C.O. 35	521

Install Metal Guard Rail, Type 3-Single w/ Steel Posts
Ramp KM @ Sta. 4+15 to @ Sta. 12+15 Rt. (800 Lin. Ft.)

COORDINATE DATA		
DESCRIPTION	NORTHING	EASTING
PC Sta.2+71.06	86,680.64	564,717.12
PI	86,403.83	564,730.40
PCC Sta.7+67.63	86,267.87	564,488.92
Center of Curve	86,659.12	564,268.63
PI	85,576.94	563,261.78
PT Sta.13+93.64	86,610.82	564,218.00
Center of Curve	86,460.62	564,380.39

CURVE DATA		
CURVE	KM-1	KM-2
Δ	63°22'00"	162°08'47"
Δ ₂	31°41'00"	81°04'24"
R	449.00	221.21
T	277.13	1408.28
C	471.65	437.05
L	496.57	626.01

DATE	
SURVEYED BY	
ORIGINAL PLAN	
DESIGNED BY	
NOTED BY	
QUANTITIES BY	
NO.	

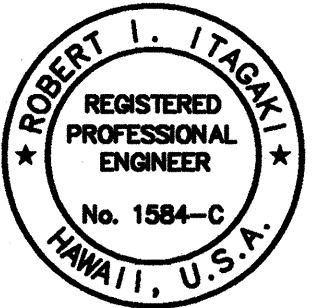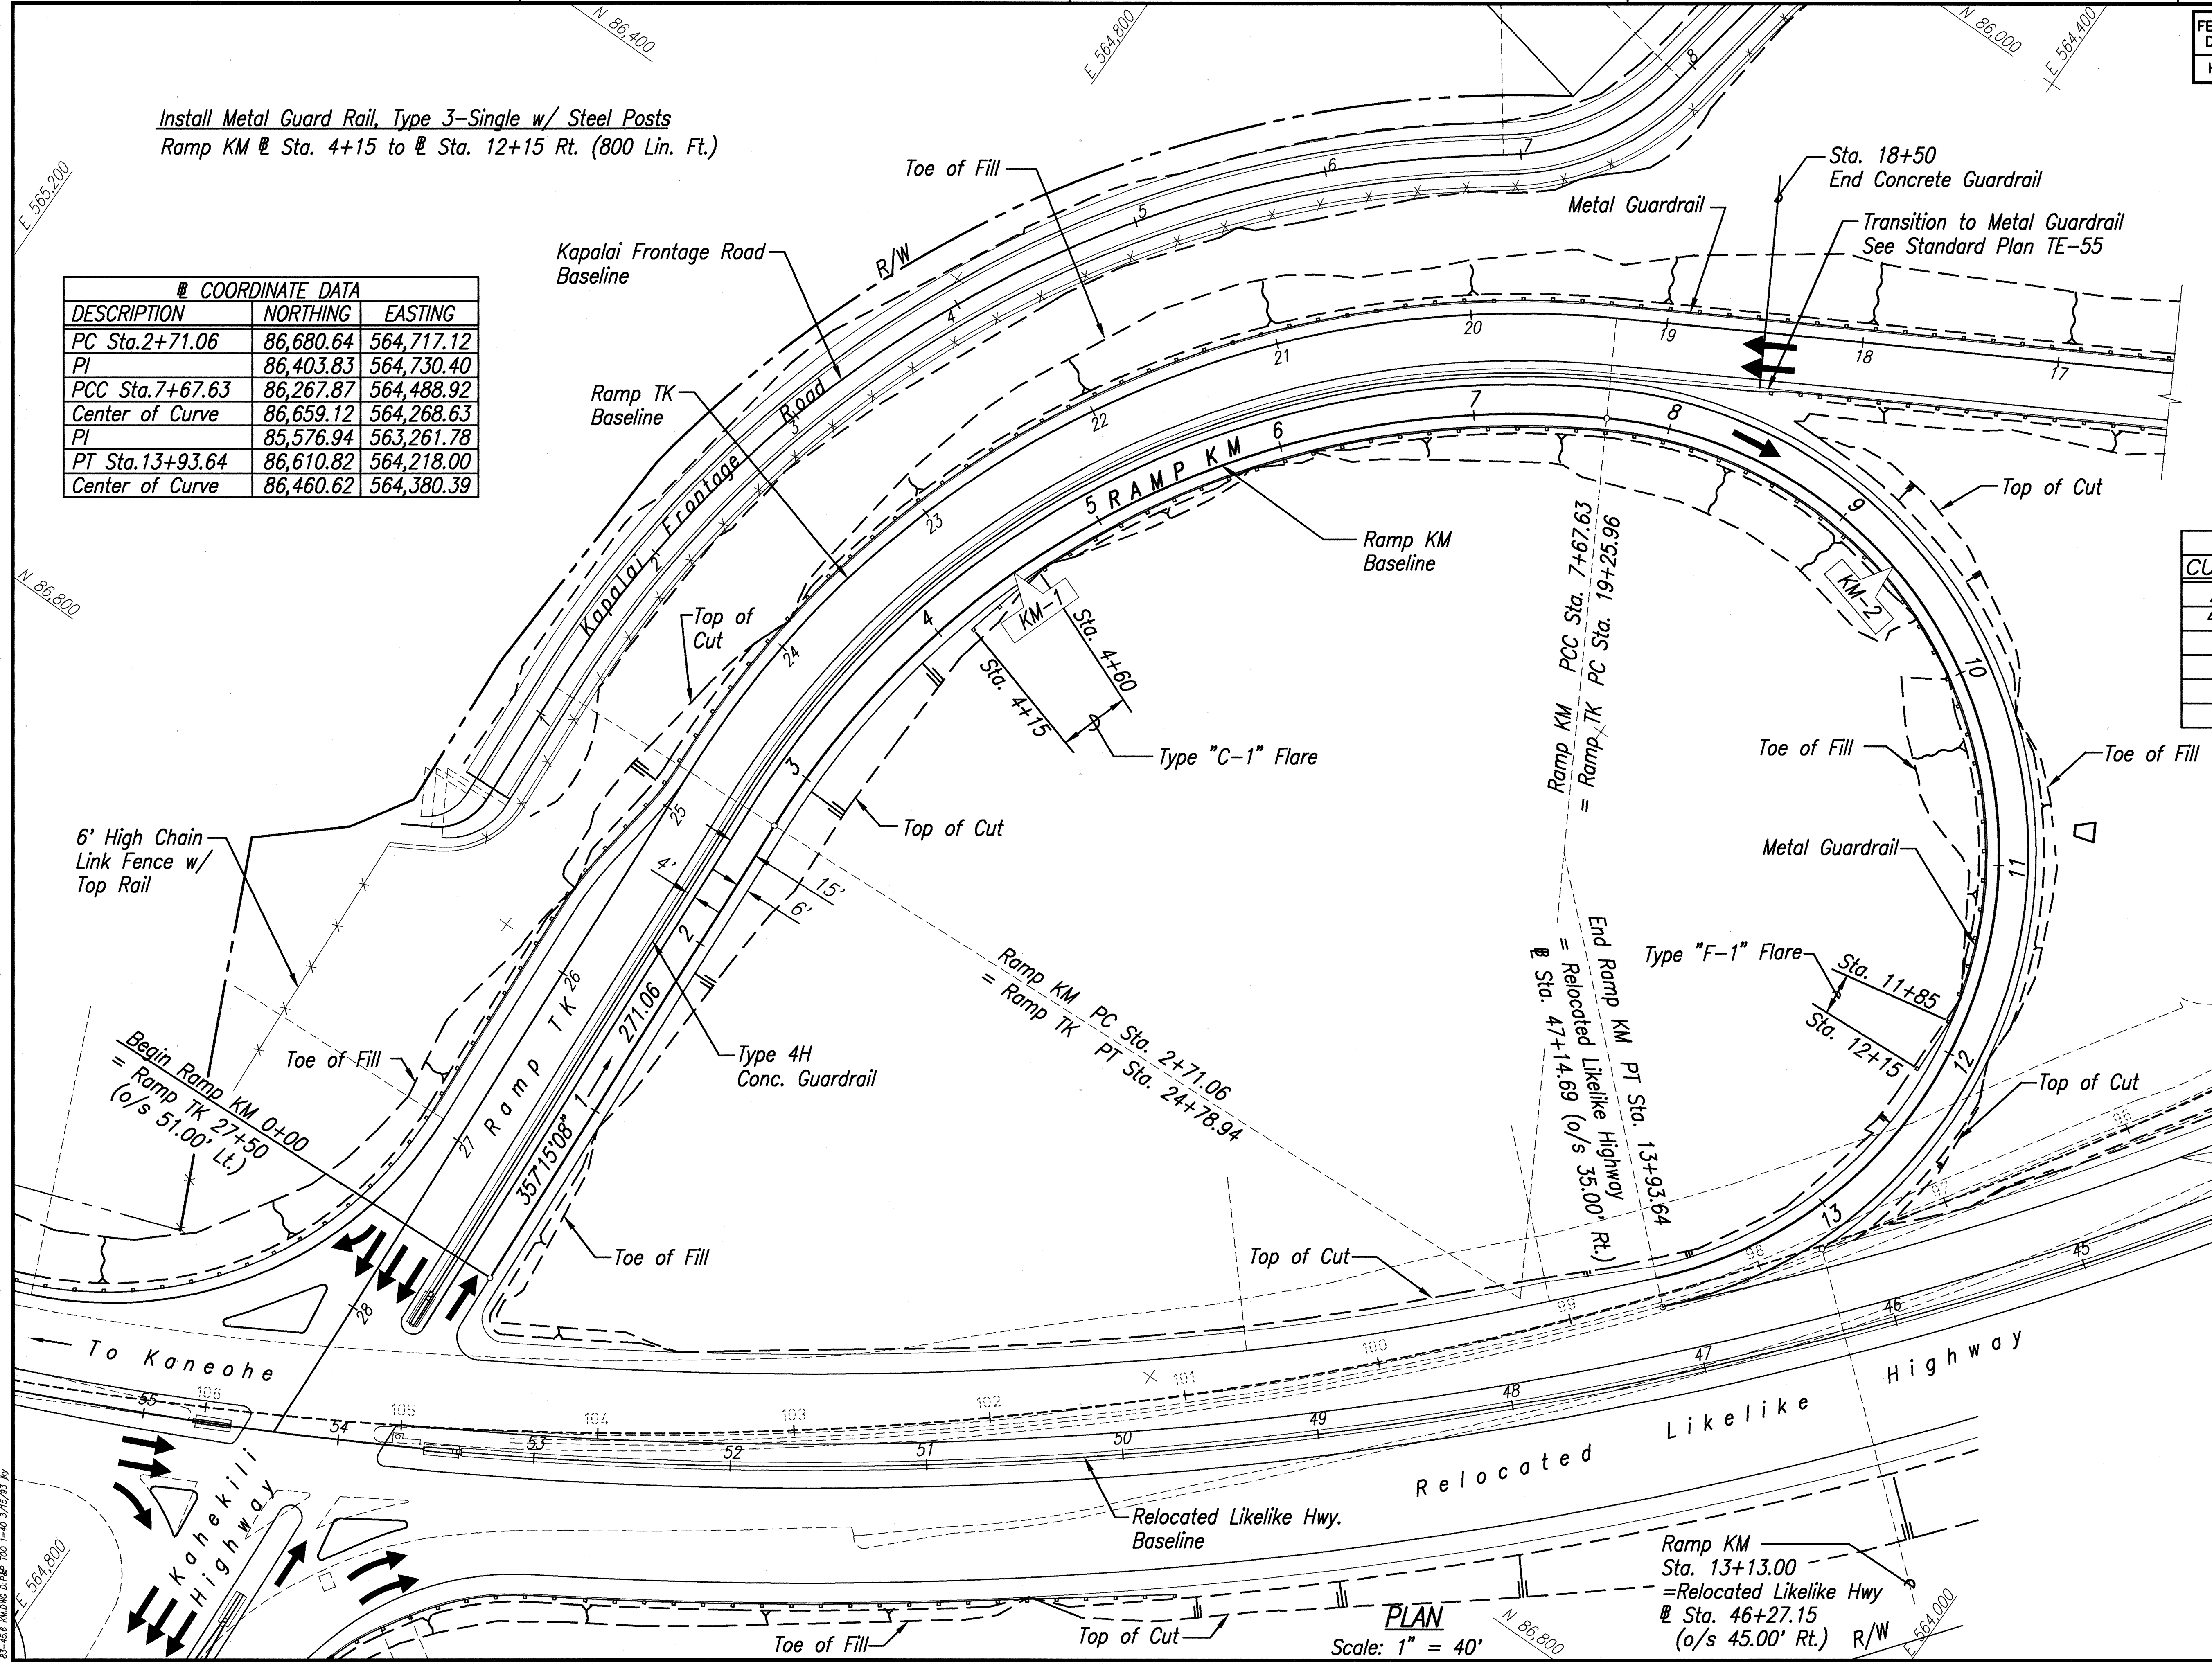

THIS WORK WAS PREPARED BY
ME OR UNDER MY SUPERVISION.


Robert L. Itagaki

3/15/93	Revised T.K. End Conc. Guardrail Location.
2/17/93	Revised Edge Pav't Radius and Added Channelizing Island at Ramp TK/Reloc. Likeline Intersection.

DATE	REVISION
------	----------


STATE OF HAWAII DEPARTMENT OF TRANSPORTATION HIGHWAYS DIVISION	
PLAN - RAMP KM	
STA. 0+00 TO STA. 13+93.42	
INTERSTATE ROUTE H-3 F.A.I. PROJ. NO. I-H3-1(72)	
SCALE: AS NOTED	DATE:
SHEET No. 24 OF 33 SHEETS	

FED. ROAD DIST. NO.	STATE	PROJ. NO.	FISCAL YEAR	SHEET NO.	TOTAL SHEETS
HAWAII	HAW.	I-H3-1(72)	1991	36	521

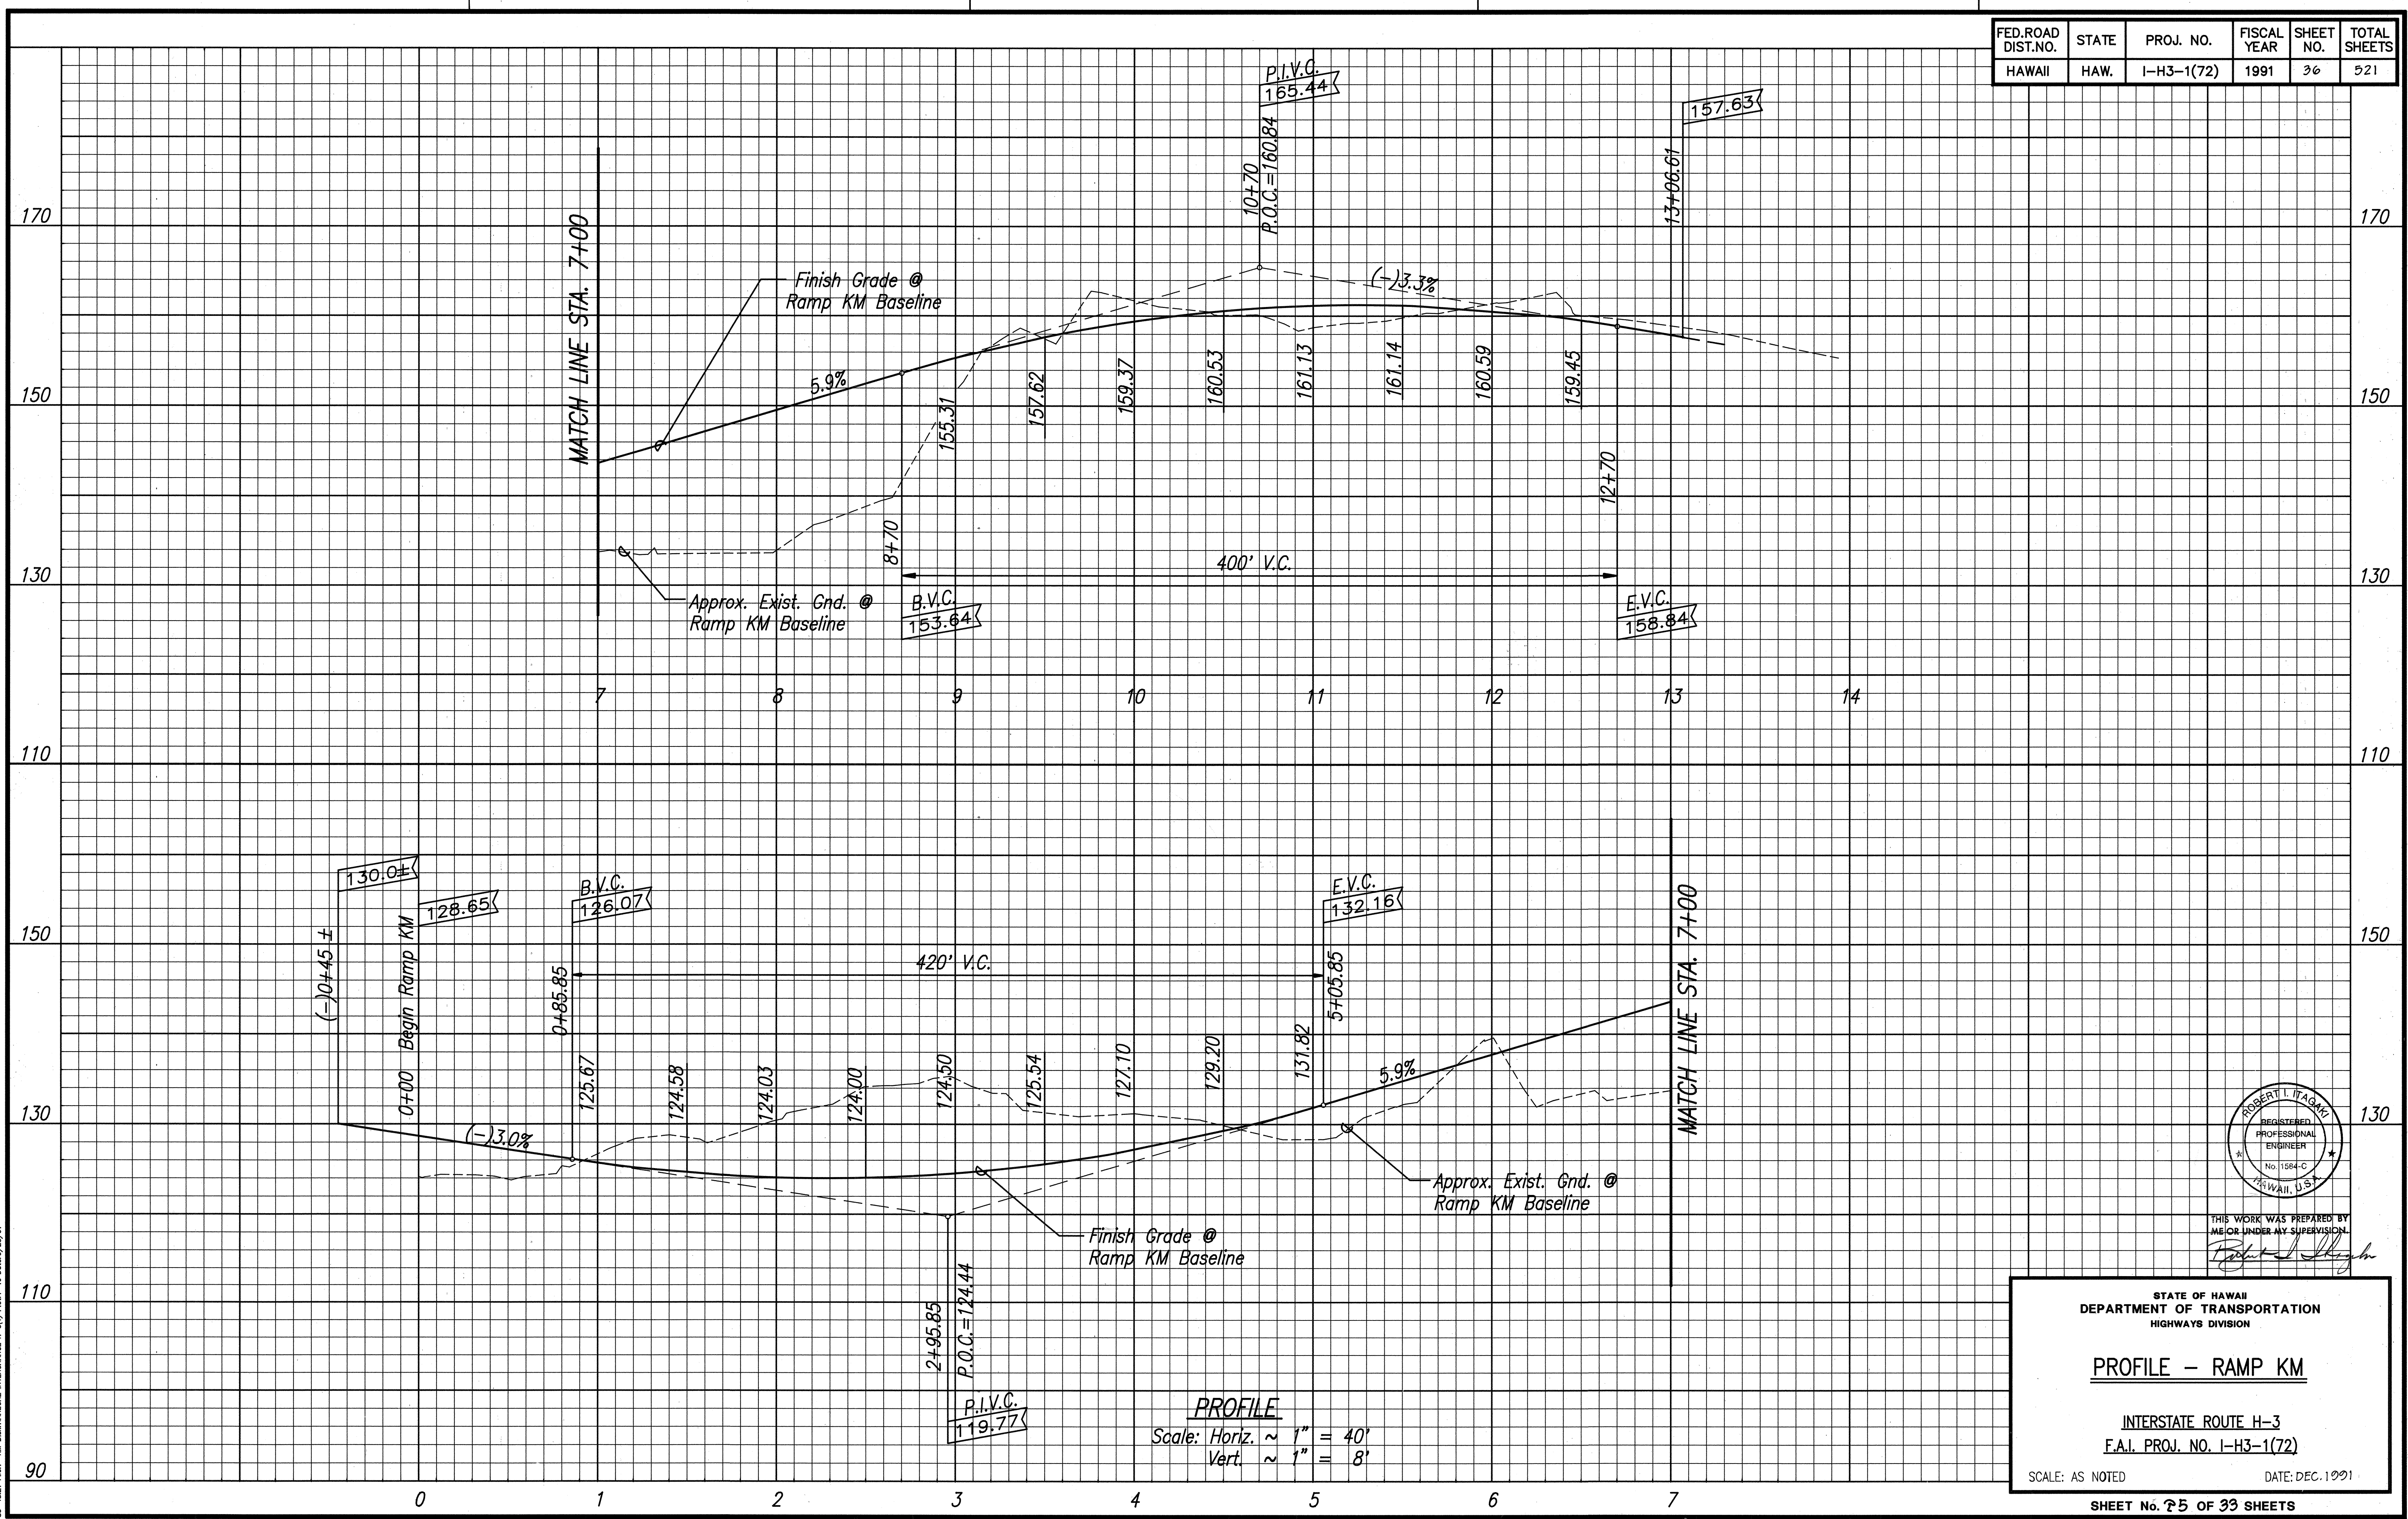

SURVEY PLOTTED BY _____ DATE _____
 DRAWN BY _____
 DESIGNED BY _____
 CHECKED BY _____
 No. _____

83-43.21 File-P-KM DASH-KANEHE INTERCHANGE (H-3) Proj. 1-40 Date: 9/23/91

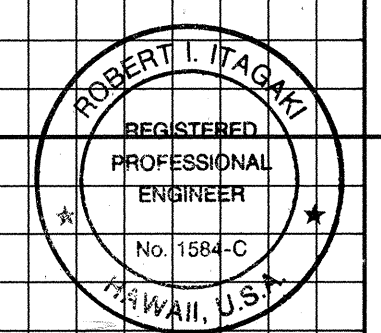

THIS WORK WAS PREPARED BY ME OR UNDER MY SUPERVISION.
Robert L. Itasca

STATE OF HAWAII
 DEPARTMENT OF TRANSPORTATION
 HIGHWAYS DIVISION


PROFILE - RAMP KM

INTERSTATE ROUTE H-3
 F.A.I. PROJ. NO. I-H3-1(72)

SCALE: AS NOTED DATE: DEC. 1991

FED. ROAD DIST. NO.	STATE	PROJ. NO.	FISCAL YEAR	SHEET NO.	TOTAL SHEETS
HAWAII	HAW.	I-H3-1(72)	1991	C.O. ADD. 37	521


EXIST. LIKELIKE HWY.
Δ = 80° 54' 00"
R = 1200.00
T = 1612.89
C = 2465.38
L = 2682.75

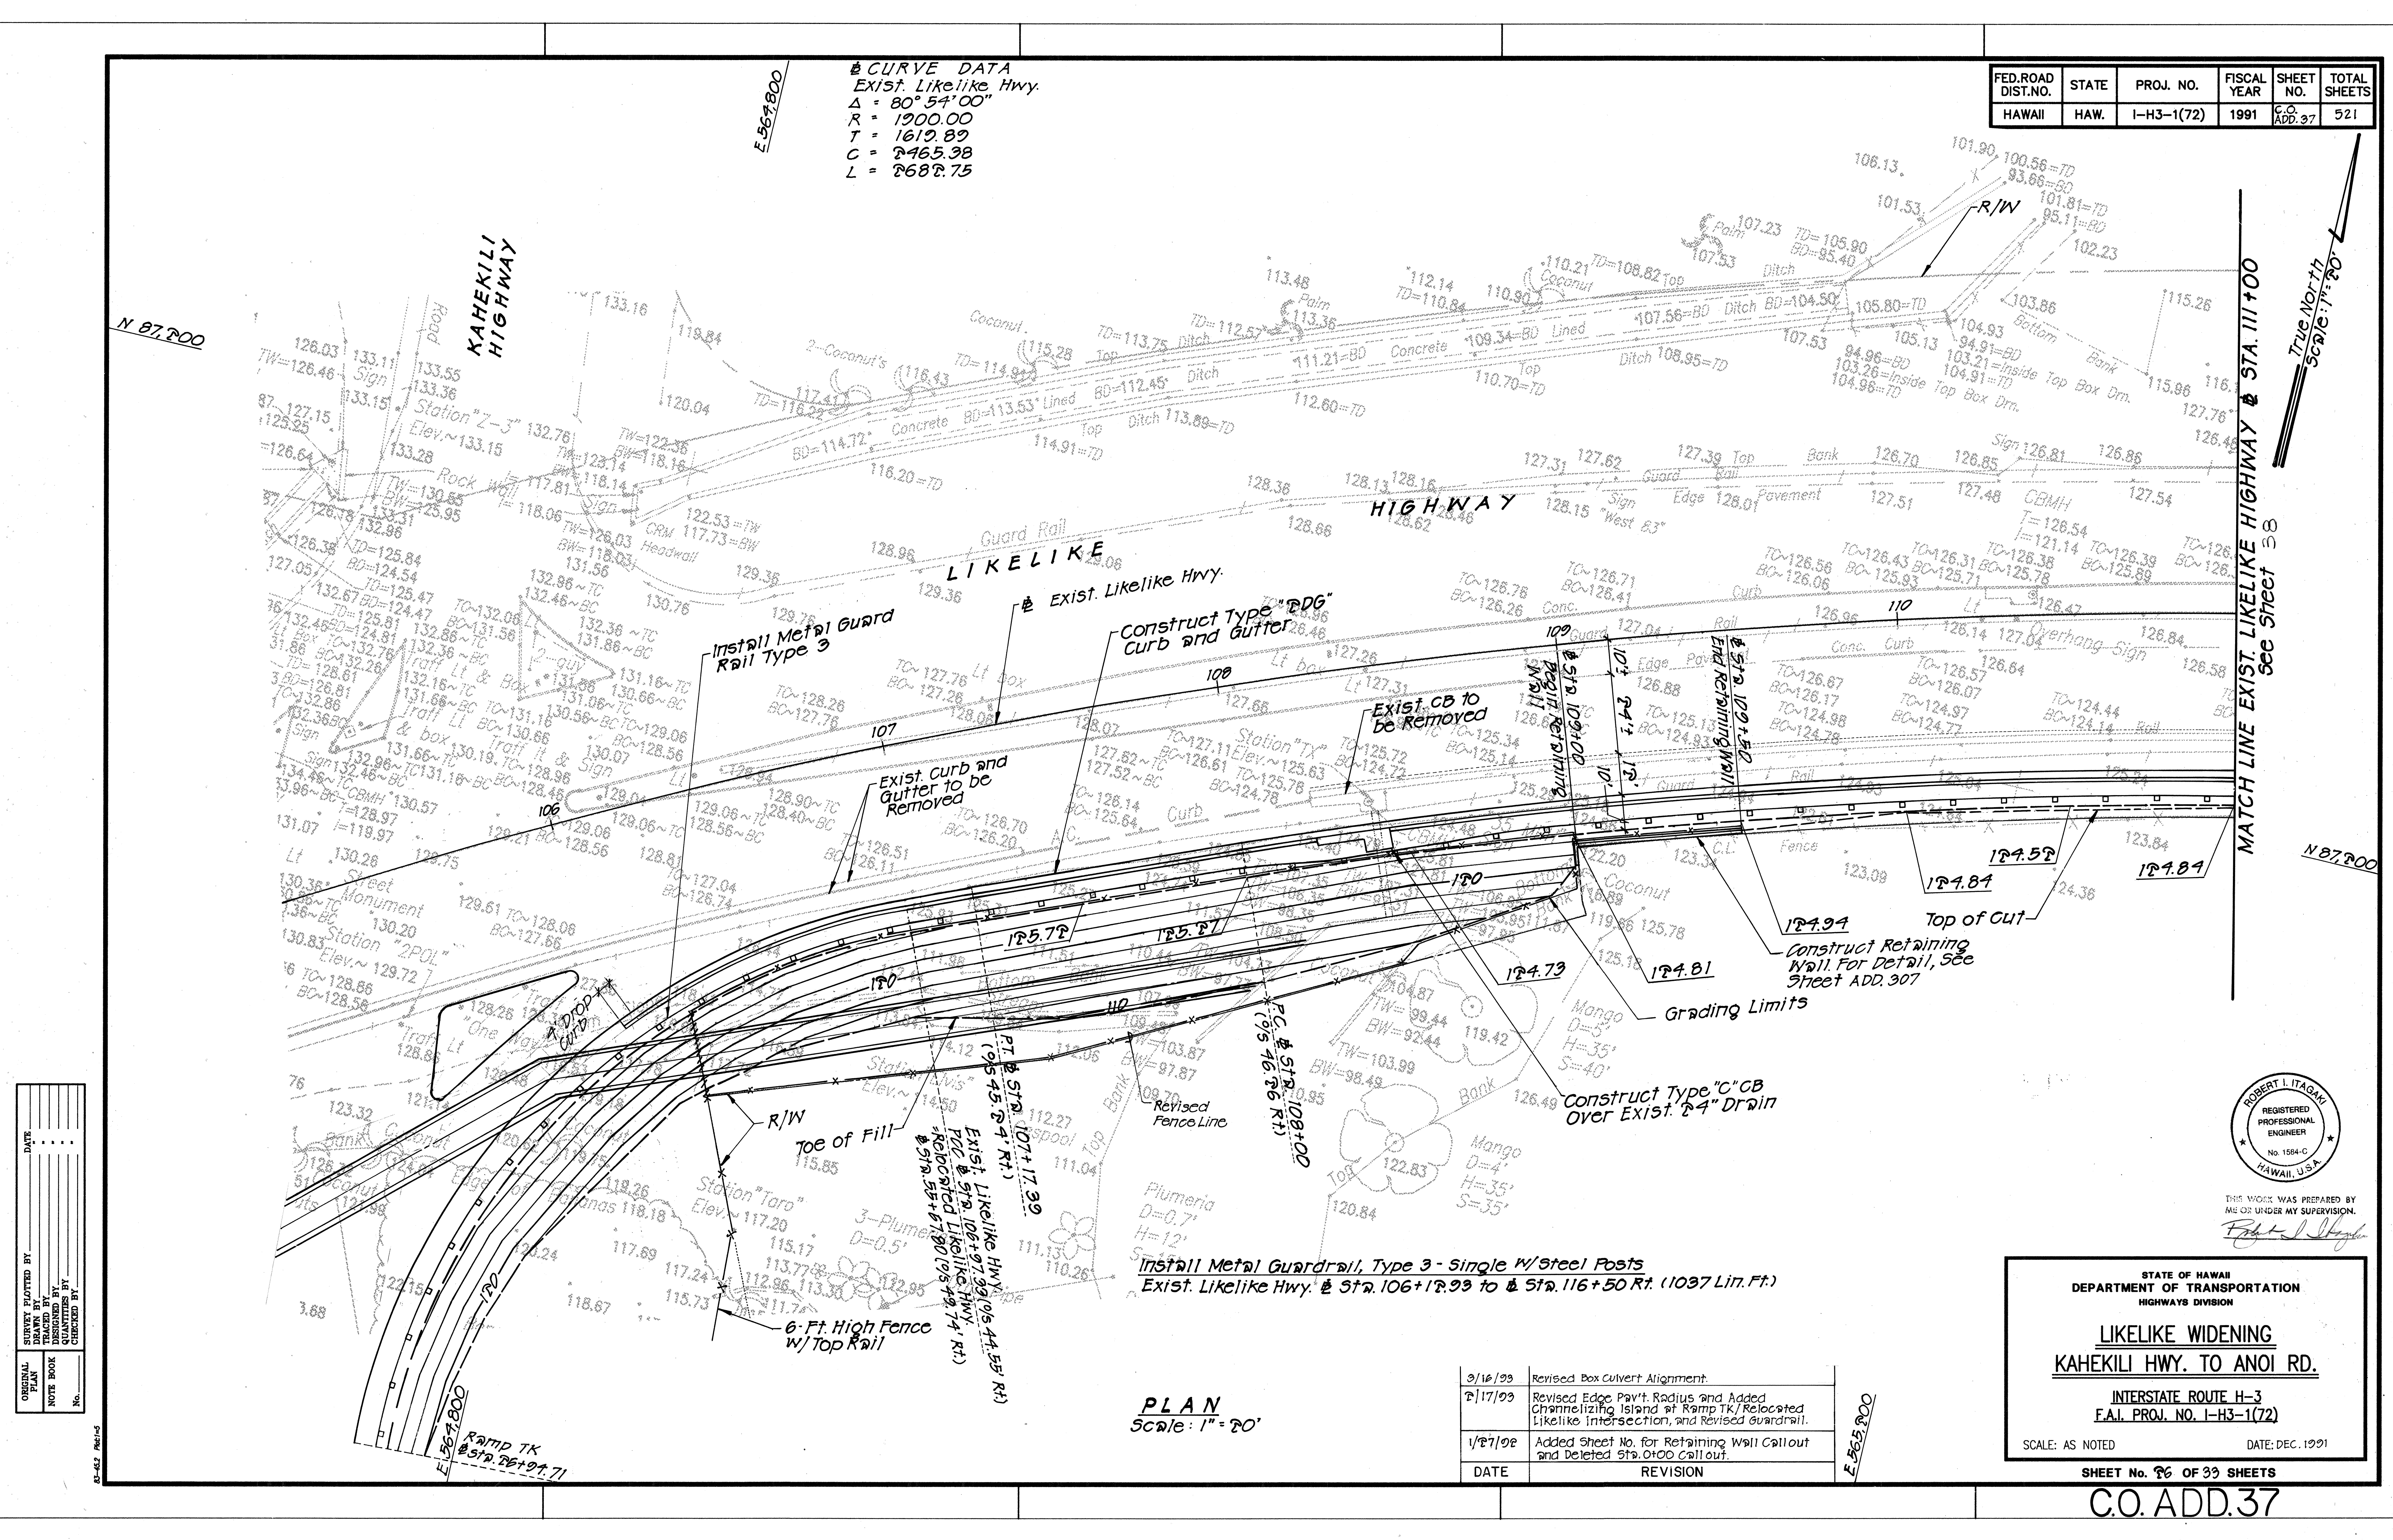

DATE	DESIGNED BY	CHECKED BY
3/16/93	REVISOR	REVISION
3/17/93	REVISOR	REVISION
1/27/92	REVISOR	REVISION

PLAN
Scale: 1" = 20'

DATE	REVISION
3/16/93	Revised Box Culvert Alignment.
3/17/93	Revised Edge Pav't. Radius and Added Channelizing Island at Ramp TK/Relocated Likelike Intersection, and Revised Guardrail.
1/27/92	Added Sheet No. for Retaining Wall Callout and Deleted Sta. 0+00 Callout.

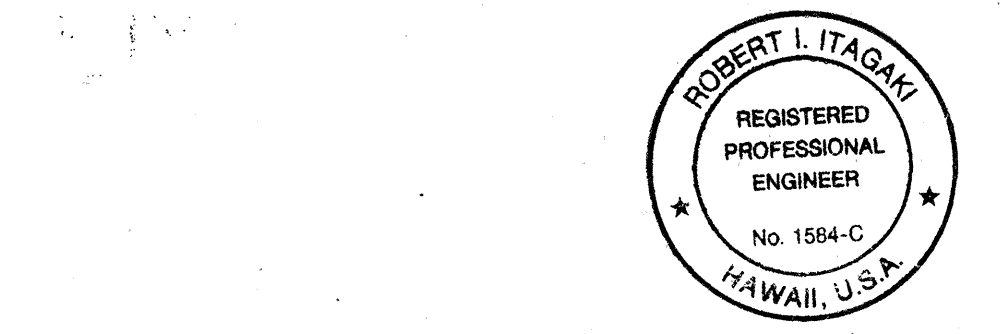

STATE OF HAWAII
DEPARTMENT OF TRANSPORTATION
HIGHWAYS DIVISION

LIKELIKE WIDENING
KAHEKILI HWY. TO ANOI RD.

INTERSTATE ROUTE H-3
F.A.I. PROJ. NO. I-H3-1(72)

SCALE: AS NOTED DATE: DEC. 1991

SHEET No. 37 OF 33 SHEETS

C.O. ADD. 37

FED. ROAD DIST. NO.	STATE	PROJ. NO.	FISCAL YEAR	SHEET NO.	TOTAL SHEETS
HAWAII	HAW.	I-H3-1(72)	1991	C.O. 39	521

True North
Scale: 1"=20'

MATCH LINE EXIST. LIKELIKE HWY. @ STA. 116+00
See Sheet 38

E 566,000

ANOI ROAD

ANOI ROAD

PLAN
Scale: 1"=20'



E 566,000

N 87,200

N 87,200

DATE	_____
SURVEY PLANNED BY	_____
DRAWN BY	_____
TRACED BY	_____
QUANTITIES BY	_____
CHECKED BY	_____
ORIGINAL PLAN	_____
NOTE BOOK	_____
No.	_____

8-42 Plat-15

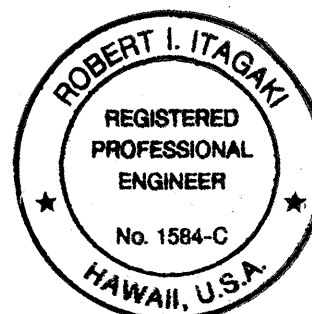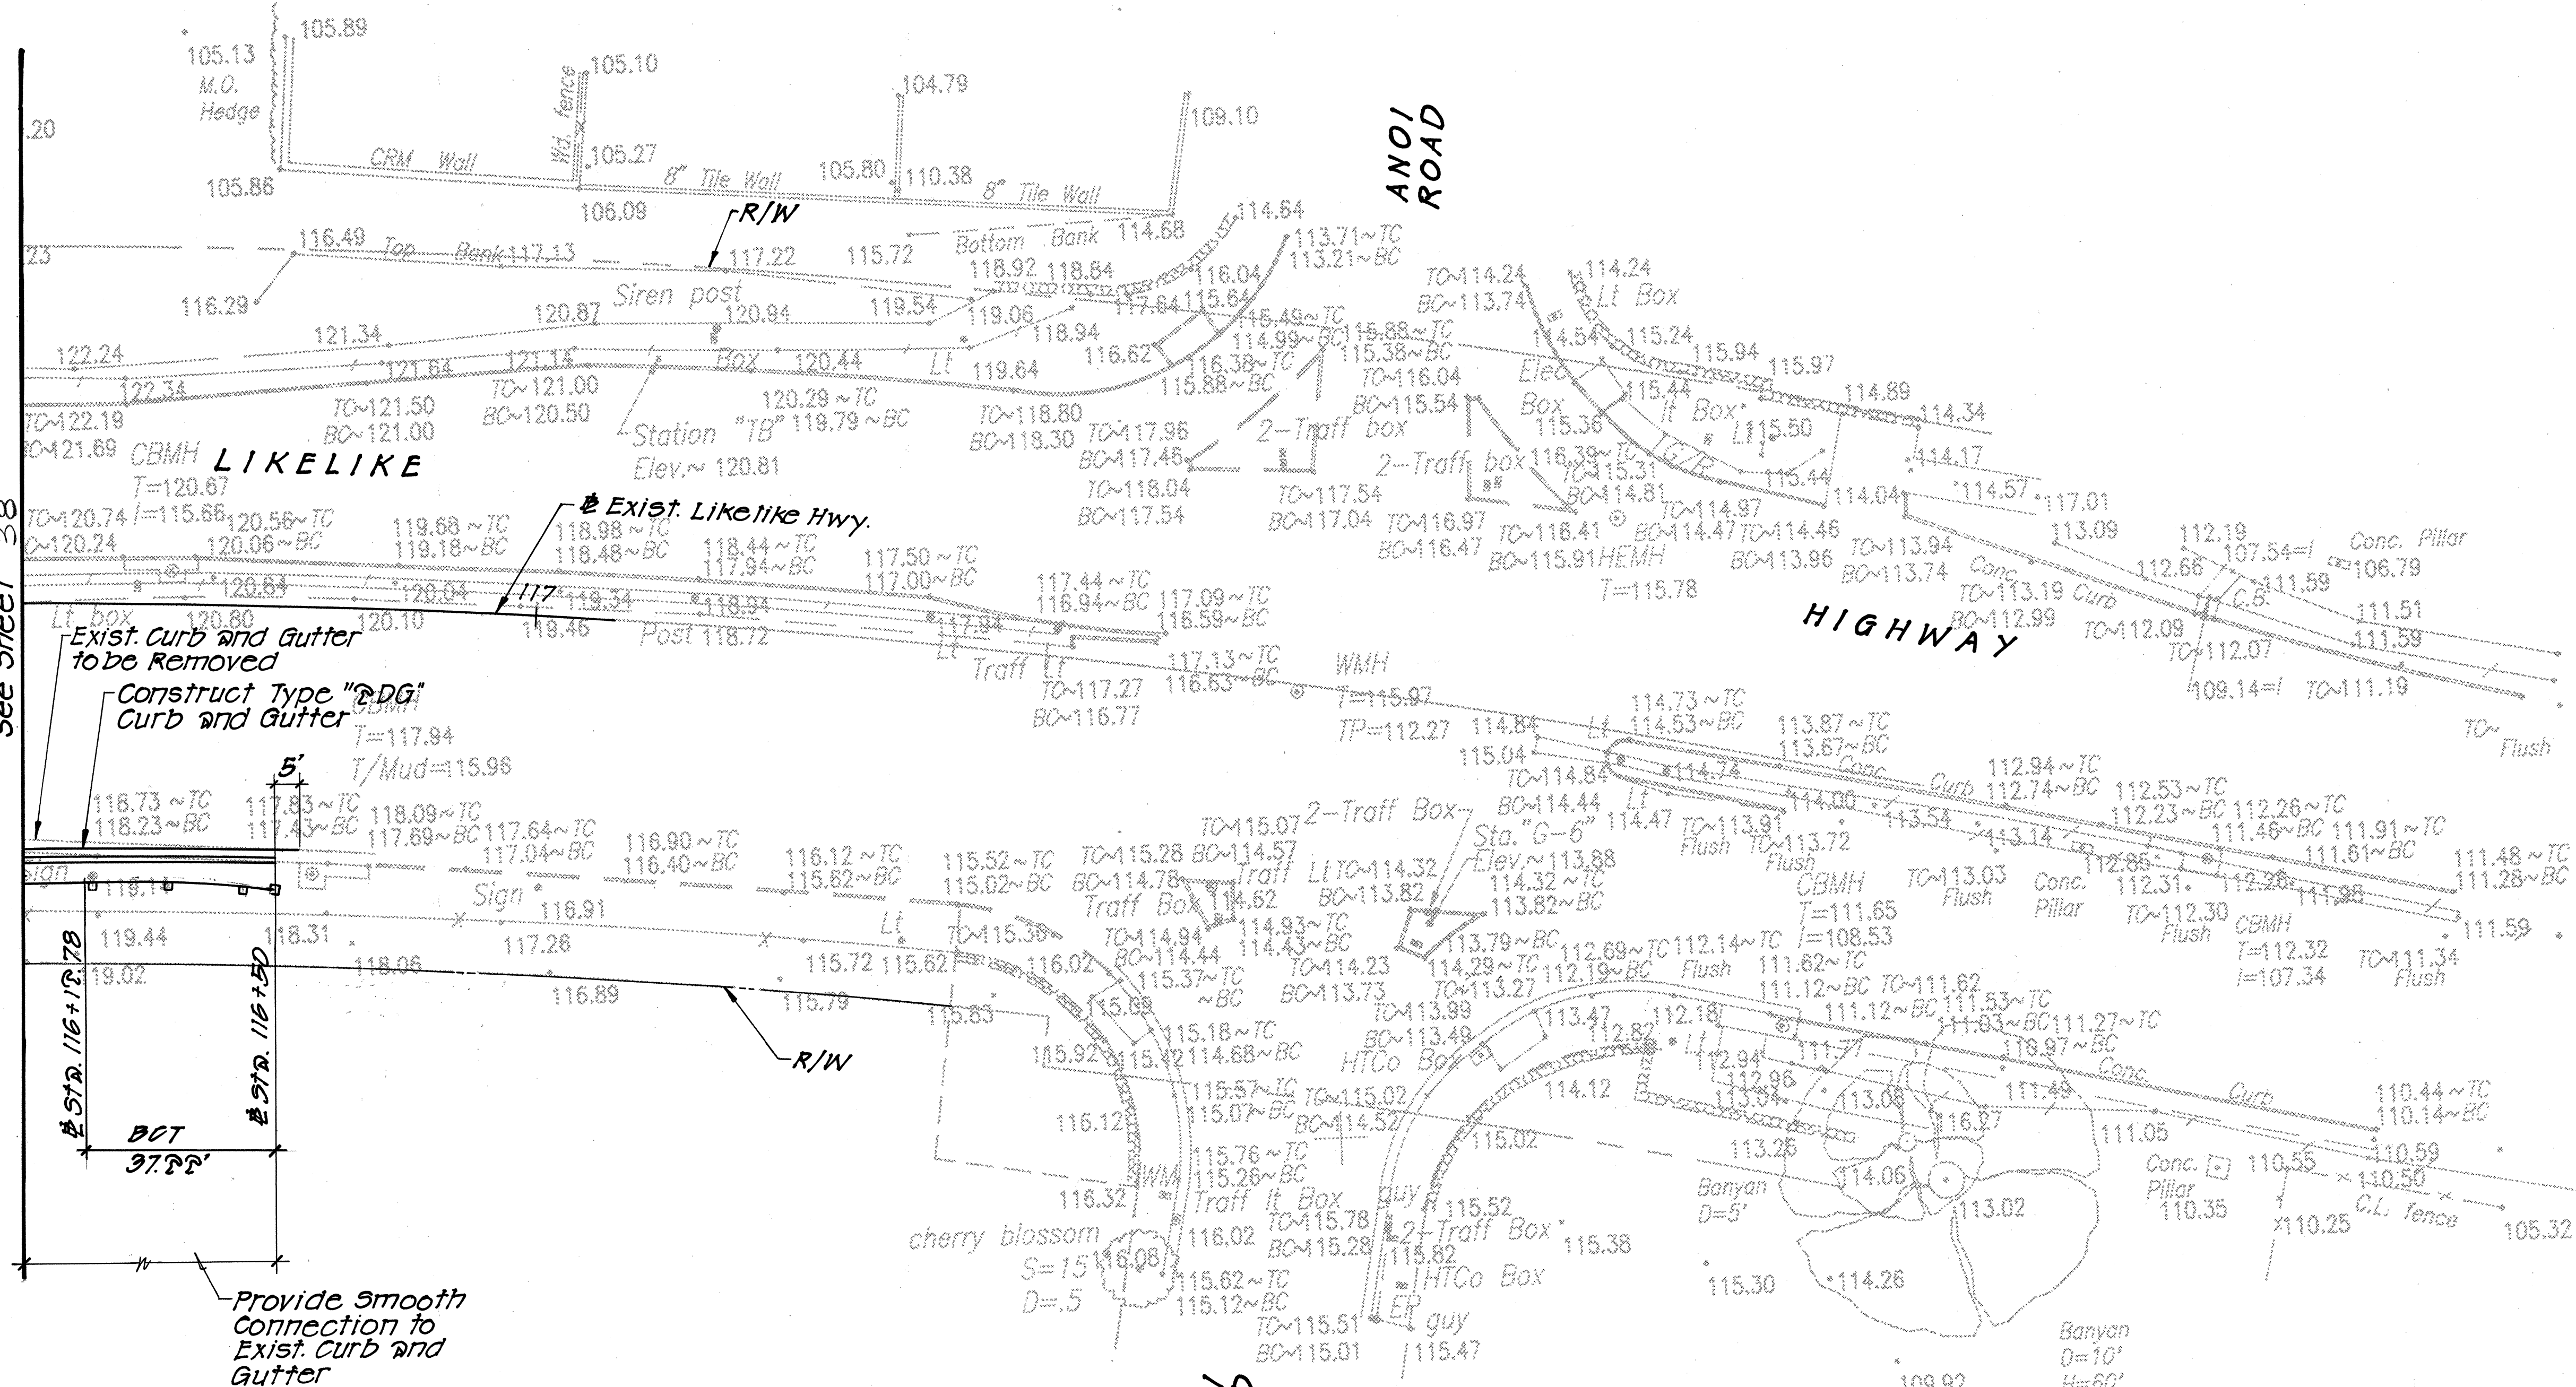

THIS WORK WAS PREPARED BY
ME OR UNDER MY SUPERVISION.

Robert L. Itagaki

STATE OF HAWAII
DEPARTMENT OF TRANSPORTATION
HIGHWAYS DIVISION

LIKELIKE WIDENING
KAHEKILI HWY. TO ANOI RD.

INTERSTATE ROUTE H-3
F.A.I. PROJ. NO. I-H3-1(72)

SCALE: AS NOTED DATE: DEC. 1991

SHEET No. 38 OF 39 SHEETS


2/17/93	Revised Metal Guardrail
DATE	REVISION

C.O.39


FED. ROAD DIST. NO.	STATE	PROJ. NO.	FISCAL YEAR	SHEET NO.	TOTAL SHEETS
HAWAII	HAW.	I-H3-1(72)	1991	C.O.41	521

COORDINATE DATA		
DESCRIPTION	NORTHING	EASTING
PC Sta. 8+55.39	86,043.00	564,545.43
PI	85,982.13	564,534.74
PT Sta. 9+70.78	85,951.99	564,480.78
Center of Curve	86,065.48	564,417.39


CURVE DATA	
CURVE	K-6
Δ	50°51'22"
$\Delta/2$	25°25'41"
R	130.00
T	61.81
C	111.64
L	115.39

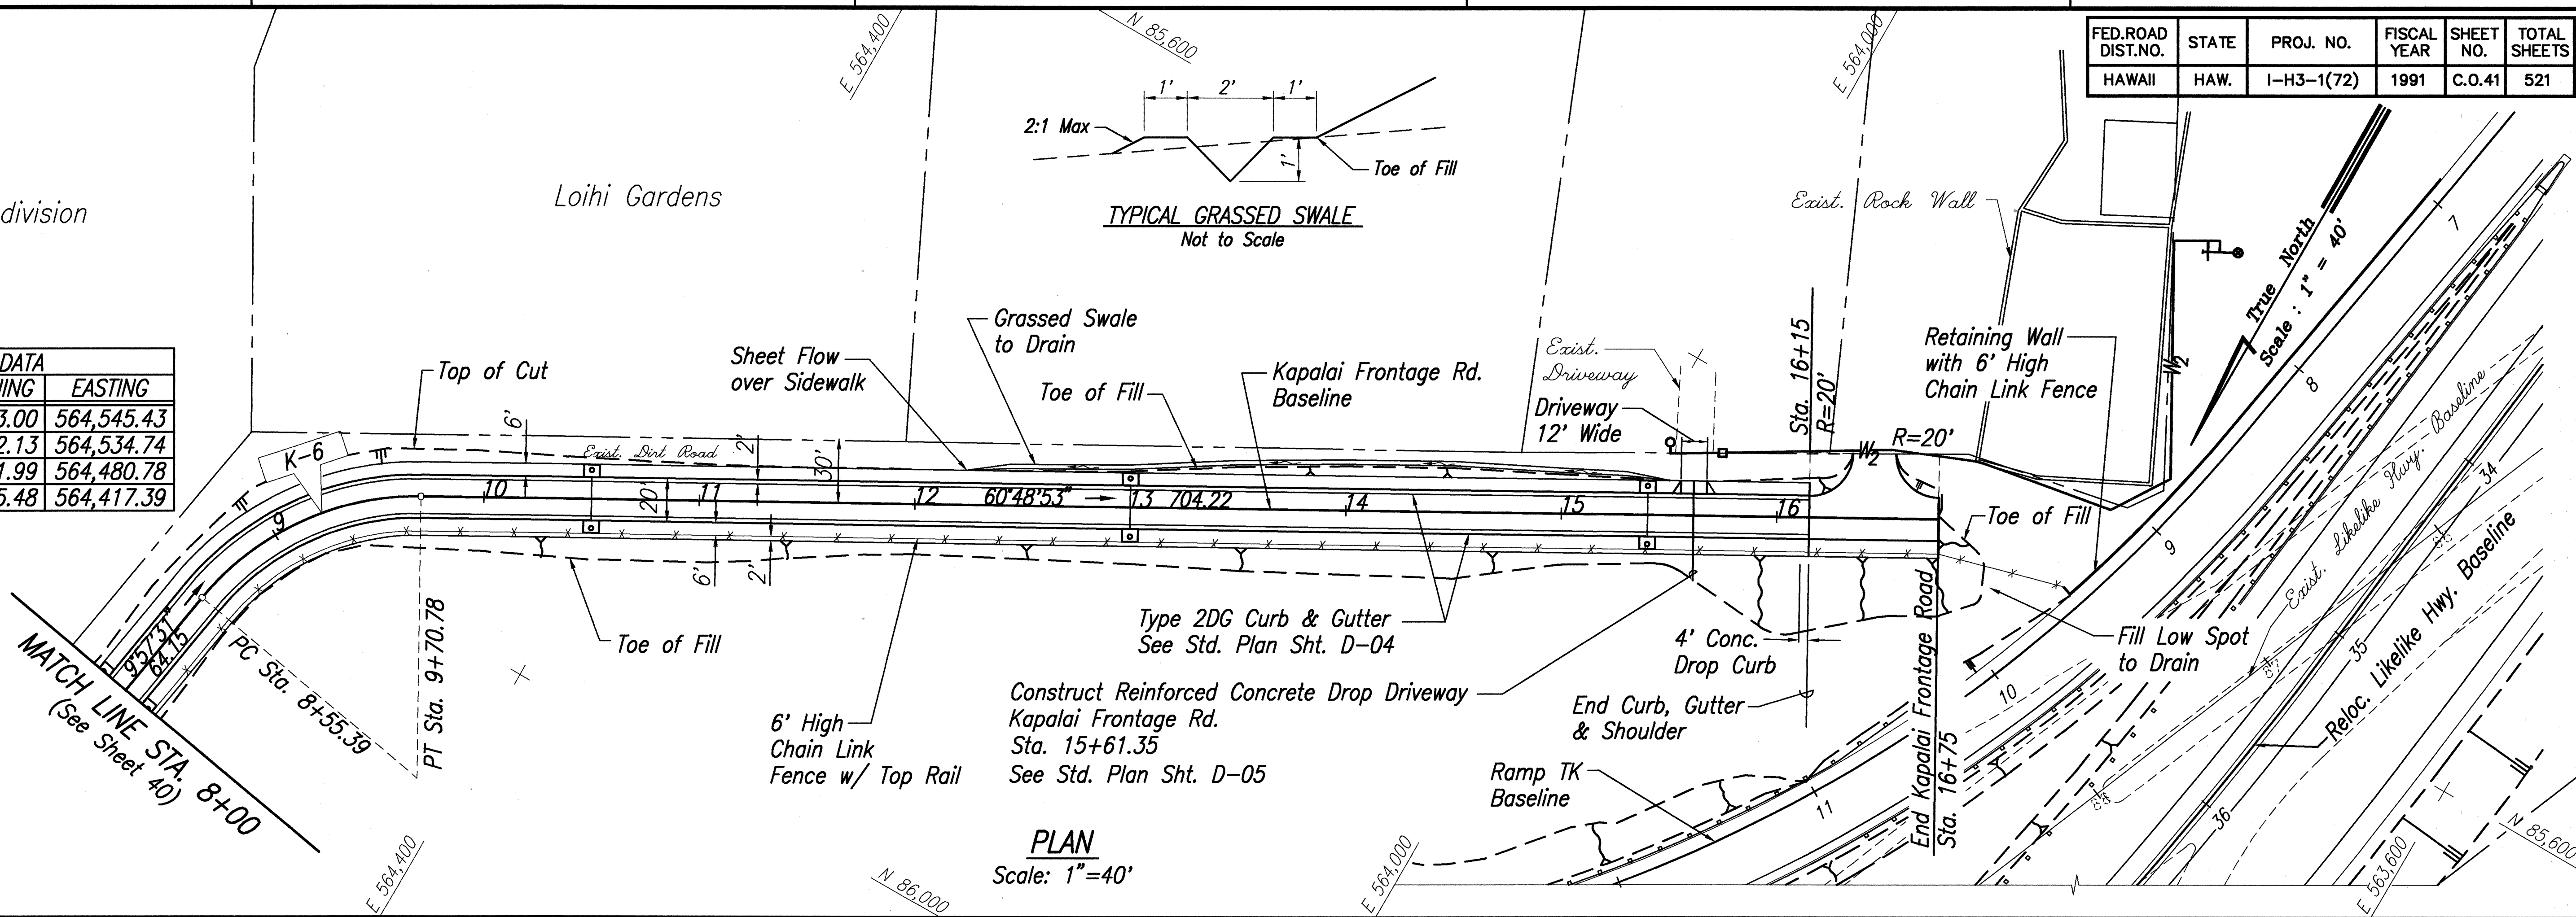

PLAN
Scale: 1"=40'

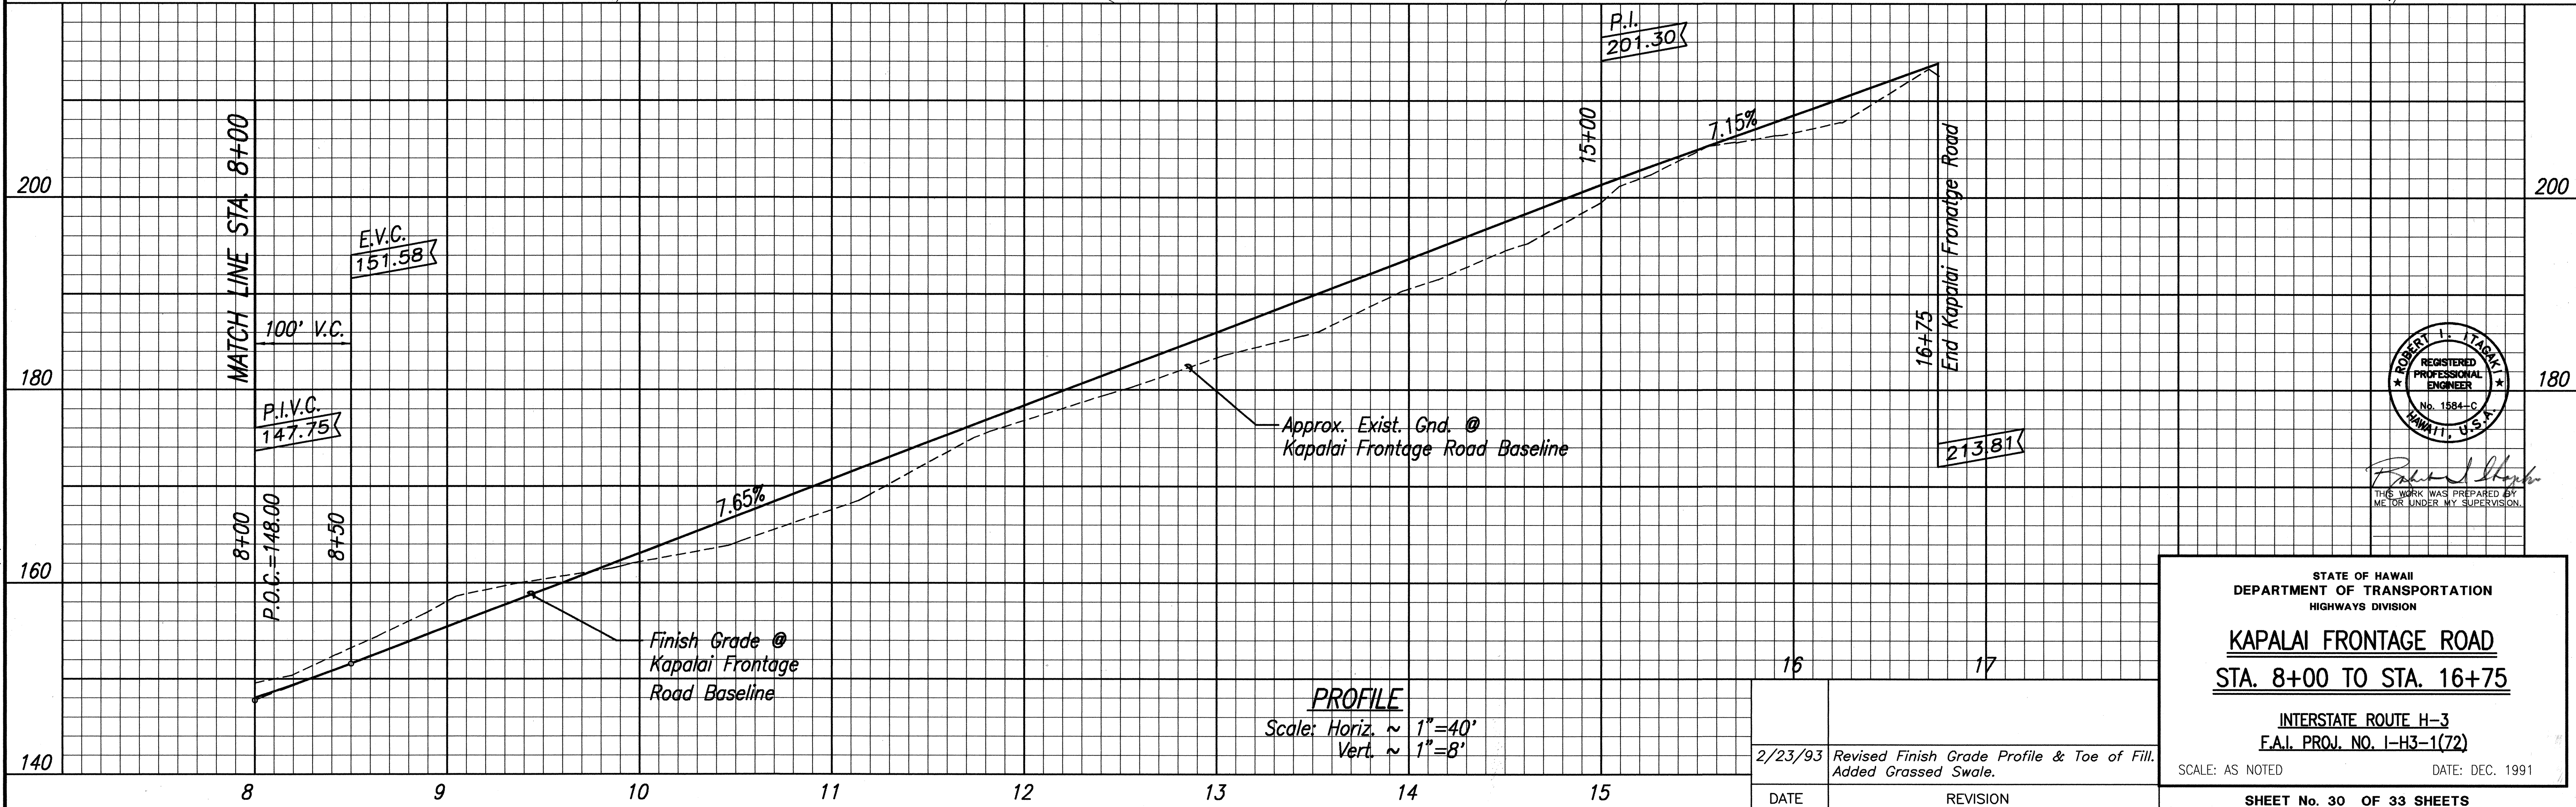

PROFILE
Scale: Horiz. ~ 1"=40'
Vert. ~ 1"=8'

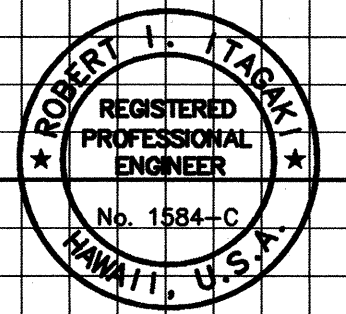

STATE OF HAWAII
DEPARTMENT OF TRANSPORTATION
HIGHWAYS DIVISION

KAPALAI FRONTAGE ROAD
STA. 8+00 TO STA. 16+75

INTERSTATE ROUTE H-3
F.A.I. PROJ. NO. I-H3-1(72)


SCALE: AS NOTED DATE: DEC. 1991

SHEET No. 30 OF 33 SHEETS



DATE	2/23/93
DESIGNED BY	
TRACED BY	
NOTE BOOK	
QUANTITIES BY	
No.	

83-482 F.P.E.-KAPALAI FRONTAGE ROAD P.I. 140 2/23/93 AF

SHEET No. OF SHEETS

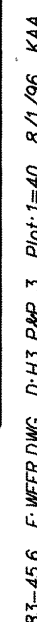

FED. ROAD DIST. NO.	STATE	PROJ. NO.	FISCAL YEAR	SHEET NO.	TOTAL SHEETS
HAWAII	HAW.	I-H3-1(72)	1991	C.O. ADD. 43	521

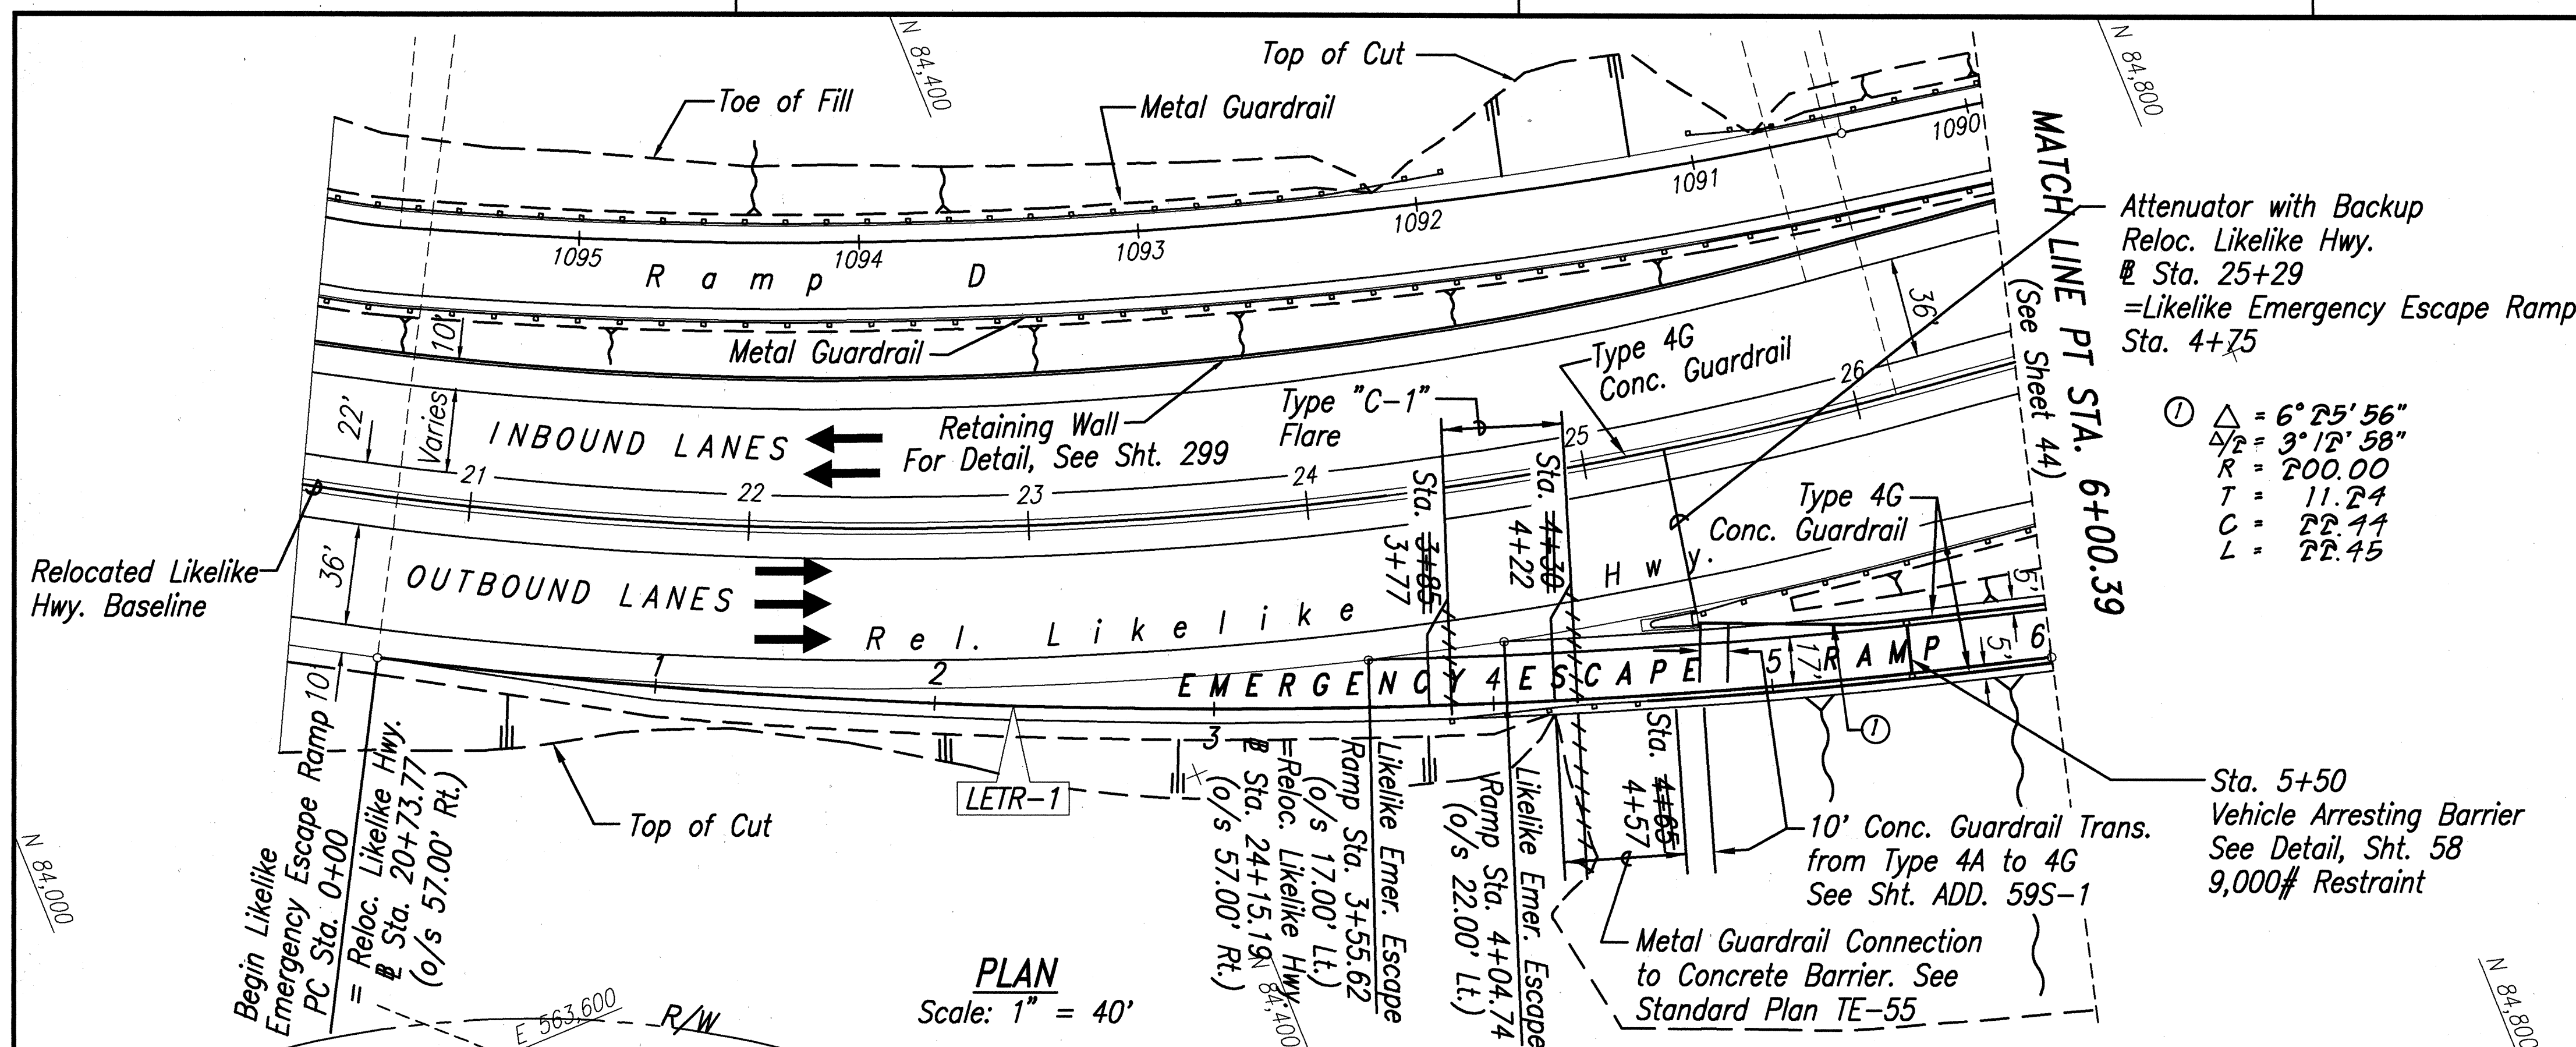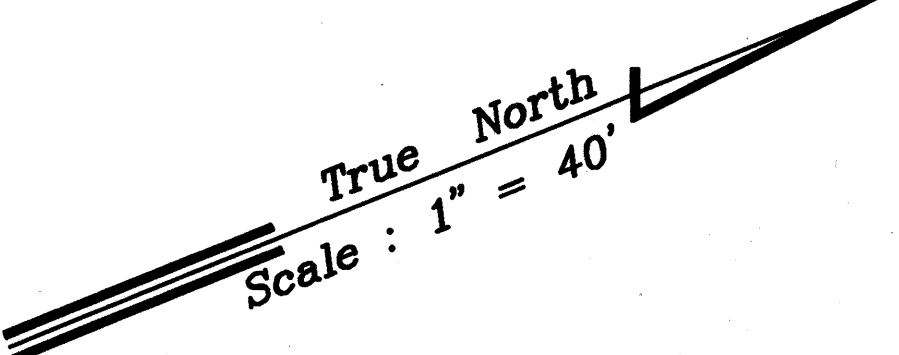


① $\Delta = 6^\circ 25' 56''$
 $\Delta/2 = 3^\circ 12' 58''$
 $R = 200.00$
 $T = 11.24$
 $C = 22.11$
 $L = 22.45$


Install Metal Guardrail, Type 3-Single w/ Steel Post
 Likelike Emer. Esc. Ramp Sta. 3+85 to Sta. 4+55 Rt. (70 Lin. Ft.)
 3+77 4+47
 Install Concrete Guardrail, Type 4G 4+47 583
 Likelike Emer. Esc. Ramp Sta. 4+55 to Sta. 10+30 Rt. (575 Lin. Ft.)
 Likelike Emer. Esc. Ramp Sta. 4+75 to Sta. 10+30 Lt. (555 Lin. Ft.)

CURVE DATA	
CURVE	LETR-1
Δ	14°20'00"
$\Delta/2$	7°10'00"
R	2400.00
T	301.77
C	598.83
L	600.39

COORDINATE DATA		
DESCRIPTION	NORTHING	EASTING
PC Sta. 0+00	84,144.38	563,450.74
PI	84,407.67	563,598.20
PT Sta. 6+00.39	84,699.27	563,675.90
Center of Curve	85,317.15	561,356.80

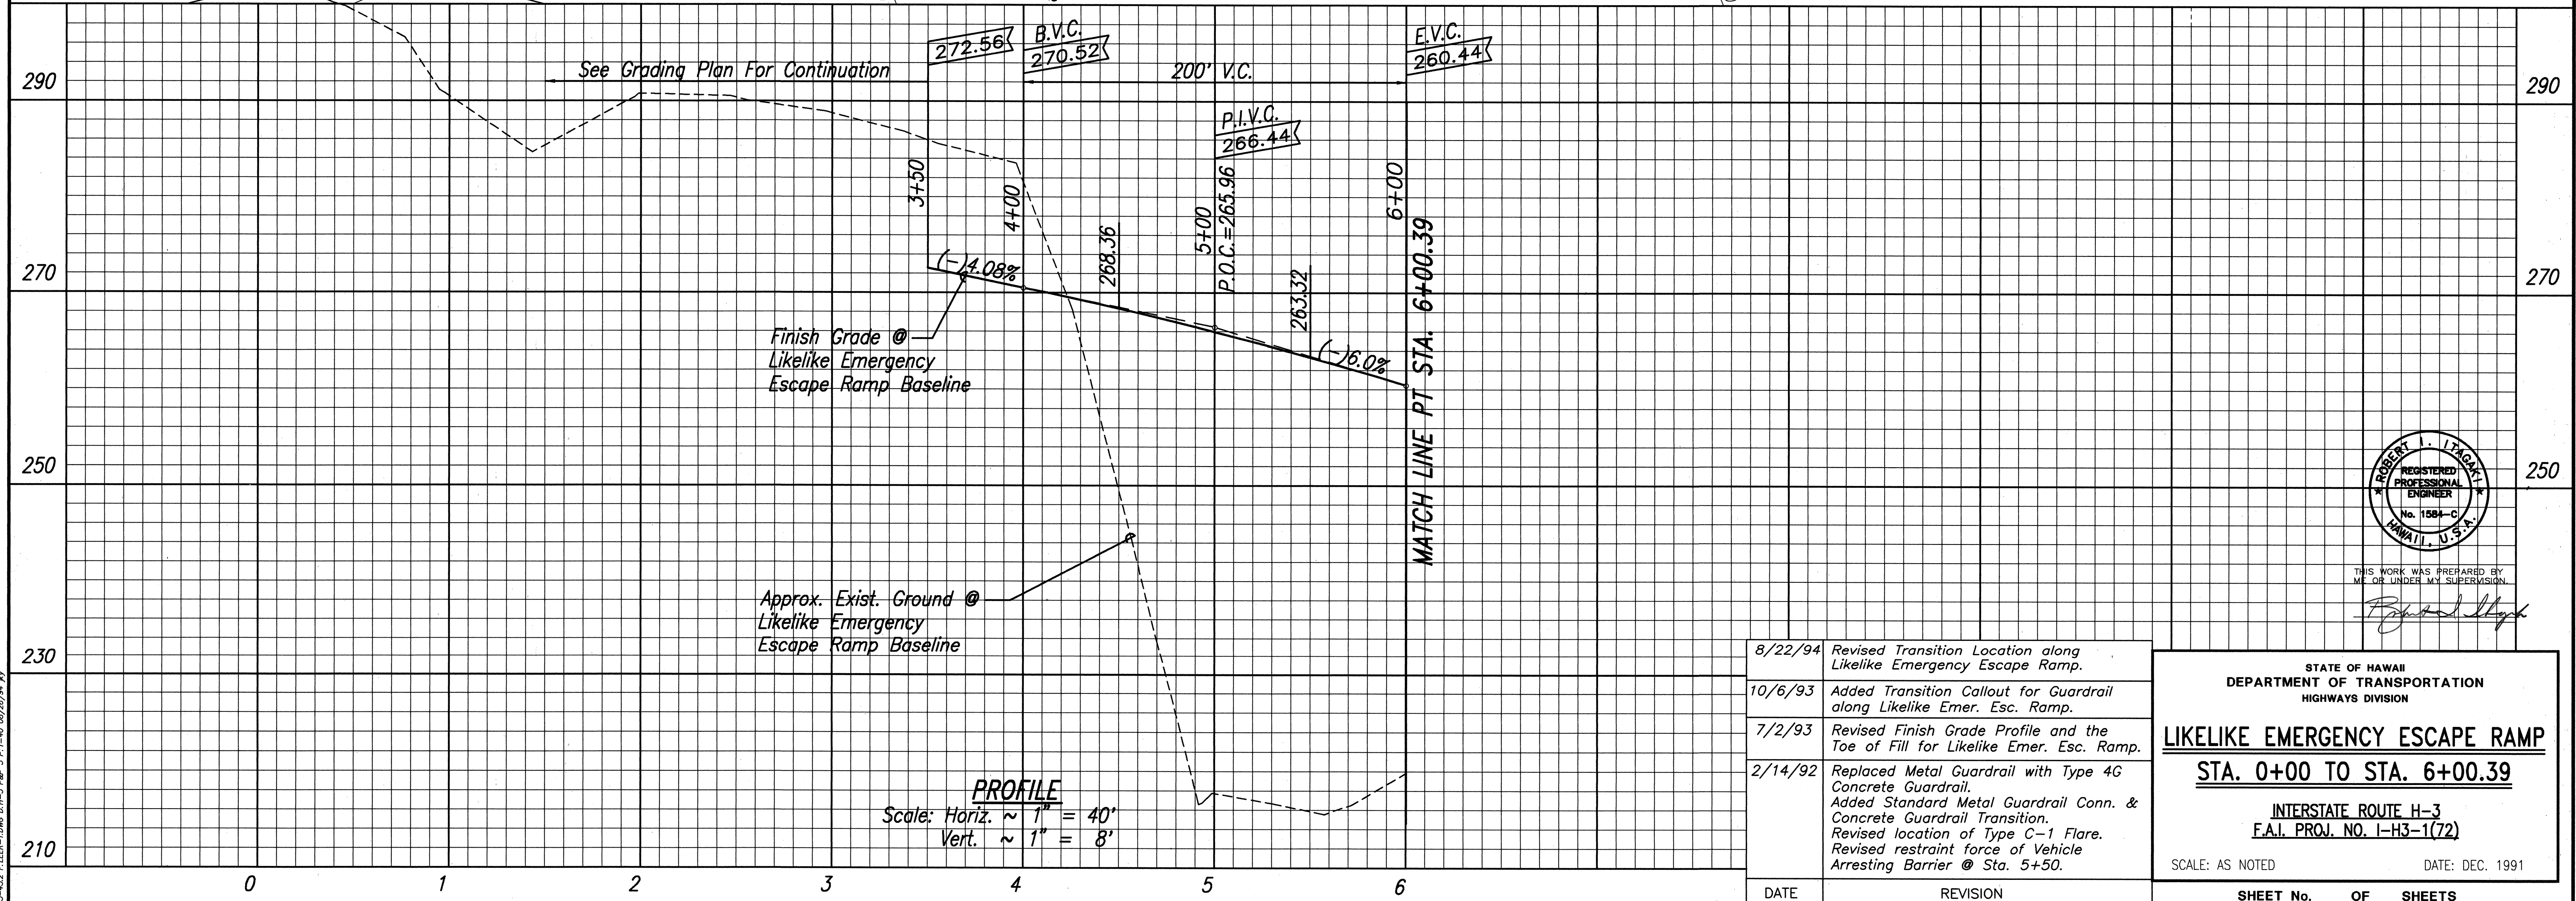

PROFILE
 Scale: Horiz. $\sim 1" = 40'$
 Vert. $\sim 1" = 8'$

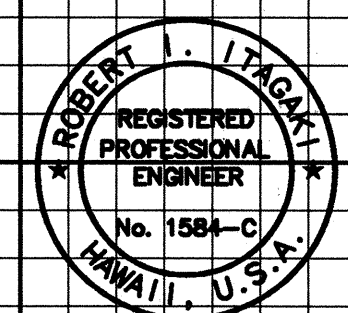

THIS WORK WAS PREPARED BY ME OR UNDER MY SUPERVISION.

Robert J. Iraggi

DATE	REVISION
8/22/94	Revised Transition Location along Likelike Emergency Escape Ramp.
10/6/93	Added Transition Callout for Guardrail along Likelike Emer. Esc. Ramp.
7/2/93	Revised Finish Grade Profile and the Toe of Fill for Likelike Emer. Esc. Ramp.
2/14/92	Replaced Metal Guardrail with Type 4G Concrete Guardrail. Added Standard Metal Guardrail Conn. & Concrete Guardrail Transition. Revised location of Type C-1 Flare. Revised restraint force of Vehicle Arresting Barrier @ Sta. 5+50.

STATE OF HAWAII
 DEPARTMENT OF TRANSPORTATION
 HIGHWAYS DIVISION

LIKELIKE EMERGENCY ESCAPE RAMP
STA. 0+00 TO STA. 6+00.39

INTERSTATE ROUTE H-3
 F.A.I. PROJ. NO. I-H3-1(72)



SCALE: AS NOTED DATE: DEC. 1991

SHEET No. OF SHEETS

SURVEY DOTTED BY	DATE
PLAN	
DESIGNED BY	
CHECKED BY	
NOTED BY	
NO.	


83-452 FLEET-10WS D-14-3 P-1-1-40 08/26/94 RY

FED. ROAD DIST. NO.	STATE	PROJ. NO.	FISCAL YEAR	SHEET NO.	TOTAL SHEETS
HAWAII	HAW.	I-H3-1(72)	1991	C.O. ADD. 44	521

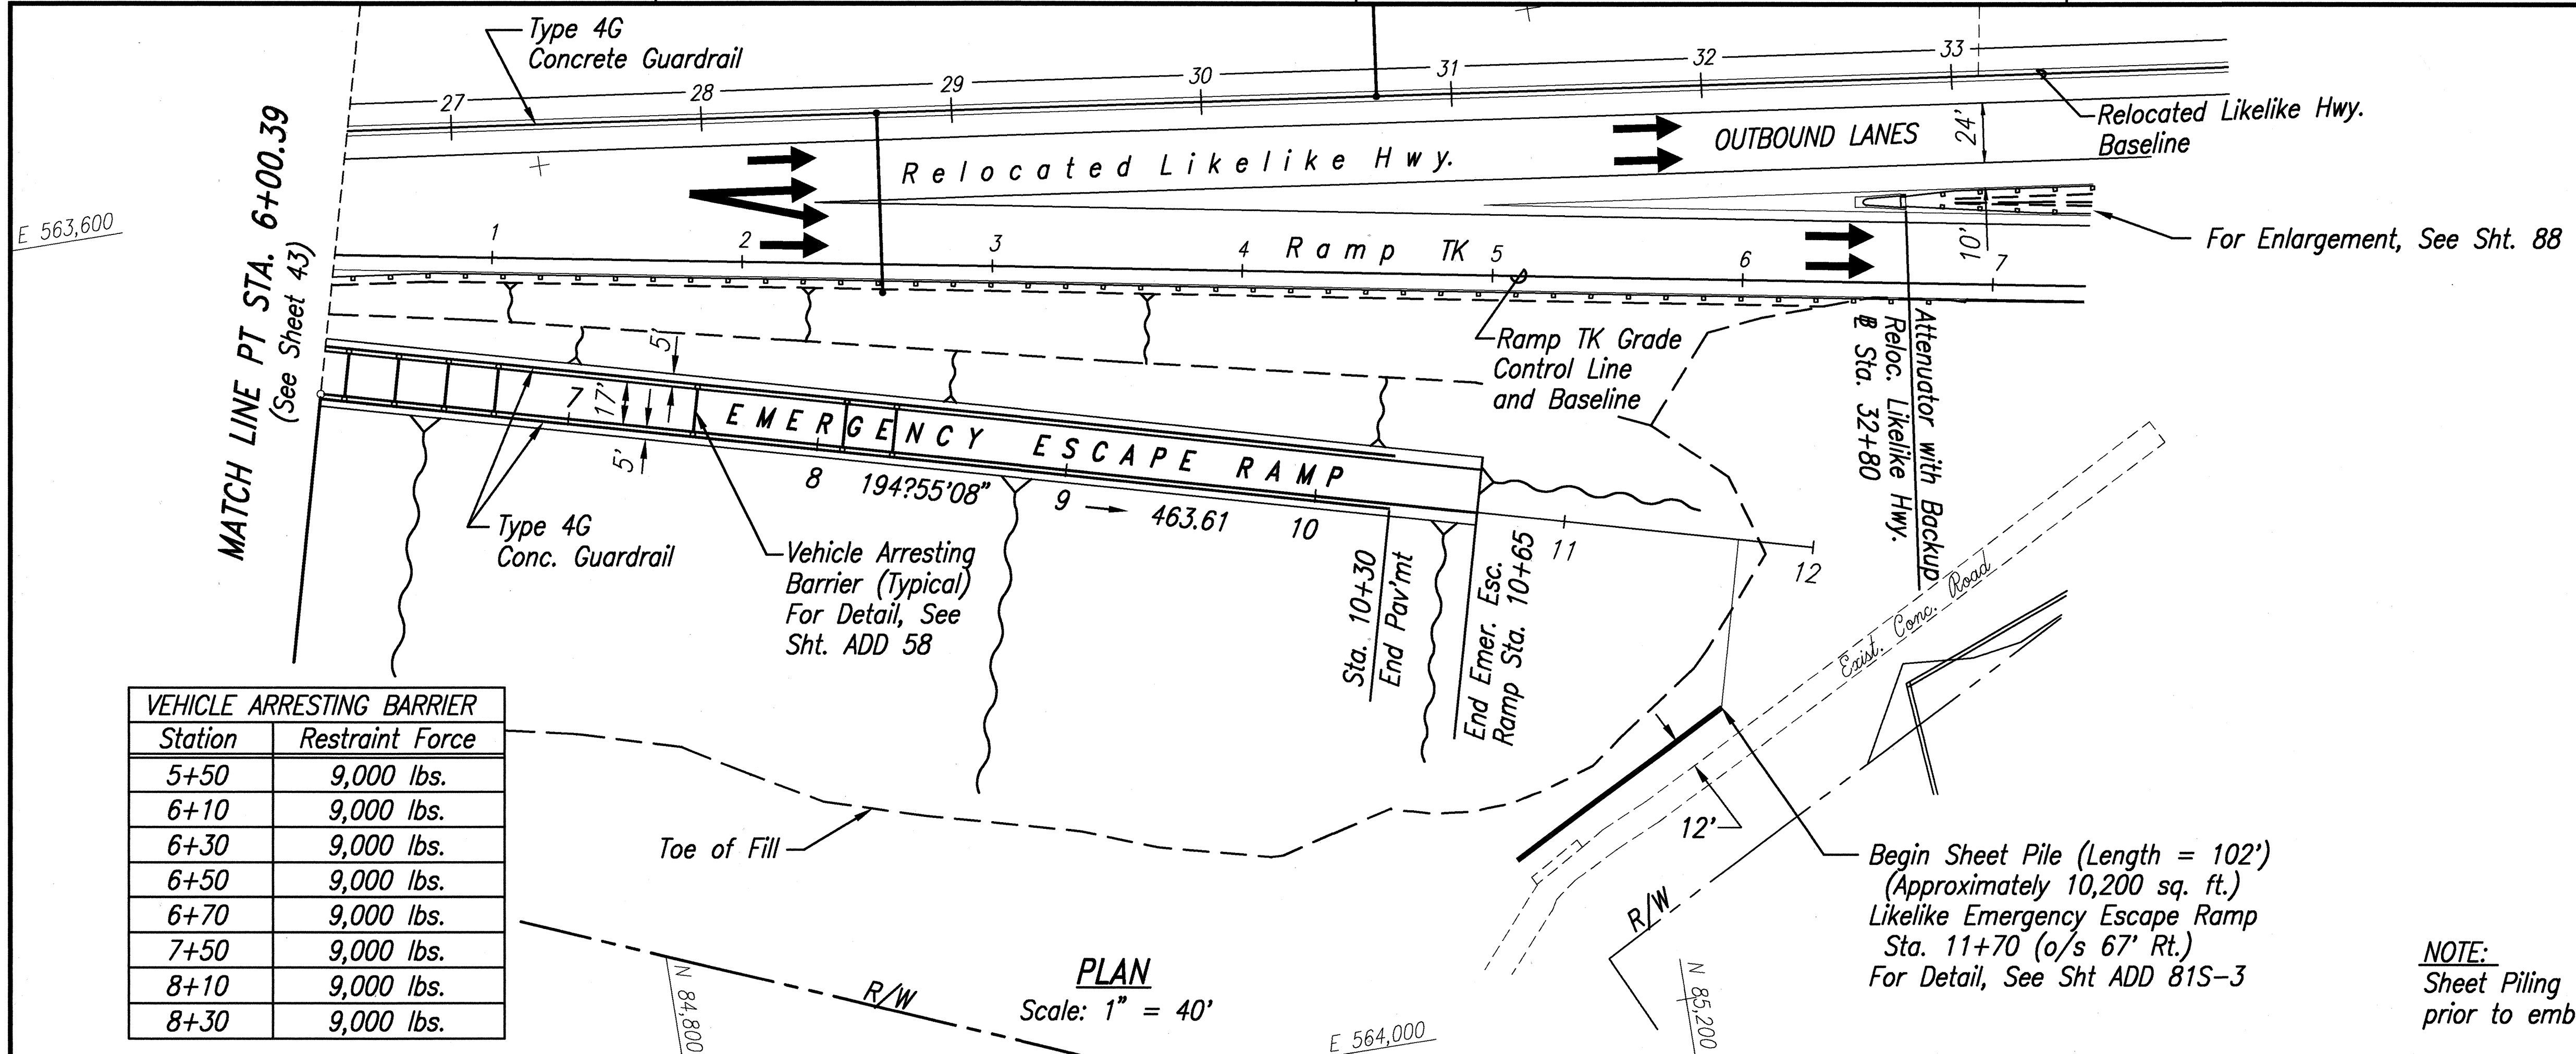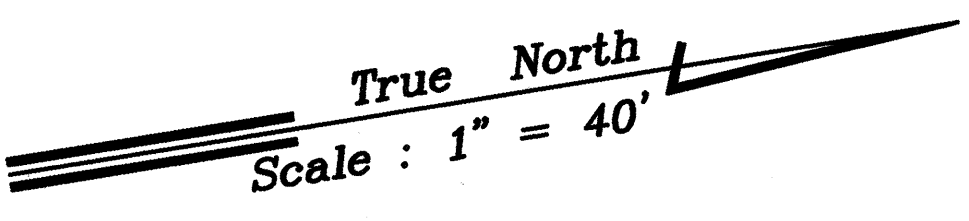


VEHICLE ARRESTING BARRIER	
Station	Restraint Force
5+50	9,000 lbs.
6+10	9,000 lbs.
6+30	9,000 lbs.
6+50	9,000 lbs.
6+70	9,000 lbs.
7+50	9,000 lbs.
8+10	9,000 lbs.
8+30	9,000 lbs.

NOTE:
Sheet Piling to be installed prior to embankment operation.

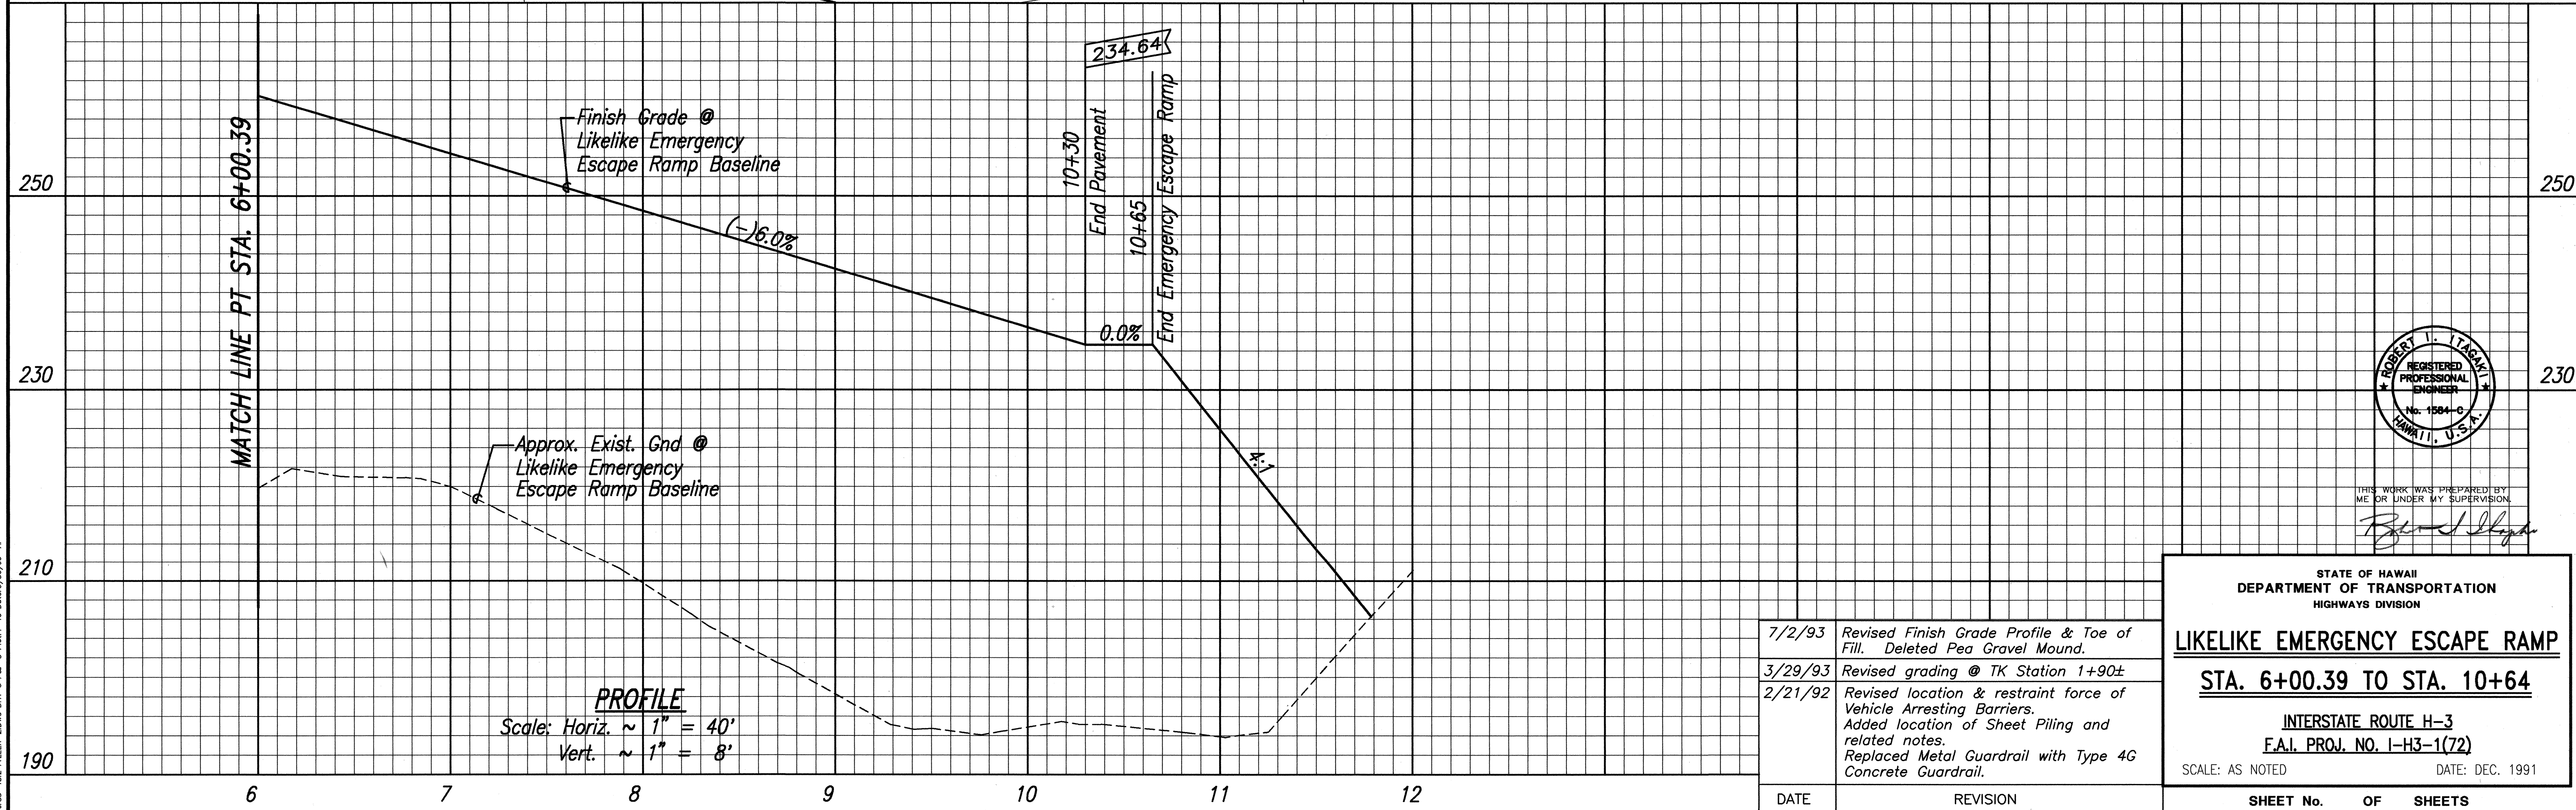

DATE	DESIGNED BY
DATE	DRAWN BY
DATE	TRACED BY
DATE	NOTED BY
DATE	QUANTITIES BY
DATE	NO.

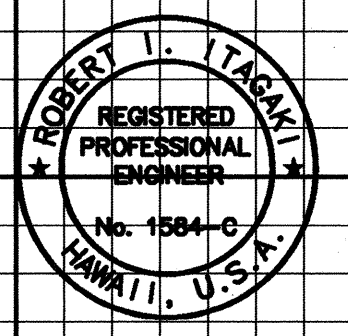

STATE OF HAWAII
DEPARTMENT OF TRANSPORTATION
HIGHWAYS DIVISION

LIKELIKE EMERGENCY ESCAPE RAMP
STA. 6+00.39 TO STA. 10+64
INTERSTATE ROUTE H-3
F.A.I. PROJ. NO. I-H3-1(72)
SCALE: AS NOTED DATE: DEC. 1991
SHEET No. OF SHEETS

7/2/93	Revised Finish Grade Profile & Toe of Fill. Deleted Pea Gravel Mound.
3/29/93	Revised grading @ TK Station 1+90±
2/21/92	Revised location & restraint force of Vehicle Arresting Barriers. Added location of Sheet Piling and related notes. Replaced Metal Guardrail with Type 4G Concrete Guardrail.
DATE	REVISION

C.O. ADD. 44