

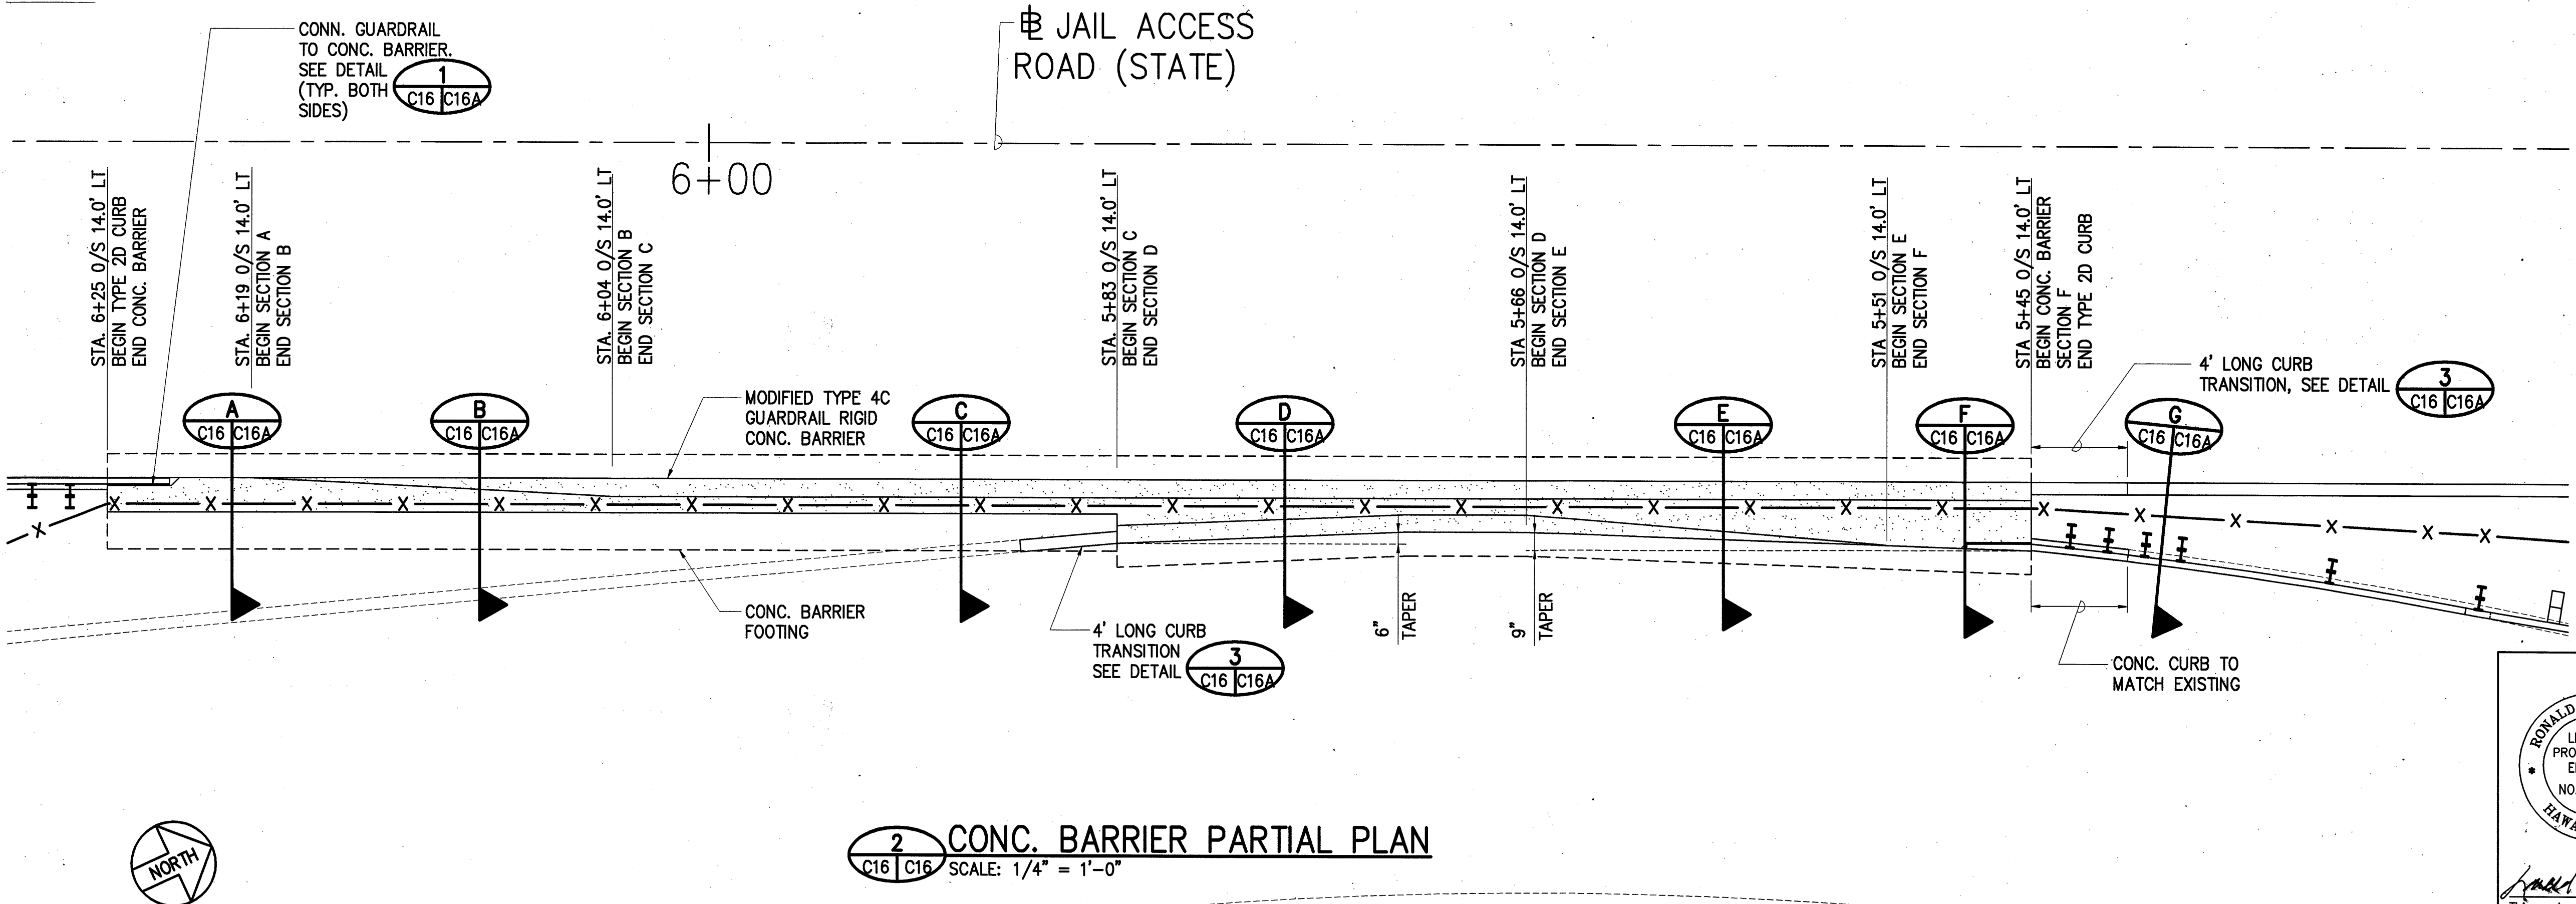


FED. ROAD DIST. NO.	STATE	FED. AID PROJ. NO.	FISCAL YEAR	SHEET NO.	TOTAL SHEETS
HAWAII	HAW.	I-H3-1-(73)	1996	20	42

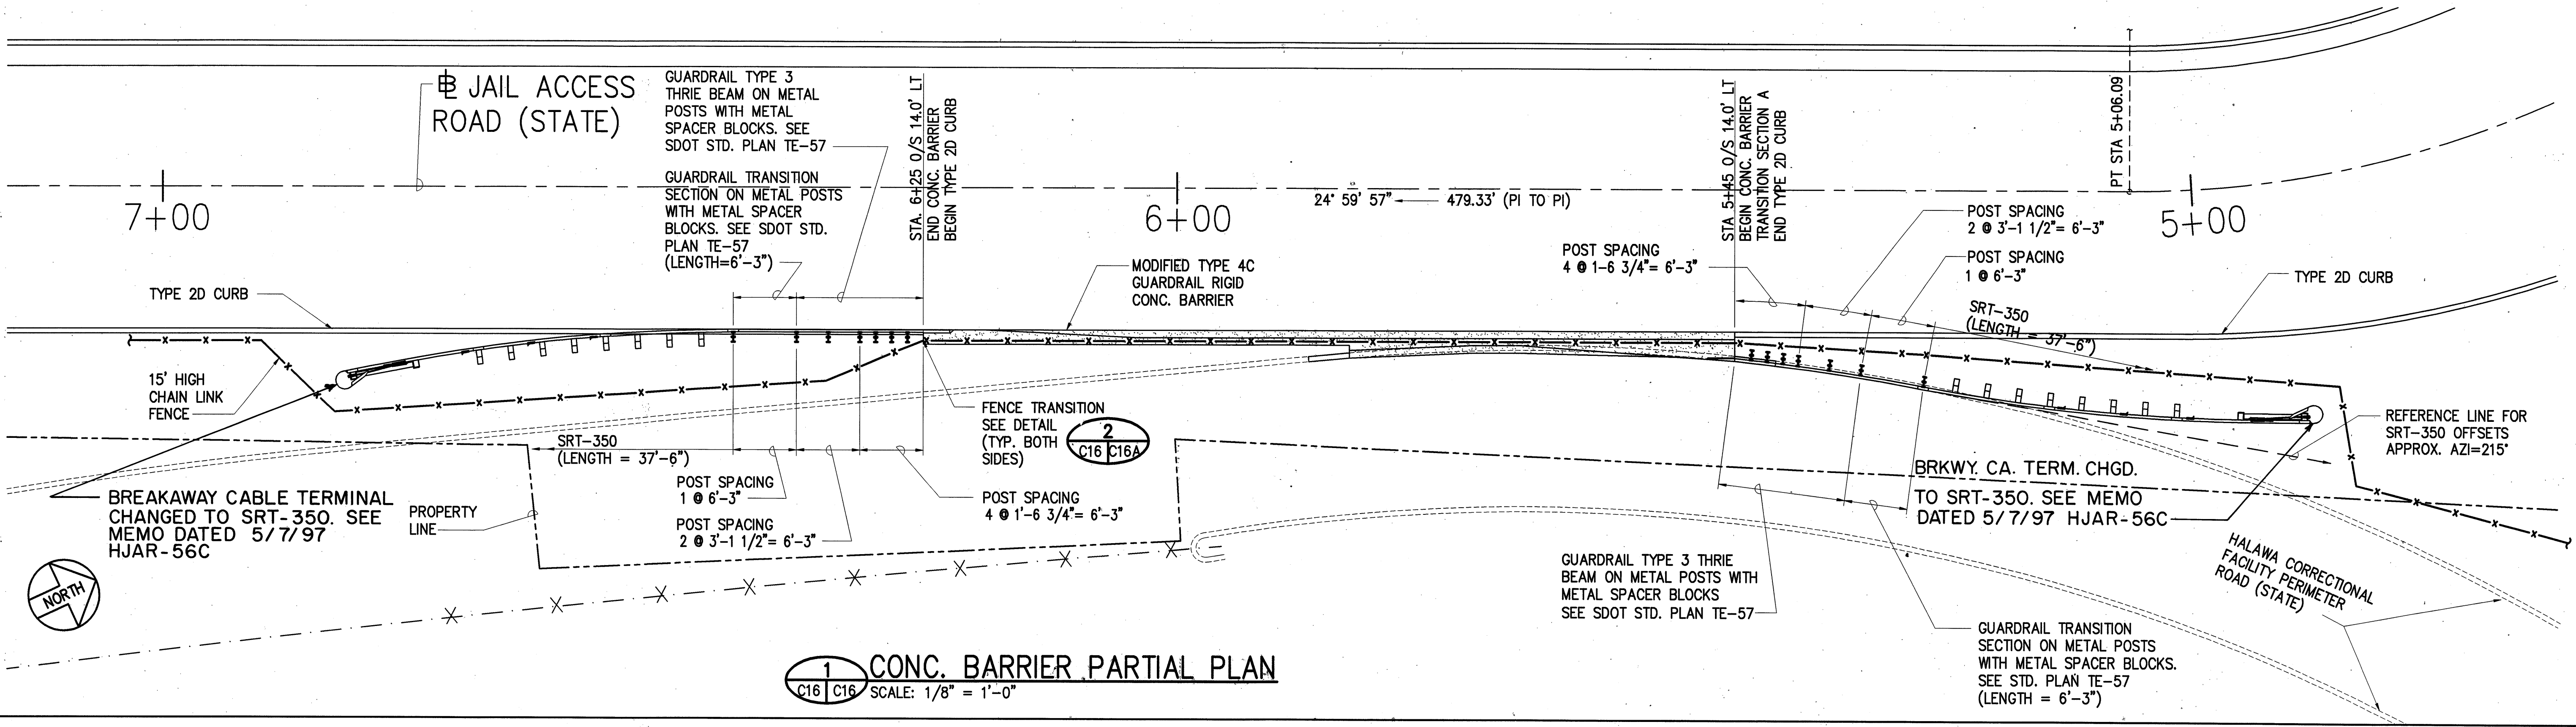


REVISION DATE	REVISION	BY
MAR. 1997	CHANGE BCT TO SRT-350, REVISE BARRIER	

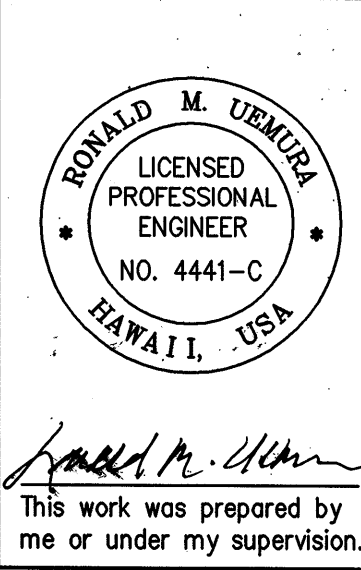


STATE OF HAWAII
DEPARTMENT OF TRANSPORTATION
HIGHWAYS DIVISION
HALAWA JAIL ACCESS ROAD
CONC. BARRIER PARTIAL PLAN
INTERSTATE ROUTE H-3
F.A.I. PROJ. I-H3-1 (73)

SCALE: AS NOTED DATE: APR. 1997
SHEET No. C16 OF 42 SHEETS


FED. ROAD DIST. NO.	STATE	FED. AID PROJ. NO.	FISCAL YEAR	SHEET NO.	TOTAL SHEETS
HAWAII	HAW.	I-H3-1-(73)	1996	205-1	42

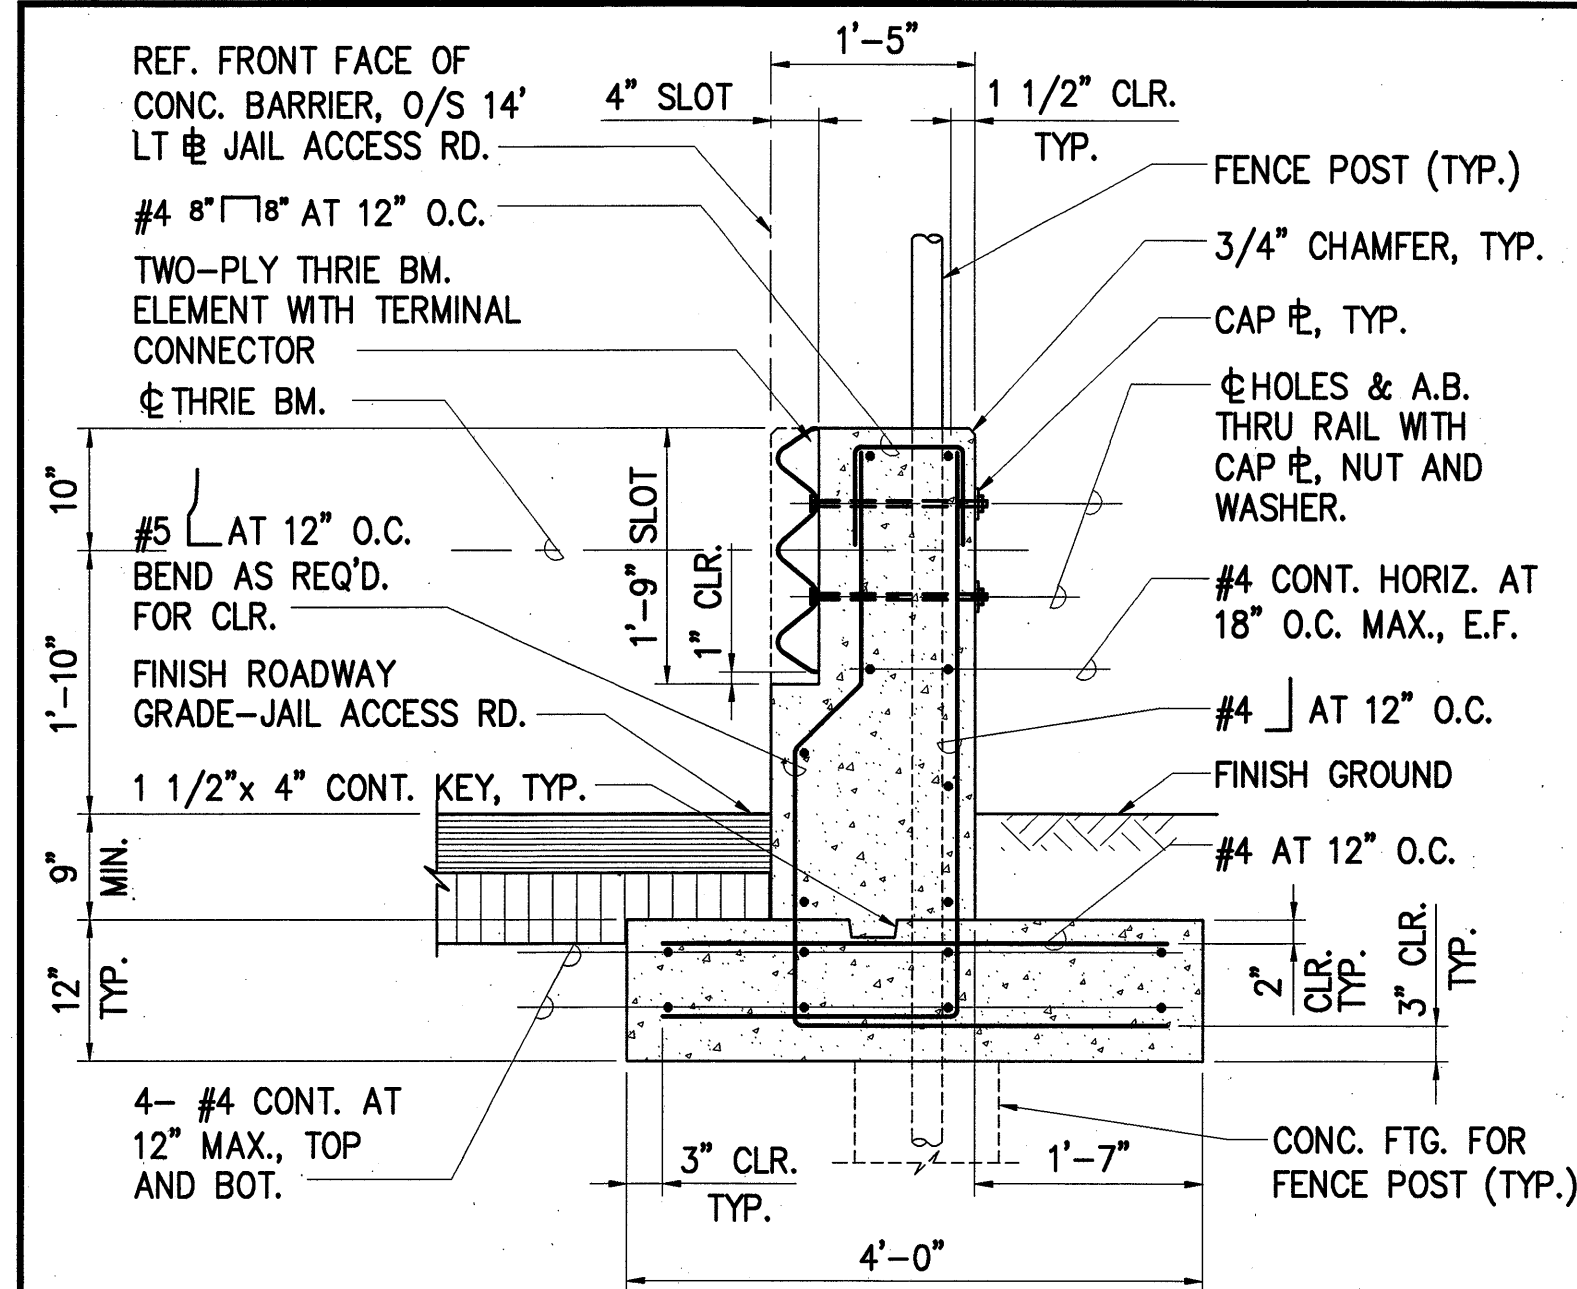


A **SECTION**
C16, C16A **C16A** SCALE: 3/4" = 1'-0"

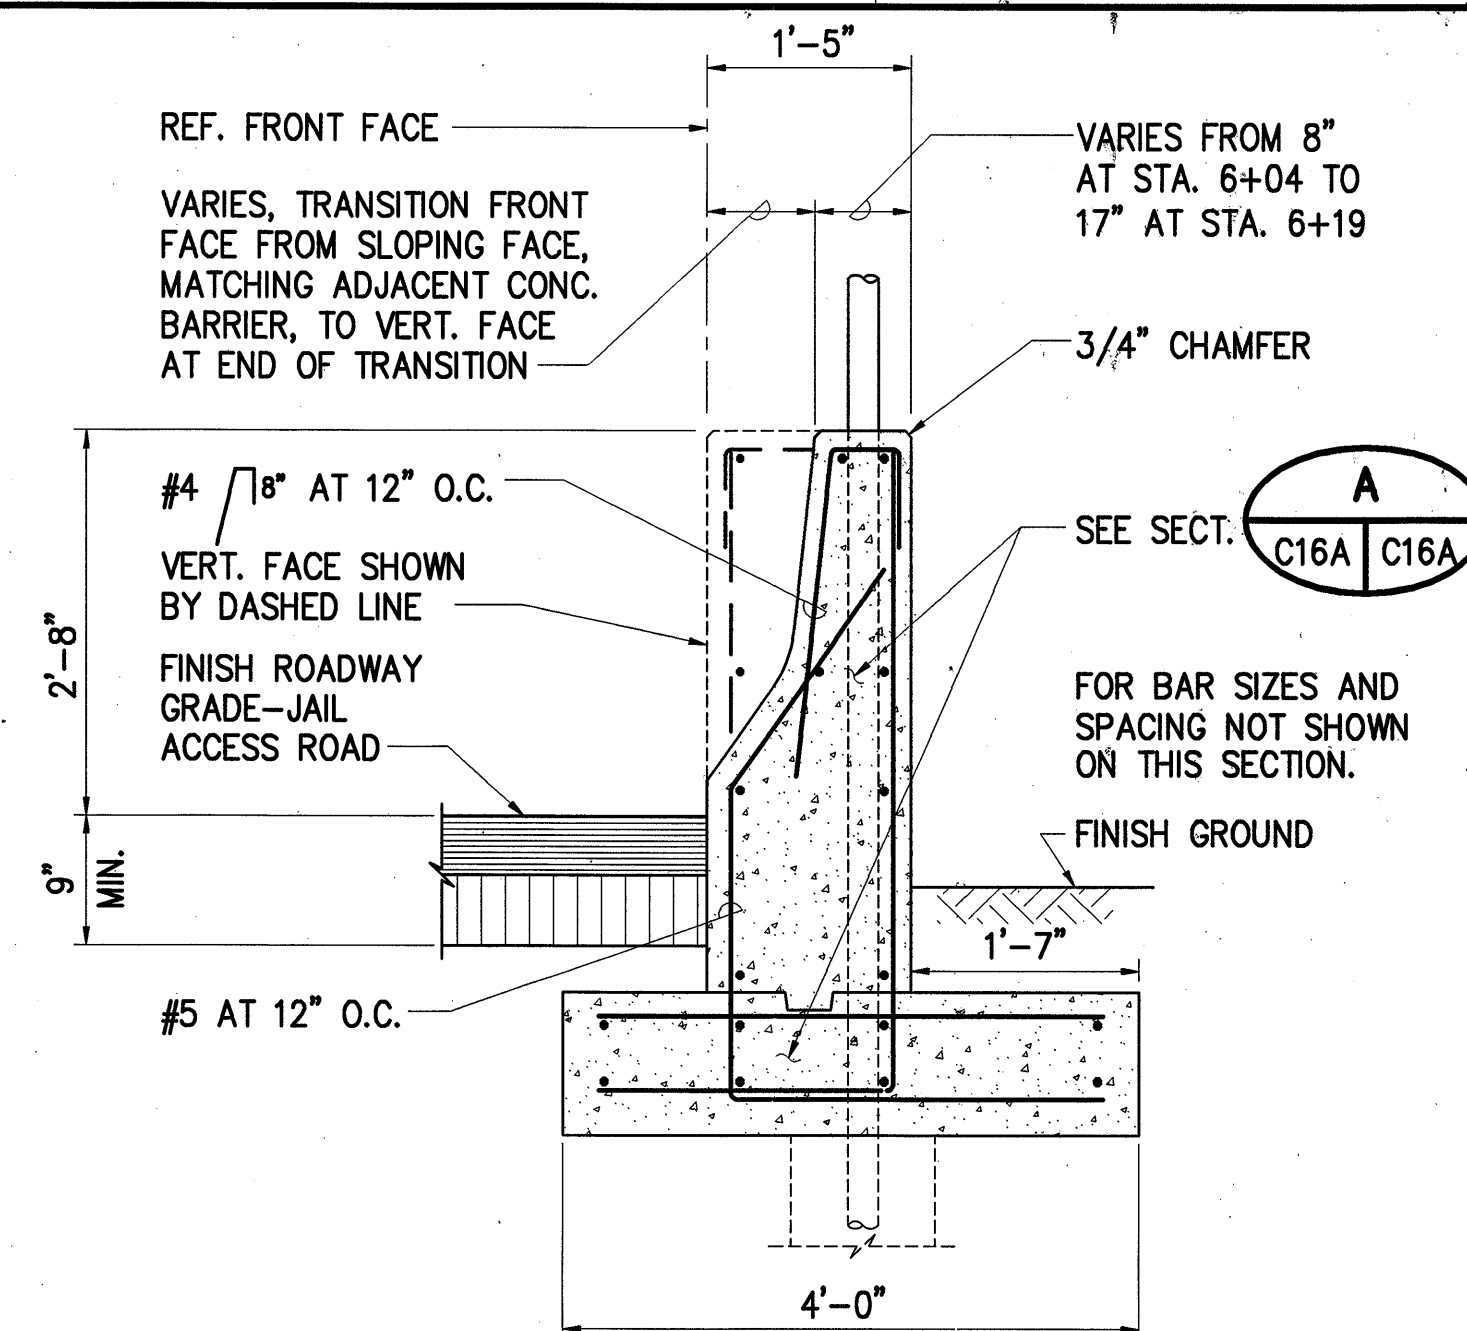


B SECTION
C16 C16A SCALE: 3/4" = 1'-0"

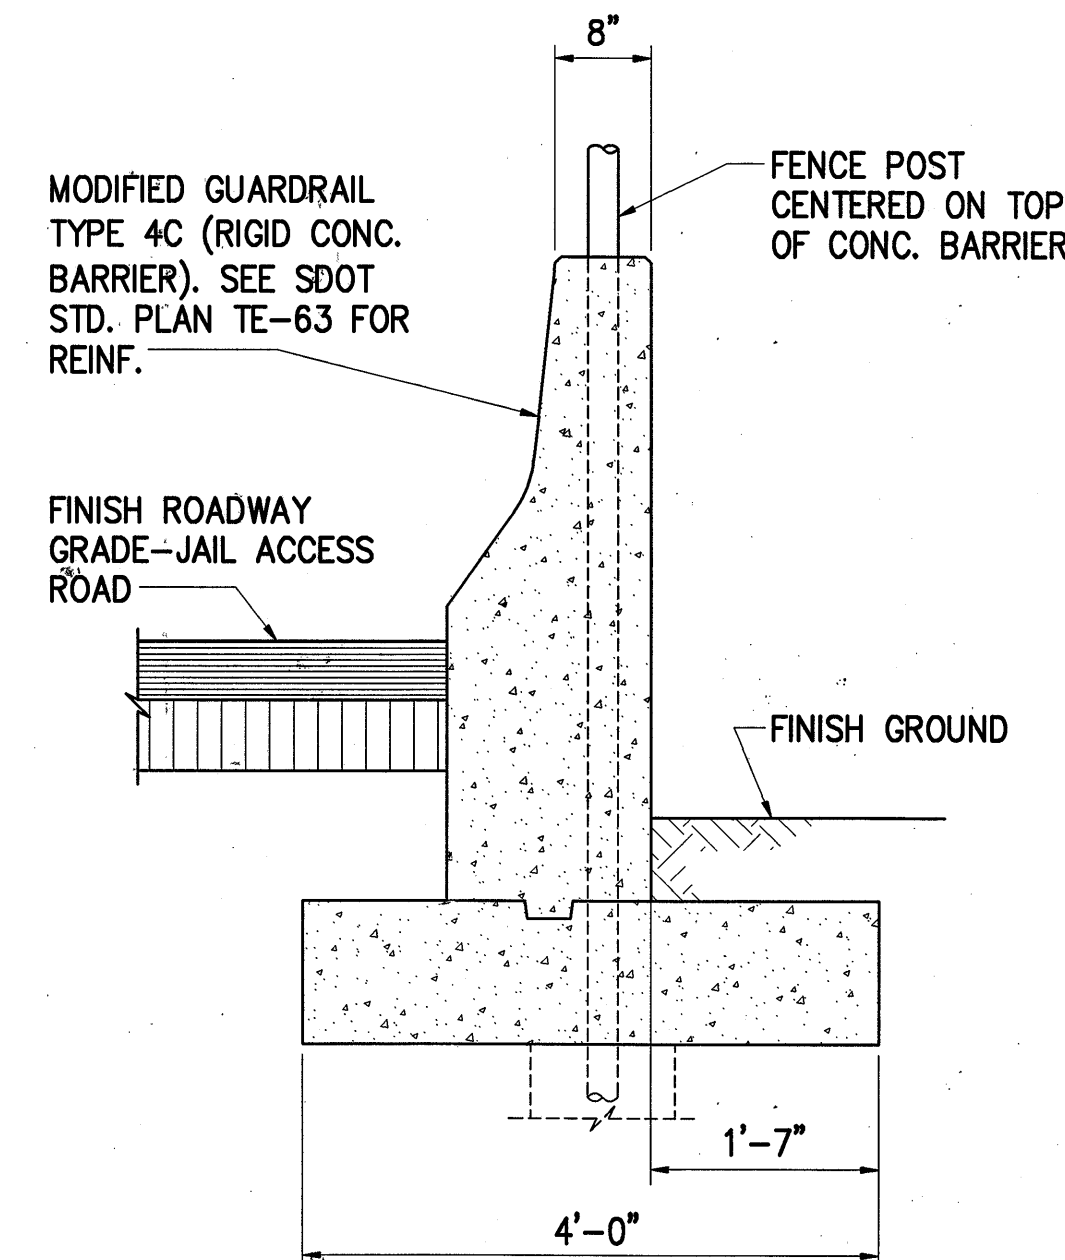


C **SECTION**
C16 | C16A SCALE: 3/4" = 1'-0"

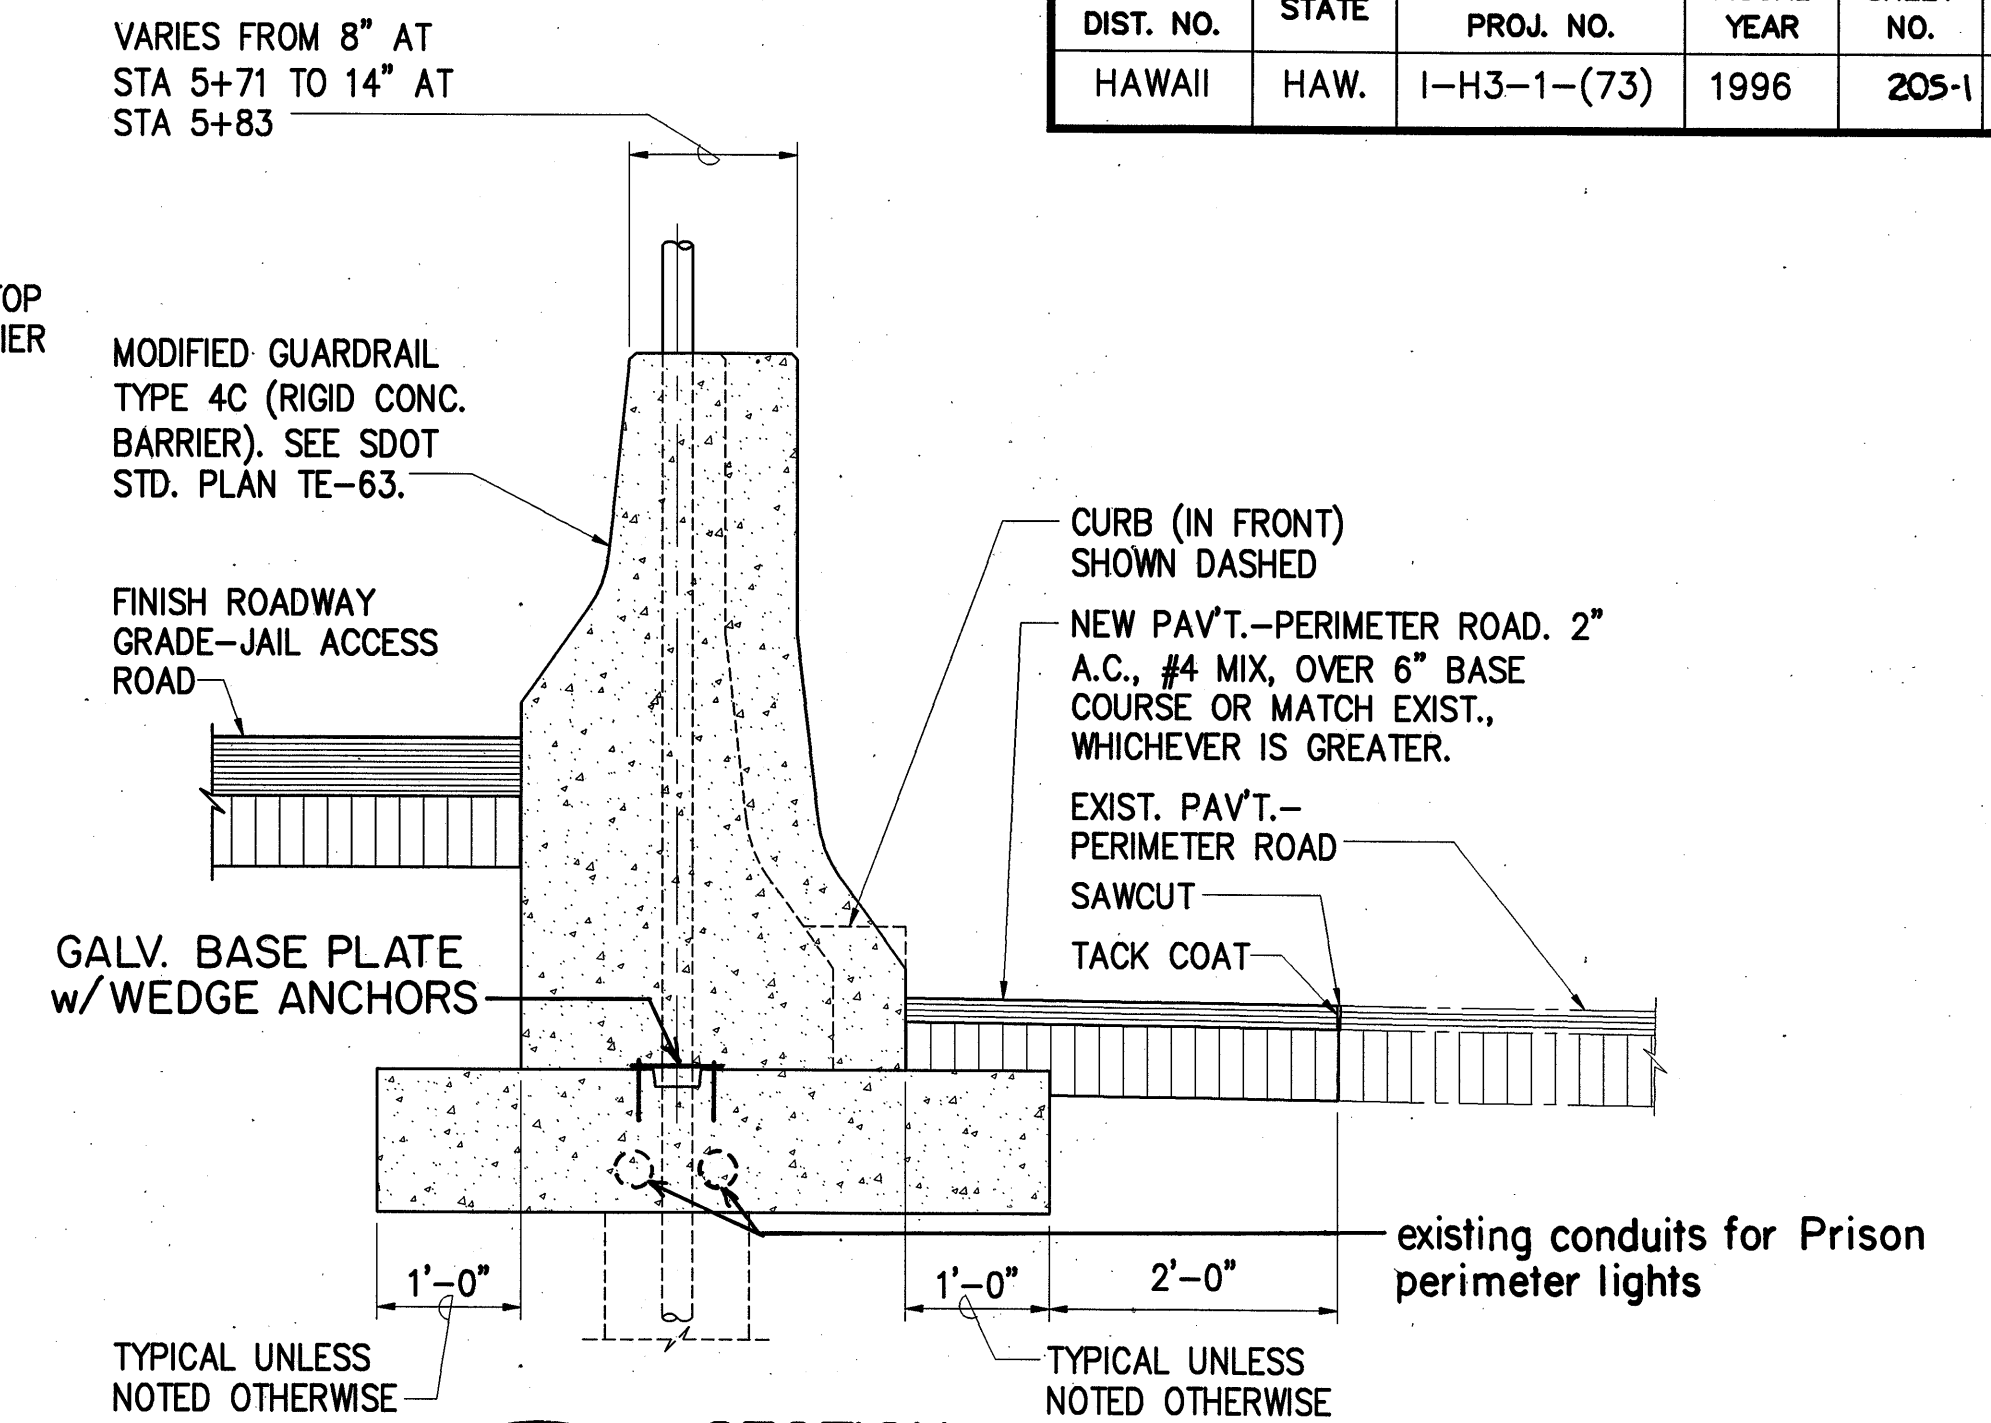


D SECTION
C16 | C16A SCALE: 3/4" = 1'-0"

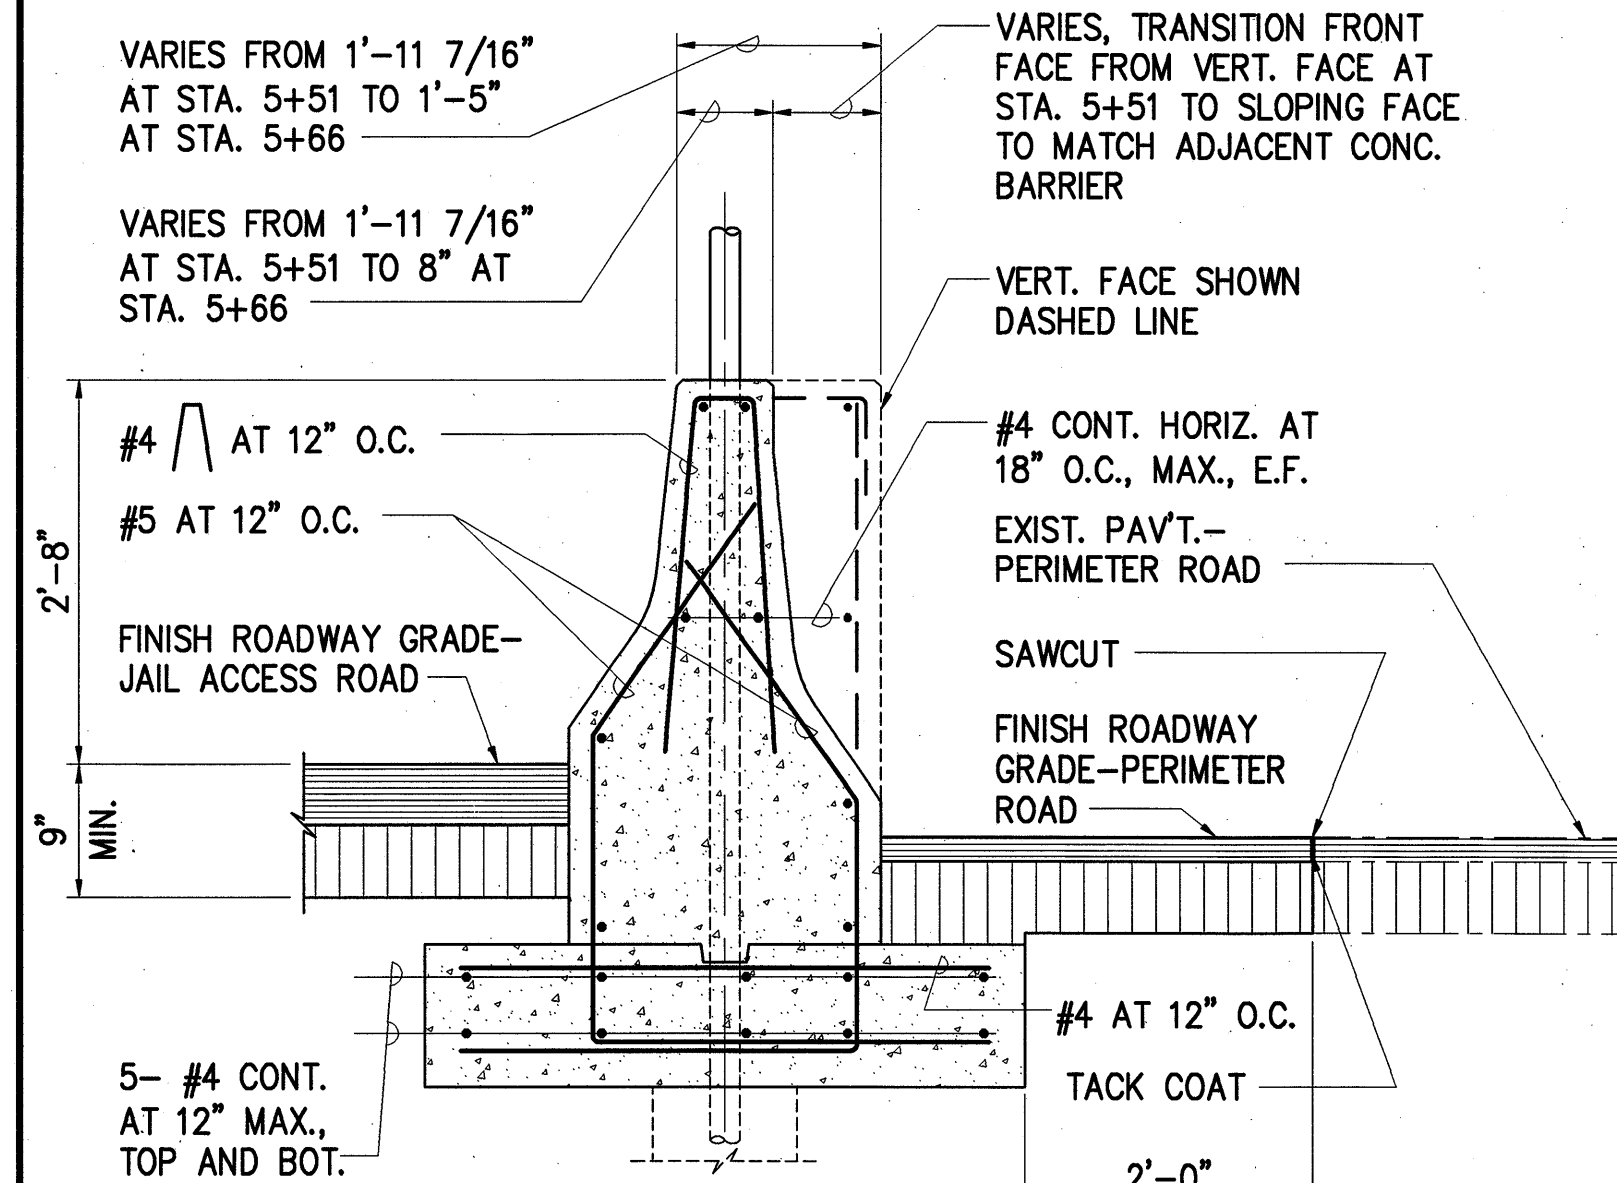


E
C16 | C16A

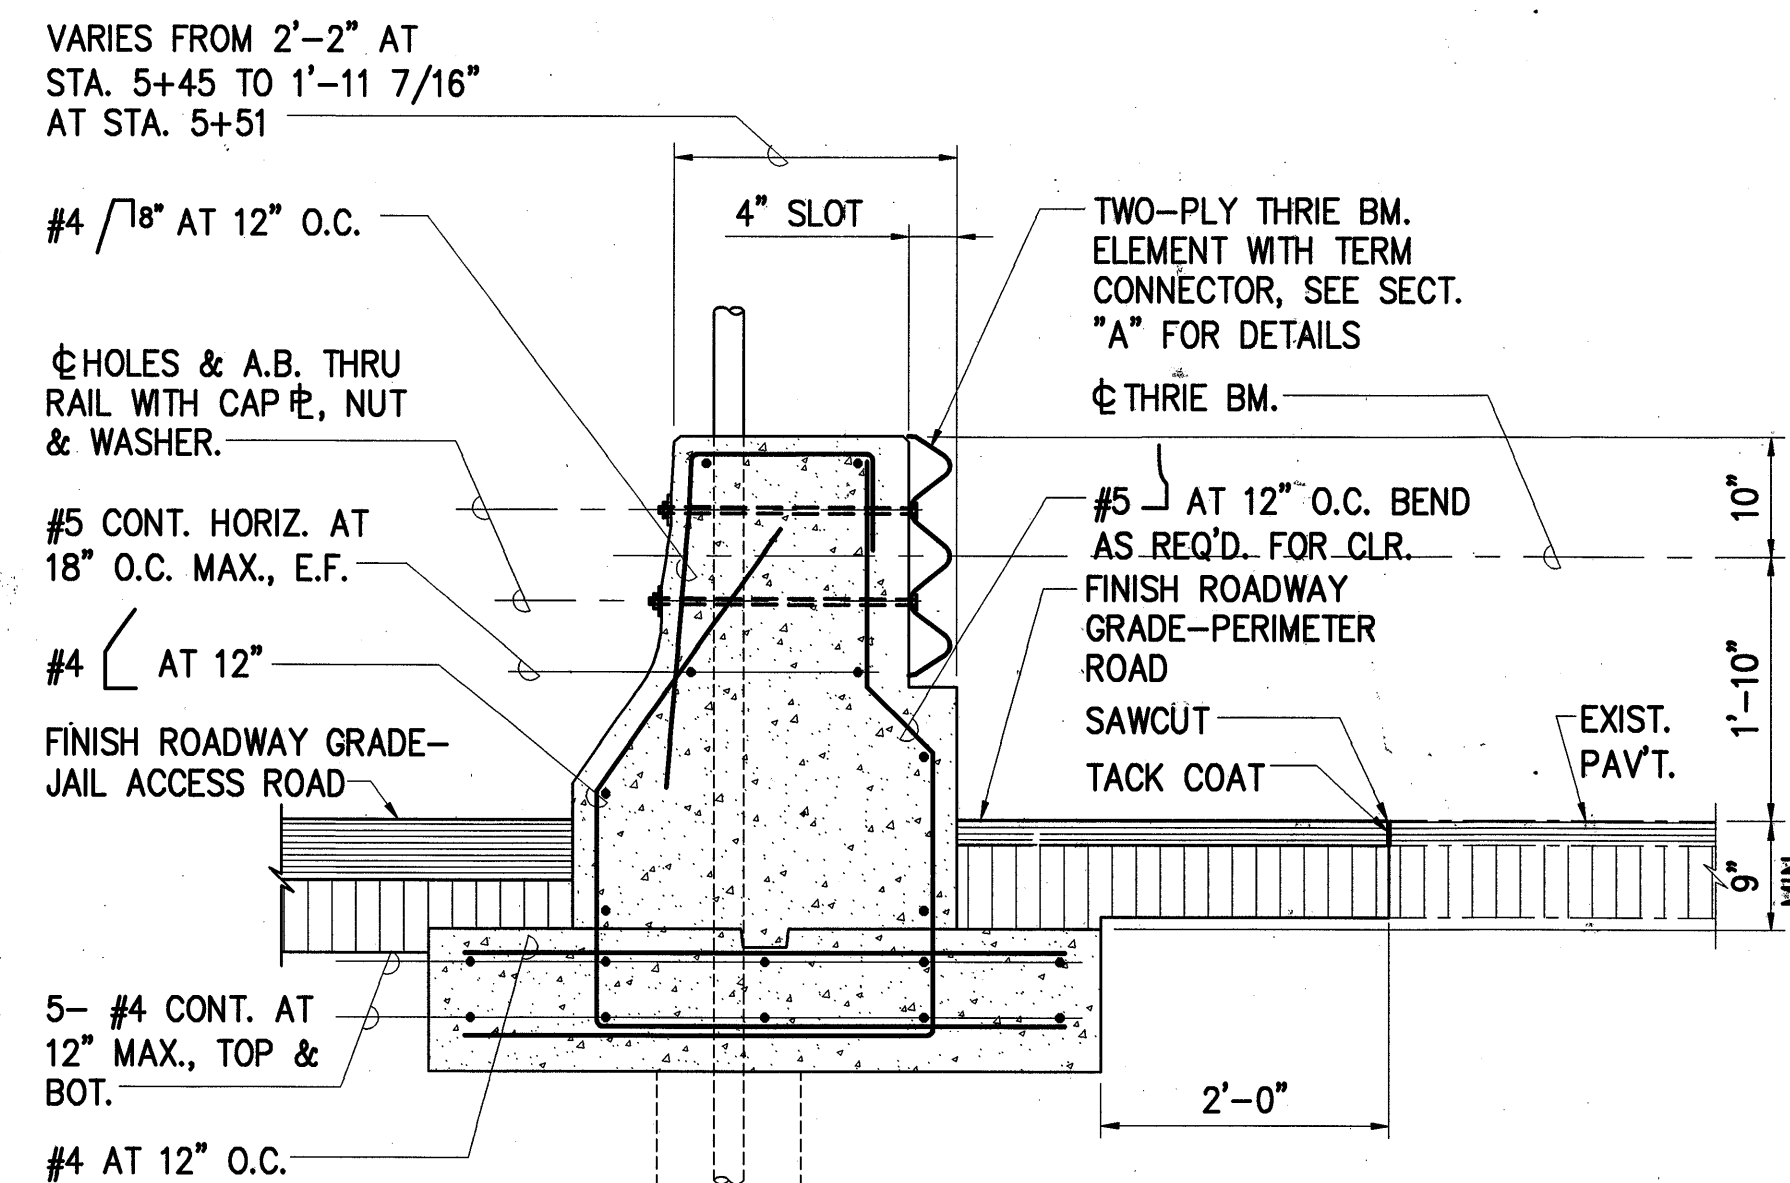

F **SECTION**
C16 C16A SCALE: $\frac{3}{4}" = 1'-0"$

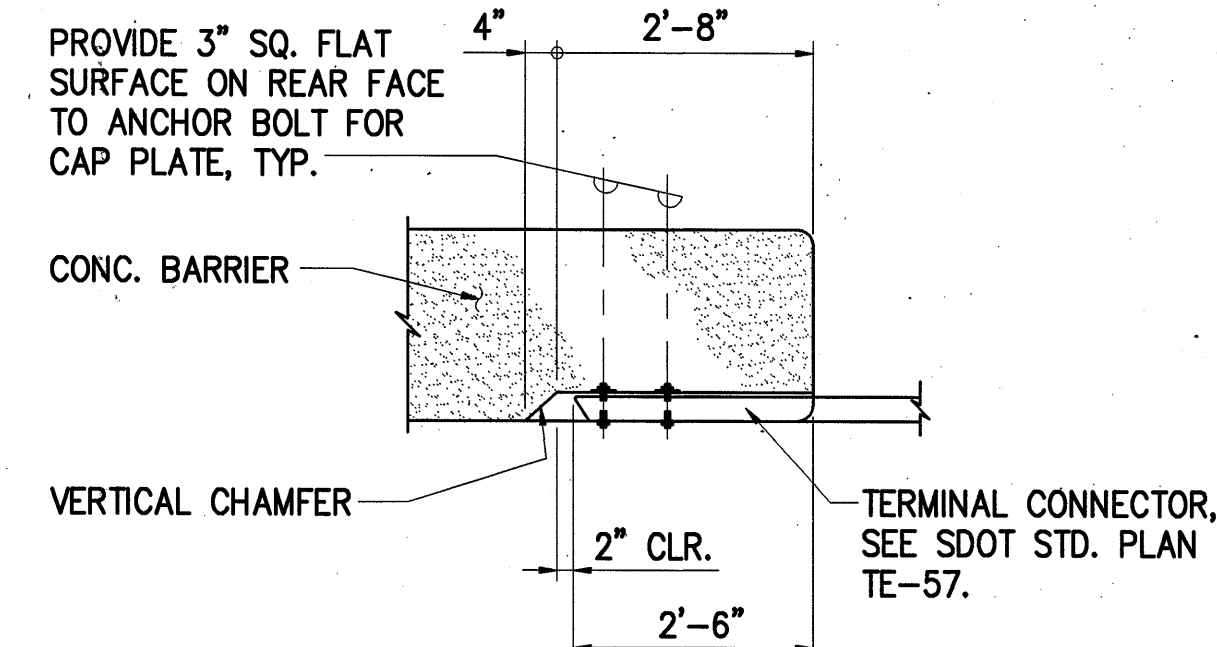


PLAN

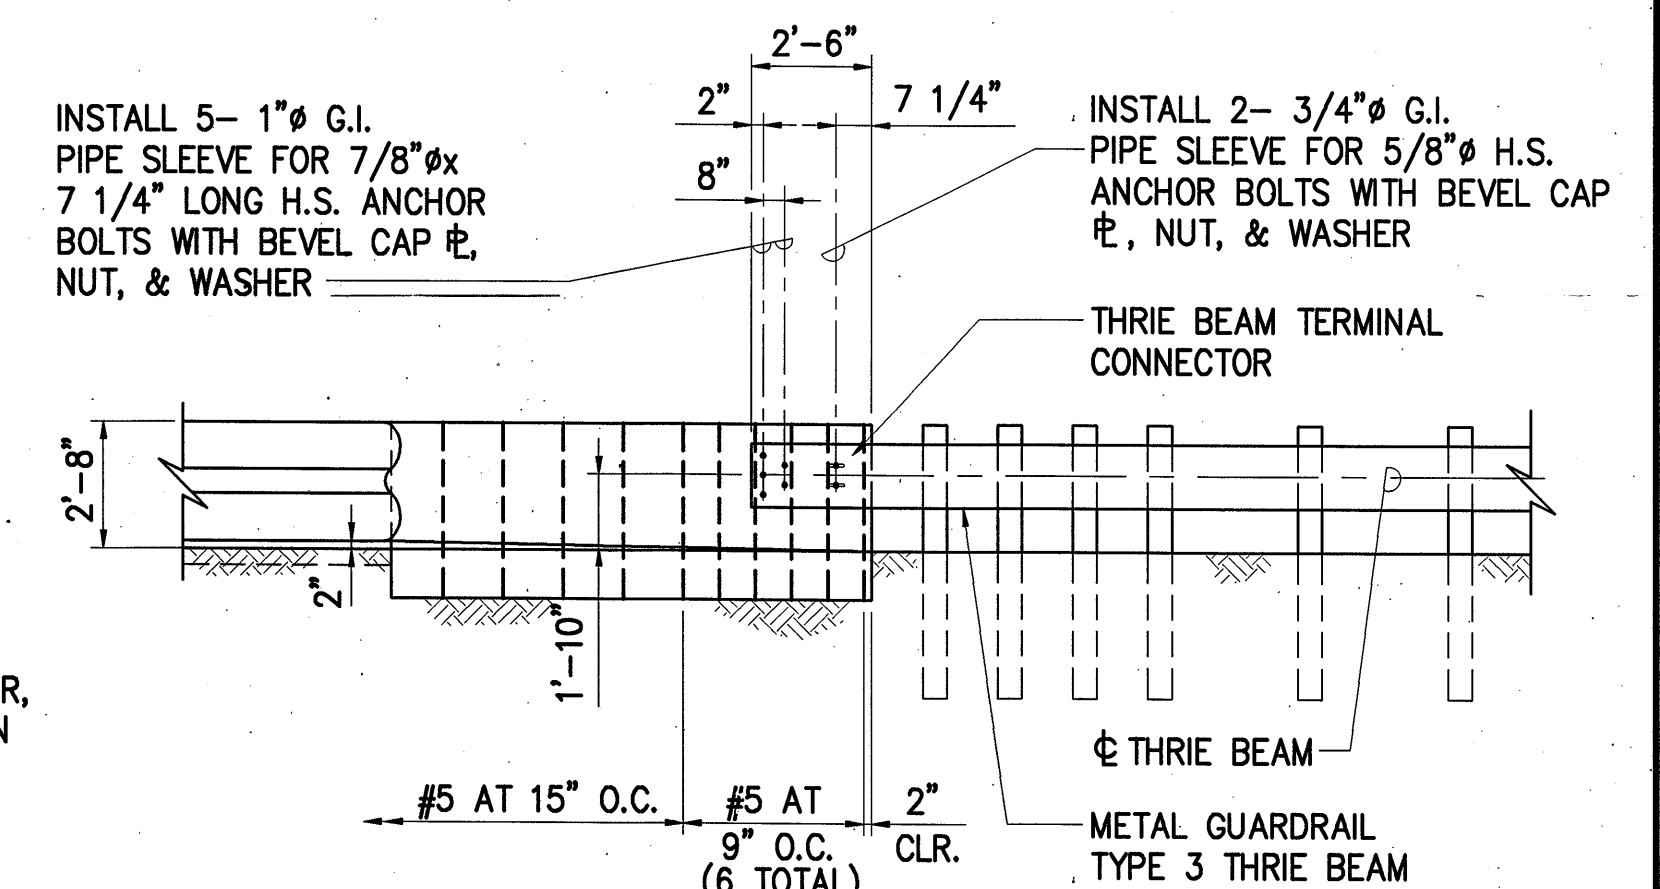


ELEVATION

NOTE:


FOR ANCHORING METAL GUARDRAIL ELEMENTS TO CONCRETE BARRIER, THE CONTRACTOR SHALL FURNISH AND INSTALL REINFORCING STEEL, BOLTS OF APPROPRIATE LENGTHS AND SIZE WITH APPURTENANT WASHERS, NUTS, WOODEN BLOCKS, PIPE SLEEVES, CAP PLATE, AND FURNISH LABOR, MATERIALS, TOOLS, EQUIPMENT, AND INCIDENTALS NECESSARY TO COMPLETE THE WORK.

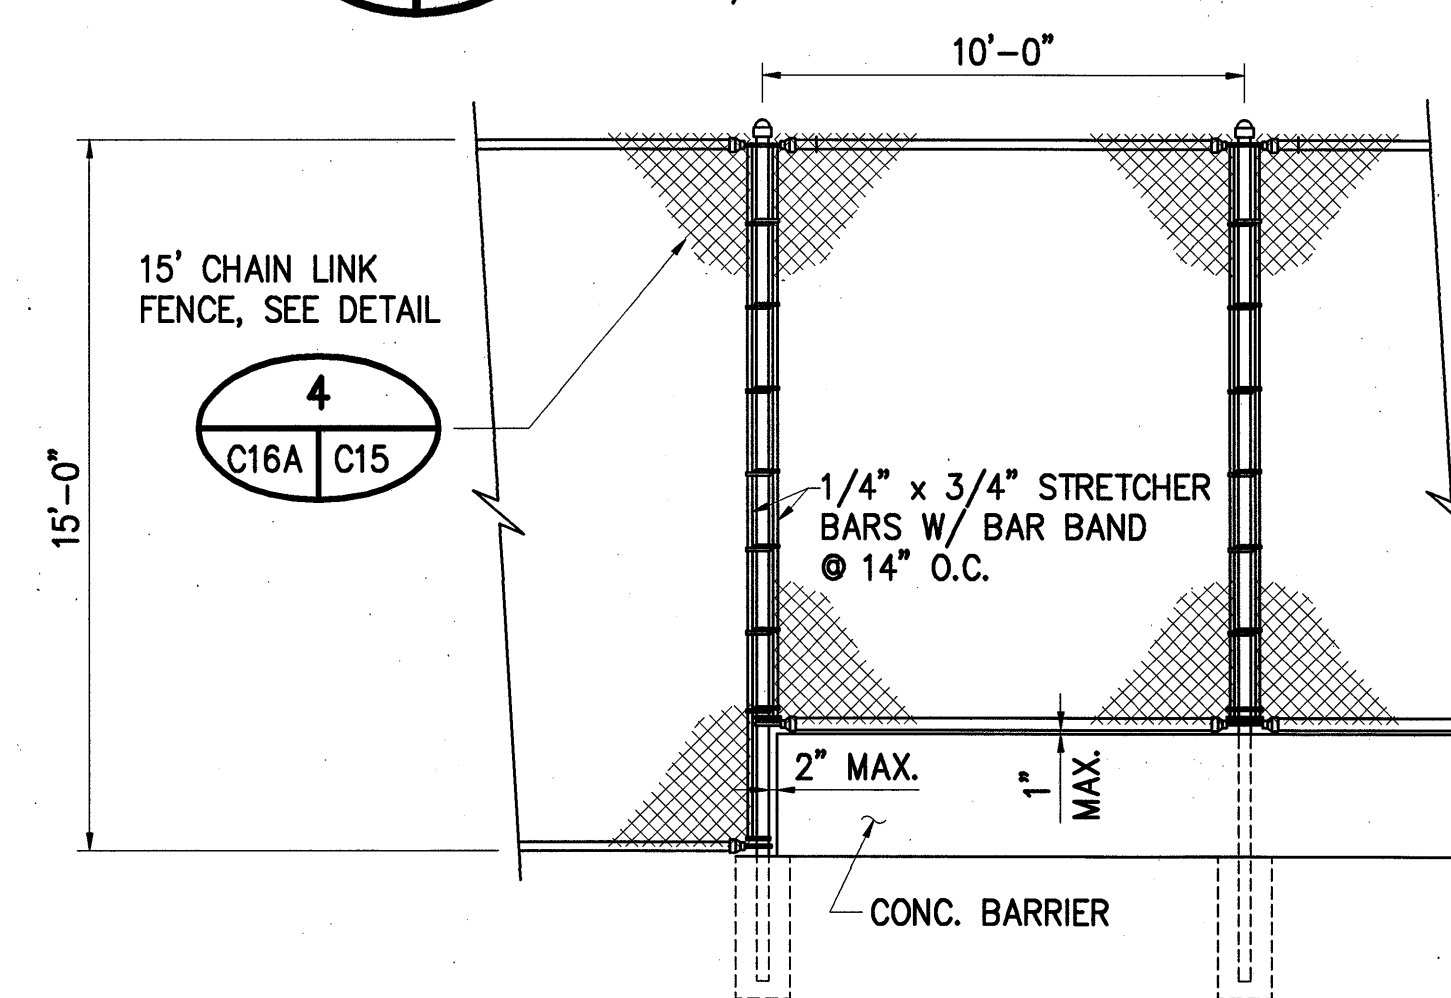

2 FENCE TRANSITION
C16 C16A NOT TO SCALE

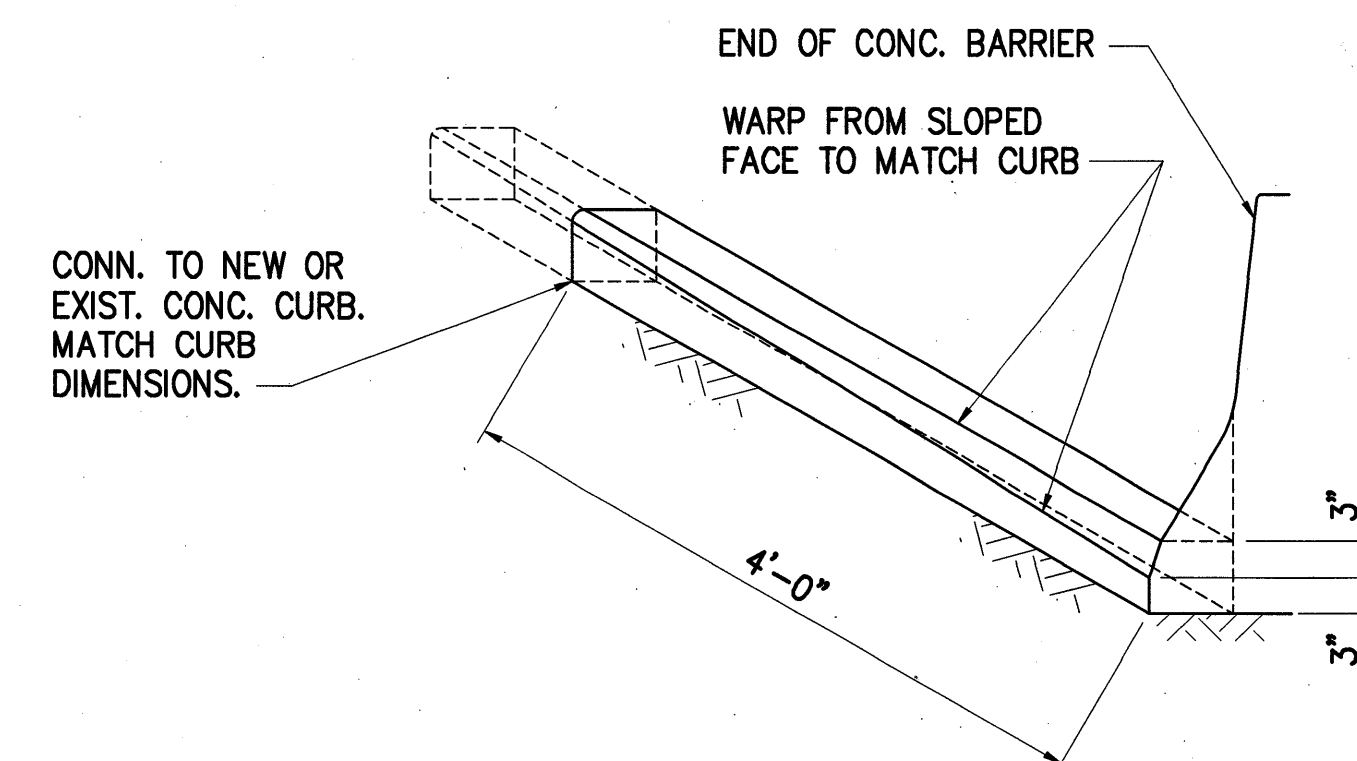



3 CURB TRANSITION DETAIL
C16 C16A SCALE: 3/4" = 1'-0"

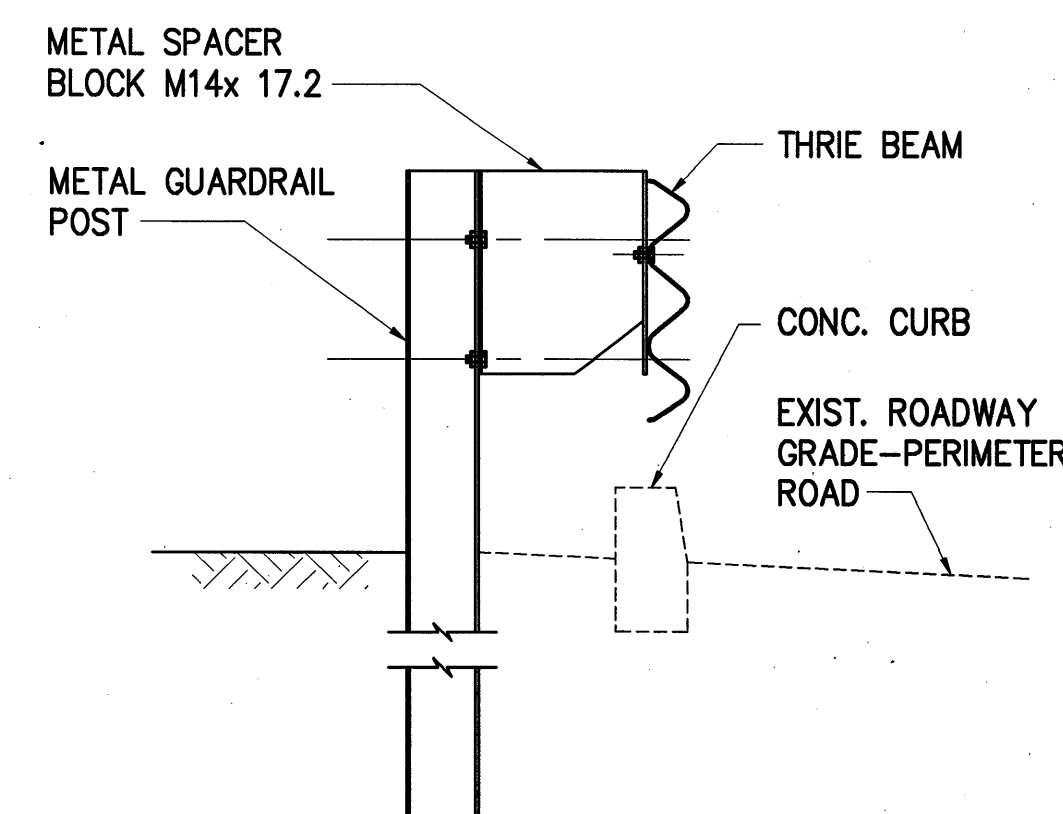

G SECTION
C16 C16A SCALE: 3/4" = 1'-0"

1 **CONNECT GUARDRAIL TO CONCRETE BARRIER**
C16 C16A NOT TO SCALE

MAR. 1997	NEW SHEET, REVISE BARRIER	
REVISION DATE	REVISION	BY

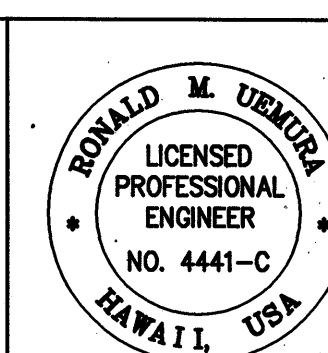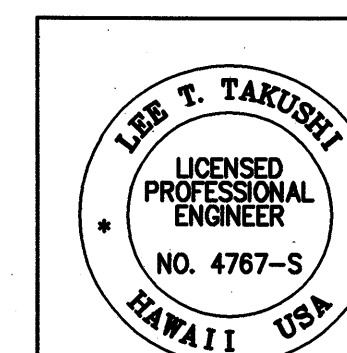

STATE OF HAWAII
DEPARTMENT OF TRANSPORTATION
HIGHWAYS DIVISION
HAWAII JAIL ACCESS ROAD
CONC. BARRIER-SECTIONS & DETAILS
INTERSTATE ROUTE H-3
F.A.I. PROJ. I-H3-1 (73)

Lee J. Tall
This work was prepared by
me or under my supervision

Spencer M. Usher
This work was prepared by
me or under my supervision

SCALE: DATE: APR. 1997

SHEET No.C16AOF 42 SHEETS

