
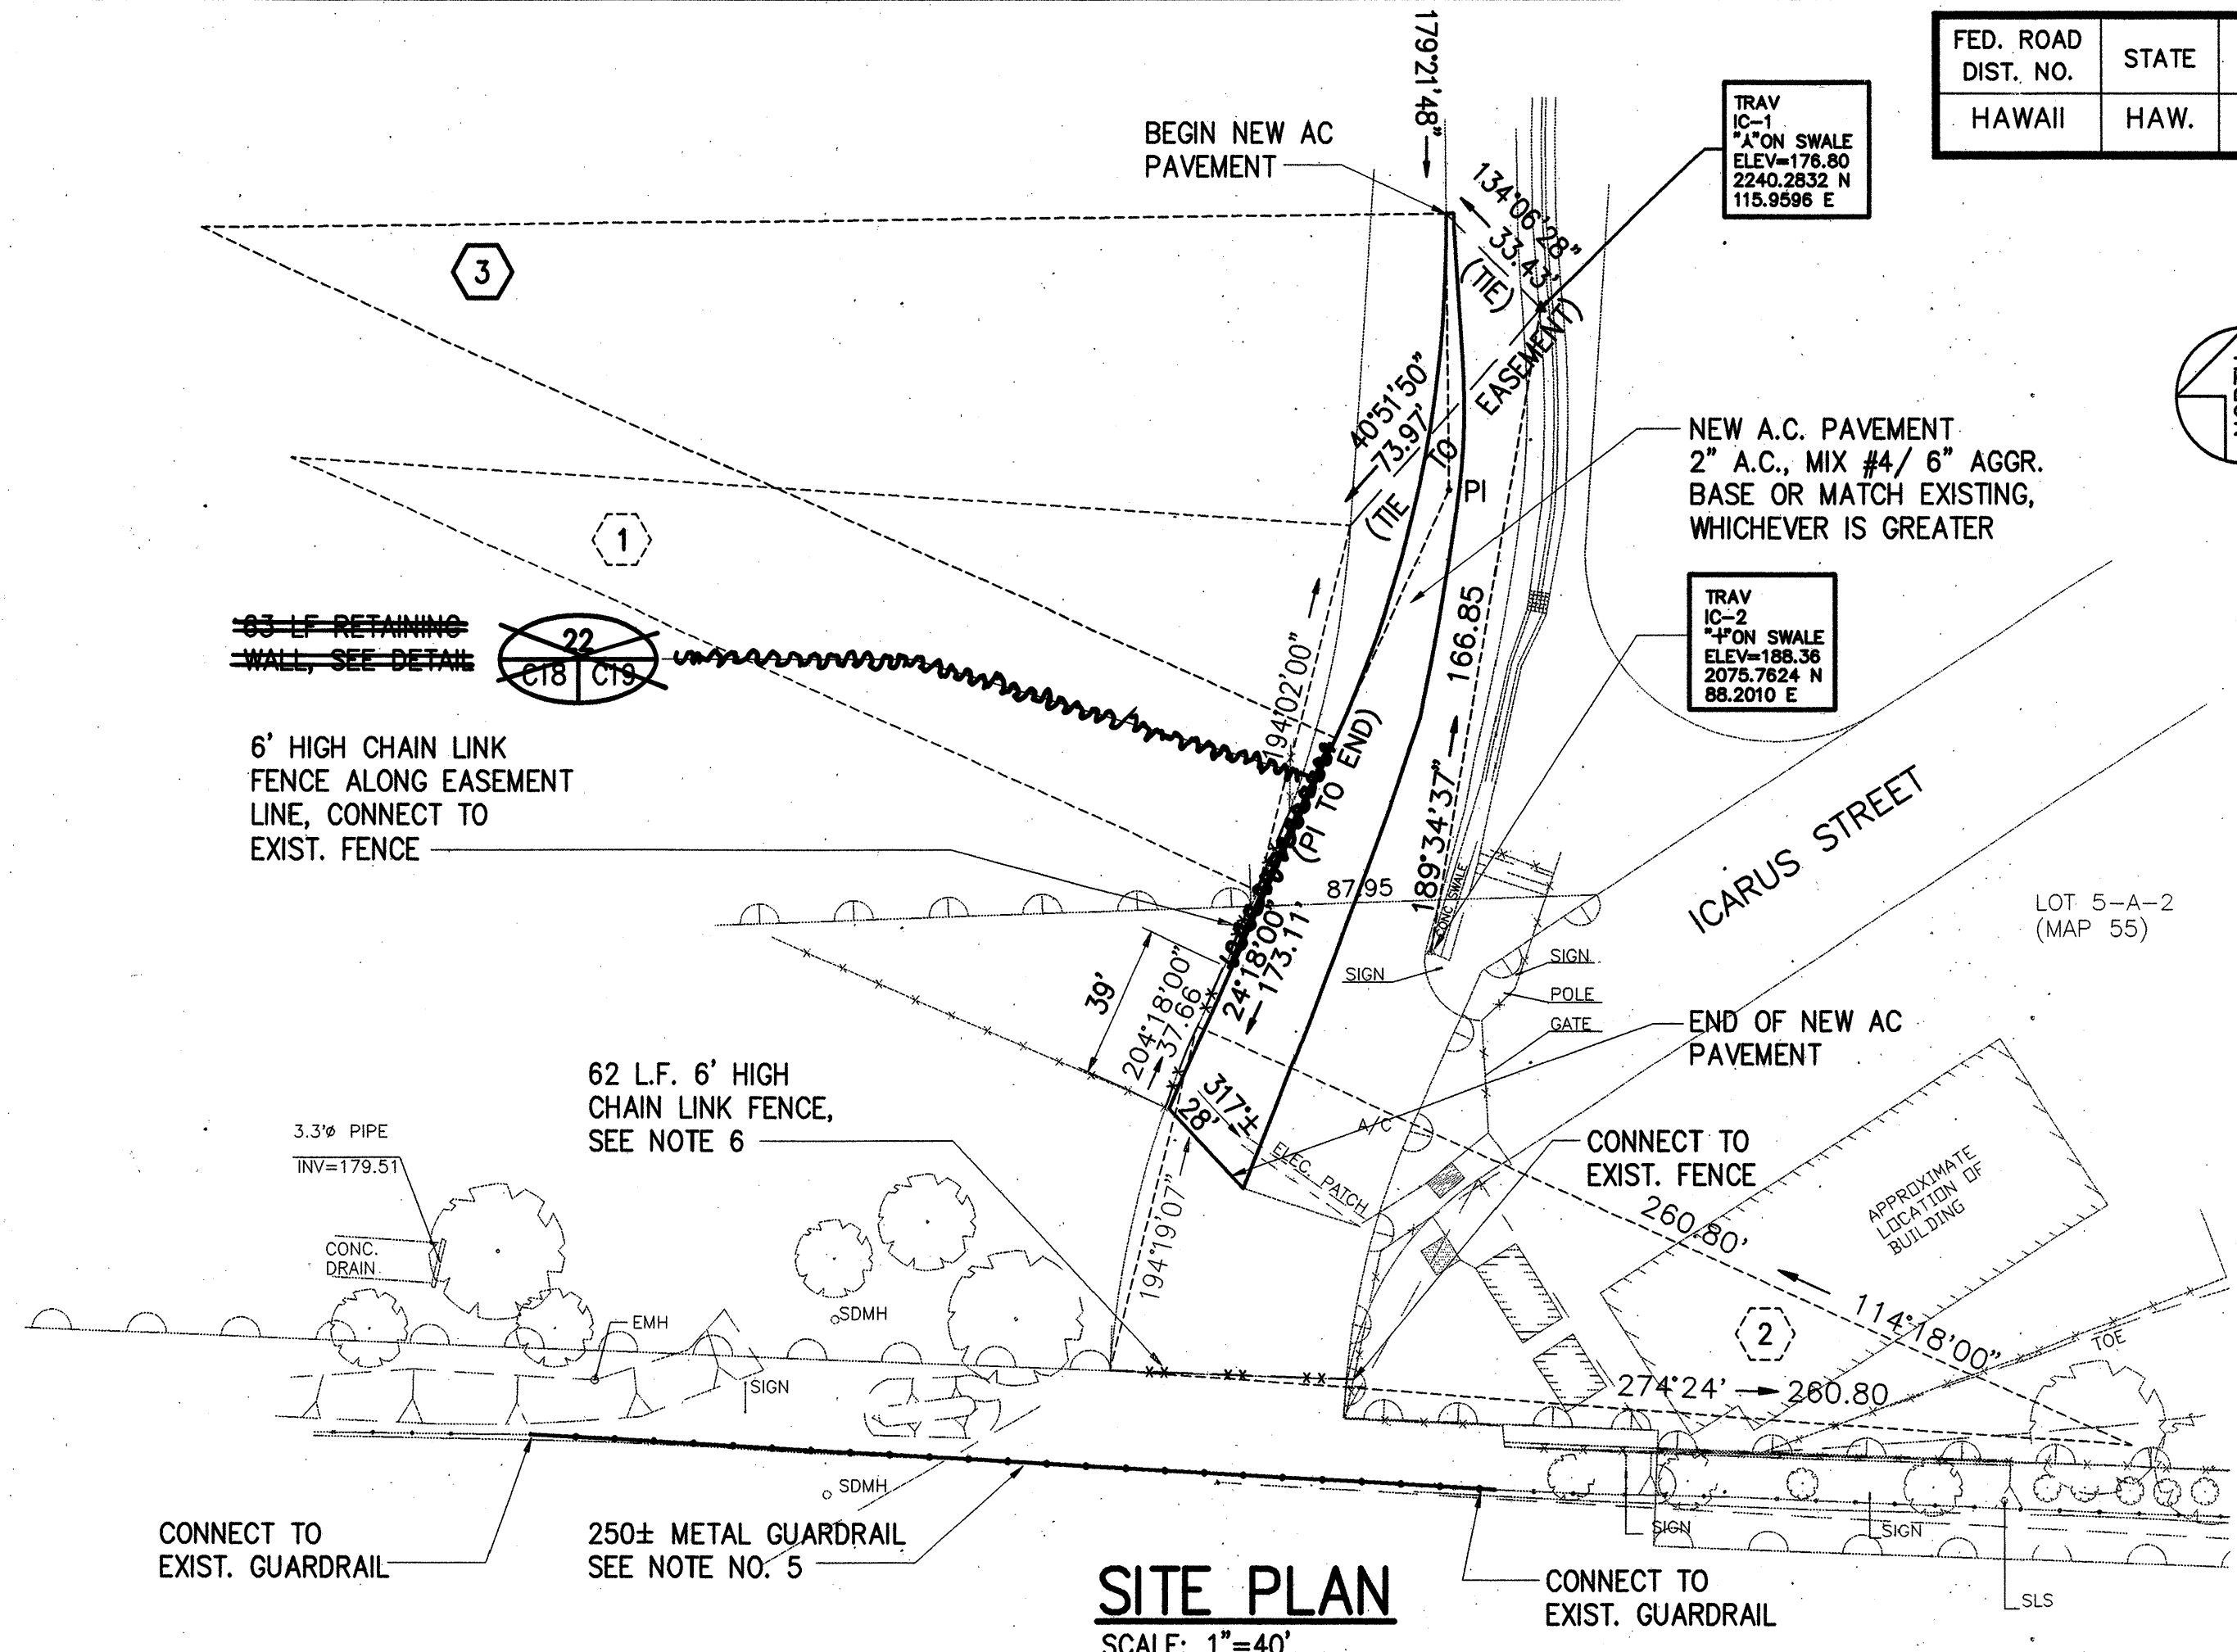


FED. ROAD DIST. NO.	STATE	FED. AID PROJ. NO.	FISCAL YEAR	SHEET NO.	TOTAL SHEETS
HAWAII	HAW.	I-H3-1-(73)	1996	39	42

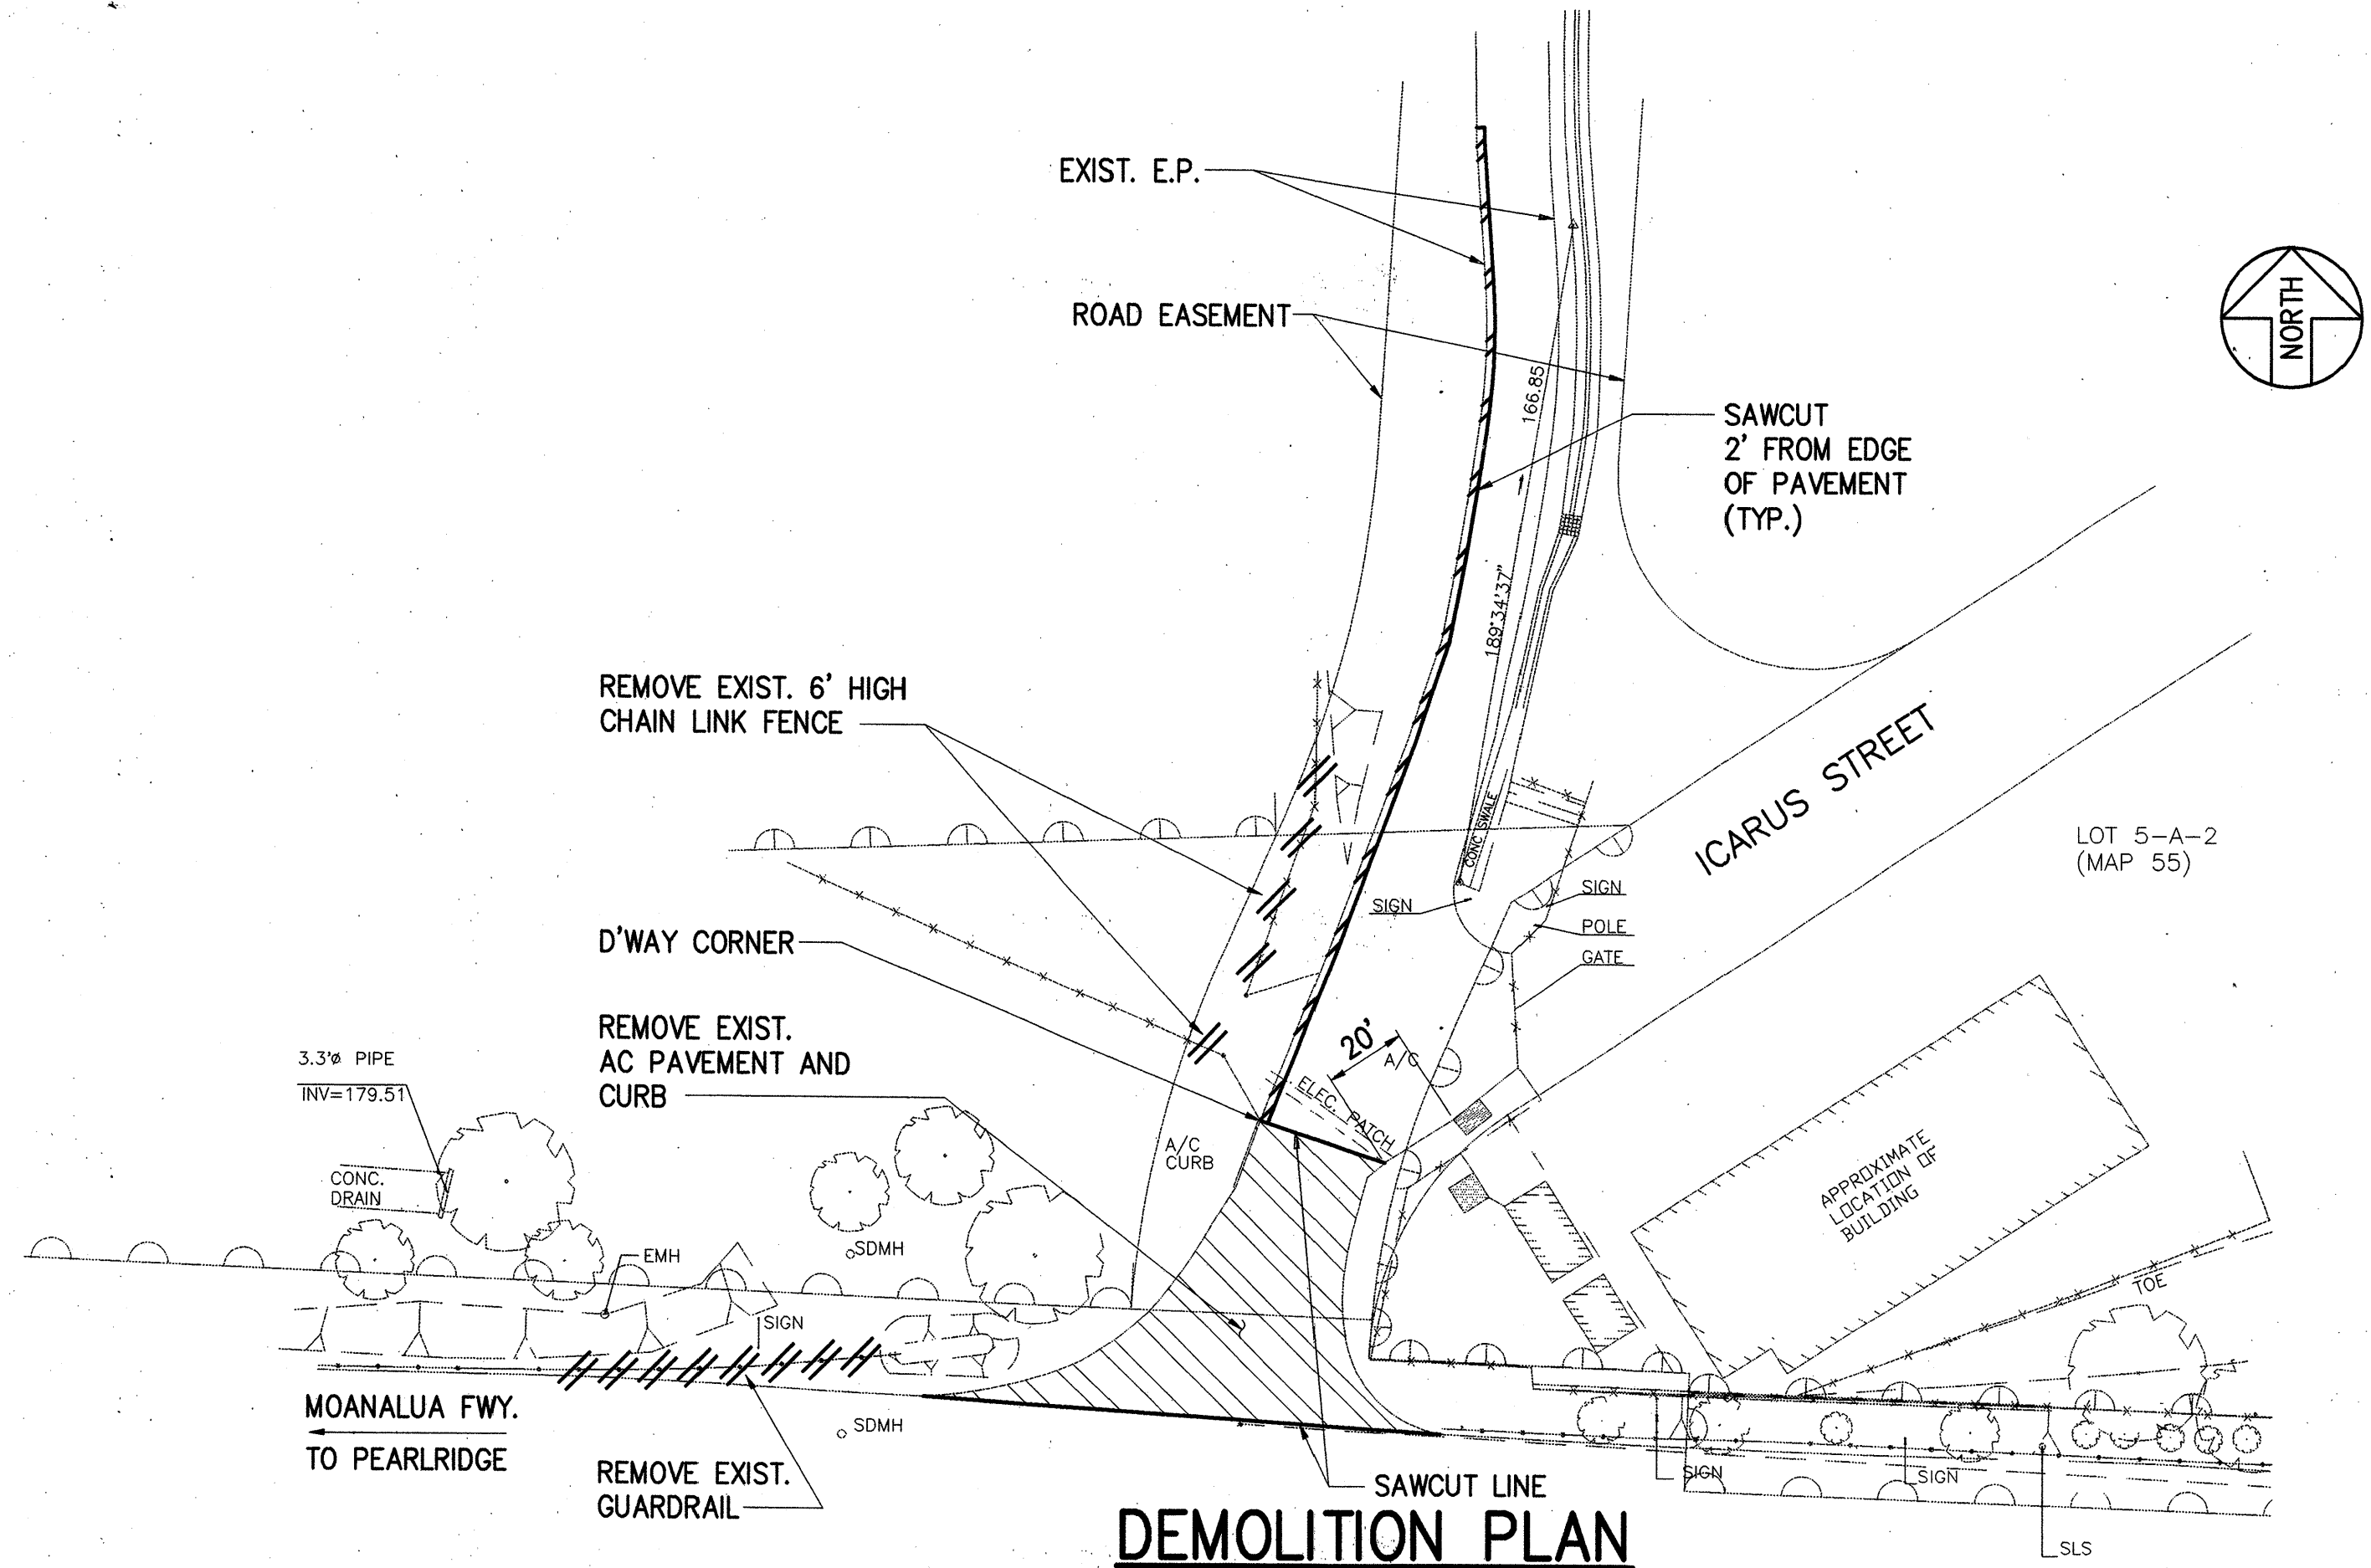


CURVE	Δ	Δ/2	R	T	L _c	Ch
1	11° 57' 20"	5° 58' 40"	270.00'	28.27'	56.34'	56.24'
2	19° 54' 00"	9° 57' 00"	260.80'	45.75'	90.58'	90.13'
3	24° 56' 12"	12° 28' 06"	316.58'	70.00'	137.78'	136.70'

EARTHWORK QUANTITIES	
GRADED AREA	0.04 AC.
EXCAVATION	1 CY
EMBANKMENT	4 CY

- NOTES:**
- WORK ON THE EXIT CLOSURE SHALL NOT COMMENCE UNTIL THE NEW JAIL ACCESS ROAD IS COMPLETE.
 - FOR LOCATION MAP. SEE SHEET 1.
 - FOR NEW SIGNING AND STRIPING, SEE SHEET C20.
 - FOR PAVEMENT CONNECTION, SEE DETAIL 17 C18/C17
 - FOR GUARDRAIL INSTALLATION DETAILS, SEE STATE OF HAWAII, DEPARTMENT OF TRANSPORTATION, STANDARD PLAN TE-50.
 - FOR CHAIN LINK FENCE INSTALLATION DETAILS, SEE SDOT STD PLAN D-01.

SSPM ENGINEERS, INC.
CONSULTING ENGINEERS
501 SUMNER STREET, SUITE 502
HONOLULU, HAWAII 96817

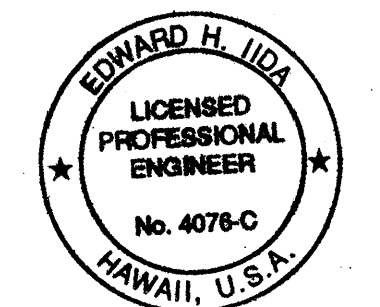


This work was prepared by me or under my supervision.

STATE OF HAWAII
DEPARTMENT OF TRANSPORTATION
HIGHWAYS DIVISION


HALAWA JAIL ACCESS ROAD
MOANALUA FWY EXIT CLOSURE
DEMOLITION, SITE & GRADING PLANS
INTERSTATE ROUTE H-3
F.A.I. PROJ. I-H3-1 (73)

SCALE: 1"=40' DATE: APR. 1996
SHEET No. C18 OF 42 SHEETS

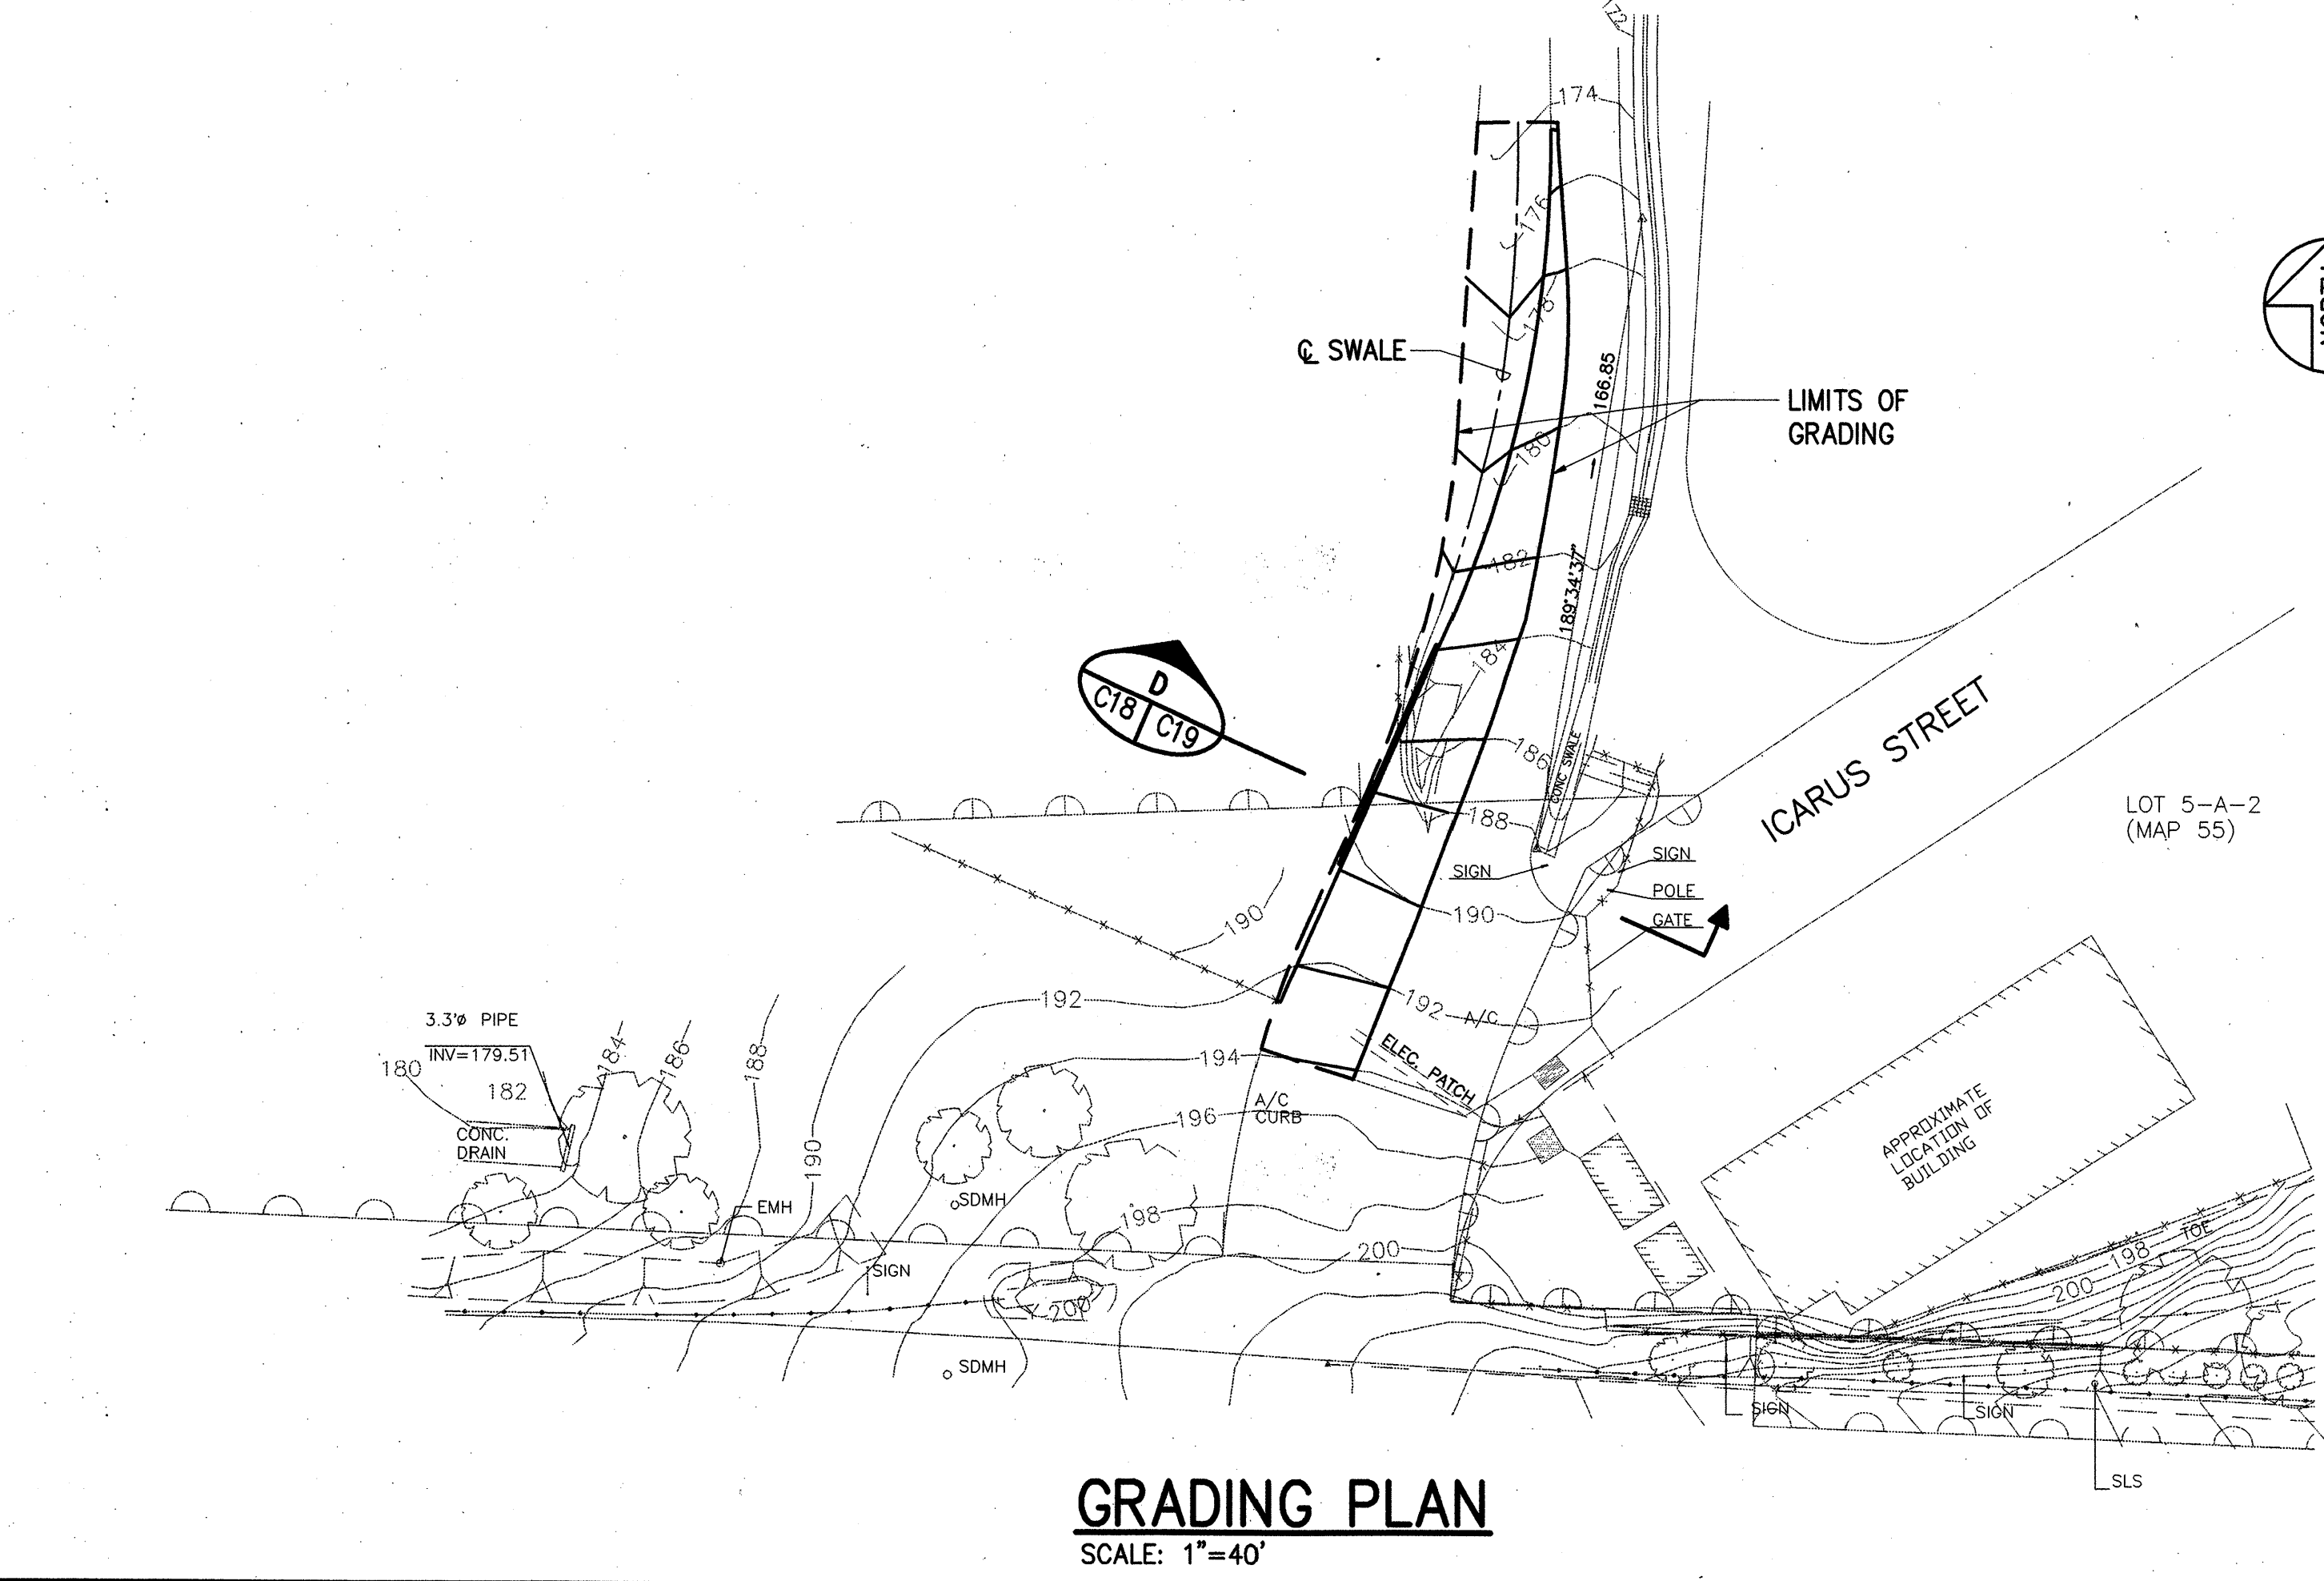


ORIGINAL PLAN	DATE
SURVEY PLOTTED BY	
DRAWN BY	
TRACED BY	
CHECKED BY	
NOTE BOOK	
QUANTITIES BY	
CHECKED BY	
No.	


FED. ROAD DIST. NO.	HAWAII	FED. AID PROJ. NO.	FISCAL YEAR	SHEET NO.	TOTAL SHEETS
HAWAII	HAW.	1-H3-1-(73)	1996	40	42

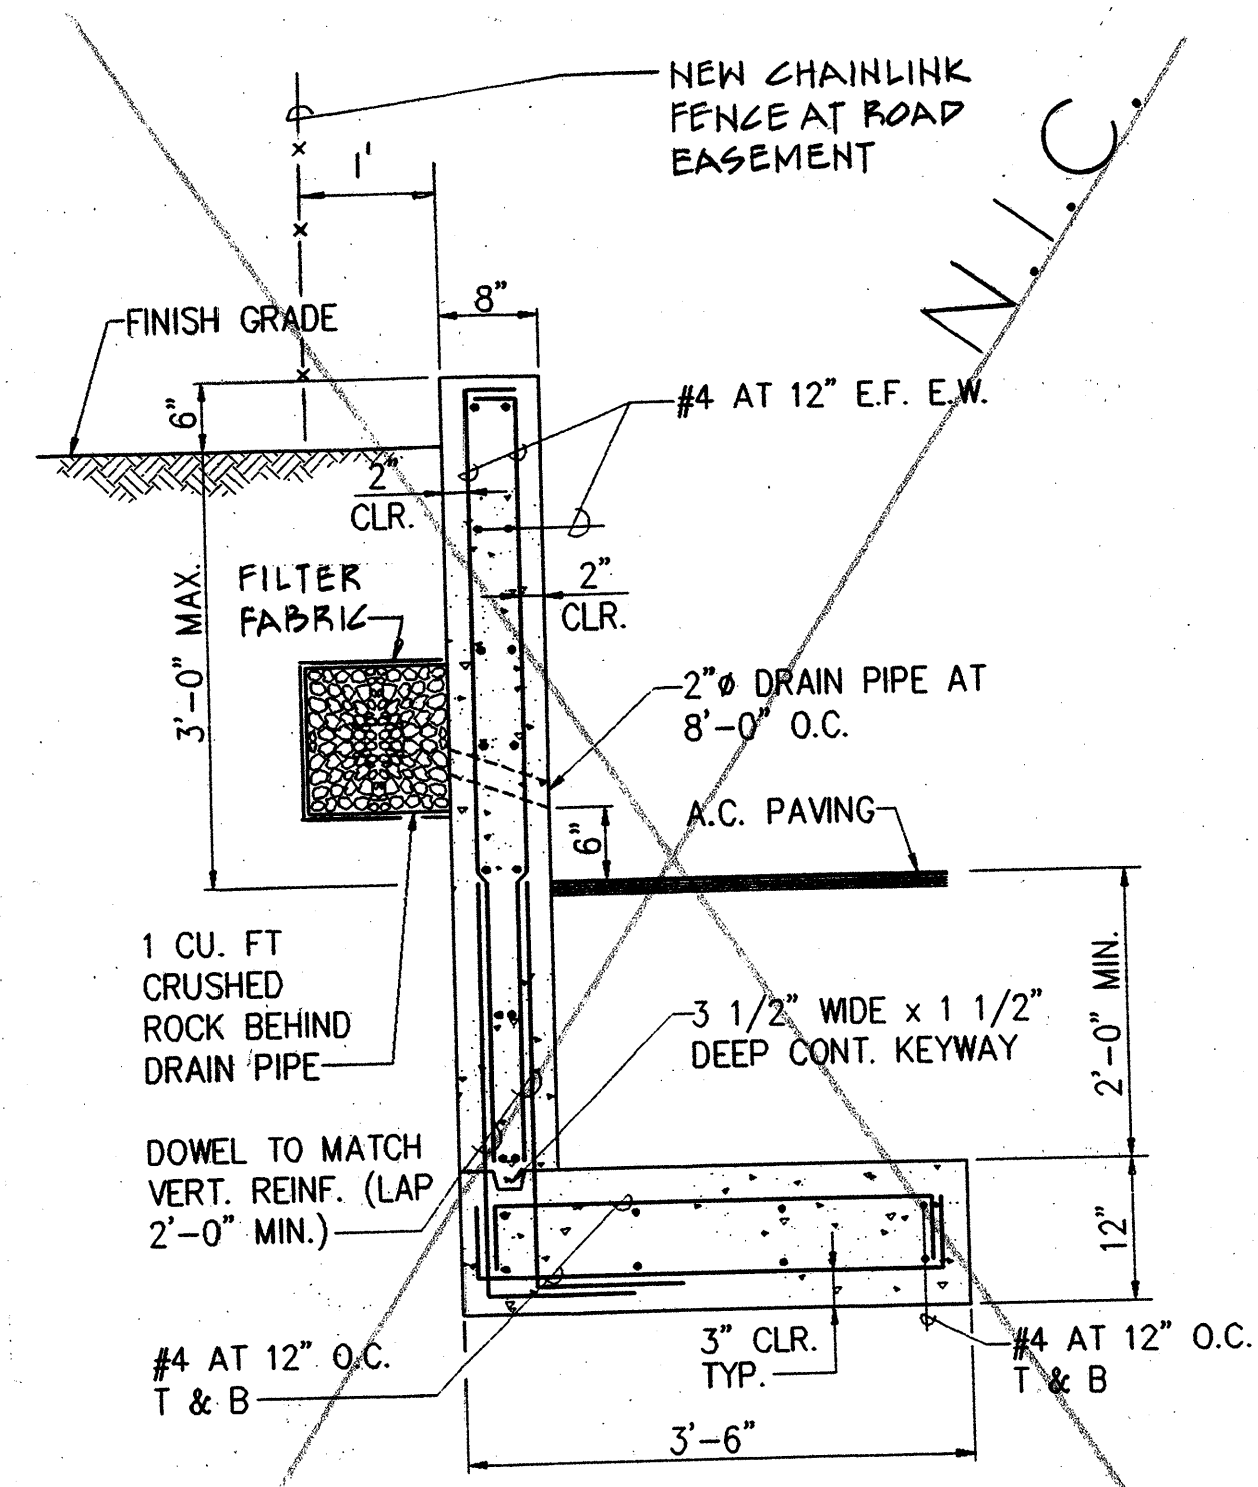

SECTION
RETAINING WALL DETAIL (22)
SCALE: 3/4"=1'-0" C18, C19

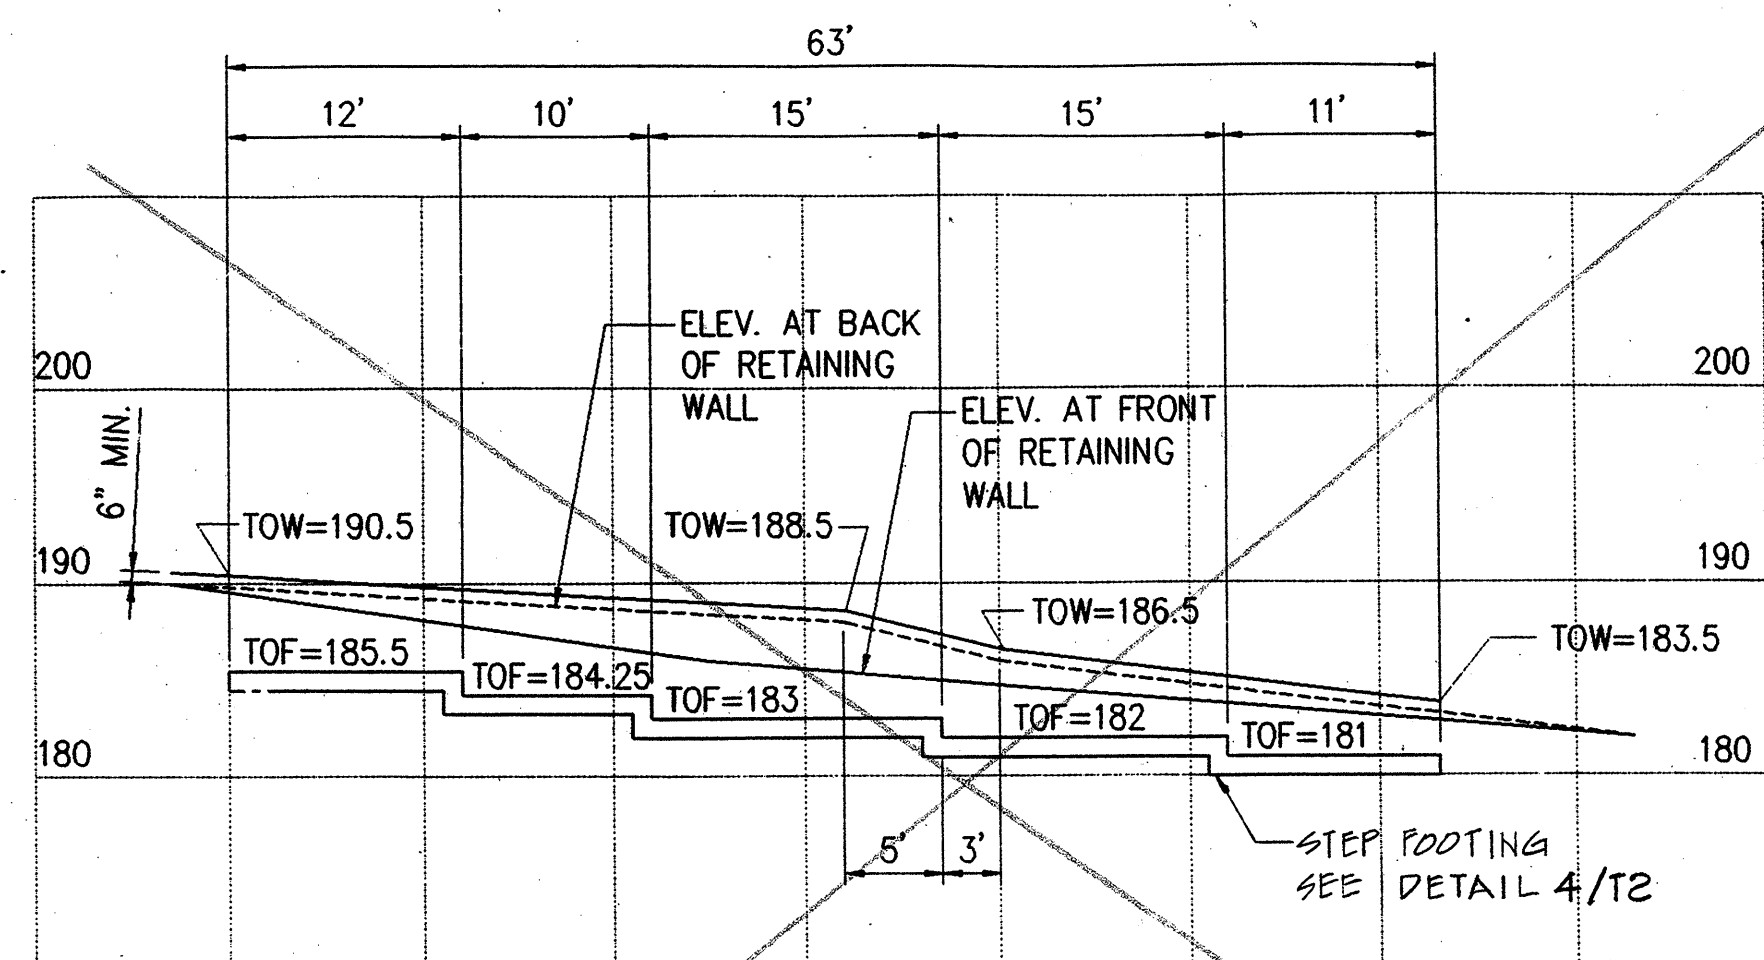


NEW RETAINING WALL ELEVATION
SCALE: 1"=10'

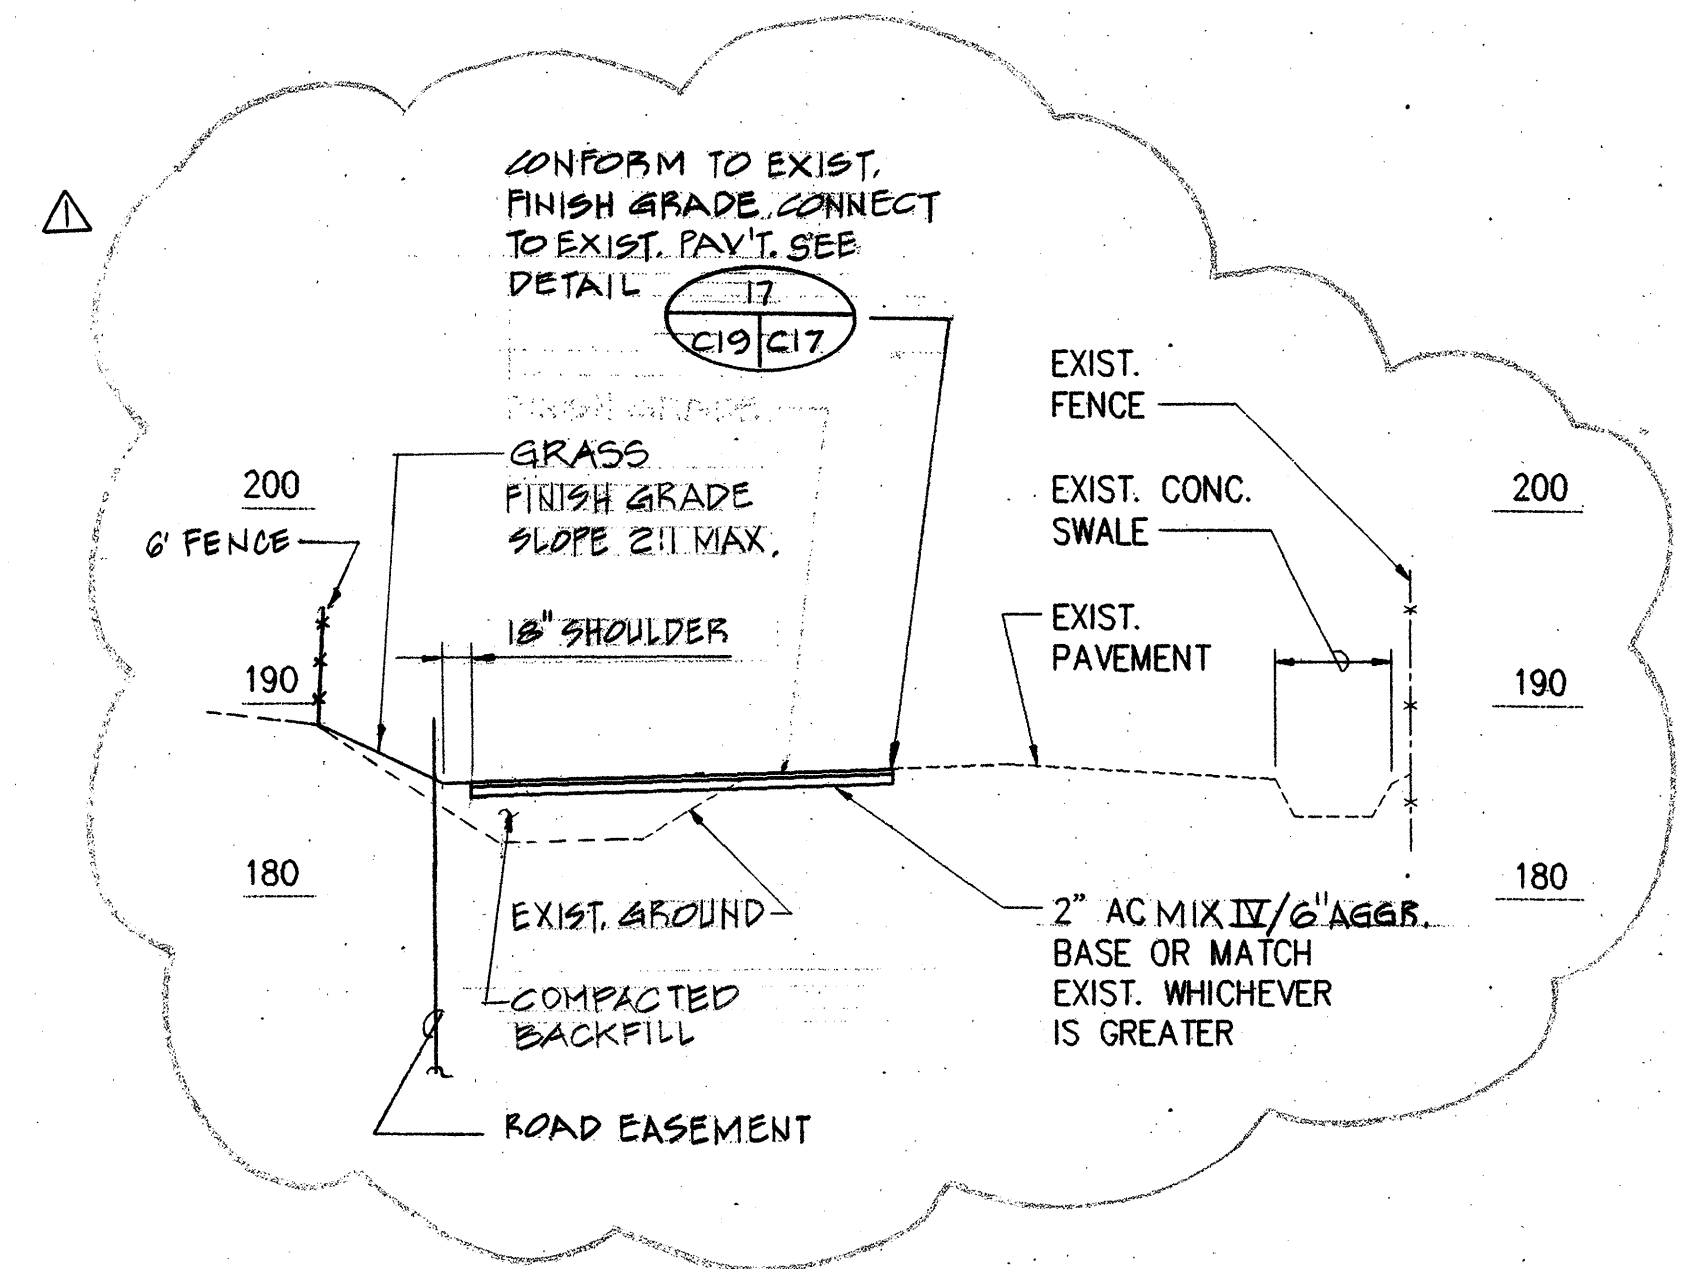

SECTION **D**
SCALE: 1"=10' C18/C19


NOTE:
GRASSING OF THE FINISH SLOPE WILL BE PAID FOR UNDER ITEM 639.0100, WATER POLLUTION CONTROL.

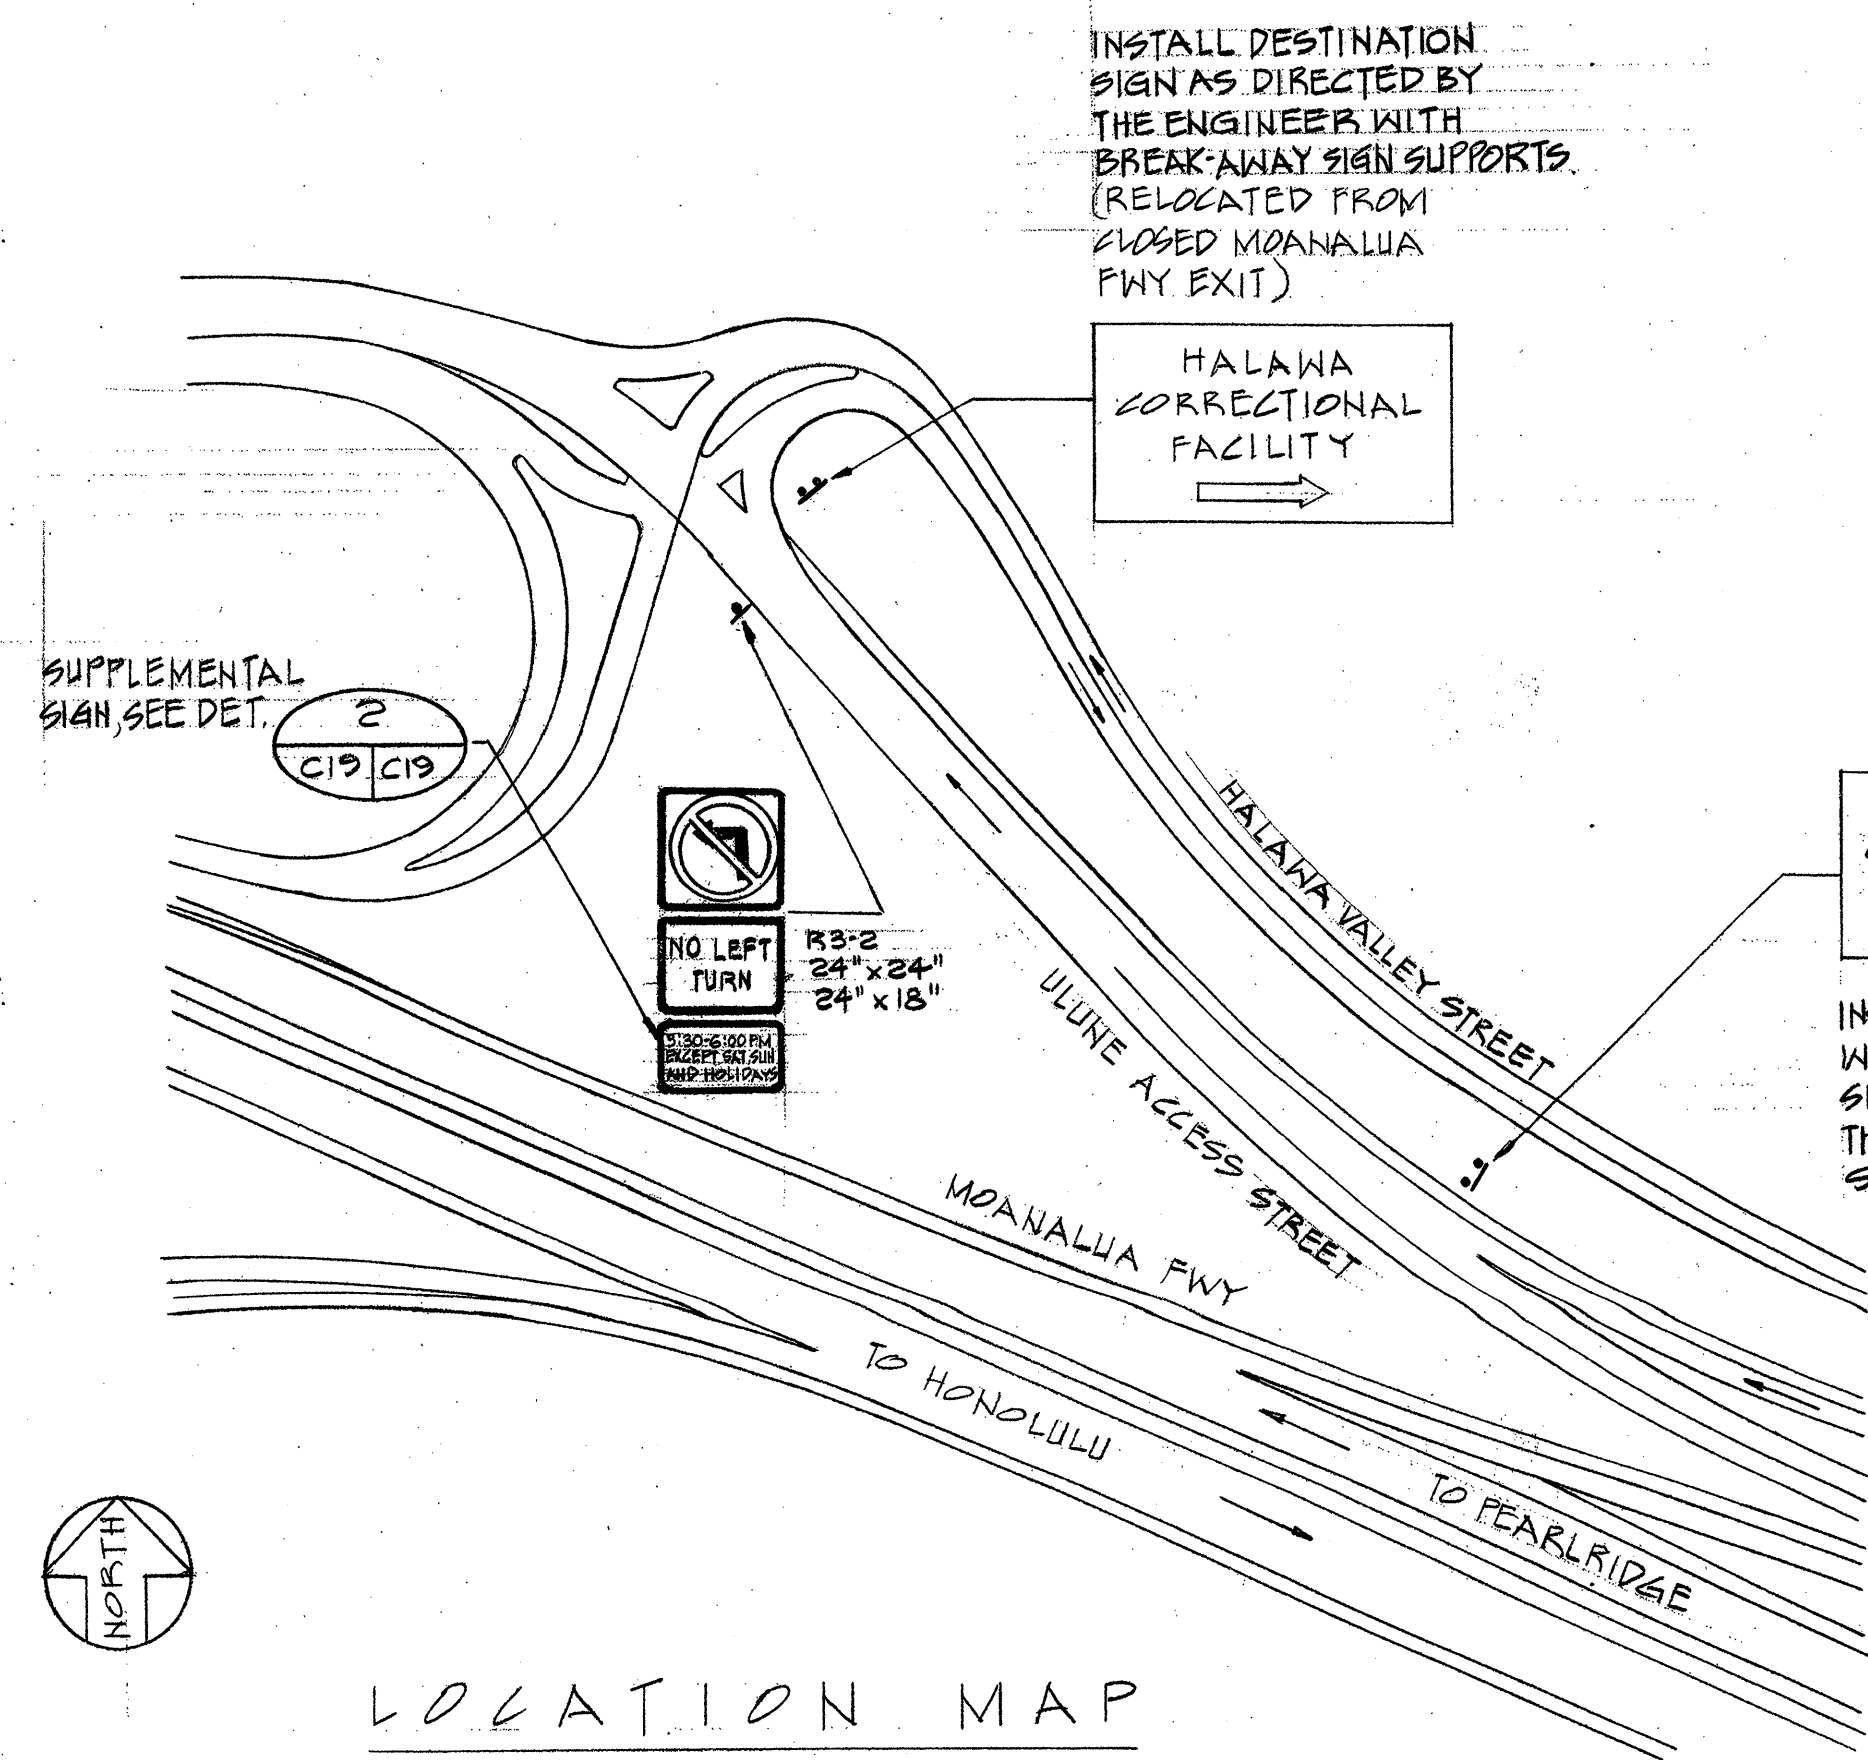

LOCATION MAP
NOT TO SCALE


HALAWA CORRECTIONAL FACILITY NEXT RIGHT

INSTALL NEW DESTINATION SIGN WITH BREAK-AWAY SIGN SUPPORTS AS DIRECTED BY THE ENGINEER SEE DETAIL (1) C19/C19

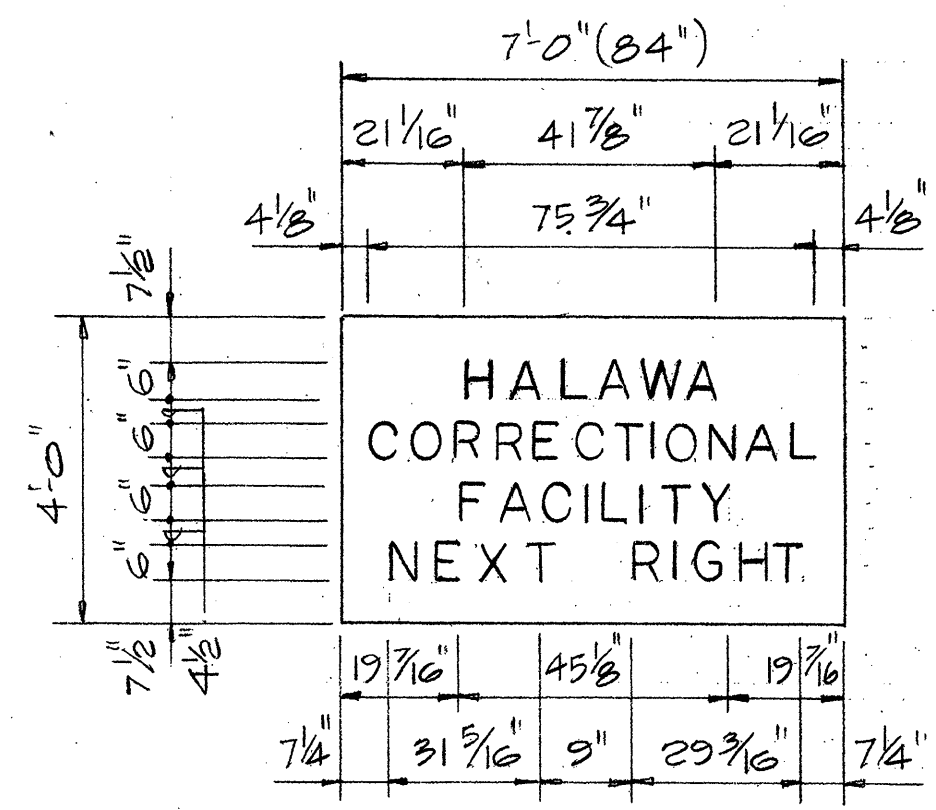

COLORS
LEGEND WHITE (REFL)
BACKGROUND GREEN (NON-REFL)


DESTINATION SIGN (1)
NOT TO SCALE C19/C19

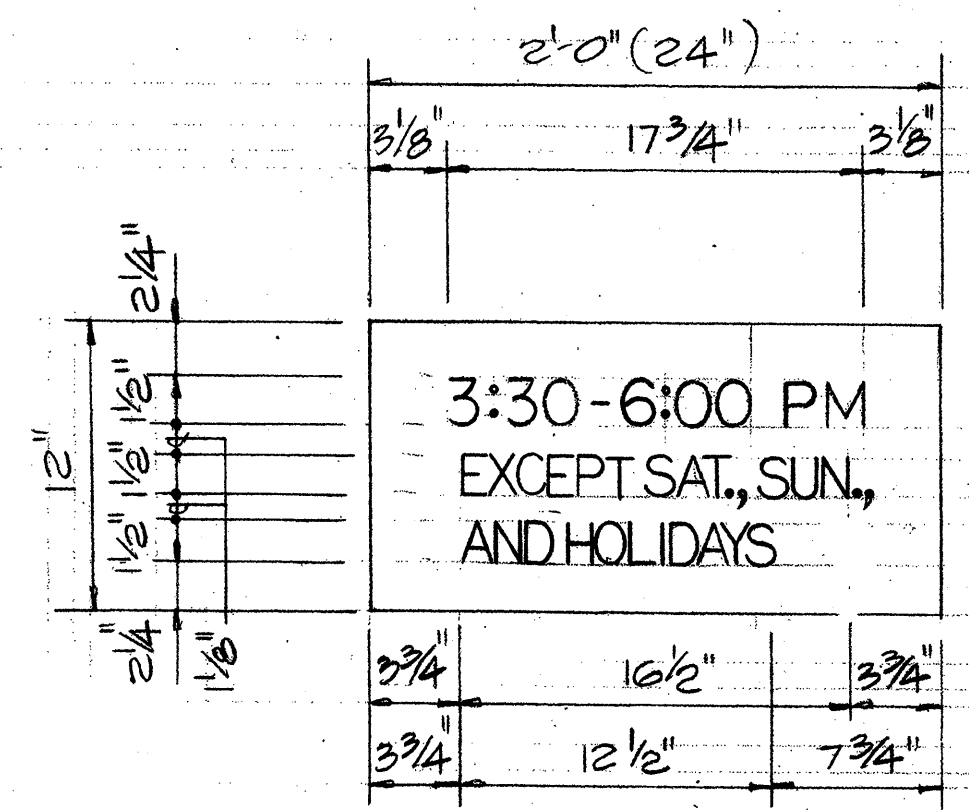

NOTE:
ALL LETTERS & NUMBERS TO BE SERIES C.




SUPPLEMENTAL SIGN (2)
NOT TO SCALE C19/C19

LEGEND (FOR INFORMATION ONLY)
40 ORIGINAL CONTRACT PLAN SHEET NUMBER
C040 PLAN SHEET INVOLVED IN REVISION

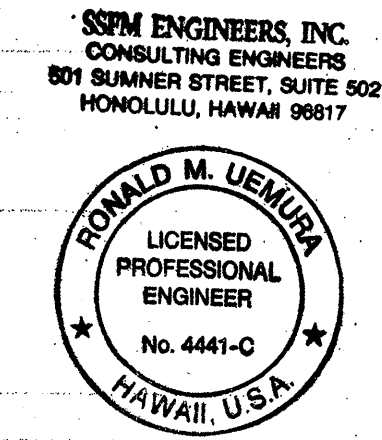

APRIL 1997	DELETED RETAINING WALL DETAIL & ELEVATION, # REVISED SECTION	BY
REVISION DATE	REVISION	
STATE OF HAWAII DEPARTMENT OF TRANSPORTATION HIGHWAYS DIVISION		
HALAWA JAIL ACCESS ROAD MOANALUA FWY EXIT CLOSURE SECTIONS AND DETAILS INTERSTATE ROUTE H3 F.A.I. PROJECT NO. 1-H3-1 (73)		
SCALE: AS NOTED	DATE: APR. 1997	
SHEET No. C19 OF 42 SHEETS		



FED. ROAD DIST. NO.	STATE	FED. AID PROJ. NO.	FISCAL YEAR	SHEET NO.	TOTAL SHEETS
HAWAII	HAW.	1-H3-1(73)	1996	41	42

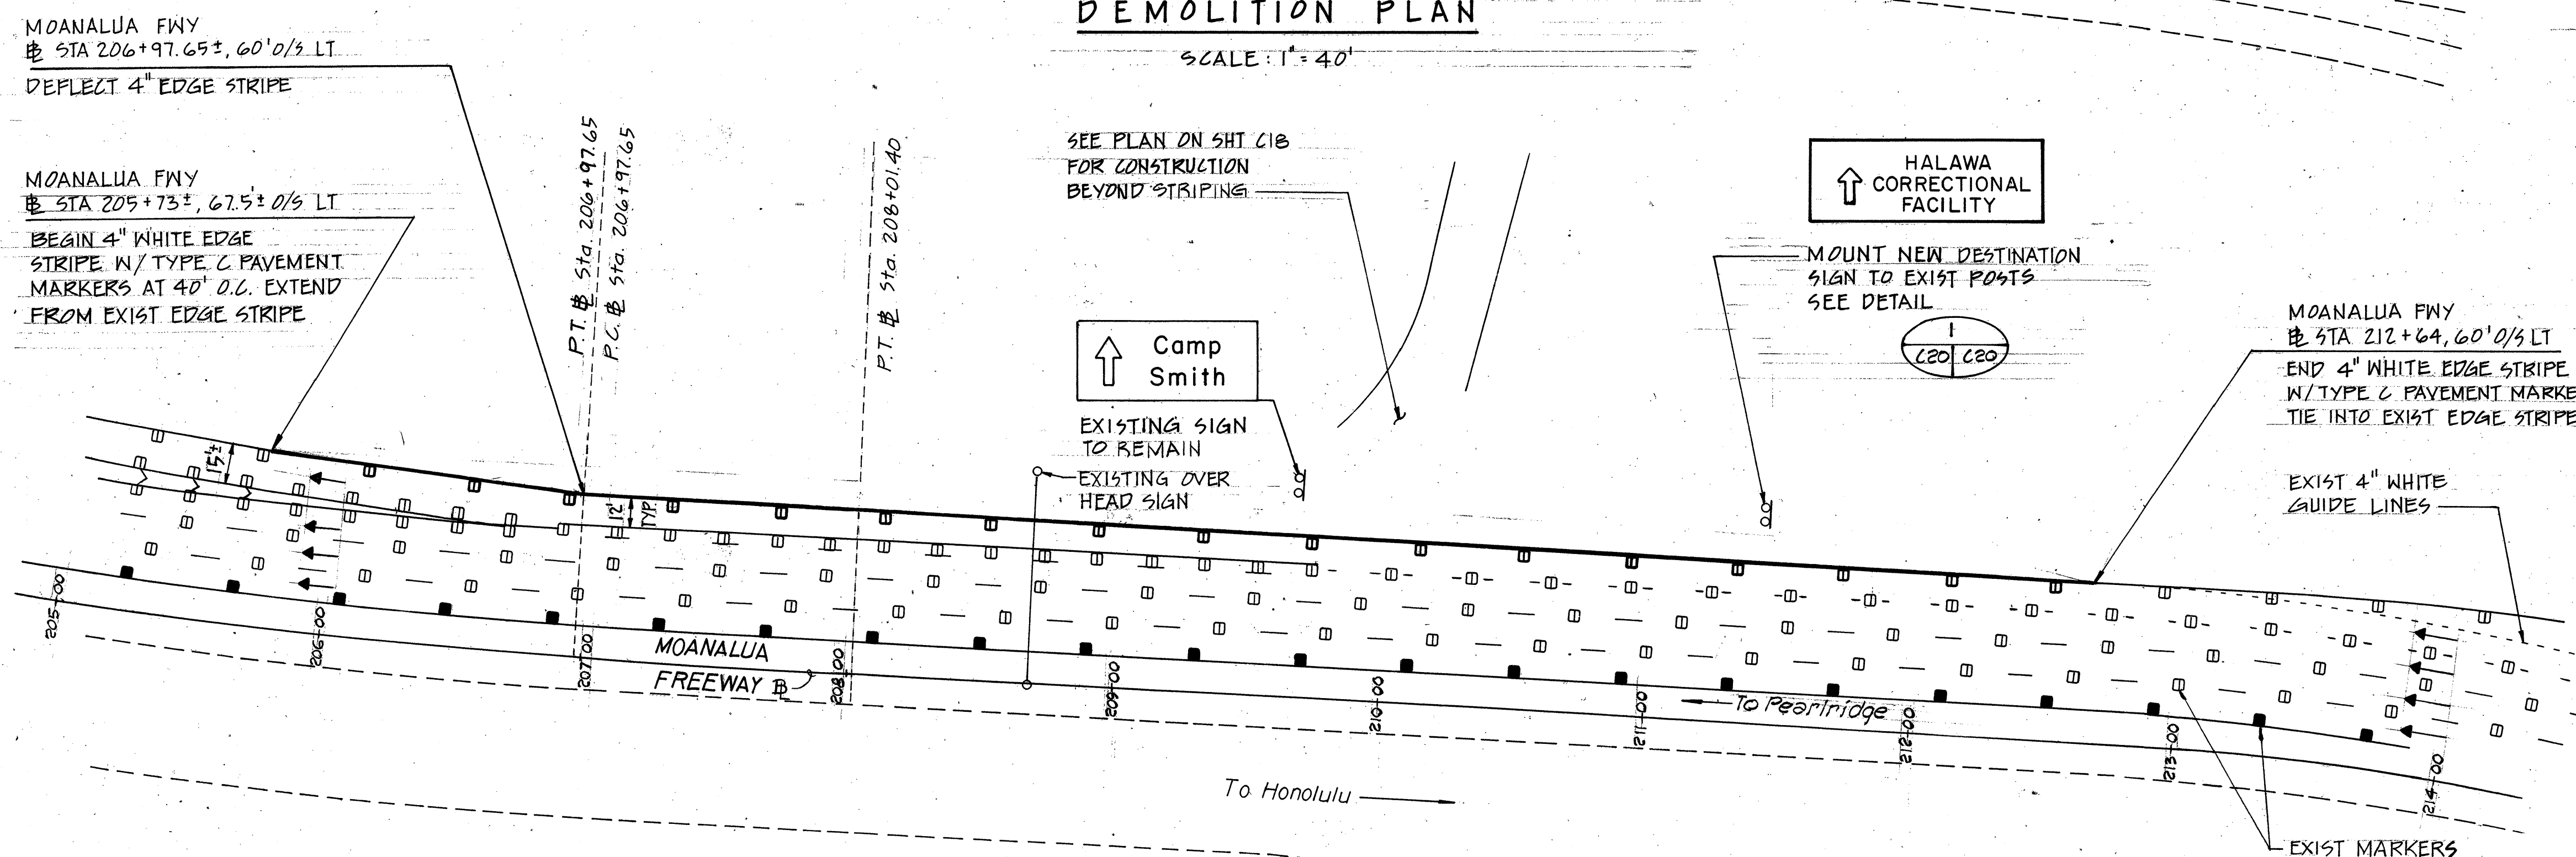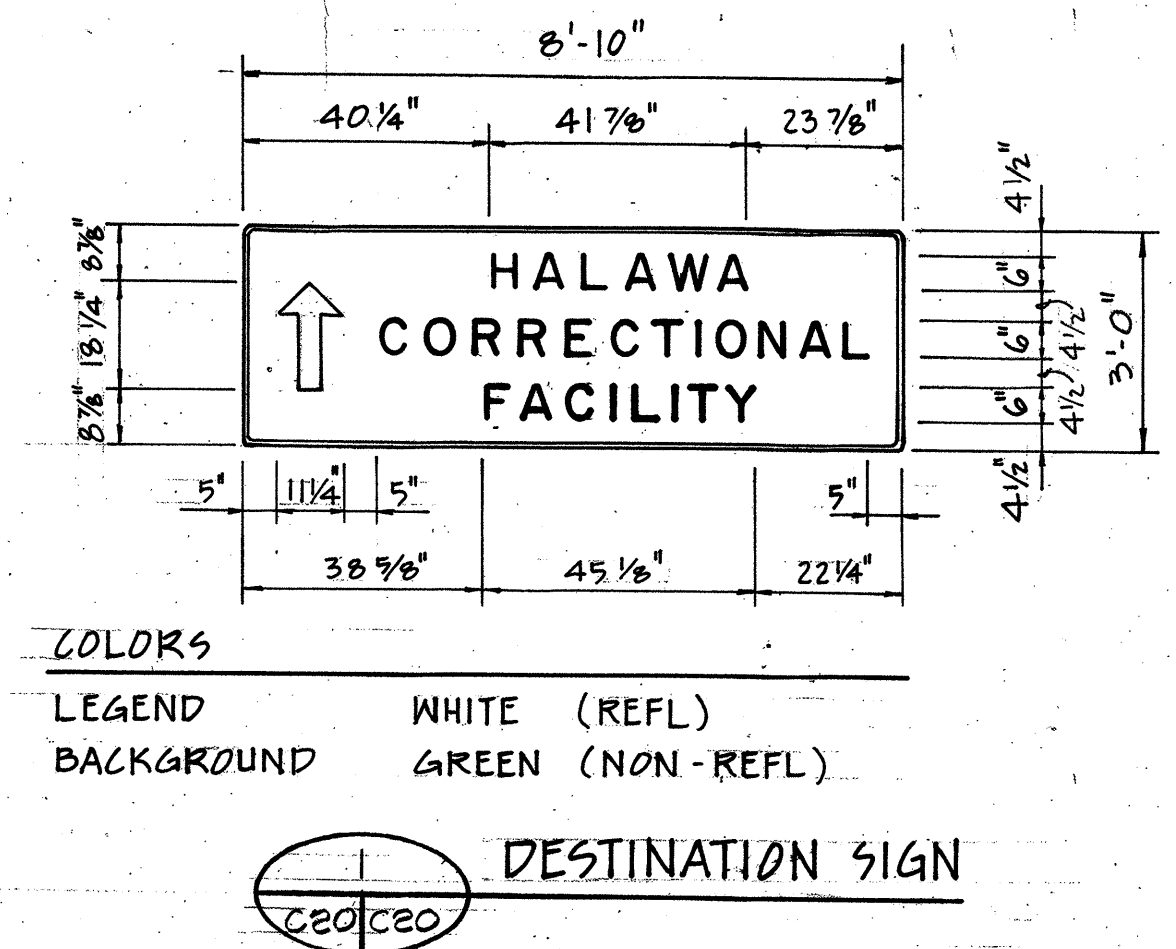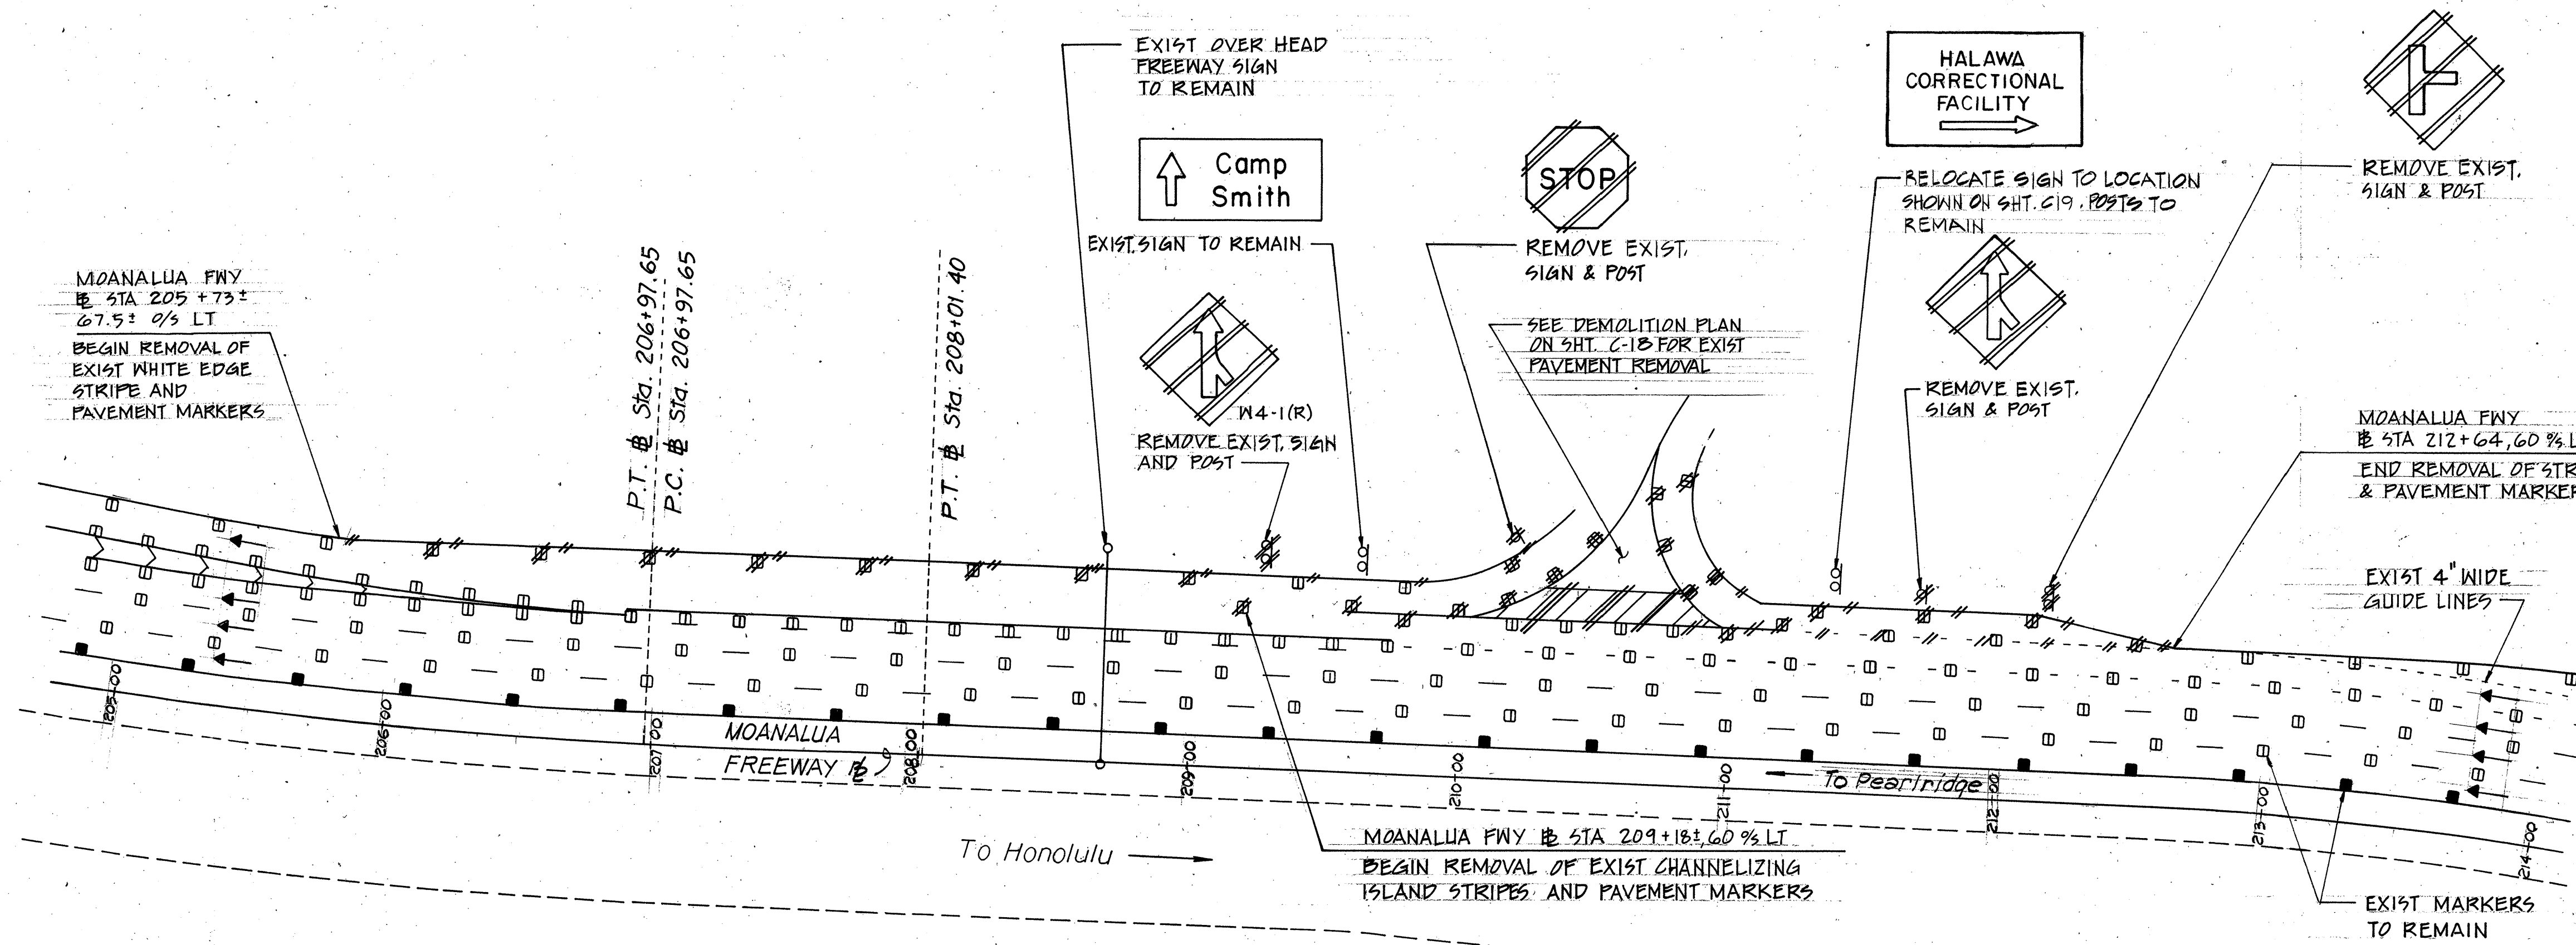

This work was prepared by me or under my supervision.

STATE OF HAWAII DEPARTMENT OF TRANSPORTATION HIGHWAYS DIVISION	
HALAWA JAIL ACCESS ROAD	
MOANALUA FWY EXIT CLOSURE SIGNING AND STRIPING PLAN	
INTERSTATE ROUTE H3 F.A.I. PROJECT NO. I-H3-1(73)	
SCALE: AS NOTED	DATE: APR. 1966
SHEET NO. C20 OF 42 SHEETS	


FED. ROAD DIST. NO.	STATE	FED. AID PROJ. NO.	FISCAL YEAR	SHEET NO.	TOTAL SHEETS
HAWAII	HAW.	I-H3-1(73)	1996	42	42

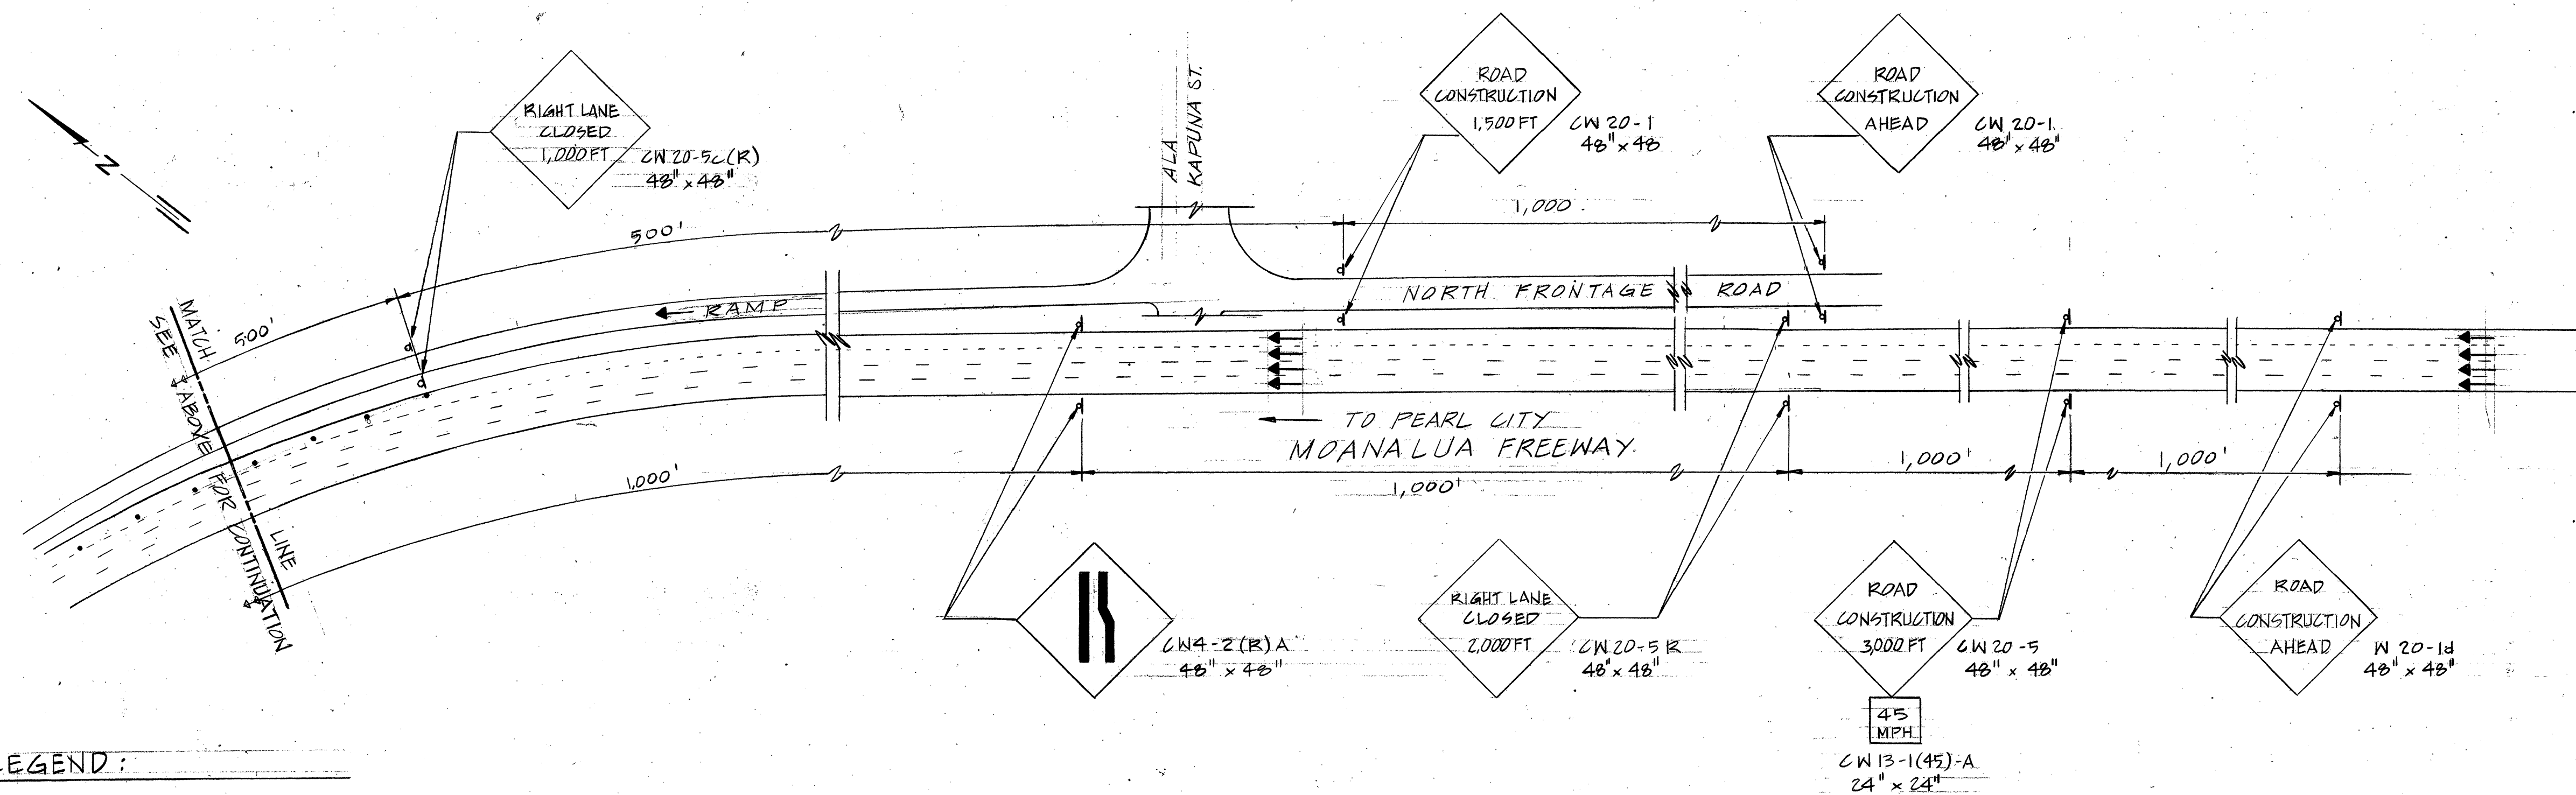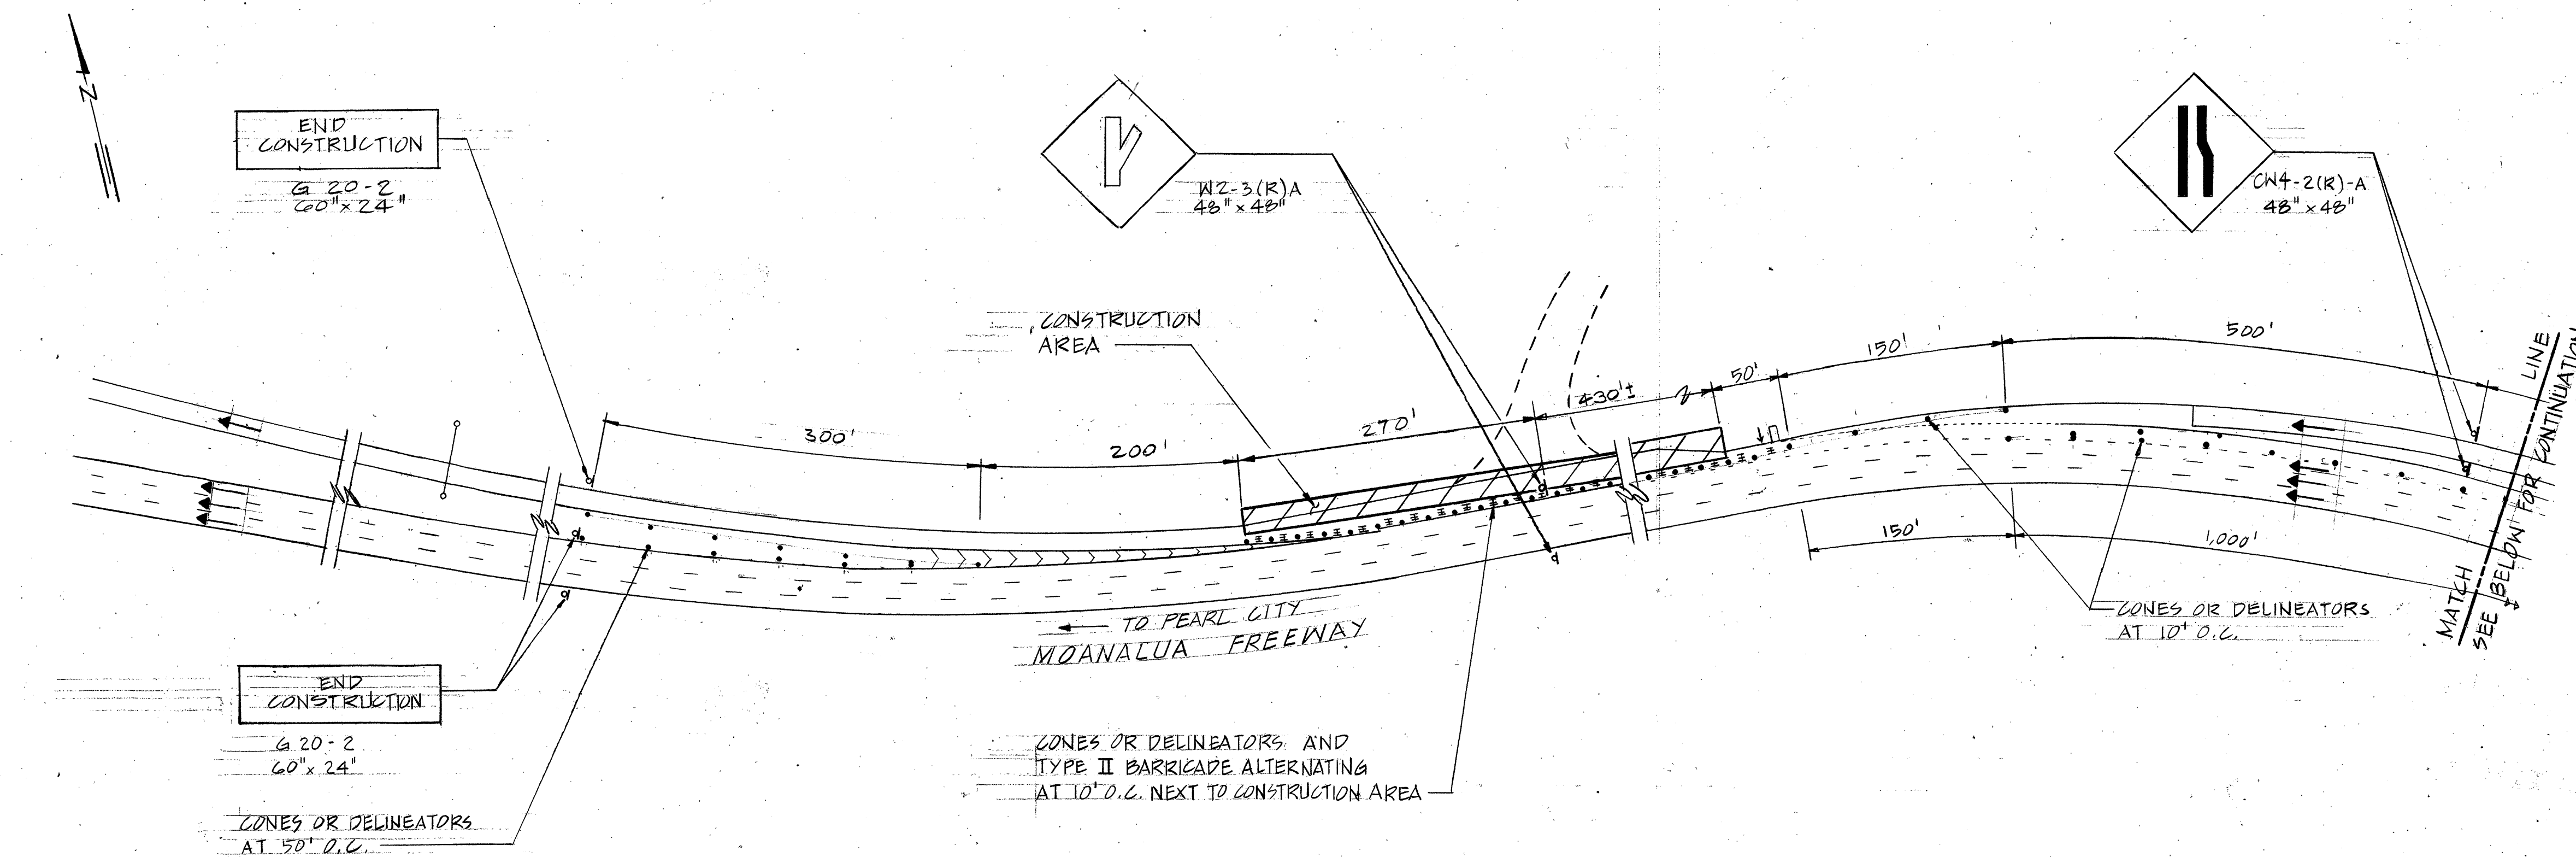

- LEGEND:**
- CONE OR DELINEATOR
 - ← DIRECTION OF TRAFFIC
 - d SIGN
 - ± TYPE II BARRICADE WITH AMBER FLASHER
 - ↓ FLASHING ARROW SIGNAL

TRAFFIC CONTROL PLAN NOT TO SCALE

SSFM ENGINEERS, INC.
CONSULTING ENGINEERS
801 SUMNER STREET, SUITE 502
HONOLULU, HAWAII 96817

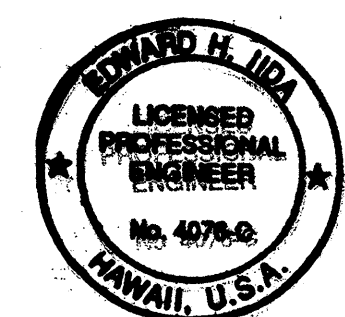

This work was prepared by me or under my supervision

STATE OF HAWAII DEPARTMENT OF TRANSPORTATION HIGHWAYS DIVISION	
HALAWA JAIL ACCESS ROAD	
MOANALUA FWY EXIT CLOSURE	
TRAFFIC CONTROL PLAN	
INTERSTATE ROUTE H3	
F.A.T. PROJECT NO. I-H3-1(73)	
SCALE: AS NOTED	DATE: APR. 1996
SHEET NO. 42 OF 42 SHEETS	