
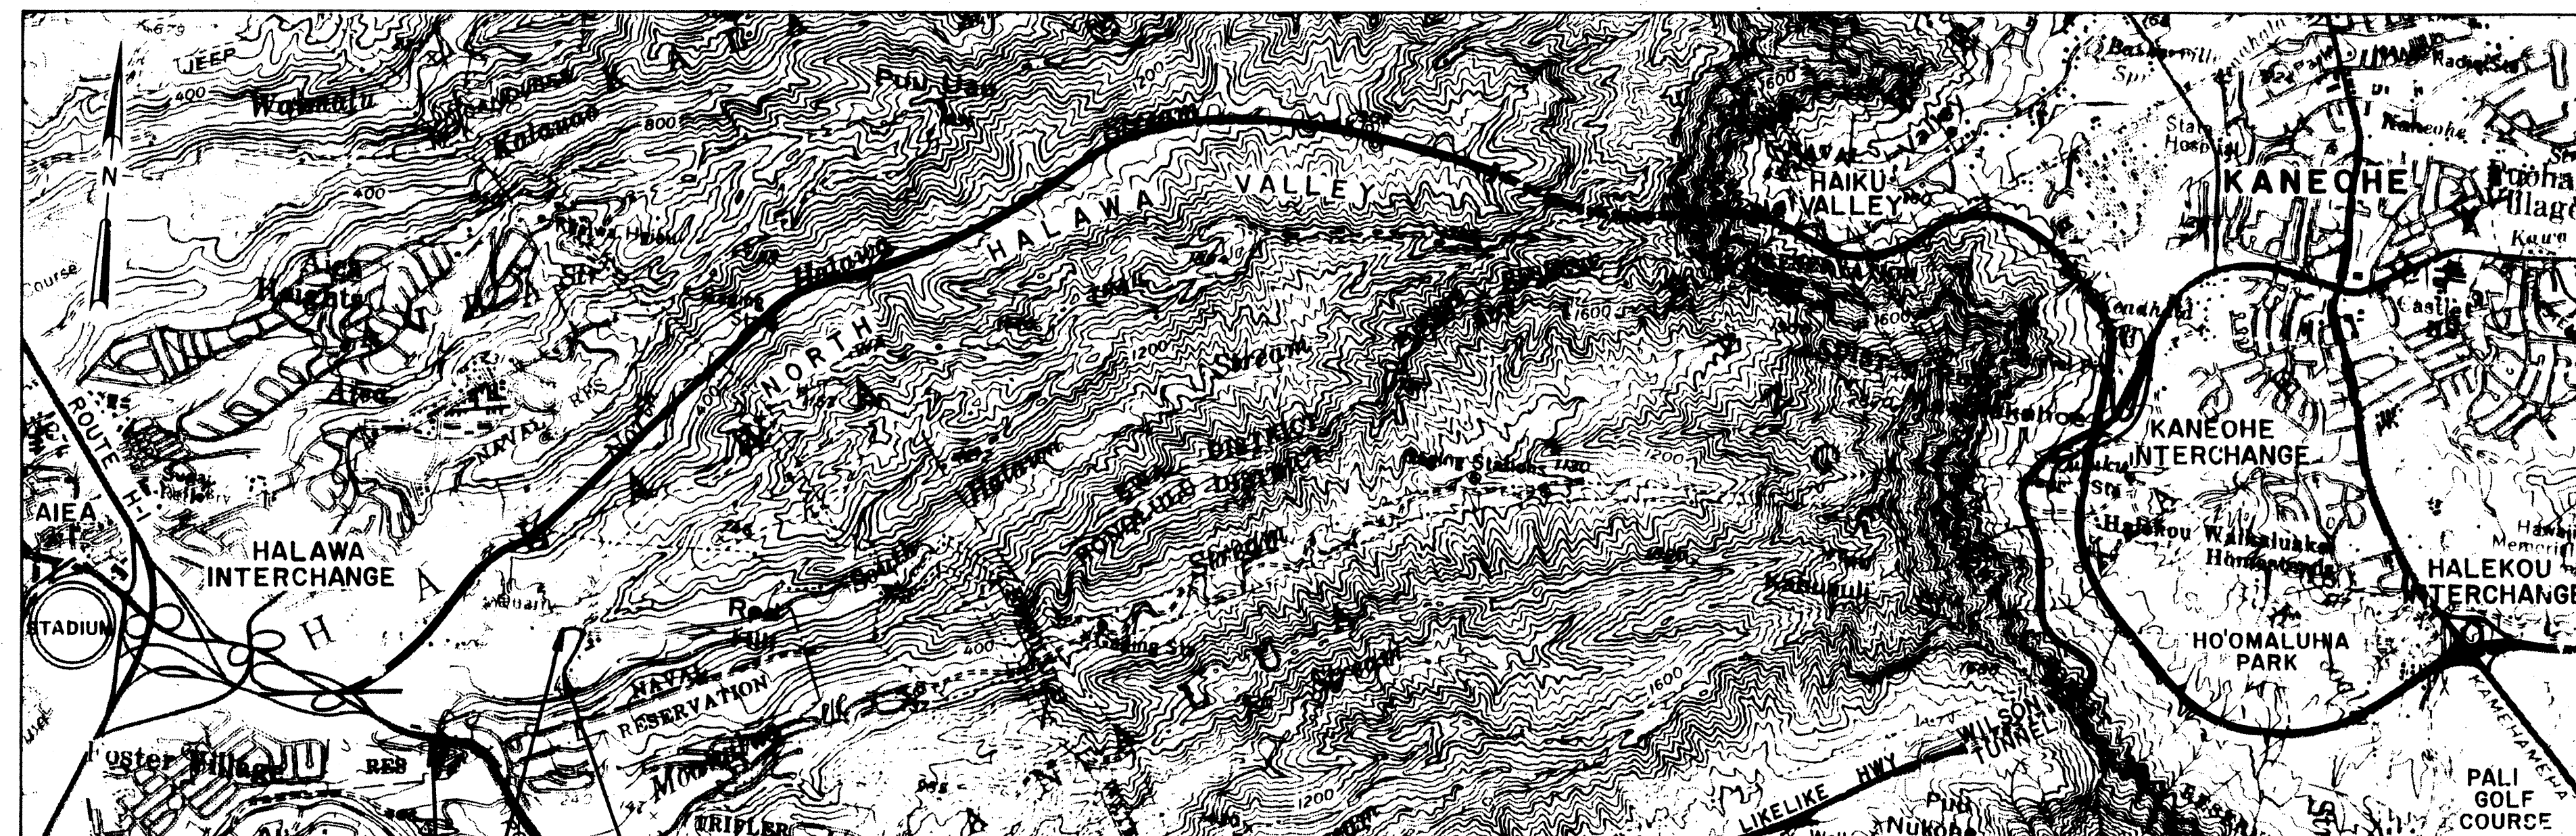
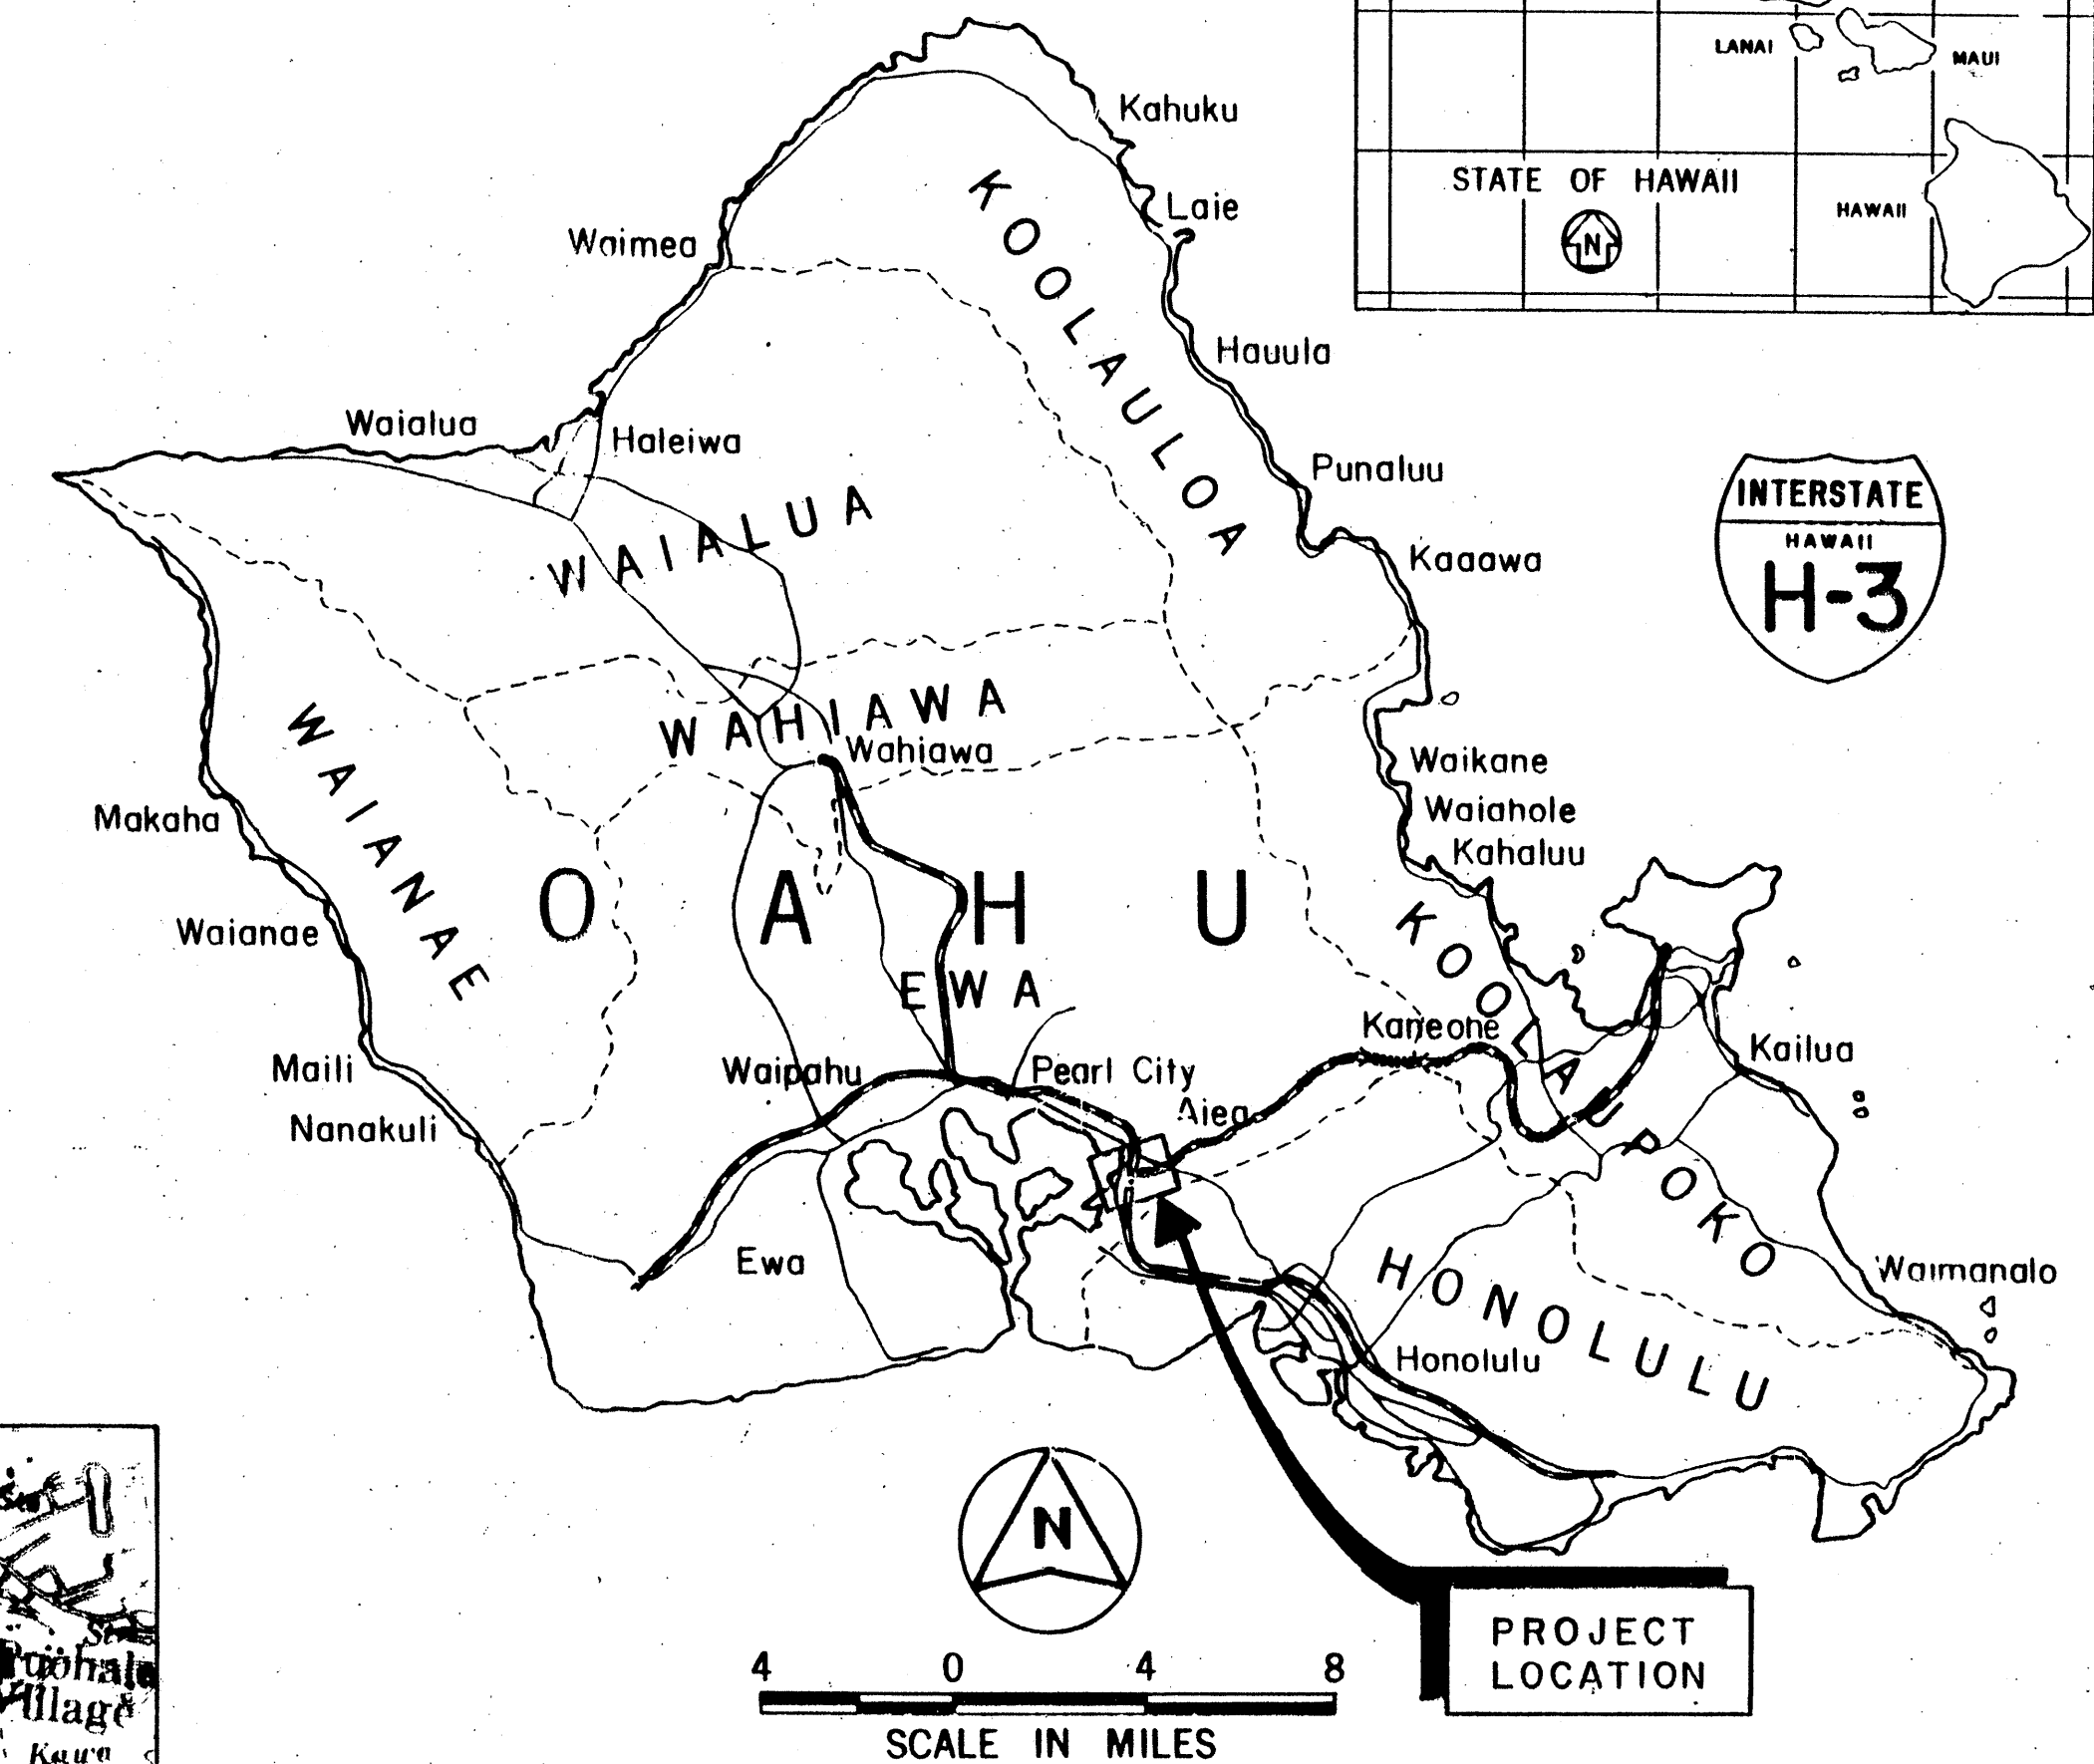


INDEX TO DRAWINGS	
SHEET NO.	DESCRIPTION
1	TITLE SHEET
2	STANDARD PLAN SUMMARY
3 & 4	GENERAL NOTES
5	DEMOLITION PLAN
6	GEOMETRIC PLAN STA. 0+00 TO STA. 11+00
6S-1	LINE-OF-SIGHT RETAINING WALL
7	GEOMETRIC PLAN STA. 11+00 TO END
7S-1	ACCESSIBILITY MODIFICATIONS
8	PROFILE & TYPICAL ROAD SECTIONS
9	GRADING PLAN
10	ROAD SECTIONS STA. 0+00 TO STA. 6+ 00
11	ROAD SECTIONS STA. 7+00 TO STA. 14+00
12	STORM DRAIN PLANS & PROFILES
13 & 14	STORM DRAIN DETAILS
15	EROSION CONTROL PLAN
16	SIGNING & STRIPING PLAN
17	E.C./SIGNING & STRIPING DETAILS
18	FENCE PLAN
19	FENCE DETAILS
20 TO 20S-2	CONC. BARRIER PLANS, SECTIONS & DETAILS
21	MISC. DETAILS
22 TO 22S-2	LOG OF BORINGS
23 TO 26	ELECTRICAL DRAWINGS
27 TO 29	LANDSCAPE DRAWINGS
30 TO 38	STRUCTURAL DRAWINGS
MOANALUA FREEWAY EXIT CLOSURE PLANS	
39	DEMOLITION, SITE & GRADING PLANS
40	SECTION & DETAILS
41	SIGNING & STRIPING PLAN
42	TRAFFIC CONTROL PLAN

STATE OF HAWAII
DEPARTMENT OF TRANSPORTATION
HIGHWAYS DIVISION
HONOLULU, HAWAII
"AS-BUILT"
PLANS FOR
CONSTRUCTION OF A PORTION OF
INTERSTATE ROUTE H-3
HALAWA JAIL ACCESS ROAD
FEDERAL AID INTERSTATE PROJECT NO. I-H3-1(73)
DISTRICT OF EWA
ISLAND OF OAHU

FED. ROAD DIST. NO.	STATE	FED. AID PROJ. NO.	FISCAL YEAR	SHEET NO.	TOTAL SHEETS
HAWAII	HAW.	I-H3-1-(73)	1996	1	42

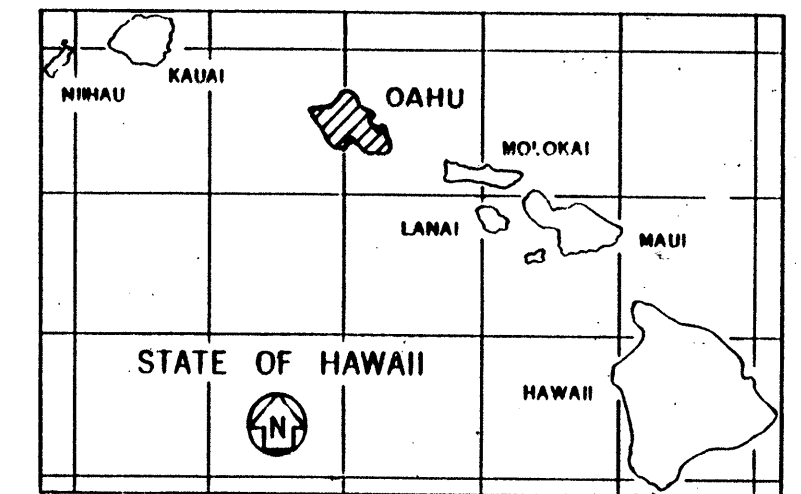

MOANALUA FWY
EXIT CLOSURE

END PROJECT
@ STA 13+00

BEGIN PROJECT
@ STA 0+00

LENGTH OF PROJECT = 0.25 MILE

LAYOUT PLAN

1/2 0 1/2 1
SCALE IN MILES

CHANGES MADE DURING CONSTRUCTION HAVE BEEN INCORPORATED ON THESE PLANS EXCEPT CHANGES IN THE ORIGINAL THEORETICAL QUANTITIES. FOR ACTUAL QUANTITIES, REFER TO PROJECT LEDGER AND/OR COMPUTATION BOOK.

Robert Hlin
RESIDENT ENGINEER

3-23-98
DATE

DESIGN CLASSIFICATION
ADT (1993).....1,225
DESIGN ADT (2008).....1,500
T24......6%
V......20 MPH

DEPARTMENT OF TRANSPORTATION
STATE OF HAWAII
APPROVED:
Dir. of Transportation 3/7/96
DIR. OF TRANSPORTATION DATE

SSFM ENGINEERS INC.
DESIGNED BY
K. WONG
P. S. & E. BY
587-2241
PHONE
MAR. 1996
DATE