INDEX TO DRAWINGS	
SHEET NO.	DESCRIPTION
1	TITLE SHEET
2	GENERAL NOTES AND LEGEND
3	NPDES GENERAL NOTES
4 – 6	DRAINAGE PLAN
7	DRAINAGE DETAILS
75-1	DRAINAGE DETAILS
75-2	DRAINAGE DETAILS
MANAGA ANTO ANTO ANTO ANTO ANTO ANTO ANTO ANT	
Aller Army Continues and the second	
Plan Sht. No.75-1 \$ 75-2 are supplementary	

Plan Sht. No.75-1 \$ 75-2 are supplementary sheets to the contract plans.
Total Sheet Count after "As-Built" posting is 9 sheets.

Kaneohe

School

STATE OF HAWAII

DEPARTMENT OF TRANSPORTATION

DIVISION HIGHWAYS HONOLULU, HAWAII "AS-BUILT"

PLANS FOR

INTERSTATE ROUTE H-3 HALEKOU INTERCHANGE DRAINAGE IMPROVEMENTS


RELINING OF TWIN 132" CULVERT AT KAMOOALII BRANCH

FEDERAL AID PROJECT NO. IM-H3-1(76)

DISTRICT OF KOOLAUPOKO ISLAND OF OAHU

NET LENGTH. OF PROJECT.....0.22 MILES

SCALE IN THOUSAND FEET

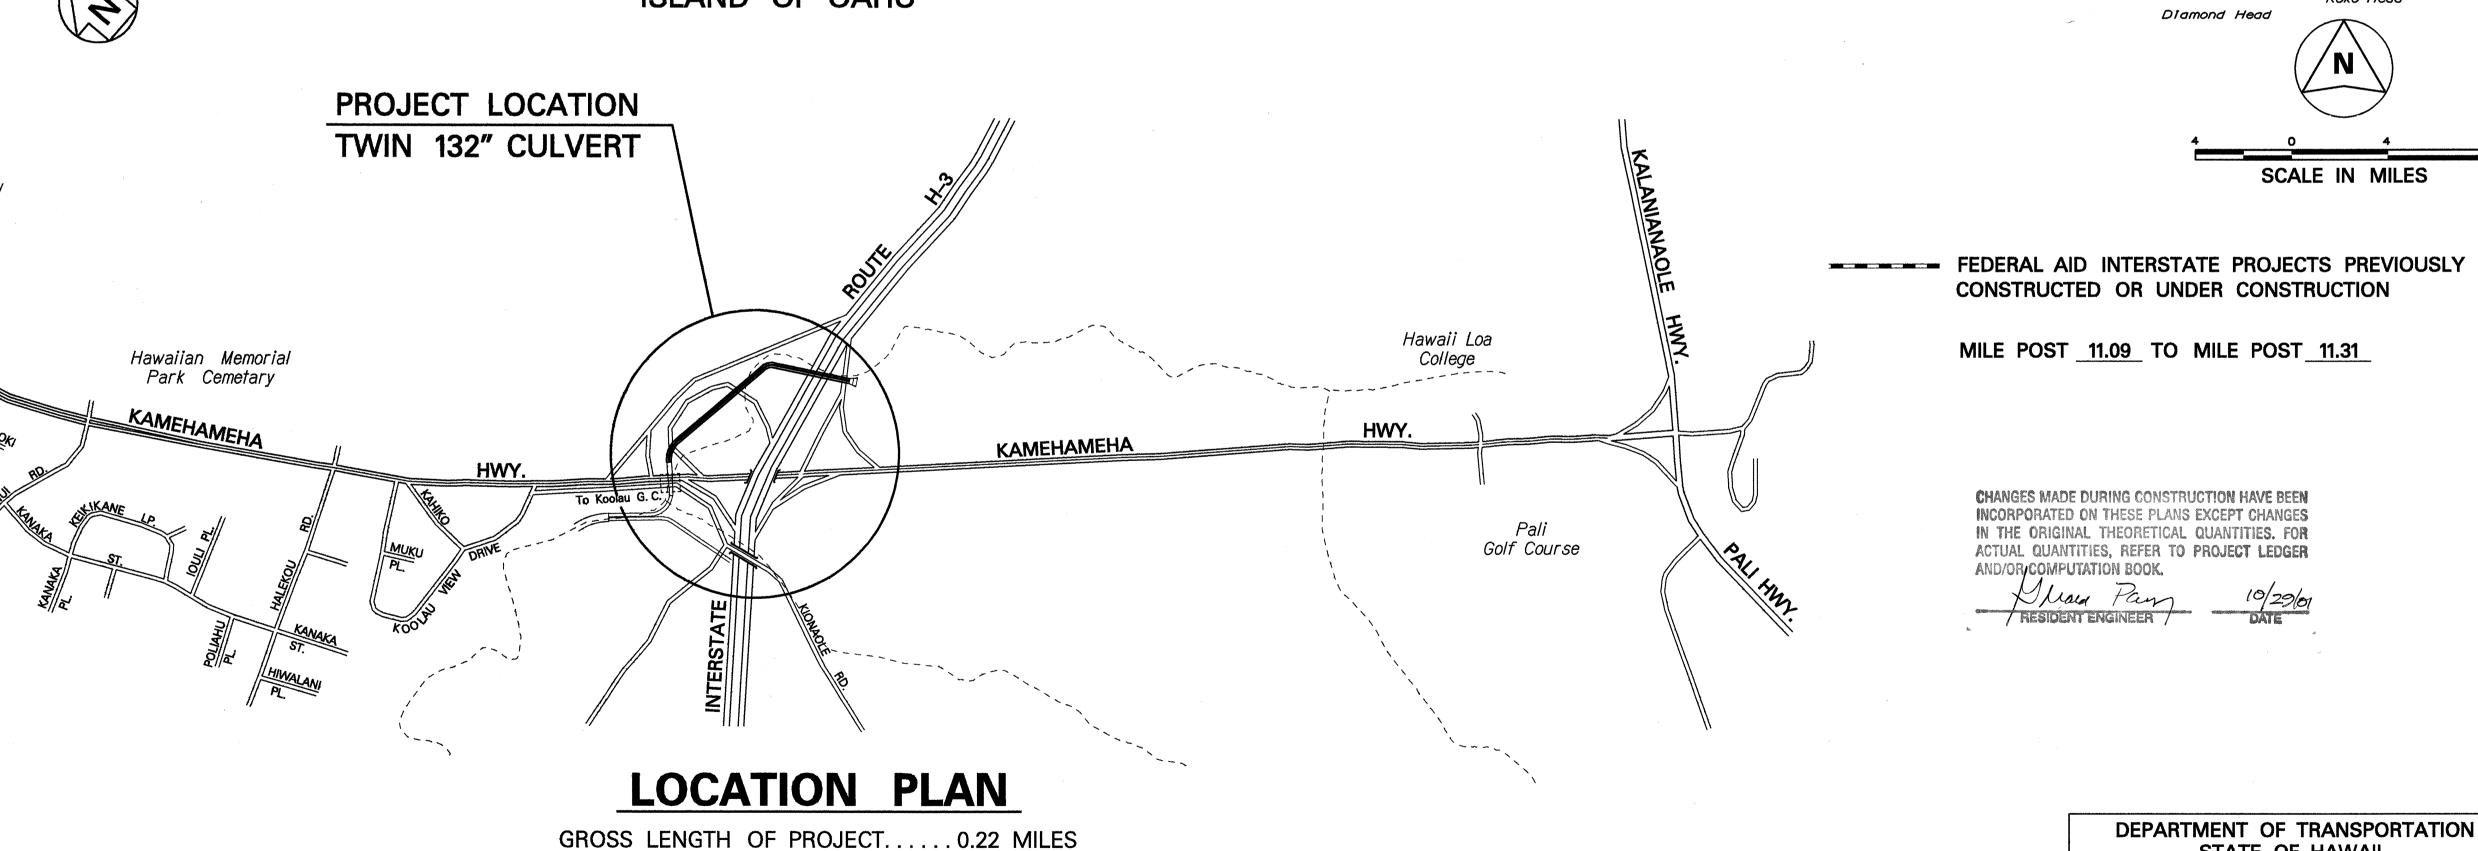

IM-H3-1(76) INTERSTATE **H3** STATE OF HAWAII **LOCATION** OF PROJECT SCALE IN MILES FEDERAL AID INTERSTATE PROJECTS PREVIOUSLY CONSTRUCTED OR UNDER CONSTRUCTION MILE POST 11.09 TO MILE POST 11.31 **CHANGES MADE DURING CONSTRUCTION HAVE BEEN** INCORPORATED ON THESE PLANS EXCEPT CHANGES IN THE ORIGINAL THEORETICAL QUANTITIES. FOR ACTUAL QUANTITIES, REFER TO PROJECT LEDGER AND/OR/COMPUTATION BOOK. Musica Para RESIDENT ENGINEER

FED. ROAD DIST. NO.

STATE

HAW.

FISCAL SHEET NO.

FED. AID PROJ. NO.

STATE OF HAWAII

DIR. OF TRANSPORTATION

1/12/98

DATE

APPROVED:

JAN. 1998 DATE