



FED. ROAD DIST. NO.	STATE	FED. AID PROJ. NO.	FISCAL YEAR	SHEET NO.	TOTAL SHEETS
HAWAII	HAW.	I-H3-1(8):14 I-H3-1(2): 8	1969	36	280

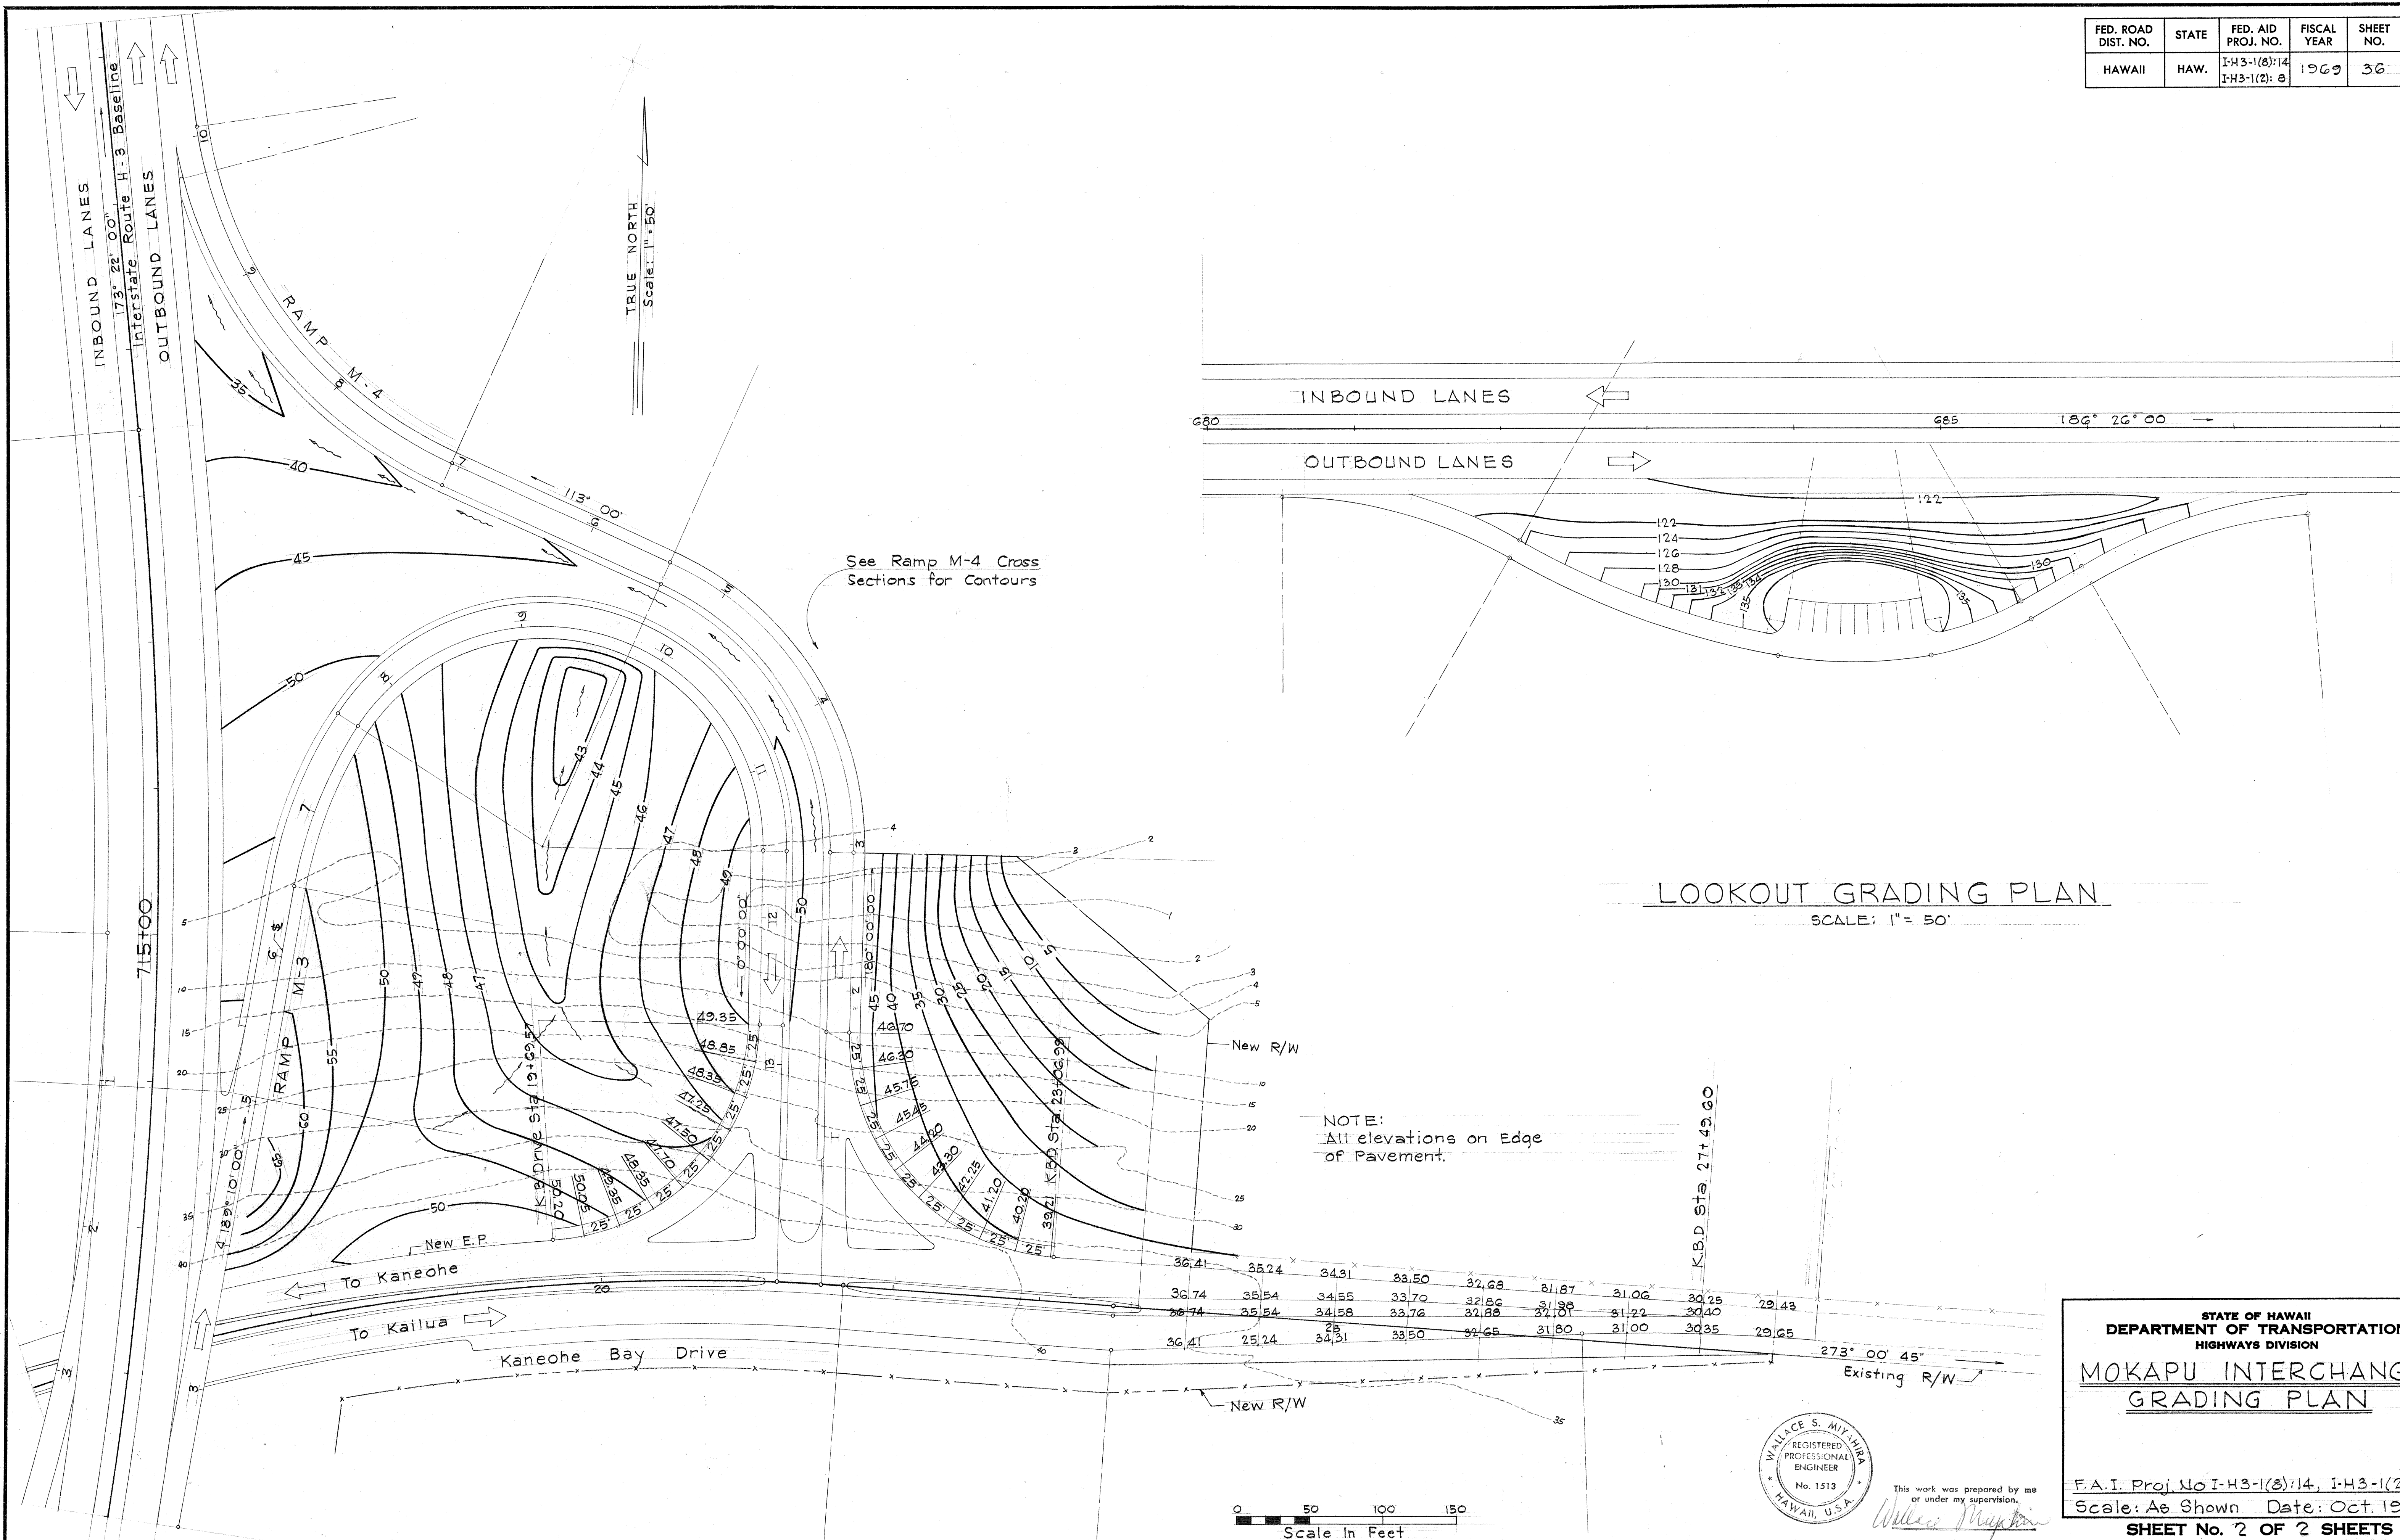

DESIGNED BY	DATE
DRAWN BY	
CHECKED BY	
NOTED BY	
NO.	

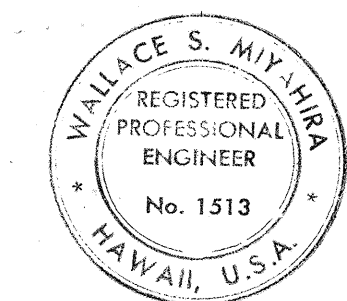

This work was prepared by me or under my supervision.

Wallace S. Miyahira

STATE OF HAWAII
DEPARTMENT OF TRANSPORTATION
HIGHWAYS DIVISION

**MOKAPU INTERCHANGE
GRADING PLAN**

F.A.I. Proj. No I-H3-1(8):14, I-H3-1(2): 8
Scale: As Shown Date: Oct. 1968
SHEET No. 2 OF 2 SHEETS