



FED. ROAD DIST. NO.	STATE	FED. AID PROJ. NO.	FISCAL YEAR	SHEET NO.	TOTAL SHEETS
HAWAII	HAW.	I-H3-1(8):14 I-H3-1(2):8	1969	C0261	280

True North
Scale: 1" = 100'

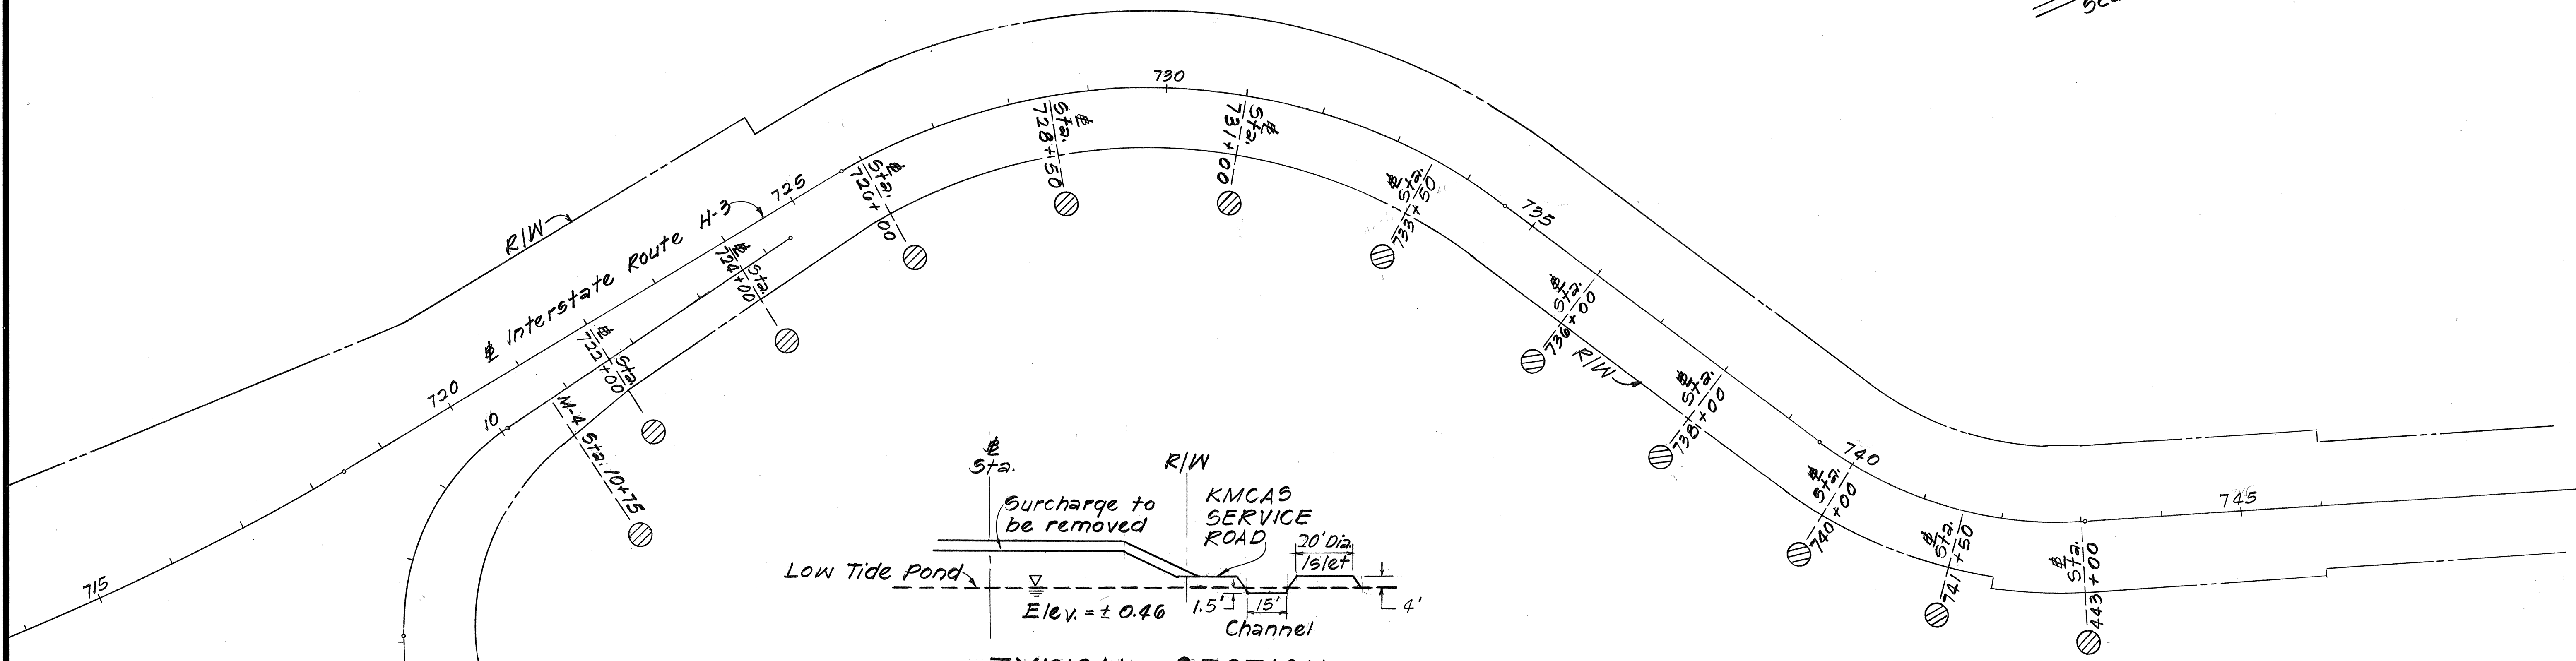

TYPICAL SECTION
STA. 722+00 to 743+00
Scale: Not to Scale

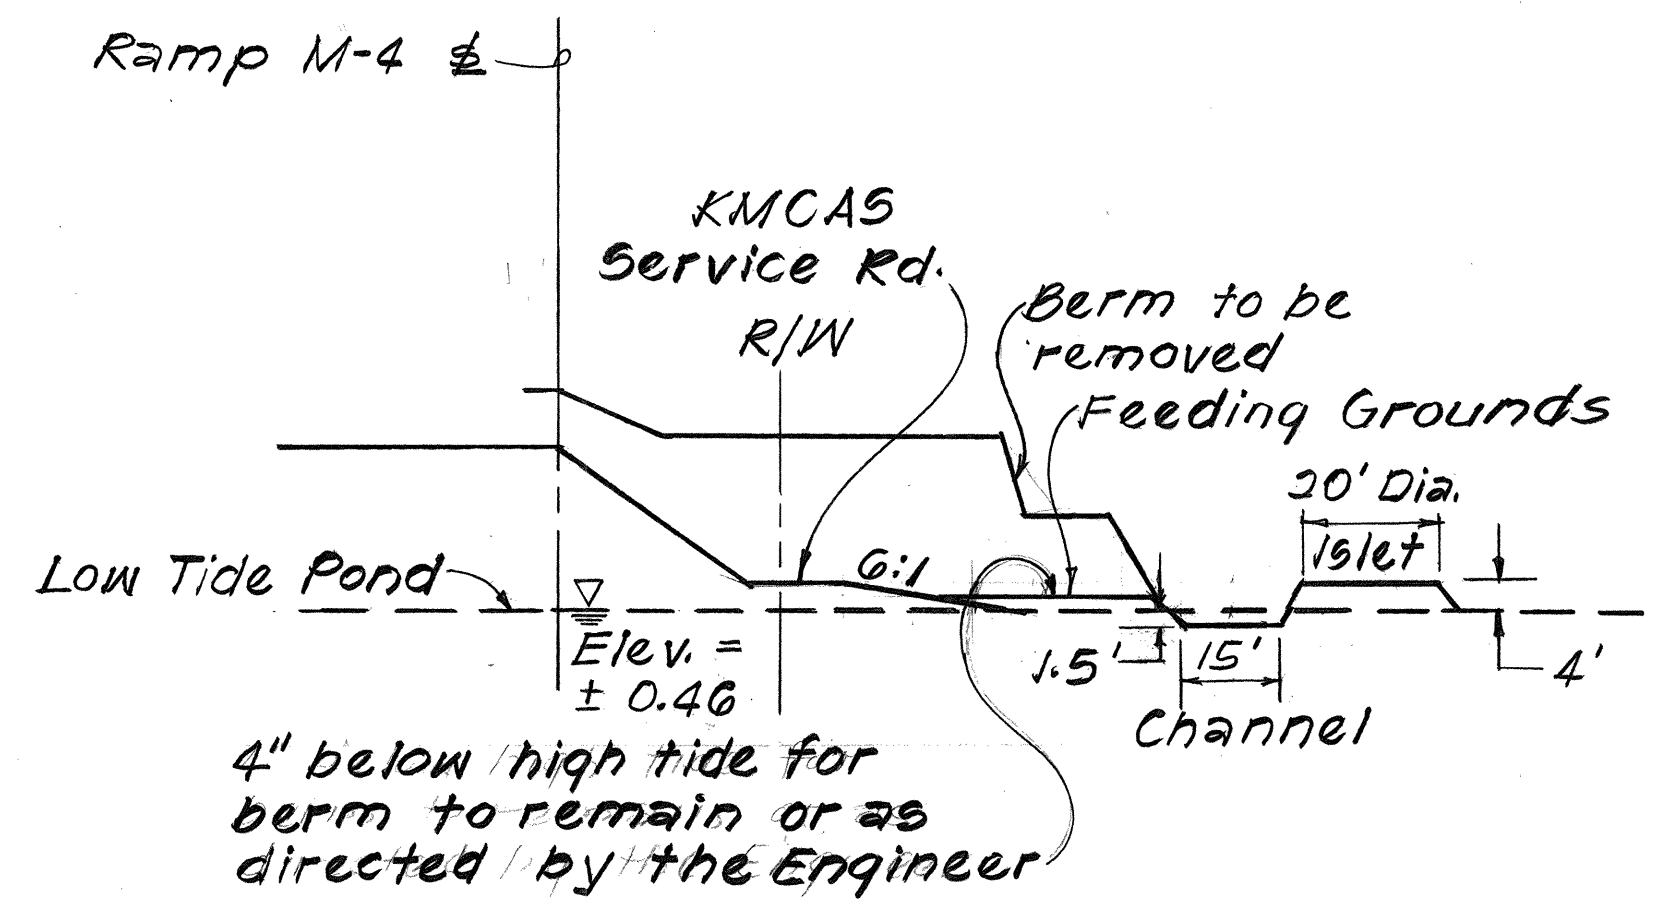

TYPICAL SECTION
RAMP M-4
STA. 3+50 to 10+75
Scale: Not to Scale

GENERAL NOTES:

1. Recommended by the United States Department of the Interior, Fish and Wildlife Service, Bureau of Sport Fisheries and Wildlife in their letter dated November 20, 1970.
2. Islets may vary in shape but not in size.

THIS TRACING PREPARED
DURING "AS-BUILT" POSTINGS.

STATE OF HAWAII
DEPARTMENT OF TRANSPORTATION
HIGHWAYS DIVISION

**PLAN & DETAILS OF
NESTING & FEEDING SITES FOR
ENDANGERED WATER BIRDS**

F.A.I. Proj. No. I-H34(8):14, I-H3-1(2):8
Scale: As Shown Date: Feb, 1984

SHEET No. 1 OF 1 SHEETS

SURVEY PLOTTED BY	DATE
DRAWN BY	
TRACED BY	
NOTED BY	
CHECKED BY	
ORIGINAL PLAN	
NOTE BOOK	
NO.	