
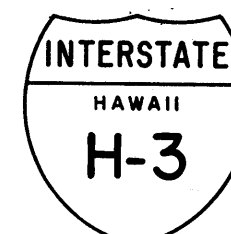


INDEX TO DRAWINGS	
SHEET NO.	DESCRIPTION
1	TITLE SHEET
2 - 3	TYPICAL SECTION
4	GENERAL NOTES & MISC. DETAILS
5 - 10	PLANS
11 - 12	DRAINAGE DETAILS
13 - 19	TRAFFIC SIGNS & PAVEMENT MARKINGS
20 - 46	STANDARD DETAILS


STATE OF HAWAII
DEPARTMENT OF TRANSPORTATION
HIGHWAYS DIVISION
"AS-BUILT"
PLANS FOR
INTERSTATE ROUTE H-3 RESURFACING
KAILUA INTERCHANGE TO KANEOHE MARINE CORPS AIR STATION
FEDERAL AID INTERSTATE PROJECT NO. IR-H3-I(55)

FED. ROAD DIST. NO.	STATE	FED. AID PROJ. NO.	FISCAL YEAR	SHEET NO.	TOTAL SHEETS
HAWAII	HAW.	IR-H3-I(55)	1985	1	46

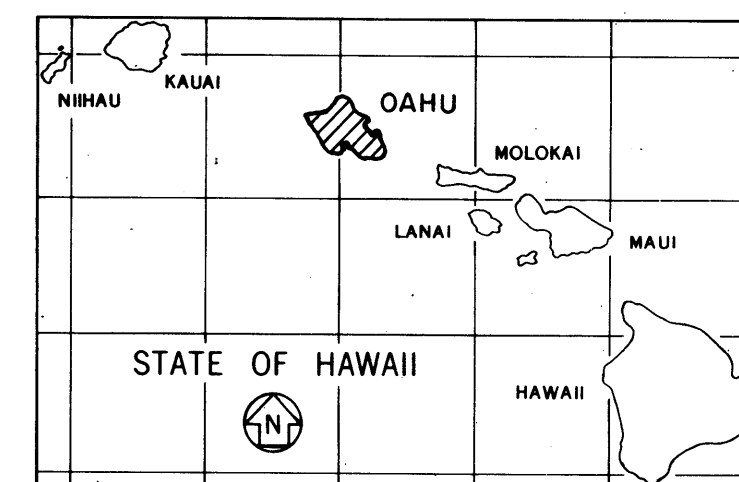

LOCATION OF PROJECT

DISTRICT OF KOOLAUPOKO
ISLAND OF OAHU

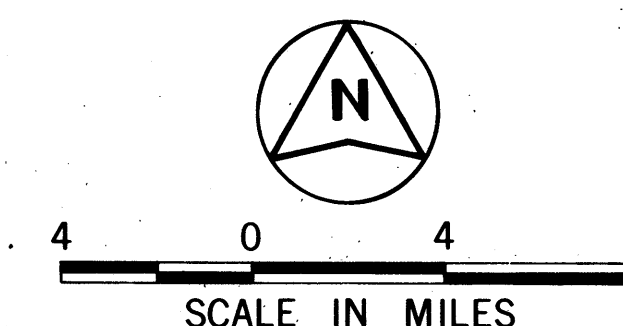

FEDERAL AID INTERSTATE PROJECTS PREVIOUSLY CONSTRUCTED OR UNDER CONSTRUCTION

DESIGN DESIGNATION

CURRENT ADT (1985) 11,000
DESIGN ADT (1995) 15,150
DHV 1,670
D 85/15
T 2.0
V 60MPH


NO SIGNIFICANT CHANGES WERE MADE DURING CONSTRUCTION ON THESE PLANS EXCEPT CHANGES IN THE ORIGINAL THEORETICAL QUANTITIES. FOR ACTUAL QUANTITIES, REFER TO PROJECT LEDGER AND/OR COMPUTATION BOOK.

David T. Hoge
RESIDENT ENGINEER 11/1/88
DATE

DEPARTMENT OF TRANSPORTATION
FEDERAL HIGHWAY ADMINISTRATION
APPROVED:
William A. McArthur 5/29/85
DIVISION ADMINISTRATOR DATE

DEPARTMENT OF TRANSPORTATION
STATE OF HAWAII
APPROVED:
Charles D. Rom *May 13, 1985*
DIR. OF TRANSPORTATION DATE

DESIGNED BY: *A. Yamaguchi*
P. S. & E. BY: *Unit "E"*
PHONE: 548-4125
DATE: May, 1985

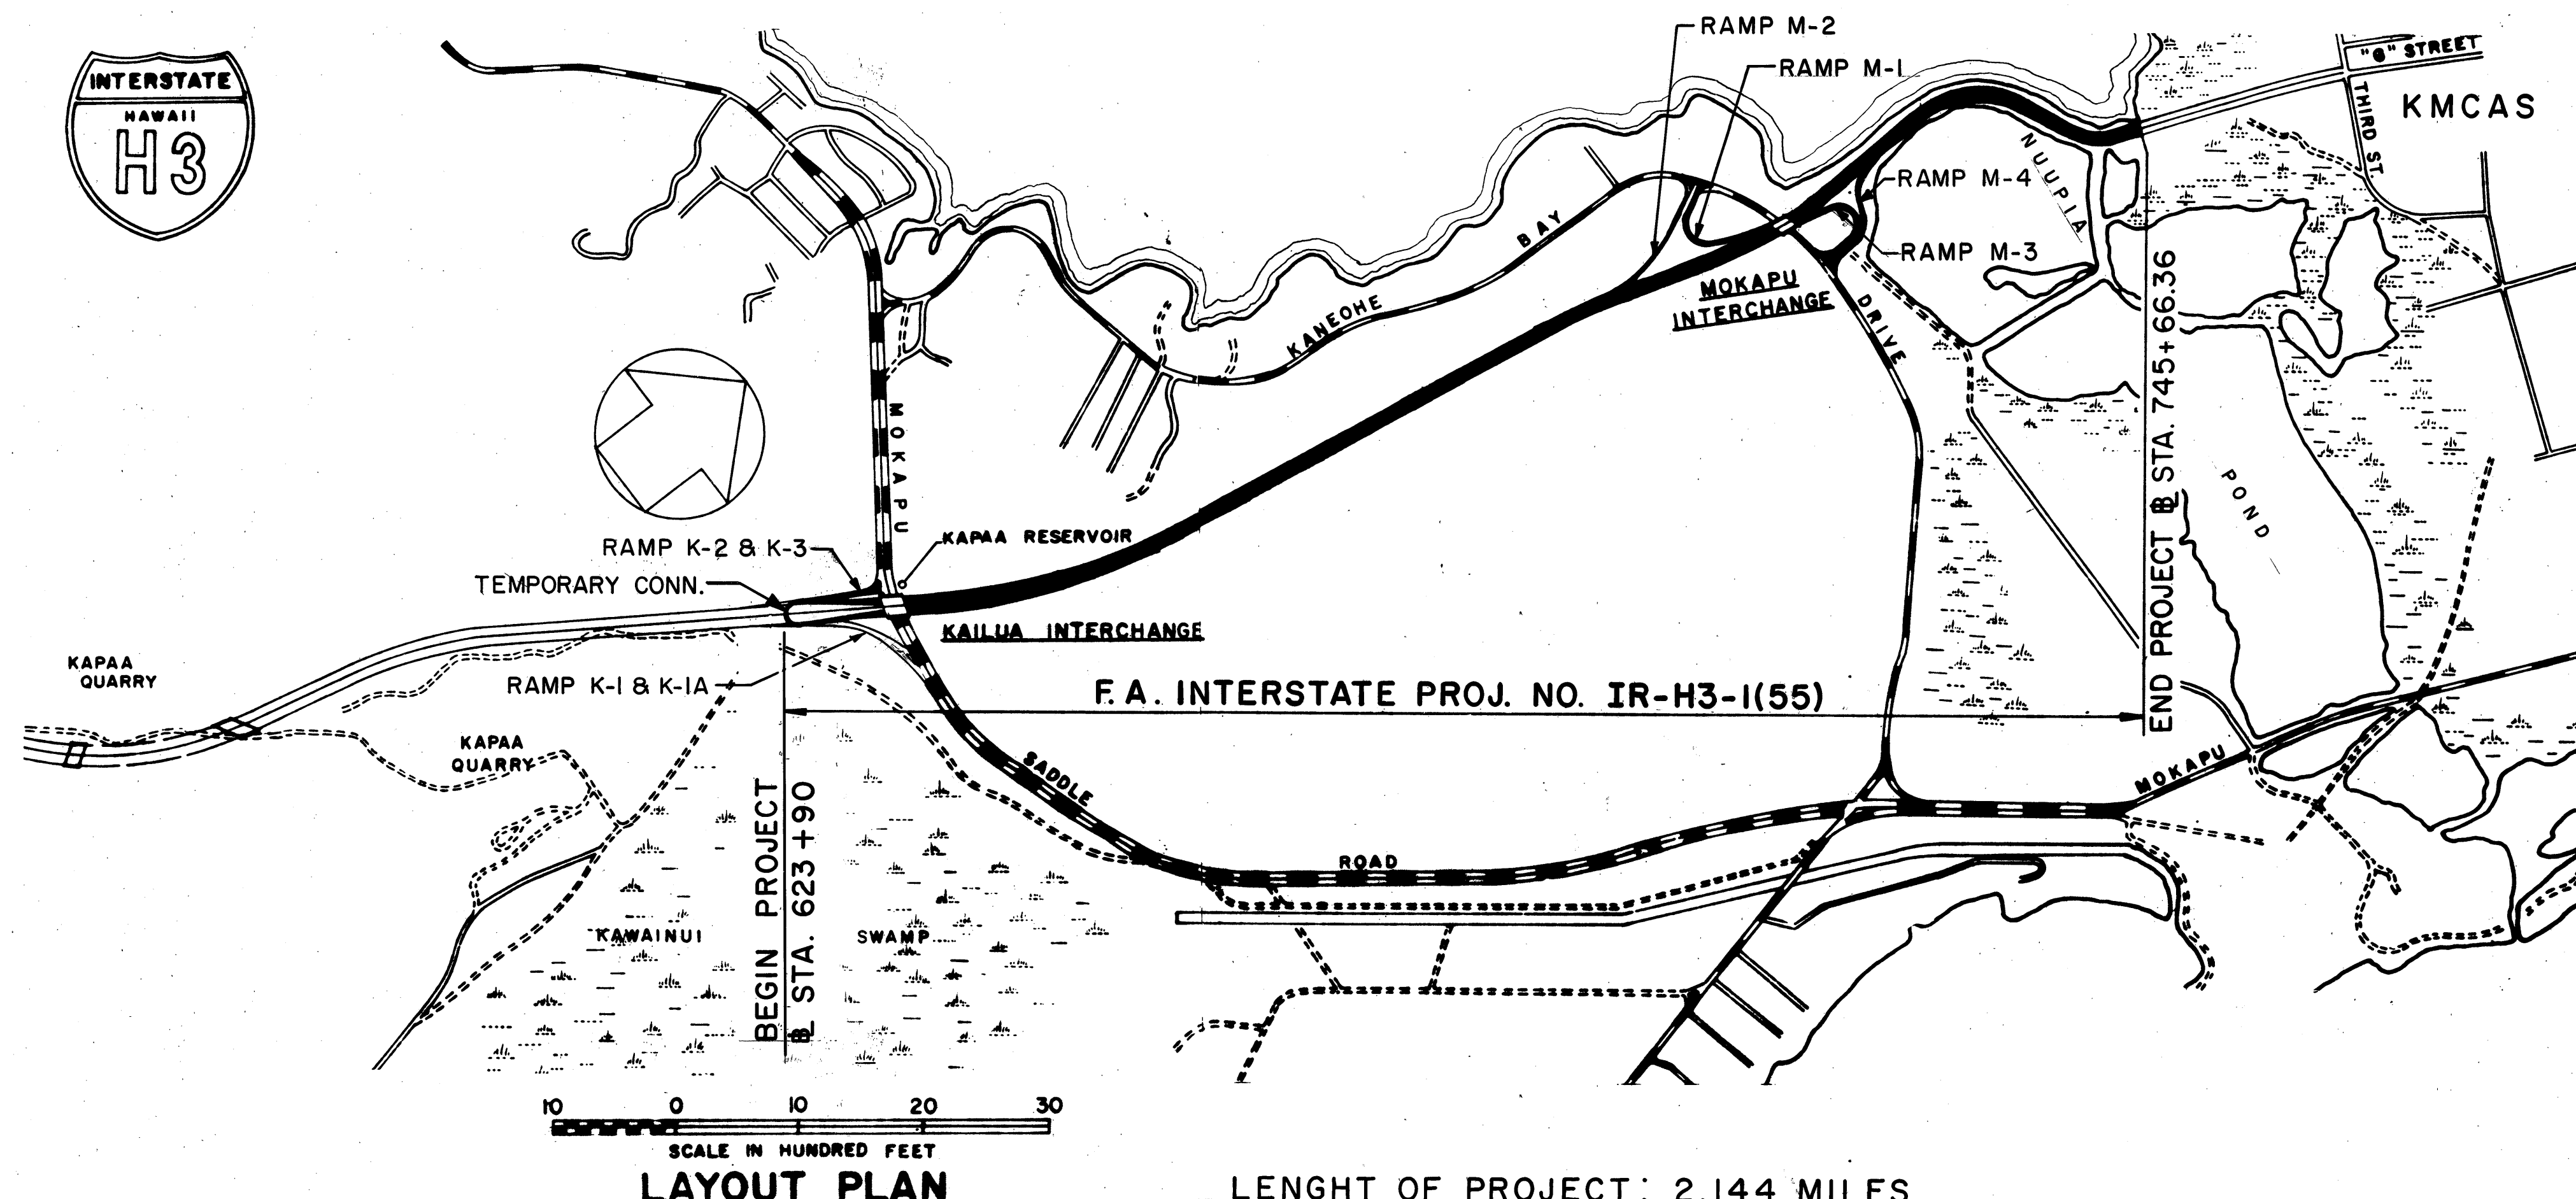

LENGHT OF PROJECT: 2.144 MILES