


FED. ROAD DIST. NO.	STATE	FED. AID PROJ. NO.	FISCAL YEAR	SHEET NO.	TOTAL SHEETS
HAWAII	HAW.	I-H3-1(29)13	1978	32	36

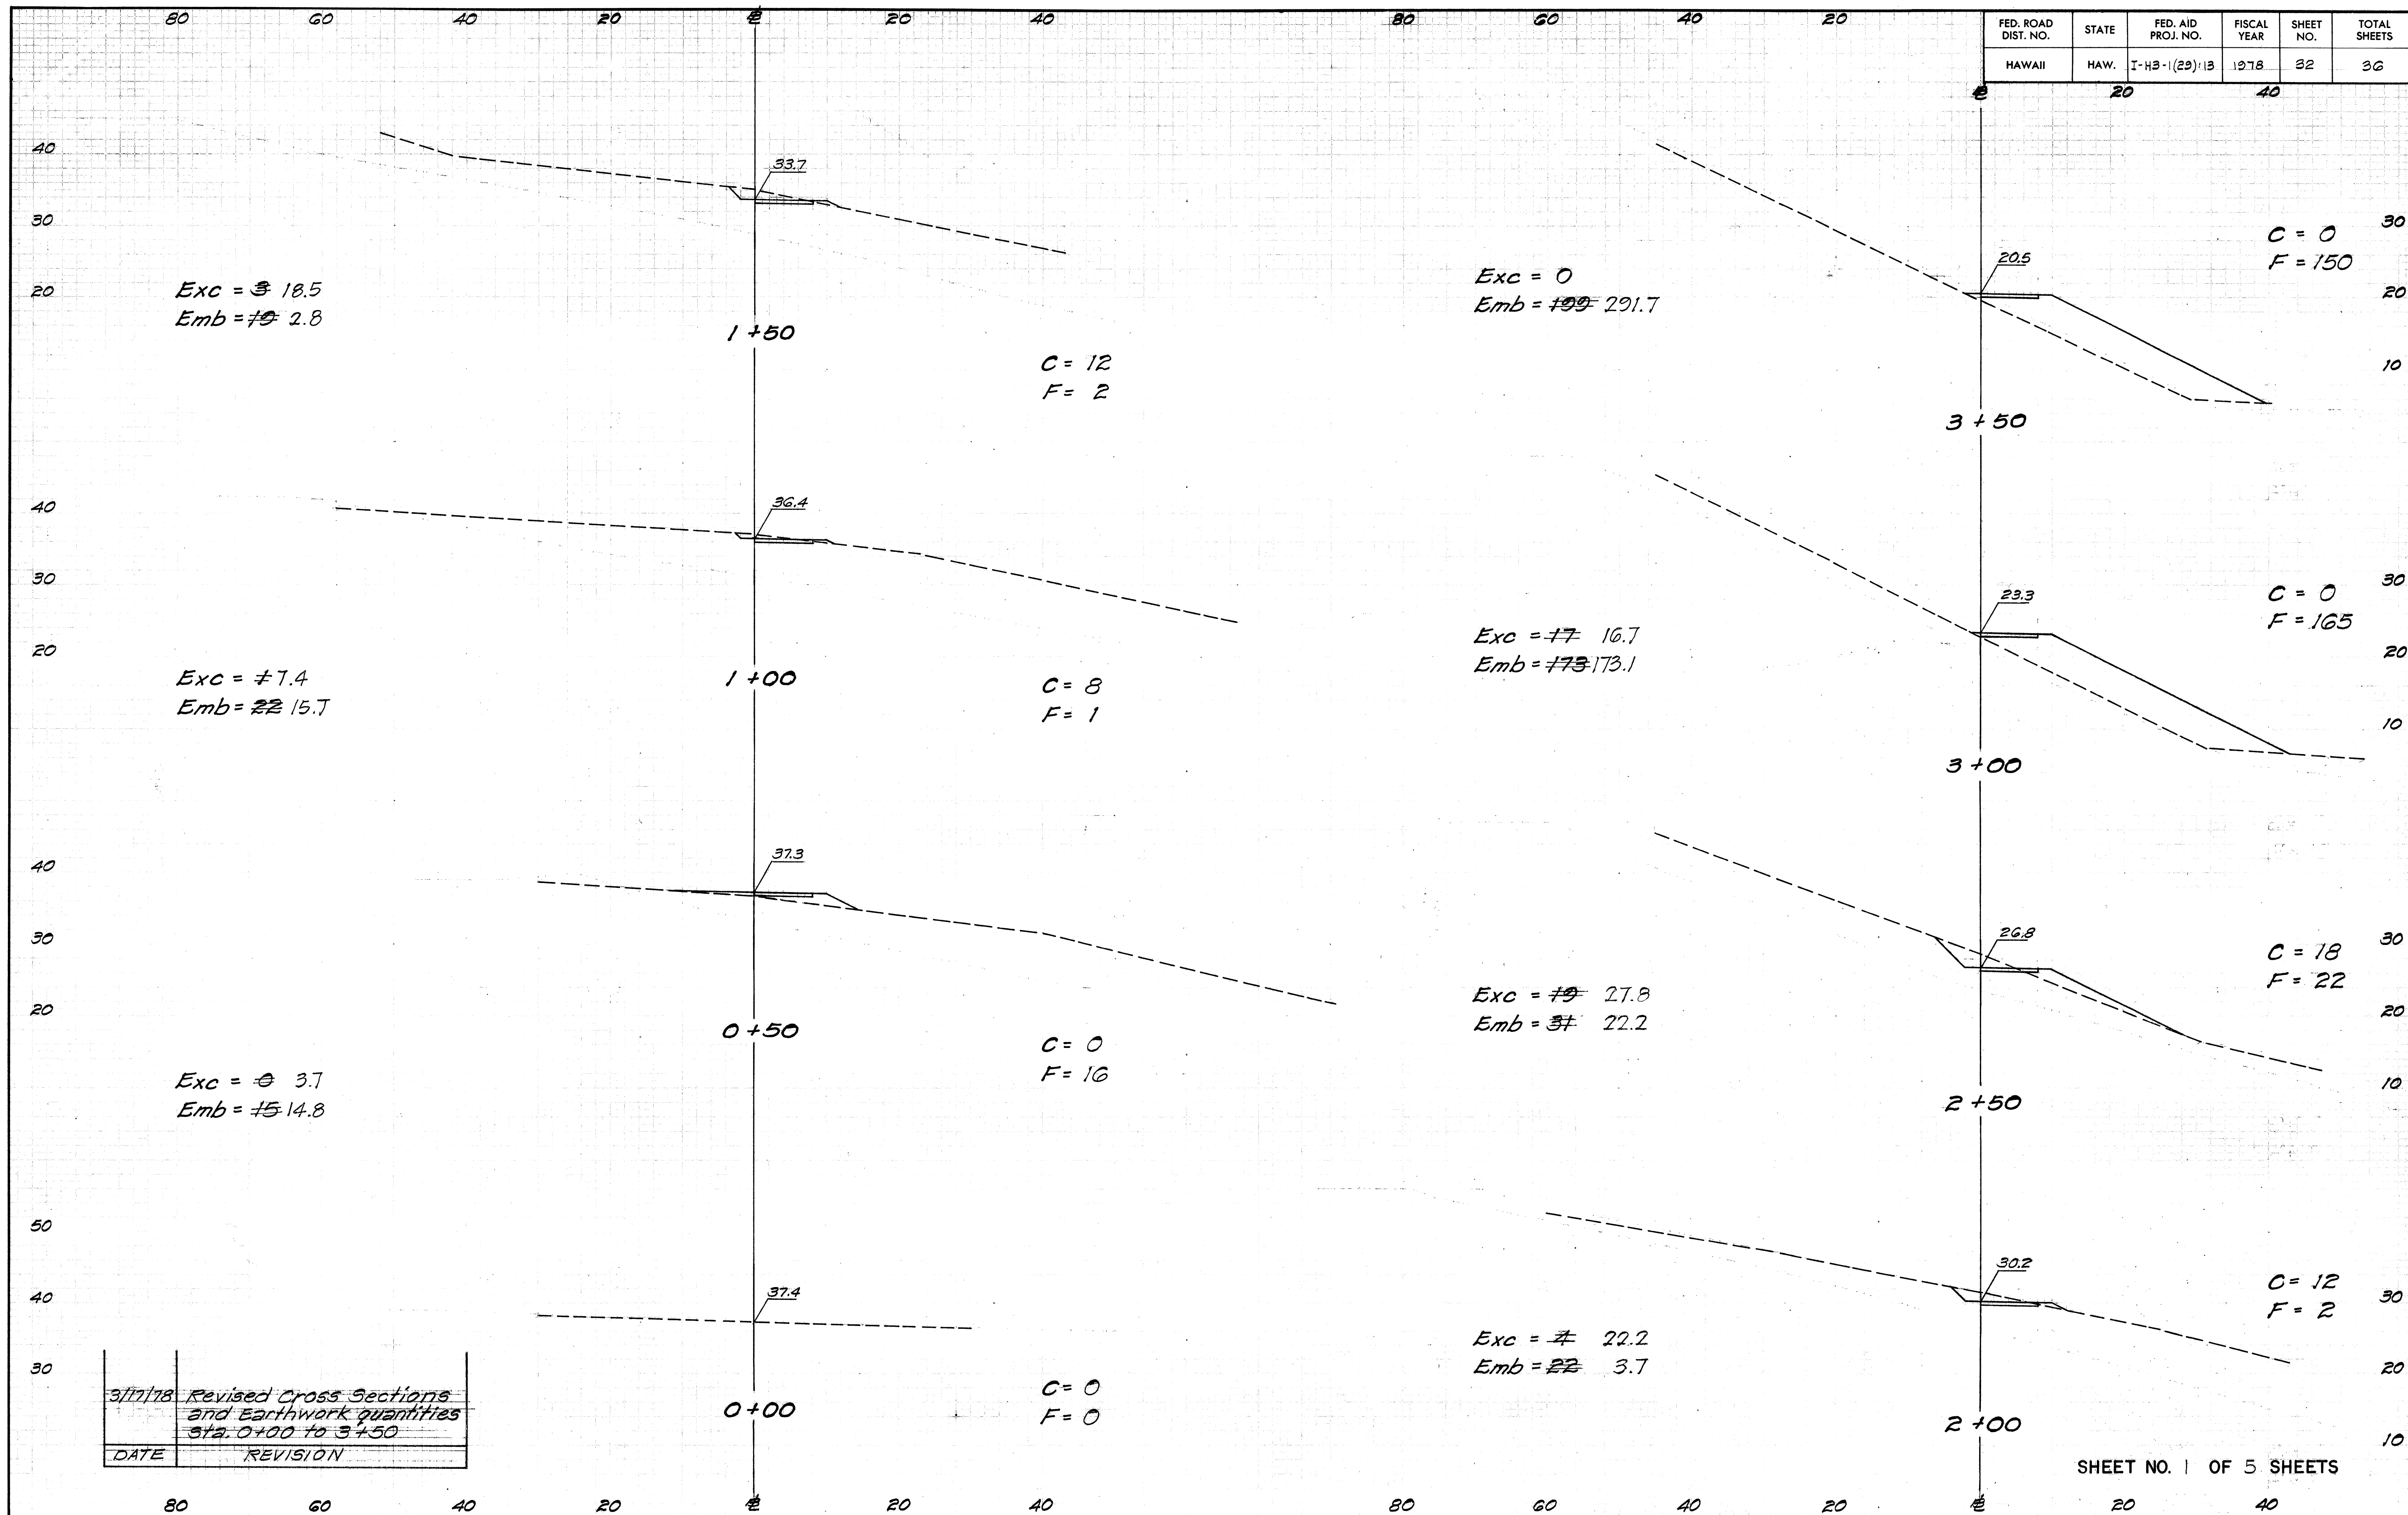


3/17/78	Revised Cross Sections and Earthwork quantities Sta. 0+00 to 3+50
DATE	REVISION

SHEET NO. 1 OF 5 SHEETS

C.O.32

FED. ROAD DIST. NO.	STATE	FED. AID PROJ. NO.	FISCAL YEAR	SHEET NO.	TOTAL SHEETS
HAWAII	HAW.	I-H3-1(23)13	1978	33	36

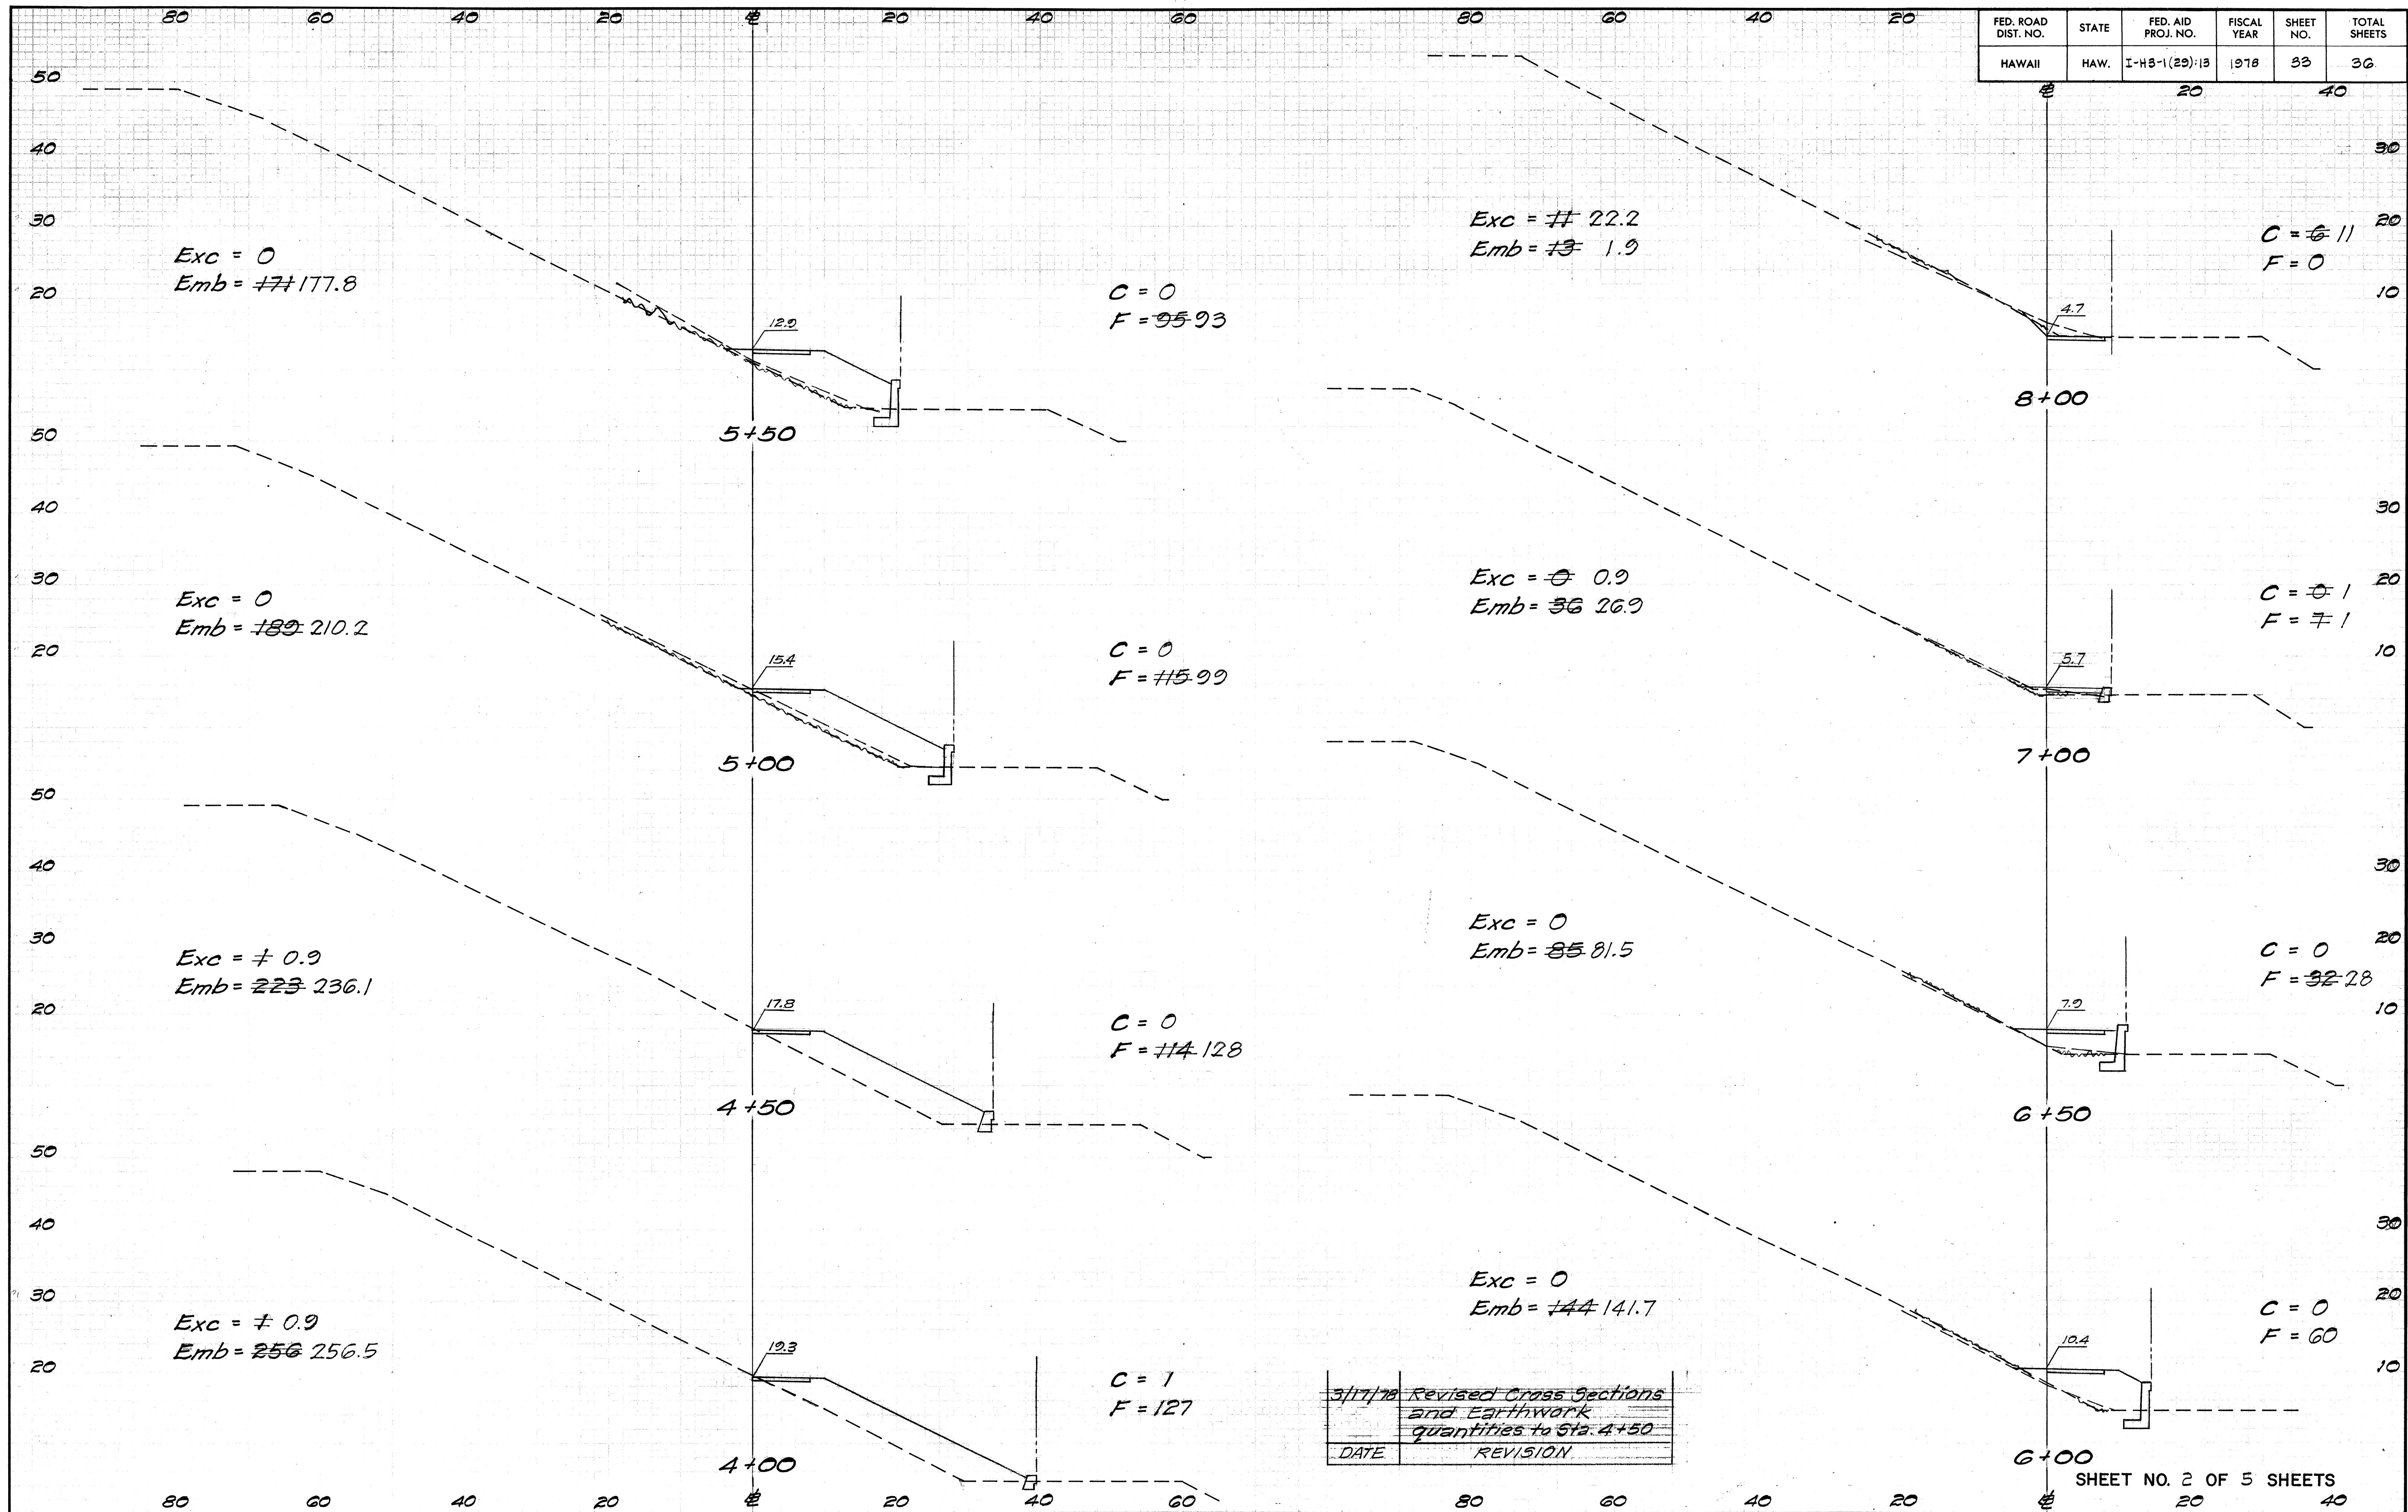


3/17/78	Revised Cross Sections and Earthwork quantities to Sta. 4+50
DATE	REVISION

SHEET NO. 2 OF 5 SHEETS


C.O.33

FED. ROAD DIST. NO.	STATE	FED. AID PROJ. NO.	FISCAL YEAR	SHEET NO.	TOTAL SHEETS
HAWAII	HAW.	I-H3-1(29)-13	1978	34	36

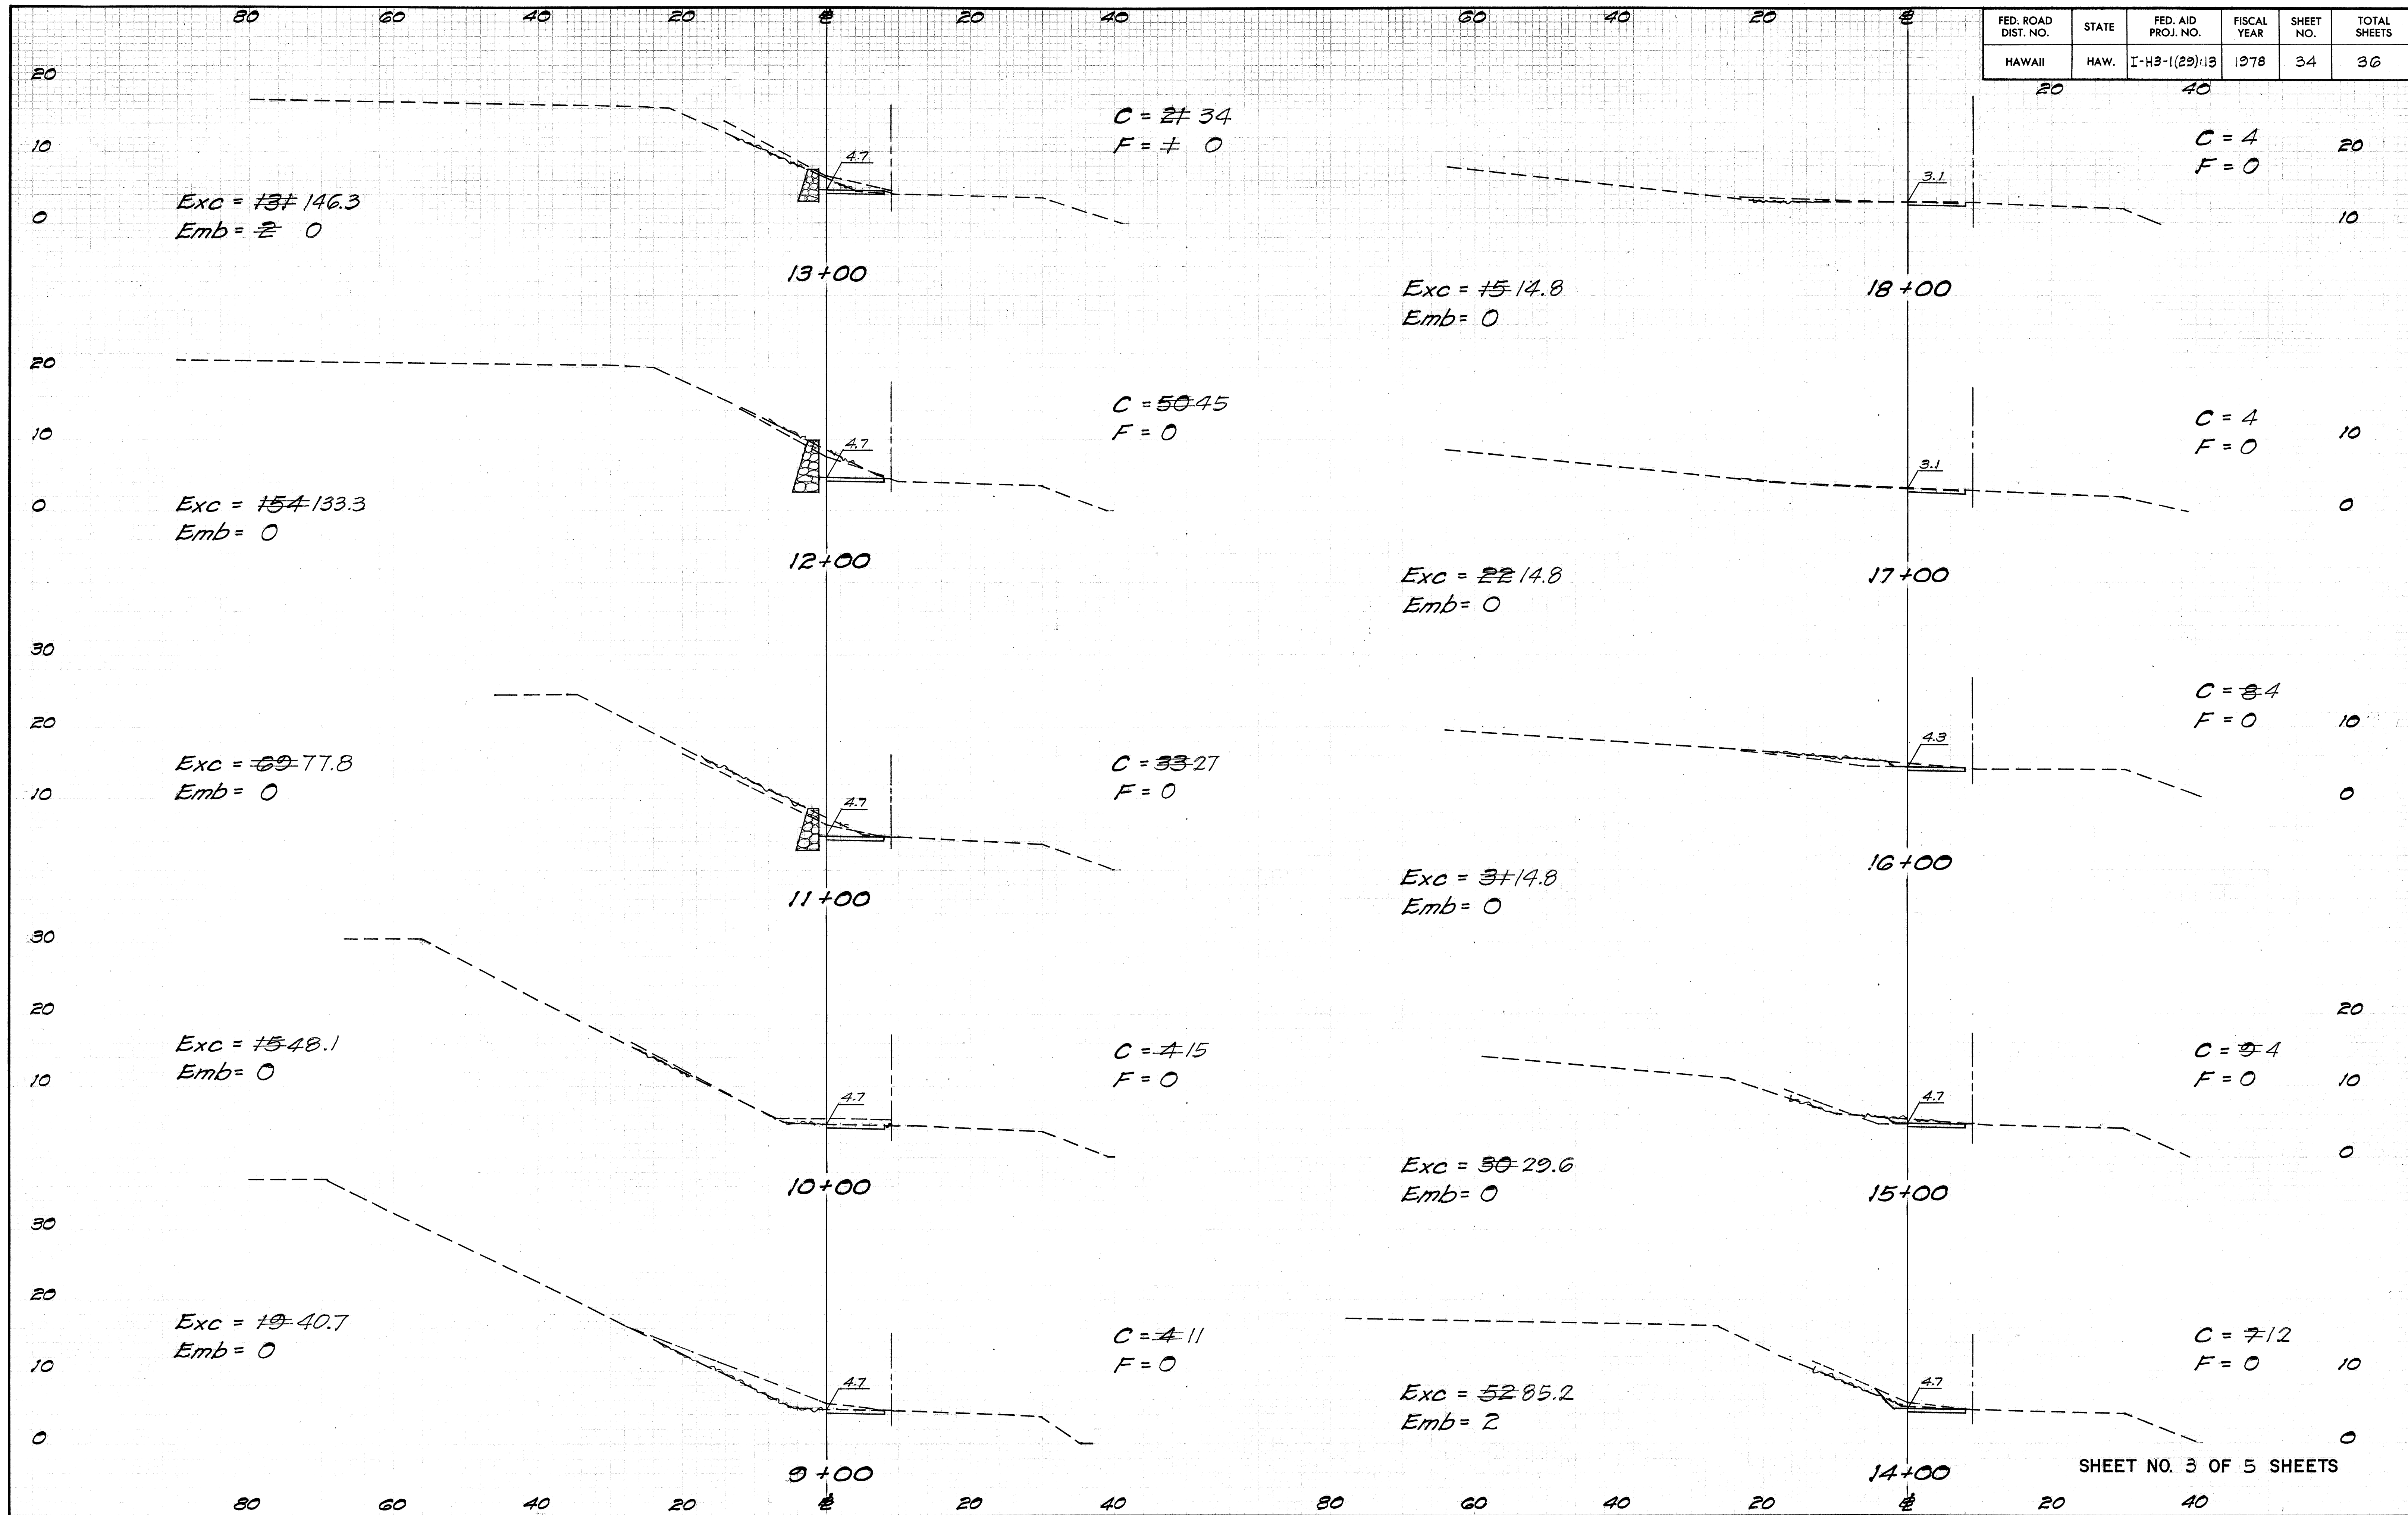


SHEET NO. 3 OF 5 SHEETS

FED. ROAD DIST. NO.	STATE	FED. AID PROJ. NO.	FISCAL YEAR	SHEET NO.	TOTAL SHEETS
HAWAII	HAW.	I-H3-1(29)13	1978	35	36

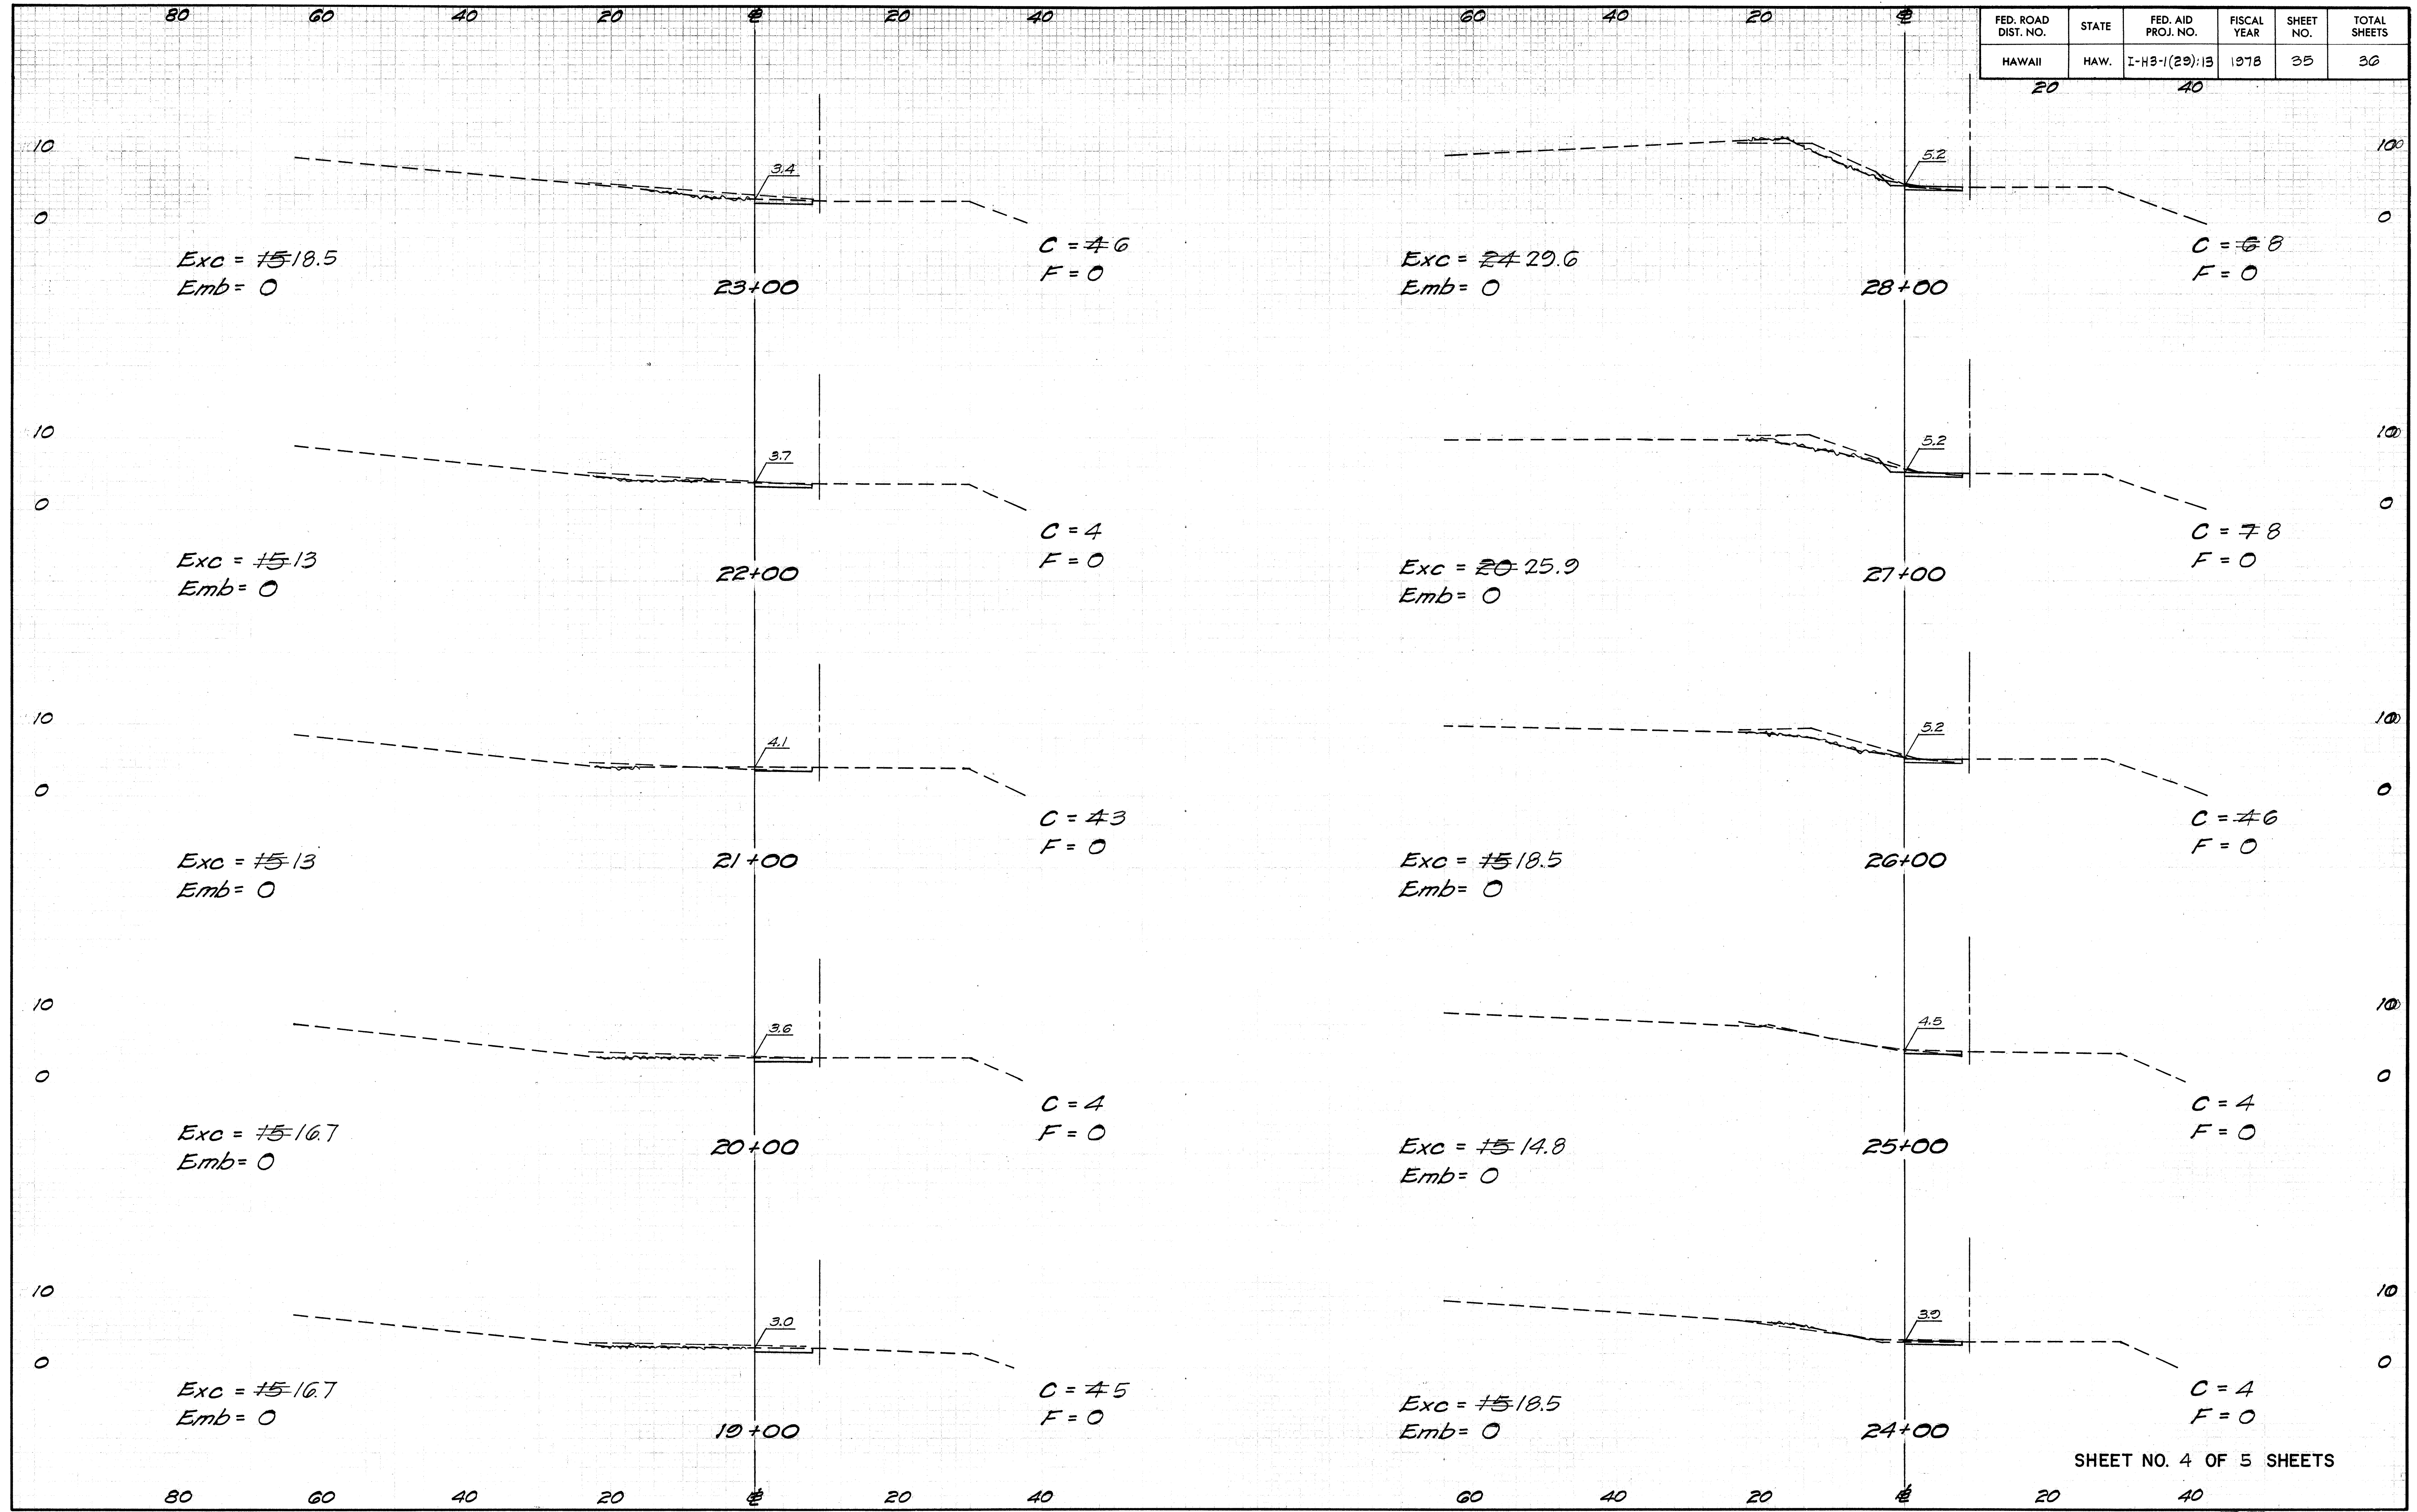

SHEET NO. 4 OF 5 SHEETS

FED. ROAD DIST. NO.	STATE	FED. AID PROJ. NO.	FISCAL YEAR	SHEET NO.	TOTAL SHEETS
HAWAII	HAW.	I-H-1-(29)13	1978	36	36

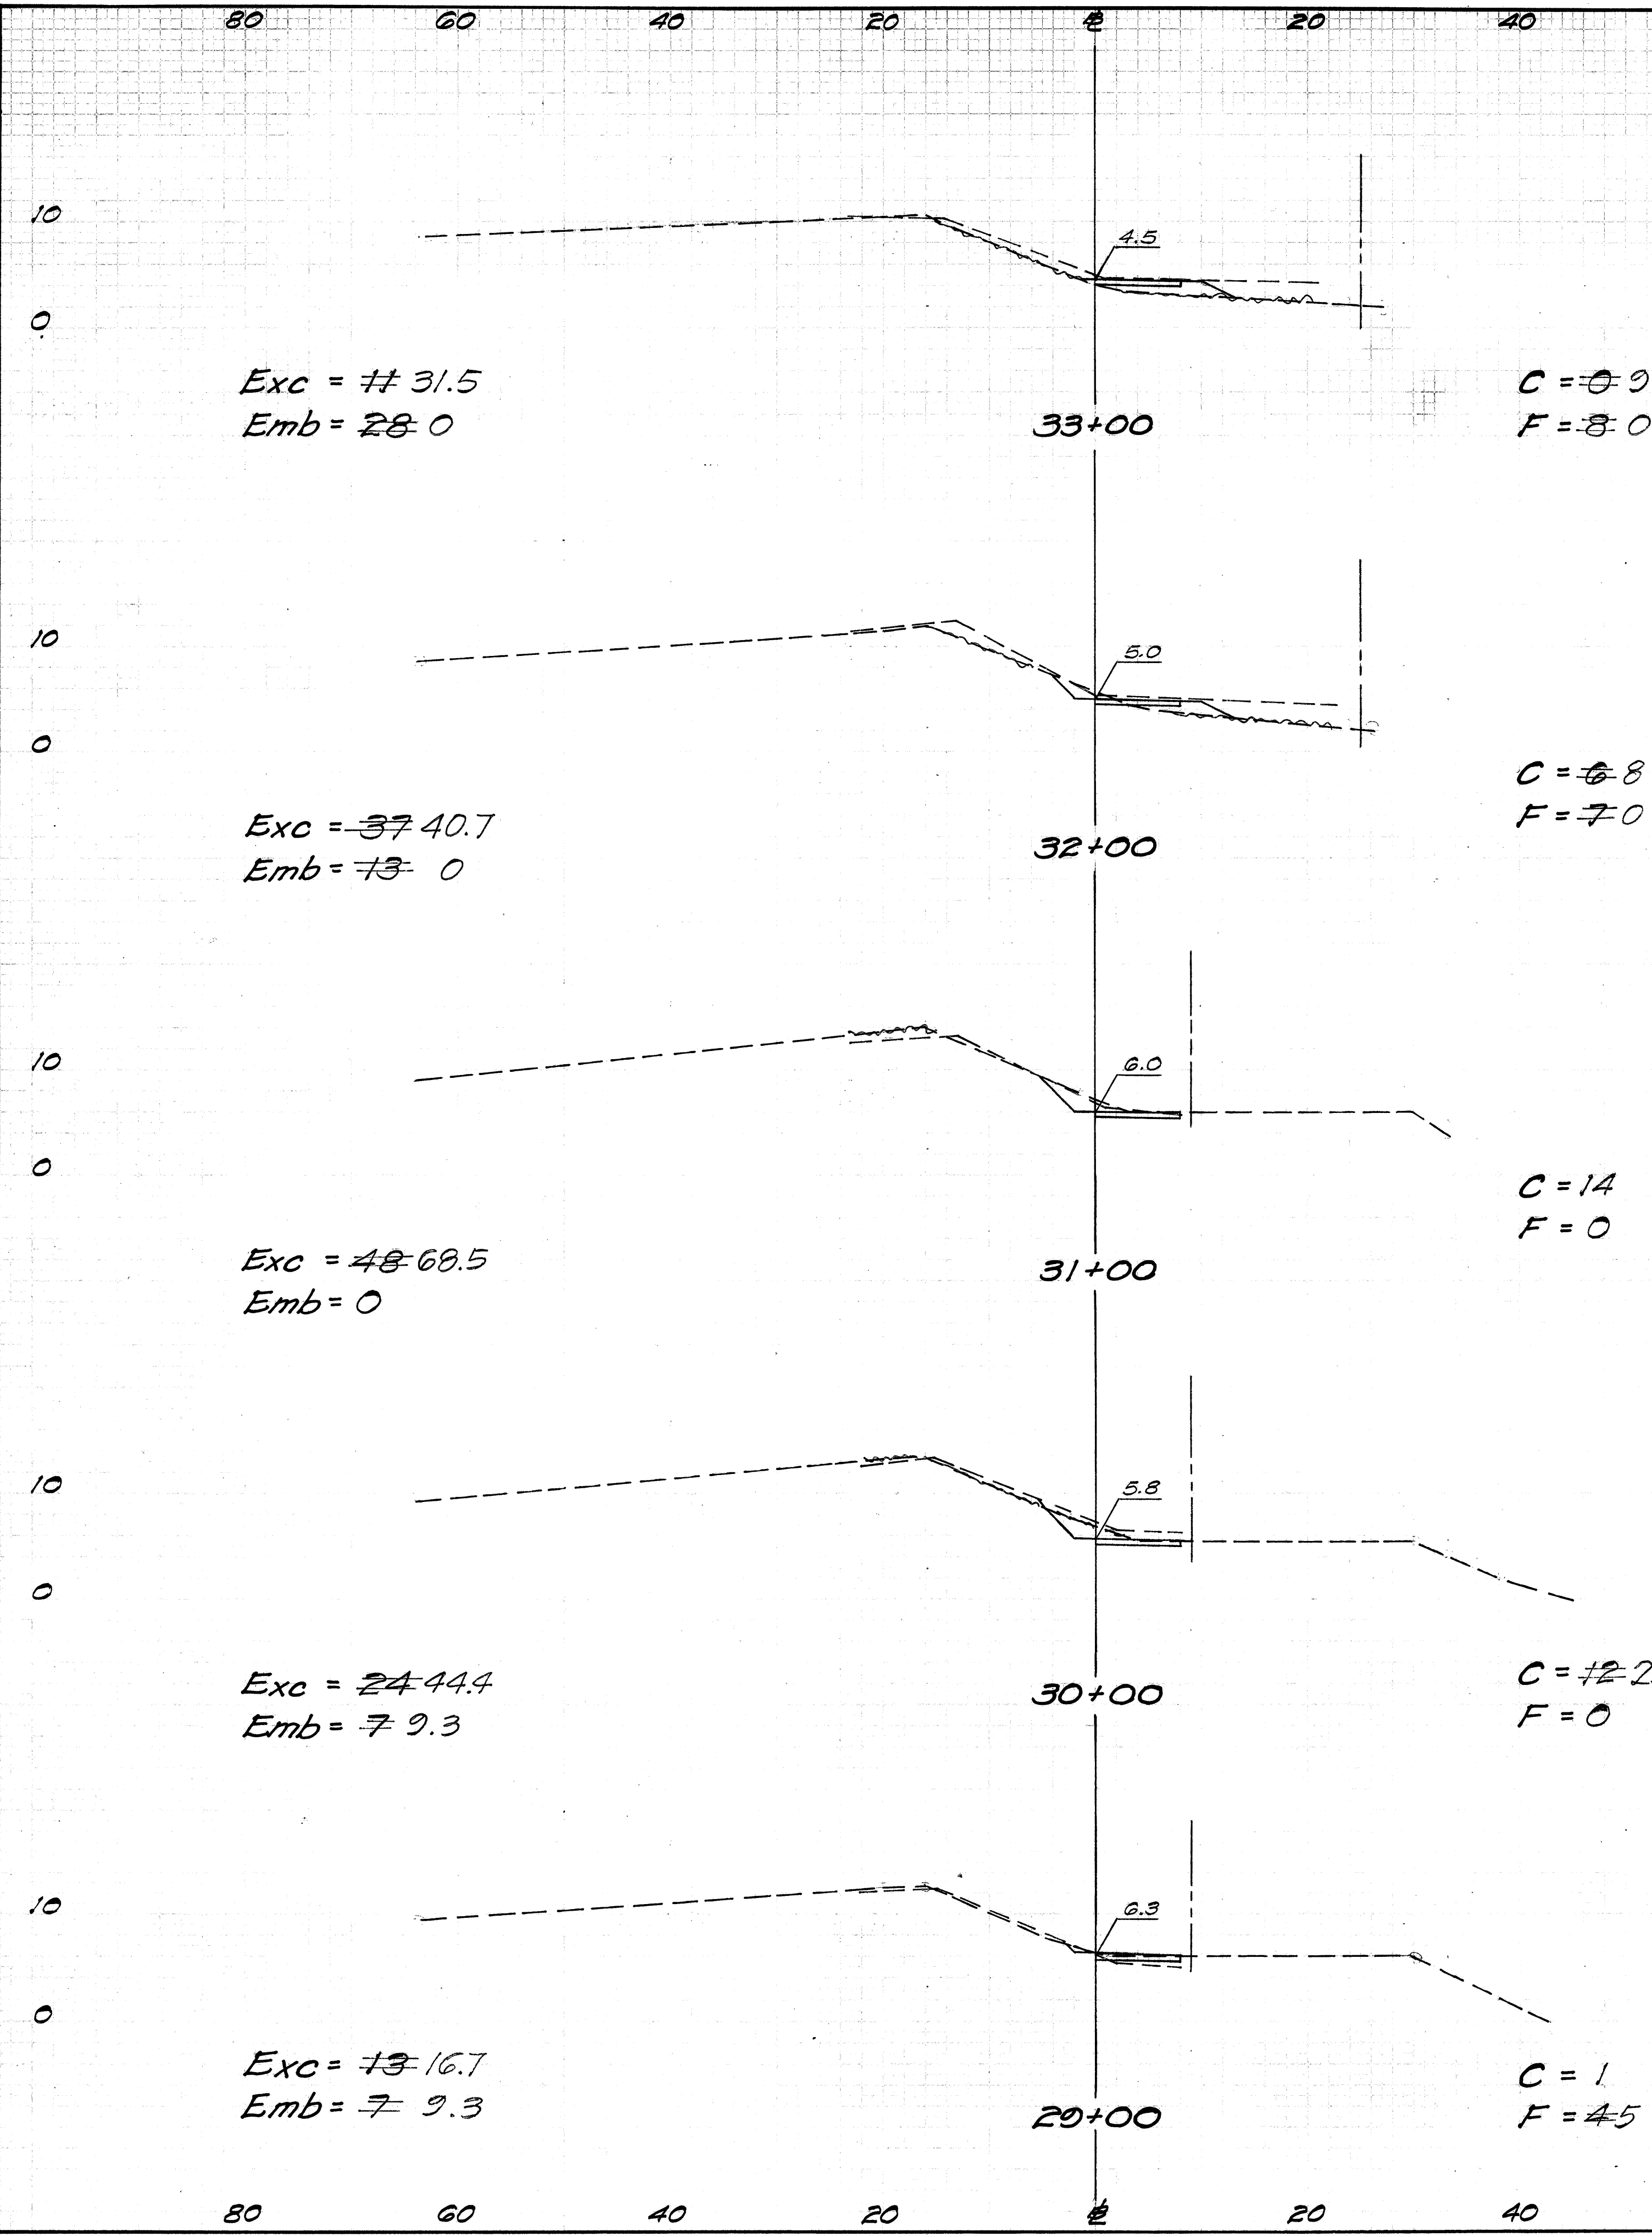

Exc = 13 22.4 ⁴⁸ Sta. 36+40 to
 Emb = 0 Sta. 37+90 99

Exc = 3.5
 Emb = 0

Exc = 28 39.7
 Emb = 2 0


Exc = 22 23.3
 Emb = 23 25.4

Exc =
 Emb =

Exc = 0
 Emb = 195 79.5

Exc = 0 16.7
 Emb = 126 33.3

STA. 36+40 to STA. 37+90

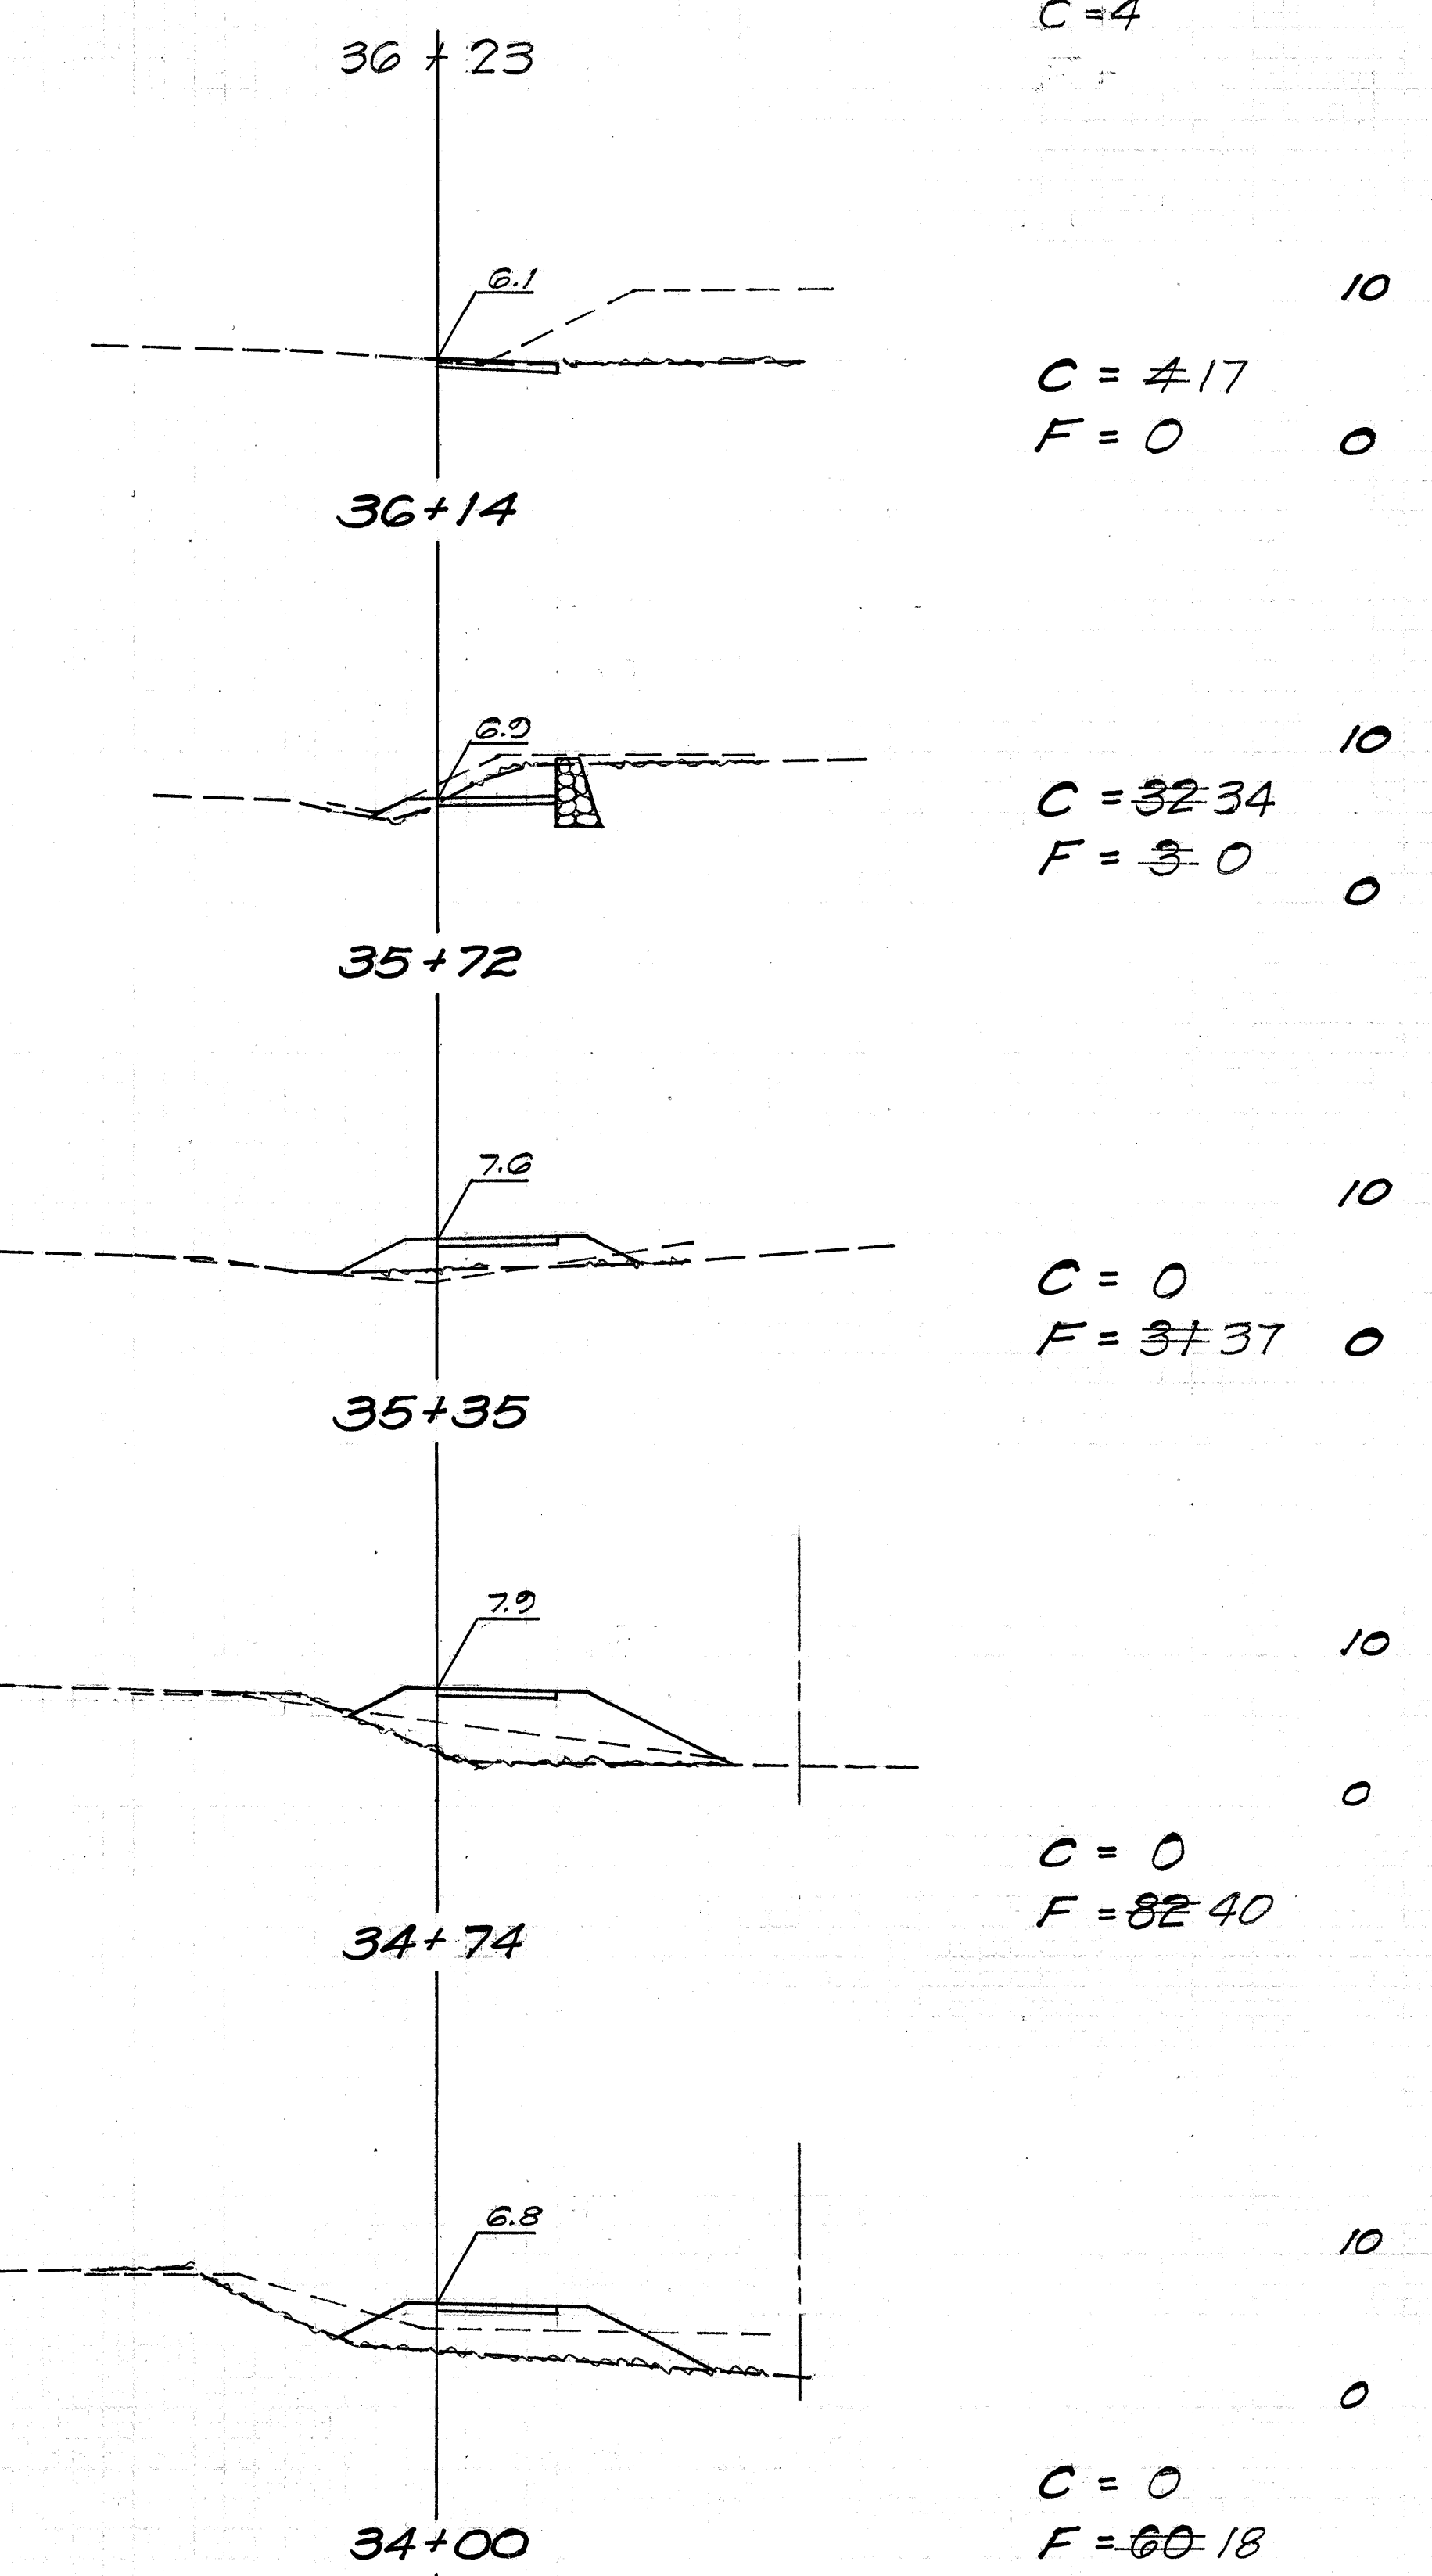

SHEET NO. 5 OF 5 SHEETS