
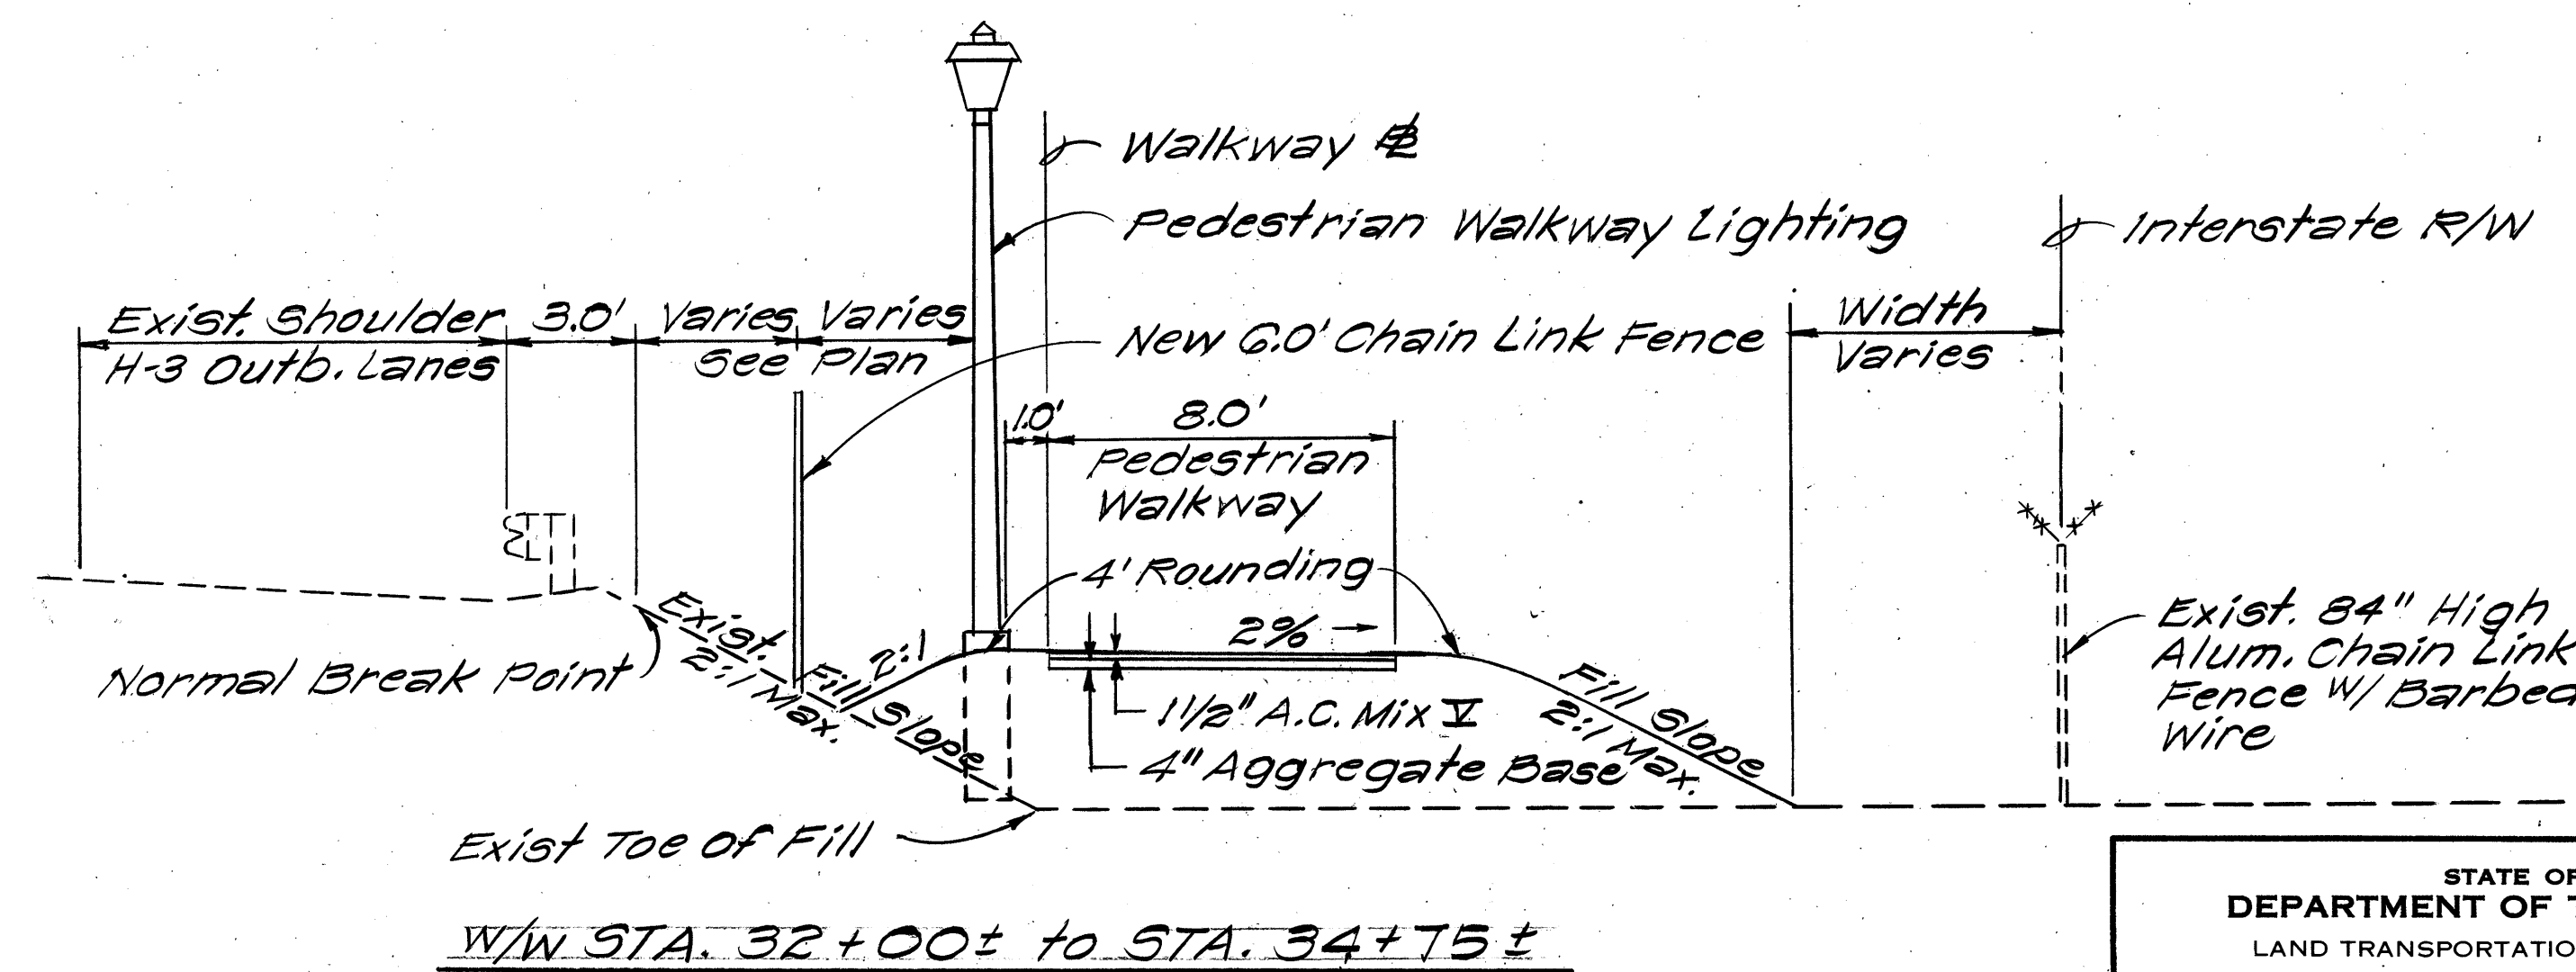
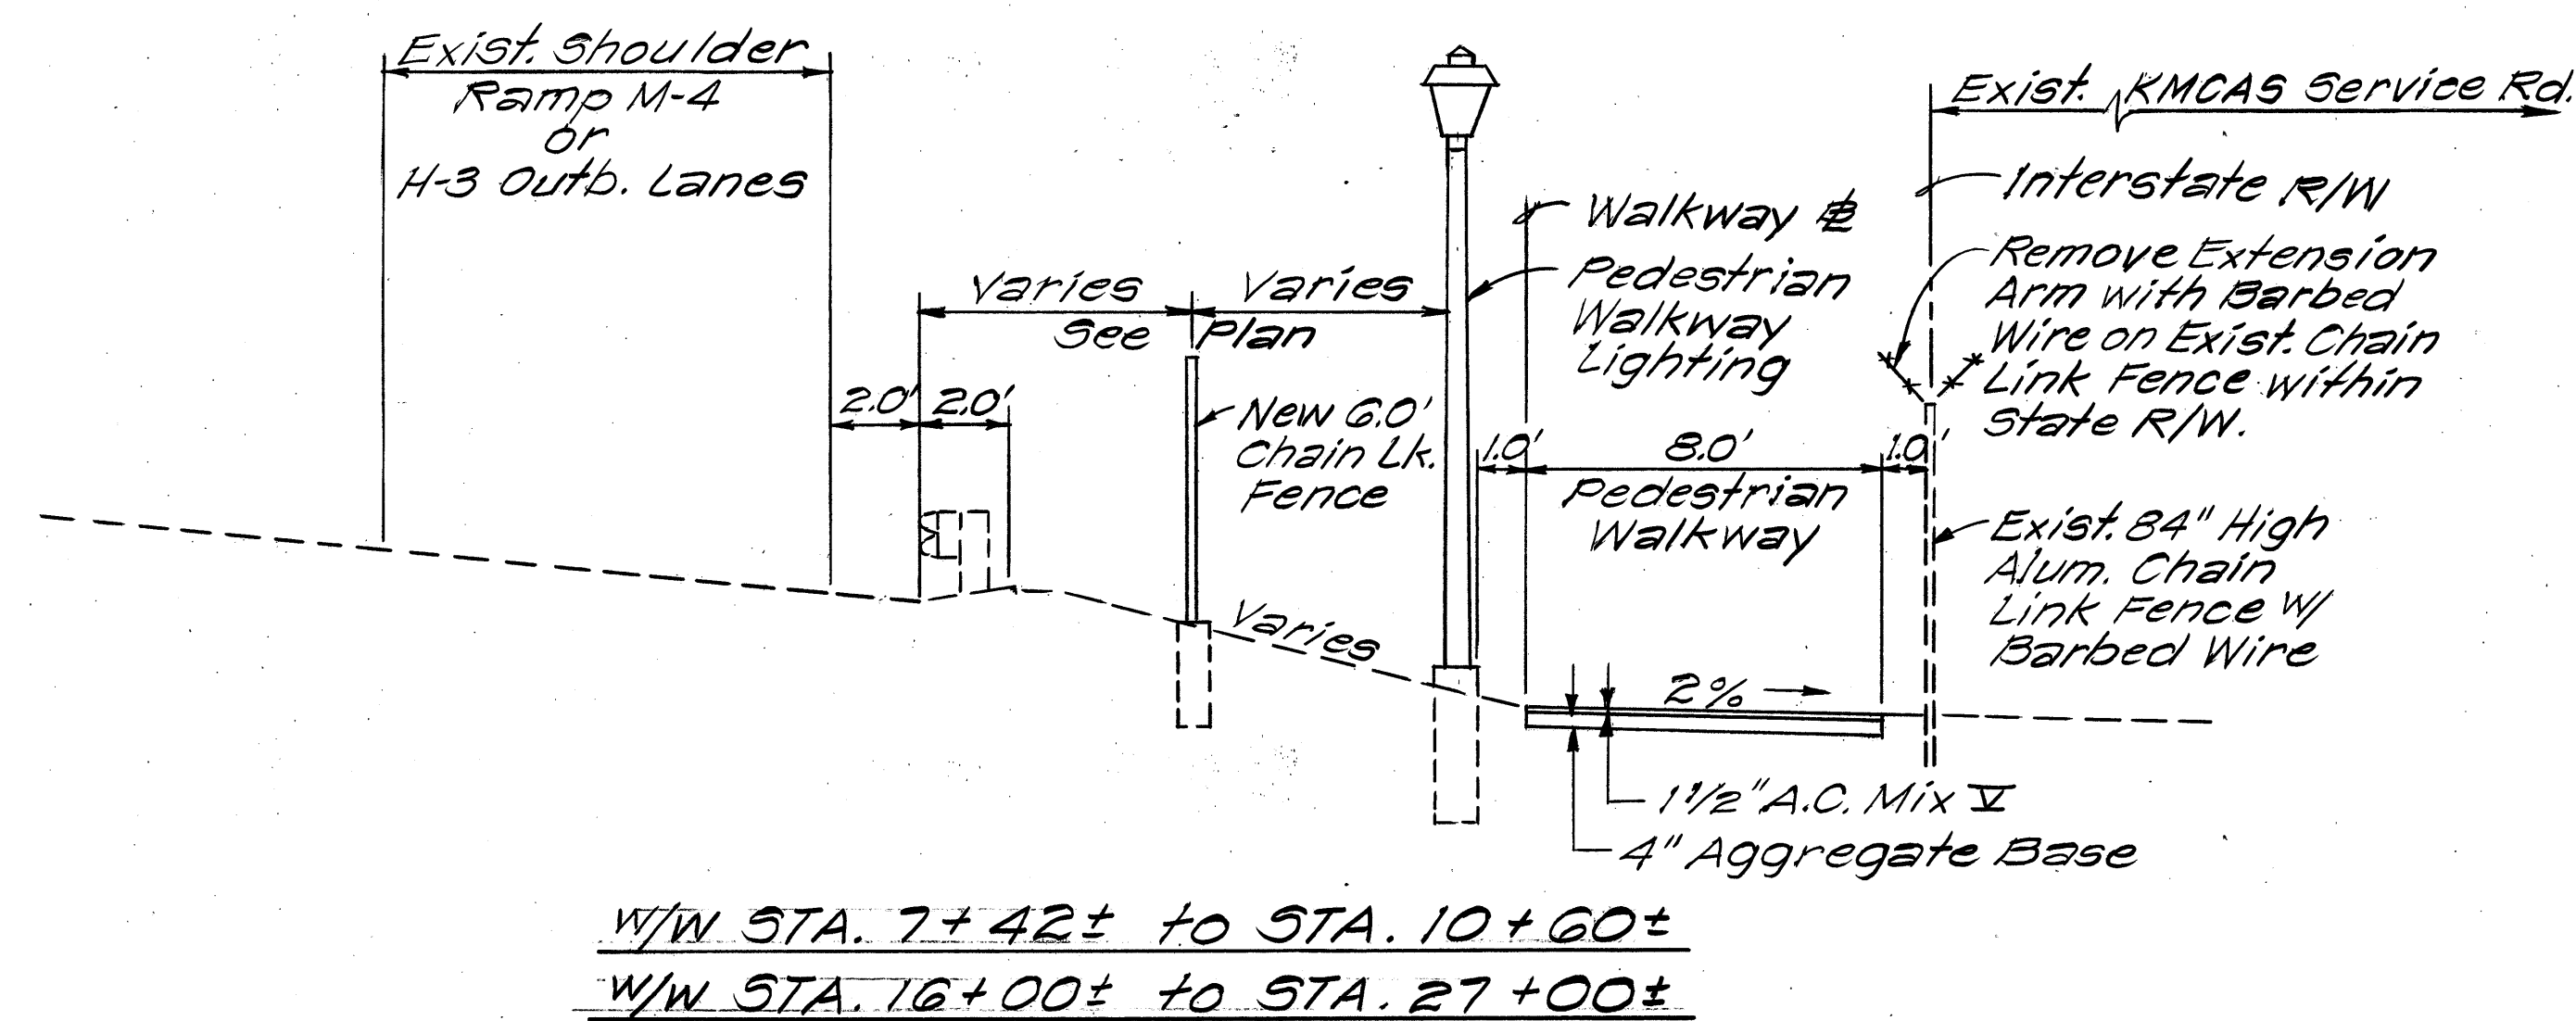
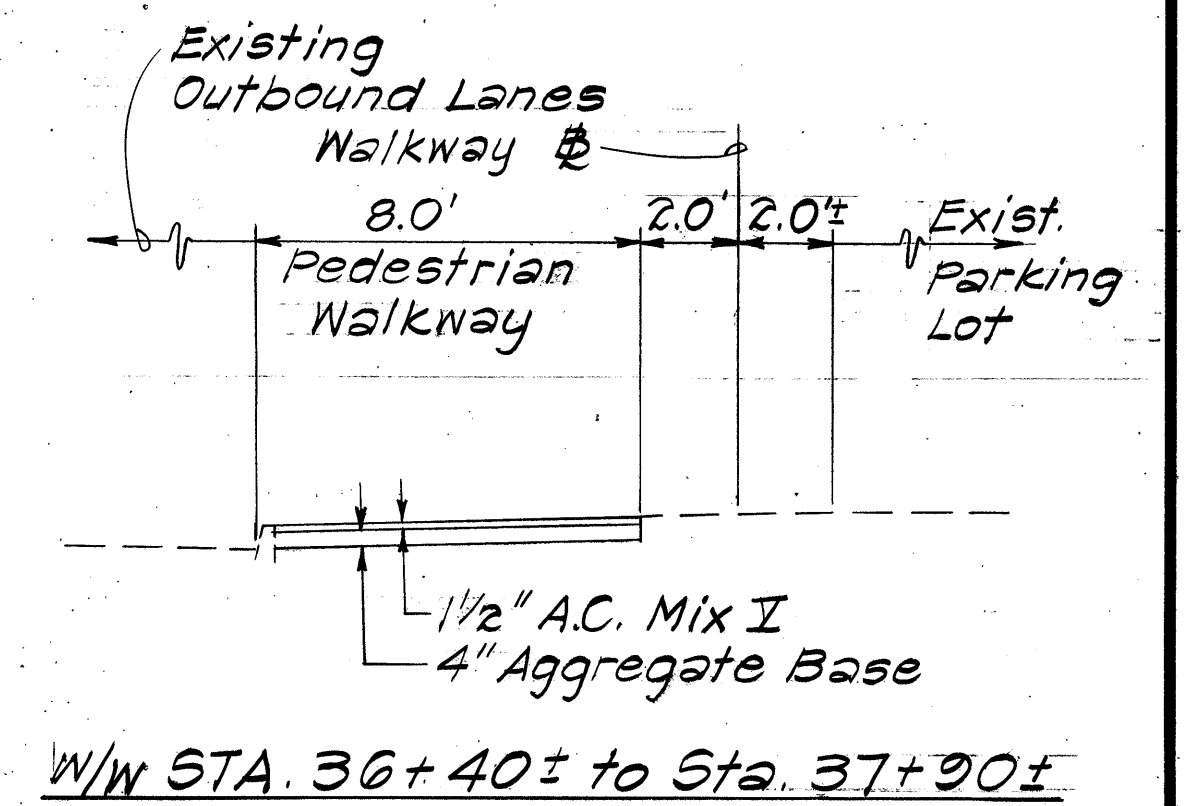
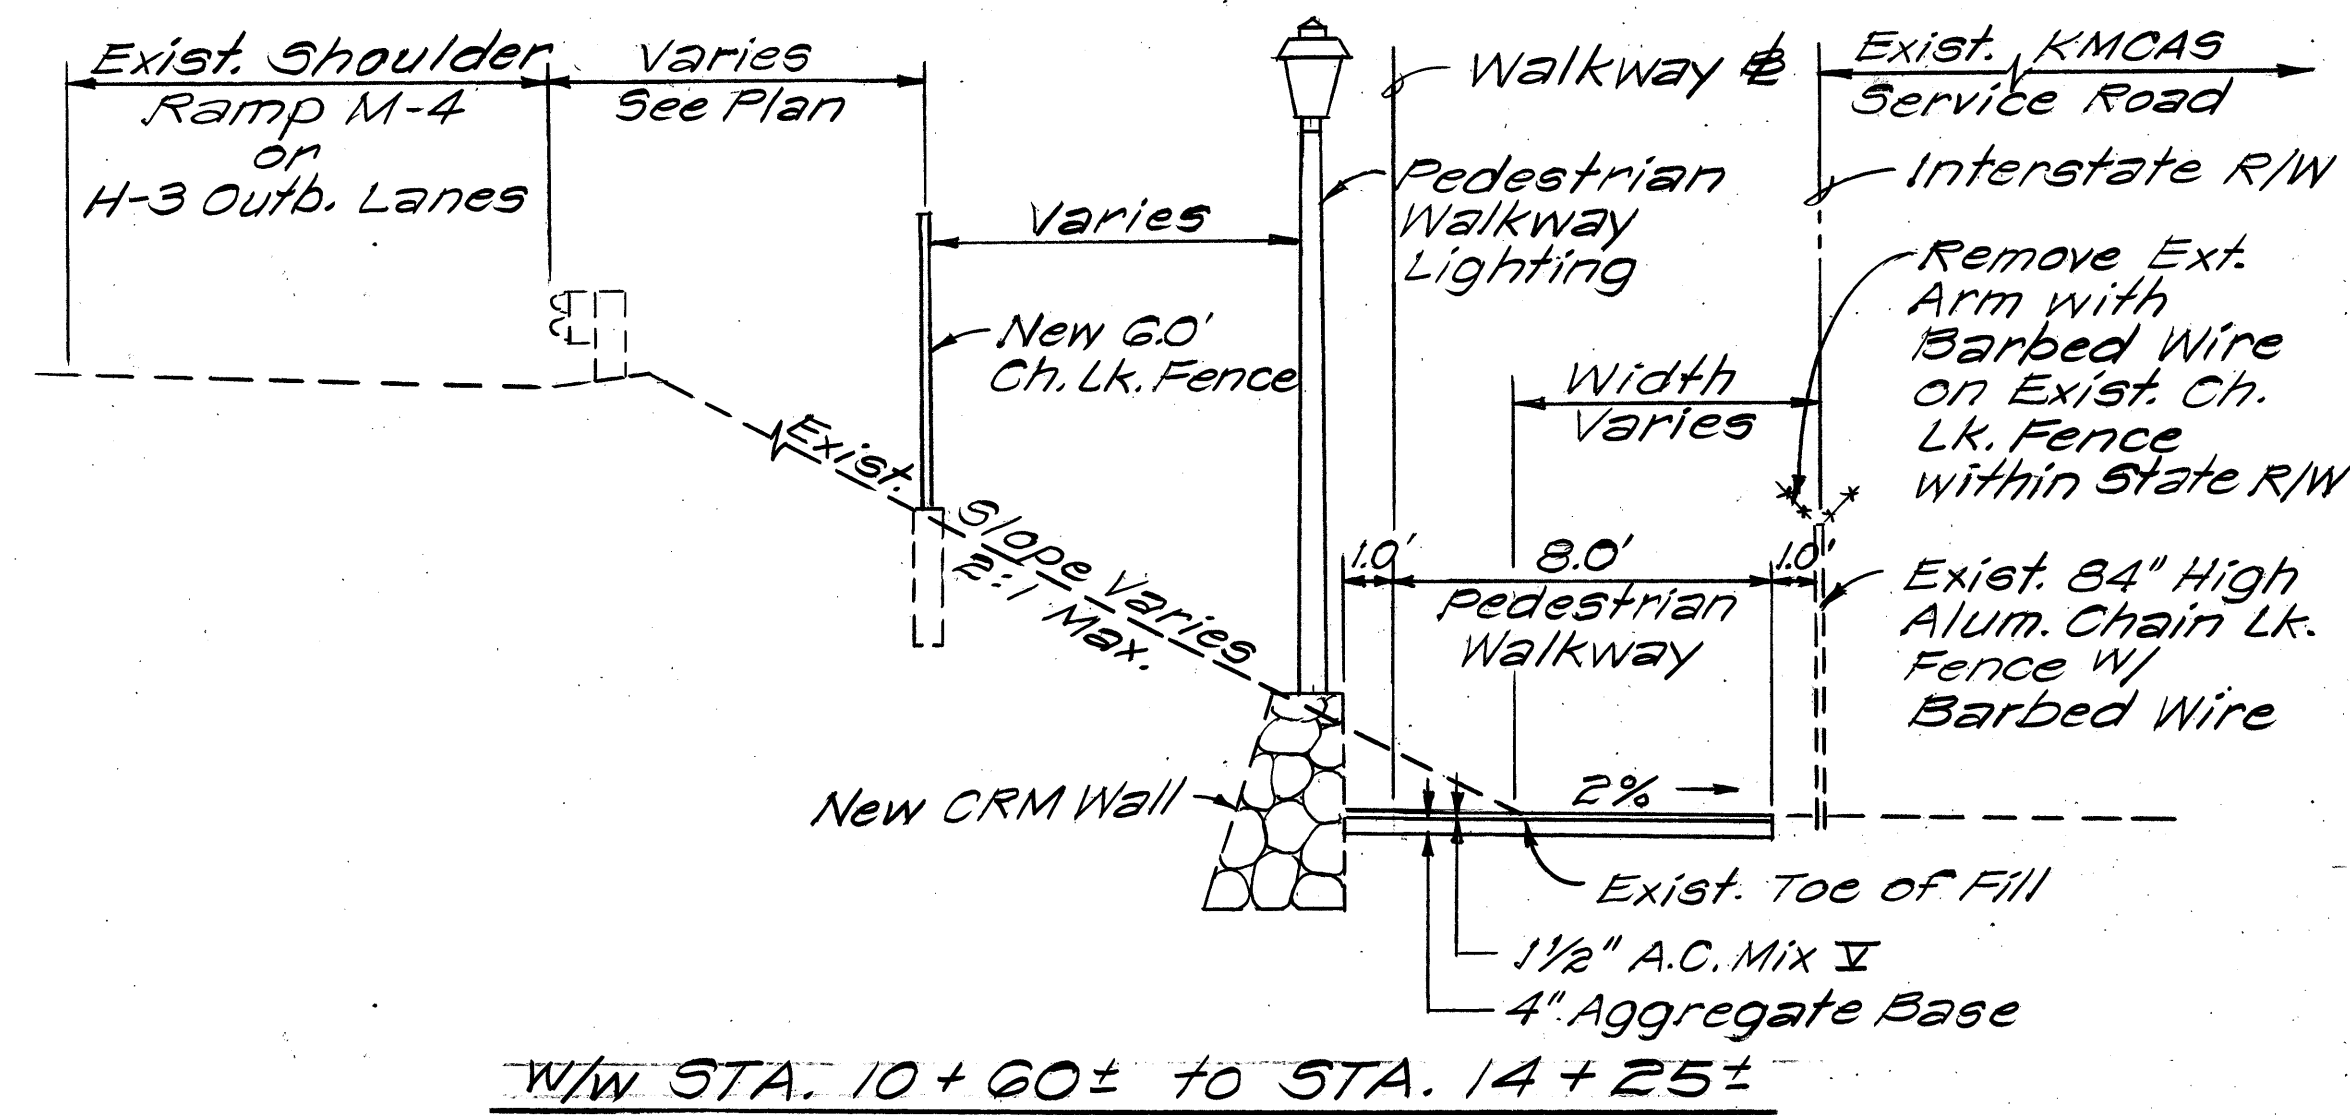
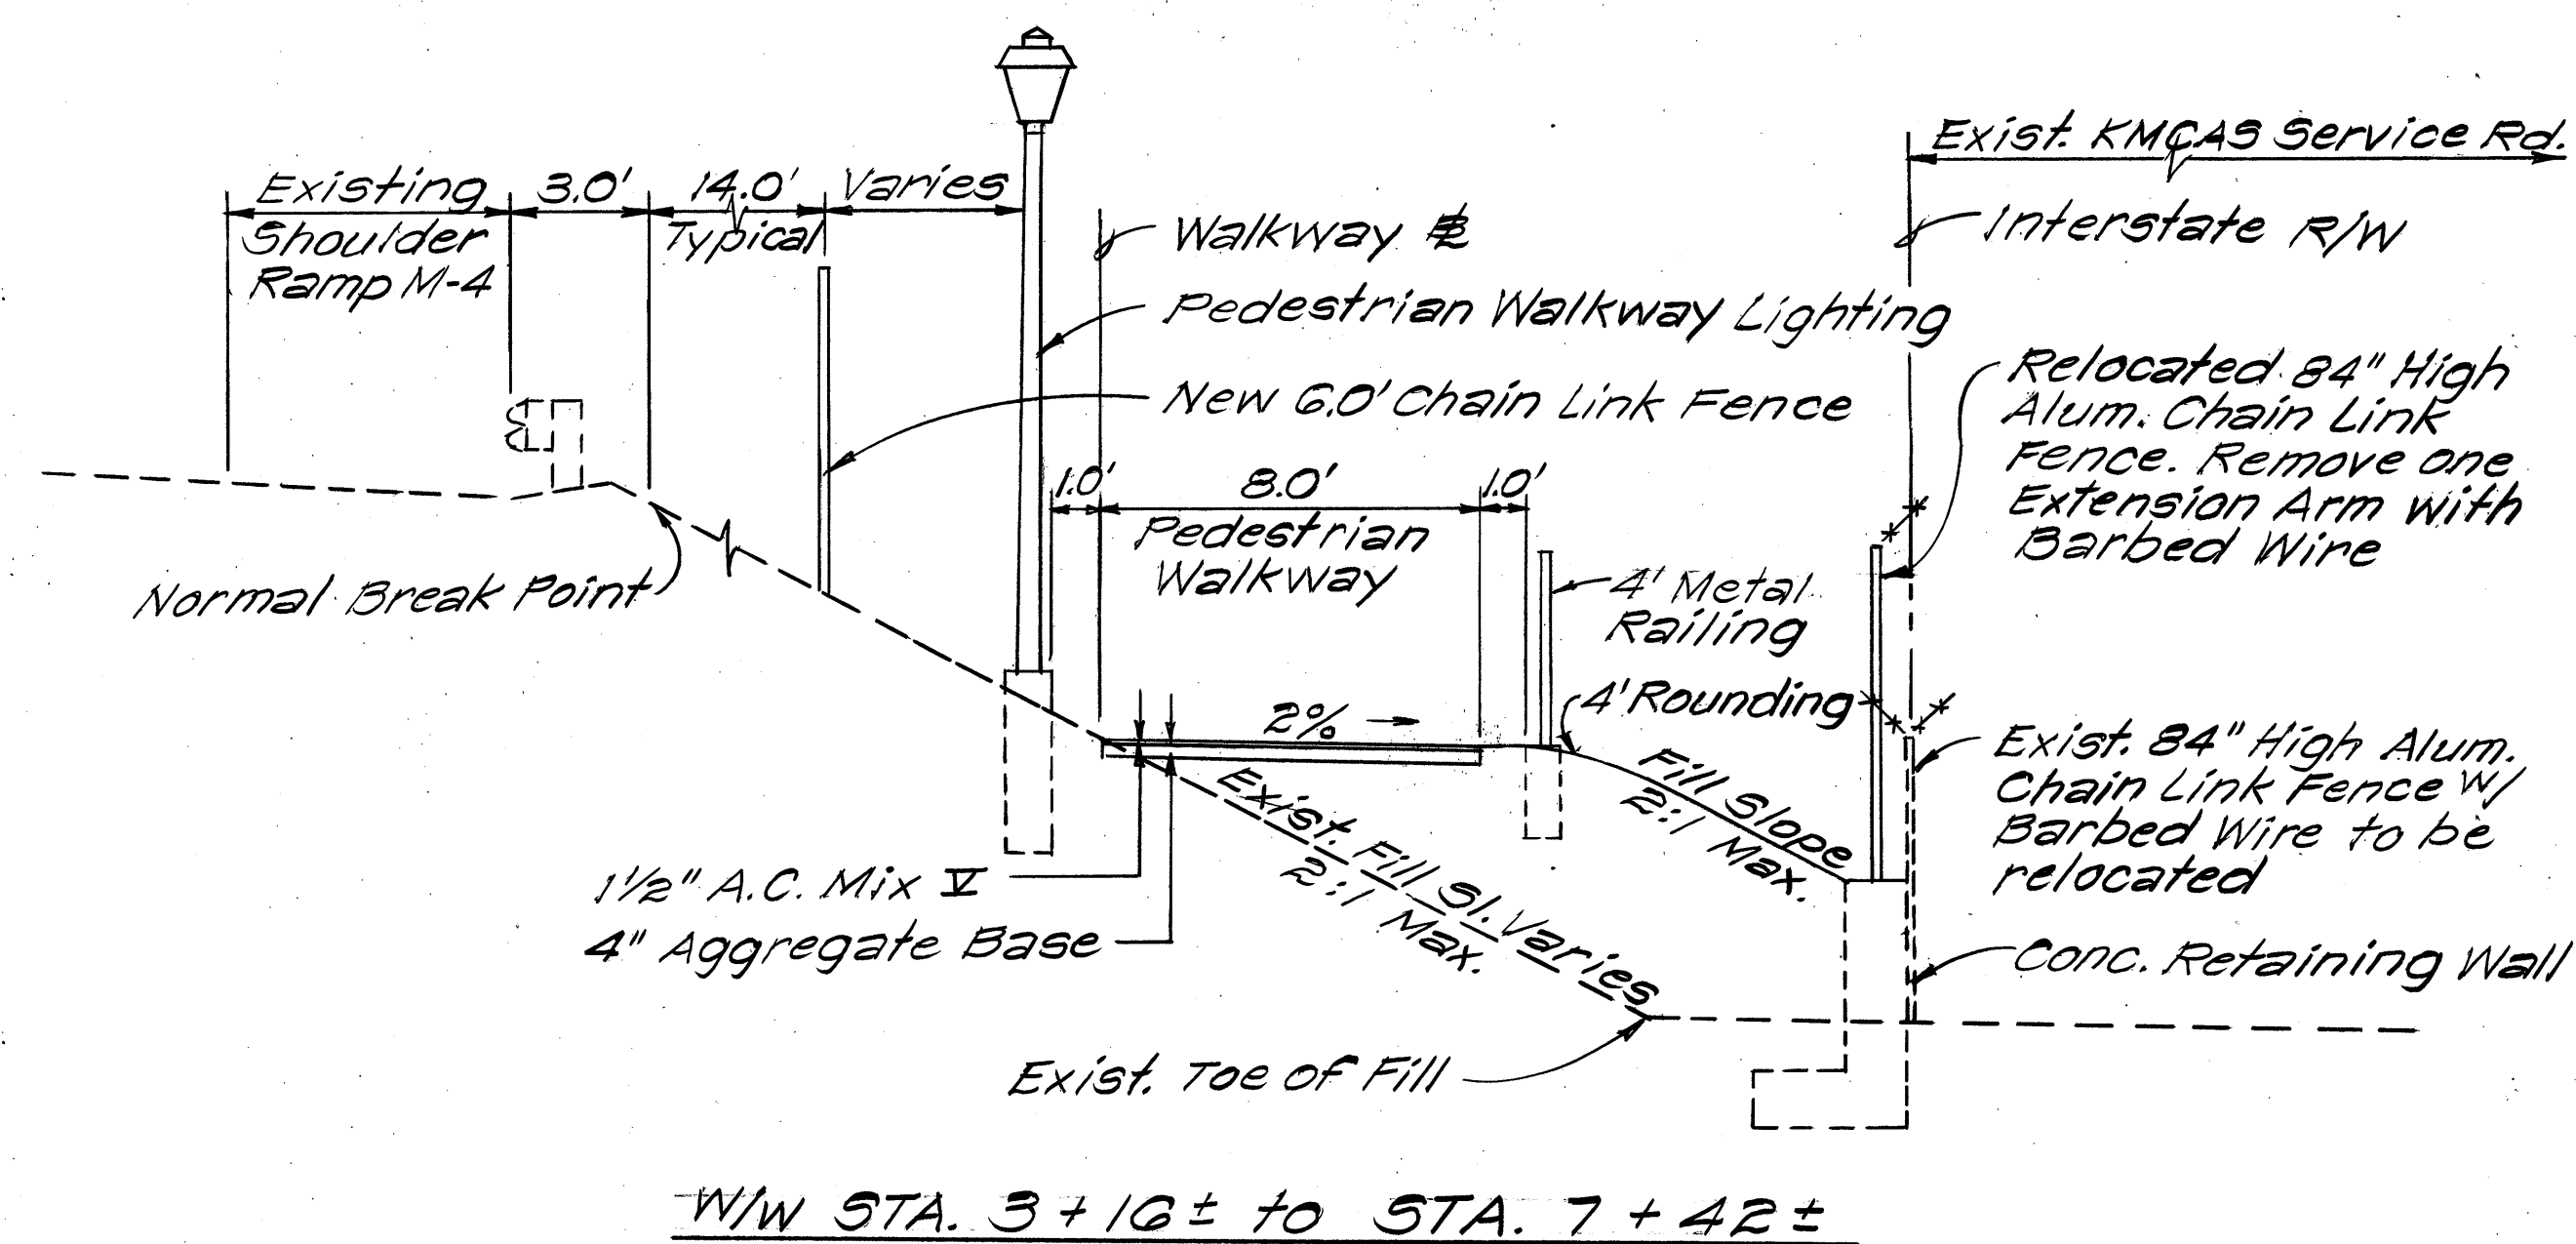
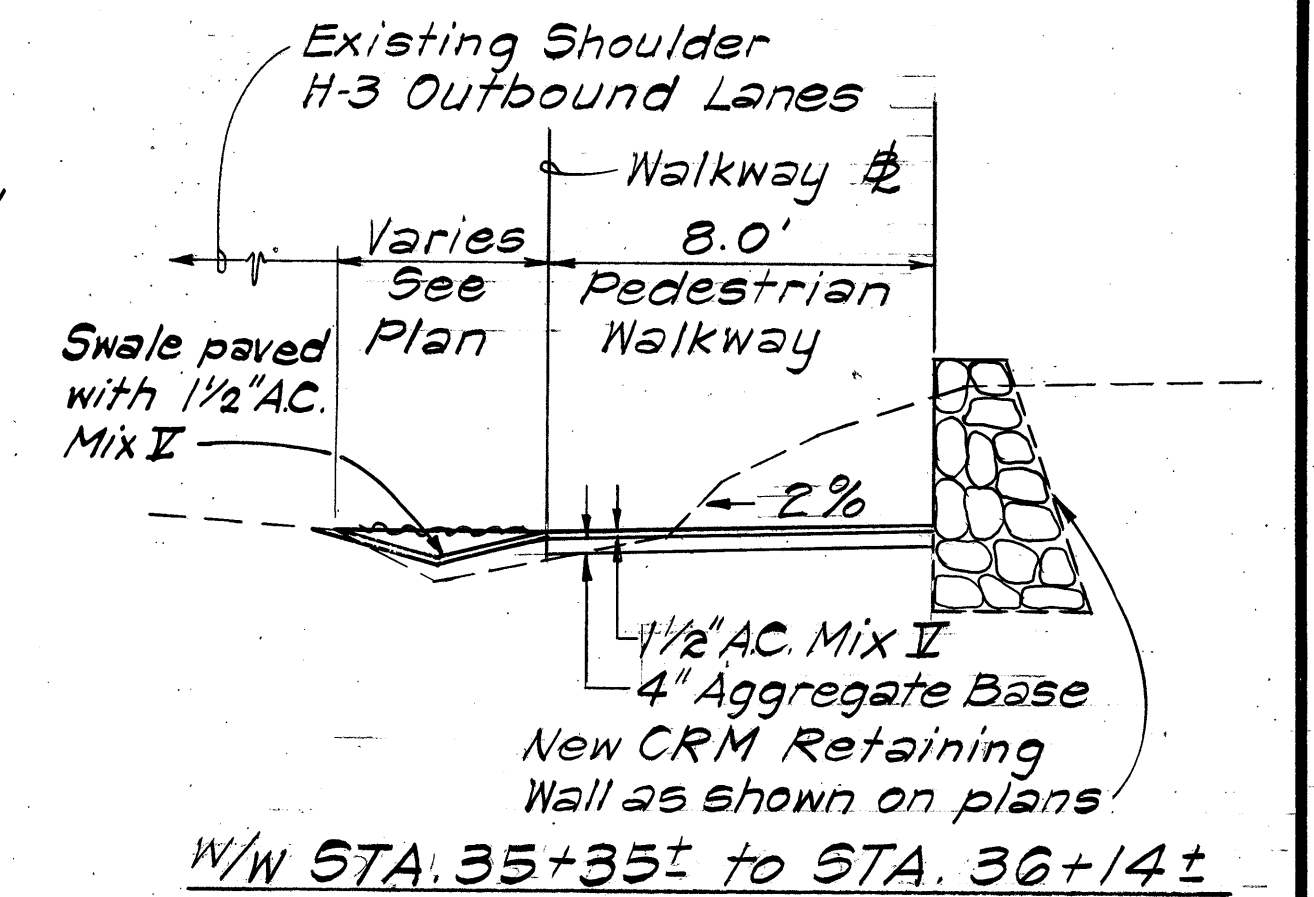
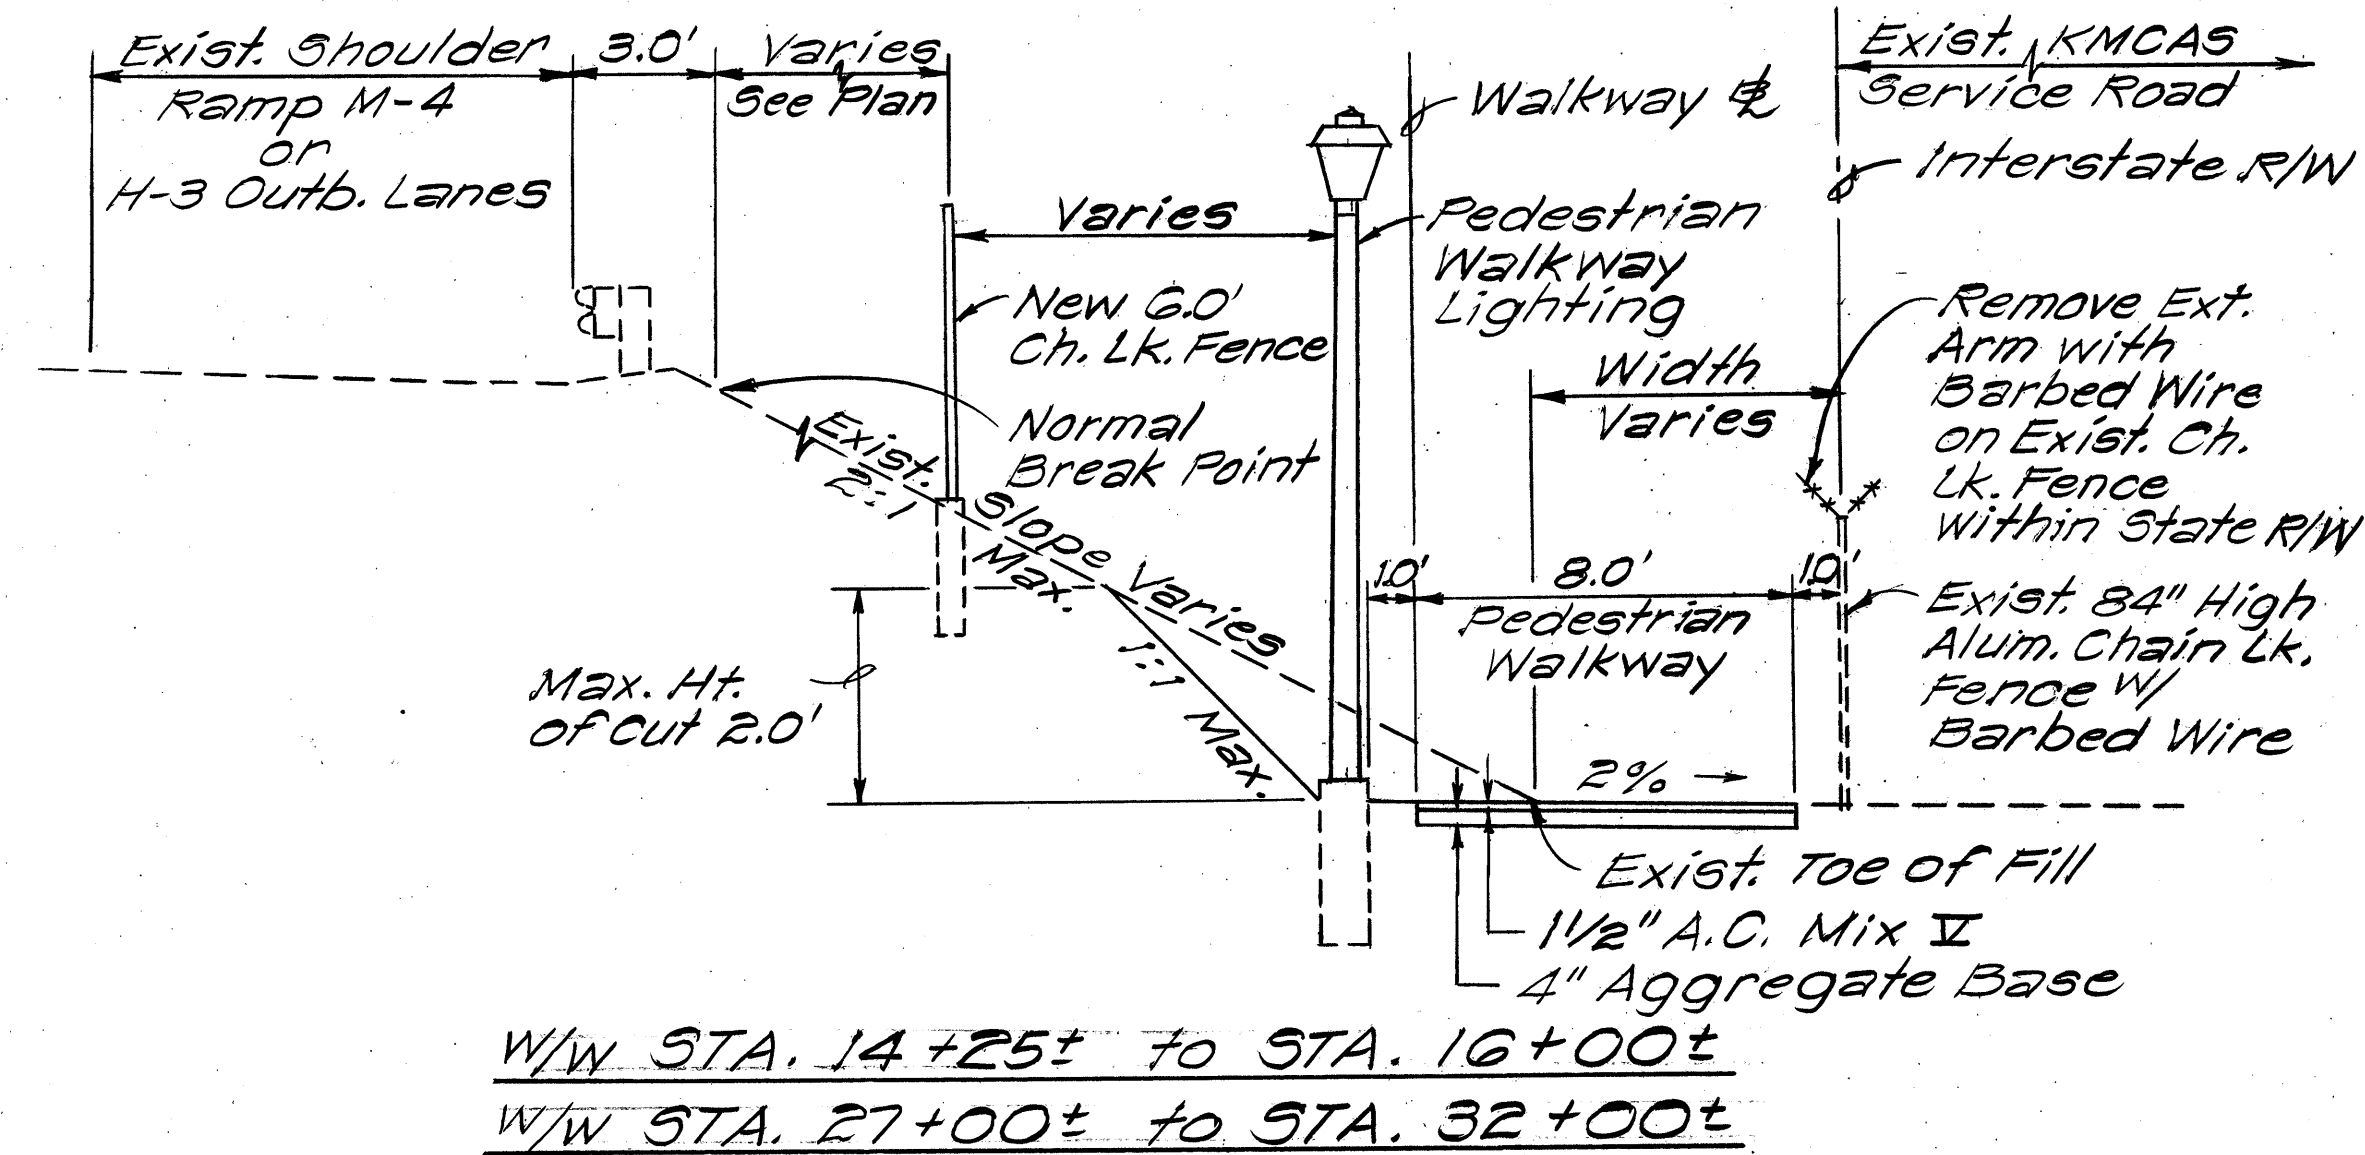


FED. ROAD DIST. NO.	STATE	FED. AID PROJ. NO.	FISCAL YEAR	SHEET NO.	TOTAL SHEETS
HAWAII	HAW.	743-(29)13	1978	2	36

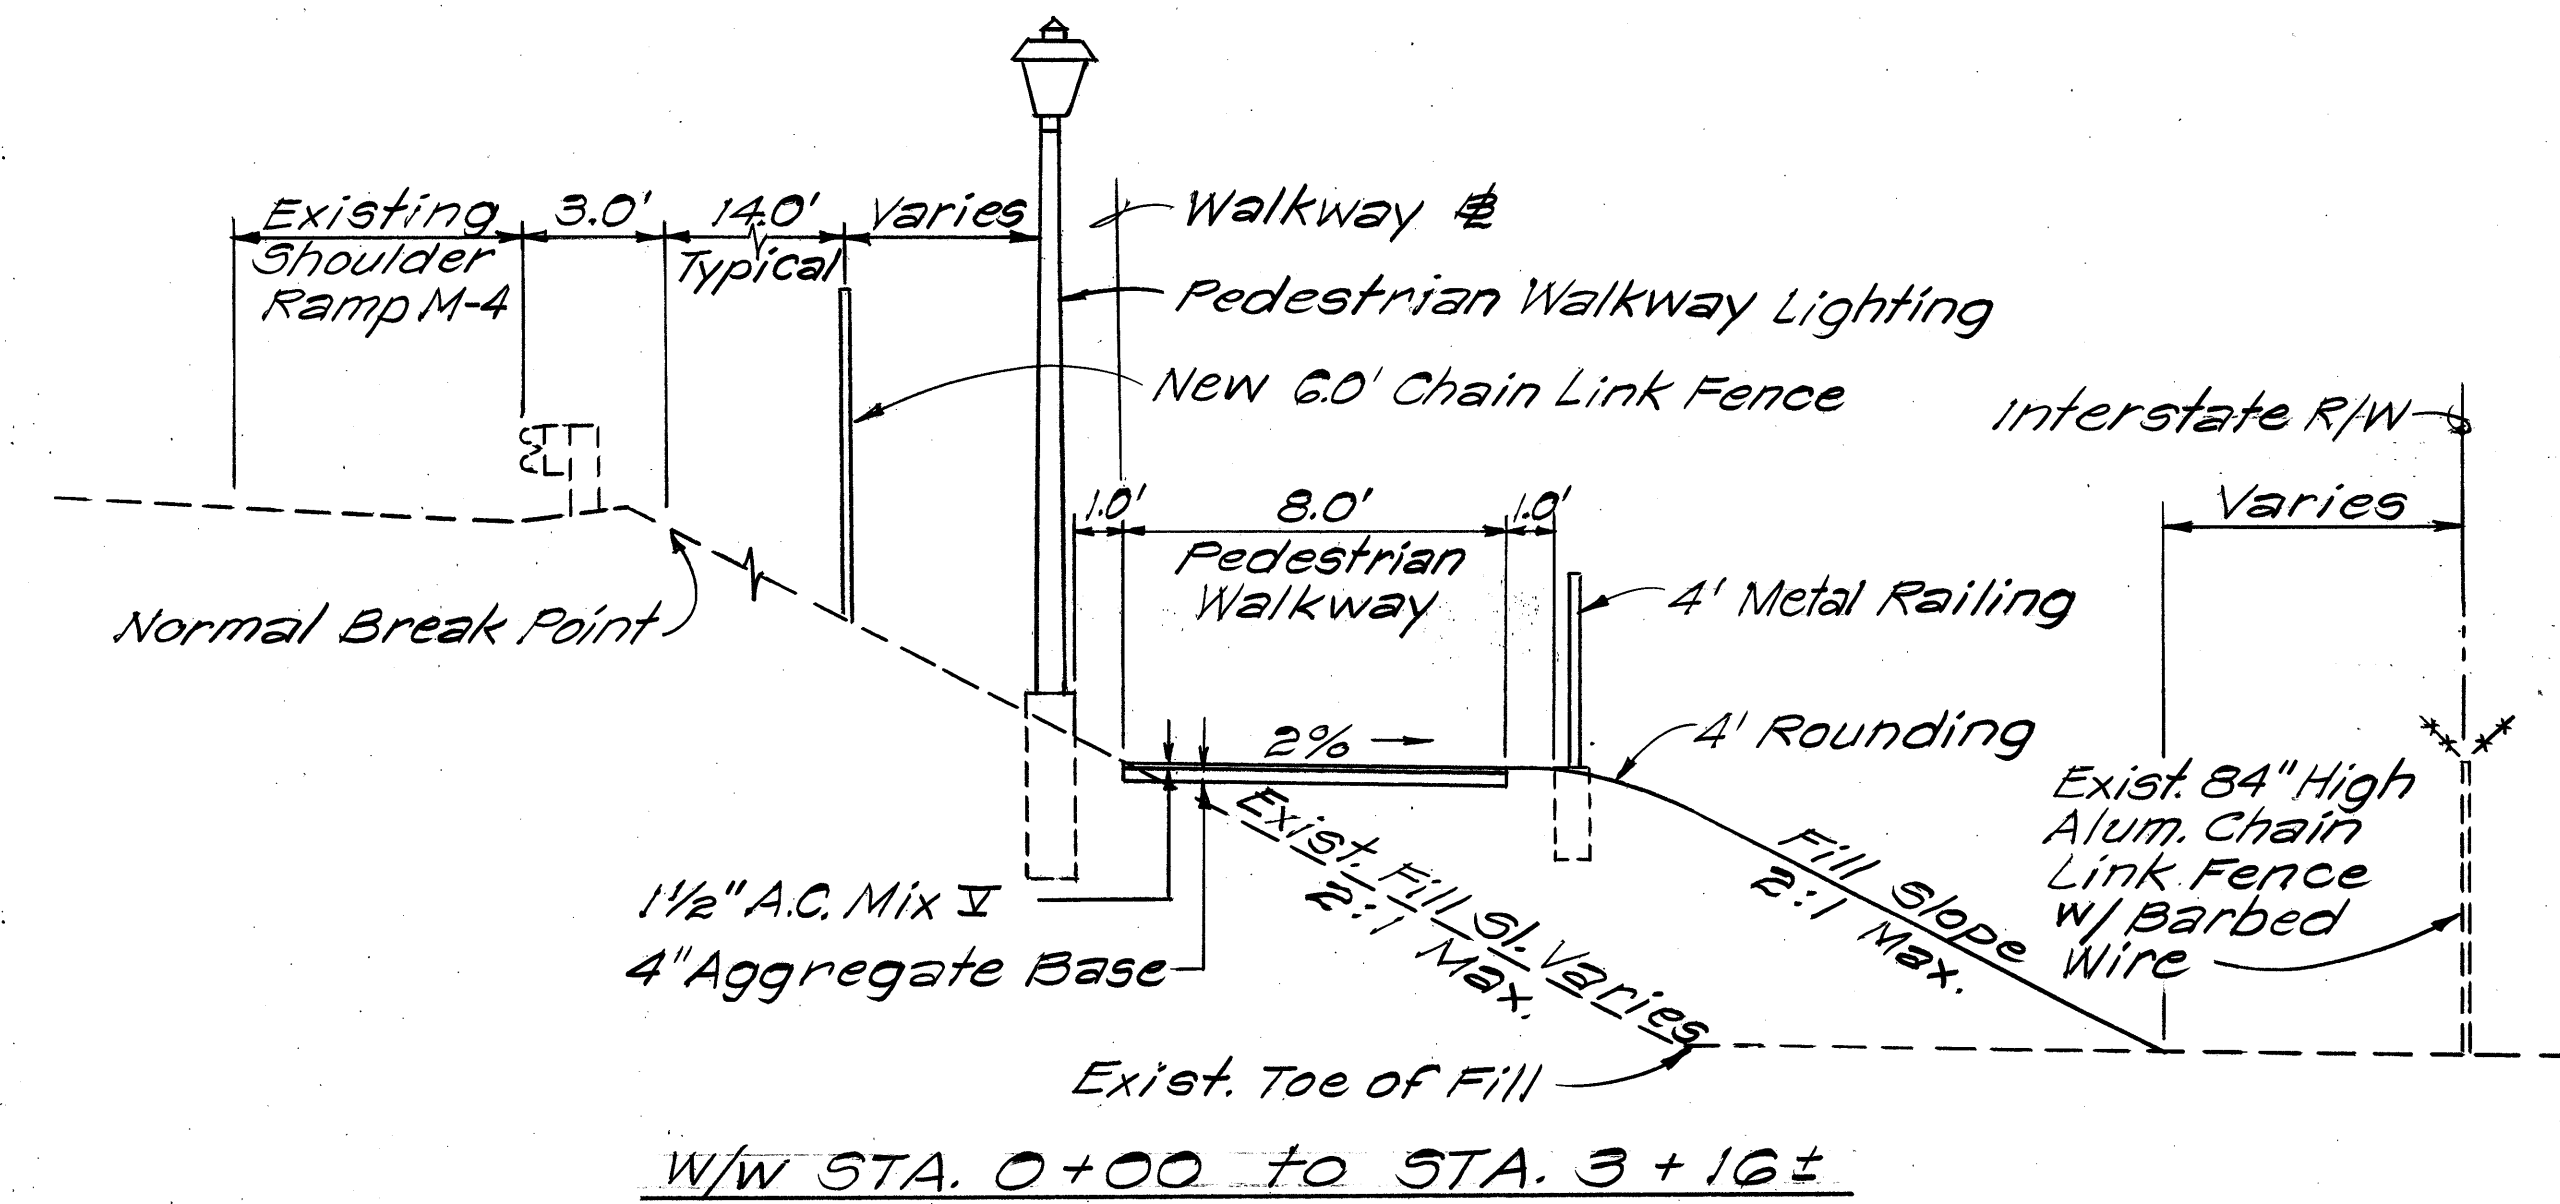

STATE OF HAWAII
DEPARTMENT OF TRANSPORTATION
LAND TRANSPORTATION FACILITIES DIVISION

TYPICAL SECTIONS

**SAFETY IMPROVEMENTS ALONG
INTERSTATE ROUTE H-3
PEDESTRIAN WALKWAY
Kaneohe Bay Drive to KMCAS**

FAI PROJECT NO. I-H3-1(29)-13
Scale: 1/4"=1'-0" Date: July, 1977

SHEET NO. 1 OF 1 SHEETS