

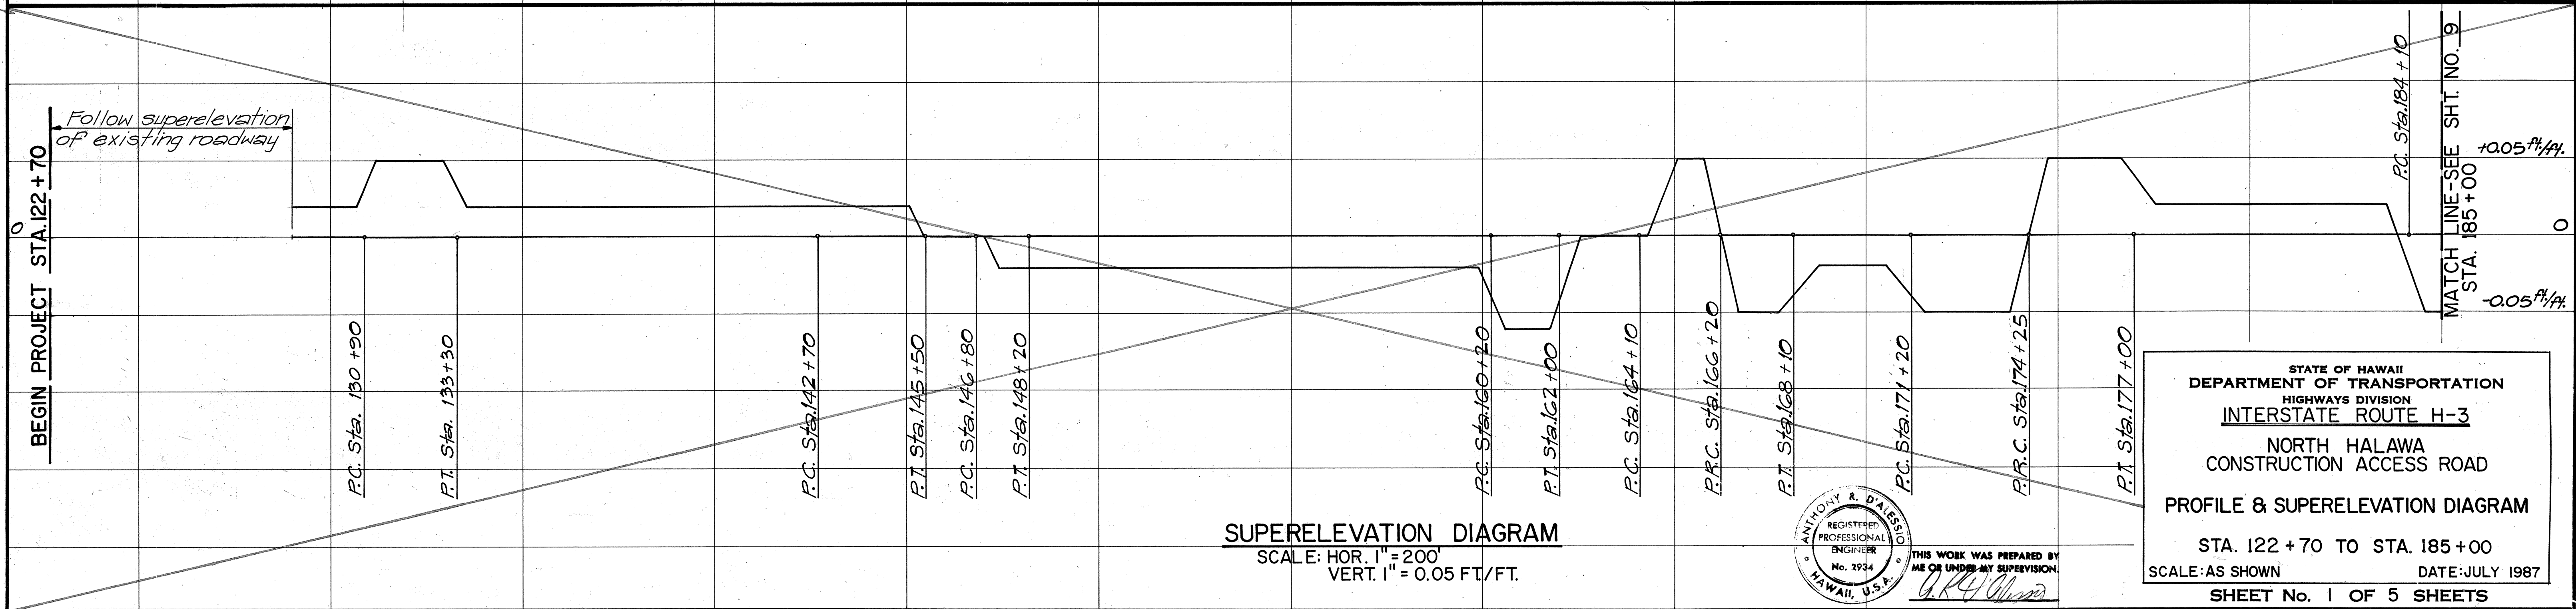


FED. ROAD DIST. NO.	STATE	FED. AID PROJ. NO.	FISCAL YEAR	SHEET NO.	TOTAL SHEETS
HAWAII	HAW.	I-H3-1(35)	1988	8	24

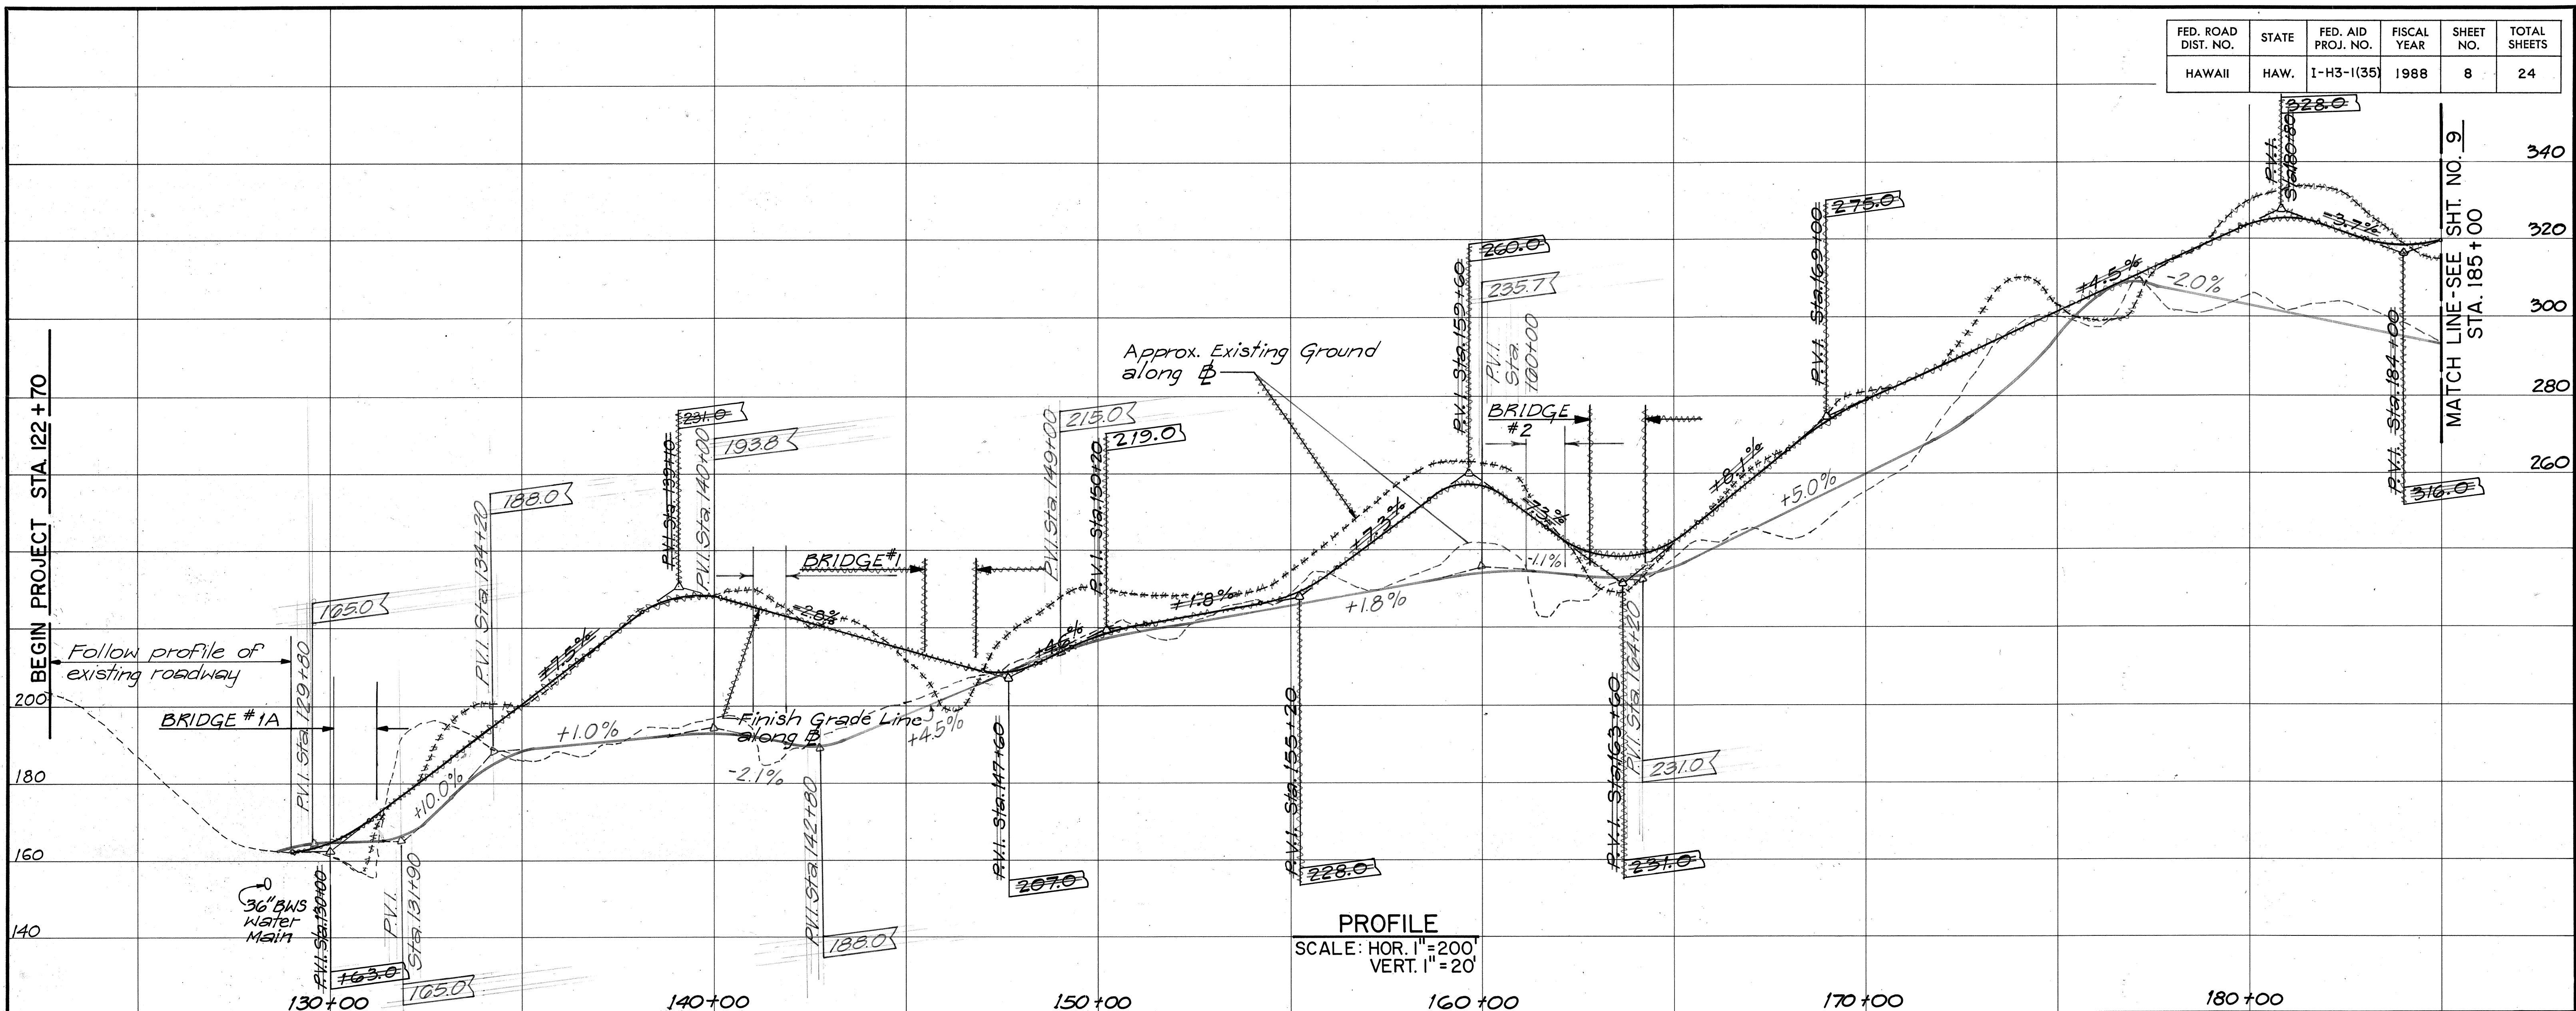

SUPERELEVATION DIAGRAM
 SCALE: HOR. 1" = 200'
 VERT. 1" = 0.05 FT/FT.


STATE OF HAWAII
 DEPARTMENT OF TRANSPORTATION
 HIGHWAYS DIVISION
 INTERSTATE ROUTE H-3
 NORTH HALAWA
 CONSTRUCTION ACCESS ROAD
PROFILE & SUPERELEVATION DIAGRAM
 STA. 122 + 70 TO STA. 185 + 00
 SCALE: AS SHOWN
 DATE: JULY 1987
 SHEET No. 1 OF 5 SHEETS

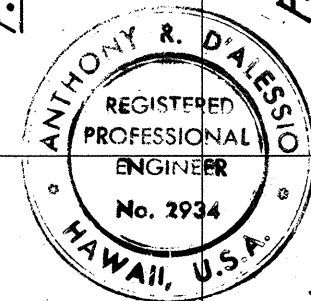


THIS WORK WAS PREPARED BY
 ME OR UNDER MY SUPERVISION
[Signature]

ORIGINAL PLAN	SURVEY PLOTTED BY	DATE
NOTED BY	DRAWN BY	
CHECKED BY	QUANTITIES BY	


FED. ROAD DIST. NO.	STATE	FED. AID PROJ. NO.	FISCAL YEAR	SHEET NO.	TOTAL SHEETS
HAWAII	HAW.	I-H3-1(35)	1988	9	24

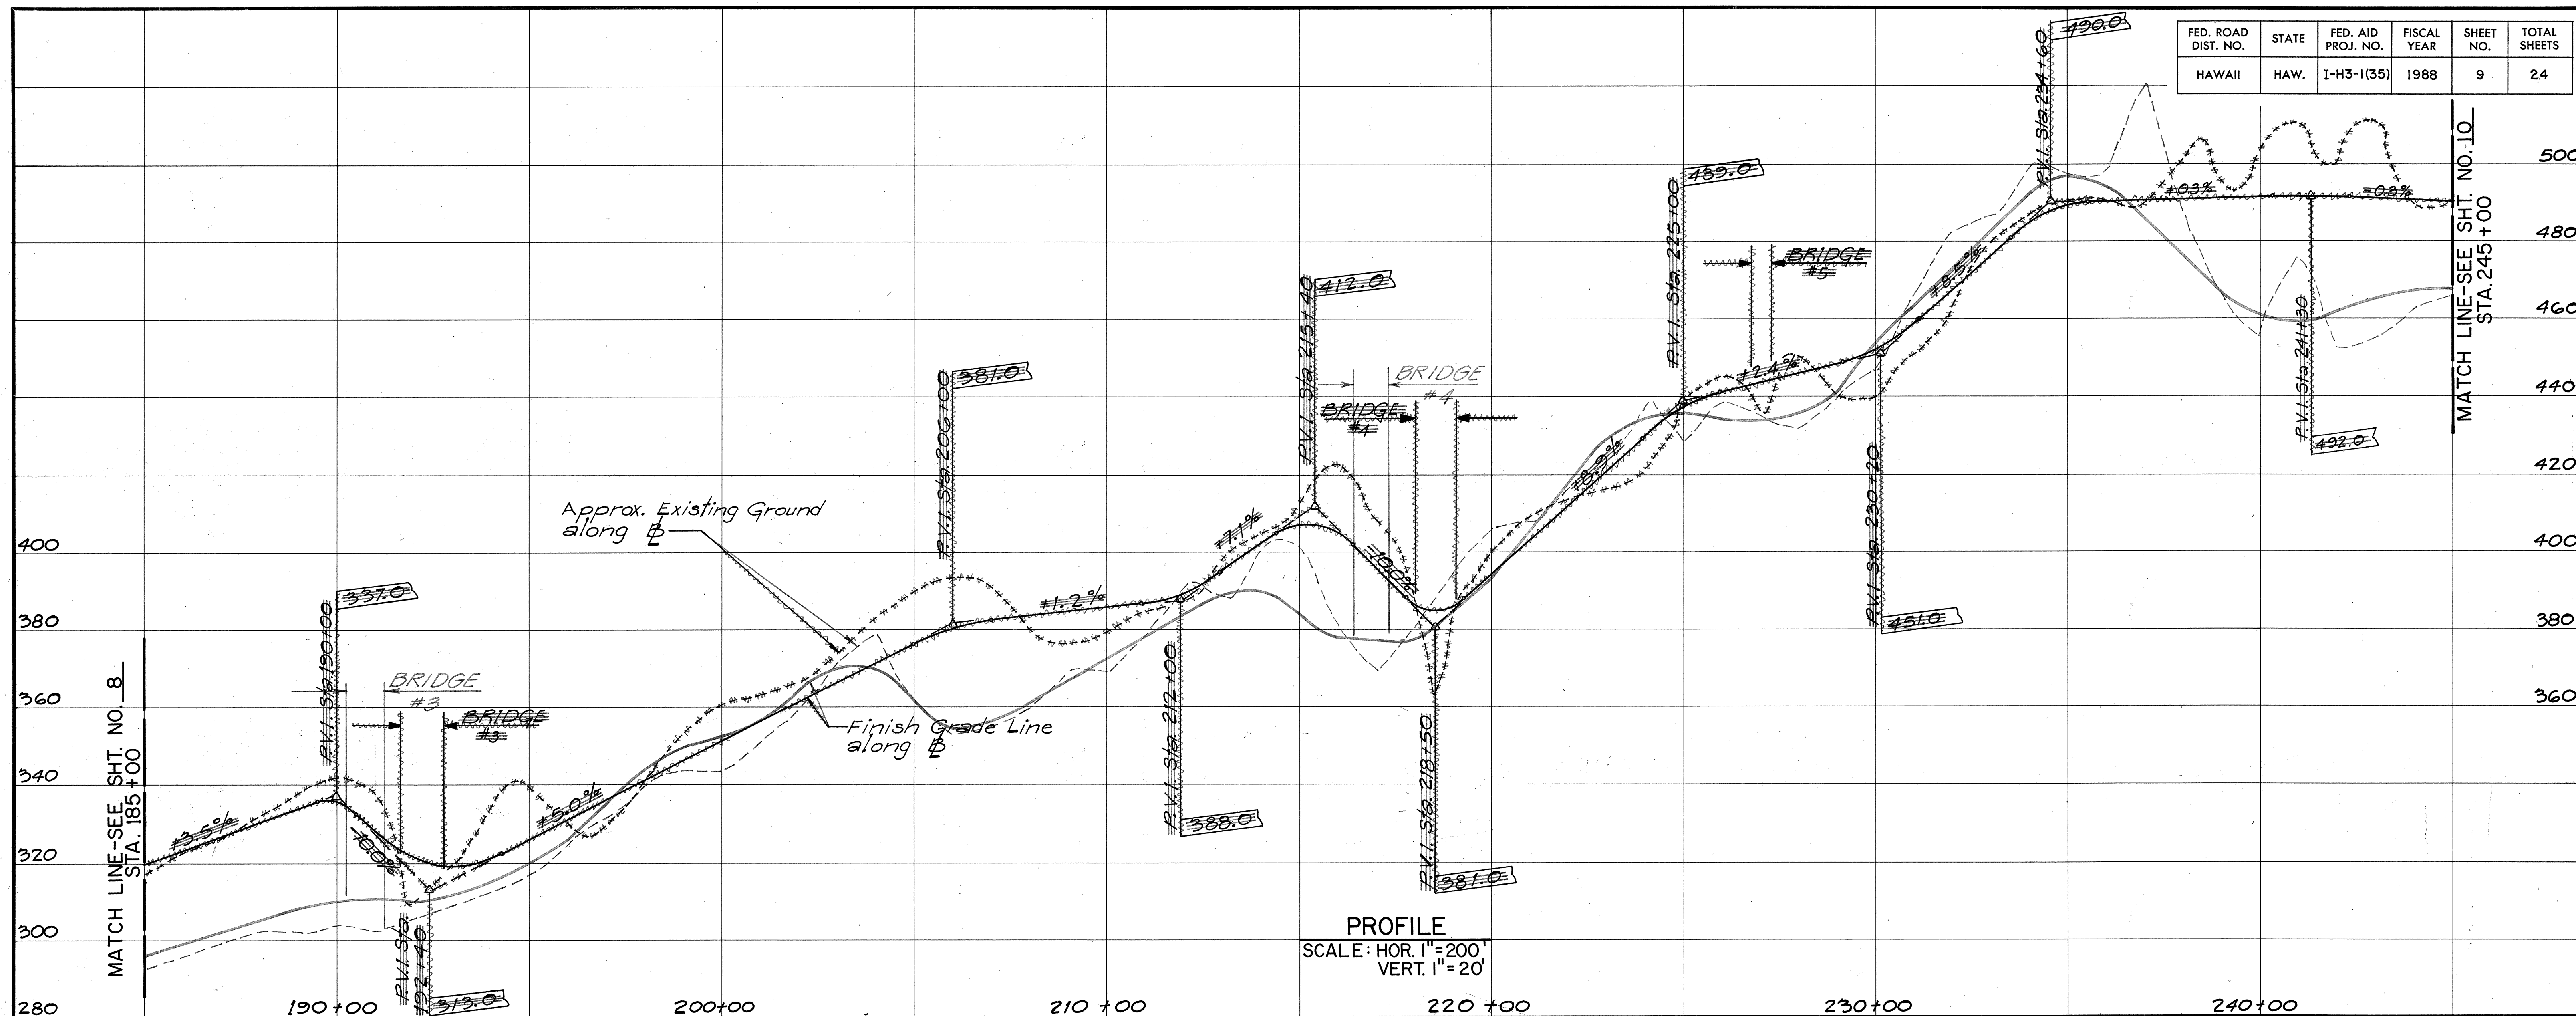

PROFILE
SCALE: HOR. 1"=200'
VERT. 1"=20'

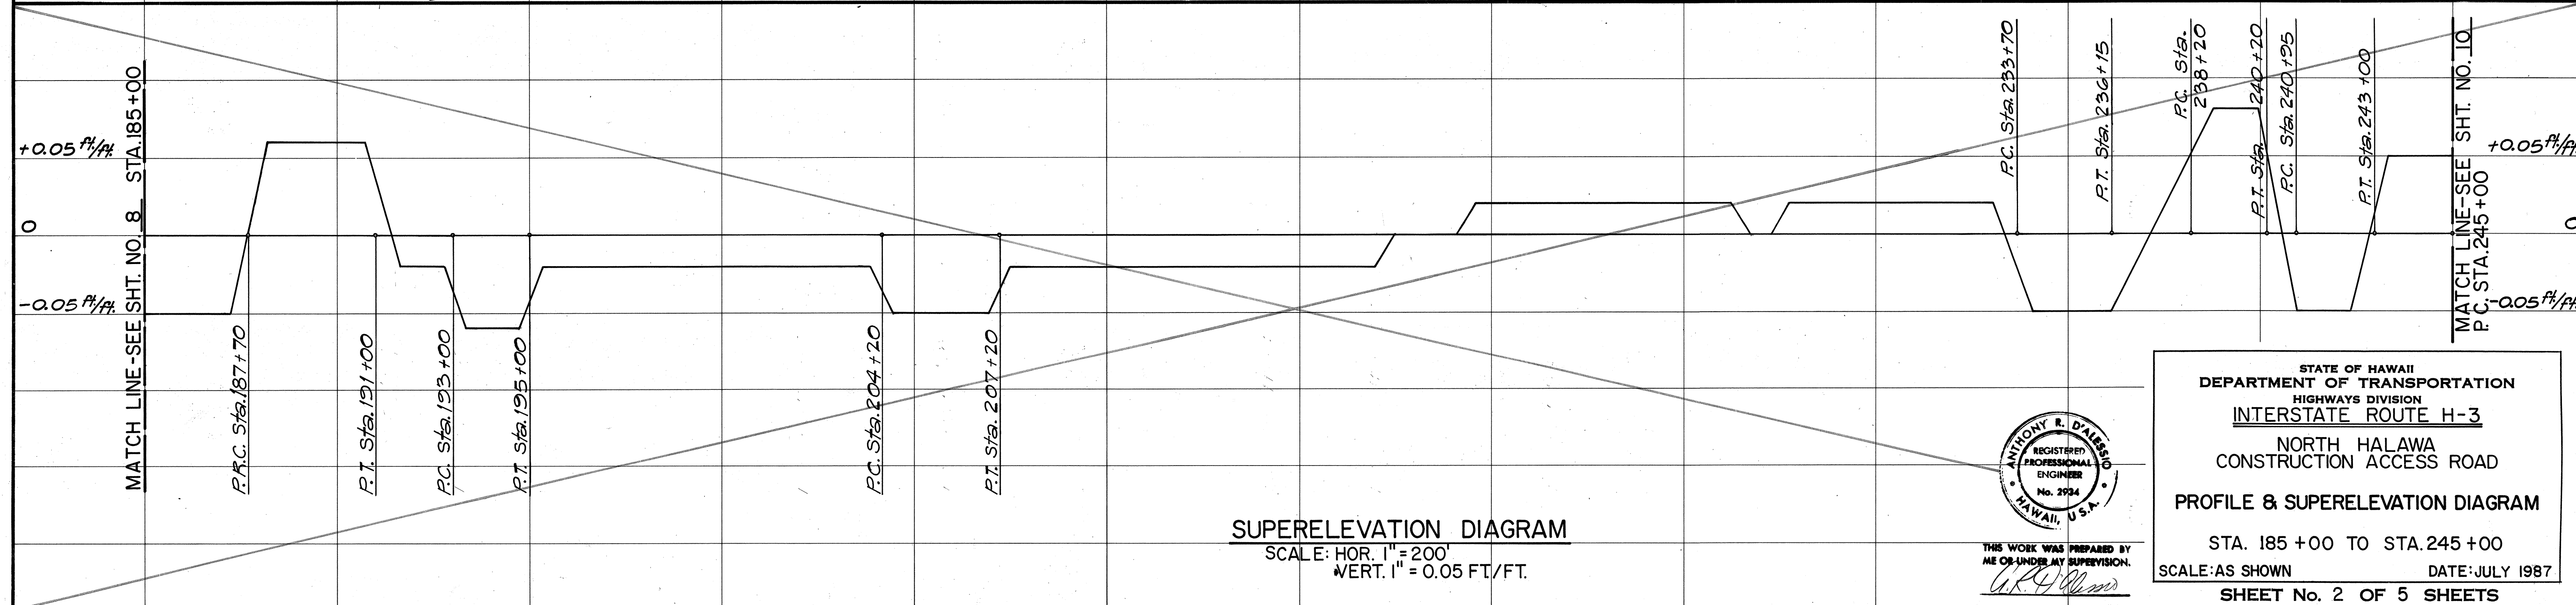

SUPERELEVATION DIAGRAM
SCALE: HOR. 1"=200'
VERT. 1"=0.05 FT/FT.

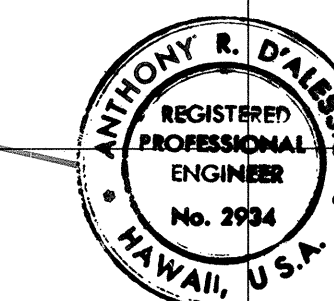


THIS WORK WAS PREPARED BY
ME OR UNDER MY SUPERVISION.
[Signature]


STATE OF HAWAII
DEPARTMENT OF TRANSPORTATION
HIGHWAYS DIVISION
INTERSTATE ROUTE H-3
NORTH HALAWA
CONSTRUCTION ACCESS ROAD
PROFILE & SUPERELEVATION DIAGRAM
STA. 185 +00 TO STA. 245 +00
SCALE: AS SHOWN
DATE: JULY 1987
SHEET No. 2 OF 5 SHEETS

DATE: _____
SURVEY PLOTTED BY: _____
DRAWN BY: _____
DESIGNED BY: _____
CHECKED BY: _____
NOTE BOOK: _____
No. _____

FED. ROAD DIST. NO.	STATE	FED. AID PROJ. NO.	FISCAL YEAR	SHEET NO.	TOTAL SHEETS
HAWAII	HAW.	I-H3-1(35)	1988	10	24

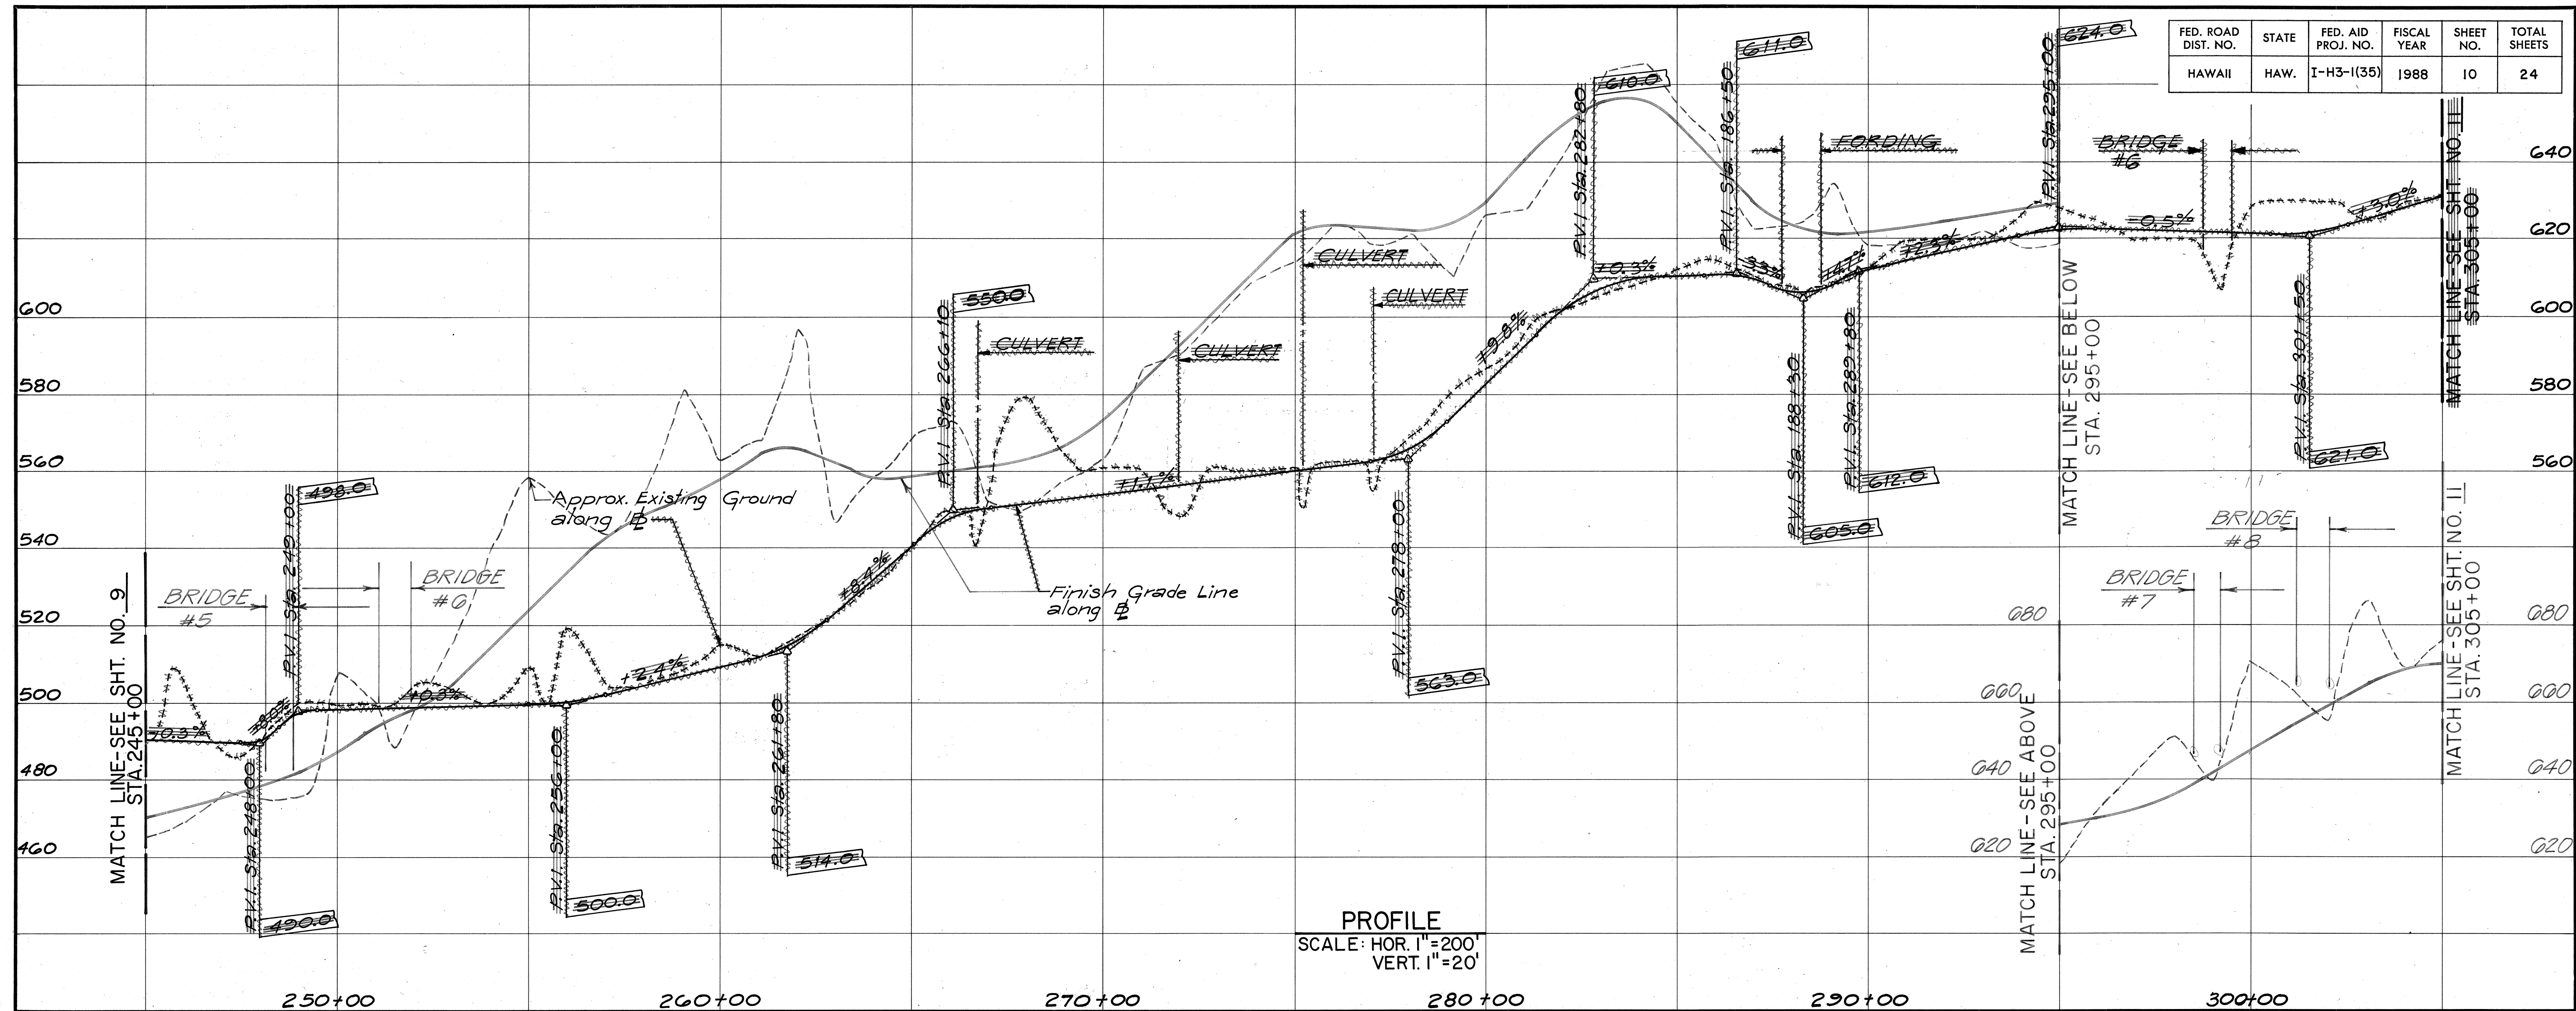


PROFILE
SCALE: HOR. 1"=200'
VERT. 1"=20'

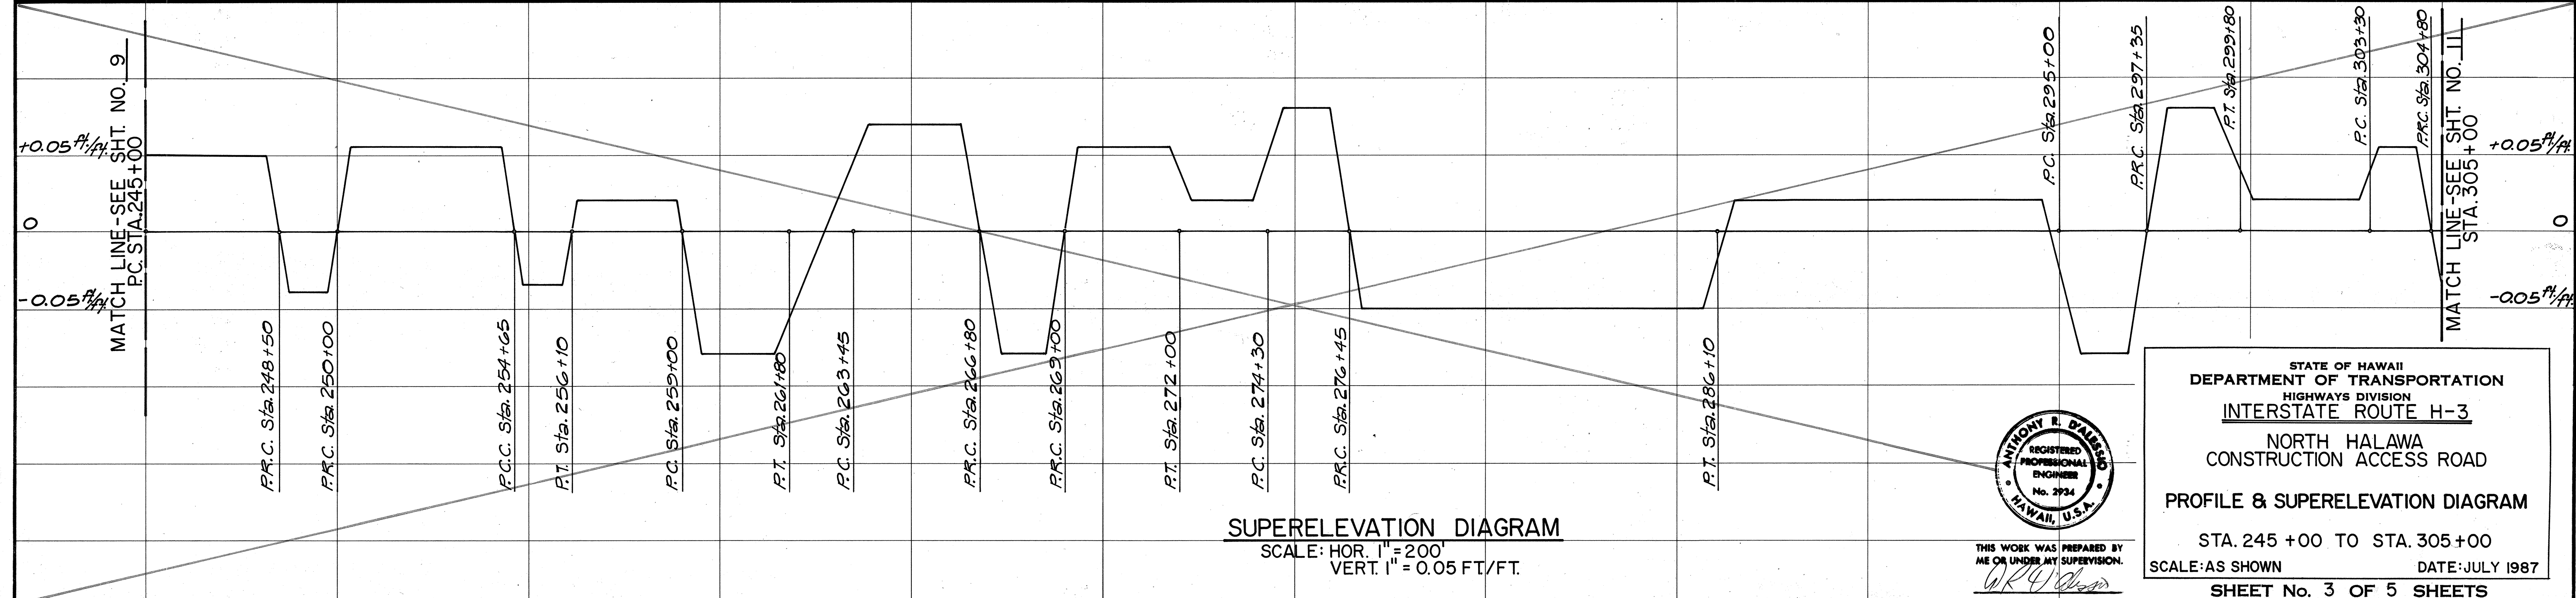

SUPERELEVATION DIAGRAM
SCALE: HOR. 1"=200'
VERT. 1"=0.05 FT/FT.



SURVEY PLOTTED BY	DATE
DRAWN BY	
DESIGNED BY	
NOTED BY	
CHECKED BY	

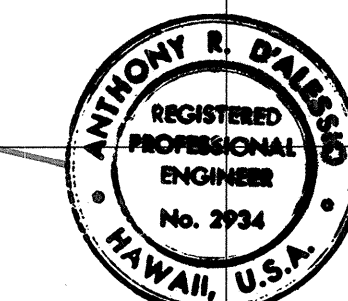

THIS WORK WAS PREPARED BY
ME OR UNDER MY SUPERVISION.
WRD

STATE OF HAWAII
DEPARTMENT OF TRANSPORTATION
HIGHWAYS DIVISION
INTERSTATE ROUTE H-3
NORTH HALAWA
CONSTRUCTION ACCESS ROAD
PROFILE & SUPERELEVATION DIAGRAM
STA. 245 +00 TO STA. 305 +00
SCALE: AS SHOWN
DATE: JULY 1987
SHEET No. 3 OF 5 SHEETS

FED. ROAD DIST. NO.	STATE	FED. AID PROJ. NO.	FISCAL YEAR	SHEET NO.	TOTAL SHEETS
HAWAII	HAW.	I-H3-1(35)	1988	11	24

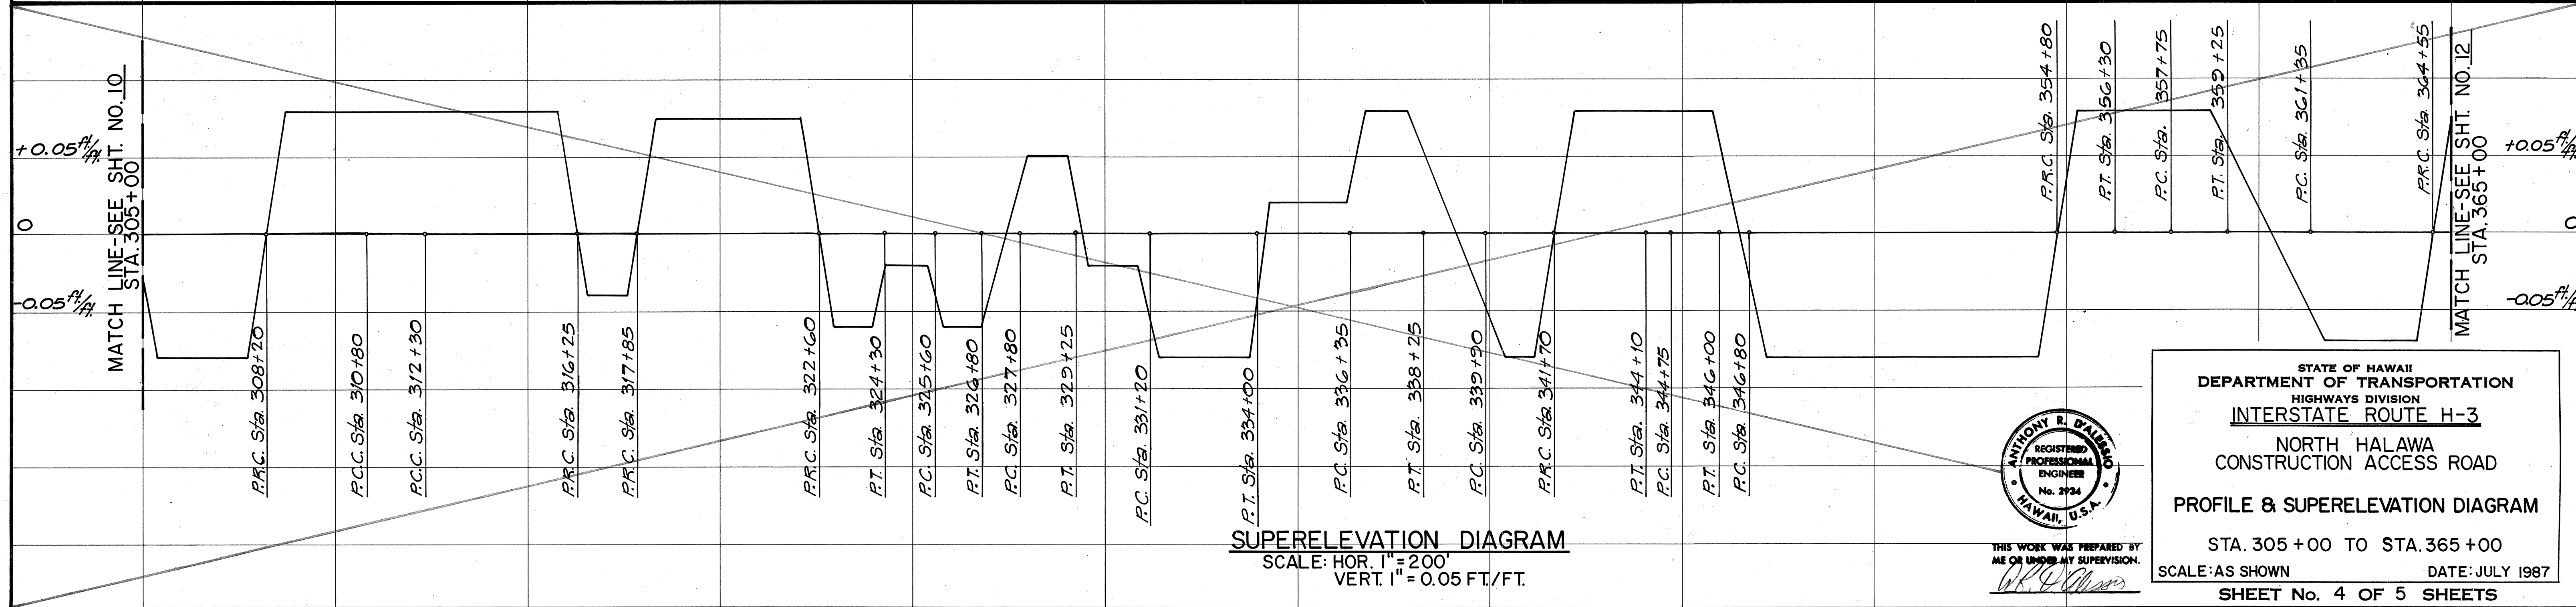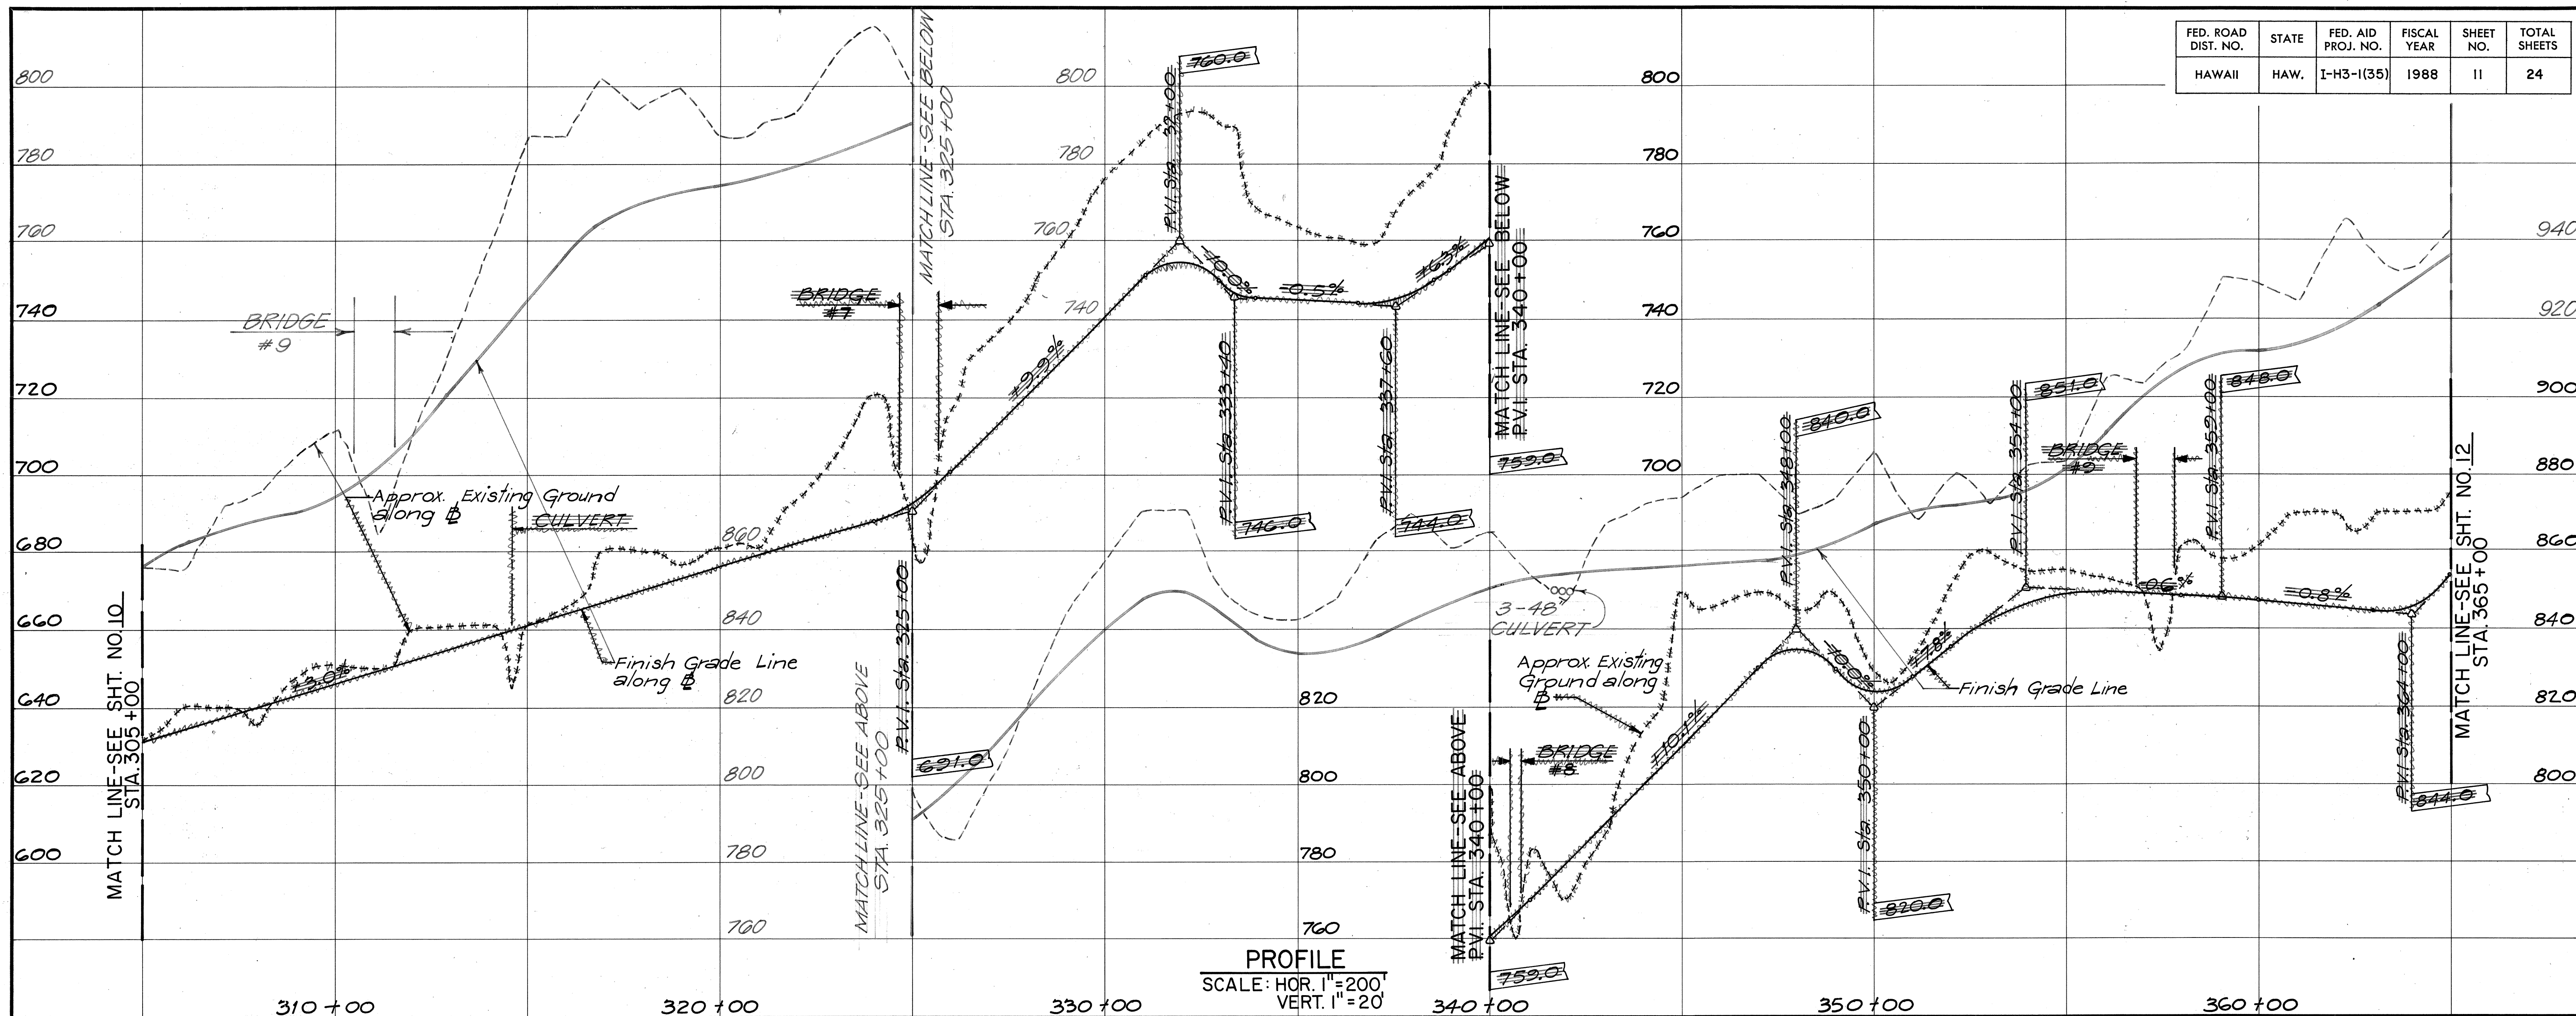


ORIGINAL PLAN	DATE
DESIGNED BY	
TRACED BY	
NOTE BOOK	
QUANTITIES BY	
CHECKED BY	
NO.	




THIS WORK WAS PREPARED BY
ME OR UNDER MY SUPERVISION.
W.R. D'Amico

STATE OF HAWAII
DEPARTMENT OF TRANSPORTATION
HIGHWAYS DIVISION
INTERSTATE ROUTE H-3
NORTH HALAWA
CONSTRUCTION ACCESS ROAD
PROFILE & SUPERELEVATION DIAGRAM
STA. 305+00 TO STA. 365+00
SCALE: AS SHOWN
DATE: JULY 1987
SHEET No. 4 OF 5 SHEETS


FED. ROAD DIST. NO.	STATE	FED. AID PROJ. NO.	FISCAL YEAR	SHEET NO.	TOTAL SHEETS
HAWAII	HAW.	I-H3-1(35)	1988	12	24

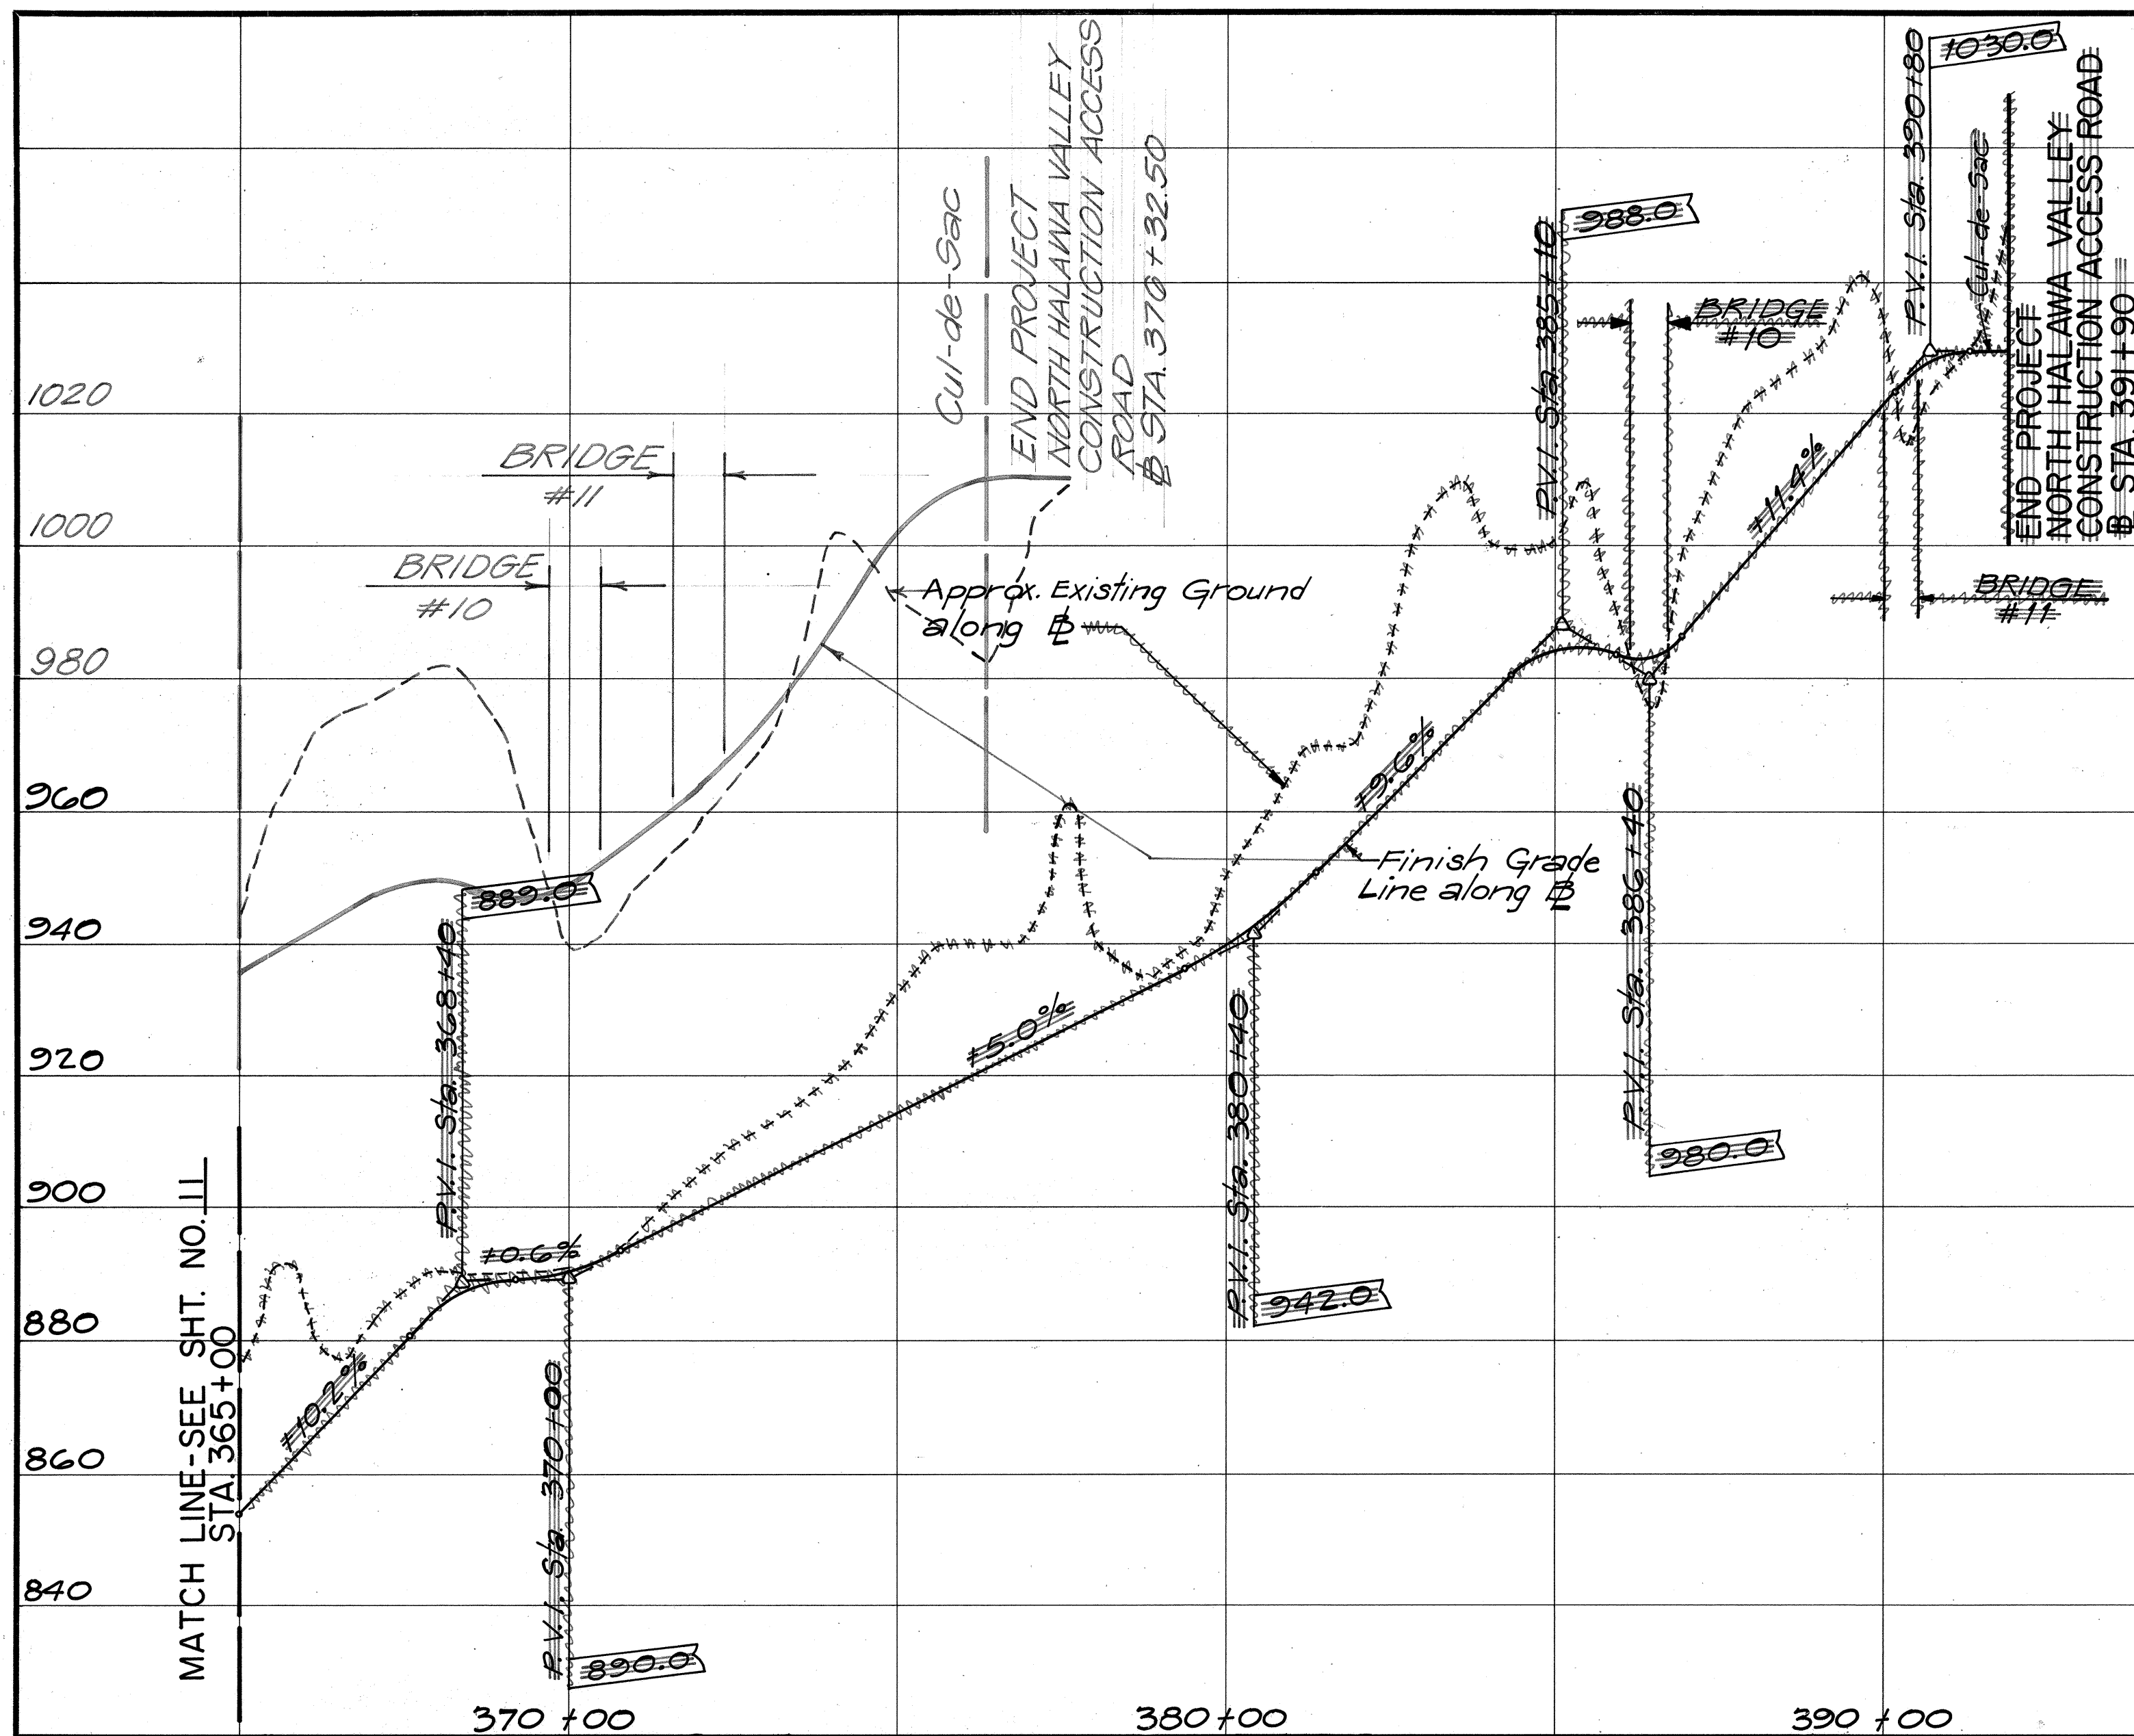

PROFILE
SCALE: HOR. 1"=200'
VERT. 1"=20'

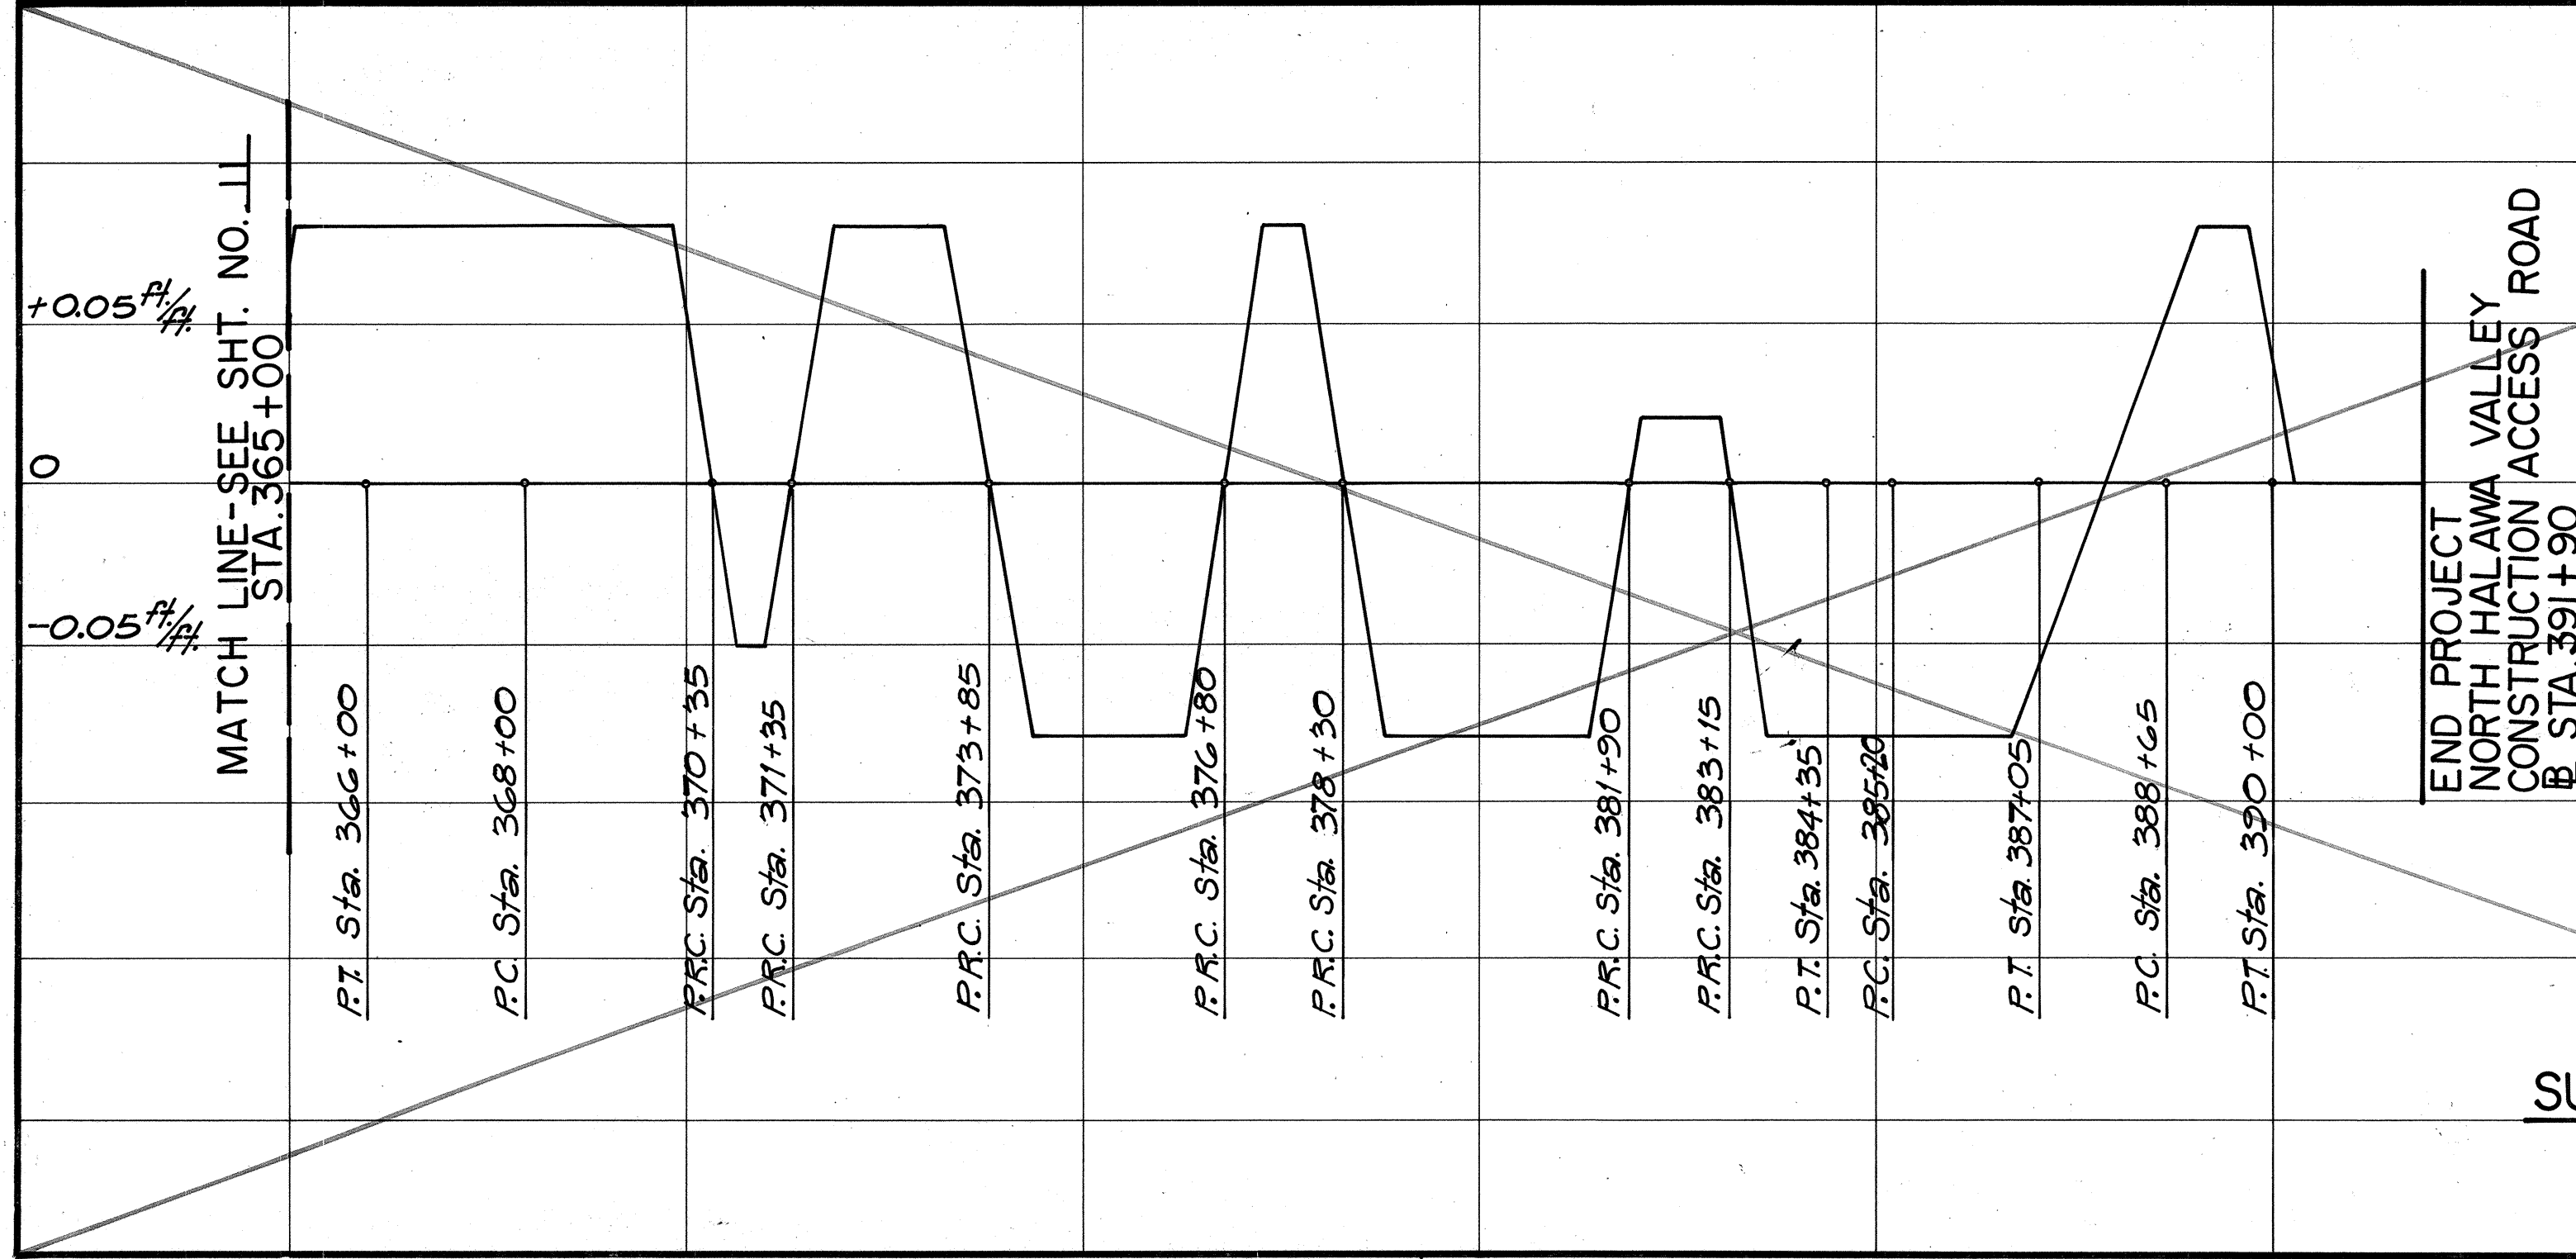

SUPERELEVATION DIAGRAM
SCALE: HOR. 1"=200'
VERT. 1"=0.05 FT/FT.

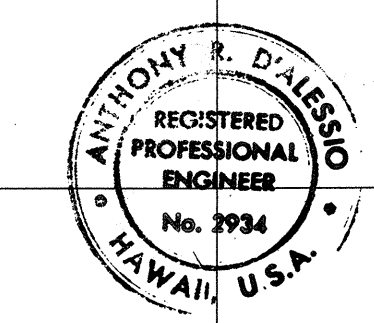

THIS WORK WAS PREPARED BY
ME OR UNDER MY SUPERVISION.
[Signature]

STATE OF HAWAII
DEPARTMENT OF TRANSPORTATION
HIGHWAYS DIVISION
INTERSTATE ROUTE H-3
NORTH HALAWA
CONSTRUCTION ACCESS ROAD
PROFILE & SUPERELEVATION DIAGRAM
STA. 365+00 TO STA. 391+90
SCALE: AS SHOWN
DATE: JULY 1987
SHEET No. 5 OF 5 SHEETS

ORIGINAL PLAN	SURVEY PLOTTED BY	DATE
NOTE BOOK	DRAWN BY	" "
No.	CHECKED BY	" "