



STATE OF HAWAII



DEPARTMENT OF TRANSPORTATION

HIGHWAYS DIVISION

HONOLULU, HAWAII

"AS-BUILT"

PLANS FOR

CONSTRUCTION OF A PORTION OF


INTERSTATE ROUTE

NORTH HALAWA VALLEY CONSTRUCTION ACCESS ROAD

FEDERAL AID INTERSTATE PROJECT NO. I-H3-I(35)


DISTRICT OF EWA ISLAND OF OAHU

> END PROJECT NO. I-H3-1(35) NORTH HALAWA VALLEY CONSTRUCTION ACCESS ROAD **STATION** 391+90 376+32.50

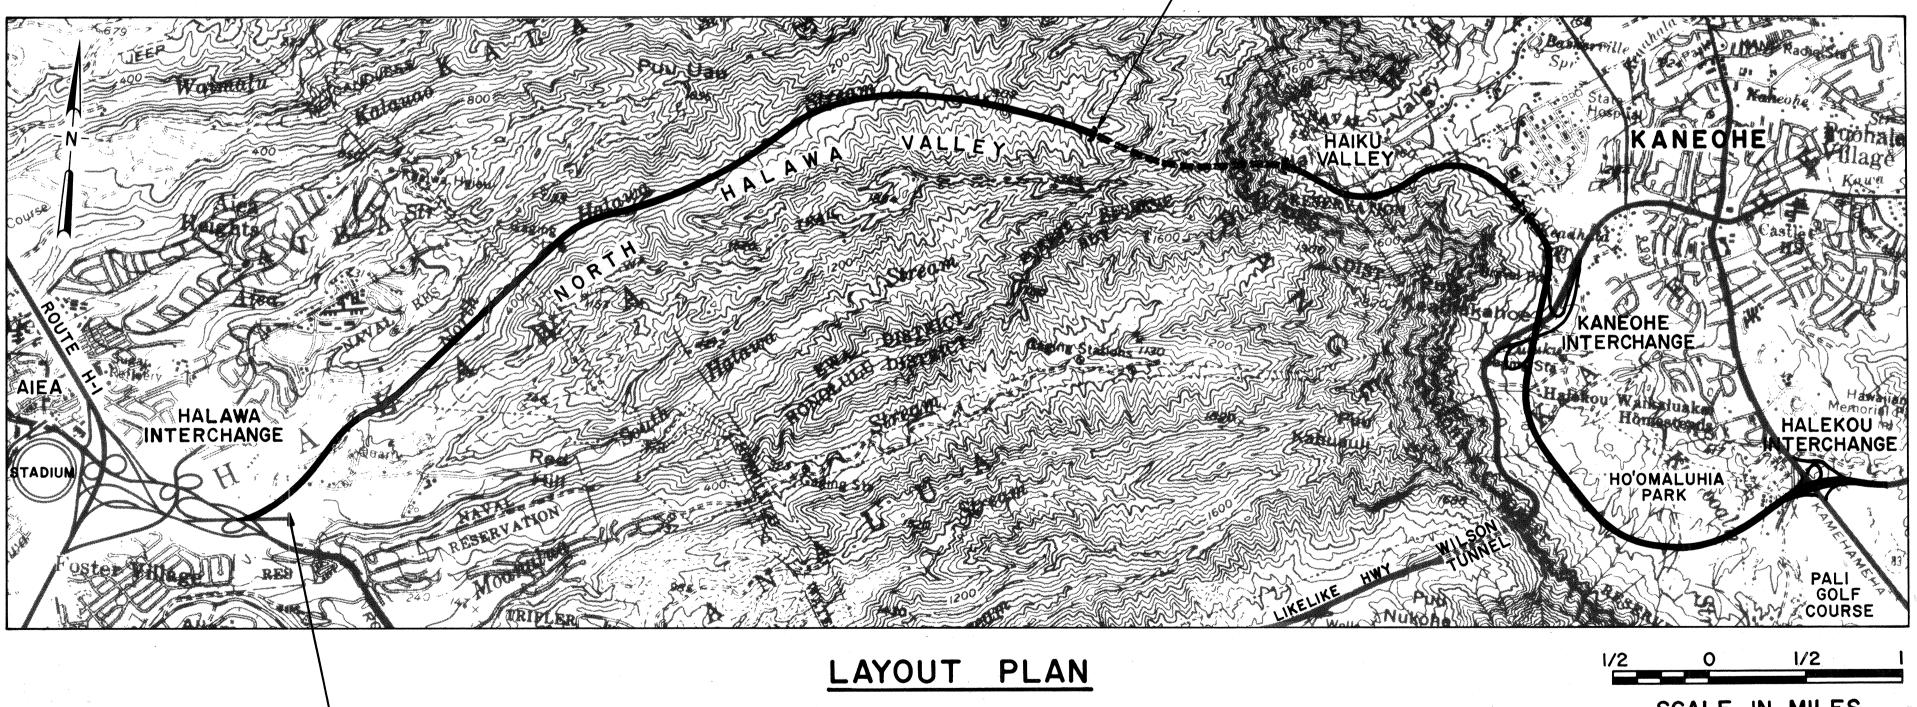

SCALE IN MILES

BEGIN PROJECT NO. I-H3-I(35) NORTH HALAWA VALLEY CONSTRUCTION ACCESS ROAD **STATION** 122 + 70

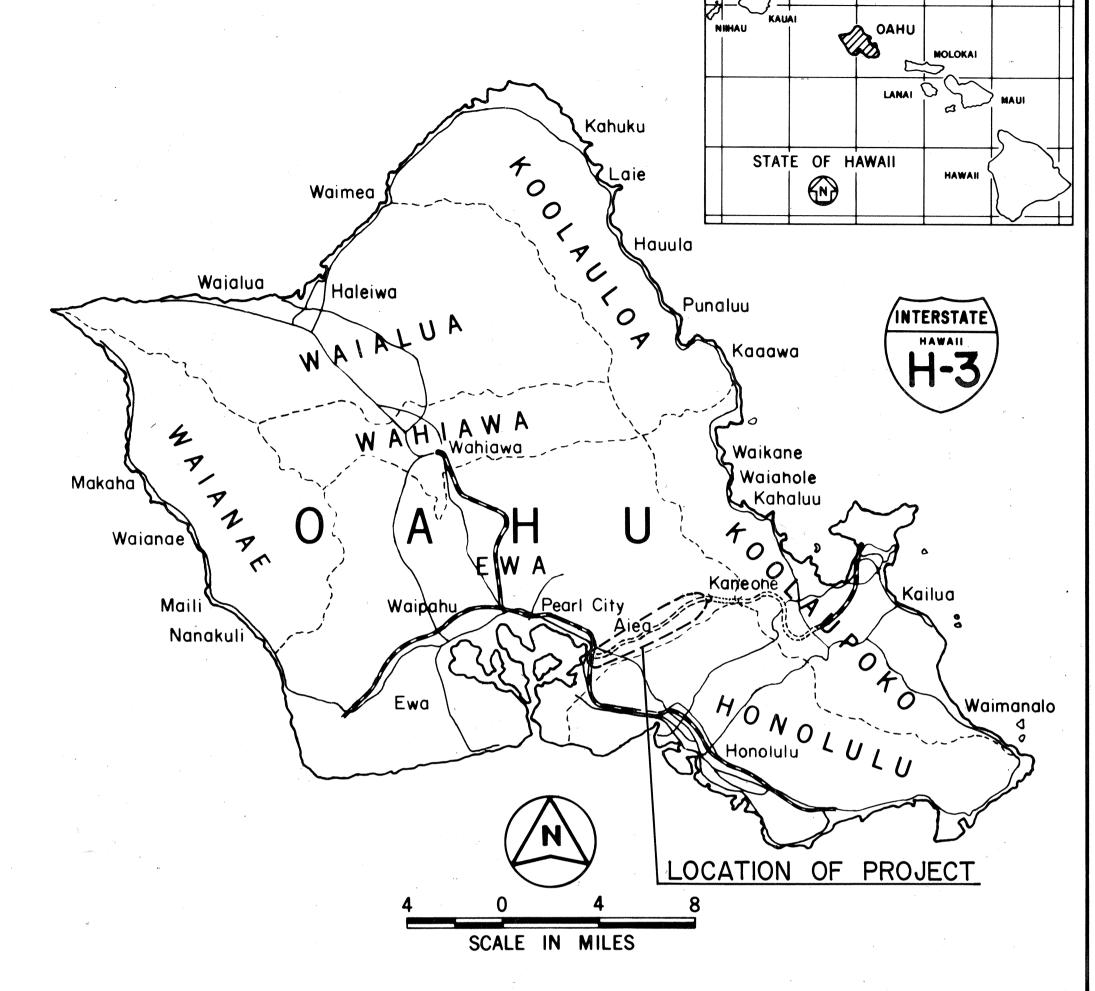

FED. ROAD DIST. NO.

FED. AID PROJ. NO.

I - H3 - I(35)

FISCAL SHEET

NO.

YEAR

FEDERAL AID INTERSTATE PROJECTS PREVIOUSLY CONSTRUCTED OR UNDER CONSTRUCTION

> CHANGES MADE DURING CONSTRUCTION HAVE BEEN INCORPORATED ON THESE PLANS EXCEPT CHANGES IN THE ORIGINAL THEORETICAL QUANTITIES. FOR ACTUAL QUANTITIES, REFER TO PROJECT LEDGER AND/OR COMPUTATION BOOK.

DEPARTMENT OF TRANSPORTATION FEDERAL HIGHWAY ADMINISTRATION APPROVED:

DIVISION ADMINISTRATOR

DEPARTMENT OF TRANSPORTATION STATE OF HAWAII **APPROVED:**