

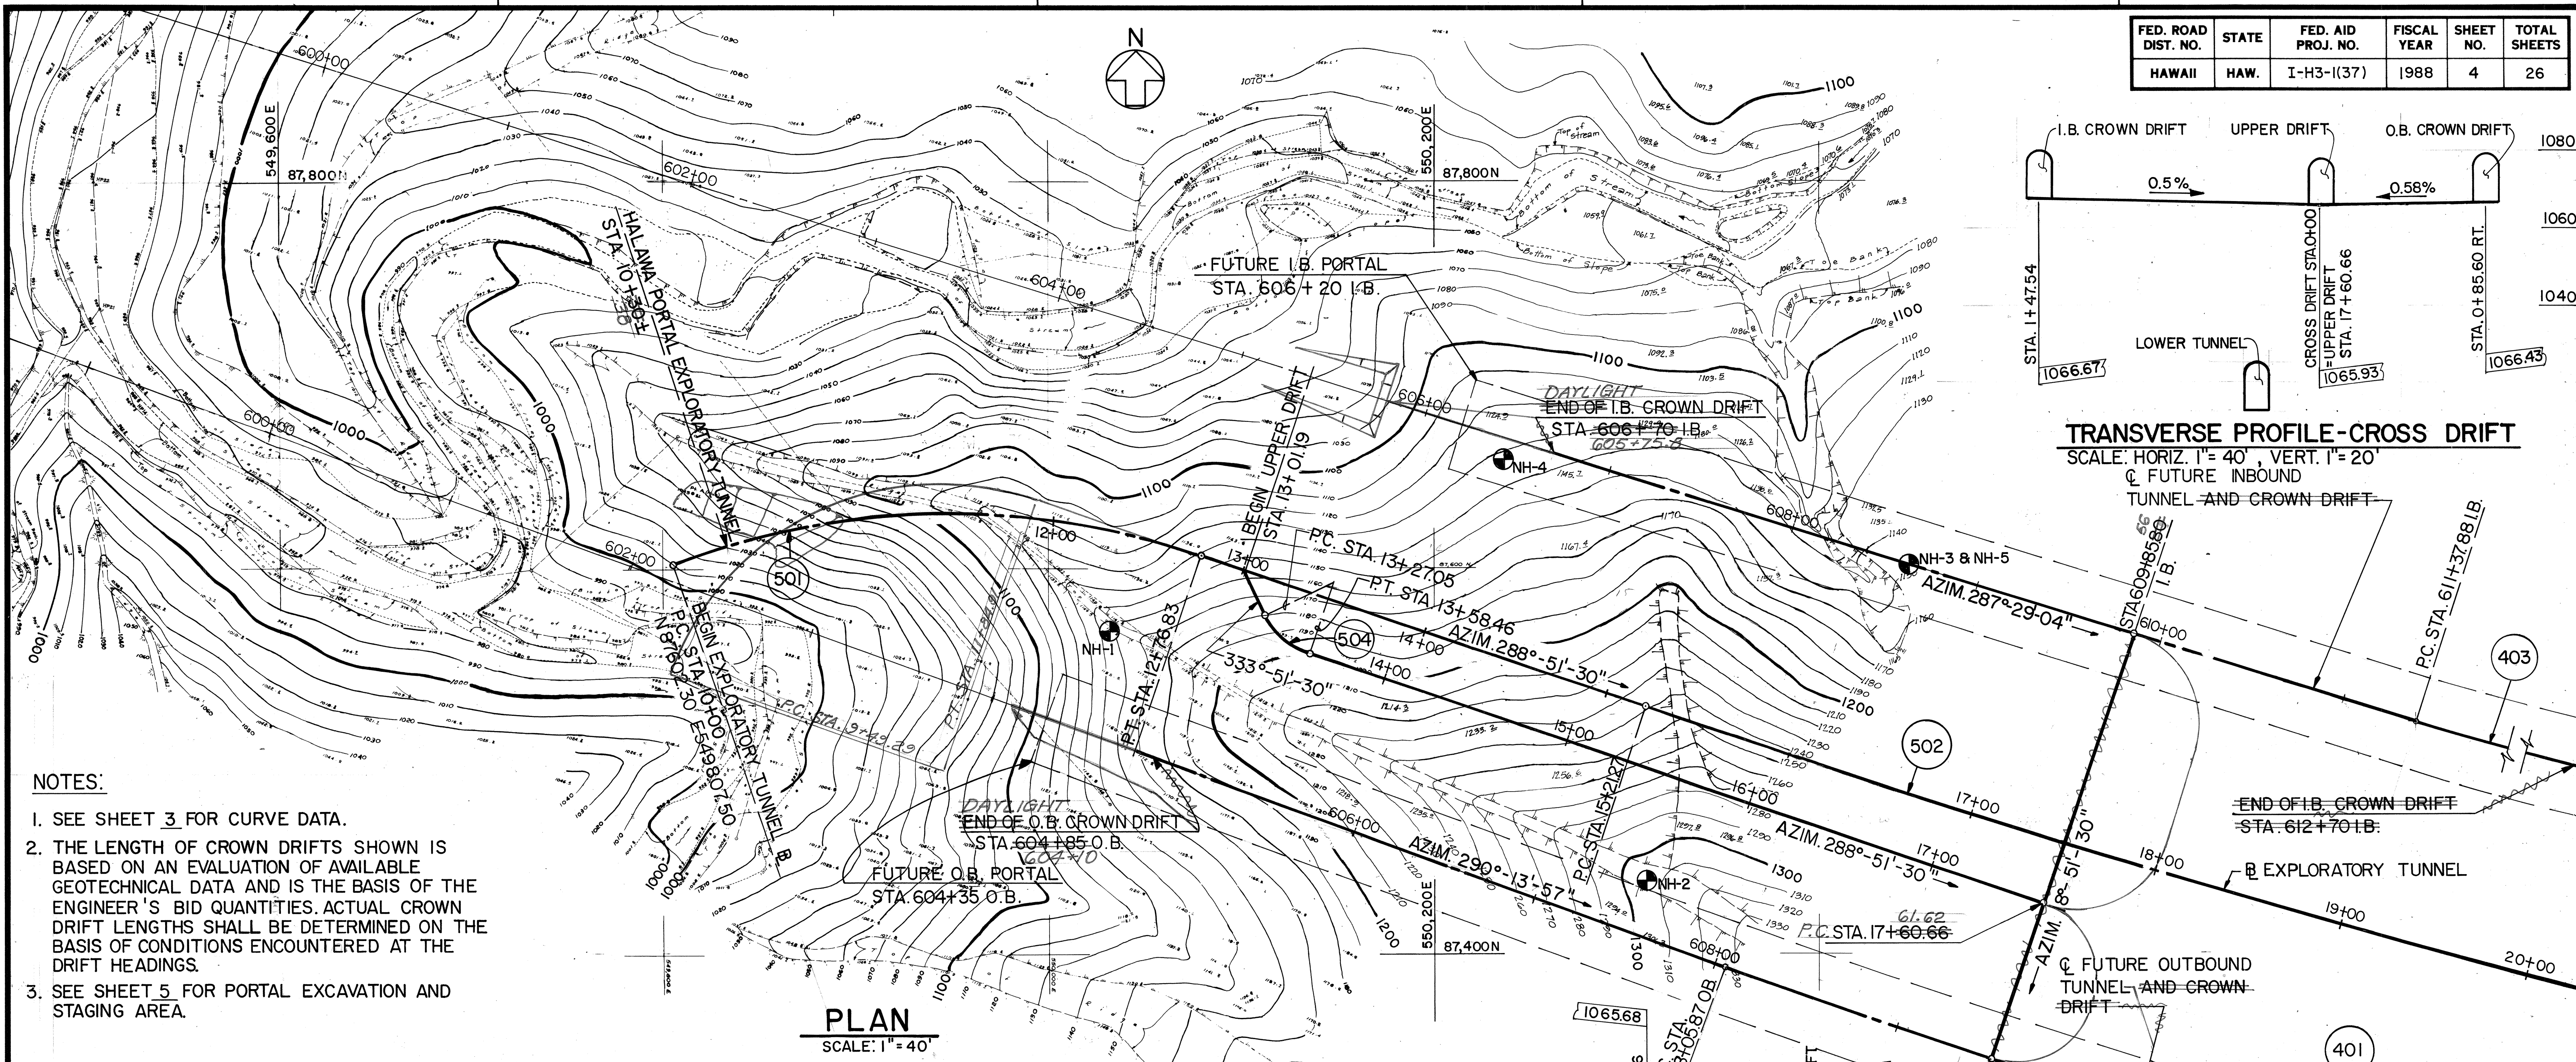



FED. ROAD DIST. NO.	STATE	FED. AID PROJ. NO.	FISCAL YEAR	SHEET NO.	TOTAL SHEETS
HAWAII	HAW.	I-H3-I(37)	1988	4	26

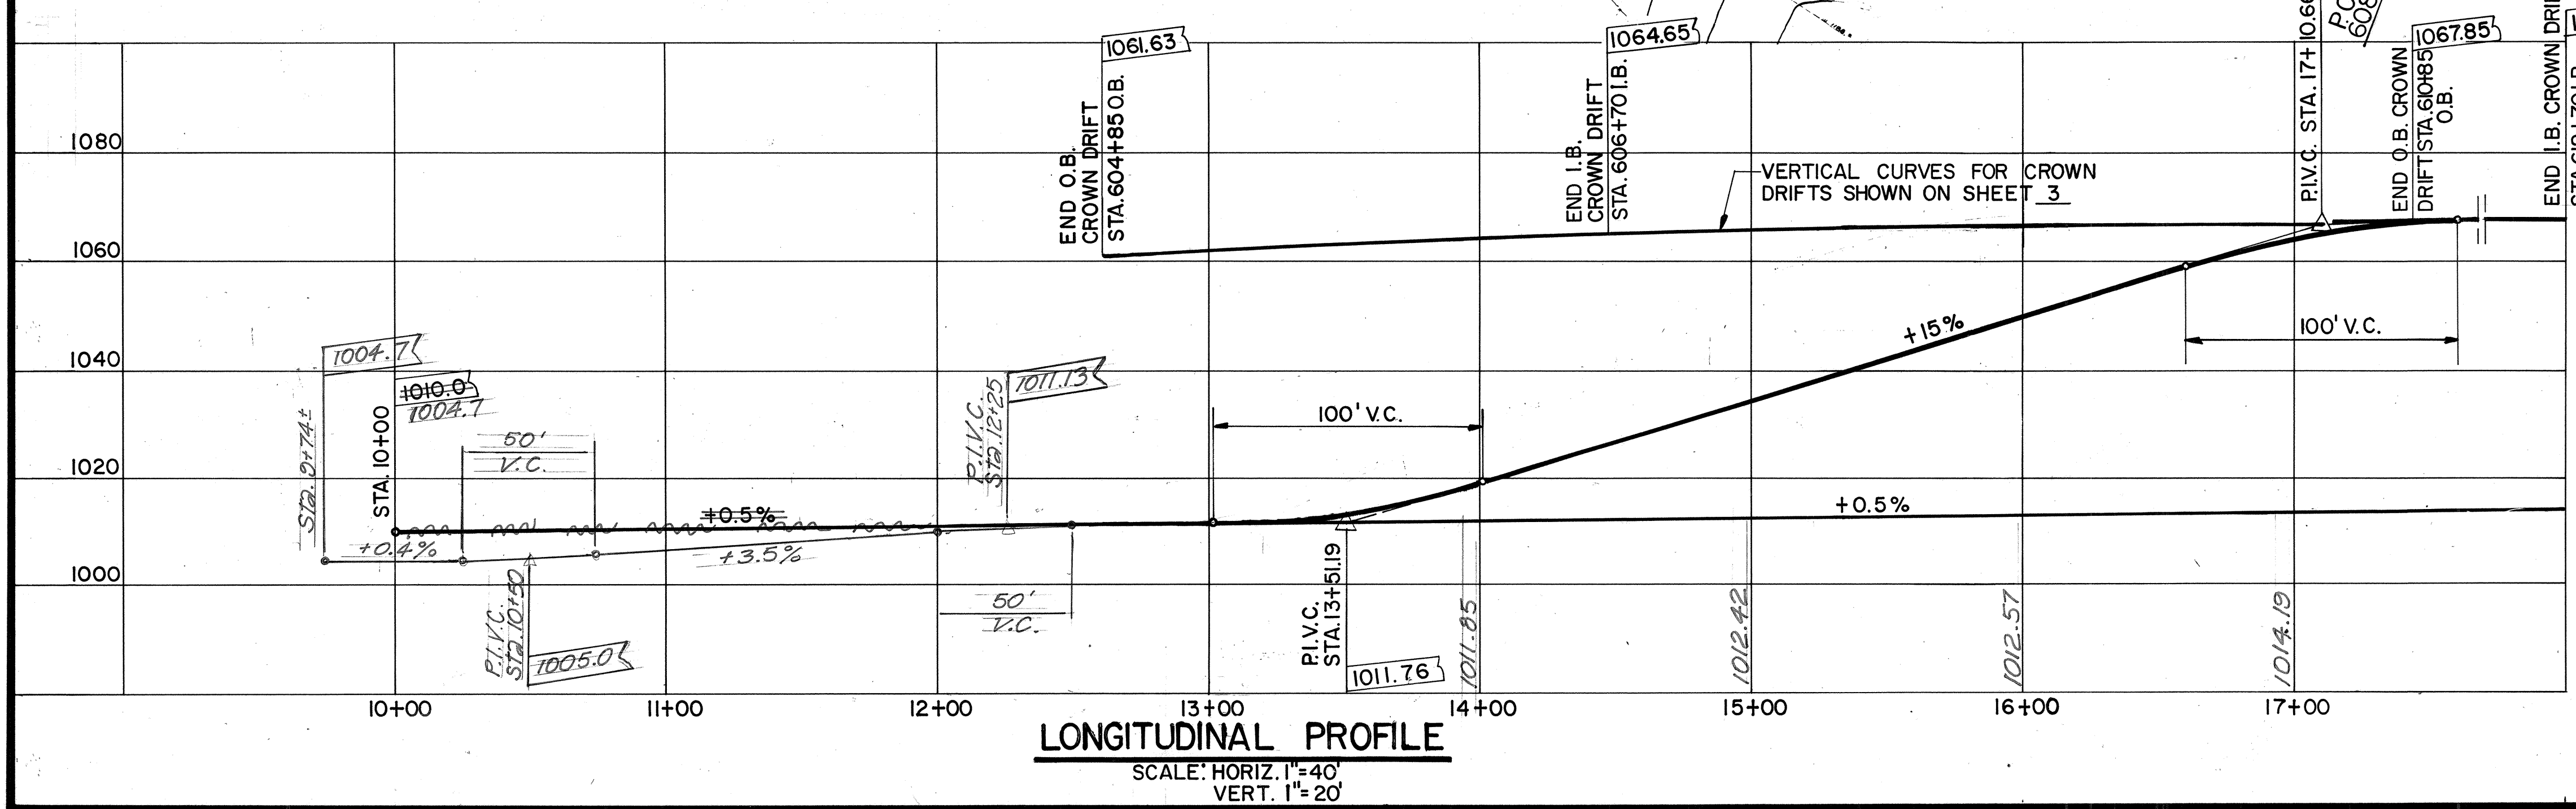

- NOTES:
- SEE SHEET 3 FOR CURVE DATA.
 - THE LENGTH OF CROWN DRIFTS SHOWN IS BASED ON AN EVALUATION OF AVAILABLE GEOTECHNICAL DATA AND IS THE BASIS OF THE ENGINEER'S BID QUANTITIES. ACTUAL CROWN DRIFT LENGTHS SHALL BE DETERMINED ON THE BASIS OF CONDITIONS ENCOUNTERED AT THE DRIFT HEADINGS.
 - SEE SHEET 5 FOR PORTAL EXCAVATION AND STAGING AREA.

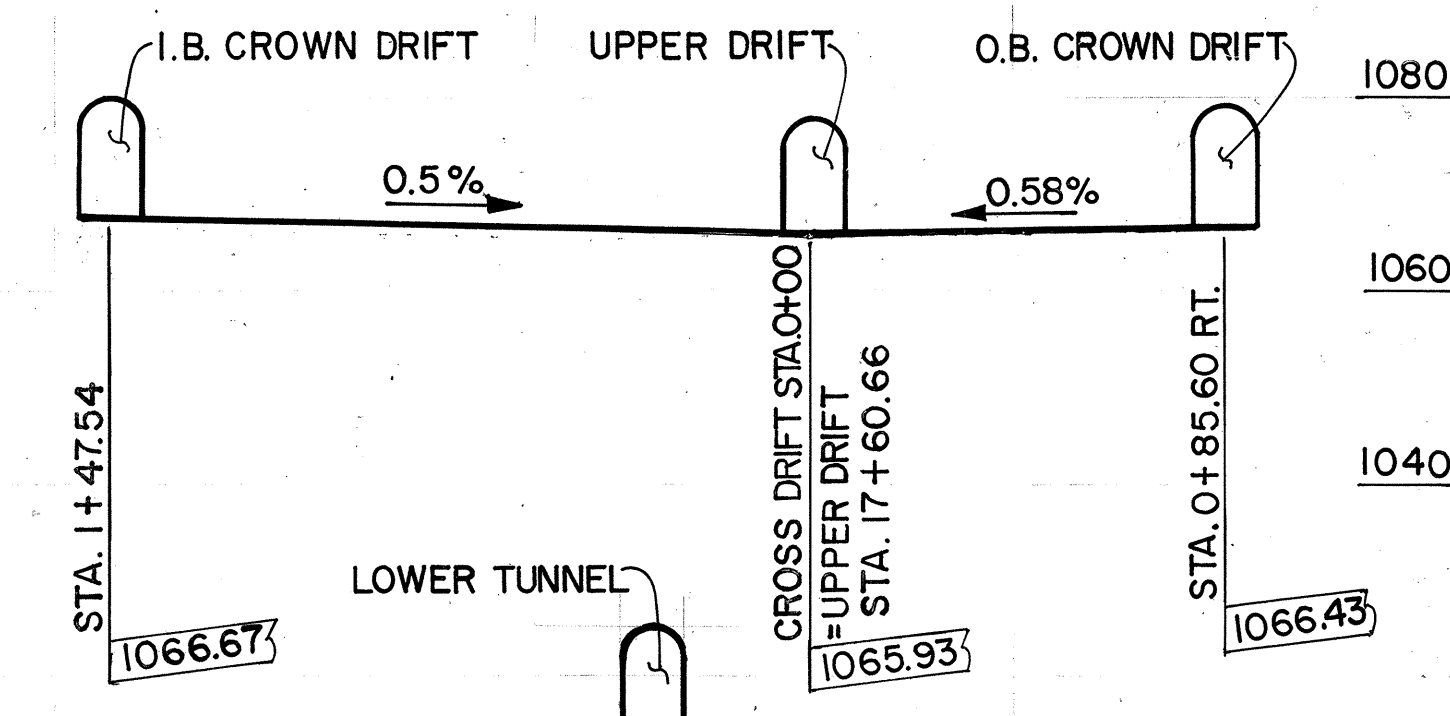

LEGEND
 LOCATION OF BORING

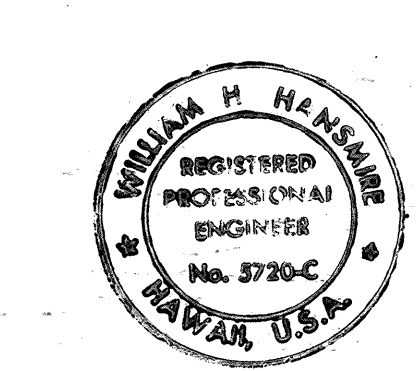

STATE OF HAWAII
 DEPARTMENT OF TRANSPORTATION
 HIGHWAYS DIVISION

HALAWA PLAN & PROFILE
 EXPLORATORY TUNNEL

INTERSTATE ROUTE H-3
 F.A.I. PROJECT NO. I-H3-I(37)

SCALE: AS NOTED DATE: AUG. 1988

SHEET NO. OF SHEETS

SURVEY PLOTTED BY	DATE
DRAWN BY	
DESIGNED BY	
CHECKED BY	
NO.	