


FED. ROAD DIST. NO.	STATE	FED. AID PROJ. NO.	FISCAL YEAR	SHEET NO.	TOTAL SHEETS
HAWAII	HAW.	I-H3-1(37)	1988	11	26


NOTES:

1. Ground support Types A and B shall be used for Alcoves and Passing Pockets as required.
2. See sheet 2 for ground support Types A & B.
3. Locations of Alcoves and Passing Pockets to be determined in the field by the engineer.

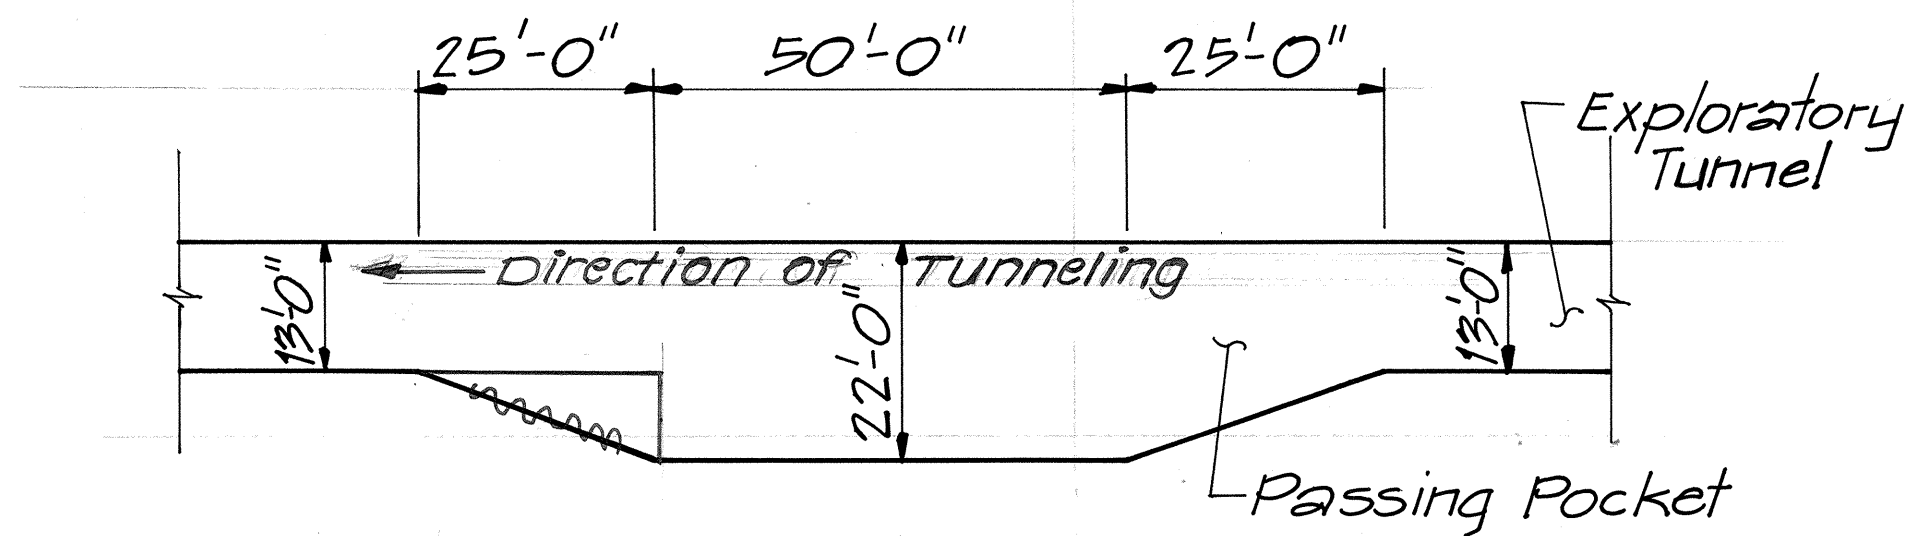


PASSING POCKET
STATION
24+91
45+50
53+80

PLAN
SCALE: 1"= 20'-0"

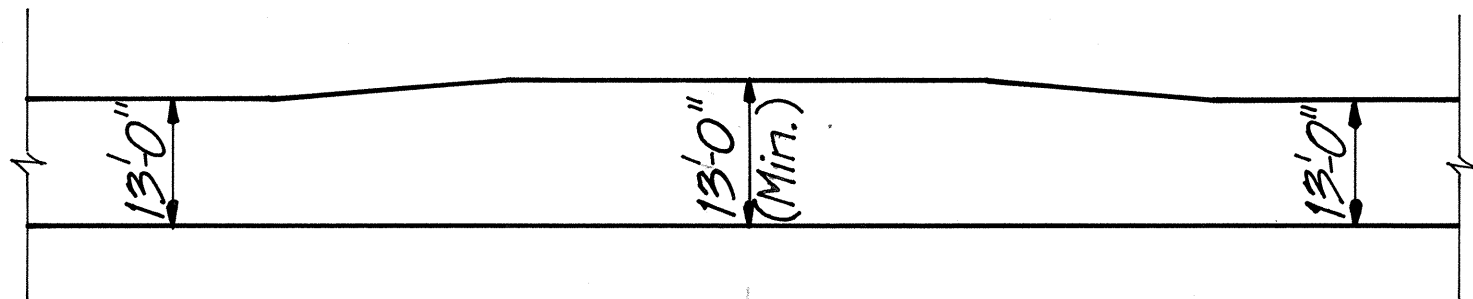


ELEVATION
SCALE: 1"= 20'-0"

TUNNEL	ALCOVE
STATION	
MAIN	12 + 41 Rt.
IBC	606 + 40 Rt.
IBC	606 + 80 Rt.
IBC	607 + 30 Lt.
IBC	608 + 00 Rt.
IBC	609 + 50 Lt.
OBC	604 + 60 Lt.
OBC	605 + 40 Rt.
OBC	606 + 20 Lt.
OBC	607 + 20 Rt.
OBC	608 + 40

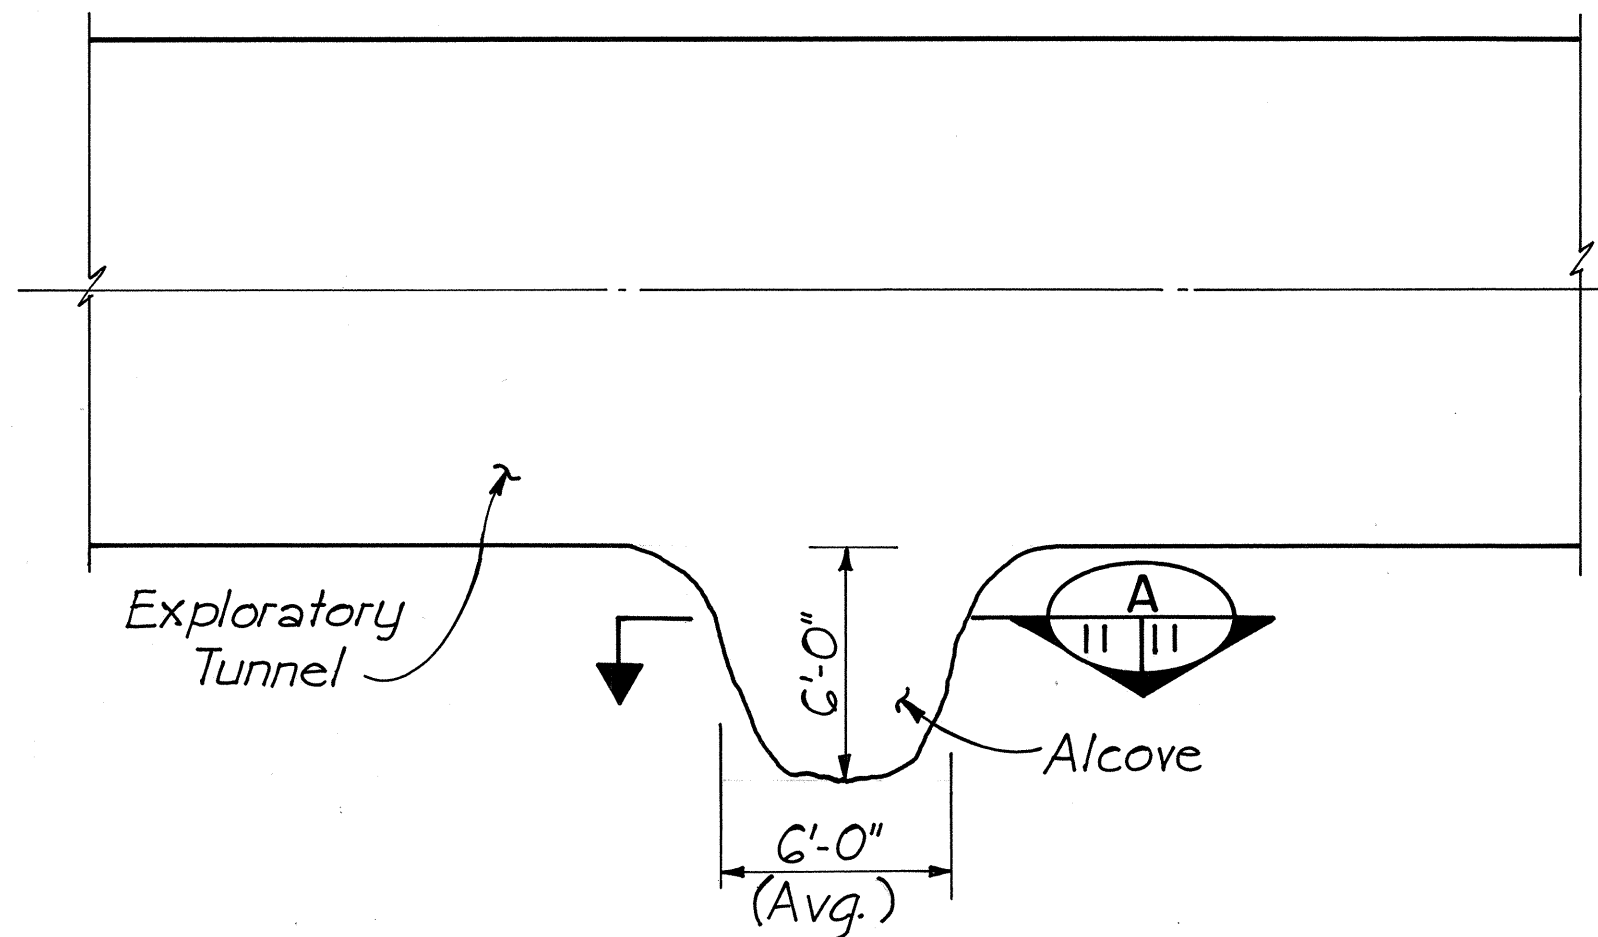


PLAN
SCALE: 1"= 5'-0"

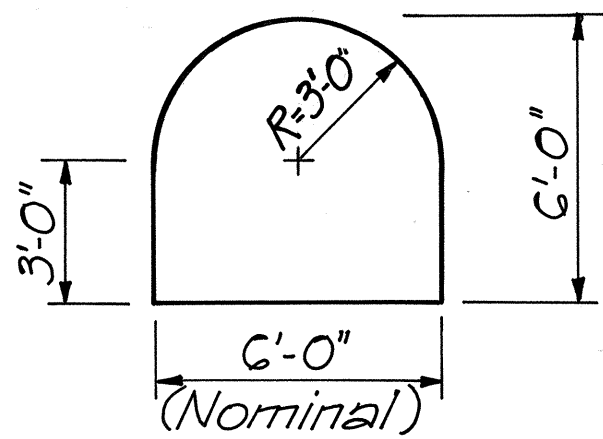

SECTION
SCALE: 1"= 4'-0"

DATE	
DESIGNED BY	
CHECKED BY	
NOTED BY	
NO.	

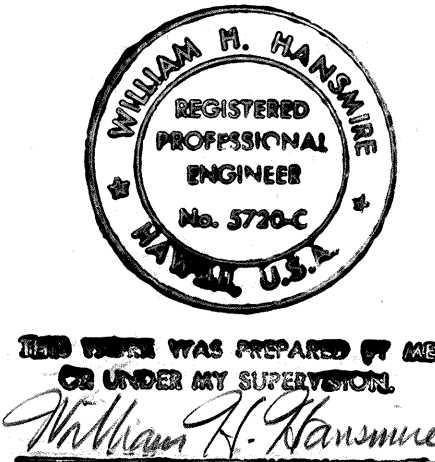

STATE OF HAWAII
DEPARTMENT OF TRANSPORTATION
HIGHWAYS DIVISION

PASSING POCKETS & ALCOVES

EXPLORATORY TUNNEL
INTERSTATE ROUTE H-3
F.A.I. PROJECT NO. I-H3-1 (37)

SCALE: AS NOTED DATE: AUG. 1988

SHEET NO. OF SHEETS