

INDEX TO DRAWINGS	
SHEET NO.	DESCRIPTION
1	TITLE SHEET
2	STANDARD PLANS SUMMARY
3	GENERAL PLAN & PROFILE
4	HALAWA PLAN & PROFILE
5	HALAWA PORTAL DETAILS
6	HAIKU PORTAL DETAILS
7	UPPER DRIFT INTERSECTION PLAN
8	PORTAL SUPPORT DETAILS
9 - 10	GROUND SUPPORT TYPES & DETAILS
11	PASSING POCKETS & ALCOVES
12	INSTRUMENTATION DETAILS
13	GEOTECHNICAL TESTING DETAILS
14	TIEBACK TEST PROGRAM
15	PRECAST CONCRETE PANELS
16 - 19	OVERHEAD POWER LINE LAYOUT-HALAWA
20 - 23	OVERHEAD POWER LINE LAYOUT-HAIKU
24	POLE METERING DETAILS
25	POWER LINE DETAILS
26	SUBSTATION LAYOUT

STATE OF HAWAII

DEPARTMENT OF TRANSPORTATION

HIGHWAYS DIVISION

HONOLULU, HAWAII

"AS-BUILT"

PLANS FOR

CONSTRUCTION OF A PORTION OF



INTERSTATE ROUTE H-3

TRANS-KOOLAU EXPLORATORY TUNNEL

FEDERAL AID INTERSTATE PROJECT NO. I-H3-1(37)

DISTRICTS OF KOOLAUPOKO AND EWA

ISLAND OF OAHU

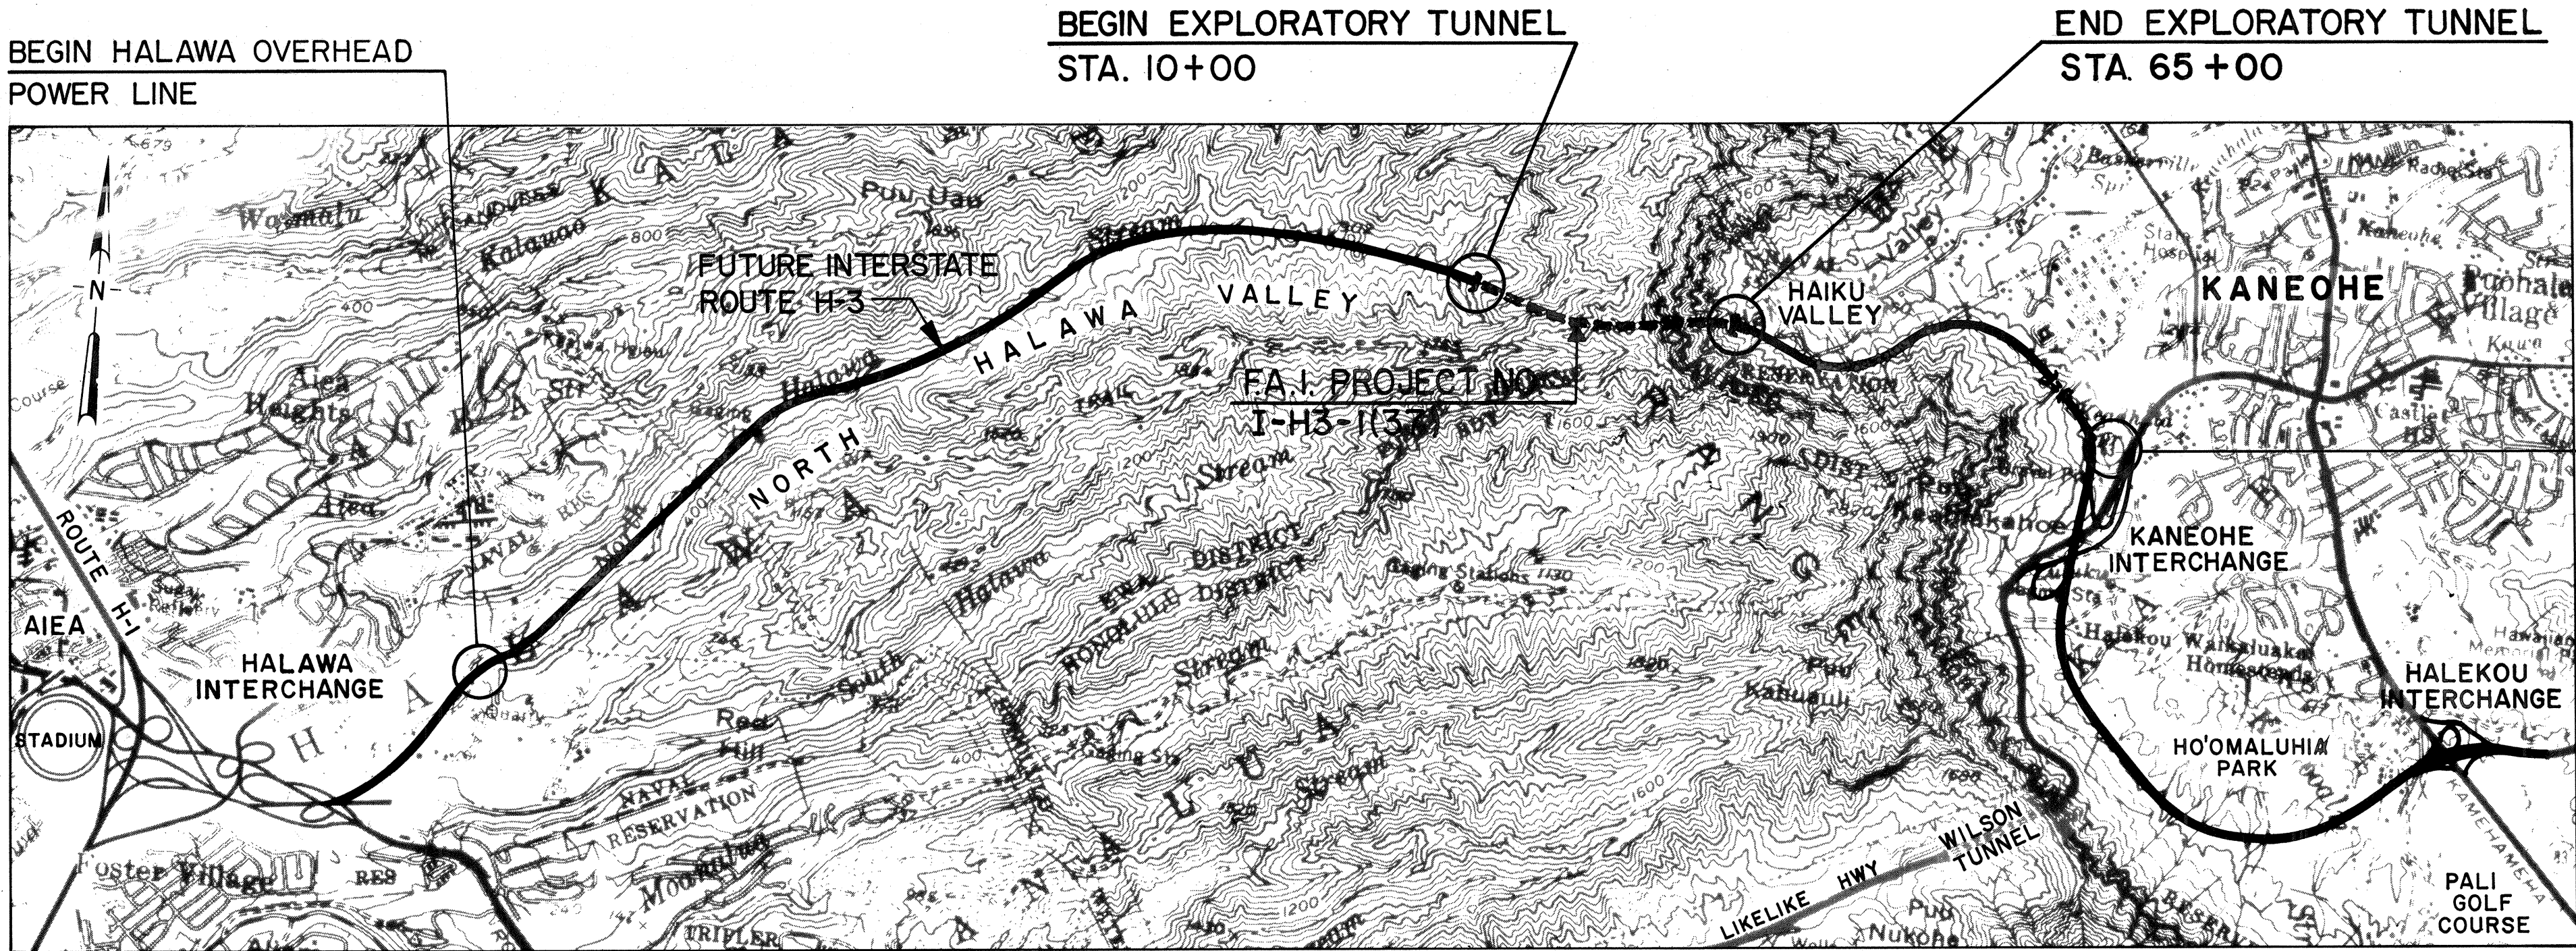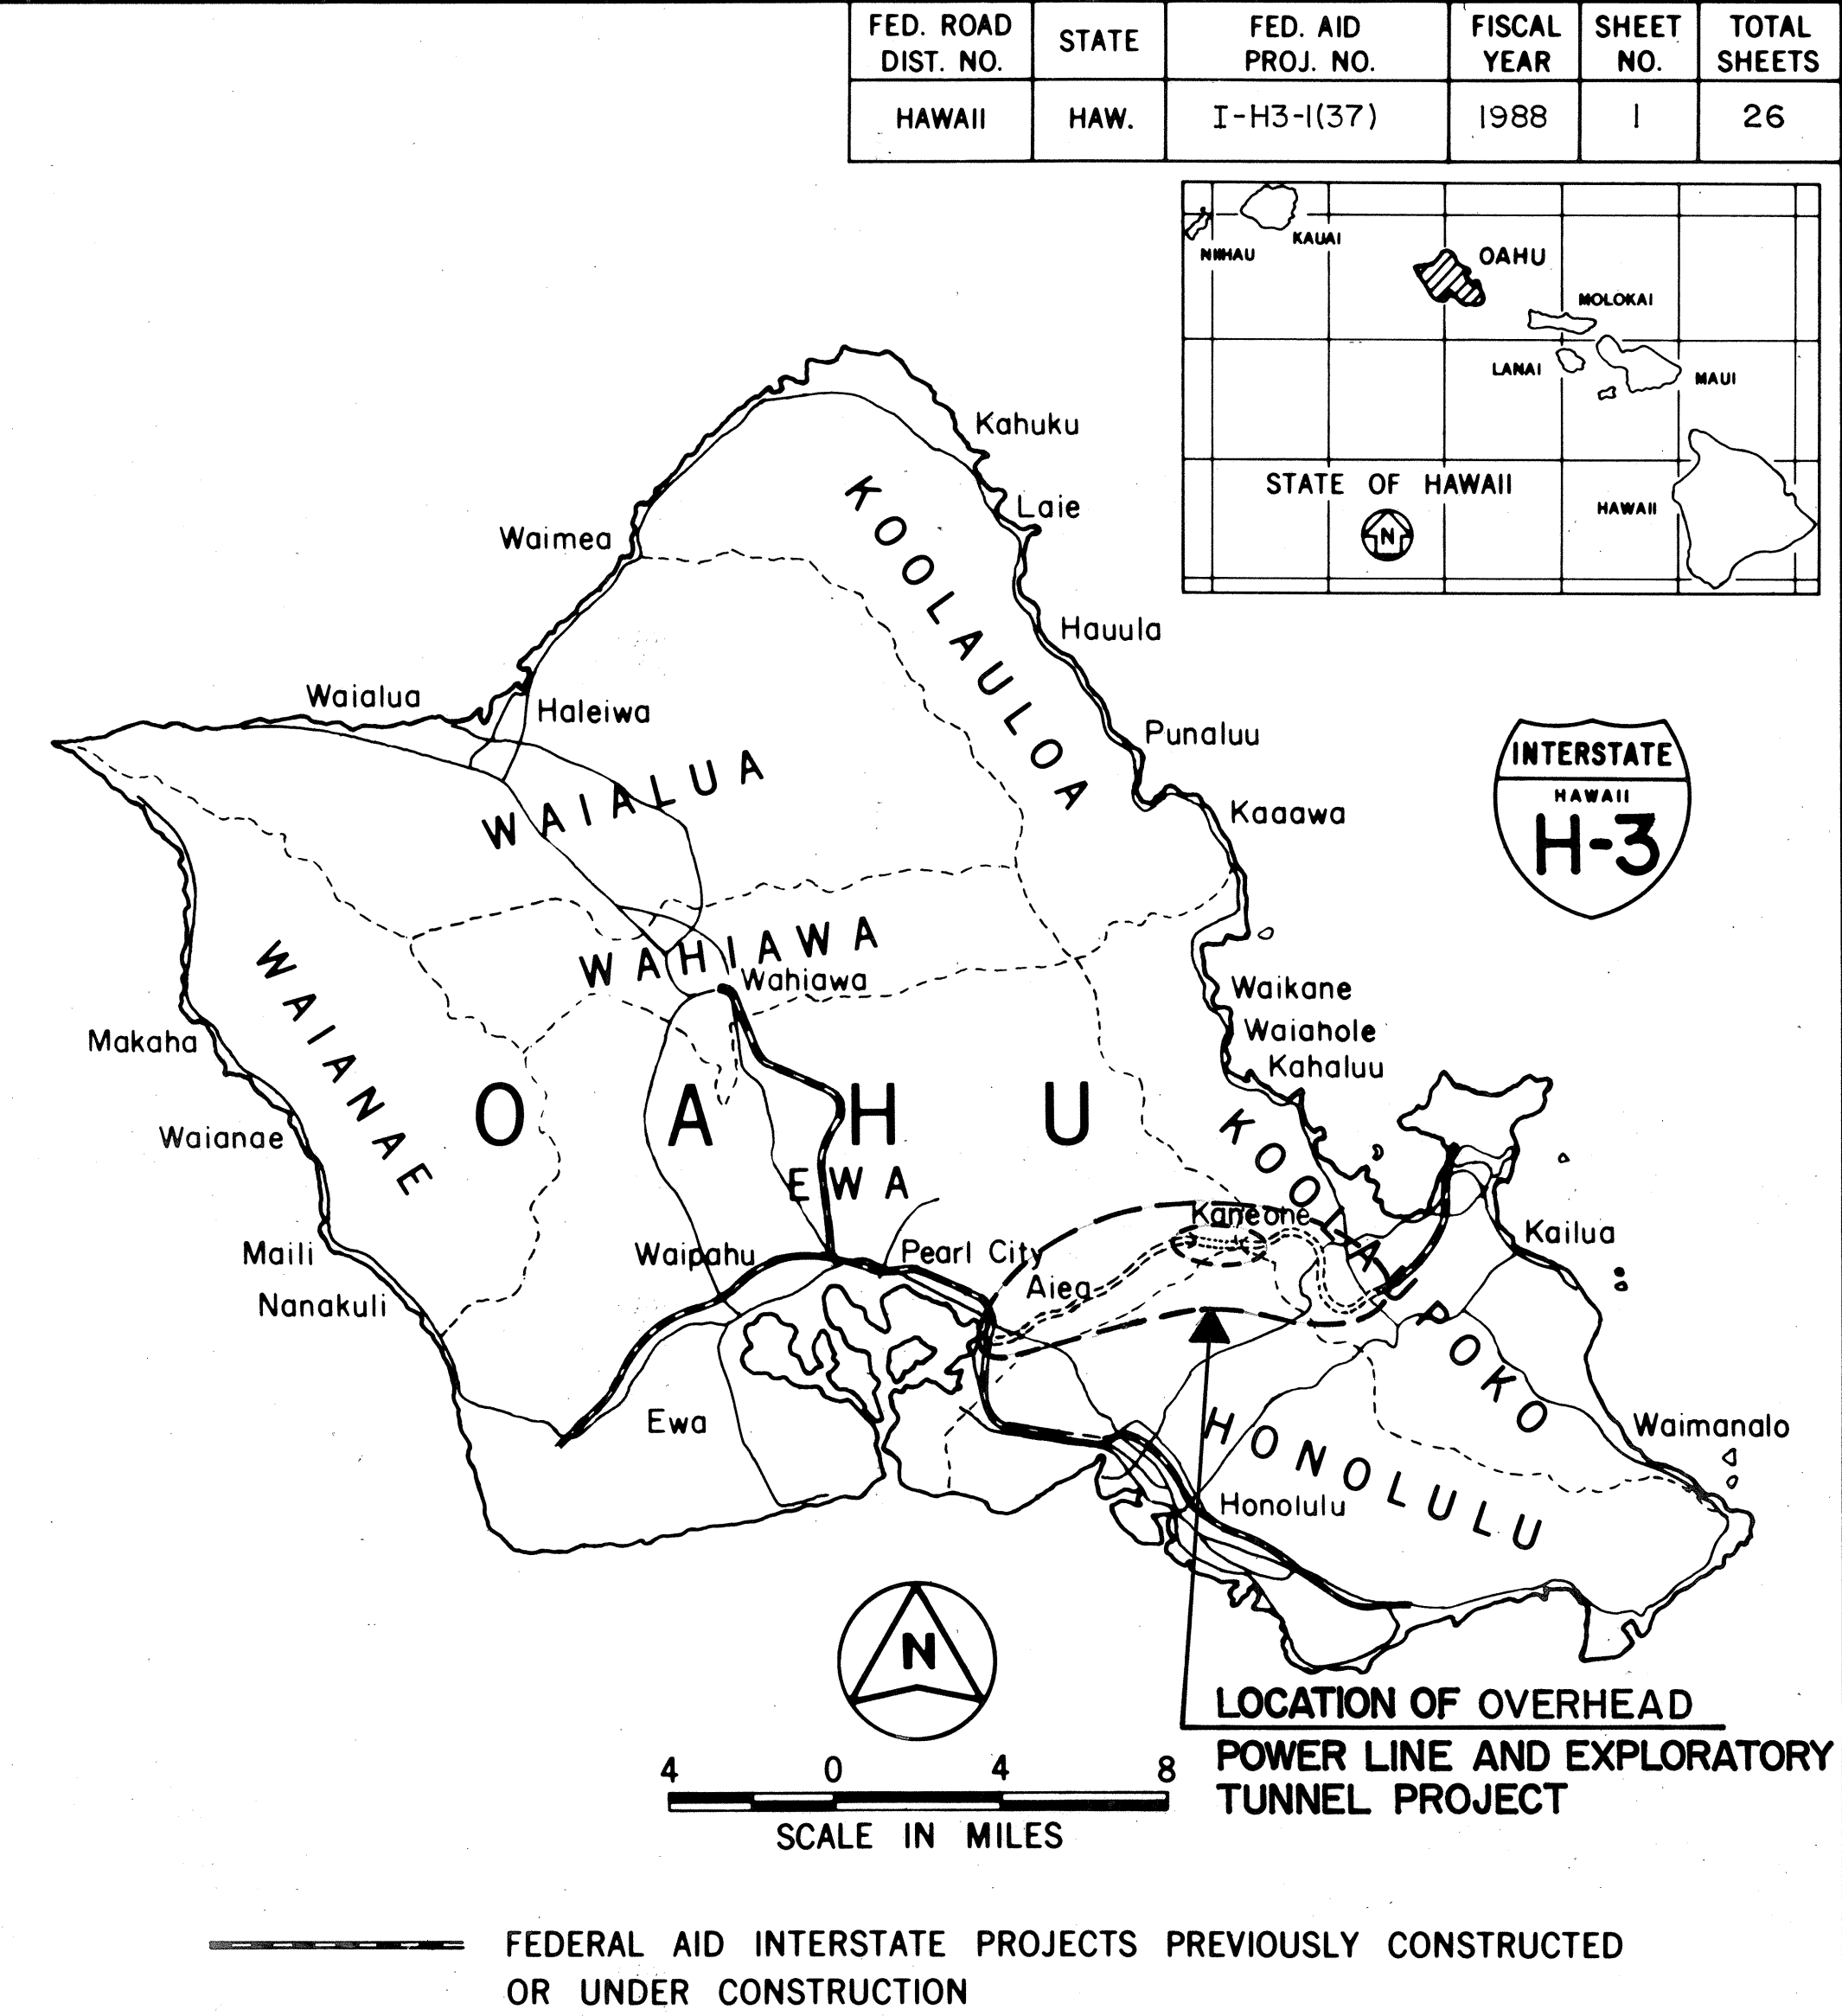

8/26/88

DATE

548-6932

PHONE

D. TANAKA

P. S. & E. BY

PBHA

DESIGNED BY

DEPARTMENT OF TRANSPORTATION

FEDERAL HIGHWAY ADMINISTRATION

APPROVED:

9/6/88

DATE

DEPARTMENT OF TRANSPORTATION

STATE OF HAWAII

APPROVED:

9/24/88

DATE

CHANGES MADE DURING CONSTRUCTION HAVE BEEN INCORPORATED ON THESE PLANS EXCEPT CHANGES IN THE ORIGINAL THEORETICAL QUANTITIES. FOR ACTUAL QUANTITIES, REFER TO PROJECT LEDGER AND/OR COMPUTATION BOOK.

2/1/2000

DATE