



DATE	BY	FINAL SURVEY	SURVEYED	PLOTTED	NOTED	NO.

DATE	BY	ORIGINAL SURVEY	SURVEYED	PLOTTED	NOTED	NO.

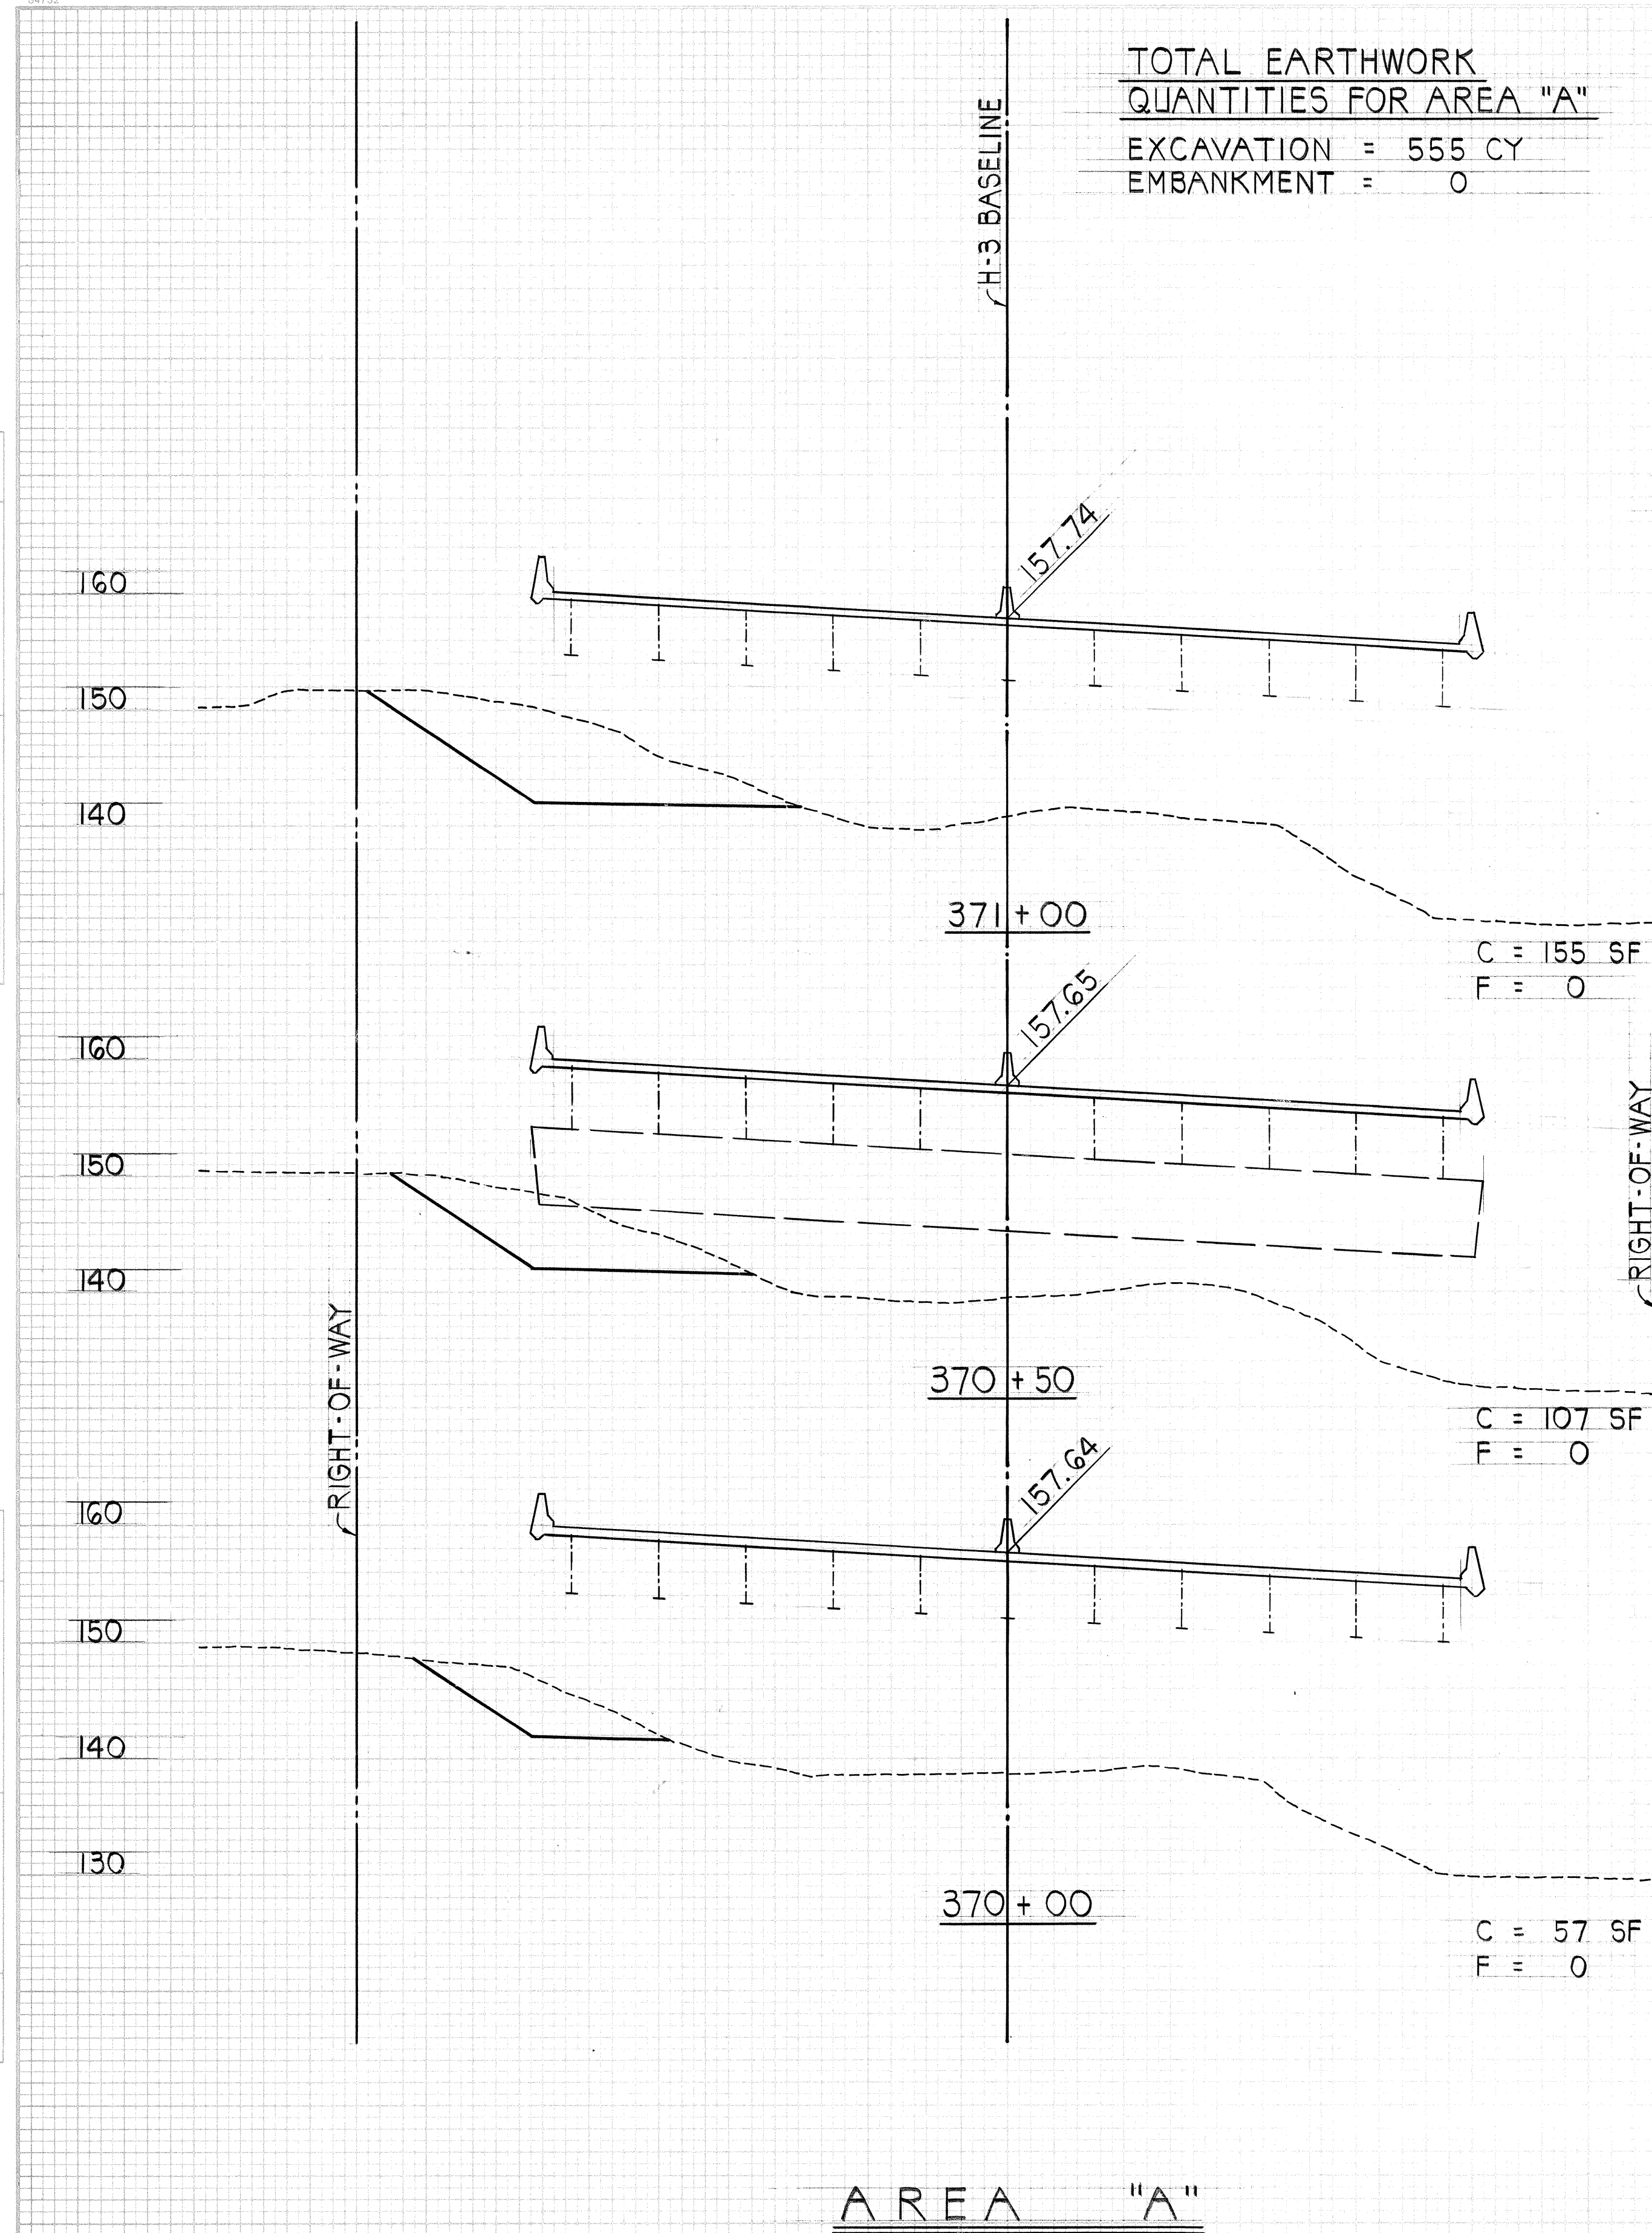


SCALES:
HORIZ. 1" = 10'
VERT. 1" = 10'

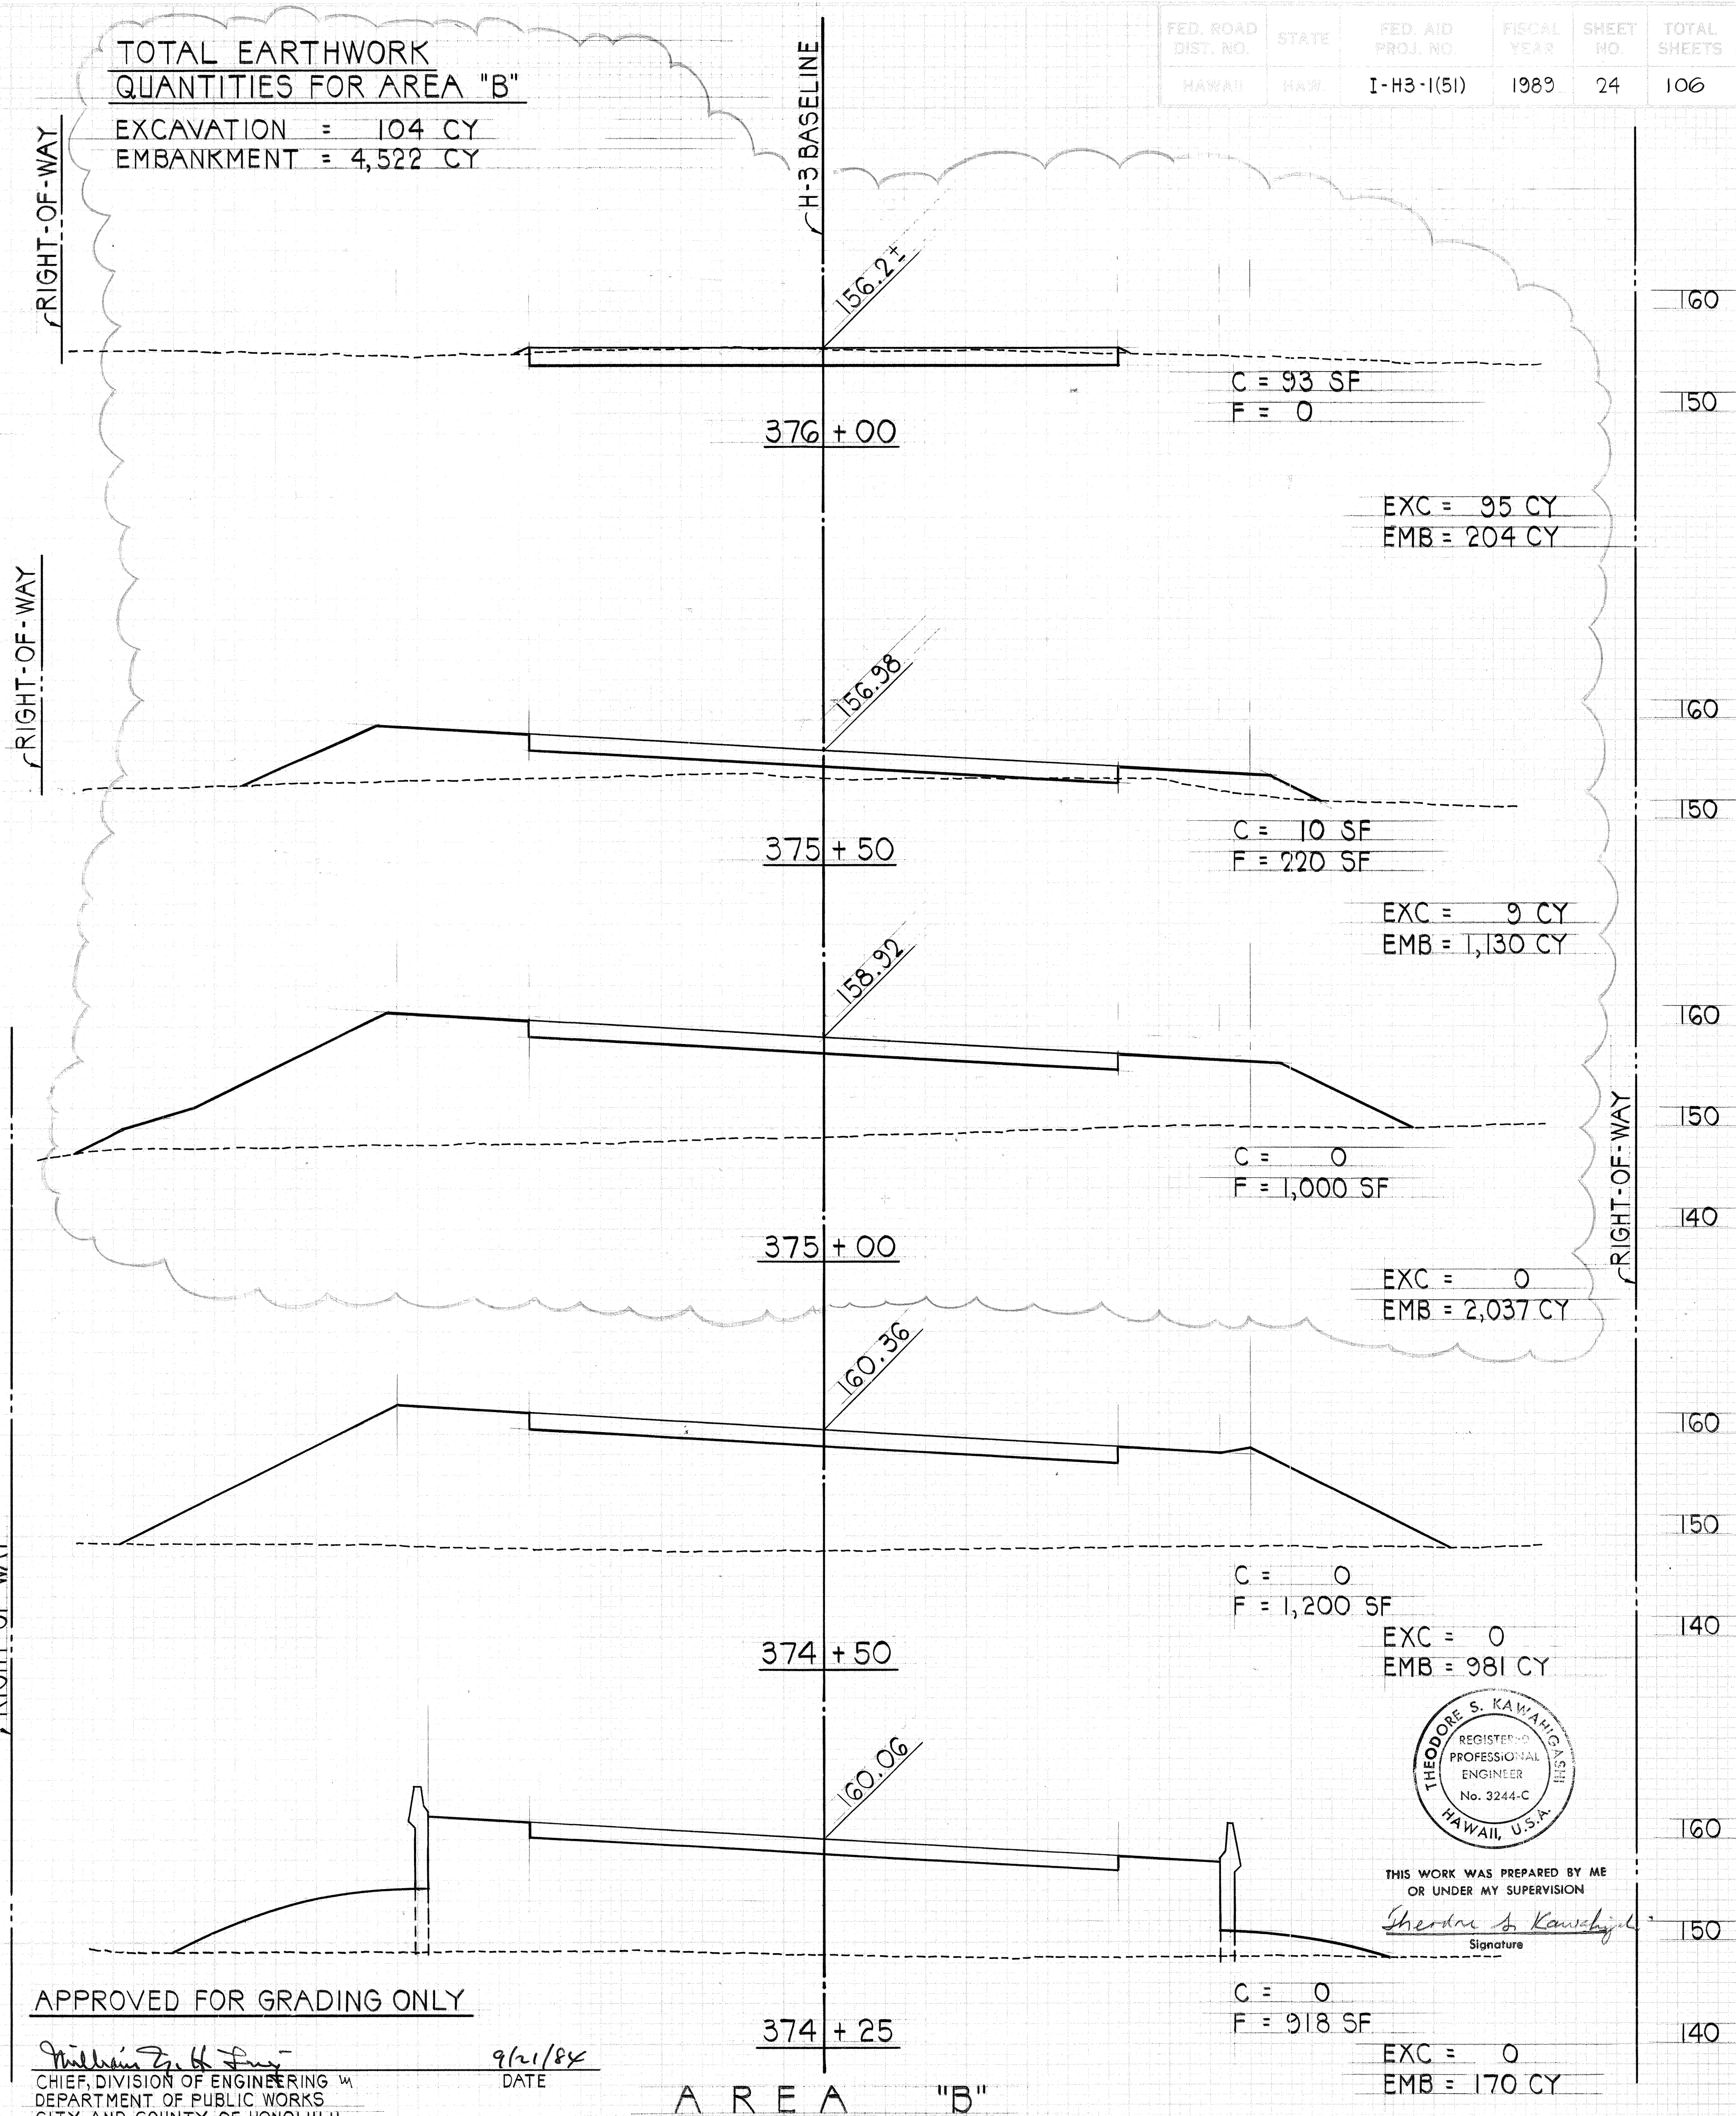

APPROVED FOR GRADING ONLY

William Z. H. Fung
CHIEF, DIVISION OF ENGINEERING
DEPARTMENT OF PUBLIC WORKS
CITY AND COUNTY OF HONOLULU

9/21/84
DATE

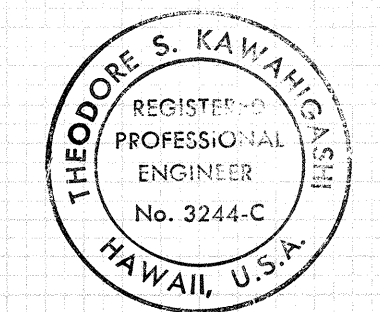

THIS WORK WAS PREPARED BY ME
OR UNDER MY SUPERVISION
Sheldon S. Kawahiga
Signature

DATE	REVISION
8/17/90	REVISED SECTIONS & QUANTITIES

C.O. 24