



FED. ROAD DIST. NO.	STATE	FED. AID PROJ. NO.	FISCAL YEAR	SHEET NO.	TOTAL SHEETS
HAWAII	HAW.	I-H3-1(51)	1989	5	106

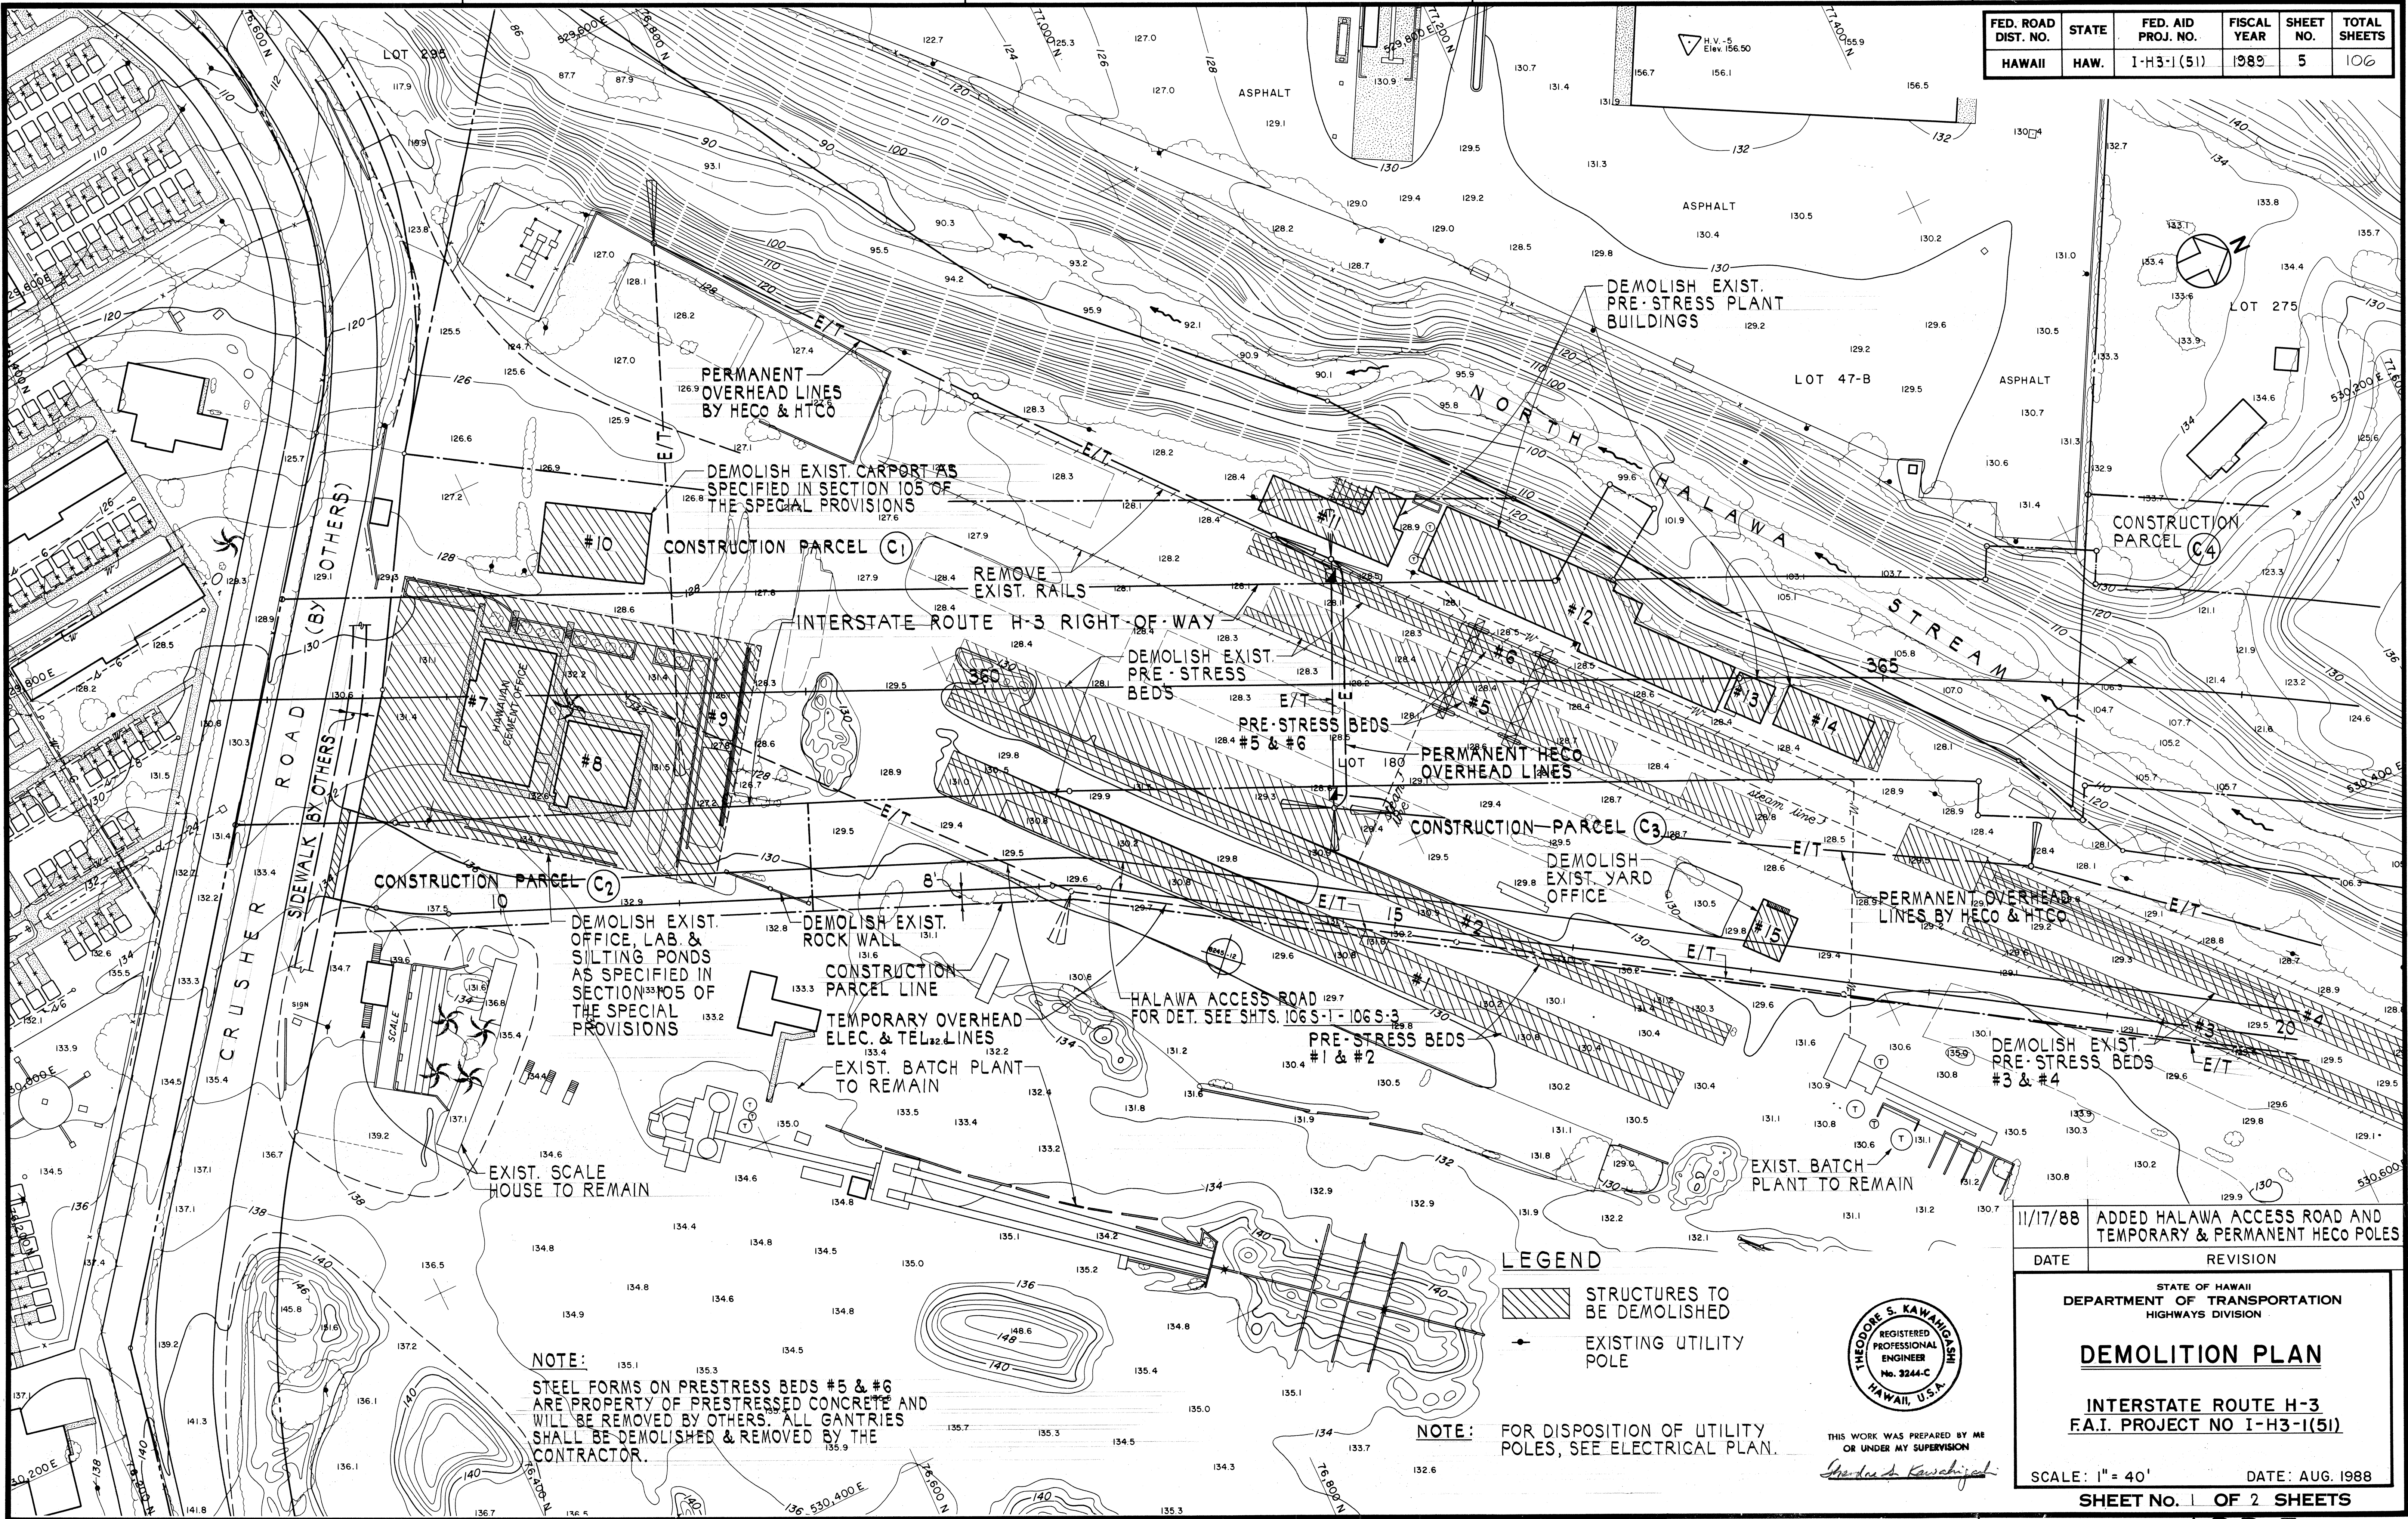

SURVEY PLOTTED BY	DATE
DRAWN BY	
DESIGNED BY	
QUANTITIES BY	
CHECKED BY	

NOTE:
STEEL FORMS ON PRESTRESS BEDS #5 & #6 ARE PROPERTY OF PRESTRESSED CONCRETE AND WILL BE REMOVED BY OTHERS. ALL GANTRIES SHALL BE DEMOLISHED & REMOVED BY THE CONTRACTOR.

- LEGEND
- [Hatched Box] STRUCTURES TO BE DEMOLISHED
 - [Circle with Cross] EXISTING UTILITY POLE

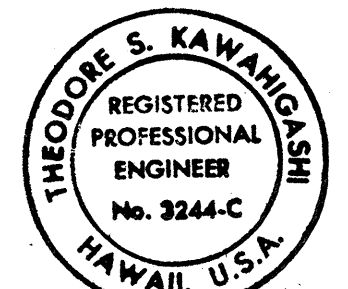

THIS WORK WAS PREPARED BY ME OR UNDER MY SUPERVISION
Theodore S. Kawahigashi

11/17/88	ADDED HALAWA ACCESS ROAD AND TEMPORARY & PERMANENT HECO POLES
DATE	REVISION

STATE OF HAWAII
DEPARTMENT OF TRANSPORTATION
HIGHWAYS DIVISION

DEMOLITION PLAN

INTERSTATE ROUTE H-3
F.A.I. PROJECT NO I-H3-1(51)

SCALE: 1" = 40' DATE: AUG. 1988

SHEET NO. 1 OF 2 SHEETS

