



FED. ROAD DIST. NO.	STATE	FED. AID PROJ. NO.	FISCAL YEAR	SHEET NO.	TOTAL SHEETS
HAWAII	HAW.	I-H3-1(51)	1988	3	106

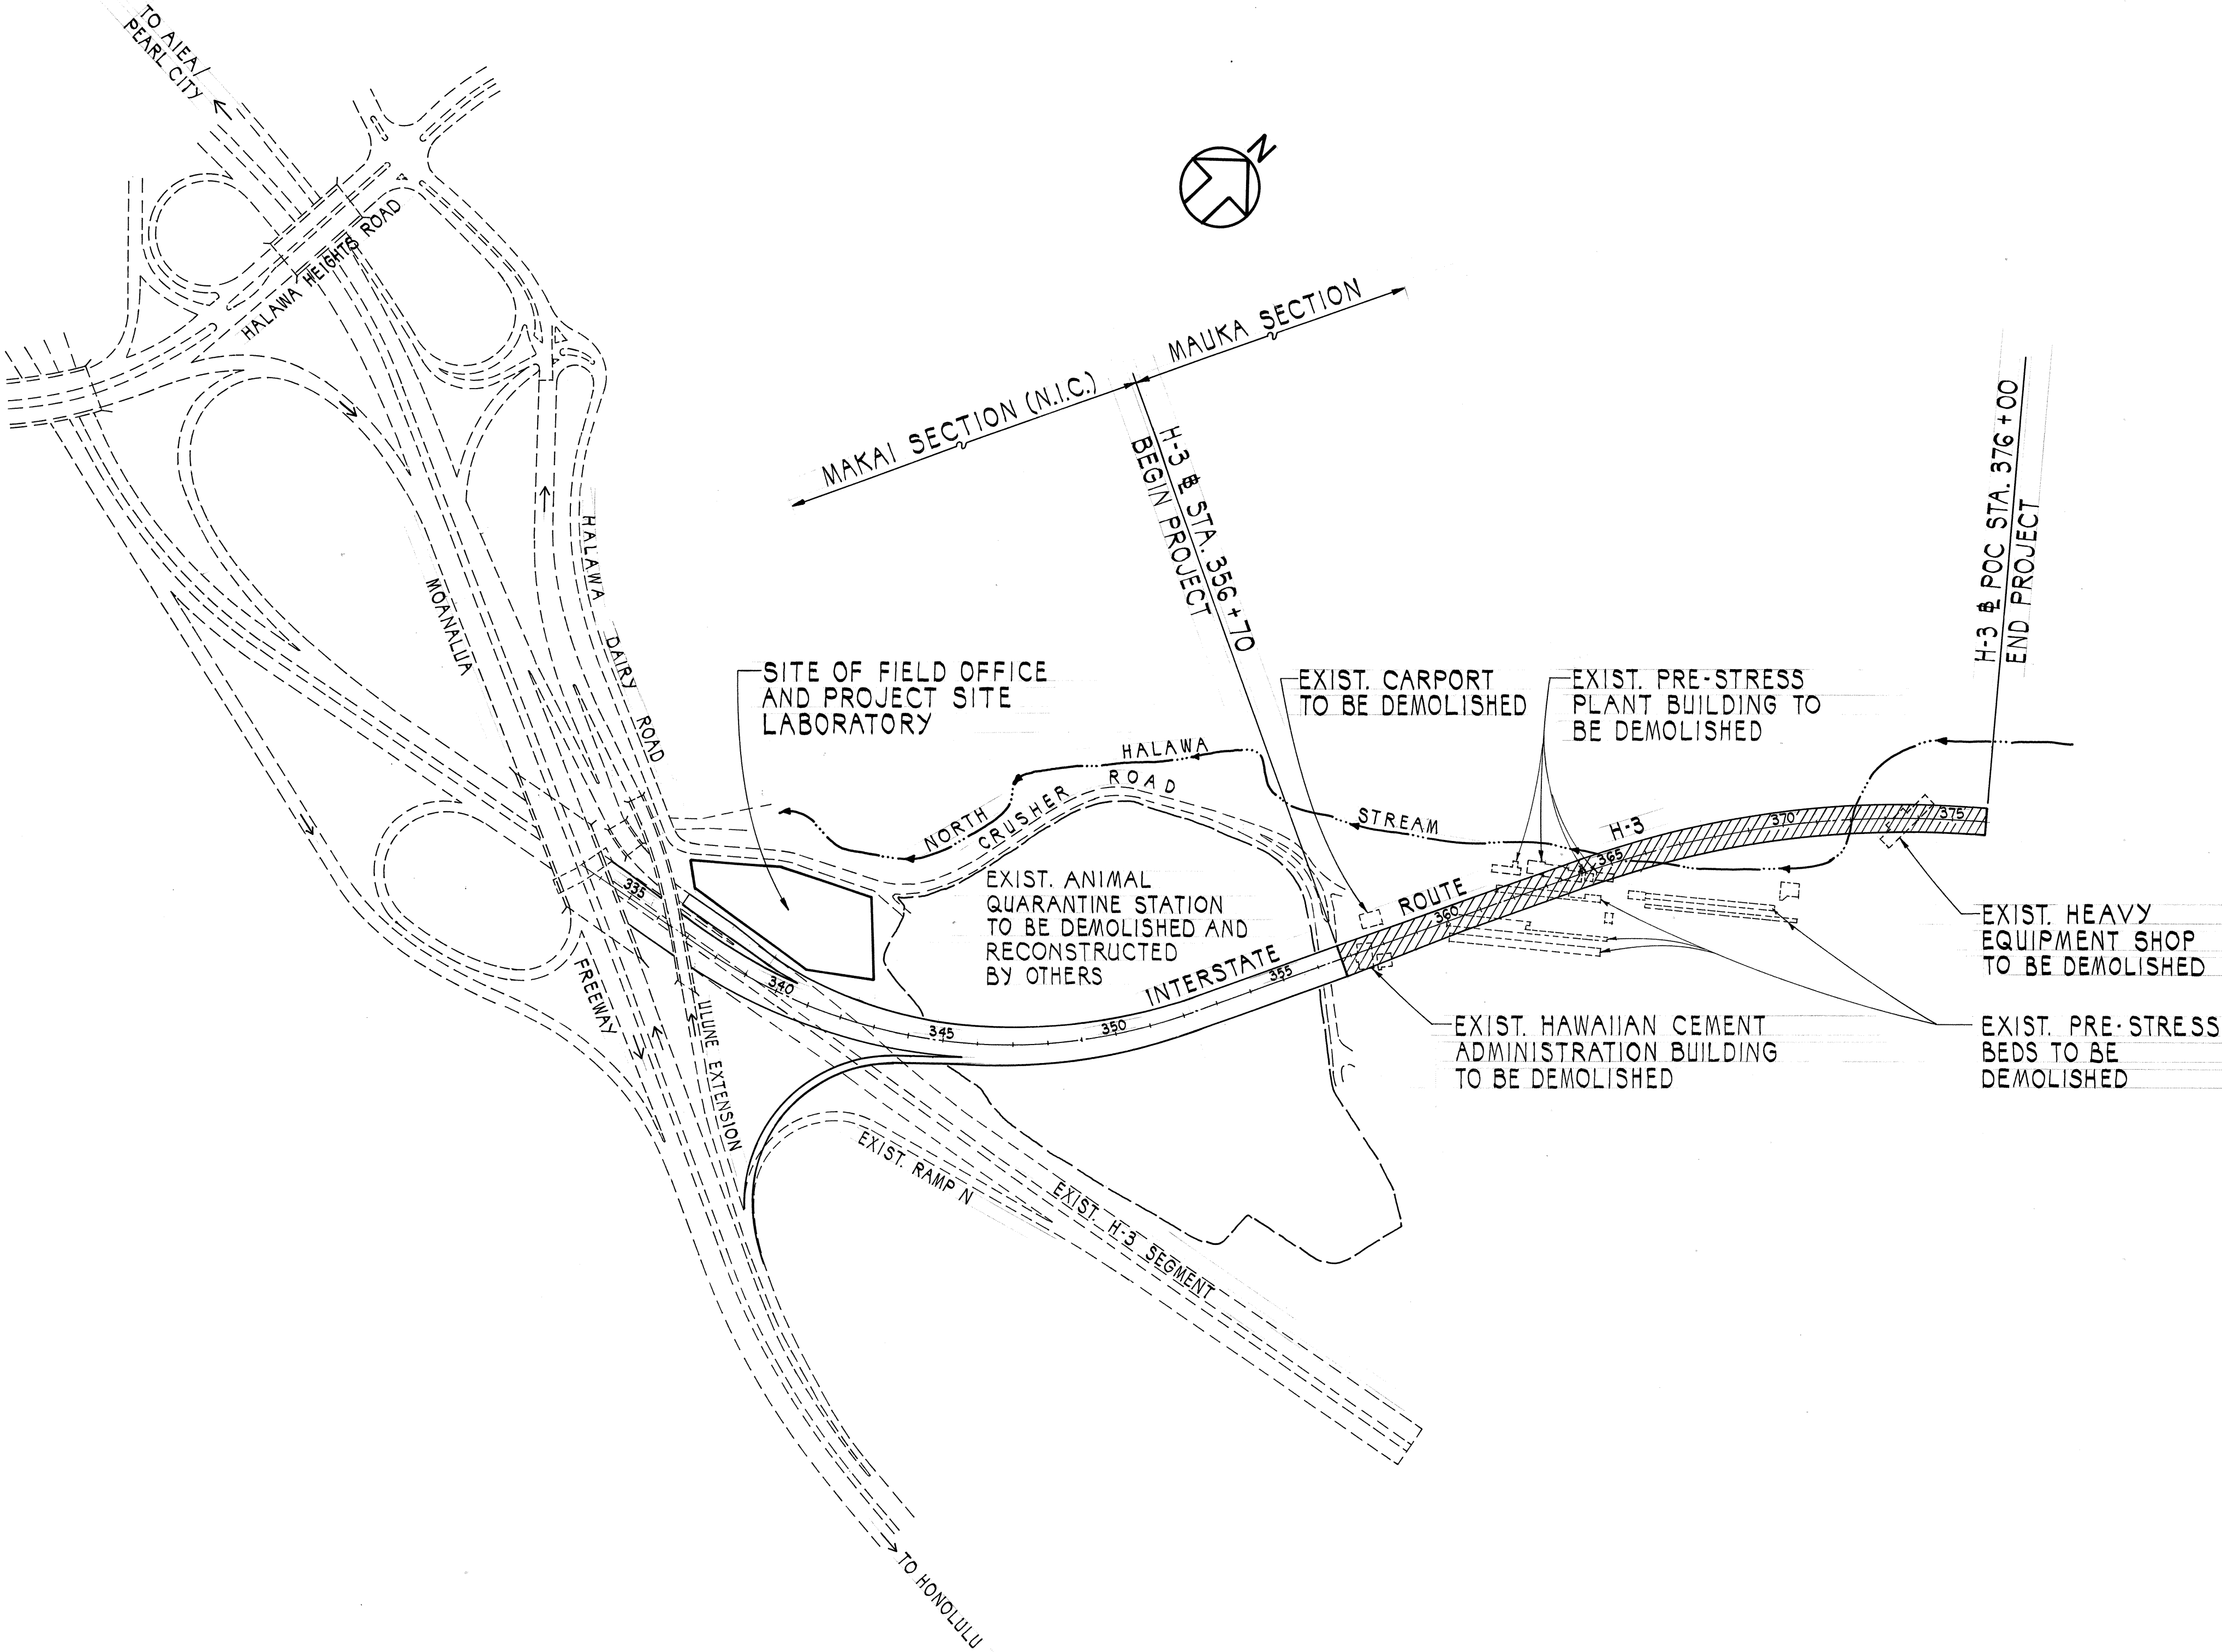

**GENERAL PLAN**  
 SCALE: 1" = 300'

SURVEY PLOTTED BY	DATE
DRAWN BY	
TRACED BY	
NOTED BY	
CHECKED BY	
ORIGINAL PLAN	
NOTE BOOK	
NO.	

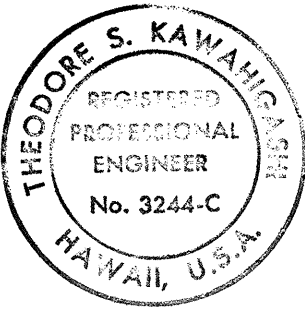

THIS WORK WAS PREPARED BY ME  
 OR UNDER MY SUPERVISION  
*Theodore S. Kawahigata*  
 Signature

11/15/88	ADDED LOCATION OF OFFICE & LAB.
DATE	REVISION
STATE OF HAWAII DEPARTMENT OF TRANSPORTATION HIGHWAYS DIVISION  <b>GENERAL PLAN</b>  INTERSTATE ROUTE H-3 F.A.I. PROJECT NO. I-H3-1(51)	
SCALE: 1" = 300'	DATE: AUG. 1988
SHEET NO. 1 OF 1 SHEETS	