


FED. ROAD DIST. NO.	STATE	FED. AID PROJ. NO.	FISCAL YEAR	SHEET NO.	TOTAL SHEETS
HAWAII	HAW.	I-H3-1(51)	1989	9	106



ORIGINAL PLAN	SURVEY PLOTTED BY _____		DATE _____
NOTE BOOK	DRAWN BY _____	DESIGNED BY _____	_____
	BY _____	QUANTITIES BY _____	_____
	_____	CHECKED BY _____	_____
	_____	_____	_____
NO. _____	_____		

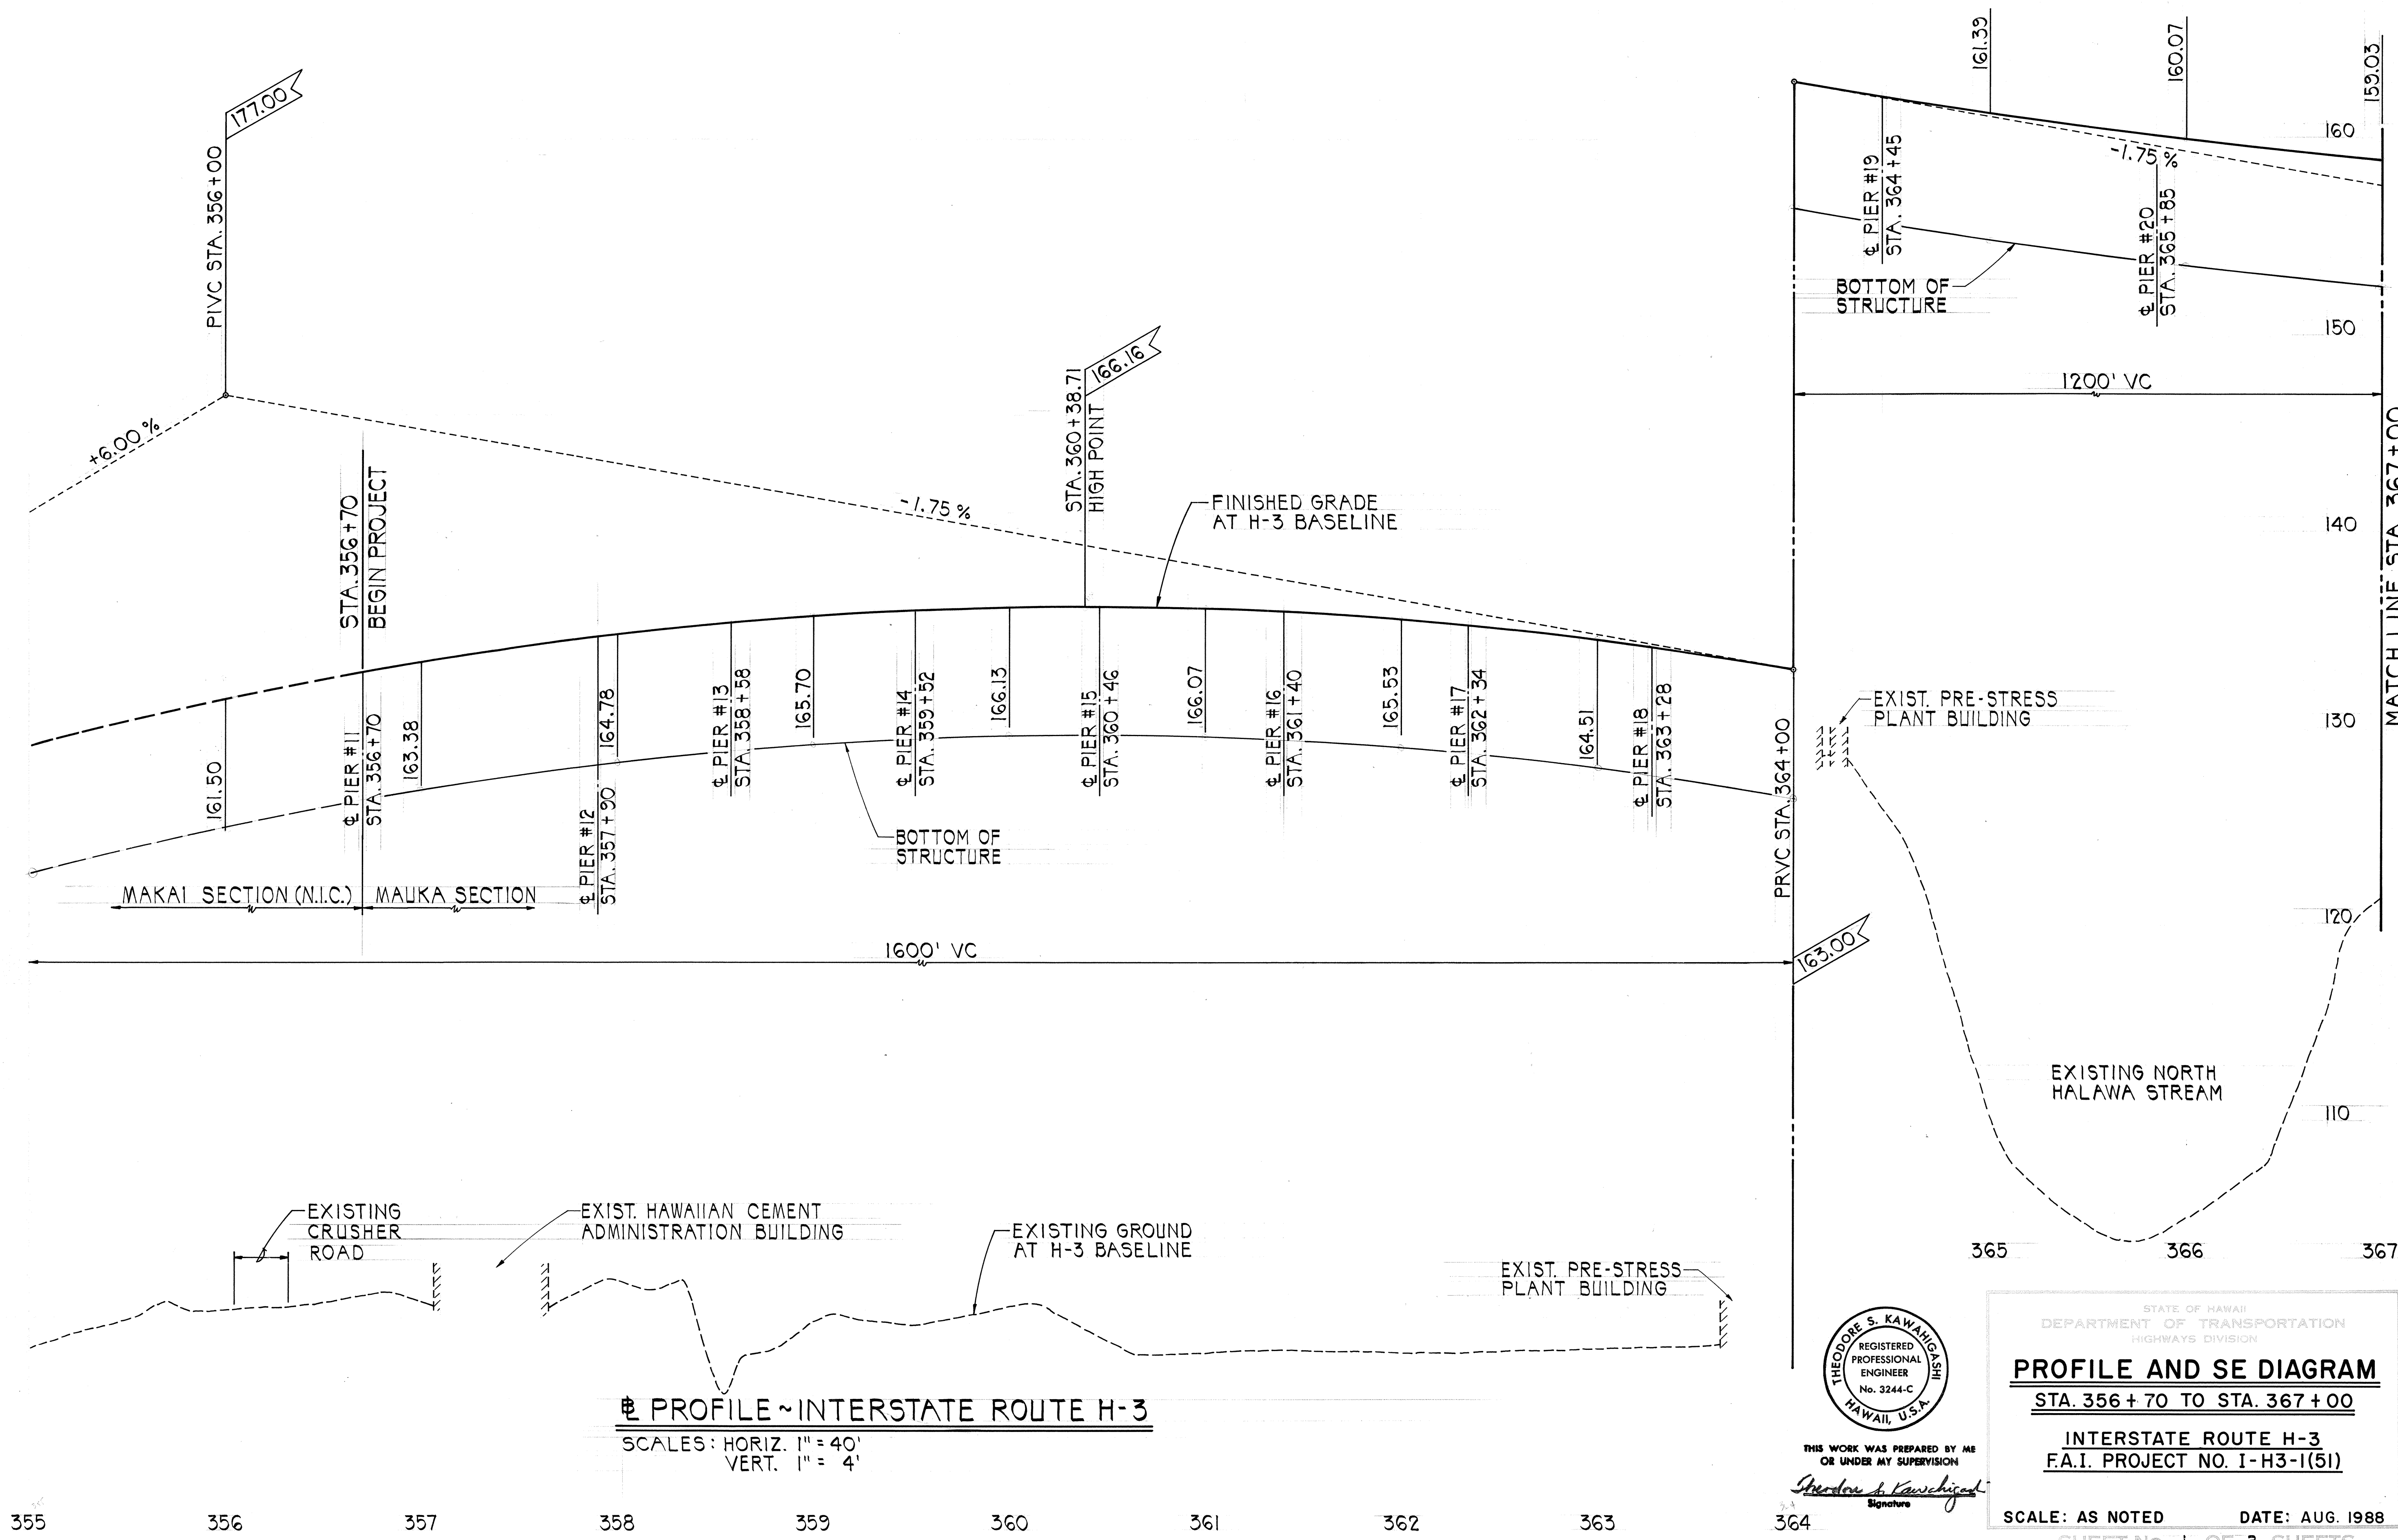

THEODORE S. KAWAHIGASHI
REGISTERED
PROFESSIONAL
ENGINEER
No. 3244-C
HAWAII, U.S.A.

THIS WORK WAS PREPARED BY
OR UNDER MY SUPERVISION

Theodore S. Kawahigashi
Signature

STATE OF HAWAII
DEPARTMENT OF TRANSPORTATION
HIGHWAYS DIVISION

PROFILE AND SE DIAGRAM


STA. 356 + 70 TO STA. 367 + 00

INTERSTATE ROUTE H-3
F.A.I. PROJECT NO. I-H3-1(51)

SCALE: AS NOTED **DATE: AUG. 1988**

SHEET NO. 1 OF 3 SHEETS

FED. ROAD DIST. NO.	STATE	FED. AID PROJ. NO.	FISCAL YEAR	SHEET NO.	TOTAL SHEETS
HAWAII	HAW.	I-H3-1(51)	1988	10	106

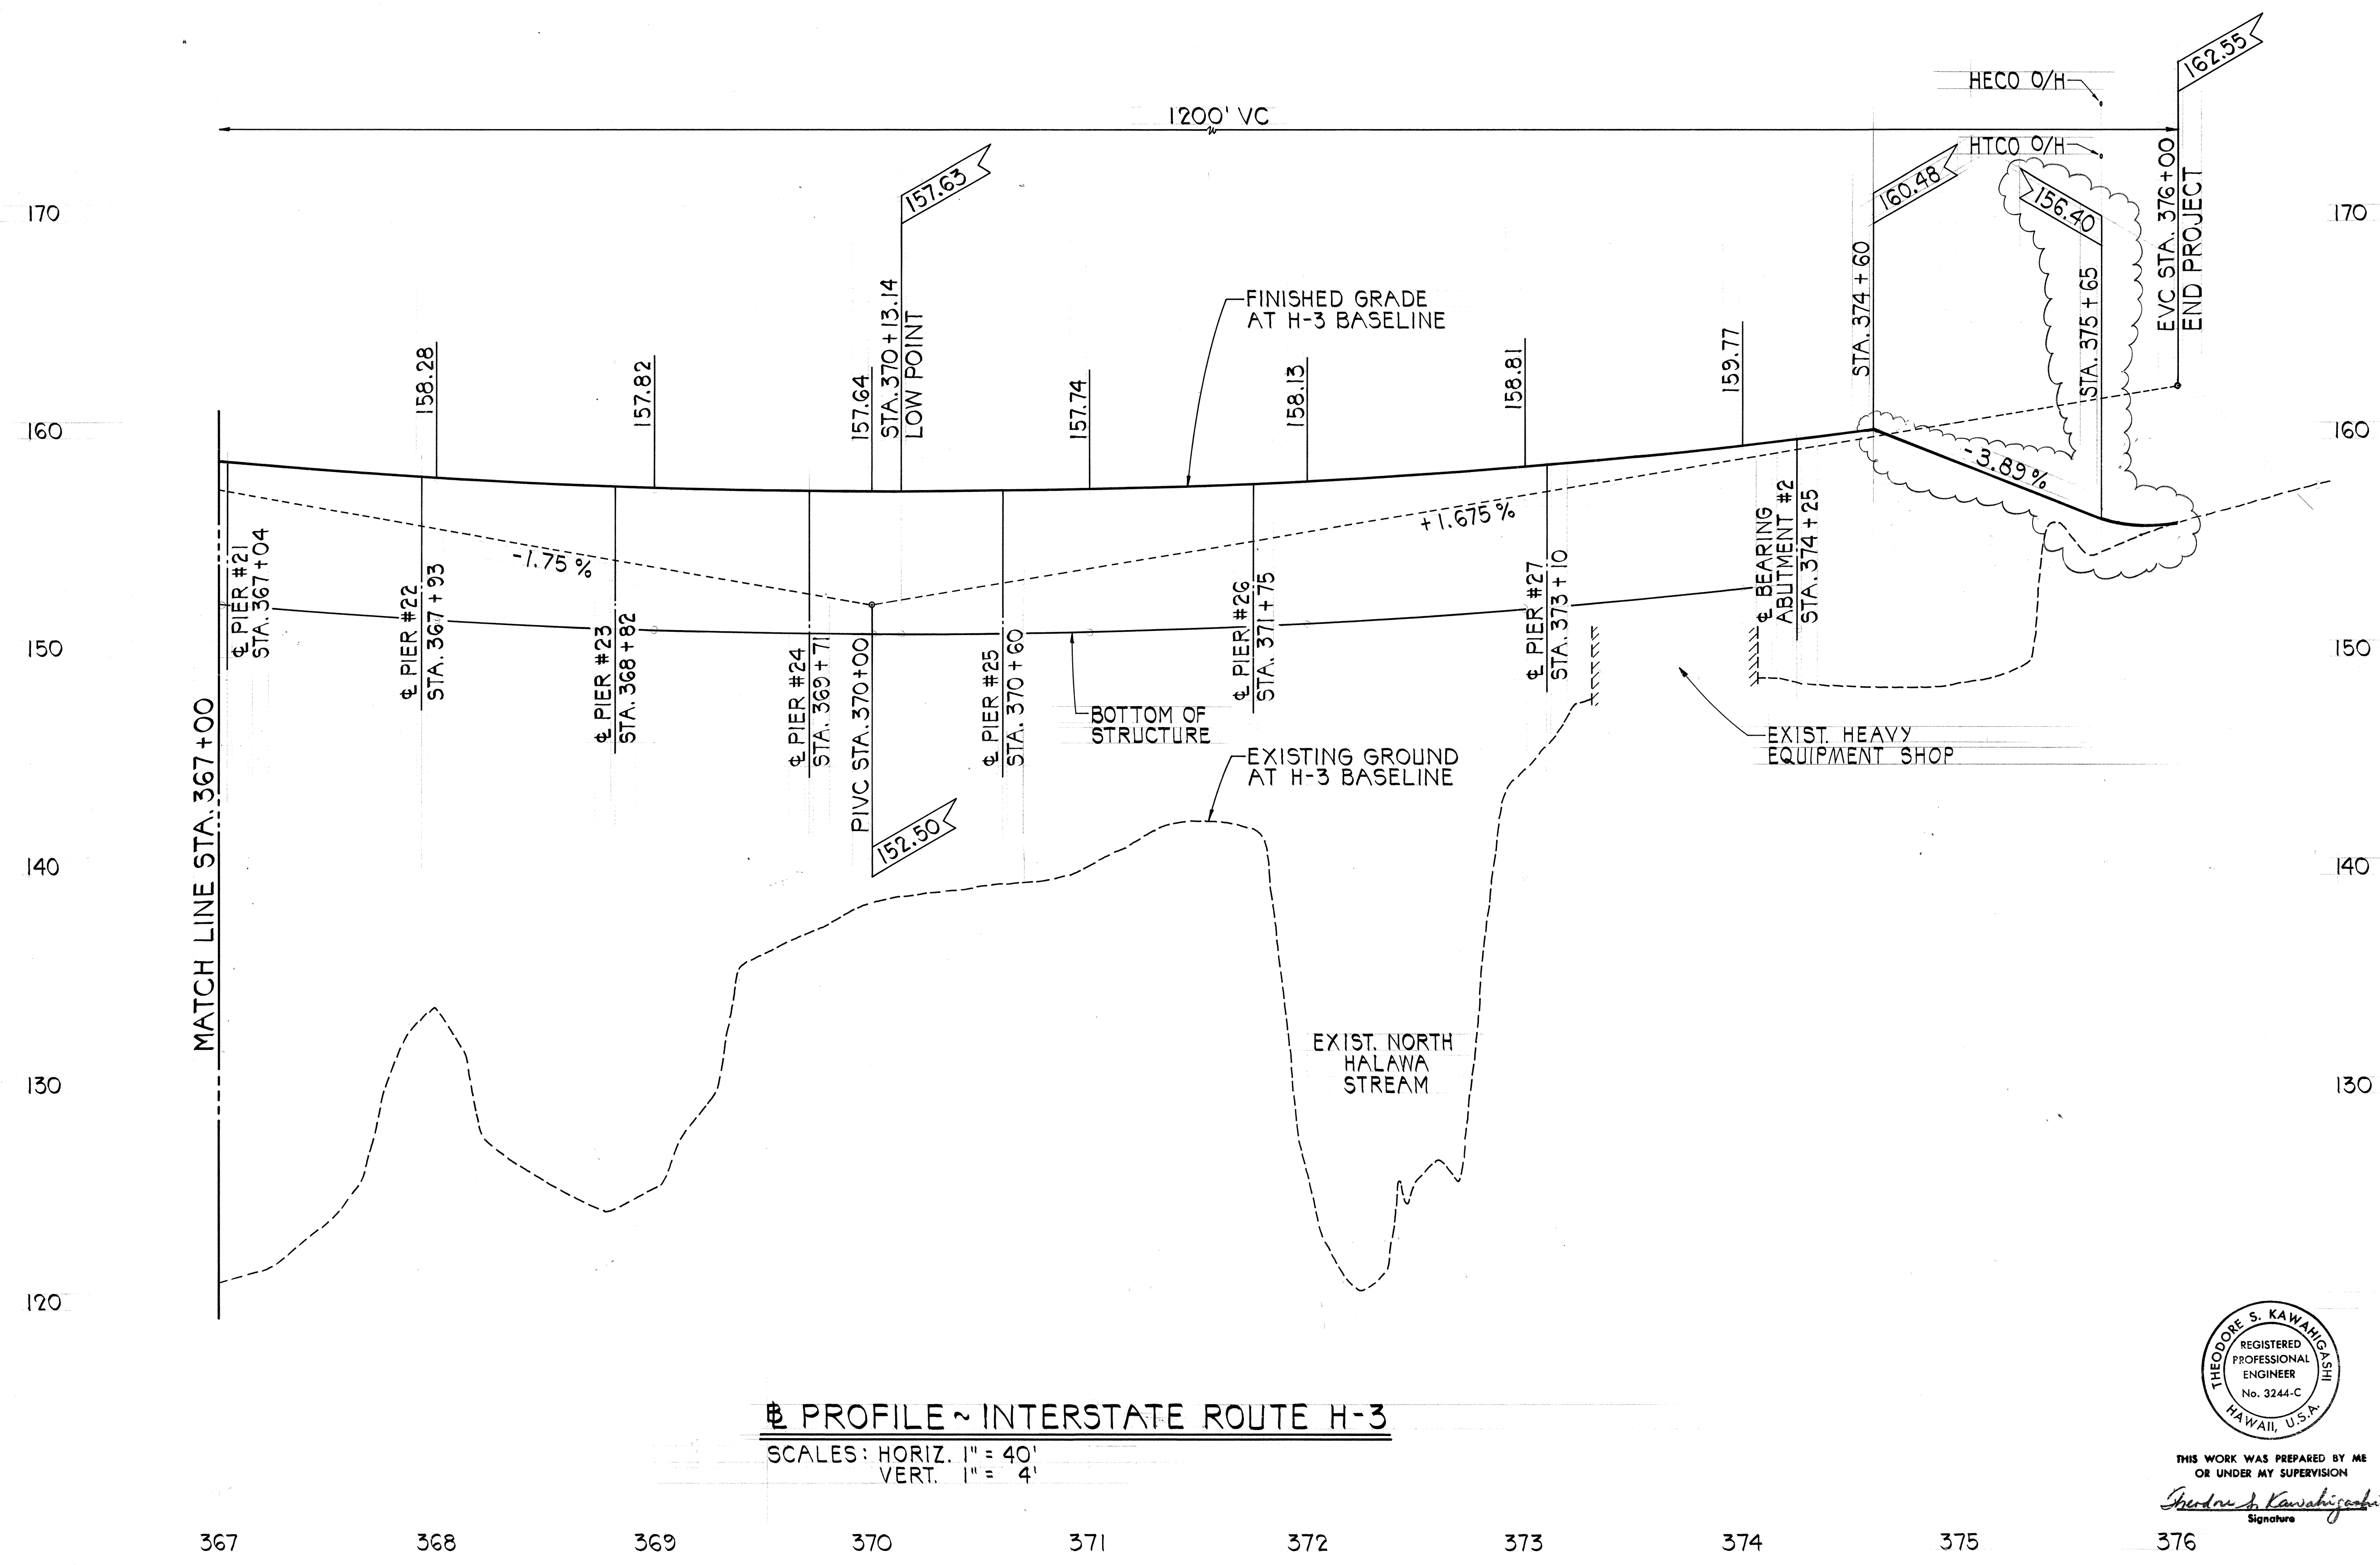


ORIGINAL PLAN	SURVEY PLOTTED BY	DATE
NOTE BOOK	DRAWN BY	
	DESIGNED BY	
	CHECKED BY	

PROFILE ~ INTERSTATE ROUTE H-3
SCALES: HORIZ. 1" = 40'
VERT. 1" = 4'

THEODORE S. KAWAHIGASHI
REGISTERED PROFESSIONAL ENGINEER
No. 3244-C
HAWAII, U.S.A.
THIS WORK WAS PREPARED BY ME
OR UNDER MY SUPERVISION
Theodore S. Kawahigashi
Signature

10/18/89	REVISED PROFILE
DATE	REVISION
STATE OF HAWAII DEPARTMENT OF TRANSPORTATION HIGHWAYS DIVISION	
PROFILE AND SE DIAGRAM STA. 367+00 TO STA. 376+00 INTERSTATE ROUTE H-3 F.A.I. PROJECT NO. I-H3-1(51)	
SCALE: AS NOTED	DATE: AUG. 1988
SHEET NO. 2 OF 3 SHEETS	

FED. ROAD DIST. NO.	STATE	FED. AID PROJ. NO.	FISCAL YEAR	SHEET NO.	TOTAL SHEETS
HAWAII	HAW.	I-H3-1(51)	1988	11	100

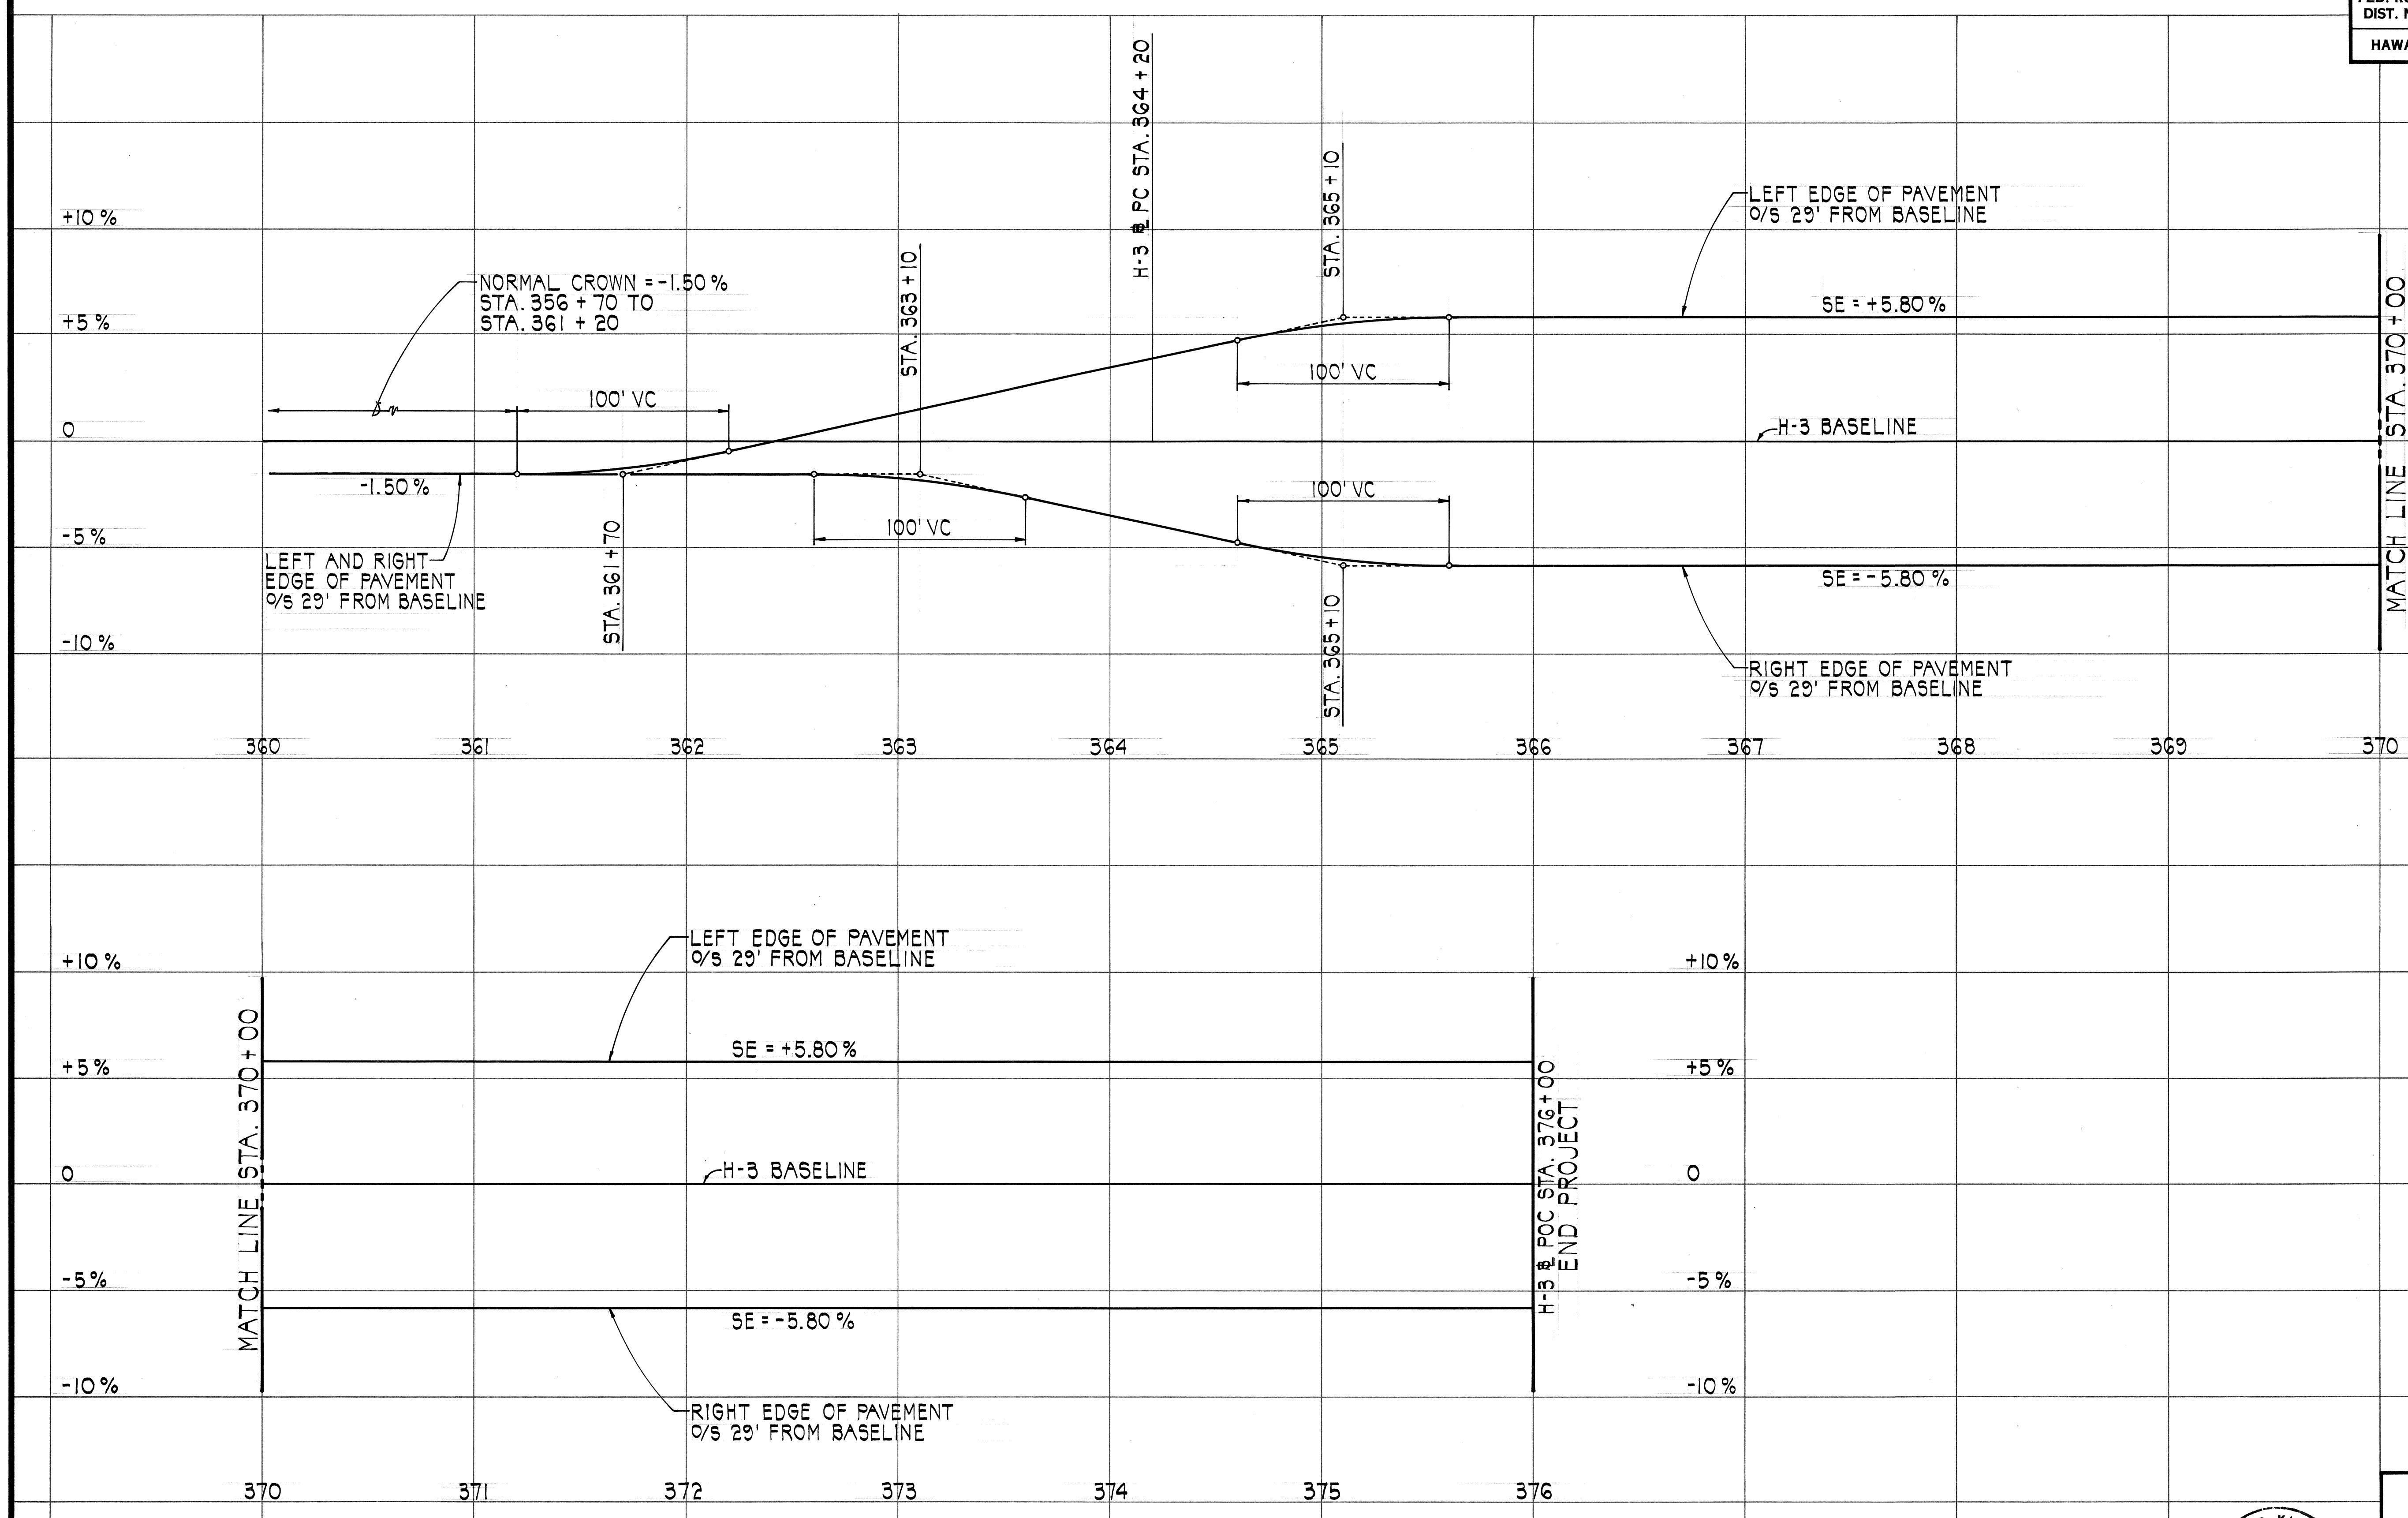

ORIGINAL PLAN	DATE
DESIGNED BY	
TRACED BY	
QUANTITIES BY	
CHECKED BY	

SUPERELEVATION DIAGRAM
INTERSTATE ROUTE H-3
SCALES: HORIZ. 1" = 40'
VERT. 1" = 4%

THEODORE S. KAWAHIGAKI
REGISTERED PROFESSIONAL ENGINEER
No. 3244-C
HAWAII, U.S.A.
THIS WORK WAS PREPARED BY ME
OR UNDER MY SUPERVISION
Theodore S. Kawahigaki
Signature

STATE OF HAWAII
DEPARTMENT OF TRANSPORTATION
HIGHWAYS DIVISION

PROFILE AND SE DIAGRAM

INTERSTATE ROUTE H-3
F.A.I. PROJECT NO. I-H3-1(51)

SCALE: AS NOTED DATE: AUG. 1988
SHEET No. 3 OF 3 SHEETS