

ORIGINAL PLAN	NO.	DATE	SURVEY PLOTTED BY	CHECKED BY	DESIGNED BY	QUANTITIES BY	CHECKED BY


1. GENERAL SPECIFICATIONS: HAWAII DEPARTMENT OF TRANSPORTATION, STANDARD SPECIFICATIONS FOR ROAD AND BRIDGE CONSTRUCTION, 1985, TOGETHER WITH SPECIAL PROVISIONS PREPARED FOR THIS CONTRACT.
2. DESIGN SPECIFICATIONS: A.A.S.H.T.O. 1983 STANDARD SPECIFICATIONS FOR HIGHWAYS BRIDGES AND ITS SUBSEQUENT INTERIM SPECIFICATIONS, GUIDE SPECIFICATION FOR SEISMIC DESIGN FOR HIGHWAY BRIDGES 1983.
3. LOADS:
(A) DEAD LOAD: AN ALLOWANCE OF 20 P.S.F. FOR FUTURF WEARING SURFACE OF ASPHALT CONCRETE HAS BEEN PROVIDED FOR IN THE DESIGN.
(B) LIVE LOAD: HS20-44 OR INTERSTATE LOADING.
4. MATERIALS:
(A) ALL CONCRETE SHALL BE CLASS A UNLESS OTHERWISE NOTED. SEE NOTES ON APPROPRIATE SHEETS.
(B) ALL REINFORCING STEEL SHALL BE A.S.T.M. A615, GRADE 40 UNLESS OTHERWISE NOTED.
(C) ALL STRUCTURAL STEEL SHALL BE A.S.T.M. A-36 HOT DIP GALVANIZED AFTER FABRICATION, UNLESS OTHERWISE NOTED.
(D) ALL ANCHOR BOLTS, WASHERS AND NUTS SHALL BE A.S.T.M. A-307, HOT DIP GALVANIZED AFTER FABRI-
CATION, UNLESS OTHERWISE SPECIFIED.
(E) FOR MATERIALS OF PRESTRESSED CONCRETE BEAMS & PILES SEE APPLICABLE PRESTRESSED CONCRETE NOTES.
5. DESIGN STRESSES: SHALL FOLLOW A.A.S.H.T.O. STANDARD SPECIFICATIONS FOR HIGHWAY BRIDGES IN ADDITION TO THOSE LISTED BELOW.
- | CONCRETE | CLASS A | CLASS BD | ALL OTHERS |
|----------------|--------------|--------------|---|
| | | | (EXCEPT PRESTRESSED CONCRETE BEAMS AND UNLESS OTHERWISE NOTED ON THE PLANS) |
| F'C | 3,000 P.S.I. | 3,750 P.S.I. | 5,000 P.S.I. |
| F _c | 1,200 P.S.I. | 1,200 P.S.I. | 2,000 P.S.I. |
| N | 9 | 9 | 7 |
- FOR PRESTRESSED CONCRETE BEAMS, SEE PRESTRESSED CONCRETE NOTES.
6. REINFORCEMENT:
(A) THE MINIMUM COVERING MEASURED FROM THE SURFACE OF THE CONCRETE TO THE FACE OF ANY REINFORCING BARS SHALL BE AS FOLLOWS:
(1) DECK SLABS (FOR BOX GIRDERS, T-BEAMS, PRESTRESSED BEAMS)
A. TOP BARS = 1-1/2"
B. BOTTOM BARS = 1-1/4"
(2) BOX GIRDERS
A. 1-1/4" TO STIRRUP FROM OUTSIDE FACES
B. 1" TO STIRRUP FROM INSIDE FACES.
C. INSIDE FACE BOTTOM SLAB AND WALLS = 1-1/2"
(3) FOR PRESTRESSED CONCRETE BEAMS SEE PRESTRESSED CONCRETE BEAM DETAILS.
(4) ABUTMENTS, PIERS AND RETAINING WALLS = 2".
(5) COLUMNS = 2" TO TIES.
(6) CONCRETE CAST AGAINST AND PERMANENTLY EXPOSED TO EARTH = 3".
(B) REINFORCING BARS SHALL BE DETAILED IN ACCORDANCE WITH A.C.I. MANUAL OF STANDARD PRACTICE FOR DETAILING REINFORCED CONCRETE HIGHWAY STRUCTURES UNLESS OTHERWISE NOTED.
(C) MINIMUM CLEAR SPACING BETWEEN PARALLEL BARS SHALL BE 1-1/2 TIMES THE DIAMETER OF BARS (FOR NON BUNDLED BARS), BUT IN NO CASE SHALL THE CLEAR DISTANCE BETWEEN THE BARS BE LESS THAN 1-1/2 TIMES THE MAXIMUM SIZE OF THE COARSE AGGREGATE.
(D) ALL DIMENSIONS RELATING TO REINFORCING BARS (E.G. SPACING OF BARS, ETC.,) ARE TO CENTERS OF BARS UNLESS OTHERWISE NOTED.
(E) REINFORCING BARS SHALL BE SECURELY TIED AT ALL INTERSECTIONS AND LAP SPLICES EXCEPT WHERE THE SPACING OF INTERSECTIONS IS LESS THAN ONE FOOT IN EACH DIRECTION, IN WHICH CASE ALTERNATE INTERSECTIONS SHALL BE TIED.
(F) VERTICAL COLUMN BARS SHALL BE ARRANGED IN SUCH A MANNER AS TO AVOID INTERFERENCE WITH PIER CAP BARS ABOVE AS DIRECTED BY THE ENGINEER.

7. GIRDER BEARINGS:
(A) CONCRETE SEAT FOR GIRDER: BEARING AREA DEVIATION FROM PLANE SHALL NOT EXCEED 1/16-INCH. THE SEAT SHALL BE CONSTRUCTED HIGHER THAN SHOWN ON PLANS AND SHALL THEN BE GROUND DOWN TO THE REQUIRED ELEVATION. SEAT SHALL BE MONOLITHIC WITH STRUCTURE.
(B) ELASTOMERIC PADS: BOTTOM OF BRIDGE BEARING PADS SHALL BE SECURED TO THE CONCRETE SEATS, TO PREVENT DISPLACEMENT, WITH ADHESIVES APPROVED BY THE ENGINEER.
8. CONSTRUCTION METHODS:
(A) SEE STANDARD SPECIFICATIONS AND SPECIAL PROVISIONS.
(B) ~~IN~~ GENERAL TOP OF CONCRETE DECK SLAB SHALL BE CONSTRUCTED TO FOLLOW THE ROADWAY VERTICAL AND HORIZONTAL CURVES.
(C) SPREAD FOOTINGS SHALL BE EXCAVATED AND POURED NEAT AGAINST UNDISTURBED GROUND. IN CASE OF OVER EXCAVATION, SPACE BETWEEN FOOTING AND GROUND SHALL BE FILLED WITH CONCRETE AT THE CONTRACTOR'S EXPENSE AND AS DIRECTED BY THE ENGINEER. THE MINIMUM QUALITY OF THE FILL CONCRETE SHALL BE CLASS D.
(D) EXCEPT AS OTHERWISE NOTED, ALL VERTICAL DIMENSIONS ARE MEASURED PLUMB.
9. GENERAL:
(A) ALL ITEMS NOTED INCIDENTAL WILL NOT BE PAID FOR SEPARATELY.
(B) THE CONTRACTOR SHALL VERIFY THE LOCATION OF ALL UTILITY LINES AND NOTIFY THE RESPECTIVE OWNERS BEFORE COMMENCING THE WORK OF EXCAVATION OR THE DRIVING OF PILES, INCLUDING ANY TEMPORARY PILING OR SHEETING.
(C) FOR CONCRETE FINISH SEE STANDARD SPECIFICATIONS.
(D) CONSTRUCTION JOINTS MAY BE RELOCATED OR ADDITIONAL ONES ADDED SUBJECT TO THE APPROVAL OF THE ENGINEER.
(E) UNLESS OTHERWISE NOTED, ALL EXPOSED CONCRETE EDGES SHALL BE CHAMFERED 3/4" X 3/4".
(F) STANDARD DETAIL DRAWINGS REFER TO ALL STRUCTURES IN GENERAL, EXCEPT FOR MODIFICATIONS AS MAY BE REQUIRED FOR SPECIAL CONDITIONS. FOR SUCH MODIFICATIONS REFER TO THE CORRESPONDING DETAILED DRAWINGS.
(G) FOR ELECTRICAL CONDUIT LOCATION DETAILS SEE ELECTRICAL DRAWINGS.
10. FOUNDATION:
(A) DESIGN LOAD FOR PILES = 100 TONS TYPICAL, 50 TONS AT PIERS 12, 13 & 14
(B) ALLOWABLE HORIZONTAL LOAD ON PILES = 7 KIPS.
(C) ALLOWABLE SOIL BEARING PRESSURE AT SPREAD FOOTINGS = 5000 P.S.F. (AT PIER #11)
(D) FOR BORING LOGS AND THEIR LOCATIONS SEE SHEET NOS. P1 THRU P4.
(E) THE PILE TIP ELEVATIONS SHOWN ON THE PLANS ARE BASED ON BORING DATA.
(F) IN DRIVING EACH GROUP OF PILES, THE CONTRACTOR SHALL START FROM CENTER OF THE GROUP AND PROCEED OUTWARDS, EXCEPT FOR TEST PILES AND LOAD TEST PILES.
(G) THE CONTRACTOR SHALL VERIFY THE TYPE OF SURFACE SOIL BEFORE STARTING TO DRIVE ANY PILE.
11. REFERENCES:
(A) FOR PRESTRESSED CONCRETE NOTES, SEE DRAWINGS FOR PRESTRESSED BEAM DETAILS.
(B) FOR ADDITIONAL PILE NOTES, SEE DRAWINGS NO. T3 THRU T6.


12. SYMBOLS AND ABBREVIATIONS:

ALT.	ALTERNATE
AZ.	AZIMUTH
(B), B, BOT.	BOTTOM
BAL.	BALANCE
B.F.	BOTH FACES
⊕	BASELINE
BM.	BEAM
BRG.	BEARING
BTWN.	BETWEEN
C.I.P.	CAST IRON PIPE
C.J.	CONSTRUCTION JOINT
⊕	CENTERLINE
CL., CLR.	CLEAR
CONT.	CONTINUOUS
DIA., ∅	DIAMETER
(E), (EXP.)	EXPANSION
E.F.	EACH FACE
EL., ELEV.	ELEVATION
E.P.	EDGE OF PAVEMENT
EQ.	EQUAL
E.W.	EACH WAY
F.F.	FAR FACE
FIN. GR.	FINISHED GRADE
(H)	HINGE

H.W.L.	HIGH WATER LINE
I.F.	INSIDE FACE
INV.	INVERT
JT.	JOINT
MIN.	MINIMUM
N.F.	NEAR FACE
N.I.C.	NOT IN CONTRACT
N.T.S.	NOT TO SCALE
O.C.	ON CENTERS
O/S	OFFSET
⊕	PLATE
R	RADIUS
REINF.	REINFORCING
SHT.	SHEET
SPCG., SP.	SPACING
STA.	STATION
STIRR.	STIRRUP
STR.	STRAIGHT OR STRINGER
SYMM.	SYMMETRY, SYMMETRICAL
(T), T.	TOP
T.O.D.	TOP OF DECK
TYP.	TYPICAL
W.P.	WORKING POINT, WATERPROOFING
@	AT
N	MODULAR RATIO

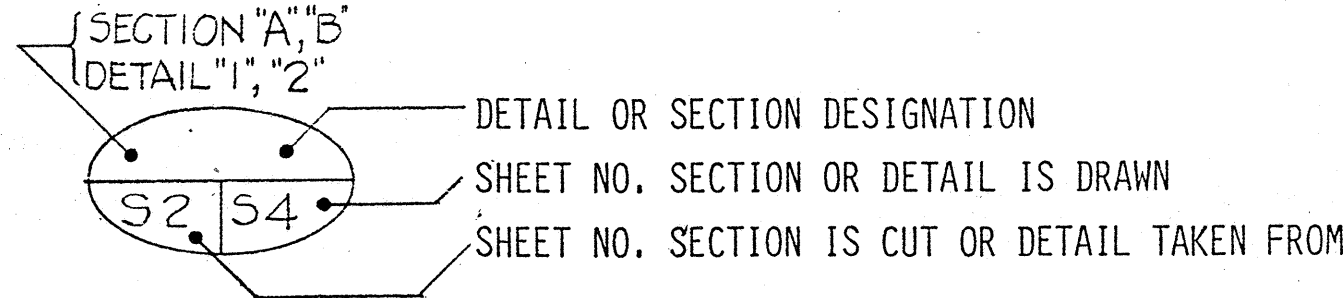

SSFM ENGINEERS INC.
501 Sumner St., #502
Honolulu, Hawaii 96817

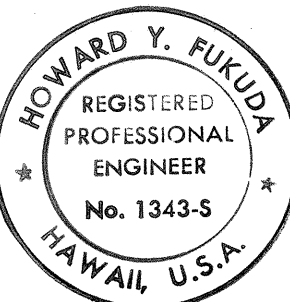

This work was prepared by
me or under my supervision.

Howard Y. Fukuda

STATE OF HAWAII
DEPARTMENT OF TRANSPORTATION
HIGHWAYS DIVISION


GENERAL NOTES

INTERSTATE ROUTE H-3
F.A.I. PROJ. NO. I-H3-I(51)


DATE:

SHEET No. 71 OF 21 SHEETS

FED. ROAD DIST. NO.	STATE	FED. AID PROJ. NO.	FISCAL YEAR	SHEET NO.	TOTAL SHEETS
HAWAII	HAW.	I-H3-1(51)	1989	87	106

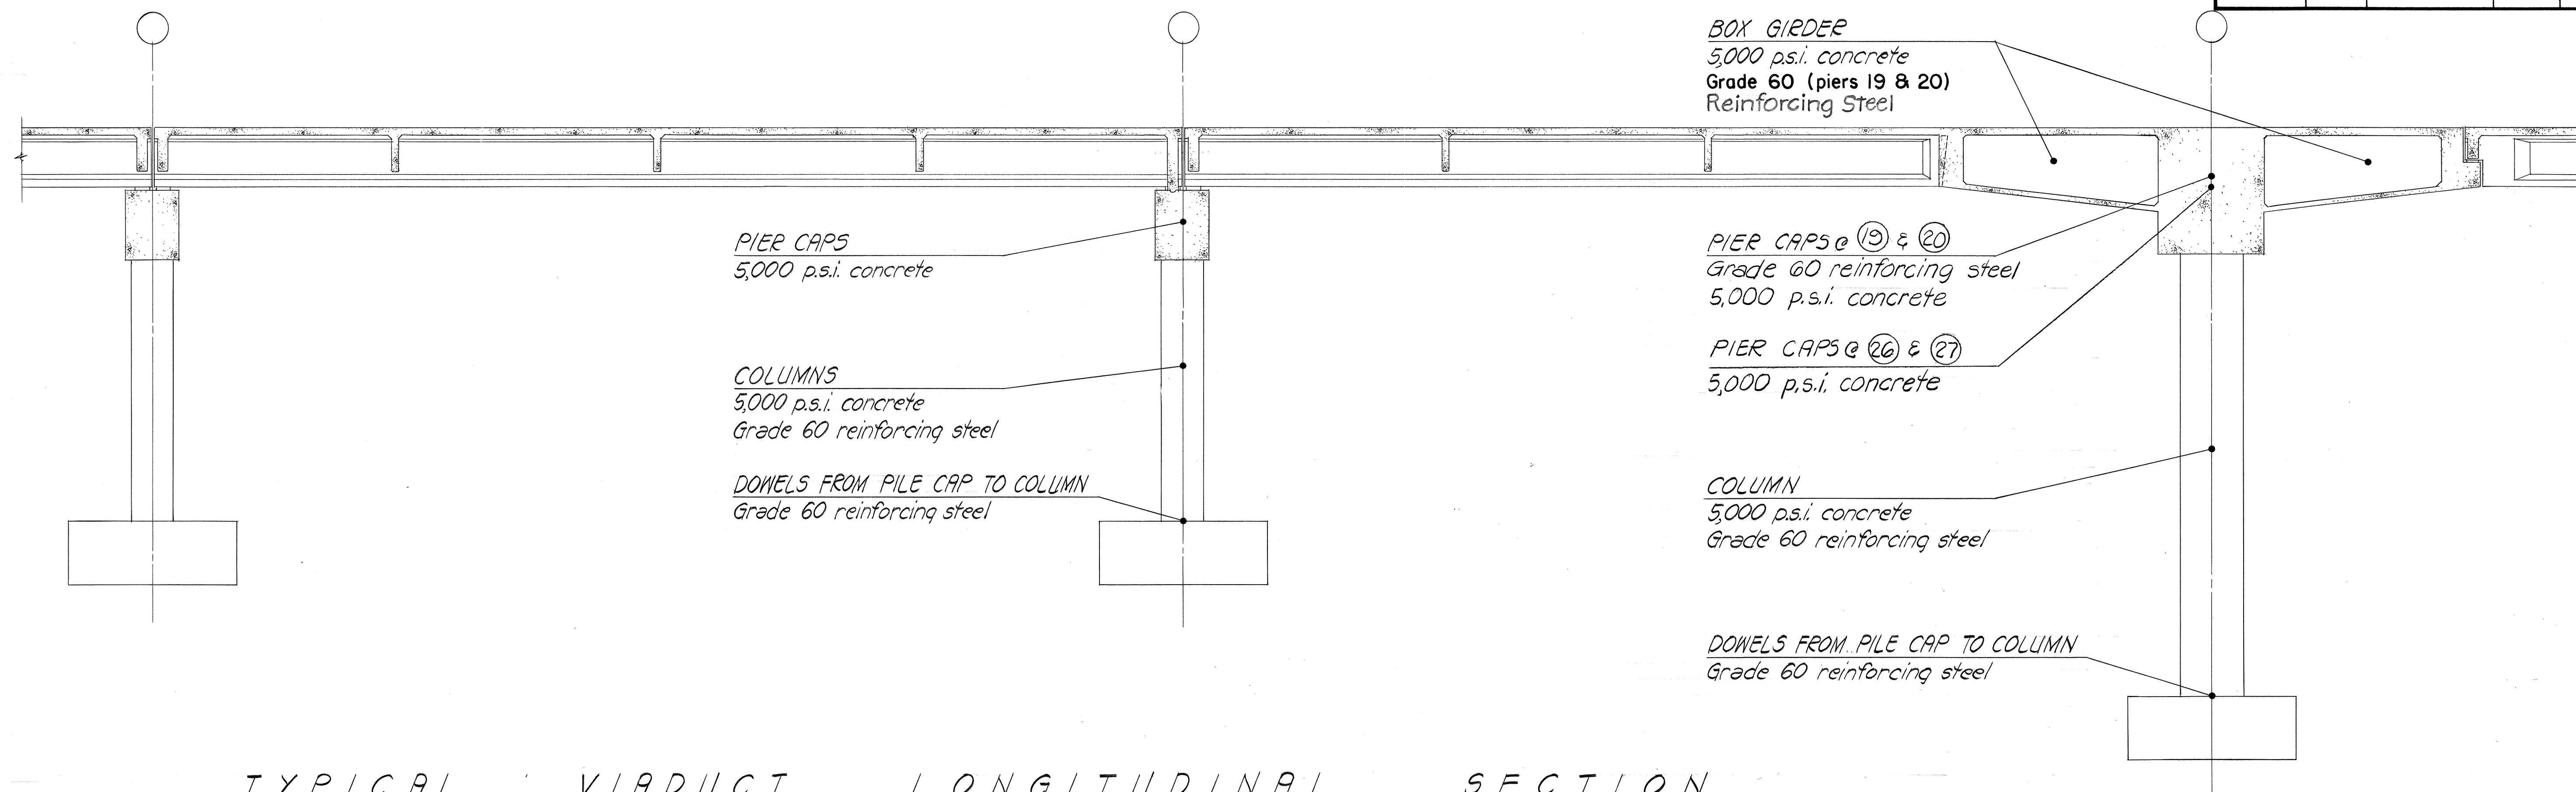


TYPICAL VIADUCT LONGITUDINAL SECTION
 Not to scale (Showing cast-in-place concrete other than Classes A & BD & grade of reinforcing steel other than Grade 40.)

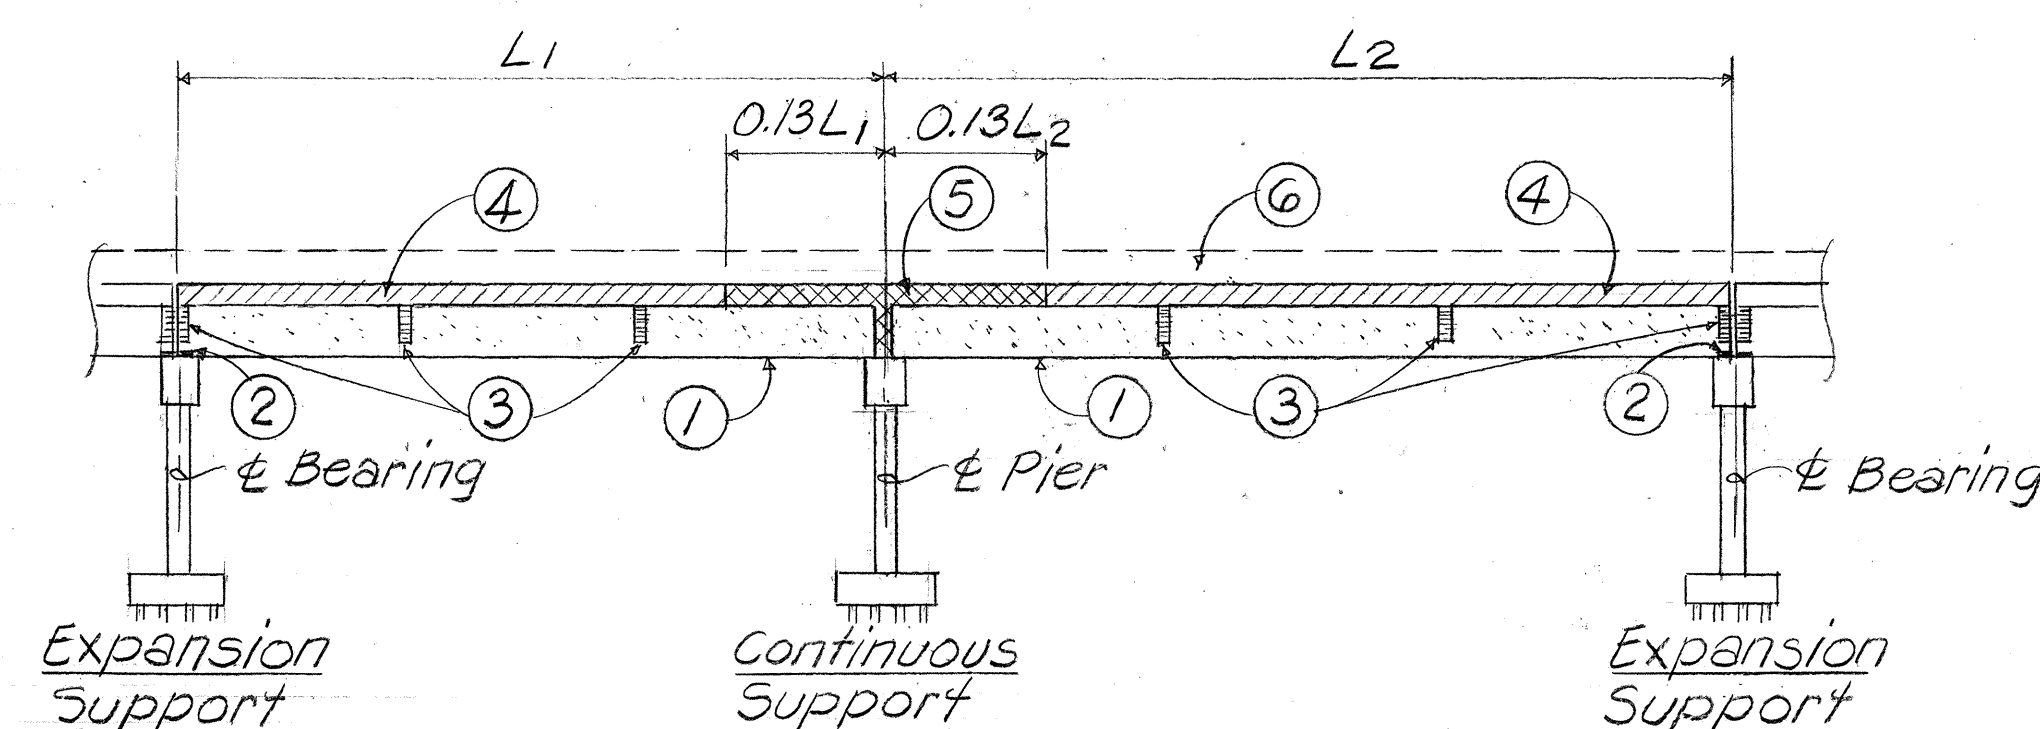


SEQUENCE OF CONSTRUCTION FOR TWO SPAN CONTINUOUS PORTION OF VIADUCT

- 1 After constructing piers, install prestress girders. Girders to be supported at piers only.
- 2 Pour creep blocks at expansion supports.
- 3 Pour diaphragms (Beams "B" & "D") except at continuous support and cure for 7 days minimum.
- 4 Pour deck slab, and cure for 14 days minimum.
- 5 Pour beam "A" (diaphragm at continuous pier), balance of deck slab, and cure for 21 days minimum.
- 6 Pour railings.

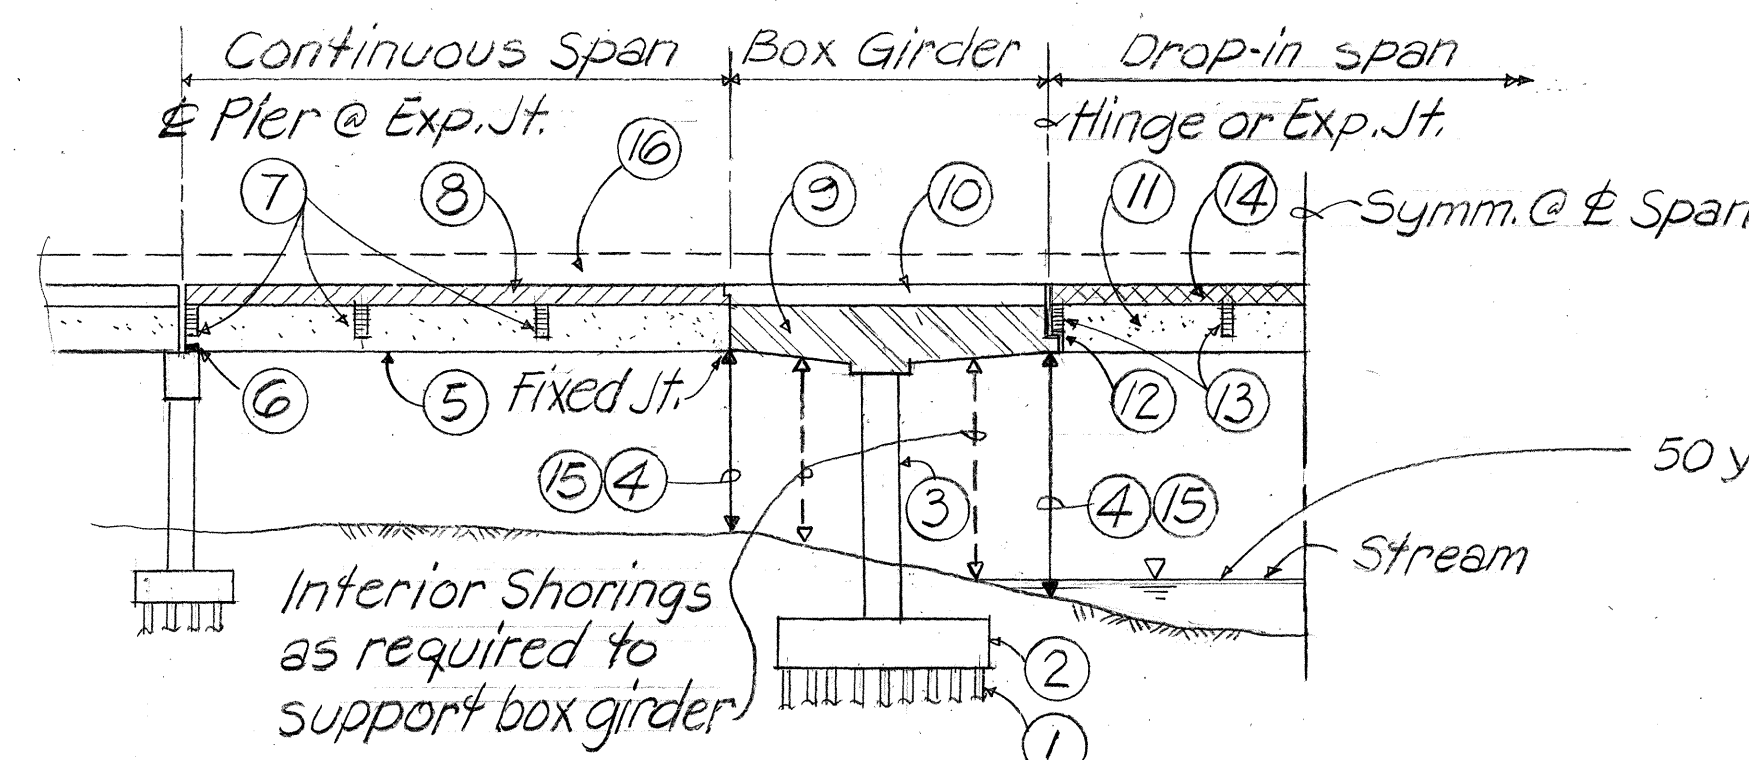


SEQUENCE OF CONSTRUCTION FOR STREAM CROSSING PORTION OF VIADUCT

- 1 Drive piles
- 2 Pour pile cap
- 3 Pour columns
- 4 Install formworks and shorings for box girder
 - a Shorings at ends of box girder shall be designed to safely support a line load of 32.5 kips per foot at each end.
 - b Shorings in stream shall be safeguarded against undermining or destruction from stream action. Shorings for pier #20 shall spaced to allow for a minimum horizontal clearance of 25 feet within the 50 year High Water Line.
- 5 Install prestressed girders for exterior continuous spans. Support girders at pier and at box girder shorings only.
- 6 Pour creep block at expansion supports of continuous span
- 7 Pour diaphragms (beams "B" & "D") and cure for 7 days minimum.
- 8 Pour deck slab for continuous spans and cure for 7 days minimum.
- 9 Pour box girder pier cap, bottom slab and webs.
- 10 Pour top slab of box girder and cure for 7 days minimum.
- 11 Install prestressed girders for drop-in span.
- 12 Pour creep block at expansion support of drop-in span.
- 13 Pour diaphragms "D", "E" & "F" and cure for 7 days minimum.
- 14 Pour deck slab for drop-in span and cure for 21 days minimum.
- 15 Remove all shorings simultaneously.
- 16 Construct concrete railings.

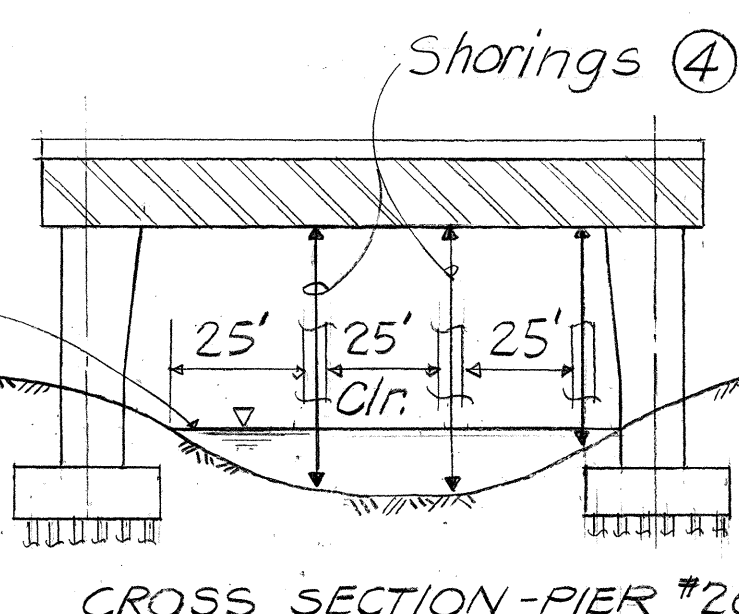

CROSS SECTION - PIER #20

SSFH Engineers, Inc.
 Consulting Structural Engineers
 12131 Kono, Honolulu, HI 96814

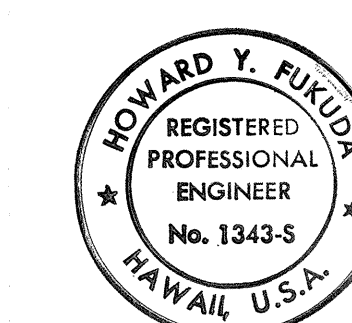

This work was prepared by me or under my supervision.
 Howard Y. Fukuda

STATE OF HAWAII
 DEPARTMENT OF TRANSPORTATION
 HIGHWAYS DIVISION

SPECIAL CONCRETE & REINF. & CONSTRUCTION SEQUENCE

INTERSTATE ROUTE H-3
 F.A.I. PROJ. NO. I-H3-1(51)

SCALE: AS NOTED DATE:


SHEET NO. 72 OF 21 SHEETS

FED. ROAD DIST. NO.	STATE	FED. AID PROJ. NO.	FISCAL YEAR	SHEET NO.	TOTAL SHEETS
HAWAII	HAW.	I-H3-1(51)	1989	88	106

GENERAL NOTES:

- Concrete strengths:
 - Typical pile: 28 day compressive strength $f_c = 6000$ p.s.i. Minimum strength before driving = 5,000 p.s.i.
 - Pile build-up without driving: $f_c = 5,000$ p.s.i. unless noted otherwise.
- Reinforcing steel shall conform to the following ASTM specifications:
 - Bar reinforcement: ASTM A615 Grade 40
 - Spiral reinforcement: ASTM A82
 - Prestressing strand: ASTM A416 Grade 270
- Splice can:
 - Structural steel shall conform to ASTM A36
 - All welding shall meet the requirements of Section 501 of the Standard Specification.
- The minimum working force (after all losses) in the prestressing strands shall be 23.5 kips. per strand.
- Piles accepted by the Engineer shall be of sound concrete. Damaged piles shall be replaced or repaired by the Contractor at his expense as directed by the Engineer.
- Work of cutting off prestress concrete piles or concrete pile build-ups shall be performed in such a manner as to avoid spalling or damaging the pile below cut-off. Damaged portions shall be removed and pile cut-off elevation lowered as required by the Engineer.
- Top of pile at cut-off line shall be prepared as required for construction joints in Section 503 of the Standard Specifications.
- Pile splice shall not be permitted except for pile length in excess of 100 feet unless otherwise approved by Engineer.
- The use of fly ash shall not be permitted in prestressed concrete.

SSFM Engineers, Inc.
Consulting Structural Engineers
1210 W. 4th Ave., Honolulu, HI 96814

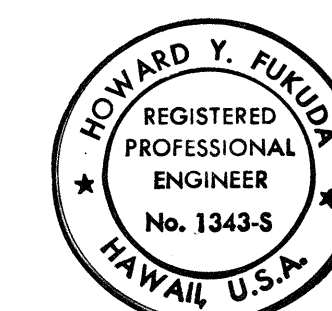

This work was prepared by me or under my supervision.
Howard Y. Fukuda


STATE OF HAWAII
DEPARTMENT OF TRANSPORTATION
HIGHWAYS DIVISION

PILE DETAILS


INTERSTATE ROUTE H-3
F.A.I. PROJ. NO. I-H3-1(51)

SCALE: AS NOTED DATE:

SHEET NO. 73 OF 21 SHEETS

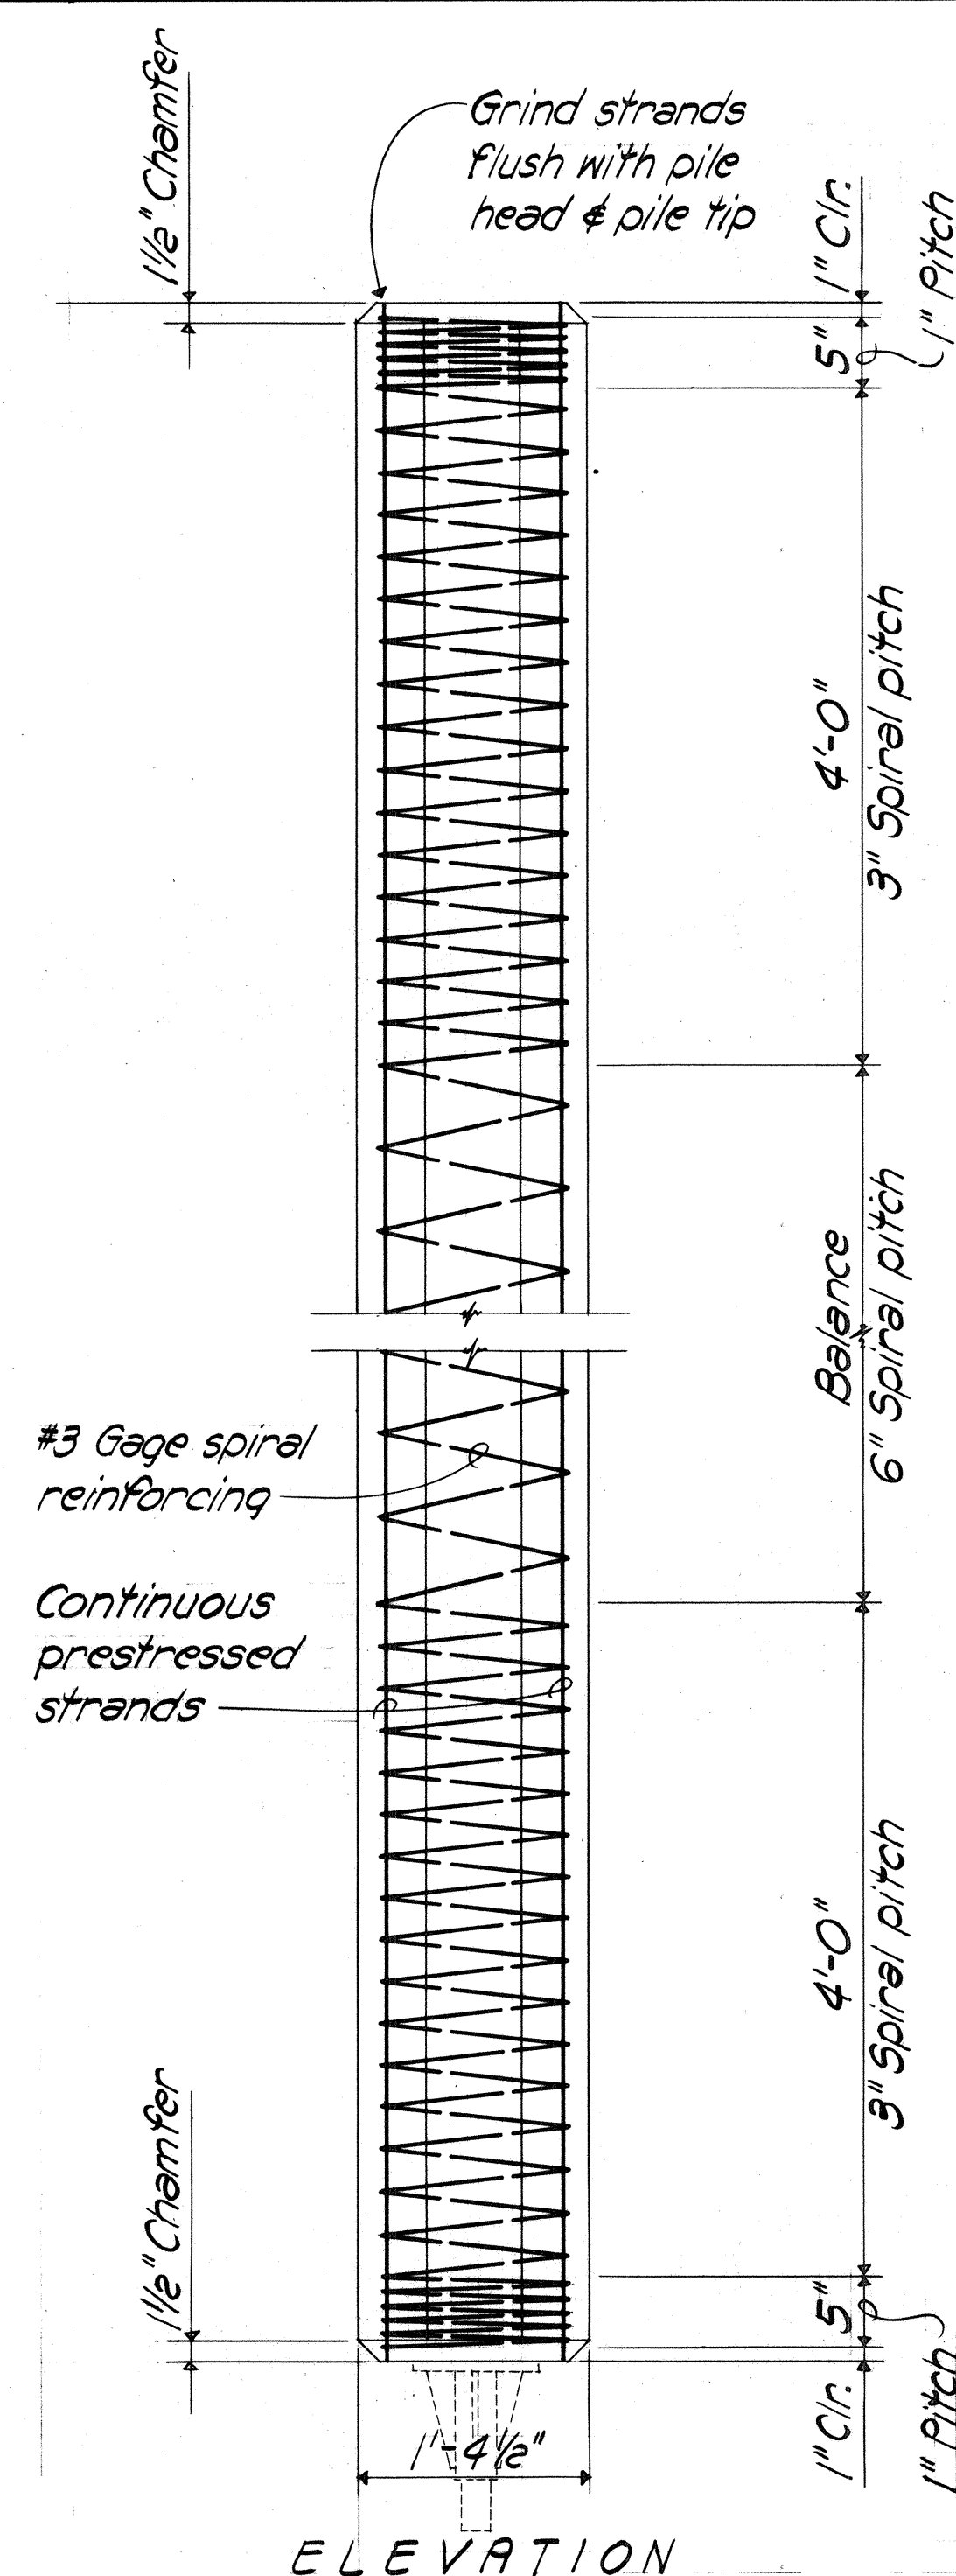


ELEVATION

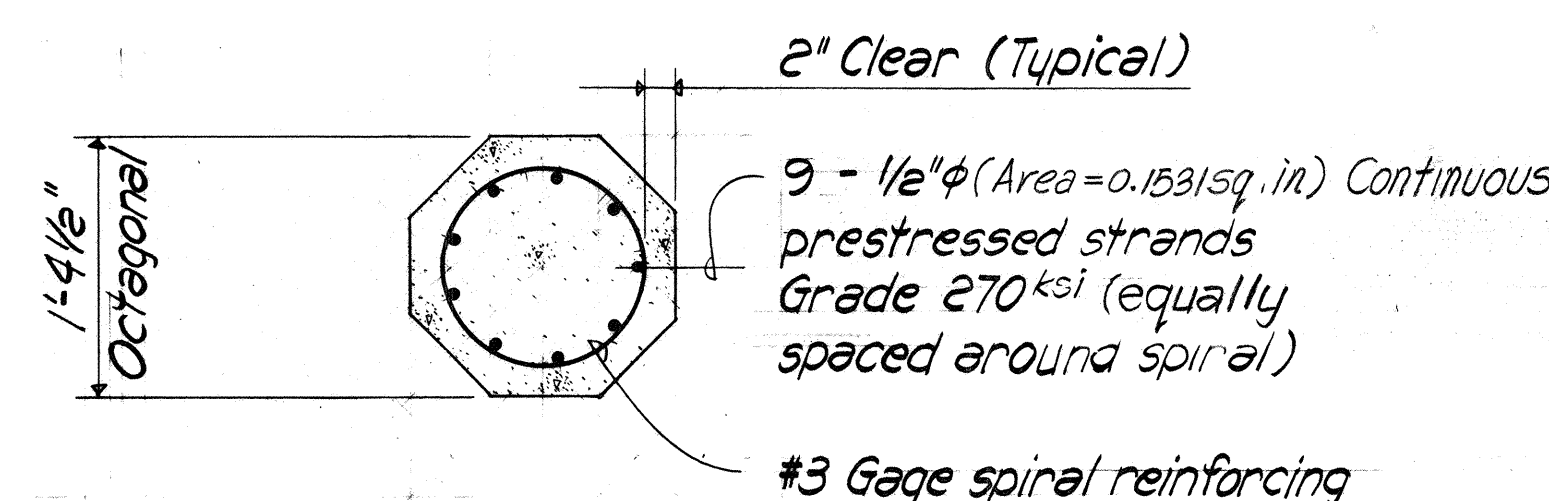

SECTION



TYPICAL PILE DETAIL

Not to scale

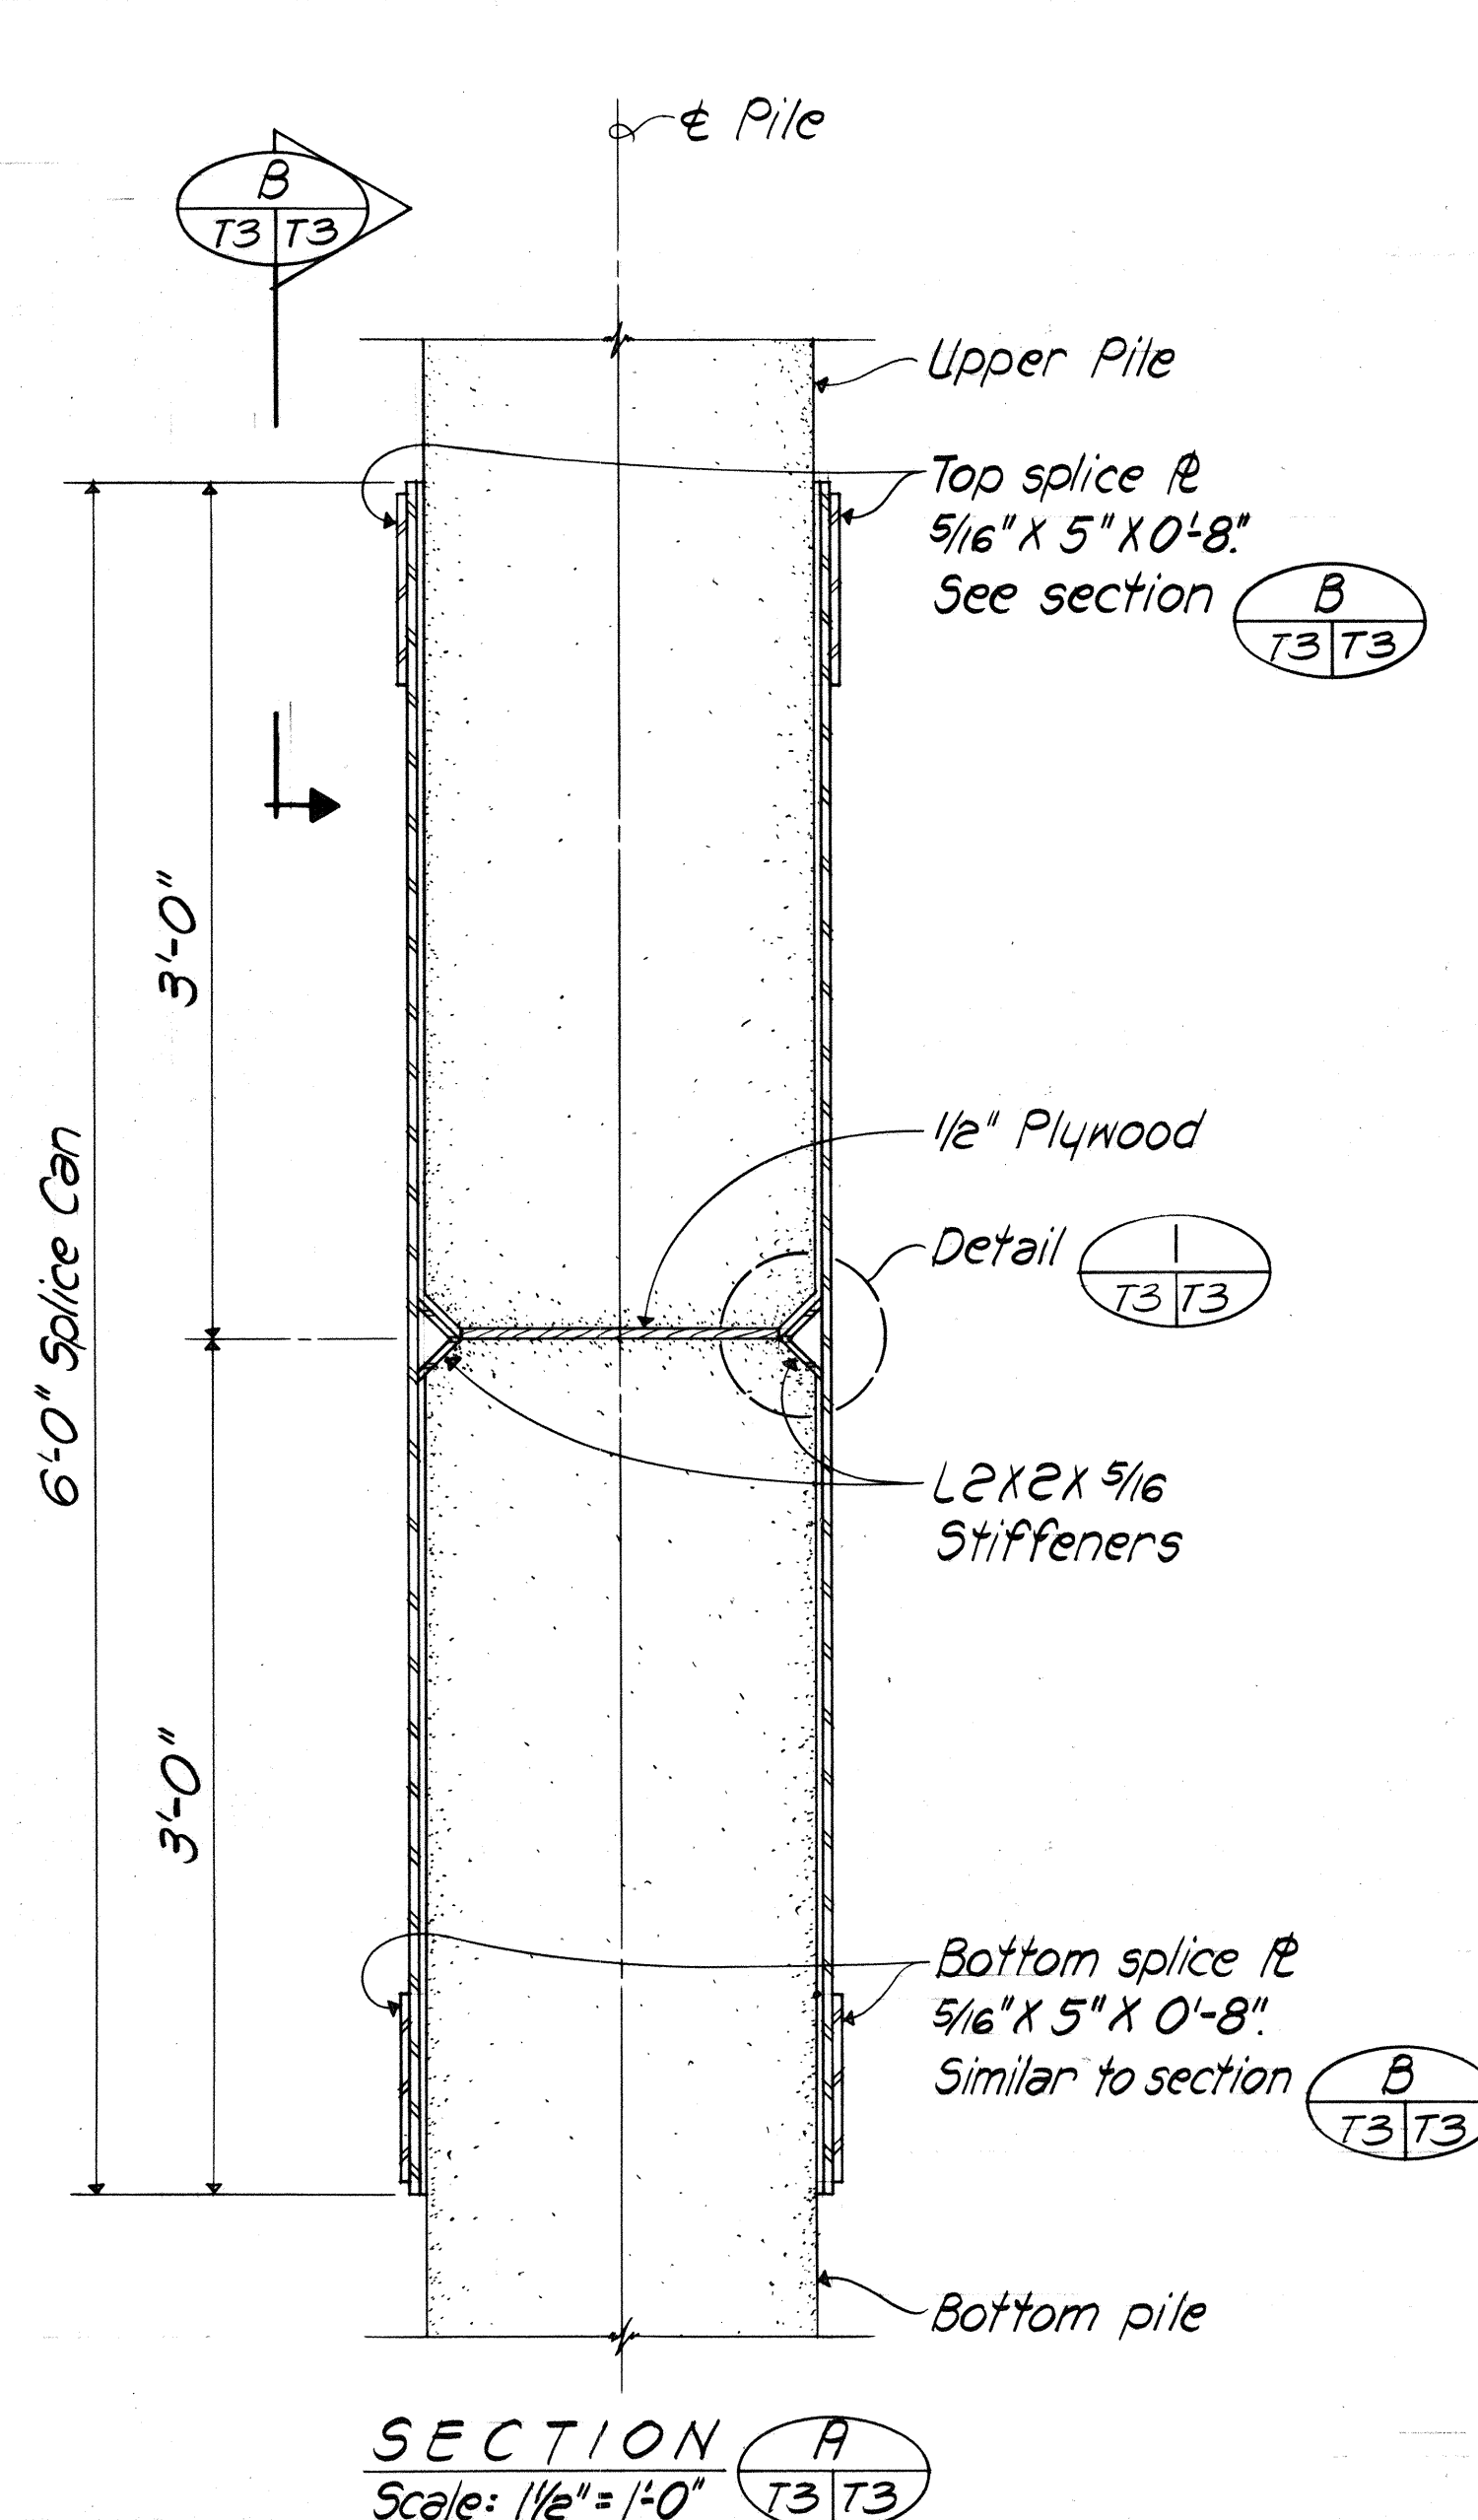

SECTION A
Scale: 1/2" = 1'-0"

TYPICAL PILE SPLICE DETAILS

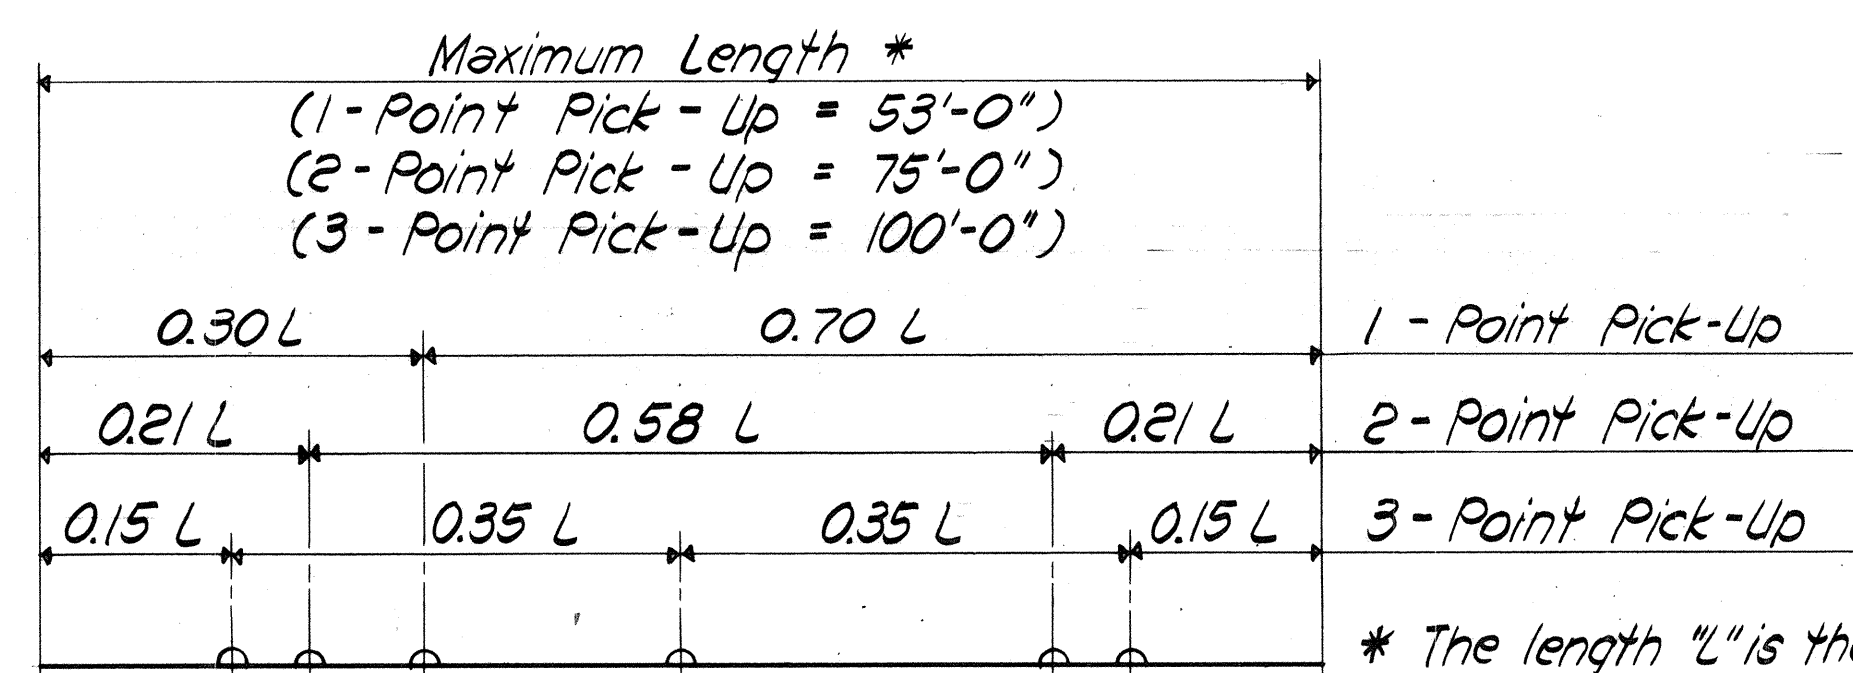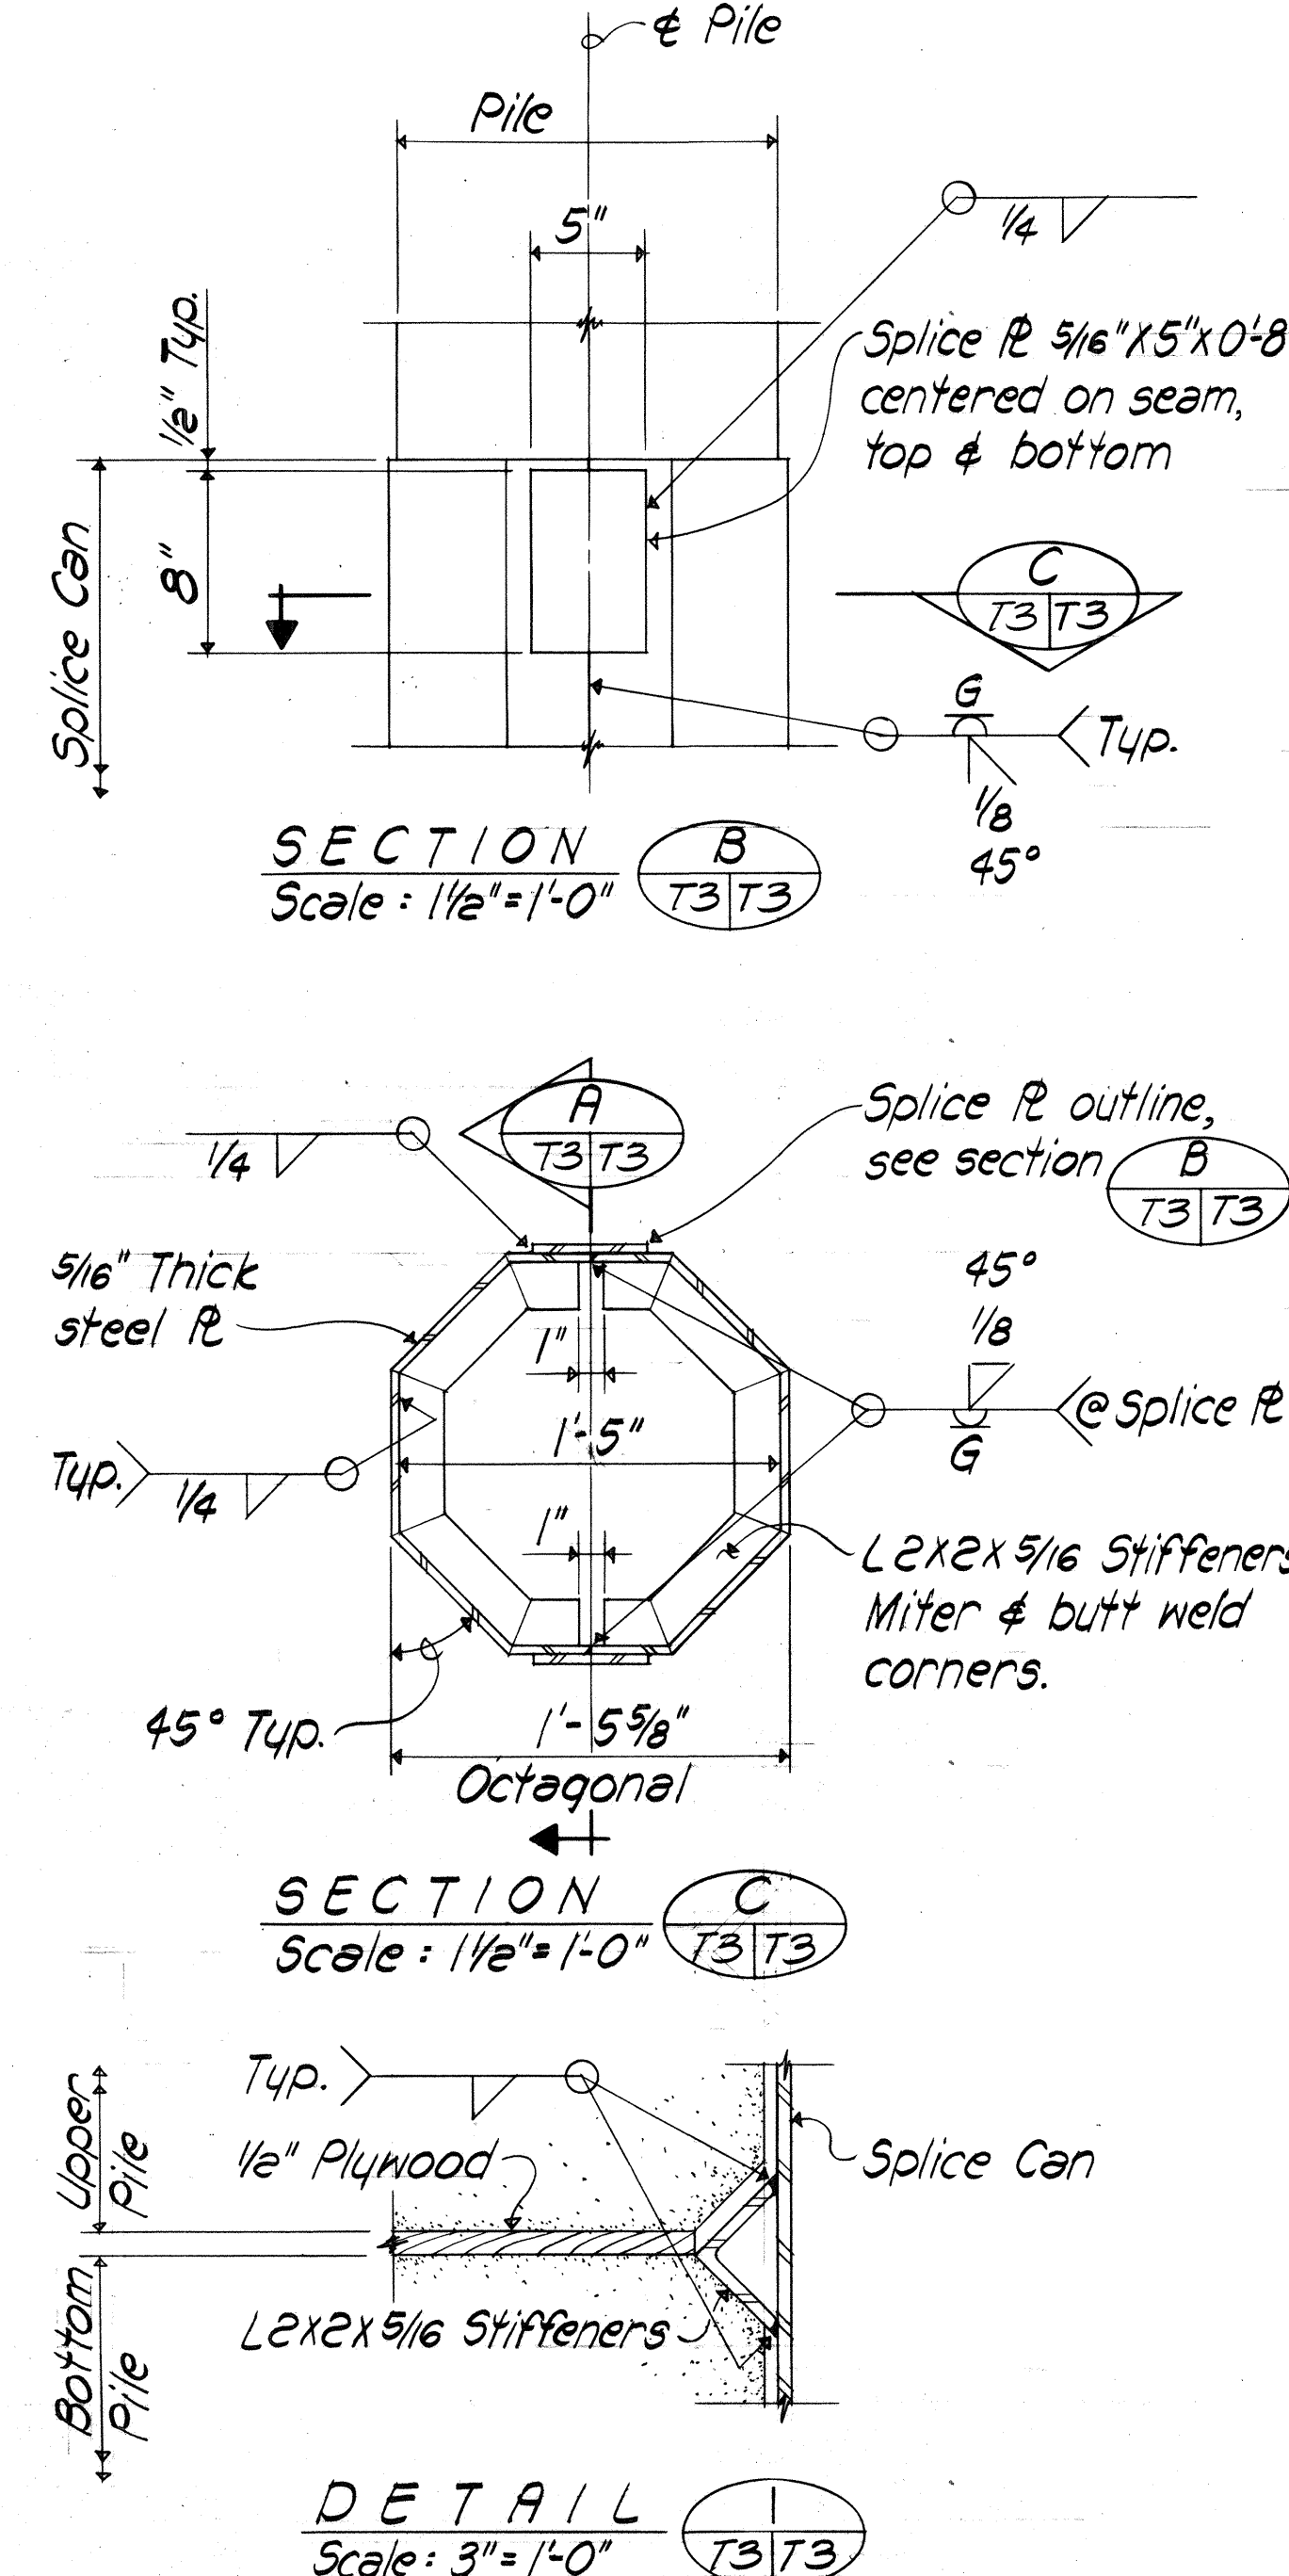


PILE PICK-UP POINTS


Not to scale

* The length "L" is the distance end to end of pile.

FED. ROAD DIST. NO.	STATE	FED. AID PROJ. NO.	FISCAL YEAR	SHEET NO.	TOTAL SHEETS
HAWAII	HAW.	I- H3- I(51)	1989	89	100

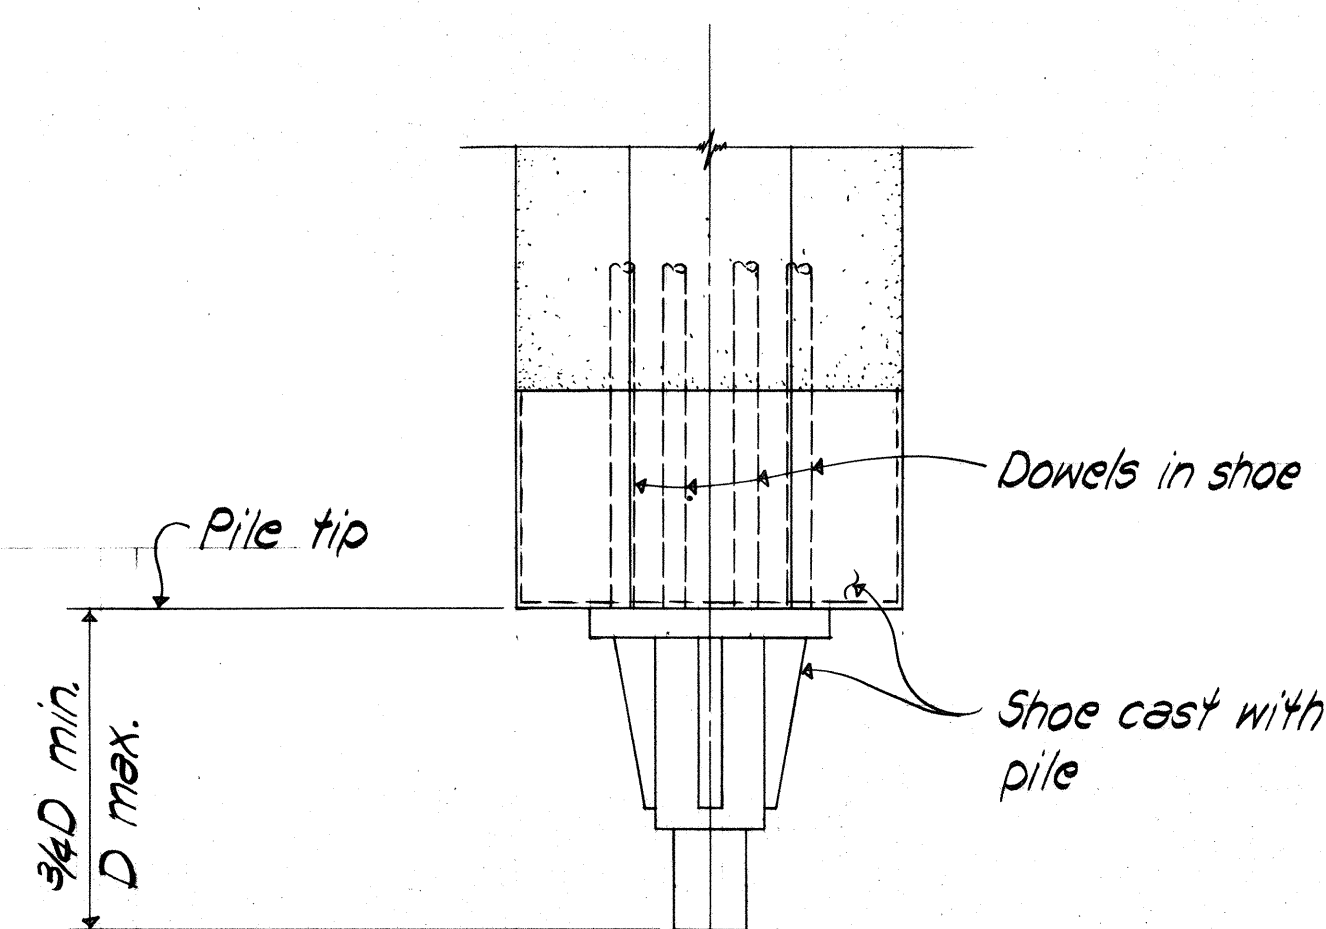

ELEVATION

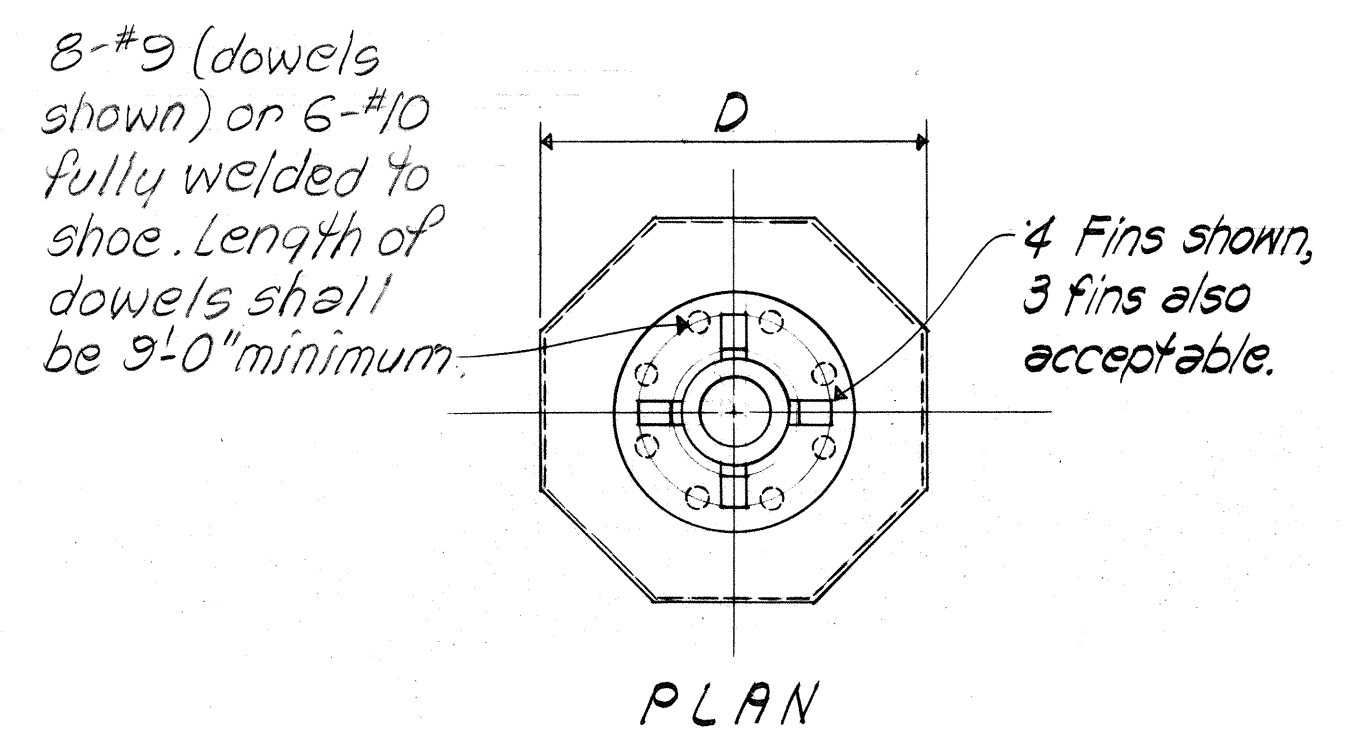

PLAN


PILE ROCK DRIVING SHOE DETAIL
Not to scale

TABLE OF PILE LOAD TESTS


PILE LOAD TEST AT PIER NUMBER	DESIGN PILE CAPACITY (TONS)
(12)	50
(15)	100
(18)	100
(22)	100
(27)	100
Abut. # 2	100

Remarks:

- (1) Pile load tests shall be performed in accordance with a procedure specified by the Engineer.
- (2) Contractor shall provide the amount of reaction load specified by the Engineer. The total reaction load shall not exceed 350 tons.
- (3) Contractor shall allow one week (seven days) for the Engineer to complete each load test.

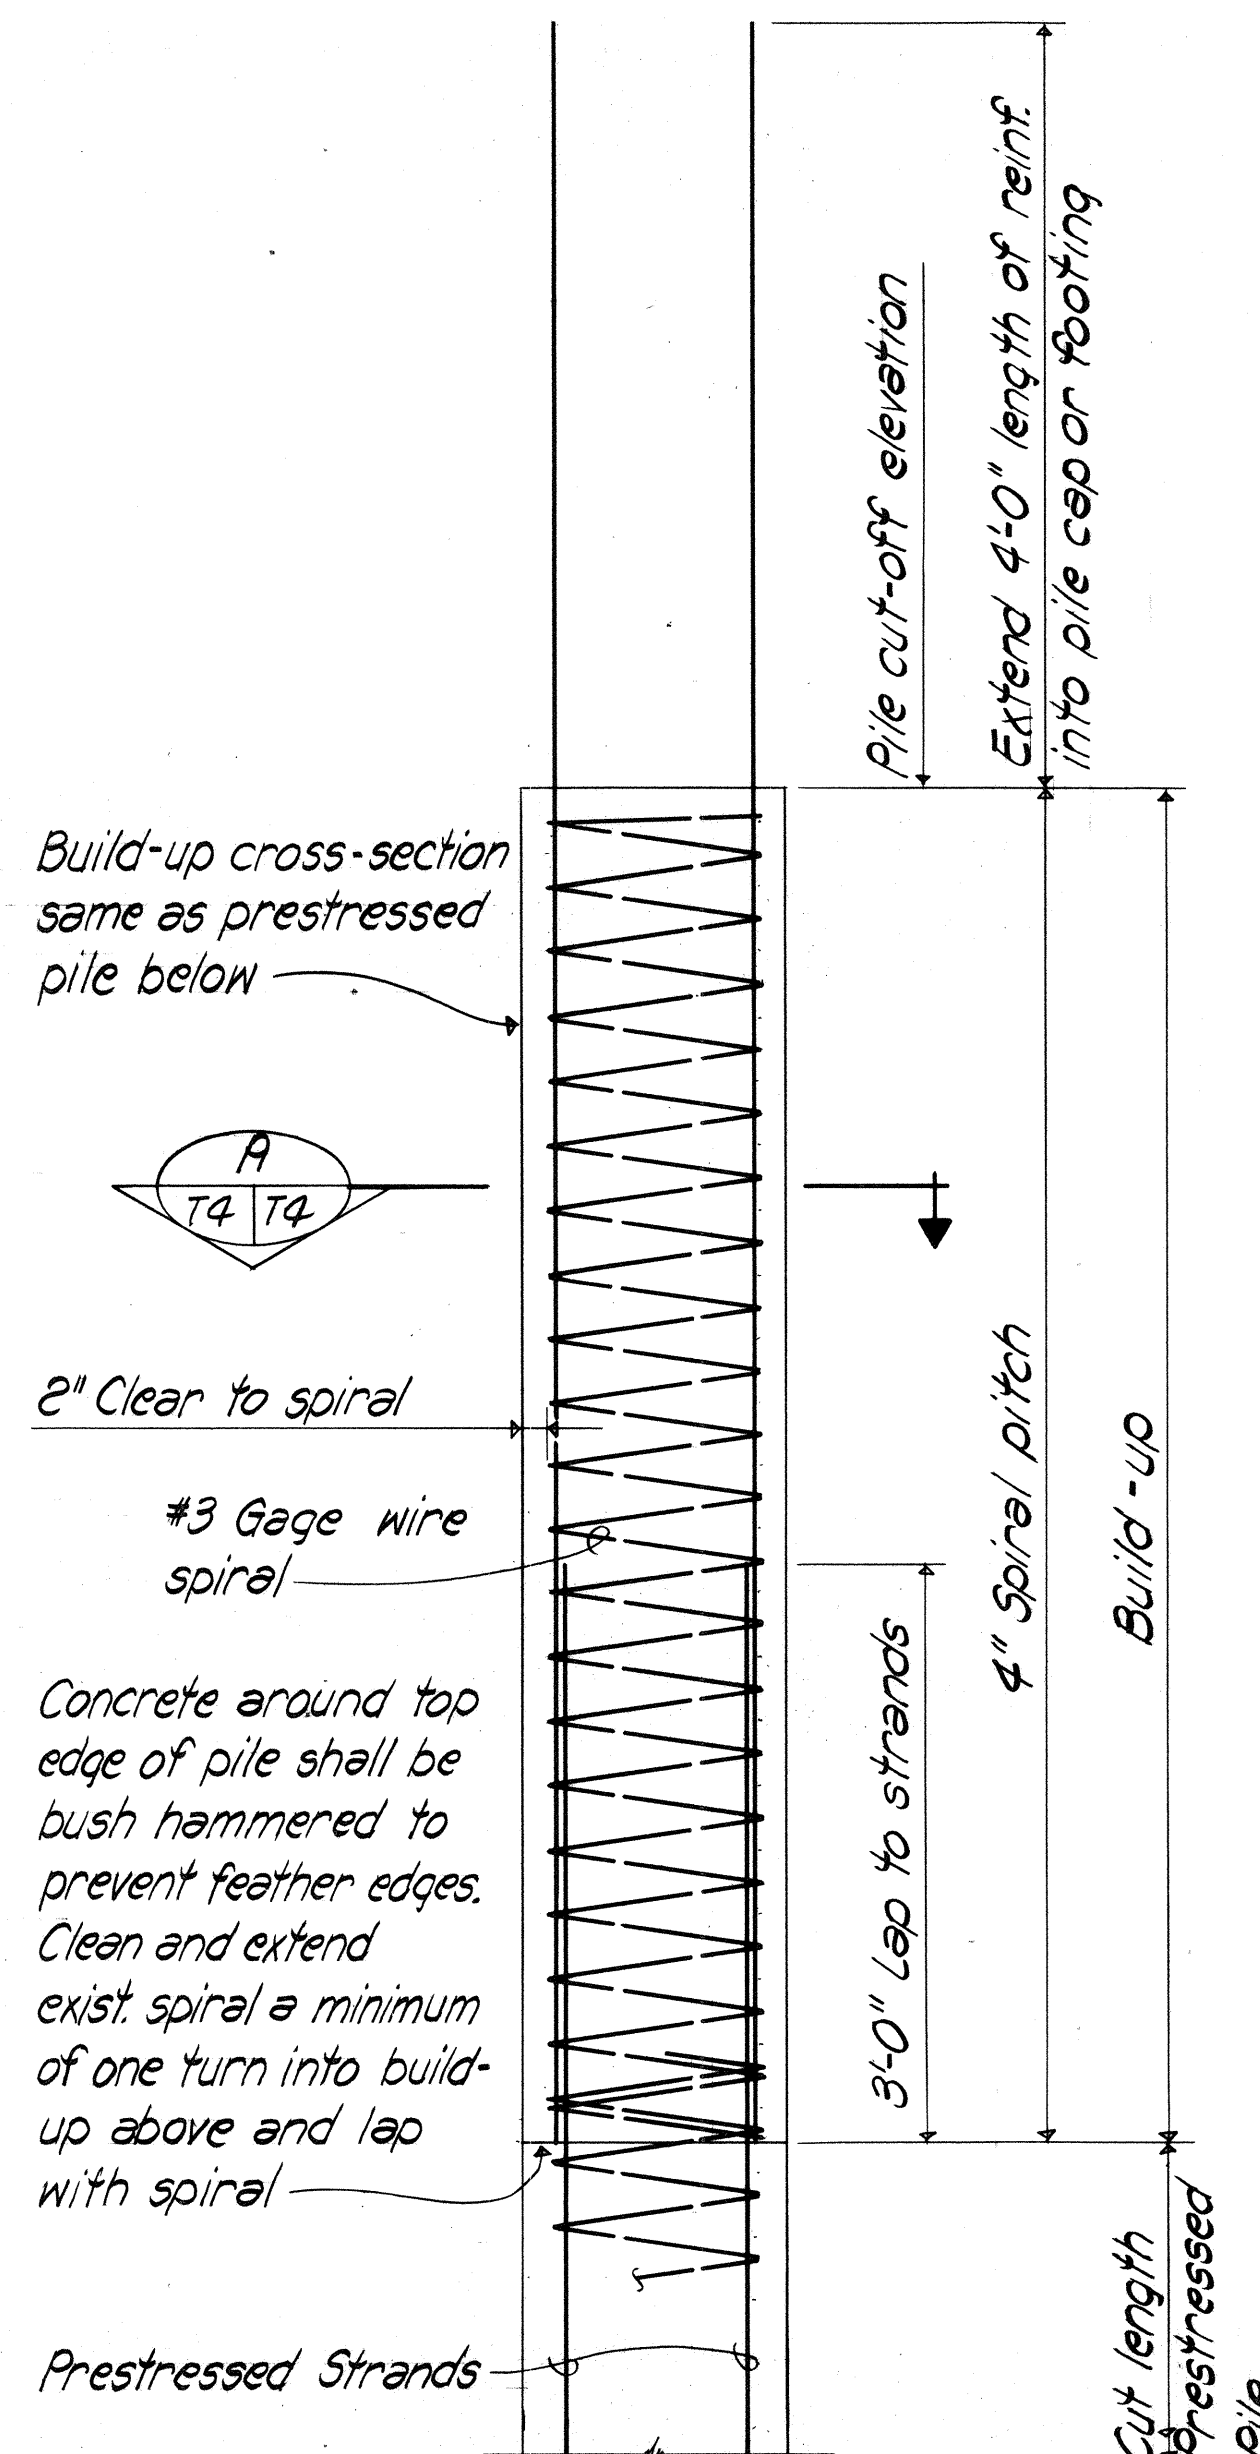

WITHOUT DRIVING ELEVATION

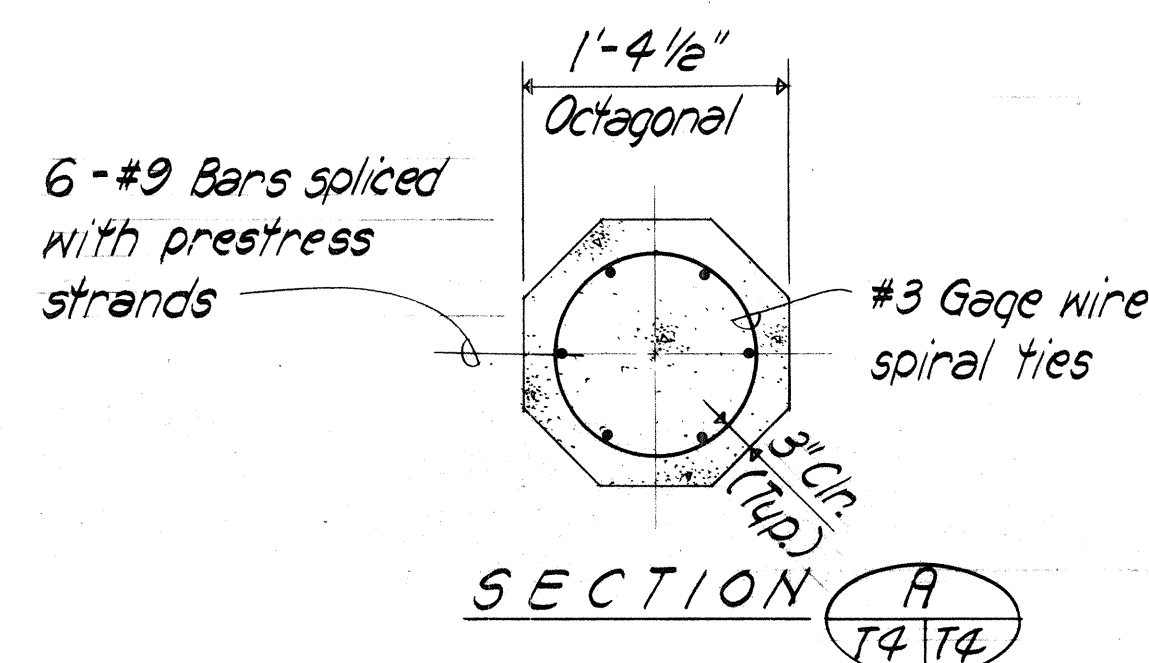


SECTION

TYPICAL PILE BUILD-UP DETAILS

Not to scale


NOTE:
Concrete in pile build-ups shall have a minimum 28 day compressive cylinder strength $f_c' = 5,000$ p.s.i.

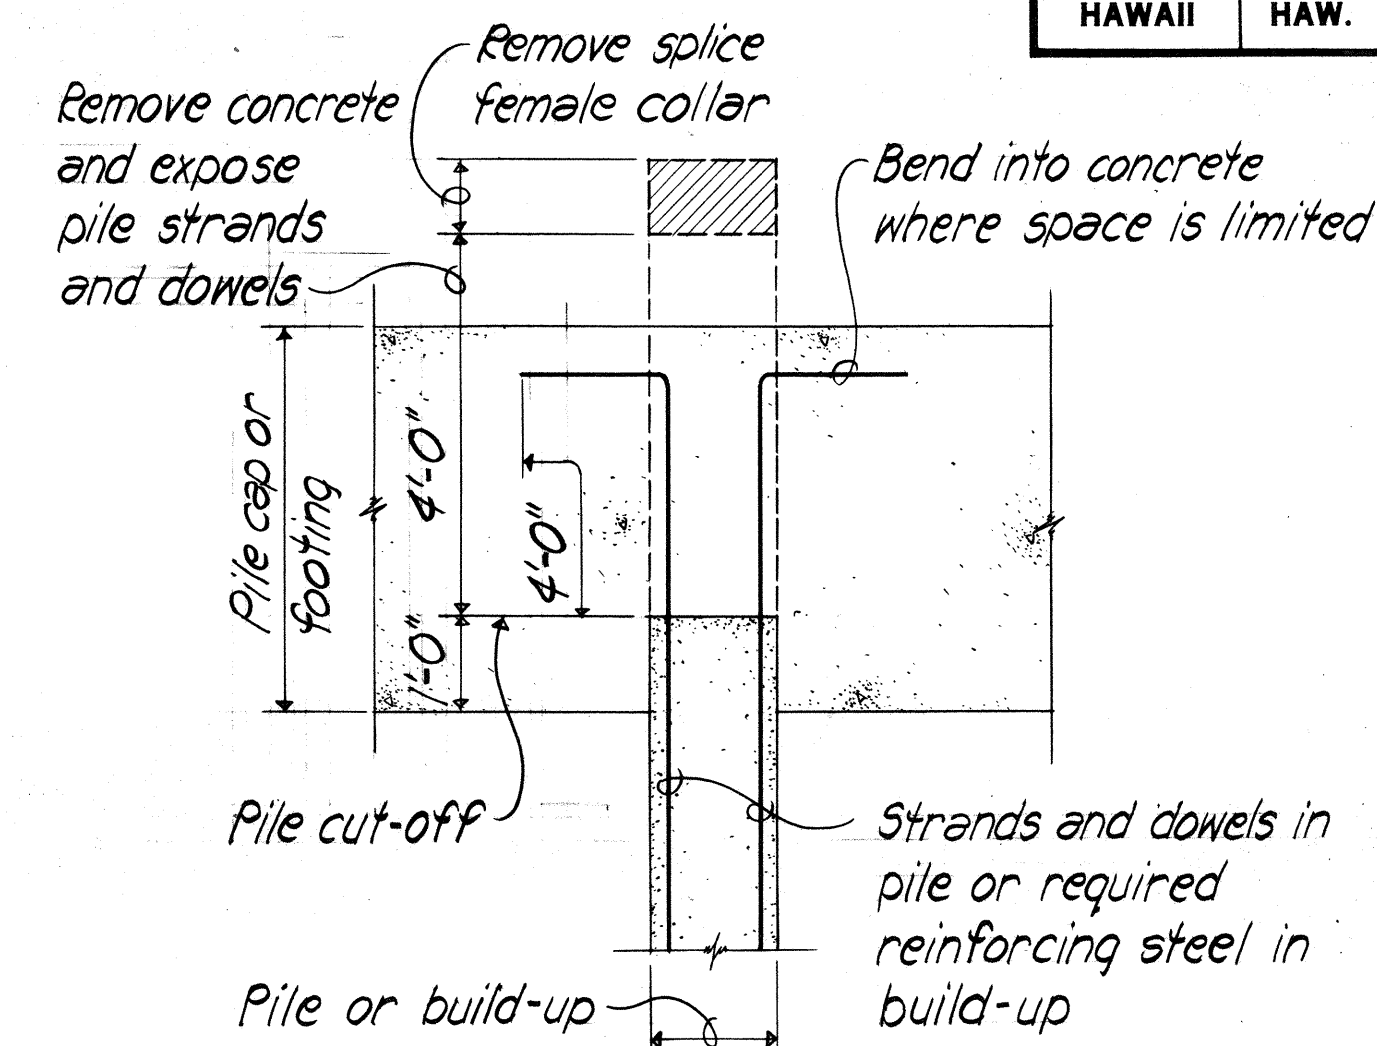

PILE REINFORCEMENT
EXTENSION DETAIL

Scale: 1/2" = 1'-0"

SSM Engineers, Inc.
Consulting Structural Engineers
1210 W. rd Ave., Honolulu, HI 96814

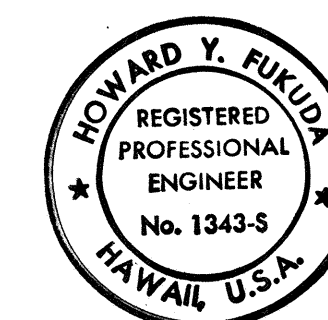

This work was prepared by me or under my supervision.

Howard Y. Fukuda

STATE OF HAWAII
DEPARTMENT OF TRANSPORTATION
HIGHWAYS DIVISION

PILE DETAILS

INTERSTATE ROUTE H-3
F.A.I. PROJ. NO. I-H3-I(51)

SCALE: AS NOTED DATE:

SHEET NO. 74 OF 21 SHEETS


11/15/88	REVISED TABLE OF PILE LOAD TEST
DATE	REVISION

ADD. 89.


FED. ROAD DIST. NO.	STATE	FED. AID PROJ. NO.	FISCAL YEAR	SHEET NO.	TOTAL SHEETS
HAWAII	HAW.	I-H3-1(51)	1989	90	106

NOTES:

- Selection of pile build-up shall be determined by the Engineer. When height of depressed portion of footing (D) exceeds 5'-0" this alternative pile build-up shall not be allowed.
- Use same number of rebars (ASTM A615 Grade 60) as number of prestress strands.
- Detail "X" shall be used only for piles already driven to desired tip elevation. Driving on pile build-ups shall not be permitted.
- Concrete in Detail "X" shall be Class A, same strength as footing.
- Top of existing pile shall be roughened to 1/4" amplitude.
- Circular section may be used instead of square section if approved by the Engineer.

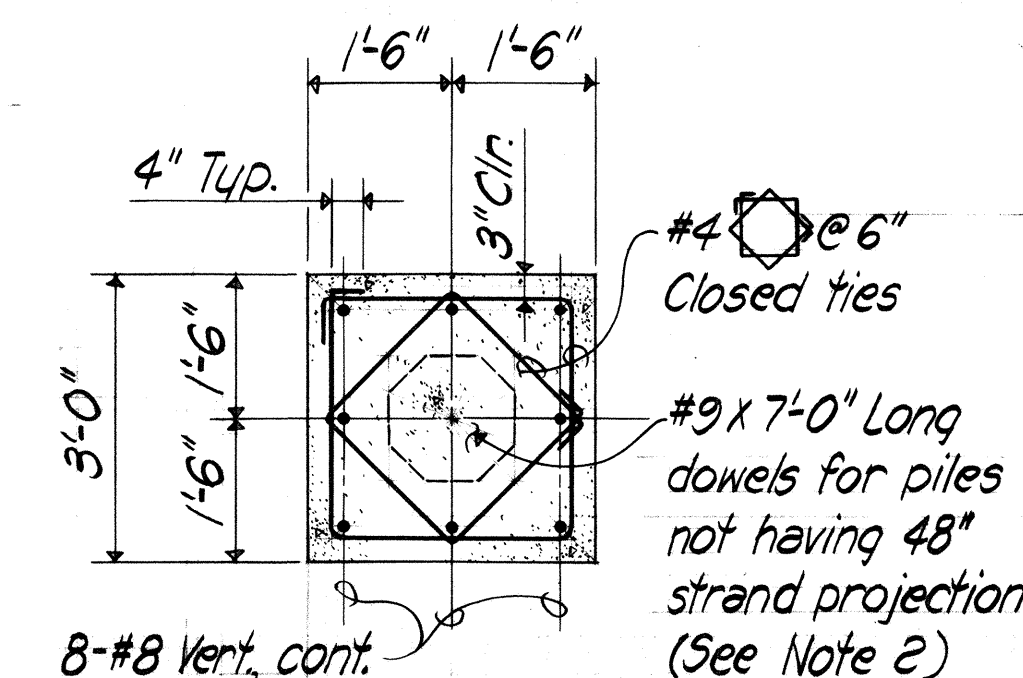


Square Build-Up

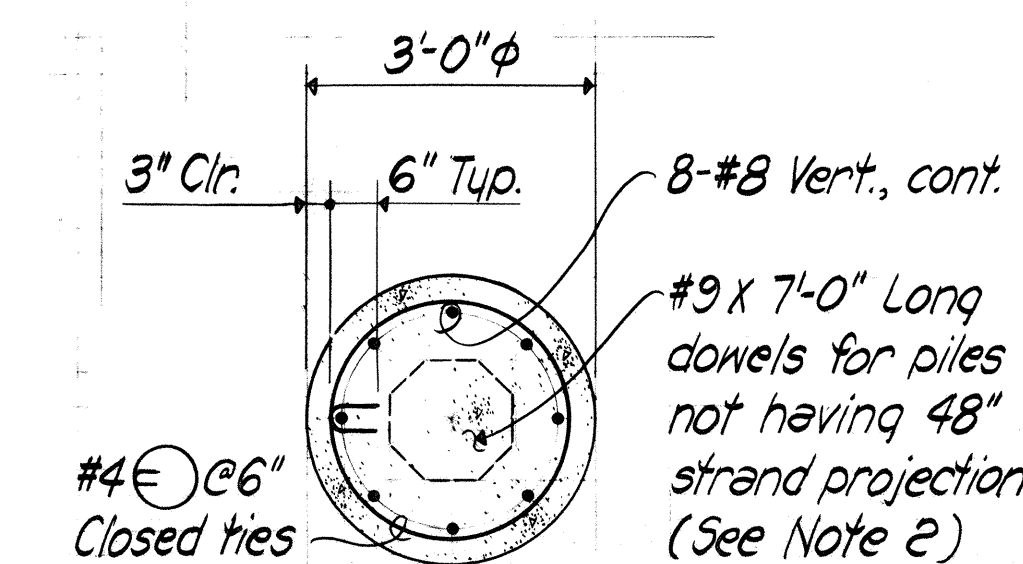

Circular Build-Up

SECTION A
T5/T5


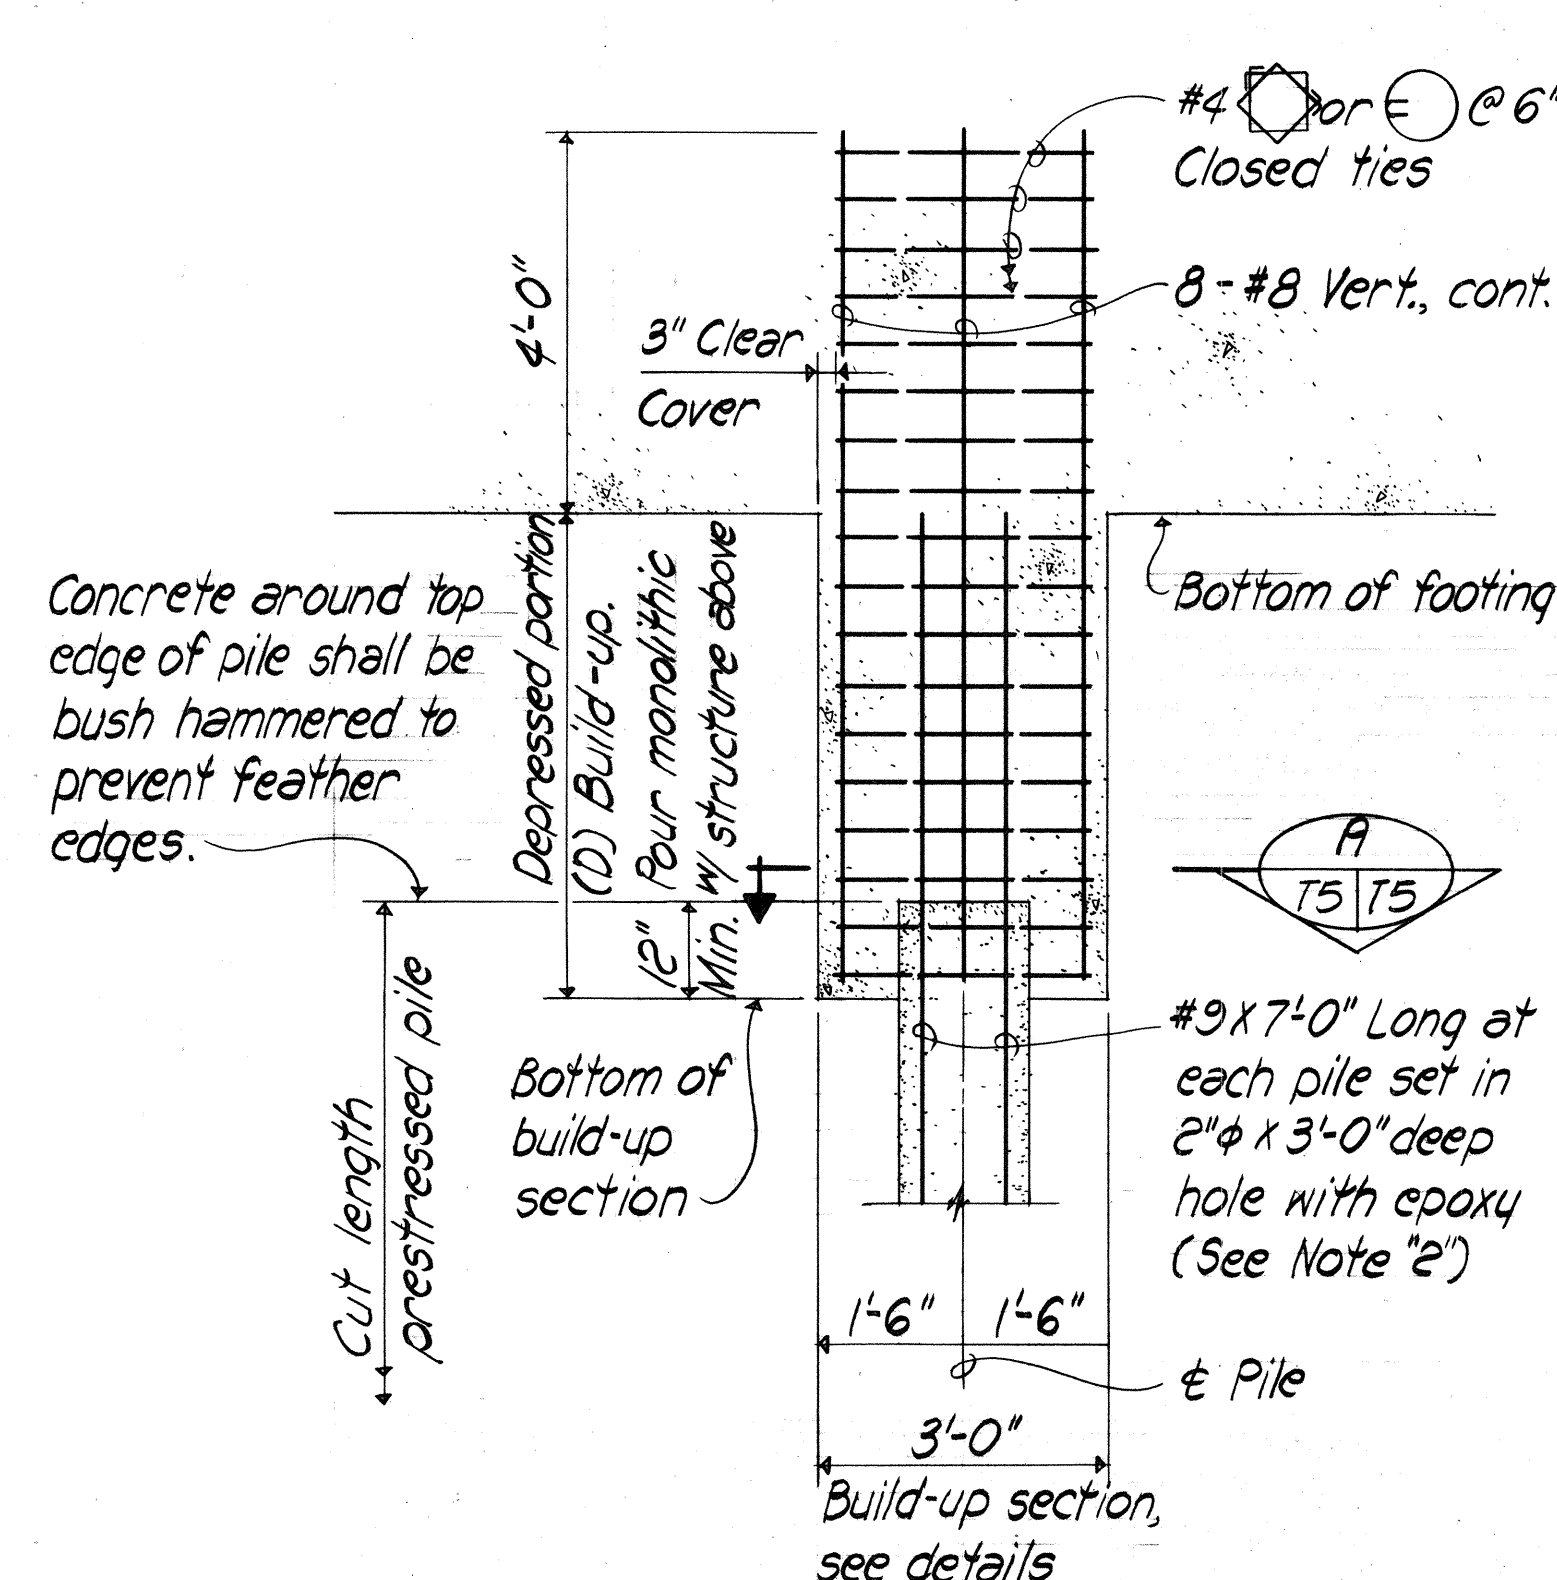


DETAIL "X"
(Without Driving)

NOTES:


- The hole to receive dowel shall be clean, dry and not oily prior to application of epoxy.
- The strength of epoxy shall be equal to or greater than that of pile concrete. The epoxy shall be non-shrink.

ALTERNATIVE PILE BUILD-UP DETAILS Not to scale

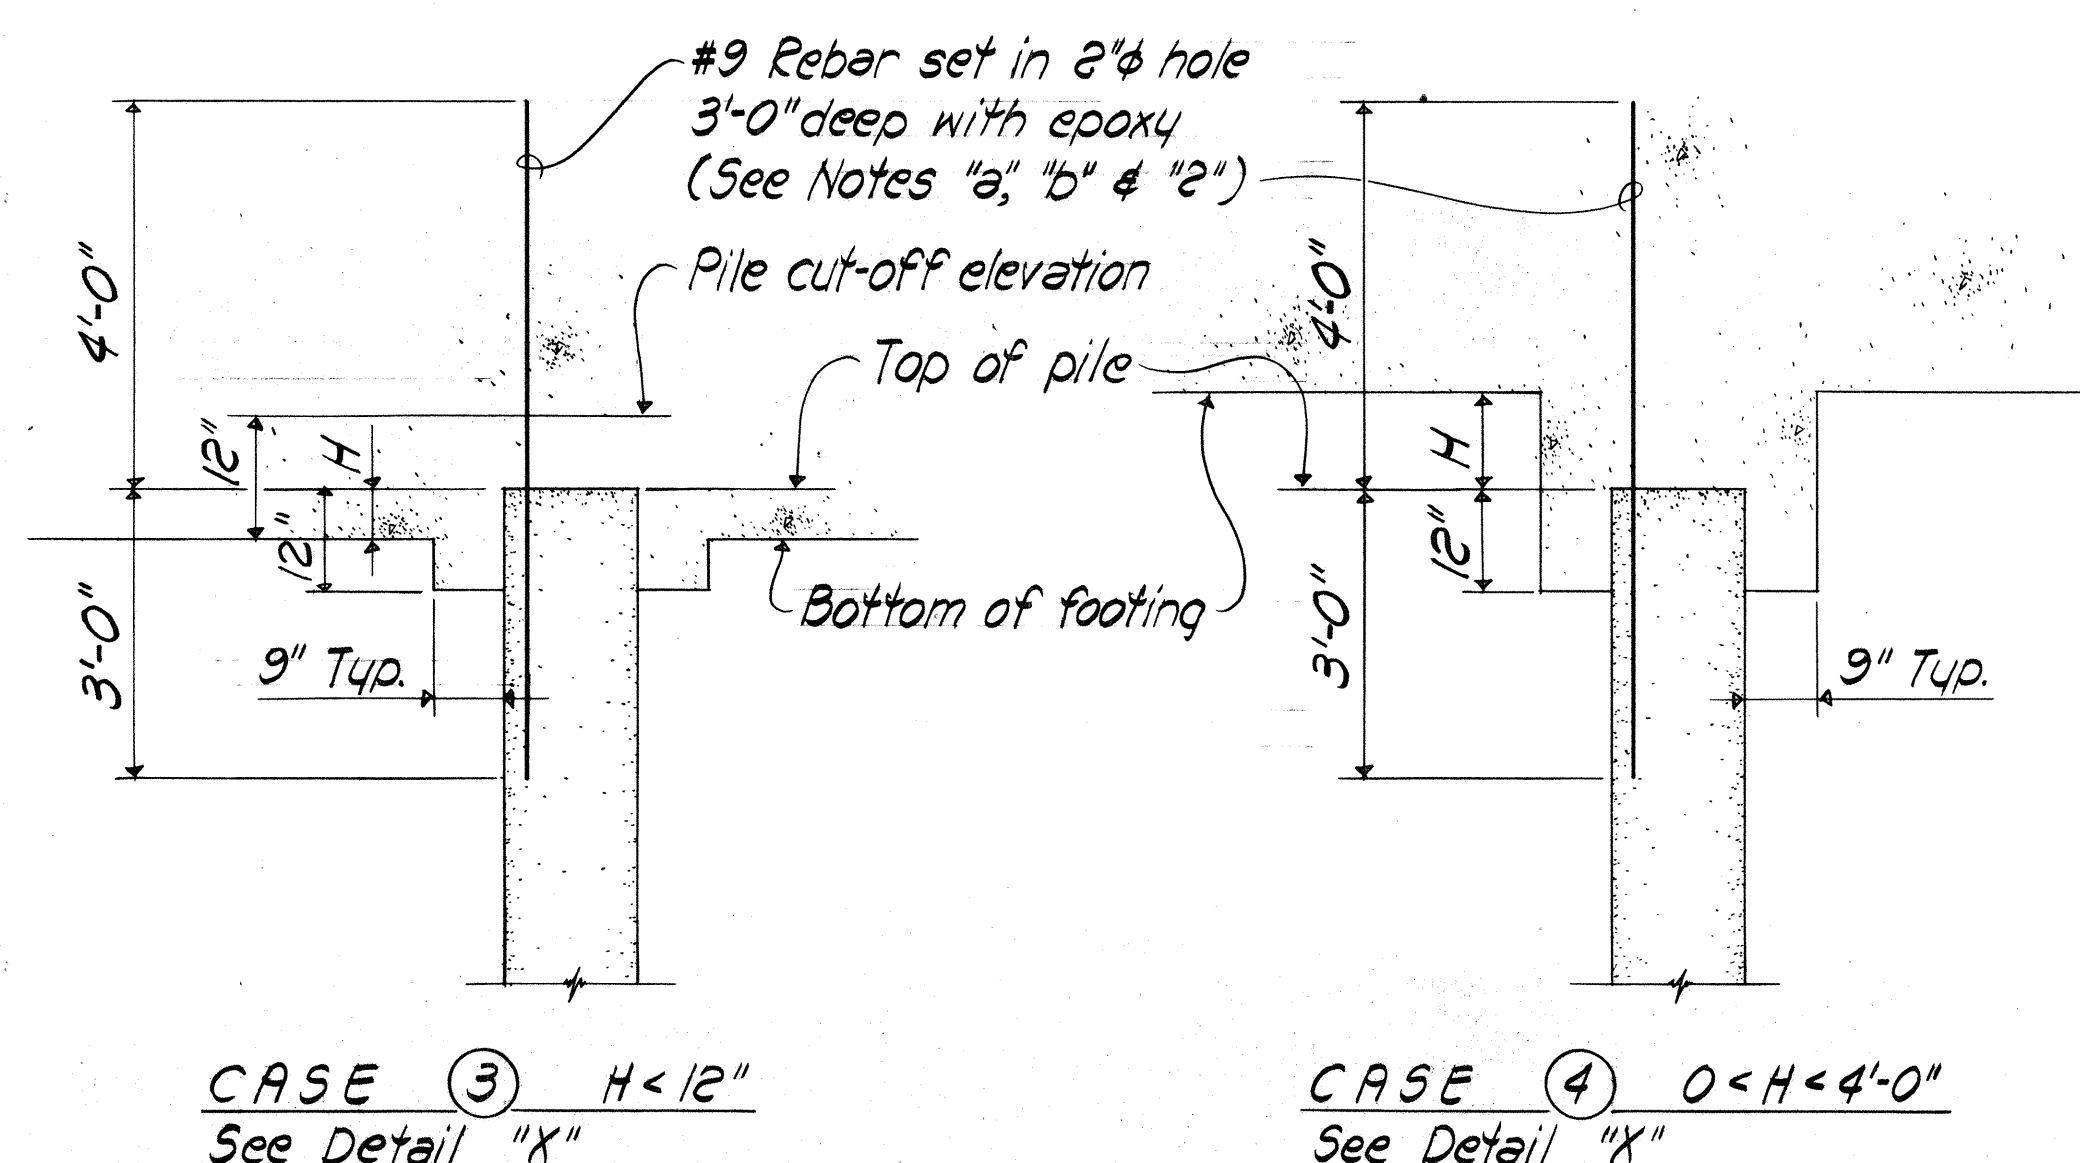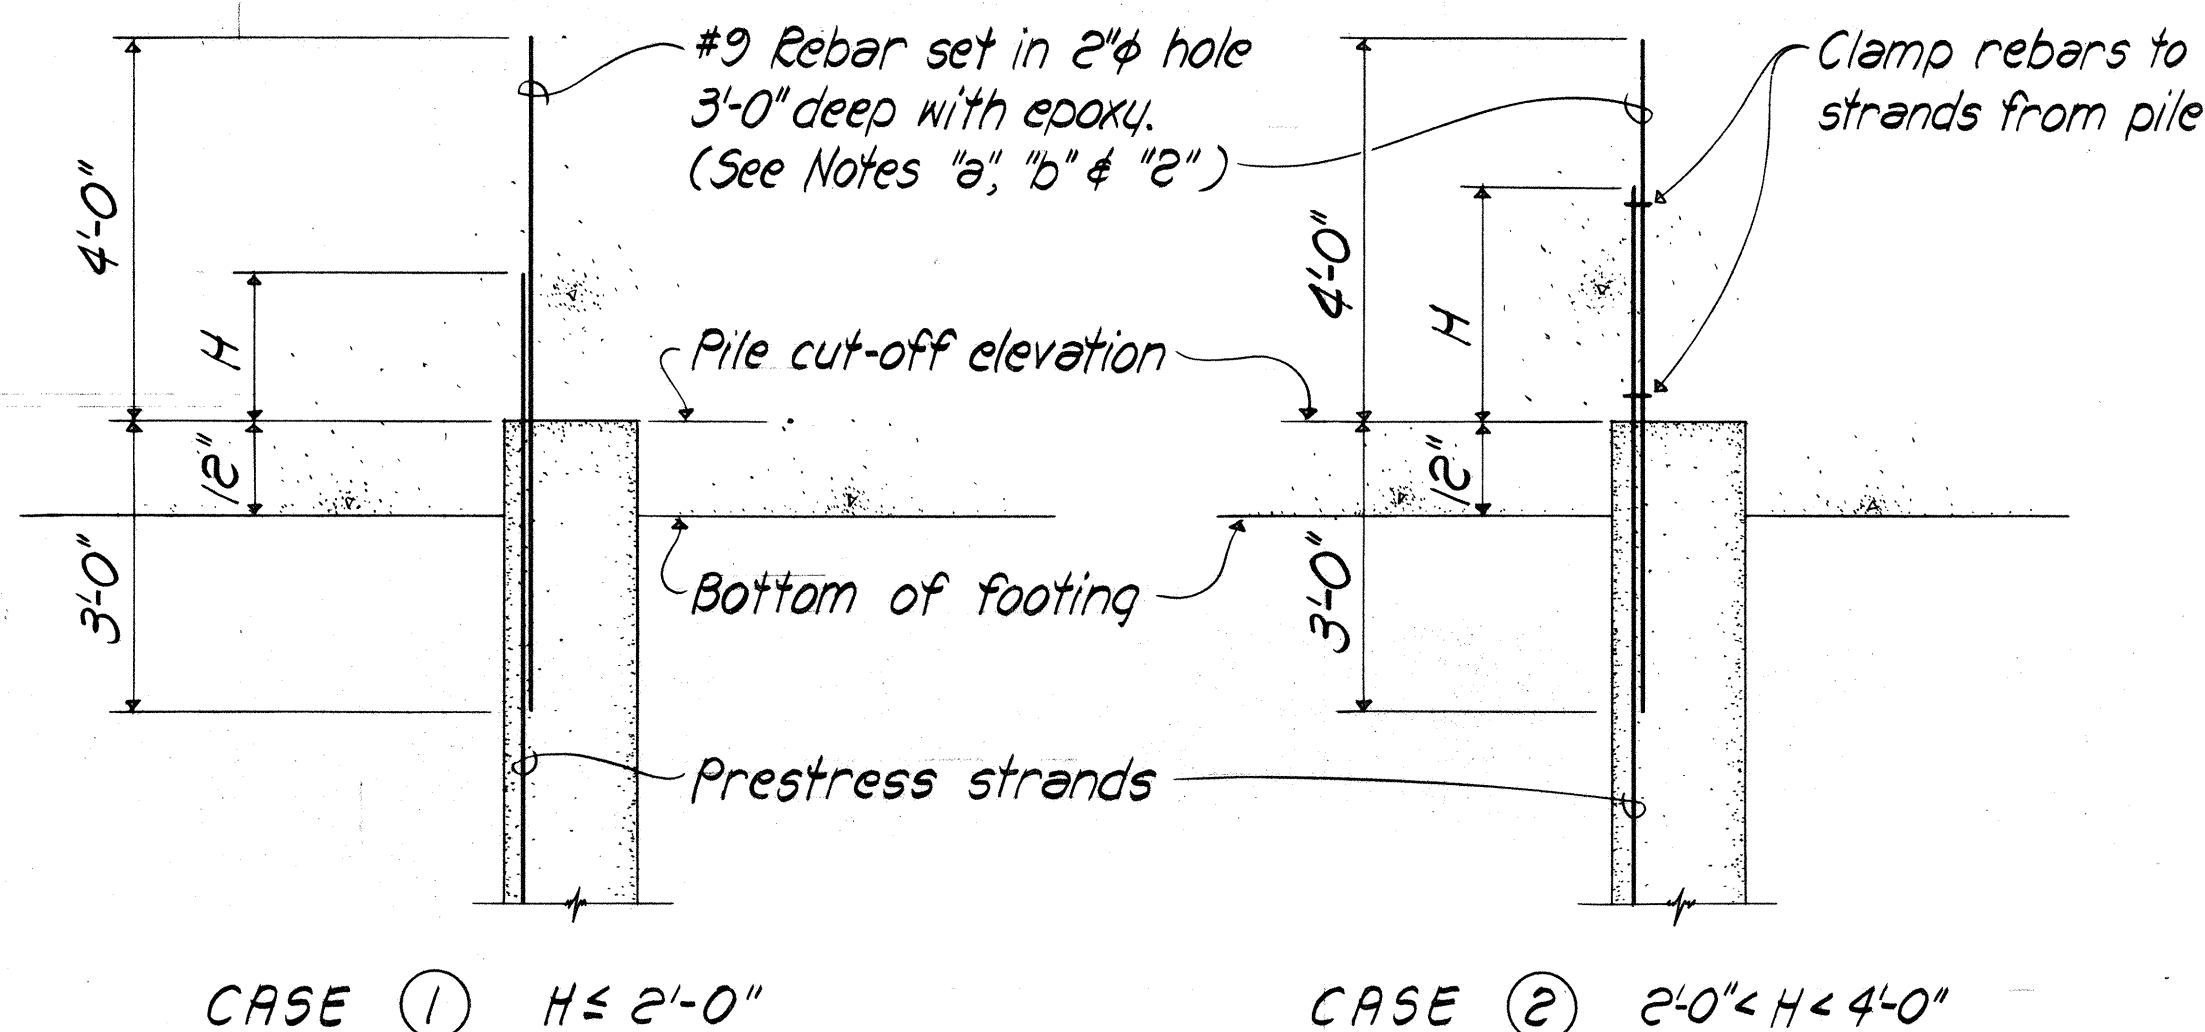

SURVEY PLOTTED BY	DATE
DRAWN BY	
DESIGNED BY	
QUANTITIES BY	
CHECKED BY	

SSFH Engineers, Inc.
Consulting Structural Engineers
1210 W. rd Ave., Honolulu, HI 96814

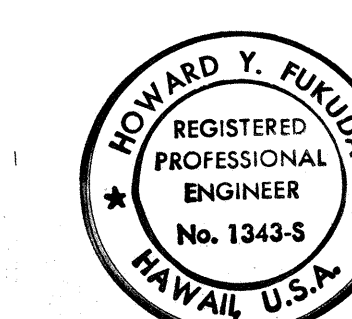

This work was prepared by
me or under my supervision.
Howard Y. Fukuda


STATE OF HAWAII
DEPARTMENT OF TRANSPORTATION
HIGHWAYS DIVISION

PILE BUILD-UP DETAILS

INTERSTATE ROUTE H-3
F.A.I. PROJ. NO. I-H3-1(51)
SCALE: AS NOTED DATE:

SHEET No. 75 OF 21 SHEETS

FED. ROAD DIST. NO.	STATE	FED. AID PROJ. NO.	FISCAL YEAR	SHEET NO.	TOTAL SHEETS
HAWAII	HAW.	I-H3-1(51)	1989	91	106

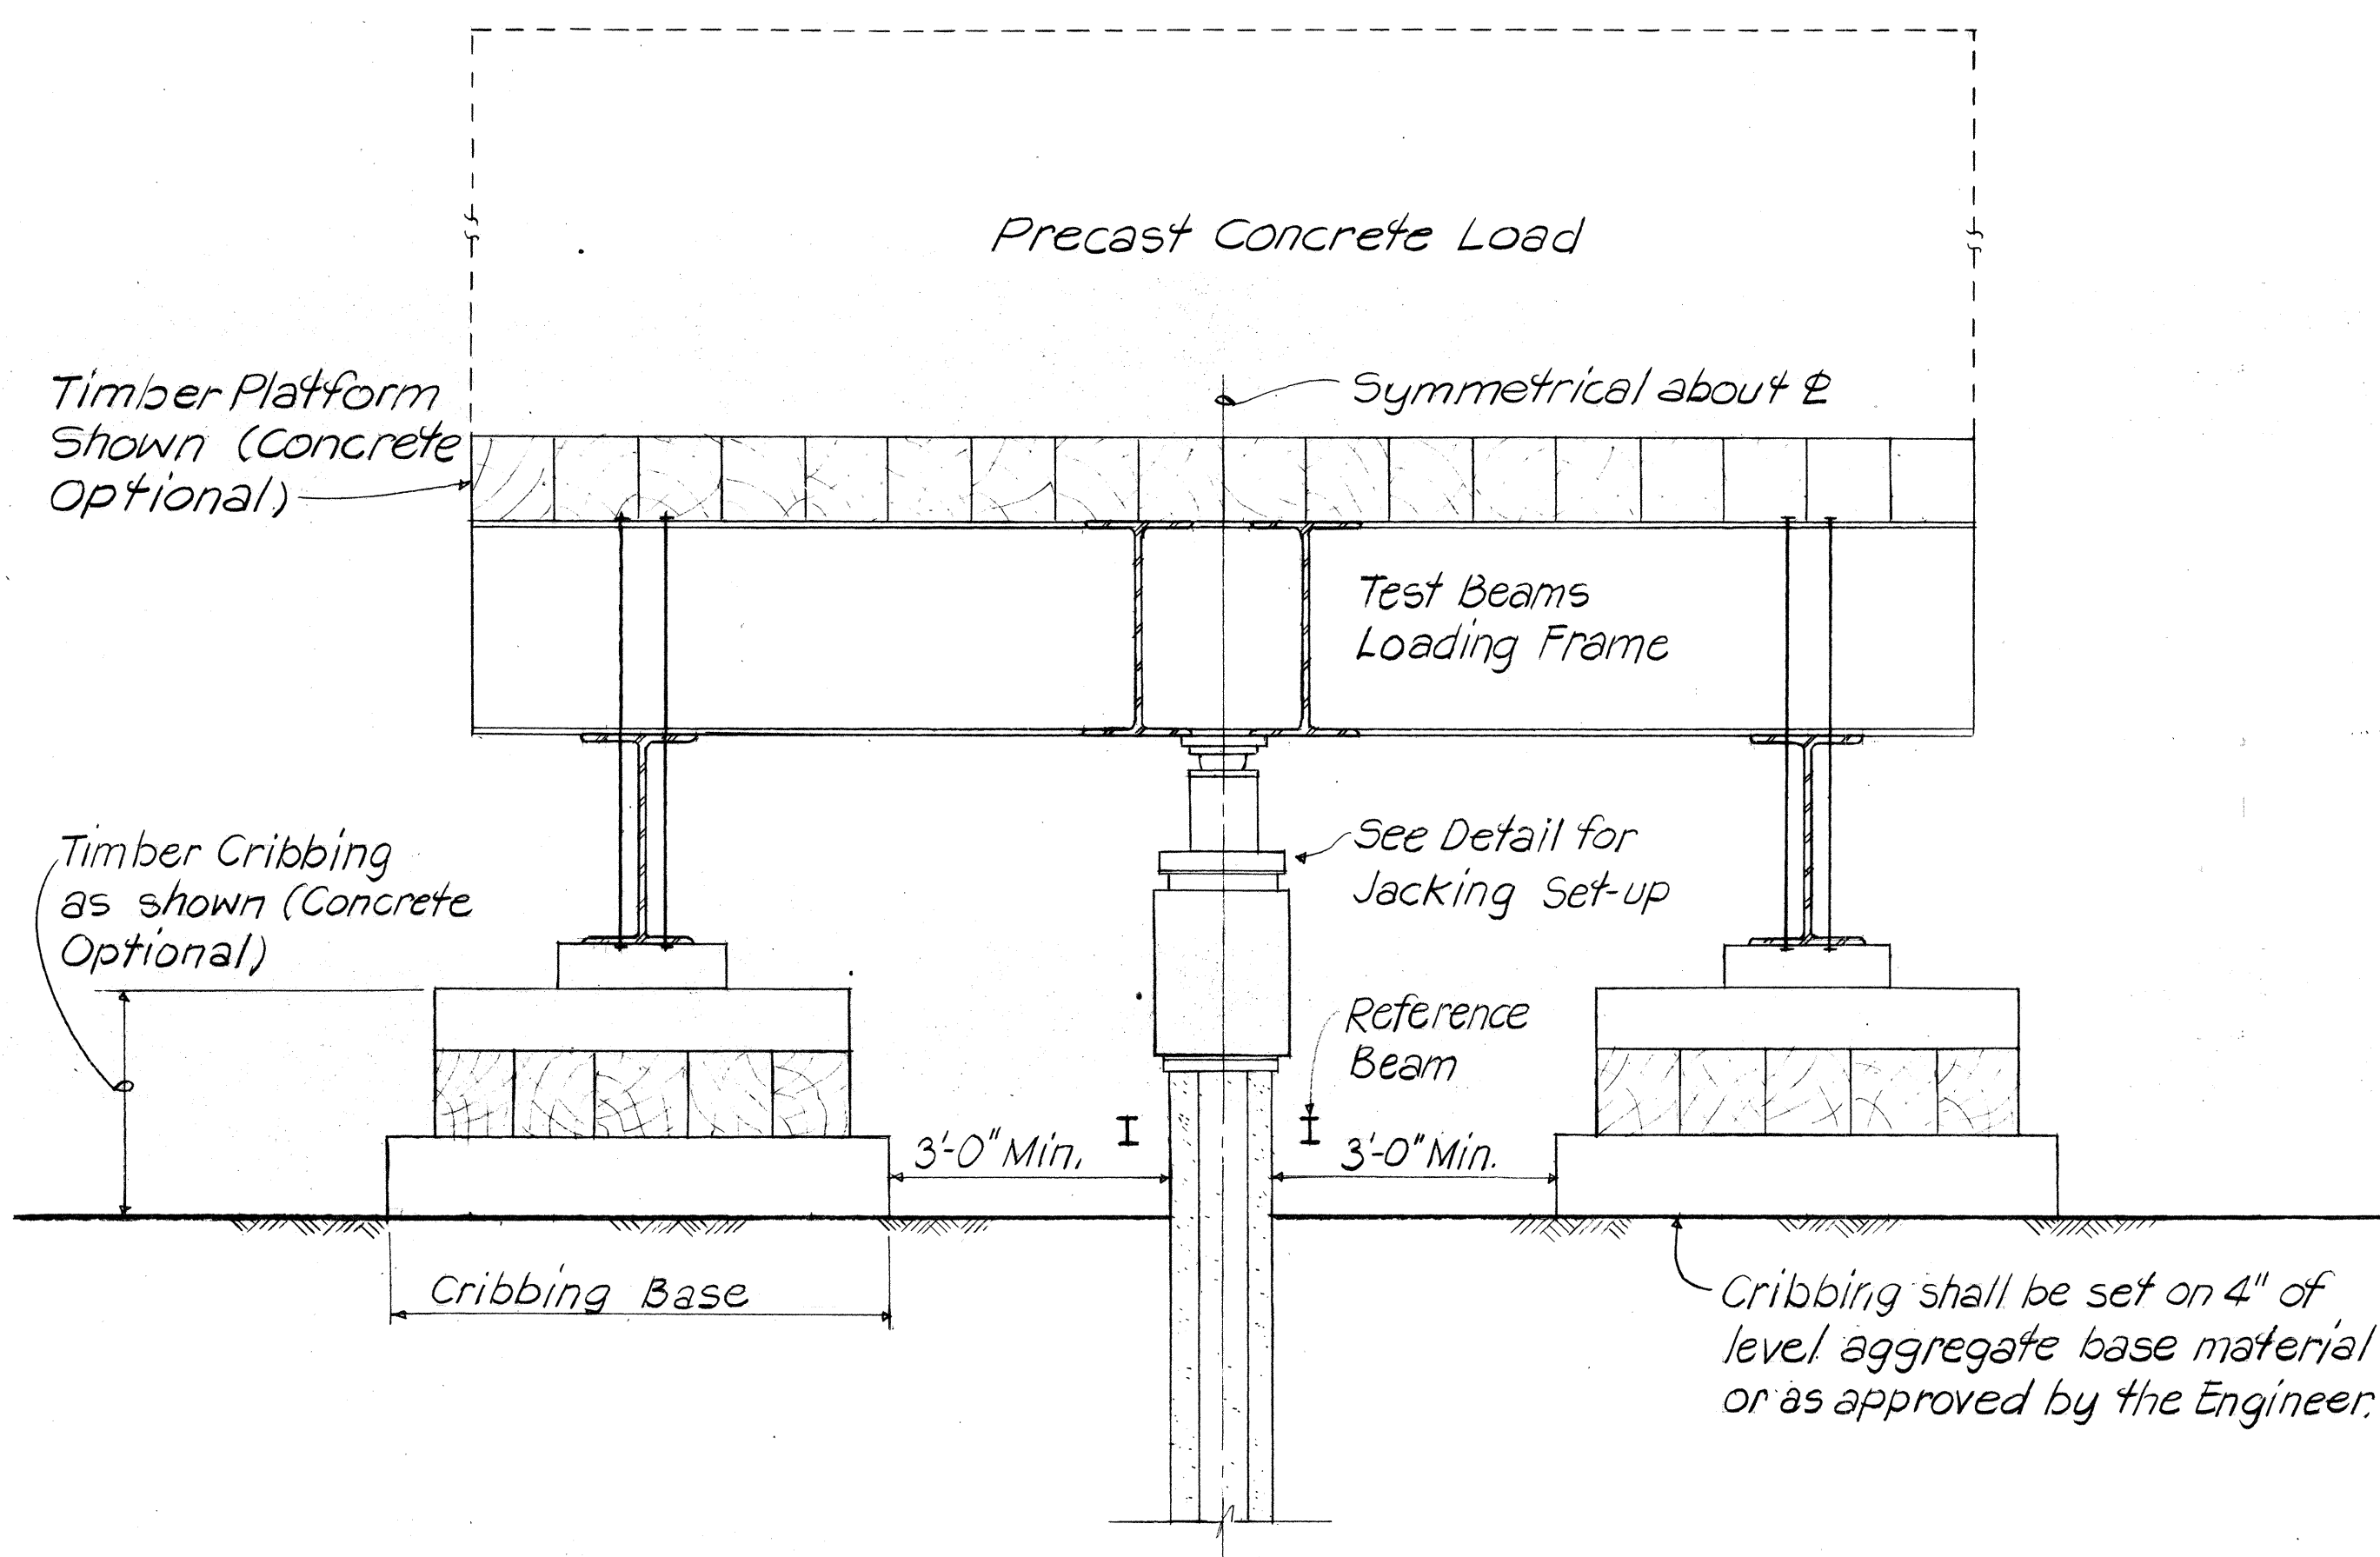

SCHEMATIC SET-UP FOR APPLYING LOADS TO TEST PILE


Scale: 1/2"=1'-0"

NOTES:

- The apparatus for applying known compressive loads to the pile shall be assembled so that the loads are applied axially to minimize eccentric loading.
- Where necessary, the unsupported length of the pile shall be braced to prevent buckling.
- The steel test plate shall be set in high-strength quick-setting grout. Full bearing must be achieved between the plate and grout; that is, no voids should exist between them.
- Two reference beams, one on each side of the pile shall be oriented perpendicular to the direction of the test beams of the load frame. Two dial gages shall be mounted approximately equidistant from the center of and on opposite sides of the pile with stems parallel to the direction of the load application.
- The reference beams shall be independently supported with supports firmly embedded

in the ground at a clear distance of not less than 10 feet from the cribbing.

- Reference beams shall be of sufficient stiffness to prevent excessive deflections and should be cross connected to provide additional rigidity.
- One end of each reference beam shall be free to move as the lengths of beams change with temperature variations.
- Smooth bearing surfaces perpendicular to the direction of measurement shall be provided for the gage stems. These surfaces shall be of glass or hard metal. No wood shall be allowed in the measurement systems.
- Provisions, such as a protective canopy, shall be made to protect the instrumentation, measuring system and reference system from adverse wind, rain and temperature variations or other disturbances.
- The lateral movements of the pile shall be measured using two dial gages mounted on the reference beams 90 degrees apart with their stems horizontal & bearing against smooth bearing plates or surfaces.

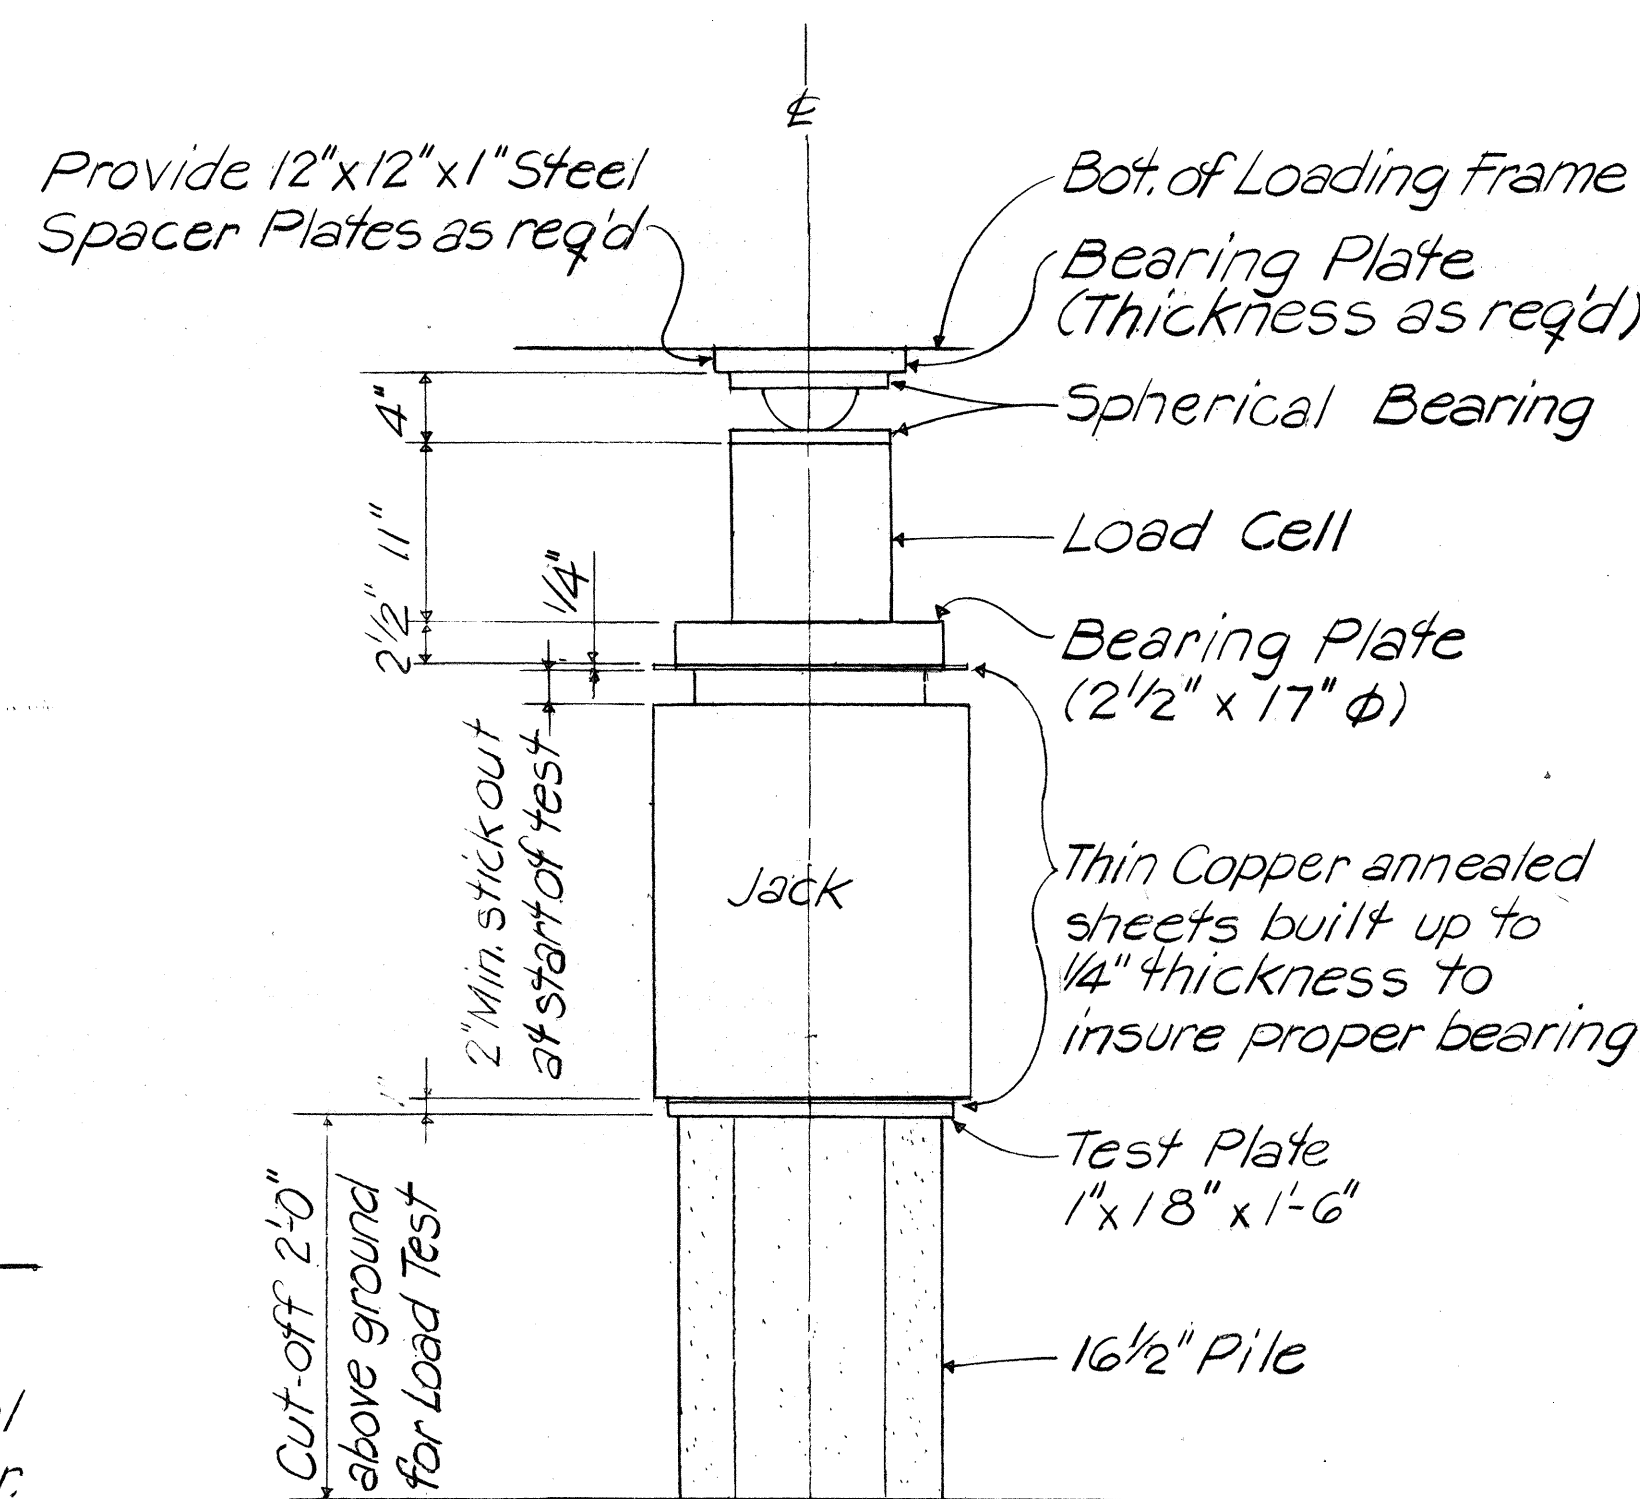


Note:

Set Test Plate in non-shrink non-metallic grout set on Pile so as to obtain full bearing. Plate surfaces receiving grout need not be planed.

DETAIL FOR JACKING SET-UP

Scale: 1"=1'-0"

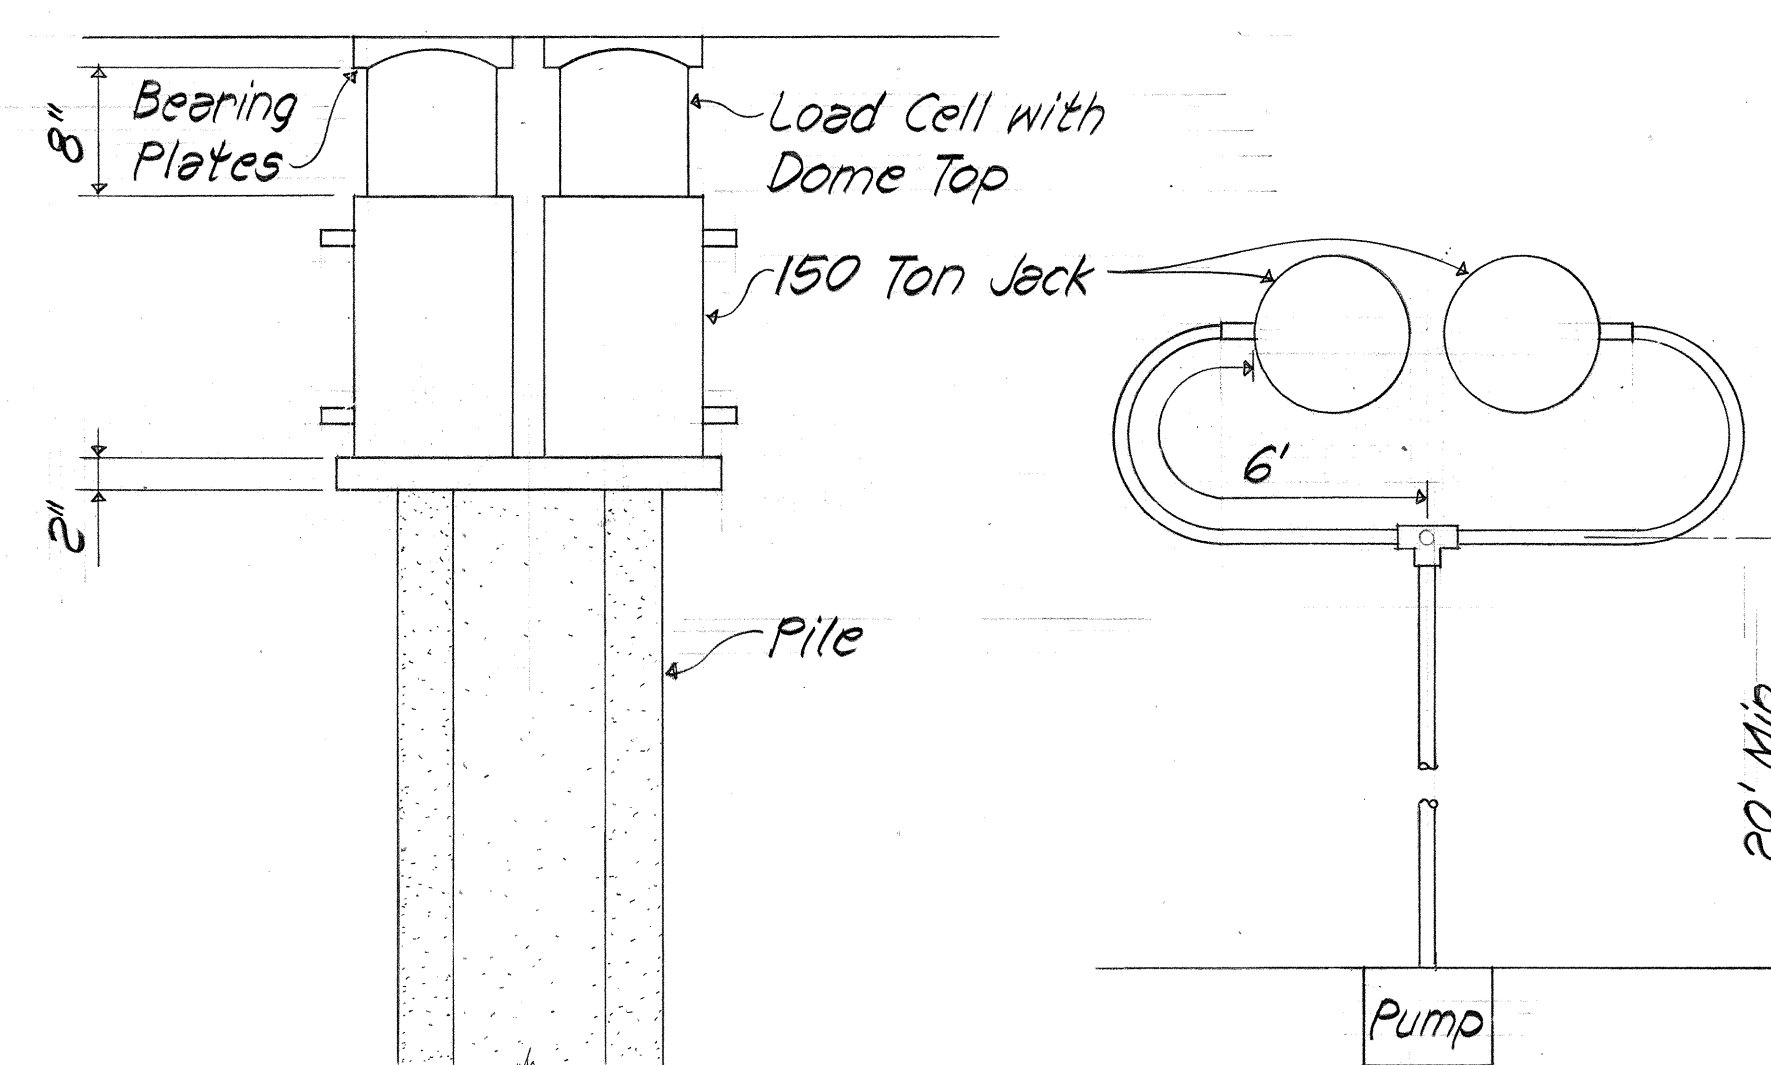

ALTERNATE LOAD TEST SET-UP


Not to Scale

11/15/88	ADDED ALTERNATE LOAD TEST SET-UP & FRAME LOAD
DATE	REVISION

LOAD FRAME NOTES:

- The Loading Frame shall be designed to support load required to permit the Test Pile to be axially loaded to 350 Tons. Loading blocks to be provided by Contractor.
- Design of Frame shall conform to the latest Edition of the Manual of Steel Construction by the American Institute of Steel Construction. Allowable stresses in this manual may be increased by 20% for main structural members. This increase in allowable stresses will not be allowed for Connections, Bolts and Welds.
- At the option of the Contractor, the Loading Frame may be fabricated from new or used structural steel shapes; or loading frames previously used in other projects may be used provided the design and construction of the frame to be furnished conforms to the requirements in Notes 1 and 2 above.
- Load test site shall be enclosed with a 5 ft. high temporary fence (wire mesh on wood poles). Payment shall be considered incidental to "Pile Load Test."
- Timber Cribbing and Platform may be of new or used sound timber and shall be of adequate size and grade to safely carry the loads imposed upon them resulting from the Load Tests.
- Surfaces of all bearing plates shall be planed or milled smooth to provide full surface contact. Top and bottom of Load Transfer Assembly to be planed after welding.

SSFM Engineers, Inc.
Consulting Structural Engineers
1210 Ward Ave., Honolulu, HI 96814

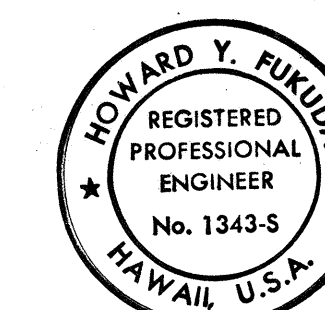

This work was prepared by
me or under my supervision
Howard Y. Fukuda

STATE OF HAWAII
DEPARTMENT OF TRANSPORTATION
HIGHWAYS DIVISION

PILE LOAD TEST DETAILS


INTERSTATE ROUTE H-3
F.A.I. PROJ. NO. I-H3-1(51)

SCALE: AS NOTED DATE:


SHEET No. 76 OF 21 SHEETS

ADD. 91

FED. ROAD DIST. NO.	STATE	FED. AID PROJ. NO.	FISCAL YEAR	SHEET NO.	TOTAL SHEETS
HAWAII	HAW.	I-H3-1(51)	1989	92	106

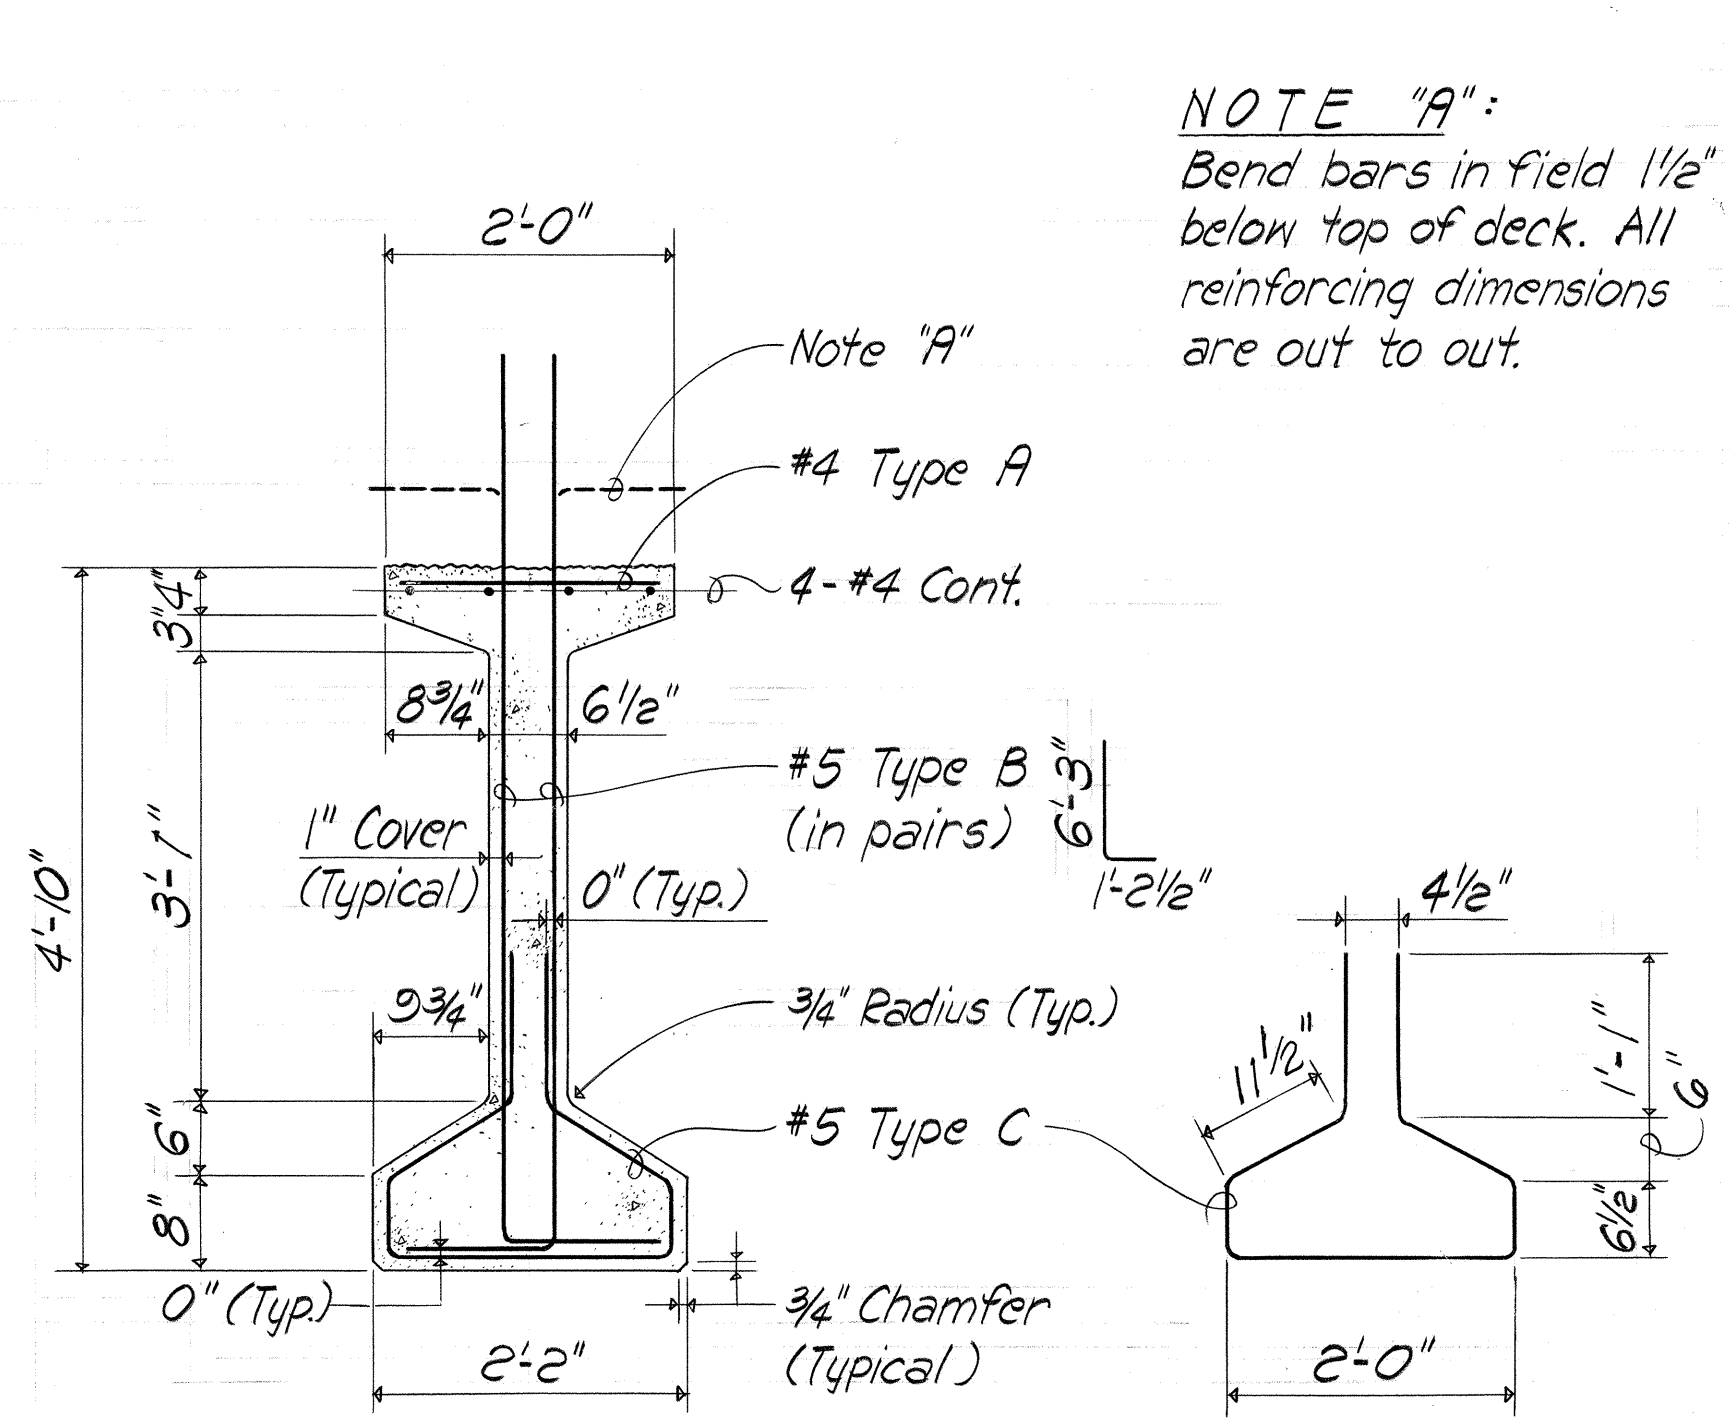


KEEHI IV GIRDER SECTION
Scale: 3/4" = 1'-0"

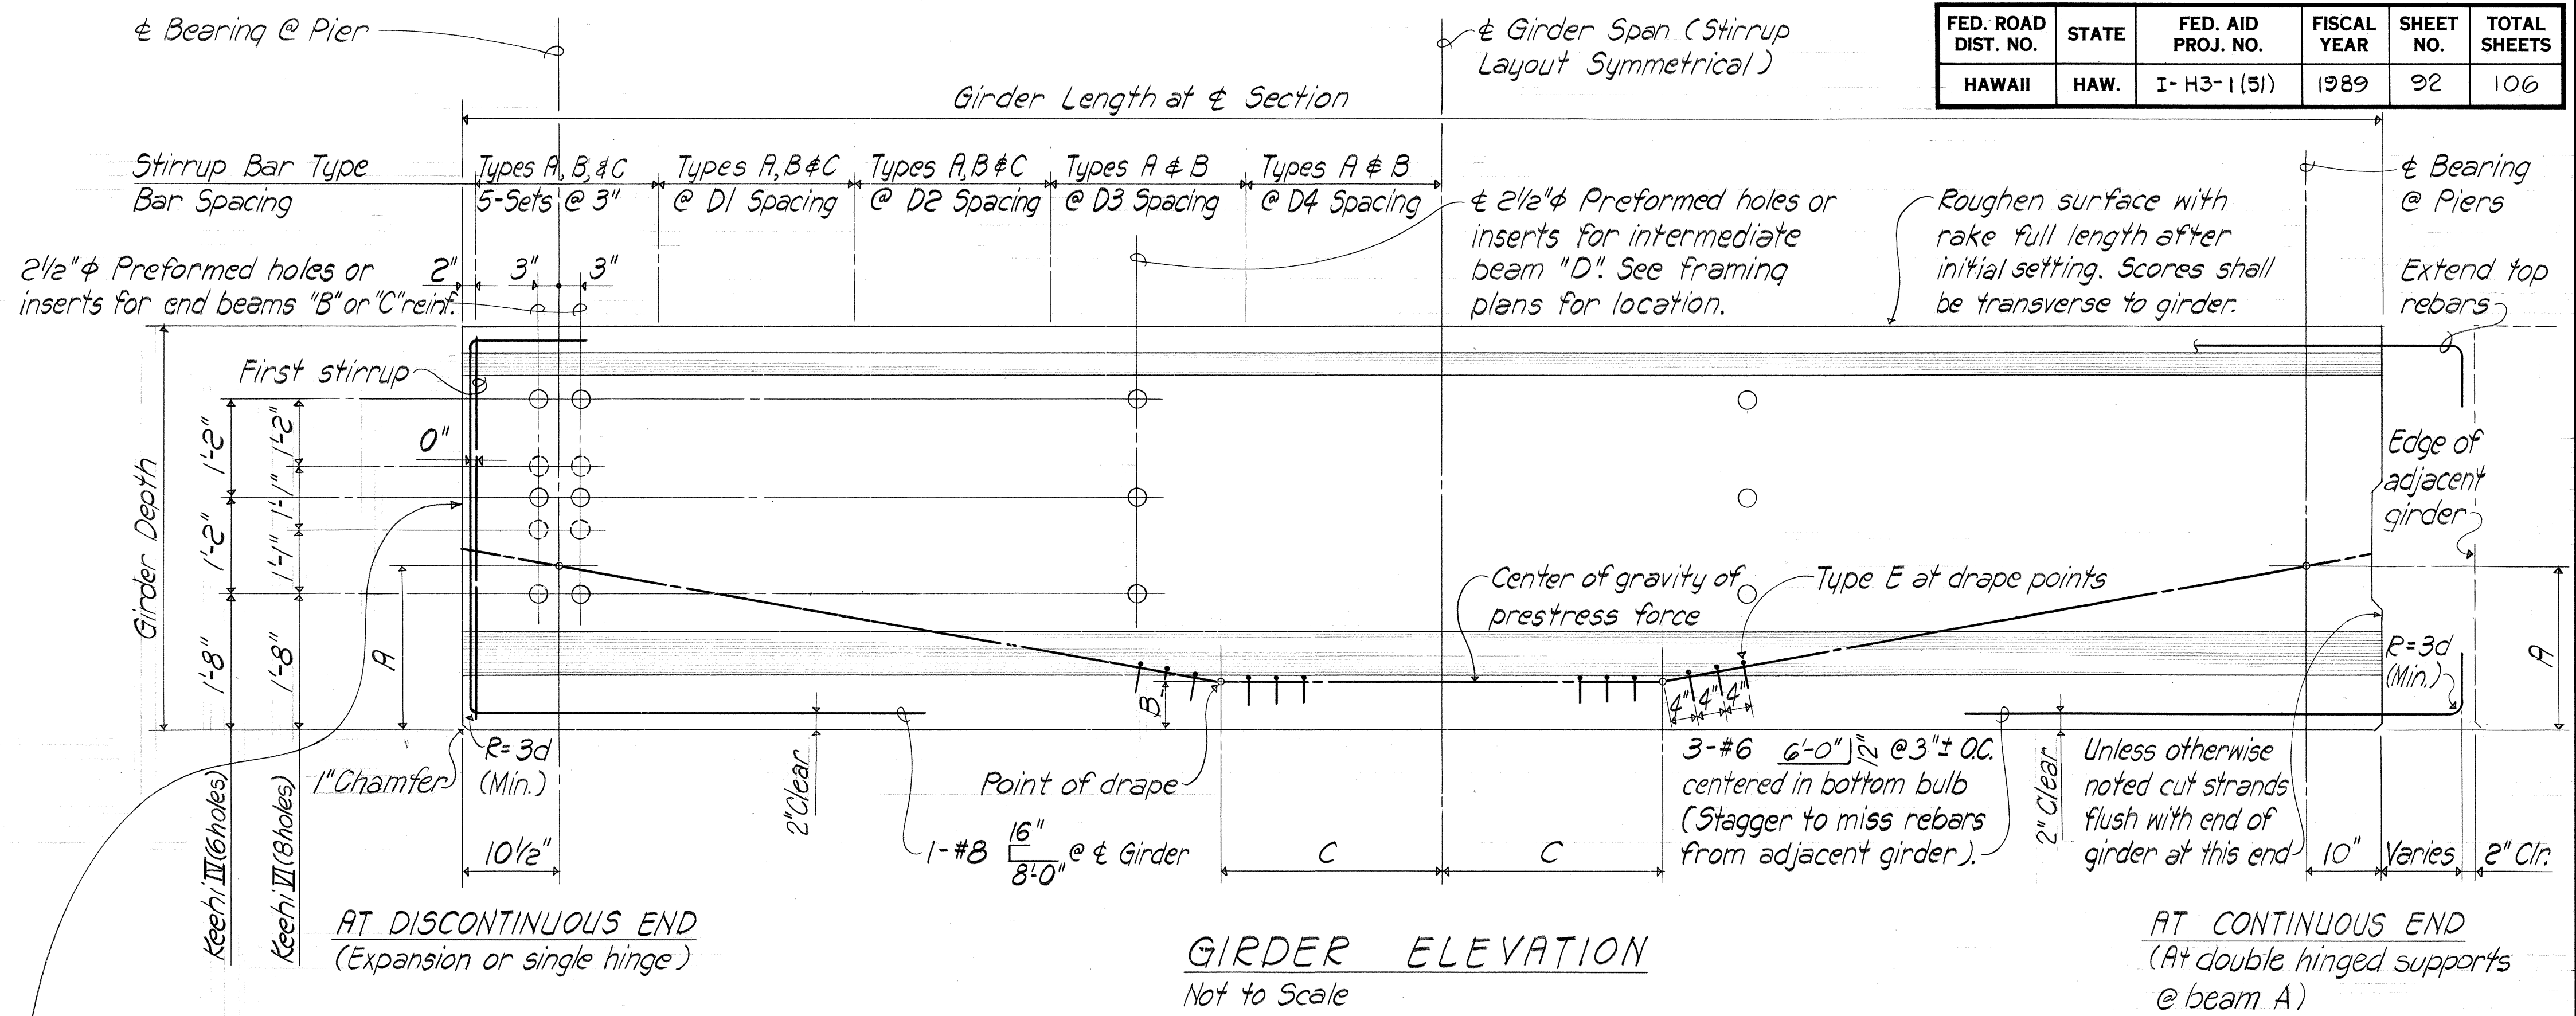


GIRDER ELEVATION
Not to Scale


Grind ends of strands flush w/ end of girder and apply 2-5 mil coats of Epoxy to end of girder at discontinuous ends

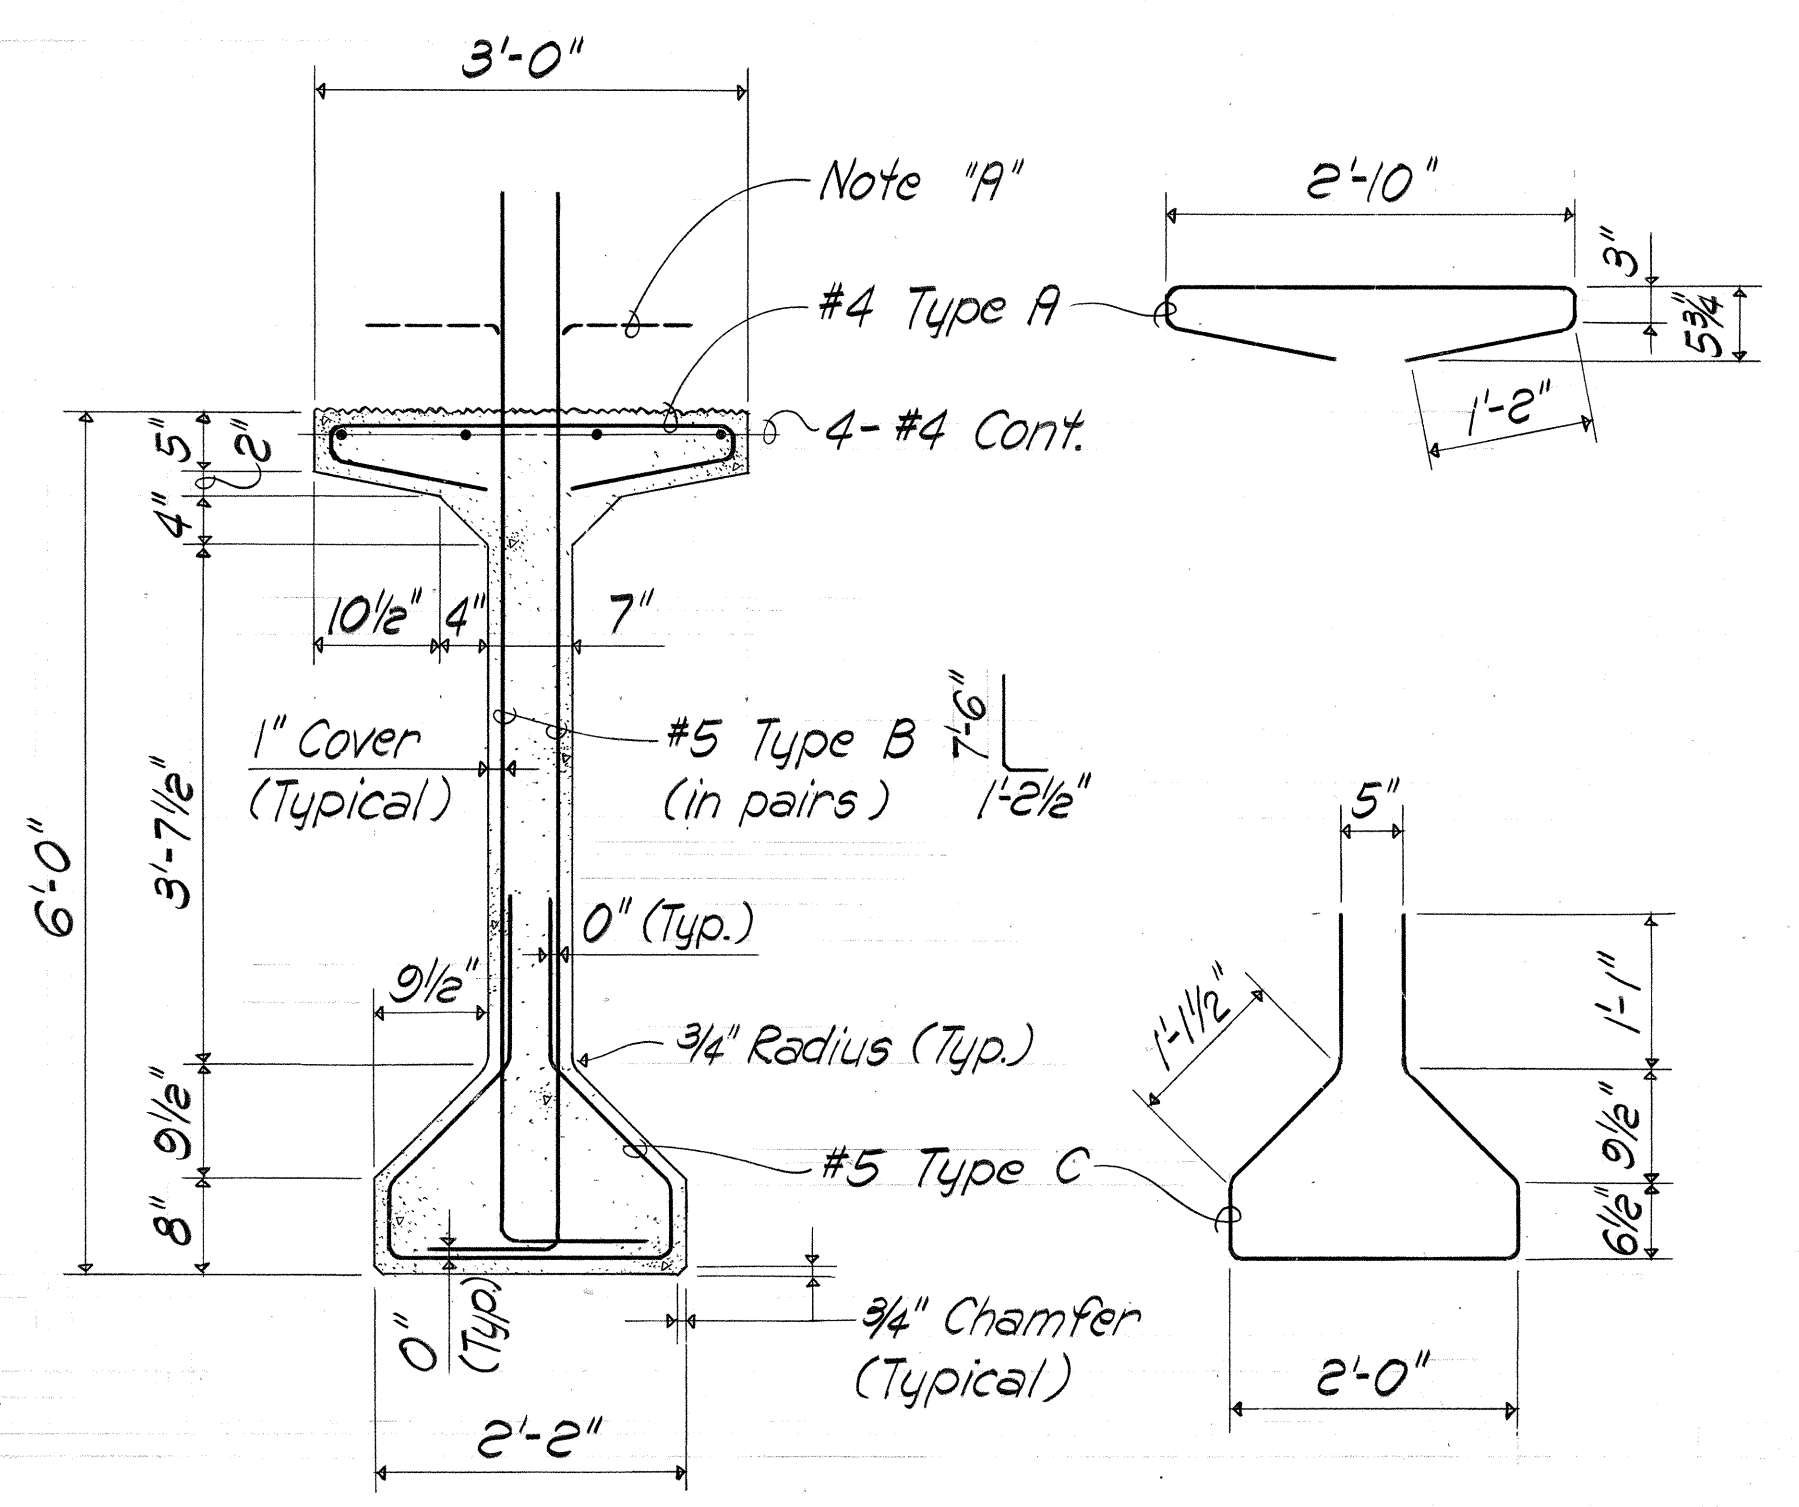

KEEHI V GIRDER SECTION
Scale: 3/4" = 1'-0"

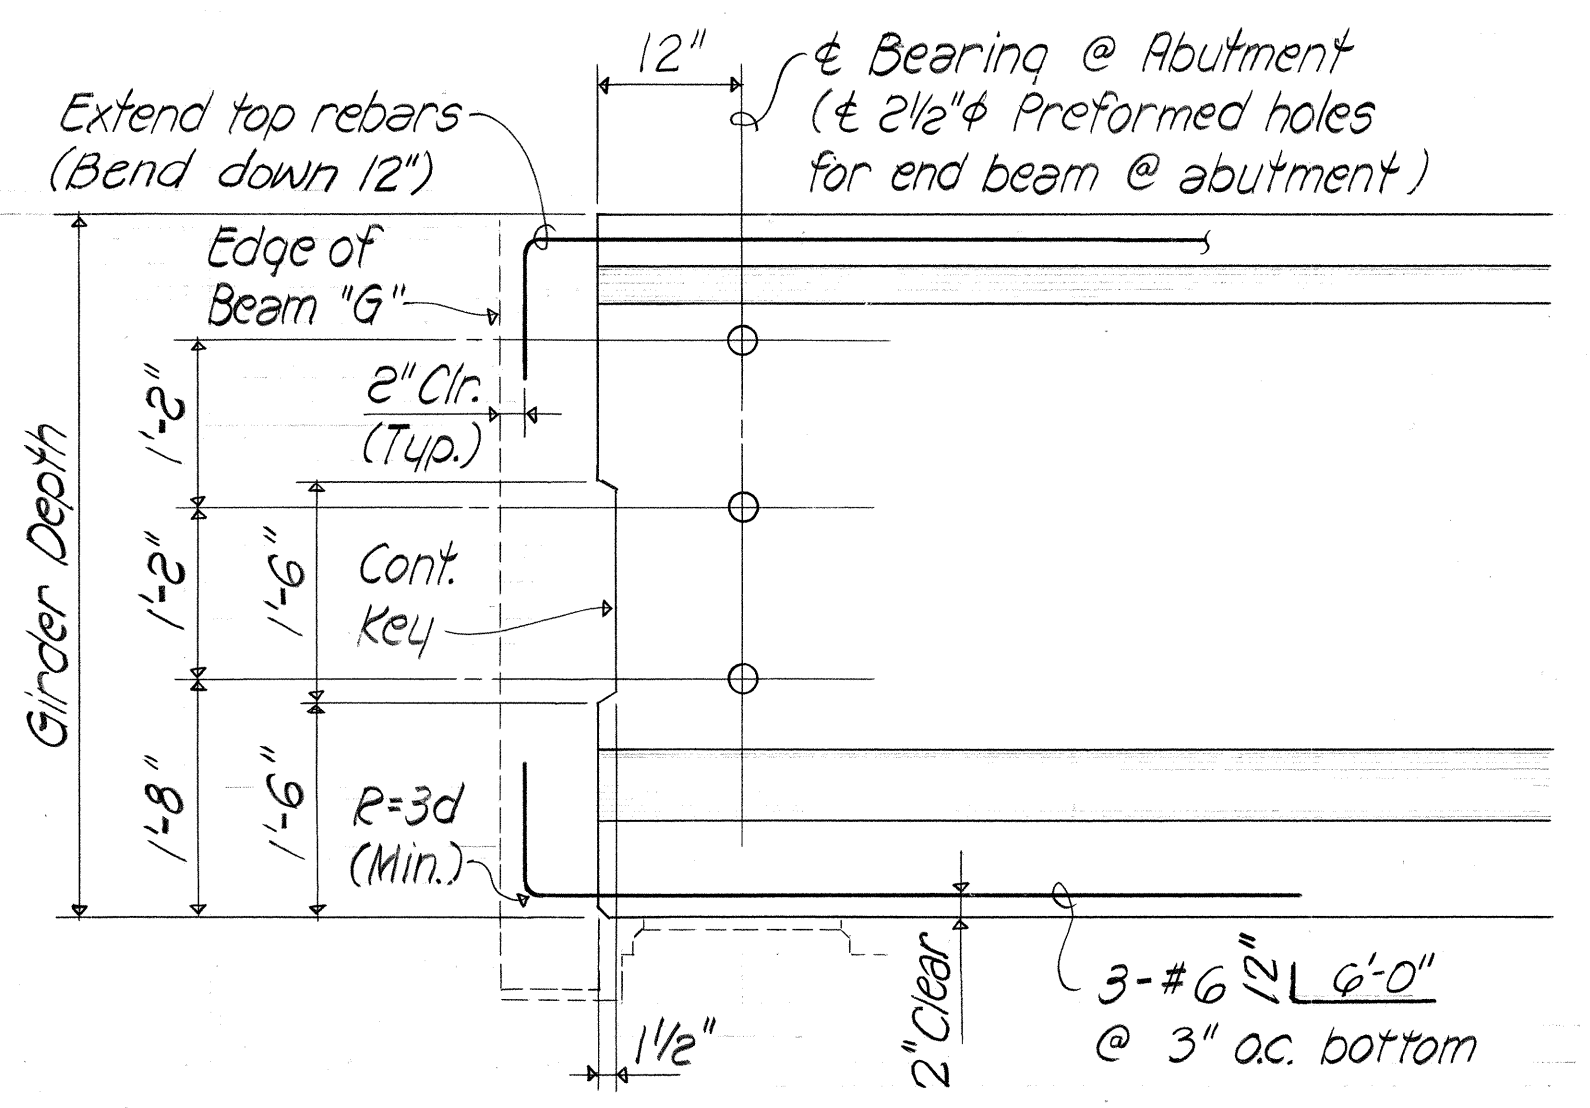

PARTIAL GIRDER ELEVATION AT ABUTMENT
Not to Scale

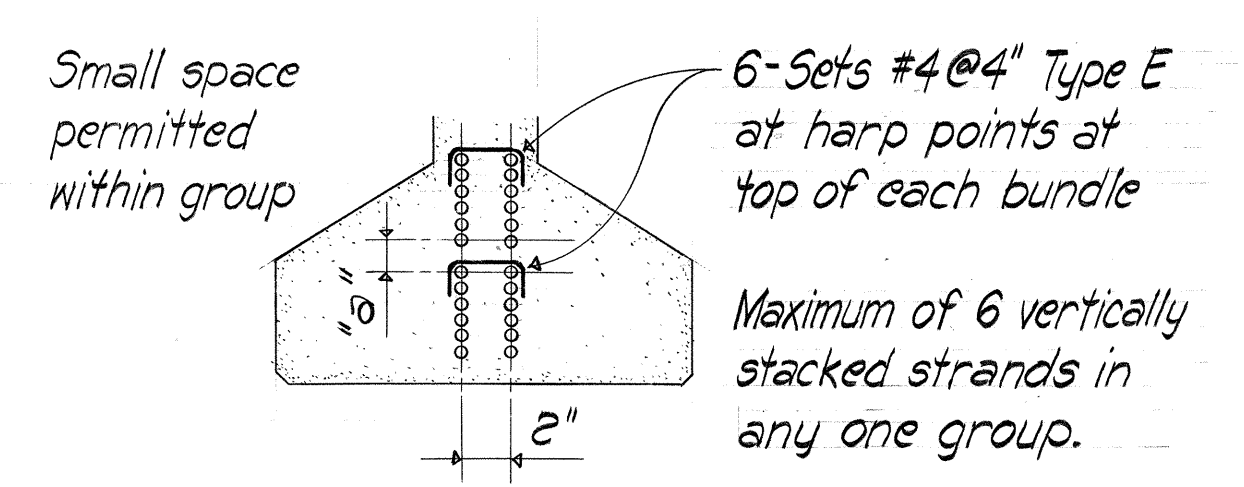

BUNDLING OF PRESTRESSING REINFORCEMENT
Not to scale

ARRANGEMENT & CLEARANCE FOR PRESTRESSING STRANDS
1. Strands may be bundled in groups as shown.
2. The minimum distance "a" between groups or individual strands is 2" for 1/2" strands.
3. "a" is measured between centers of adjacent strands.

- REFERENCE DRAWINGS:
- 1. Girder dapped and fixed end connections details ----- Sht. T10
 - 2. Girder schedule ----- Sht. T9

- NOTES:
- 1. Inserts & preformed holes are incidental to prestressed girders.
 - 2. Unless noted otherwise, ends of girders shall be vertical.

STATE OF HAWAII

DEPARTMENT OF TRANSPORTATION

HIGHWAYS DIVISION

PRESTRESSED

GIRDER DETAILS

KEEHI IV & KEEHI VI GIRDERS

INTERSTATE ROUTE H-3

F.A.I. PROJ. NO. I-H3-1(51)

SCALE: AS NOTED

DATE:

SHEET NO. 77 OF 21 SHEETS

SS&M Engineers, Inc.

Consulting Structural Engineers

1210 Ward Ave., Honolulu, HI 96816

HOWARD Y. FUKUDA

REGISTERED PROFESSIONAL ENGINEER

No. 1343-S


HAWAII, U.S.A.

This work was prepared by me or under my supervision.

Howard Y. Fukuda

ORIGINAL PLAN	SURVEY PLOTTED BY	DATE
TRACED BY	DRAWN BY	
DESIGNED BY	CHECKED BY	
NOTE BOOK		
NO.		


FED. ROAD DIST. NO.	STATE	FED. AID PROJ. NO.	FISCAL YEAR	SHEET NO.	TOTAL SHEETS
HAWAII	HAW.	I-H3-1(51)	1989	93	106

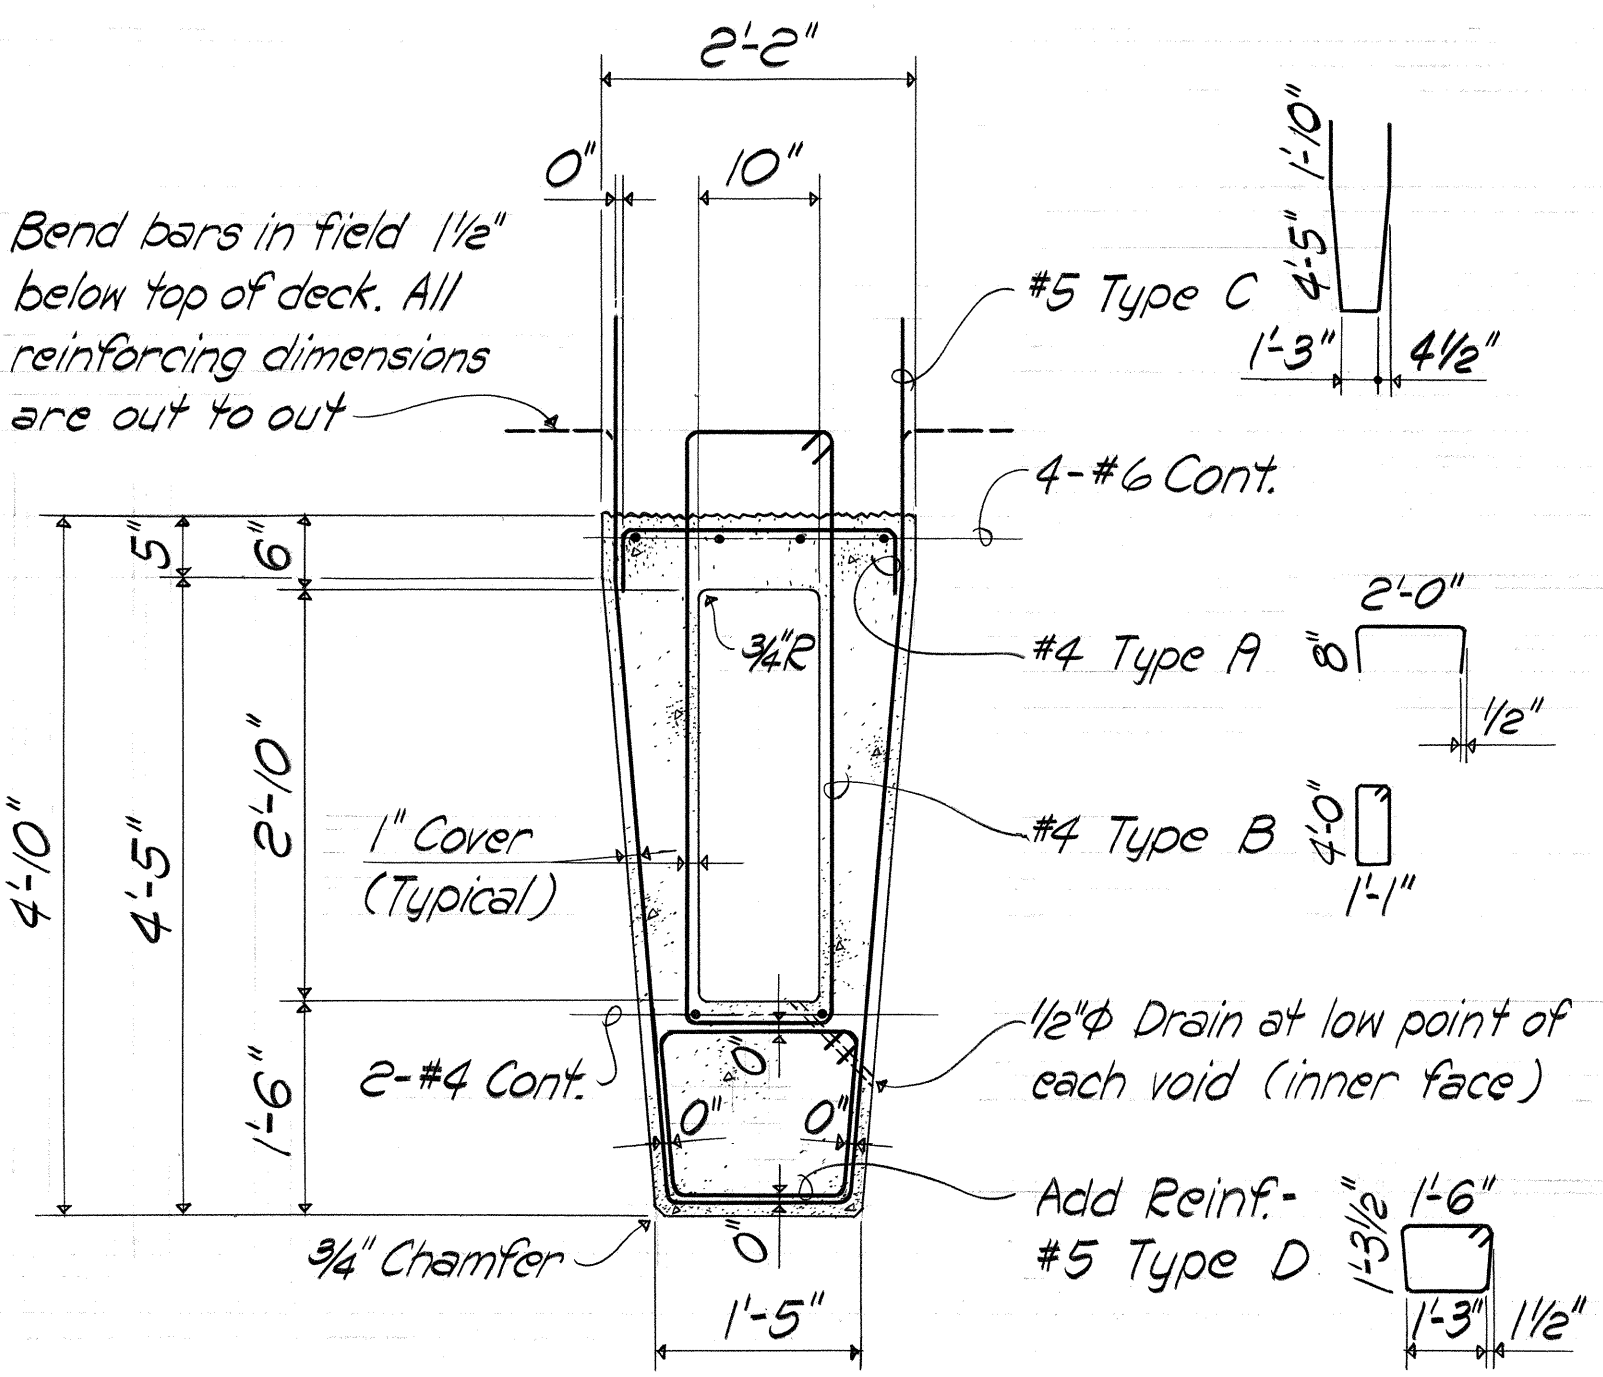

KEEHI I/F GIRDER SECTION

Scale: 3/4" = 1'-0"


Grind ends of strand flush w/ end of girder and apply 2-5mil coats of Epoxy to end of girder at discontinuous ends

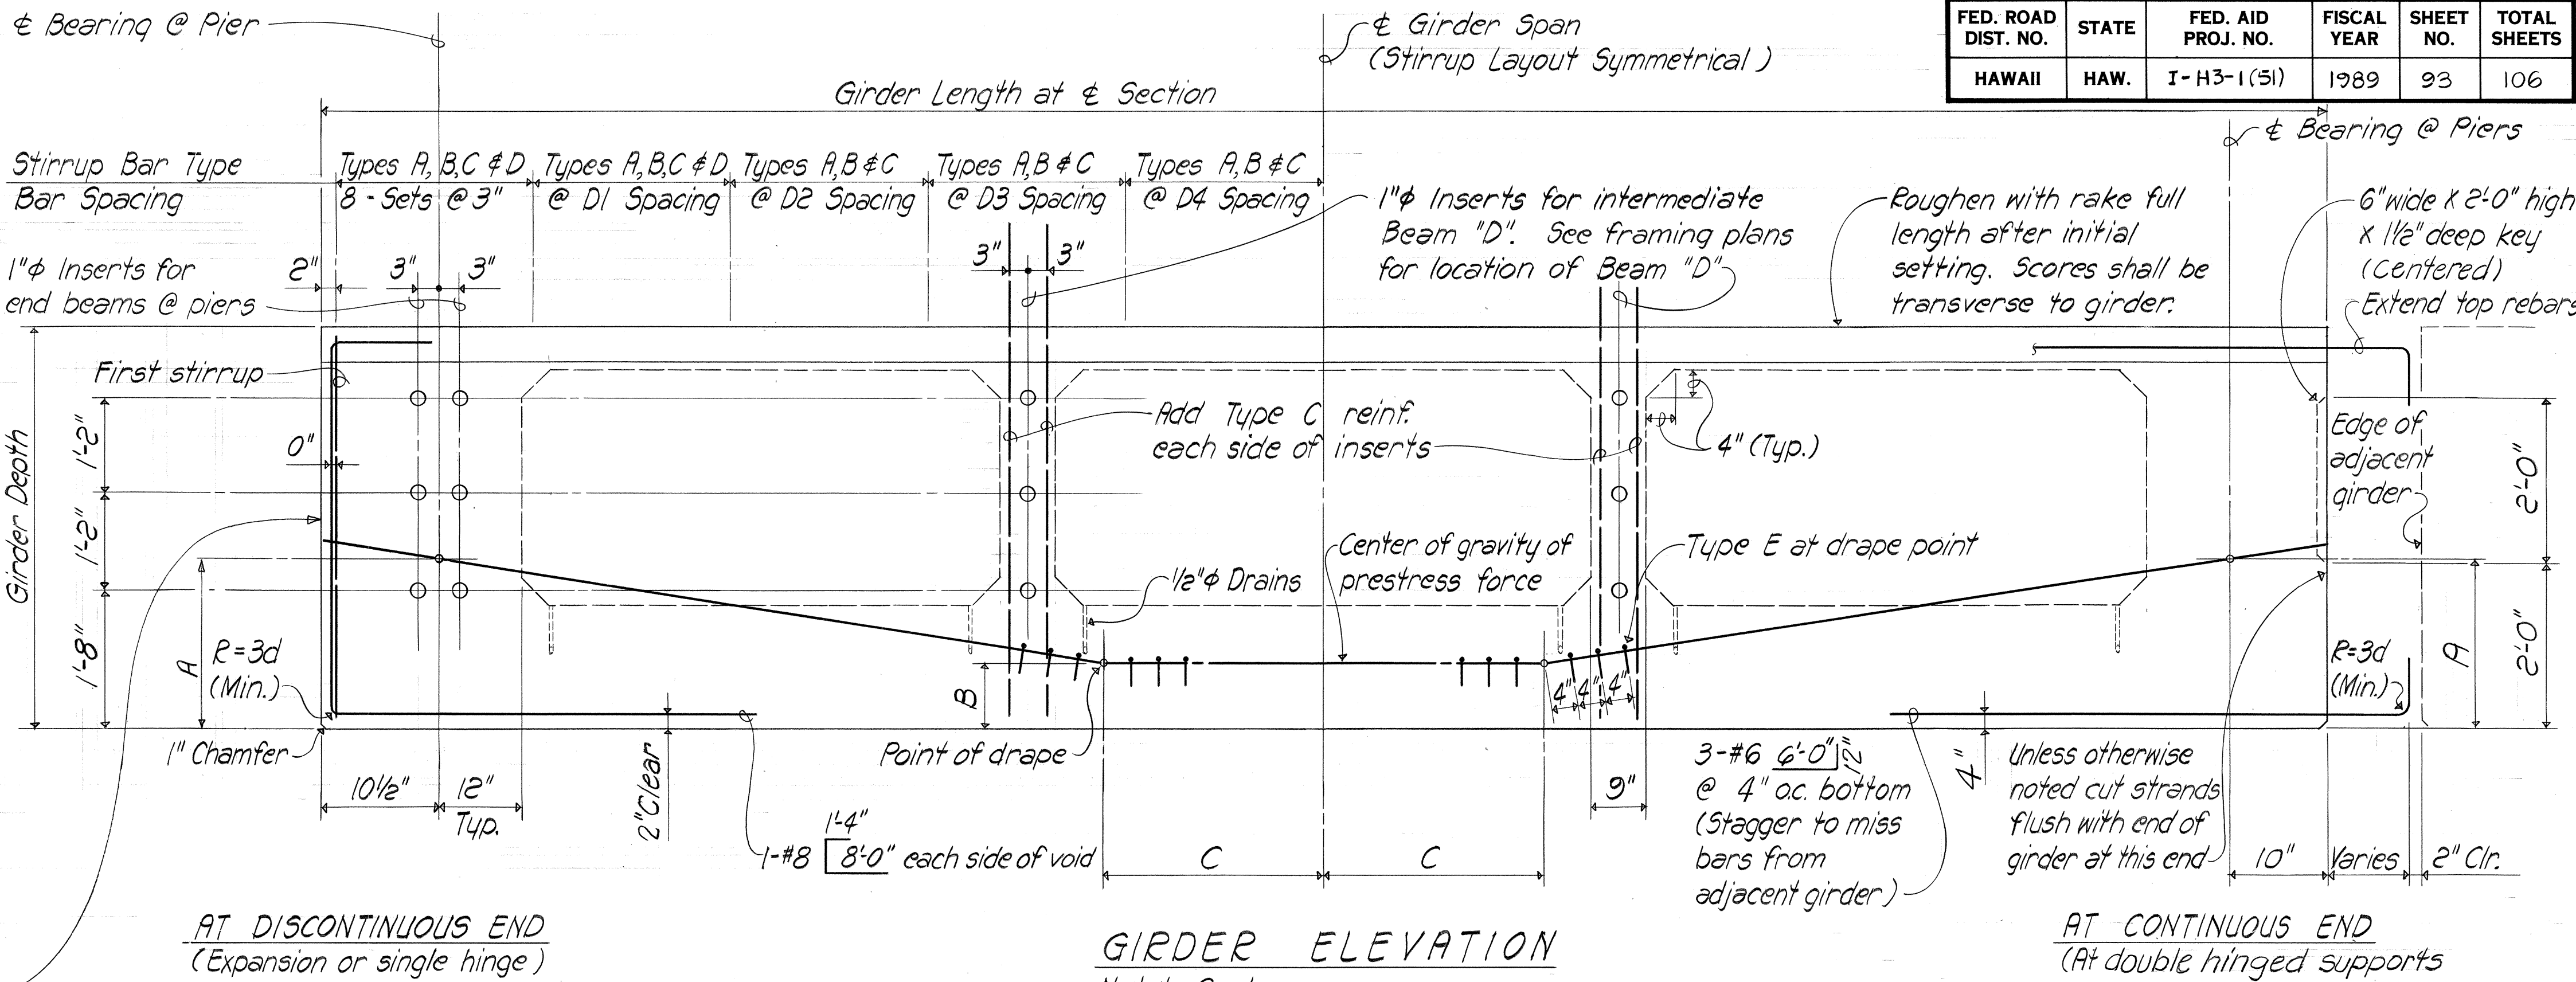


AT DISCONTINUOUS END
(Expansion or single hinge)

GIRDER ELEVATION
Not to Scale

AT CONTINUOUS END
(At double hinged supports @ beam A)

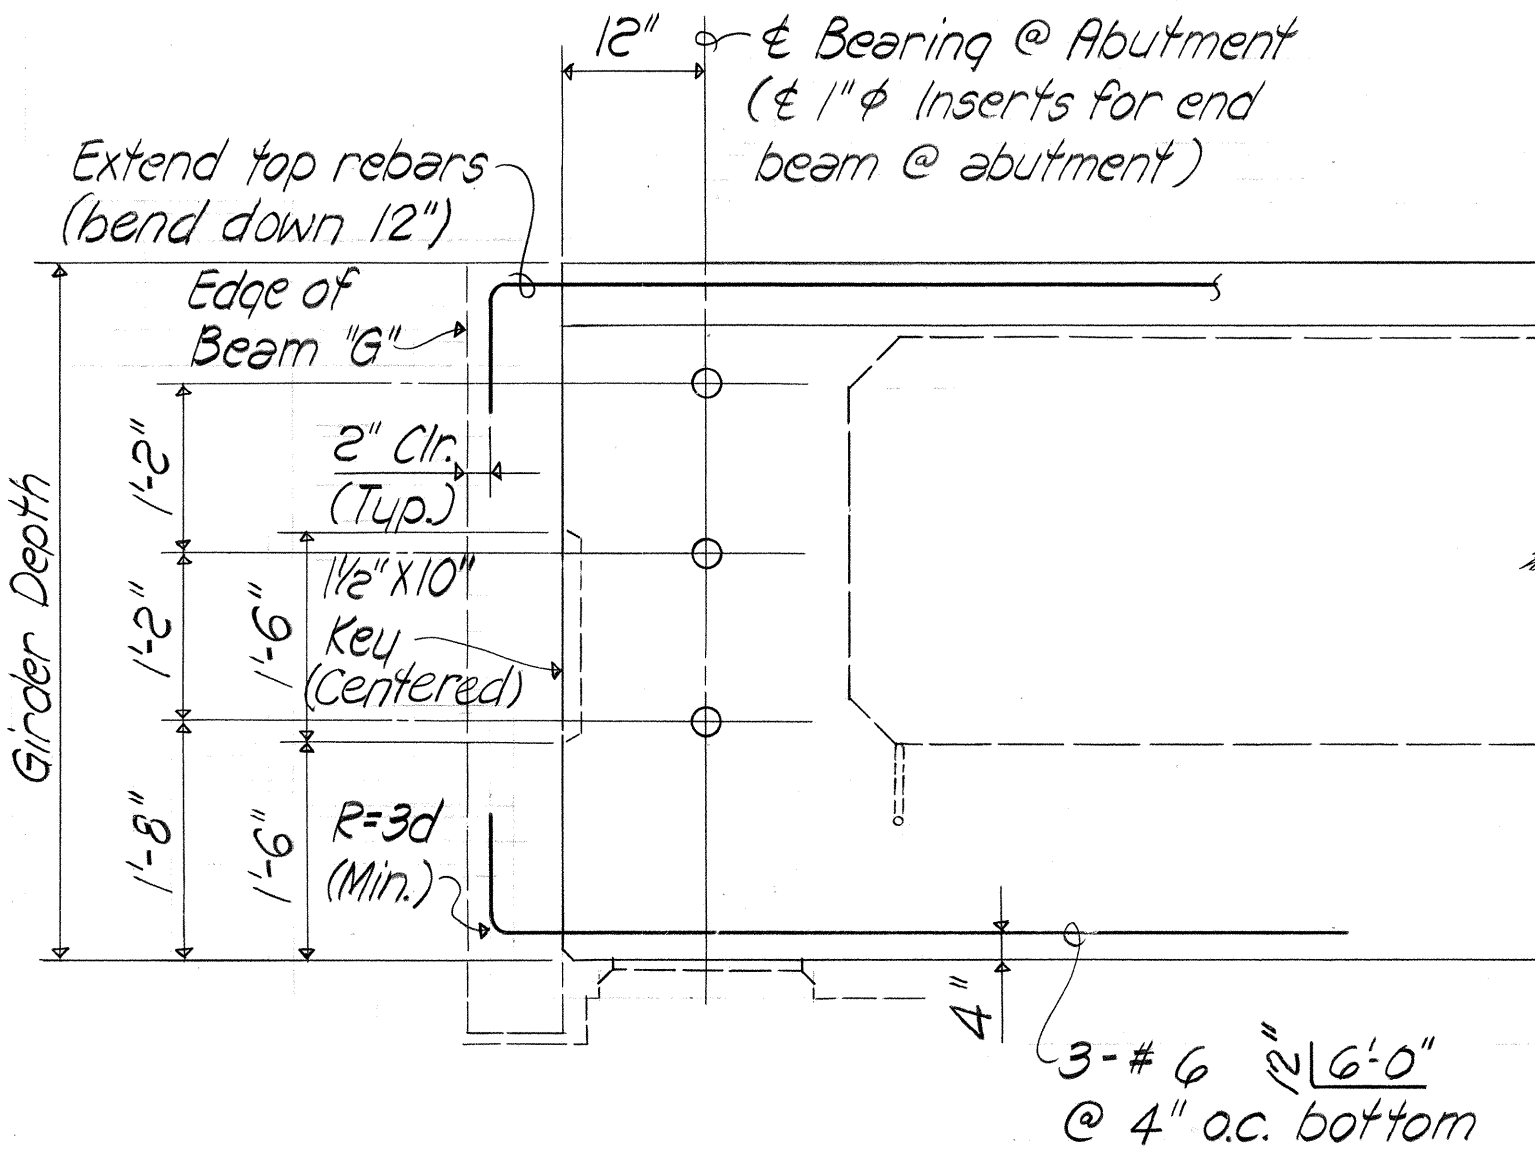

PARTIAL GIRDER ELEVATION AT ABUTMENT
Not to Scale

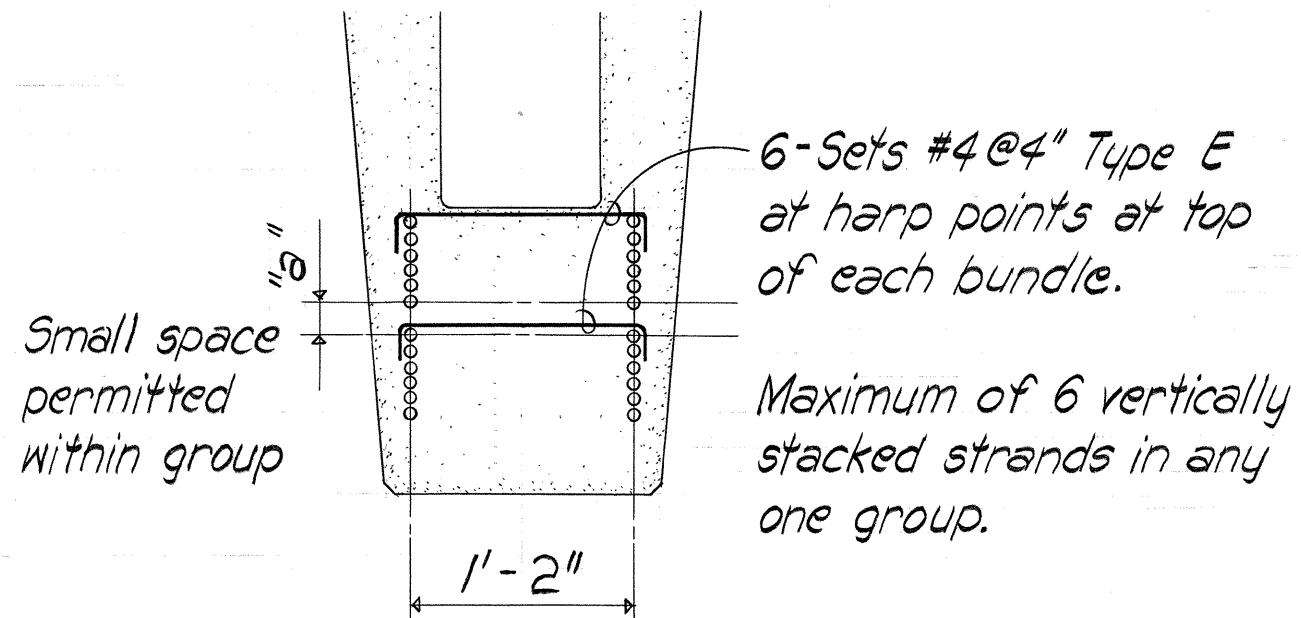

BUNDLING OF PRESTRESSING REINFORCEMENT
Not to Scale

- REFERENCE DRAWINGS:
- Girder dapped and fixed end connections details ----- Sht. T11
 - Girder schedule ----- Sht. T9

SS&H Engineers, Inc.
Consulting Structural Engineers
1219 W. 1st Ave., Honolulu, HI 96814



This work was prepared by me or under my supervision.
Howard Y. Fukuda

STATE OF HAWAII
DEPARTMENT OF TRANSPORTATION
HIGHWAYS DIVISION


PRESTRESSED
GIRDER DETAIL
KEEHI I/F GIRDER
INTERSTATE ROUTE H-3
F.A.I. PROJ. NO. I-H3-1(51)
SCALE: AS NOTED DATE: SHEET NO. 78 OF 21 SHEETS

SURVEY PLOTTED BY	DATE
DRAWN BY	
CHECKED BY	
NOTED BY	
ORIGINAL PLAN	
NOTE BOOK	
NO.	

GIRDER TYPE	WORKING PRESTRESS FORCE (AFTER ALL LOSSES) KIPS	CALCULATED CAMBER (SEE NOTE 4 THIS SHEET) INCHES	DEAD LOAD DEFLECTION (SEE NOTE 5 THIS SHEET) INCHES	LOCATION OF CENTER OF GRAVITY OF PRESTRESS FORCE						STIRRUPS NUMBER & SPACING				REQUIRED MINIMUM CONCRETE STRENGTH BEFORE RELEASE OF STRANDS (PSI)	REMARKS (See legend for notes below)
				DISTANCE A (INCHES)	DISTANCE B (INCHES)	DISTANCE C	MASKED STRAND DATA		@ D1 SPACING	@ D2 SPACING	@ D3 SPACING	@ D4 SPACING			
							EFFECTIVE PRESTRESS FORCE	DISTANCE A*					DISTANCE M		
IV-1	611	- 0.46	0.32	17.31	8.38	L/10				16 @ 6"	12 @ 8"	6 @ 12"	Bal. @ 16"	4000	Note (a)
IV-2	942	- 1.22	1.15	16.60	7.18	L/10				40 @ 5 1/2"	16 @ 8"	7 @ 12"	Bal. @ 16"	4500	Note (b)
IV-3	895	- 1.15	0.77	15.38	7.18	L/10				19 @ 6"	16 @ 8"	9 @ 12"	Bal. @ 16"	4500	Note (a) & (c) @ spans 20 & 27
IV-4	895	- 1.13	0.92	15.38	7.88	L/10				35 @ 6"	13 @ 8"	9 @ 12"	Bal. @ 16"	4500	Note (b)
IV-5	895	- 1.01	0.70	15.47	8.38	L/10				12 @ 6"	16 @ 8"	8 @ 12"	Bal. @ 16"	4500	Note (d)
IVF-1	705	- 0.64	0.35	18.21	8.71	L/10				12 @ 6"	16 @ 8"	8 @ 12"	Bal. @ 16"	4000	Note (a)
IVF-2	1178	- 1.35	1.13	20.72	11.00	L/10				33 @ 5 1/2"	22 @ 8"	4 @ 12"	Bal. @ 16"	4500	Note (b)
IVF-3	1130	- 1.53	1.10	21.08	8.80	L/10				20 @ 6"	16 @ 8"	9 @ 12"	Bal. @ 16"	4500	Note (a)
IVF-4	1130	- 1.27	0.86	20.42	10.71	L/10				19 @ 6"	16 @ 8"	10 @ 12"	Bal. @ 16"	4500	Notes (a) & (c)
IVF-5	1081	- 1.40	1.04	18.71	9.21	L/10				26 @ 6"	16 @ 8"	10 @ 12"	Bal. @ 16"	4500	Note (b)
IVF-6	1178	- 1.40	0.93	20.72	10.65	L/10				19 @ 6"	17 @ 8"	12 @ 12"	Bal. @ 16"	4500	Note (d)
VII-1	1272	- 1.58	1.41	22.81	7.97	L/10				25 @ 6"	22 @ 8"	13 @ 12"	Bal. @ 16"	4500	Note (a)
VII-2	1178	- 1.38	1.08	21.44	7.77	L/10				27 @ 6"	19 @ 8"	12 @ 12"	Bal. @ 16"	4500	Note (a)
NOTES: (a) Simple span girder (b) Continuous support at one end. (c) Dapped ends (d) Fixed joint at one end.															



Not to scale

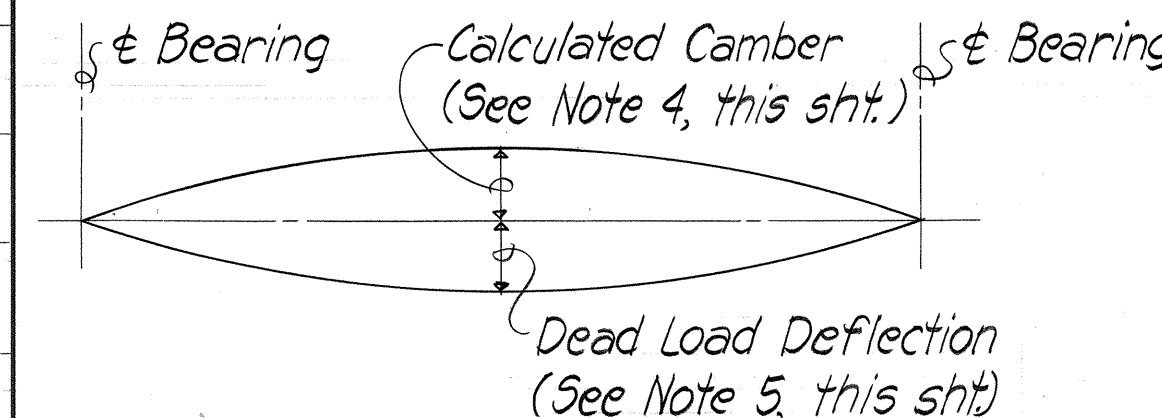

CAMBER DIAGRAM

Not to scale

FED. ROAD DIST. NO.	STATE	FED. AID PROJ. NO.	FISCAL YEAR	SHEET NO.	TOTAL SHEETS
HAWAII	HAW.	I-H3-1(51)	1989	94	106

Inserts to develop
a minimum ultimate
pulling strength
of 24 kips


INSERT DETAIL

Not to scale

- NOTES FOR PRESTRESSED GIRDERS:

1. Concrete shall have a minimum ultimate 28-day cylinder strength of 6000 psi.
2. Prestensioned strands shall be 7-wire $\frac{1}{2}$ " ϕ stress-relieved steel strands (area = 0.153 in.² with an ultimate strength of 270 ksi. For properties see State Standard Specifications.
Total loss due to creep, shrinkage, elastic shortening and relaxation of steel = 45,000 psi
3. Non-prestressed reinforcing steel shall be Grade 40, unless otherwise noted. For properties see State Standard Specifications.
4. The calculated camber includes the effect of the initial prestress force and the weight of the girder after removal from bed. Negative values shown for calculated camber indicate a net upward deflection. Calculated camber values shown do not account for any camber growth of the girders. The actual girder camber shall not exceed the calculated camber shown on the plans by more than 100% at time of installation.
5. The dead load deflection includes the combined effects of the weight of slab, haunch and diaphragm.
6. Strand pattern shall be symmetrical about the longitudinal ϵ of the girder span.
7. Strand release sequence shall not induce any lateral deflection of the girder.
8. Contractor shall submit his proposed strand pattern and releasing sequence to the Engineer for approval.
9. During curing care shall be taken to avoid any lateral deflection of the girder due to improper orientation.
10. Lifting devices shall be placed as close as possible to the center line of bearings of the girder. Details and locations of lifting devices shall be submitted to the Engineer for approval. Such approval does not relieve the Contractor of his responsibilities if girder is damaged due to failure of the lifting device.
11. See Framing Plans for locations of diaphragms, type, mark number and length of individual girders. Lengths shown do not include effect of elastic shortening.
12. Grind ends of strand flush with end of girder and apply 2-5mil coats of Epoxy to end of girder at discontinuous ends.
13. The use of fly ash shall not be permitted in prestressed concrete.

SSFH Engineers, Inc.
Consulting Structural Engineers
1210 Ward Ave., Honolulu, HI 9681

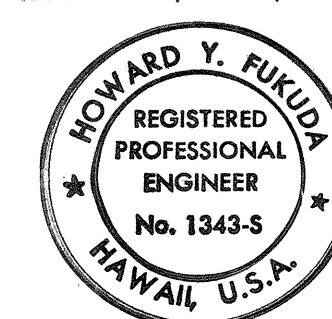

This work was prepared by me or under my supervision
Howard G. Tucker

STATE OF HAWAII
DEPARTMENT OF TRANSPORTATION
HIGHWAYS DIVISION

PRESTRESSED GIRDER SCHEDULE

INTERSTATE ROUTE H-3
F.A.I. PROJ. NO. I-H3-1(5)

SCALE: AS NOTED DATE: _____


SHEET No. 79 OF 21 SHEETS

ORIGINAL PLAN	SURVEY PLOTTED BY _____	DATE _____
NOTE BOOK	DRAWN BY _____	# _____
	TRACED BY _____	# _____
	DESIGNED BY _____	# _____
	QUANTITIES BY _____	# _____
No. _____	CHECKED BY _____	# _____


FED. ROAD DIST. NO.	STATE	FED. AID PROJ. NO.	FISCAL YEAR	SHEET NO.	TOTAL SHEETS
HAWAII	HAW.	I- H3- 1(51)	1989	25	106

NOTE:

All girder ends to be vertical, all seat areas to be level.

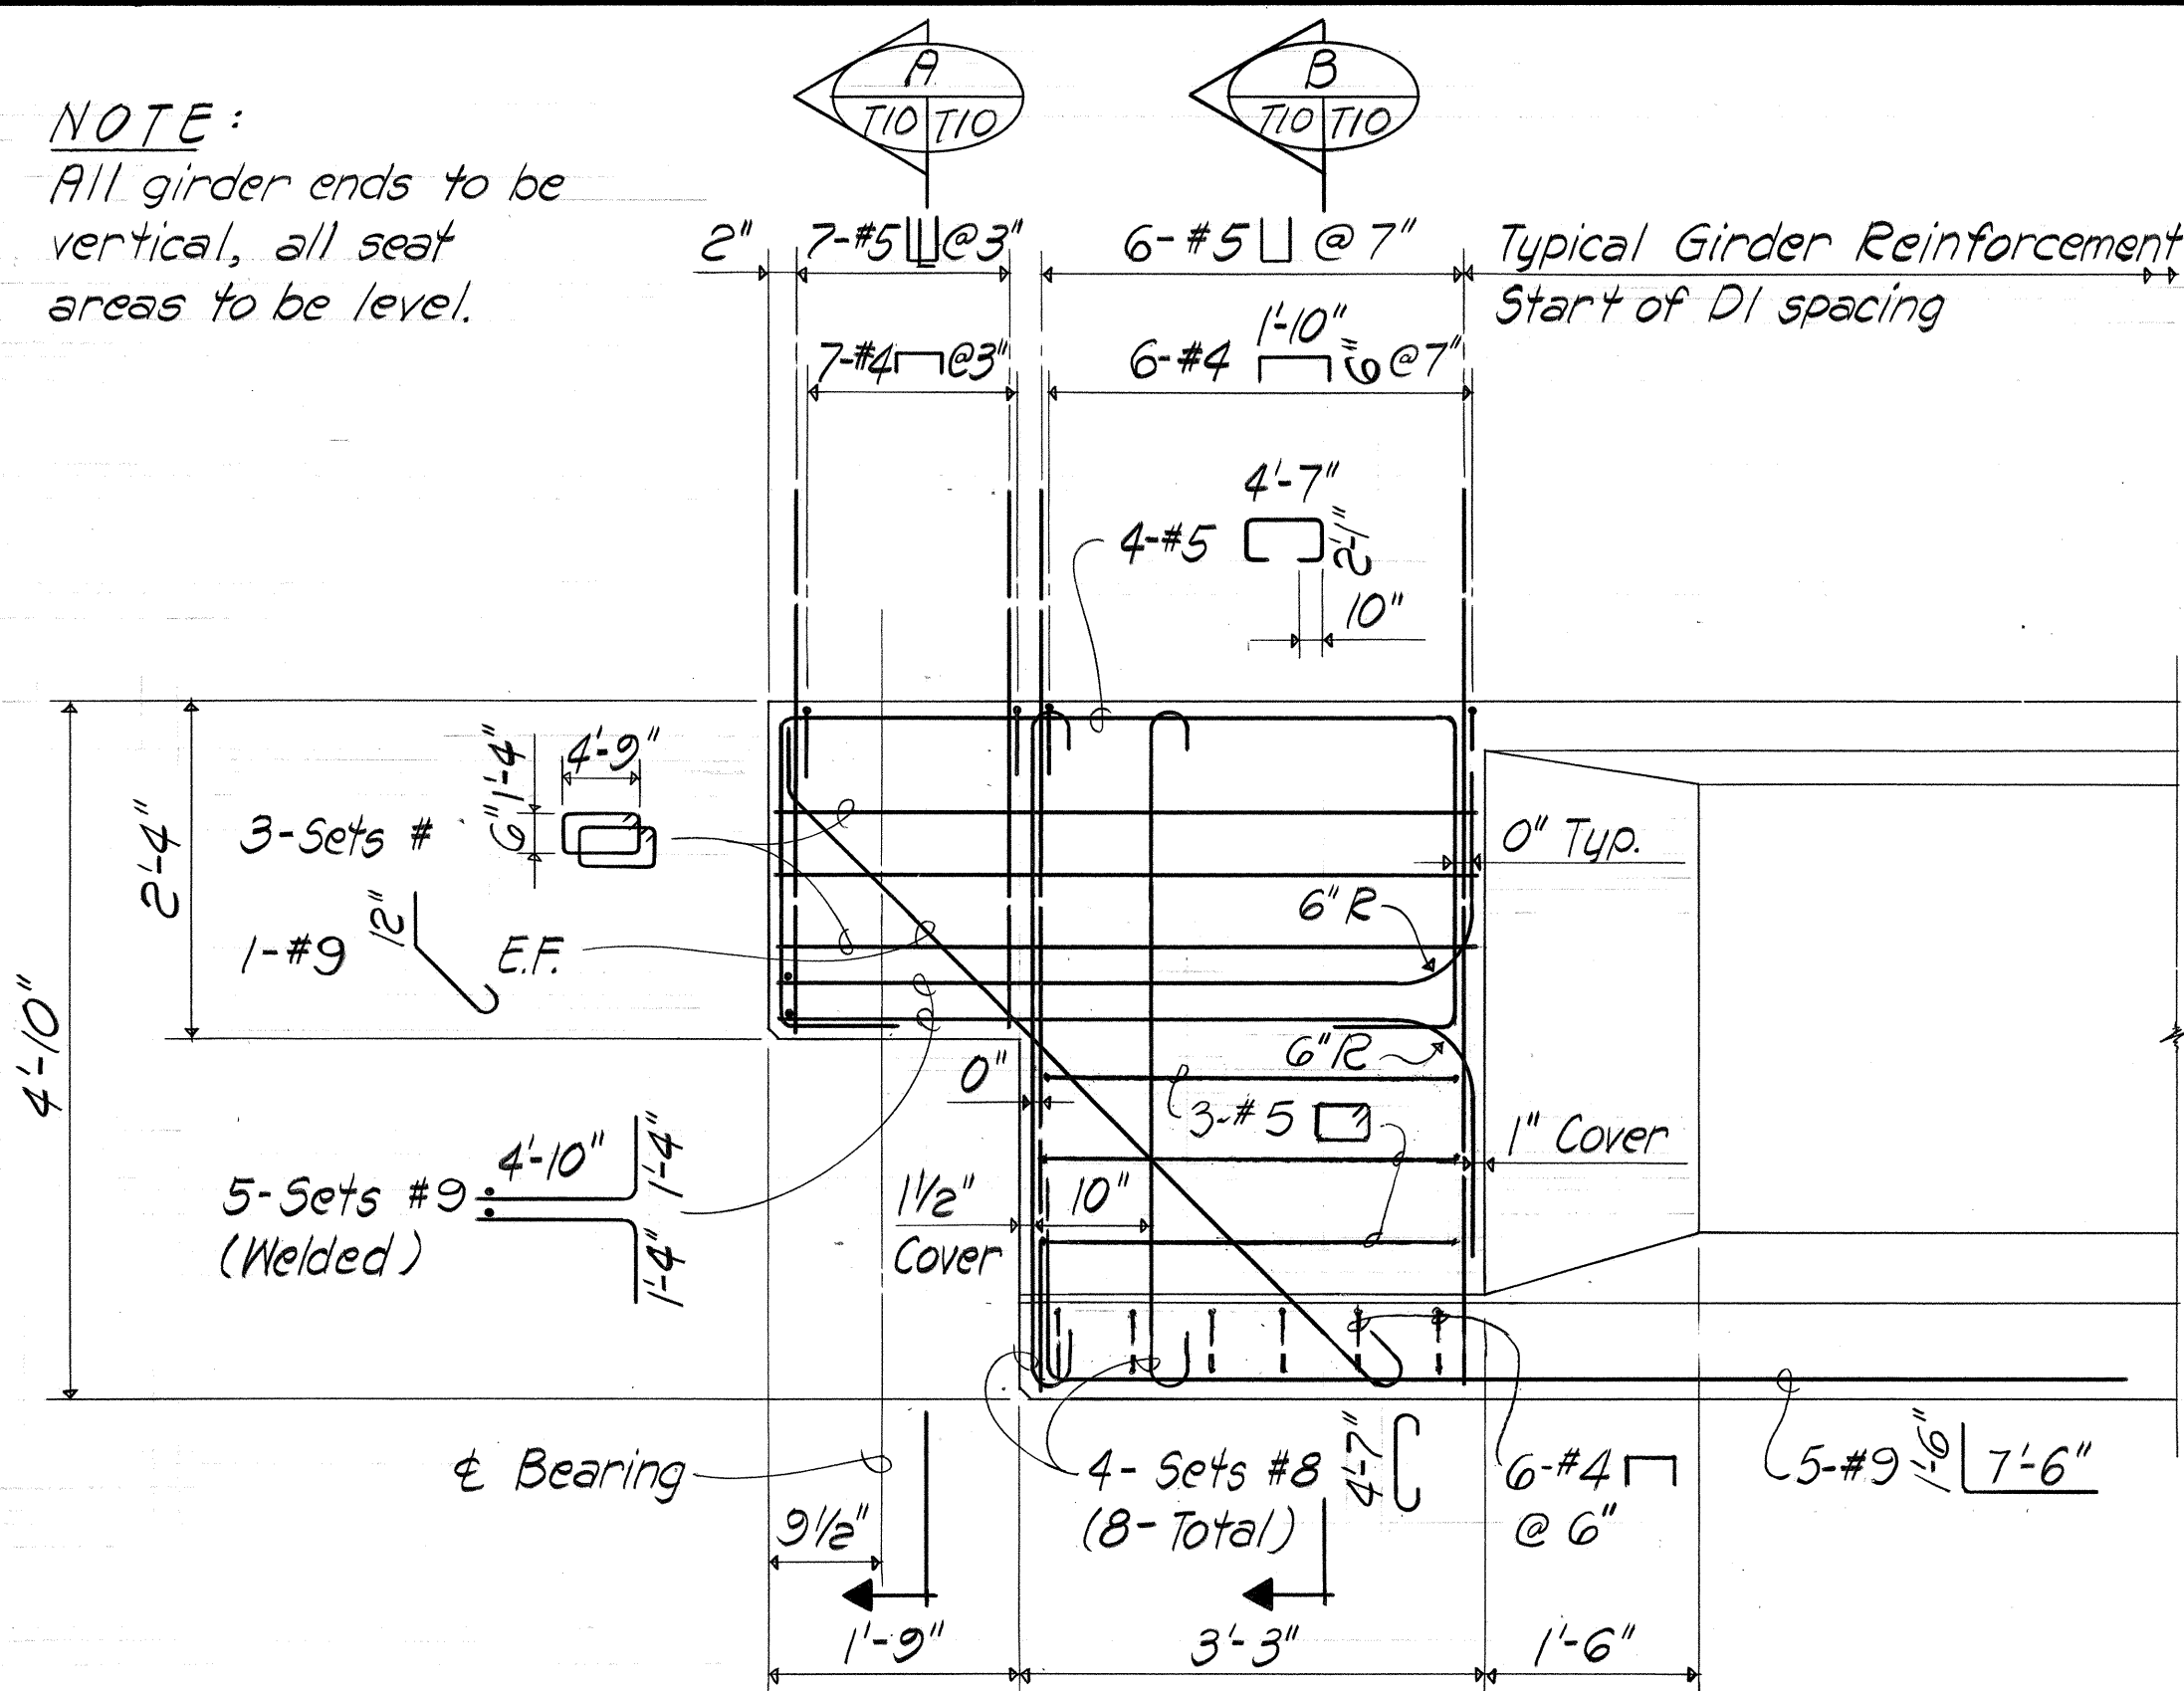


KEEHI IV GIRDER DAPPED END ELEVATION
Scale: 3/4" = 1'-0"

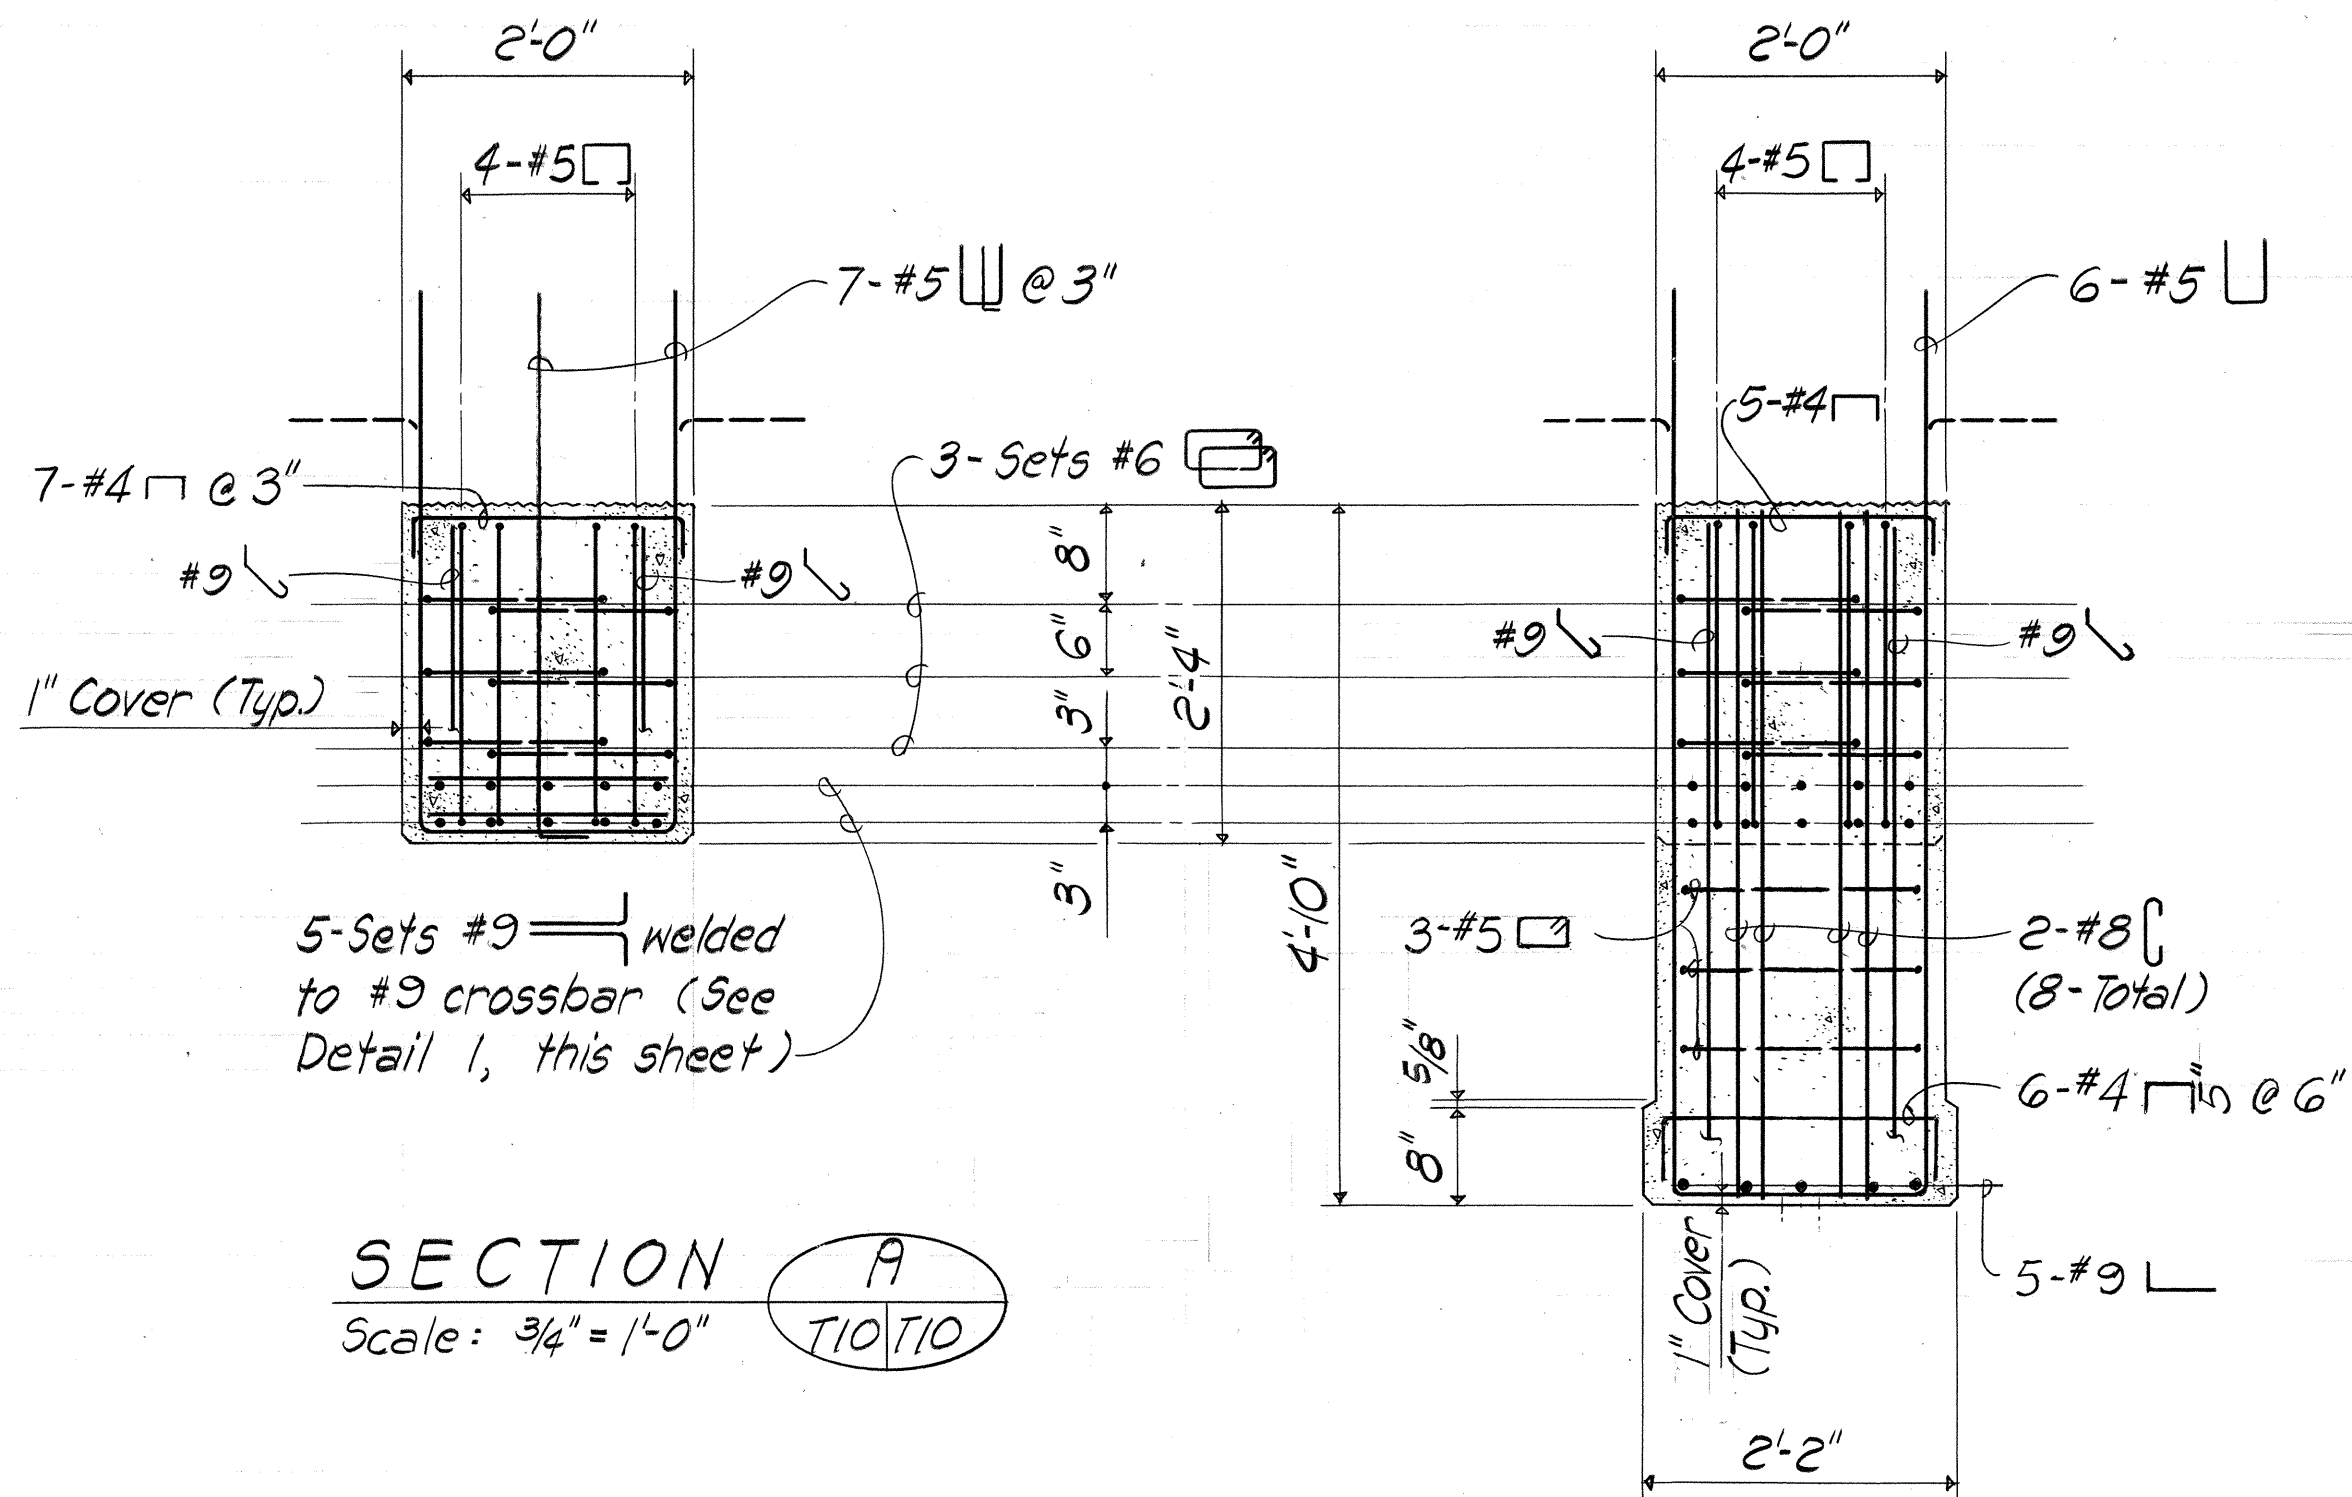


SECTION A
Scale: 3/4" = 1'-0"


SECTION B
Scale: 3/4" = 1'-0"

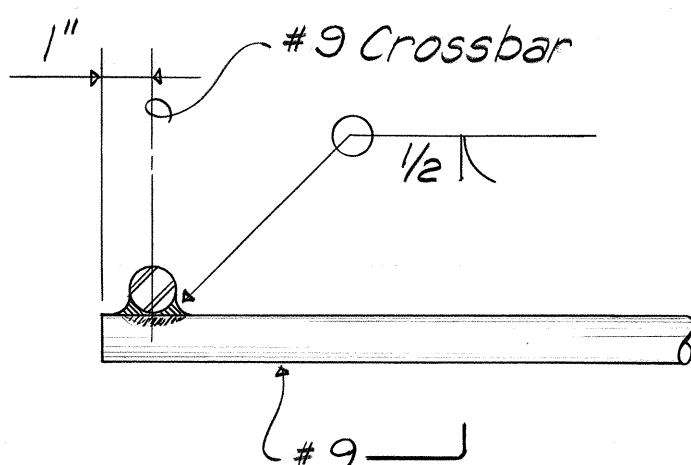


DETAIL 1
Scale: 3" = 1'-0"

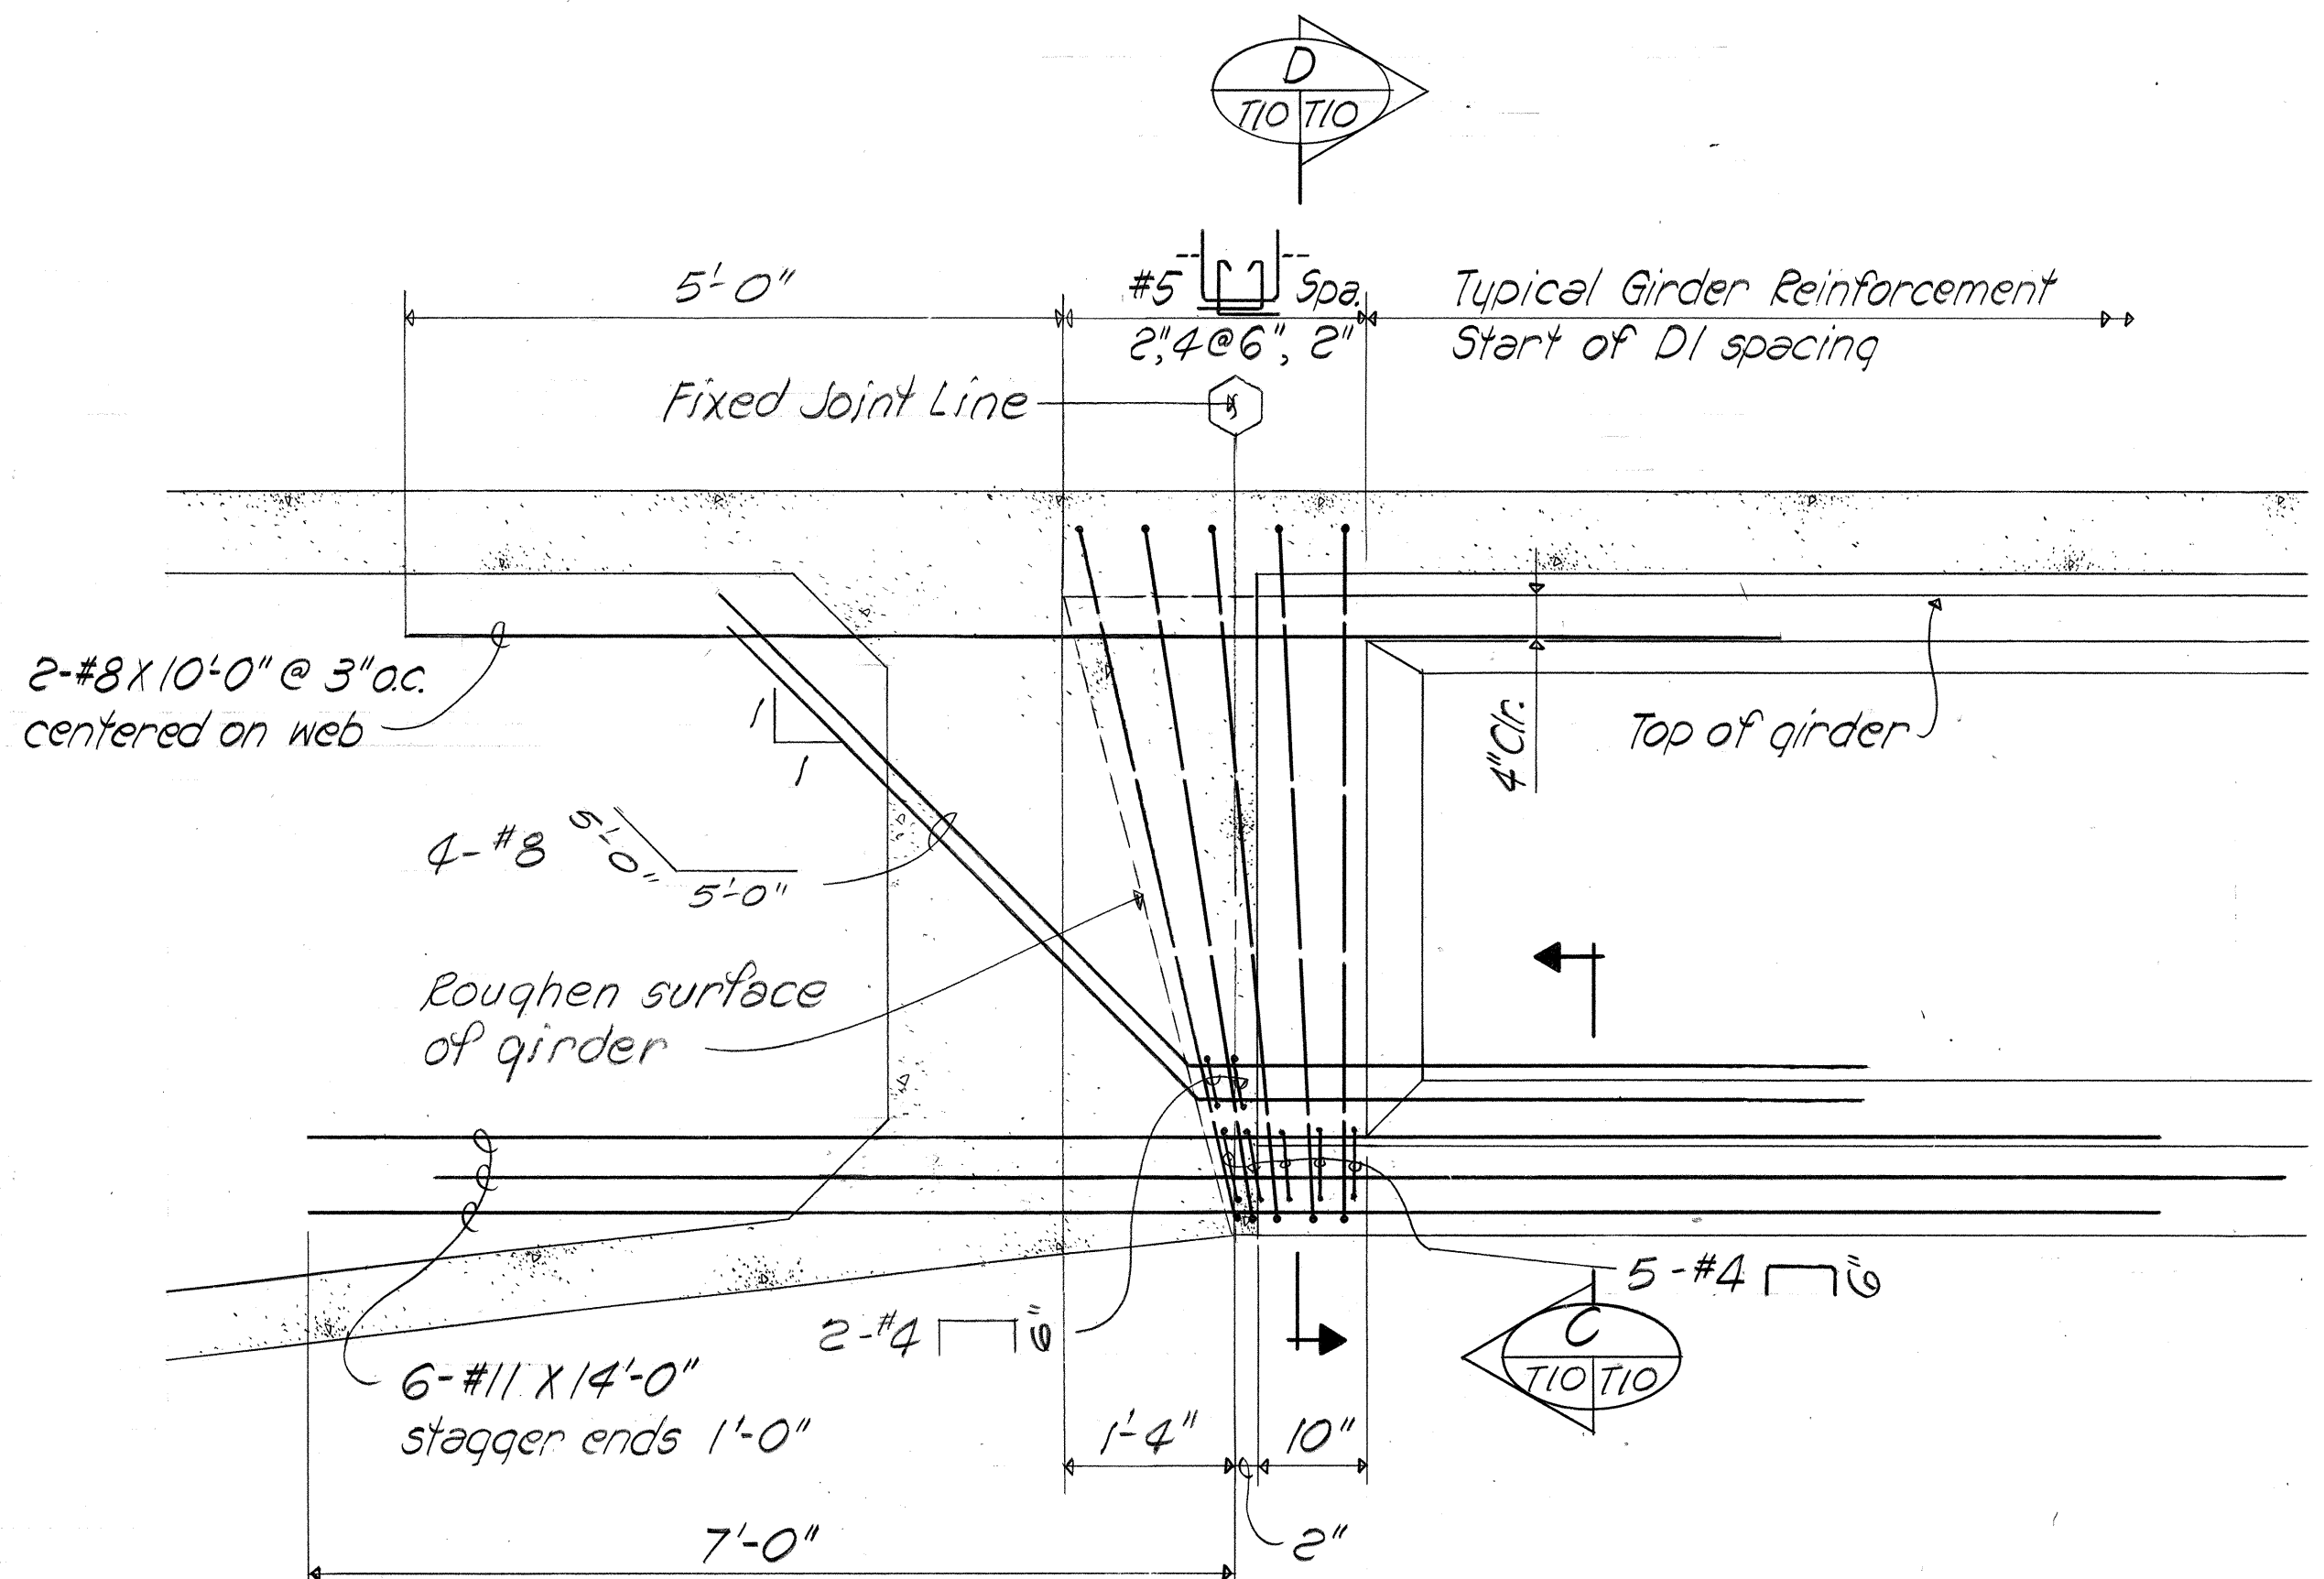

KEEHI IV GIRDER FIXED END ELEVATION
Scale: 3/4" = 1'-0"

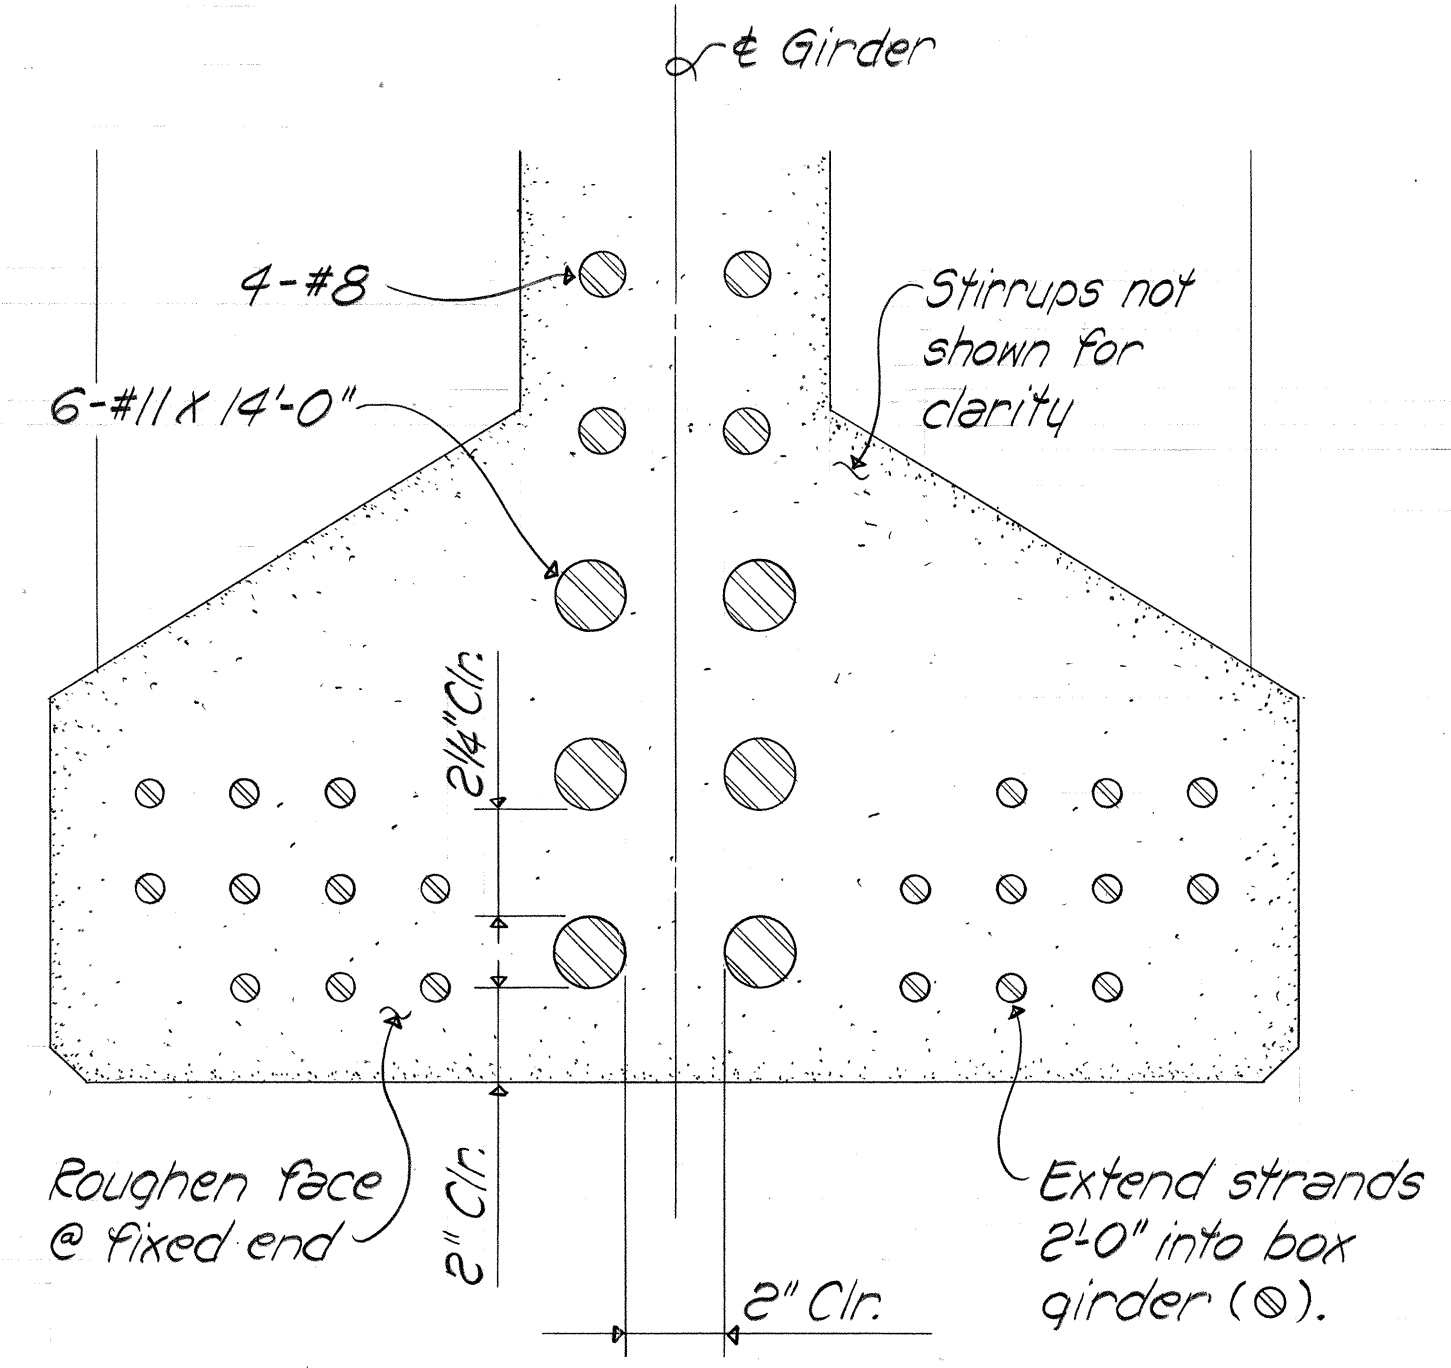


SECTION C
Scale: 3" = 1'-0"

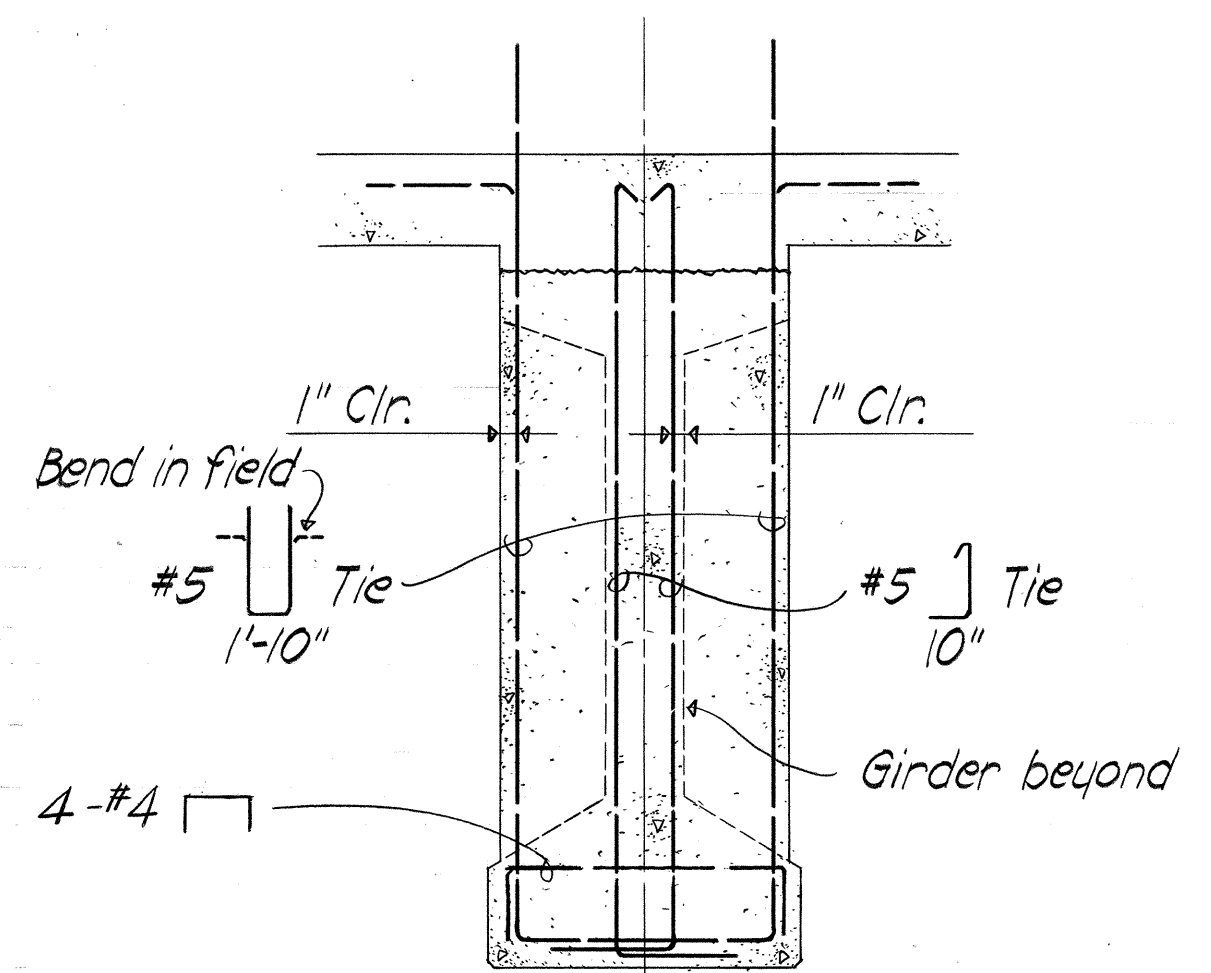

SECTION D
Scale: 3/4" = 1'-0"

SSFM Engineers, Inc.
Consulting Structural Engineers
1210 Ward Ave., Honolulu, HI 96814

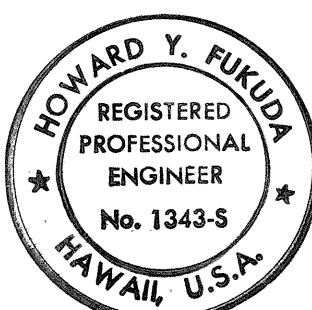

This work was prepared by me or under my supervision.
Howard Y. Fukuda

STATE OF HAWAII
DEPARTMENT OF TRANSPORTATION
HIGHWAYS DIVISION


KEEHI IV GIRDER
DAPPED & FIXED END DETAILS

INTERSTATE ROUTE H-3
F.A.I. PROJ. NO. I-H3-1(51)
SCALE: AS NOTED DATE: _____
SHEET NO. 11 OF 21 SHEETS


DATE: _____	NO. _____
SURVEY PLOTTED BY: _____	ORIGINAL PLAN _____
DRAWN BY: _____	TRACED BY: _____
CHECKED BY: _____	NOTED BY: _____

FED. ROAD DIST. NO.	STATE	FED. AID PROJ. NO.	FISCAL YEAR	SHEET NO.	TOTAL SHEETS
HAWAII	HAW.	I- H3-1 (51)	1989	96	106

NOTE:
All girder ends to be vertical, all seat areas to be level.

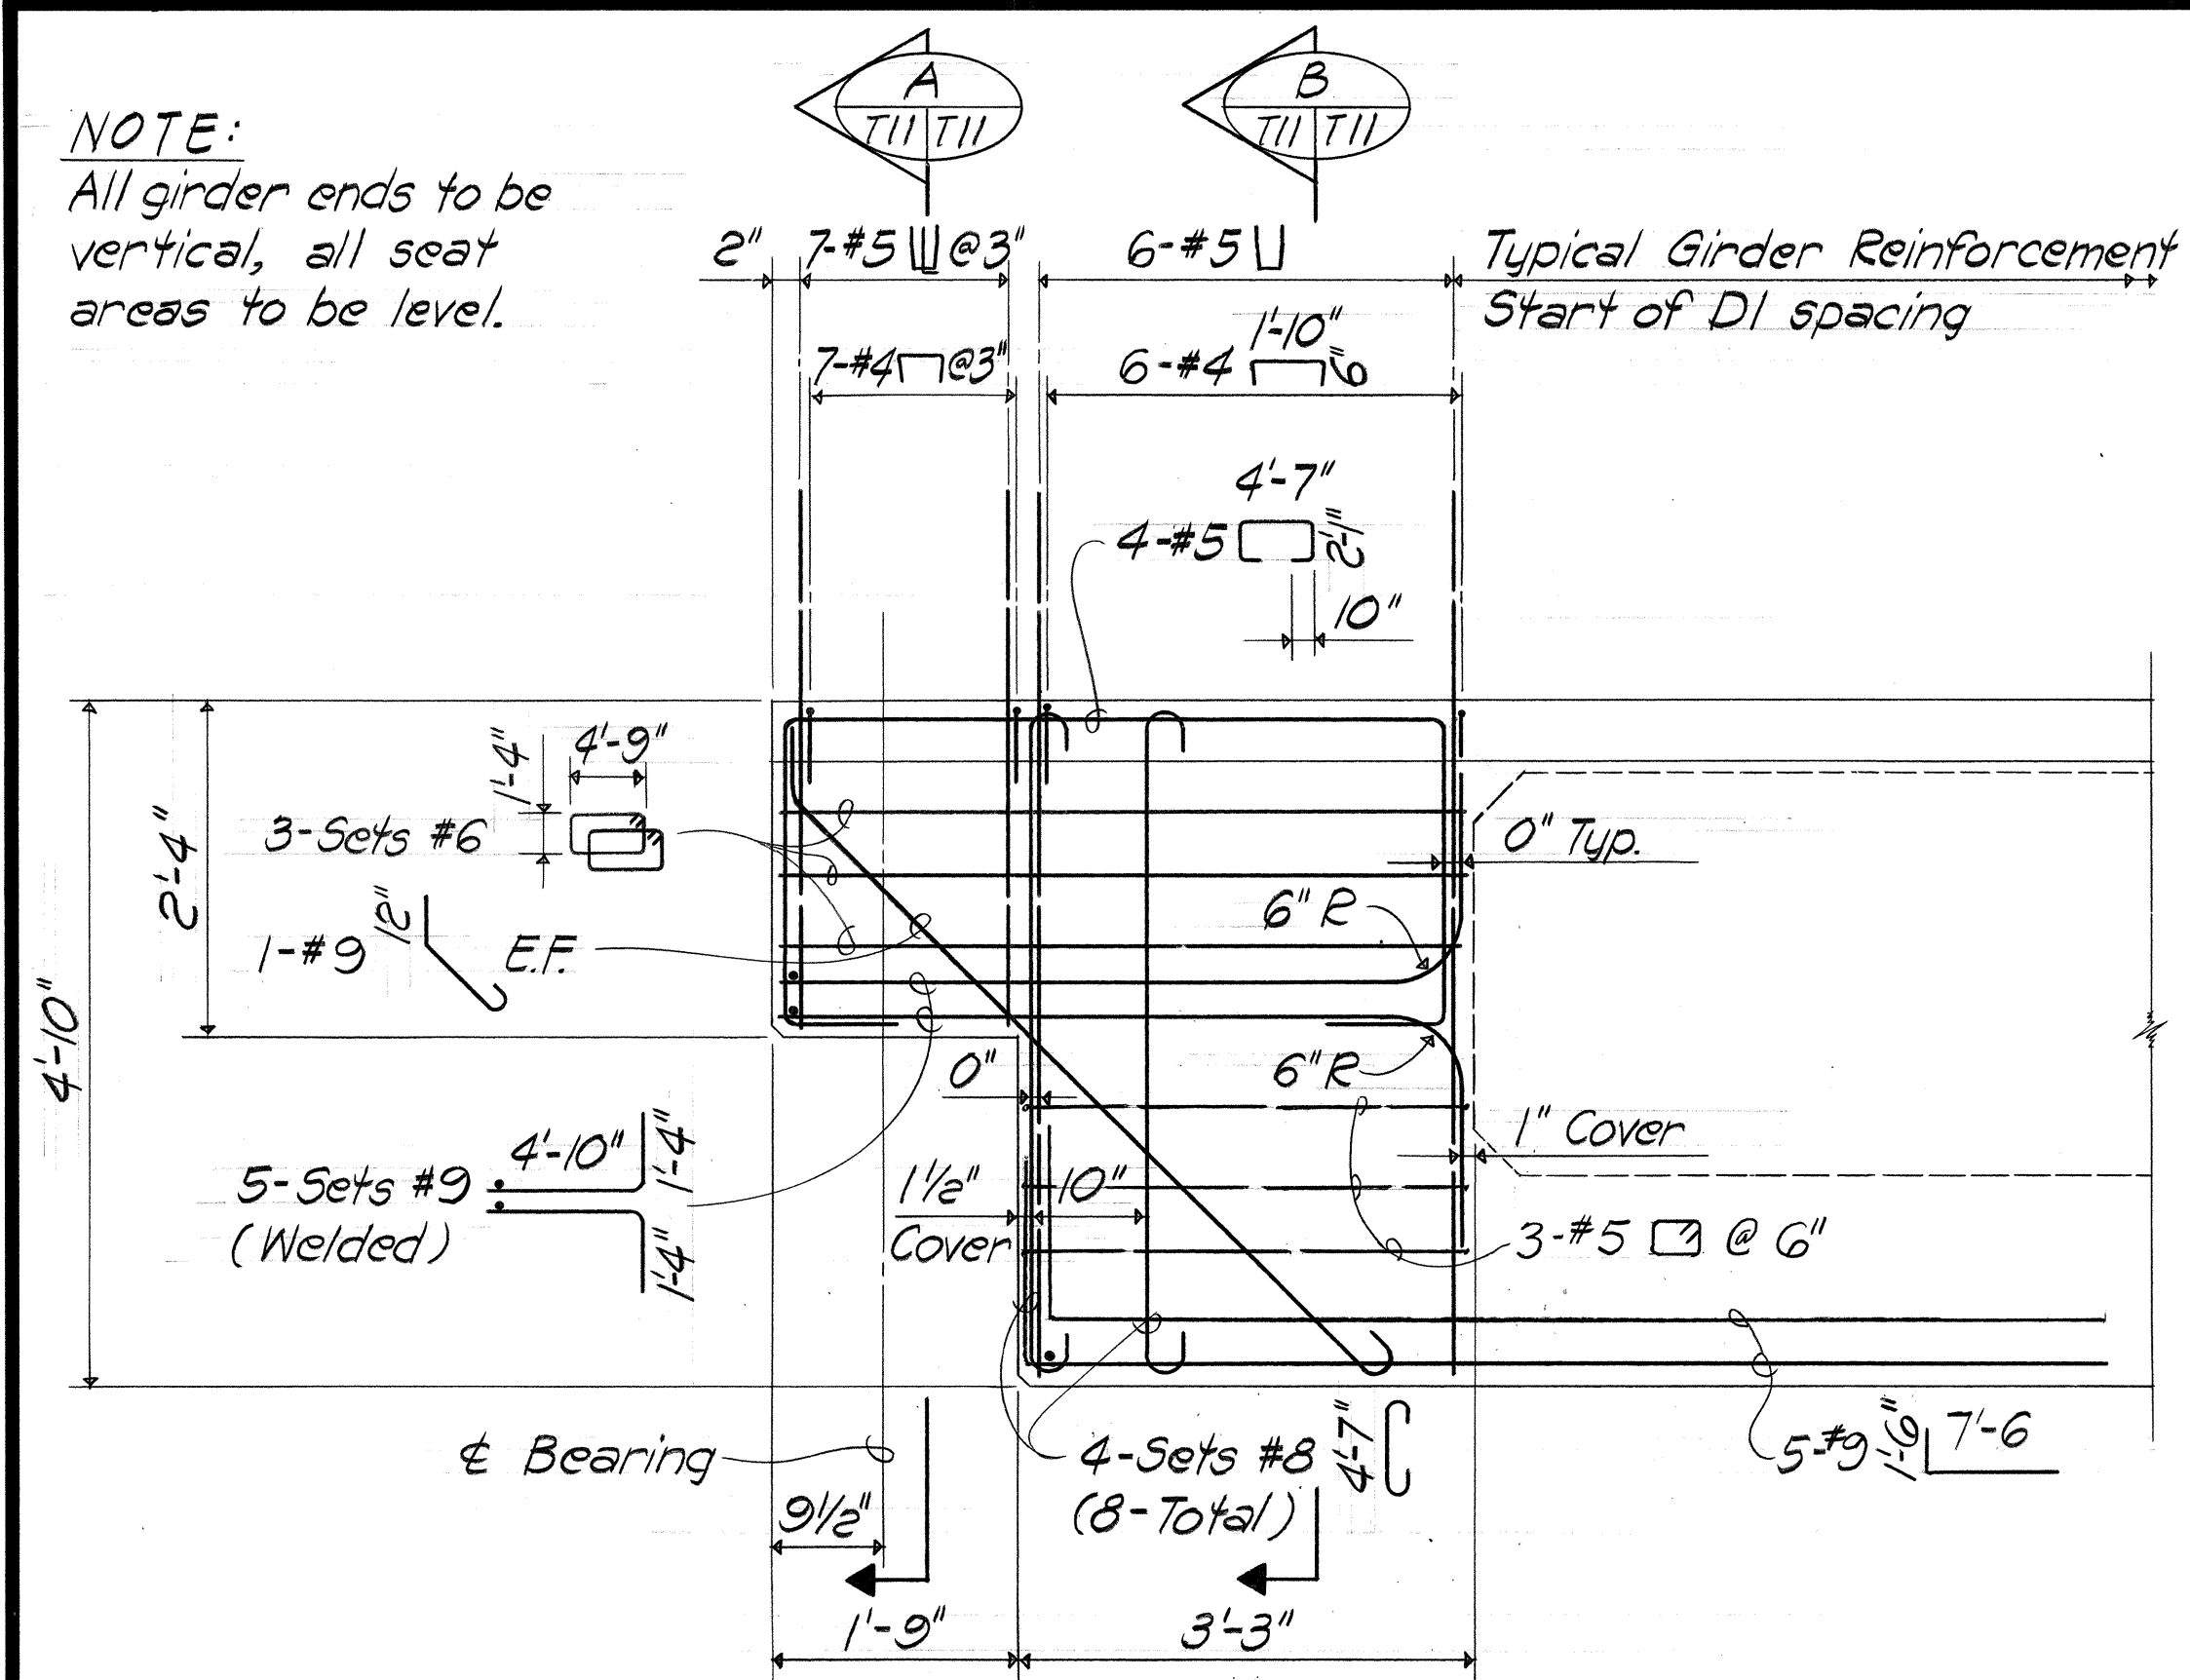


KEEHI IVF GIRDER DAPPED END ELEVATION
Scale: 3/4" = 1'-0"

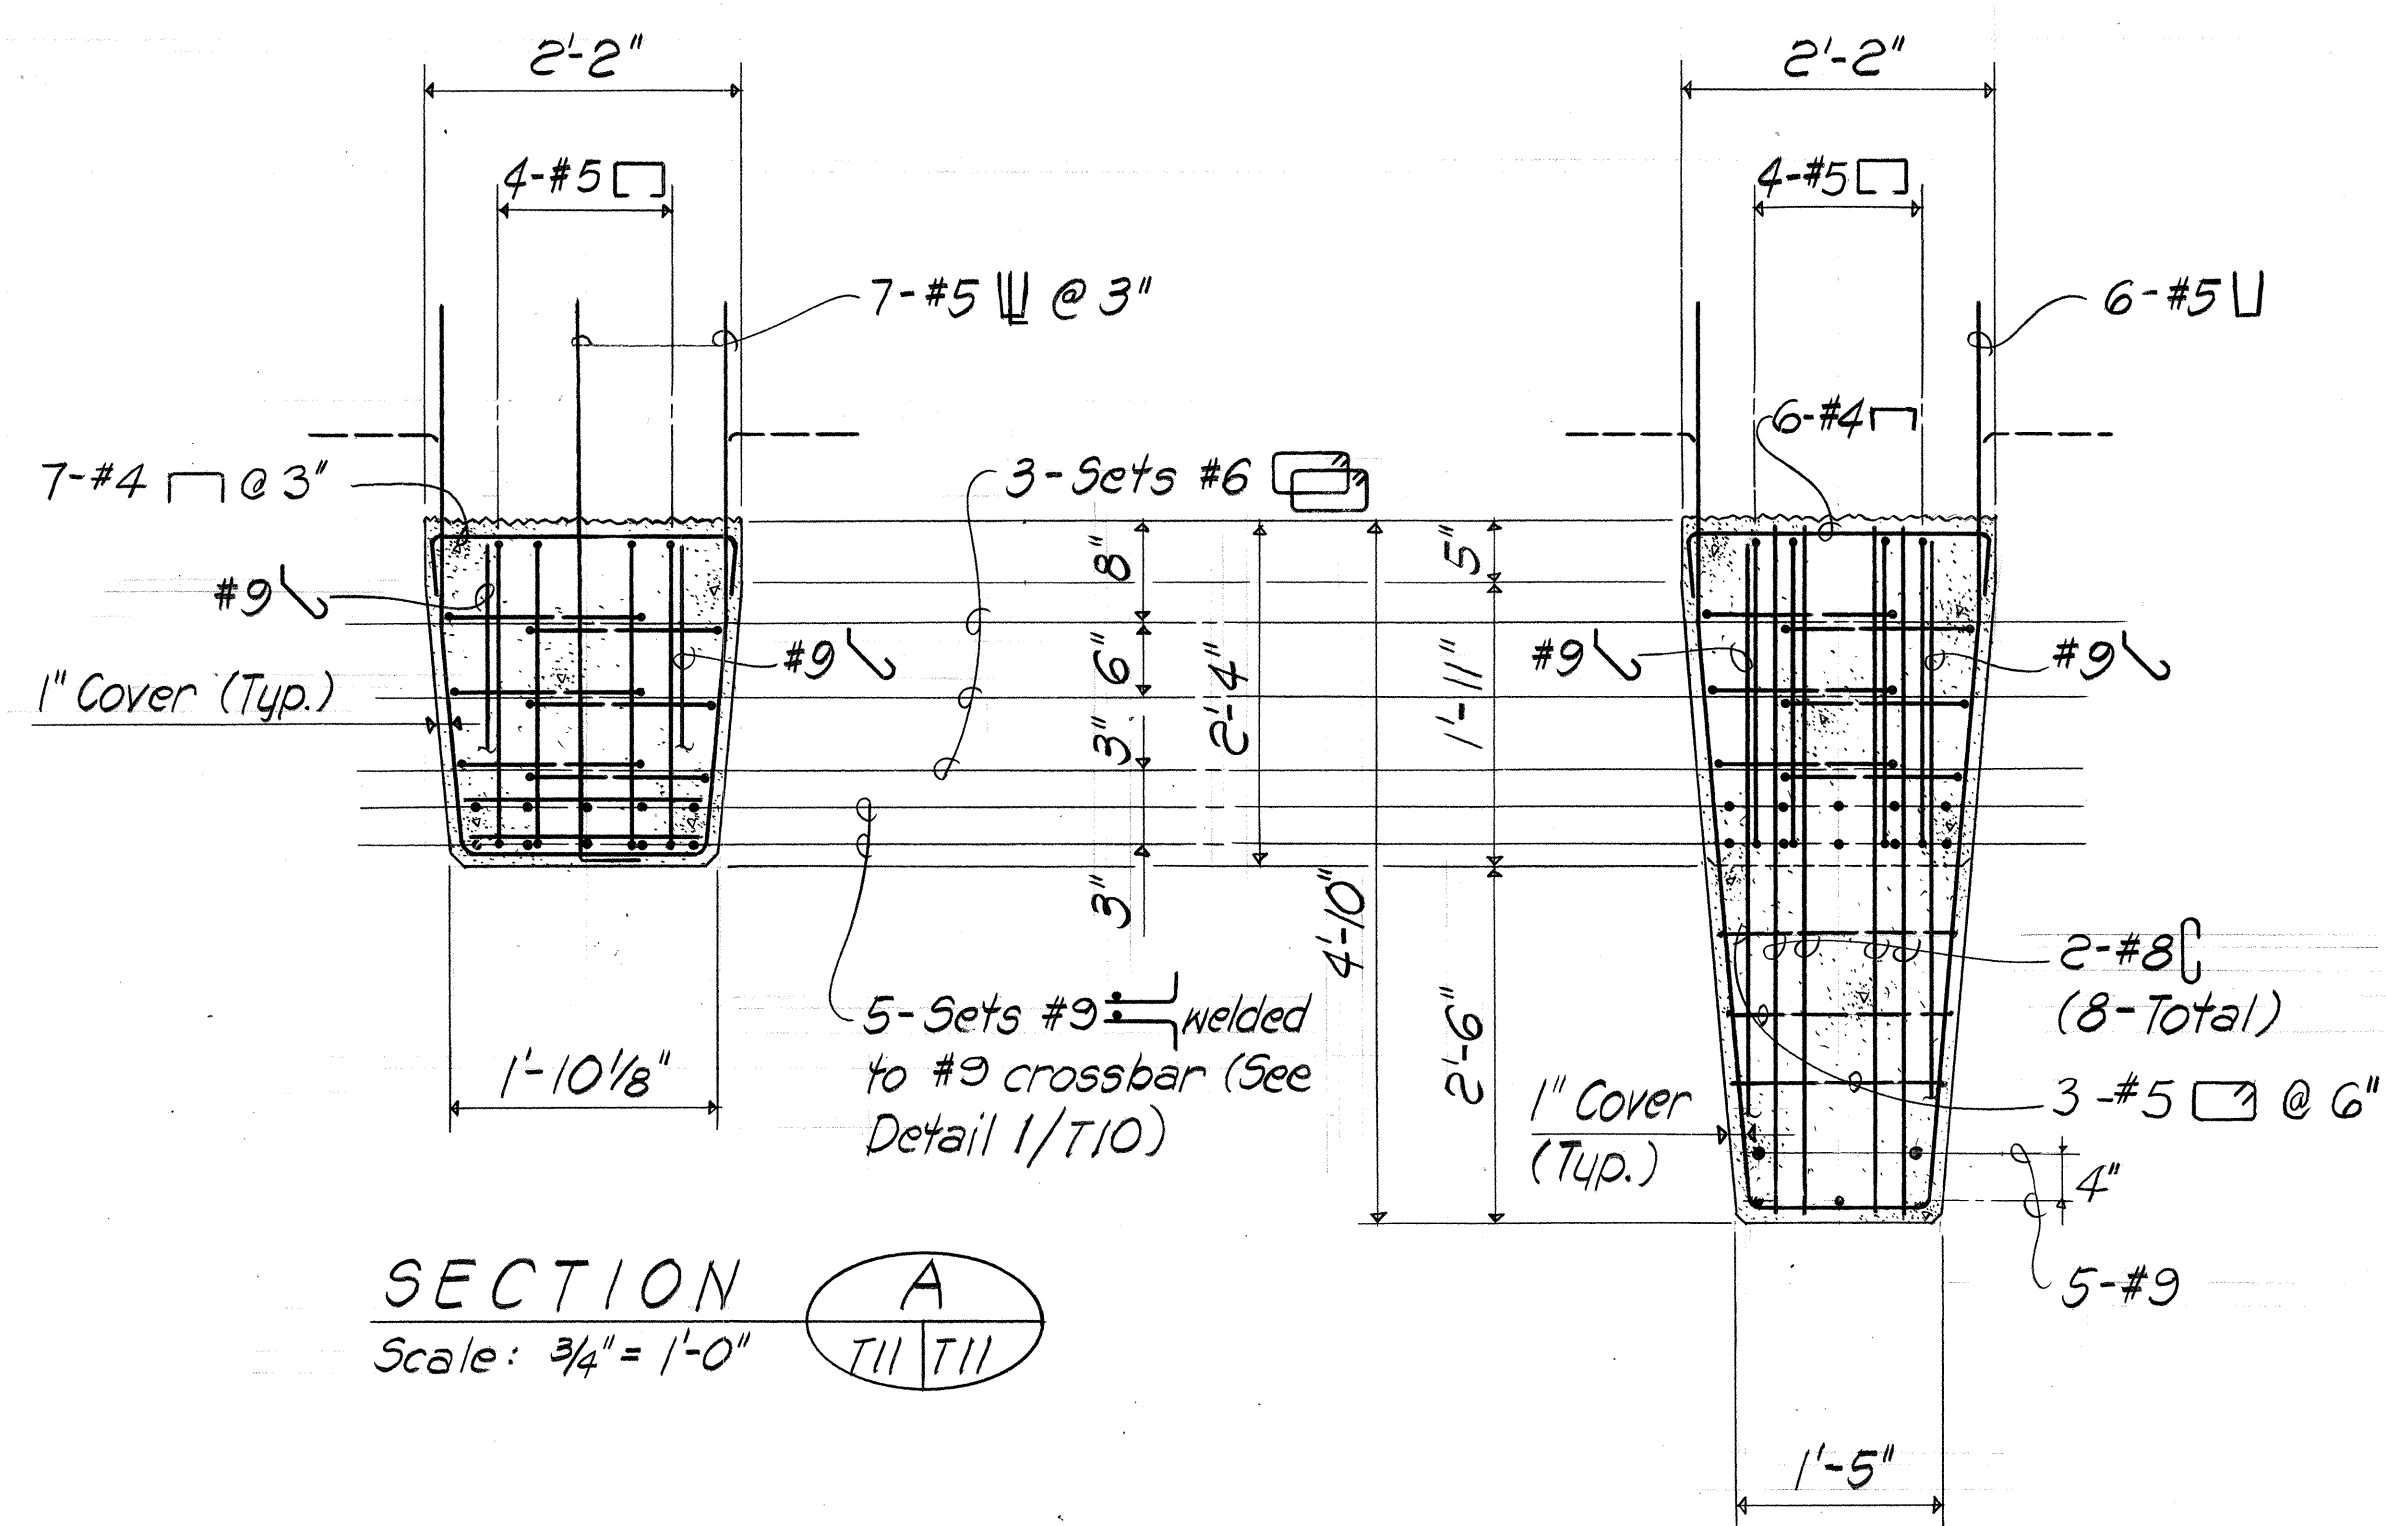


SECTION A
Scale: 3/4" = 1'-0"

SECTION B
Scale: 3/4" = 1'-0"

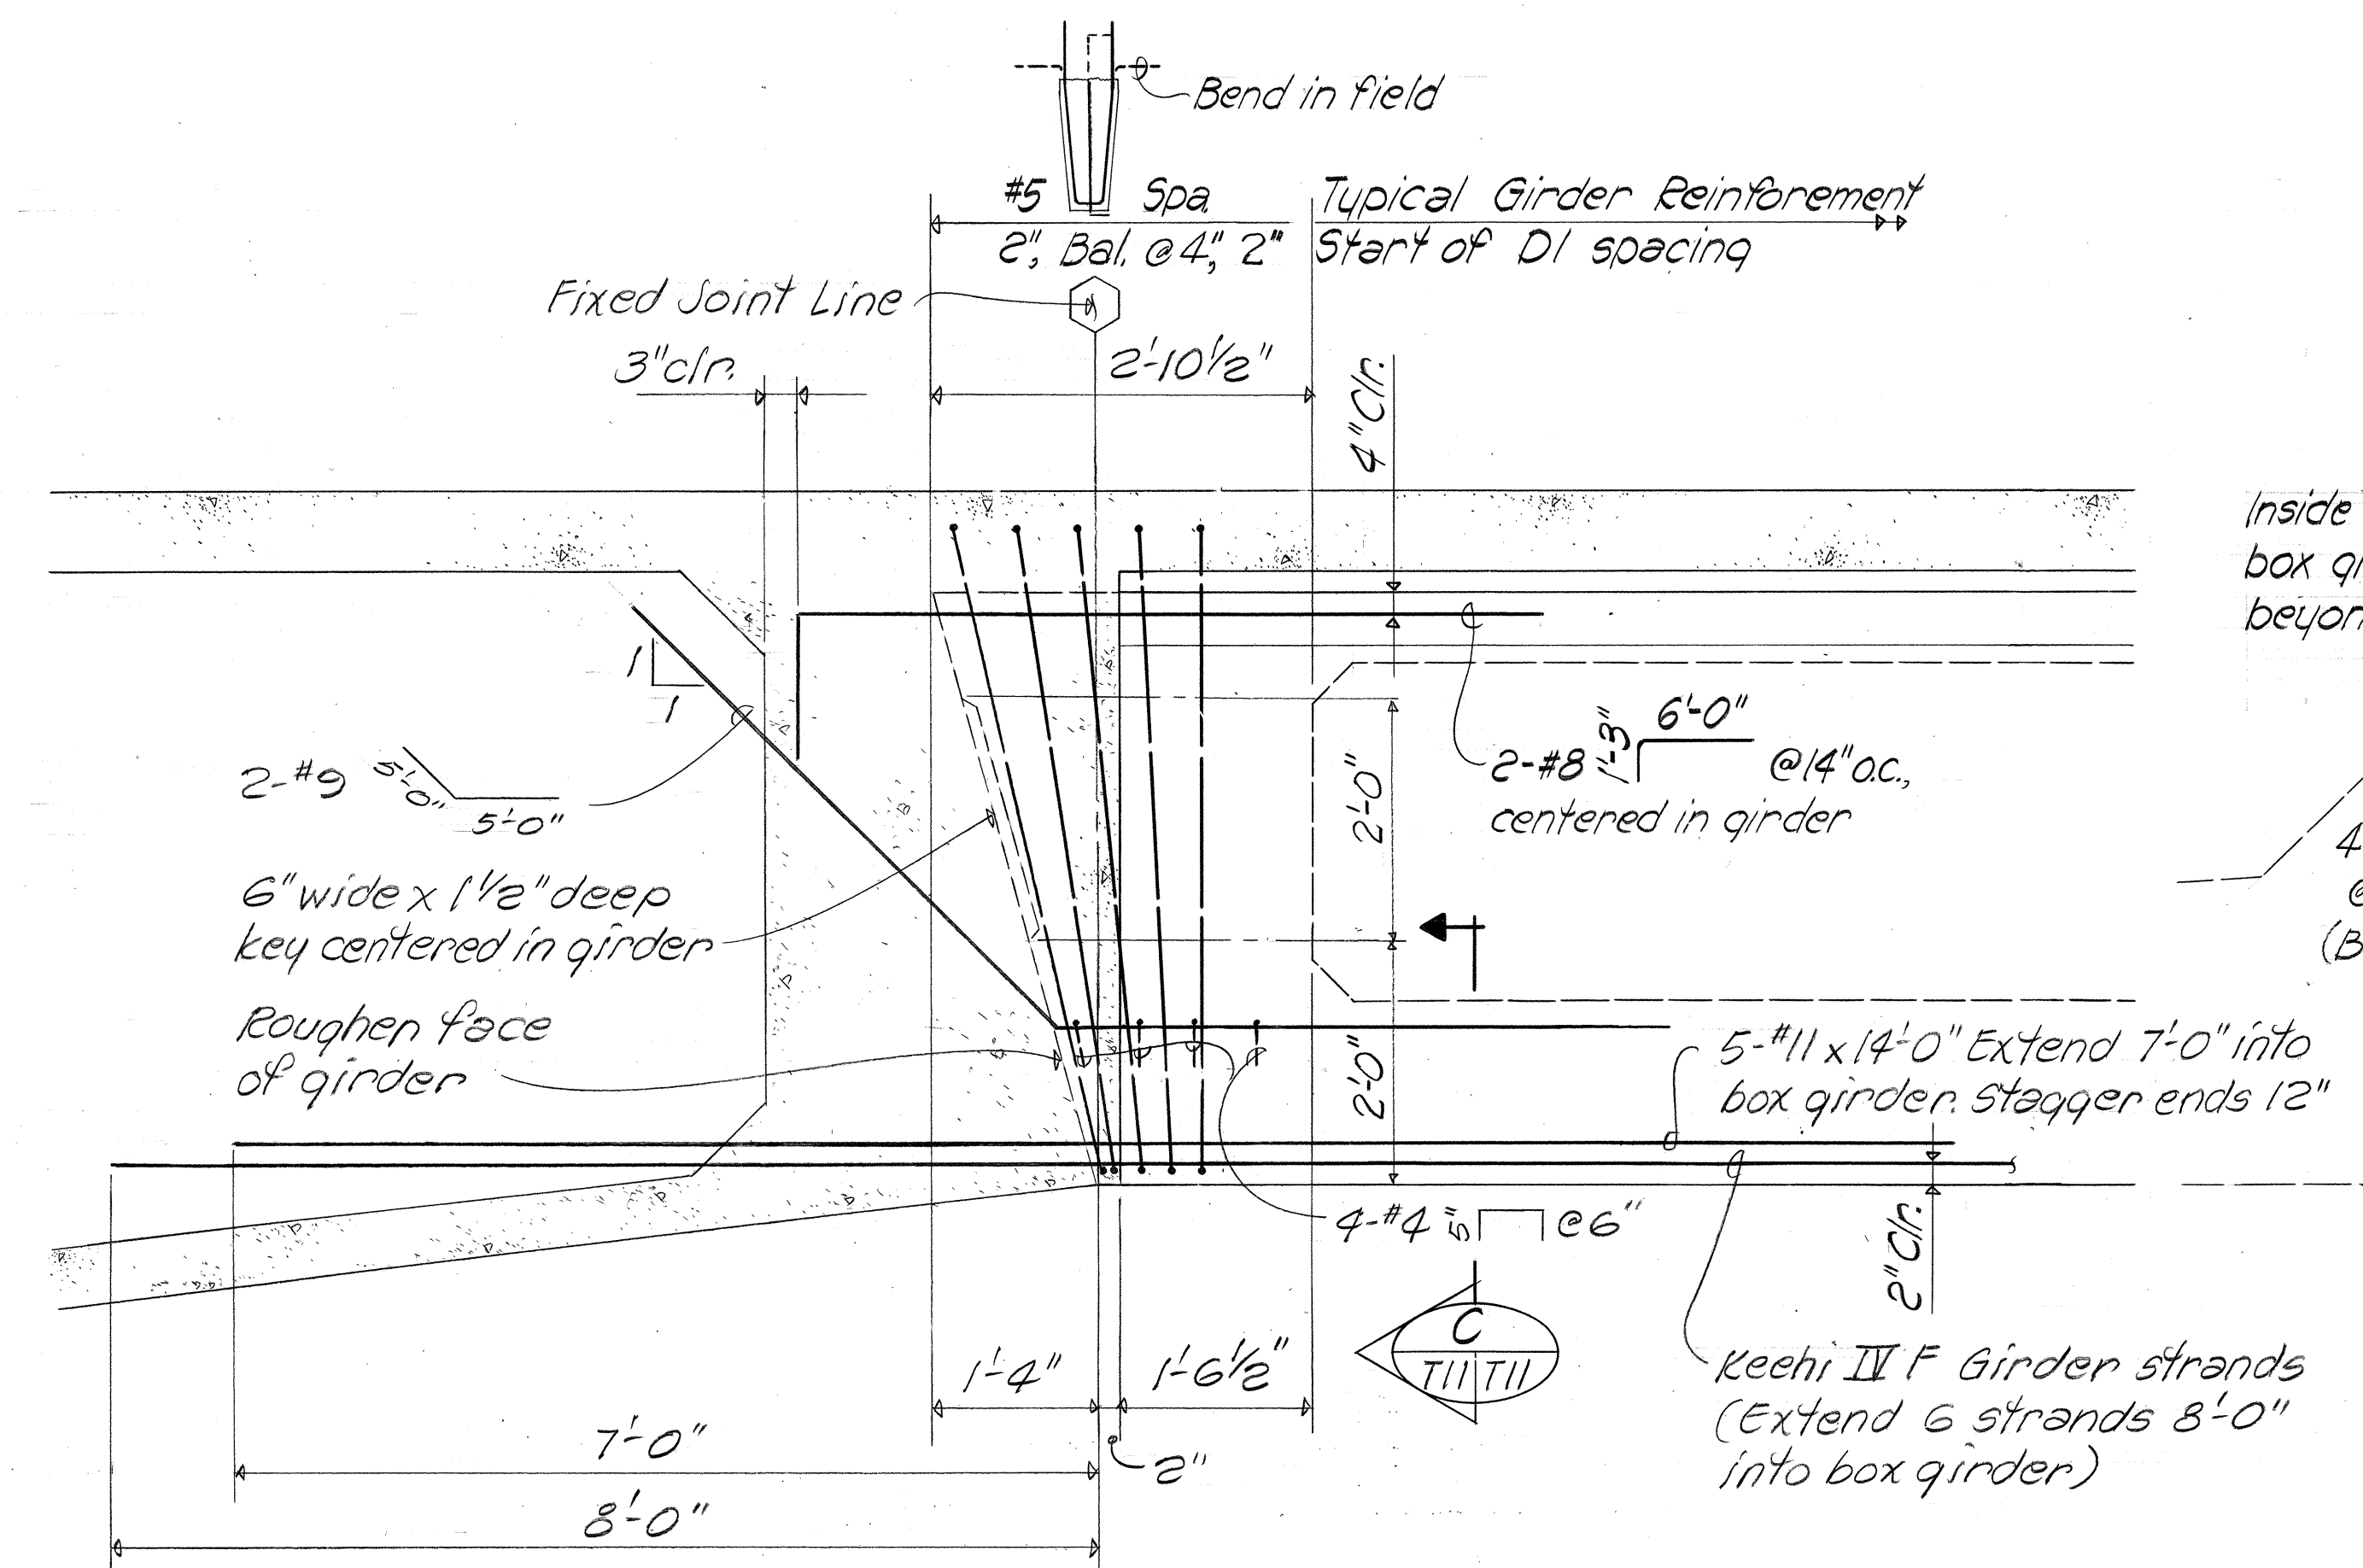

KEEHI IVF GIRDER FIXED END ELEVATION
Scale: 3/4" = 1'-0"

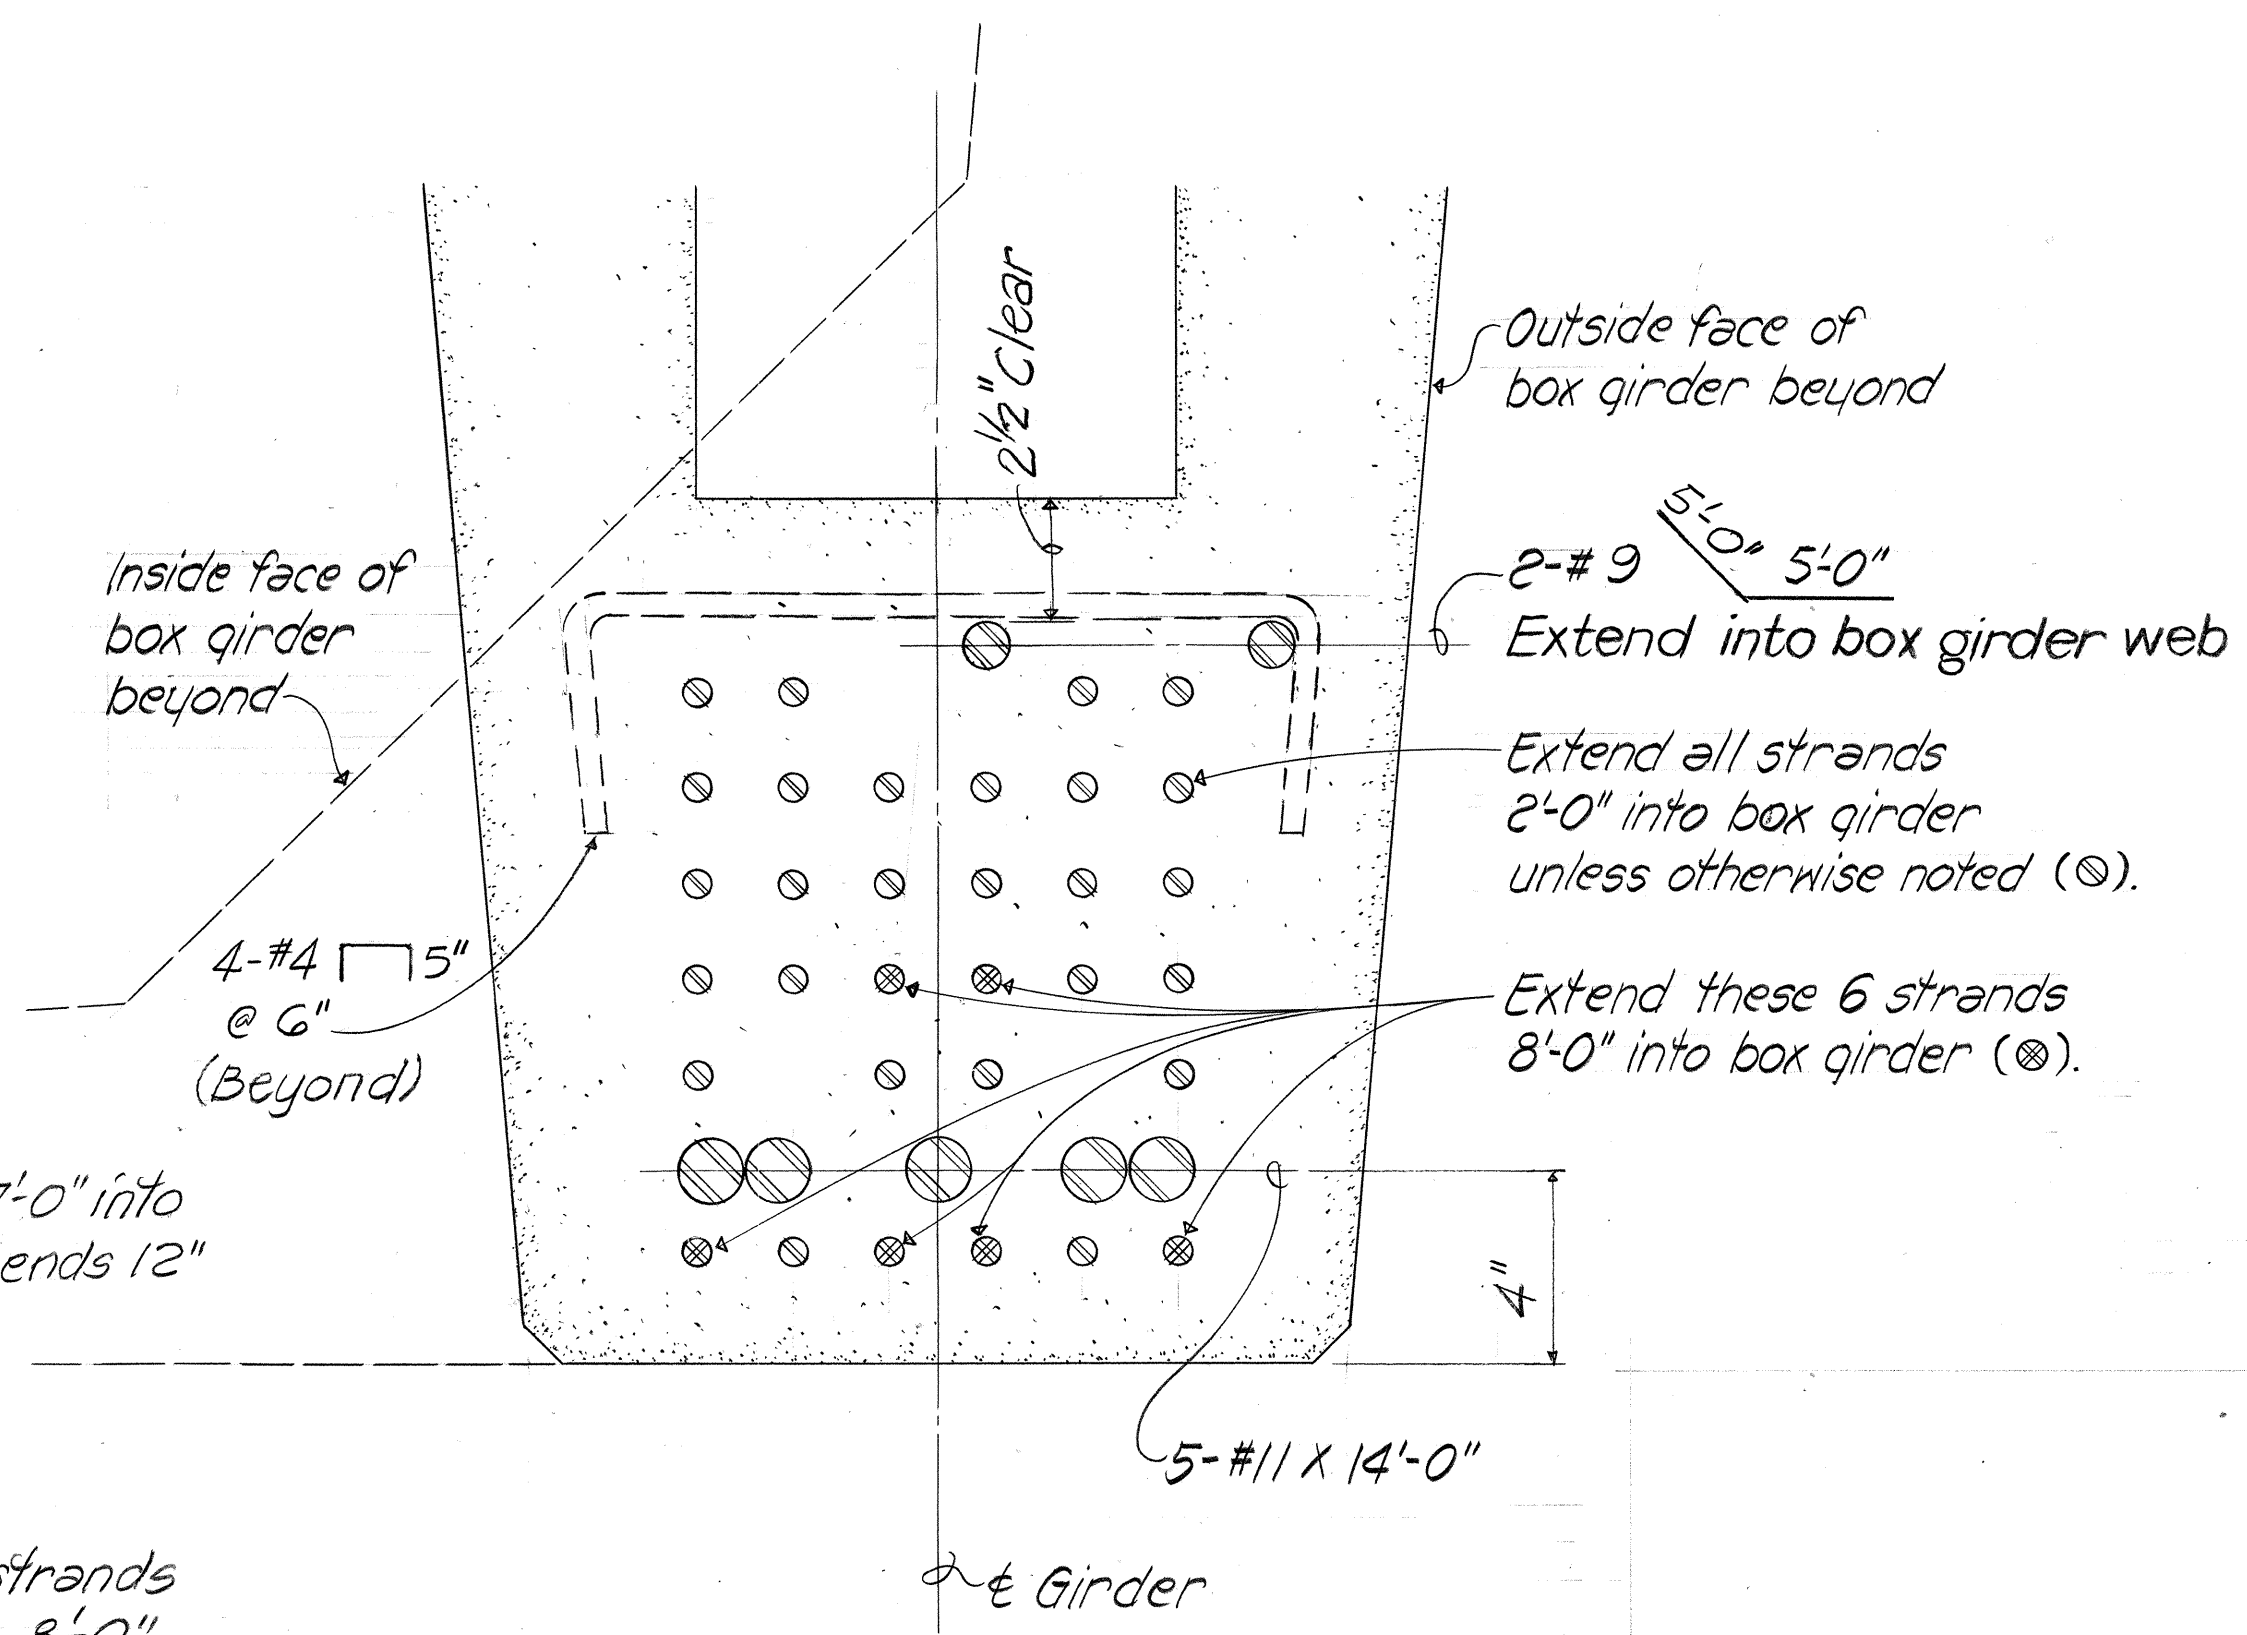

SECTION C
Scale: 3" = 1'-0"



This work was prepared by me or under my supervision.
Howard Y. Fukuda

STATE OF HAWAII
DEPARTMENT OF TRANSPORTATION
HIGHWAYS DIVISION


KEEHI IVF GIRDER
DAPPED & FIXED END DETAILS

INTERSTATE ROUTE H-3
F.A.I. PROJ. NO. I-H3-1(51)

SCALE: AS NOTED DATE: _____


SHEET NO. 7/11 OF 21 SHEETS

FED. ROAD DIST. NO.	STATE	FED. AID PROJ. NO.	FISCAL YEAR	SHEET NO.	TOTAL SHEETS
HAWAII	HAW.	I-H3-1(51)	1989	97	106

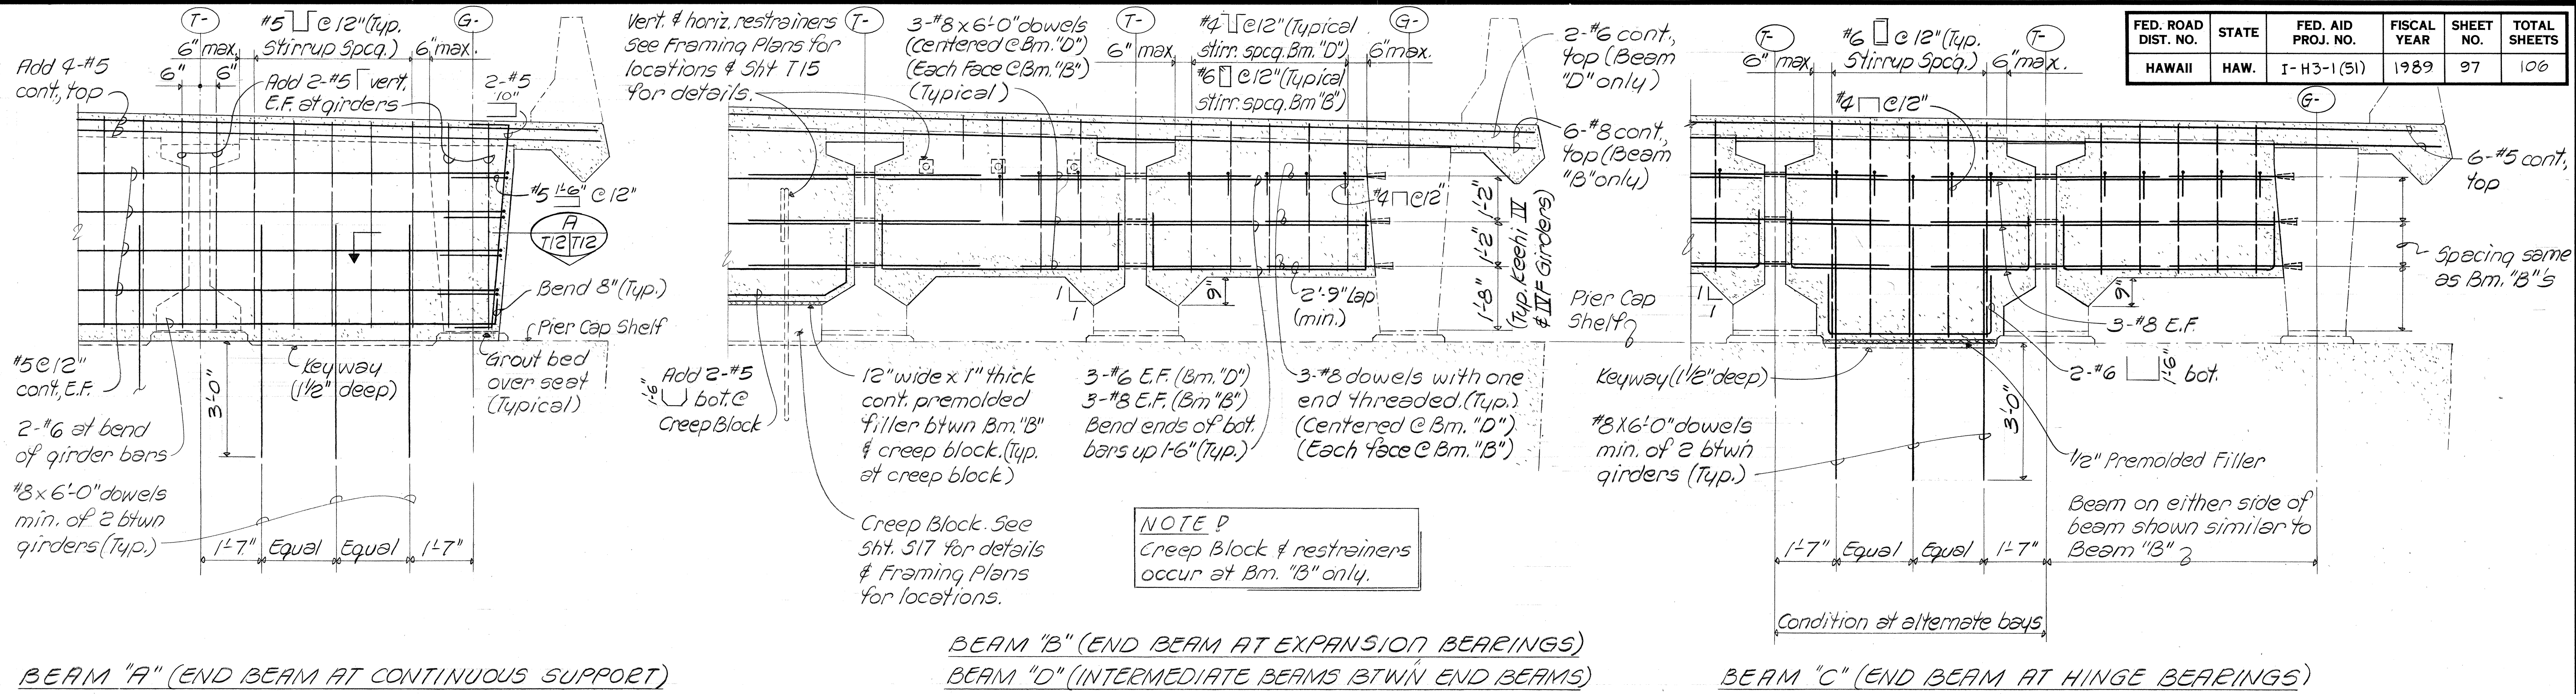


PARTIAL ELEVATIONS OF END BEAMS AT SUPPORTS SHOWING REINFORCING

Scale: 1/2" = 1'-0"

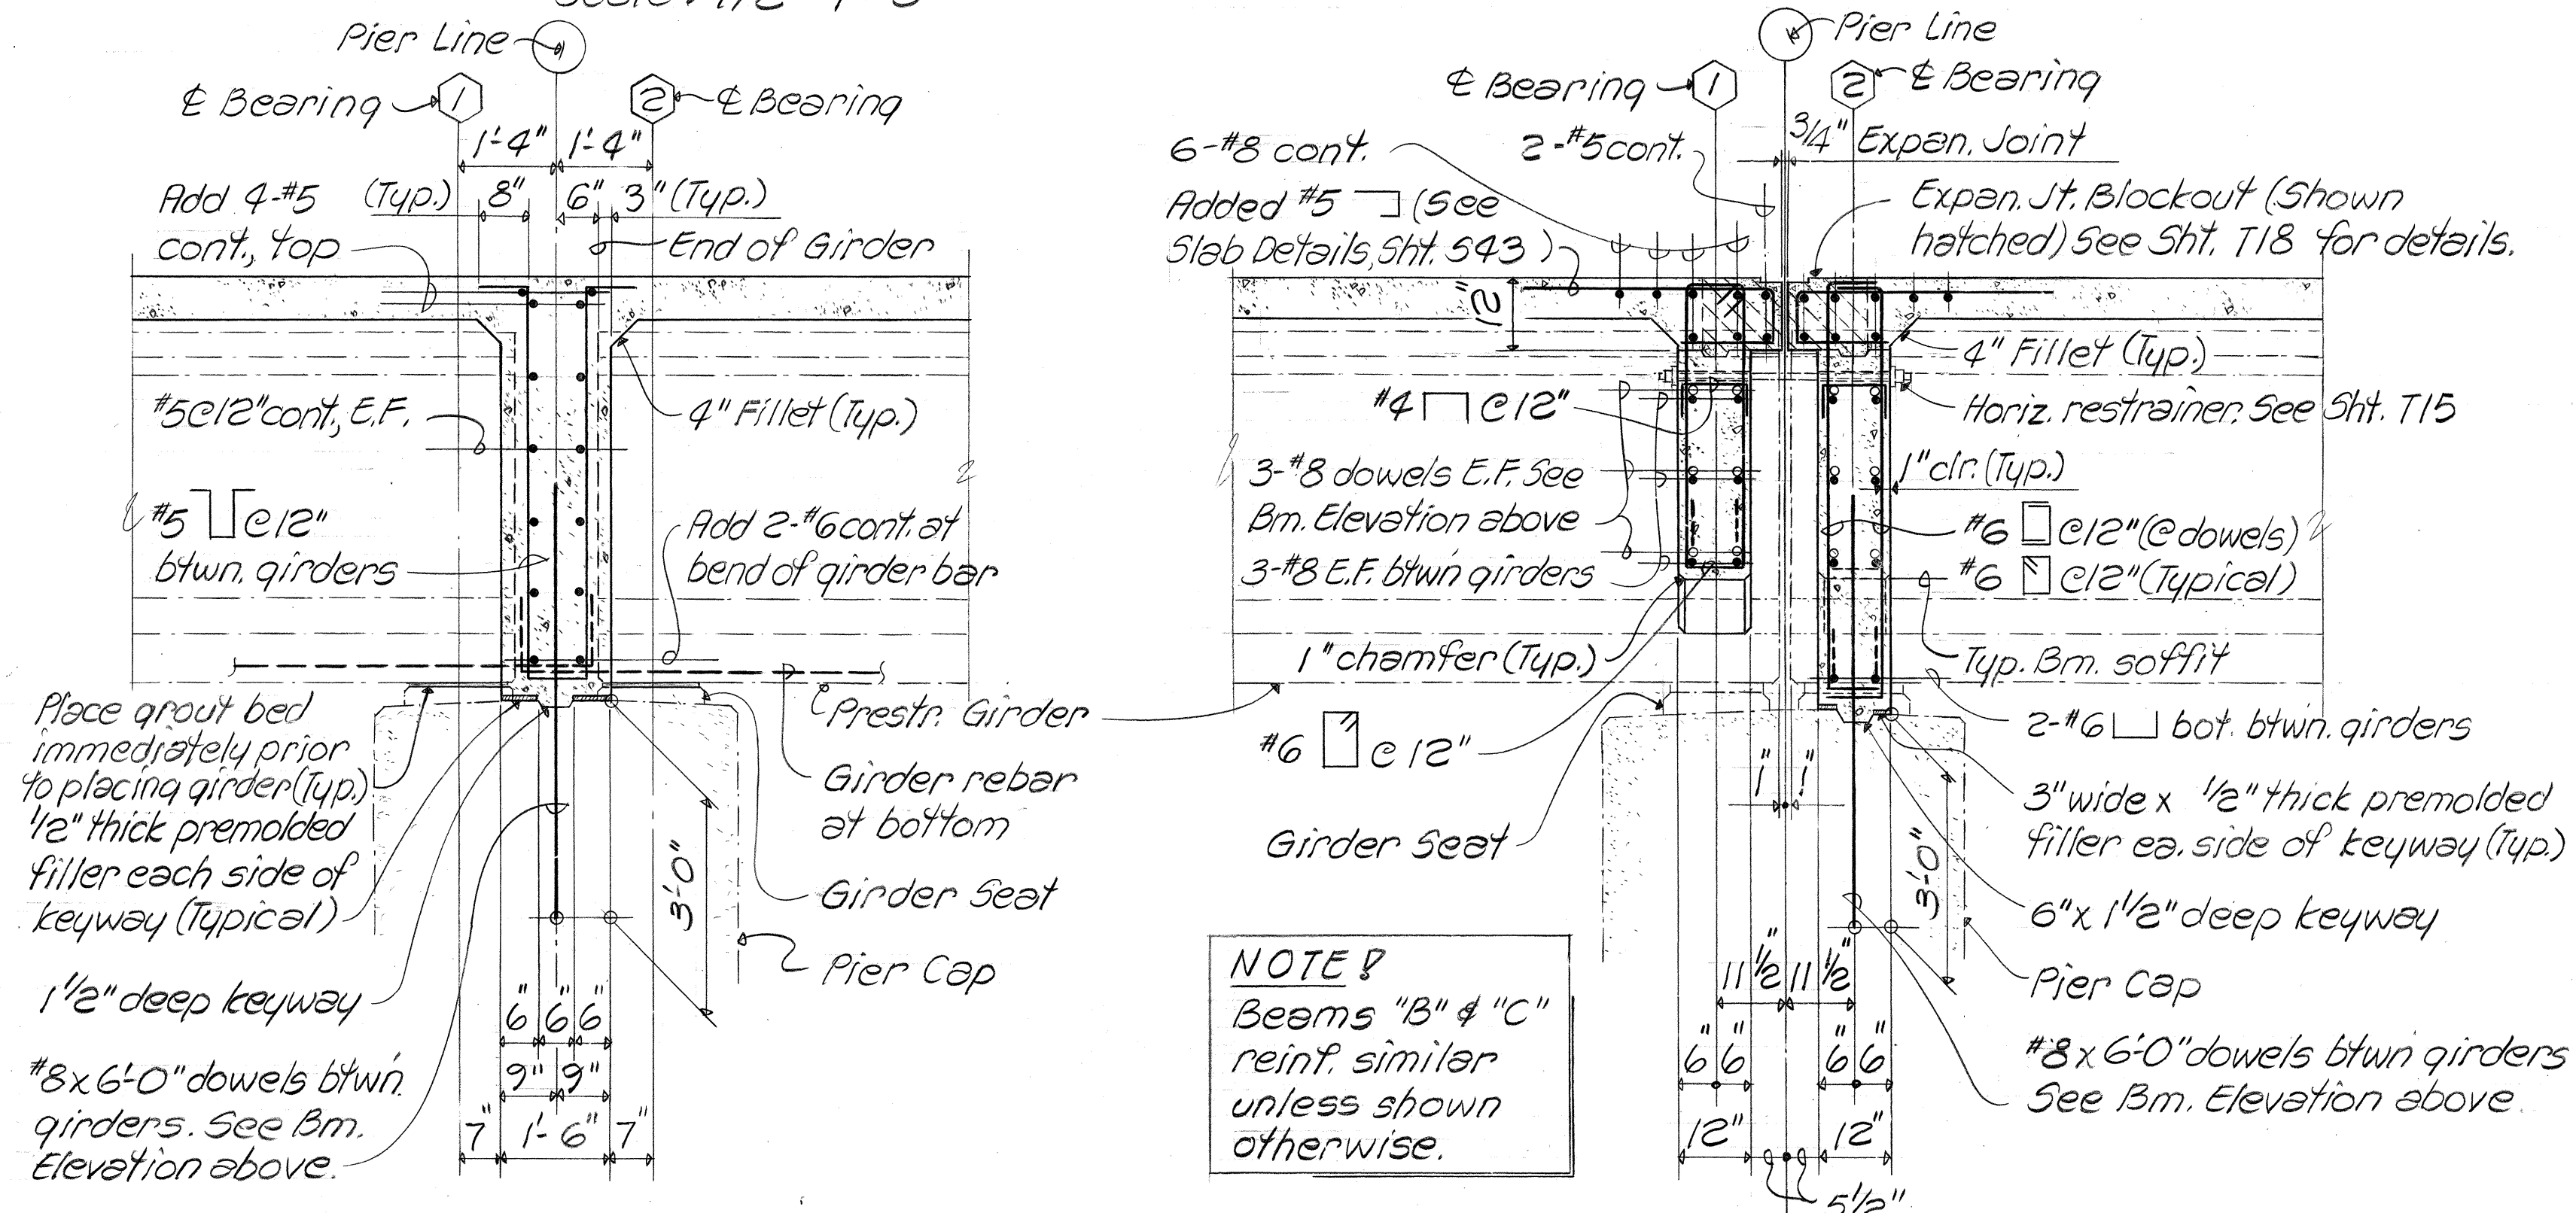


END BEAM SECTIONS

Scale: 1/2" = 1'-0"

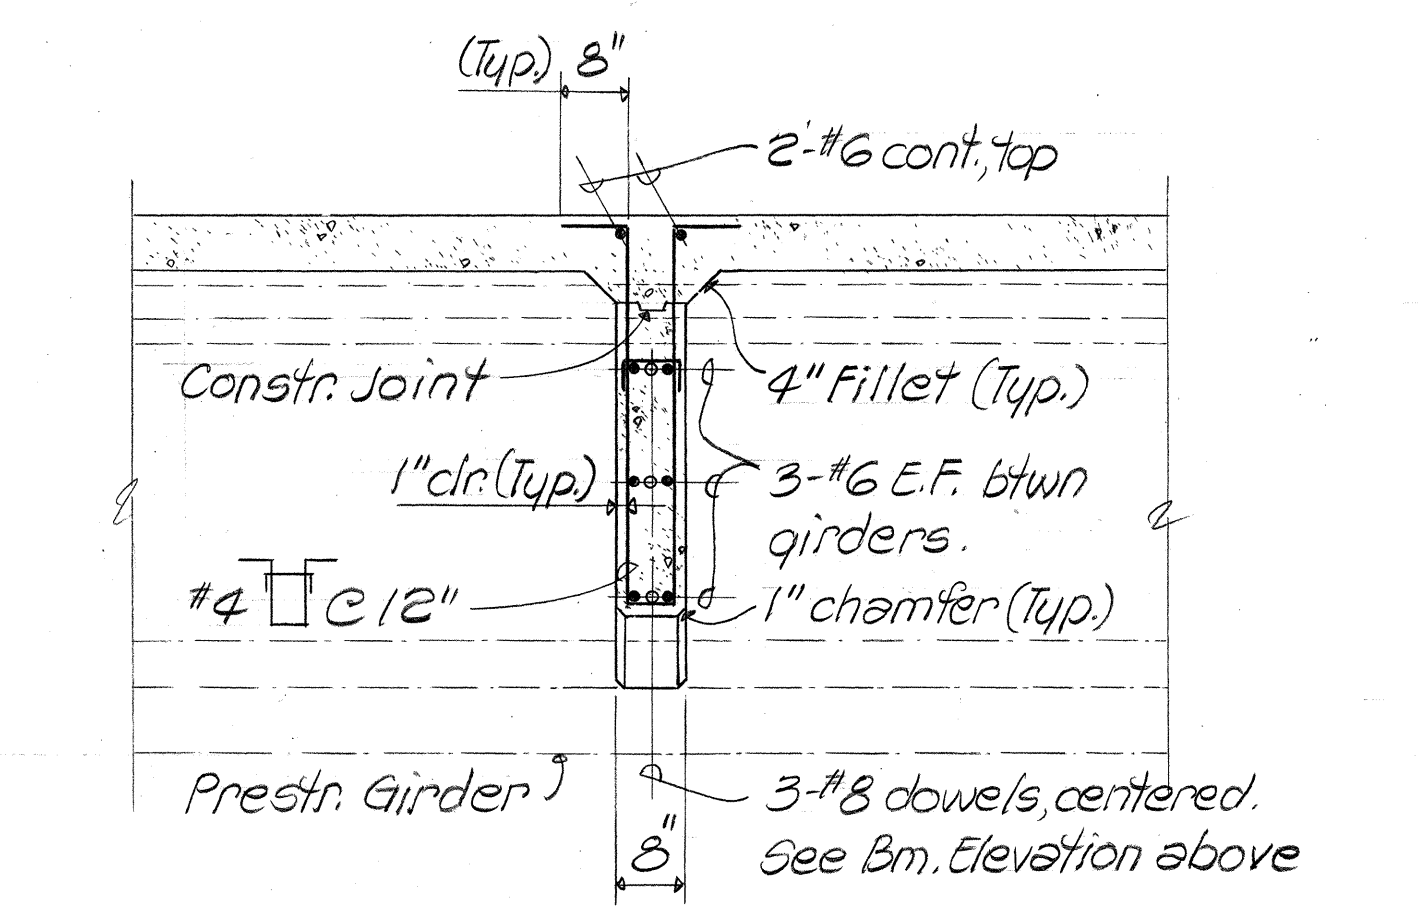


Scale: 1/2" = 1'-0"

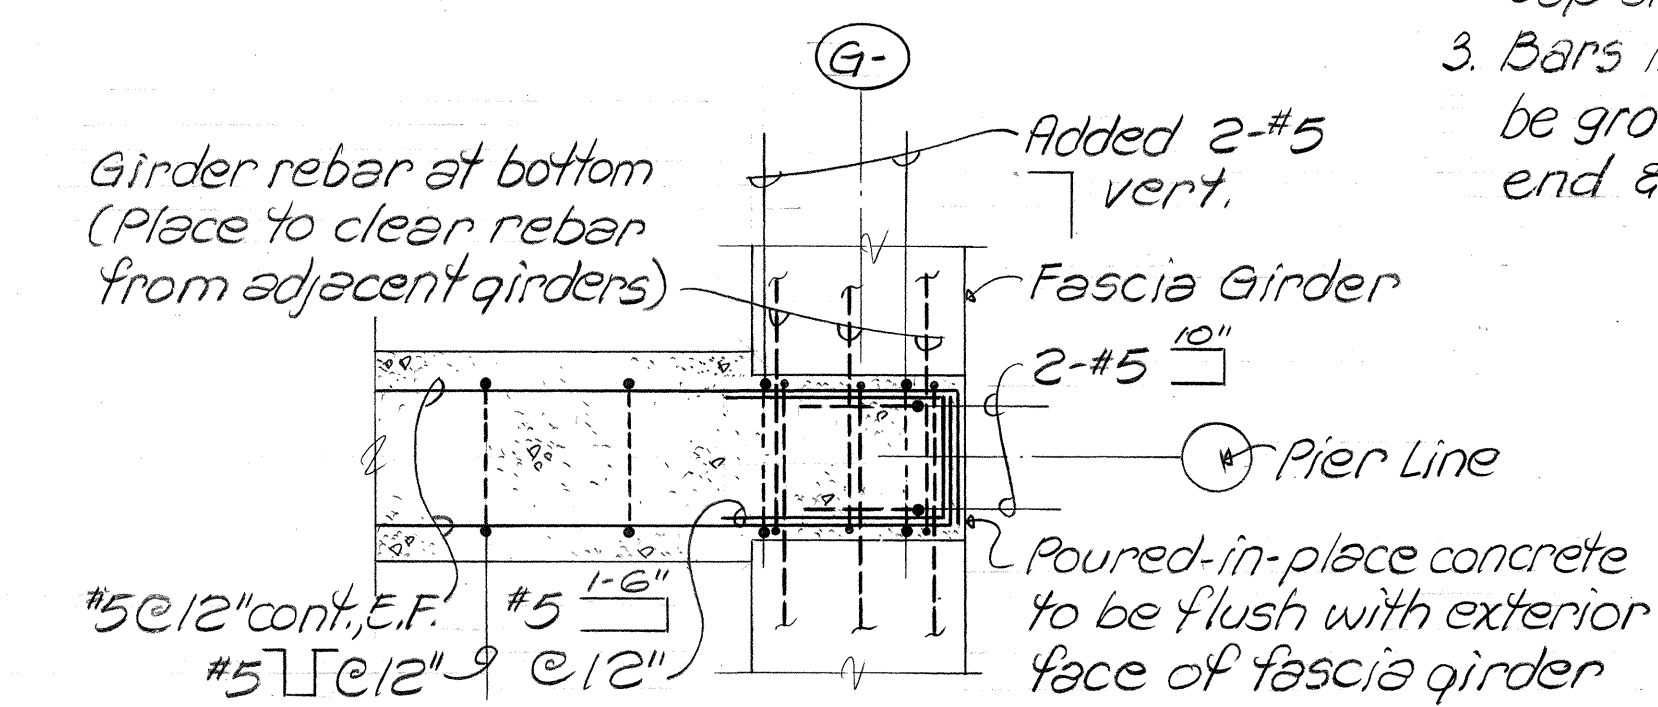

Scale: 3/4" = 1'-0"

- NOTES:**
- Beams B, C, D, E, F & G shall be poured at least 7 days prior to pouring deck slab.
 - See Sht. 517 for top of Pier Cap shelf details.
 - Bars in preformed holes shall be grouted in place before pouring end & intermediate beams.

SSFM Engineers, Inc.
Consulting Structural Engineers
1210 Ward Ave., Honolulu, HI 96814

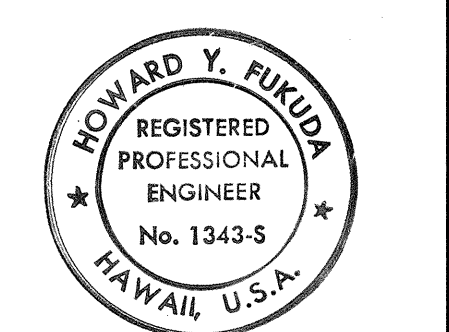

This work was prepared by me or under my supervision.
Howard Y. Fukuda

STATE OF HAWAII
DEPARTMENT OF TRANSPORTATION
HIGHWAYS DIVISION

BEAM DETAILS
BEAMS "A", "B", "C" & "D"

INTERSTATE ROUTE H-3
F.A.I. PROJ. NO. I-H3-1(51)

SCALE: AS NOTED DATE: AUG., 1984

SHEET NO. 172 OF 21 SHEETS

Vert. & horizontal restrainers. See Framing Plans for locations & Sht. for details

NOTE: Beam "F" & "E" reinf. similar unless shown otherwise

12" wide x 1" thick preformed filler b/w. Beam "F" & Creep Block (typ.)

Creep Block. See Sht. 517 for details & Framing Plans for locations

Roofing felt

Girder outline (full height)

Pier Box Girder outline

FED. ROAD DIST. NO.	STATE	FED. AID PROJ. NO.	FISCAL YEAR	SHEET NO.	TOTAL SHEETS
HAWAII	HAW.	I- H3-1 (51)	1989	28	106

Technical drawing of a pier box girder cross-section. The drawing shows a central pier with a box girder section. Reinforcement details include 1-#5 continuous top and bottom bars, 4-#8 bars in the top flange, 3-#8 bars in the bottom flange, and 4-#4 bars in the web. Dimensions include a total width of 3'-1", a top flange width of 1'-0", a bottom flange width of 6'-6", and a web thickness of 12". Annotations include "E Bearing", "Expan. Jt., See Sht.", "Expan. Jt. Blockout (Shown hatched) See Sht. T18 for details.", "Horiz. restainer (At Expansion Bearing only) See Sht. T15 for details", "3-#8 dowels, E.F. See Bm. 'E' Elevation at left.", "3-#8 E.F. btwn. girders", "4\" #4 C12", "3/4\" chamfer (Typical)", "Pier Box Girder", "Girder Seat", "Prestr. Girder", "4\" Filler", and "4\" #4 C12".

6-#8 cont., top

3-#8 x 4'-6" dowels I.F. (Typical)

#4 E.F.

#4 @ 12" (Typical stirrup spc'g)

3-#8 cont., O.F. (Bend down 8" at ends)

#4 @ 8" O.F.

3-#5 cont., E.F. (Bend ends 8")

Add 2-#5 cont. at girder bars

Preformed filler btwn Beam "G" & abutment

12" wide x 1" thick preformed filler

Creep Block. See Framing Plan for locations & Sht. 317 for details

3-#8 I.F. (Bend bot bar up 1'-6")

3-#8 dowels I.F. w/ one end threaded

Abutment Breast Wall

1-8" x 1-2" x 1-2"

Abut. Shelf

Bot. of Beam at far side

Roofing felt

Add 2-#6 @ bot

Vertical hinge restrainers See Framing Plan for locations & Sht. 115 for details

6" max.

6" max.

Lap 2'-0"

1'-8" 1'-2" 1'-2"

3-#8 cont., top

#5 cont., E.F.

1-8" 1'-2" 1'-2"

#4

3-#8 cont, O.F.

Waterproofing

3"

#5 cont, E.F. below

#4 $\square$ @ 8" full length

1/2" Premolded Filler

& Bearing Abut. #2

Abutment Breast Wall

3-#8

3-#8 dowels

Abutment Breast Wall

Abut. Shelf

Prestr. Girder

Scale: 1/2" = 1'-0"

6-#8 cont, top

2'-0"

1'-8"

12"

8"

NOTE
 Unless otherwise shown, details & reinf. for Beams "E" & "F" sections below similar to Typical Beam Section above.


3-#8 @ 12" dowels. See Bm. "E" Elevation above
 6" x 1 1/2" deep key
 Girder Seat
 3" wide x 1/2" thick premolded filler
 Prestn. Girder
 Pier Box Girder

BM. "E" SECT. AT HINGE CONN.
 Scale: 1/2" = 1'-0"

BM. "E" SECT. AT HINGE CONN.
Scale: $1/2" = 1' - 0"$

BM. "F" SECT. AT CREEP BLOCK
Scale: 1/2" = 1'-0"

SSFM Engineers, Inc.
Consulting Structural Engineers
1210 Ward Ave., Honolulu, HI 96813

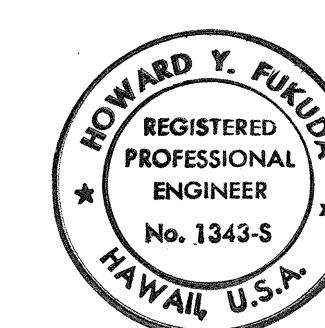

This work was prepared by me or under my supervision

James J. [Signature]

BEAM DETAILS


BEAMS "E", "F" & "G"

SCALE: AS NOTED DATE:


SHEET No. 13 OF 21 SHEETS

ORIGINAL PLAN	SURVEY PLOTTED BY _____ DATE _____
NOTE BOOK	DRAWN BY _____
	TRACED BY _____
	DESIGNED BY _____
	QUANTITIES BY _____
No. _____	CHECKED BY _____


FED. ROAD DIST. NO.	STATE	FED. AID PROJ. NO.	FISCAL YEAR	SHEET NO.	TOTAL SHEETS
HAWAII	HAW.	I-H3-1(51)	1989	100	106

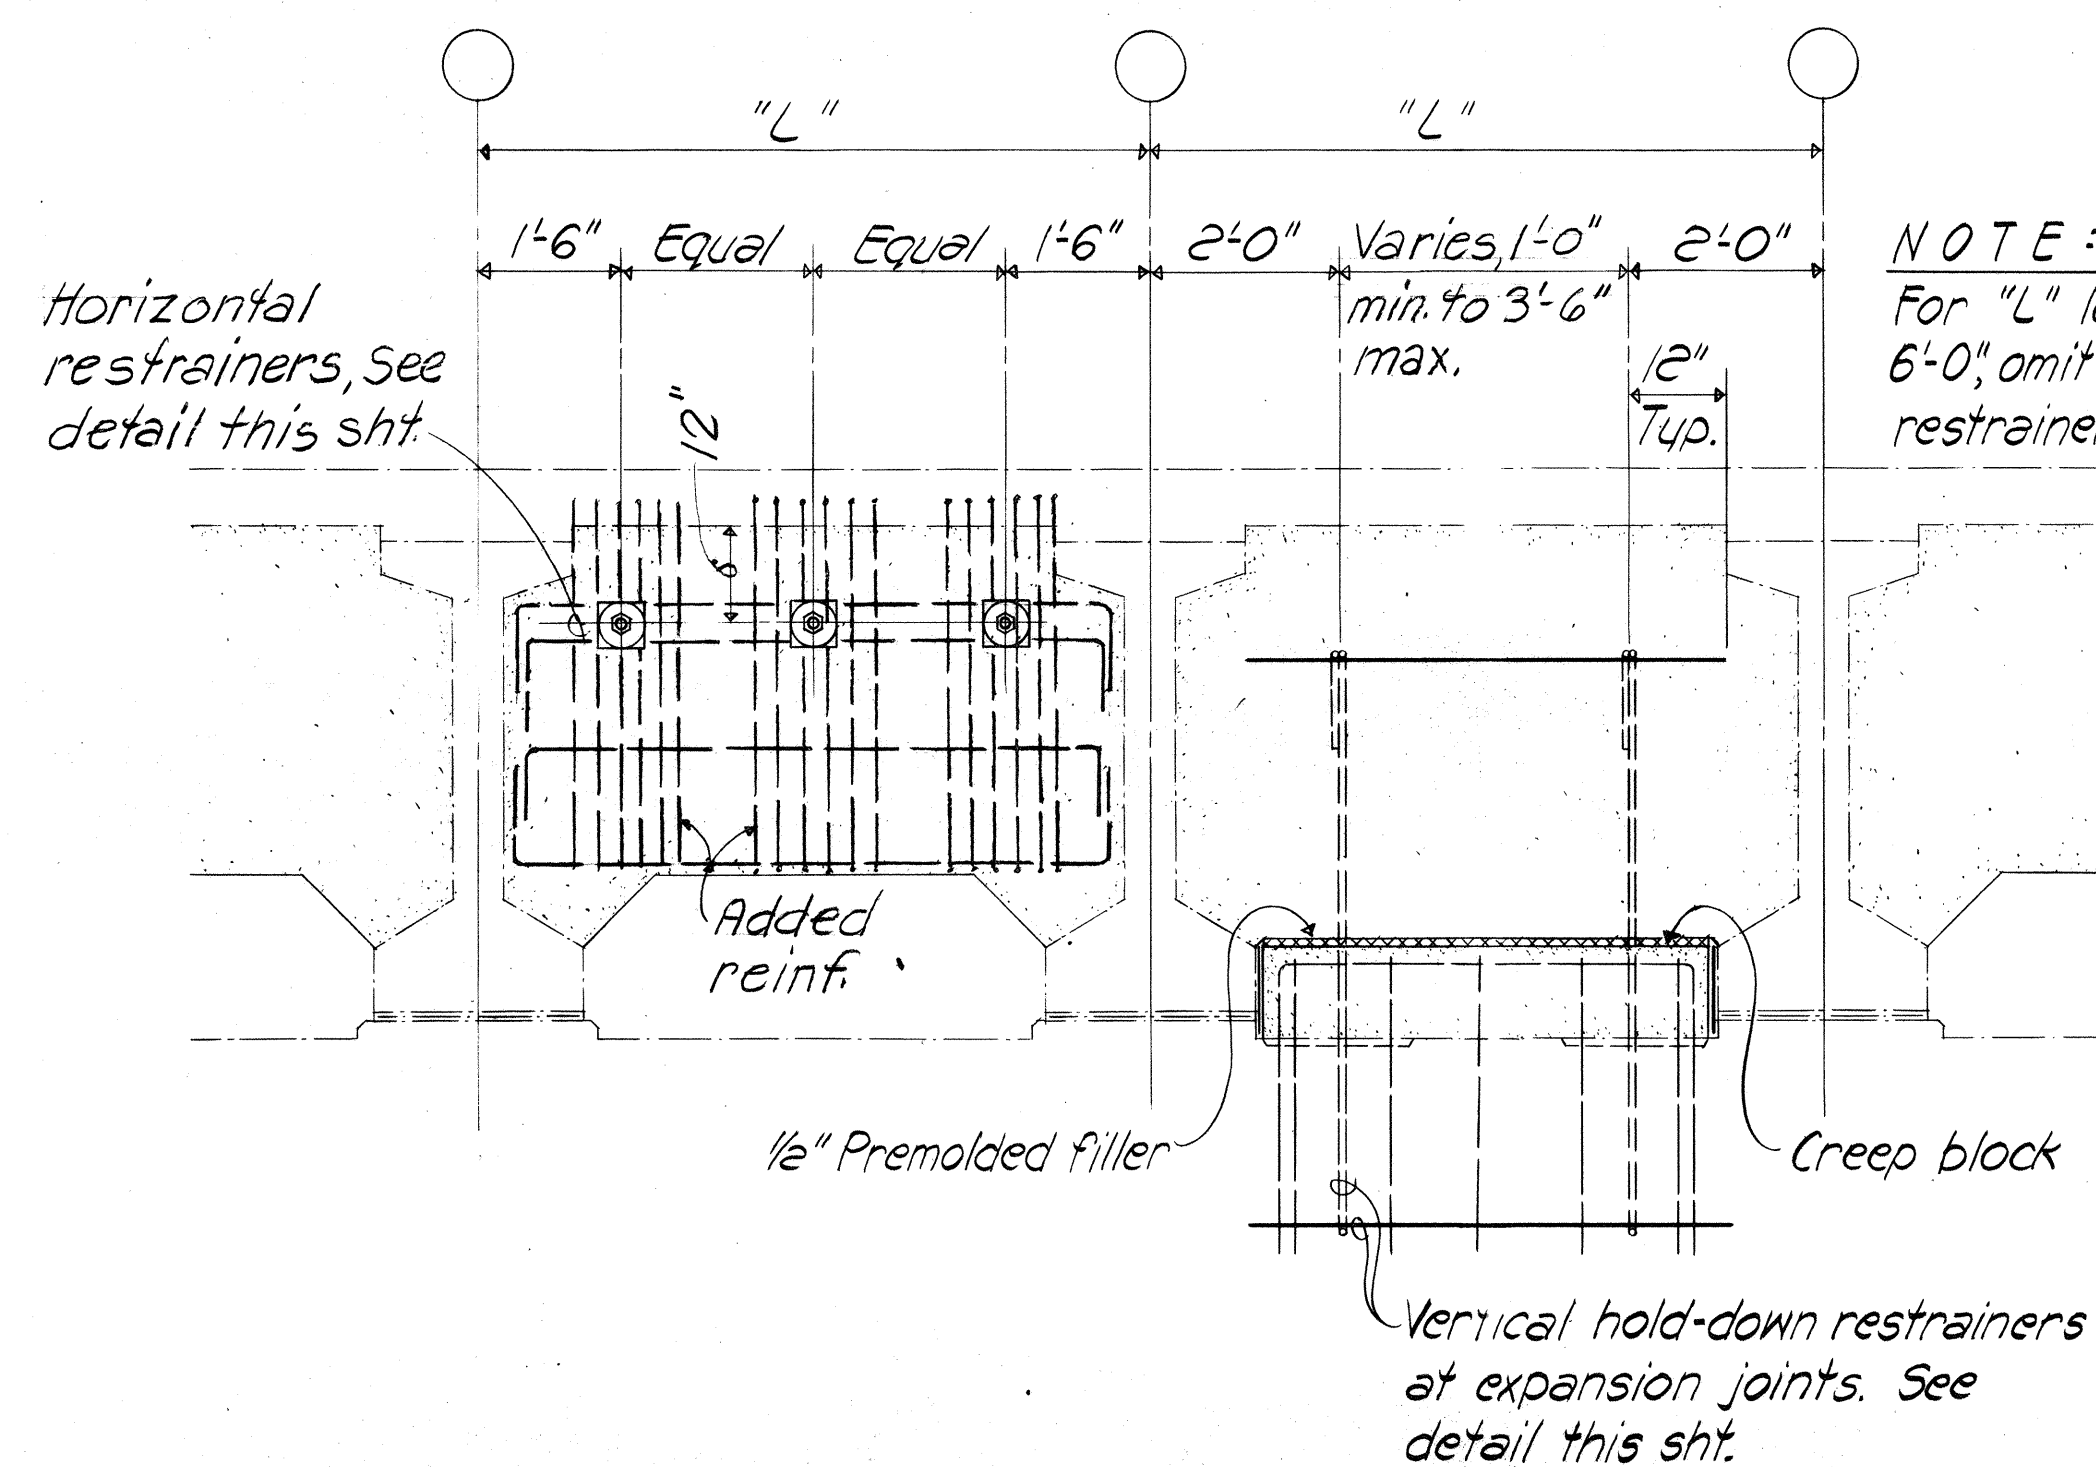


END BEAM ELEVATION AT EXPANSION JOINT
Scale: 1/2" = 1'-0"

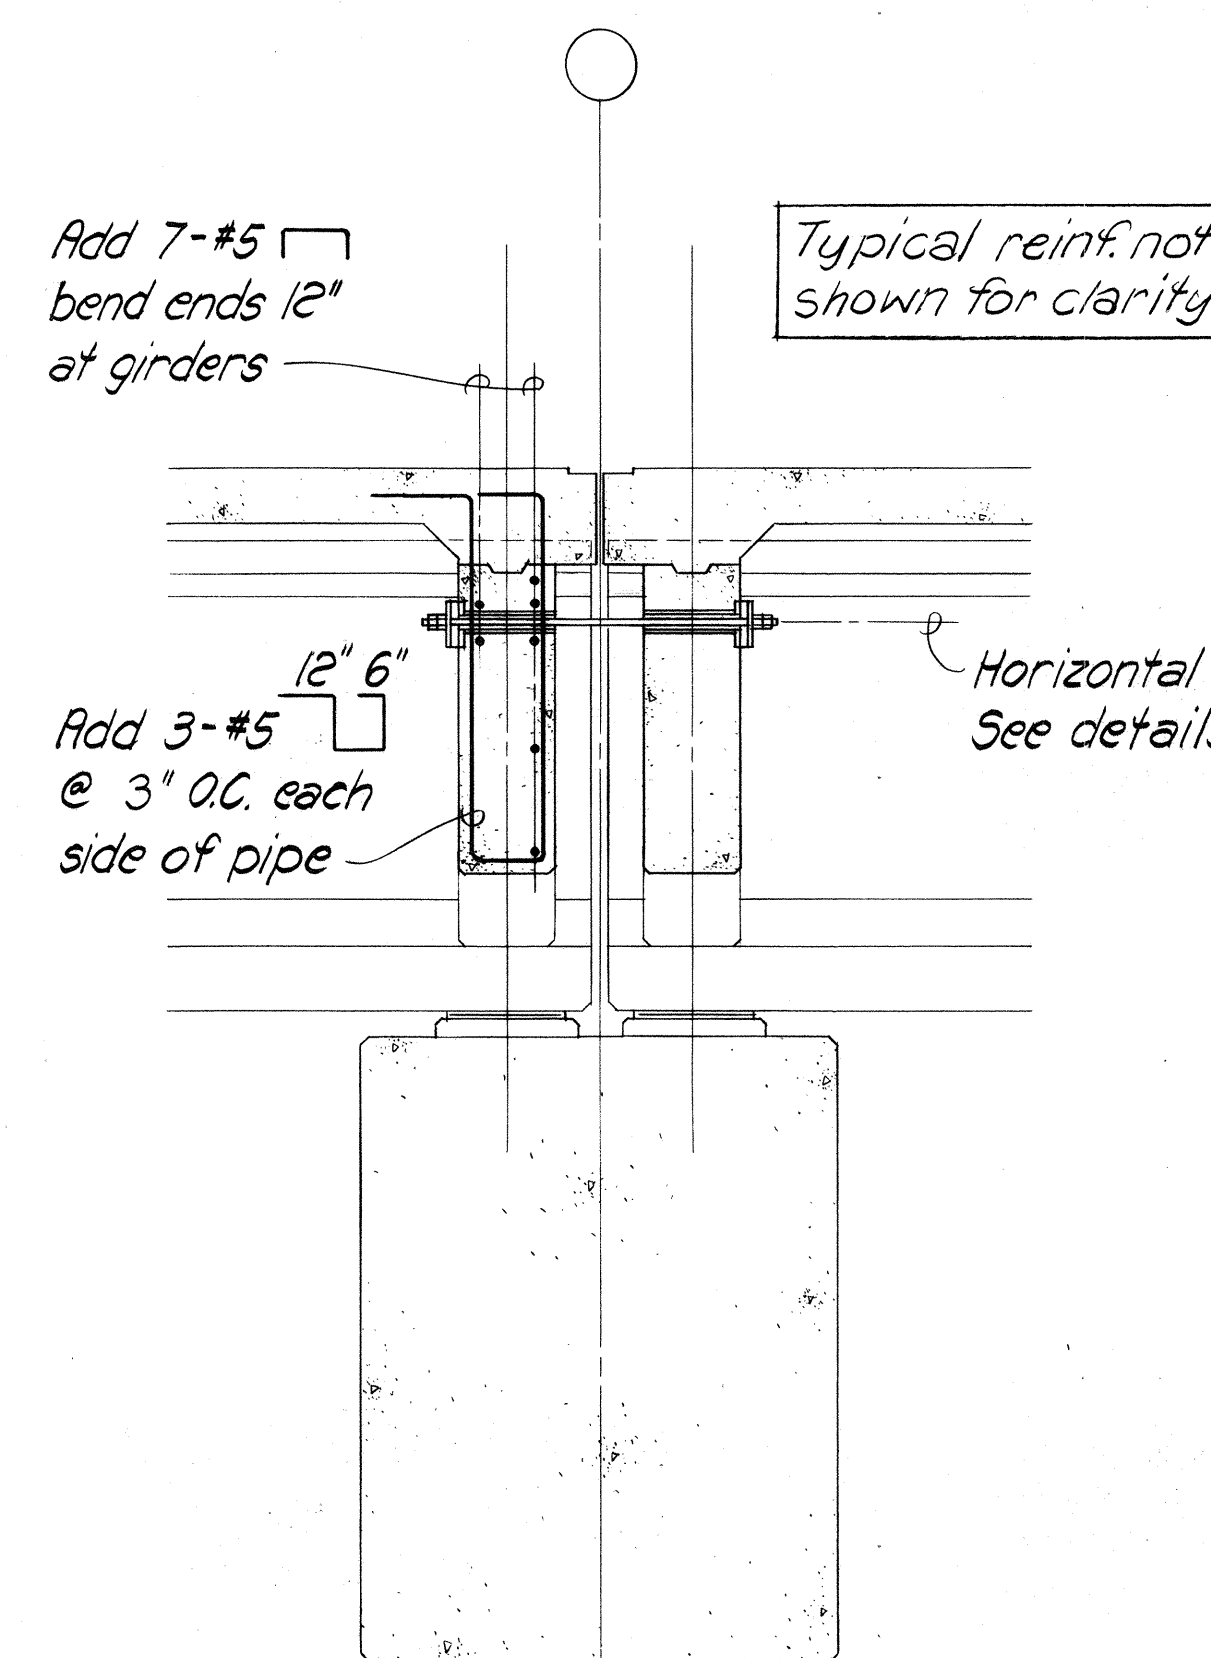


END BEAM SECTION AT DOUBLE EXPANSION END
Scale: 1/2" = 1'-0"

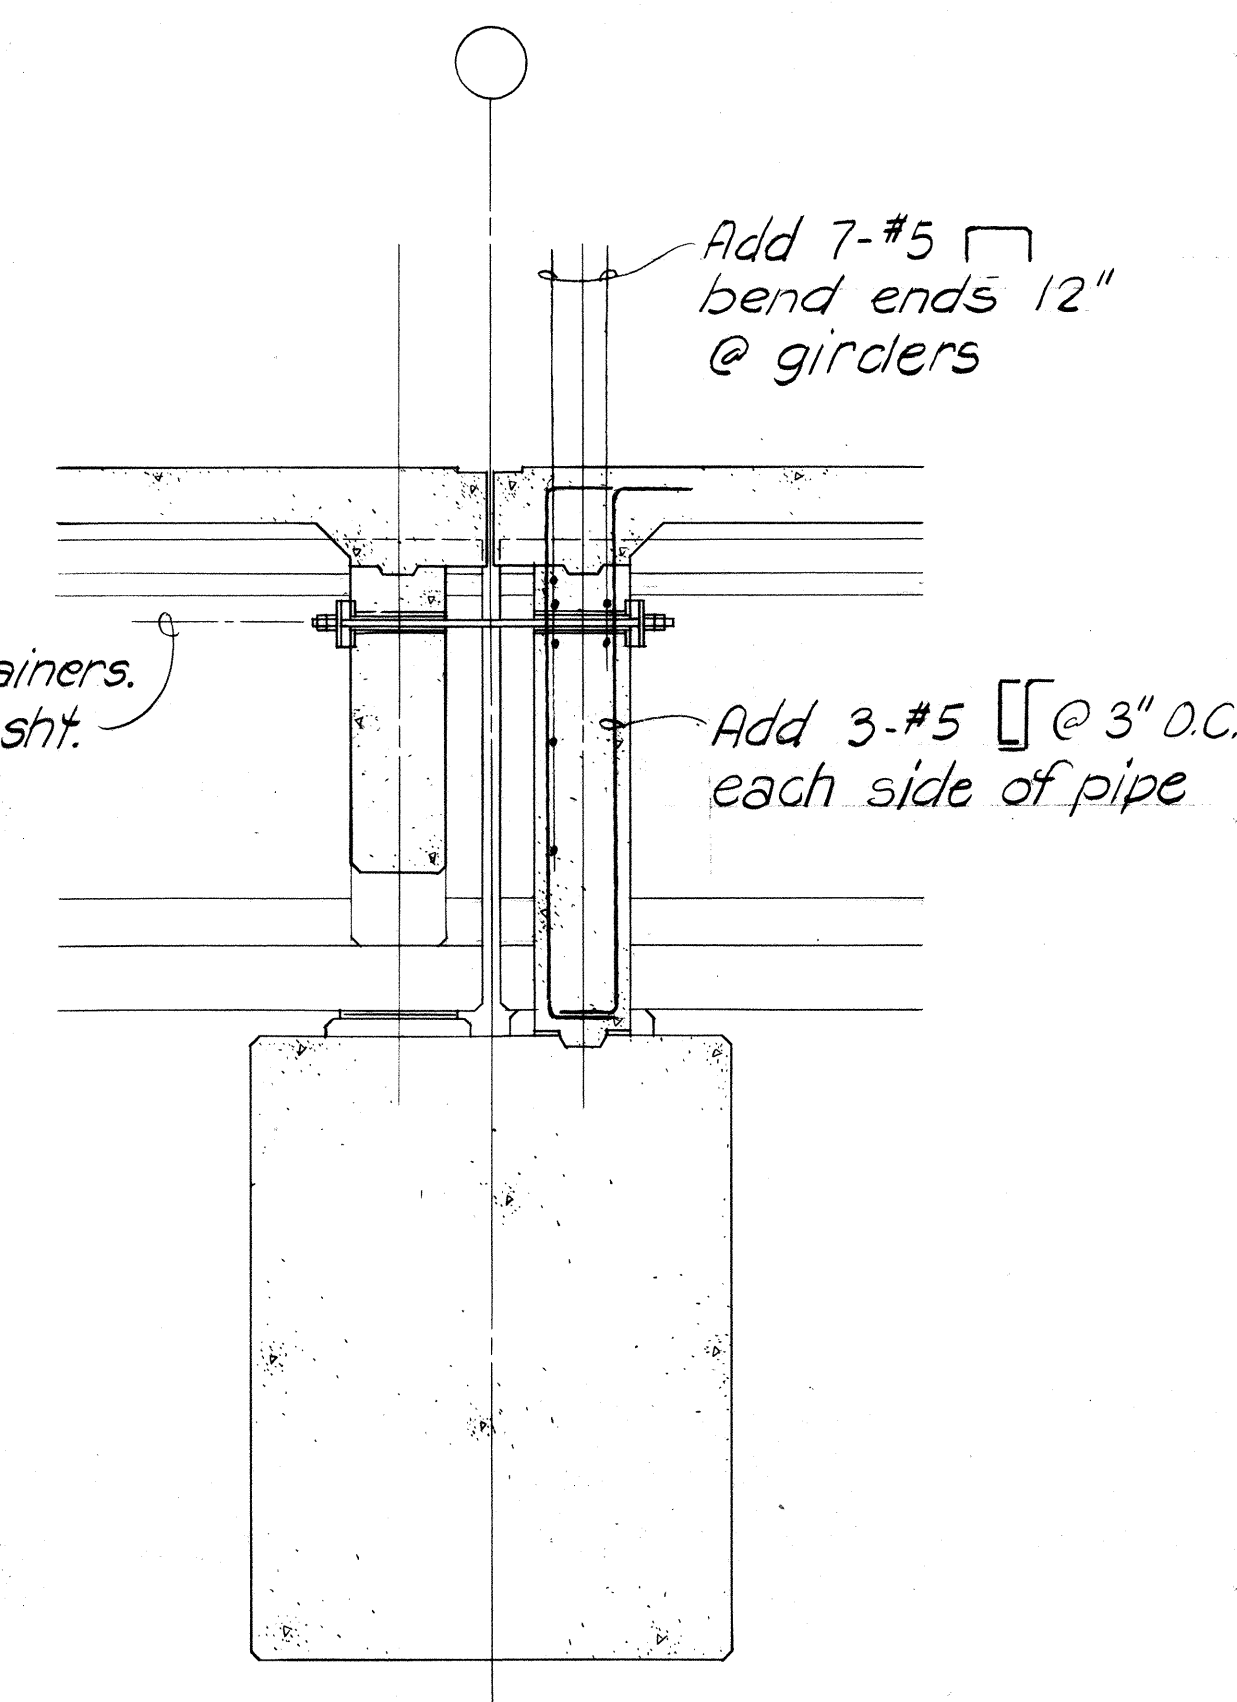


END BEAM SECTION AT EXPANSION & HINGE END
Scale: 1/2" = 1'-0"

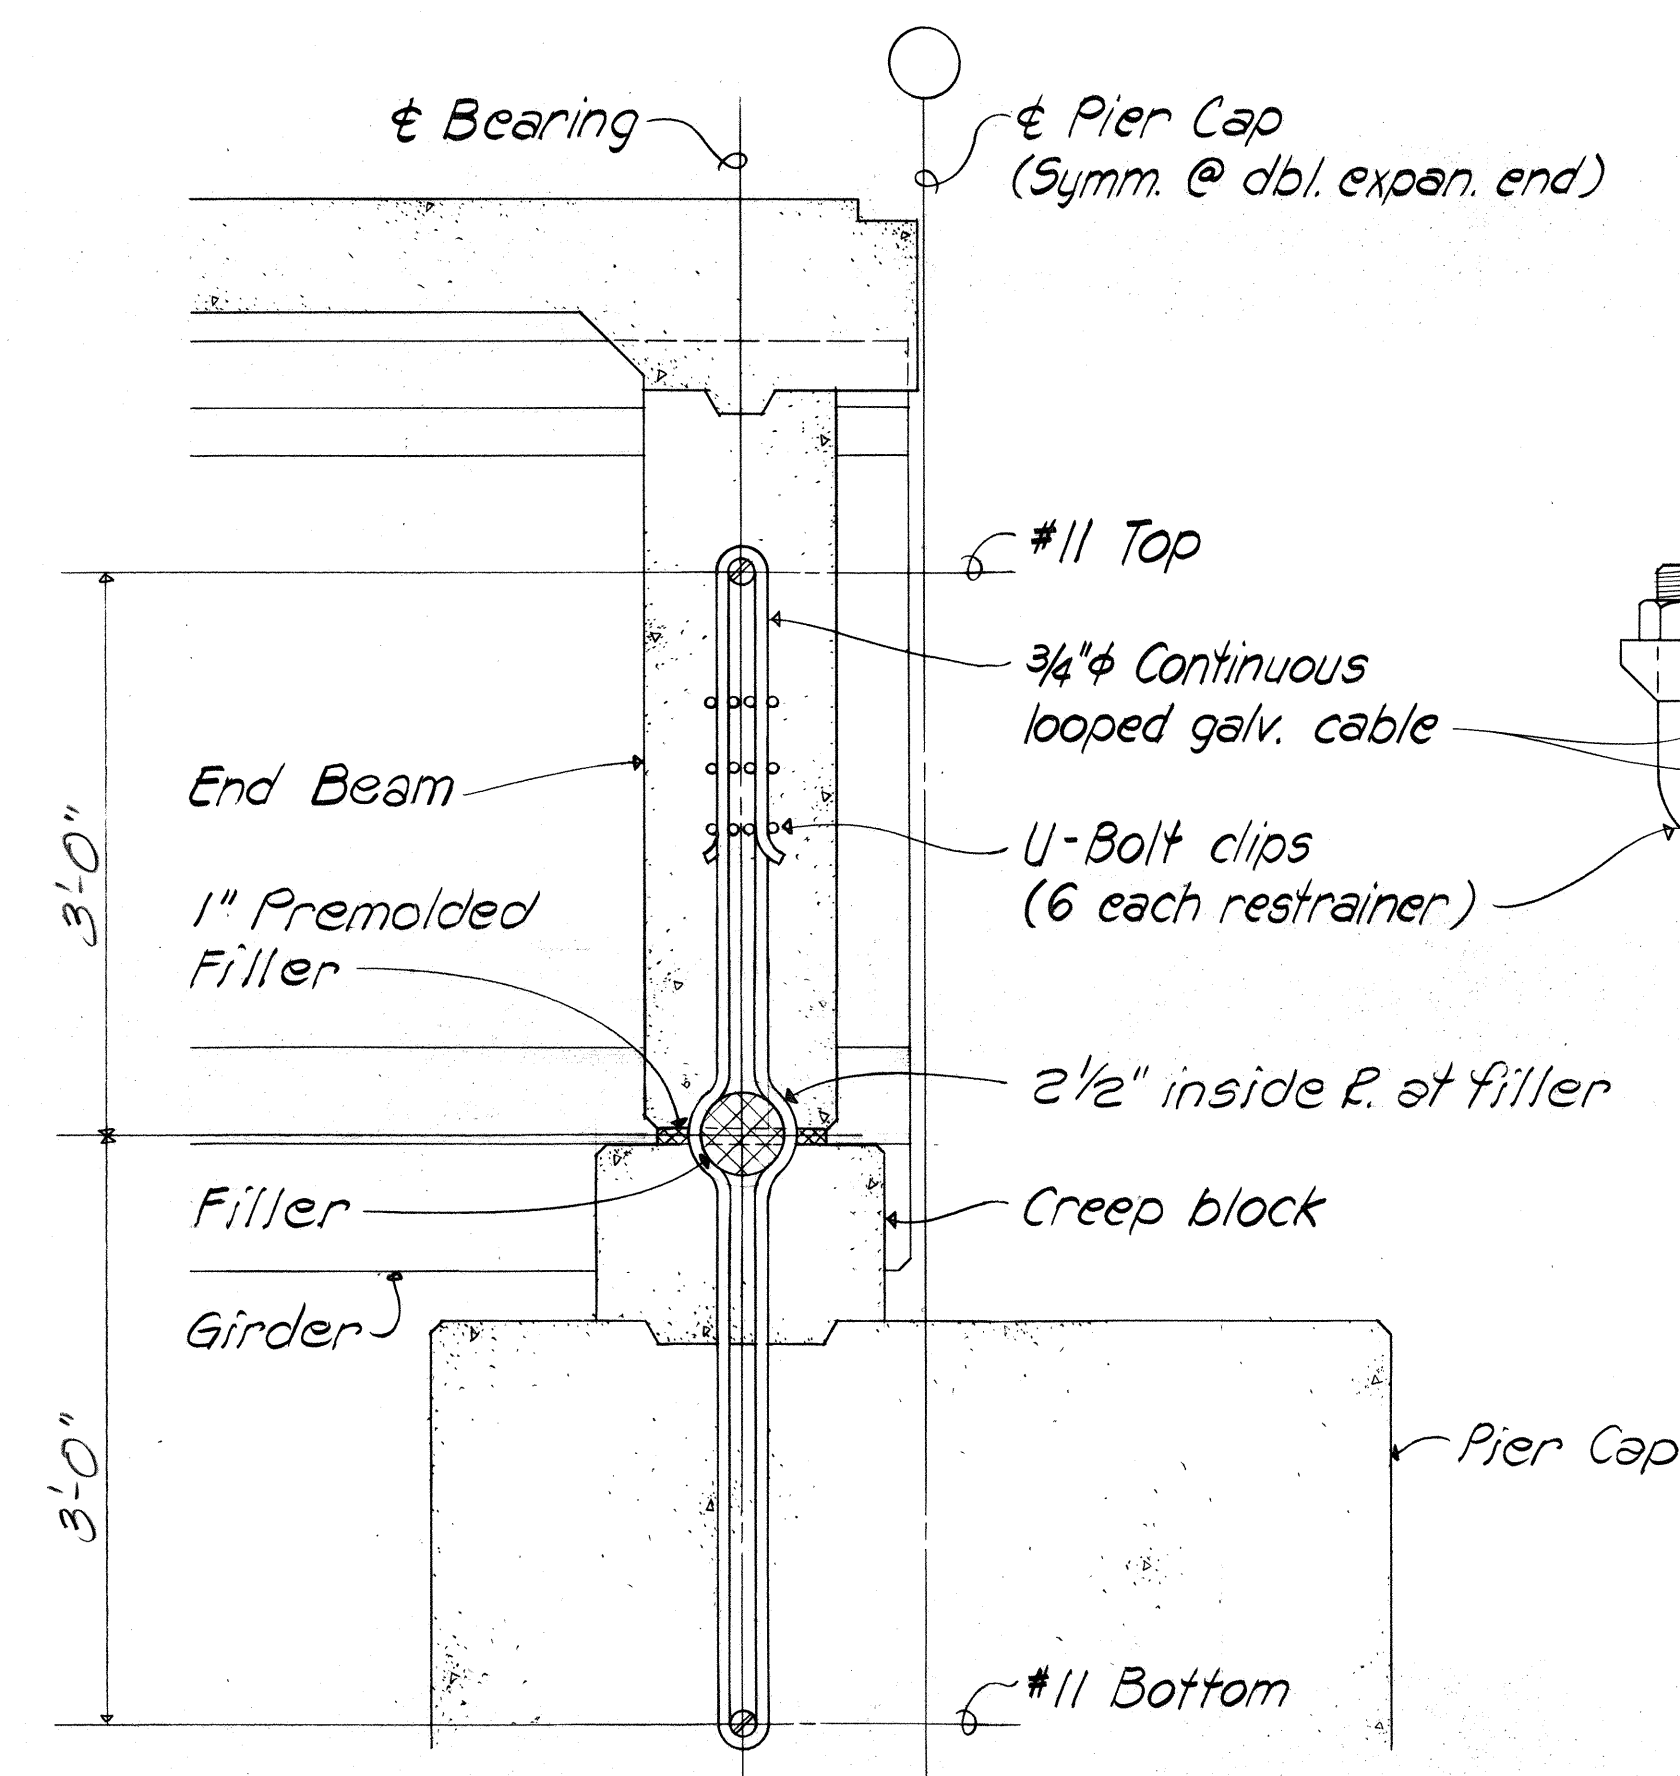

TYPICAL VERTICAL RESTRAINER DETAIL
Scale: 1" = 1'-0"

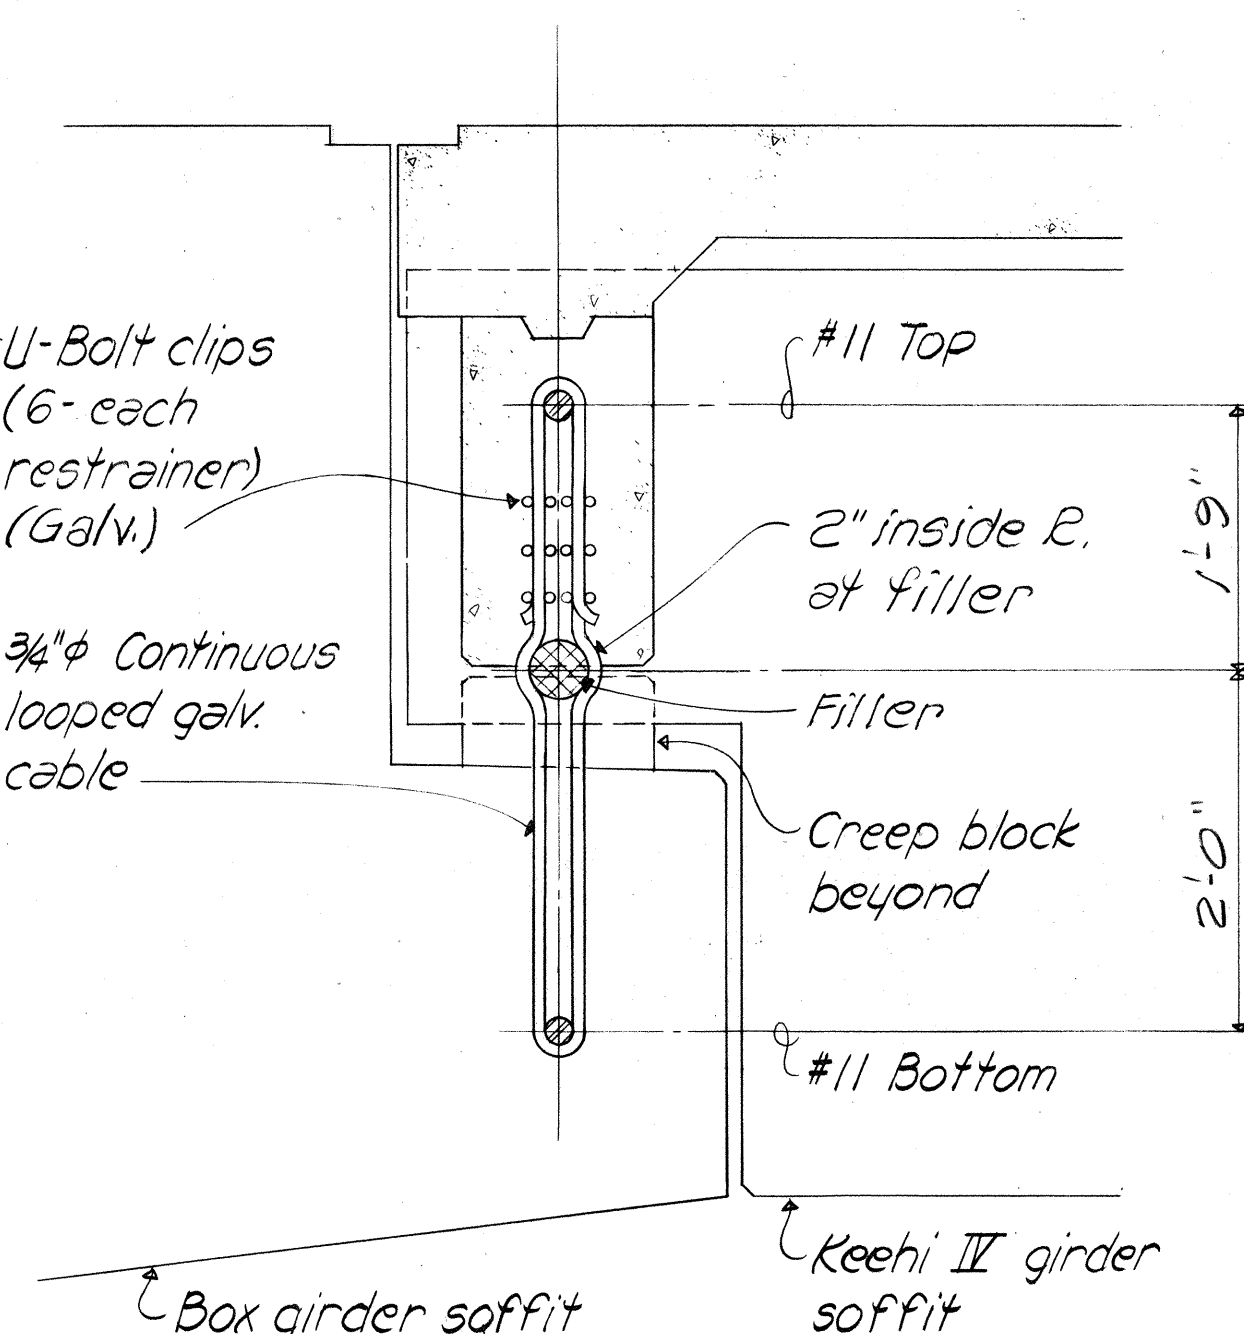


VERTICAL RESTRAINER AT GIRDER DAPPED END
Scale: 1" = 1'-0"

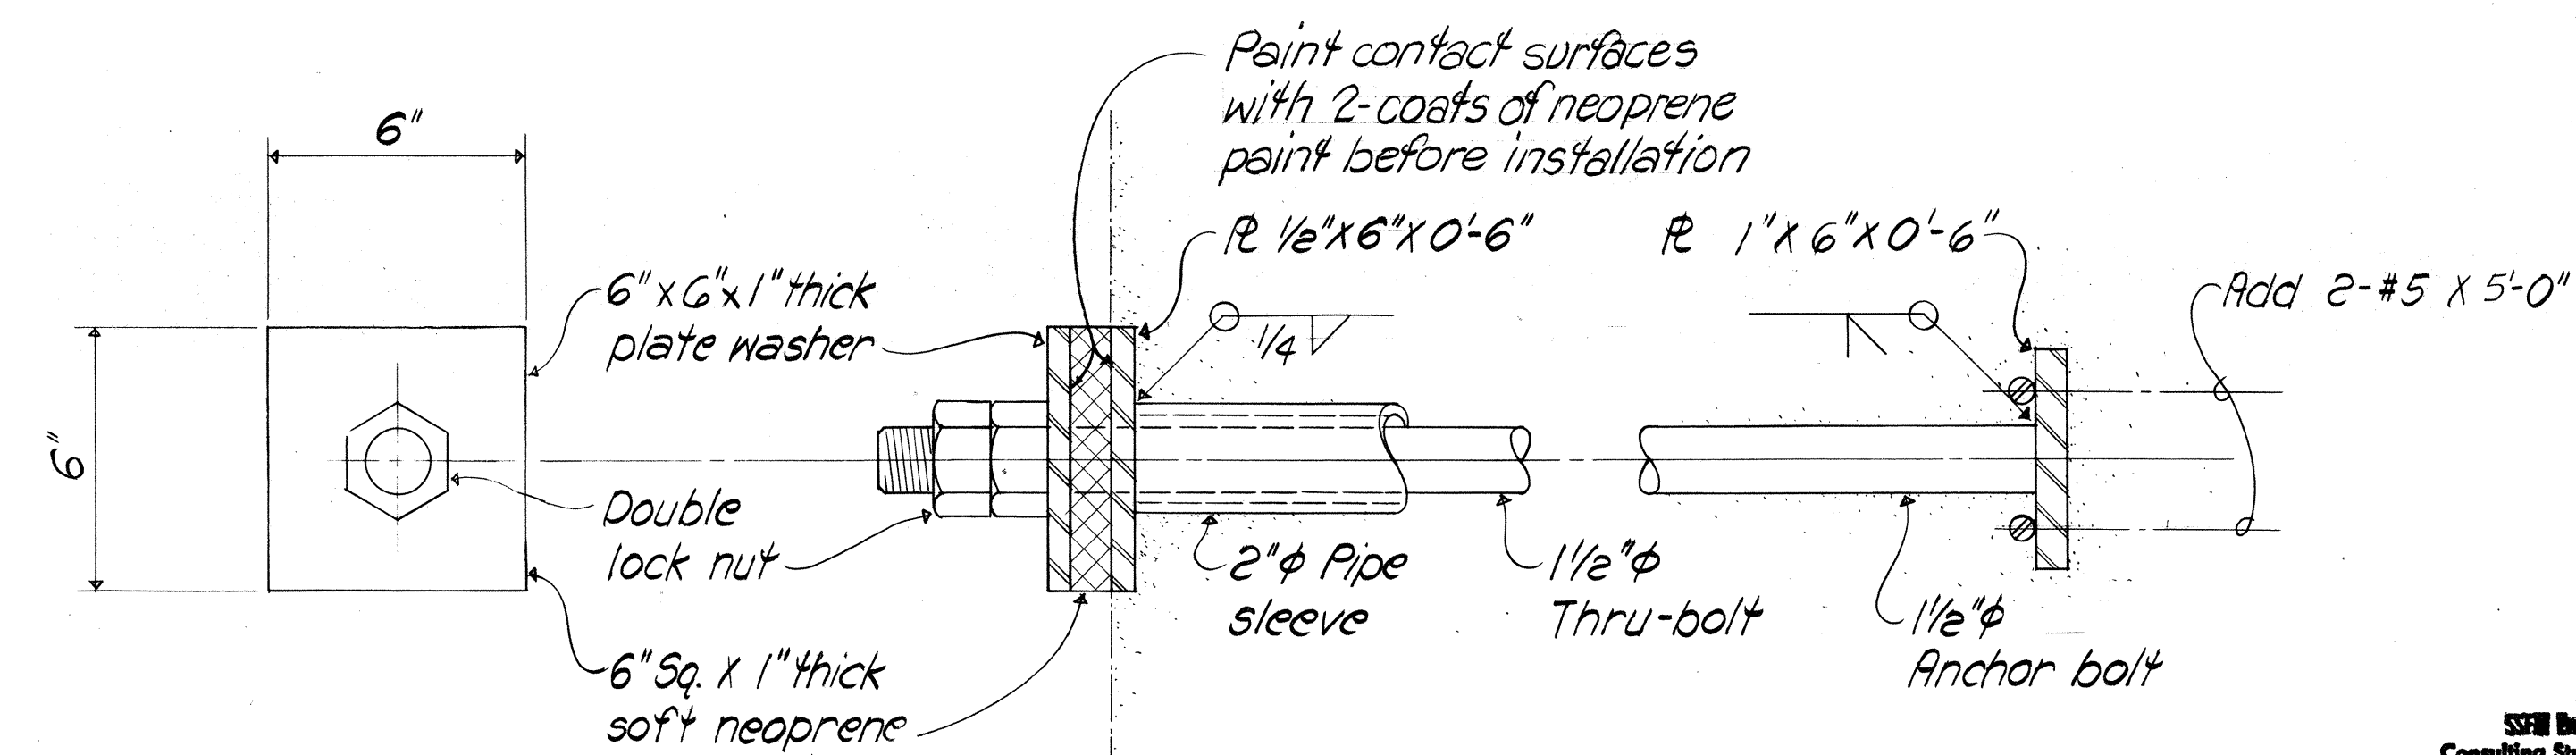

HORIZONTAL RESTRAINER DETAIL
Scale: 3" = 1'-0"

- NOTES:
- Galv. all hardware after fabrication.
 - Paint all exposed surfaces with 2 coats of neoprene paint after installation.

SS&B Engineers, Inc.
Consulting Structural Engineers
1210 Ward Ave., Honolulu, HI 96814

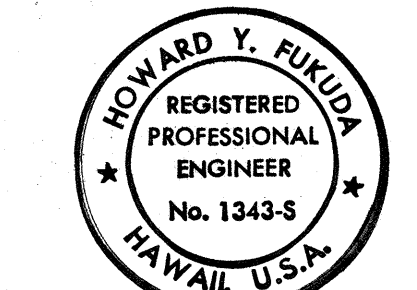


This work was prepared by me or under my supervision.
Howard Y. Fukuda

STATE OF HAWAII
DEPARTMENT OF TRANSPORTATION
HIGHWAYS DIVISION







HINGE RESTRAINER DETAILS

INTERSTATE ROUTE H-3
FAI PROJ. NO. I-H3-1(51)
SCALE: AS NOTED DATE: AUG, 1984
SHEET NO. 7/5 OF 21 SHEETS

FED. ROAD DIST. NO.	STATE	FED. AID PROJ. NO.	FISCAL YEAR	SHEET NO.	TOTAL SHEETS
HAWAII	HAW.	I-H3-1(51)	1989	101	106

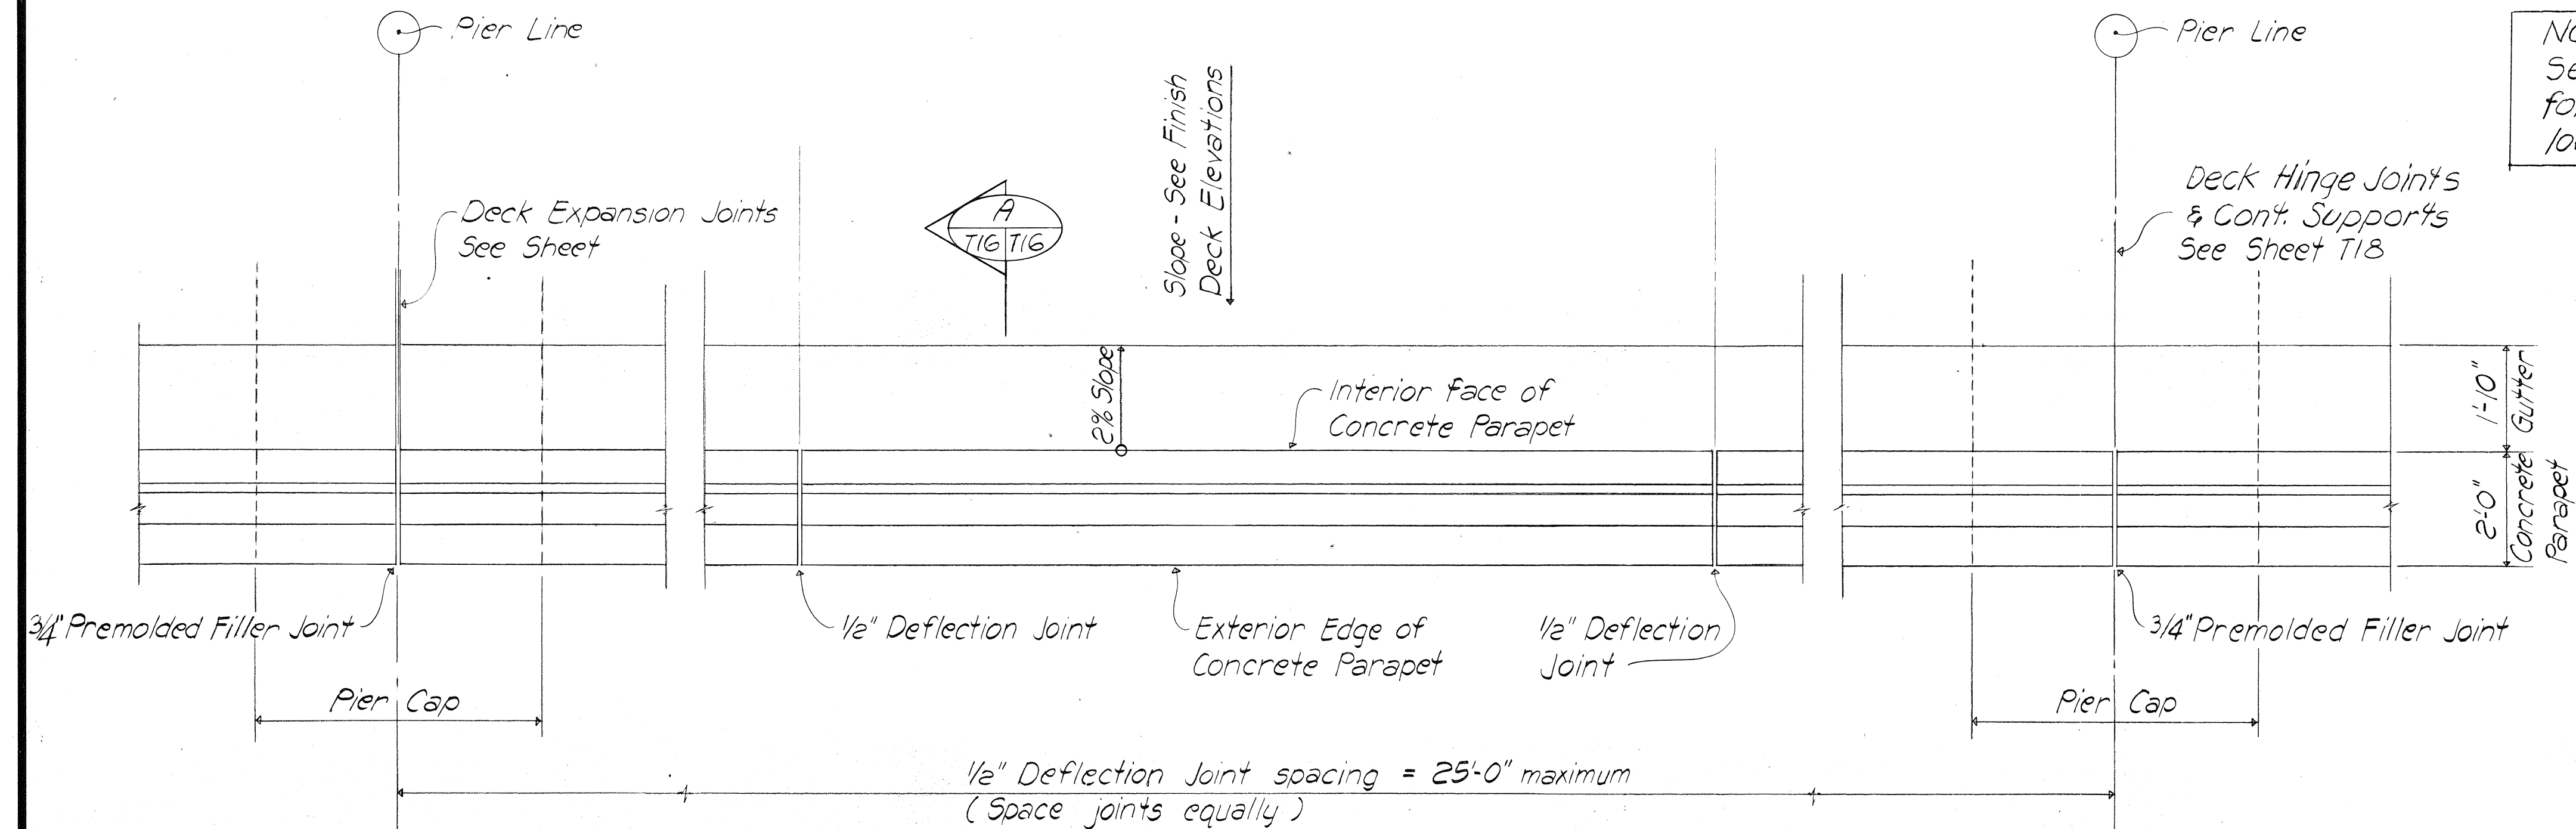

NOTE:
See Electrical Drawings
for duct & junction box
locations in parapet.

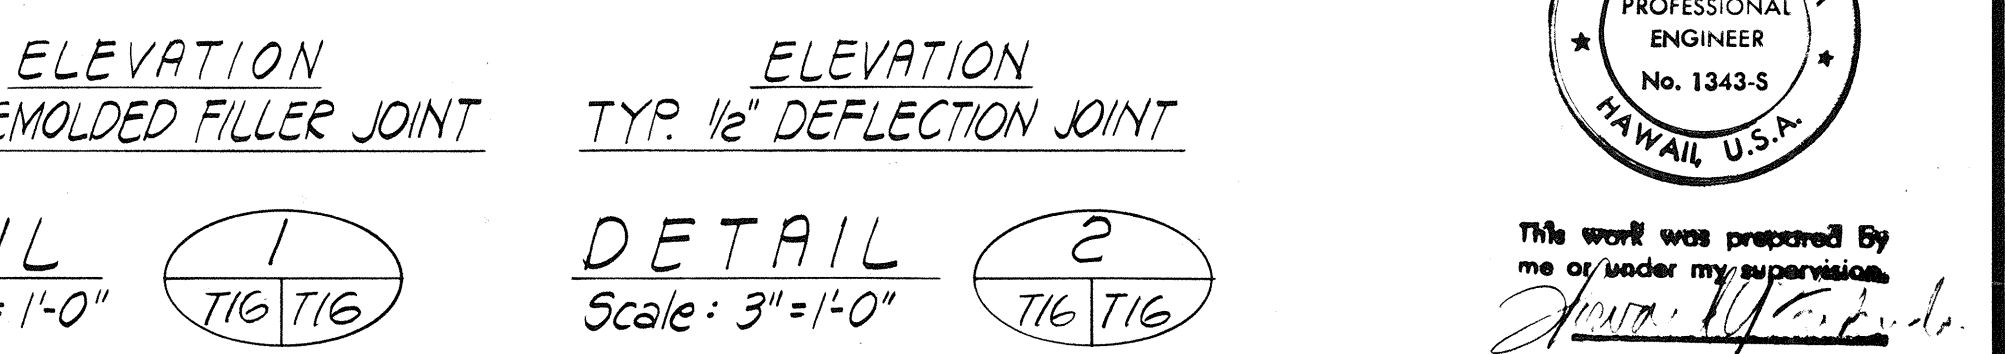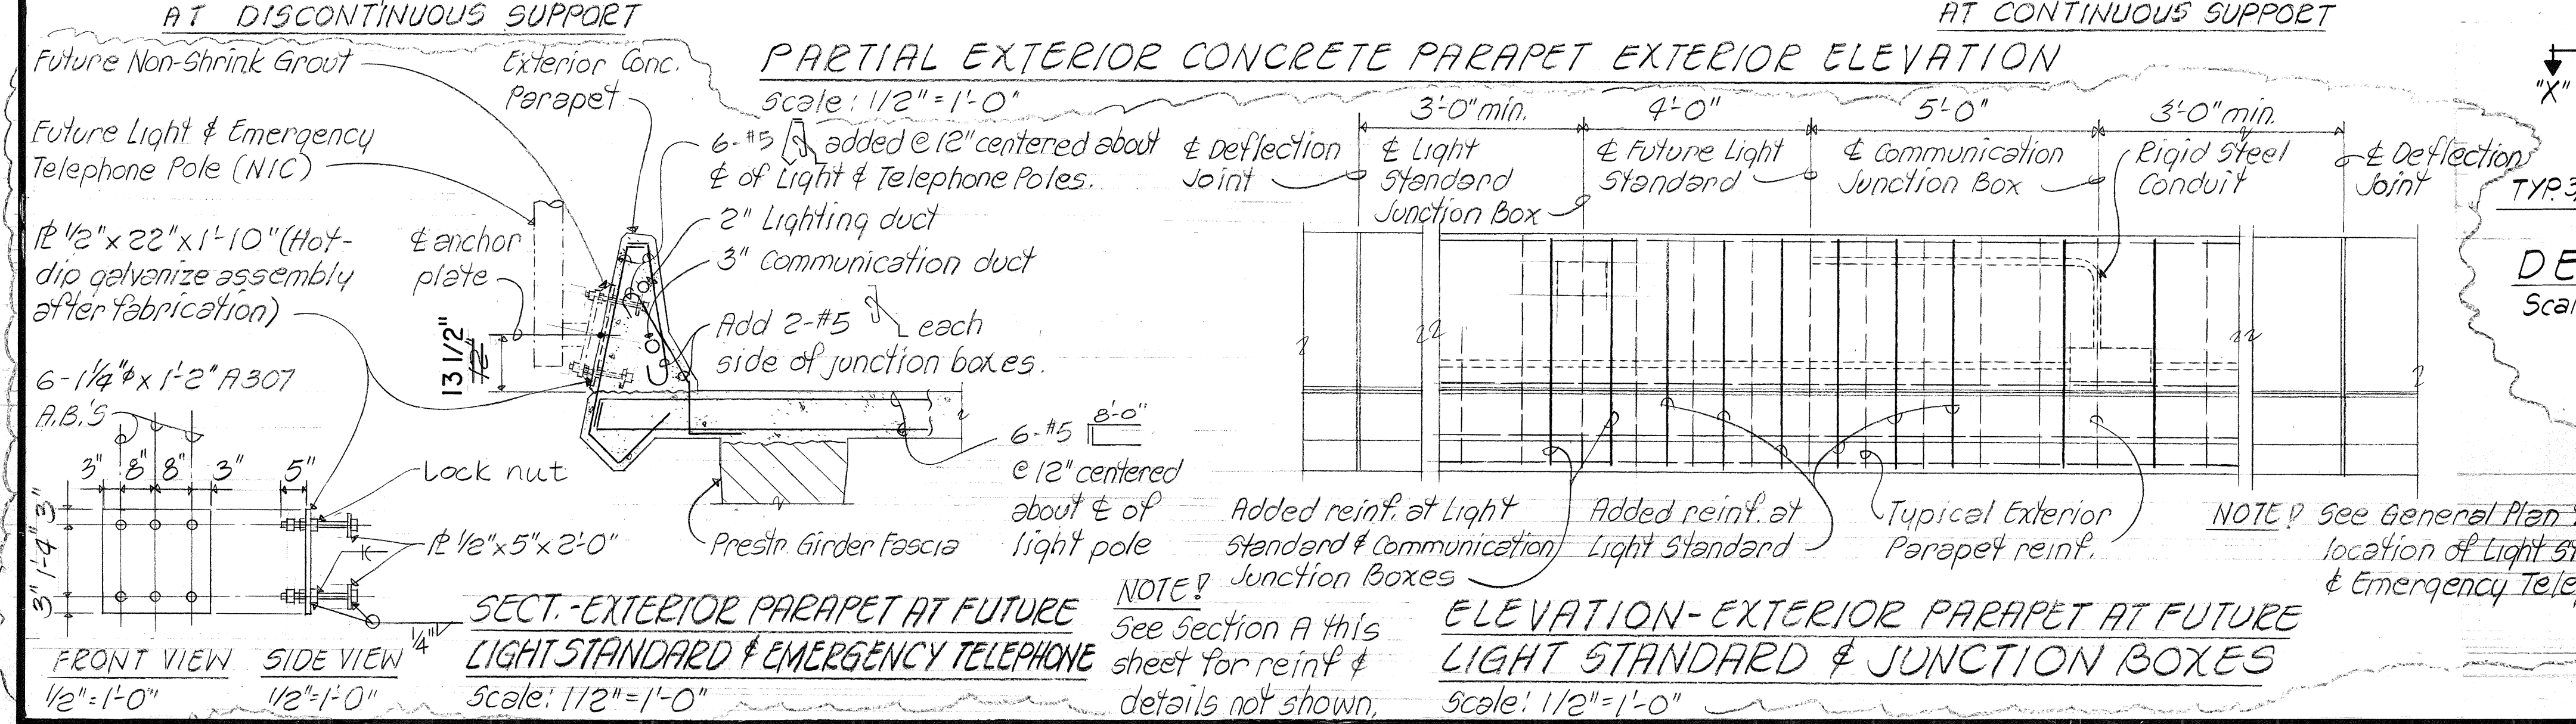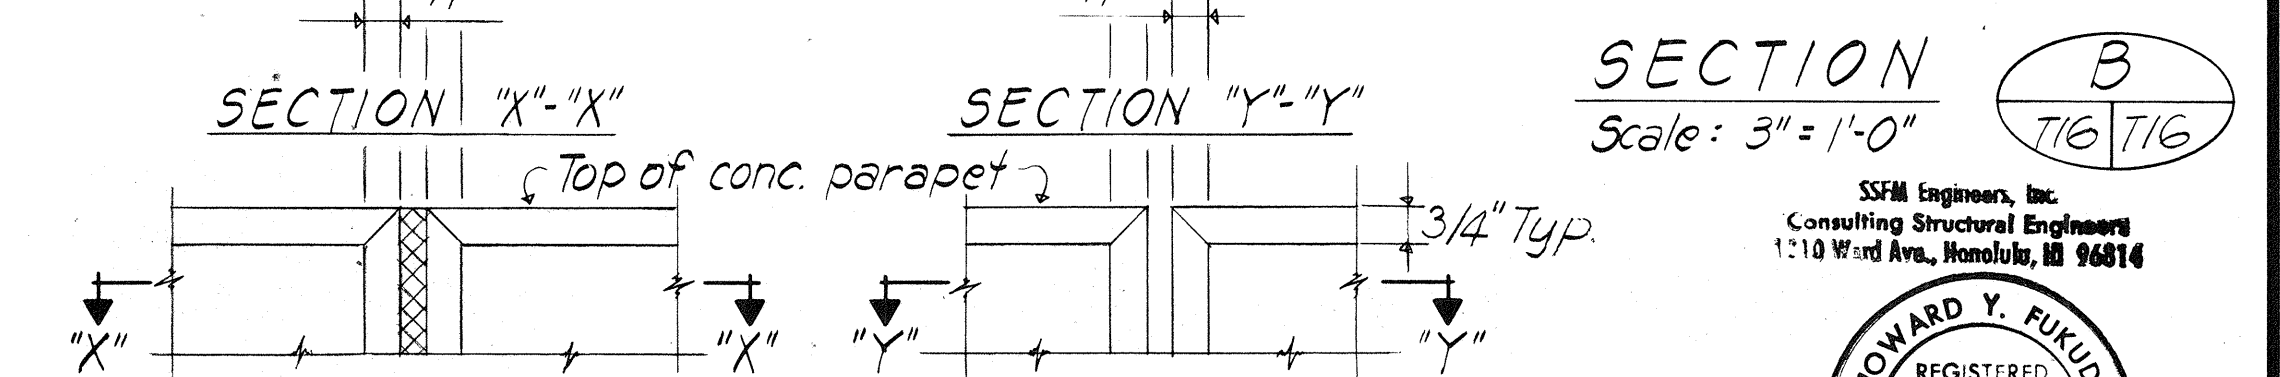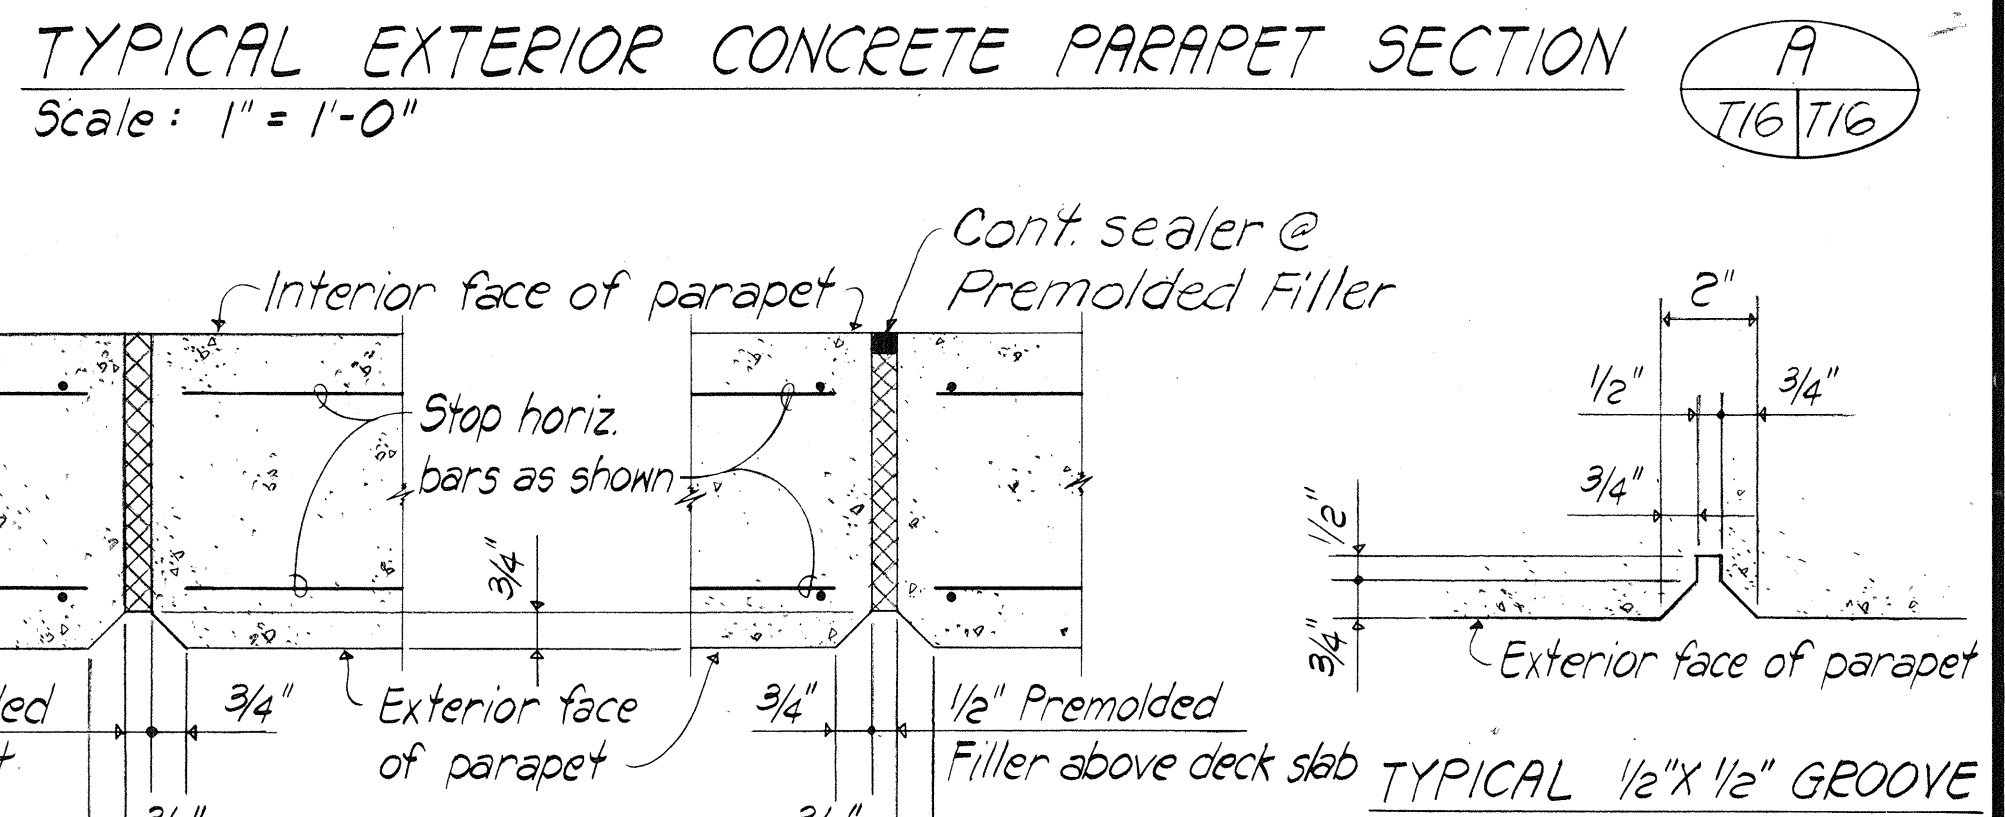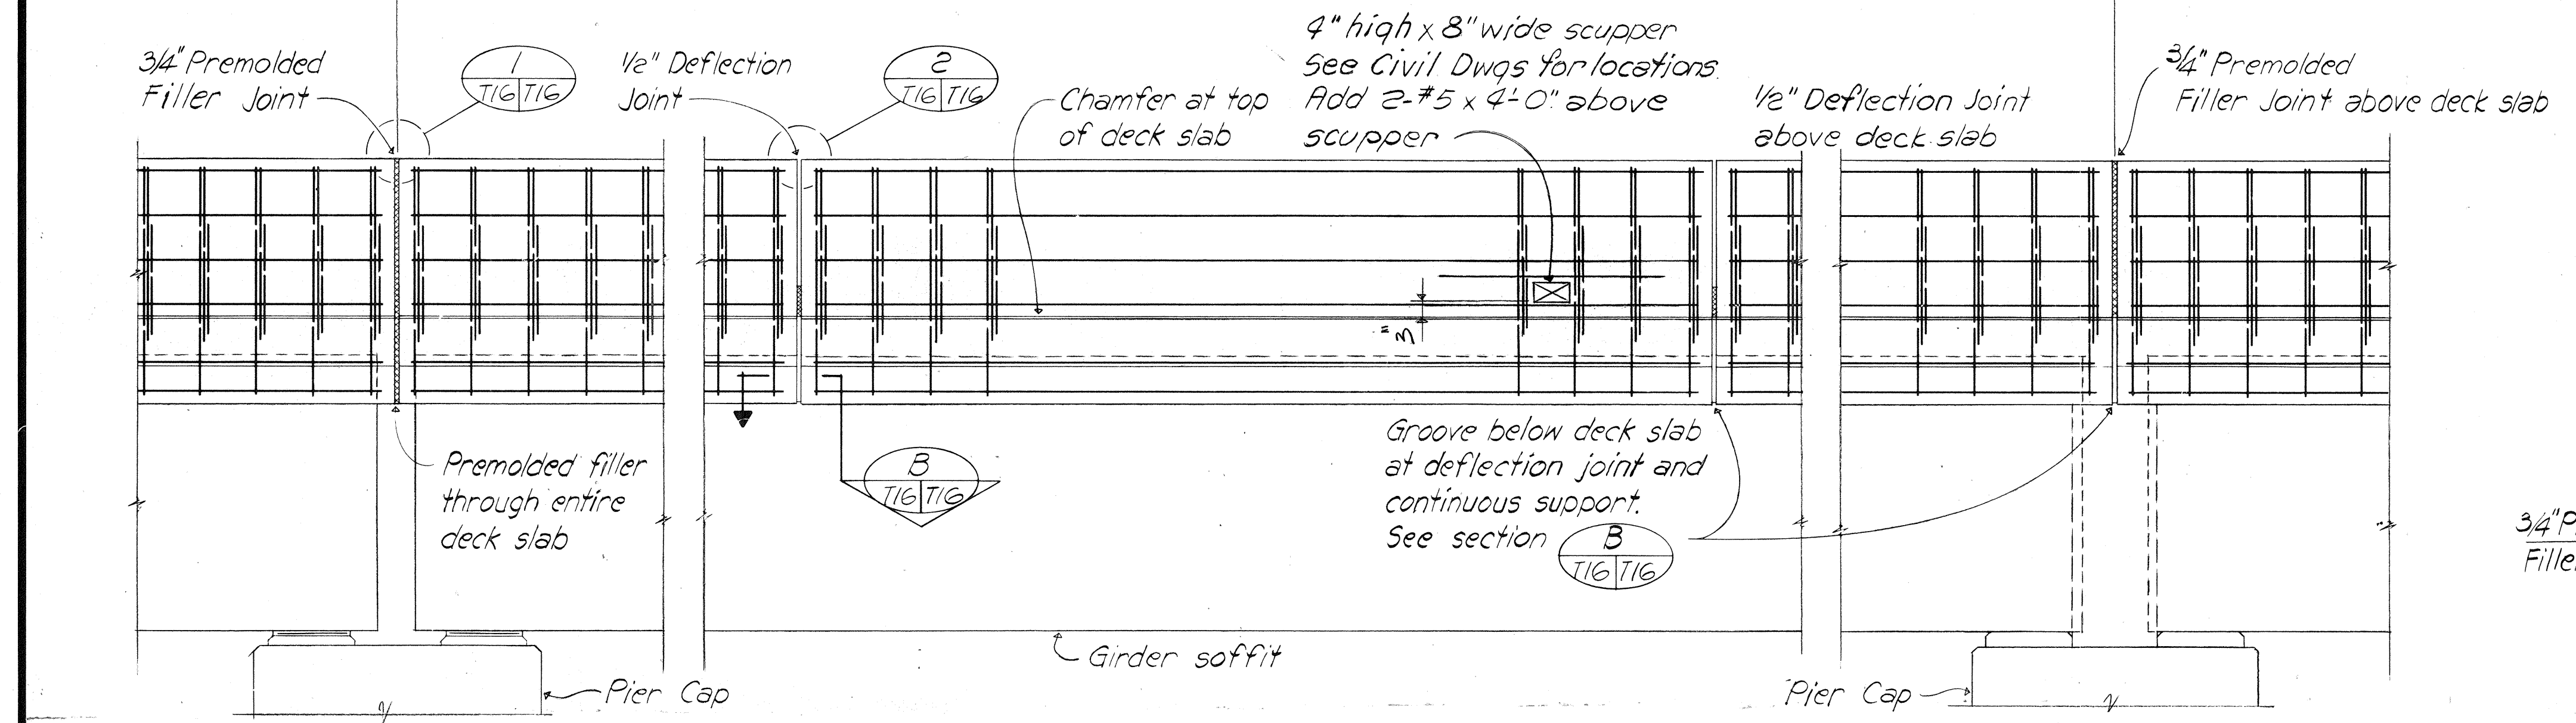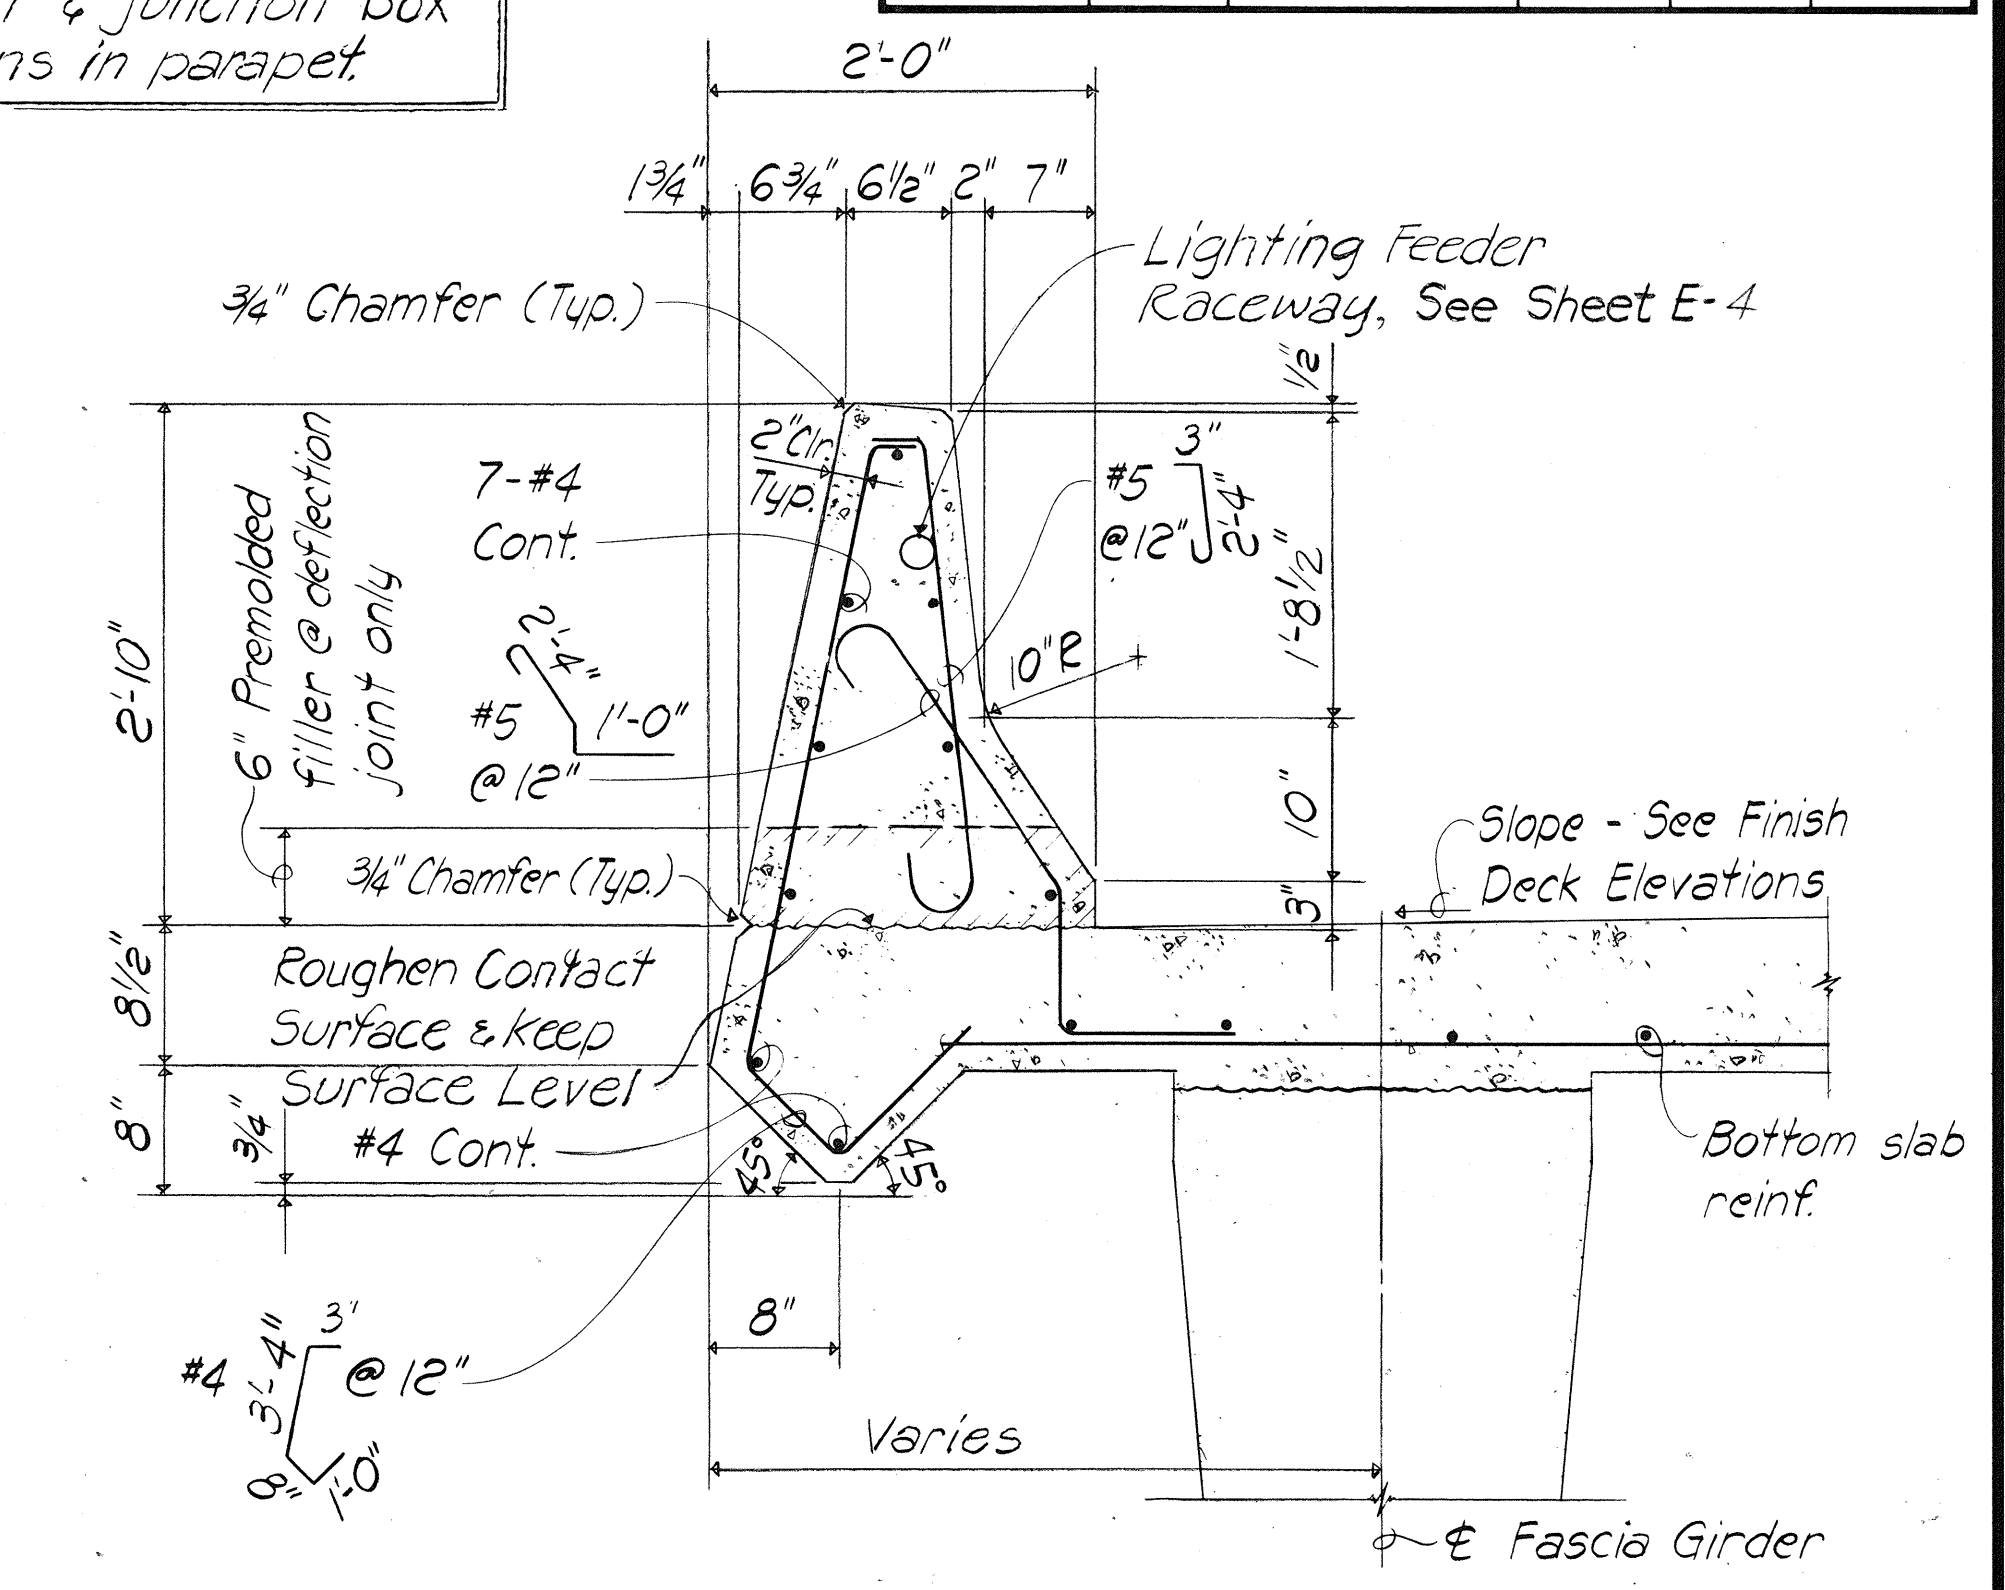

DETAIL 1
Scale: 3" = 1'-0"

DETAIL 2
Scale: 3" = 1'-0"

STATE OF HAWAII
DEPARTMENT OF TRANSPORTATION
HIGHWAYS DIVISION

EXTERIOR PARAPET DETAILS

INTERSTATE ROUTE H-3
F.A.I. PROJ. NO. I-H3-1(51)


SCALE: AS NOTED DATE: 11/190

Added details at light & emergency telephone pole

DATE Revision


SHEET NO. 101 OF 21 SHEETS

SURVEY PLOTTED BY	DATE
DRAWN BY	
DESIGNED BY	
QUANTITIES BY	
CHECKED BY	
ORIGINAL PLAN	
NOTE BOOK	
NO.	

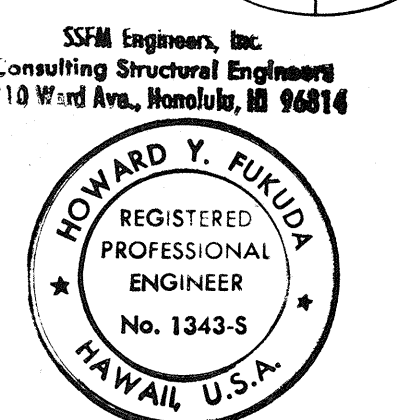


This work was prepared by me or under my supervision.


FED. ROAD DIST. NO.	STATE	FED. AID PROJ. NO.	FISCAL YEAR	SHEET NO.	TOTAL SHEETS
HAWAII	HAW.	I-H3-1(51)	1989	102	106

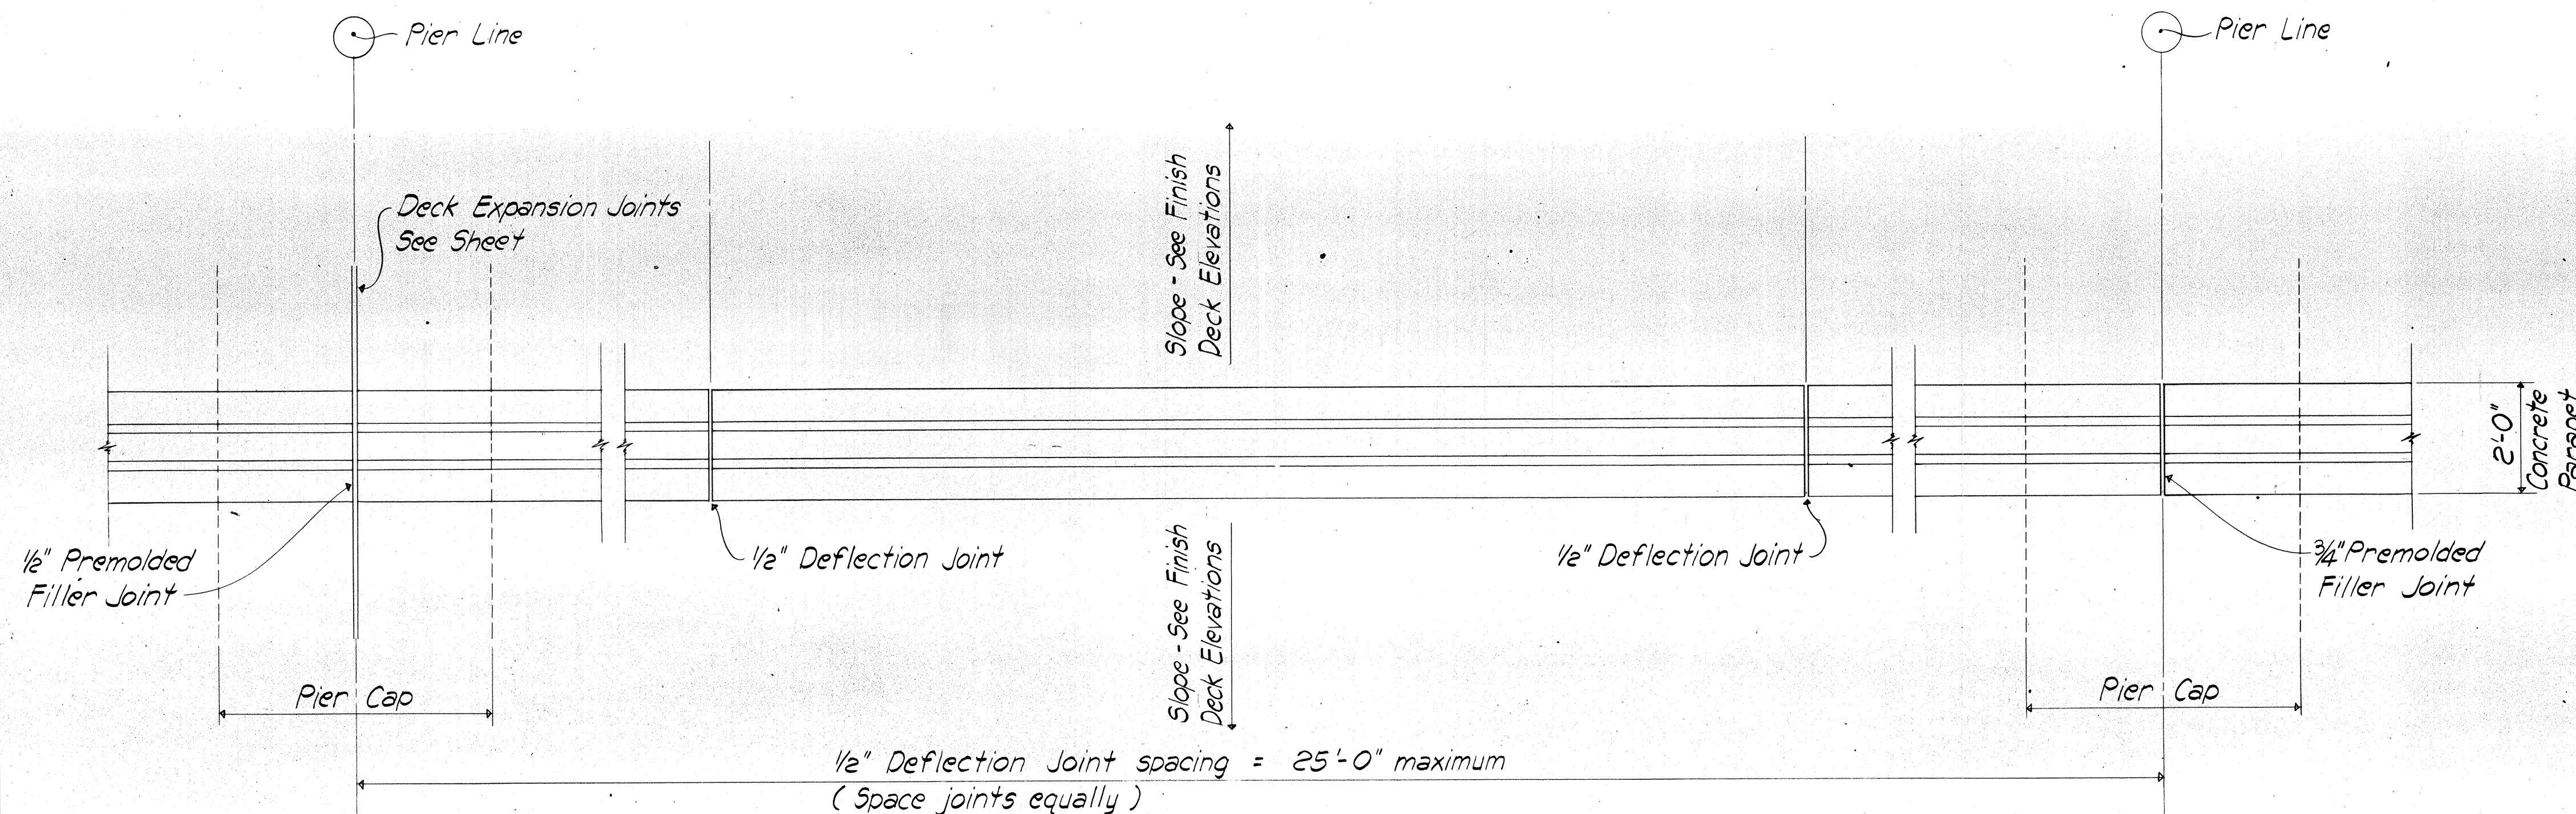

PARTIAL PLAN - INTERIOR CONCRETE PARAPET
Scale: 1/2" = 1'-0"

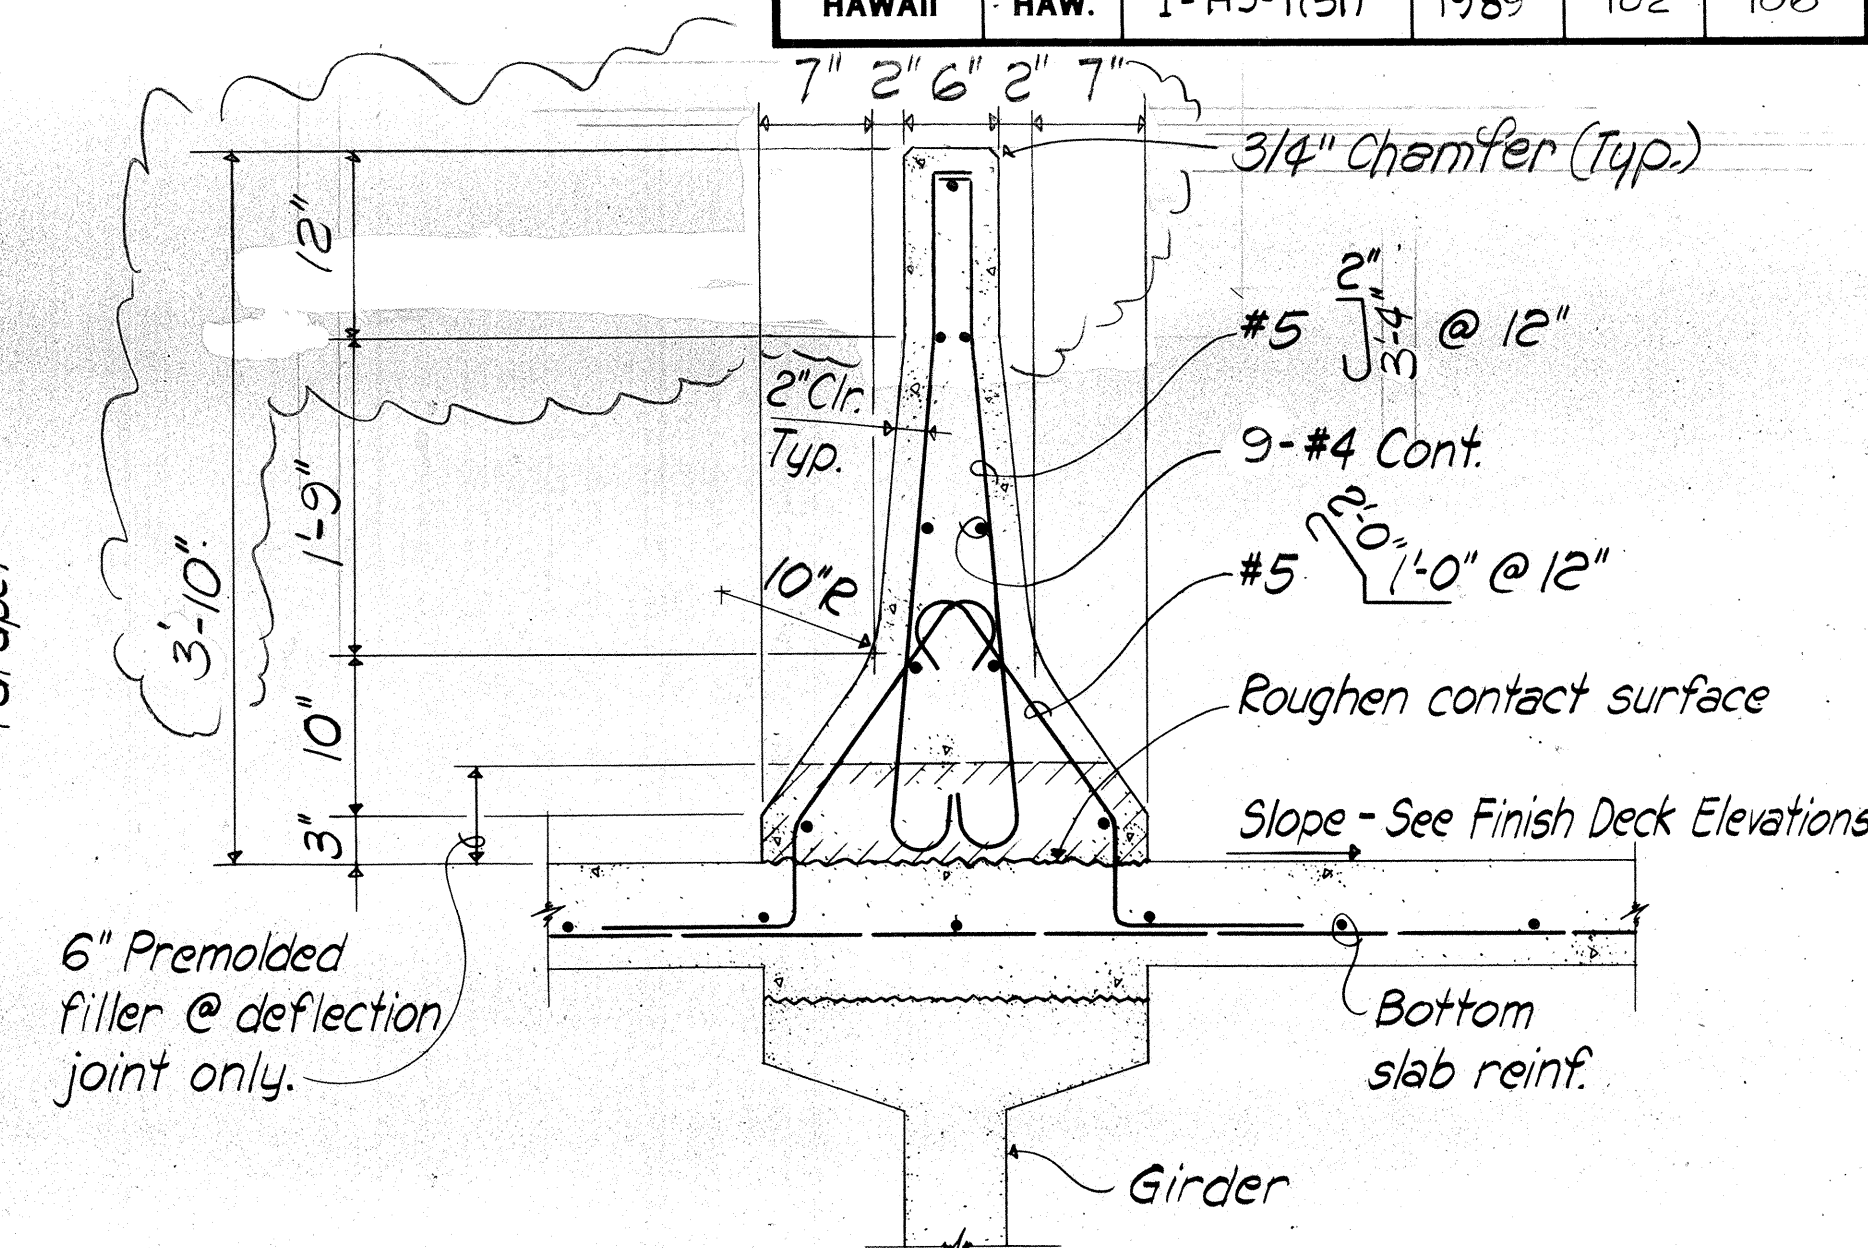


TYPICAL INTERIOR CONCRETE PARAPET SECTION
Scale: 1" = 1'-0"

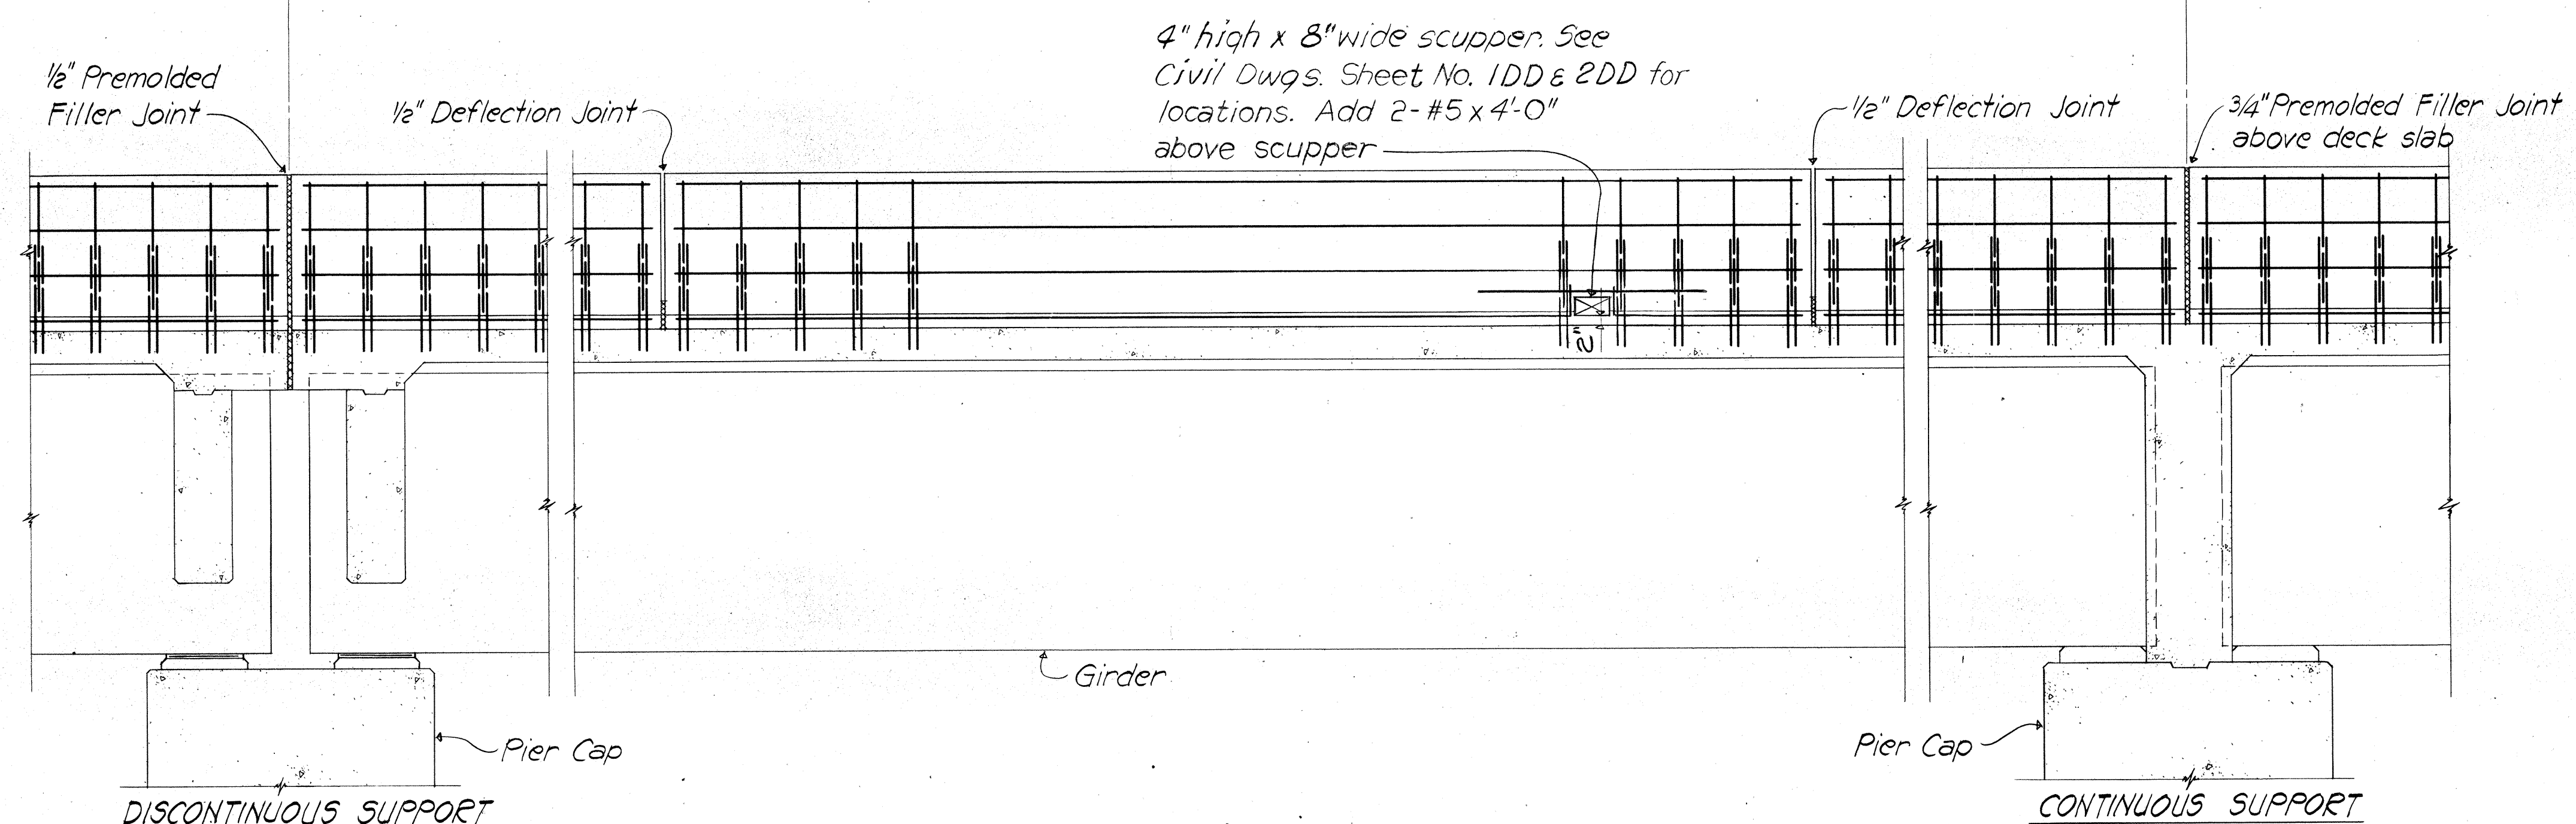

PARTIAL ELEVATION - INTERIOR CONCRETE PARAPET
Scale: 1/2" = 1'-0"

- REFERENCE DRAWINGS:
1. Premolded filler & deflection joint details-----Sht. T16
 2. Expansion joint detail-----Sht. T18

2078 Engineers, Inc.
Consulting Structural Engineers
1210 Ward Ave., Honolulu, HI 96814

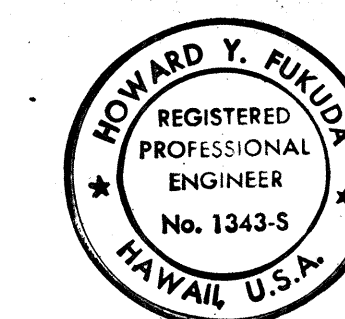

This work was prepared by
me or under my supervision.
Howard Y. Fukuda

STATE OF HAWAII
DEPARTMENT OF TRANSPORTATION
HIGHWAYS DIVISION


INTERIOR PARAPET DETAILS

INTERSTATE ROUTE H-3
F.A.I. PROJ. NO. I-H3-1(51)
SCALE: AS NOTED
DATE:


SHEET NO. T17 OF 21 SHEETS

1/5/90	REVISED CONC. PARAPET SECTION
DATE	REVISION


FED. ROAD DIST. NO.	STATE	FED. AID PROJ. NO.	FISCAL YEAR	SHEET NO.	TOTAL SHEETS
HAWAII	HAW.	I-H3-1(51)	1989	103	106

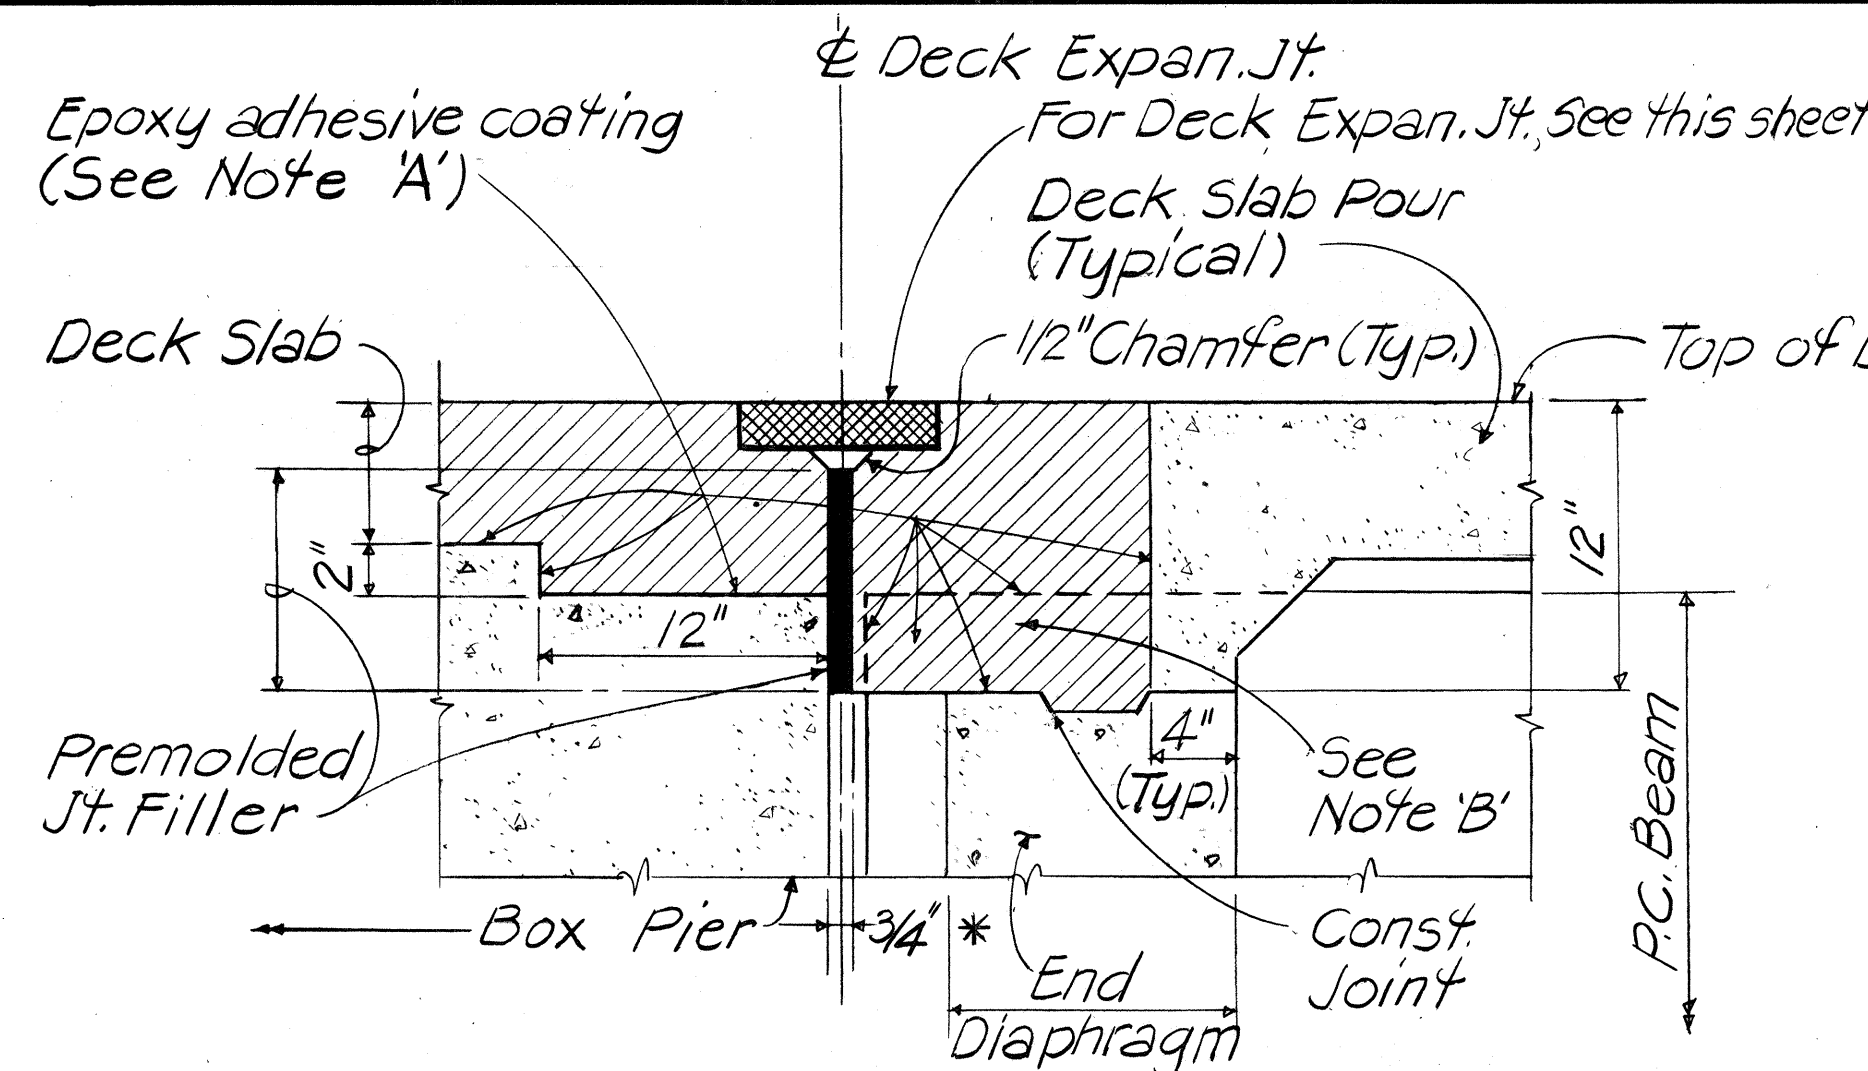


TYPICAL DECK SECTION AT BOX PIER
Not to Scale

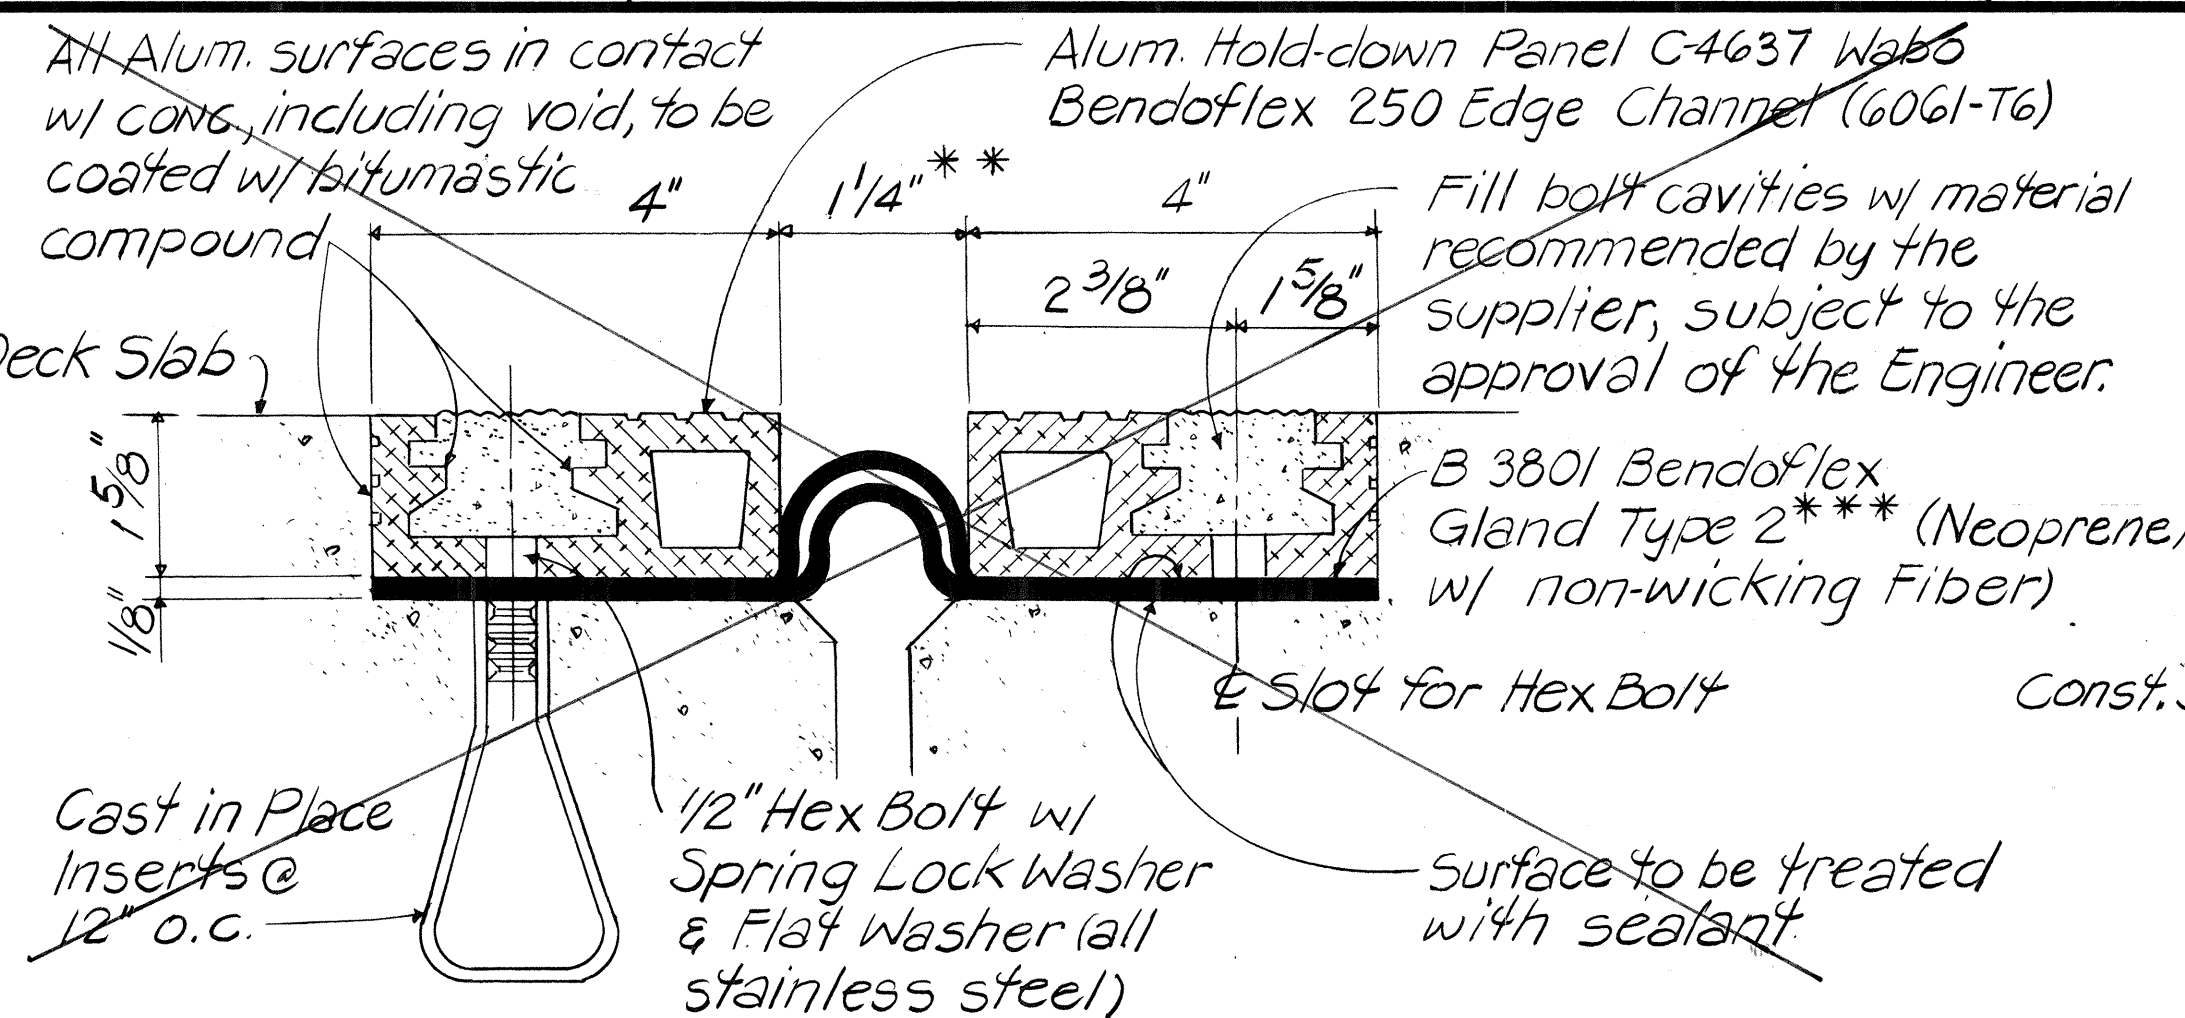


WABO BENDOFLEX 250
(Mfr.: Watson Bowman Assoc. Inc.)

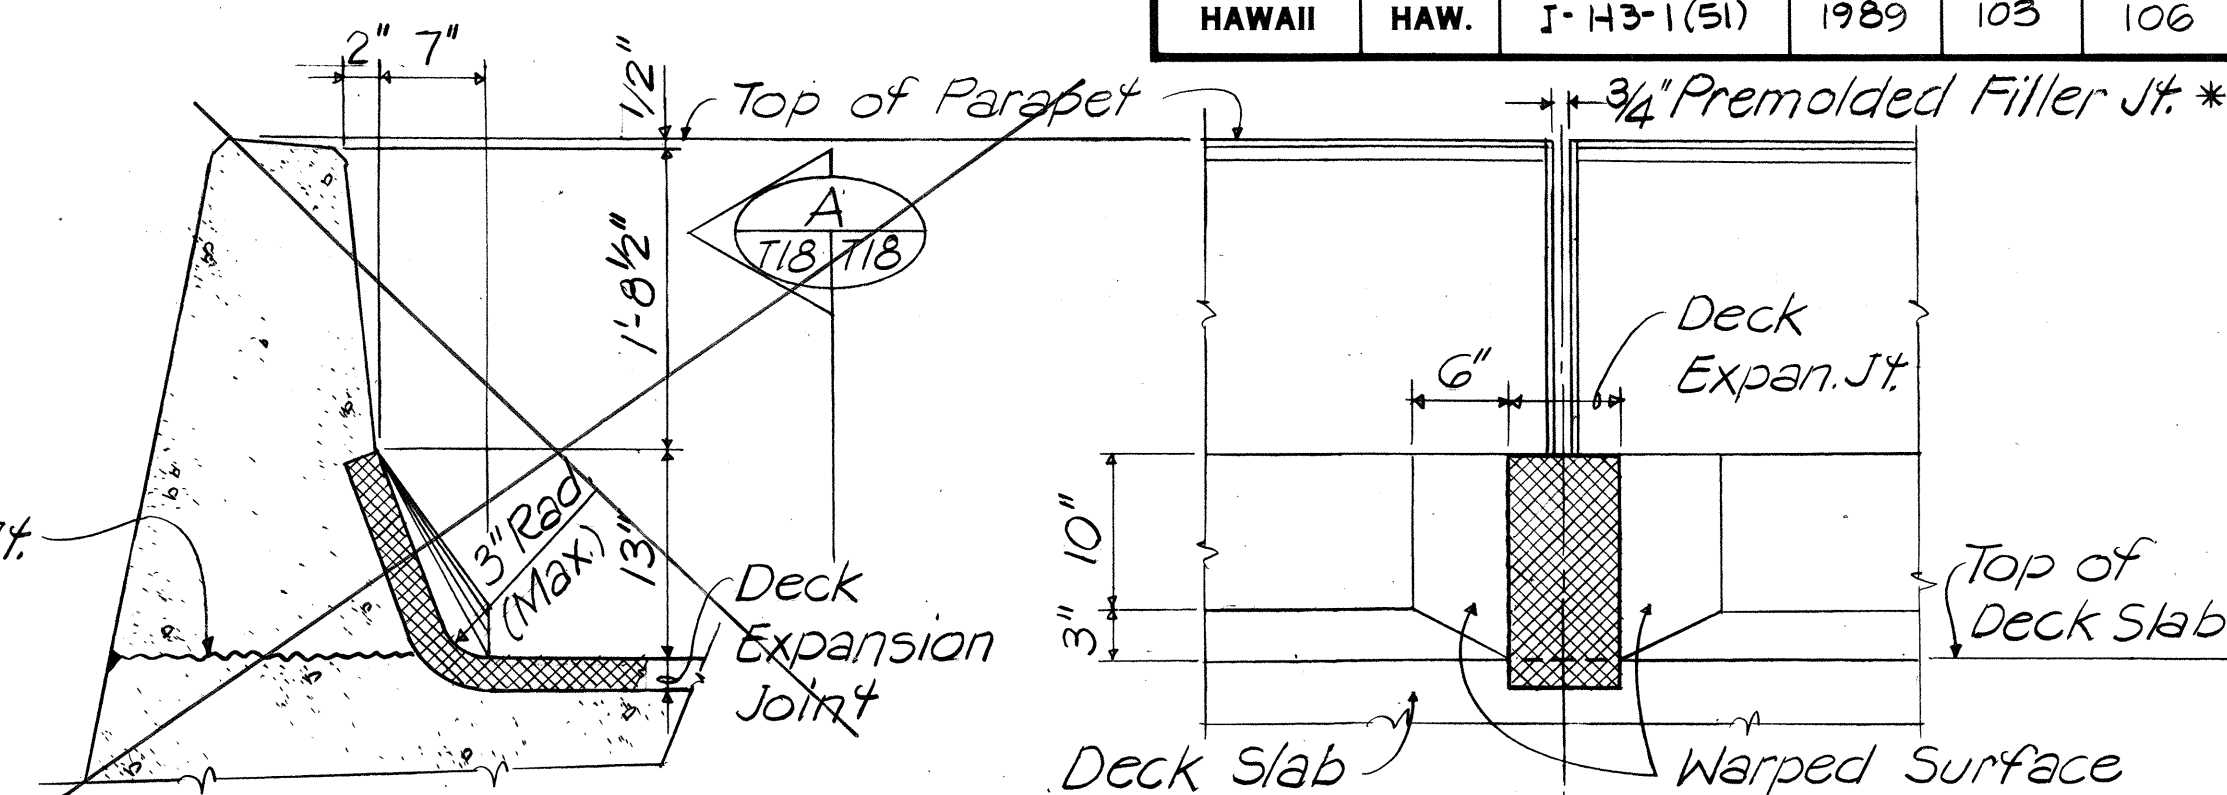


TYPICAL SECTION AT STD. PARAPET (SIM. @ MEDIAN)

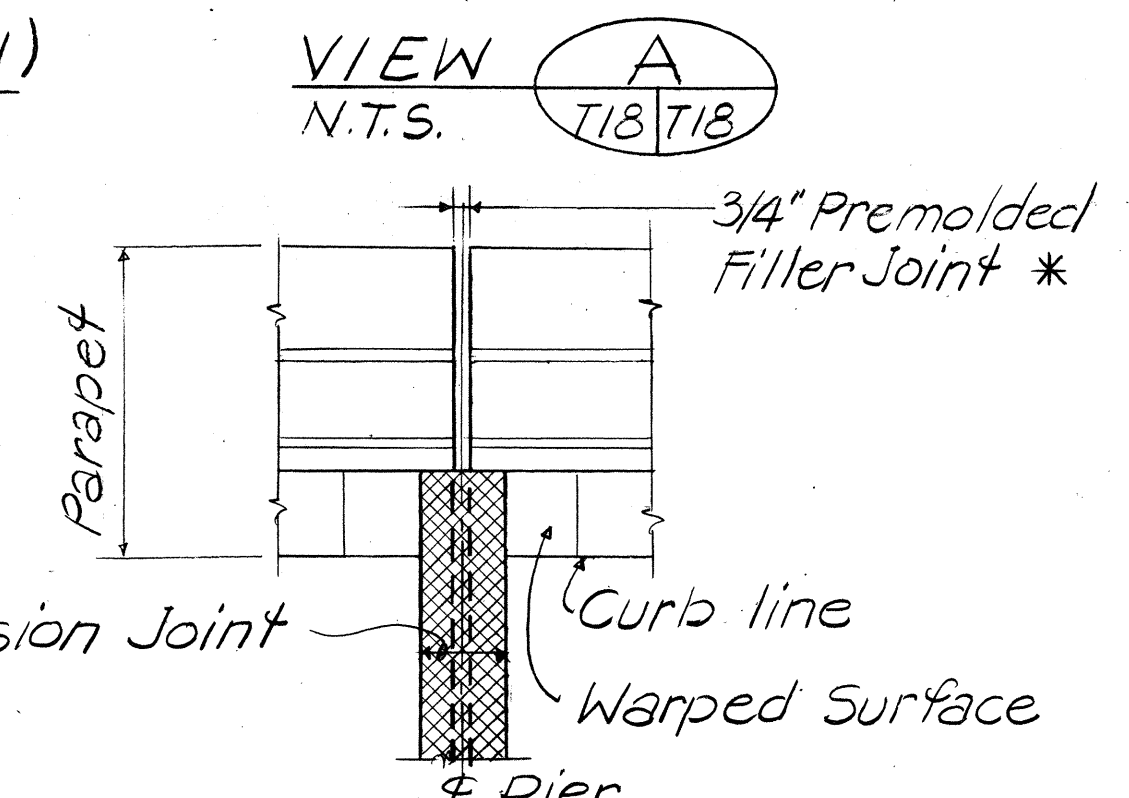


TYPICAL PLAN - SKEW ANGLE = 0°-15°
NOT TO SCALE

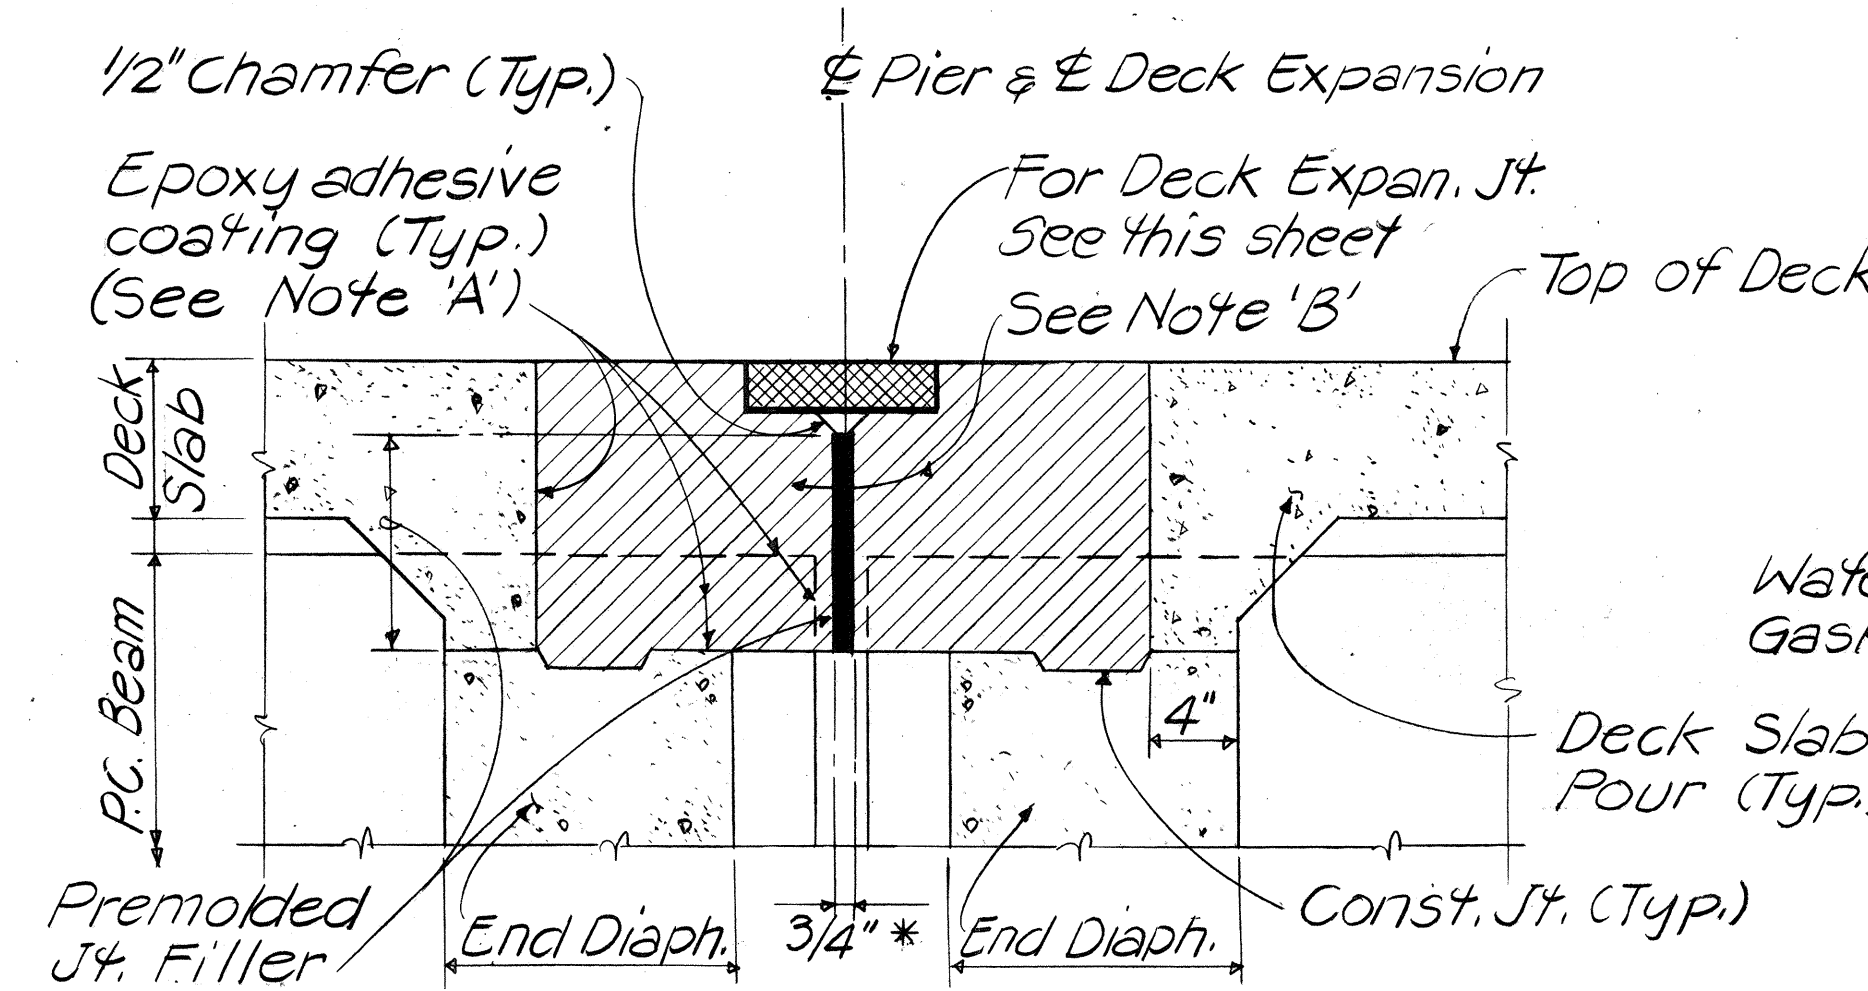

TYPICAL DECK SECTION AT TYPICAL PIERS
Not to Scale

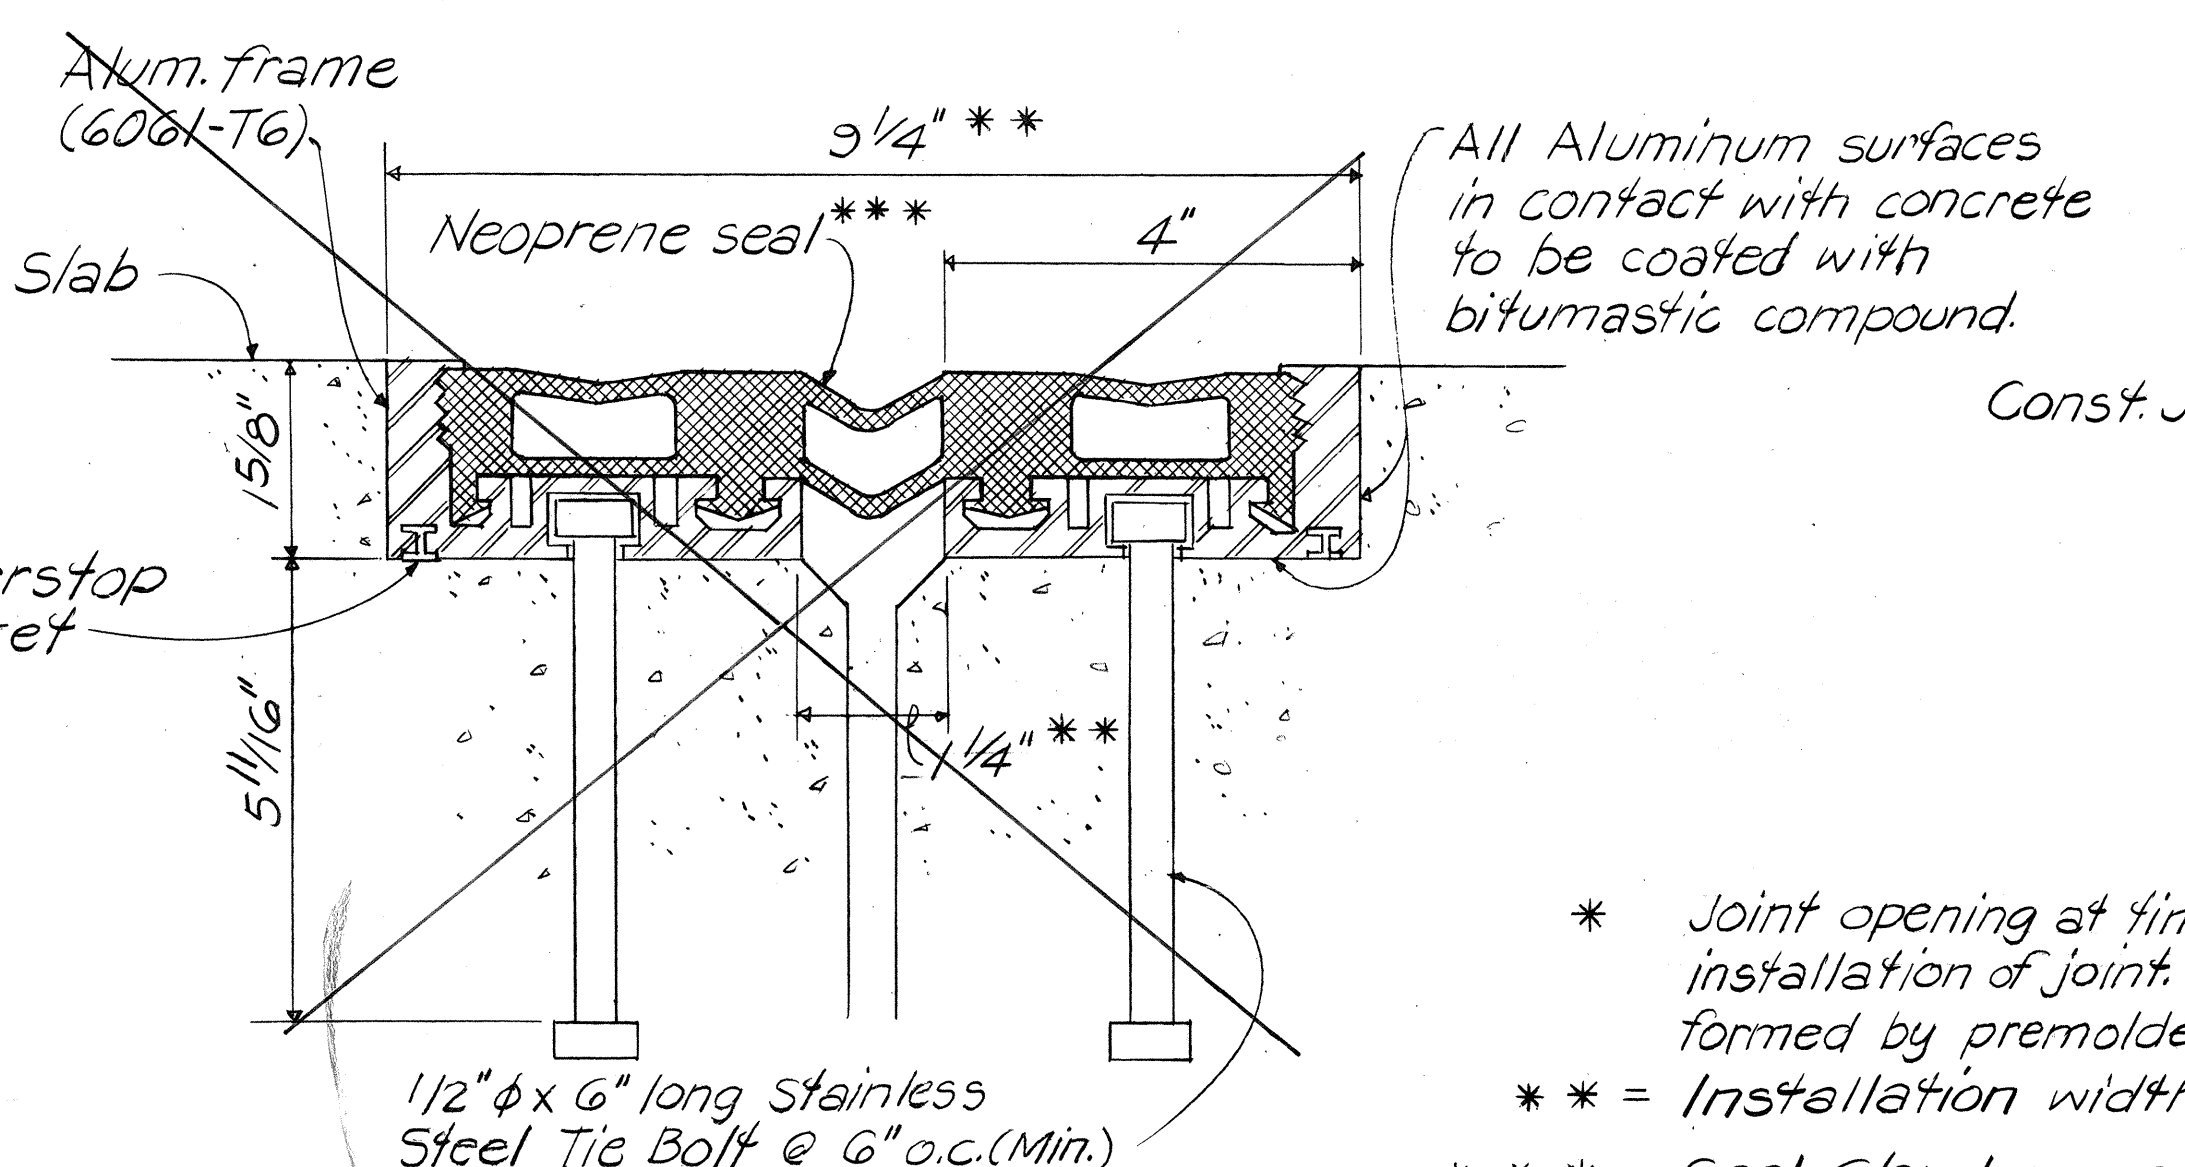


DELASTIFLEX TYPE SM 200
(Mfr.: D. S. Brown & Co.)

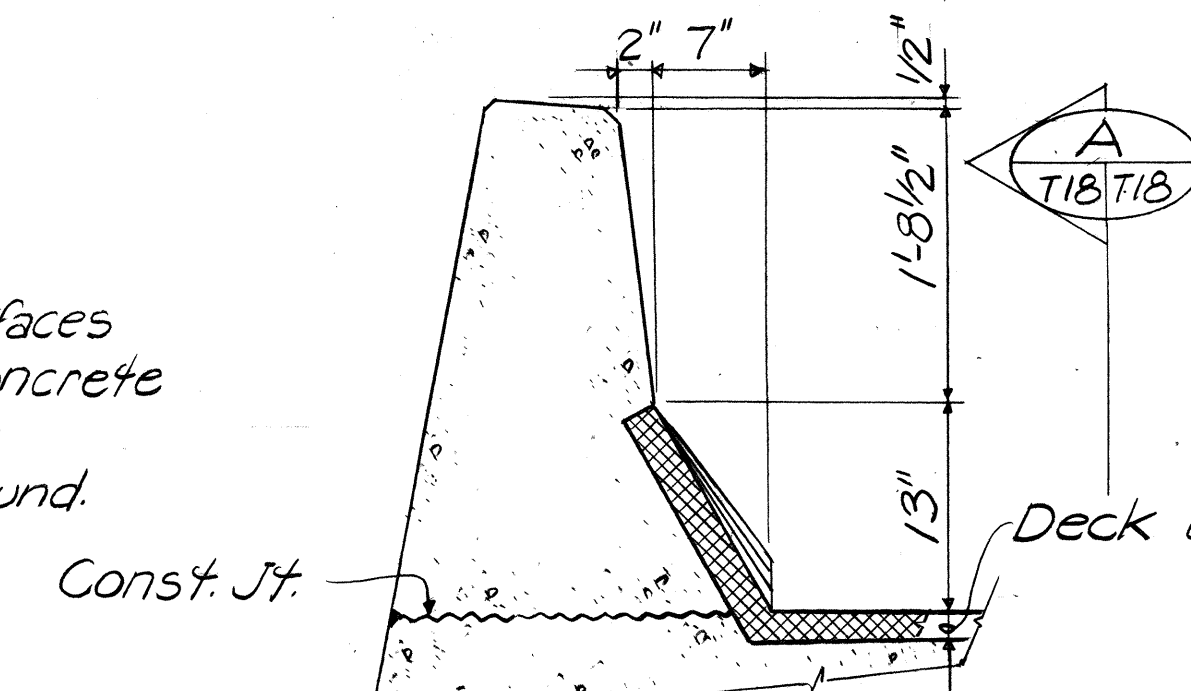

ALTERNATE DETAIL AT PARAPET
(Similar detail at interior parapet)

- NOTES:**
- Four alternative Deck Expansion Joint Systems are shown. Contractor has the option of selecting any one of the systems. The contractor shall verify dimensions and submit detailed shop drawings of the selected joint to the Engineer for approval.
 - The Contractor also has the option of using an alternative Deck Expansion Joint system provided it complies with the requirements of the plans and specifications.

- * Joint opening at time of installation of joint. Joint to be formed by premolded filler.
- ** = Installation width @ 75°F
- *** = Seal Gland or membrane shall be continuous across the full width of the structure.

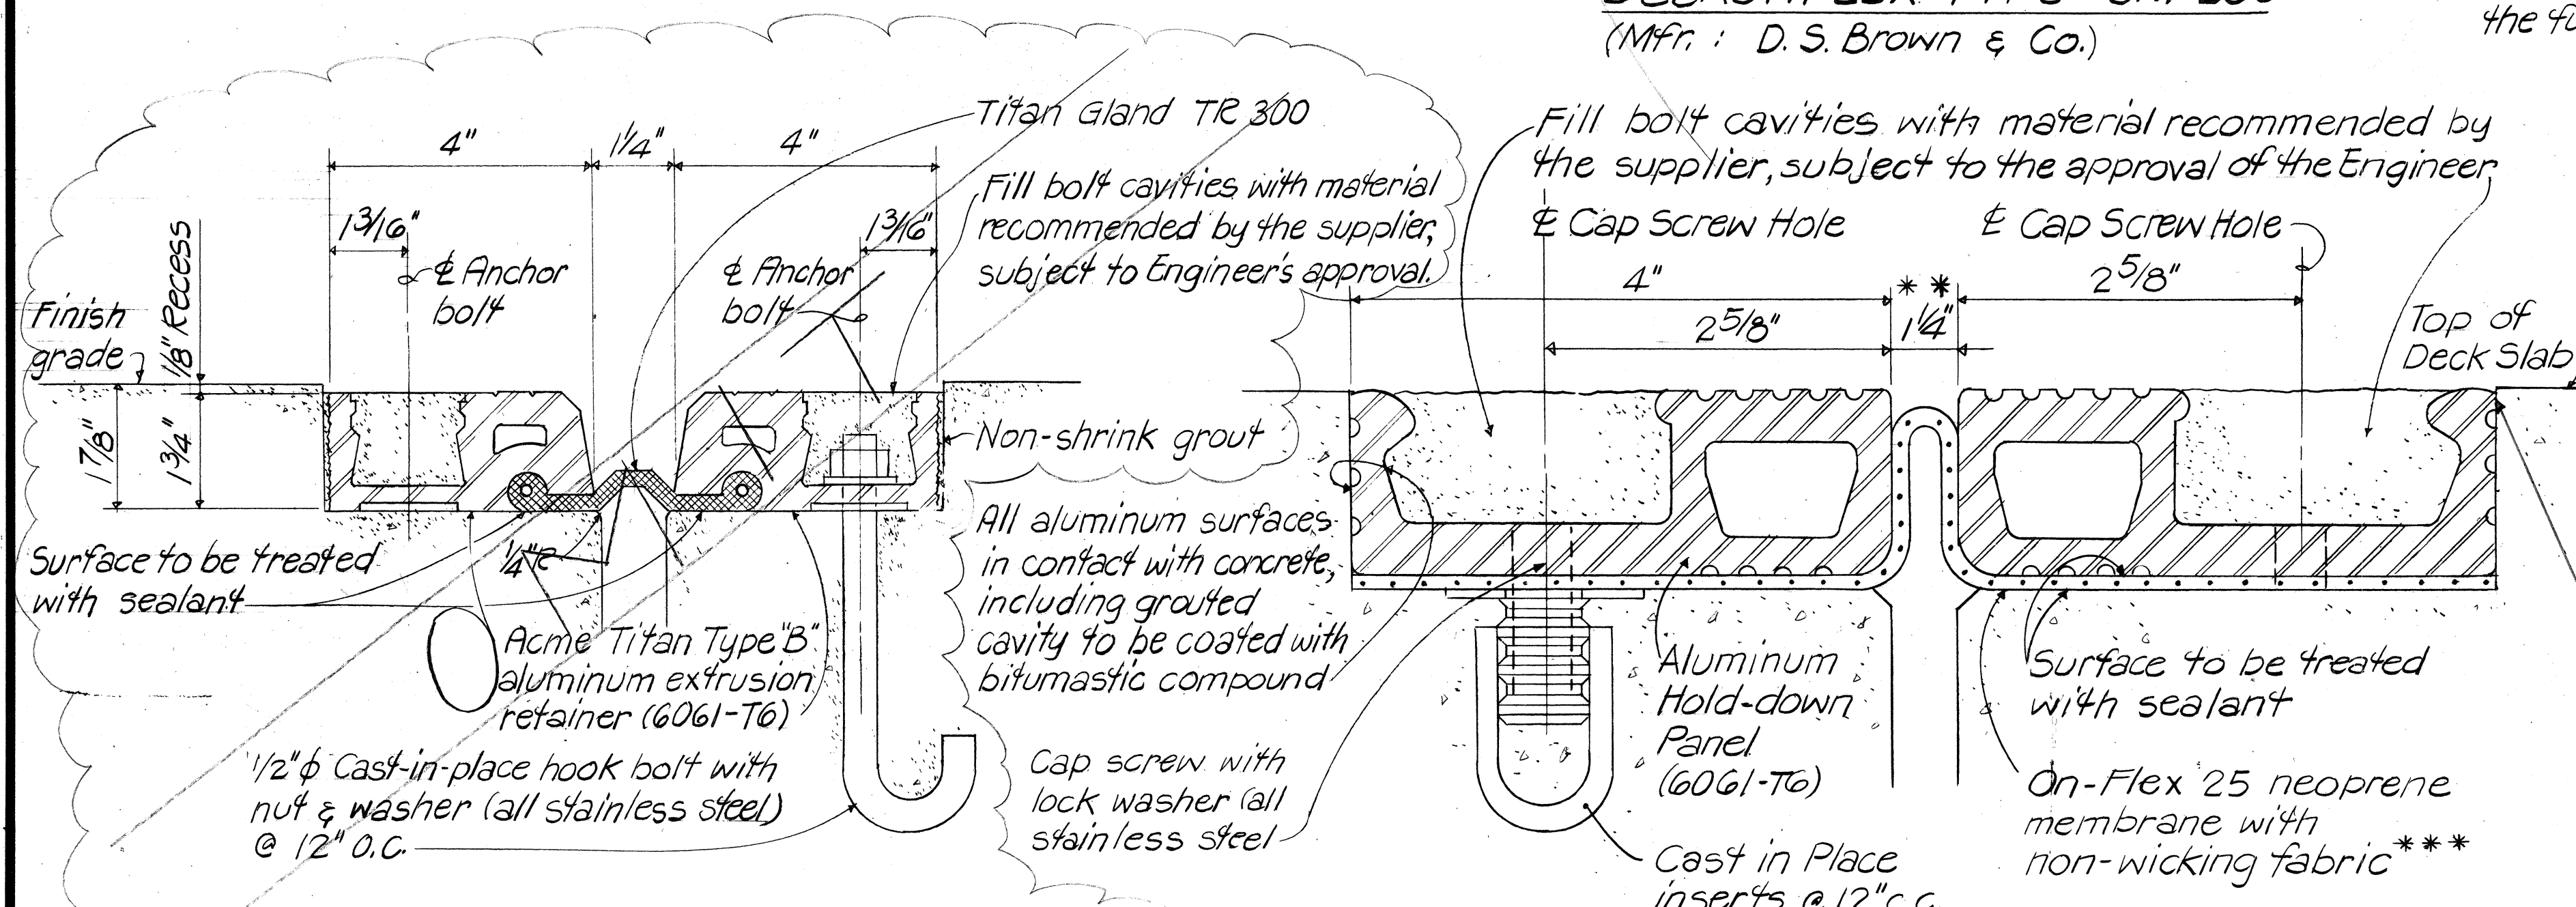


ACME TITAN TYPE "B" EXPANSION JOINT
Not to Scale

ON-FLEX 25
(Mfr.: Structural Accessories Inc.)

- NOTE 'A'**
Just prior to concreting of the hatched areas, coat the indicated surfaces with an epoxy adhesive. (See Special Provision, Sec. 705.14)
- NOTE 'B'**
Hatched areas shall be concreted after 14 days of deck slab pour. Anchor devices shall be located and held in their final position, as per Manufacturer's requirement, during the concreting of the hatched areas.
- NOTE 'C'**
The closure pour (hatched areas) for deck expansion joint installation is required for spans with Keehi Type II & Type IIF beams
- Adhesive Sealant in gap

SSM Engineer, Inc.
Consulting Structural Engineers
1210 Ward Ave., Honolulu, HI 96814

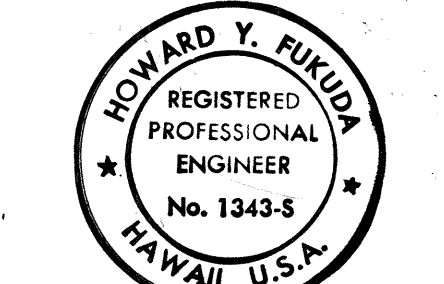

This work was prepared by me or under my supervision.
Howard Y. Fukuda

STATE OF HAWAII
DEPARTMENT OF TRANSPORTATION
HIGHWAYS DIVISION

DECK EXPANSION JOINT DETAILS


INTERSTATE ROUTE H-3
F.A.I. PROJ. NO. I-H3-1(51)

SCALE: AS NOTED DATE:

SHEET No. 7/8 OF 21 SHEETS

FED. ROAD DIST. NO.	STATE	FED. AID PROJ. NO.	FISCAL YEAR	SHEET NO.	TOTAL SHEETS
HAWAII	HAW.	I-H3-1(51)	1989	104	106

Foundation Schedule					
FTG	Rectangle footing on earth	Pedestal			
	Size (W×T×L)	Long Reinforcements (Bottom)	Vertical Reinforcements	ELEV. "A"	ELEV. "B"
L	5'-0"×2'-0"×14'-0"	#7 Bars @12"	8-#7 Bars	161.84	154.84
R	5'-0"×2'-0"×14'-0"	#7 Bars @12"	8-#7 Bars	162.64	155.00
					P Post Spacing


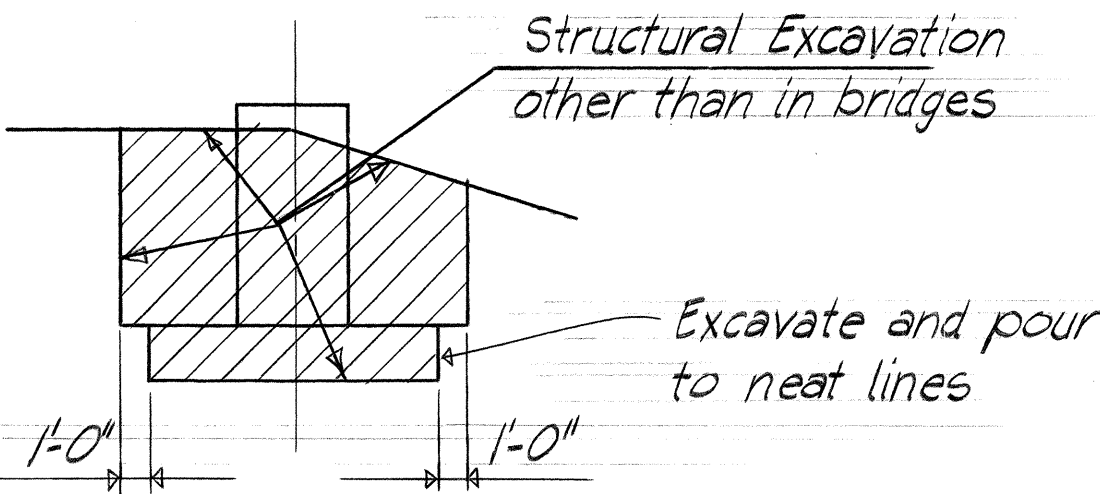


EXCAVATION PAYMENT LIMITS

Note:
Upper limit for payment of structural excavation shall be the lower of existing ground, finished ground, or subgrade of roadway.


L and R refer to left and right footing when viewing signs as viewed by approaching traffic.

Conduits and anchor bolts not shown.

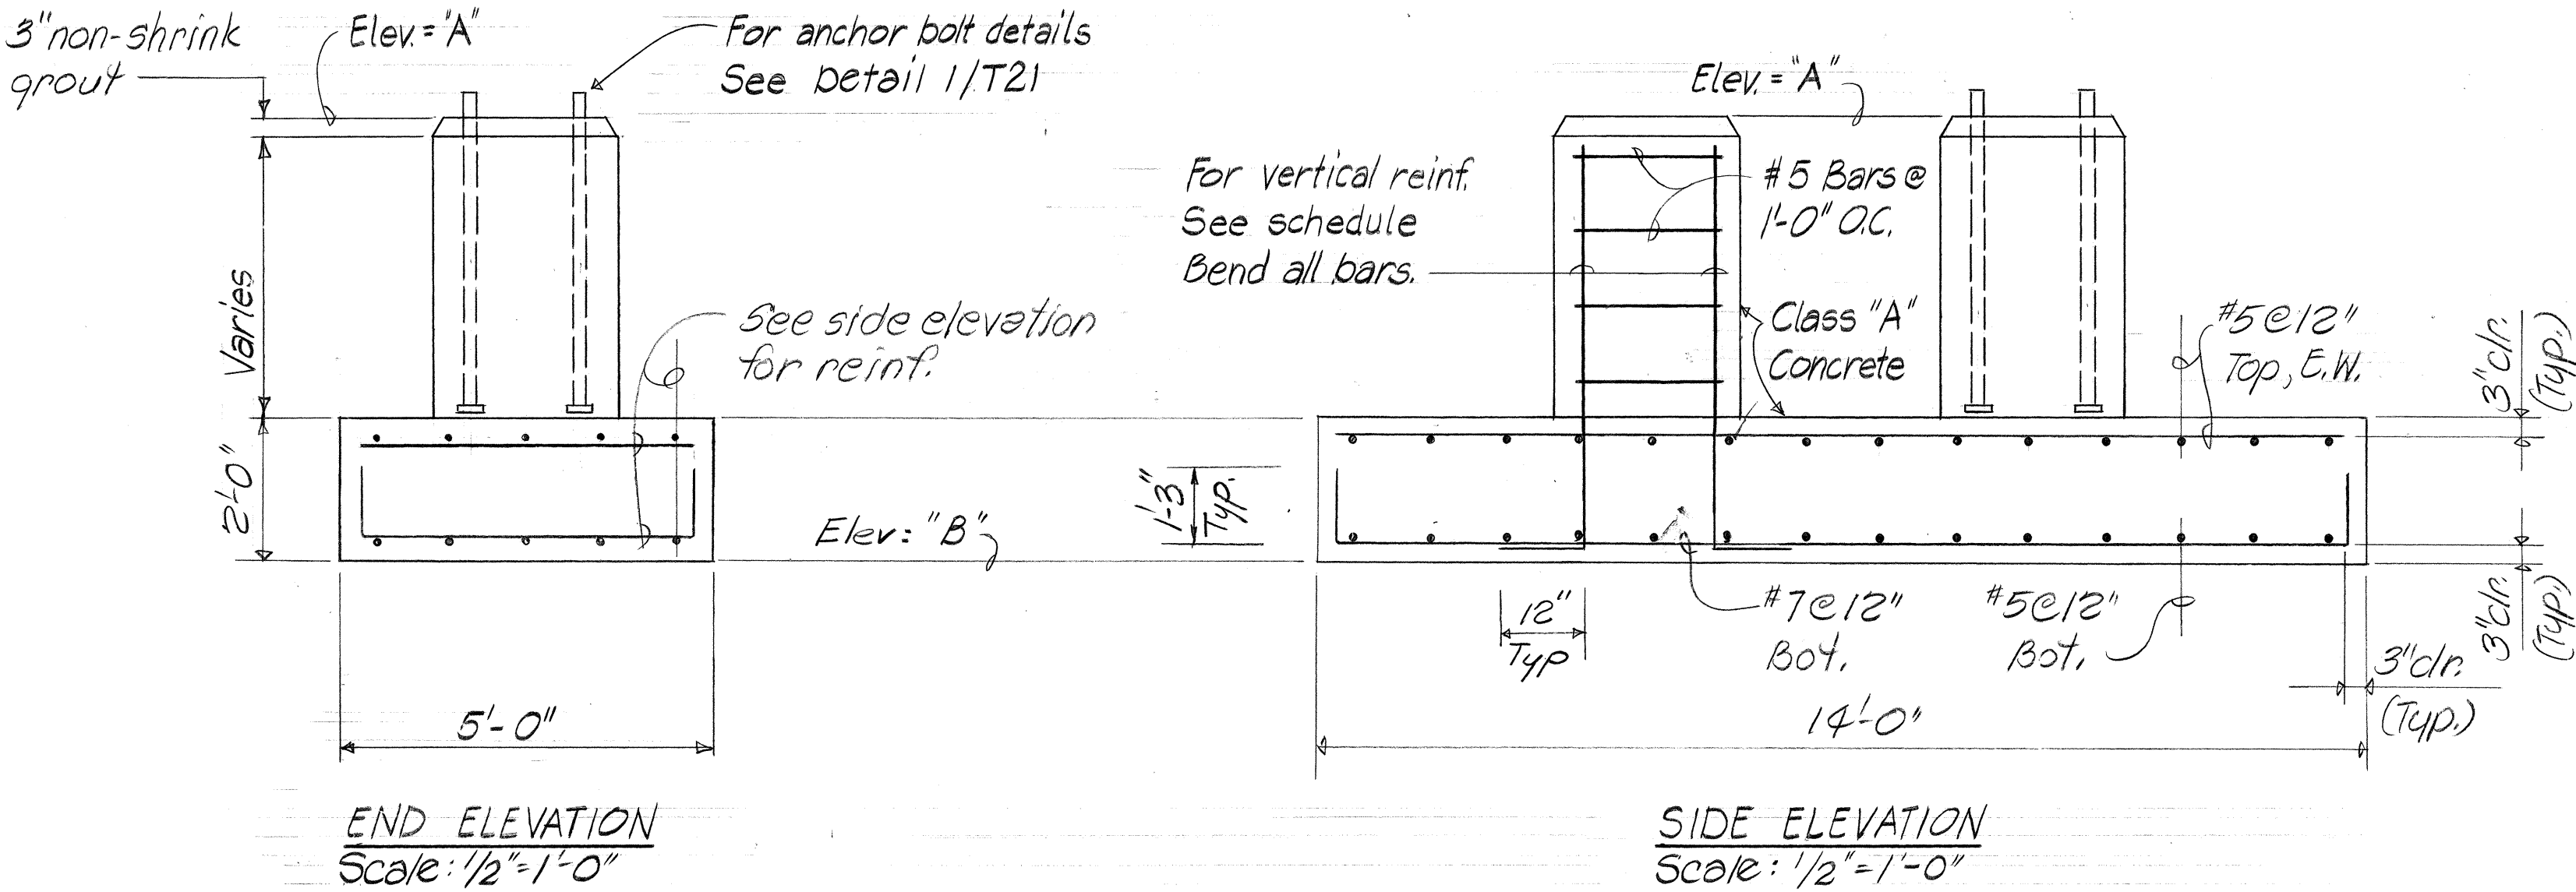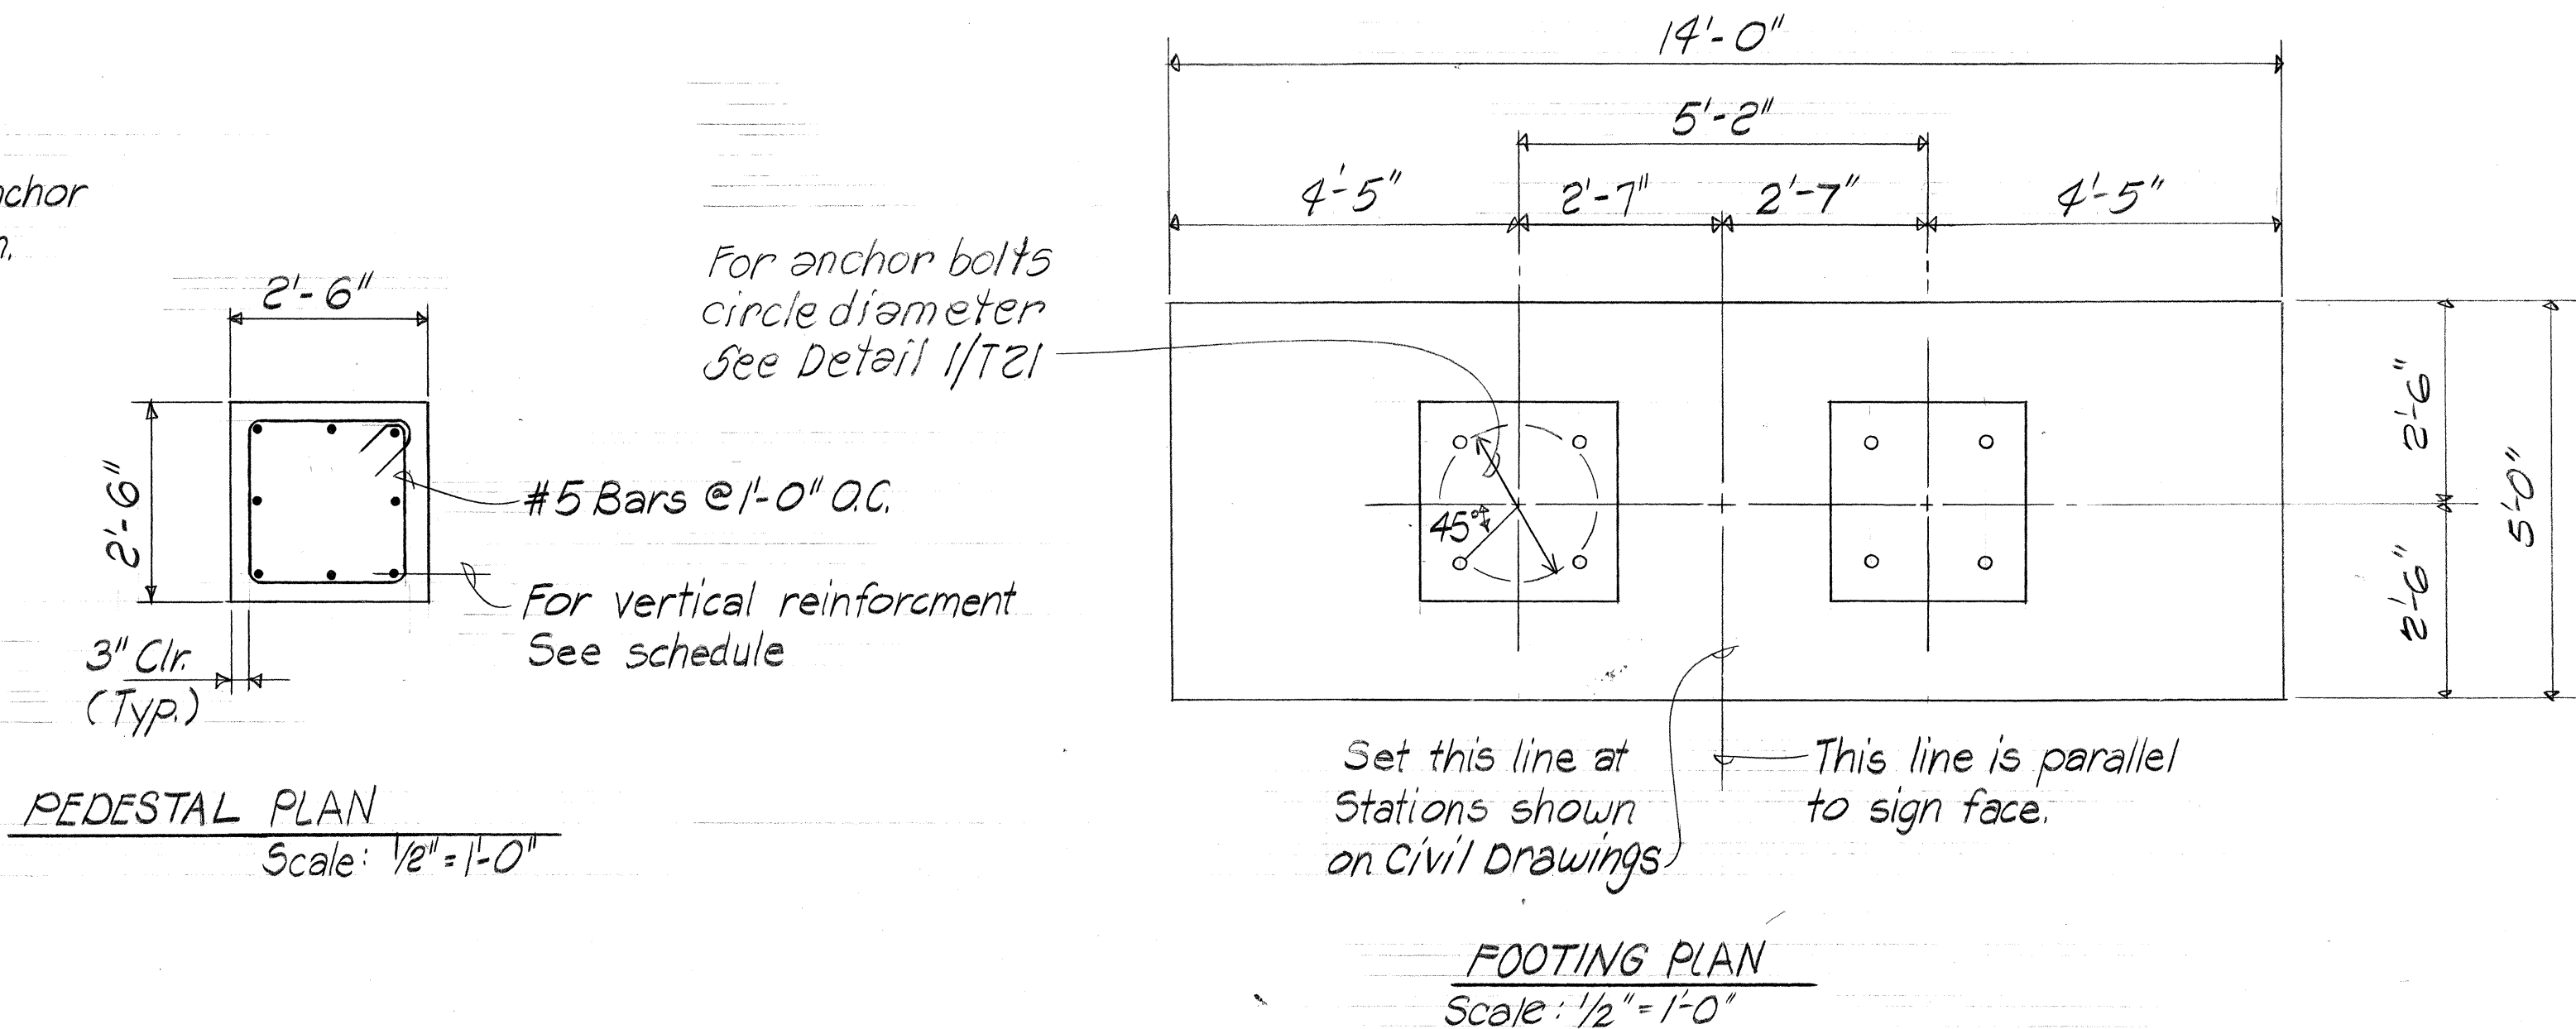

Note: This Sign Structure was removed & replaced in a later H-3 contract.

SSFM ENGINEERS INC.
501 Summer St., #502
Honolulu, Hawaii 96817

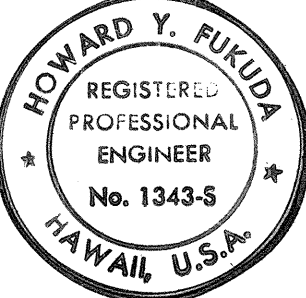

This work was prepared by me or under my supervision.
Howard Y. Fukuda




STATE OF HAWAII
DEPARTMENT OF TRANSPORTATION
HIGHWAYS DIVISION

SIGN STRUCTURE FOUNDATION DETAIL

INTERSTATE ROUTE H-3
F.A.I. PROJ. NO. I-H3-1(51)
SCALE: AS NOTED DATE:
SHEET NO. 119 OF 21 SHEETS



11-7-90 Revised Footing Elevations
Date Revision

FED. ROAD DIST. NO.	STATE	FED. AID PROJ. NO.	FISCAL YEAR	SHEET NO.	TOTAL SHEETS
HAWAII	HAW.	I-H3-1(51)	1989	105	106

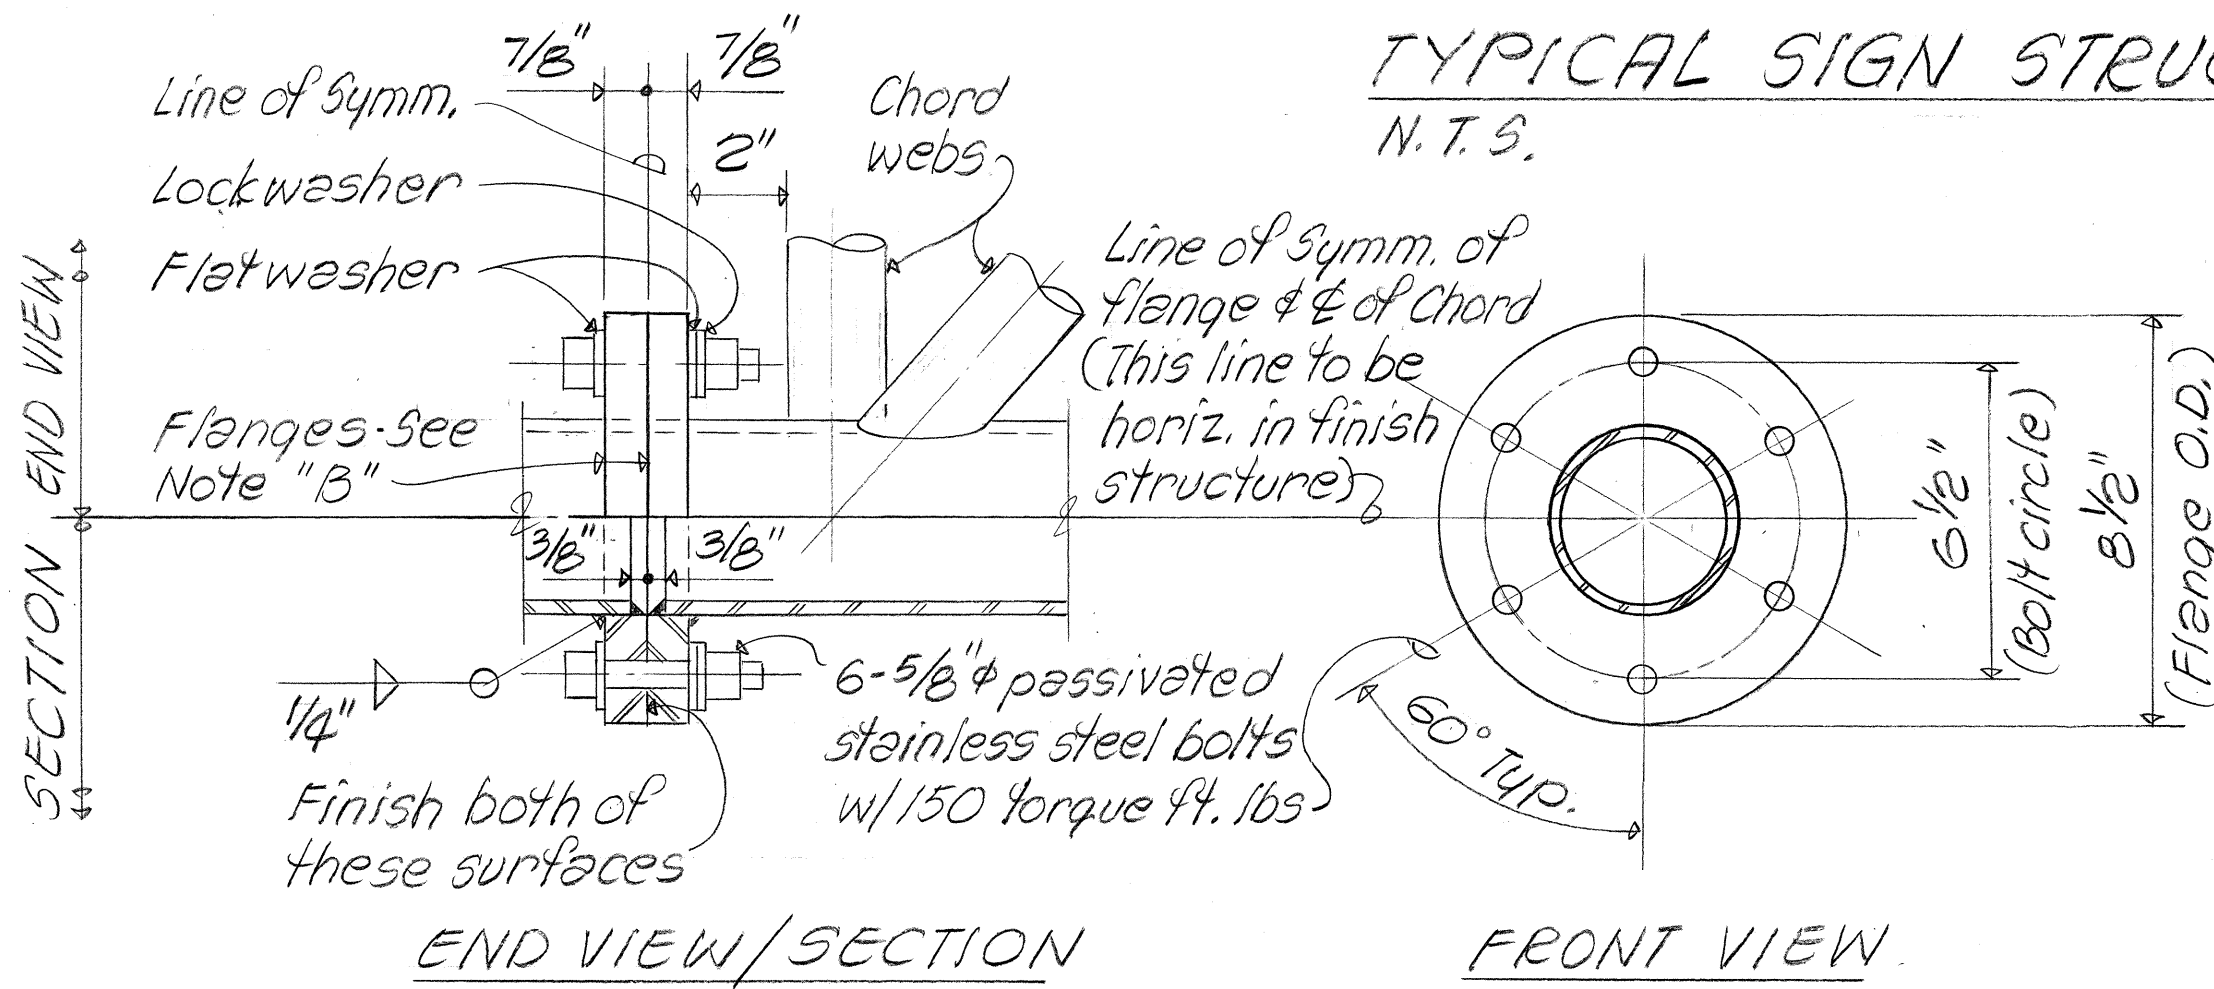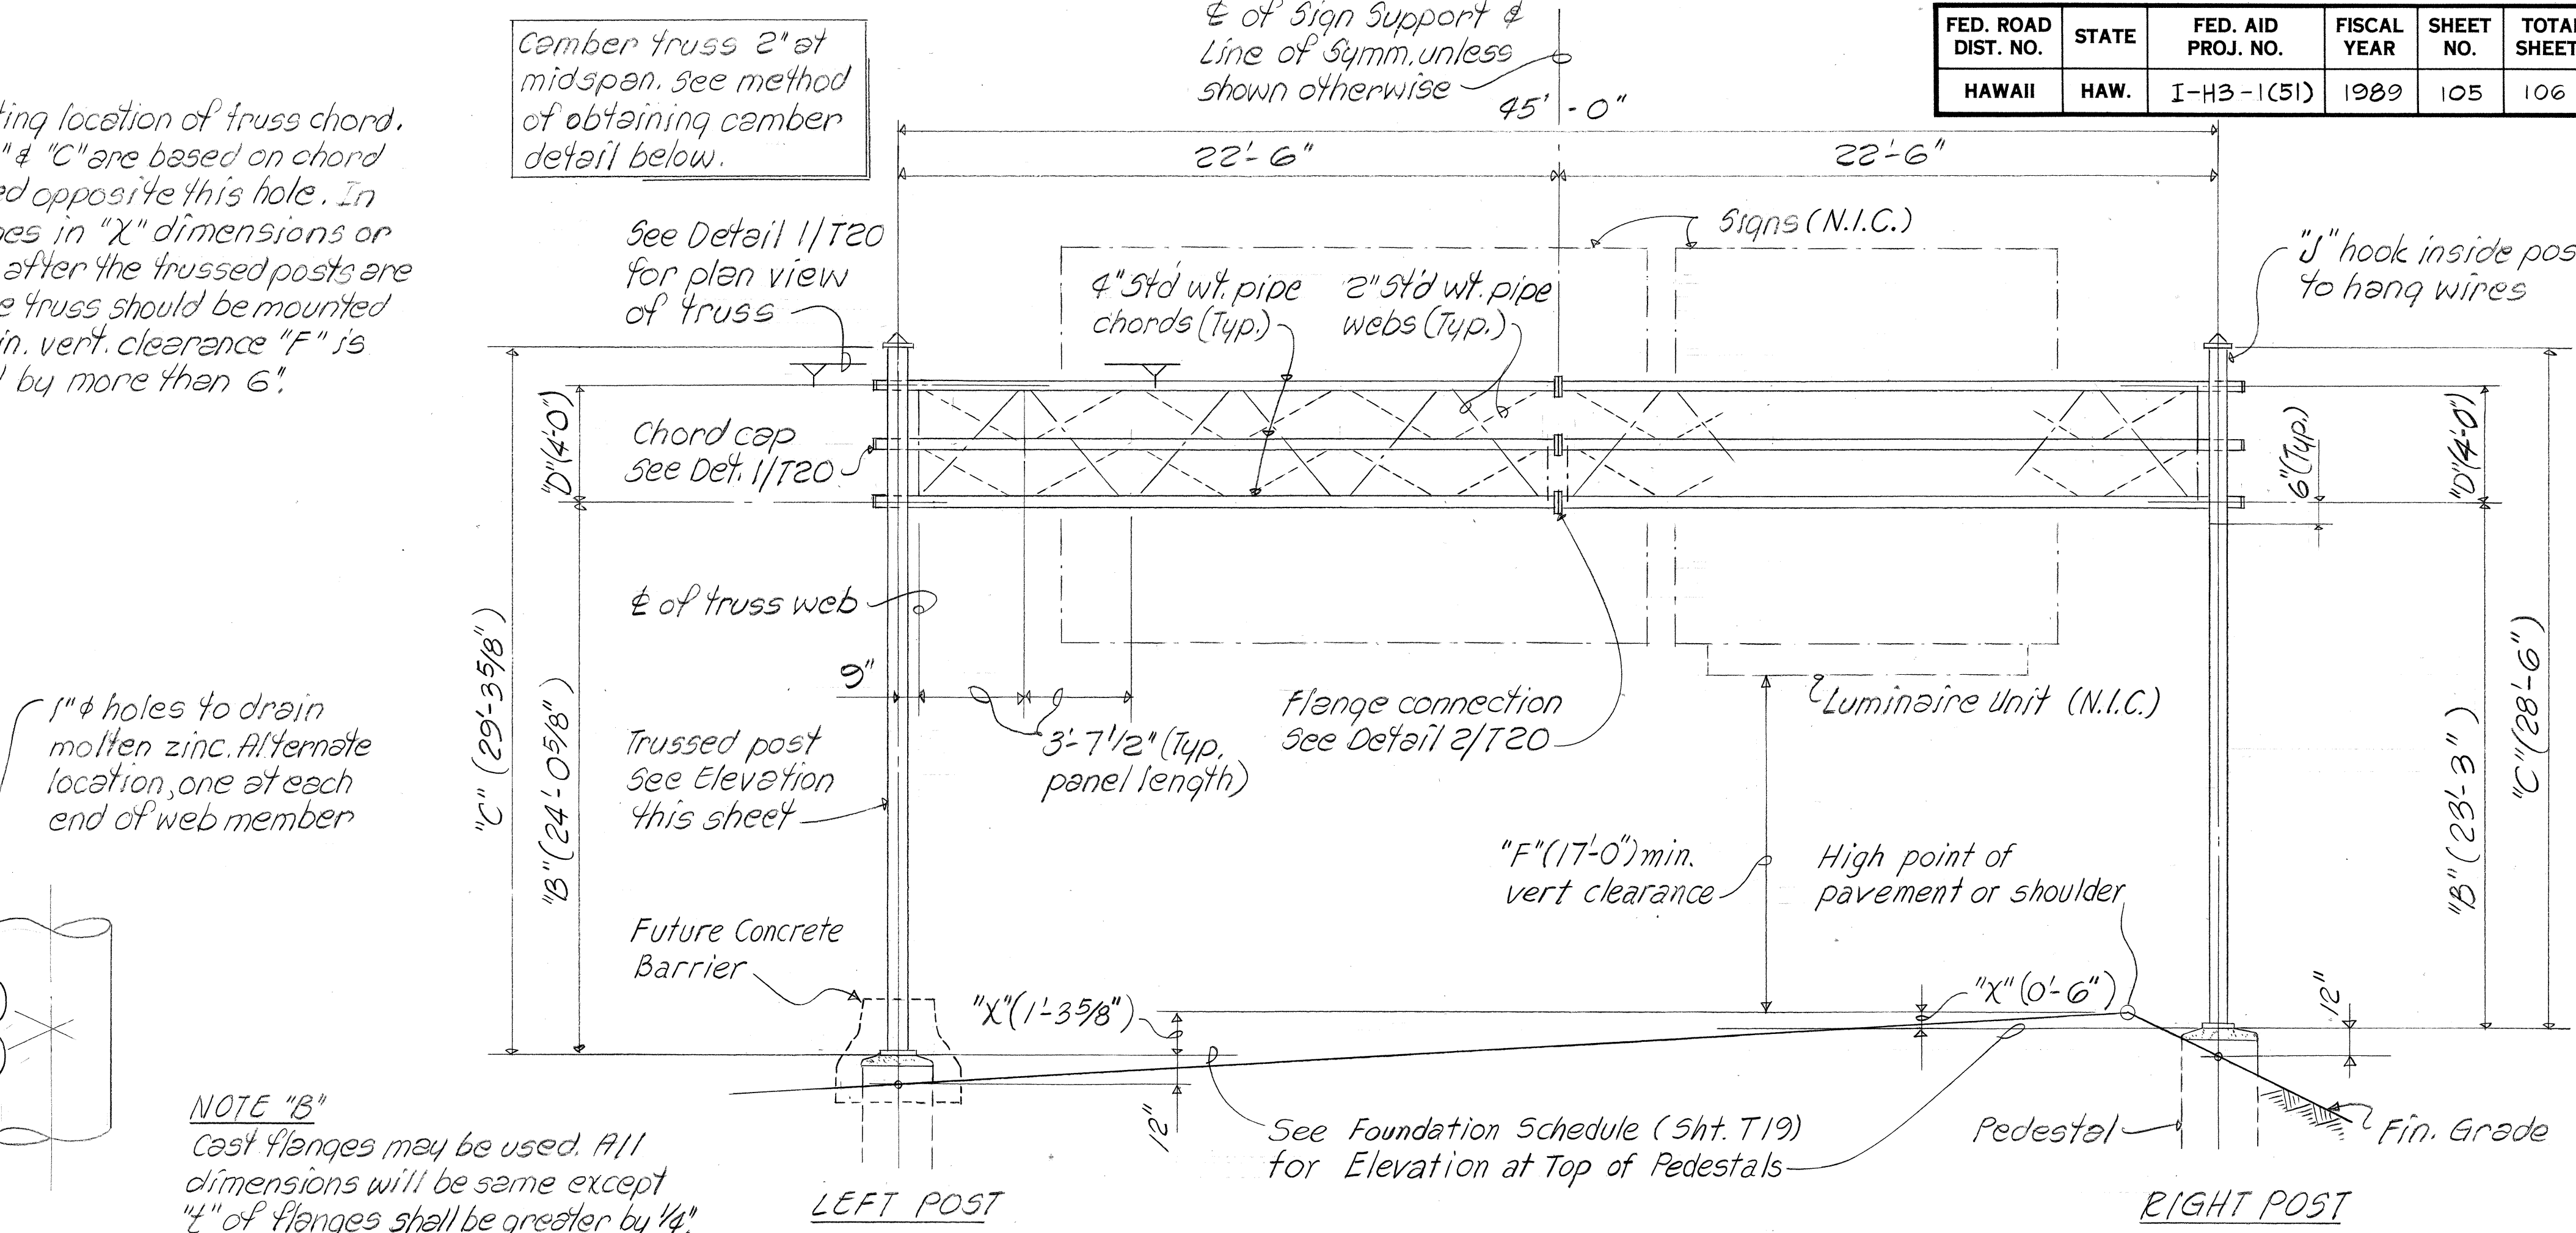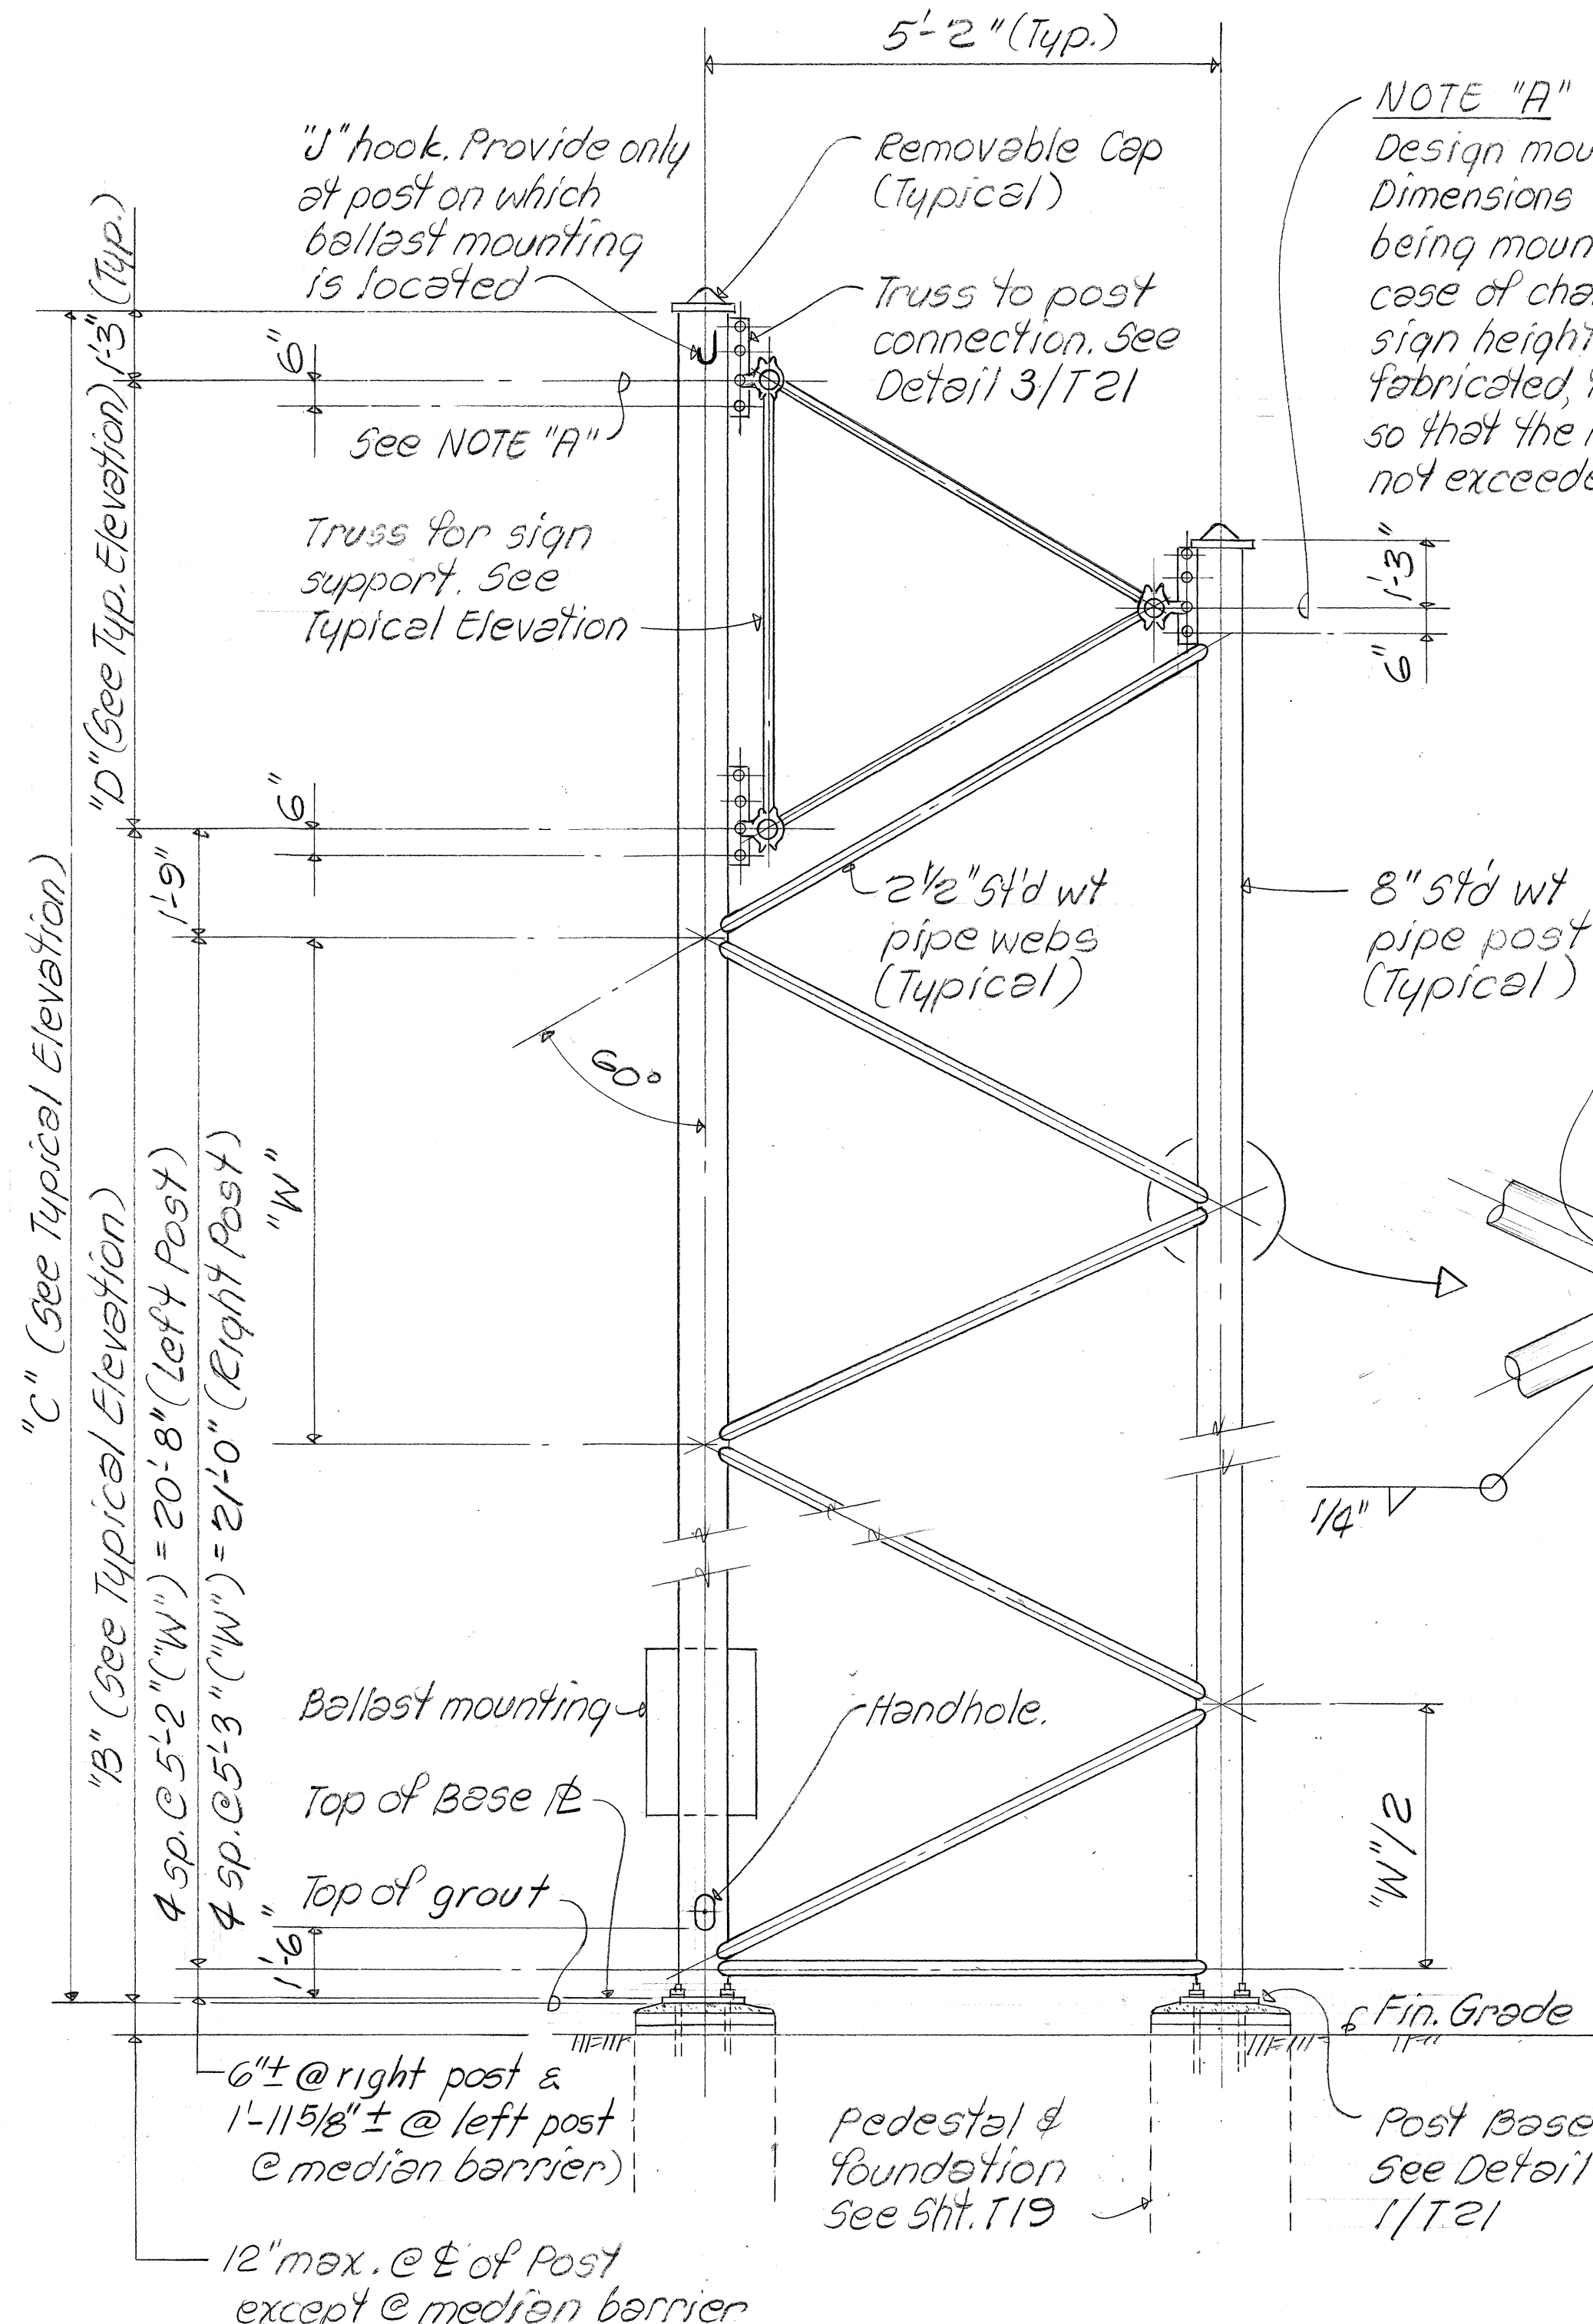


4. Stainless steel bolts shall conform to the Standard Specification for Alloy-Steel Bolting Materials for High Temperature Service, ASTM Designation A193, current edition, Type B6 (AISI Type 410 with a minimum yield of 85000 p.s.i.). Nuts shall conform to the Standard Specification for Carbon & Alloy Steel Nuts for High-Pressure & High Temperature Service, ASTM Designation A194, current edition, Type 6 (AISI Type 416). Flat washers & lock washers shall conform to the Standard Specification for Corrosion-Resisting Chromium-Nickel Steel Plate, Sheet & Strip, ASTM Designation A167, current edition, Type 304. After heat treatment all stainless steel hardware must be descaled & cleaned to conform to ASTM Designation A380-57, Descaling & Cleaning Stainless Steel Surfaces, & then passivated.
5. All bolts & washers except stainless steel bolts shall be galvanized.
6. See Specs. for painting.

- NOTES:**
1. The number & arrangement of panels in each section must be such that the web members in each face of the truss form continuous trussing in the structure from post to post.
 2. Single & double posts, base plates & post to plate connections are fabricated of galvanized steel.
 3. Galvanized steel in contact with aluminum must be separated by "Fabco or Fabreke Pads."

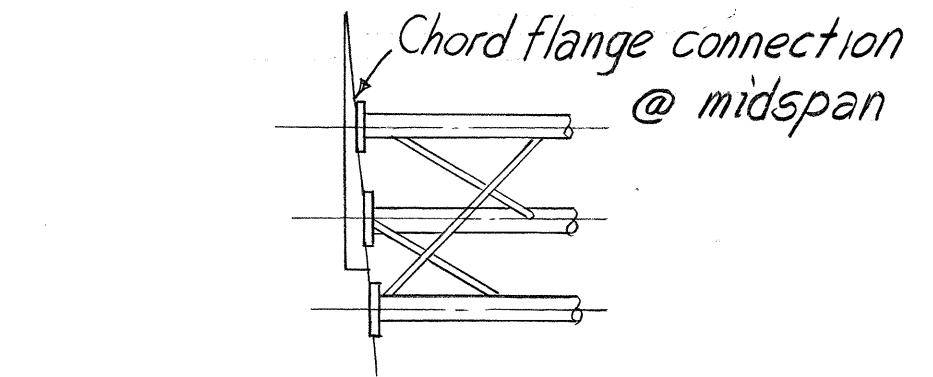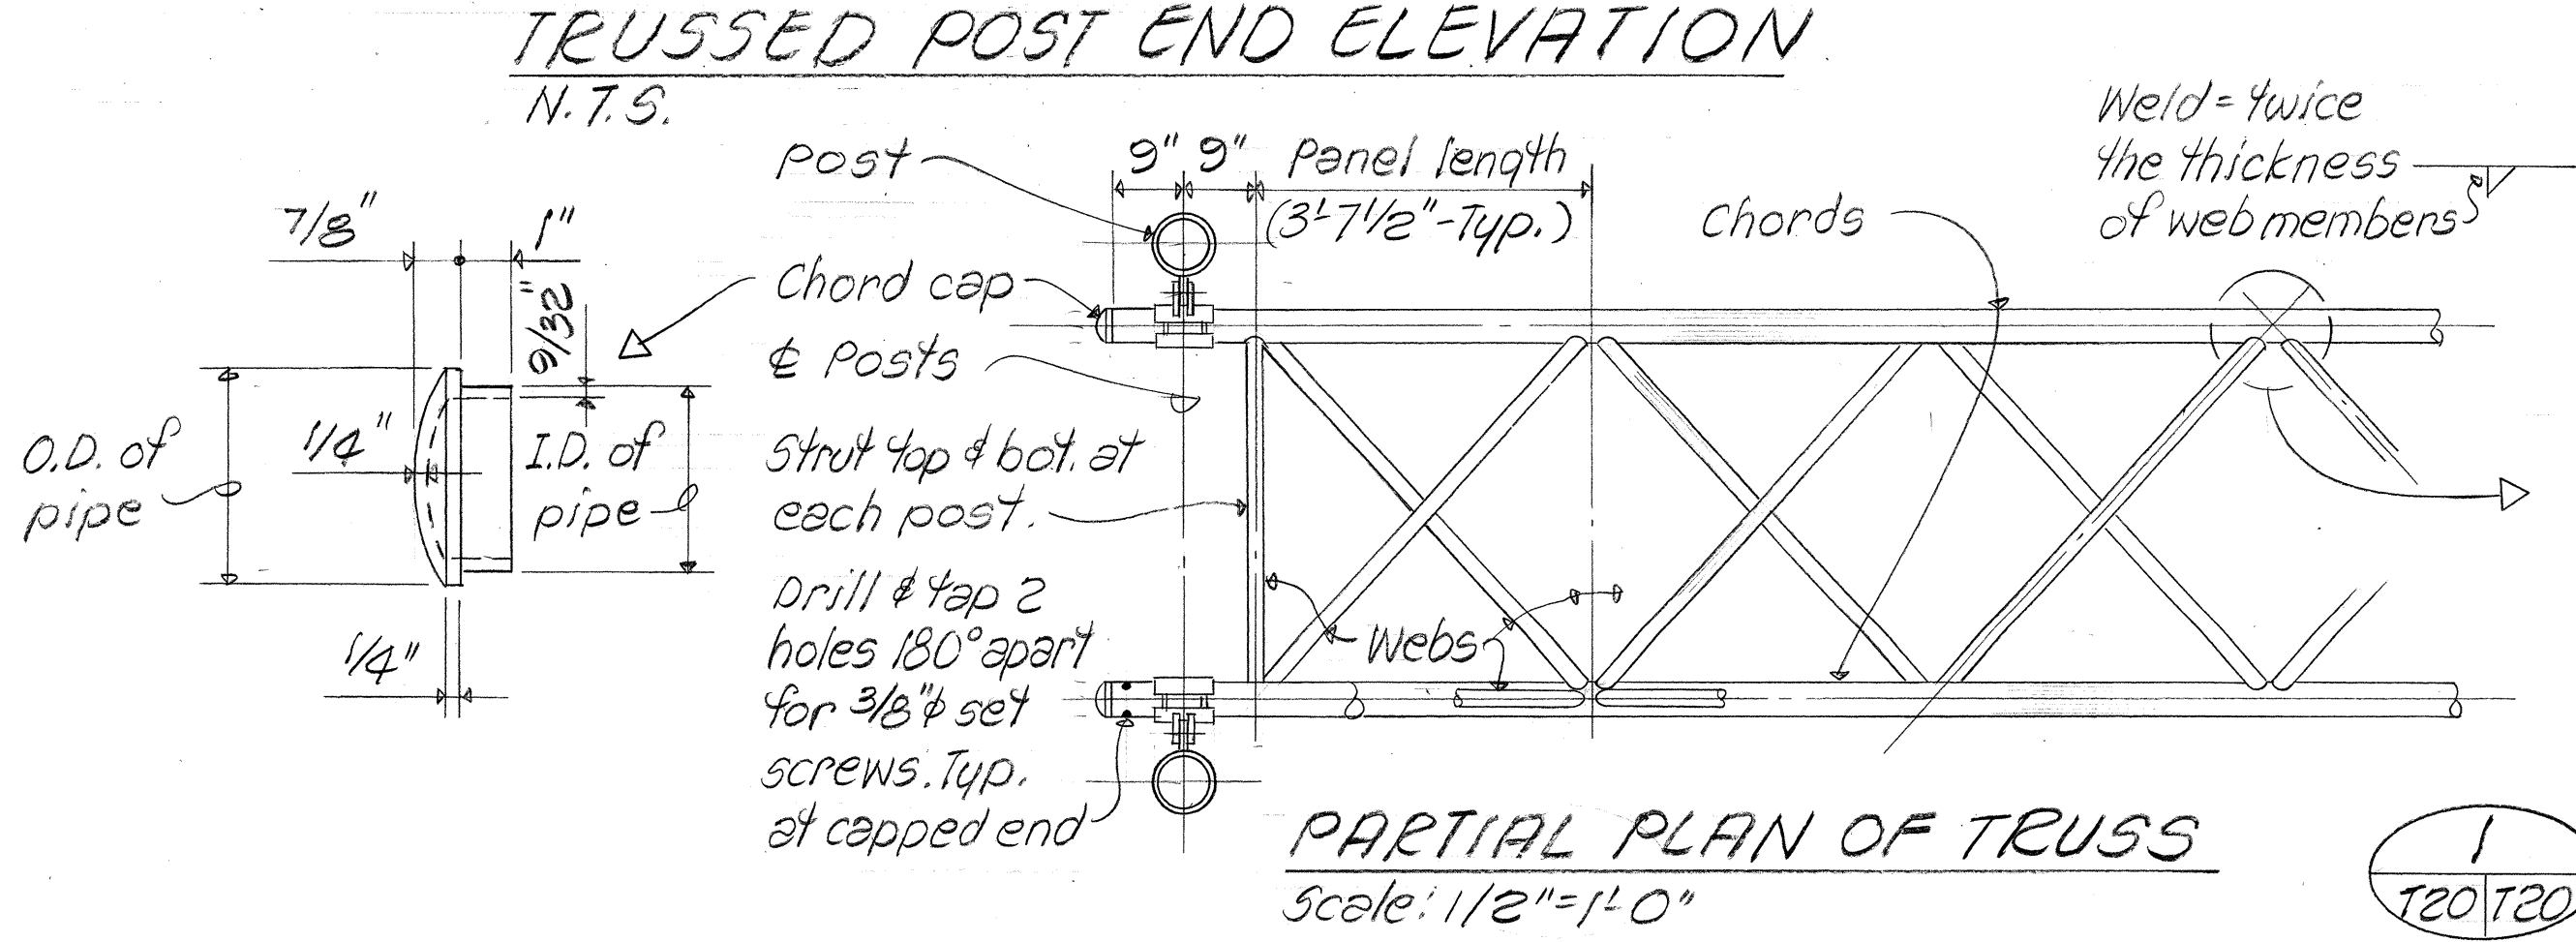


NOTE:
This Sign Structure was Removed & Replaced in a later H-3 contract.

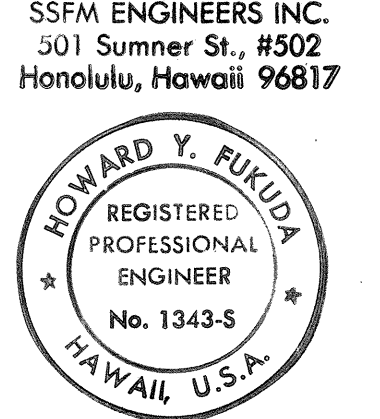

STATE OF HAWAII DEPARTMENT OF TRANSPORTATION HIGHWAYS DIVISION	
SIGN STRUCTURE TRUSS DETAILS	
INTERSTATE ROUTE H-3 F.A.I. PROJ. NO. I-H3-1(51)	
SCALE: AS NOTED	DATE:
SHEET NO. T20 OF 21 SHEETS	

11/15/88	SIGNS & LUMINAIRE N.I.C.
DATE	REVISION

FED. ROAD DIST. NO.	STATE	FED. AID PROJ. NO.	FISCAL YEAR	SHEET NO.	TOTAL SHEETS
HAWAII	HAW.	I-H3-1(51)	1989	106	106

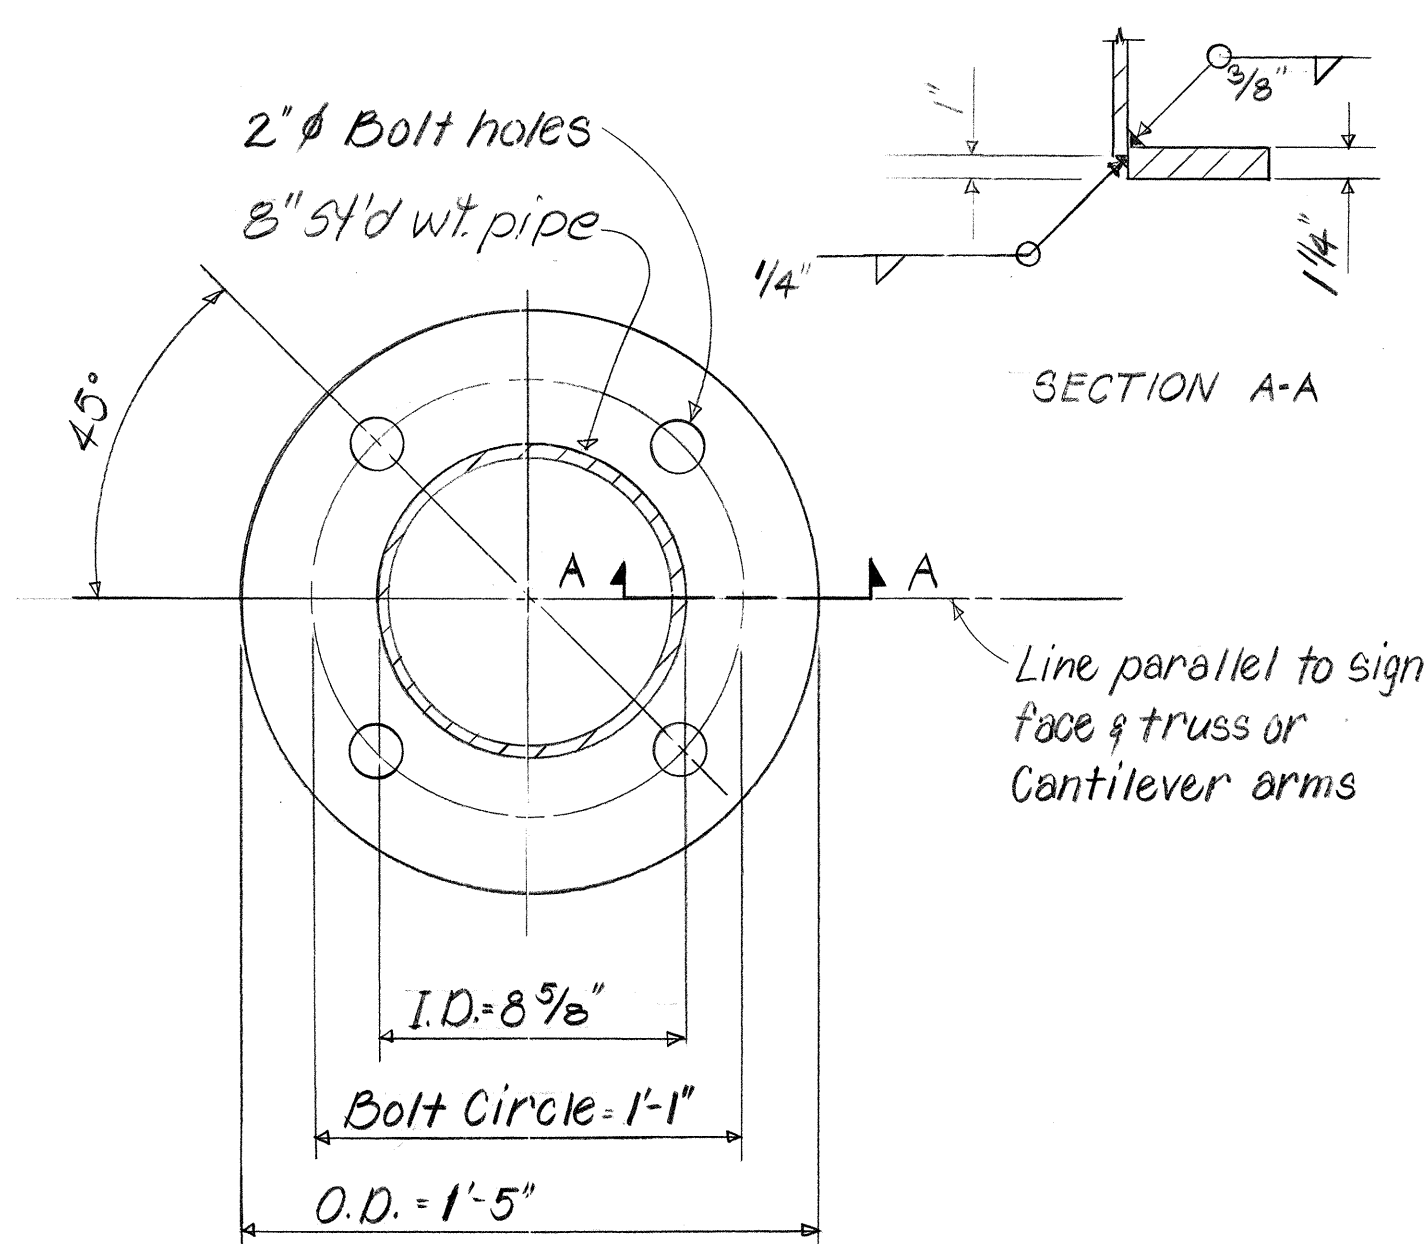


PLAN-BASE PL DETAIL

SECTION A-A

Line parallel to sign face & truss or cantilever arms

When used with pedestals on rectangular footings these anchor bolts may be shortened if necessary so that the lower end rests on the top of the rectangular footing. 3/8 inch thick anchor plates will be required. Refer to anchor plate detail.

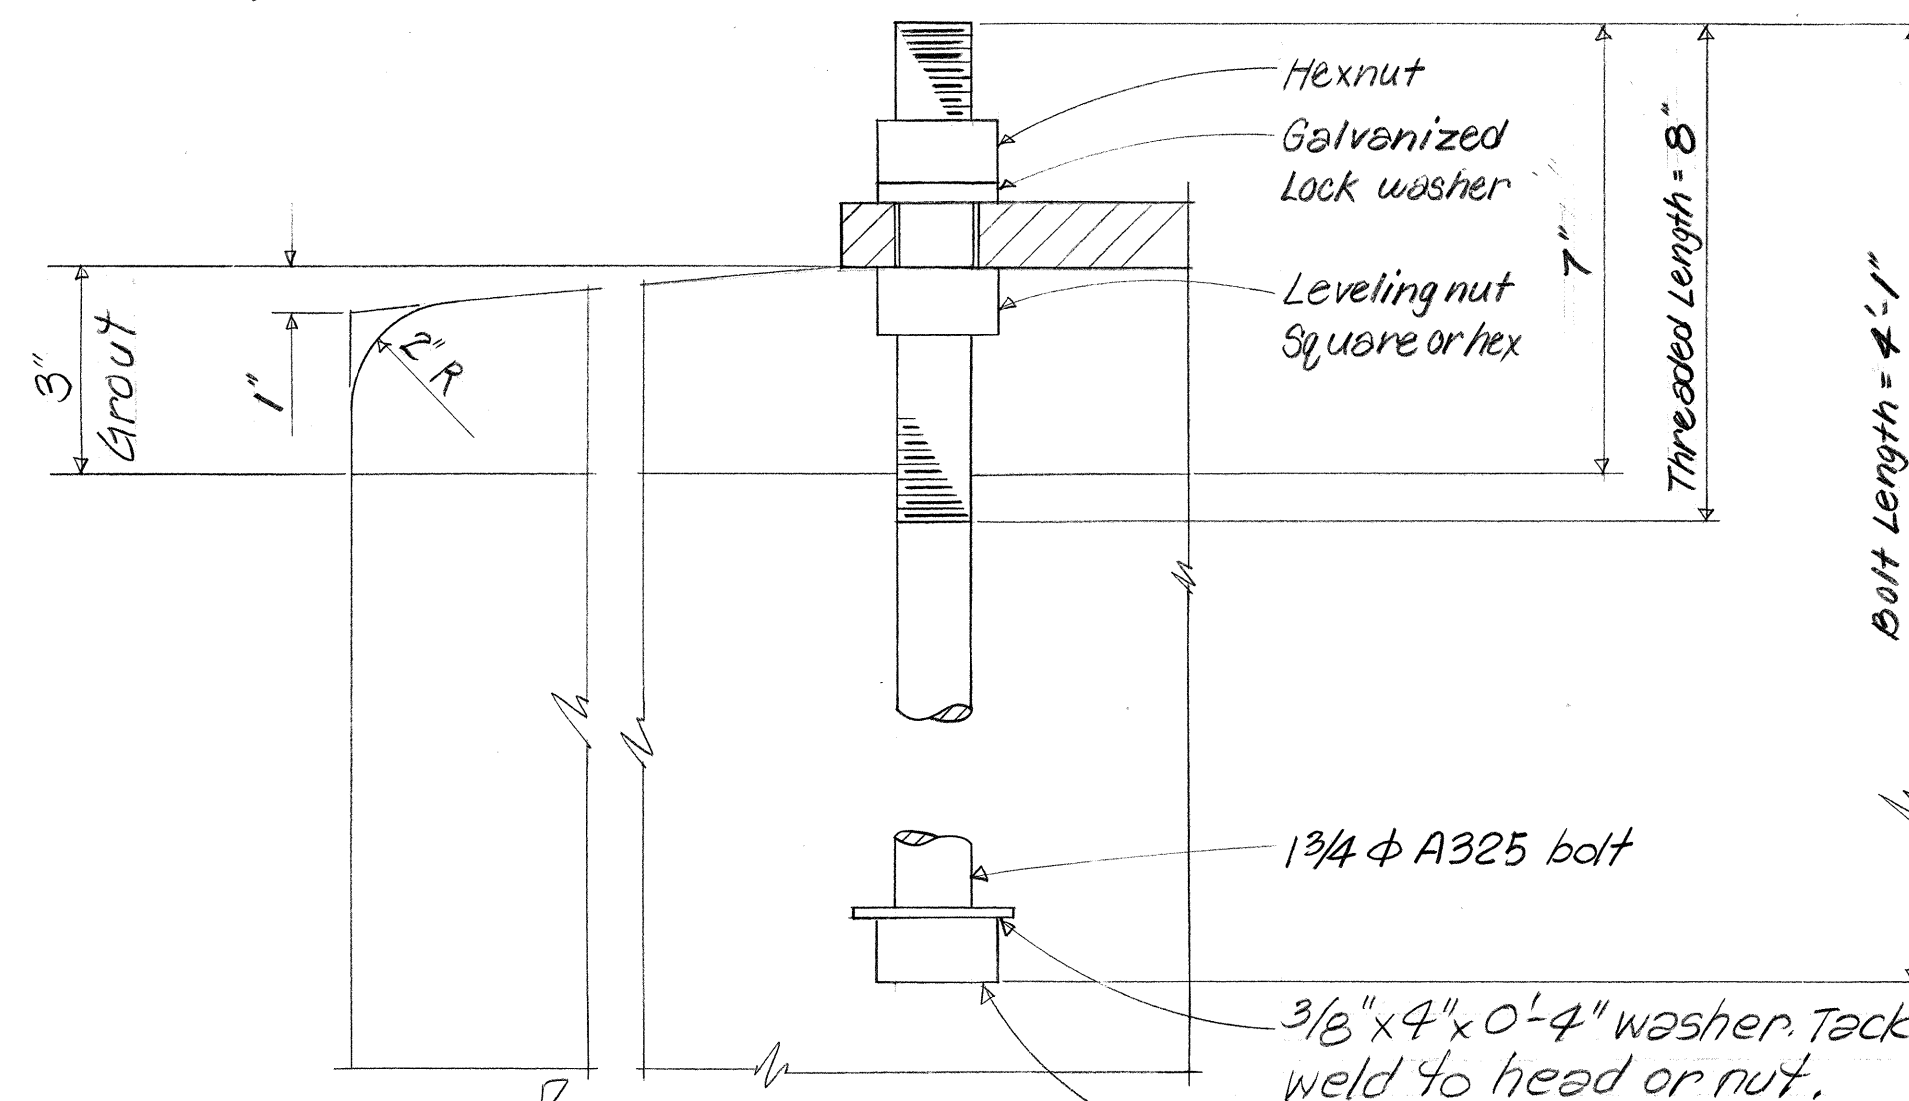

NOTE!

Galvanize bolts, plates & washers.

Head maybe replaced by a nut, threaded on & took welded

ELEVATION-ANCHOR BOLT DETAIL


TRUSSED POST BASE DETAIL

N.T.S.



NOTE "A":


Galv. anchor PL to be used in lieu of washers when nominal bolt length exceeds height of pedestal plus 4".

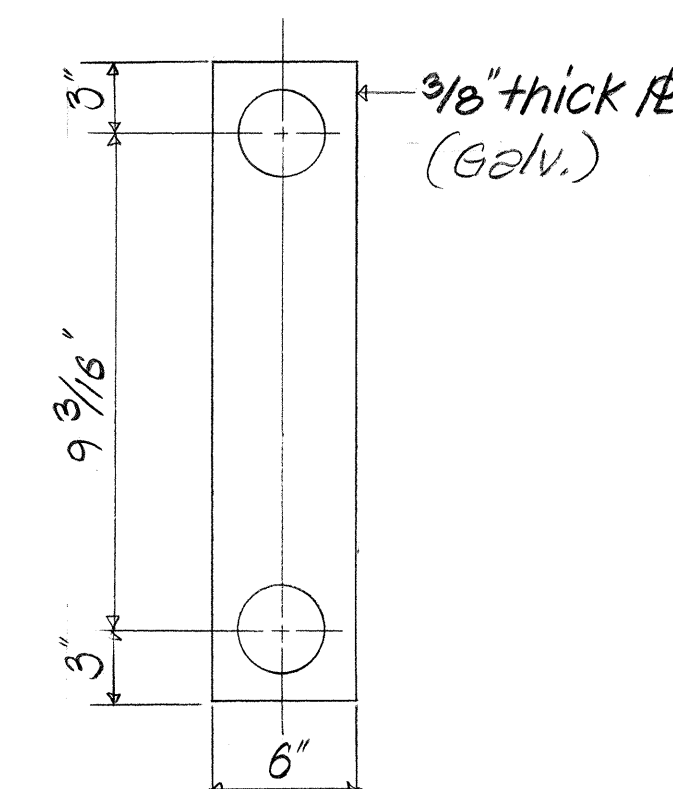


PLAN-ANCHOR PL DETAIL
SEE NOTE "A" ABOVE

5/16 inch diameter hole for 1/4 inch cotter pin or U-bolt. Hole to be vertical in completed structure


1 inch diameter bolt ASTM A325

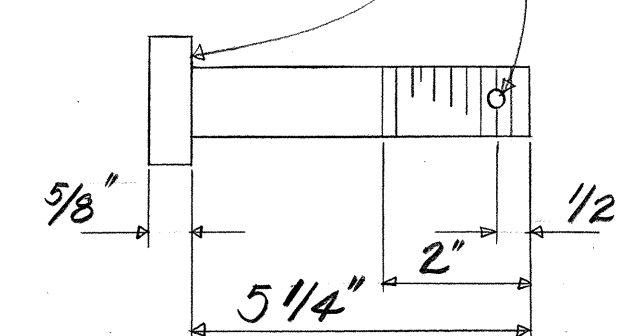

1" BOLT DETAIL

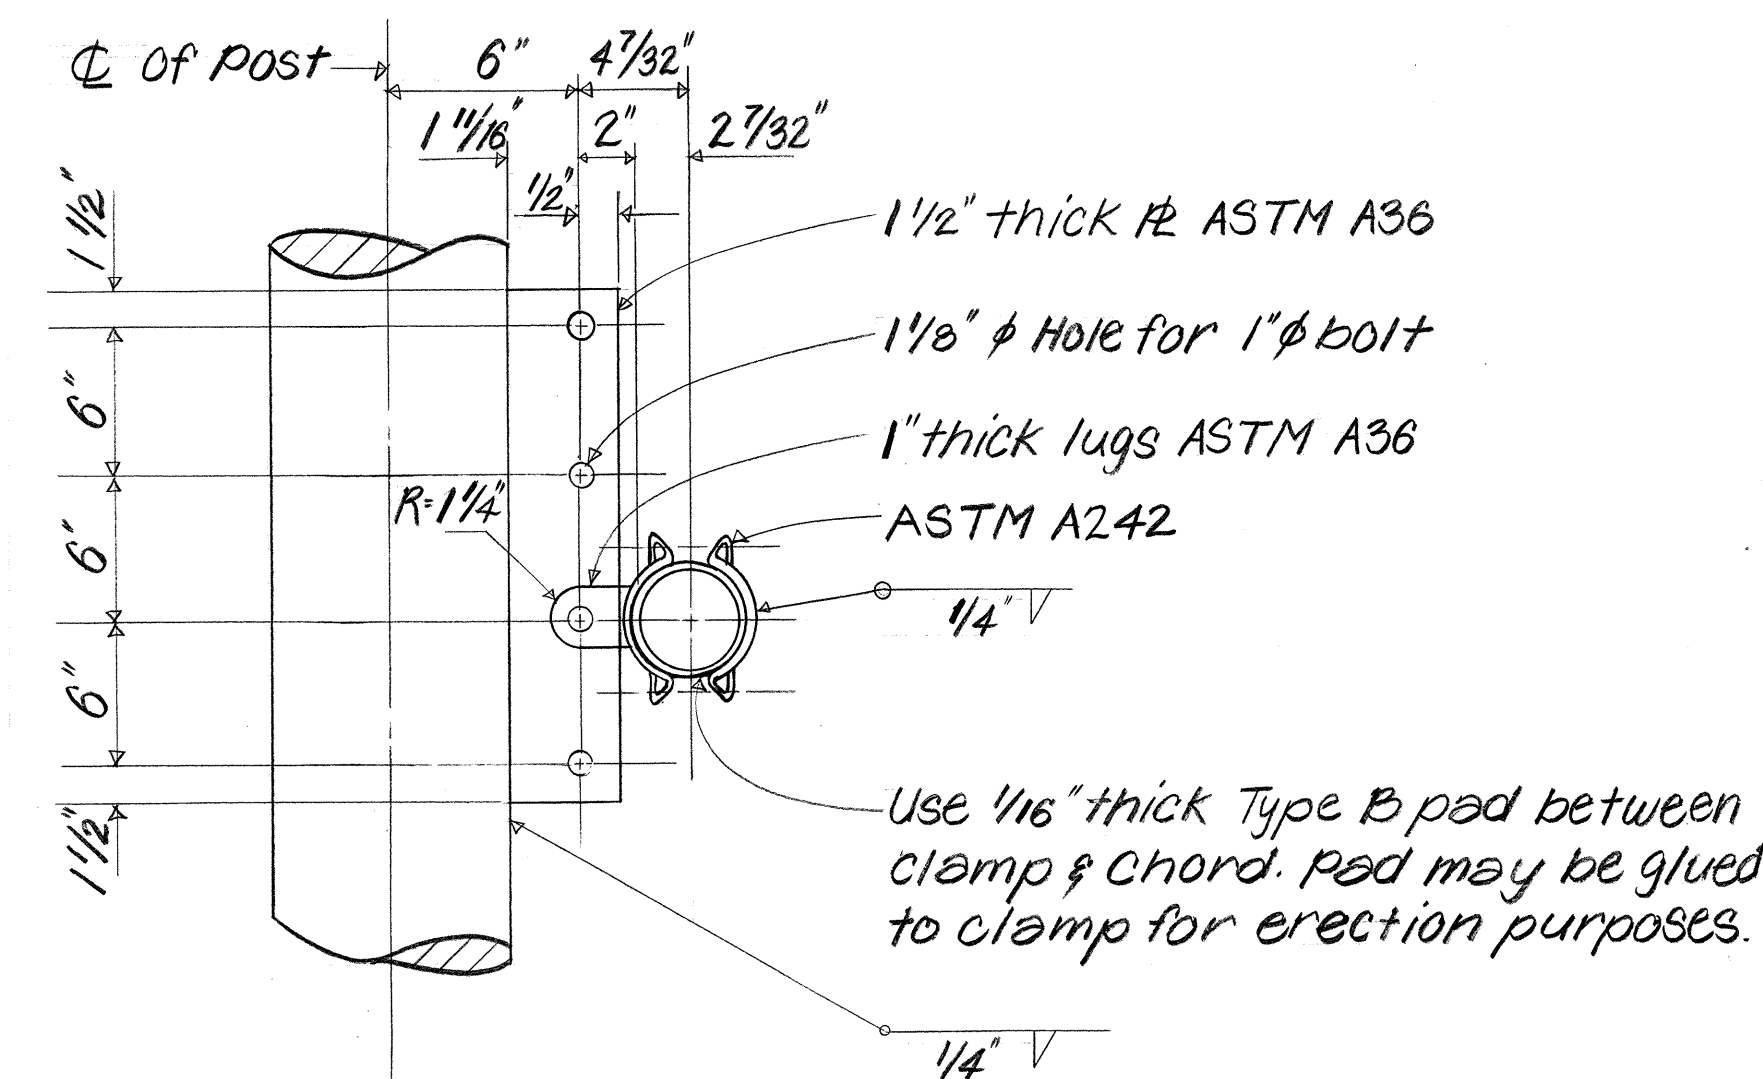



ELEVATION

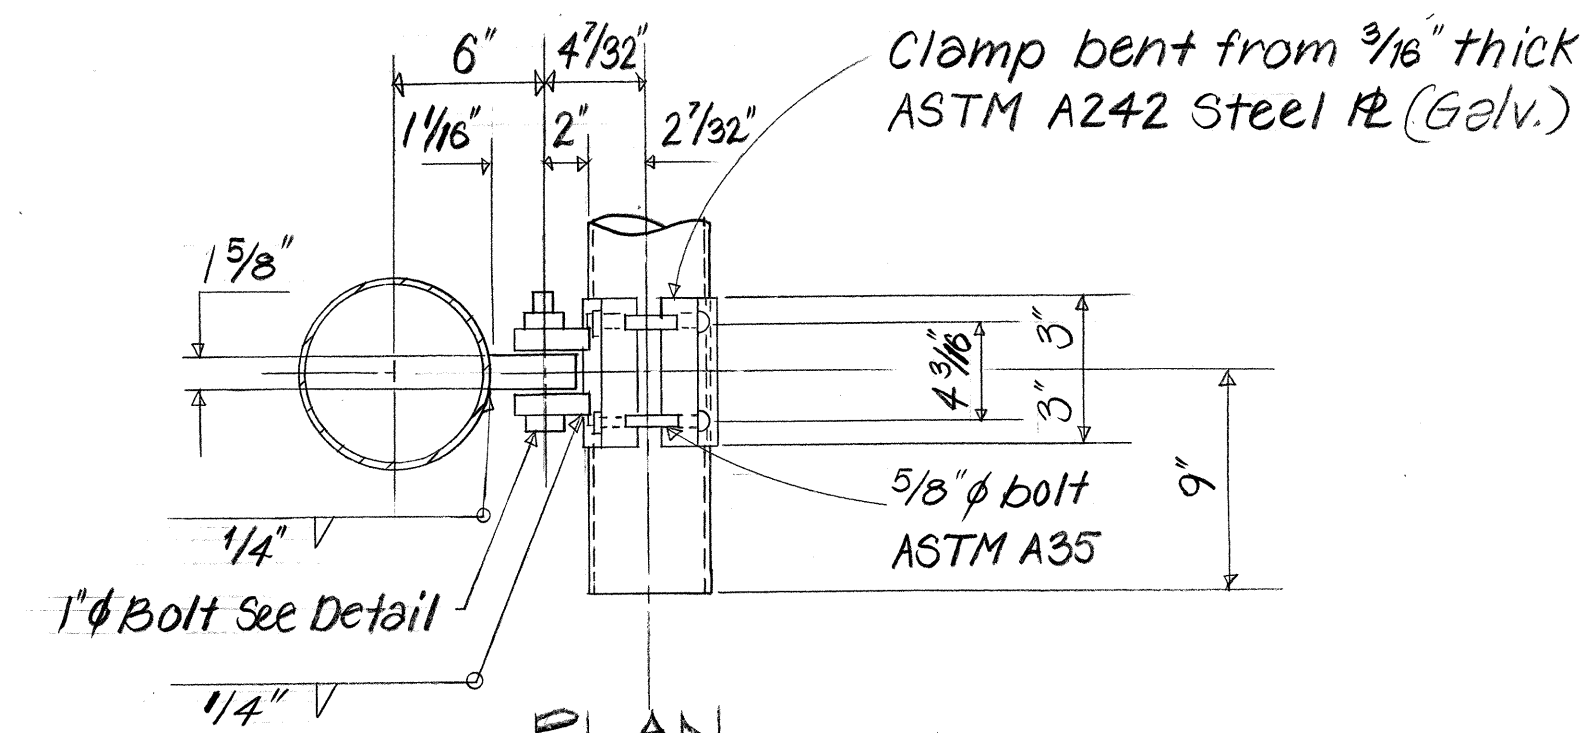


PLAN

TRUSS TO POST CONNECTION DETAIL


N.T.S.

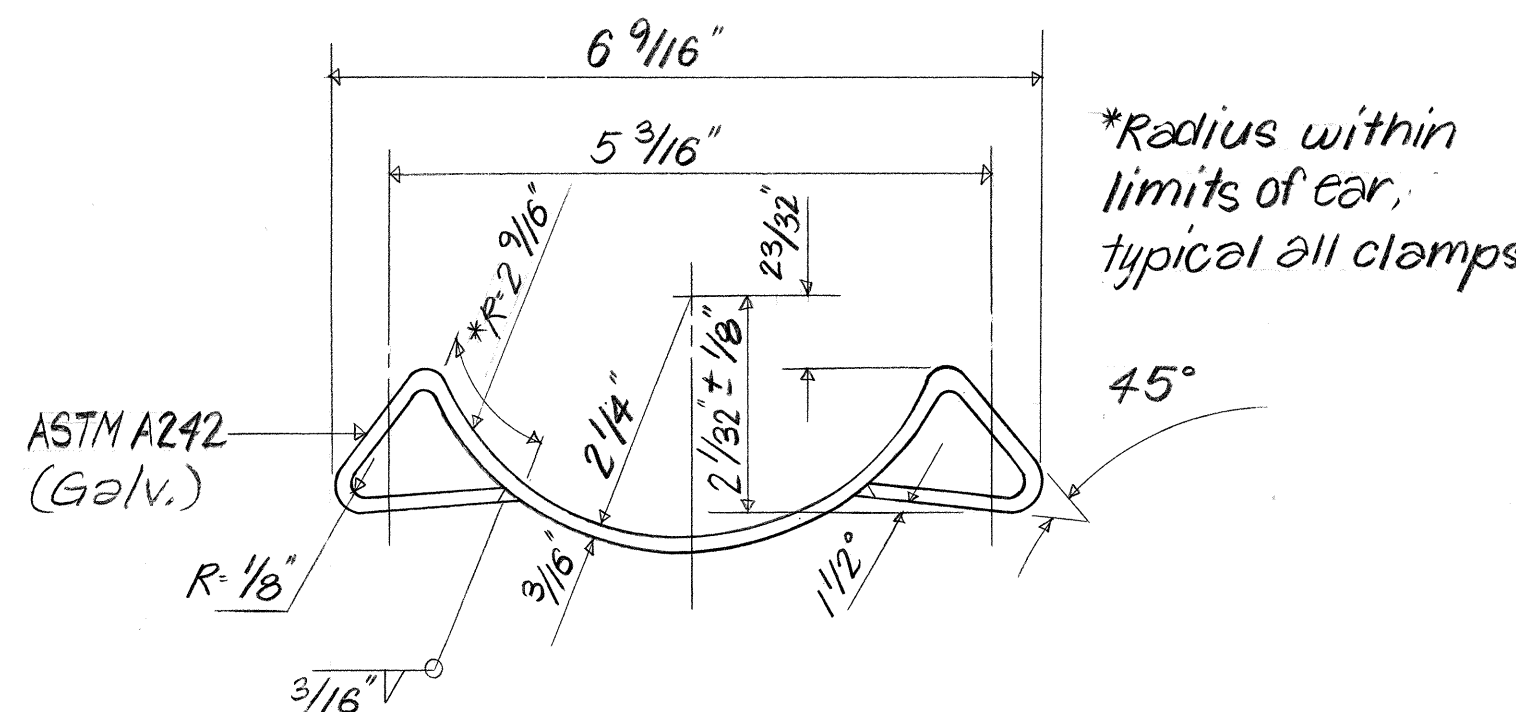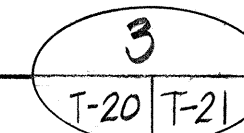

ELEVATION

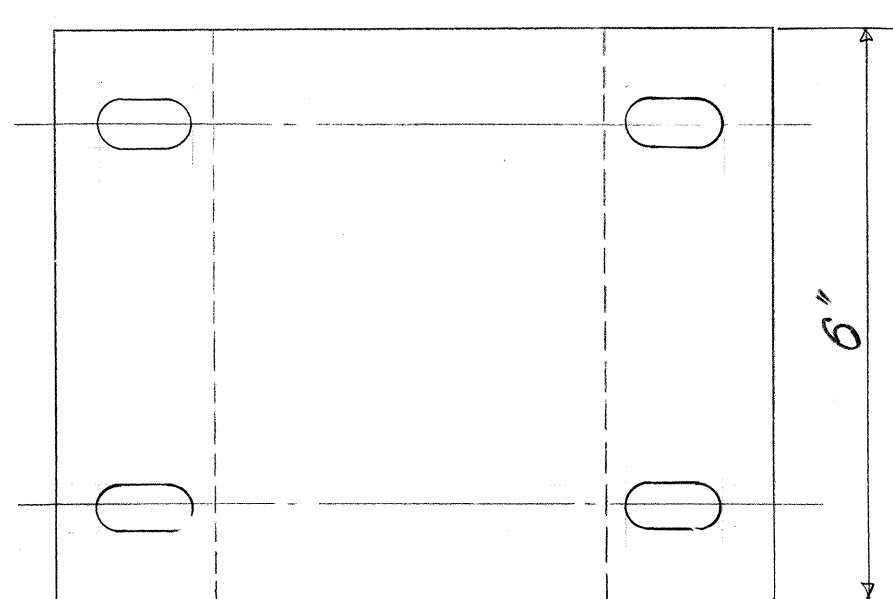


PLAN

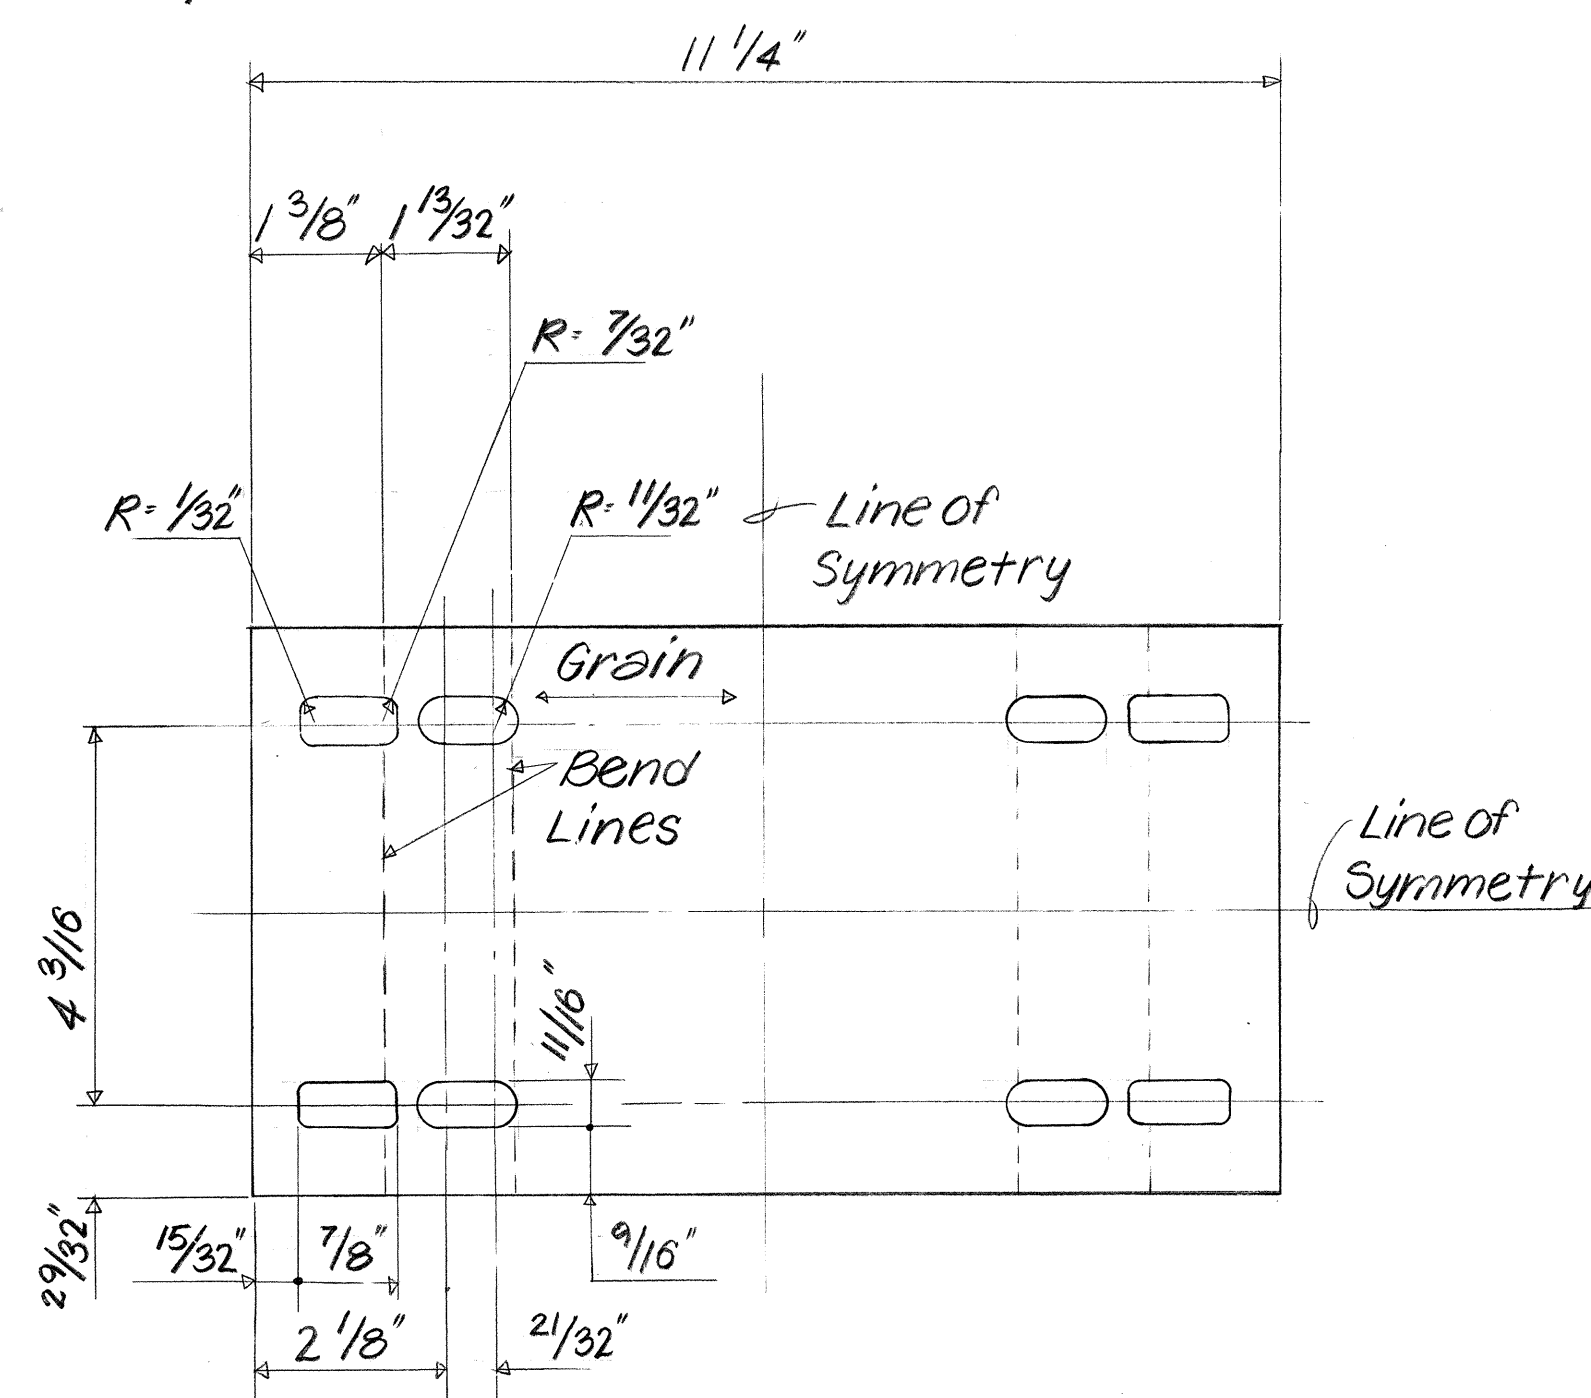

DEVELOPMENT


CLAMP DETAILS

N.T.S.

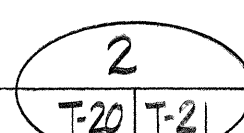

Note:
This sign structure was removed & replaced in a later H3 contract.

SSFM ENGINEERS INC.
501 Sumner St., #502
Honolulu, Hawaii 96817

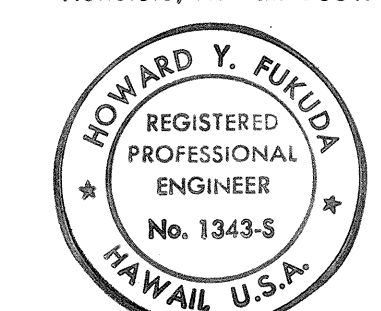

This work was prepared by me or under my supervision.
Howard Y. Fukuda

STATE OF HAWAII
DEPARTMENT OF TRANSPORTATION
HIGHWAYS DIVISION

**SIGN STRUCTURE
CONNECTION DETAILS**

INTERSTATE ROUTE H-3
F.A.I. PROJ. NO. I-H3-1(51)

SCALE: AS NOTED DATE:

SHEET No. T-21 OF 21 SHEETS

ORIGINAL PLAN	DATE
DRAWN BY	
DESIGNED BY	
QUANTITIES BY	
CHECKED BY	
NO.	