


INDEX TO DRAWINGS	
SHEET NO.	DESCRIPTION
1	TITLE SHEET
2	STANDARD PLANS SUMMARY
3	GENERAL PLAN
4	TYPICAL ROADWAY SECTIONS
5 & 6	DEMOLITION PLANS
7 & 8	GEOMETRICS PLANS
9 TO 11	PROFILE AND SE DIAGRAMS
12	DRAINAGE ESTIMATED QUANTITIES
① 3 & 14	GRADING & DRAINAGE PLANS
② 5 & 16	DRAINAGE DETAILS
17 & 18	BRIDGE DECK DRAIN LAYOUT PLANS
19 TO 23	DECK DRAIN DETAILS
24	CROSS SECTIONS
25 TO 28	LOG OF BORINGS
29	SIGNING & STRIPING PLAN VOID (9/12/94)
30	SIGN DETAILS VOID (9/12/94)
31	LOCATION PLAN & ELECTRICAL SYMBOLS
32 & 33	ELECTRICAL PLANS
34 & 35	ELECTRICAL DETAILS
36	HANDHOLE GROUP PLANS & DUCTLINE PROFILES
37	5 X 7 HANDHOLE DETAILS
38	MISCELLANEOUS HANDHOLE DETAILS
39	LANDSCAPE PLANTING PLAN
40 TO 85	STRUCTURAL DRAWINGS
86 TO 106	STRUCTURAL TYPICAL DRAWINGS
③ 106 S-1 TO 106 S-3	HALAWA ACCESS ROAD

Plan Sheet No ① 13S-1 through 13S-3, ② 15S-1, and ③ 106S-1 through 106S-3A are supplemental sheets to this project.

TOTAL SHEET COUNT after "AS BUILT" postings.
114 Sheets.

SSFM ENGINEERS
DESIGNED BY
R. MIKAMI
P. S. & E. BY
548-7468
SEPT. 1988
DATE
PHONE

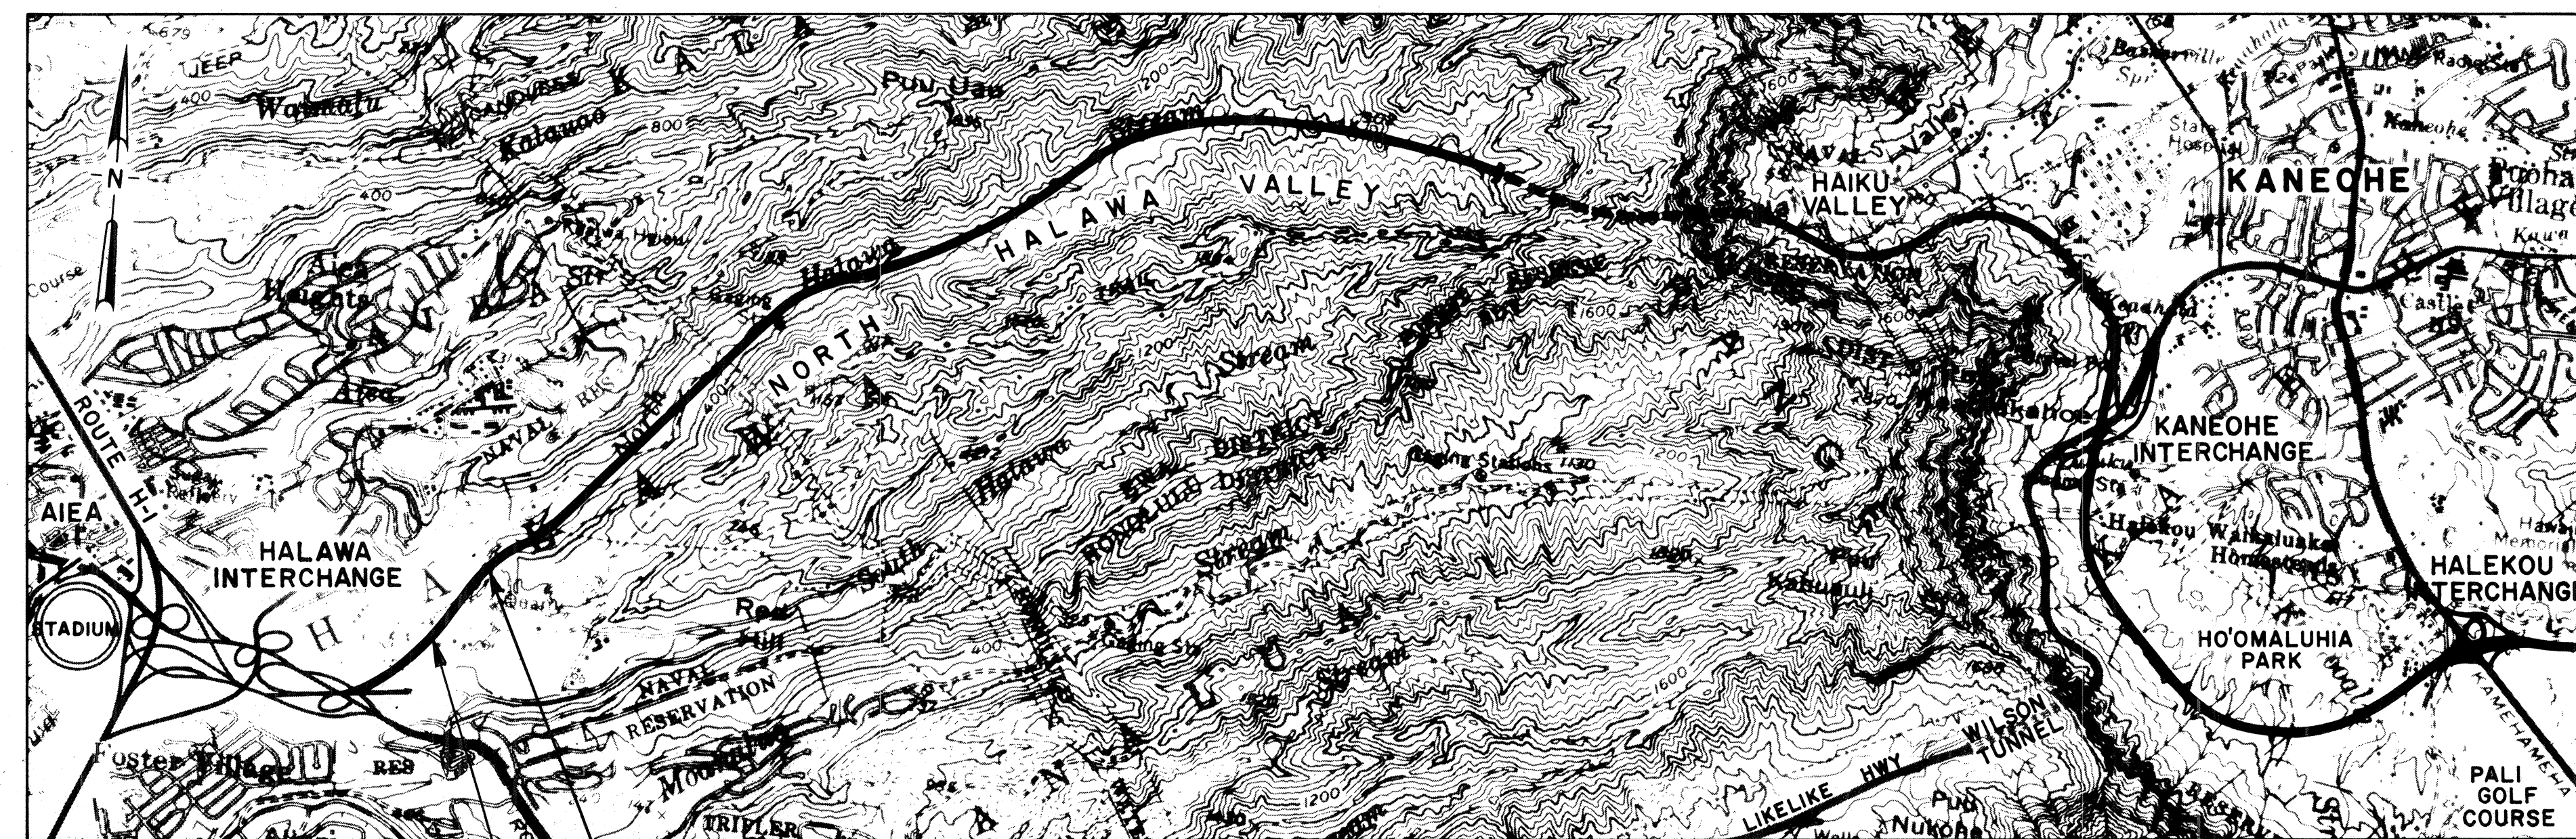

LAYOUT PLAN

END PROJECT
@ STA. 376 + 00

BEGIN PROJECT
@ STA. 356 + 70


LENGTH OF PROJECT = 0.37 MILE

1/2 0 1/2 1
SCALE IN MILES

11/15/88	ADDED HALAWA ACCESS ROAD SHEETS
DATE	REVISION

STATE OF HAWAII
DEPARTMENT OF TRANSPORTATION
HIGHWAYS DIVISION
HONOLULU, HAWAII
"AS-BUILT"
PLANS FOR
CONSTRUCTION OF A PORTION OF
INTERSTATE ROUTE H-3
HALAWA QUARRY VIADUCT
MAUKA SECTION
FEDERAL AID INTERSTATE PROJECT NO. I-H3-1(51)
DISTRICT OF EWA
ISLAND OF OAHU

FED. ROAD DIST. NO.	STATE	FED. AID PROJ. NO.	FISCAL YEAR	SHEET NO.	TOTAL SHEETS
HAWAII	HAW.	I-H3-1(51)	1989	1	106

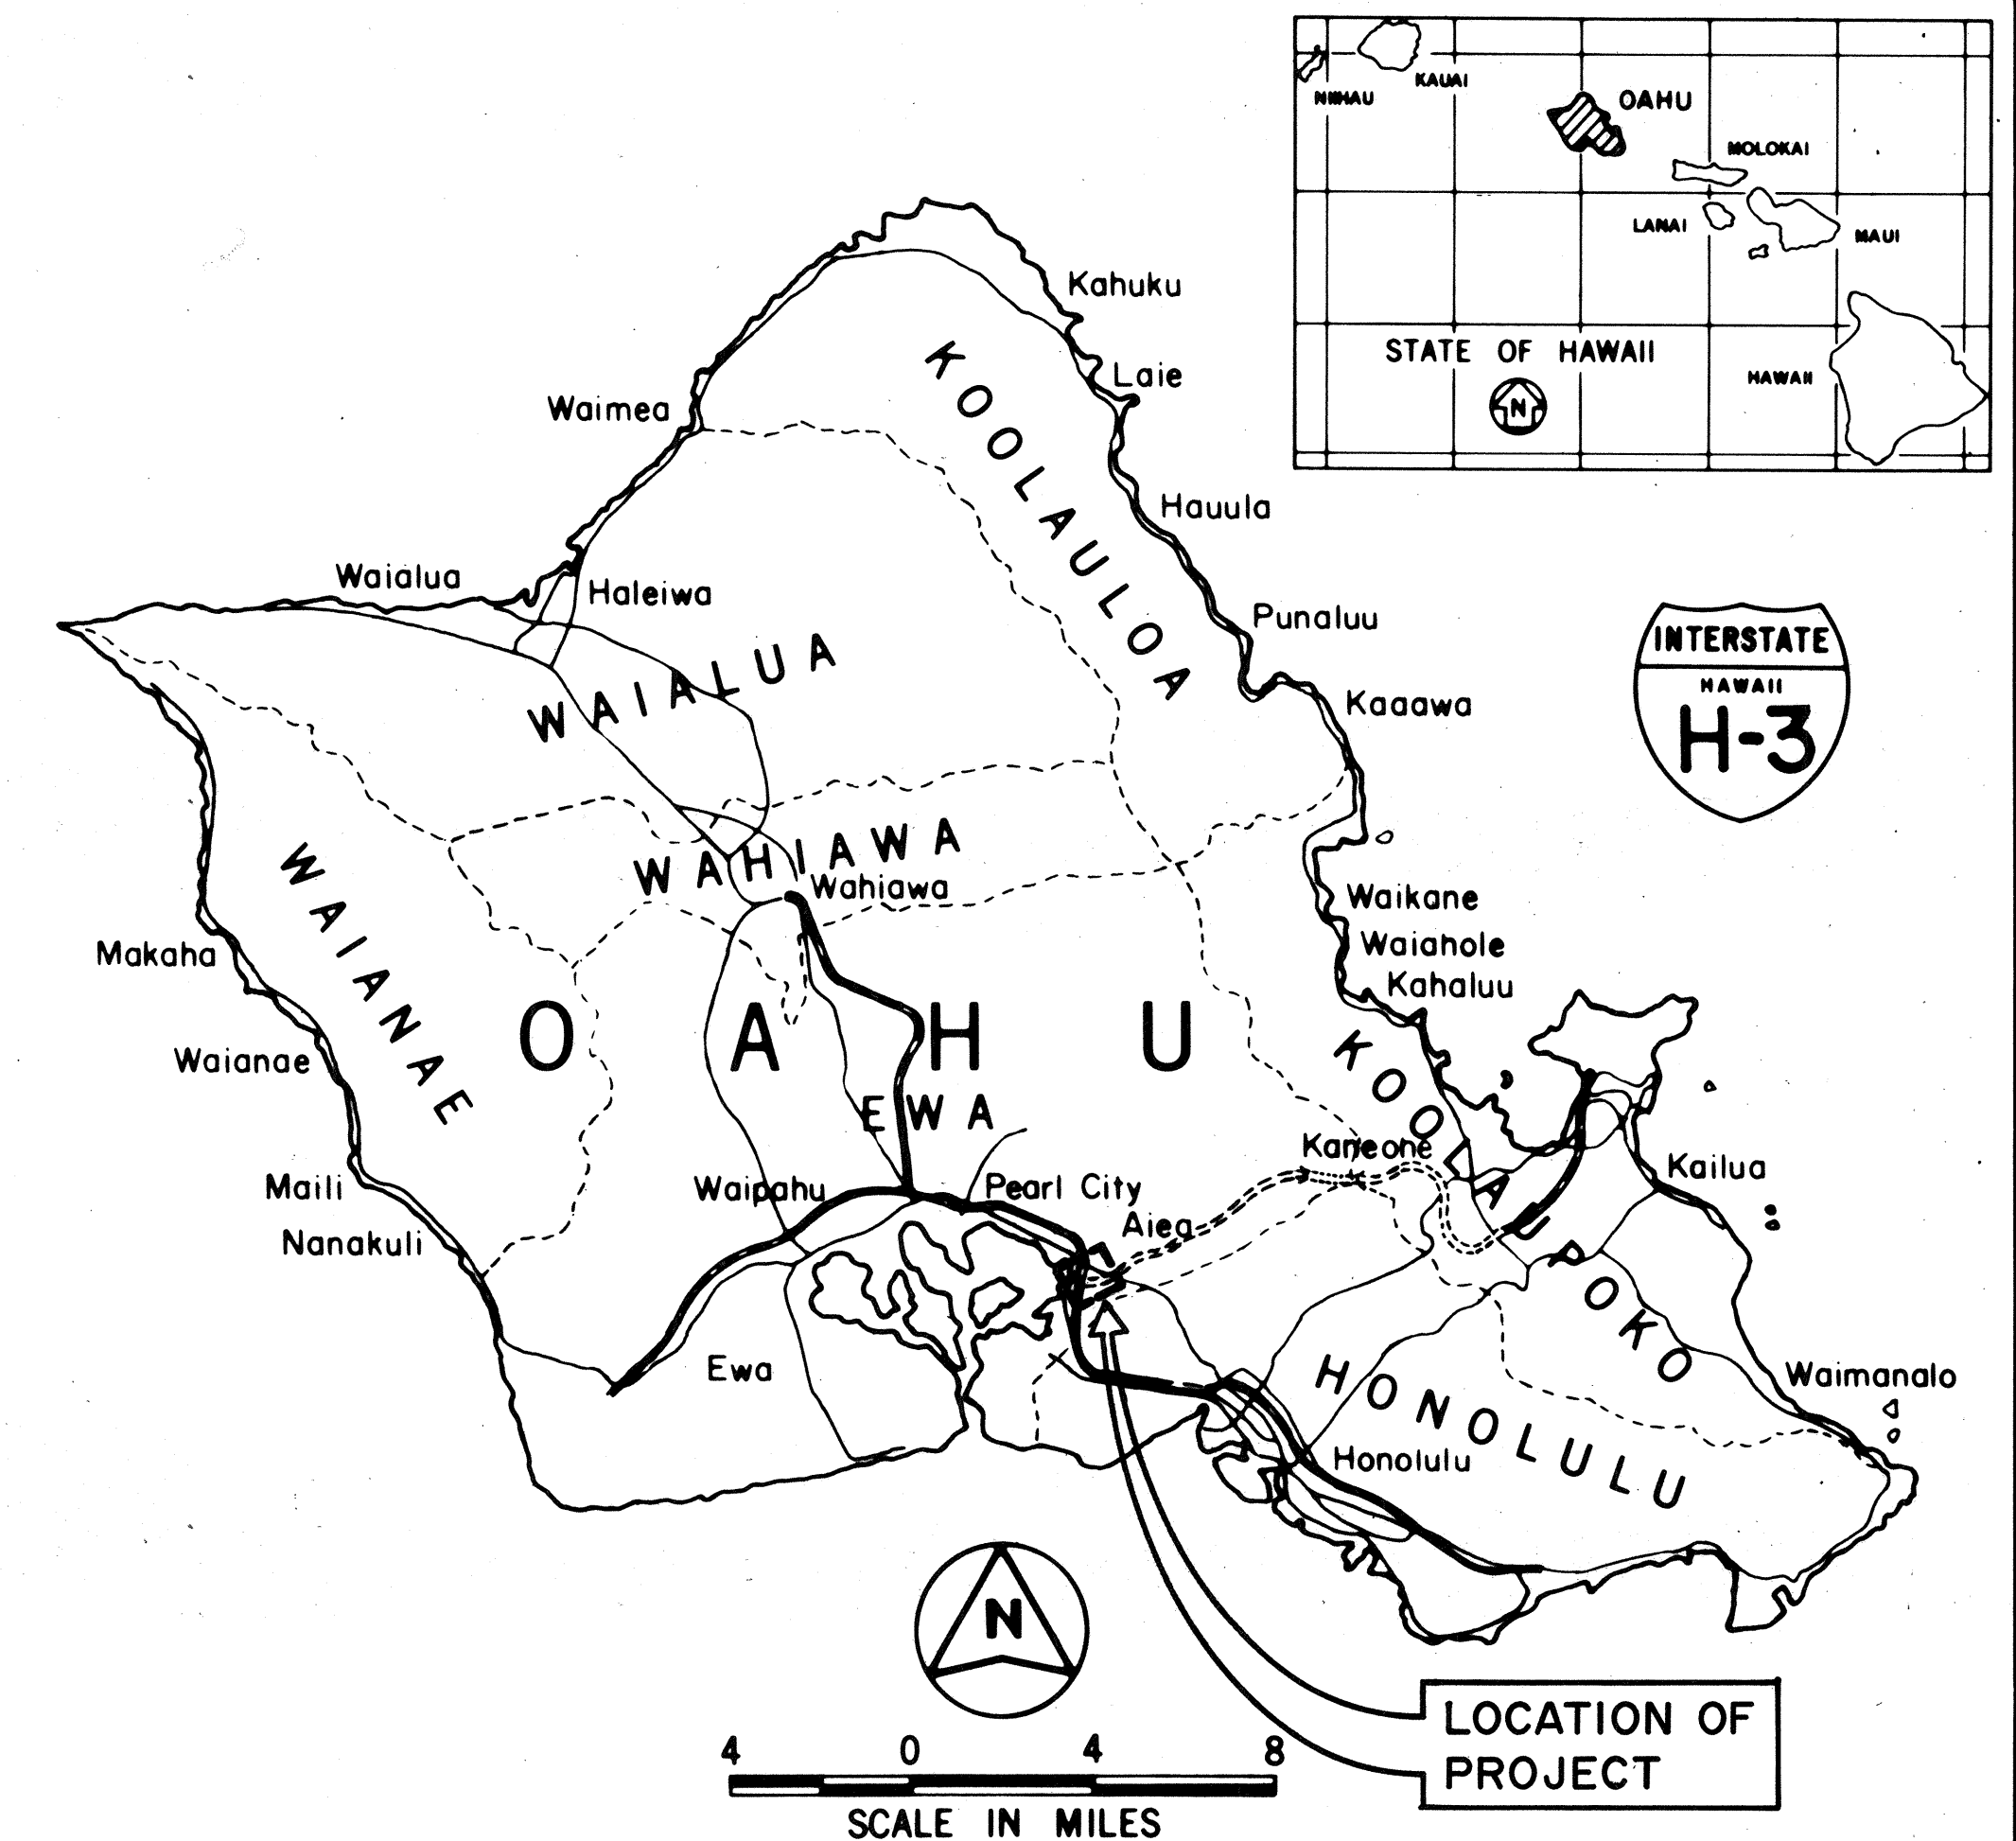

SCALE IN MILES
FEDERAL AID INTERSTATE PROJECTS PREVIOUSLY CONSTRUCTED OR UNDER CONSTRUCTION

NOTE:
ALL CHANGES MADE DURING CONSTRUCTION HAVE BEEN NOTED IN RED ON THESE TRACINGS AND CHECKED BY:
RESIDENT ENGINEER
DATE

DESIGN CLASSIFICATION

DESIGN ADT (2008)...45,220
DHV..... 4,282
D..... 76/24
T..... 2.1%
T24..... 4.1%
V..... 60 MPH

DEPARTMENT OF TRANSPORTATION FEDERAL HIGHWAY ADMINISTRATION	
APPROVED:	9/19/88
DIVISION ADMINISTRATOR	DATE

DEPARTMENT OF TRANSPORTATION STATE OF HAWAII	
APPROVED:	8/15/88
DIR. OF TRANSPORTATION	DATE

ADD. 1