


FED. ROAD DIST. NO.	STATE	FED. AID PROJ. NO.	FISCAL YEAR	SHEET NO.	TOTAL SHEETS
HAWAII	HAW.	I-H3-1(51)	1989	4	106

# LEGEND

AC	ACRE	IN	INCH
ALUM	ALUMINUM	INV	INVERT
APPROX	APPROXIMATE	LB	POUND
AZ	AZIMUTH	LC	LENGTH OF CURVE
BL	BASELINE	LF	LINEAL FEET
BOTT	BOTTOM	LONGIT	LONGITUDINAL
C	CUT	LT	LEFT
CAP	CORRUGATED ALUMINUM PIPE	LT EP	LEFT EDGE OF PAVEMENT
CC	CENTER OF CURVE	MAX	MAXIMUM
Ch	CHORD	MIN	MINIMUM
CL	CENTERLINE	N	NORTH
CMP	CORRUGATED METAL PIPE	NIC	NOT IN CONTRACT
CONC	CONCRETE	NO	NUMBER
CONT	CONTINUATION	OPEN'G	OPENING
CORR	CORRUGATED	O/S	OFFSET
CY	CUBIC YARD	PC	POINT OF CURVATURE
d	EXISTING DRAIN LINE	PI	POINT OF INTERSECTION
DET	DETAIL	PIVC	POINT OF INTERSECTION OF VERTICAL CURVE
DI	DRAIN INLET	POC	POINT ON CURVE
DISCONT	DISCONTINUED	PRVC	POINT OF REVERSE VERTICAL CURVE
DIST	DISTRICT	PVC	POLYVINYL CHLORIDE
DL	DRAIN LINE	R	RADIUS
DWGS	DRAWINGS	RCP	REINFORCED CONCRETE PIPE
E	EAST	REINF	REINFORCING
EA	EACH	RT	RIGHT
ELEV	ELEVATION	RT EP	RIGHT EDGE OF PAVEMENT
EMB	EMBANKMENT	R/W	RIGHT-OF-WAY
ENGR	ENGINEER	SE	EXISTING SEWER LINE
EVC	END OF VERTICAL CURVE	SRMP	SUPERELEVATION
EXC	EXCAVATION	STA	STATION
EXIST	EXISTING	STRUC	STRUCTURE
EXP	EXPANSION	SY	SQUARE YARD
F	FILL	T & B	TOP AND BOTTOM
FAI	FEDERAL AID INTERSTATE	TAN	TANGENT
FED	FEDERAL	THK	THICK
FIN	FINISHED	TYP	TYPICAL
GA	GAUGE	VC	VERTICAL CURVE
GALV	GALVANIZED	VERT	VERTICAL
GRD	GRADE	W	EXISTING WATER LINE
HAW	HAWAII	W/	WITH
HORIZ	HORIZONTAL		
HV	HORIZONTAL/VERTICAL		
HWL	HIGH WATER LEVEL		

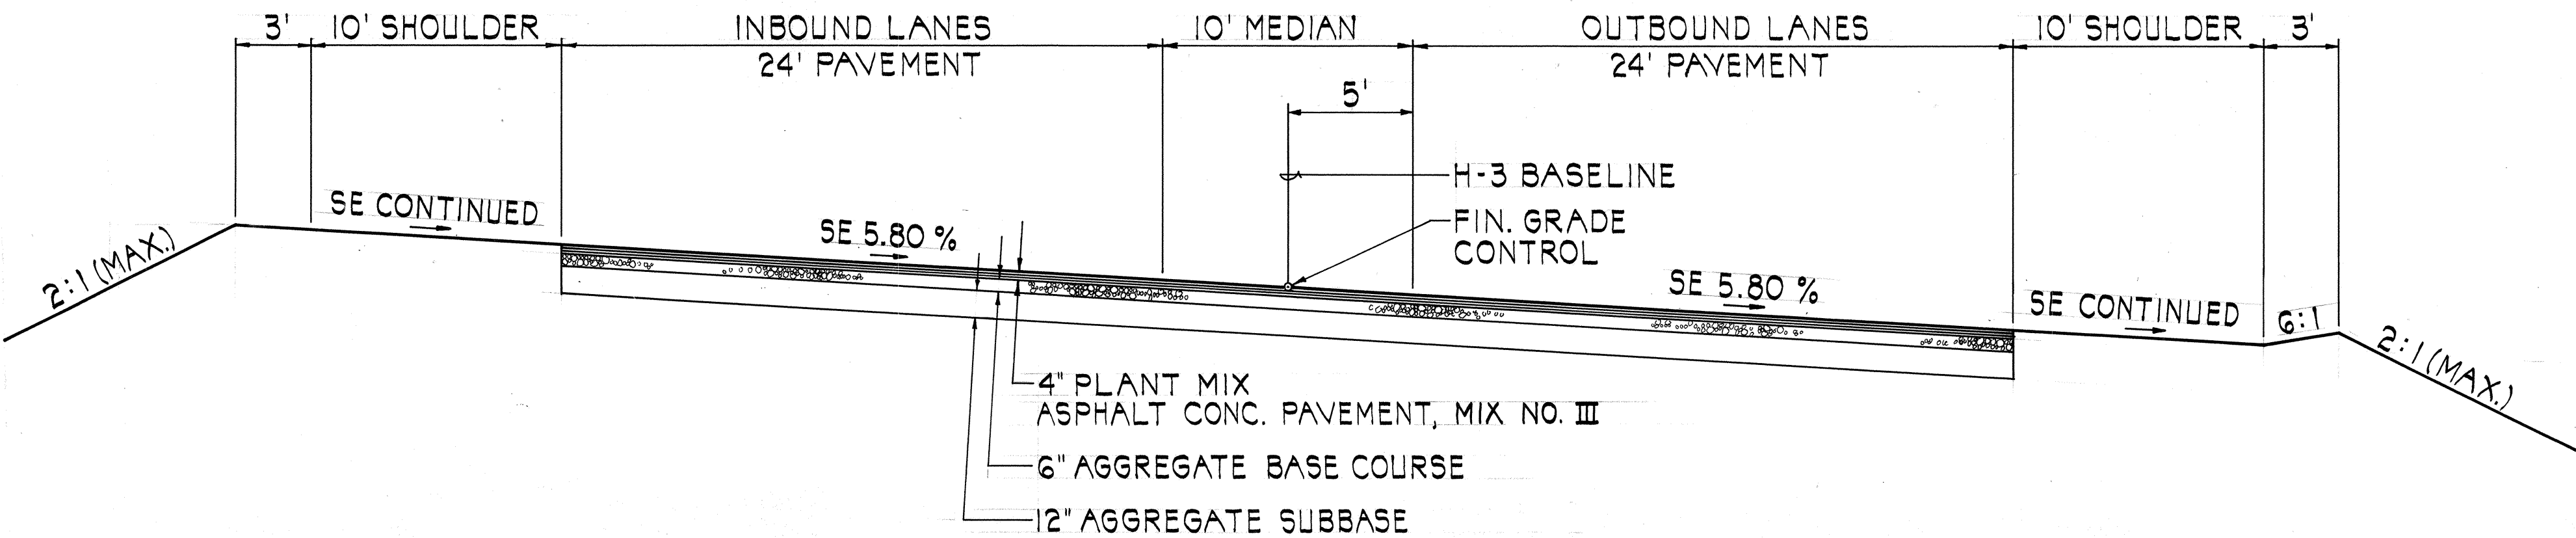

TEMPORARY ROADWAY SECTION  
 STA. 374 + 25 TO STA. 376 + 00  
 SCALE: 1" = 5'

SURVEY PLOTTED BY	DATE
DRAWN BY	
TRACED BY	
CHECKED BY	
NOTED BY	
NO.	



THIS WORK WAS PREPARED BY ME  
 OR UNDER MY SUPERVISION  
*Theodore S. Kawahigashi*  
 Signature

11/15/88 ADDED DIMENSION TO BASELINE

STATE OF HAWAII  
DEPARTMENT OF TRANSPORTATION  
HIGHWAYS DIVISION  
  
**TYPICAL  
ROADWAY SECTIONS**  
  
INTERSTATE ROUTE H-3  
F.A.I. PROJECT NO. I-H3-1(51)  
  
SCALE: 1" = 5'

DATE: AUG. 1988  
SHEET NO. 1 OF 1 SHEETS