

PBHA/TLA	D. TANAKA	548-6932	MAY '88
DESIGNED BY	P. S. & E. BY	PHONE	DATE


DD-R-2-2

A map of the Hawaiian Islands. The islands shown are Niihau, Kauai, Oahu, Molokai, Lanai, Maui, and Hawaii. Oahu is highlighted with a hand icon. The text "STATE OF HAWAII" is written across the bottom.



CHANGES MADE DURING CONSTRUCTION HAVE
BEEN INCORPORATED ON THESE PLANS EXCEPT
CHANGES IN THE ORIGINAL THEORETICAL
QUANTITIES. FOR ACTUAL QUANTITIES, REFER TO
PROJECT LEDGER AND/OR COMPUTATION BOOK.

9/20/91
DATE

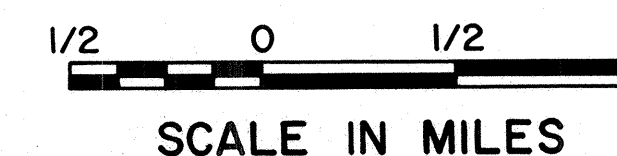

GROSS LENGTH OF PROJECT.....	2.19	MILES
BRIDGES OVER 20 FT. SPAN.....	0.15	MILES
NET LENGTH OF ROADWAY.....	2.04	MILES

DEPARTMENT OF TRANSPORTATION STATE OF HAWAII	
APPROVED: <i>Edward J. Hunt</i> 5/4/80	
DIR. OF TRANSPORTATION	DATE