
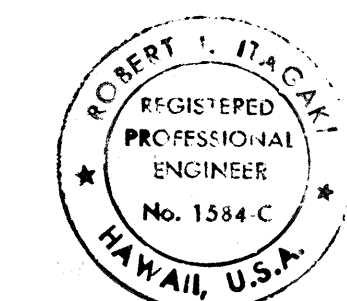


FED. ROAD DIST. NO.	STATE	FED. AID PROJ. NO.	FISCAL YEAR	SHEET NO.	TOTAL SHEETS
HAWAII	HAW.	I-H3-1(53)	1988	8	124

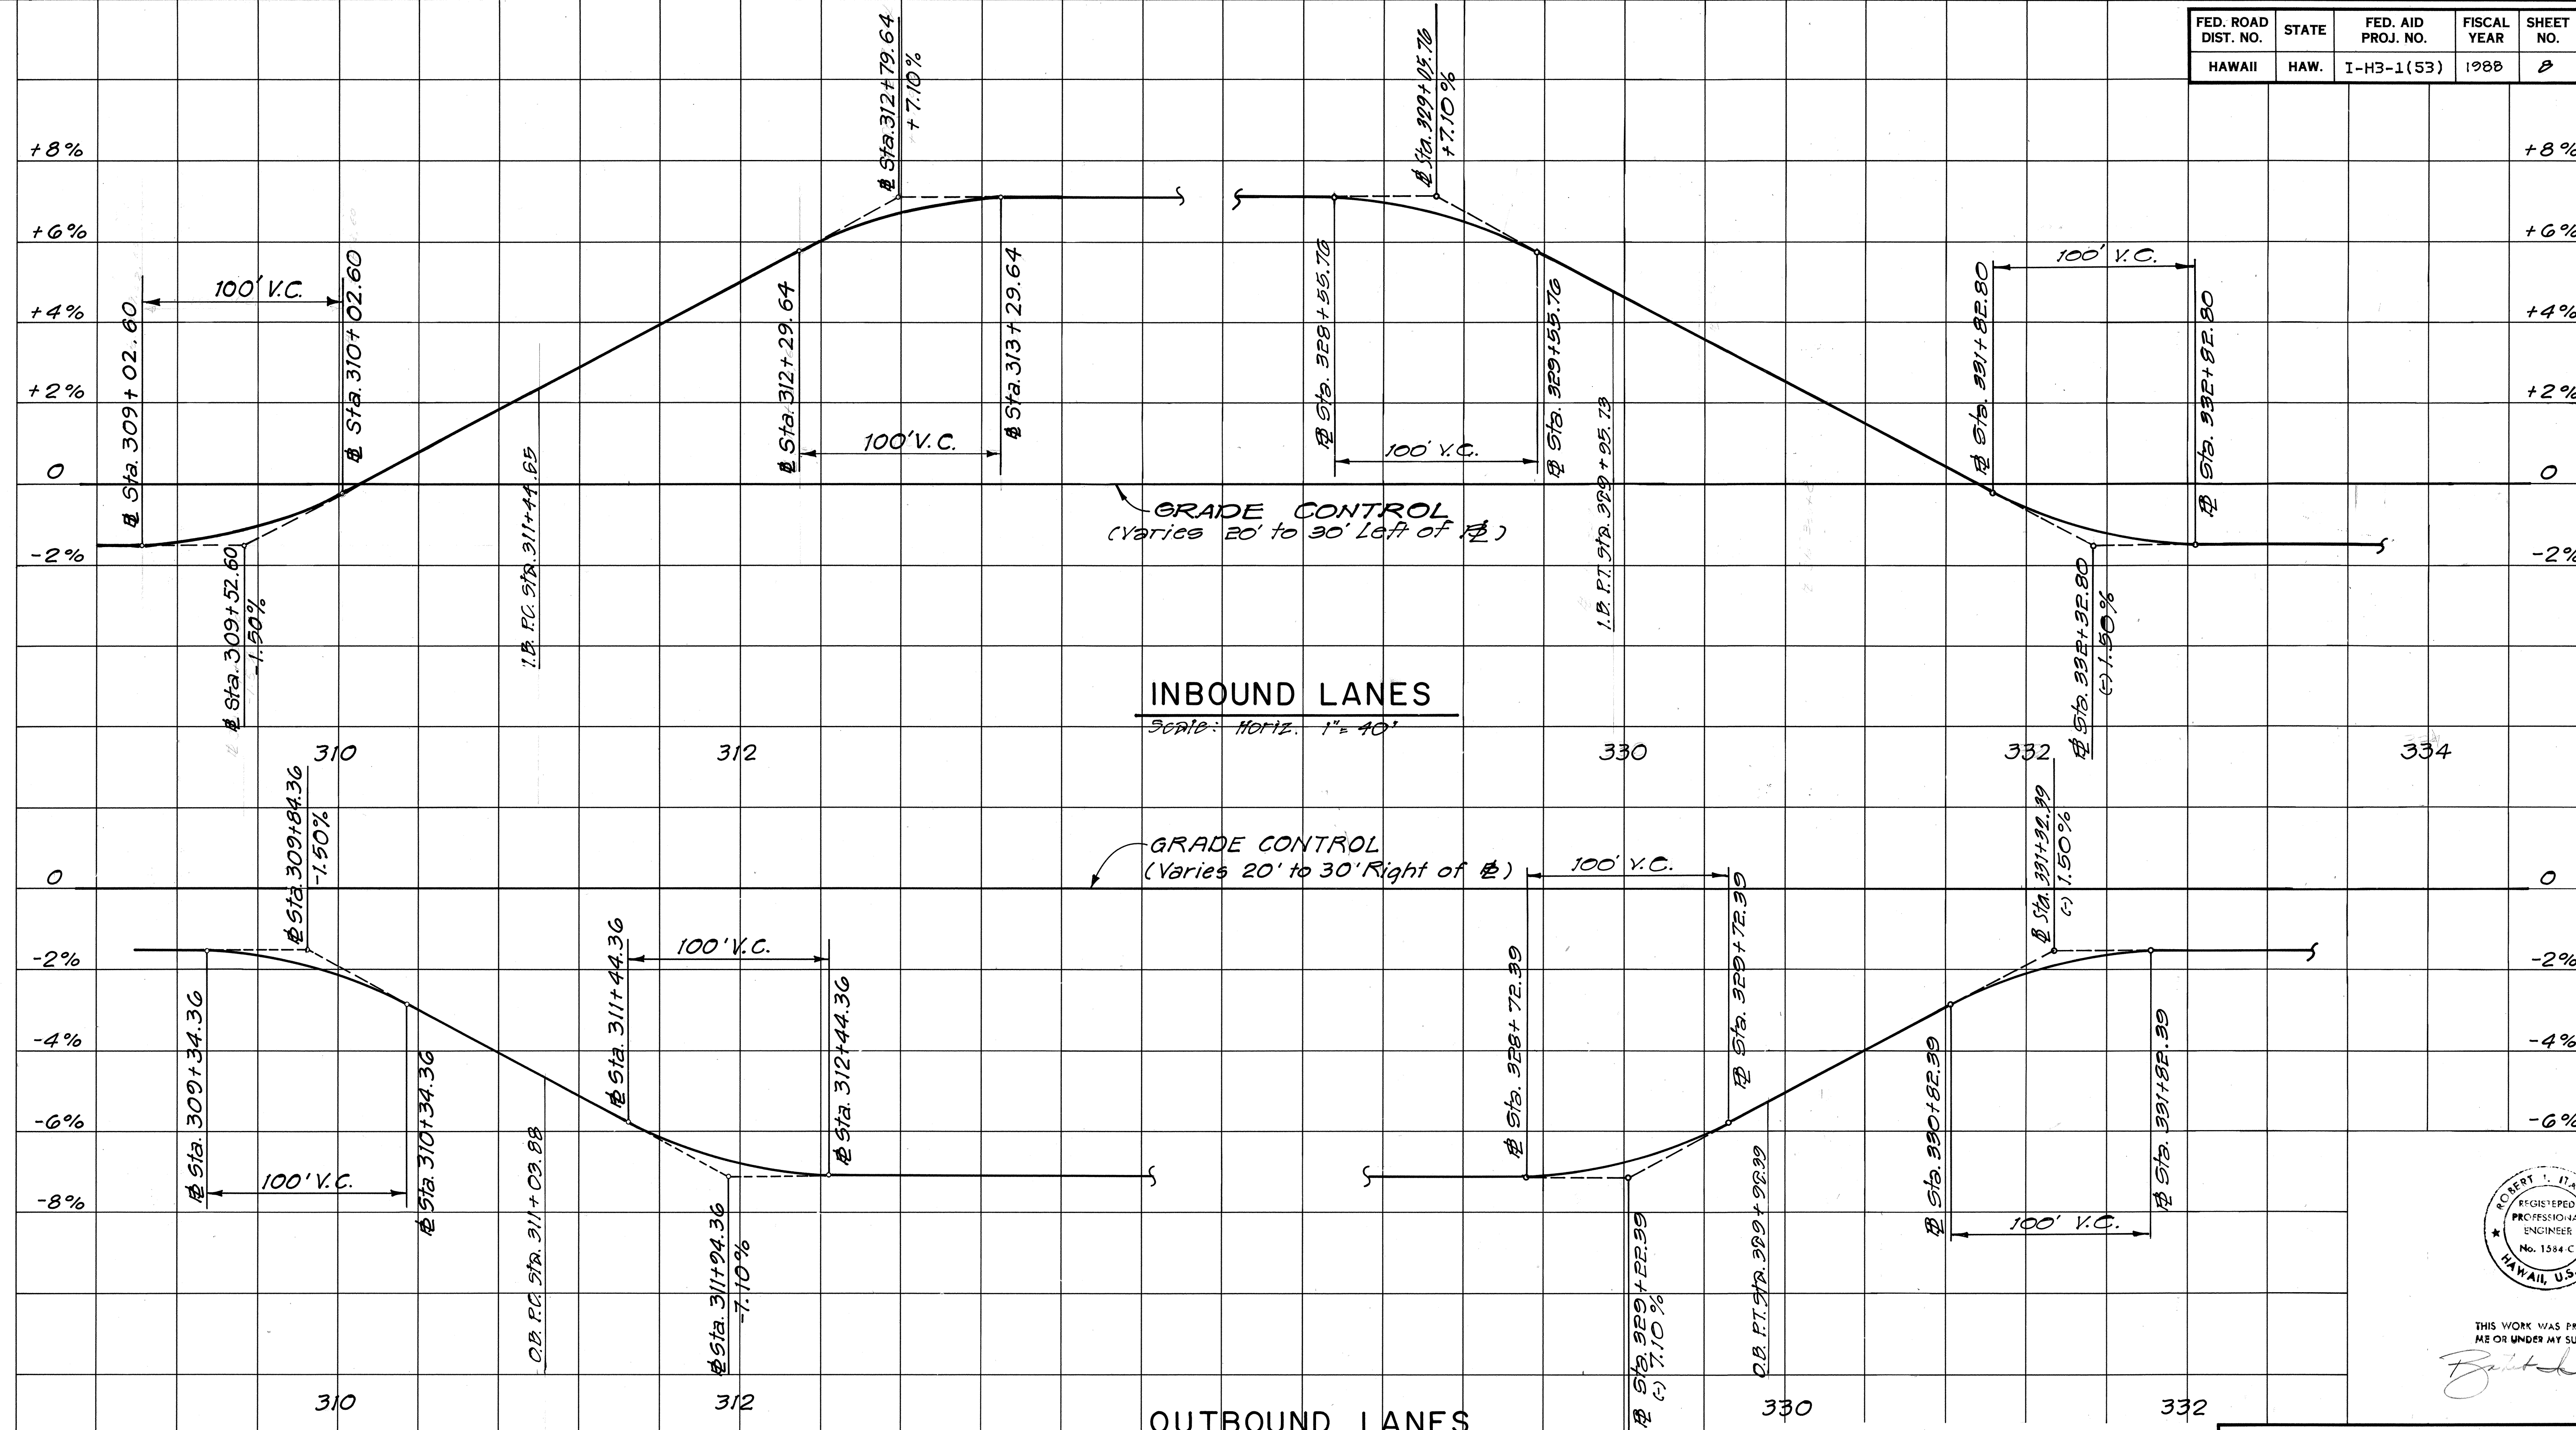

THIS WORK WAS PREPARED BY
 ME OR UNDER MY SUPERVISION
Robert A. Hagan

STATE OF HAWAII
 DEPARTMENT OF TRANSPORTATION
 HIGHWAYS DIVISION

SUPERELEVATION DIAGRAMS

INTERSTATE ROUTE H-3
 F.A.I. PROJ. NO. I-H3-1(53)

SCALE: AS NOTED DATE: AUG., 1988

SHEET NO. 1 OF 1 SHEETS

ORIGINAL PLAN	DATE
NOTED BY	
DESIGNED BY	
QUANTITIES BY	
CHECKED BY	
NO.	