




FED. ROAD DIST. NO.	STATE	FED. AID PROJ. NO.	FISCAL YEAR	SHEET NO.	TOTAL SHEETS
HAWAII	HAW.	I-H3-1(28)13	1977	2	55

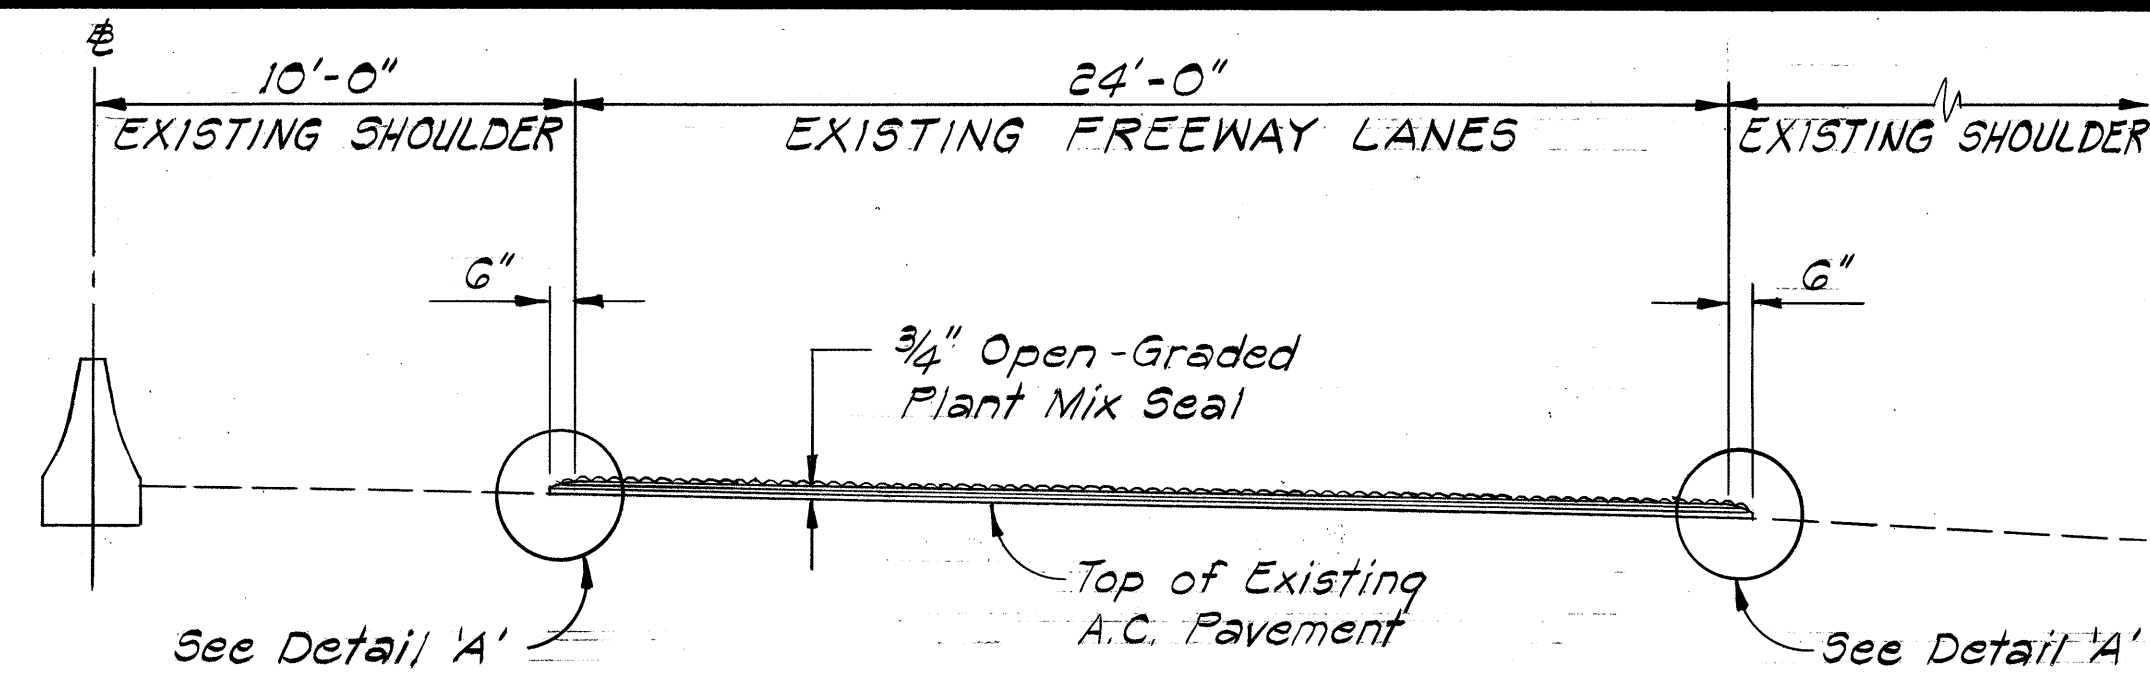


TYPICAL SECTION
OPEN-GRADED PLANT MIX SEAL SURFACING
± STA. 628+50± TO ± STA. 711+35±
Not To Scale

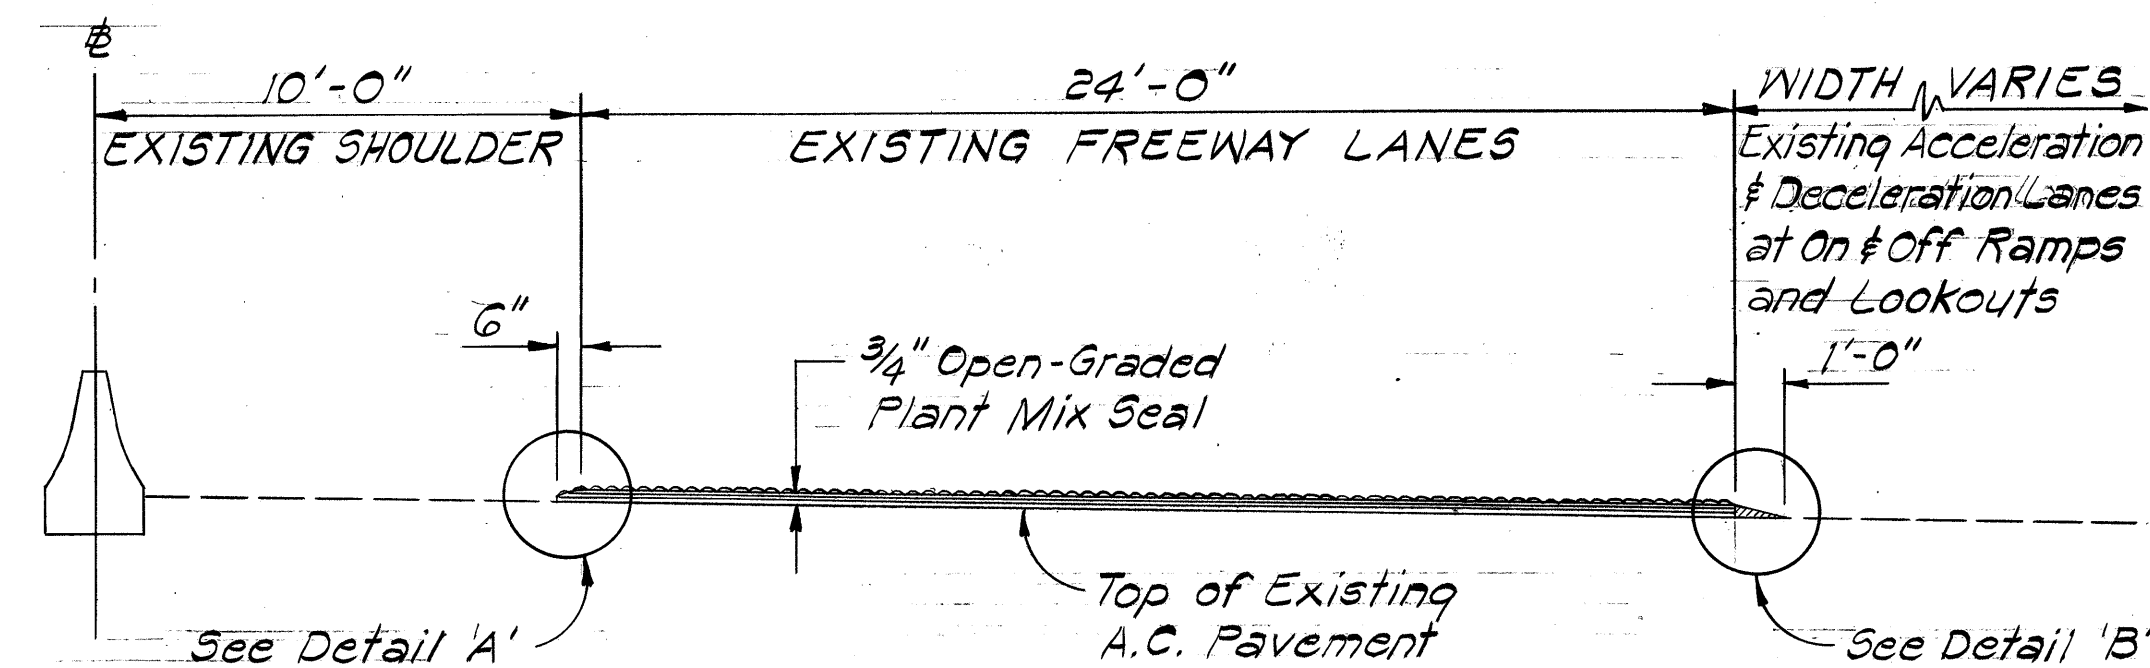


TYPICAL SECTION
OPEN-GRADED PLANT MIX SEAL SURFACING
± STA. 628+50± TO ± STA. 711+35±
Not To Scale

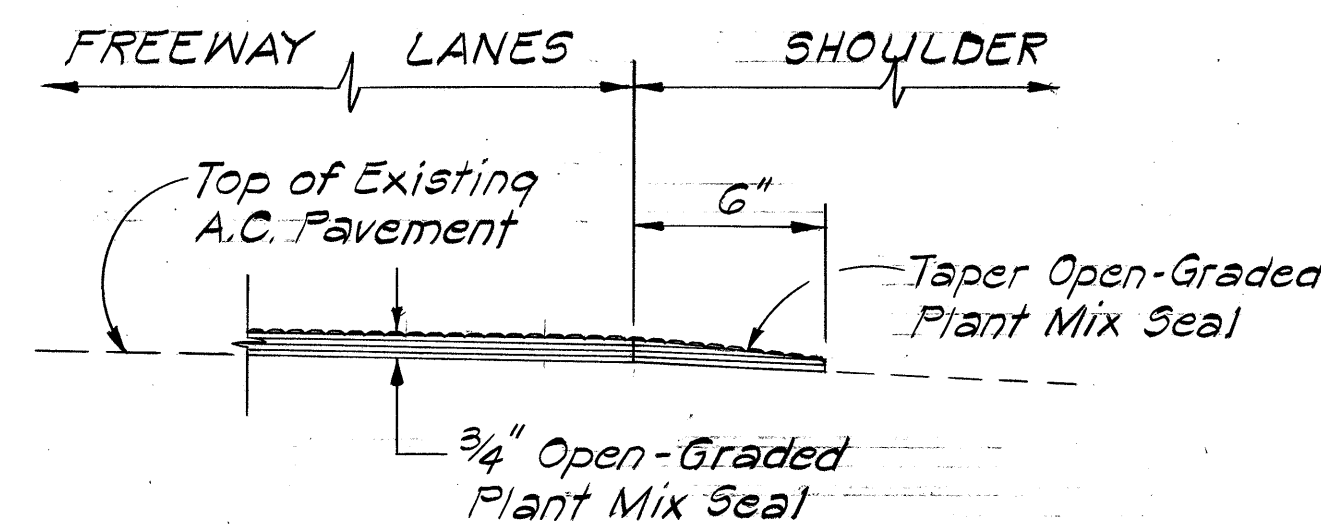


DETAIL 'A'
Scale: 2" = 1'-0"

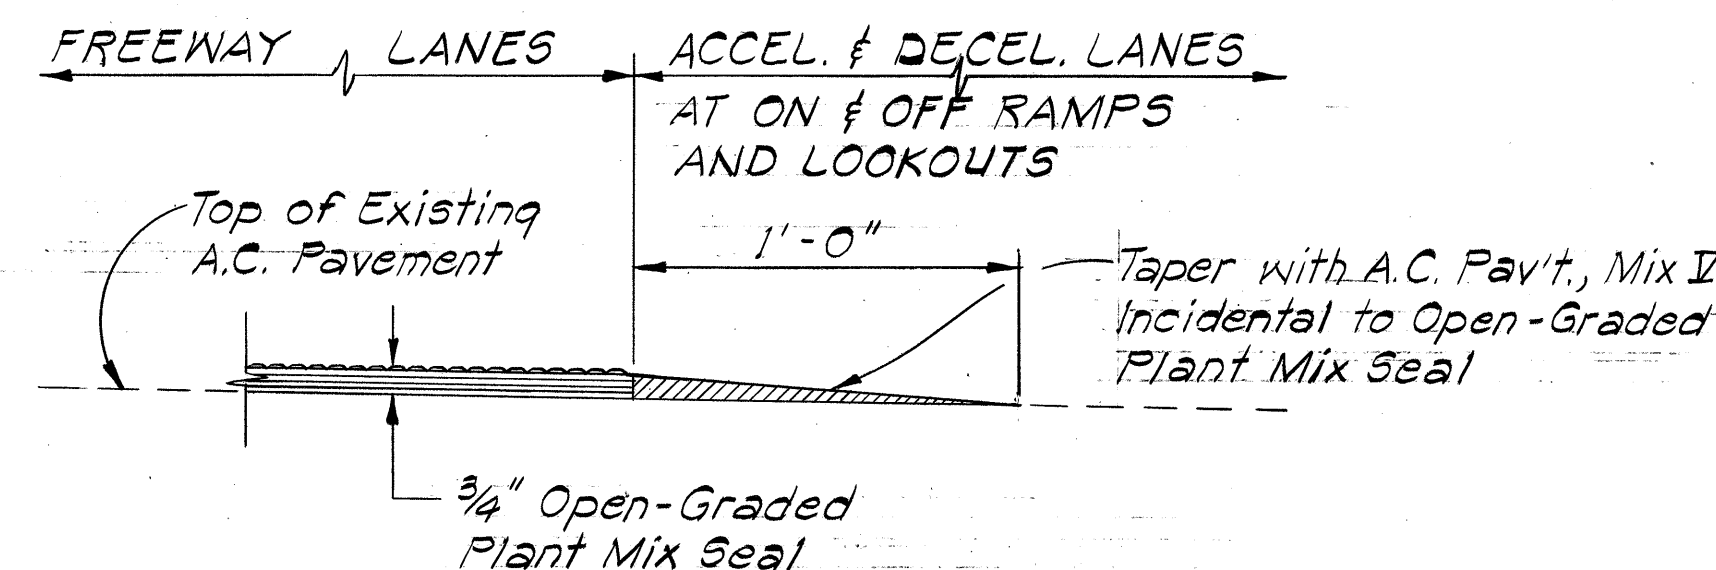


DETAIL 'B'
Scale: 2" = 1'-0"

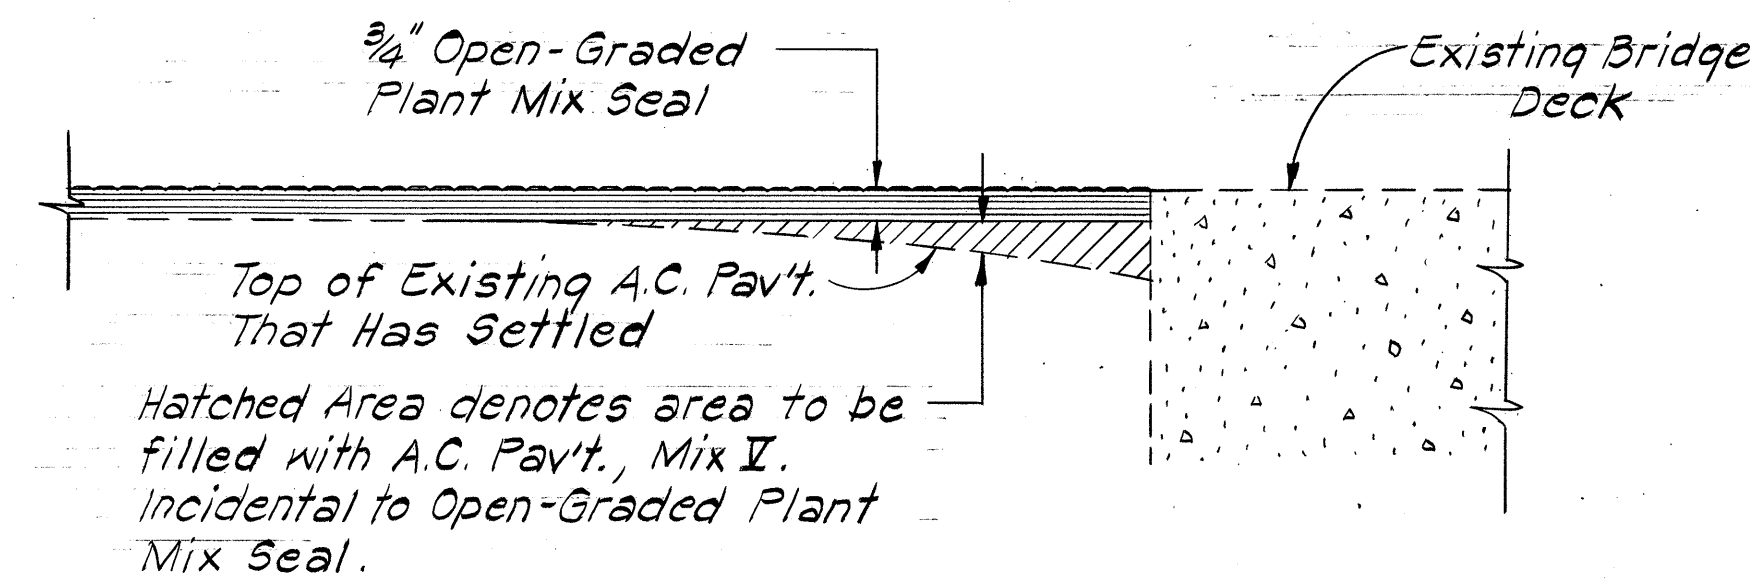

TYPICAL DETAIL FOR TREATMENT
AT EDGE OF EXISTING BRIDGE DECKS
WHERE EXISTING PAVEMENT HAS SETTLED
Not To Scale

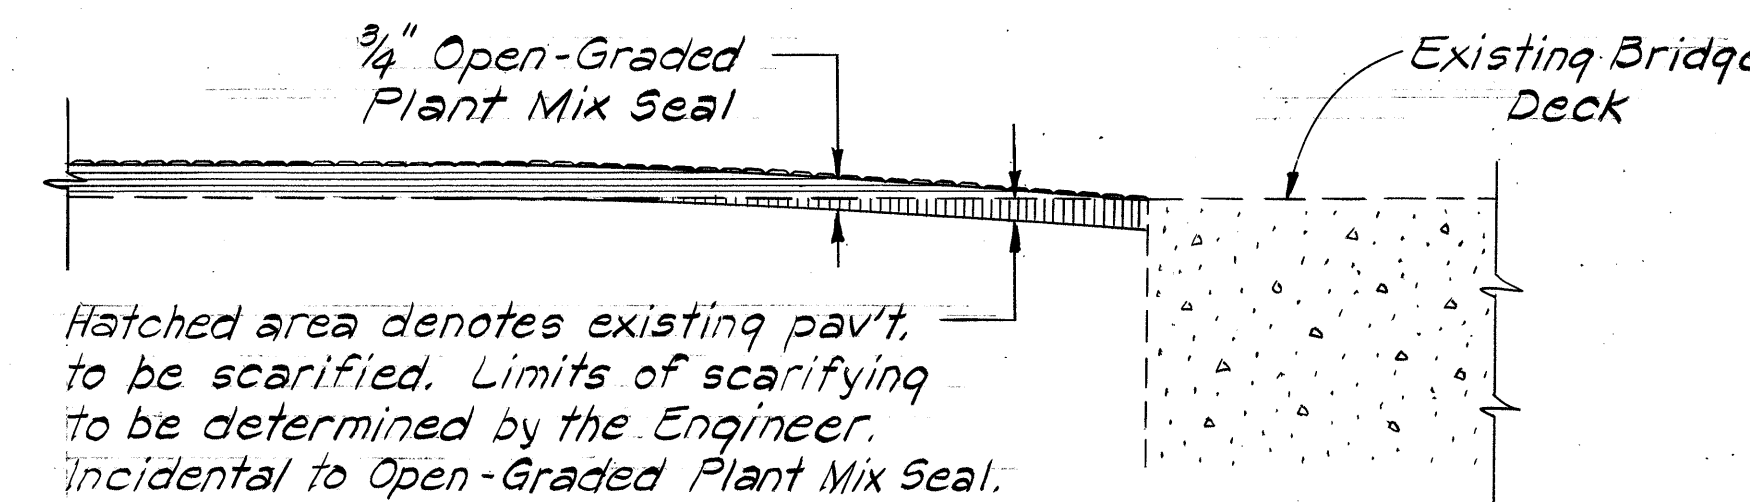

TYPICAL DETAIL FOR TREATMENT
AT EDGE OF EXISTING BRIDGE DECK
WHERE EXISTING PAVEMENT HAS NOT SETTLED
Not To Scale

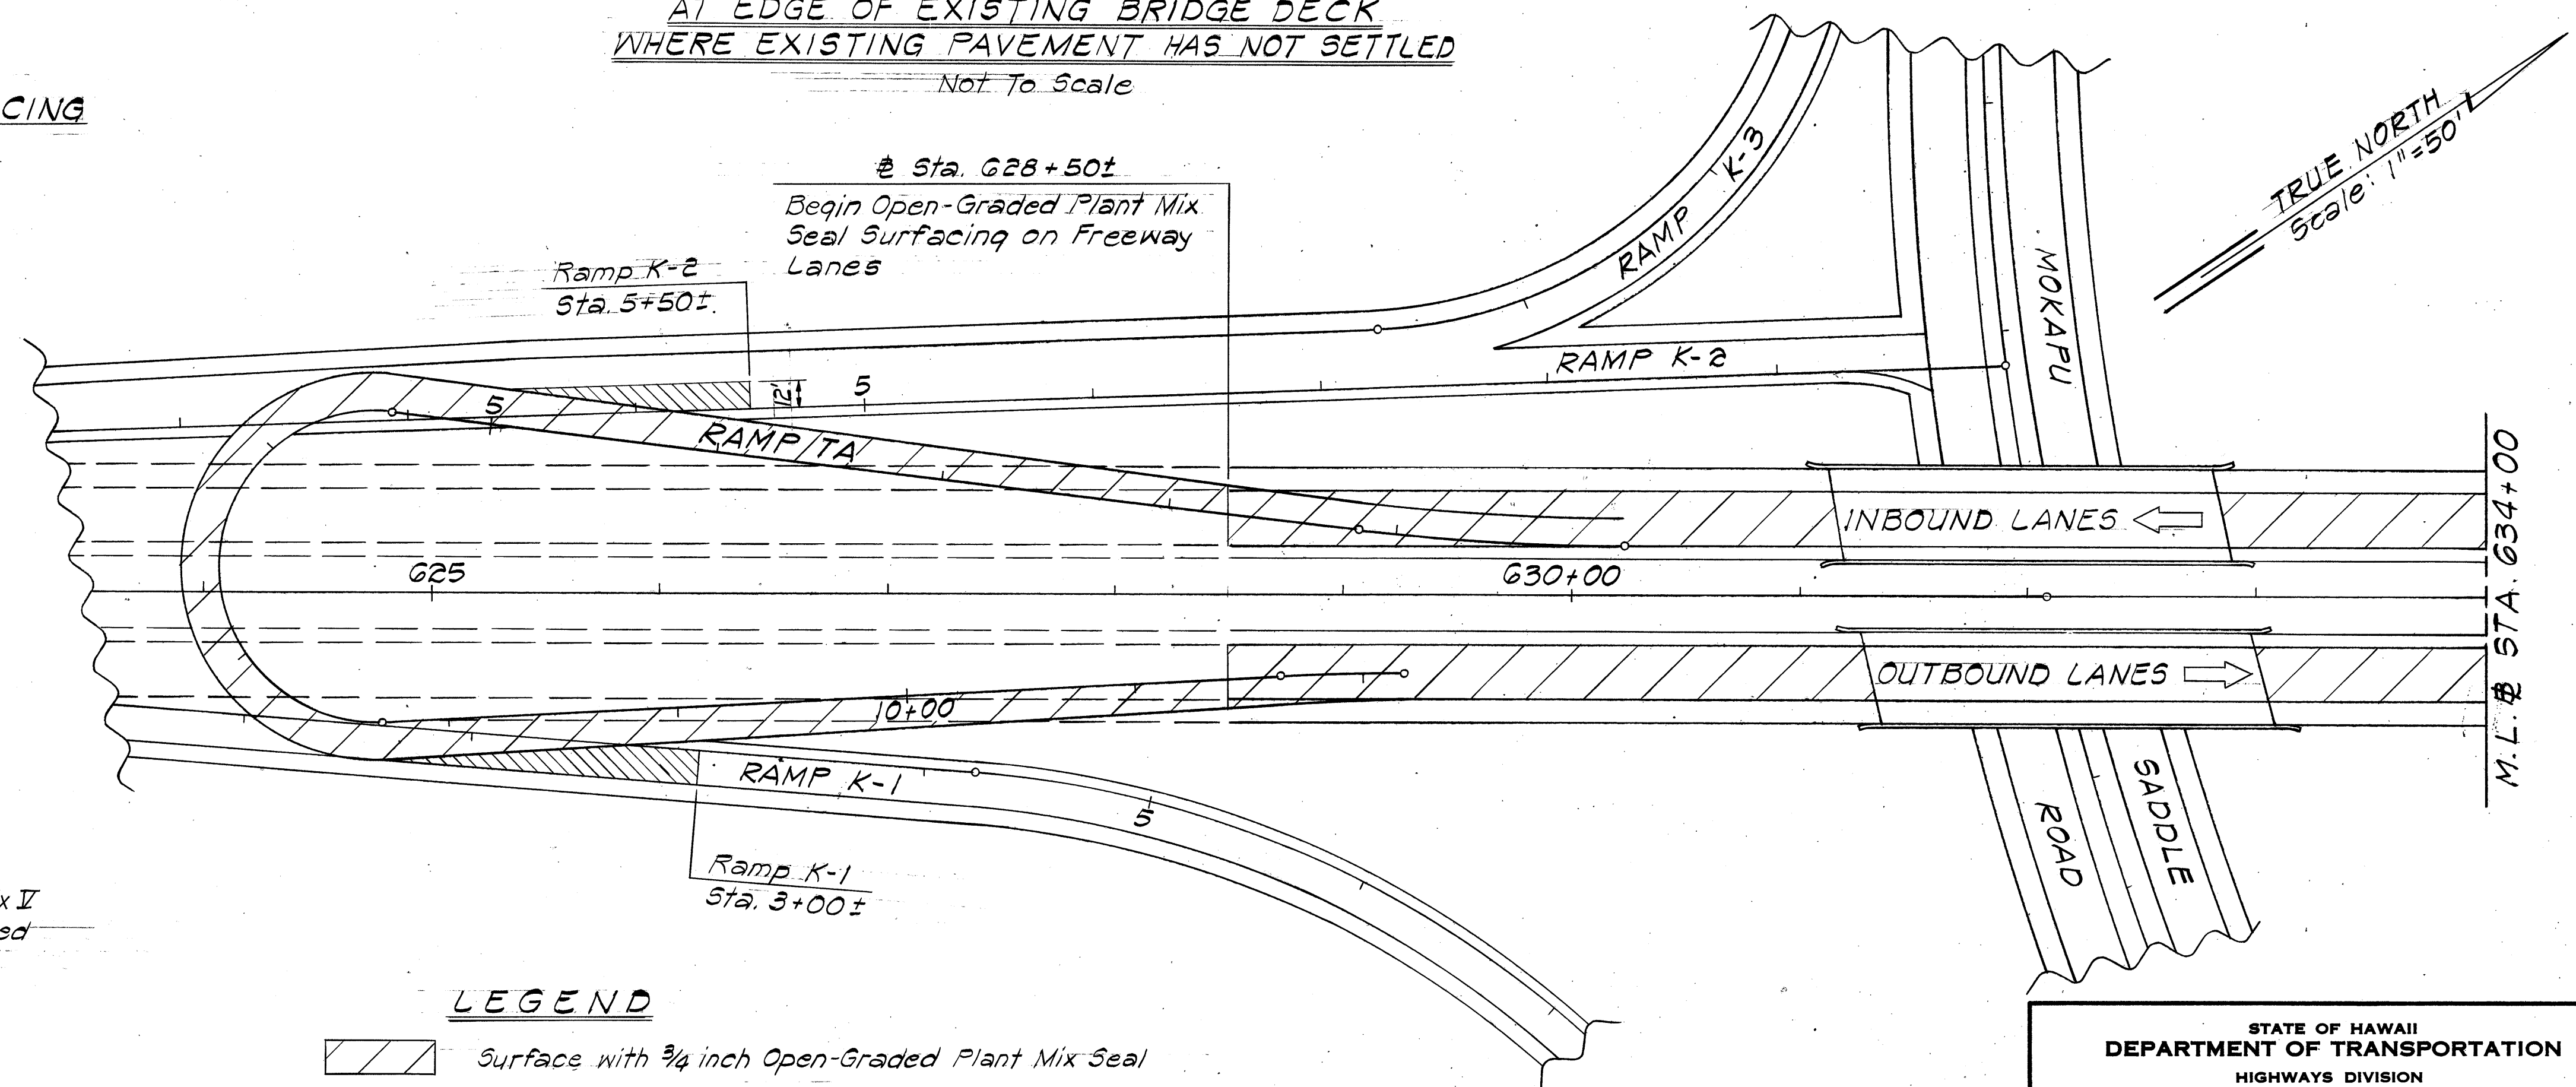

LEGEND

- Surface with 3/4 inch Open-Graded Plant Mix Seal
- Transition Area - Surface with A.C. Pavement Mix II to make a smooth riding connection to Ramp TA

STATE OF HAWAII
DEPARTMENT OF TRANSPORTATION
HIGHWAYS DIVISION

**TYPICAL SECTIONS &
OPEN-GRADED PLANT
MIX SEAL SURFACING**


INTERSTATE ROUTE H-3
TEMPORARY CONNECTION AT KAILUA I.C.
F.A.I. PROJ. NO. I-H3-1(28)13

Scale: As Shown Date: Nov. 1976


SHEET No. 2 OF 4 SHEETS

FED. ROAD DIST. NO.	STATE	FED. AID PROJ. NO.	FISCAL YEAR	SHEET NO.	TOTAL SHEETS
HAWAII	HAW.	I-H3-1(28):13	1977	10	55


TRUE NORTH
Scale: 1"=50'

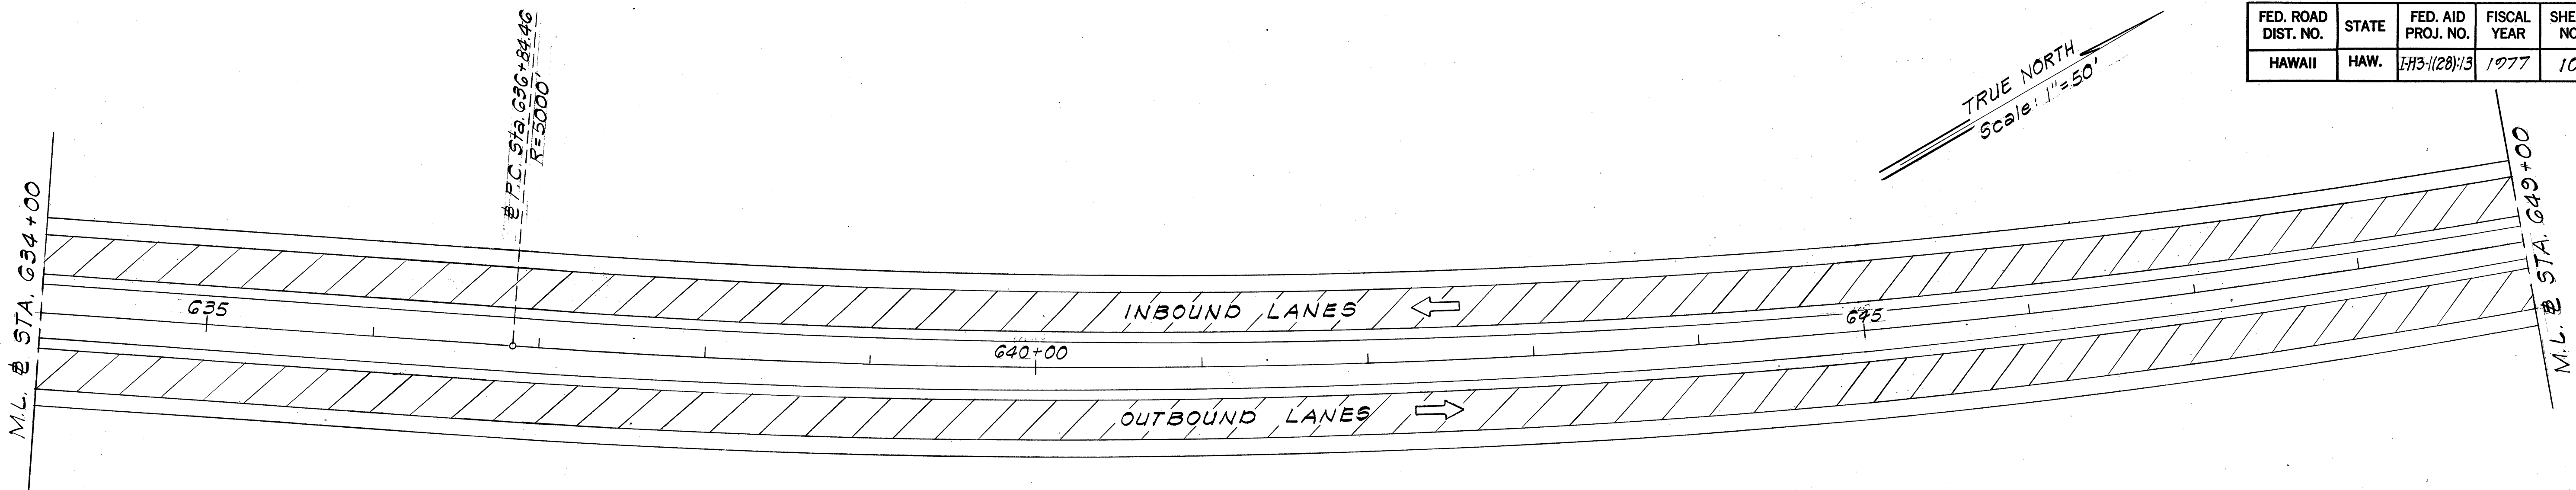

TRUE NORTH
Scale: 1"=50'

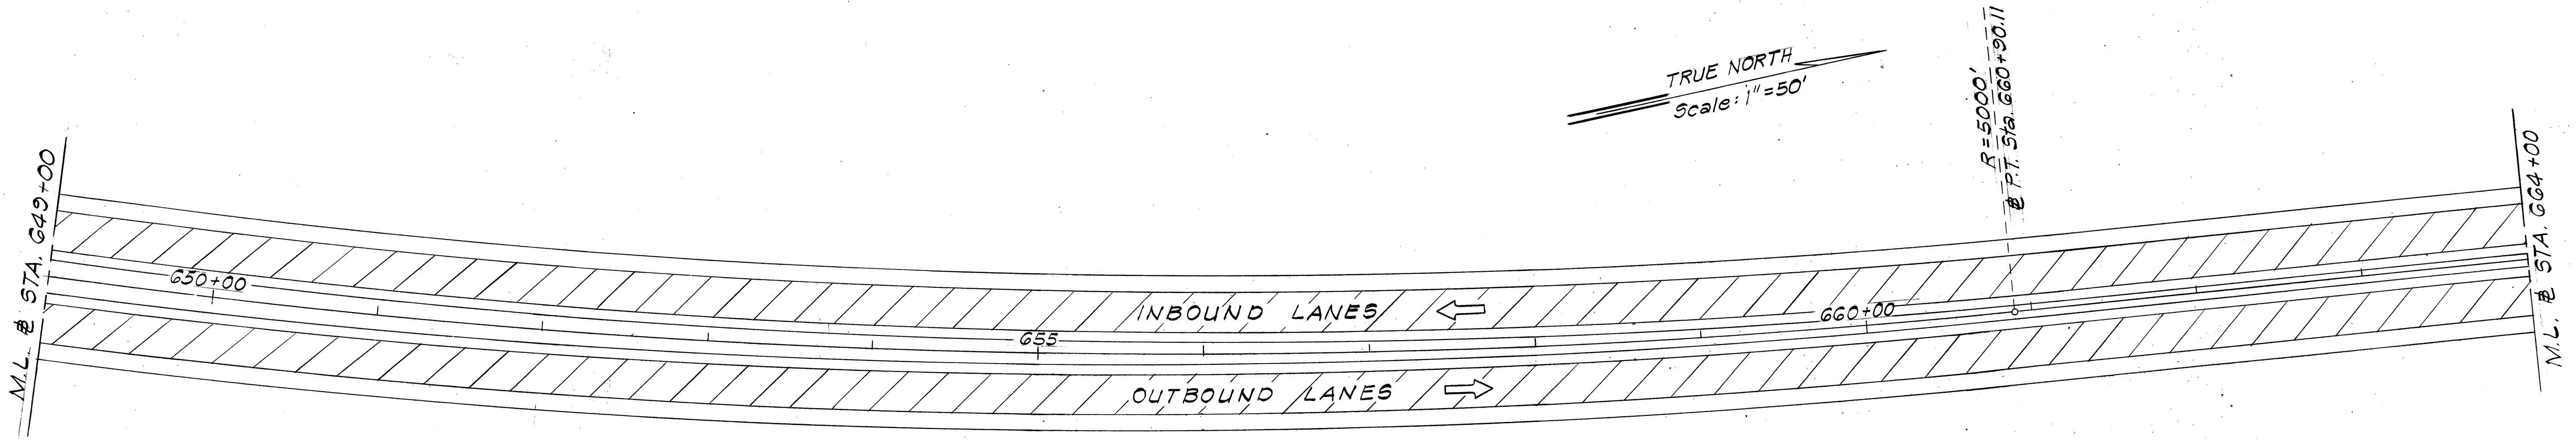

TRUE NORTH
Scale: 1"=50'

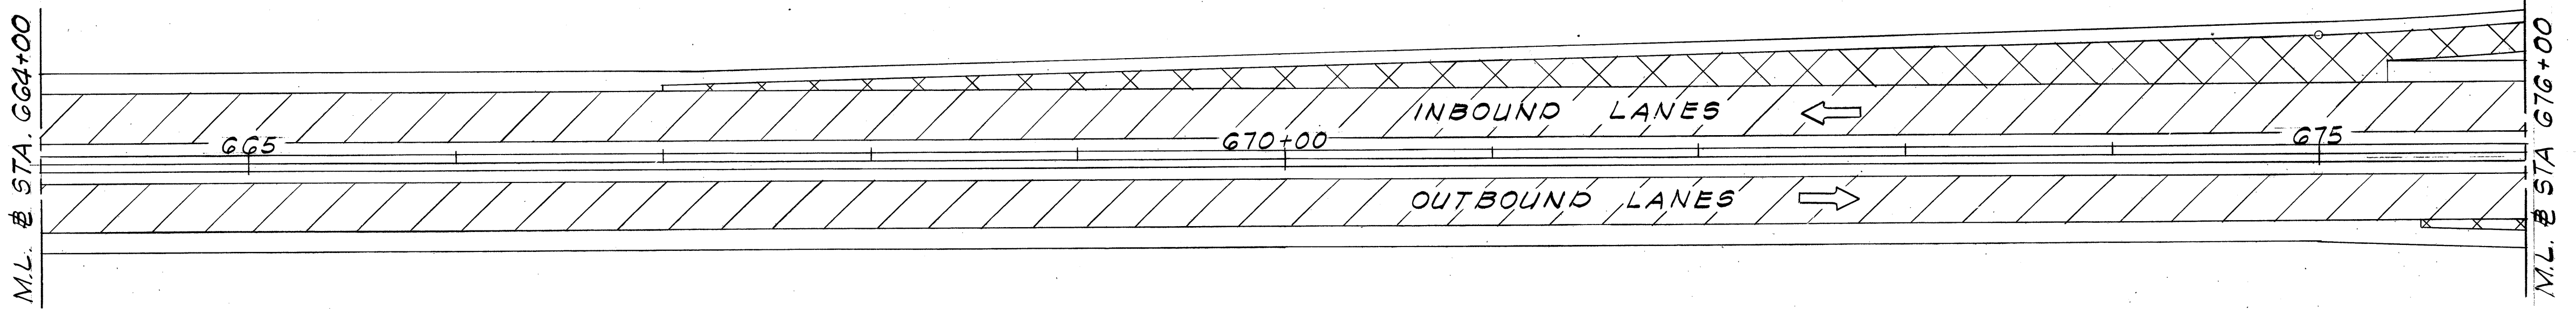


2/9/77	Additional Open-Graded Plant Mix Surfacing on Acceleration and Deceleration Lanes.
DATE	REVISION
STATE OF HAWAII DEPARTMENT OF TRANSPORTATION HIGHWAYS DIVISION OPEN-GRADED PLANT MIX SEAL SURFACING INTERSTATE ROUTE H-3 TEMPORARY CONNECTION AT KAILUA I.C. F.A.I. PROJ. NO. I-H3-1(28):13 Scale: 1"=50' Date: Nov. 1976 SHEET No. 2 OF 4 SHEETS	

C.O.10

ORIGINAL SURVEY PLOTTED BY	DATE
DRAWN BY	"
TRACED BY	"
DESIGNED BY	"
NOTED BY	"
CHECKED BY	"
No.	

FED. ROAD DIST. NO.	STATE	FED. AID PROJ. NO.	FISCAL YEAR	SHEET NO.	TOTAL SHEETS
HAWAII	HAW.	I-H3-1(28)13	1977	11	55

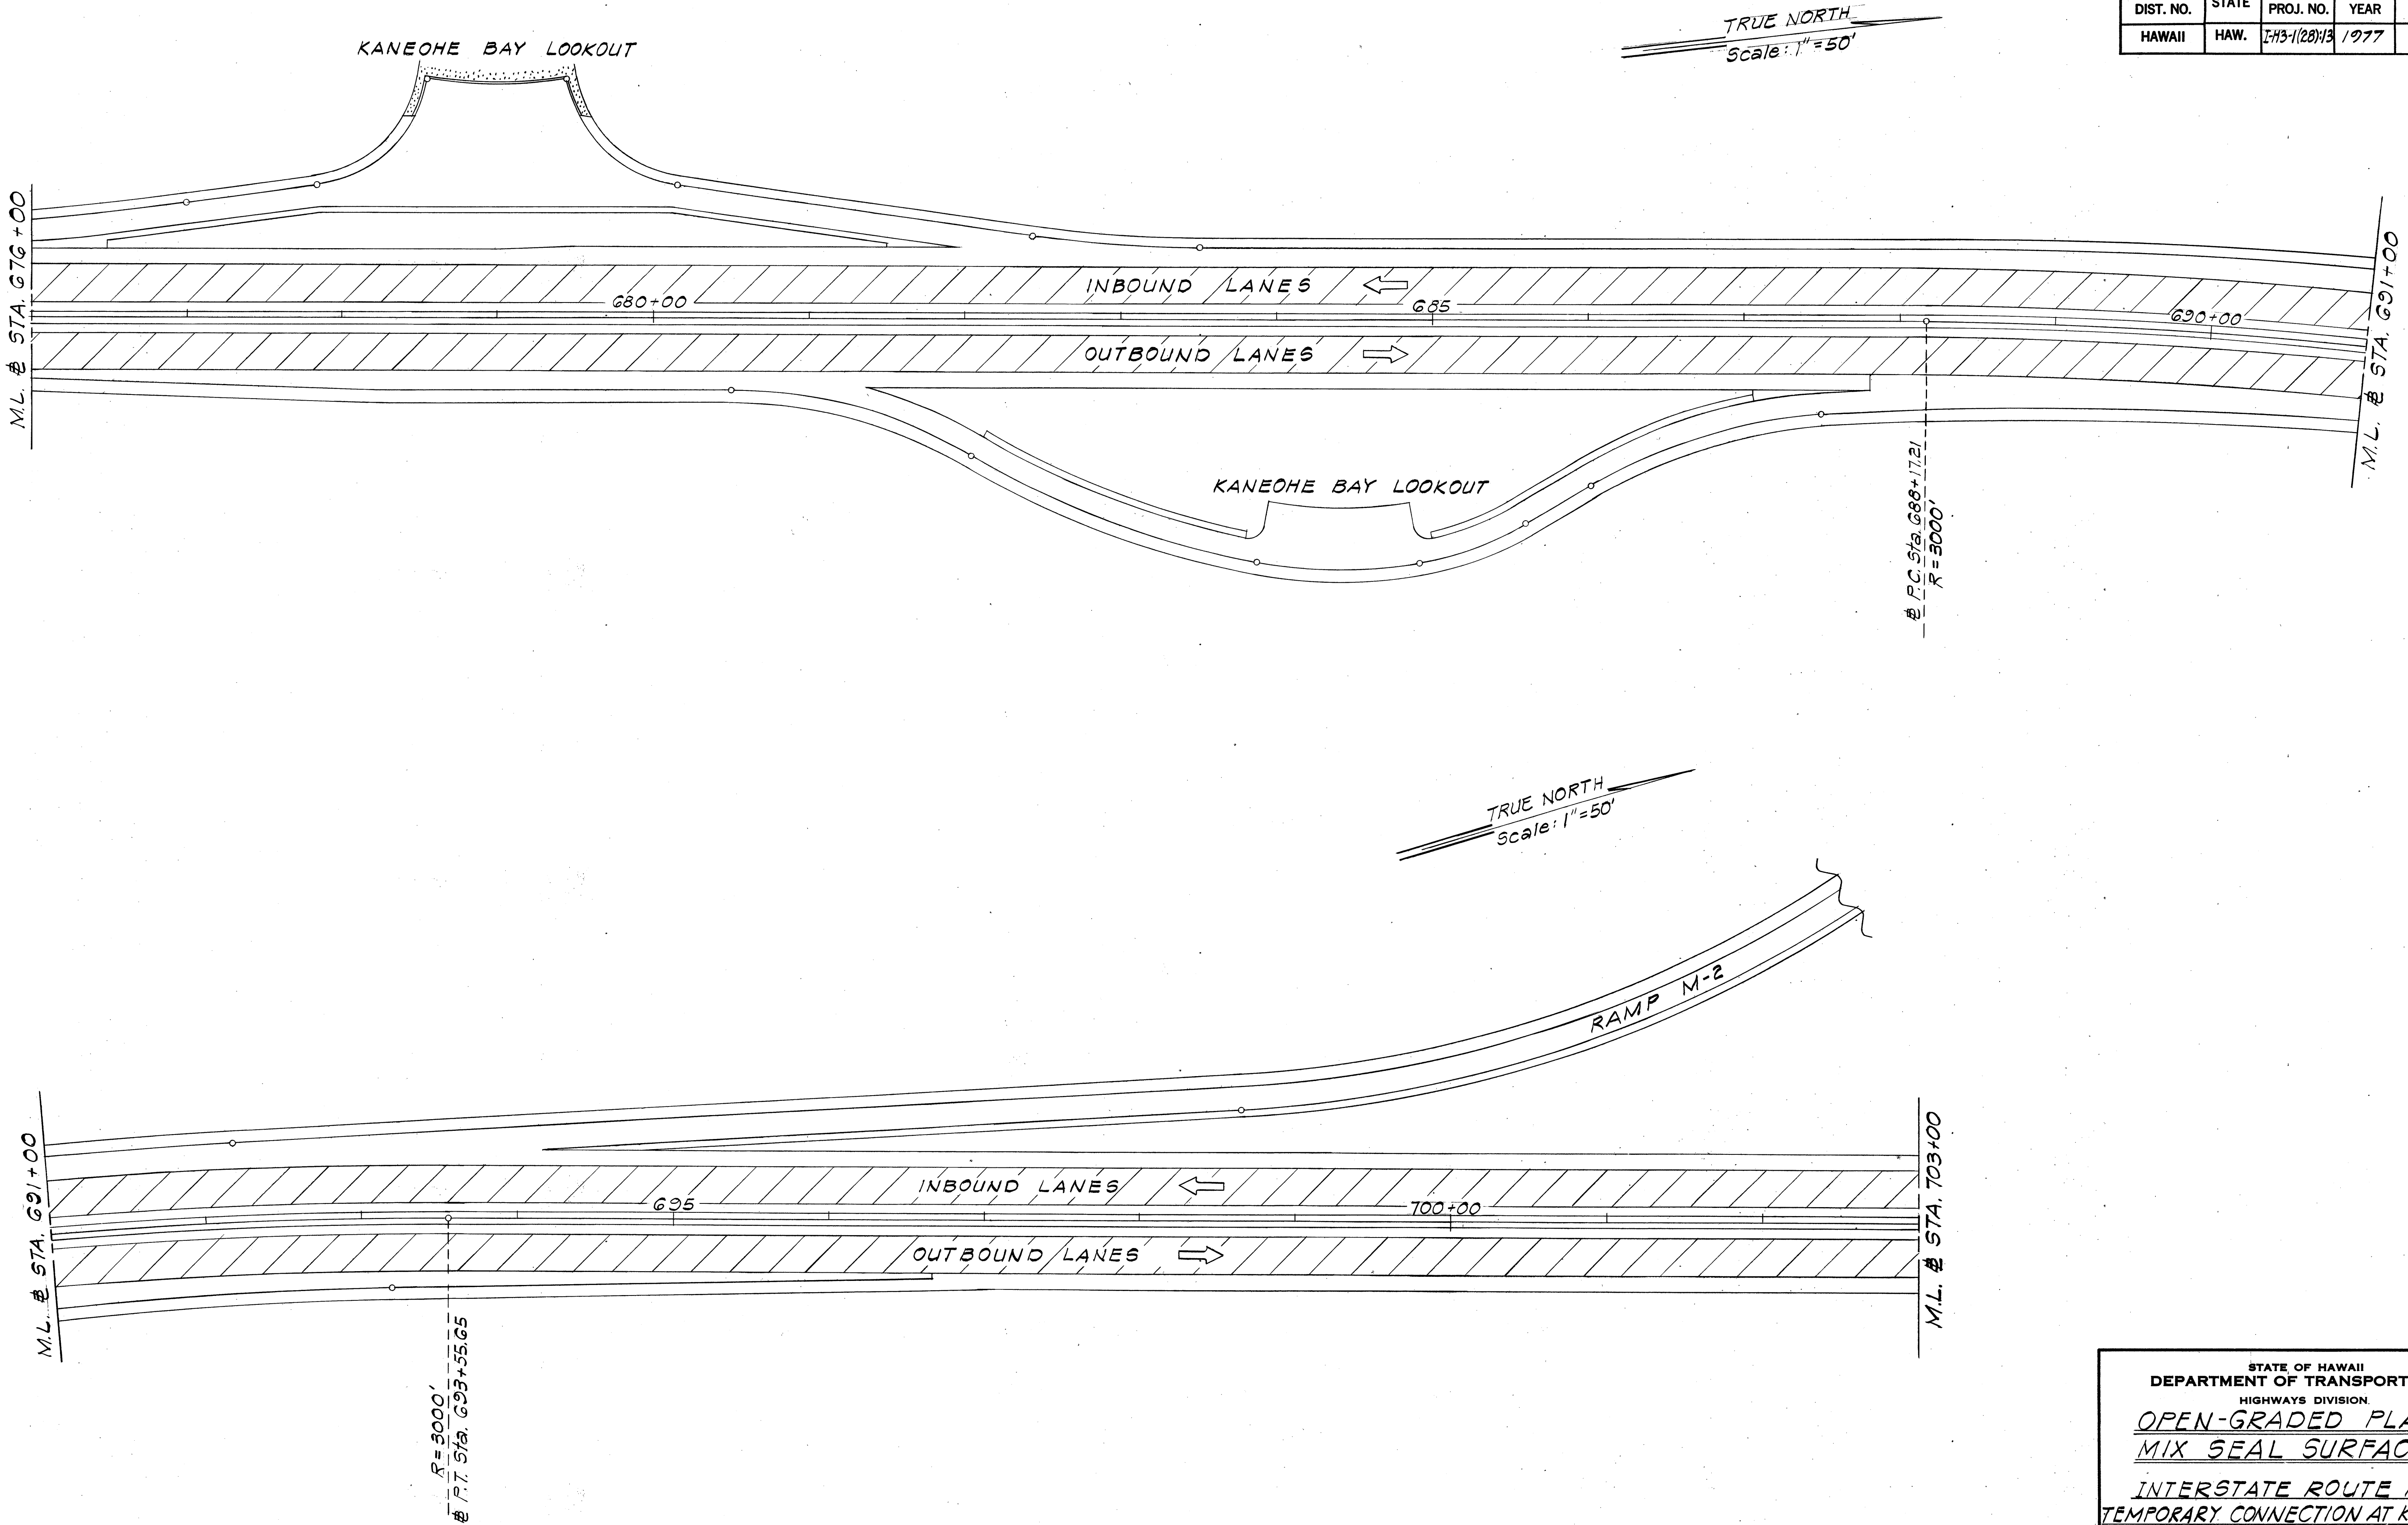


STATE OF HAWAII
DEPARTMENT OF TRANSPORTATION
HIGHWAYS DIVISION
**OPEN-GRADED PLANT
MIX SEAL SURFACING**
INTERSTATE ROUTE H-3
TEMPORARY CONNECTION AT KAILUA I.C.
F.A.I. PROJ. NO. I-H3-1(28)13
Scale: 1"=50' Date: Nov. 1976
SHEET No. 3 OF 4 SHEETS

ORIGINAL PLAN	SURVEY PLOTTED BY	DATE
NOTE BOOK	DRAWN BY	" "
No.	TRACED BY	" "
	DESIGNED BY	" "
	QUANTITIES BY	" "
	CHECKED BY	" "

FED. ROAD DIST. NO.	STATE	FED. AID PROJ. NO.	FISCAL YEAR	SHEET NO.	TOTAL SHEETS
HAWAII	HAW.	I-H3-1(28):13	1977	12	55

~~Sta. 716+00 to Sta. 745+66±~~
~~Surfacing with Open-Graded Plant Mix Seal to be continued to Sta. 745+66± or as directed by the Engineer. At the end of the surfacing with Open-Graded Plant Mix Seal, a smooth transition with the existing pavement using A.C. Mix V shall be made as directed by the Engineer. No payment will be made for this transition and will be considered incidental to Open-Graded Plant Mix Seal.~~

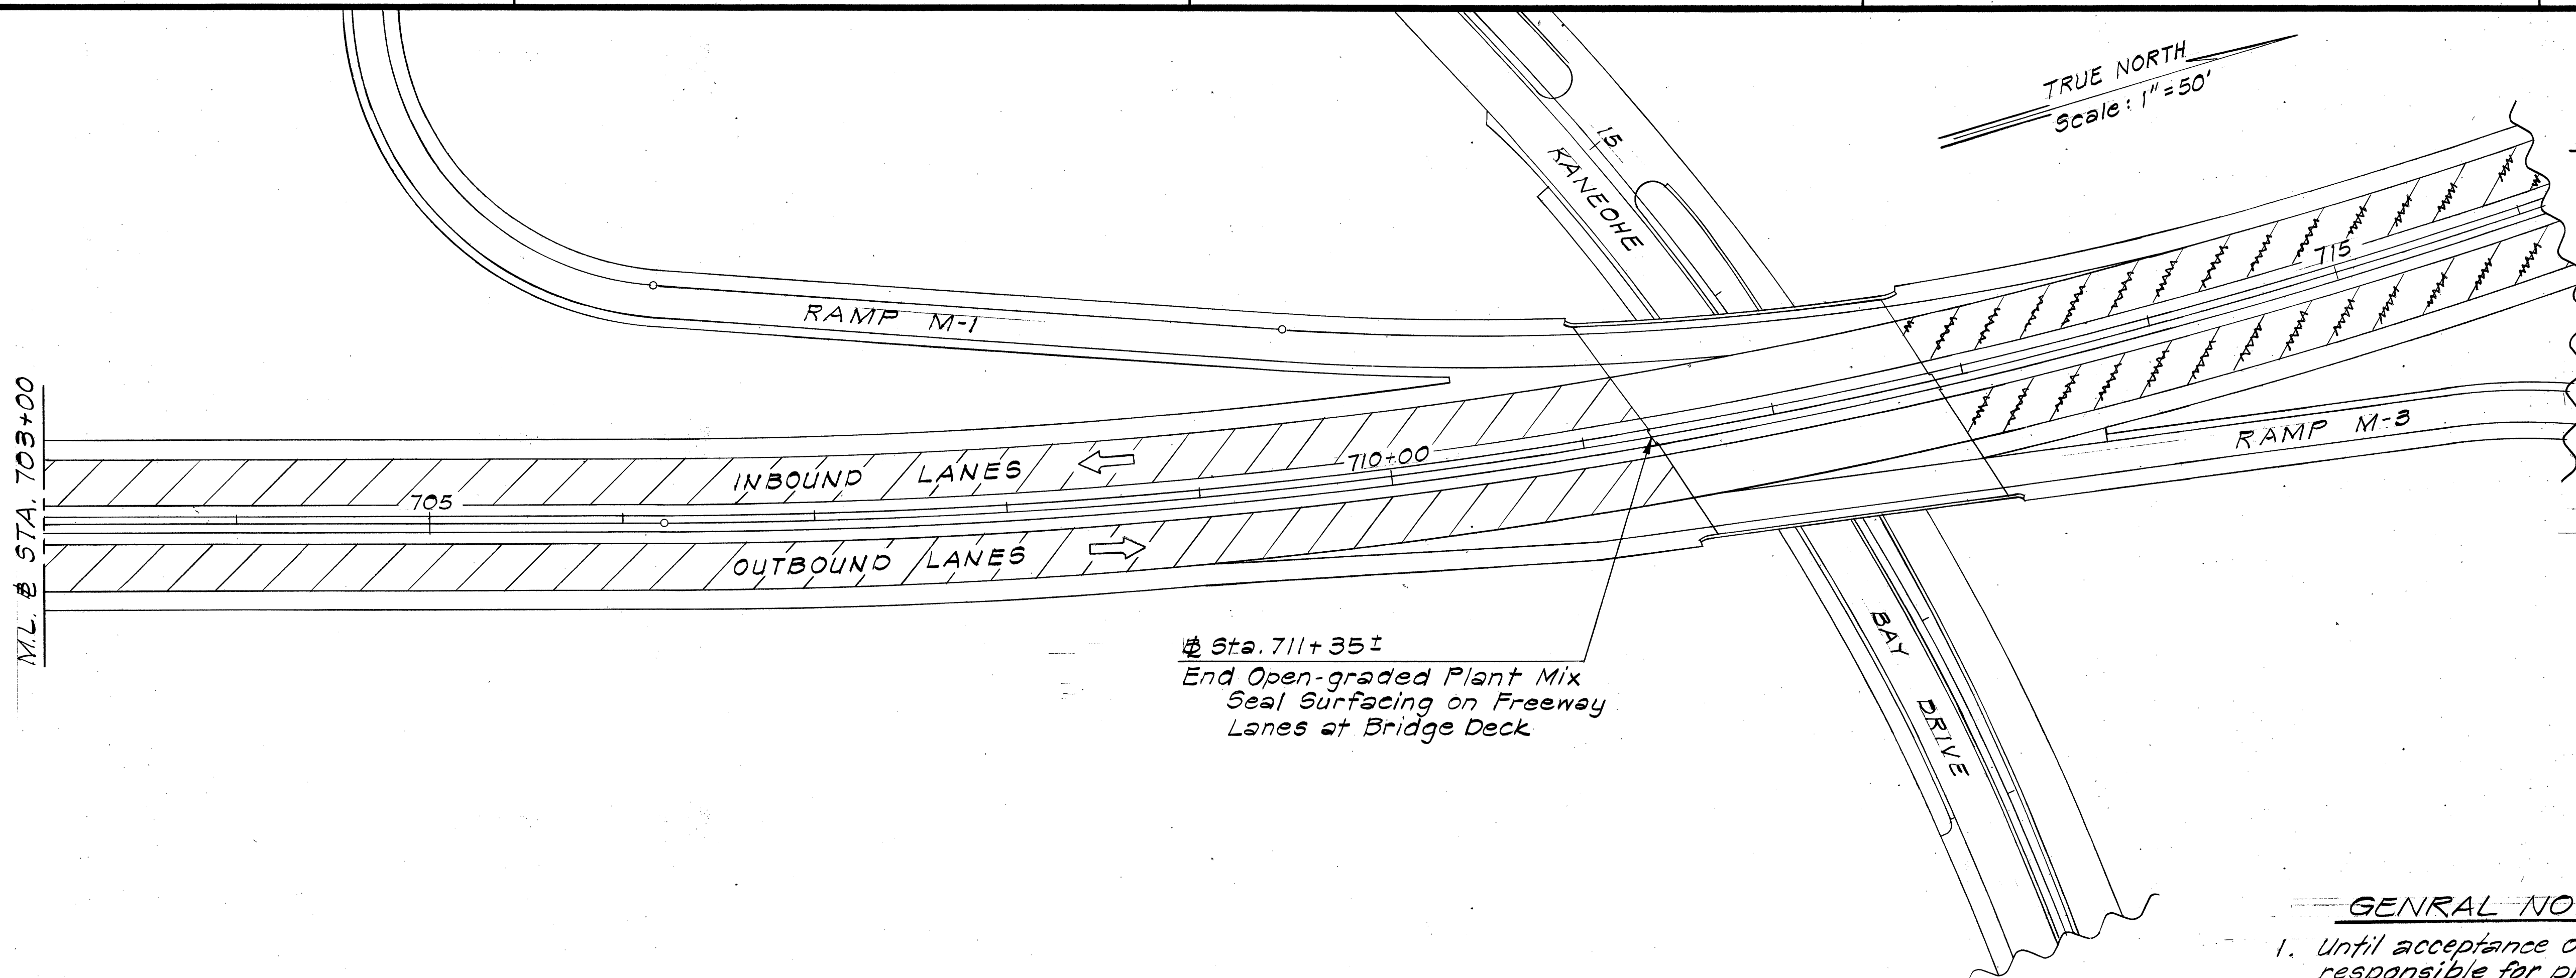

GENERAL NOTES FOR MOKAPU I.C.

1. Until acceptance of all work the Contractor shall be responsible for preventing the public from entering Ramps M-1, M-2, M-3 and M-4. This work shall be subject to the approval of the Engineer and will not be paid for separately, but will be considered incidental to various contract items.
2. Where possible, materials from the existing fence across Ramps M-1 and M-2 shall be salvaged and used at Sta. 622+00.
3. Replacement of Metal Bridge Railings and appurtenances, where missing at Mokapu Interchange or as directed by the Engineer, will be paid for under Metal Bridge Railings. For Metal Bridge Railings Details, see sheet No. 8.

ORIGINAL PLAN	SURVEY PLOTTED BY	DATE
NOTE BOOK	DRAWN BY	" "
No.	DESIGNED BY	" "
	QUANTITIES BY	" "
	CHECKED BY	" "

STATE OF HAWAII
DEPARTMENT OF TRANSPORTATION
HIGHWAYS DIVISION
**OPEN-GRADED PLANT
MIX SEAL SURFACING**
INTERSTATE ROUTE H-3
TEMPORARY CONNECTION AT KAILUA I.C.
F.A.I. PROJ. NO. I-H3-1(28):13
Scale: 1"=50' Date: Nov. 1976
SHEET No. 4 OF 4 SHEETS