


| INDEX TO DRAWINGS |                                                                                       |
|-------------------|---------------------------------------------------------------------------------------|
| SHEET NO          | DESCRIPTION                                                                           |
| II                | TITLE SHEET                                                                           |
| 2-3               | PLAN & TYPICAL SECTIONS FOR TEMPORARY CONNECTION                                      |
| 4-8               | MISC. & STANDARD ROADWAY DETAILS                                                      |
| 9-12              | OPEN-GRADED PLANT MIX SEAL SURFACING PLANS                                            |
| 13-20             | HIGHWAY LIGHTING SYSTEM PLANS & DETAILS                                               |
| **21-55           | TRAFFIC SIGNS, PAVEMENT MARKINGS, BARRICADES & HEADLIGHT GLARE SCREEN PLANS & DETAILS |
|                   |                                                                                       |
|                   |                                                                                       |
|                   |                                                                                       |

|          |                                                     |
|----------|-----------------------------------------------------|
| 12-21-76 | REVISED "INDEX TO DRAWINGS,"<br>PER ADDENDUM NO. 2. |
| DATE     | REVISION                                            |

STATE OF HAWAII  
DEPARTMENT OF TRANSPORTATION  
HIGHWAYS DIVISION  
HONOLULU, HAWAII  
"AS - BUILT"  
PLANS FOR  
CONSTRUCTION OF A PORTION OF  
INTERSTATE ROUTE H-3  
TEMPORARY CONNECTION AT KAILUA INTERCHANGE


ALL CHANGES MADE DURING CONSTRUCTION HAVE BEEN INCORPORATED ON THESE PLANS IN RED EXCEPT CHANGES IN THE ORIGINAL THEORETICAL QUANTITIES. FOR ACTUAL QUANTITIES REFER TO PROJECT LEDGER AND/OR COMPUTATION BOOK.

DISTRICT OF KOOLAUPOKO  
ISLAND OF OAHU

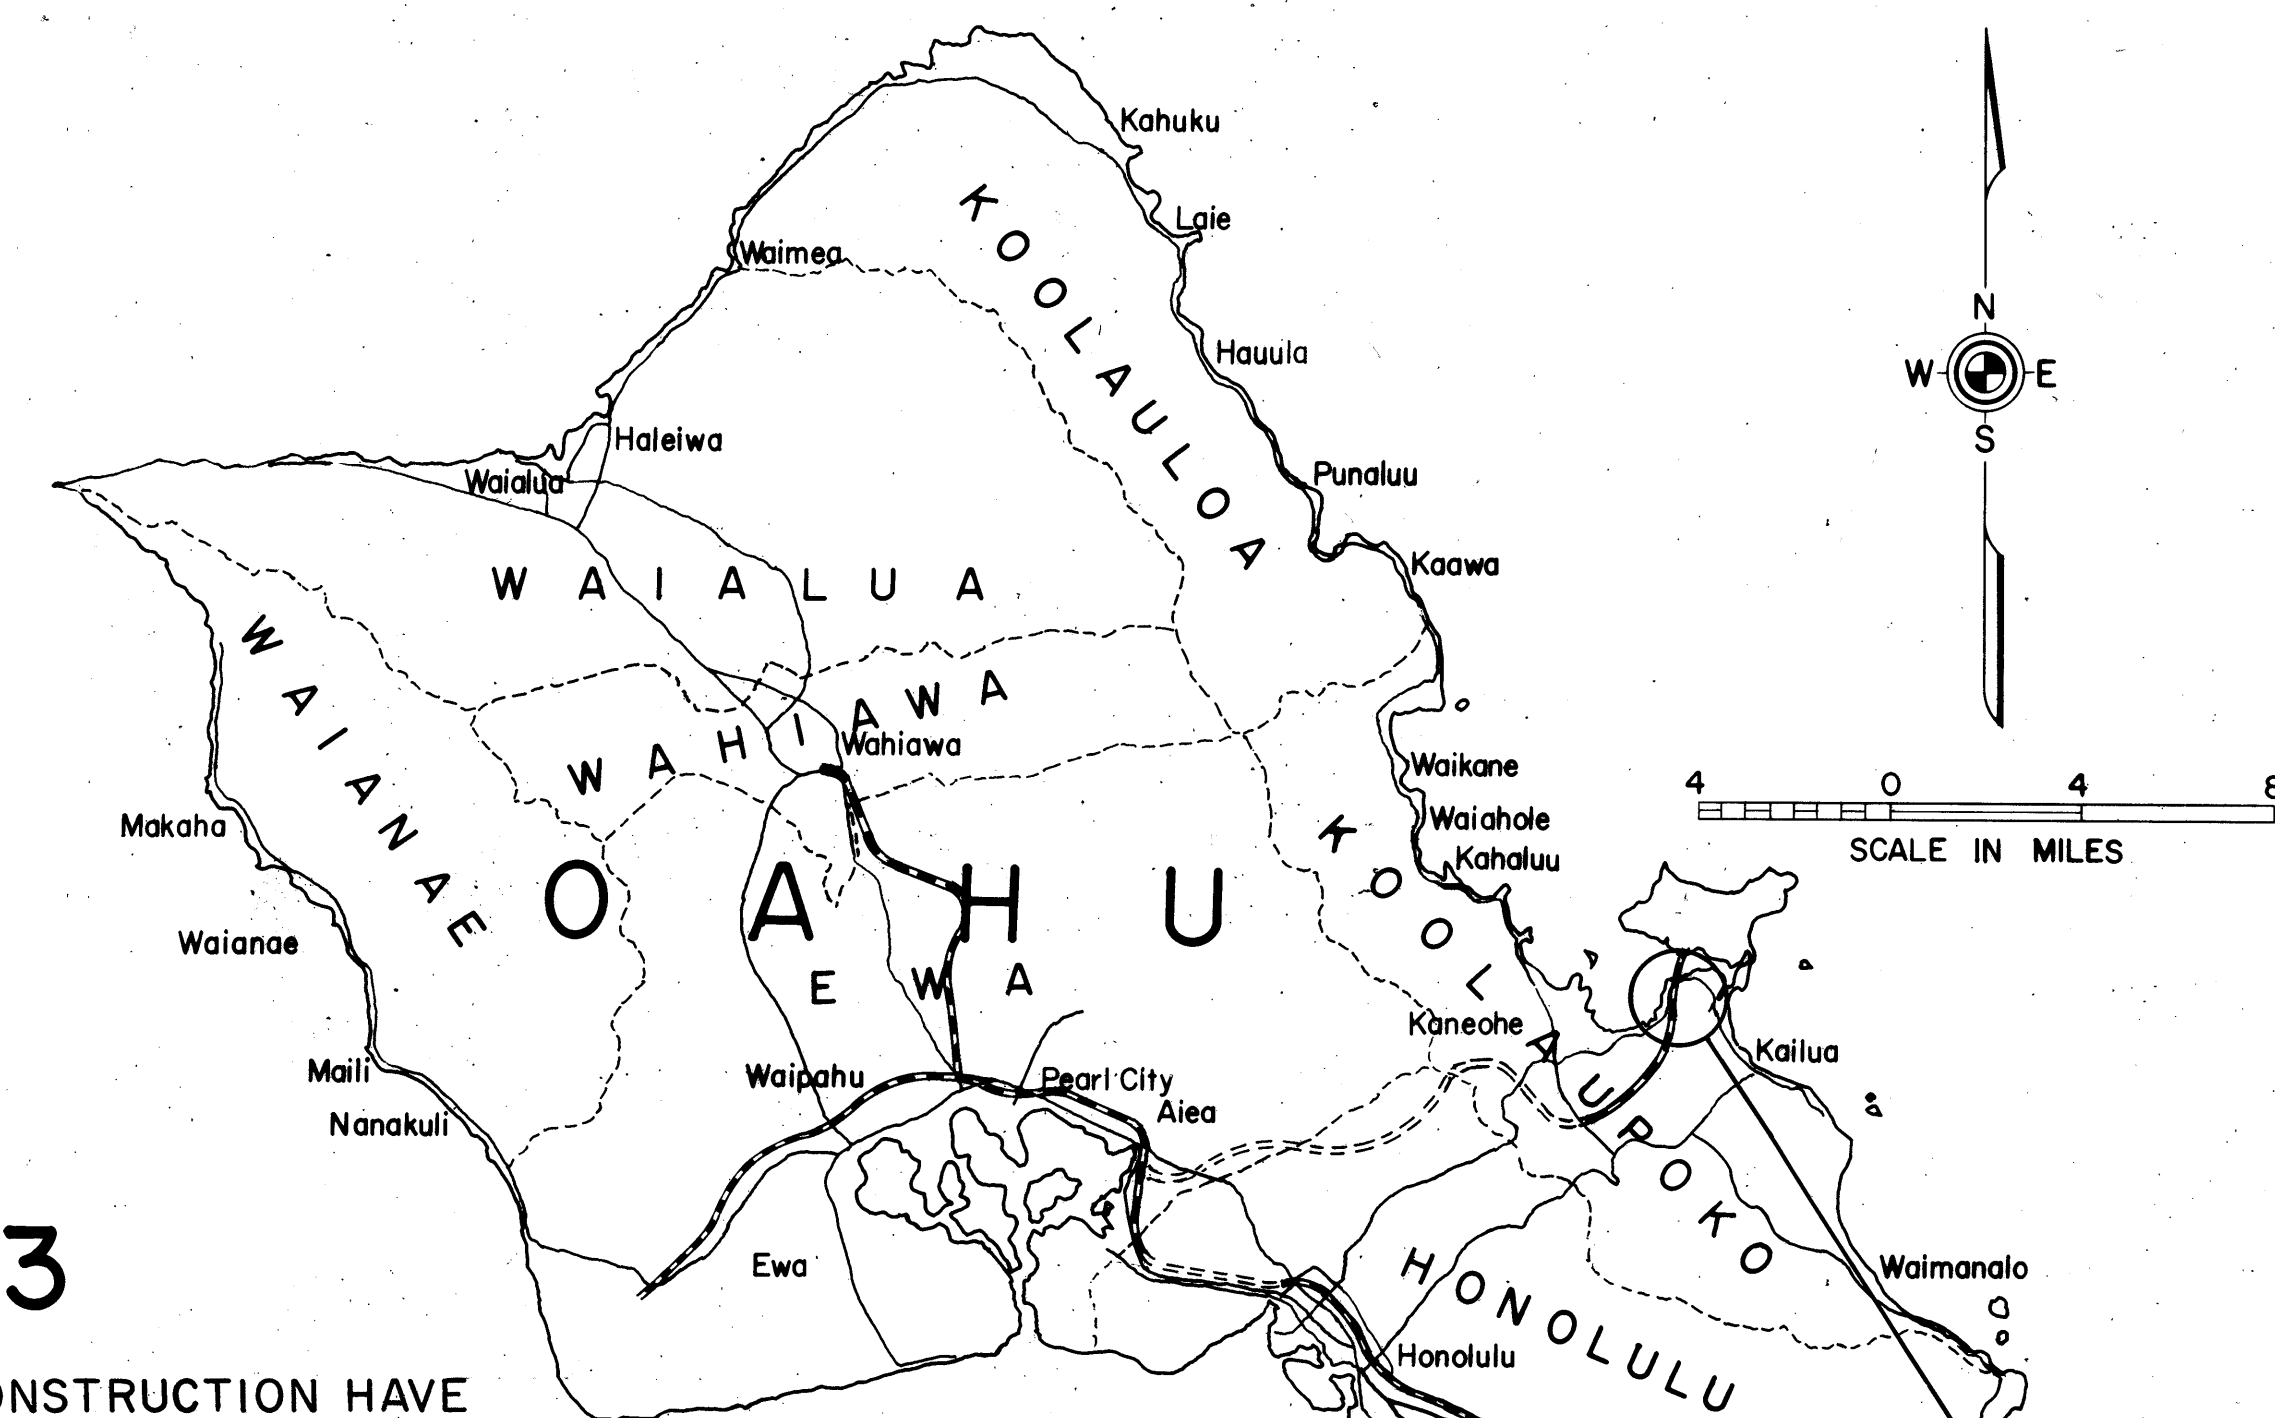

Merton L. Ishida  
PROJECT ENGINEER

 Federal Aid Interstate Projects Previously Constructed or Under Construction

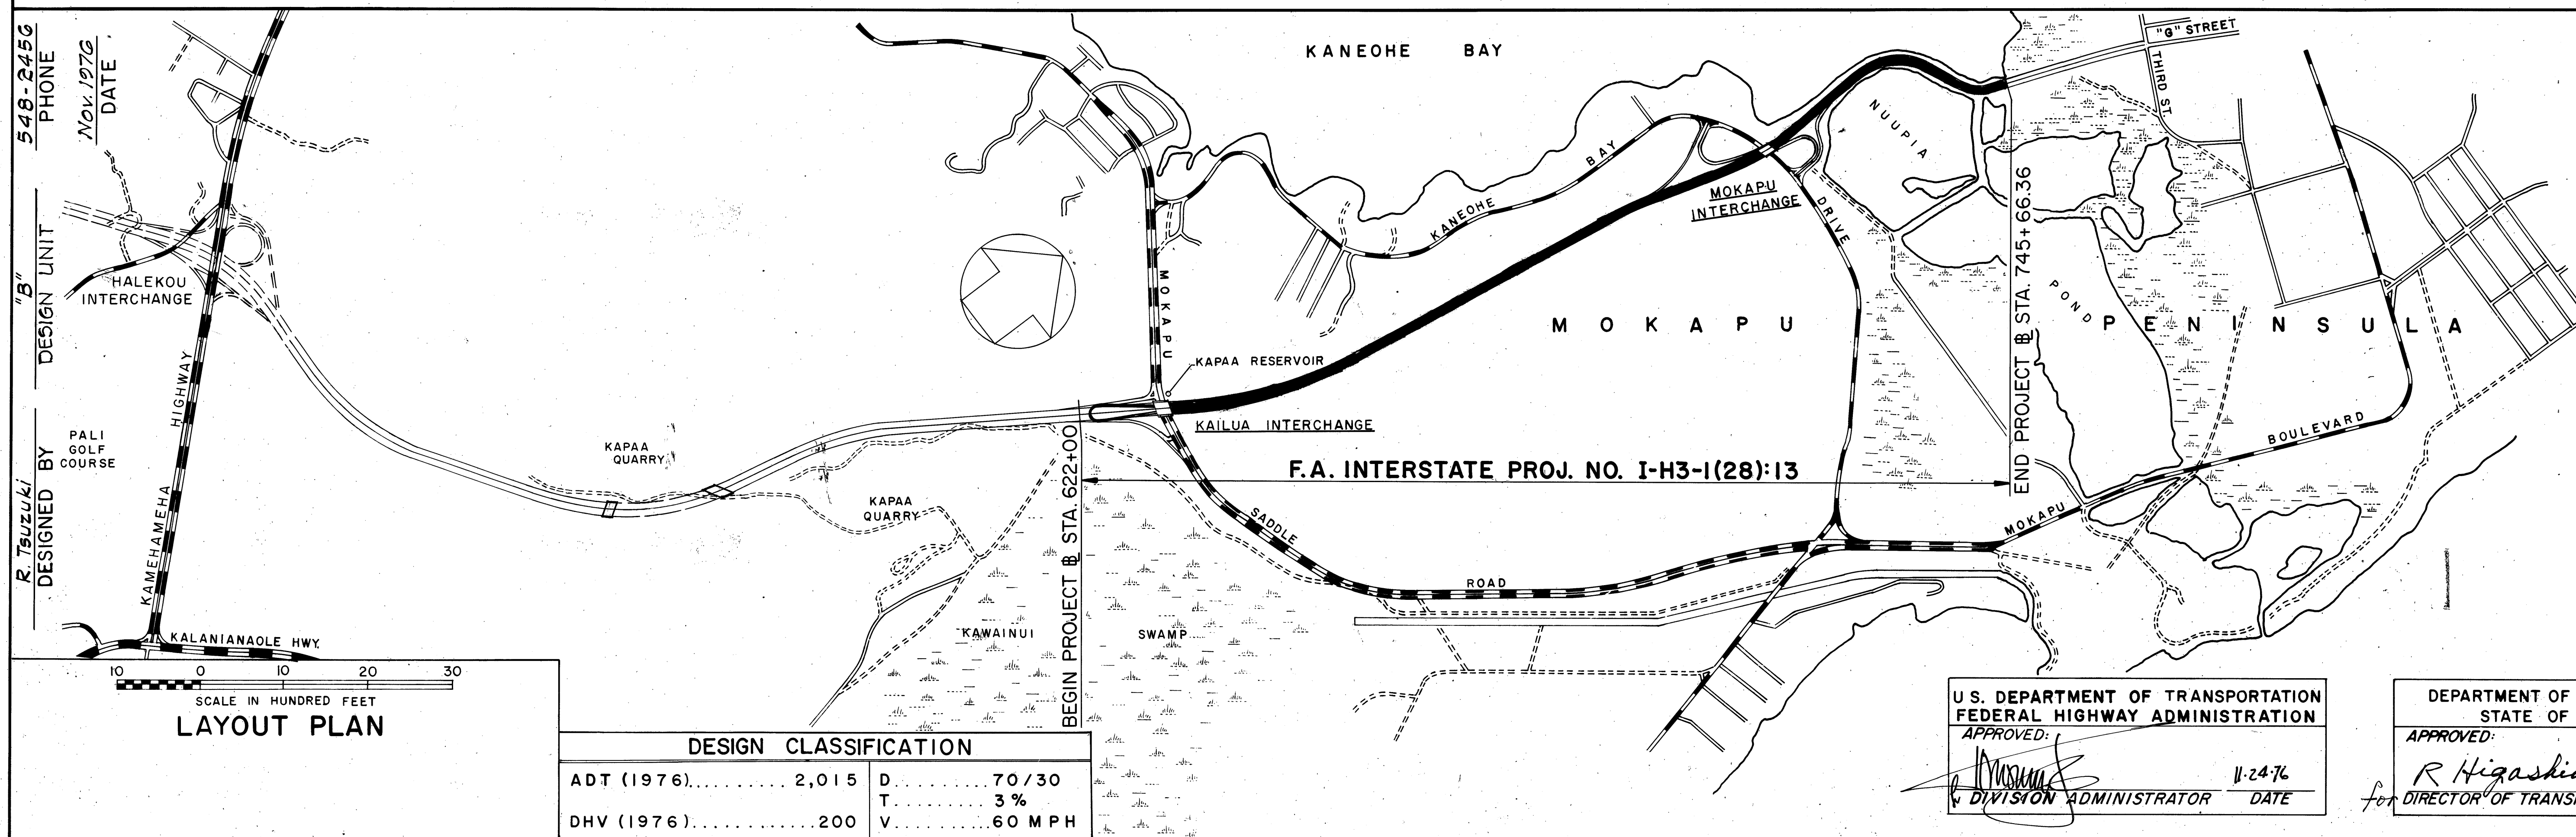

U.S. DEPARTMENT OF TRANSPORTATION  
FEDERAL HIGHWAY ADMINISTRATION

APPROVED: 

 DIVISION ADMINISTRATOR 11-24-76 DATE

|                                                                            |                  |
|----------------------------------------------------------------------------|------------------|
| DEPARTMENT OF TRANSPORTATION<br>STATE OF HAWAII                            |                  |
| APPROVED:<br><i>R Higashionna</i><br><i>for</i> DIRECTOR OF TRANSPORTATION | 11-23-70<br>DATE |

ADD. I R