

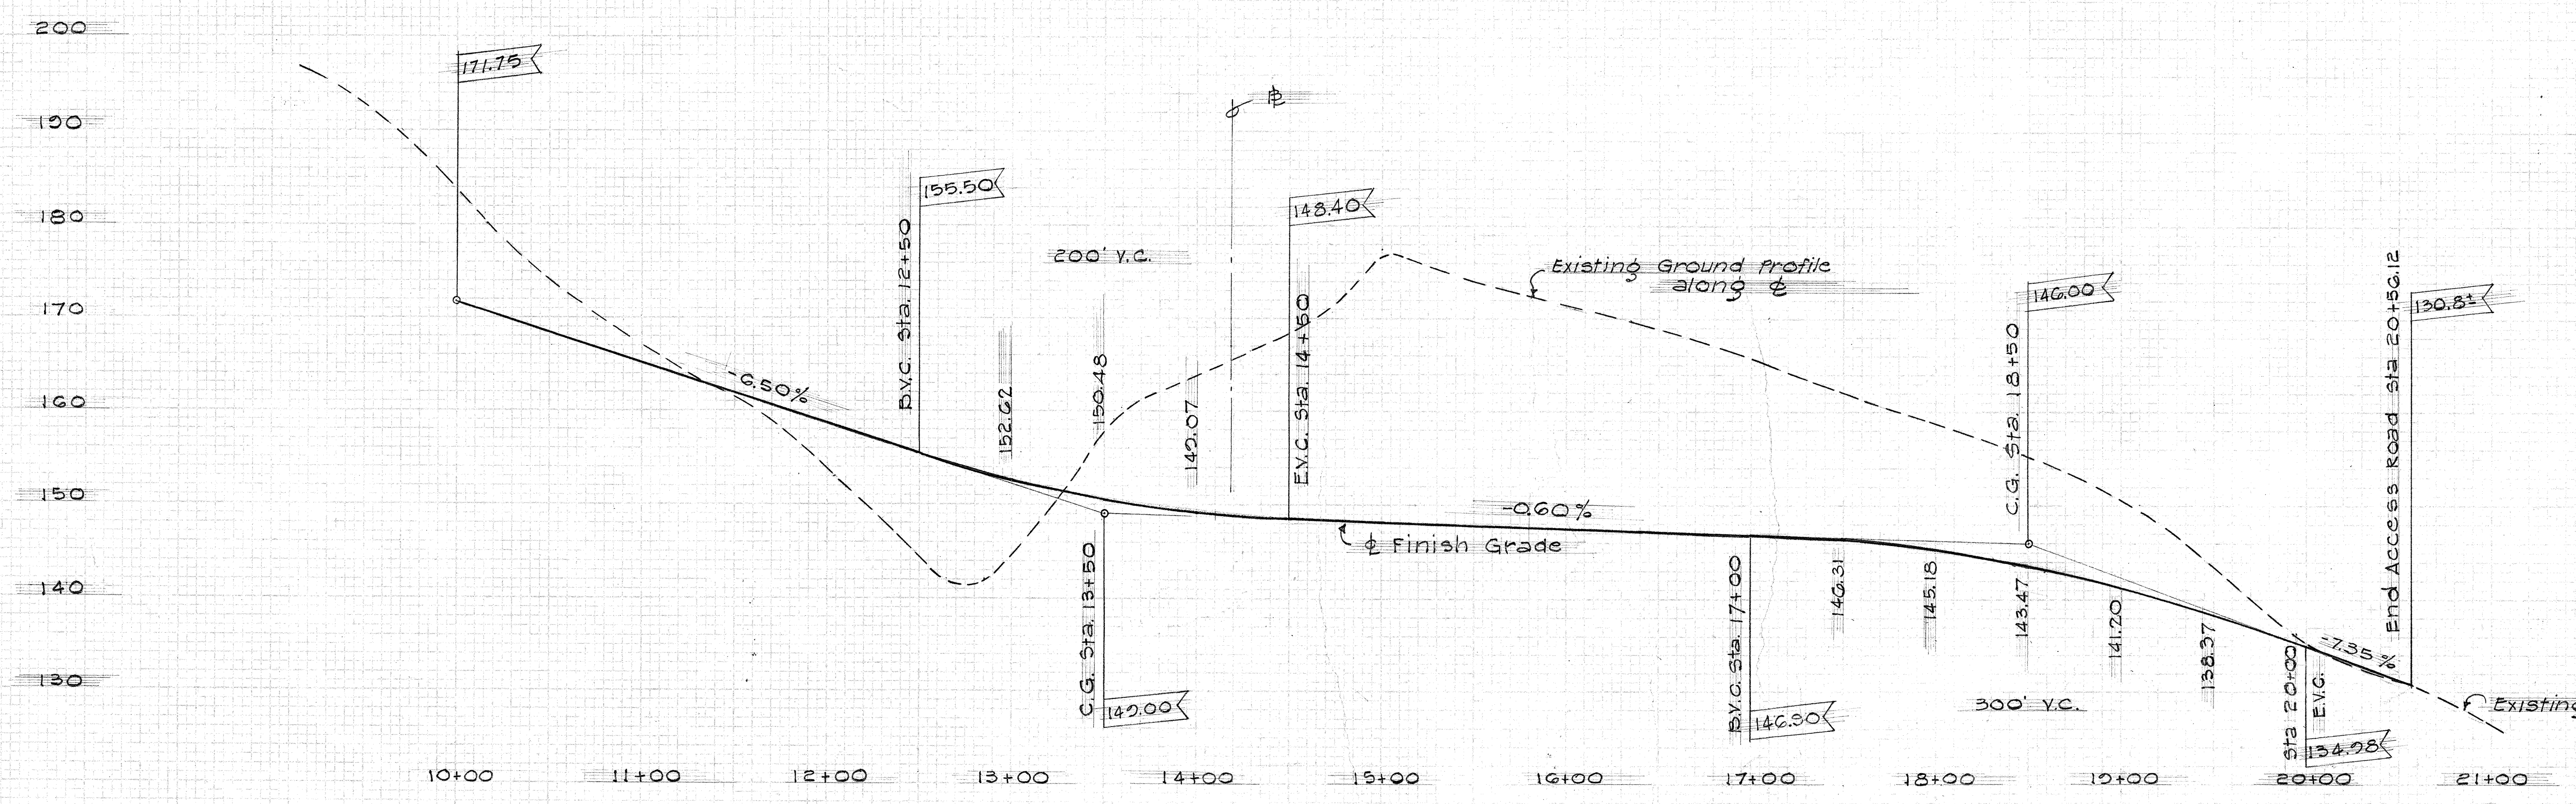


FED. ROAD DIST. NO.	STATE	FED. AID PROJ. NO.	FISCAL YEAR	SHEET NO.	TOTAL SHEETS
HAWAII	HAW.	1-H3-162	1975	7	127

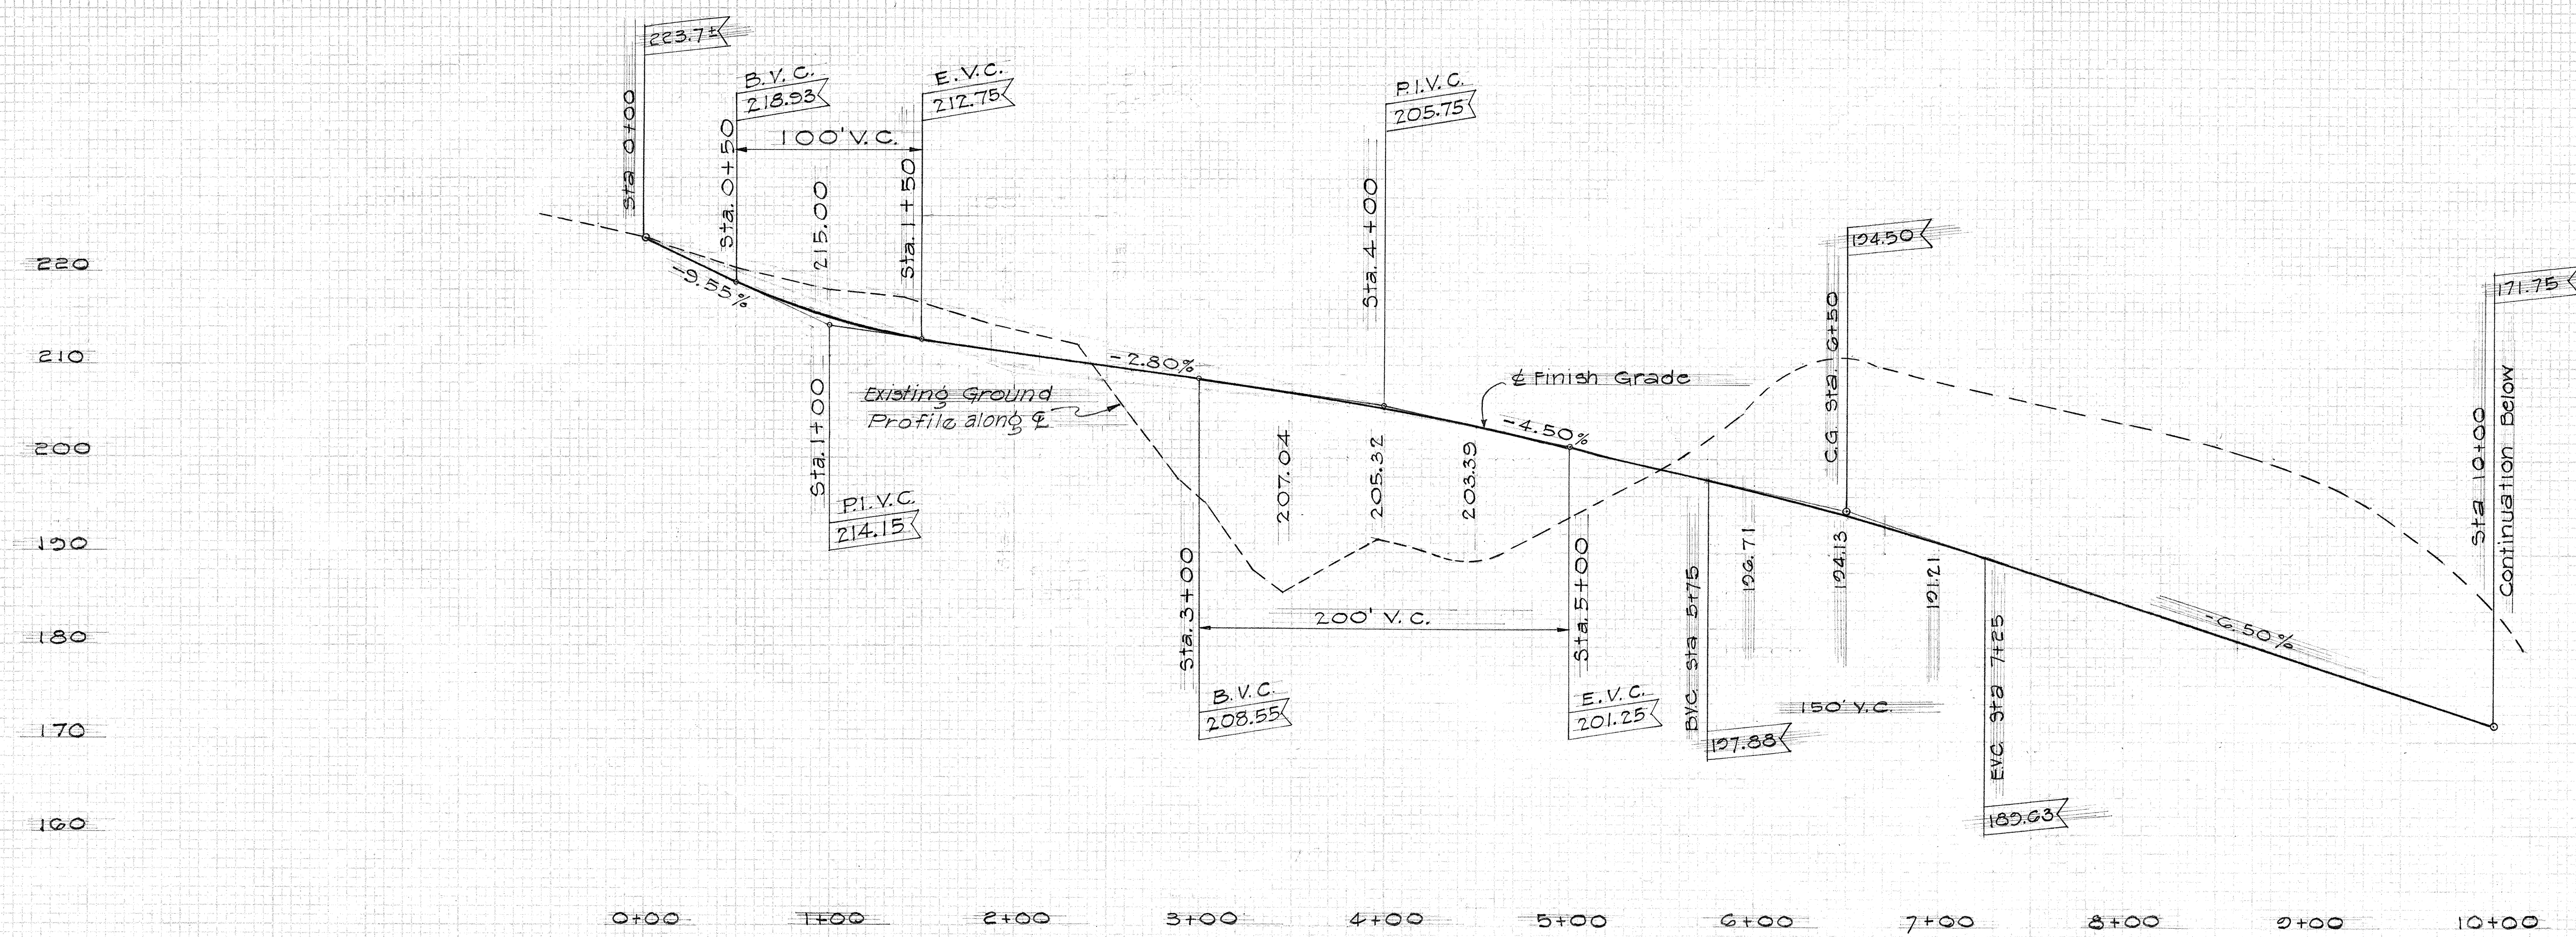


PROFILE - H.C. & D. ACCESS ROAD A-1
 SCALES: HORIZ. 1"=50'
 VERT. 1"=10'

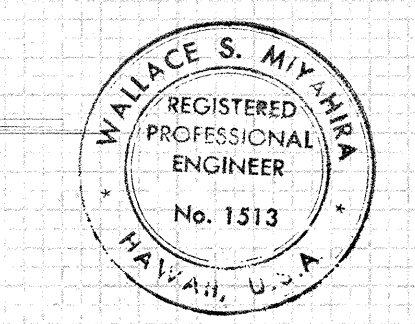

This work was prepared by me or under my supervision.
Wallace S. Miyahira


FED. ROAD DIST. NO.	STATE	FED. AID PROJ. NO.	FISCAL YEAR	SHEET NO.	TOTAL SHEETS
HAWAII	HAW.	I-H3-1(6)112	1975	9	127

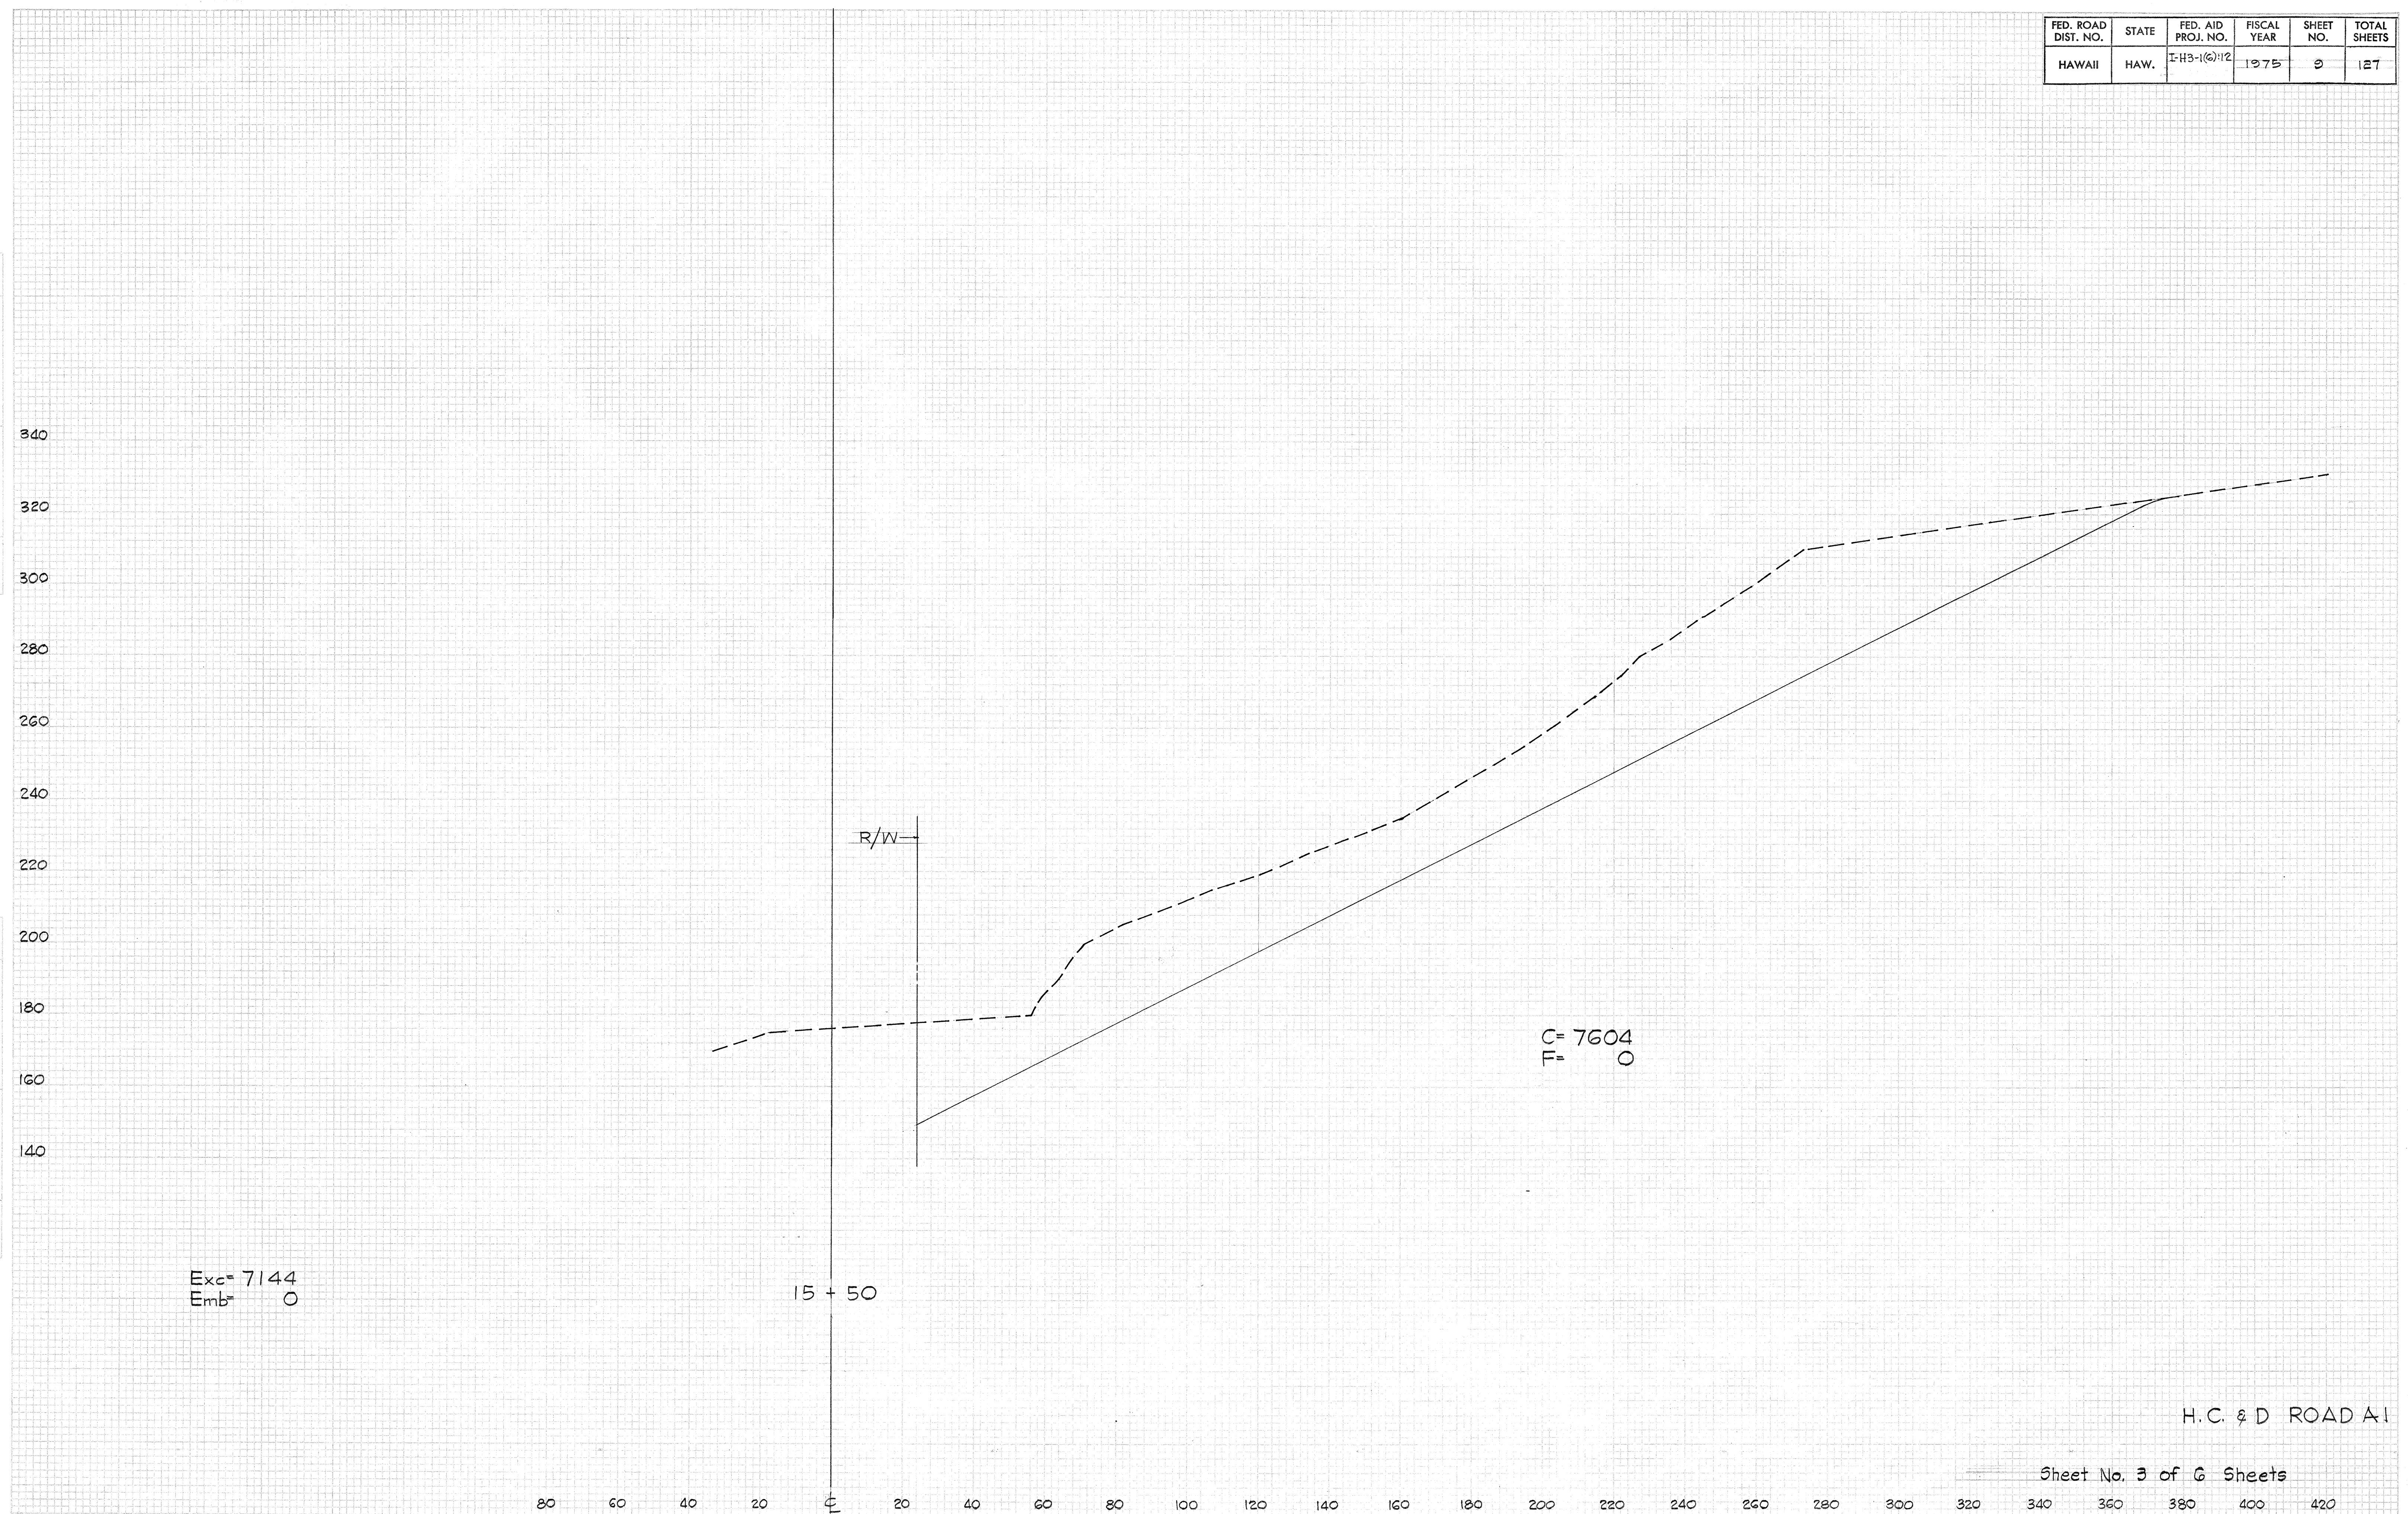

FED. ROAD DIST. NO.	STATE	FED. AID PROJ. NO.	FISCAL YEAR	SHEET NO.	TOTAL SHEETS
HAWAII	HAW.	I-HB-16112	1975	10	127

FINAL SURVEY	DATE	BY
NOTED	DATE	BY
REVISIONS	DATE	BY


DATE	BY
DATE	BY
DATE	BY

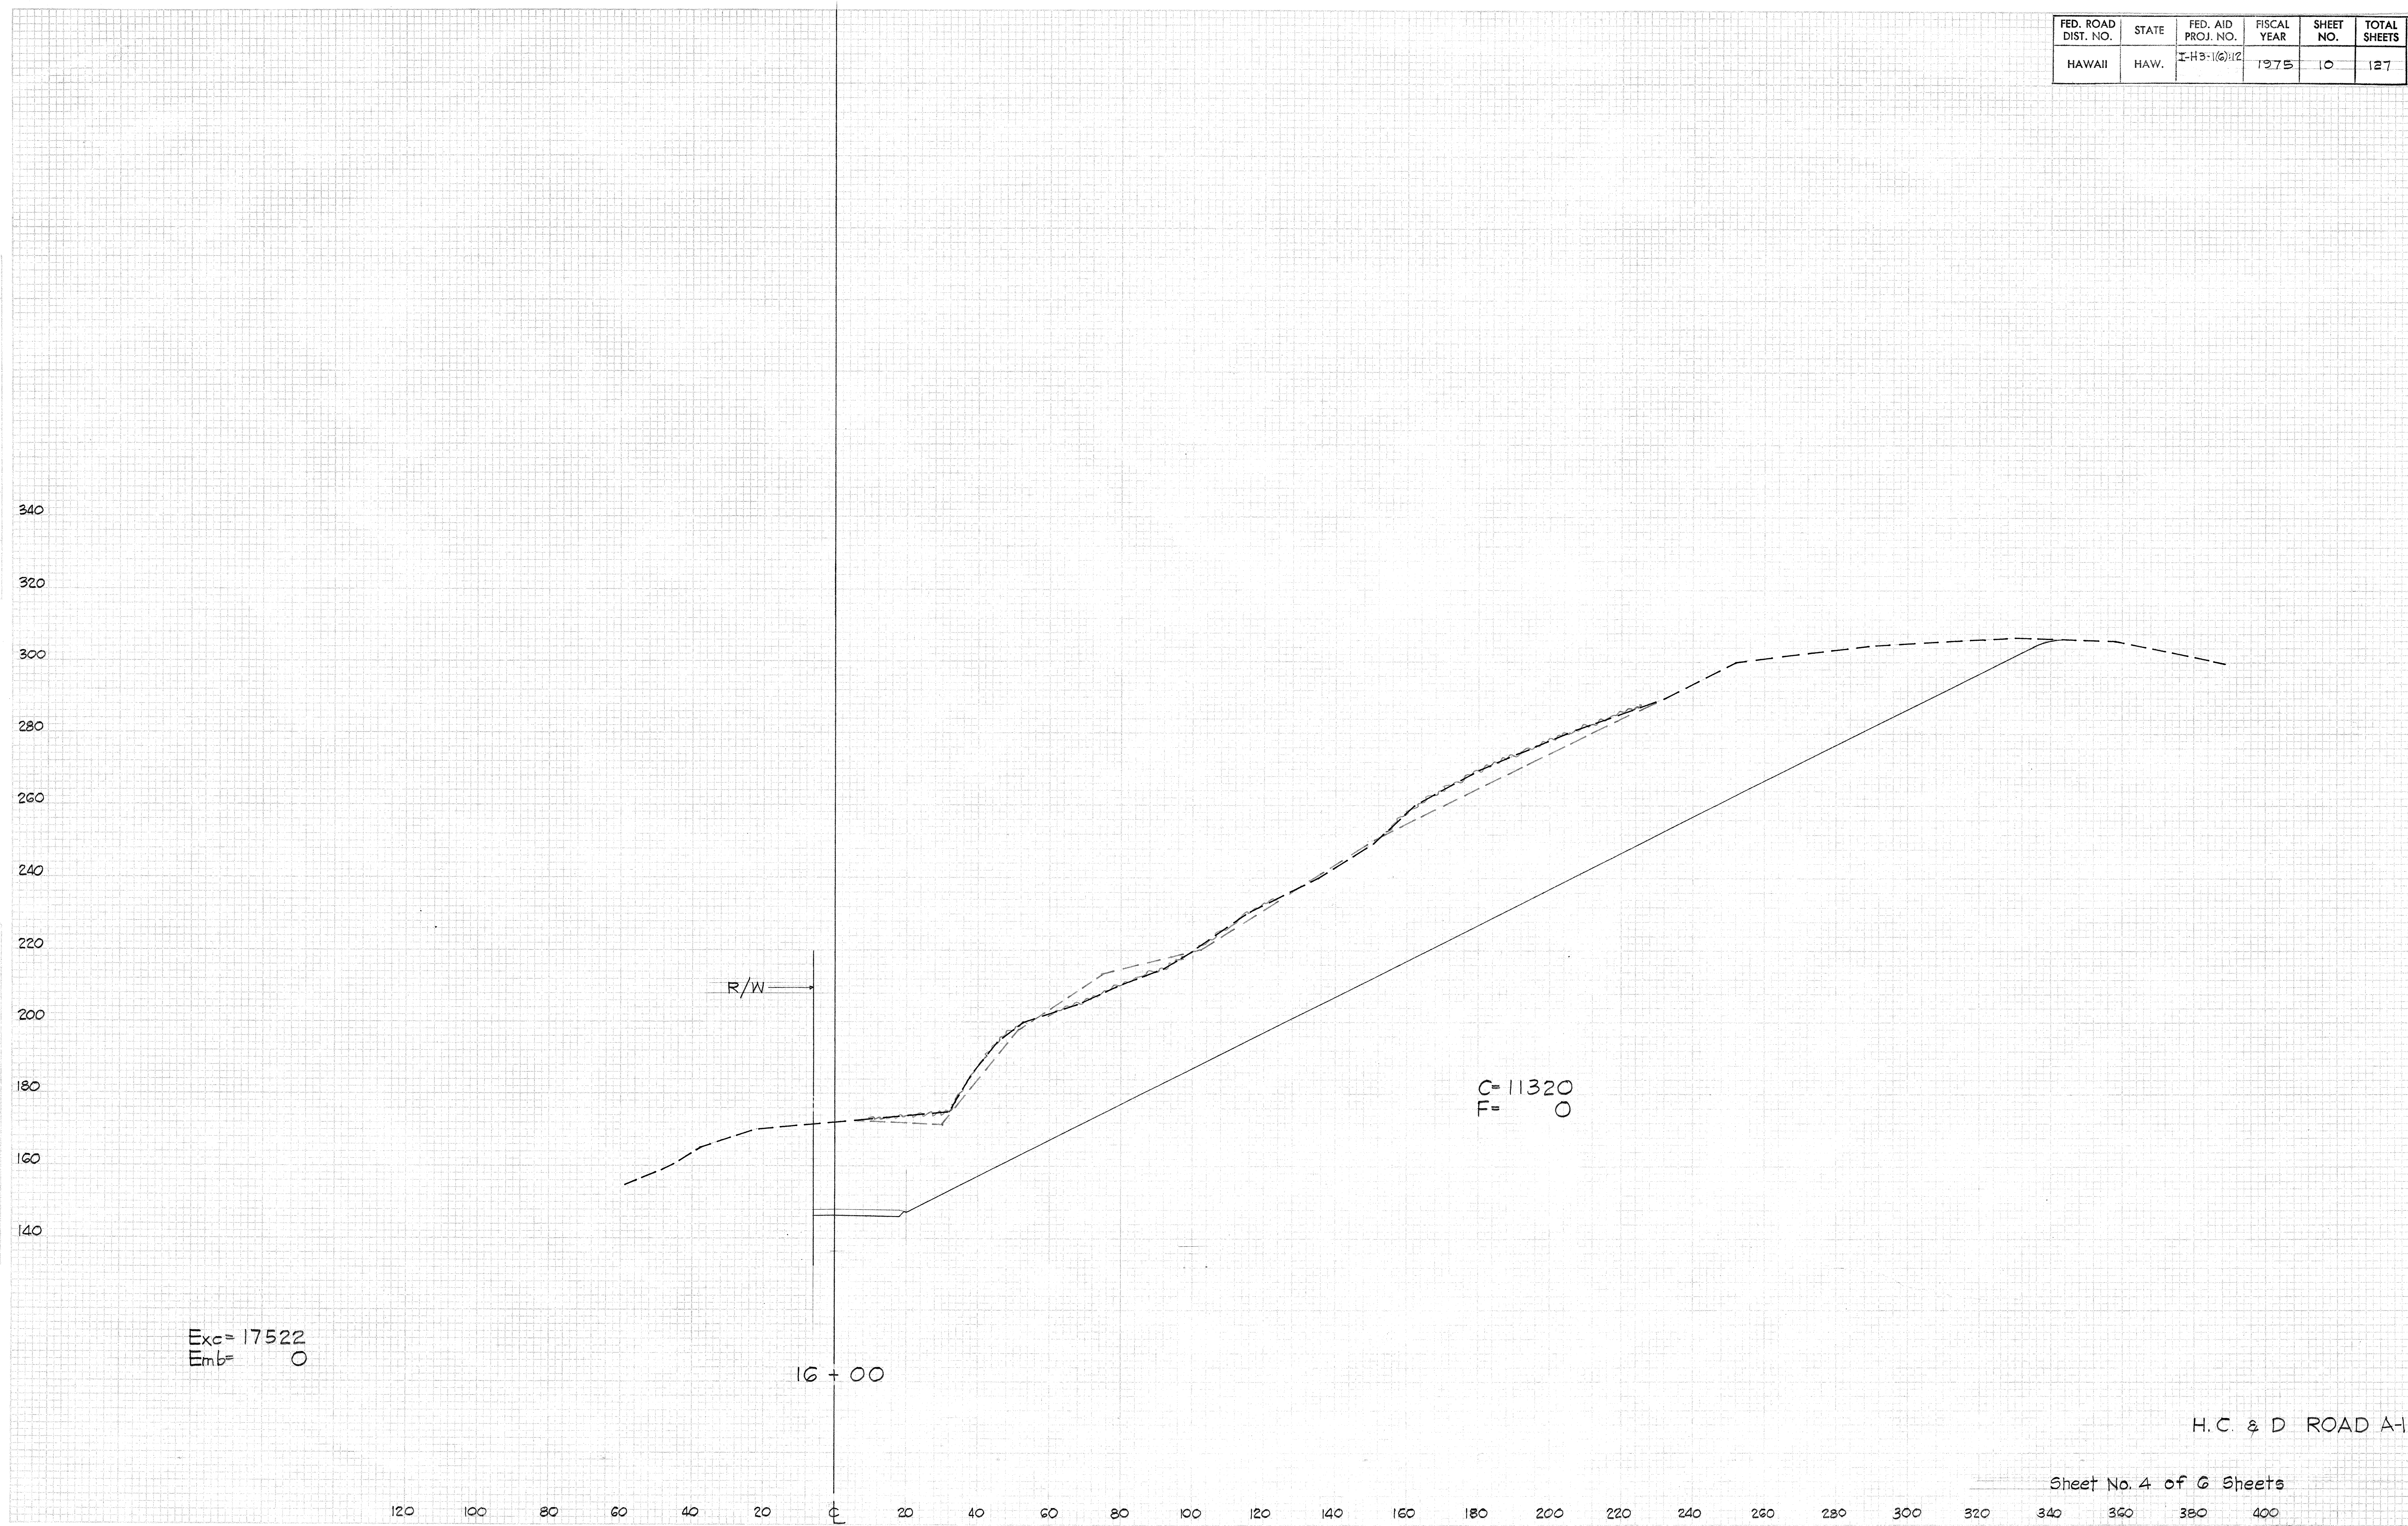

FED. ROAD DIST. NO.	STATE	FED. AID PROJ. NO.	FISCAL YEAR	SHEET NO.	TOTAL SHEETS
HAWAII	HAW.	1-H3-(6)-12	1975	12	127

DATE	BY
DESIGNED	CHECKED
DRAWN	APPROVED
NOTED	DATE
NO.	BY

DATE	BY
DESIGNED	CHECKED
DRAWN	APPROVED
NOTED	DATE
NO.	BY

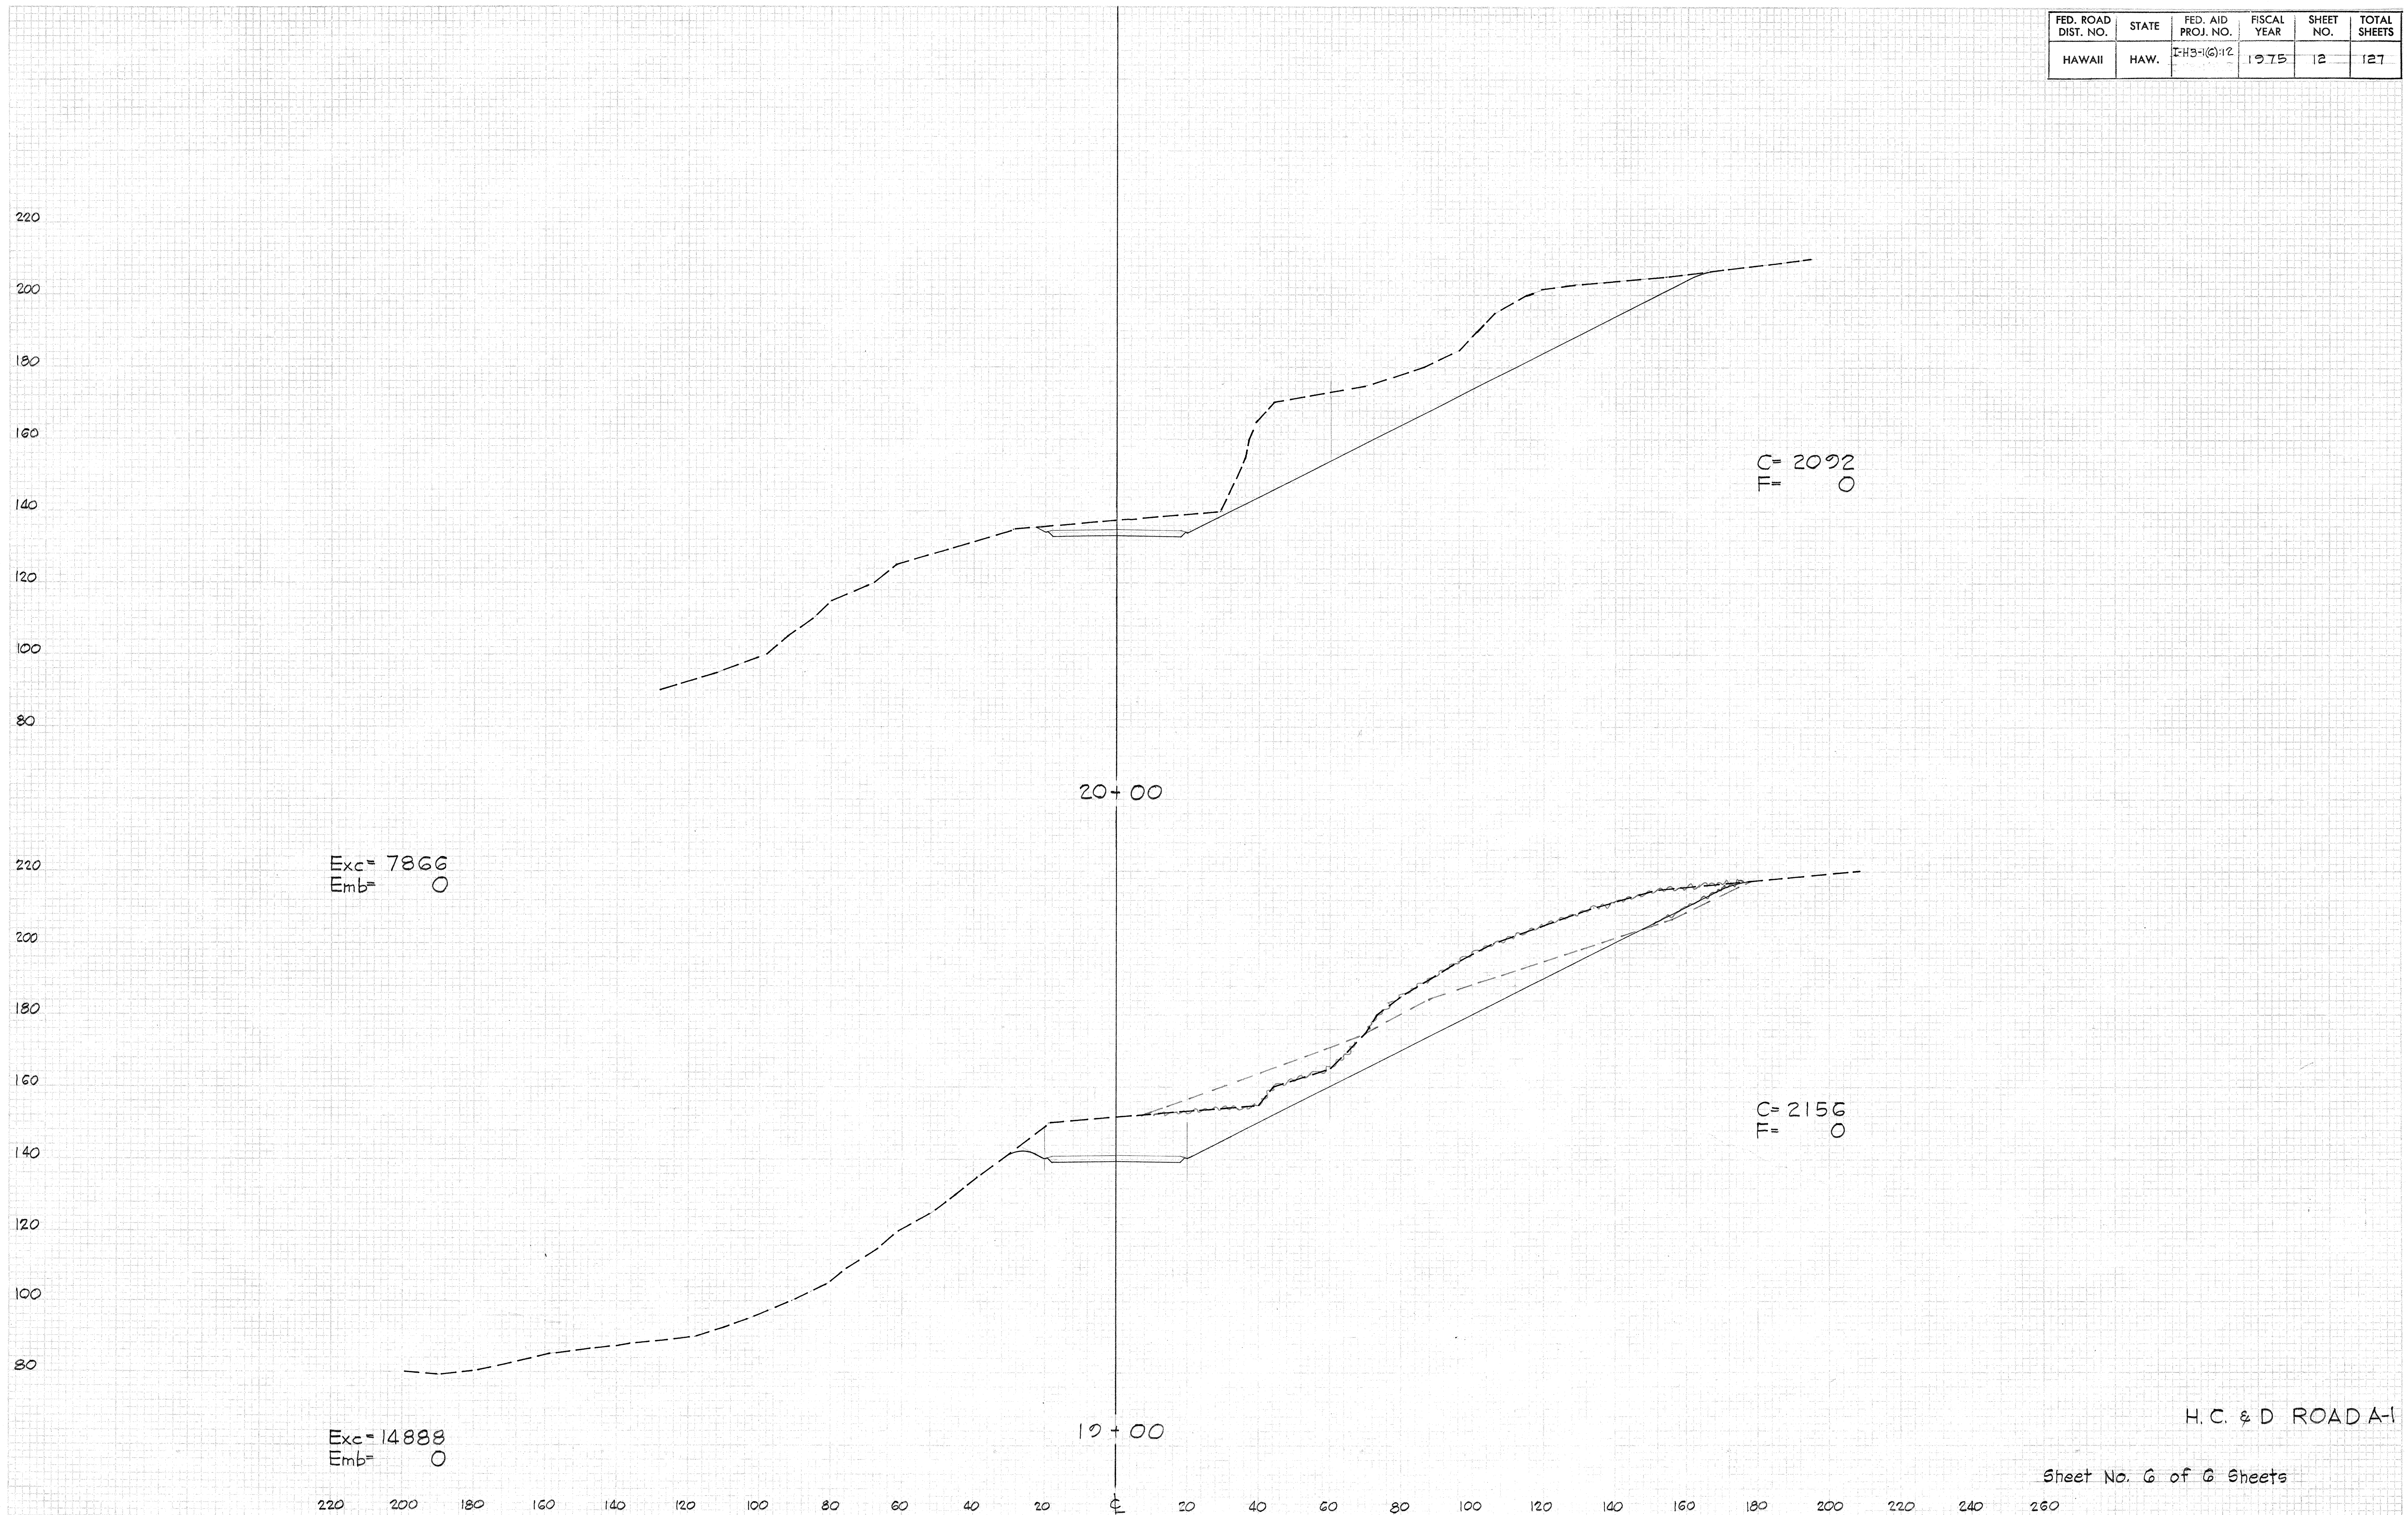

H.C. & D. ROAD A-1

Sheet No. 6 of 6 Sheets