



FED. ROAD DIST. NO.	STATE	FED. AID PROJ. NO.	FISCAL YEAR	SHEET NO.	TOTAL SHEETS
HAWAII	HAW.	I-183(6)112	1975	13	127

FINAL SURVEY	DATE
NO.	
BY	
REVIEWED	
PLOTTED	
NOTE BOOK	
AREAS CHECKED	

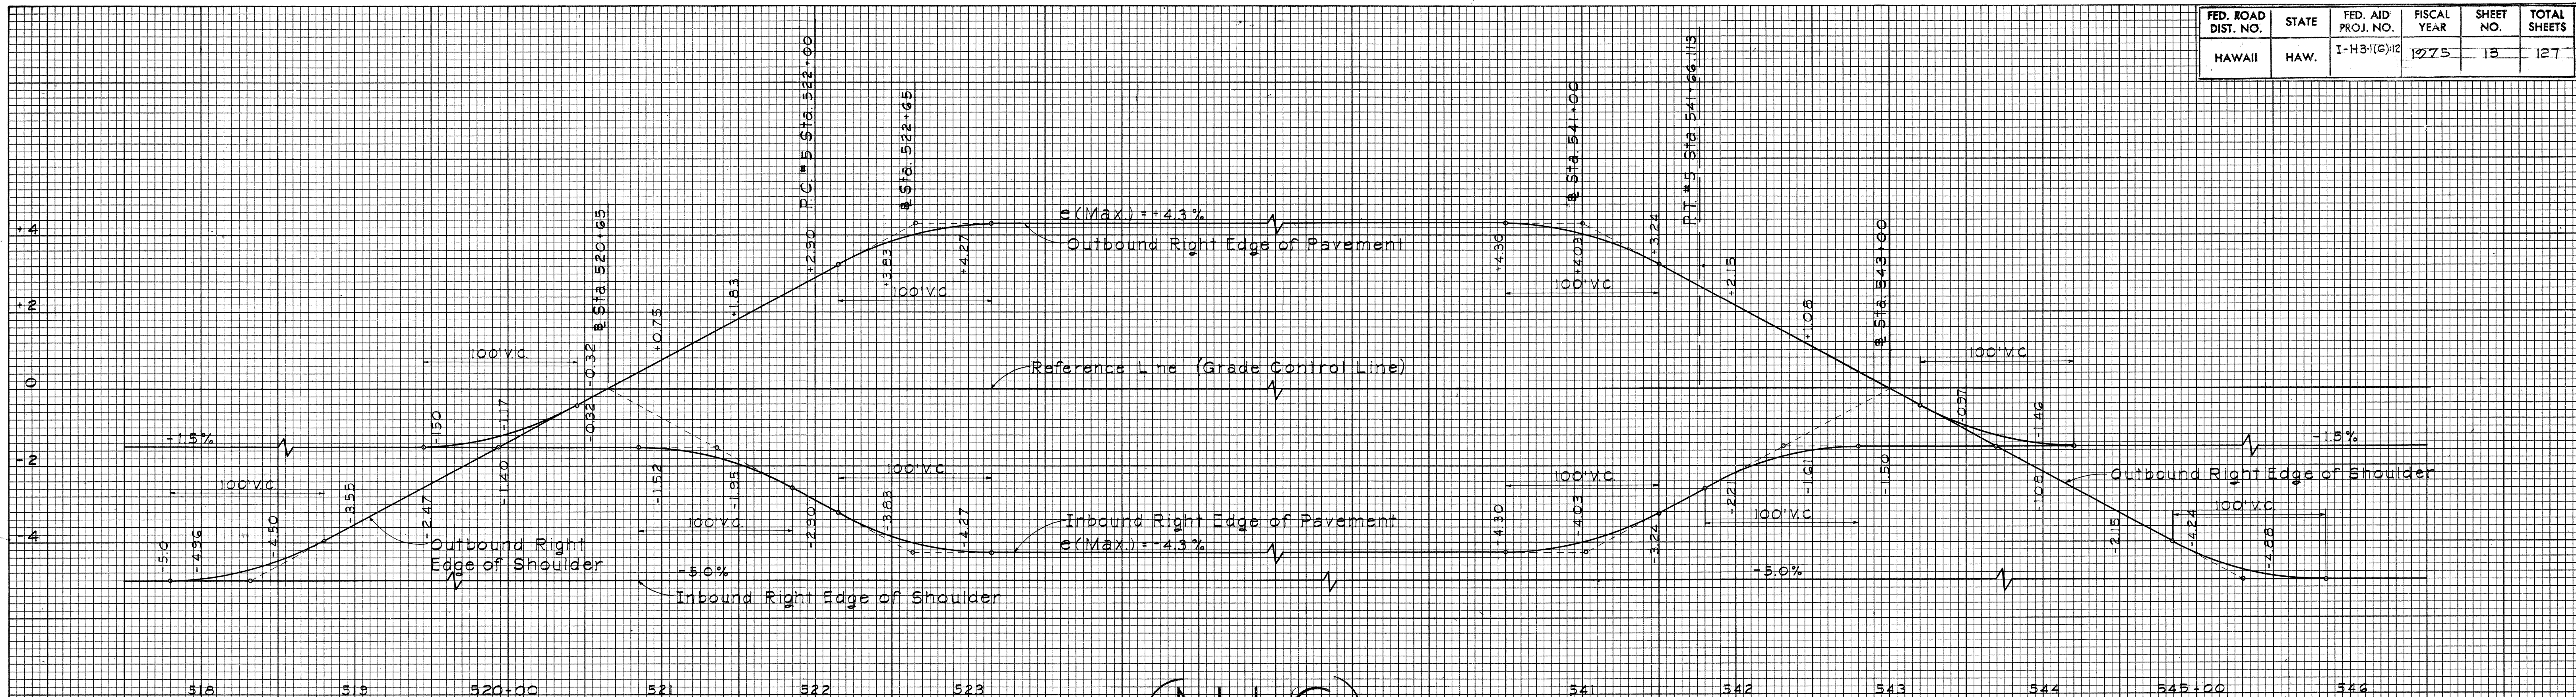

SUPERELEVATION DIAGRAM - CURVE B-5

ORIGINAL SURVEY	DATE
NO.	
BY	
REVIEWED	
PLOTTED	
NOTE BOOK	
AREAS CHECKED	

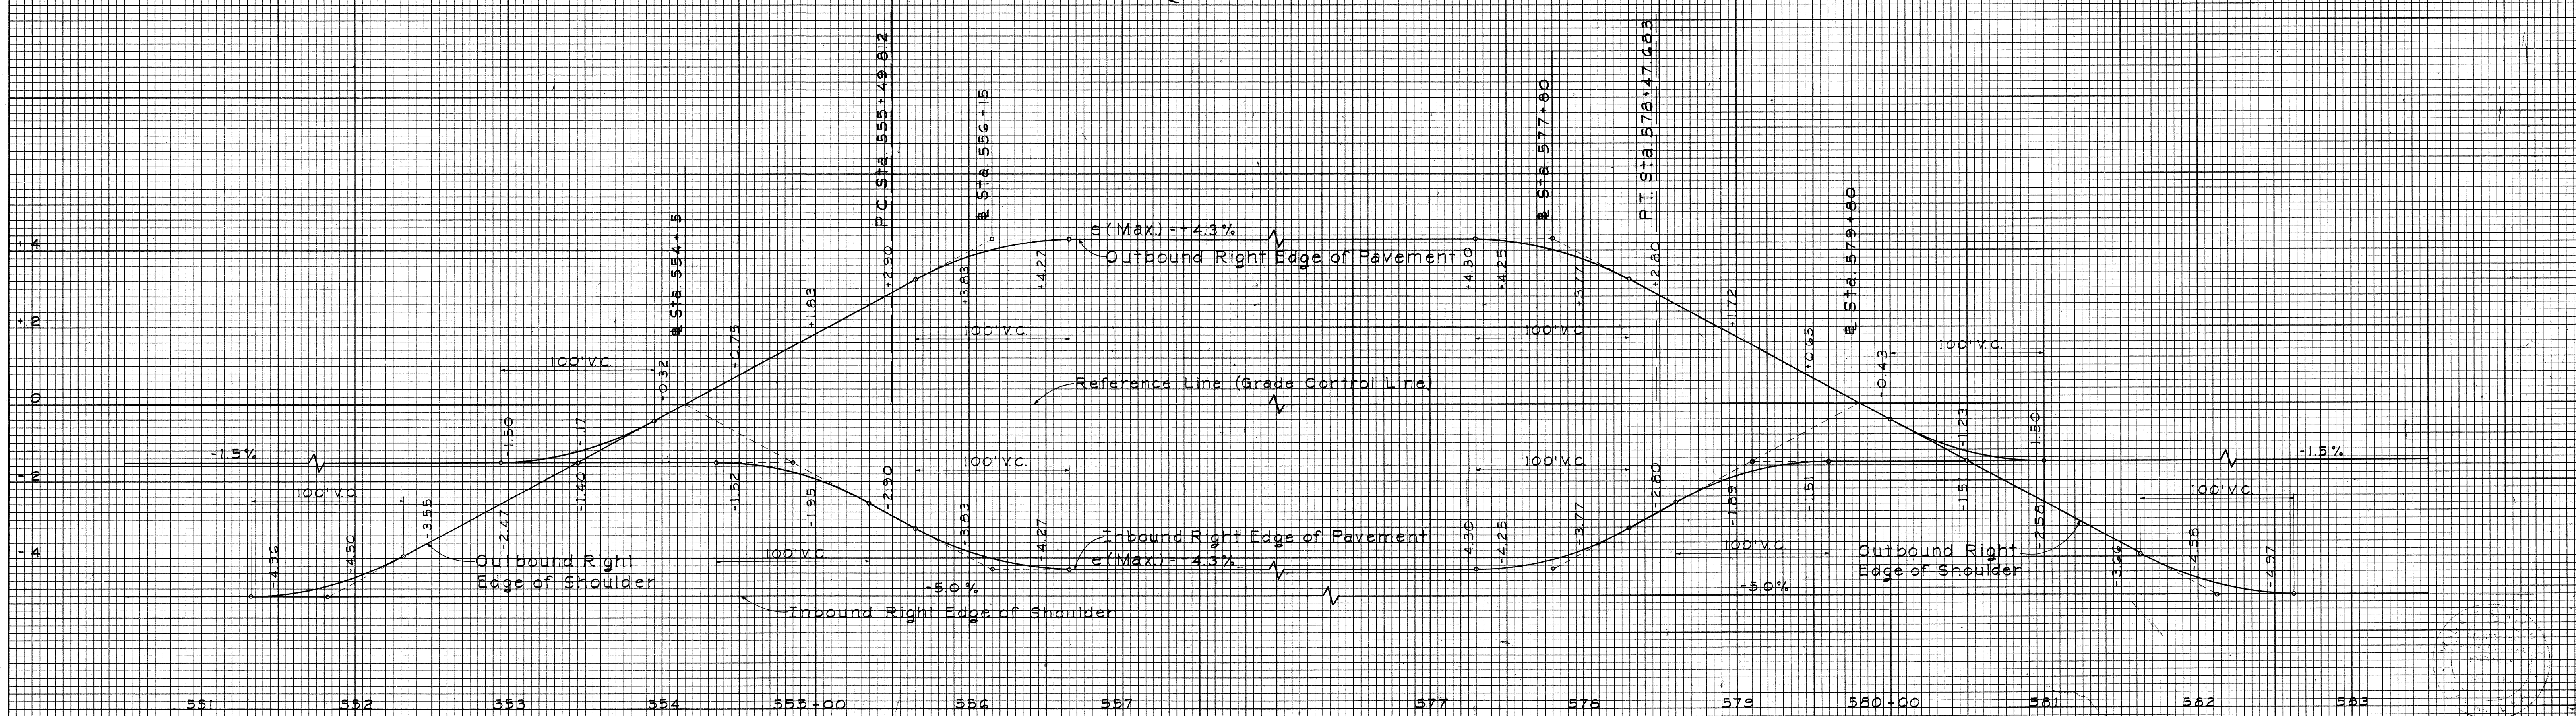

SUPERELEVATION DIAGRAM - CURVE B-5A

Scale Horiz. 1" = 50'
Vert. 1" = 2'