

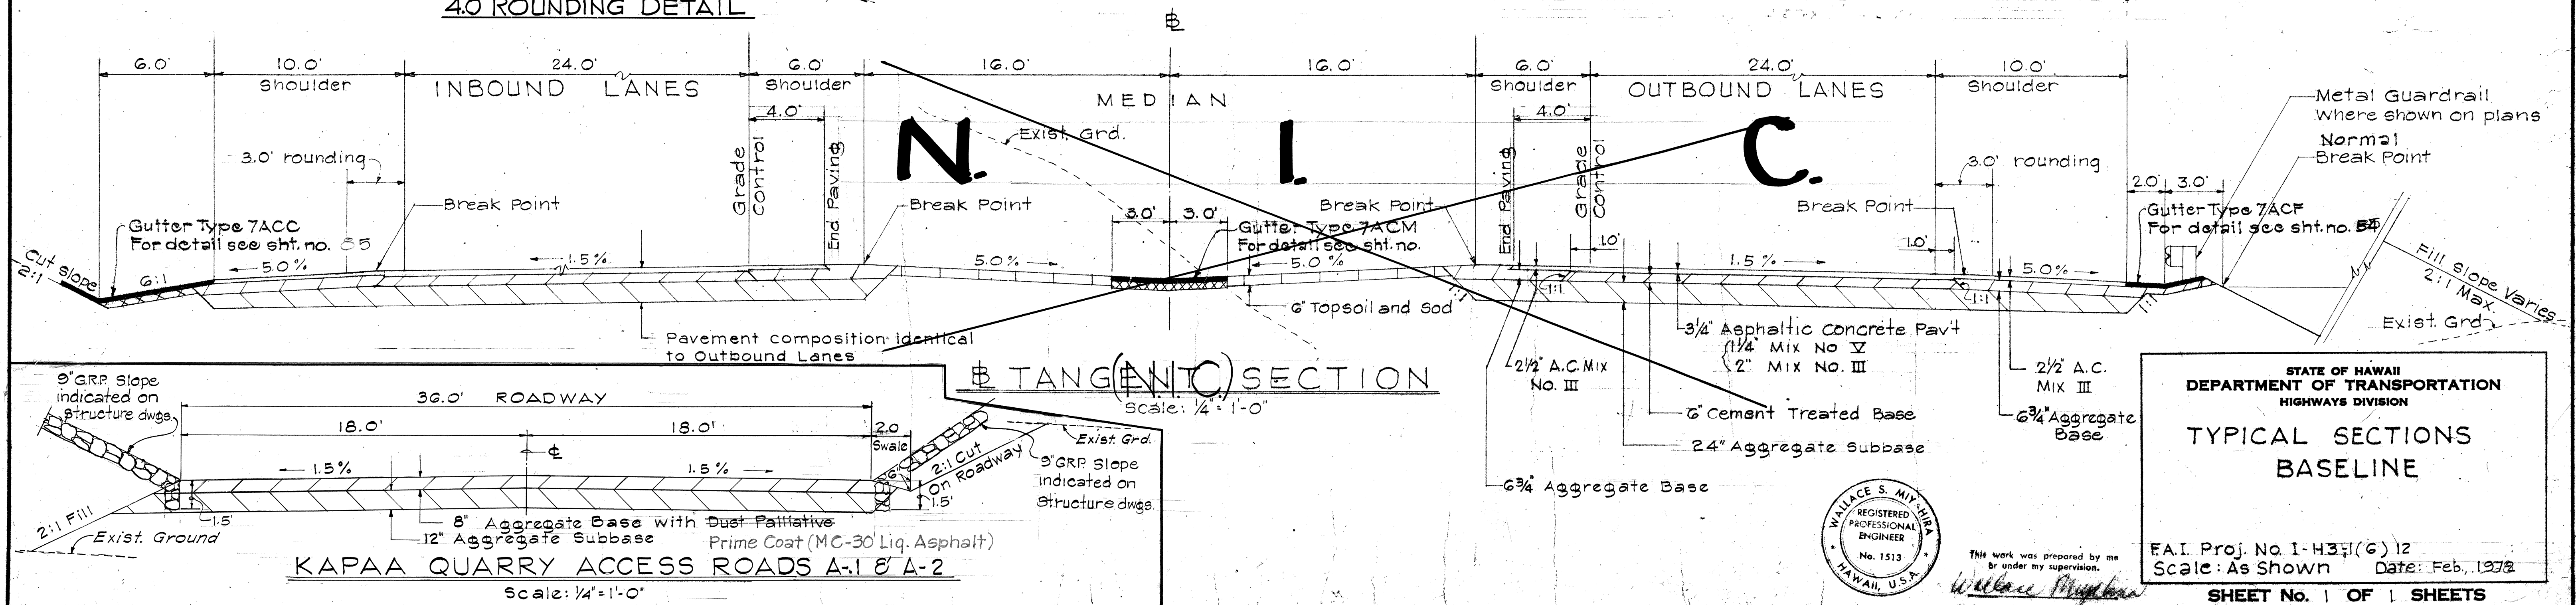
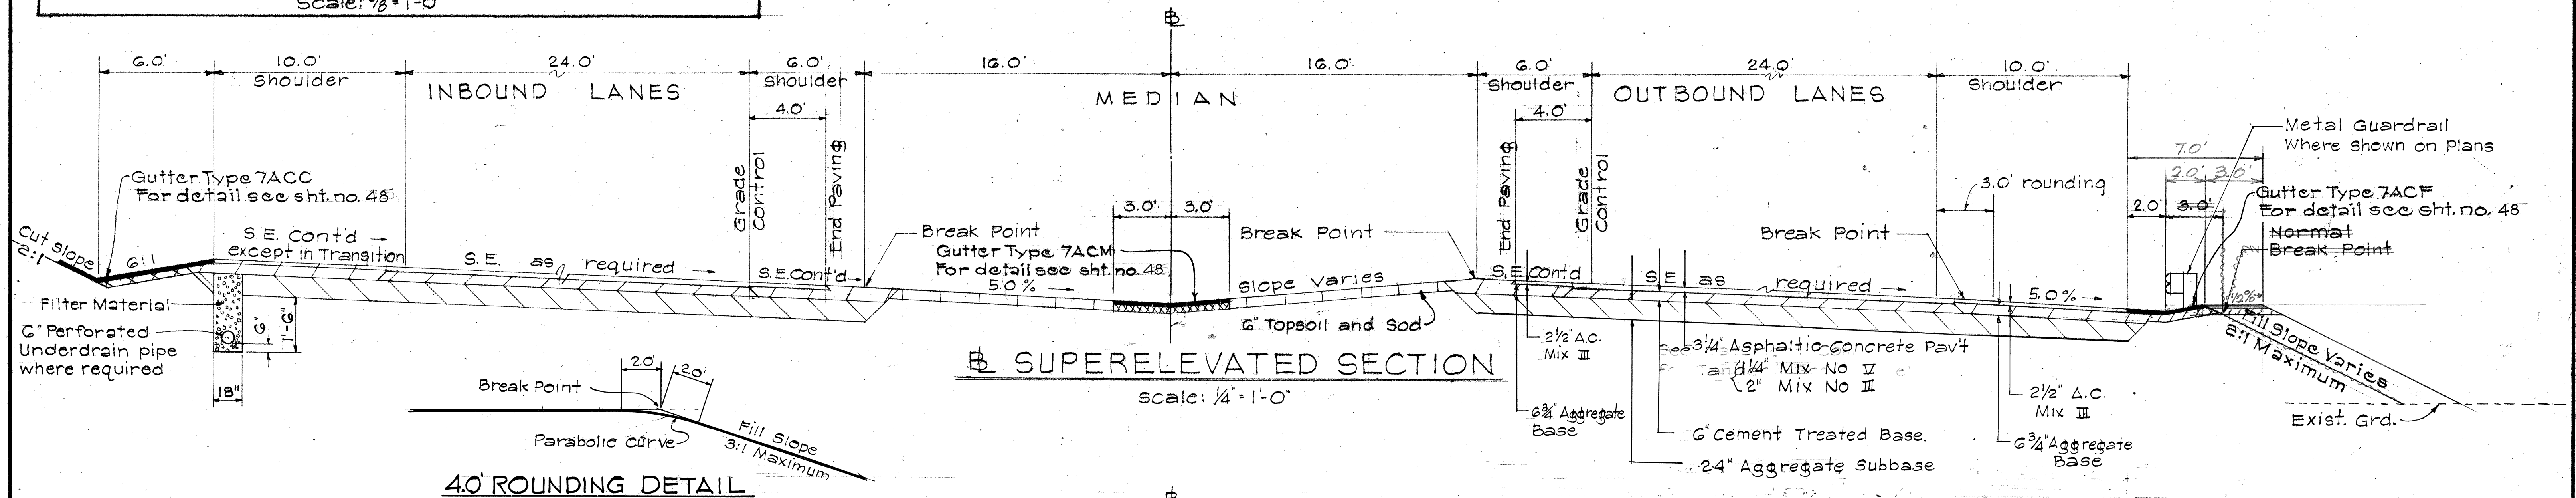


FED. ROAD DIST. NO.	STATE	FED. AID PROJ. NO.	FISCAL YEAR	SHEET NO.	TOTAL SHEETS
HAWAII	HAW.	1-437(6)12	1975	2	127

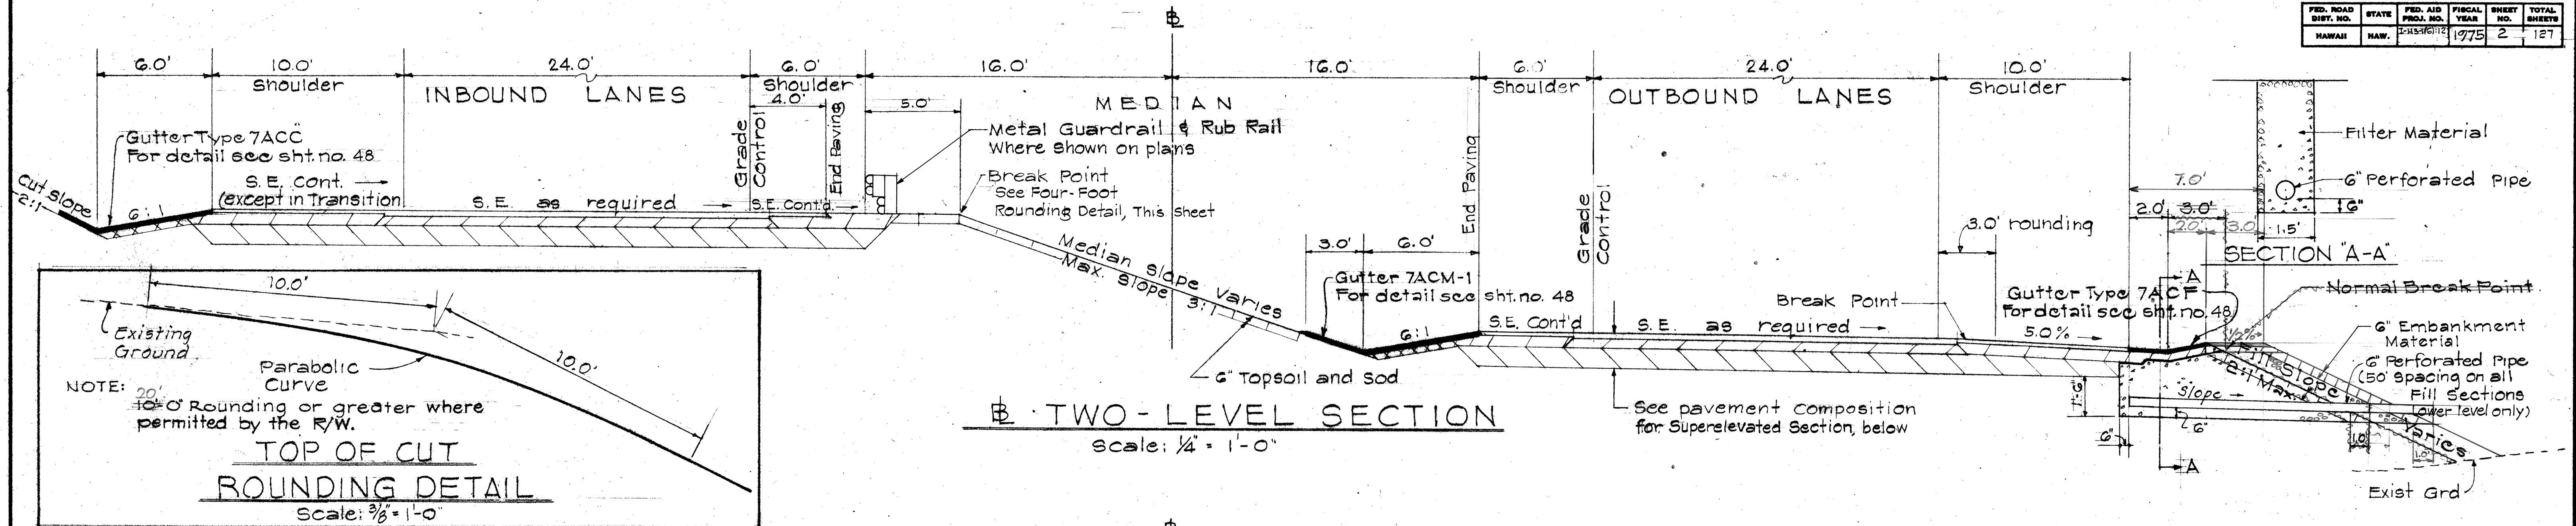

DATE	1975
DESIGNED BY	WALLACE S. MYR
CHECKED BY	WALLACE S. MYR
NOTED BY	WALLACE S. MYR
NO.	1

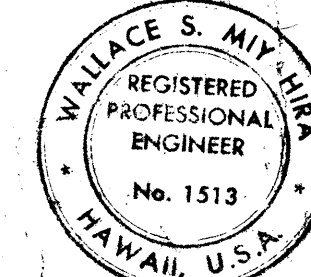

STATE OF HAWAII
DEPARTMENT OF TRANSPORTATION
HIGHWAYS DIVISION

**TYPICAL SECTIONS
BASELINE**

FAI Proj. No. 1-437(6)12
Scale: As Shown Date: Feb. 1975

SHEET No. 1 OF 1 SHEETS