
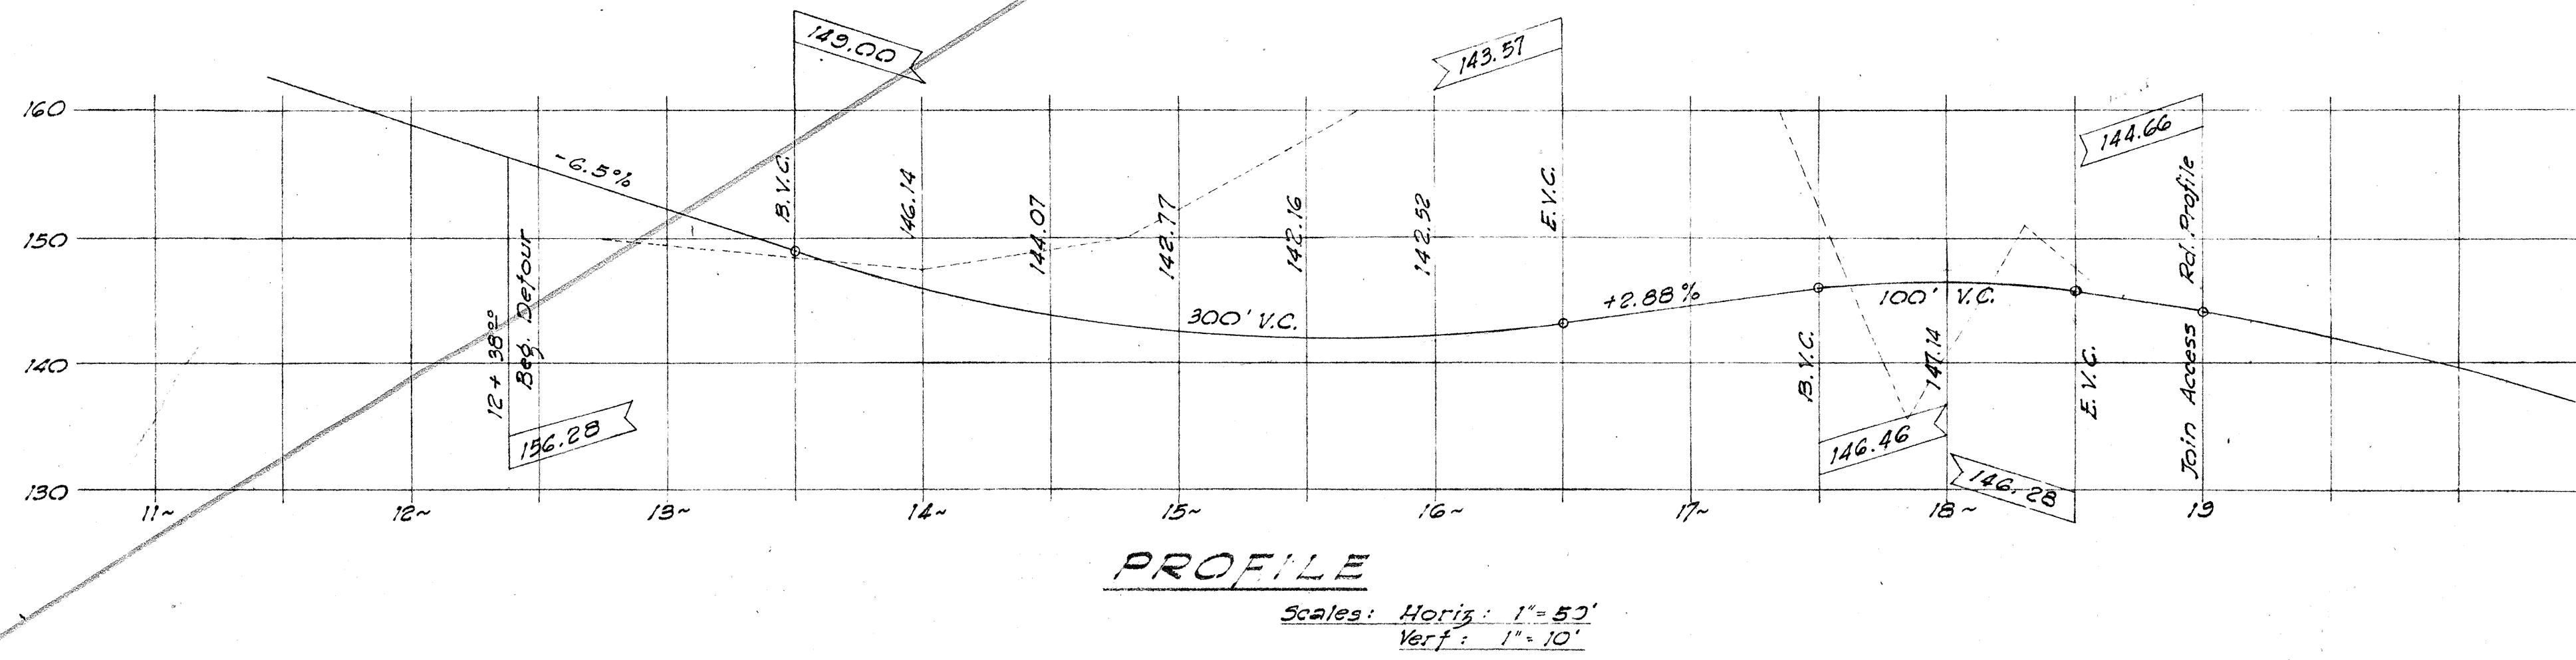
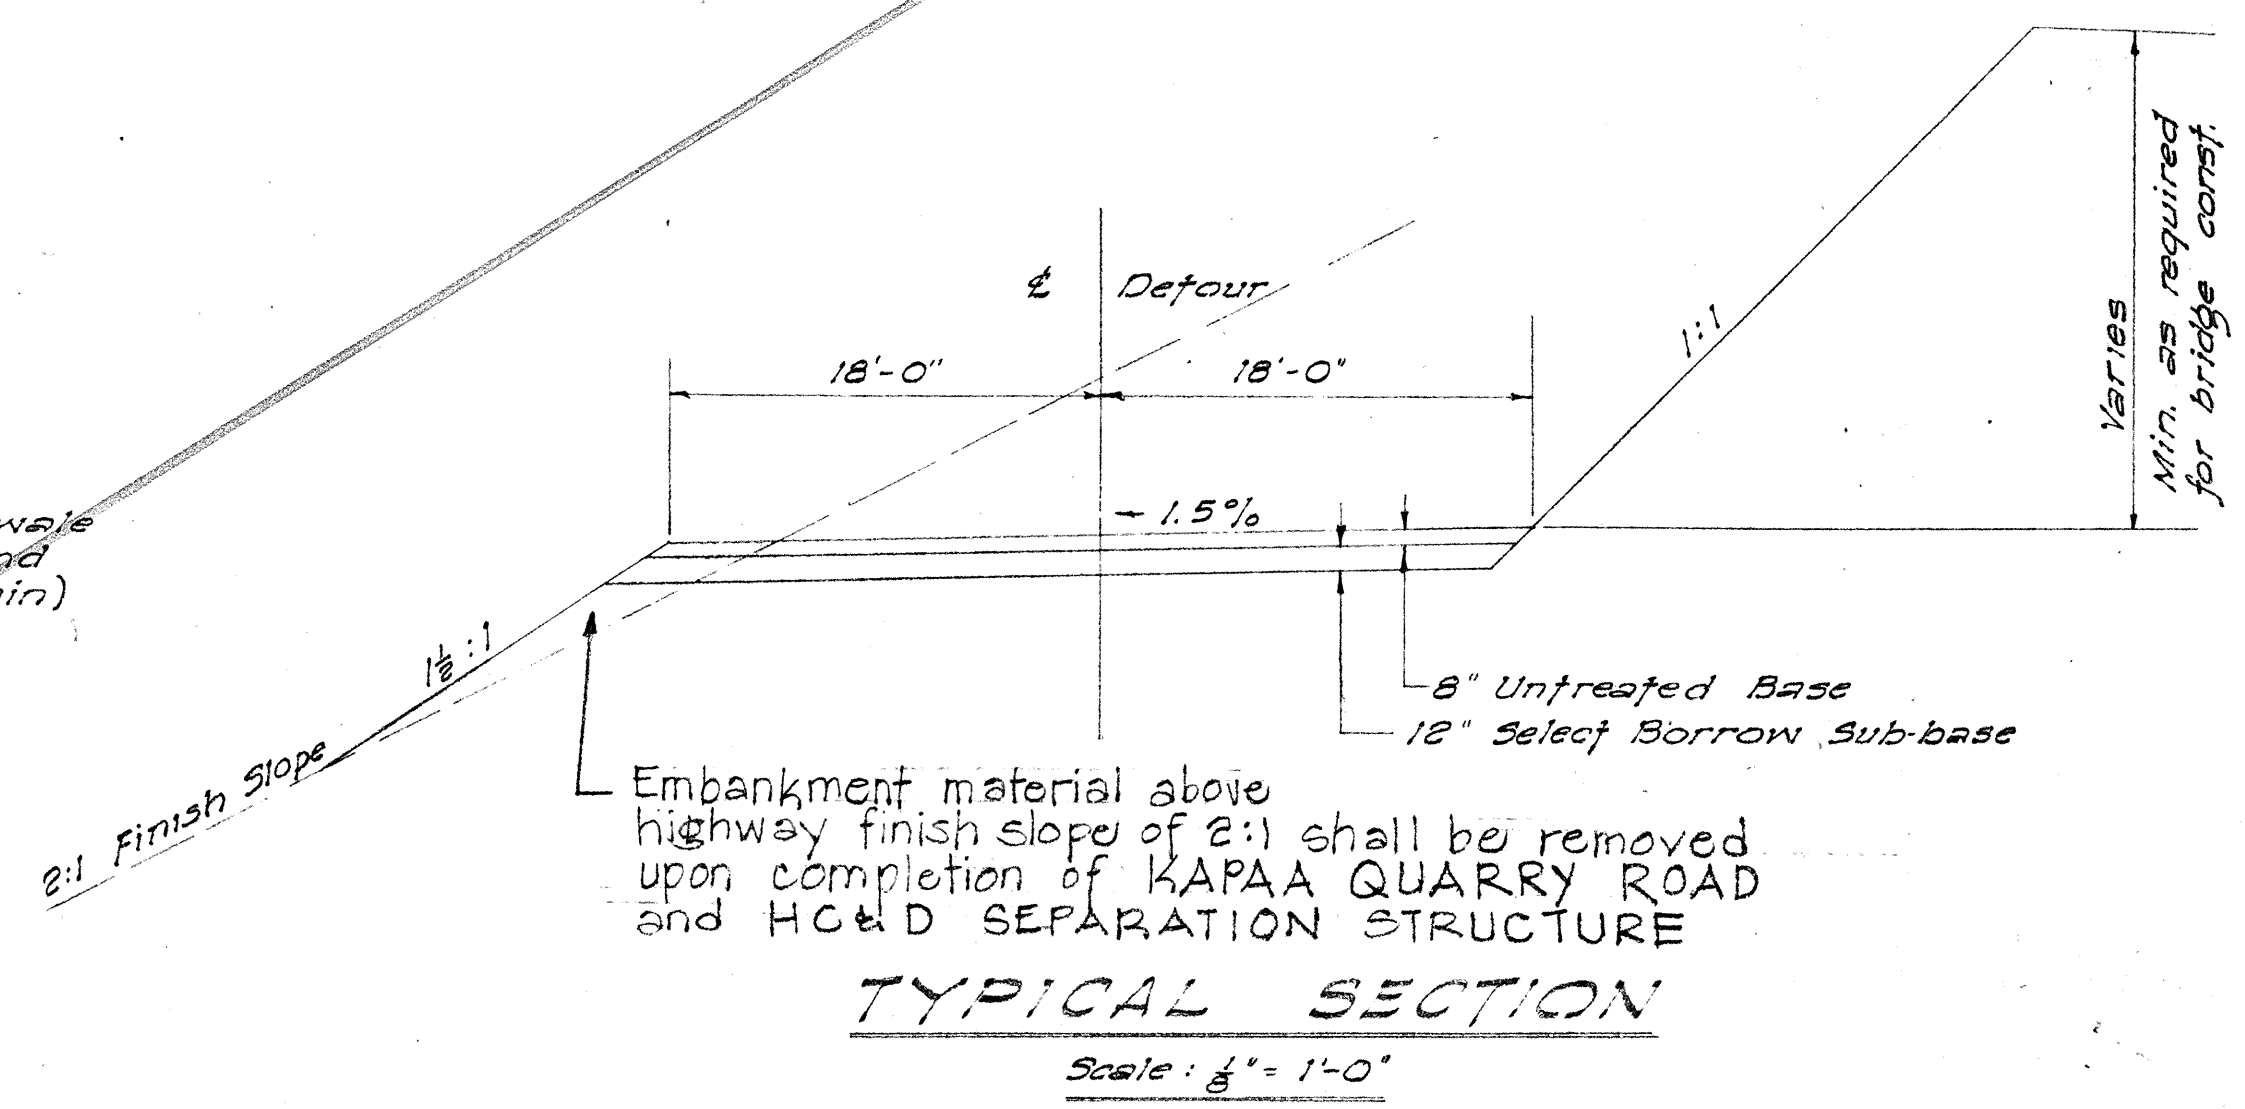



FED. ROAD DIST. NO.	STATE	FED. AID PROJ. NO.	FISCAL YEAR	SHEET NO.	TOTAL SHEETS
HAWAII	HAW.	I-H3-1(23):1 I-H3-1(2):1	1970	24	224

CURVE DATA

① $\Delta = 25^{\circ}05'23''$ $R = 200'$ $T = 44.50$ $L = 87.58'$	② $\Delta = 43^{\circ}09'46''$ $R = 150'$ $T = 59.33$ $L = 113.00$	③ $\Delta = 22^{\circ}03'31''$ $R = 200'$ $T = 38.98$ $L = 77.00$	④ $\Delta = 74^{\circ}12'42''$ $R = 150'$ $T = 113.47$ $L = 194.29$	⑤ $\Delta = 60^{\circ}42'29''$ $R = 150'$ $T = 87.84$ $L = 158.93$
⑥ $\Delta = 2^{\circ}40'21''$ $R = 1400'$ $T = 32.65$ $L = 65.30$				

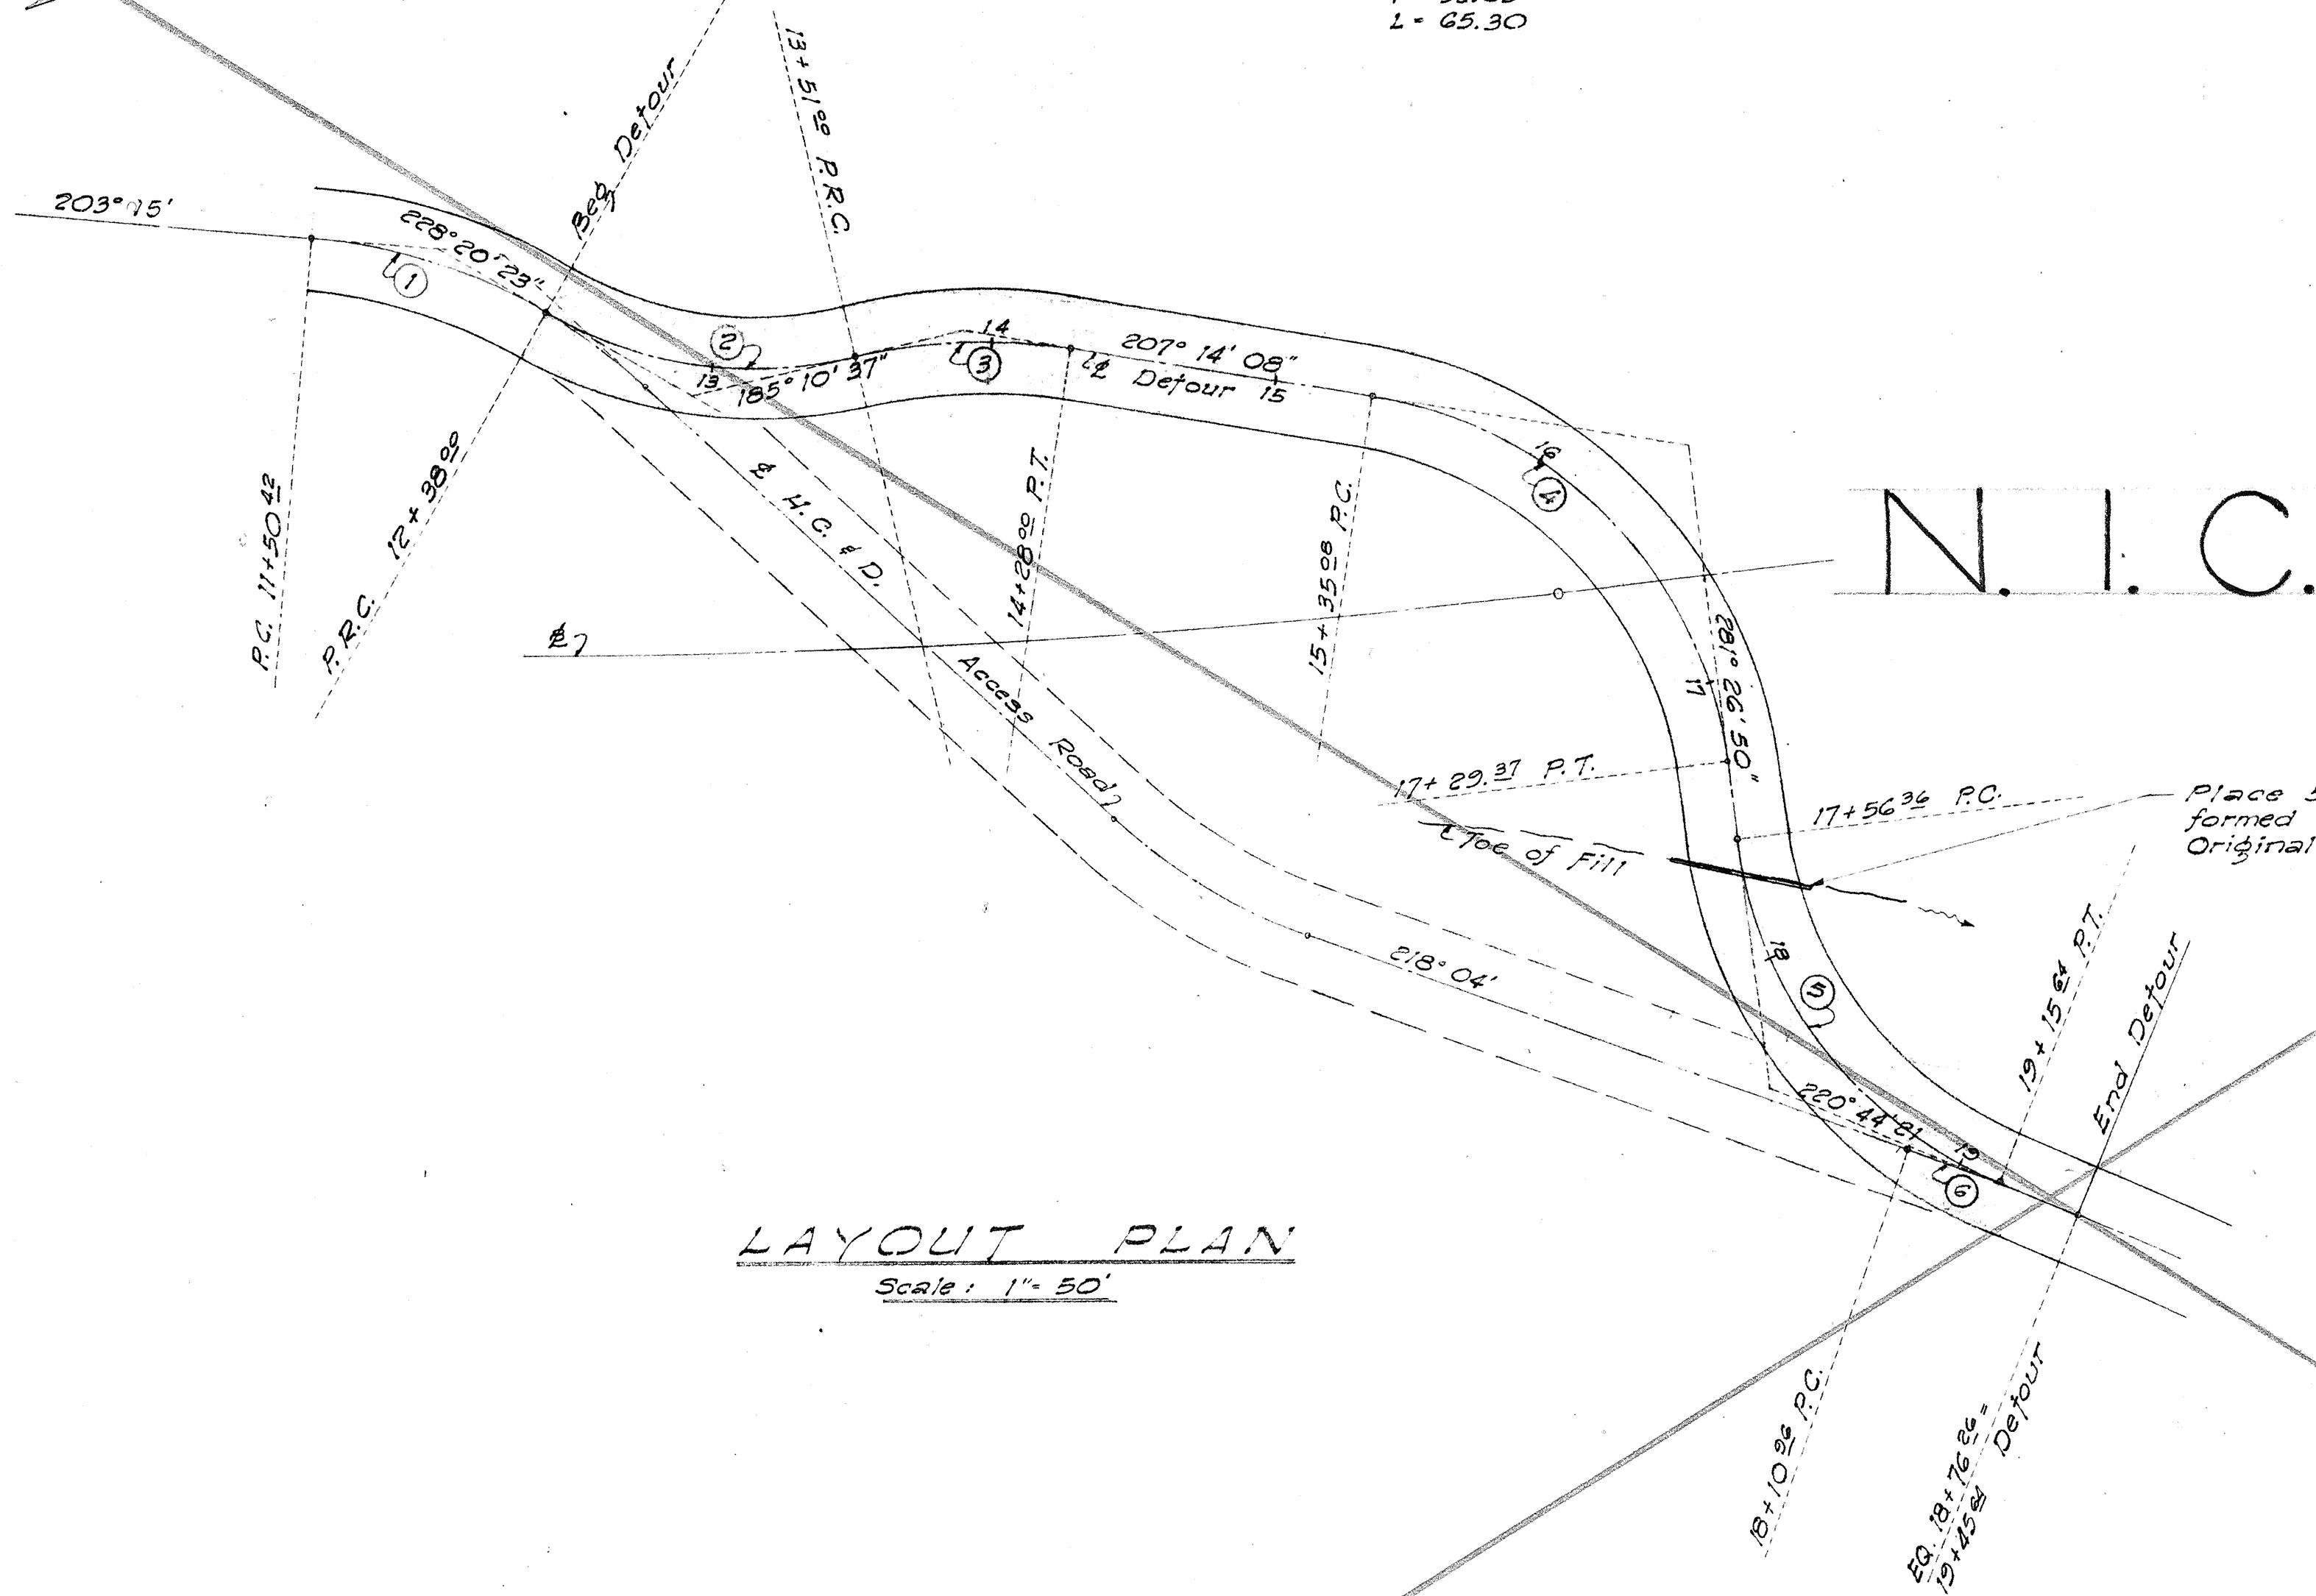

DATE	_____
DESIGNED BY	_____
CHECKED BY	_____
NOTED BY	_____
PLANNED BY	_____
ORIGINAL	_____

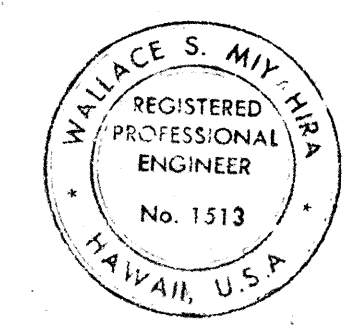

This work was prepared by me or under my supervision.
Wallace S. Miyahira

STATE OF HAWAII
DEPARTMENT OF TRANSPORTATION
HIGHWAYS DIVISION

**H.C. & D. SEPARATION
CONST. DETOUR**

FAI Proj. No. I-H3-1(23):1, I-H3-1(2):1
Scale: As Shown Date: Oct. 1968

SHEET No. 1 OF 2 SHEETS

FED. ROAD DIST. NO.	STATE	FED. AID PROJ. NO.	FISCAL YEAR	SHEET NO.	TOTAL SHEETS
HAWAII	HAW.	I-H3-1(23)II I-H3-1(2)III	1970	25	224

FINAL SURVEY	DATE
	BY
NO. 1	SURVEYED
	PLOTTED
NO. 2	NOTED
	CHECKED
NO. 3	AREAS
	CHECKED

ORIGINAL SURVEY	DATE
	BY
NO. 1	SURVEYED
	PLOTTED
NO. 2	NOTED
	CHECKED
NO. 3	AREAS
	CHECKED

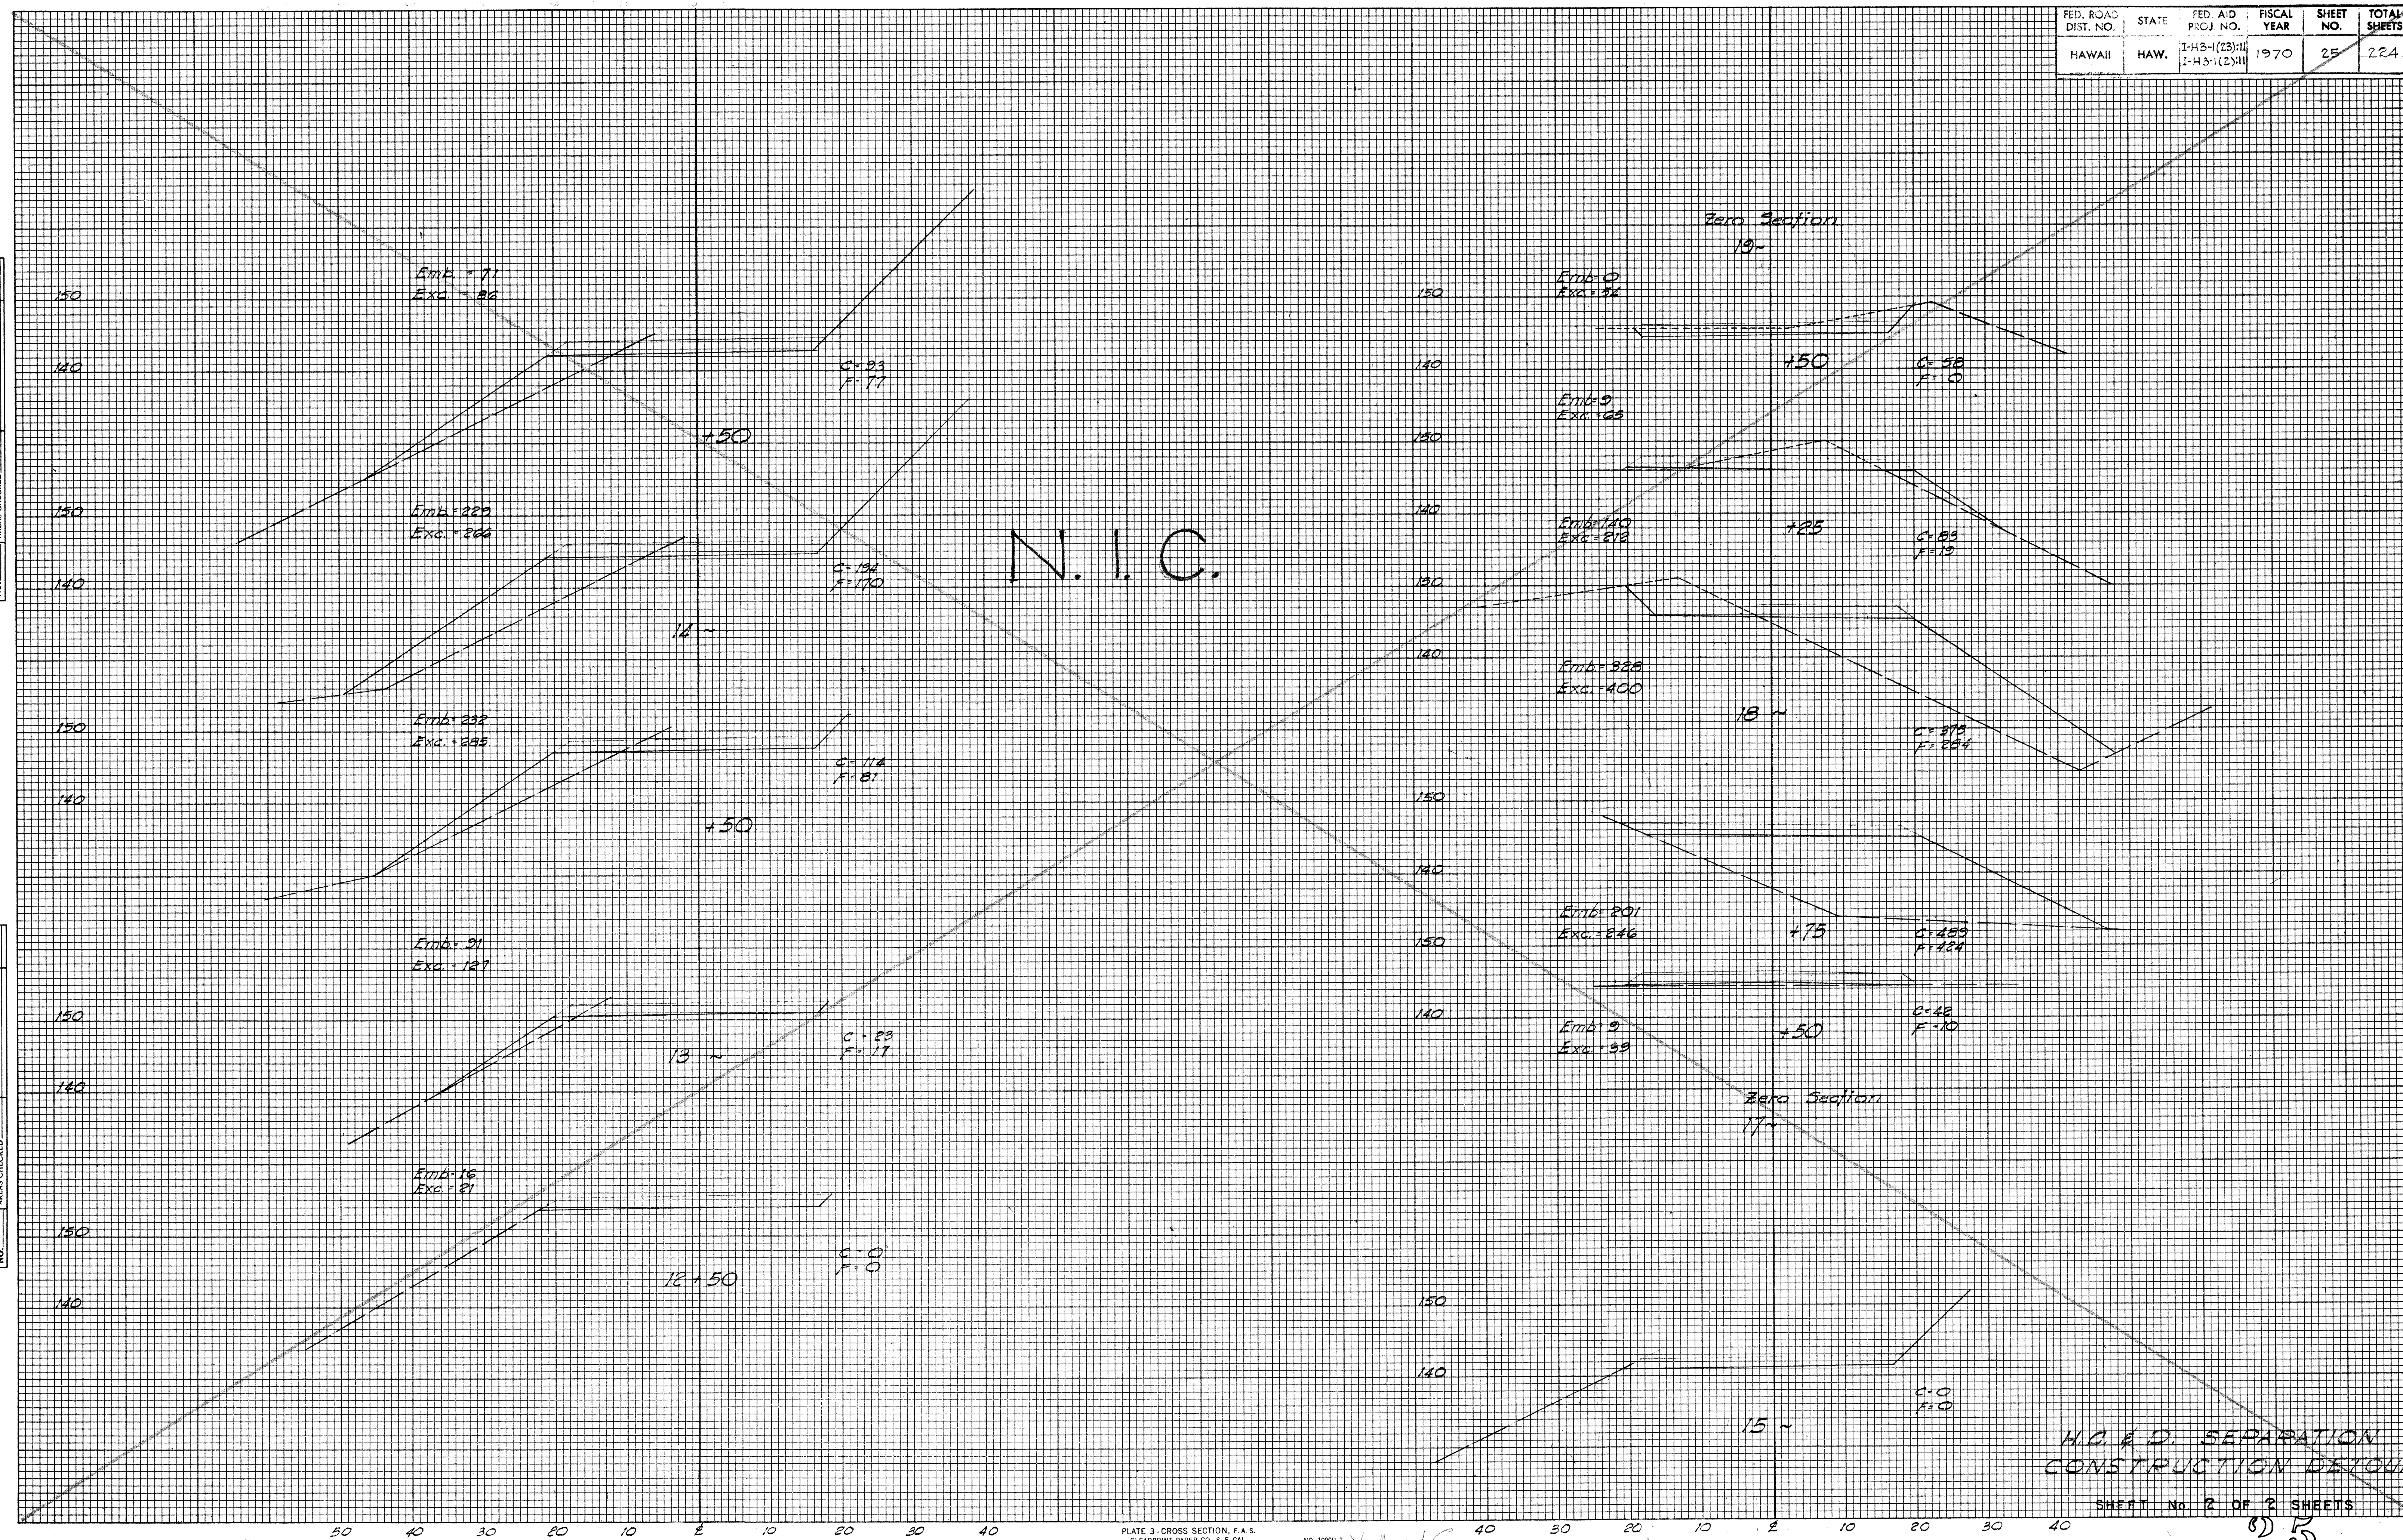


PLATE 3. CROSS SECTION, F.A.S.
CLEARPRINT PAPER CO., S.F. CAL.

NO. 1000H-3

H.O. & D. SEPARATION
CONSTRUCTION DETOUR

SHEET No. 2 OF 2 SHEETS

25