



FED. ROAD DIST. NO.	STATE	FED. AID PROJ. NO.	FISCAL YEAR	SHEET NO.	TOTAL SHEETS
HAWAII	HAW.	I-H3-1(7):13 I-H3-1(2):8	1968	13	86

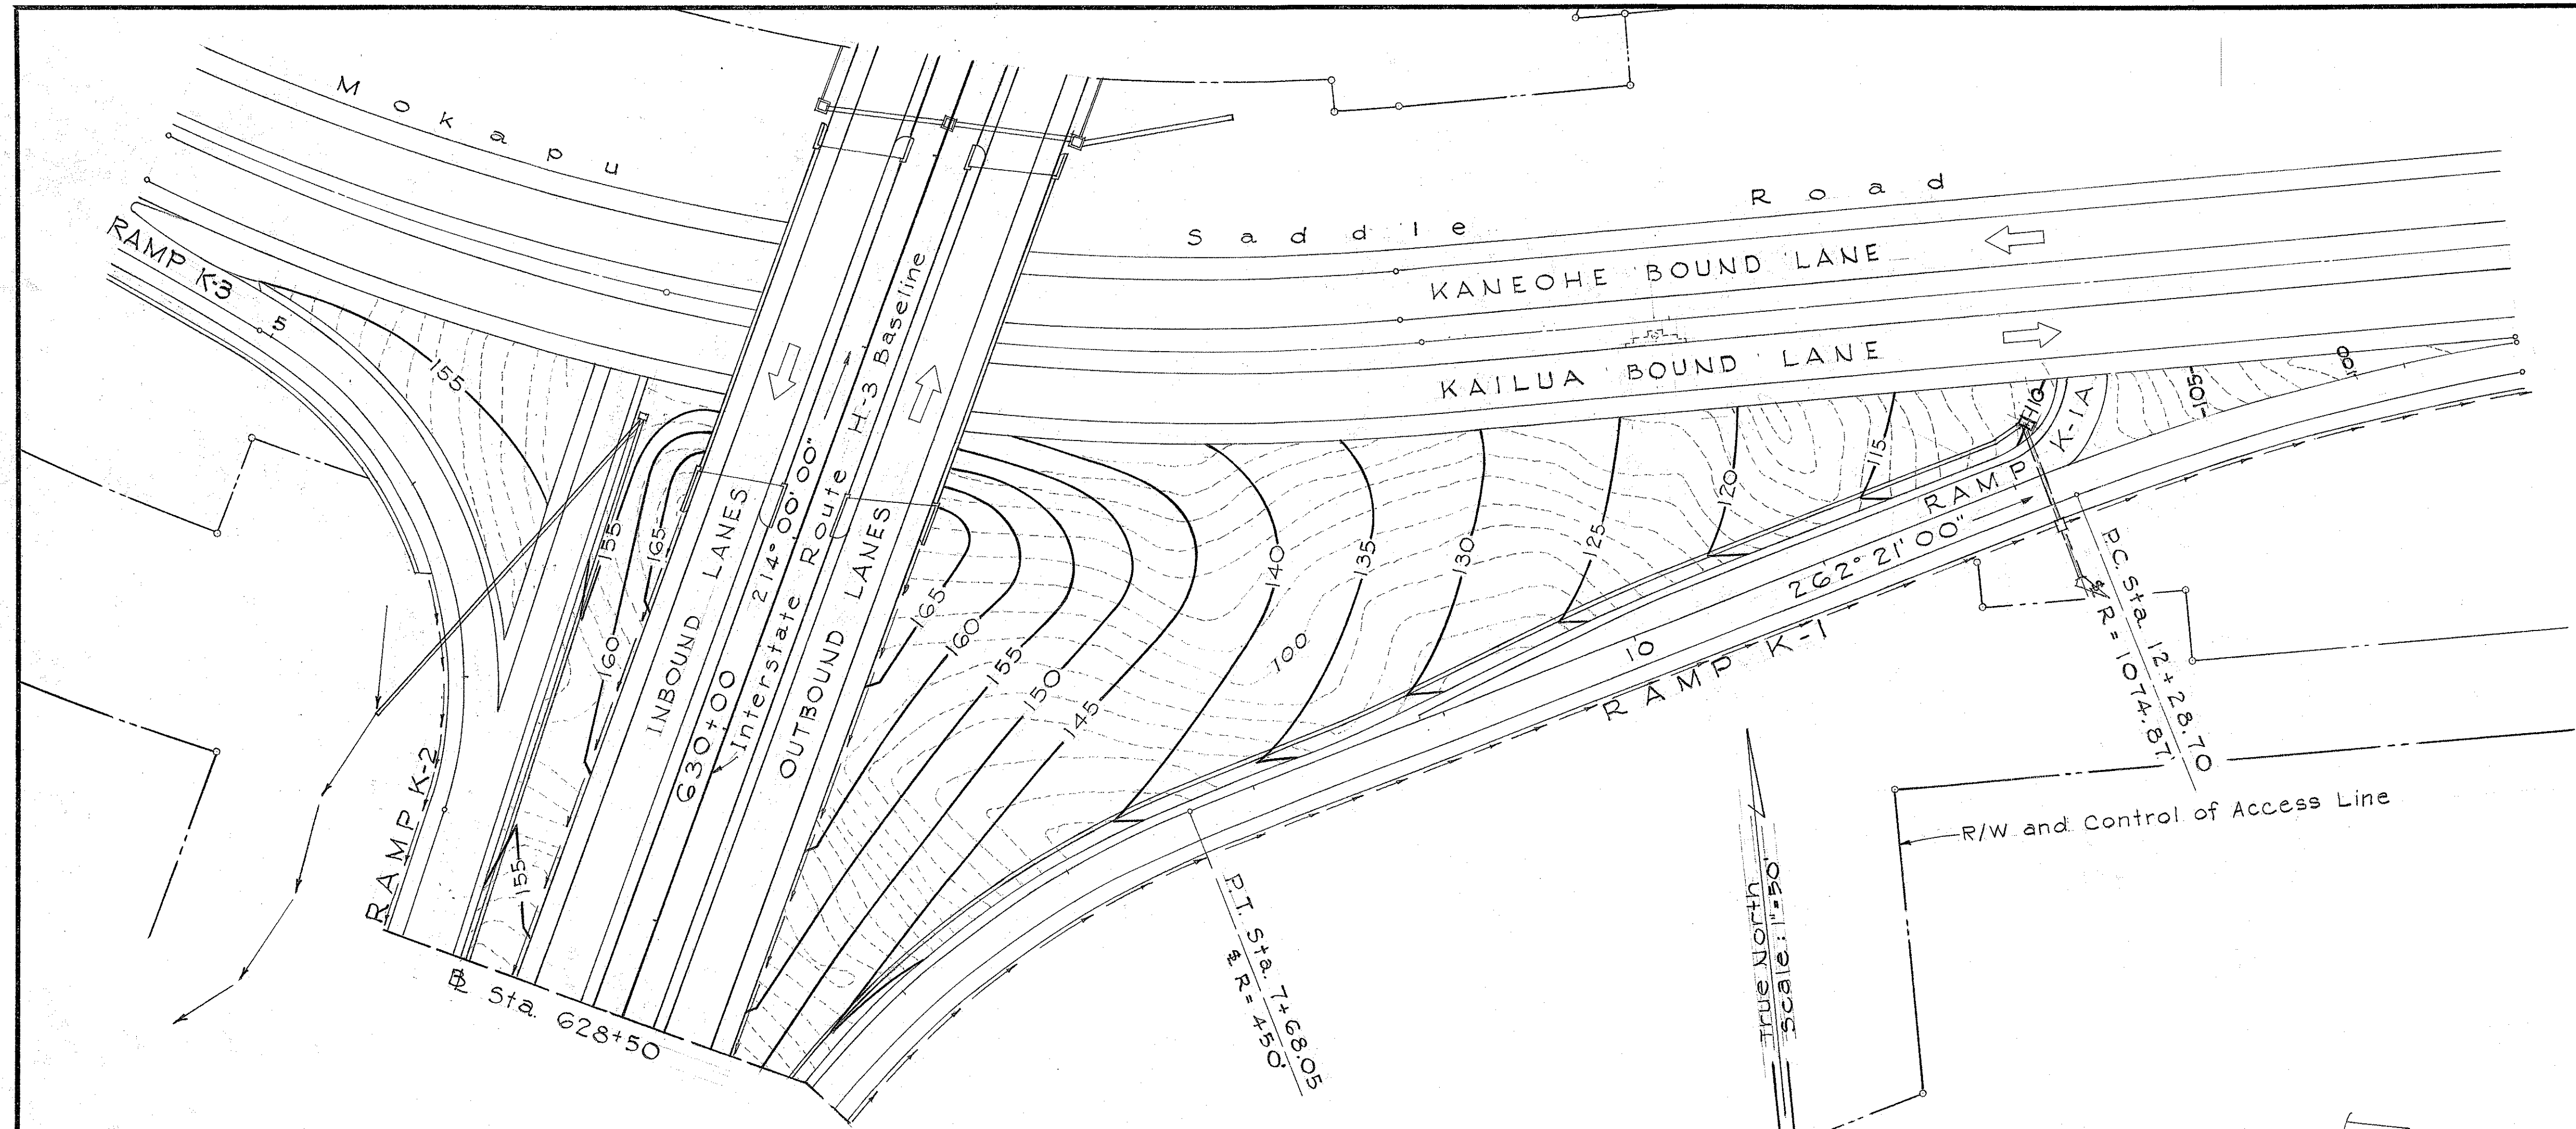


KAILUA INTERCHANGE GRADING PLAN
Scale: 1"=50'

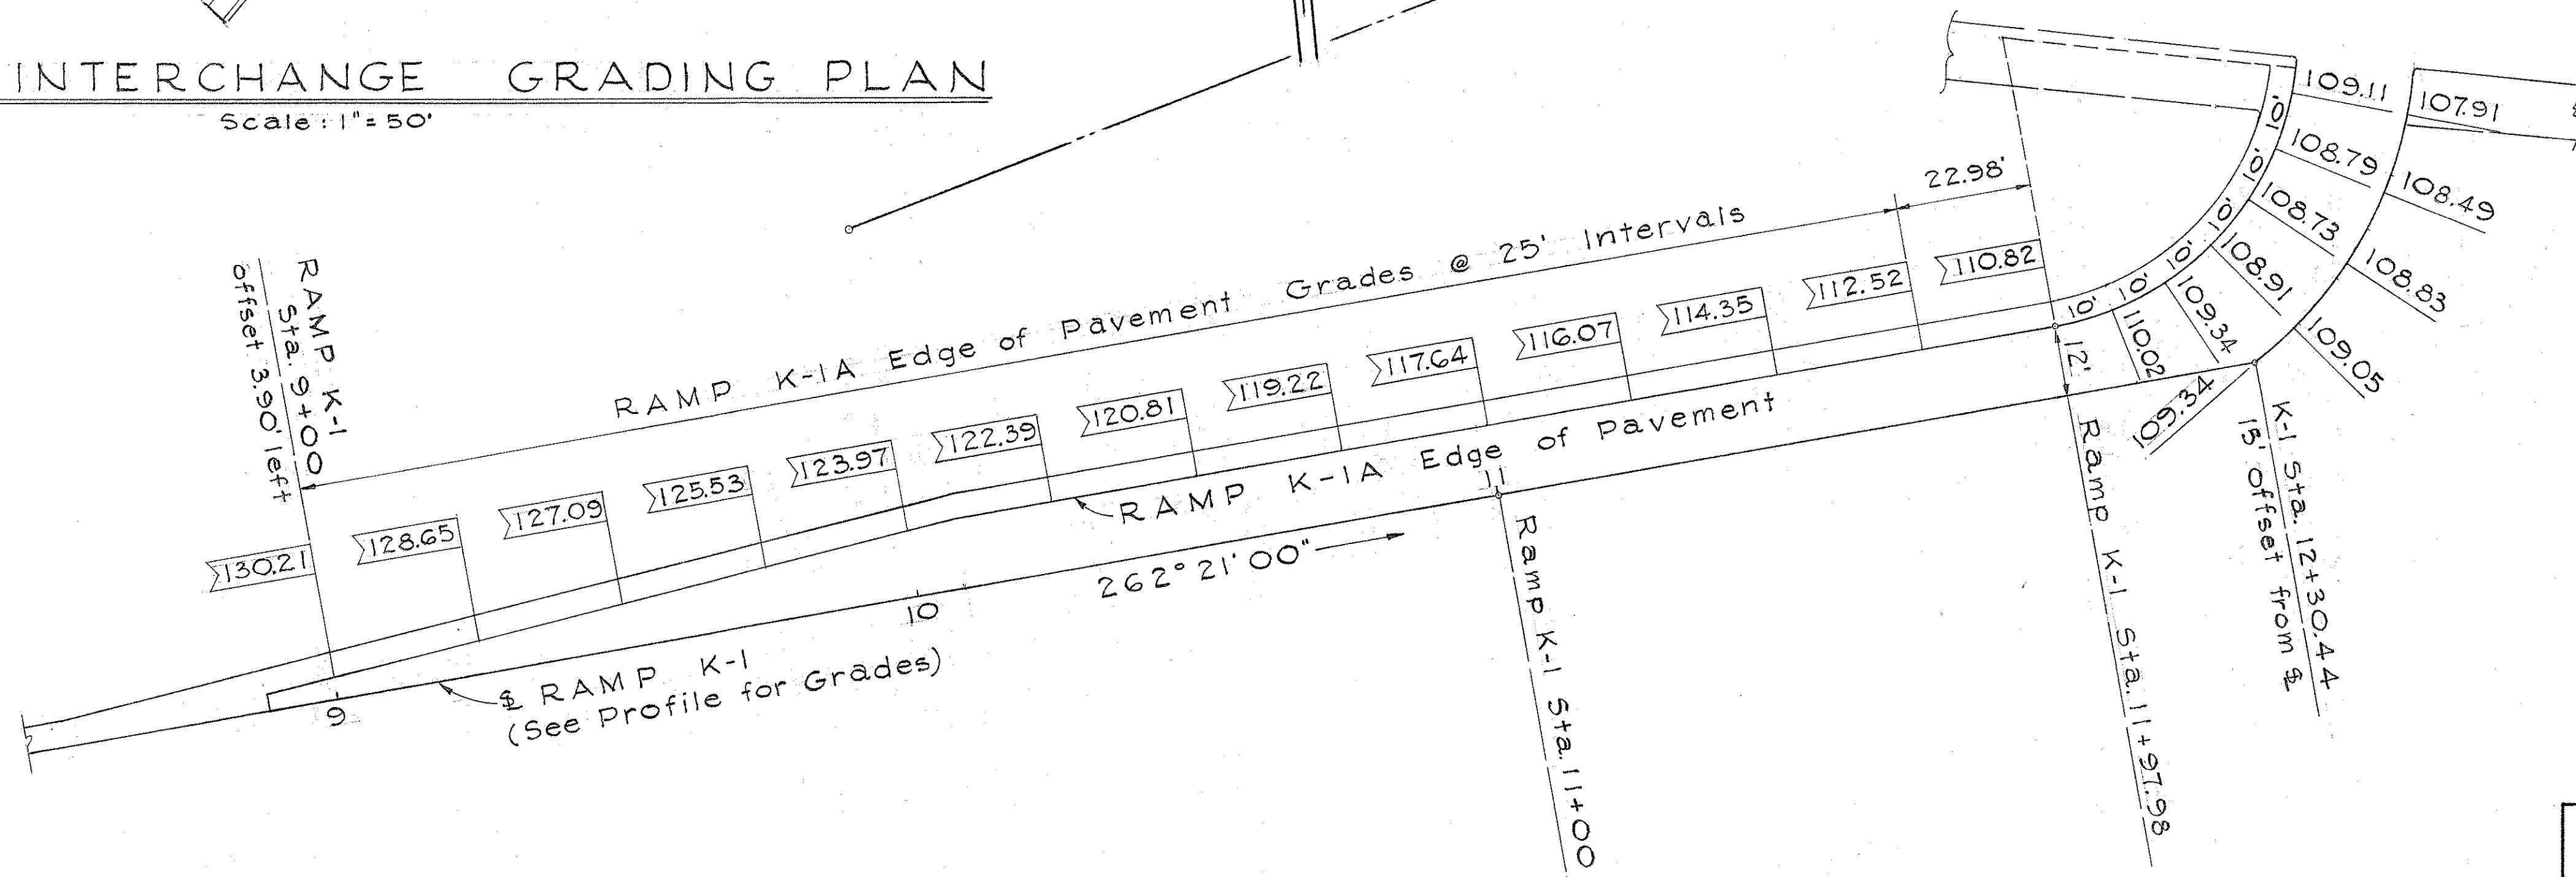

RAMP K-1A GRADING PLAN
Scale: 1"=20'

DATE	_____
DESIGNED BY	_____
CHECKED BY	_____
NOTED BY	_____
NO.	_____

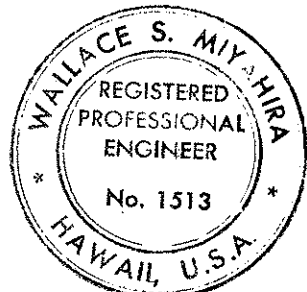

This work was prepared by me or under my supervision.
Wallace S. Miyahira

STATE OF HAWAII
DEPARTMENT OF TRANSPORTATION
HIGHWAYS DIVISION

KAILUA INTERCHANGE
GRADING PLAN

FA.I. Proj. No. I-H3-1(7):13, I-H3-1(2):8
Scale: As Shown Date: Jan. 1968
SHEET No. 13 OF 86 SHEETS