


FED. ROAD DIST. NO.	STATE	FED. AID PROJ. NO.	FISCAL YEAR	SHEET NO.	TOTAL SHEETS
HAWAII	HAW.	I-H3-1(7):13 I-H3-1(2):8	1968	43	86



KAILUA SEPARATION
DATE _____
For additional information
see sheet #54 & #55.

DESIGNED BY	DATE
DRAWN BY	
CHECKED BY	
NOTED BY	
APPROVED BY	

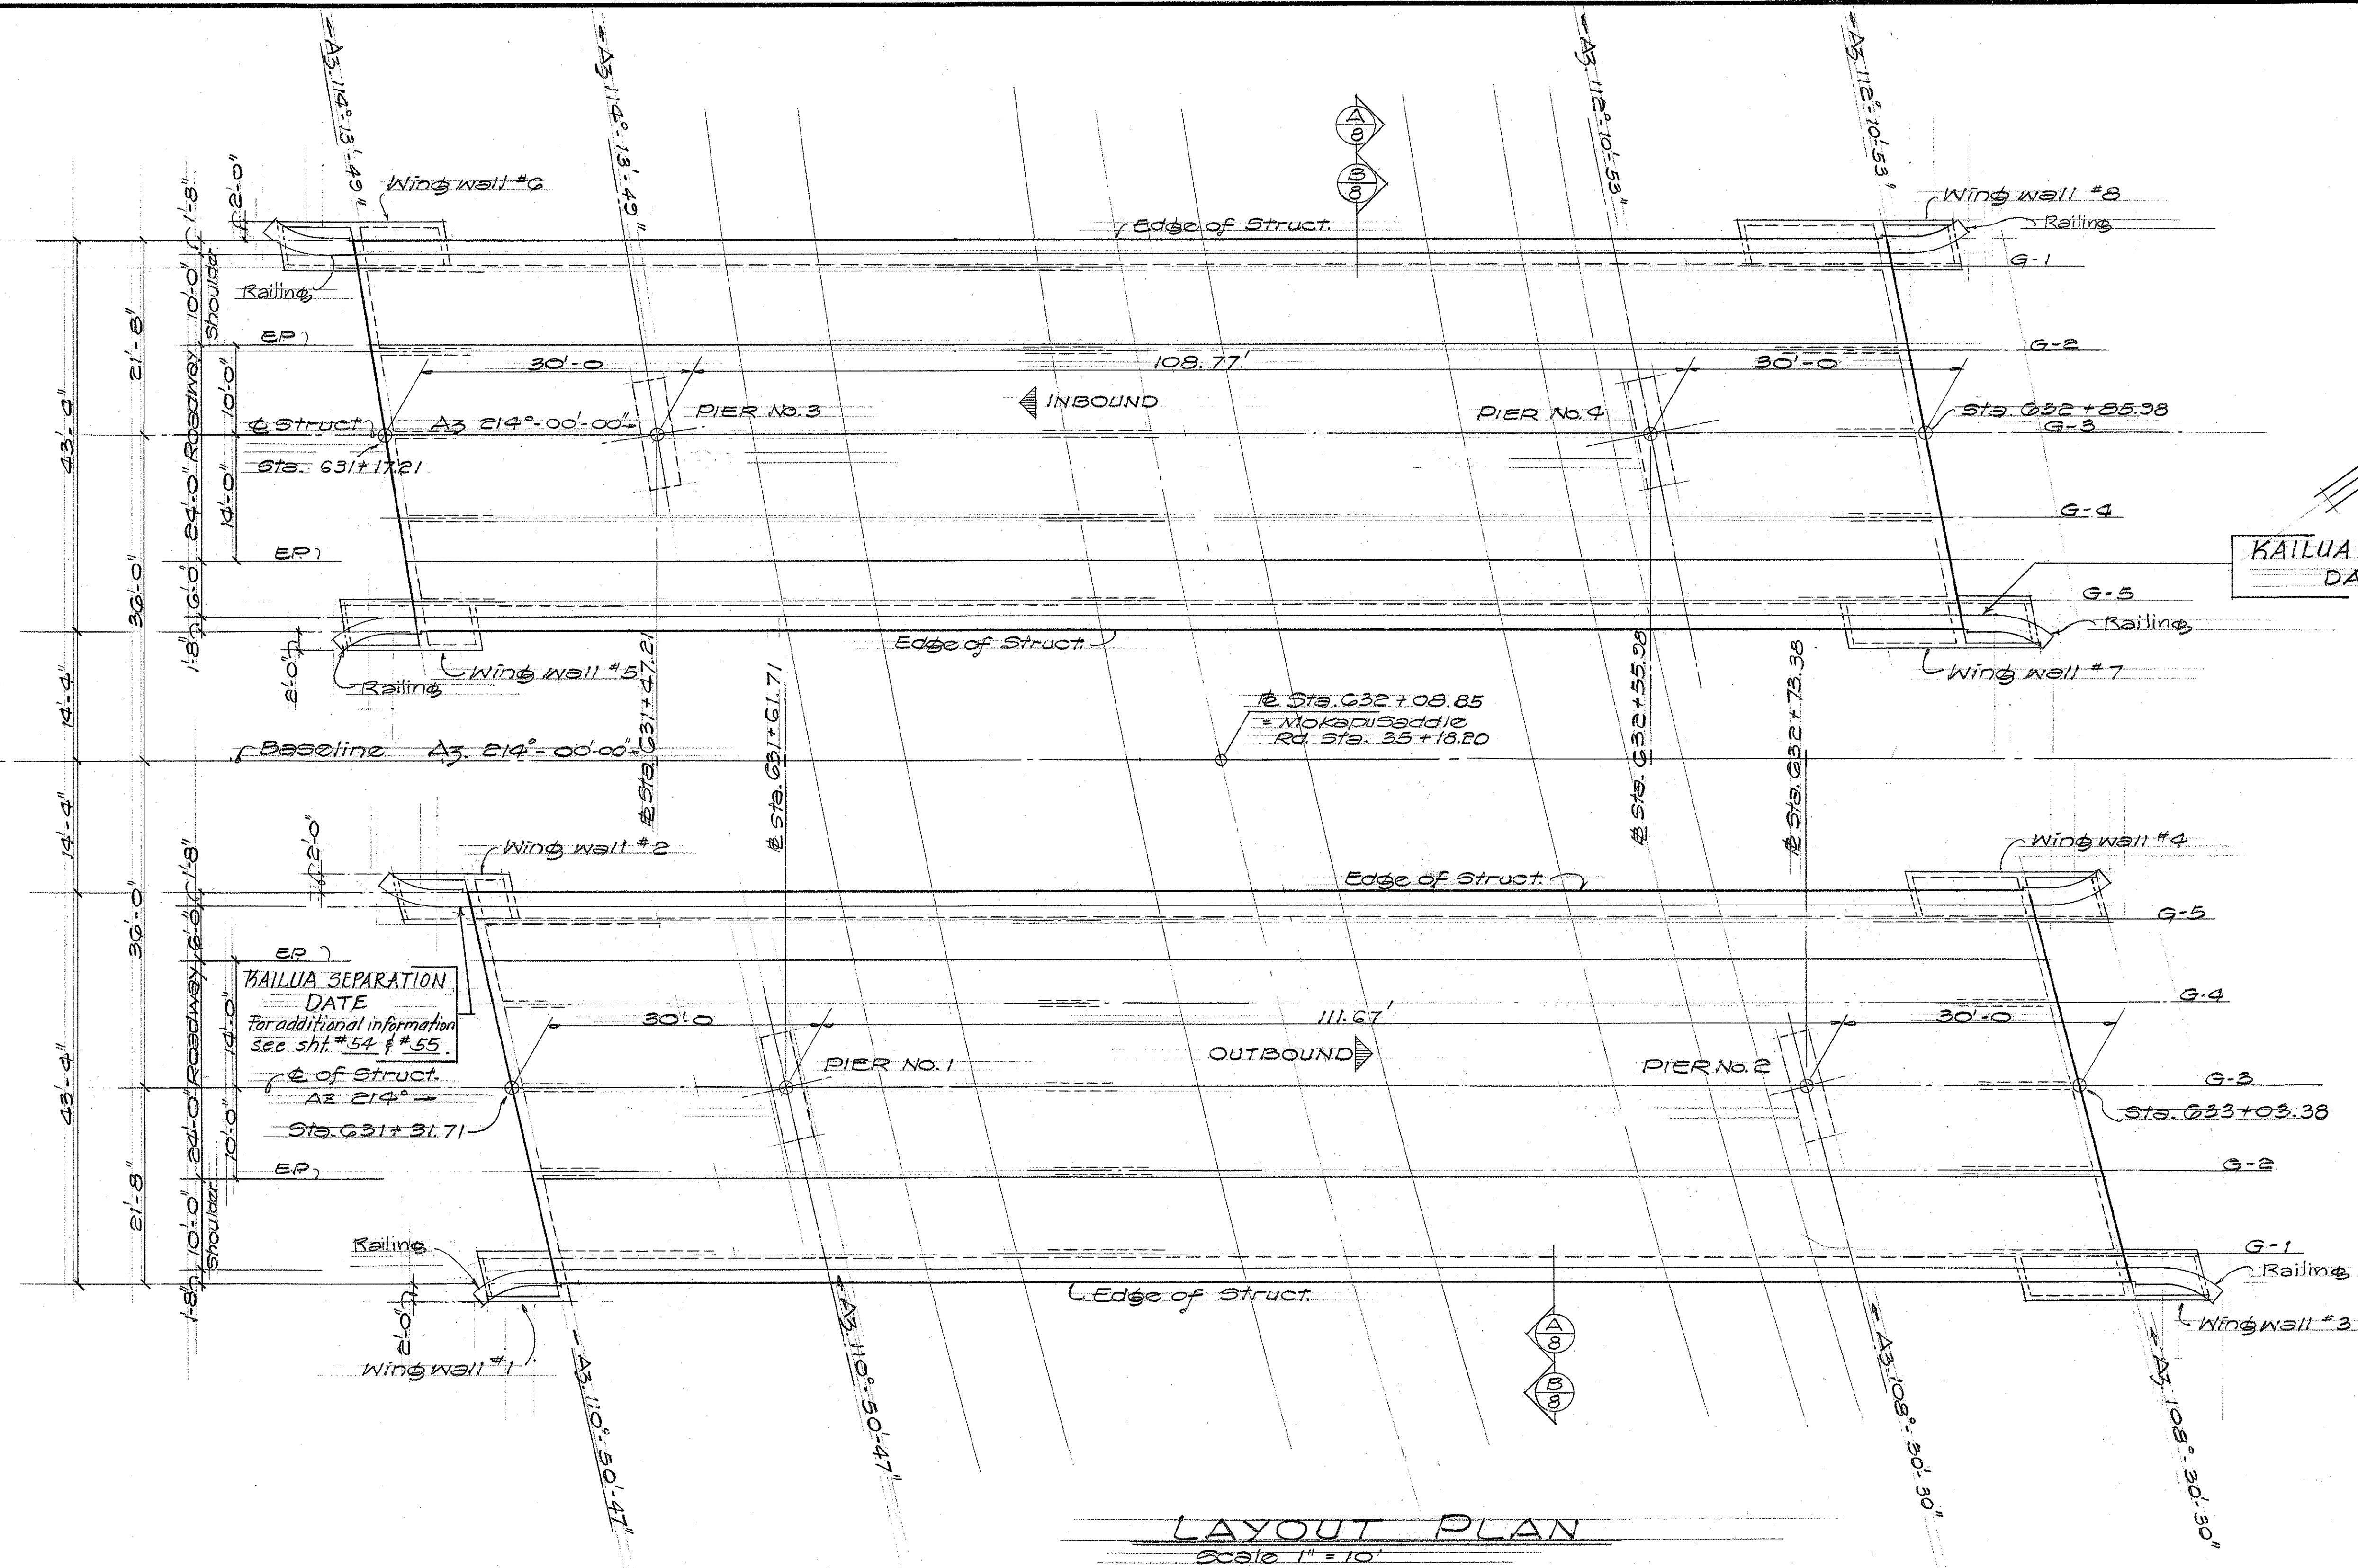

This work was prepared by me
or under my supervision.
Kuan Doo Park

STATE OF HAWAII
DEPARTMENT OF TRANSPORTATION
HIGHWAYS DIVISION

**KAILUA INTERCHANGE
STRUCTURE
LAYOUT PLAN**

F.A.I. Proj. No. I-H3-1(7):13, I-H3-1(2):8
SCALE: AS SHOWN DATE: NOV. 1967


SHEET No. 1 OF 13 SHEETS

430 126

BORING LOG and PLOT PLAN

FED. ROAD DIST. NO.	STATE	FED. AID PROJ. NO.	FISCAL YEAR	SHEET NO.	TOTAL SHEETS
HAWAII	HAW.	145-1(2)8	1968	44	86

BORING S-16 AUG. 1, 1967 95 Firm brown silty clay w/ traces of gravel 90 Unweathered dense basalt rock (frac.) 80 70 Unweathered dense basalt rock 65	BORING S-19 AUG. 10, 1967 180 Firm brown clay Firm yellow-brown silty clay Highly weathered rock 170 Highly weathered rock (frac.) Stiff brown silty clay & highly wea. gravel 160 Highly weathered rock Slightly weathered dense basalt rock (frac.) 150 Moderate weathered dense basalt rock (frac.) Highly & slightly wea. dense basalt rock (frac.) 140 Slightly weathered dense basalt rock (frac.) 130 Moderate weathered dense basalt rock (frac.) 120	BORING S-21 JULY 31, 1967 125 120 Firm brown silty clay 110 Very stiff gray silty clay Moderate & highly wea. dense basalt boulder 100 Very stiff brown silty clay w/ few highly weathered gravel Highly weathered rock 90 Mod. & highly weathered dense basalt rock 80 Highly weathered rock	BORING S-23 AUG. 10, 1967 200 Firm brown silty clay & highly weathered gravel Highly weathered rock 190 Highly weathered rock (frac.) Highly & mod. wea. dense basalt rock (frac.) 180 Slightly & mod. wea. dense basalt rock (frac.) Mod. weathered dense basalt rock (frac.) 170 Slightly weathered dense basalt rock (frac.) Slightly weathered dense basalt rock 160 155
BORING S-17 JULY 28, 1967 120 Firm brown silty clay 110 Stiff gray silty clay 100 Very stiff gray silty clay 90 Highly weathered rock Highly & mod. weathered dense basalt rock (frac.) 80 Unweathered dense basalt rock 75	BORING S-20 AUG. 10, 1967 200 Stiff light brown silty clay Highly wea. rock & stiff light brown silty clay 190 Highly wea. rock & stiff light brown silty clay w/ moderate wea. rock 180 Very stiff brown silty clay w/ some highly wea. rock Very stiff light brown clay Moderate & slightly wea. frac. rock 170 Highly weathered rock Unweathered dense frac. rock Highly weathered frac. rock 160 Unweathered dense frac. rock 150	BORING S-22 AUG. 16, 1967 185 180 Firm brown silty clay Silty brown silty clay & highly wea. gravel 170 160 Unweathered dense basalt rock w/ some highly weathered rock (frac.) 150 140 Unweathered dense basalt rock (frac.) 130 120 115	
BORING S-18 AUG. 1, 1967 125 120 Firm brown silty clay 110 Very stiff brown silty clay Highly weathered rock 100 Moderate weathered dense basalt rock (frac.) 90			

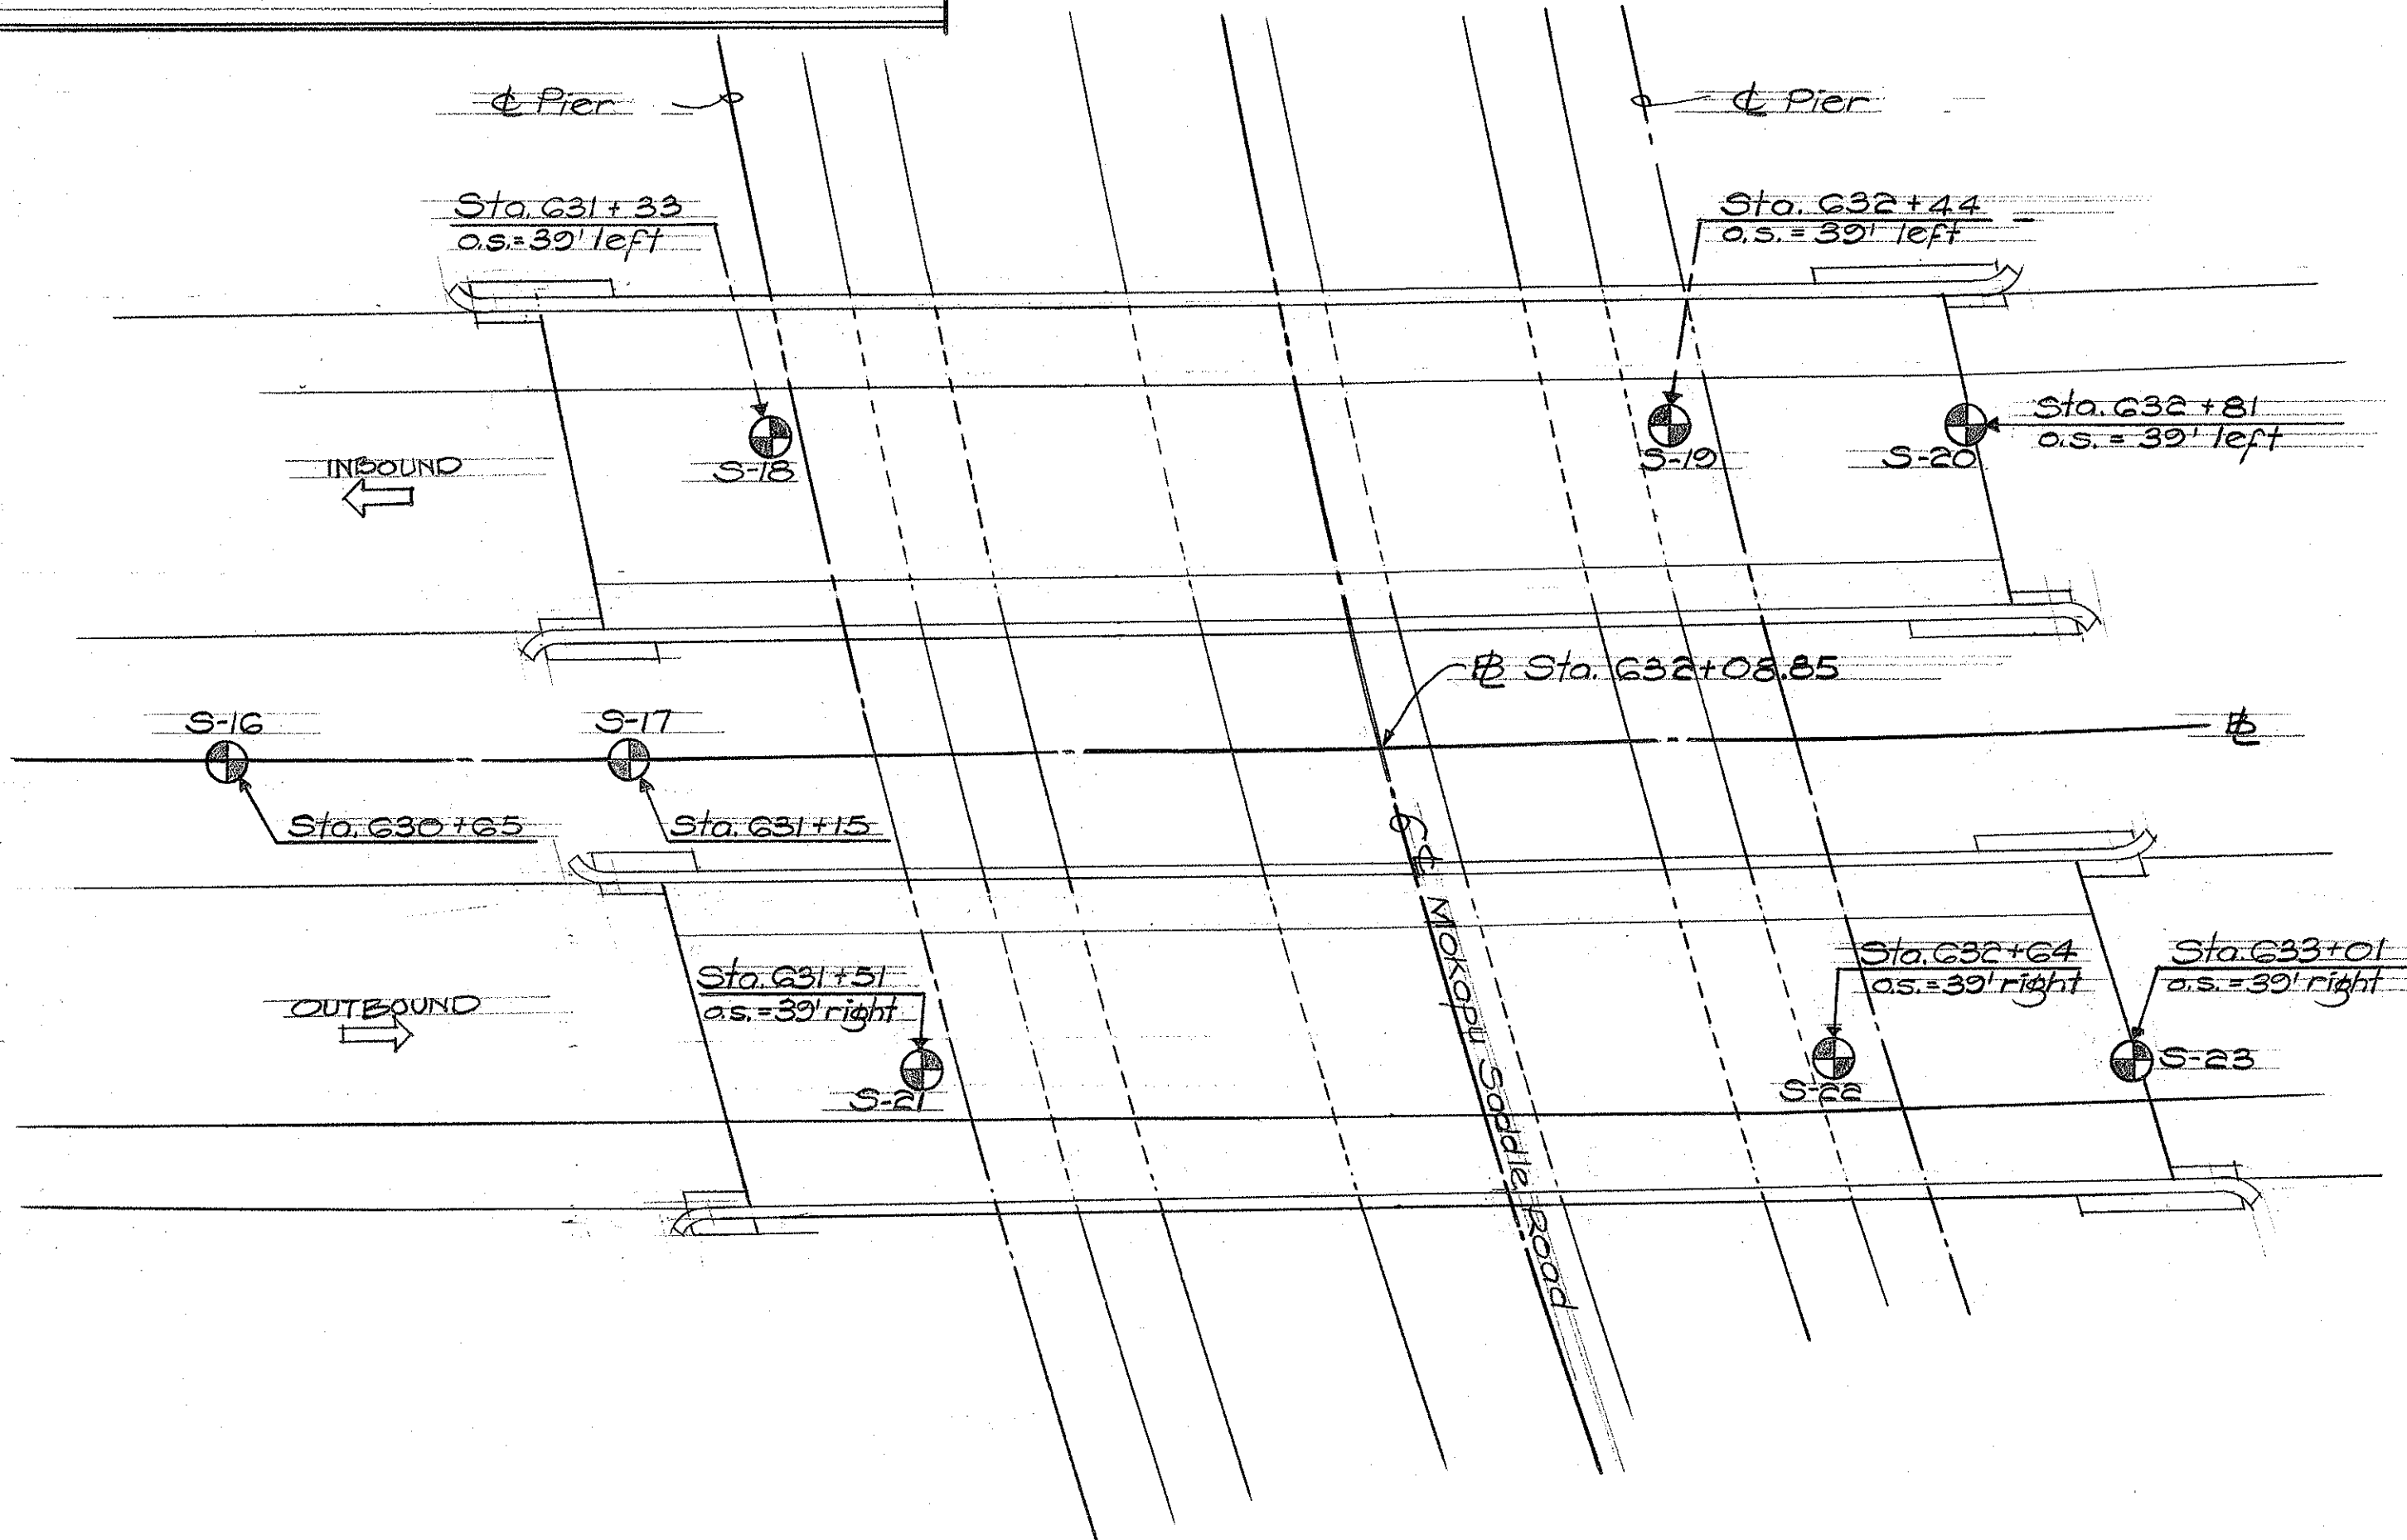

BORING PLOT PLAN



This work was prepared by me or under my supervision.
Kwan Doo Park



STATE OF HAWAII
DEPARTMENT OF TRANSPORTATION
HIGHWAYS DIVISION

KAILUA INTERCHANGE
STRUCTURE
BORING LOG & PLOT PLAN


F.A.I. Proj. No. I-H3-1(7):13, I-H3-1(2):8
SCALE: AS SHOWN
DATE: 3 NOV. 1967

SHEET No. 2 OF 13 SHEETS

ORIGINAL PLAN	SURVEY PLOTTED BY	DATE
DESIGNED BY		
NOTED BY		
CHECKED BY		

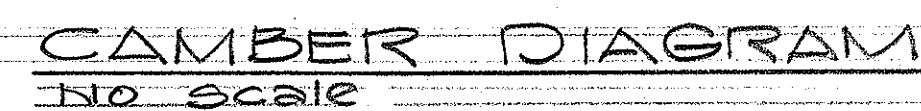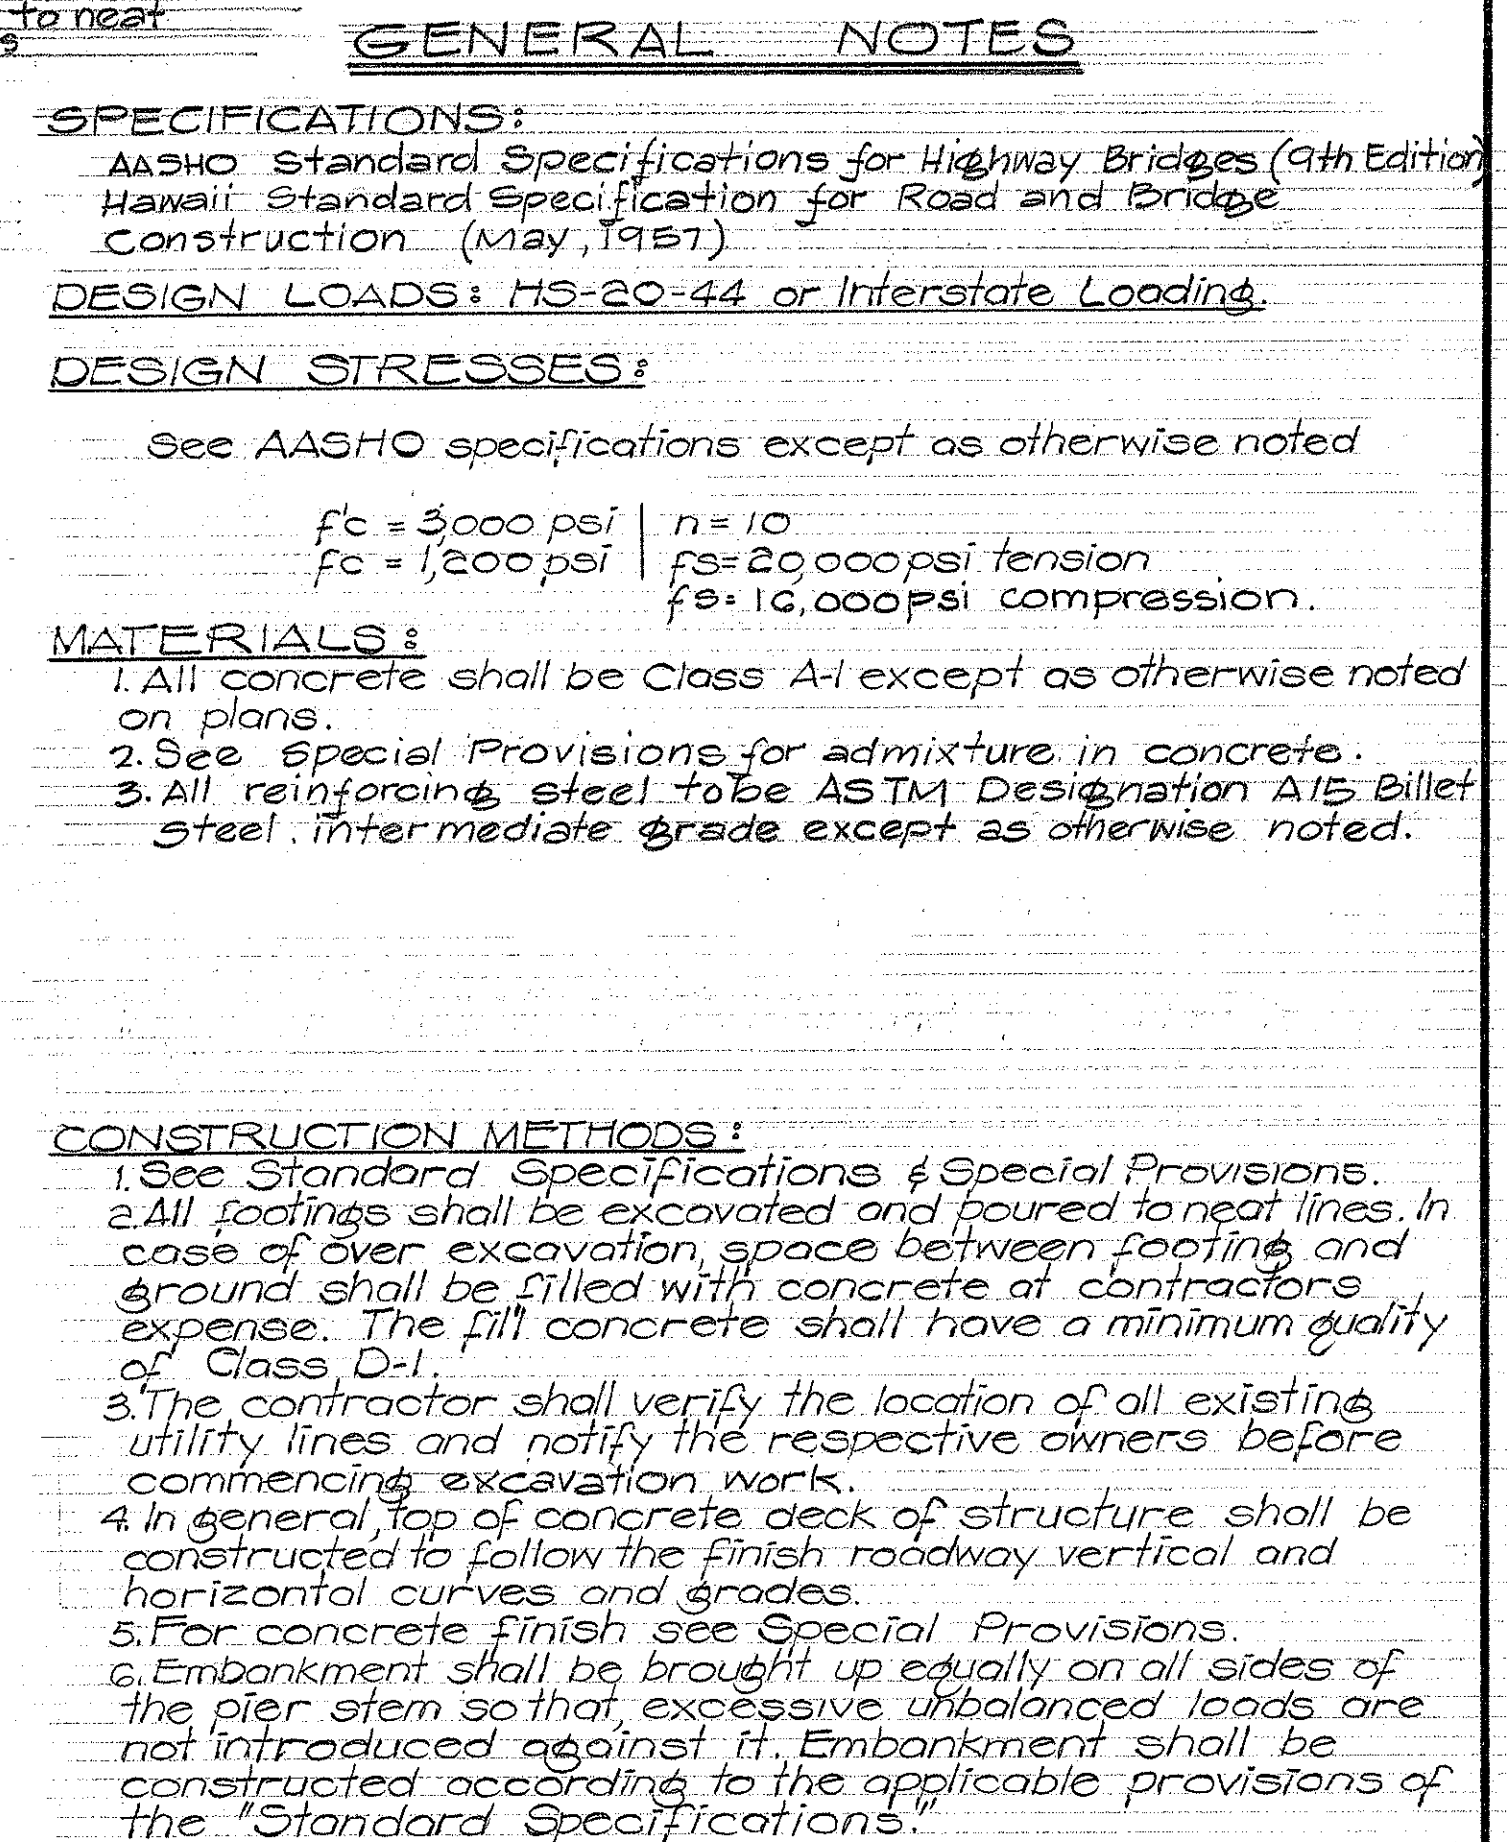[illegible]

ORIGINAL PLAN	SURVEY PLOTTED BY _____	DATE _____
NOTE BOOK	DRAWN BY _____	" _____
	TRACED BY _____	" _____
	DESIGNED BY _____	" _____
	QUANTITIES BY _____	" _____
No. _____	CHECKED BY _____	" _____

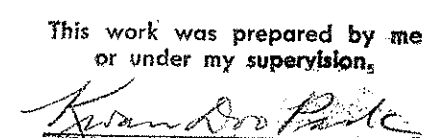


KAILUA INTERCHANGE STRUCTURE LONGITUDINAL SECTION


SCALE: AS SHOWN DATE: NOV. 1967

SHEET No. 3 OF 13 SHEETS

FED. ROAD DIST. NO.	STATE	FED. AID PROJ. NO.	FISCAL YEAR	SHEET NO.	TOTAL SHEETS
HAWAII	HAW.	I-H3-1(7):13 I-H3-1(2):8	1968	46	86

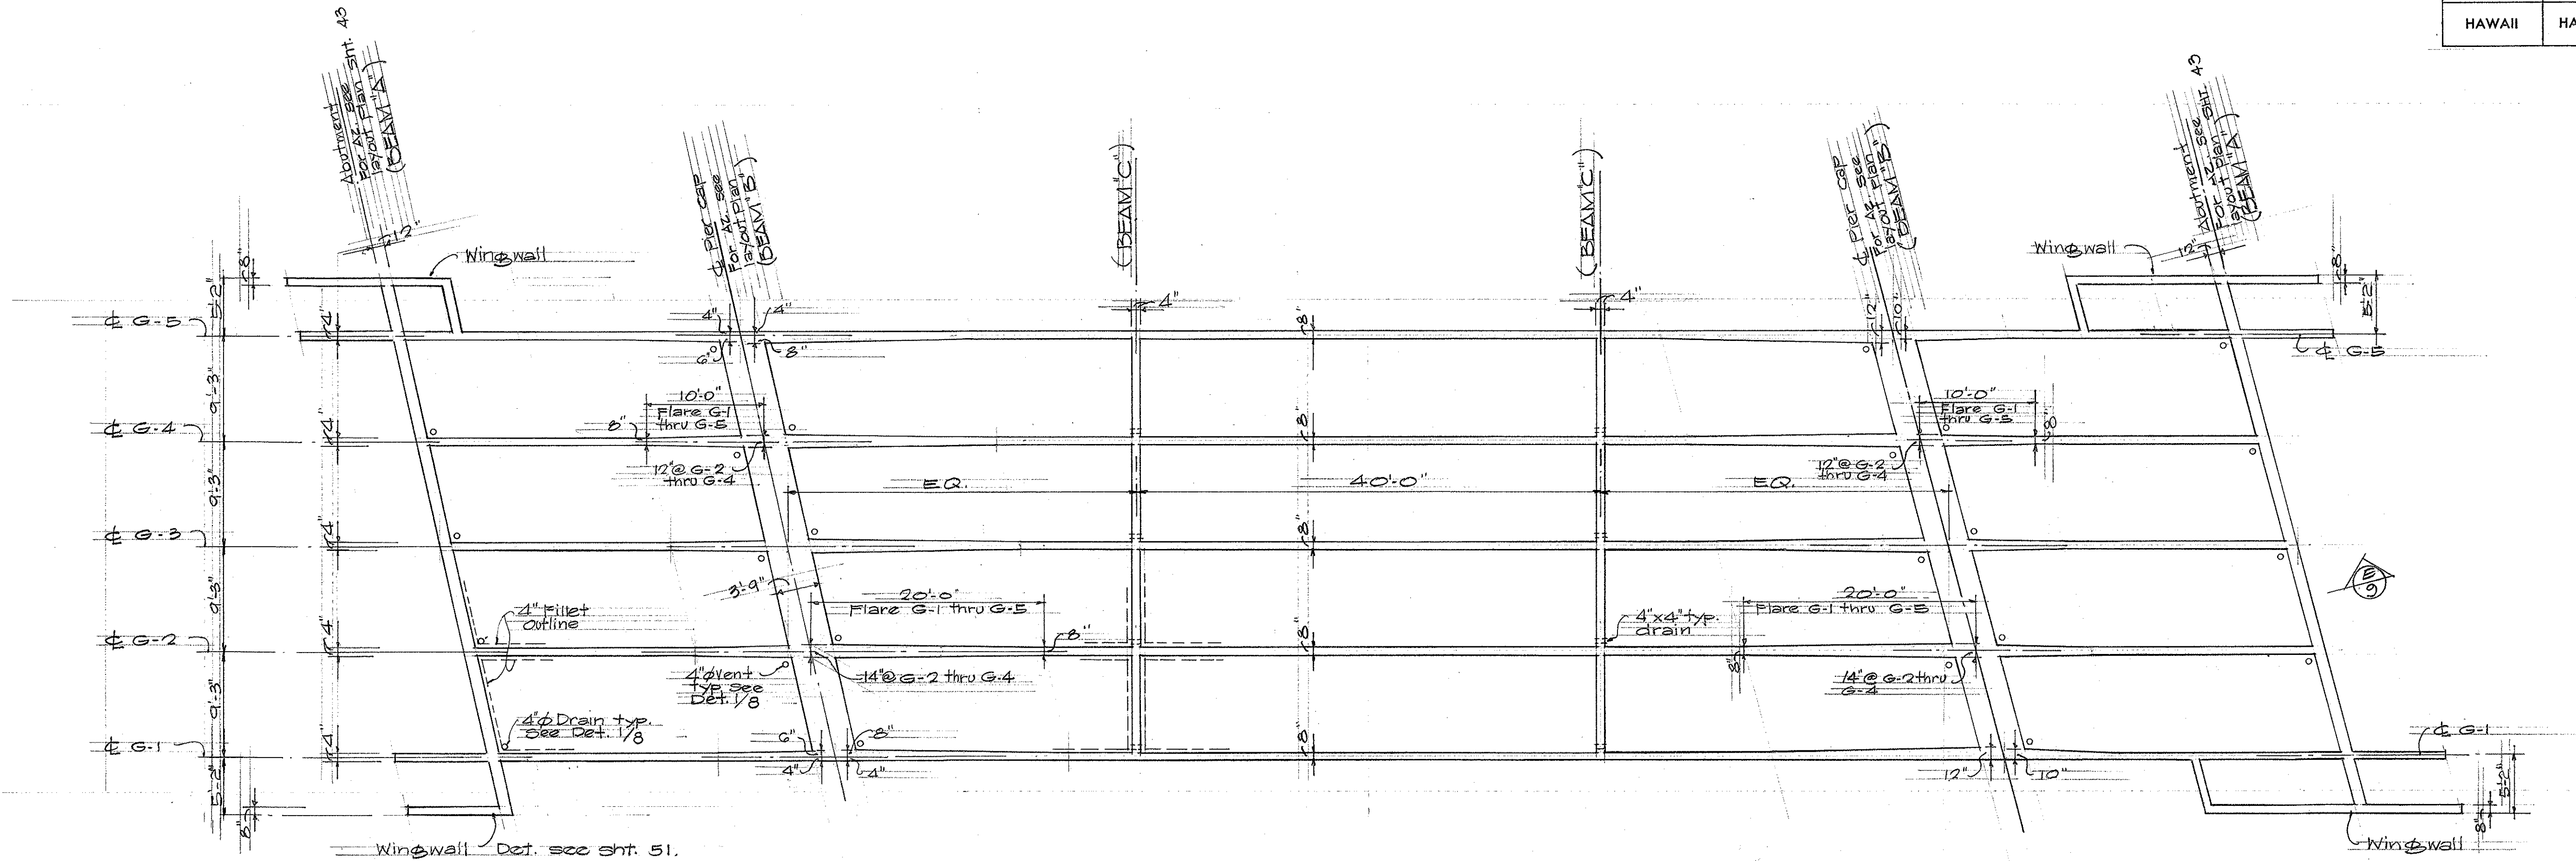


GIRDER FRAMING PLAN OUTBOUND AS SHOWN
Inbound similar, except opposite hand & as otherwise noted

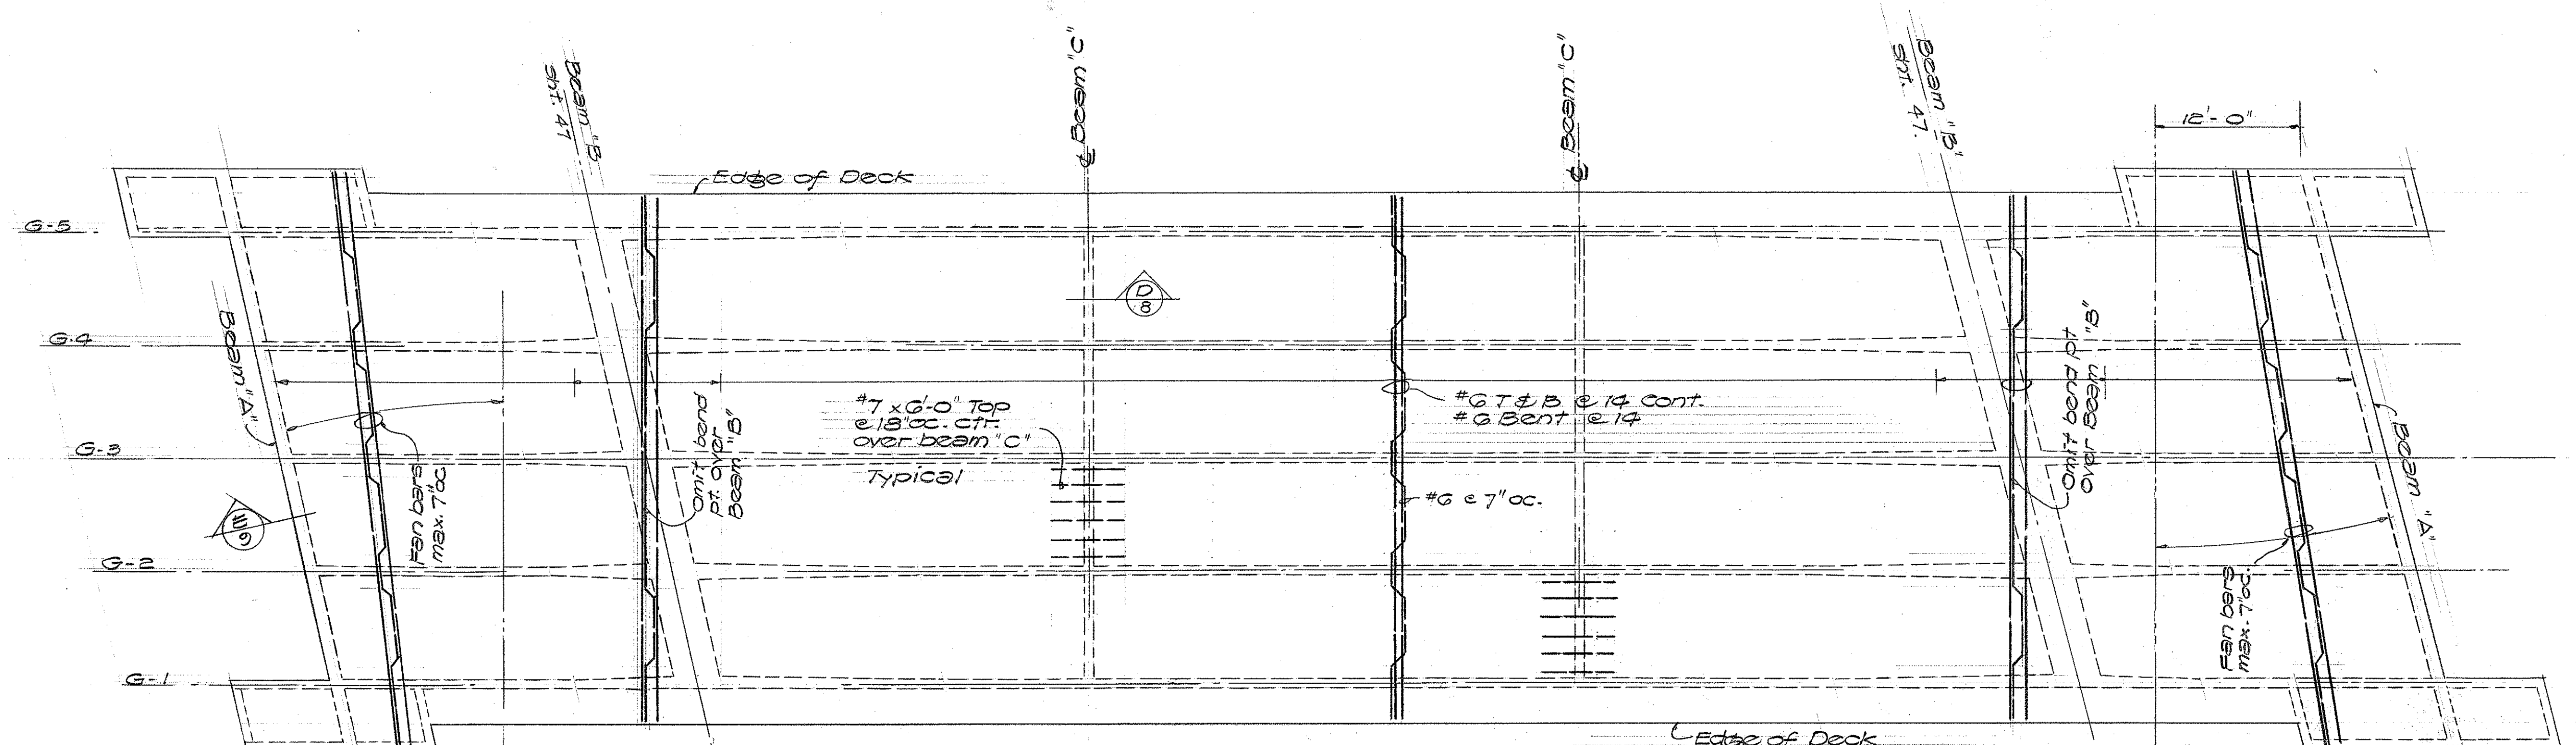

TOP FLANGE - TRANSVERSE REINF. PLAN
Scale: 1/8" = 1'-0"

DATE	BY
DESIGNED BY	
CHECKED BY	
NOTED BY	
ORIGINAL PLAN	

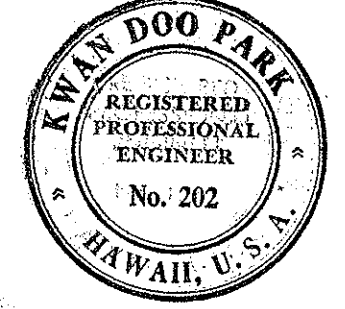

This work was prepared by me or under my supervision.
Kwan Doo Park

STATE OF HAWAII
DEPARTMENT OF TRANSPORTATION
HIGHWAYS DIVISION














**KAILUA INTERCHANGE
STRUCTURE**

FRAMING & REINFORCING PLAN

F.A.I. Proj. No. I-H3-1(7):13, I-H3-1(2):8
SCALE: AS SHOWN DATE: NOV. 1967


SHEET No. 4 OF 13 SHEETS

FED. ROAD DIST. NO.	STATE	FED. AID PROJ. NO.	FISCAL YEAR	SHEET NO.	TOTAL SHEETS
HAWAII	HAW.	F-H3-1(7):13 F-H3-1(2):8	1968	47	86

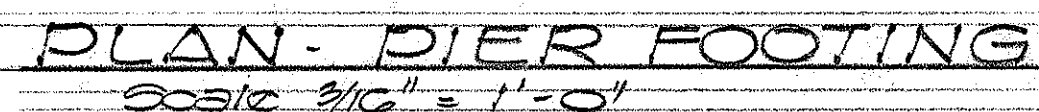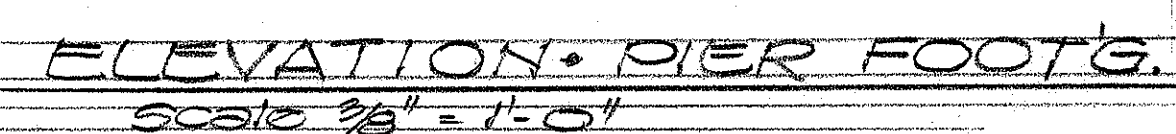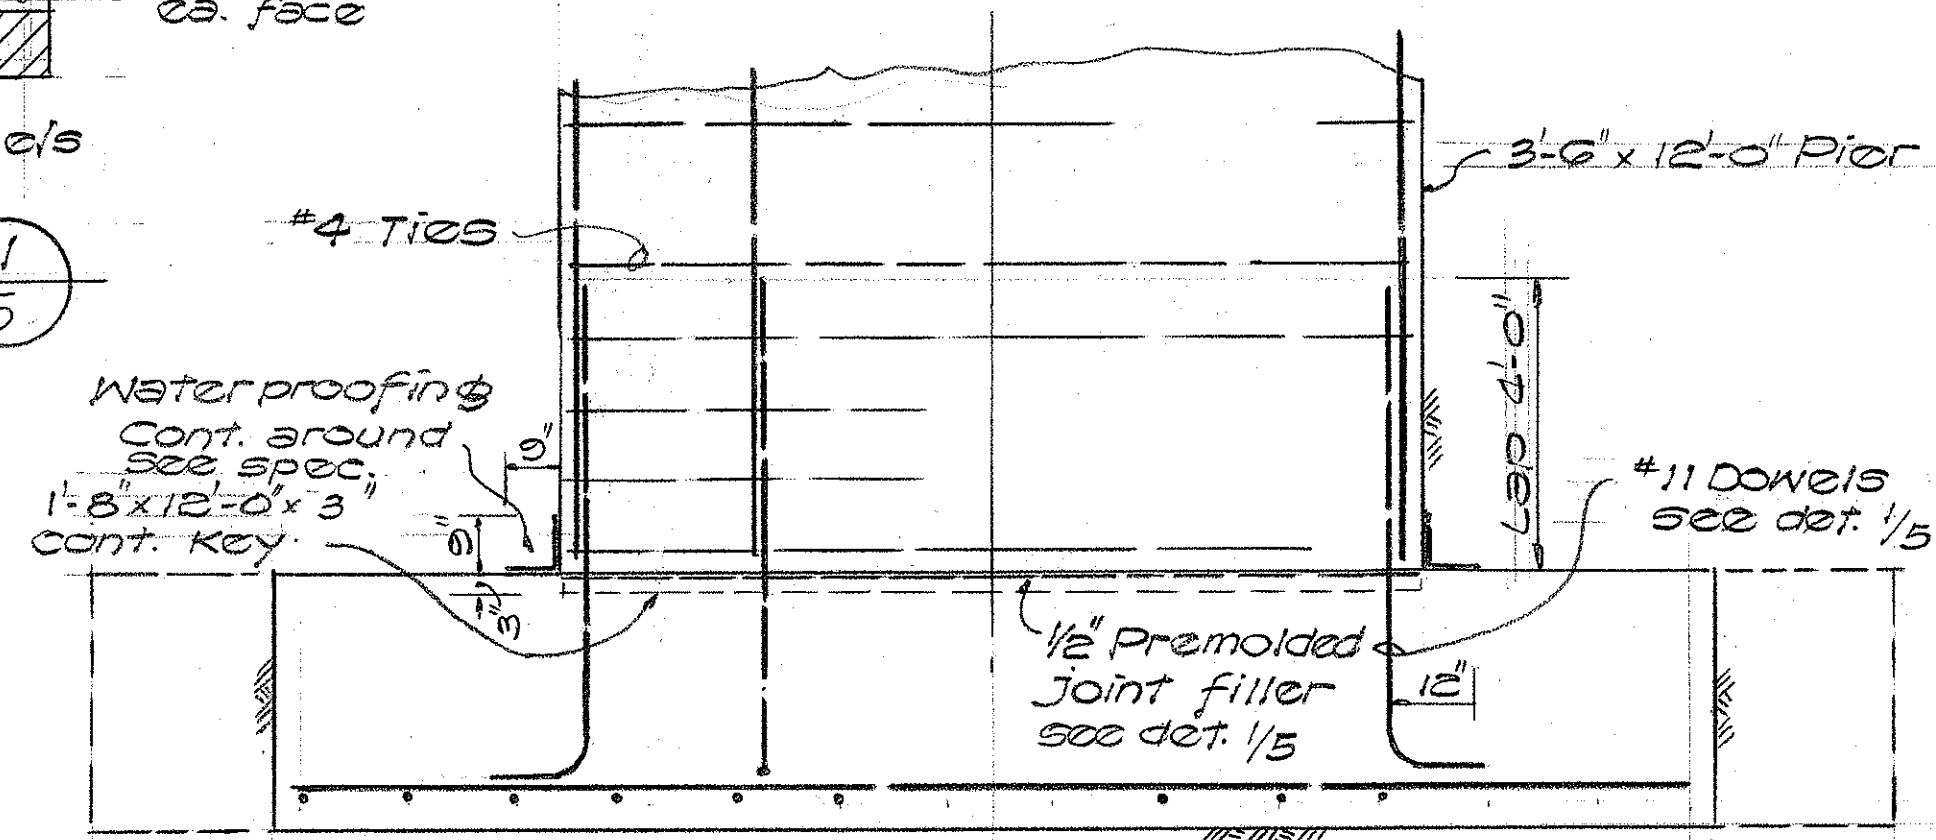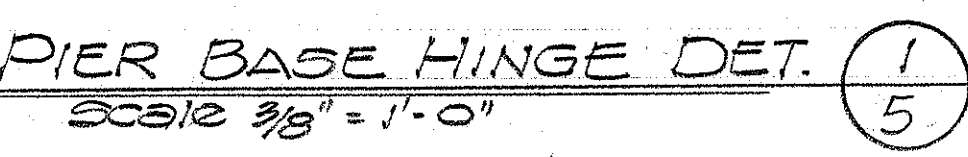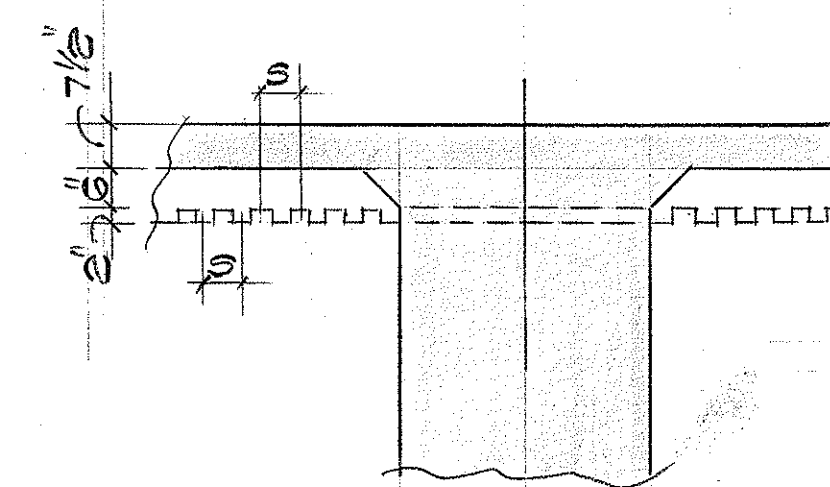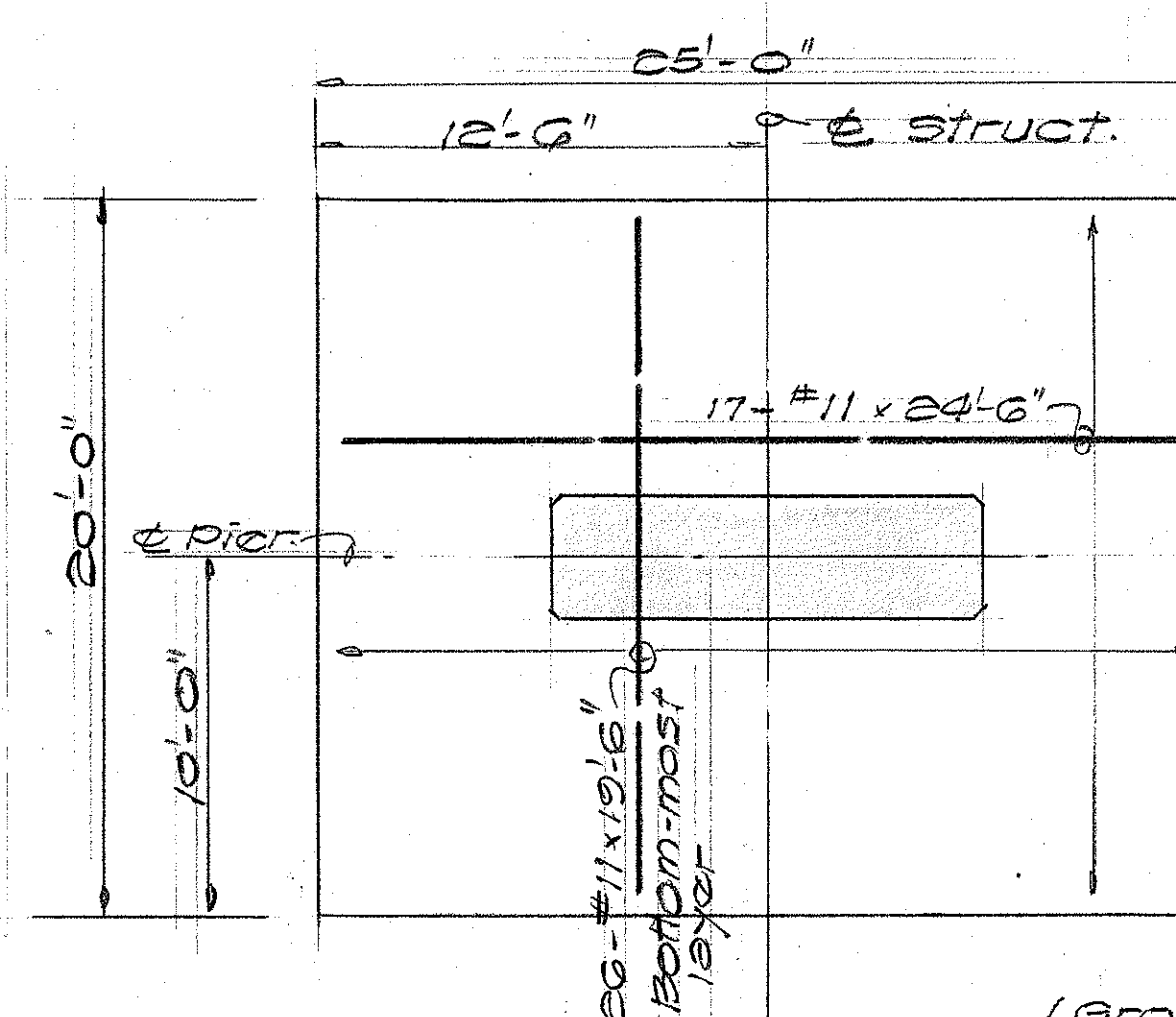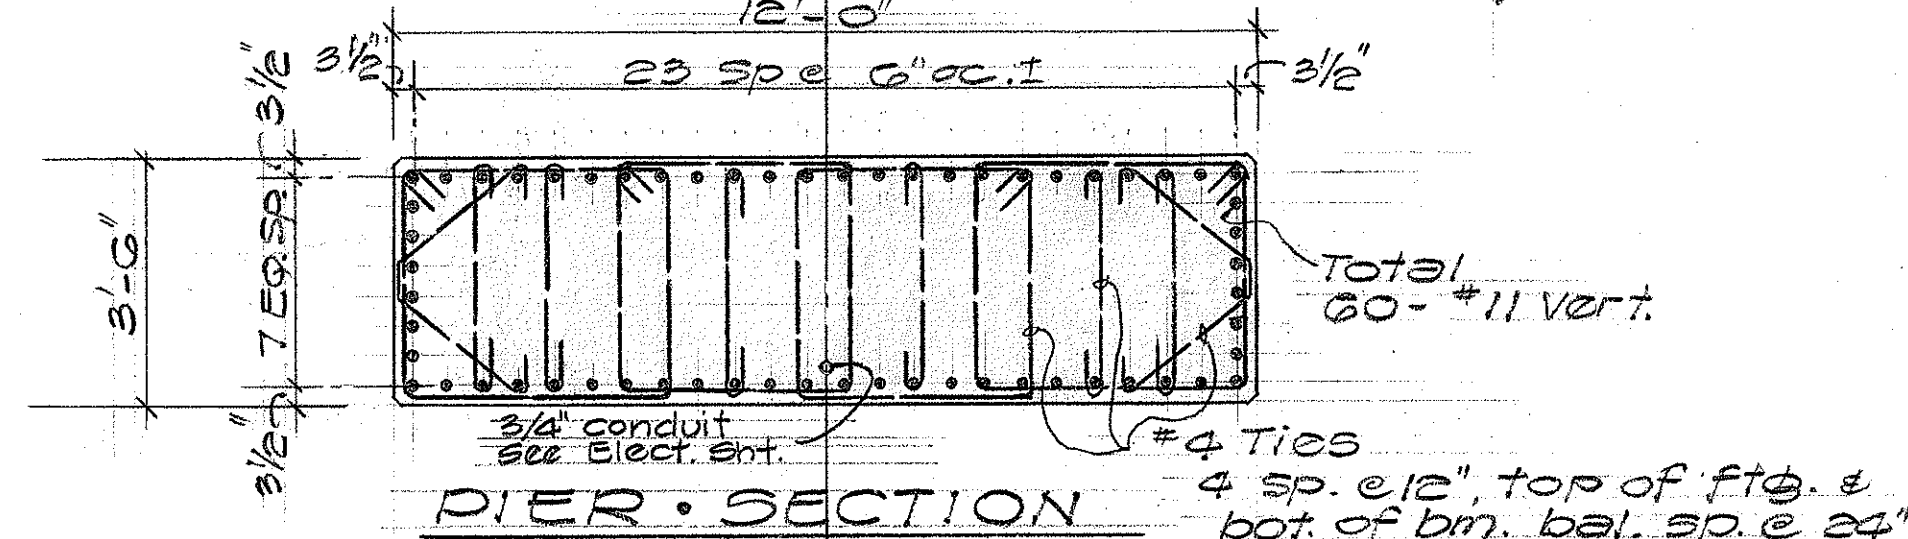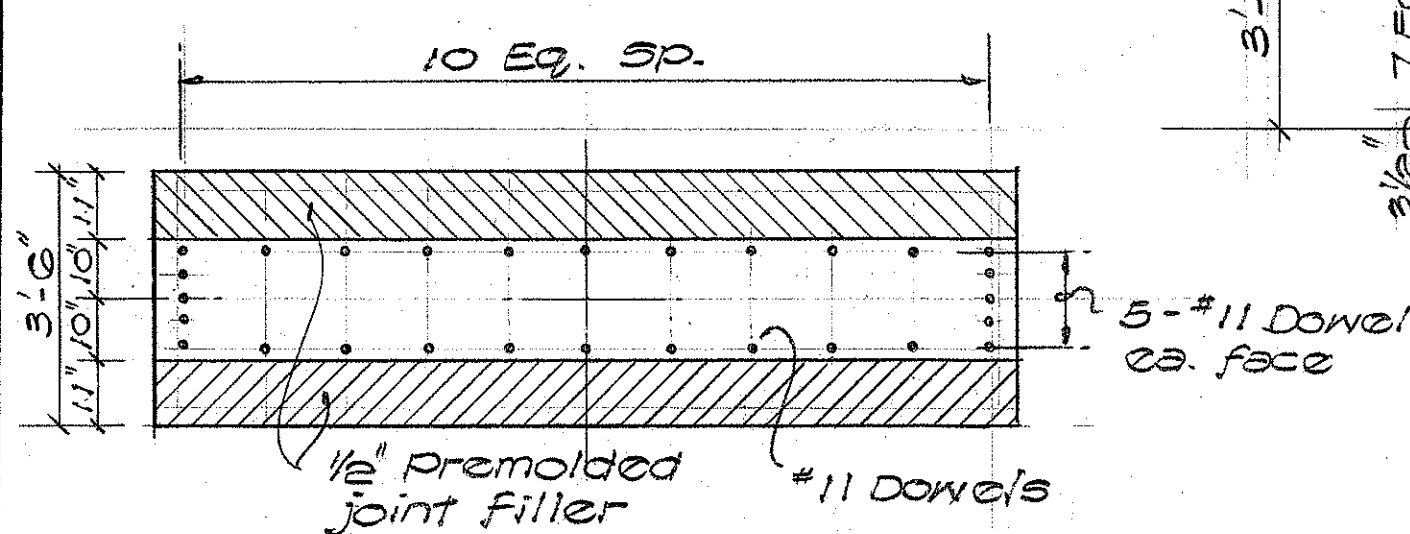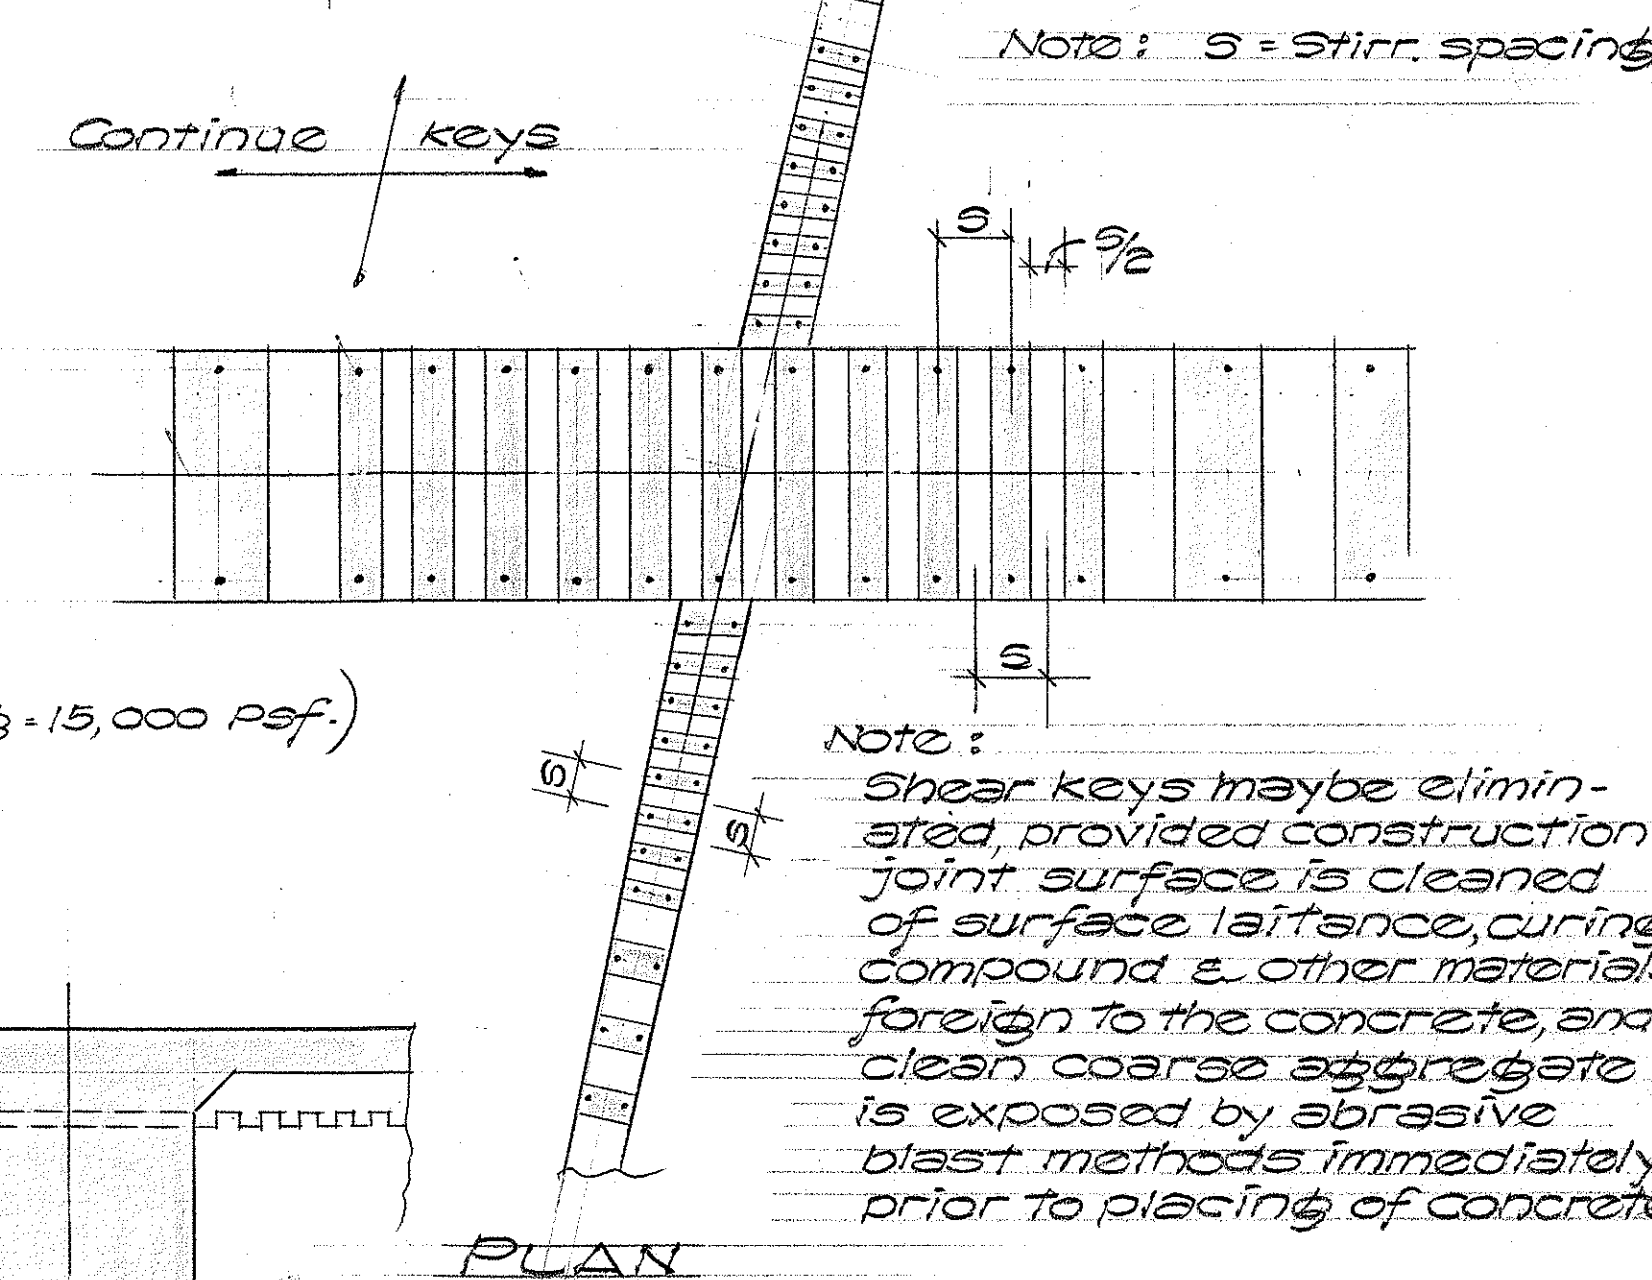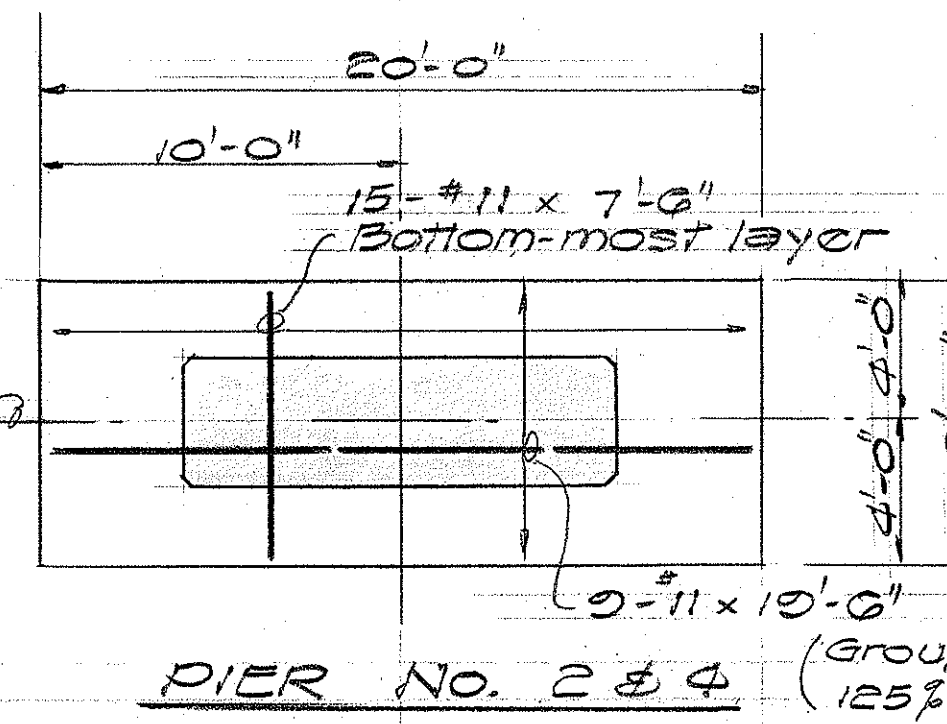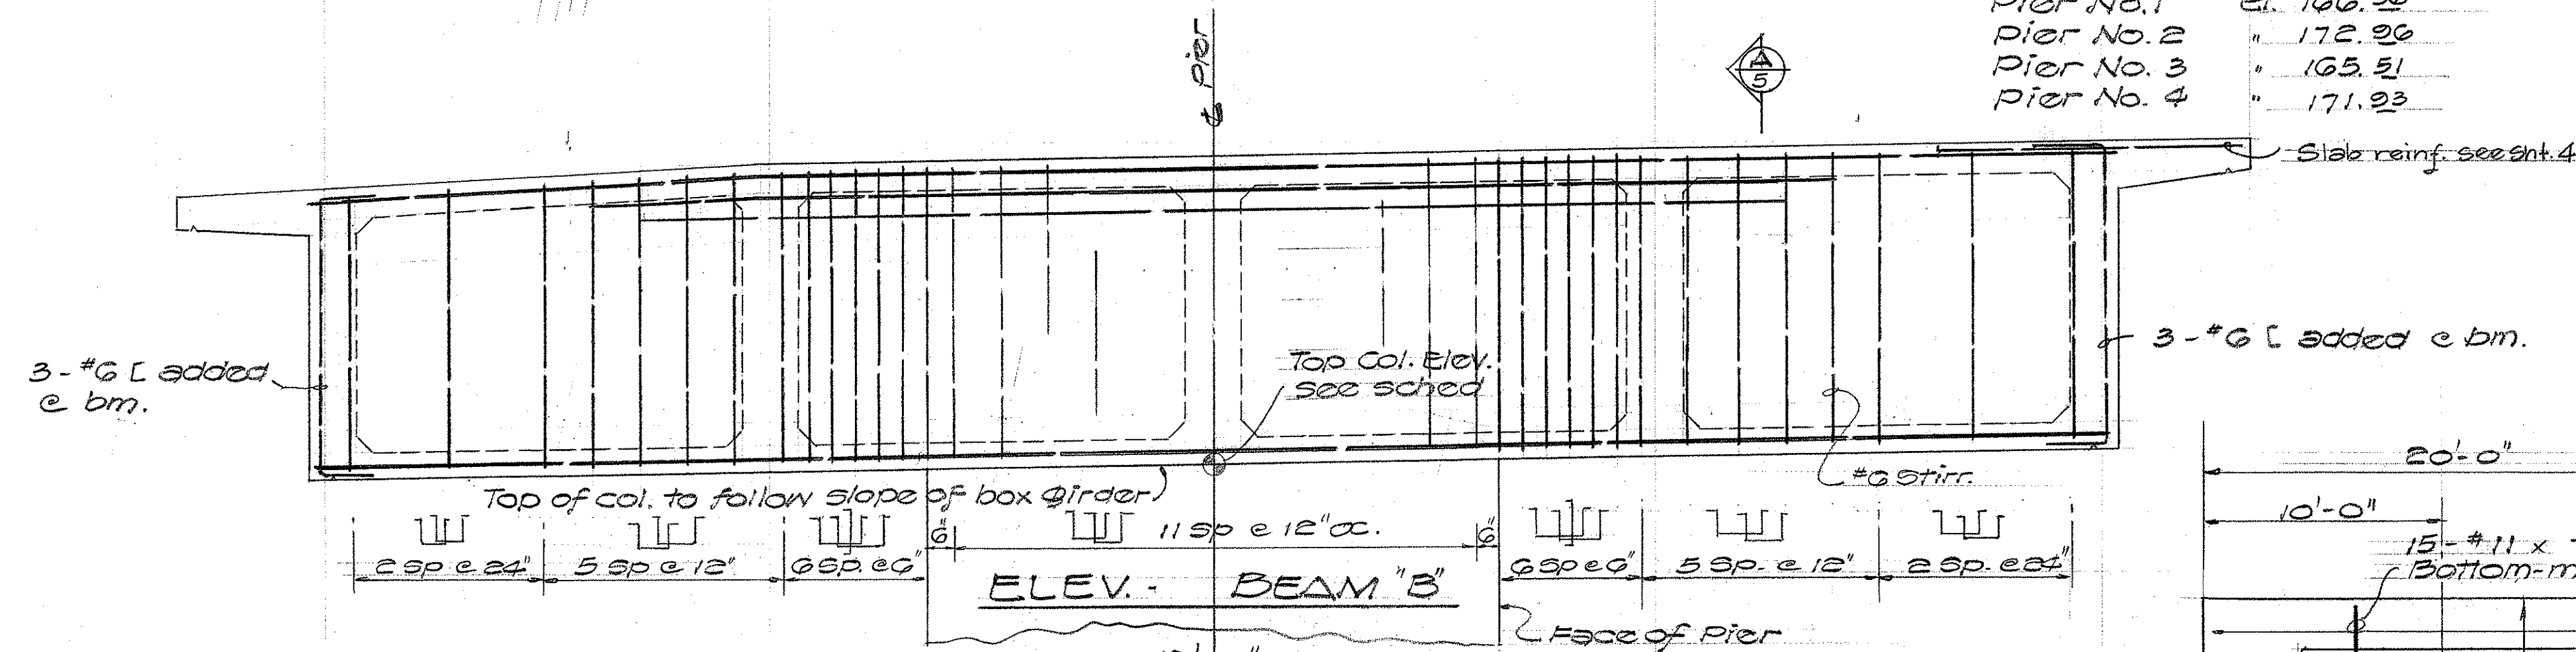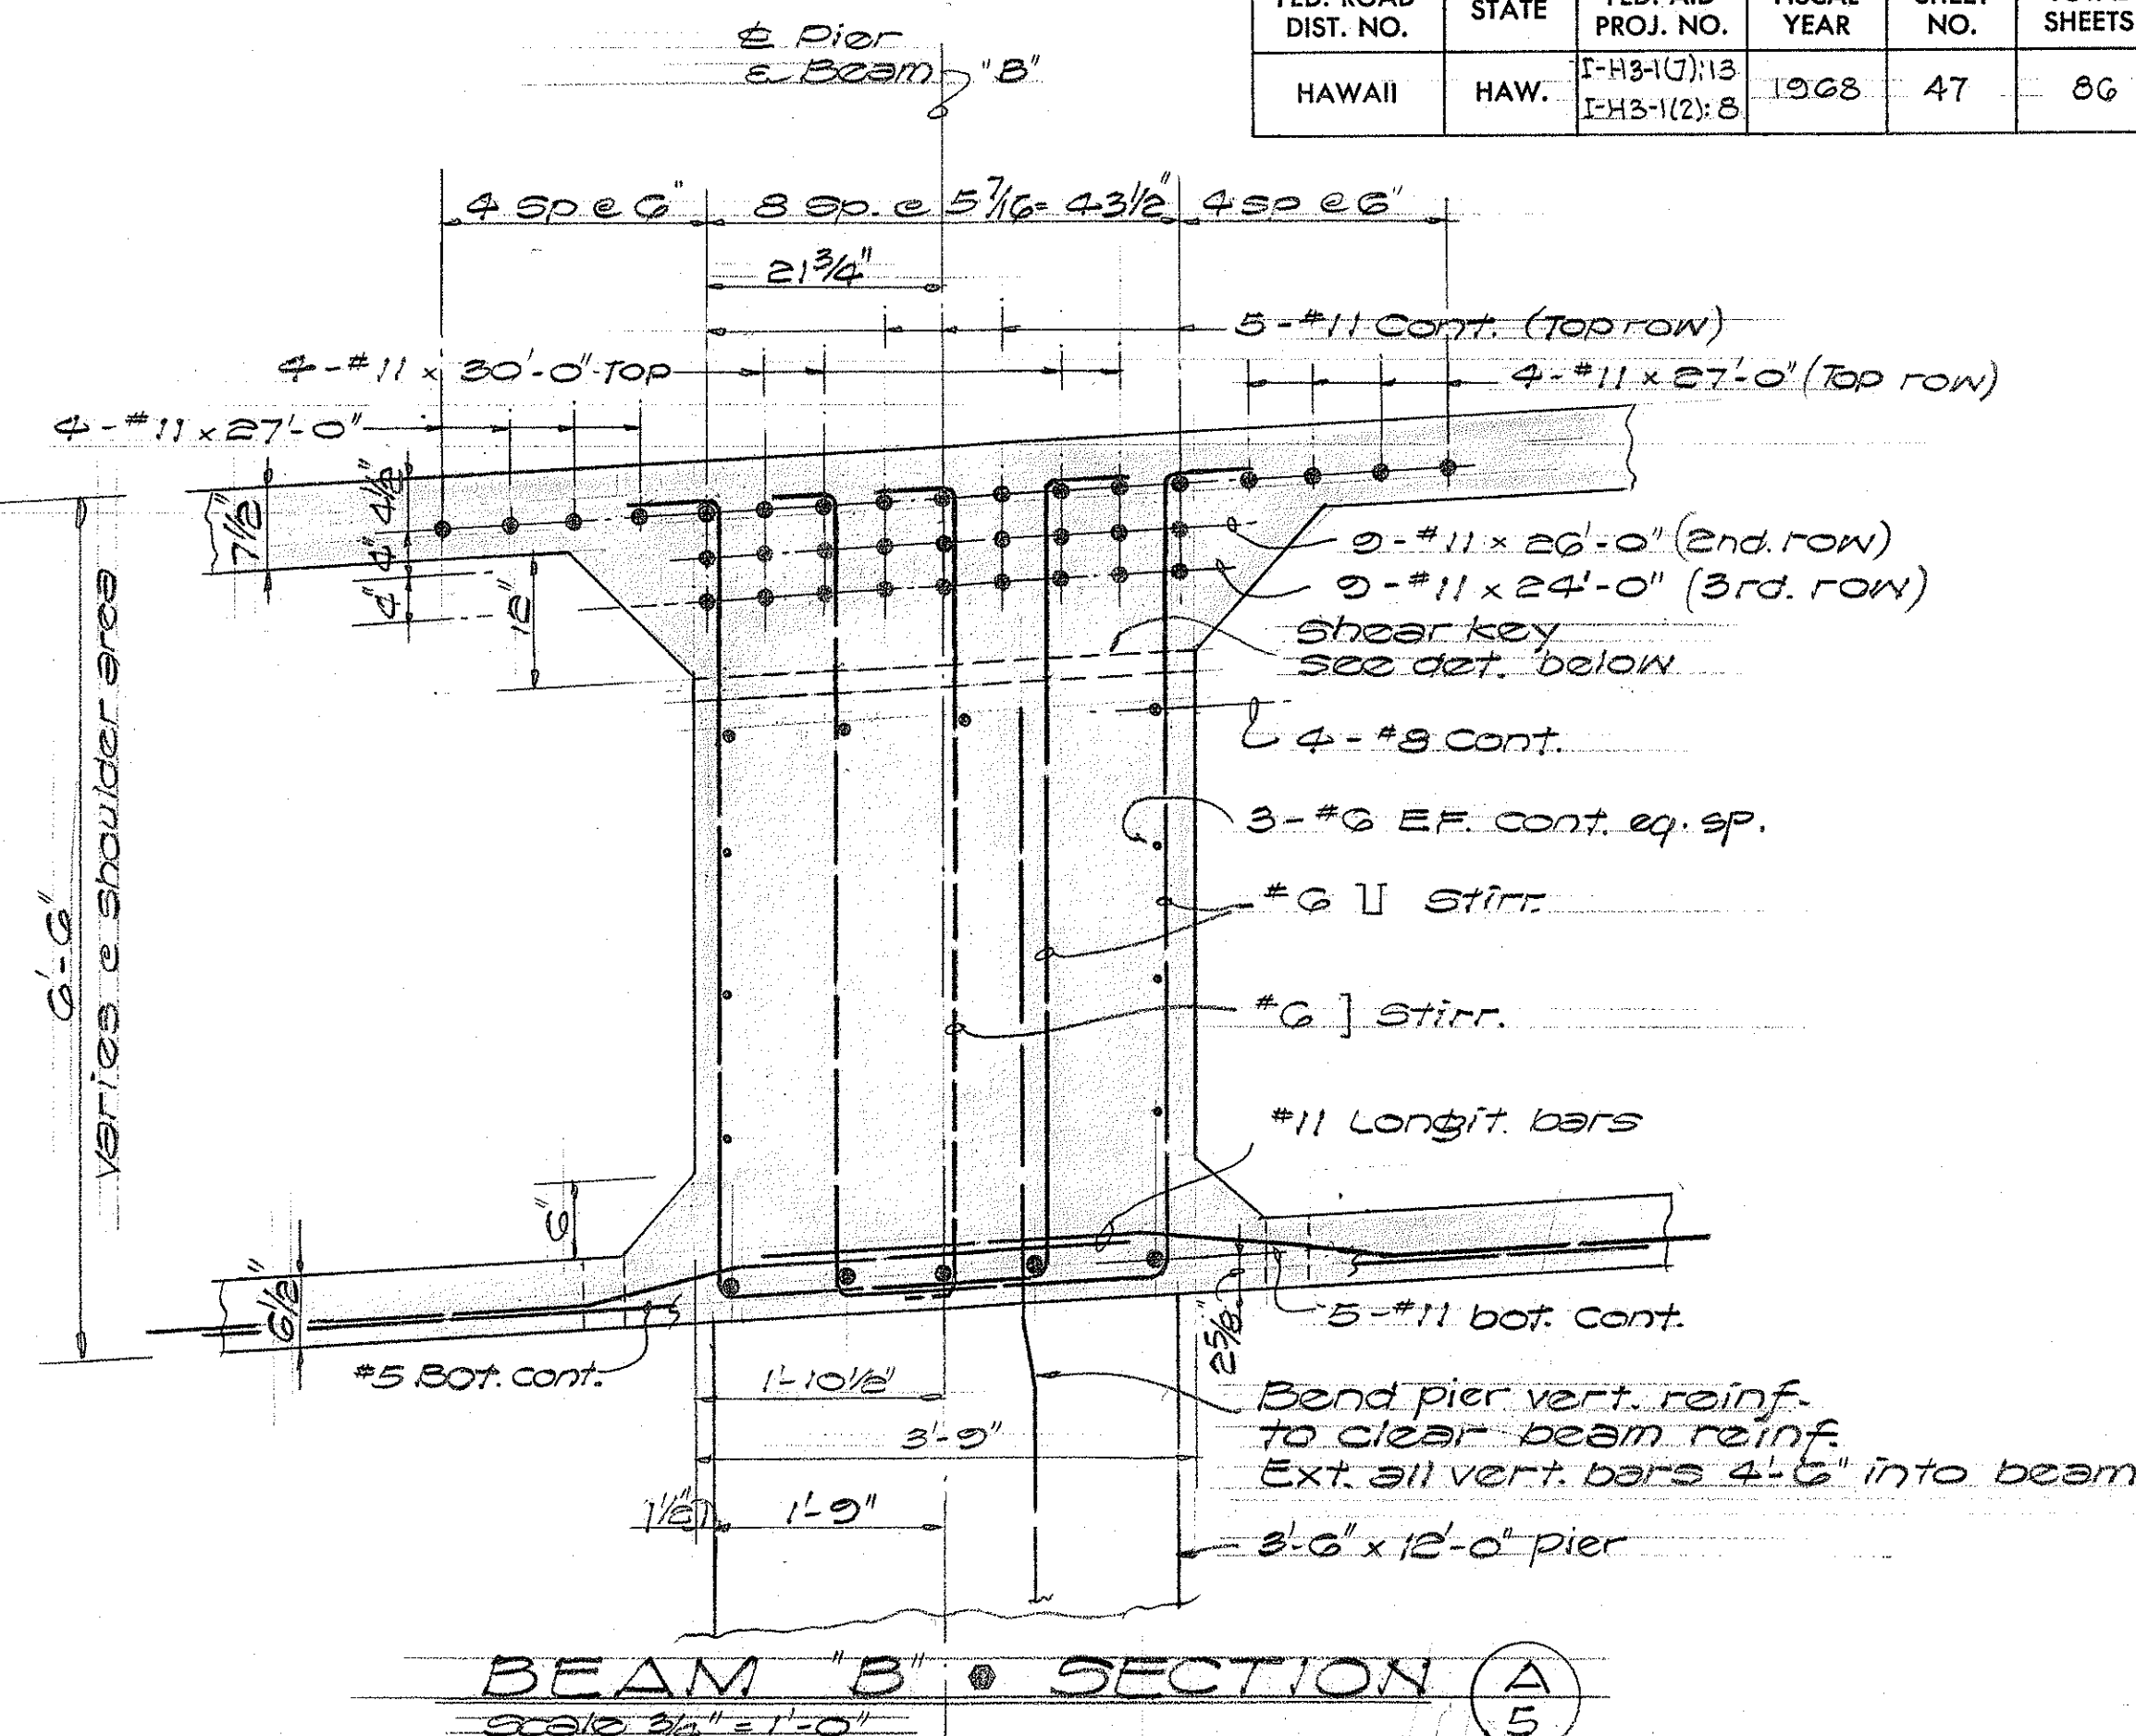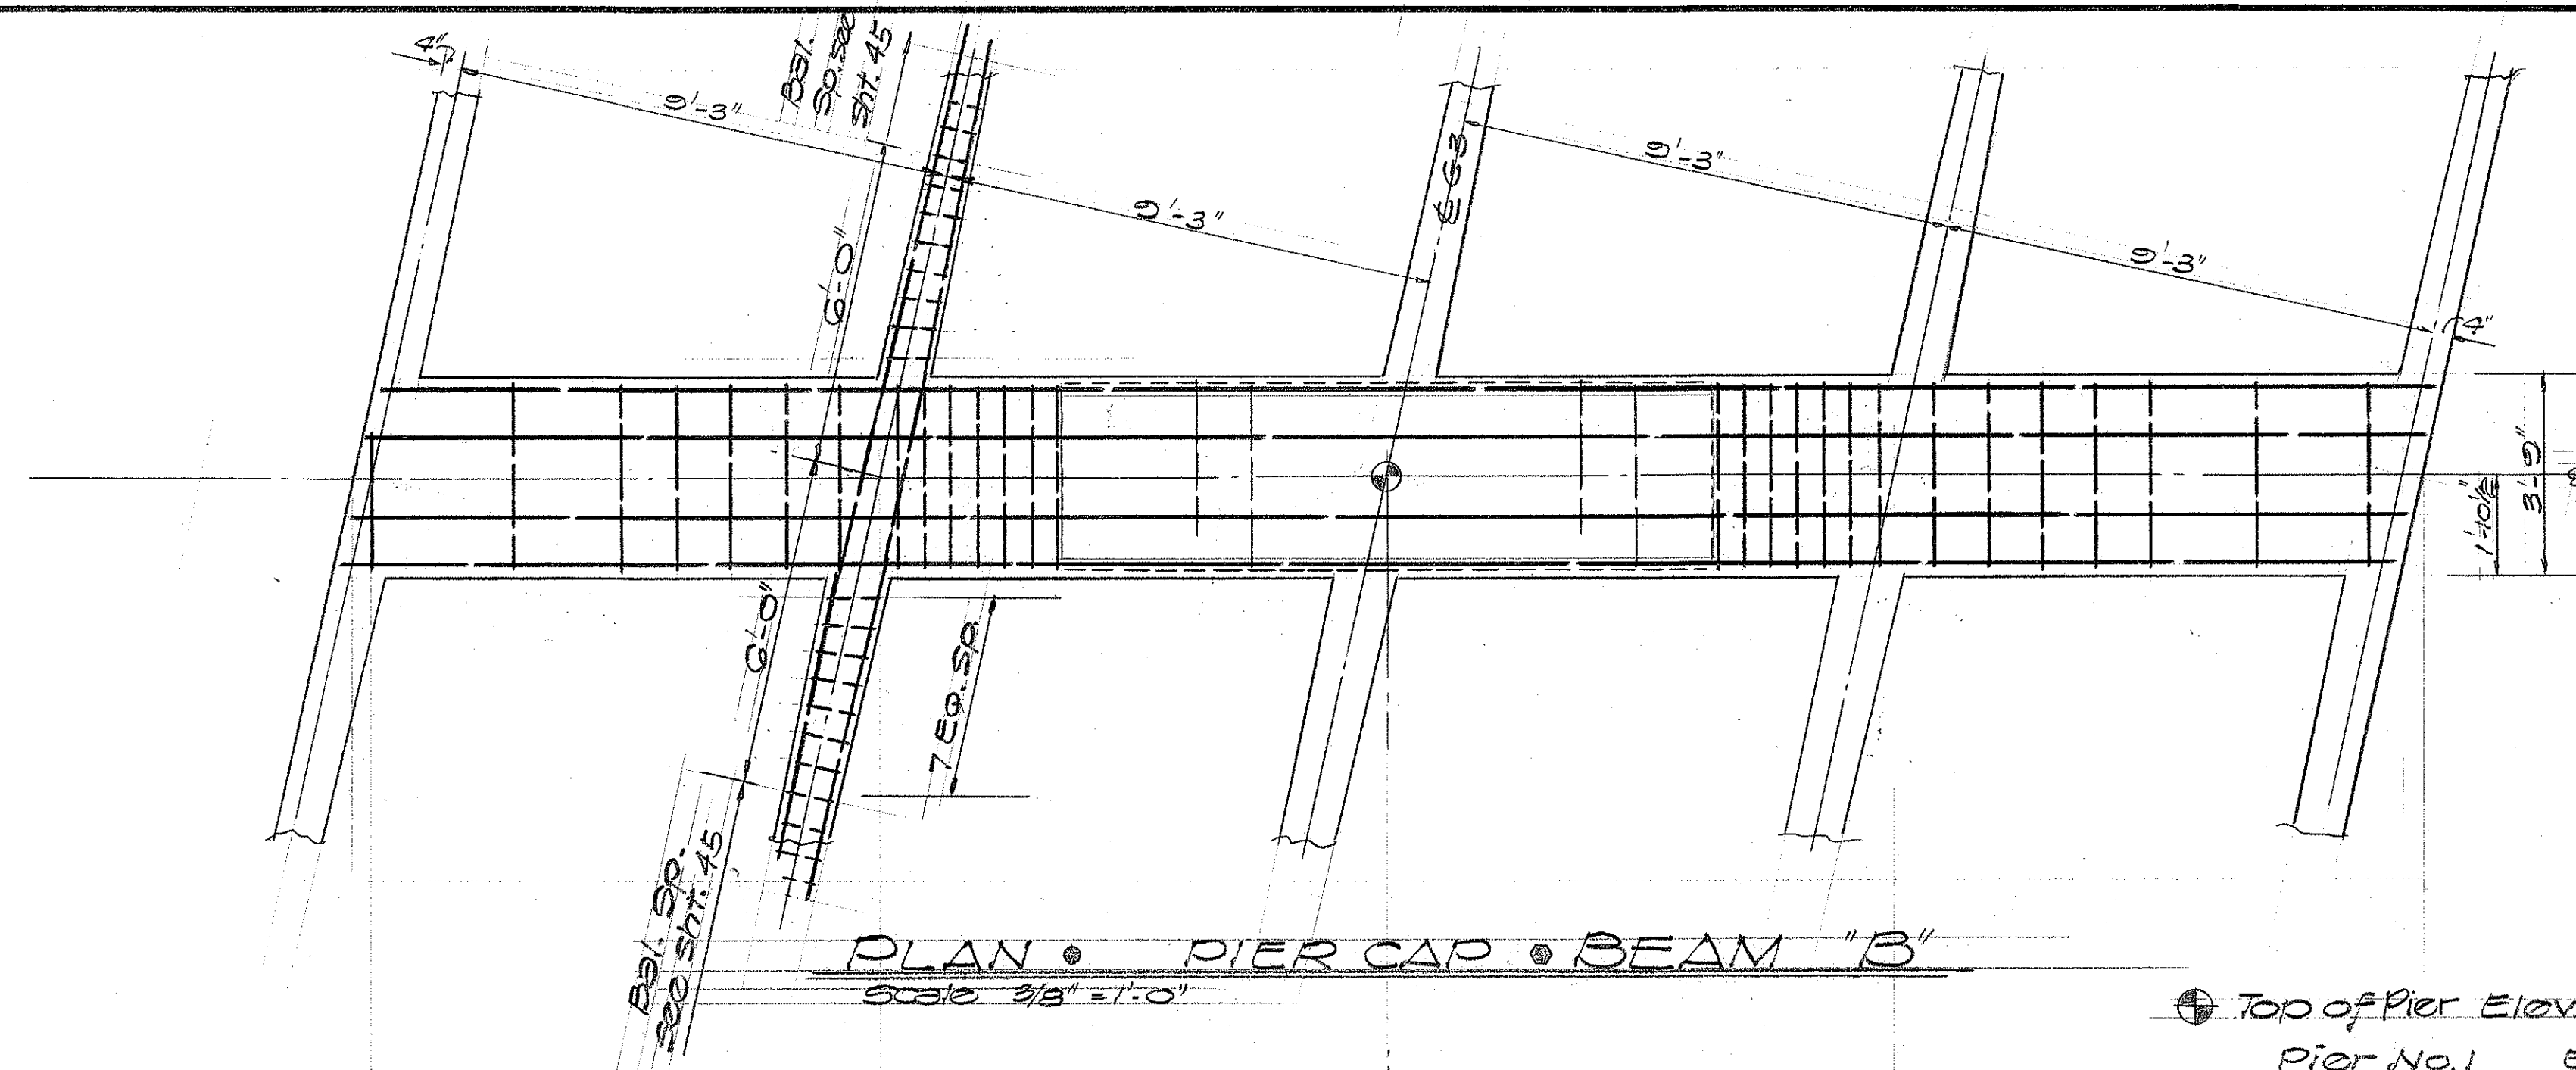

THIS WORK WAS PREPARED BY ME
OR UNDER MY SUPERVISION

Karen D. Parker
Signature

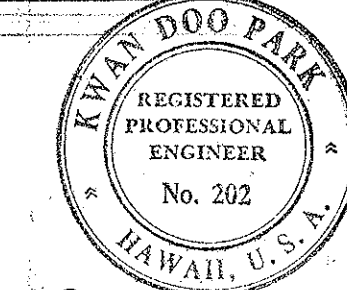

**STATE OF HAWAII
DEPARTMENT OF TRANSPORTATION
HIGHWAYS DIVISION**

KAILUA INTERCHANGE STRUCTURE

PIER & BEAM
PLAN, SECTIONS & ELEVATION

FAI Proj. No. I-H3-1(7):13, I-H3-1(2):8.


SCALE: AS SHOWN DATE: NOV. 1967

SHEET No. 5 OF 13 SHEETS


ORIGINAL PLAN	SURVEY PLOTTED BY	DATE
	DRAWN BY	"
	TRACED BY	"
NOTE BOOK	DESIGNED BY	"
	QUANTITIES BY	"
No.	CHECKED BY	"

Pier No. 1	Elev. 1139
Pier No. 2	Elev. 1329
Pier No. 3	Elev. 1159
Pier No. 4	Elev. <u>137</u>

FED. ROAD DIST. NO.	STATE	FED. AID PROJ. NO.	FISCAL YEAR	SHEET NO.	TOTAL SHEETS
HAWAII	HAW.	I-H3-1(7):13 I-H3-1(2):8	1965	49	86

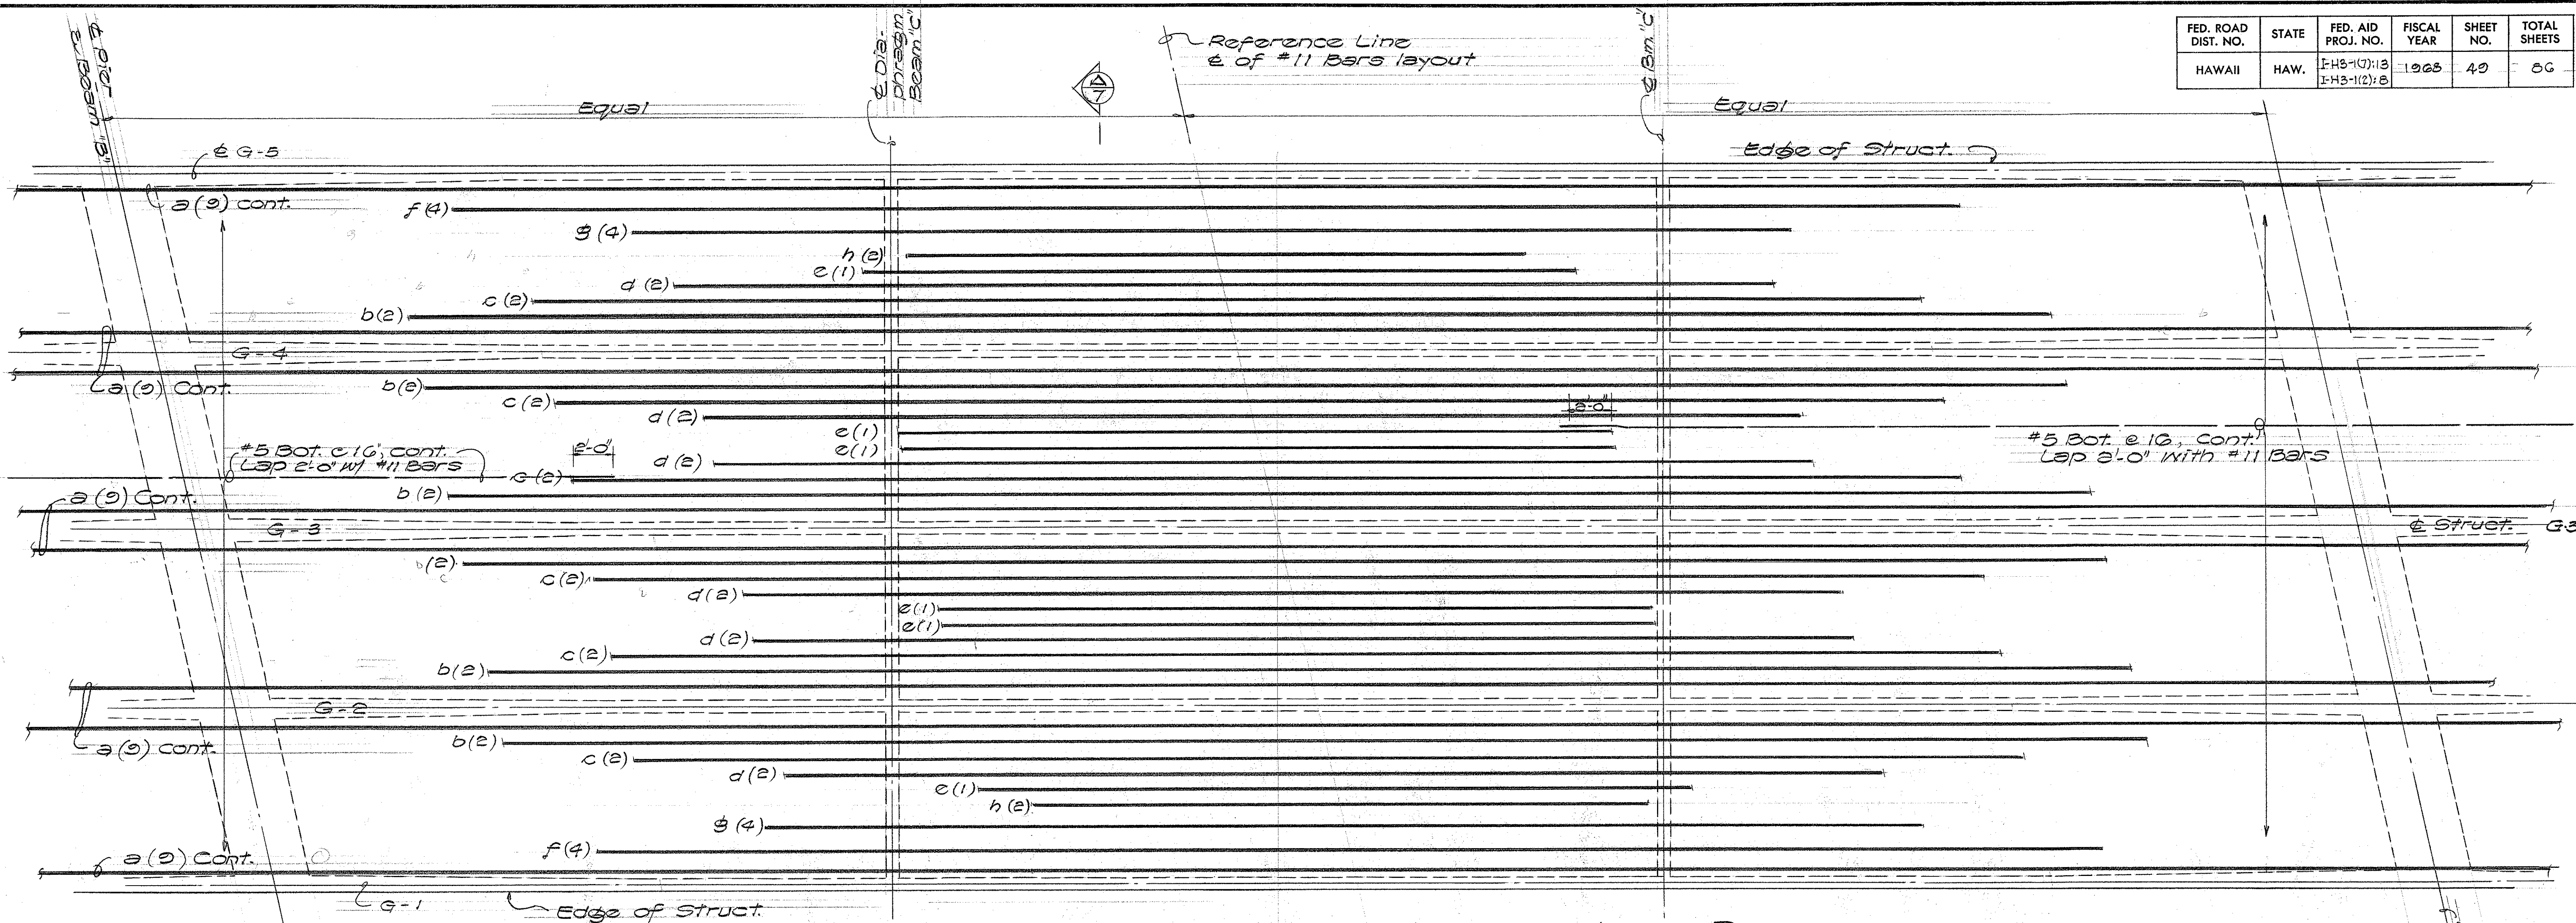

NOTE:
 1. Numerals within parenthesis, accompanying the alphabets, indicate the number of lettered bars in the location. See sect. (4) below for arrangement.
 2. See Section (5) for bending of cont. longitudinal reinforcing at Beam 'A'.

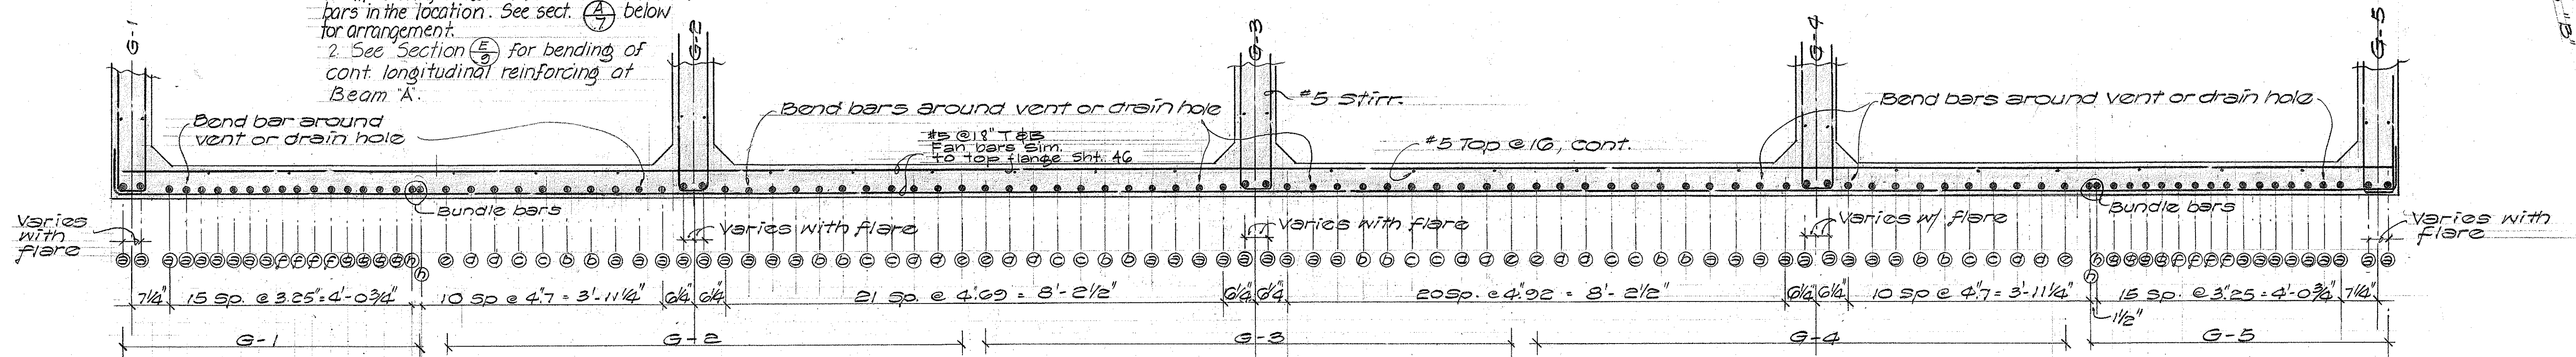

BOTTOM FLANGE #11 BARS SCHED.

GIRDER	G-2, G-3, G-4					G-1, G-5			
MARK	a	b	c	d	e	f	g	h	
NO.	9	4	4	4	2	9	4	4	2
LENGTH	Cont.	85'	72'	57'	37'	Cont.	78'	60'	32'



THIS WORK WAS PREPARED BY ME
 OR UNDER MY SUPERVISION
 Kwan Doo Park
 Signature

STATE OF HAWAII
 DEPARTMENT OF TRANSPORTATION
 HIGHWAYS DIVISION








KAILUA INTERCHANGE
 STRUCTURE

PARTIAL PLAN - BOT. FLANGE MAIN
 REINF. & SECTIONS

F.A.I. Proj. No. I-H3-1(7):13, I-H3-1(2):8
 SCALE: AS SHOWN DATE: NOV. 1967

SHEET No. 7 OF 13 SHEETS

FED. ROAD DIST. NO.	STATE	FED. AID PROJ. NO.	FISCAL YEAR	SHEET NO.	TOTAL SHEETS
HAWAII	HAW.	I-H3-1(7):13 I-H3-1(2):8	1968	50	86

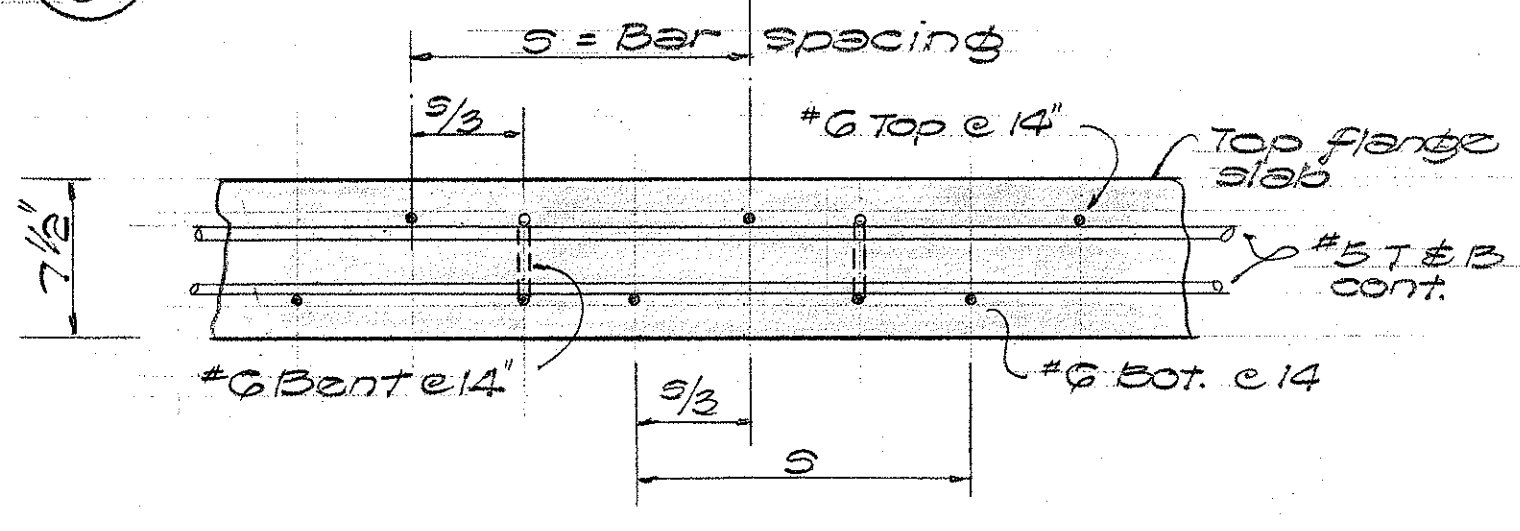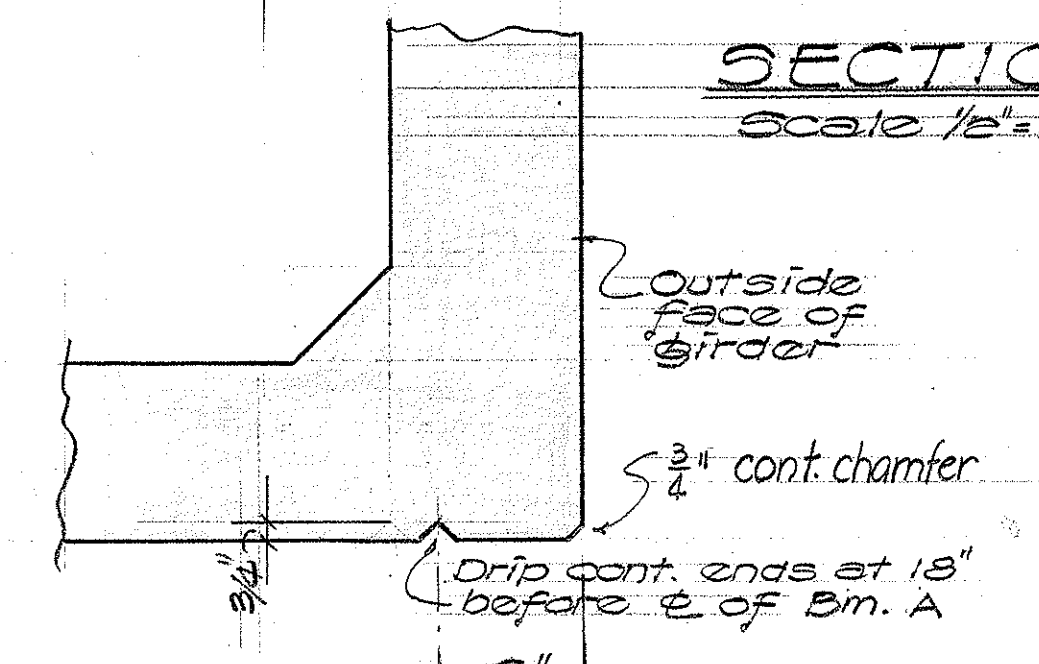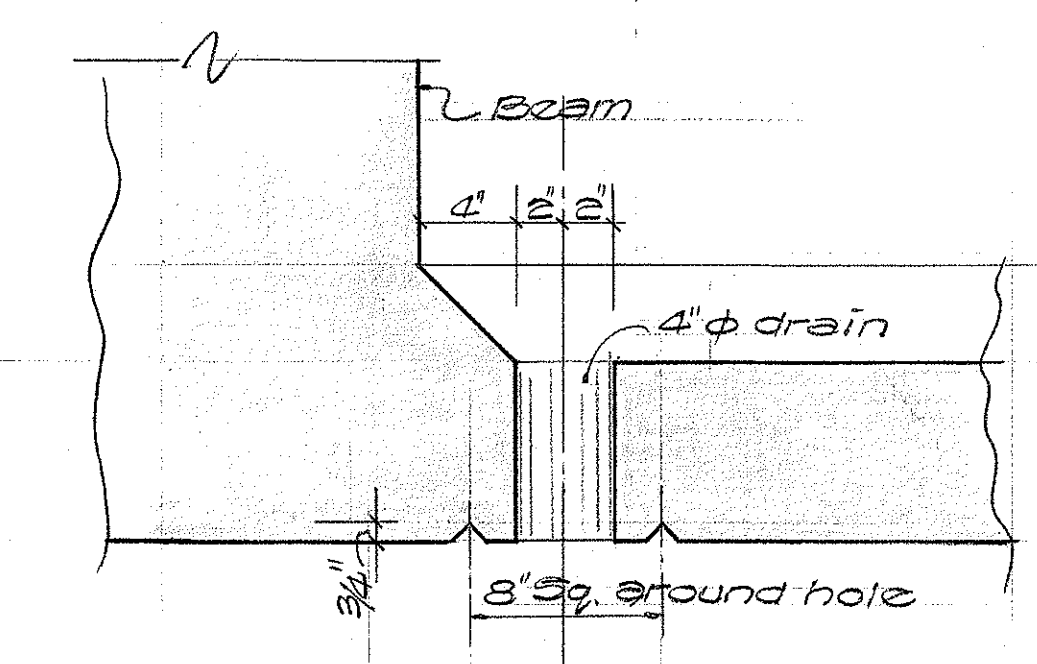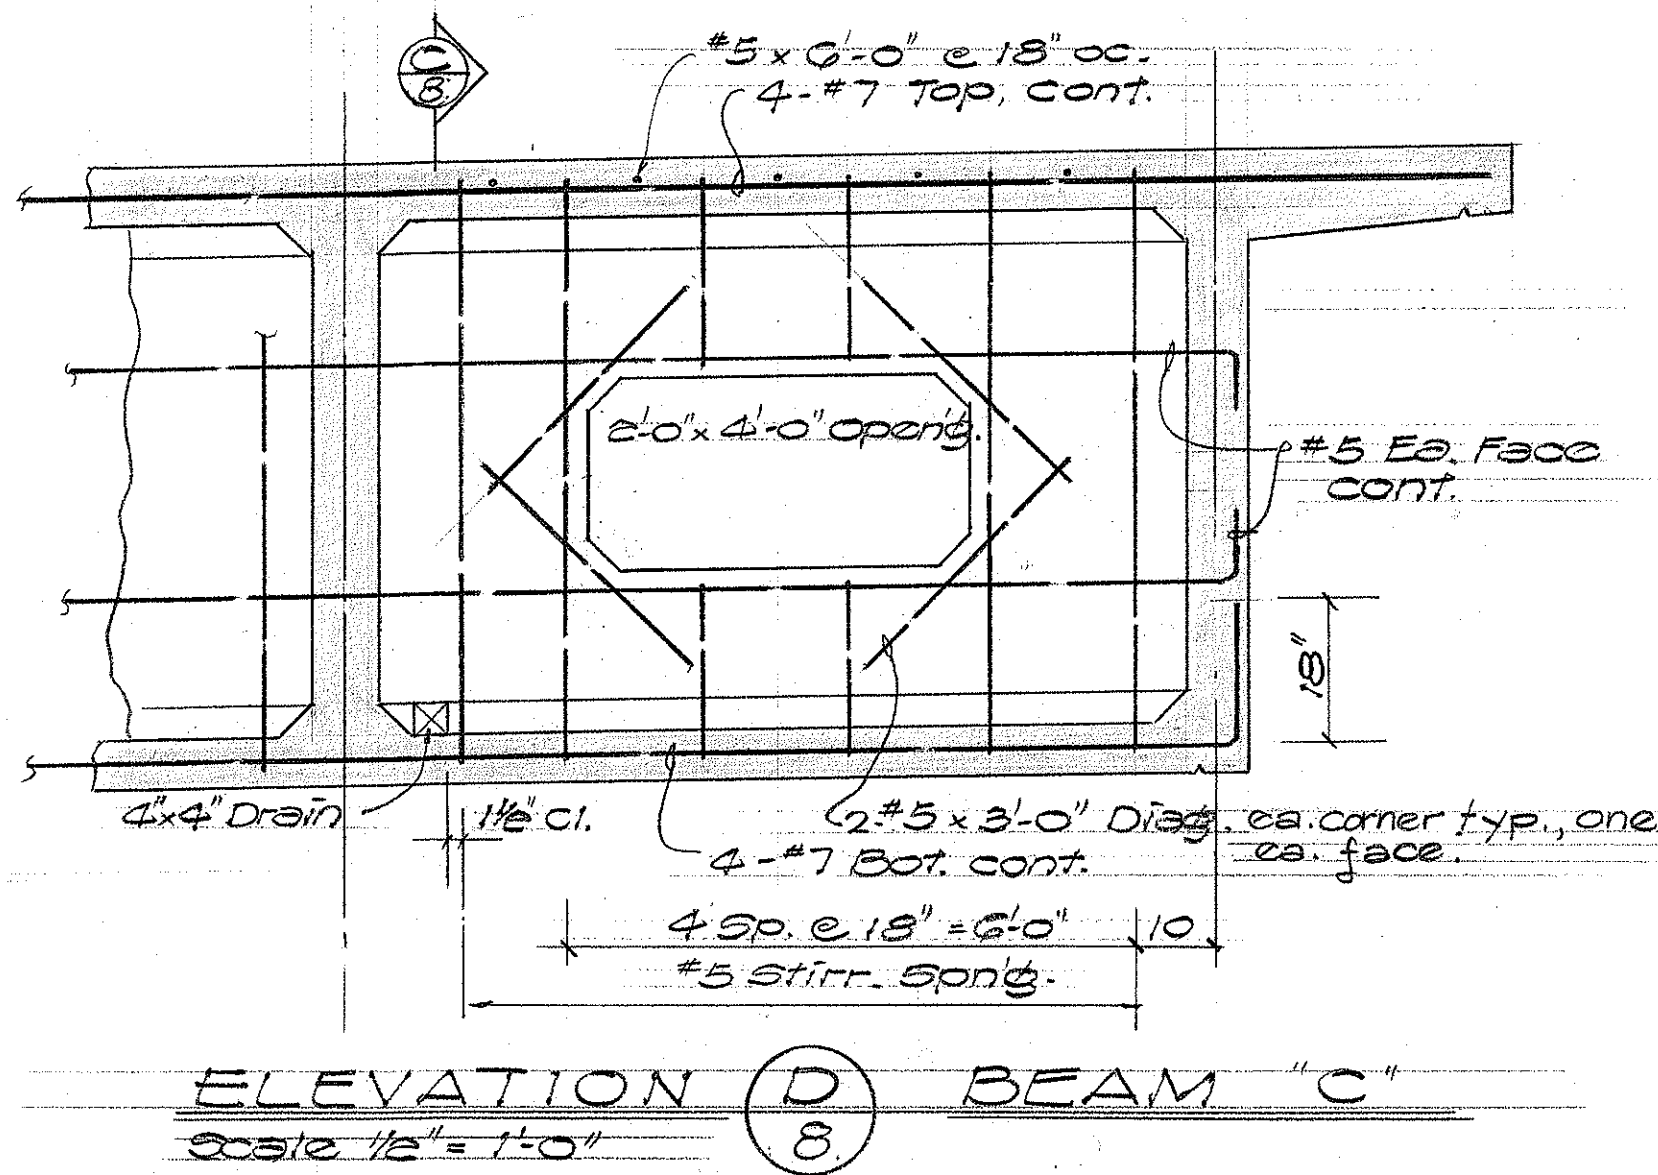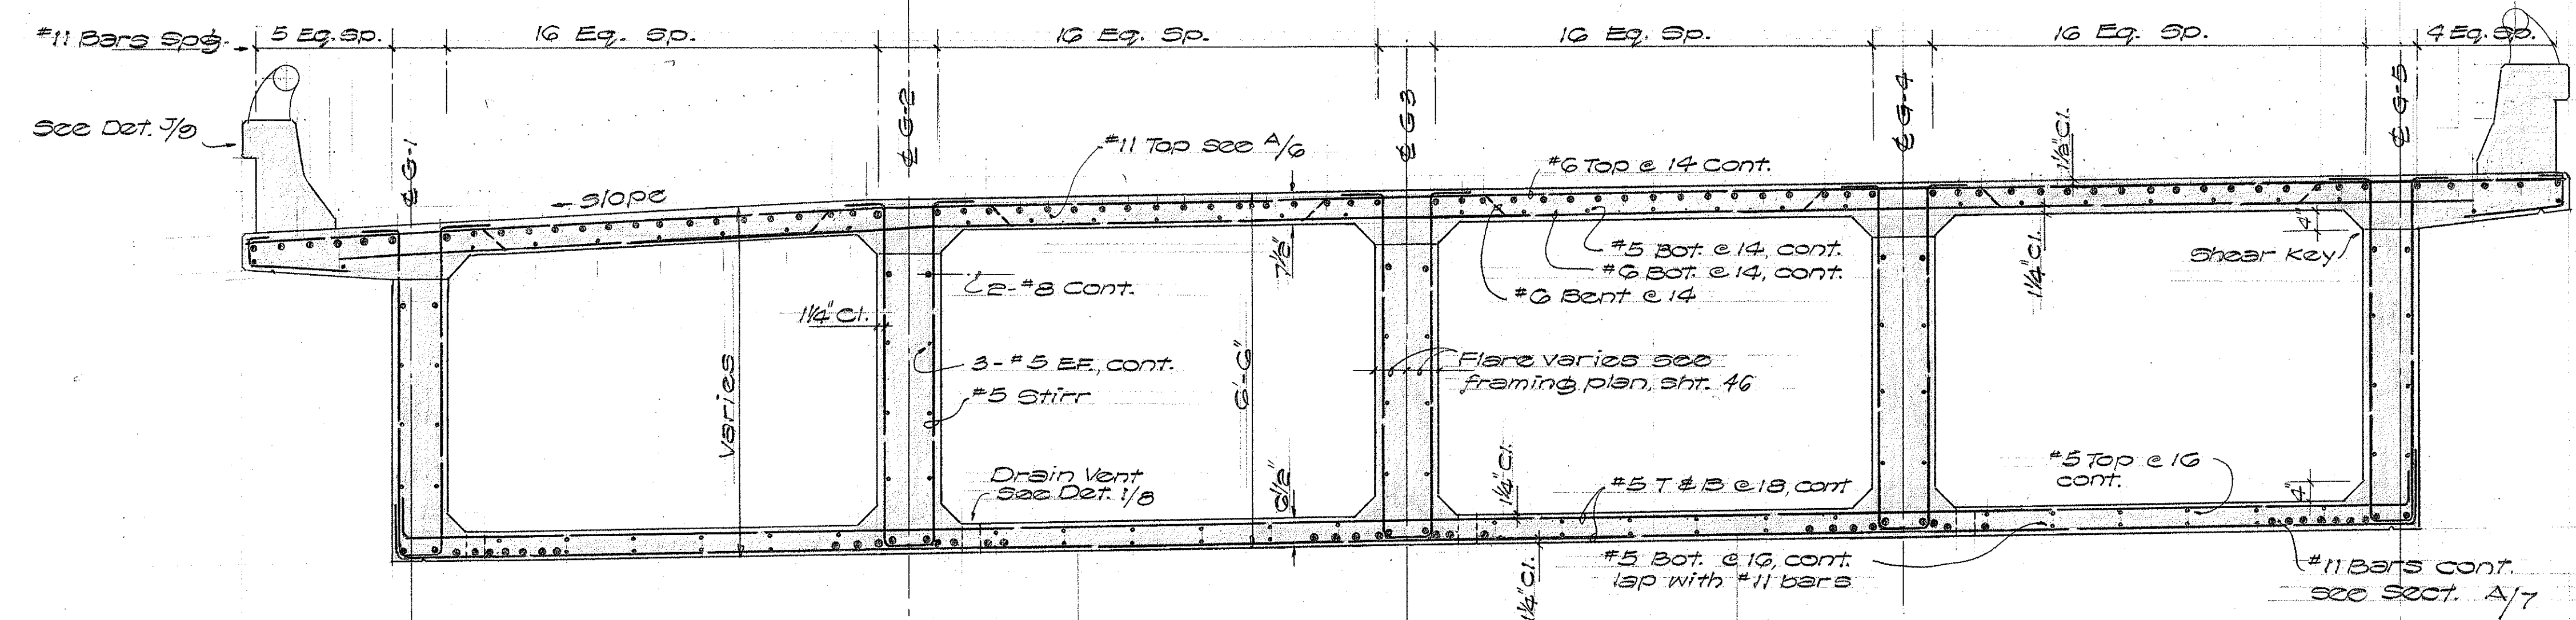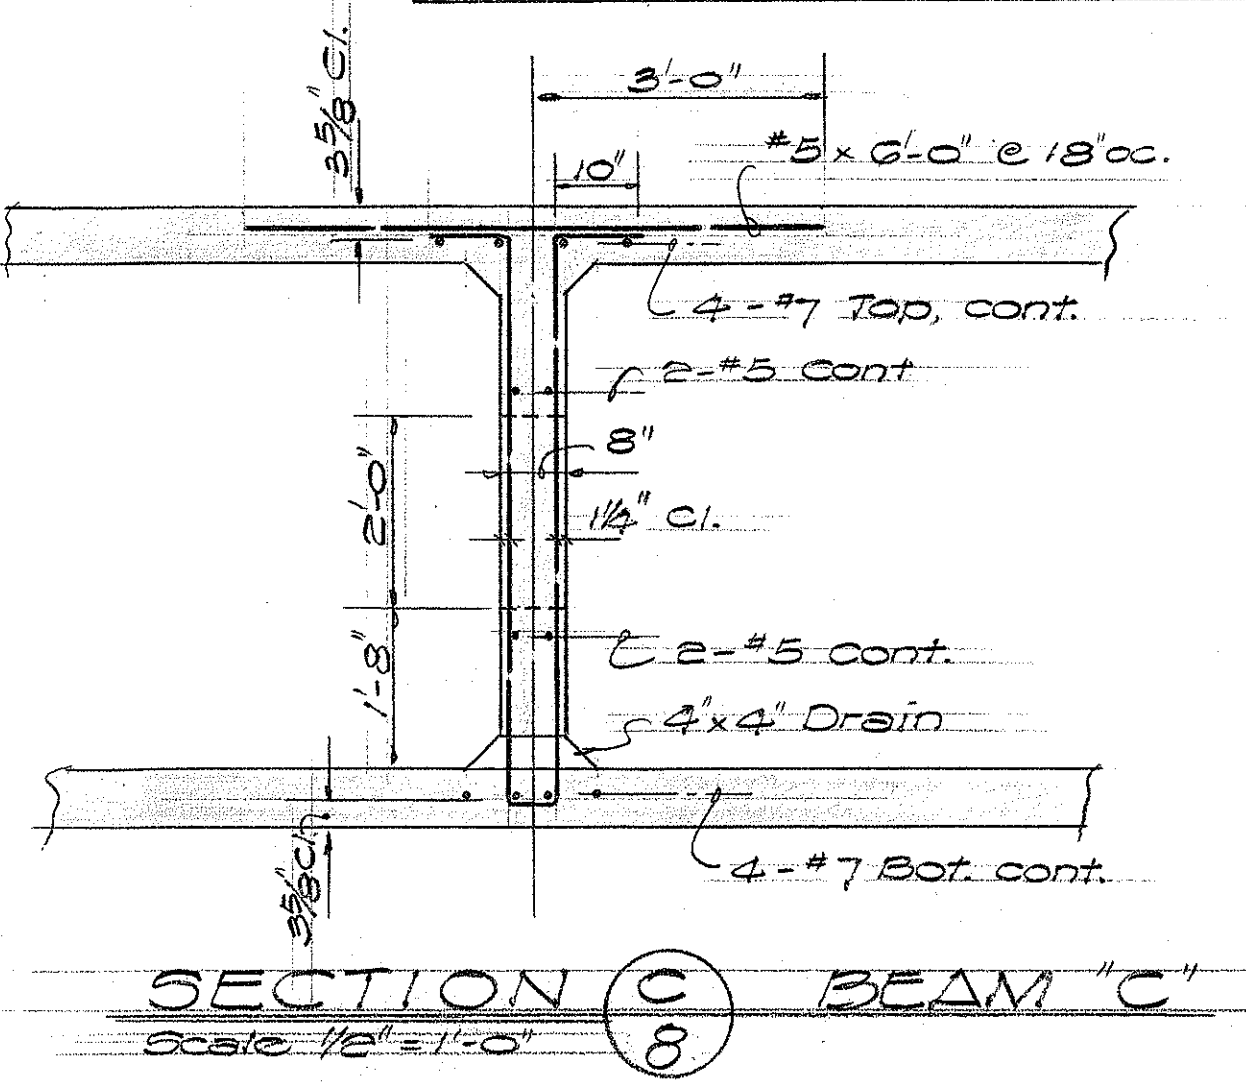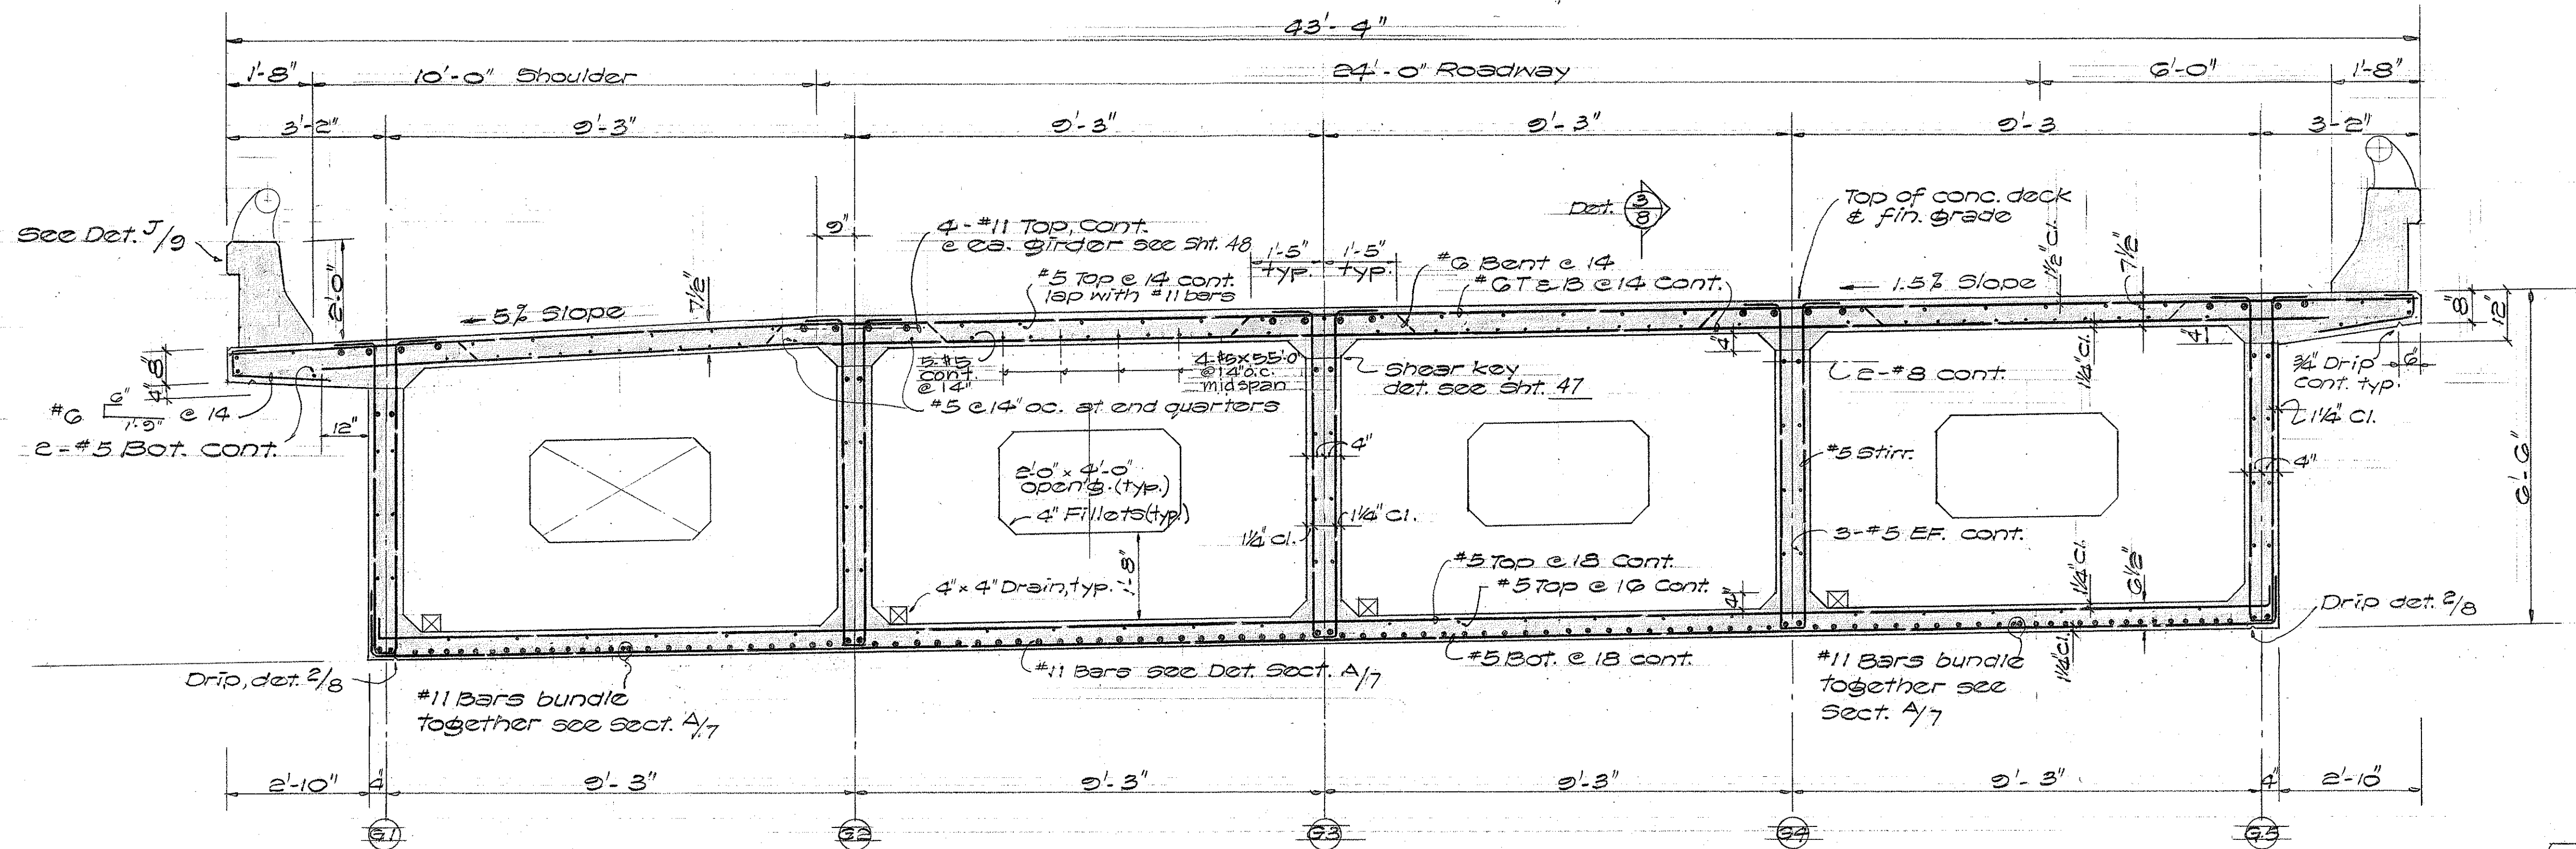

THIS WORK WAS PREPARED BY ME OR UNDER MY SUPERVISION
 Kwan Doo Park
 Signature

STATE OF HAWAII
 DEPARTMENT OF TRANSPORTATION
 HIGHWAYS DIVISION

KAILUA INTERCHANGE
 STRUCTURE

SECTIONS & DETAILS





E.A.I. Proj. No. I-H3-1(7):13, I-H3-1(2):8
 SCALE: AS SHOWN DATE: NOV. 1967

SHEET No. 8 OF 13 SHEETS





FED. ROAD DIST. NO.	STATE	FED. AID PROJ. NO.	FISCAL YEAR	SHEET NO.	TOTAL SHEETS
HAWAII	HAW.	I-H3-1(7):13 I-H3-1(2):8	1968	51	86

WING WALL No. (Ref. S-1)	"L" ft.
2	5'
3	13' 6"
4	13' 10"
5	6' 6"
6	11'
7	13' 12"
8	16' 13"

FOR CHANGES IN WINGWALL LENGTHS, SEE CCO # 14.

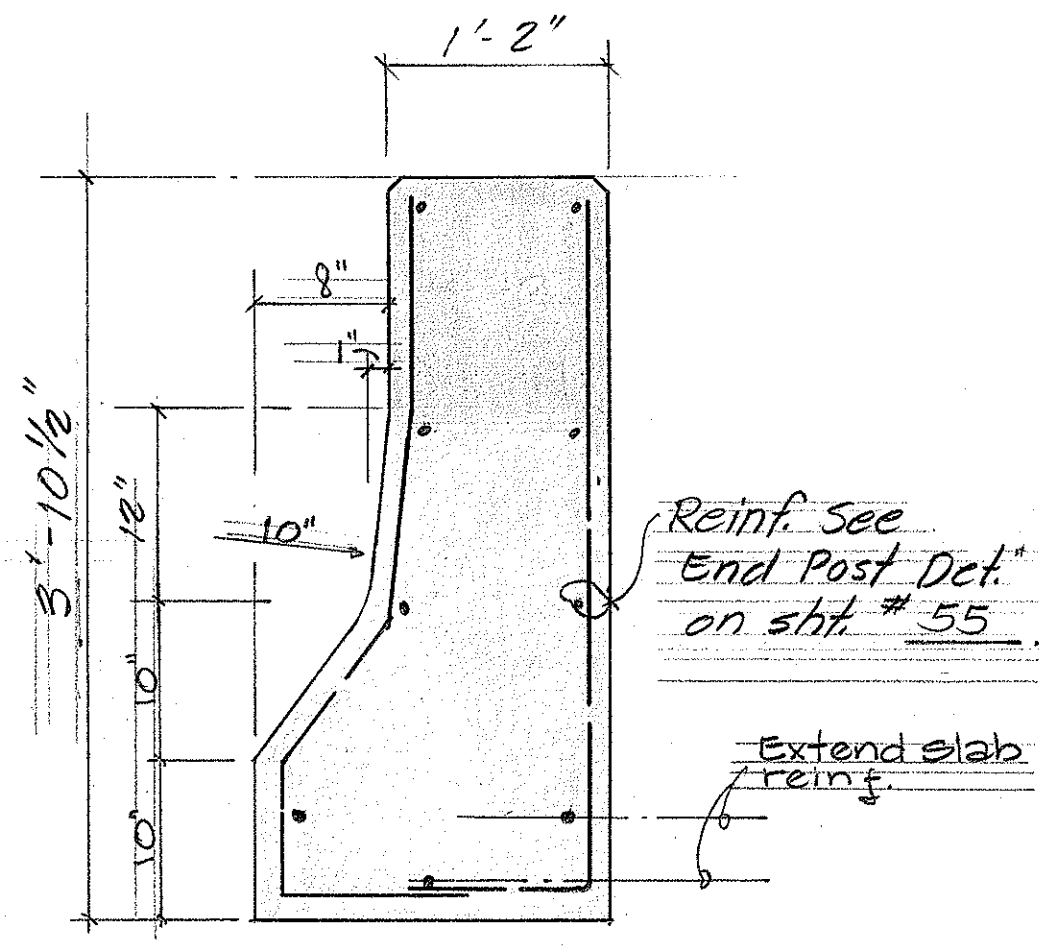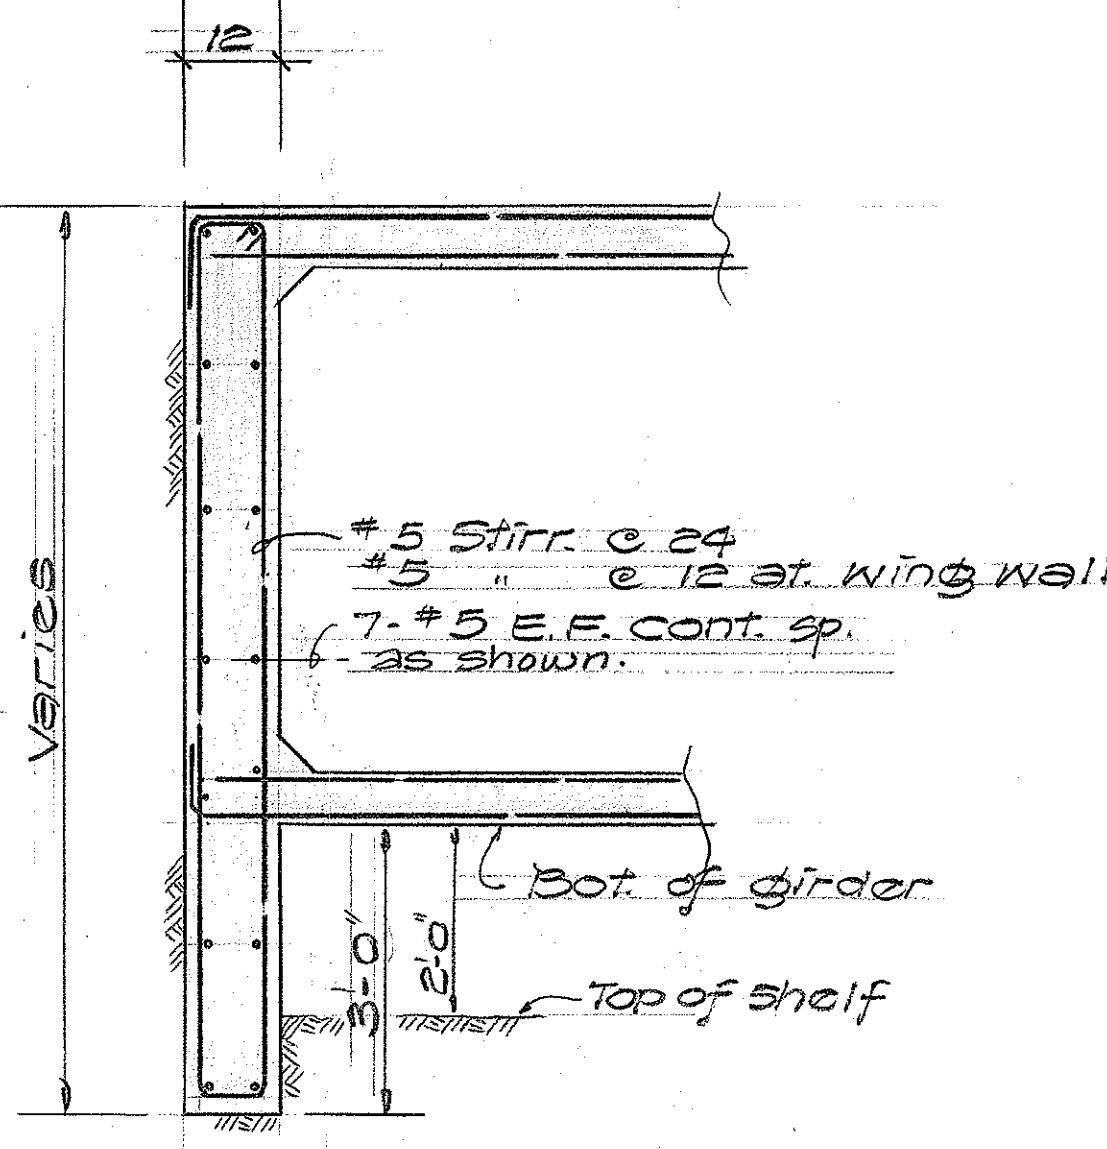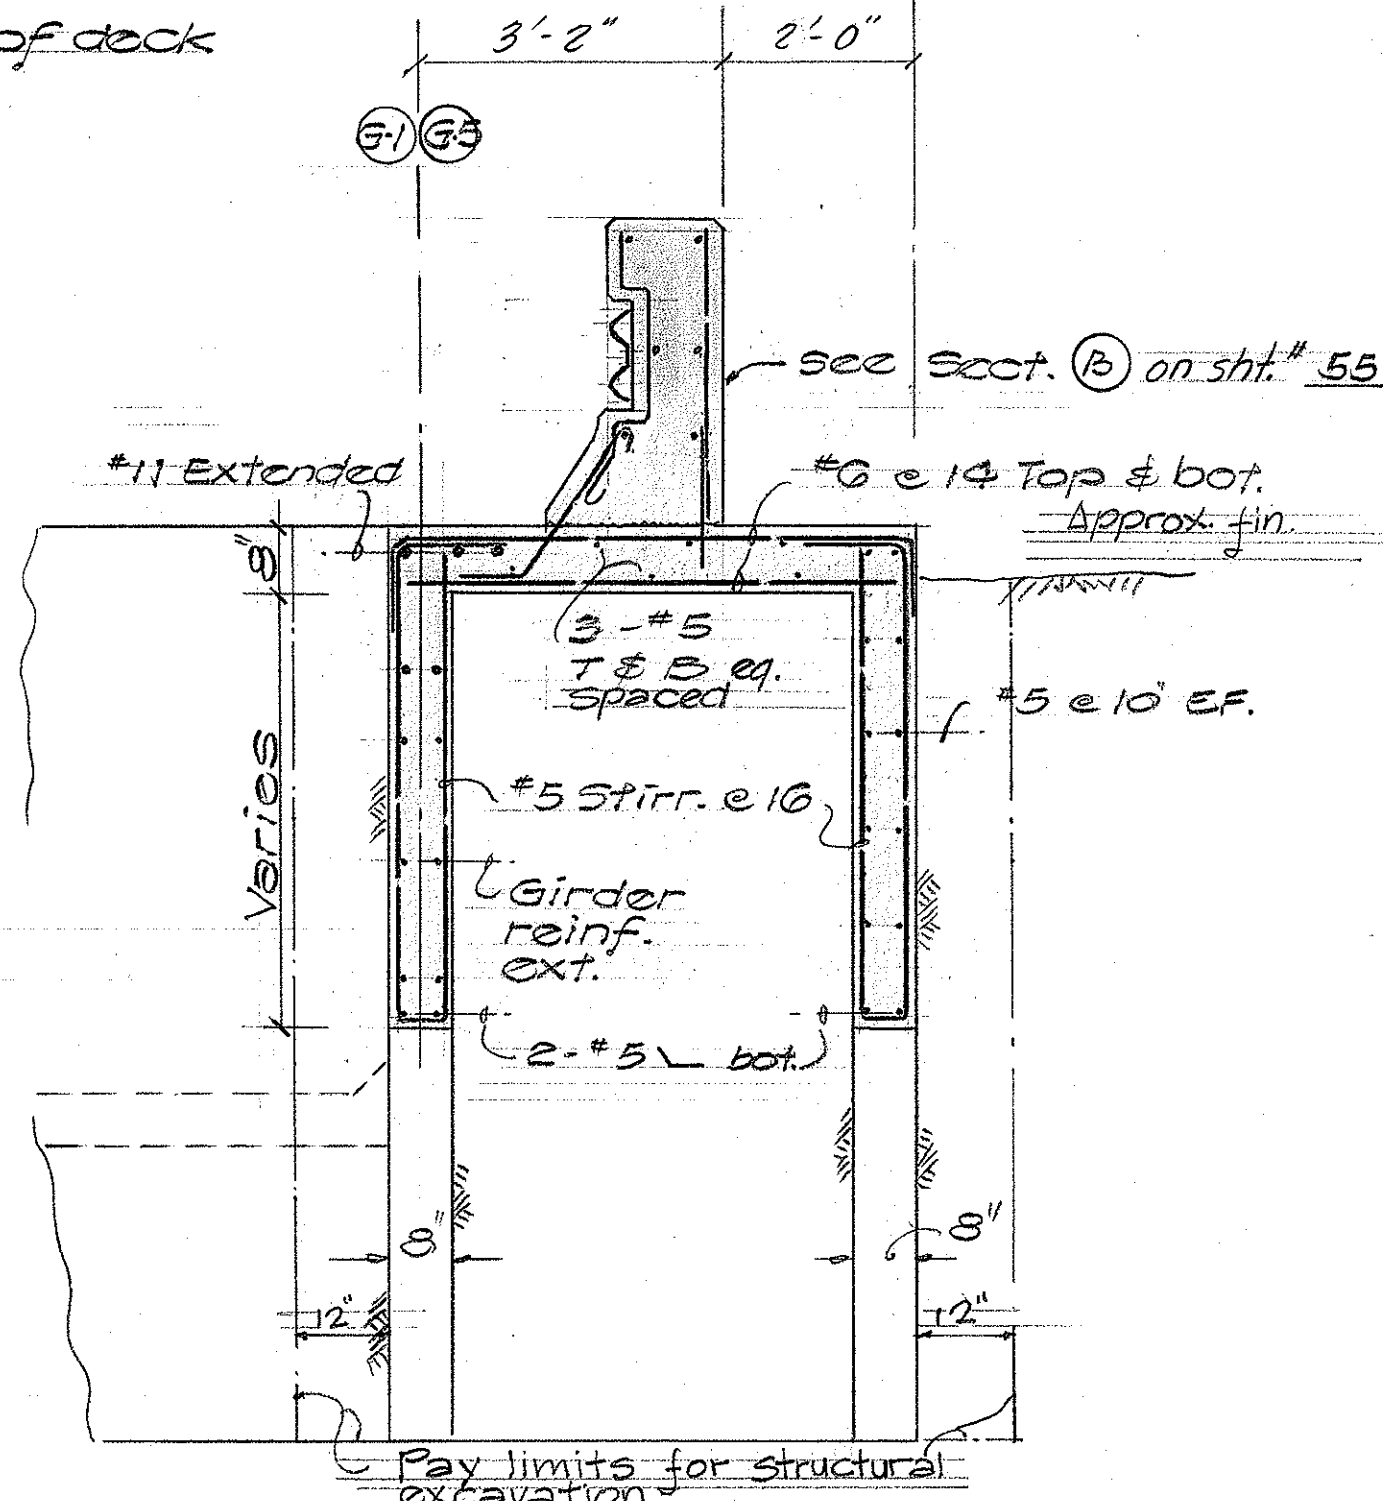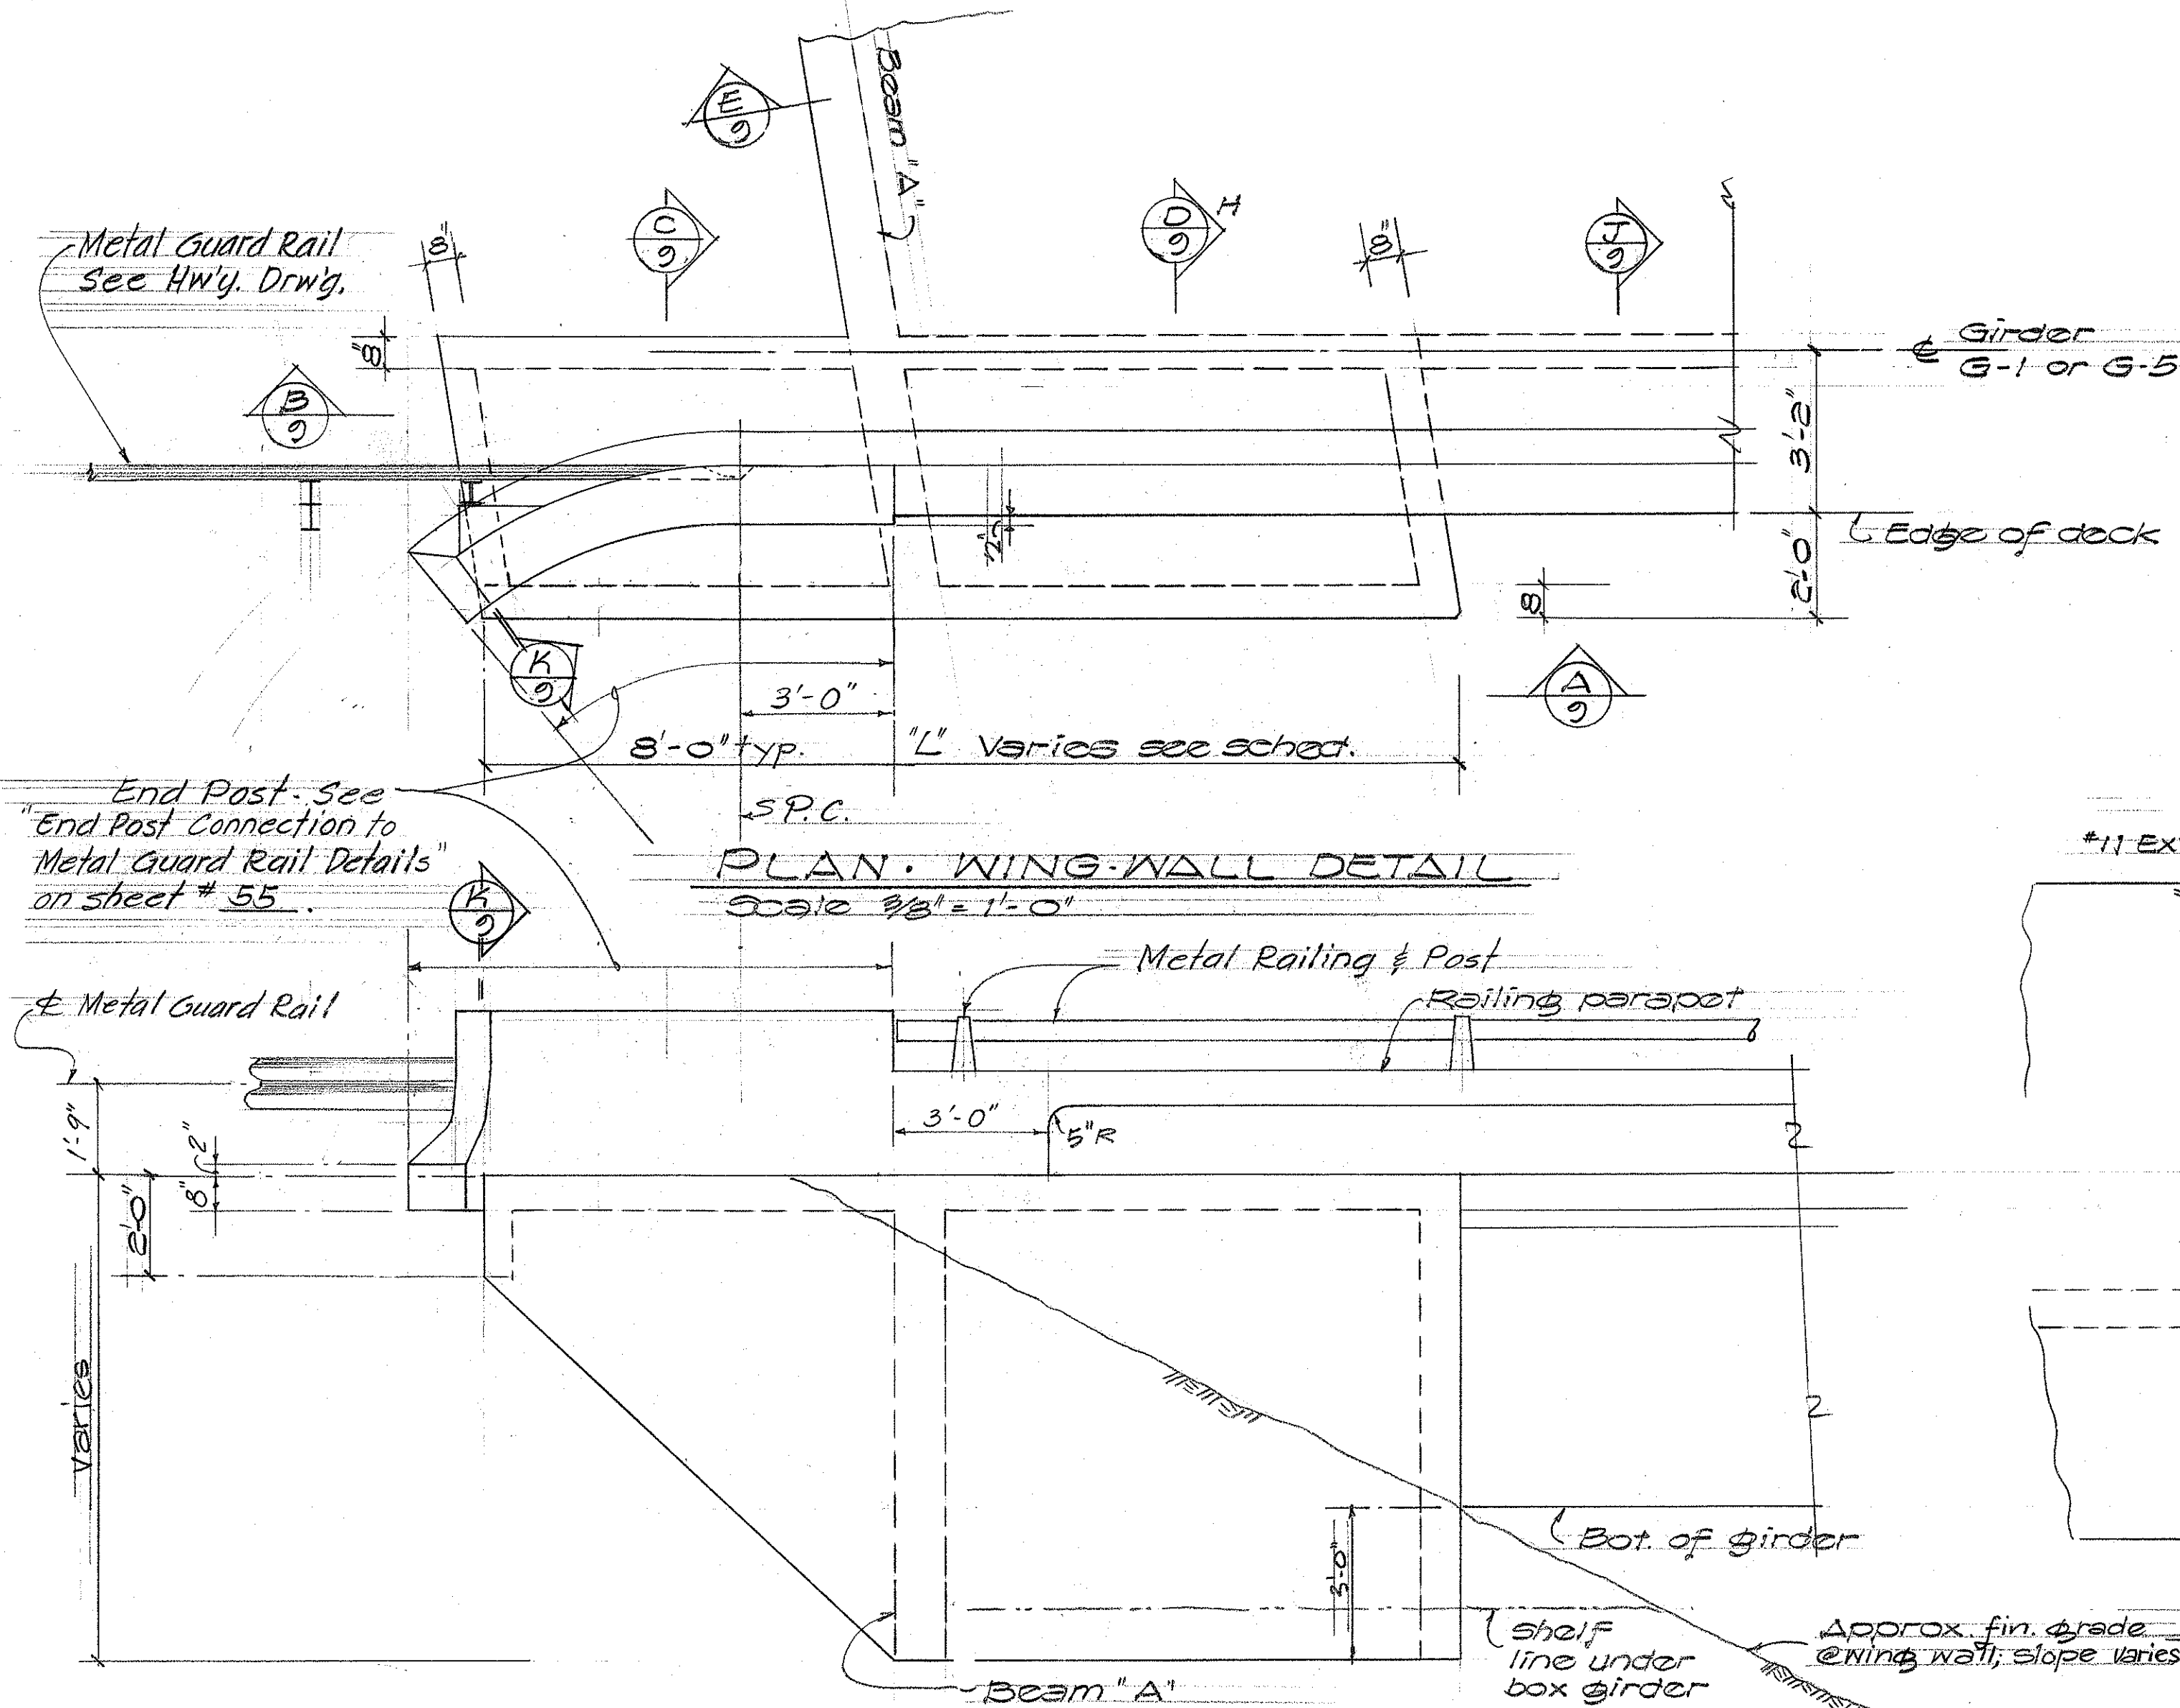

ELEVATION (A) 9

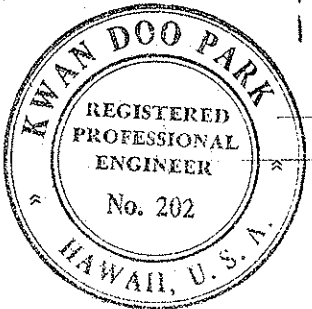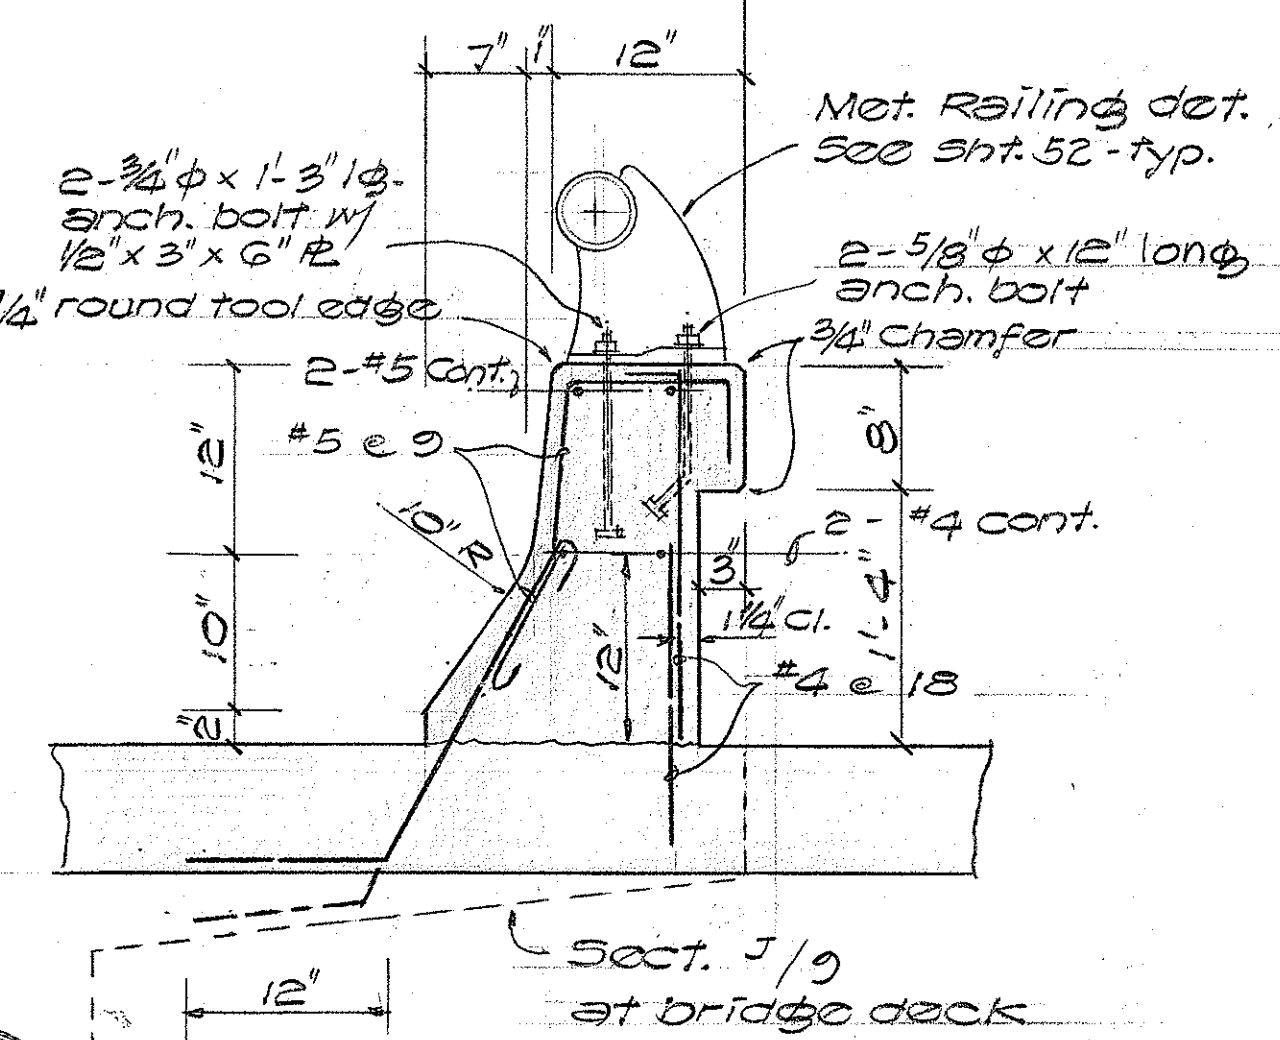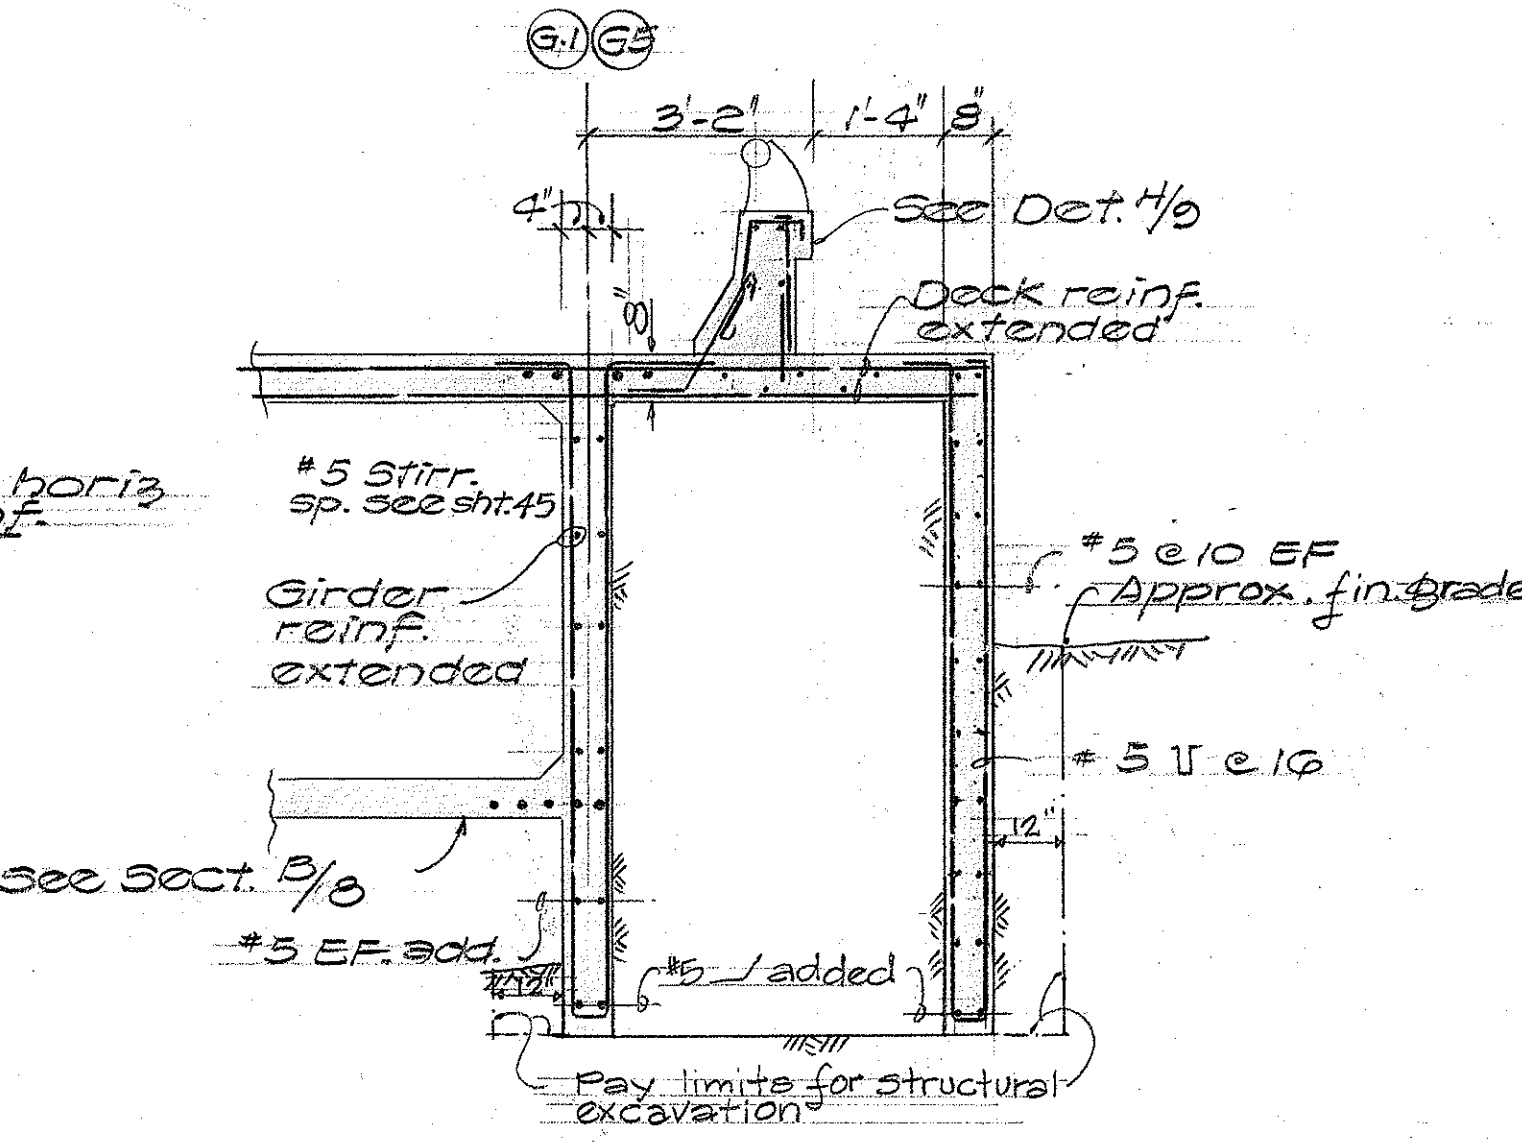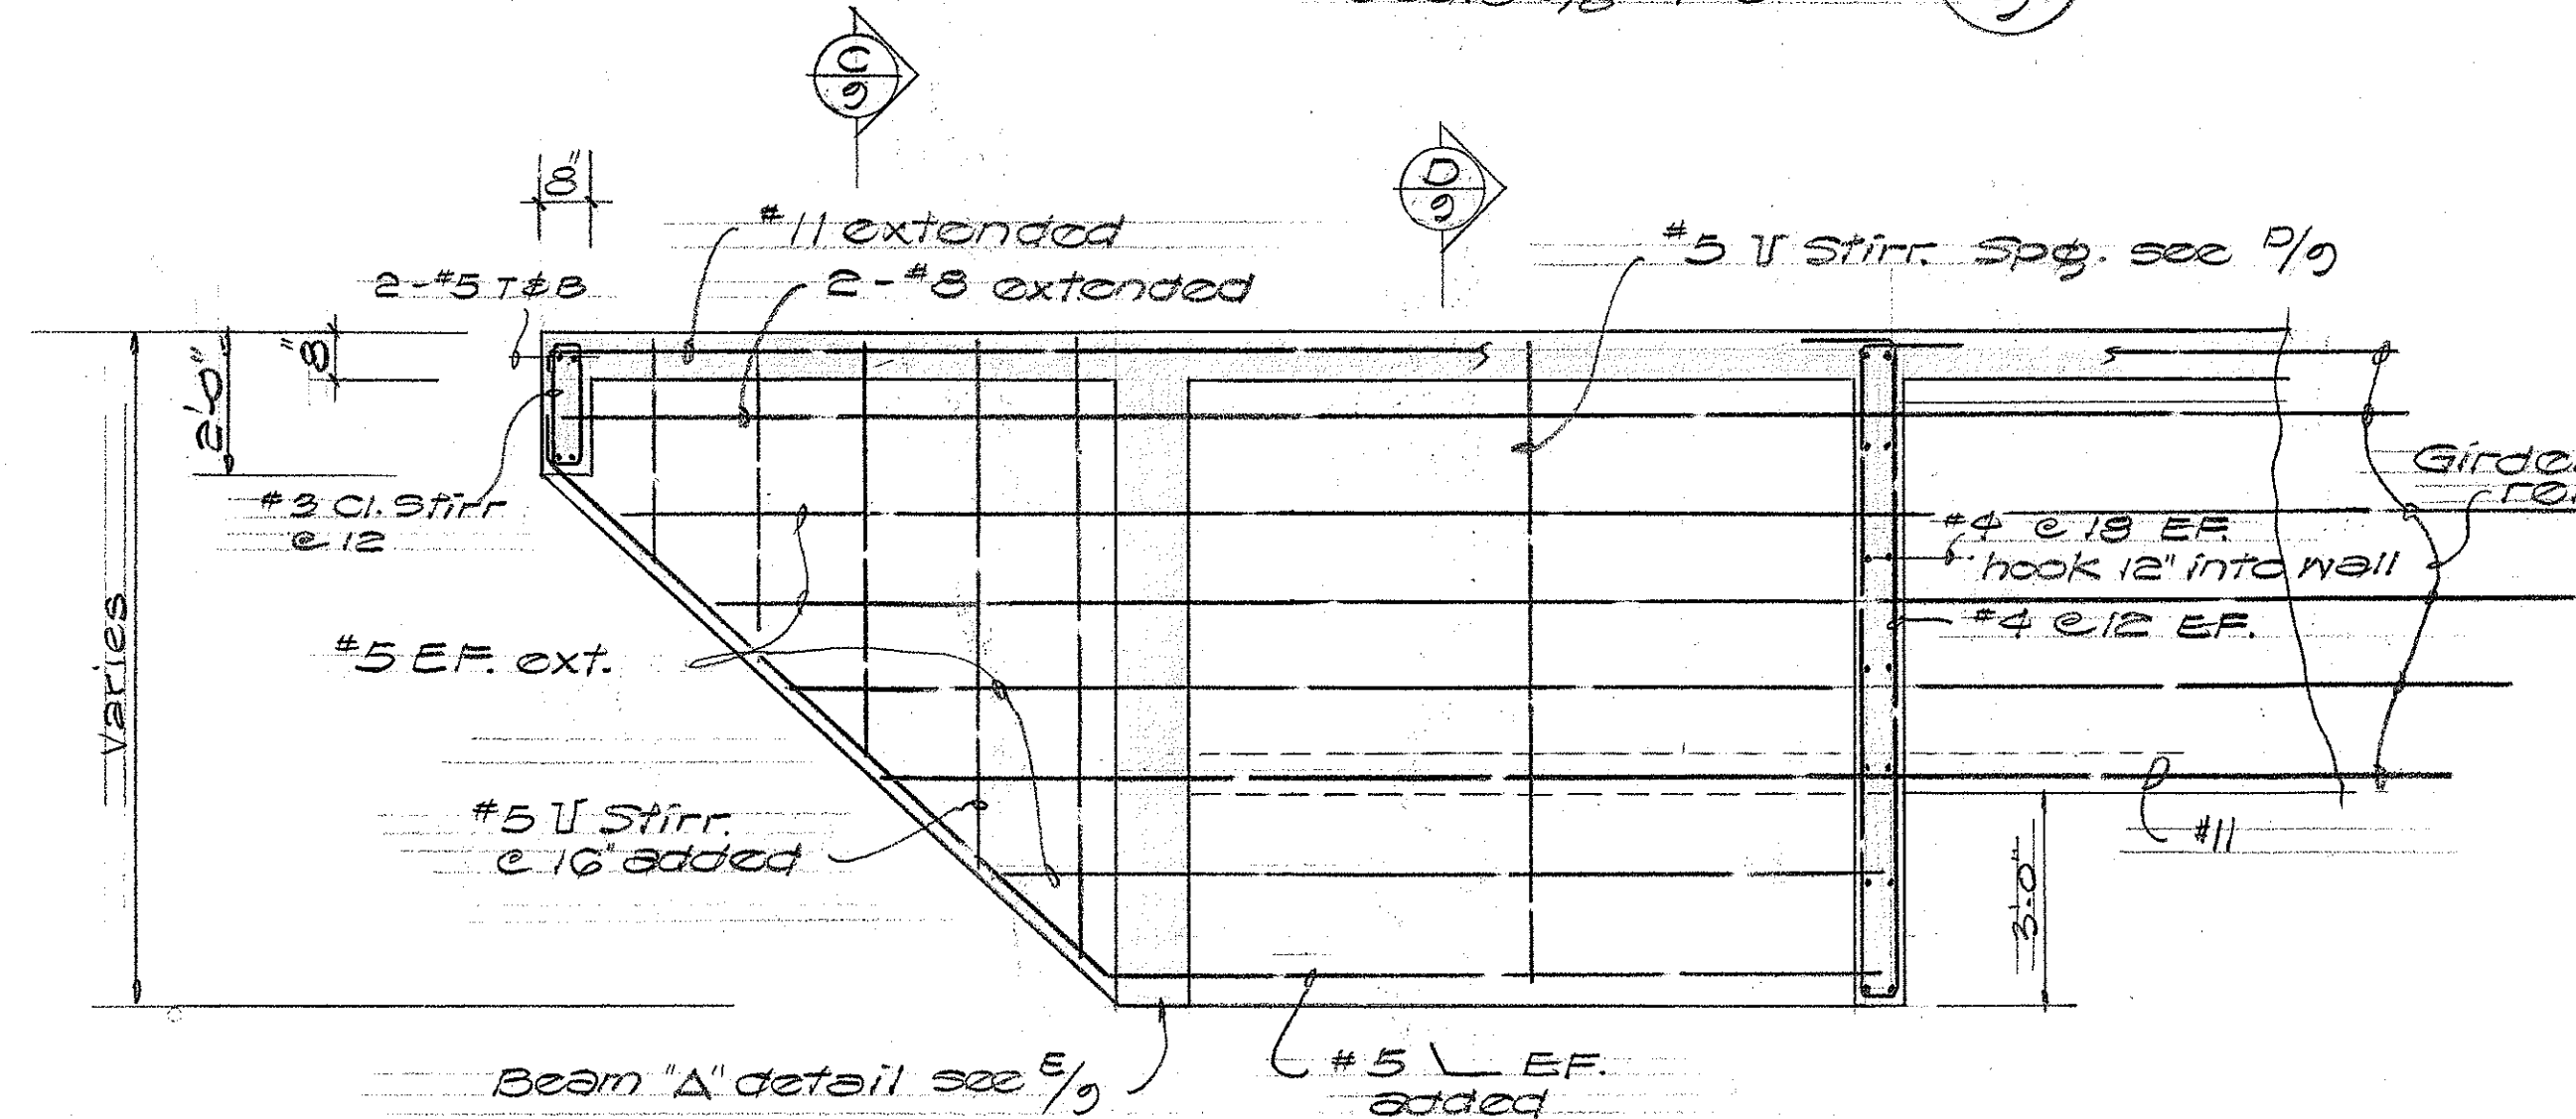

THIS WORK WAS PREPARED BY ME OR UNDER MY SUPERVISION
Kwan Doo Park
Signature

STATE OF HAWAII
DEPARTMENT OF TRANSPORTATION
HIGHWAYS DIVISION


KAILUA INTERCHANGE
STRUCTURE
WING WALL - PLAN, SECT & DET.

F.A.I. Proj No. I-H3-1(7):13, I-H3-1(2):8
SCALE: AS SHOWN DATE: NOV. 1967

SHEET No. 9 OF 13 SHEETS

DATE	
DESIGNED BY	
CHECKED BY	
NOTED BY	
ORIGINAL PLAN	
NO. 1	

FED. ROAD DIST. NO.	STATE	FED. AID PROJ. NO.	FISCAL YEAR	SHEET NO.	TOTAL SHEETS
HAWAII	HAW.	1-H3-1(7)3 1-H3-1(2)3	1968	52	86

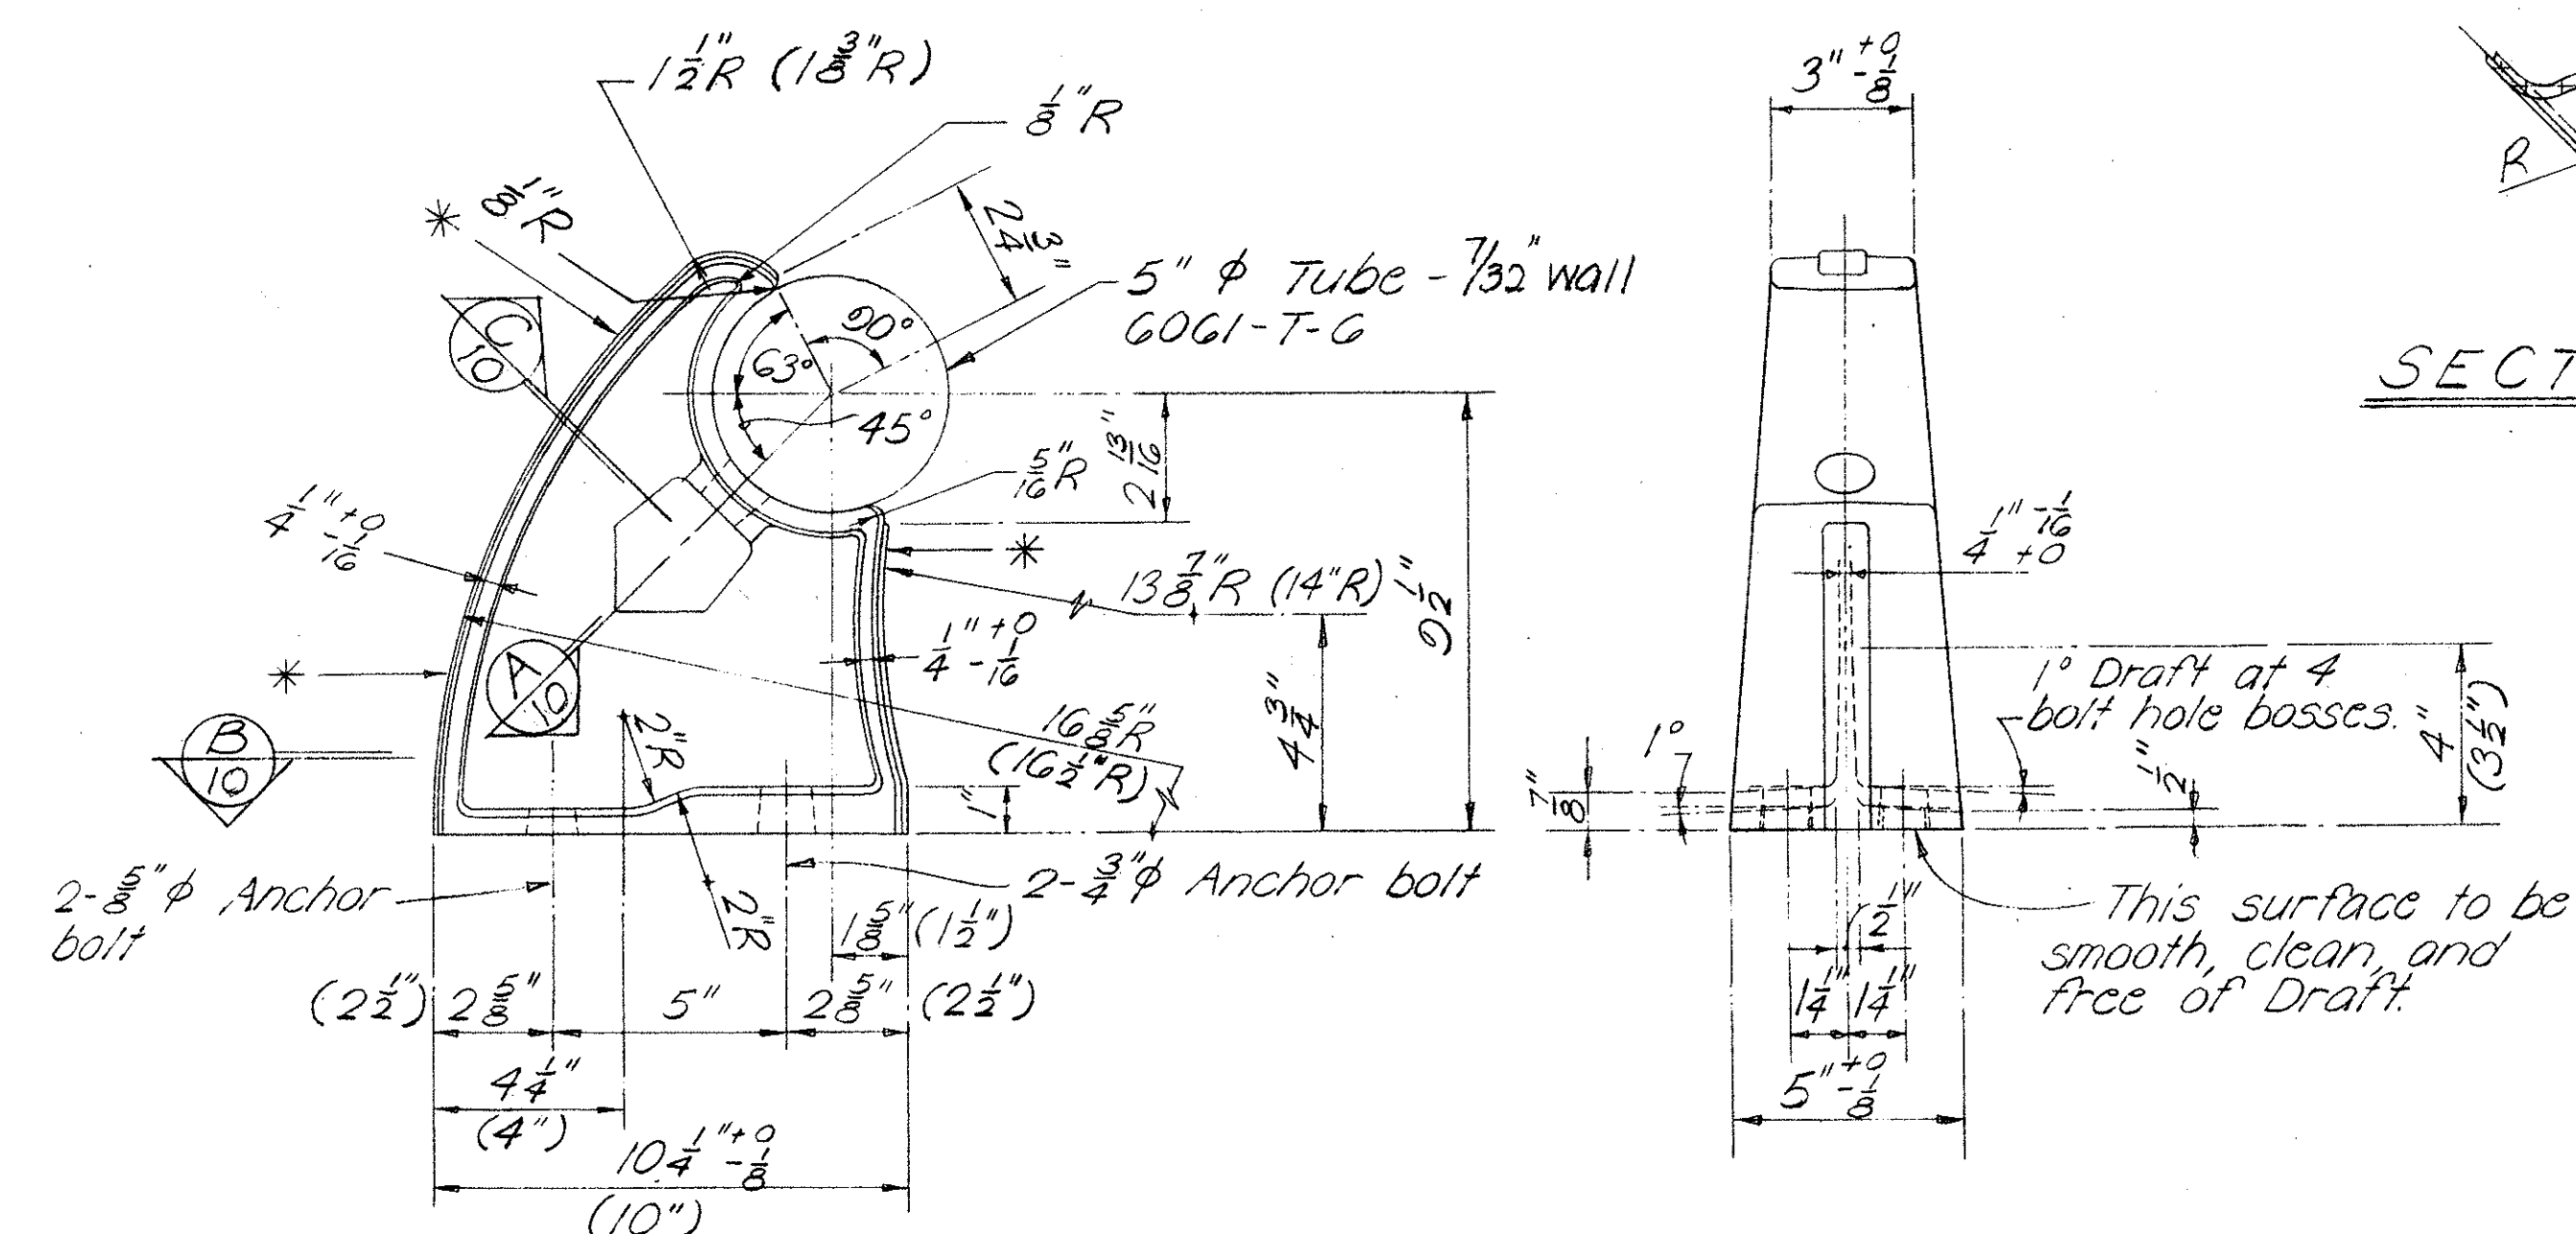

SIDE ELEVATION

END ELEVATION

NOTE:

* Casting to be supplied with a standard scratch brush finish on entire gating rib surface and as indicated by an asterisk (*). Finish shall be approved by the Engineer.

Casting to be neatly trimmed and any protruding flash to be broken off.
for cast post specifications, see Special Provisions.


Unless otherwise specified, draft angles to be 3° , corner radii to be $\frac{3}{32}"R$, fillet radii to be $\frac{3}{32}"R$, casting tol. to be $\pm \frac{1}{32}"$, wall thickness to be $\pm \frac{1}{32}"$.

Dimensions may be as shown or as shown in parenthesis ().

Dimensions may be as shown or as shown in parenthesis ().

TYPICAL RAIL POST DETAILS

Scale: 3" = 1'-0"

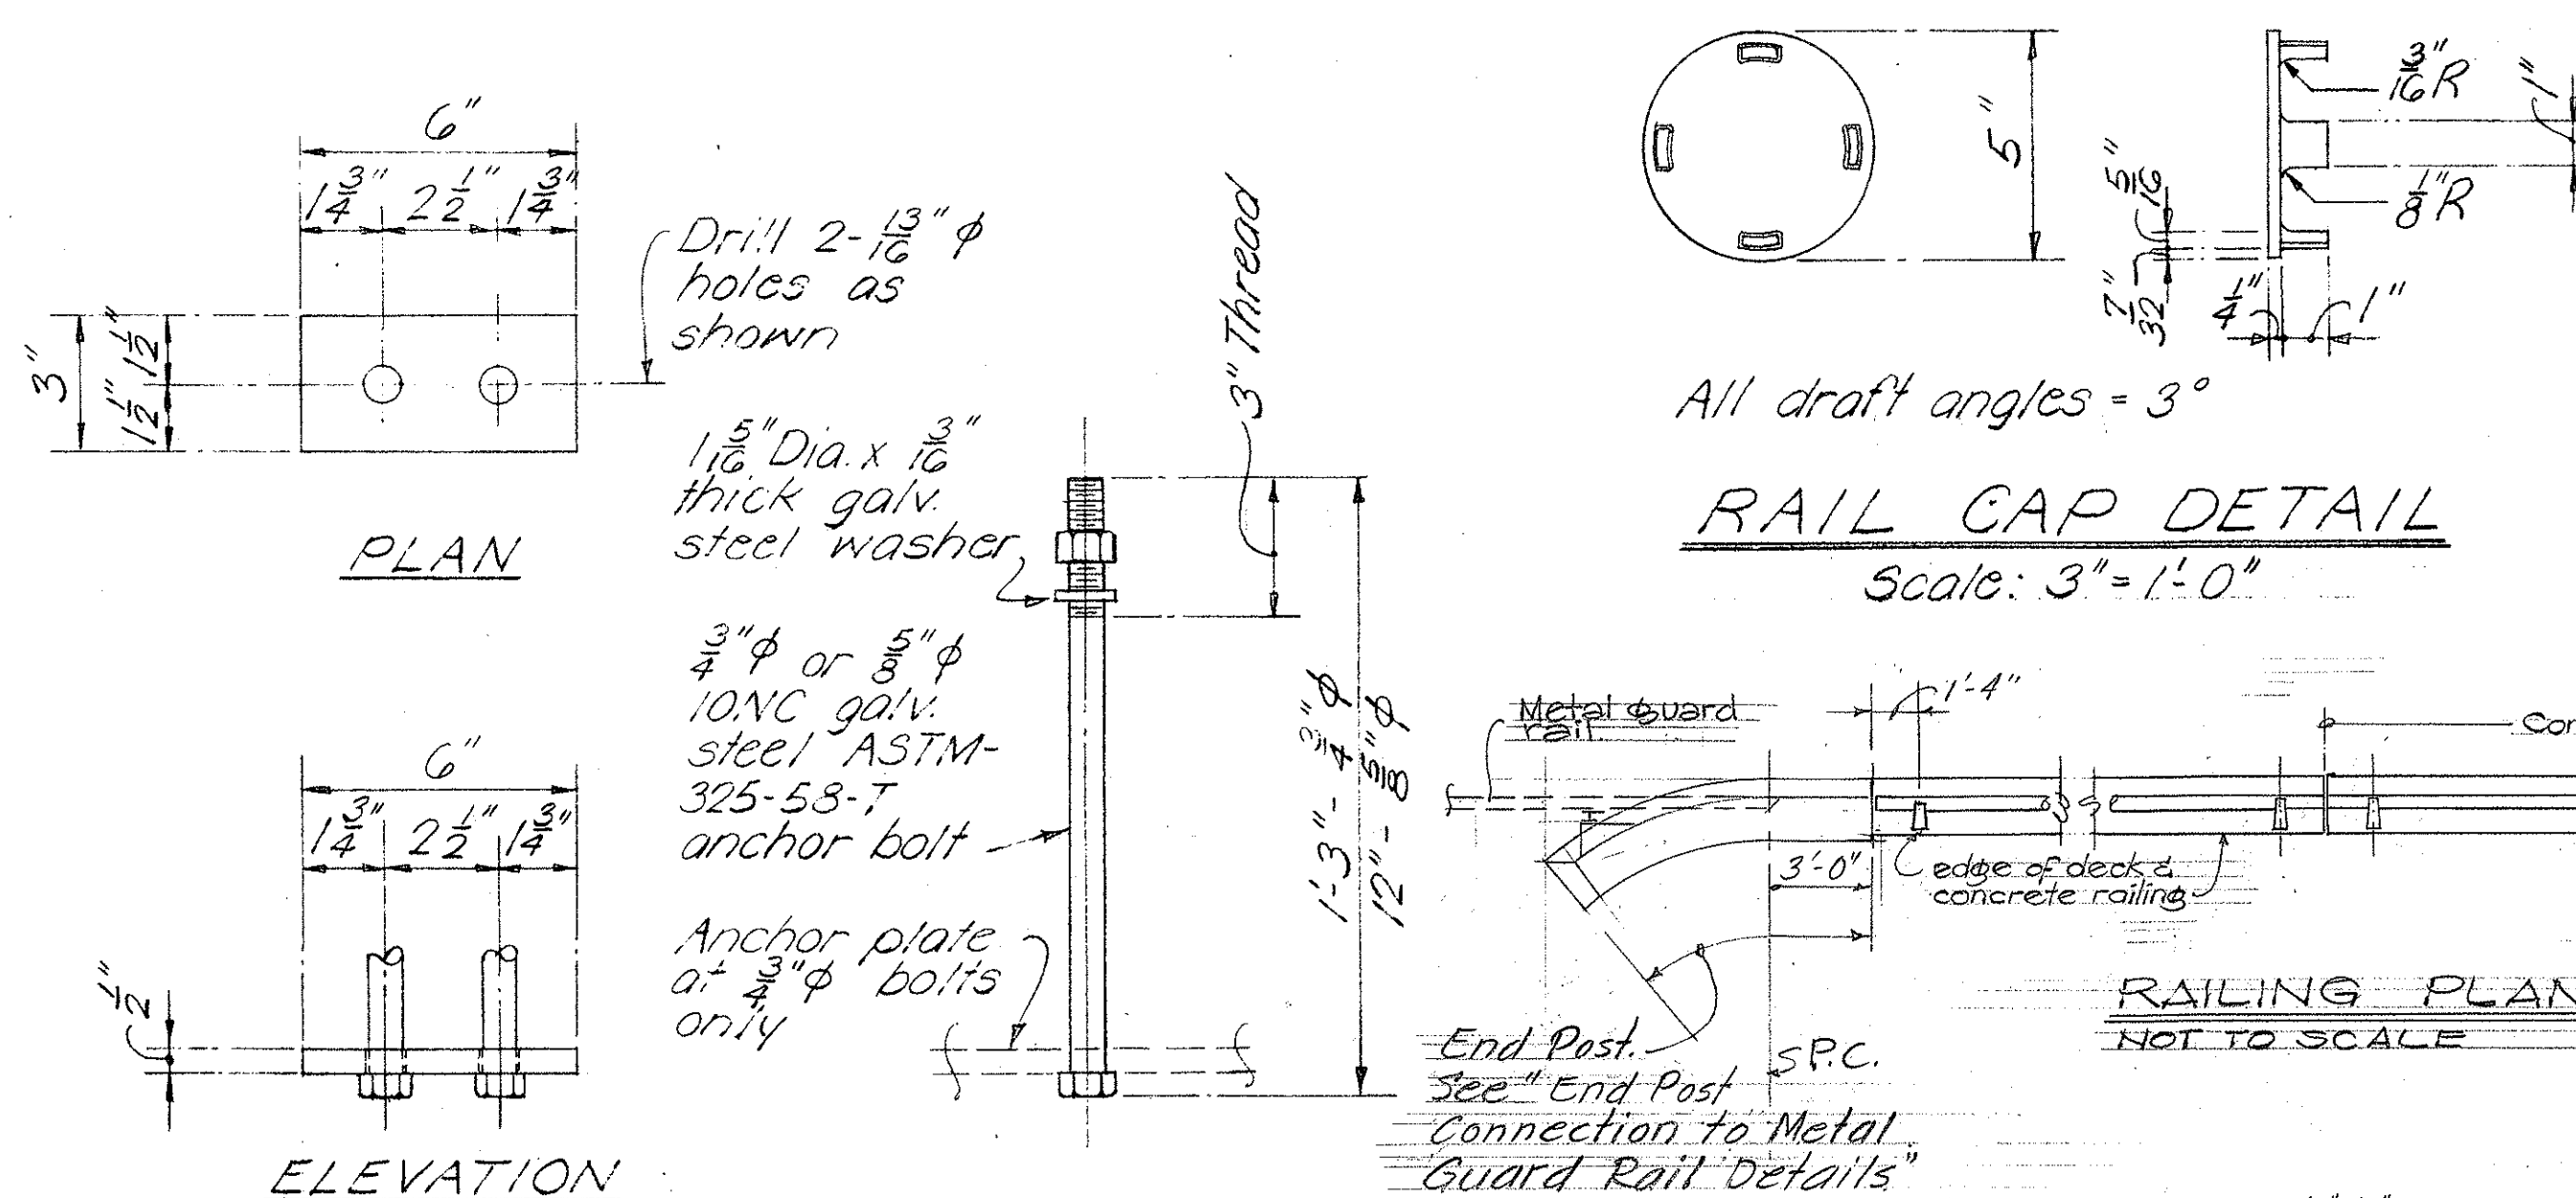

PLAN


LEVATION

ANCHOR ~~PL~~ DETAIL ANCHOR BOLT


TYPICAL RAIL POST

ANCHOR BOLT ASSEMBLY


Scale: 3" = 1'-0"

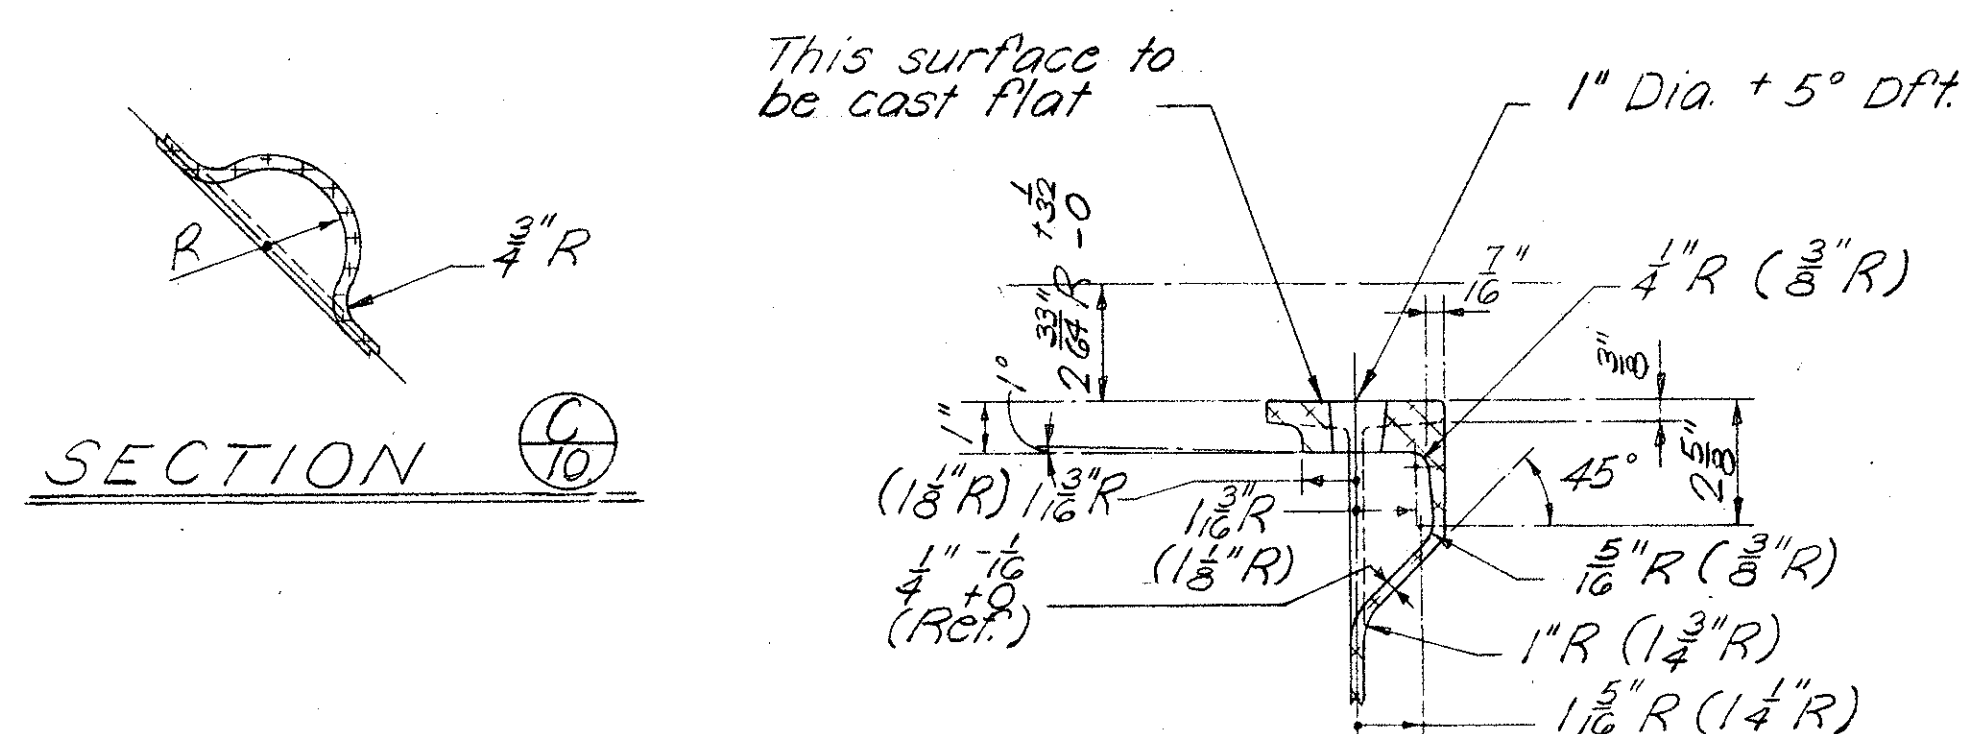

SECTION

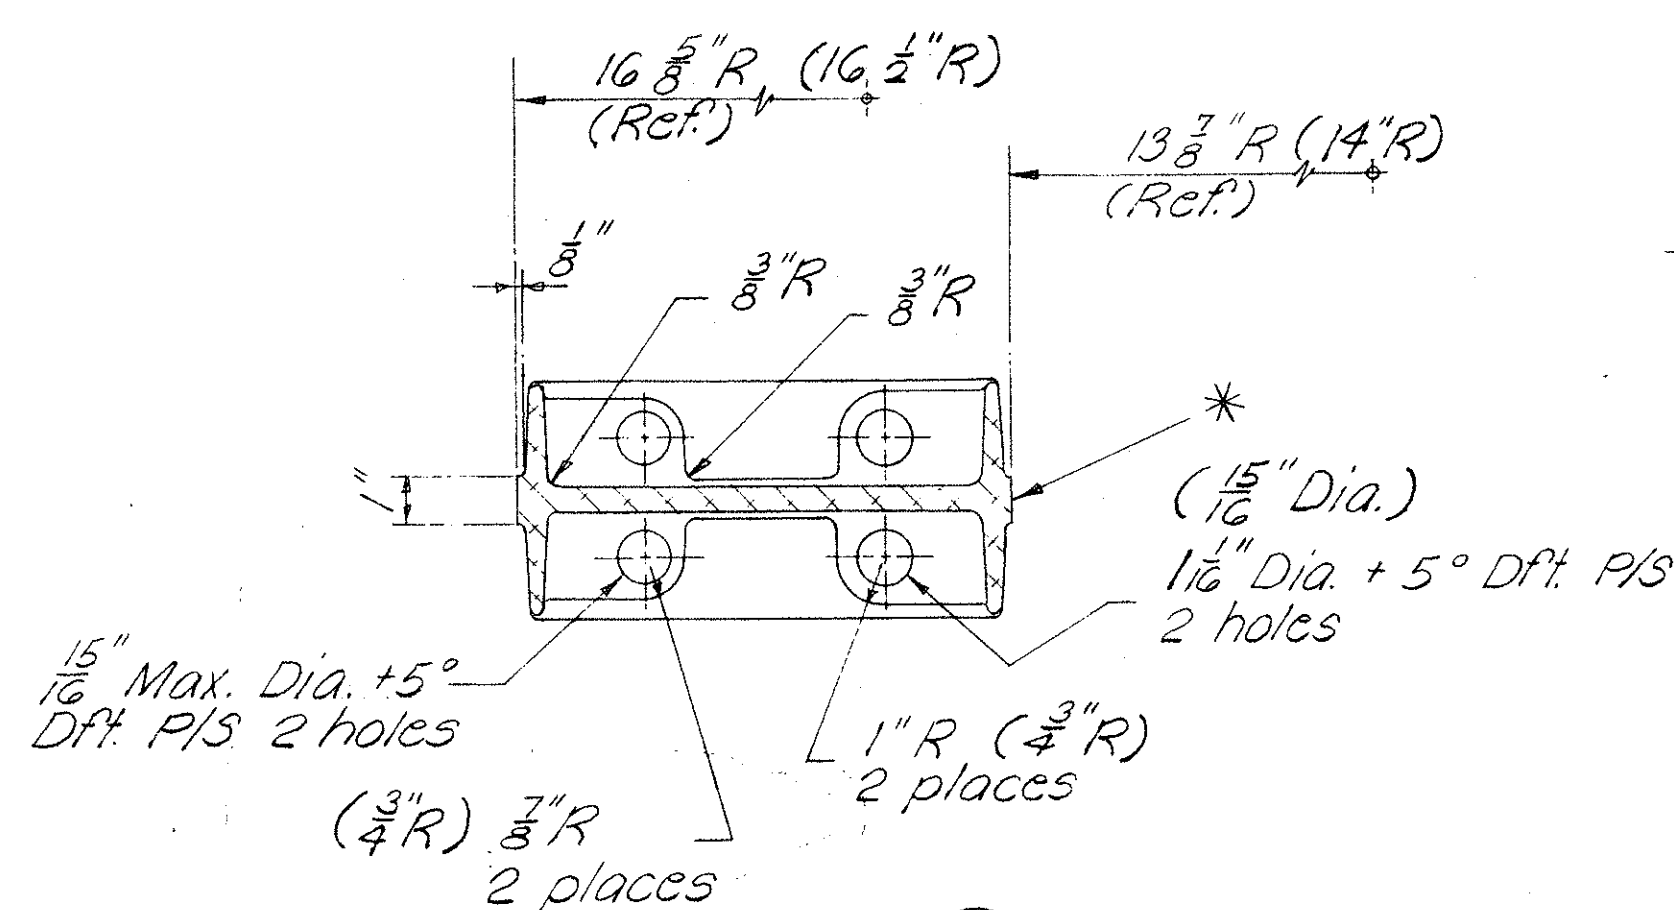
SECTION 

SECTION

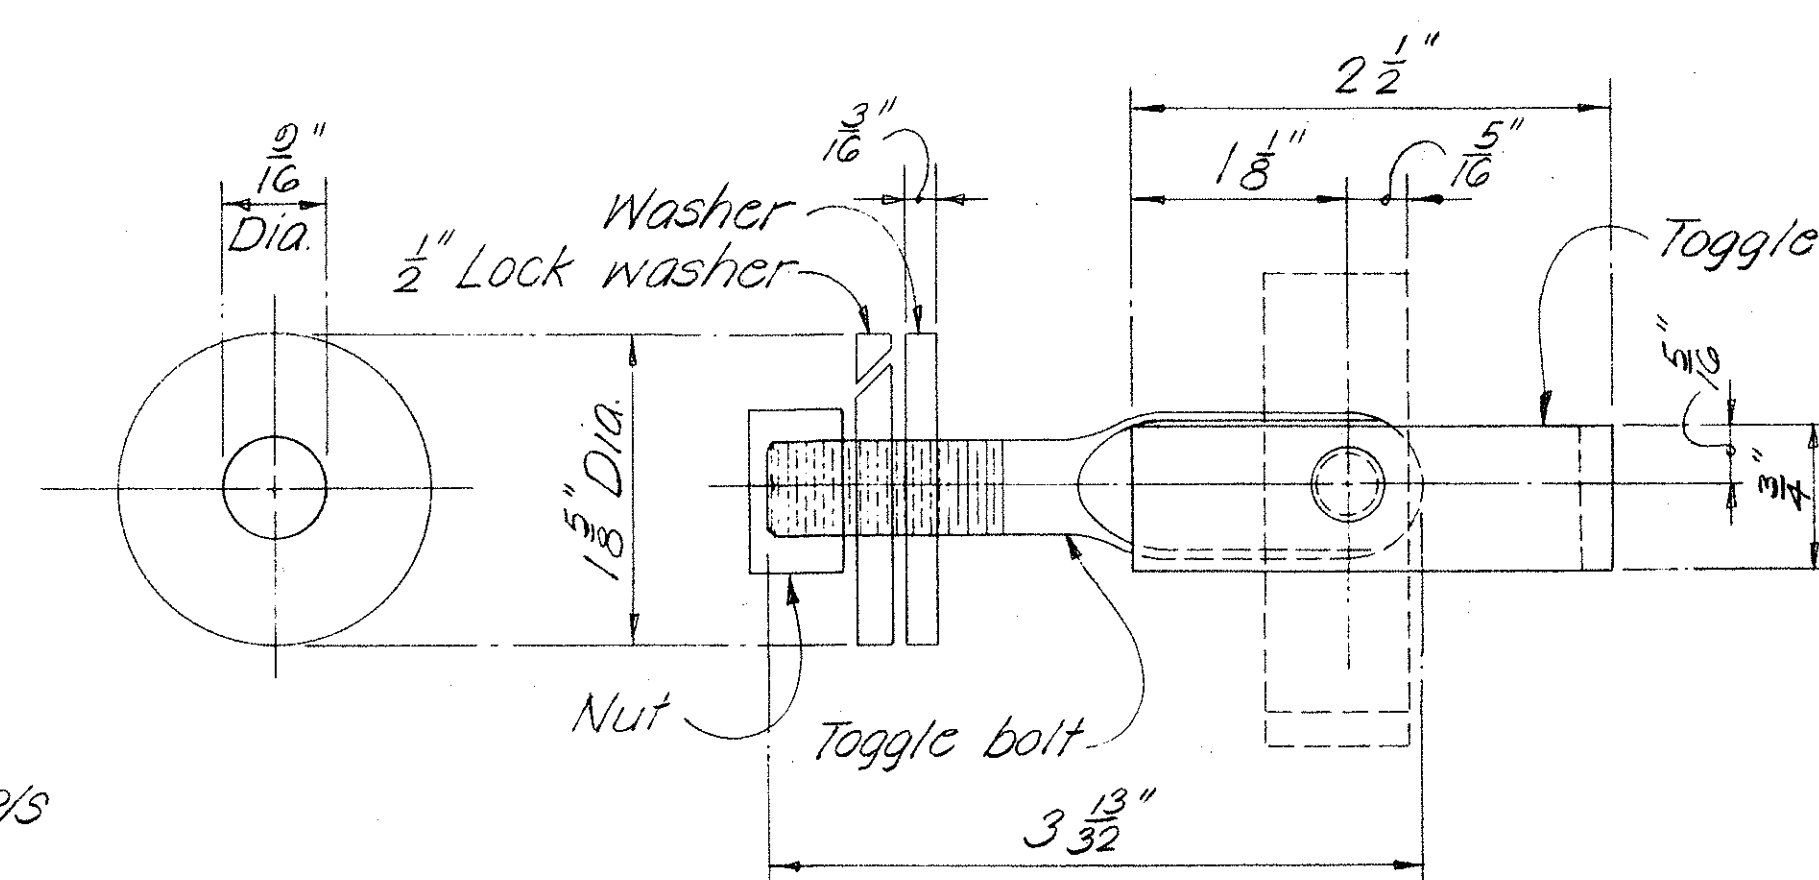

WASHER


SIDE ELEVATION ASSEMBLAGE

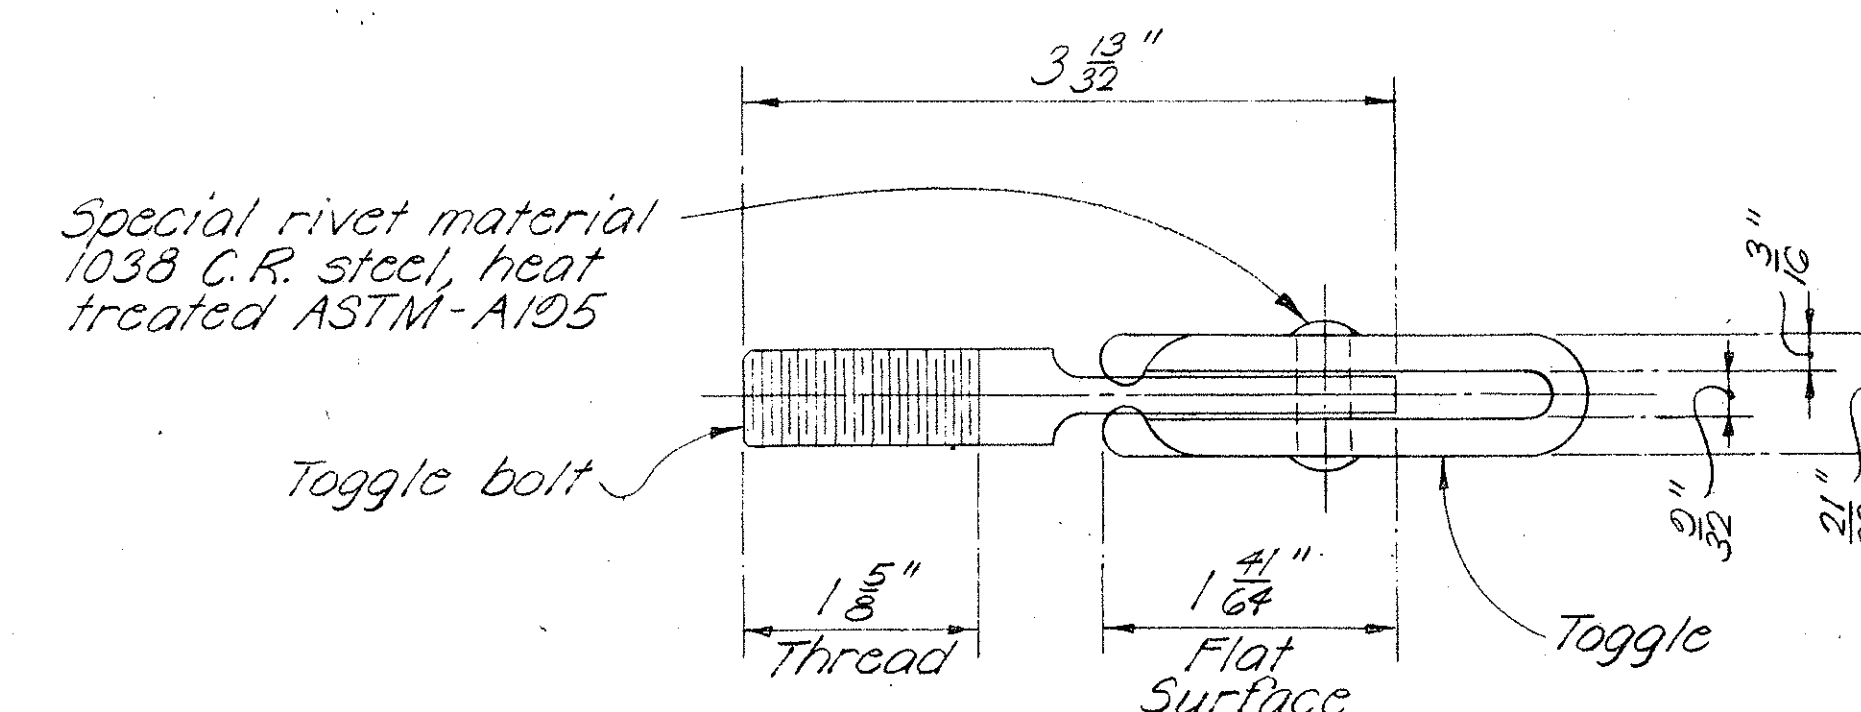

TOP PLAN

$\frac{1}{2}$ " ϕ TOGGLE BOLT DETAILS

Full Scale

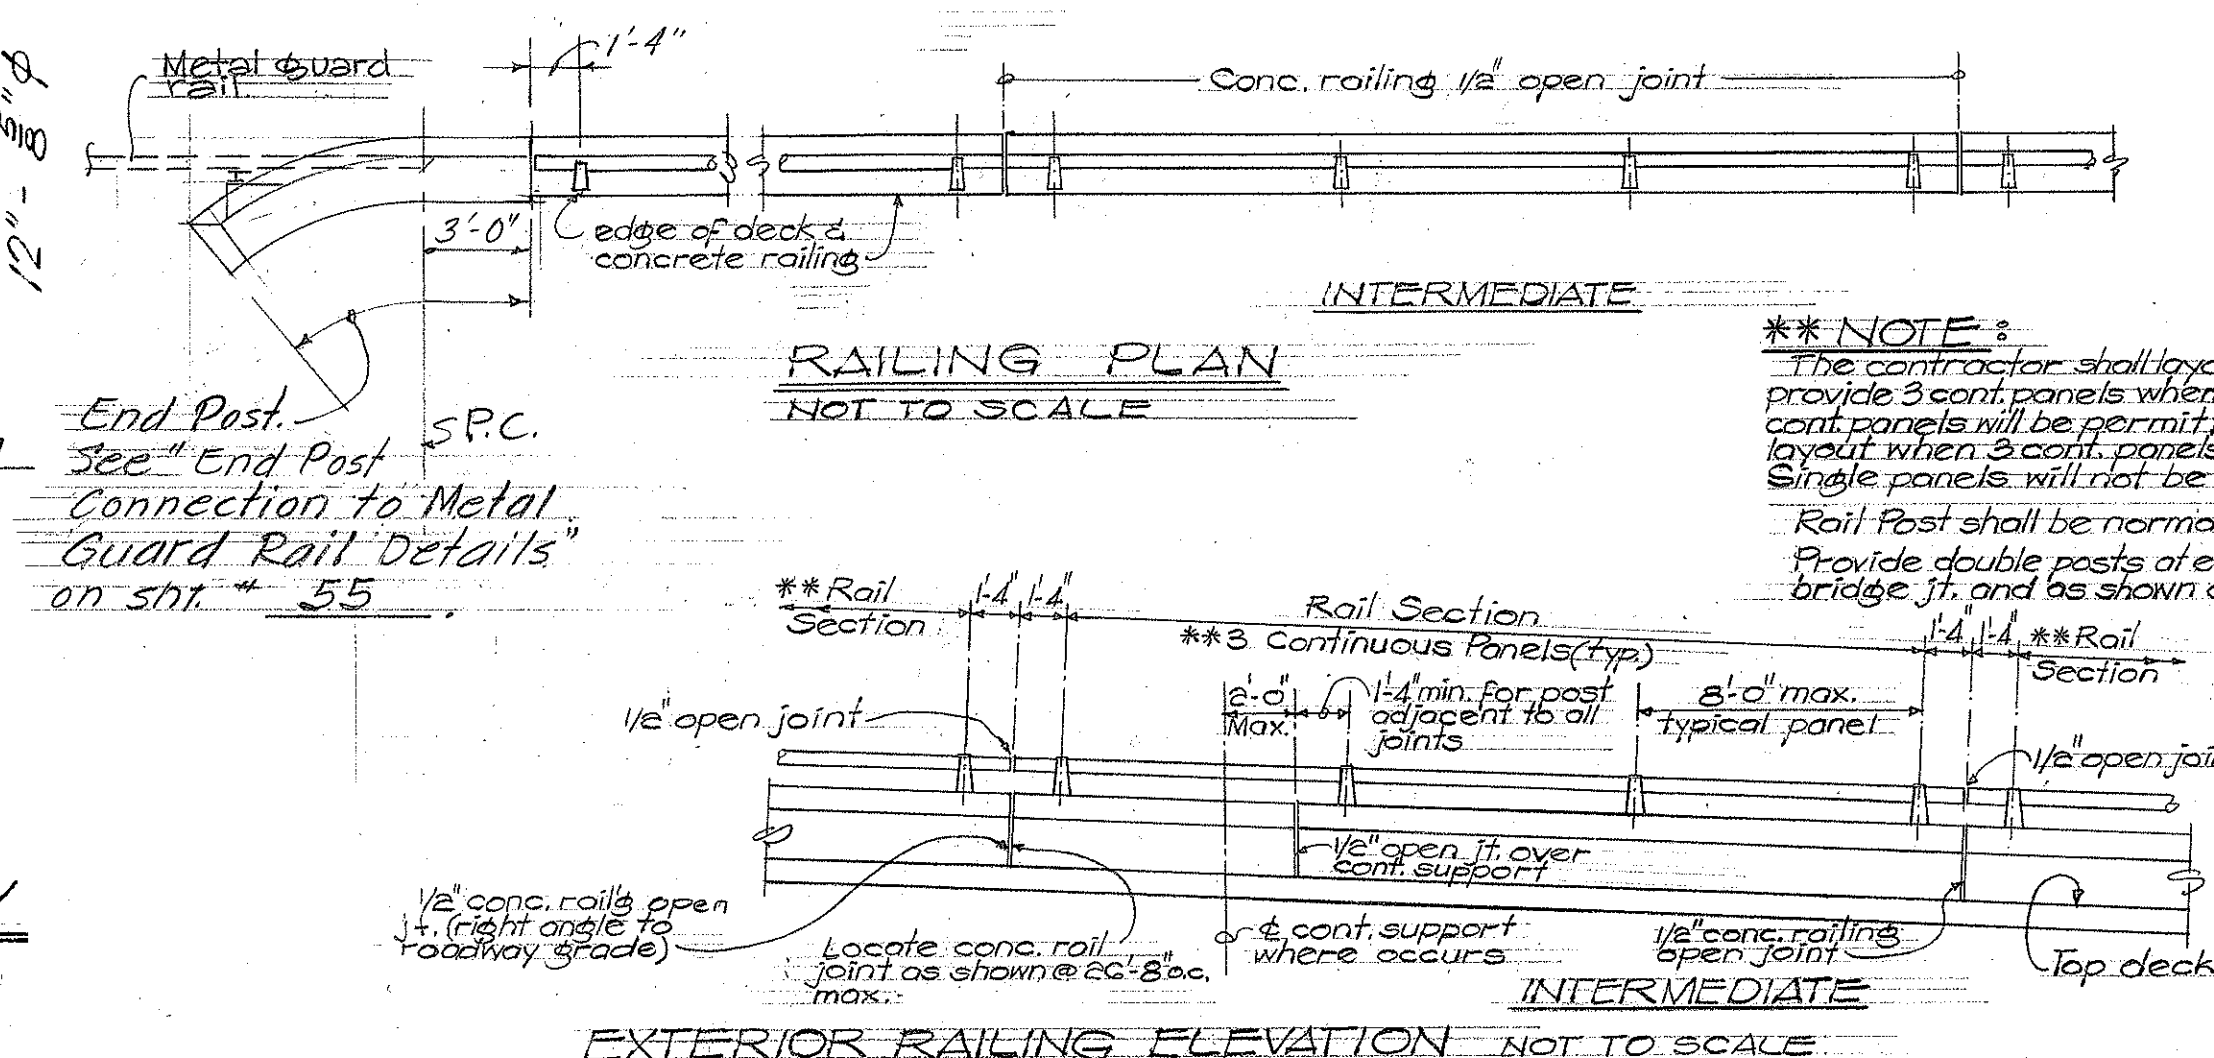

RAILING PLAN
NOT TO SCALE

EXTERIOR RAILING ELEVATION NOT TO SCALE

**** NOTE:**
The contractor shall layout the railing to provide 3 cont. panels whenever possible. For 4 cont. panels will be permitted to complete the layout when 3 cont. panels cannot be made. Single panels will not be permitted.
Rail Post shall be normal to grade.
Provide double posts at each expansion fit, fixed bridge fit, and as shown on detailed drawings.

GENERAL NOTES

Metal bridge railing shown is for Aluminum bridge railing. See Special Provisions for alternate railing in steel.

STATE OF HAWAII
DEPARTMENT OF TRANSPORTATION
HIGHWAYS DIVISION


STANDARD DETAILS
METAL BRIDGE RAILINGS
SINGLE RAIL

F.A.I. Proj. No. I-H3-1(7):13, I-H3-1(2):8
Scale as noted Date: Oct. 1968

July 1967

NOTE:


D = Depth of girder stem to bottom of slab.
S = Distance between top & bott. cont. girder stem longitudinal bars.
For additional details see Normal Section of the Plans.

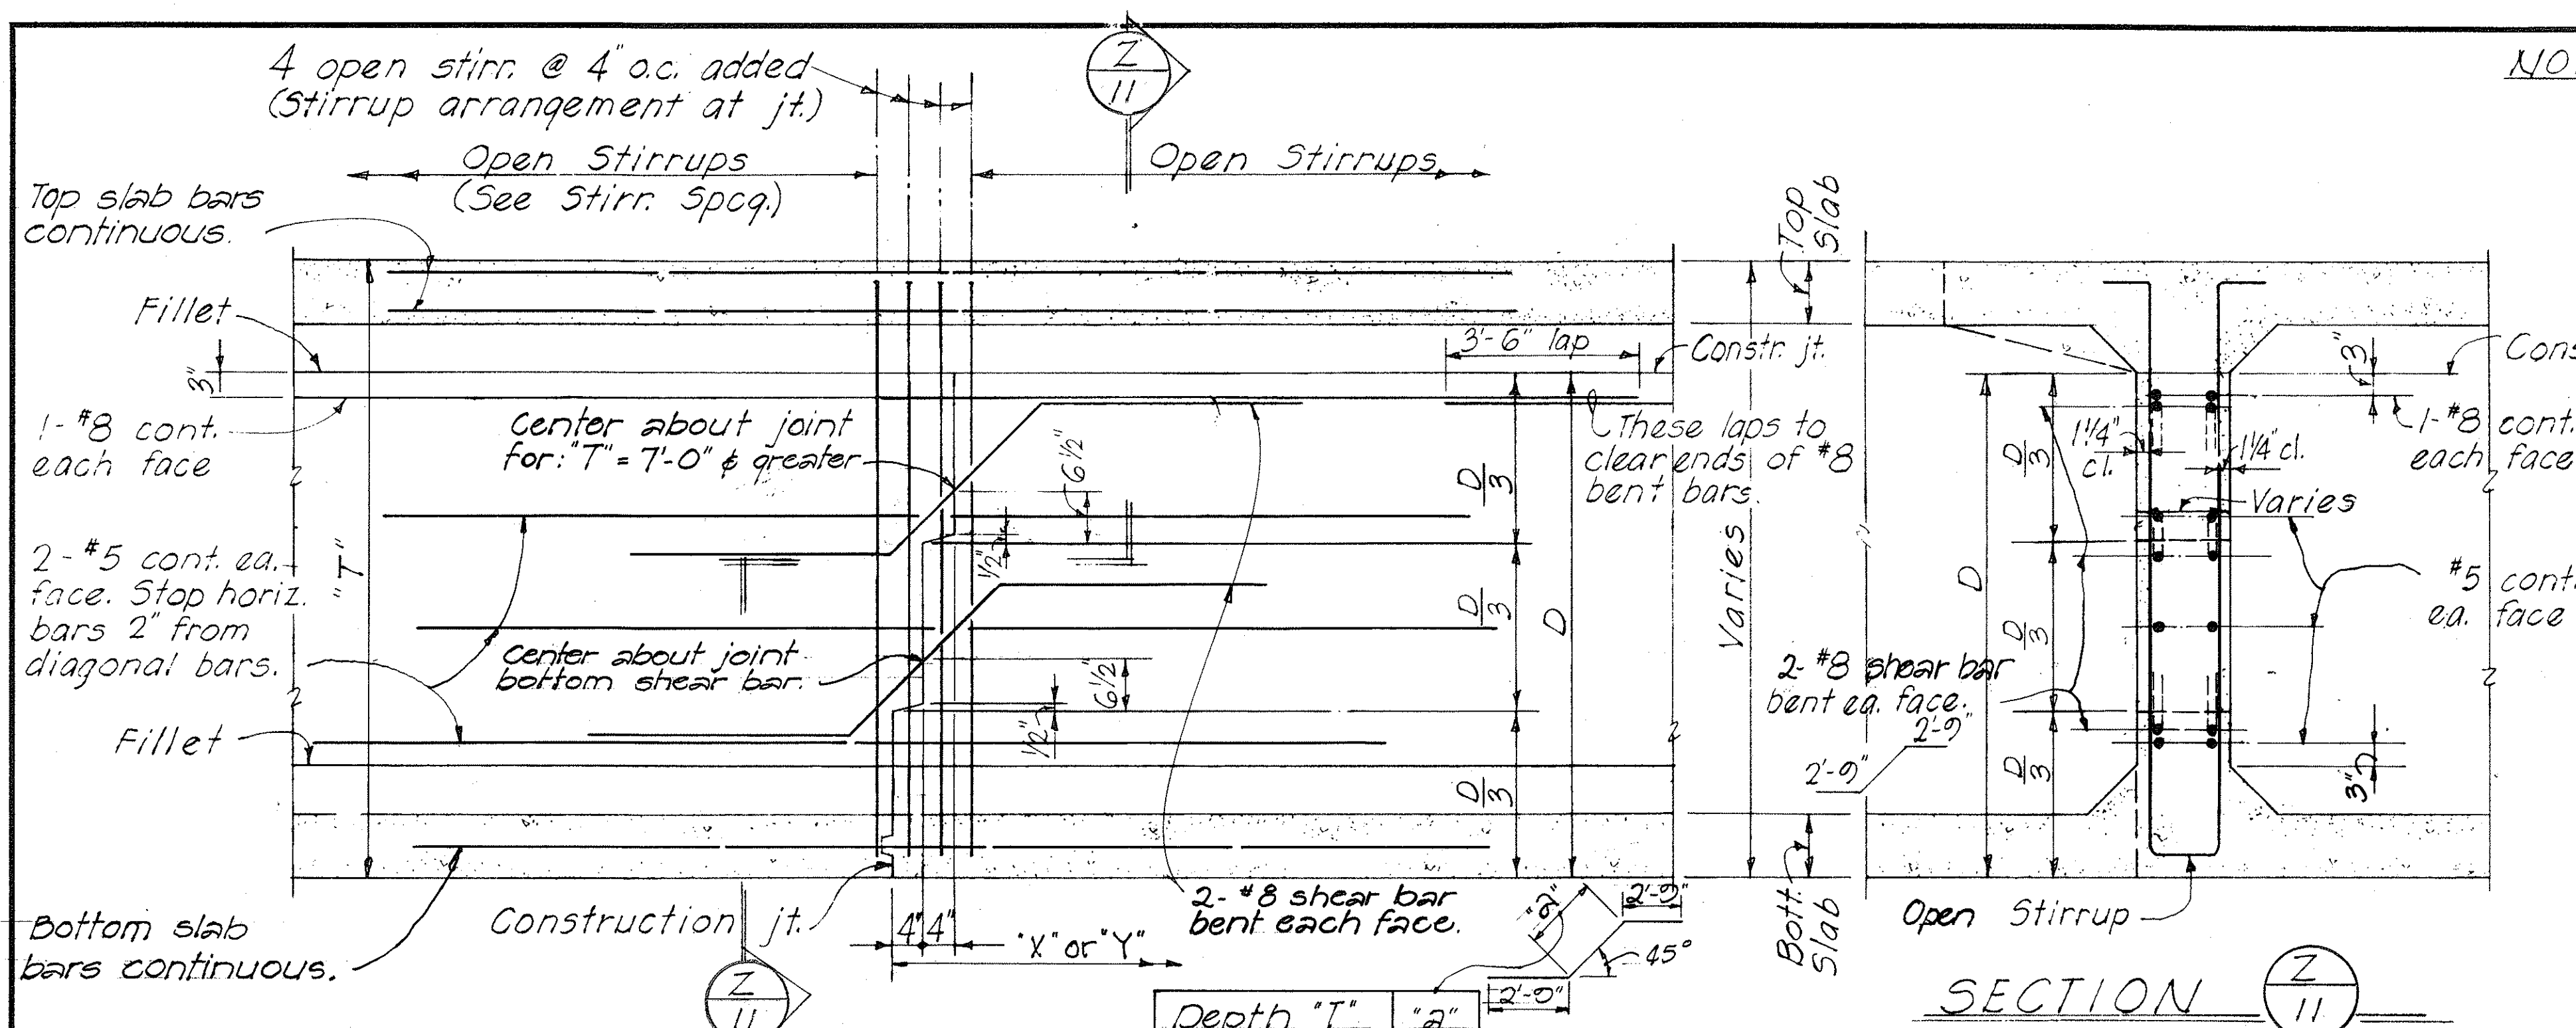

GIRDER STEM CONSTRUCTION JOINT

Depth "T"	"a"
4'-11" & smaller	1'-0"
5'-0" to 5'-11"	2'-0"
6'-0" to 6'-11"	2'-3"
7'-0" & greater	3'-0"


NOTE: D = Depth of girder stem to bott. of slab.

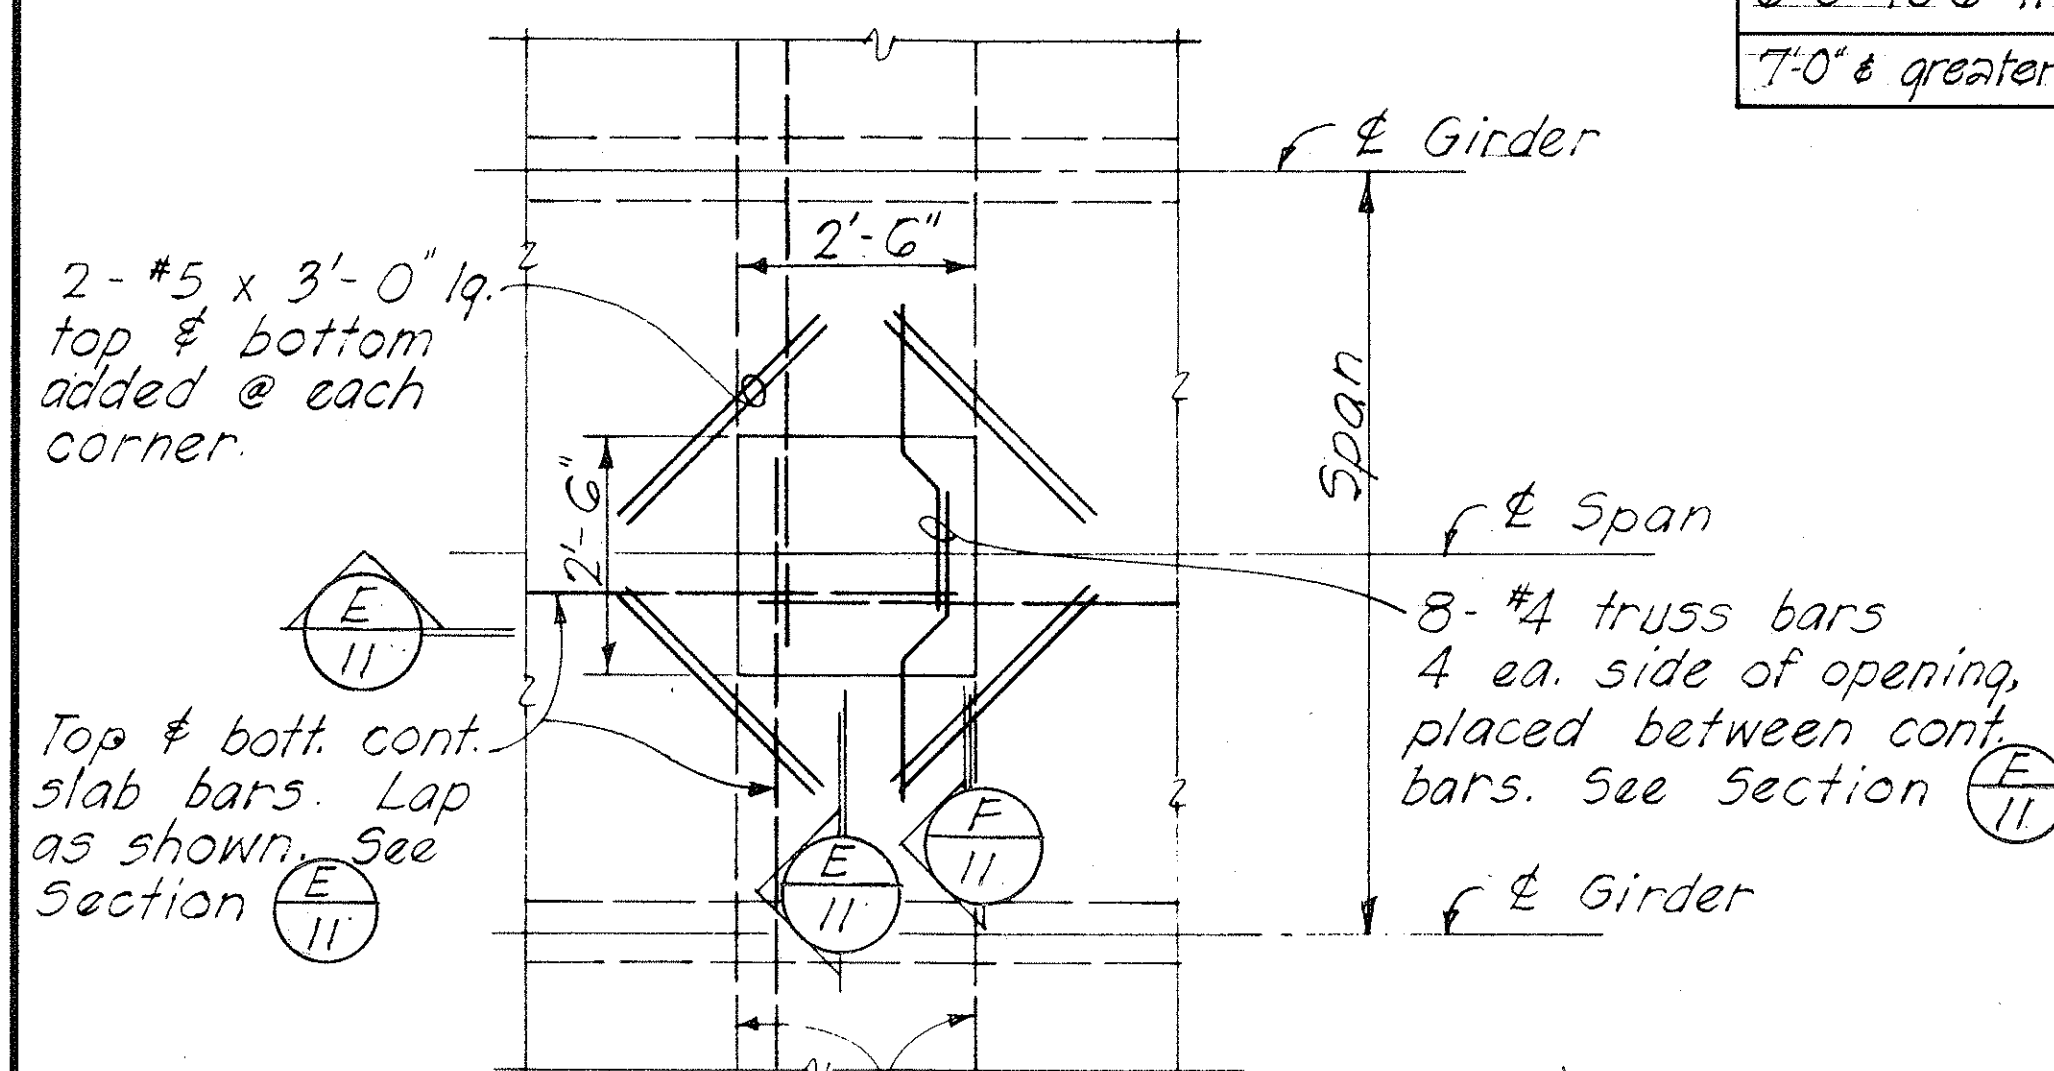


Note: Final location of opening shall be determined by the Engineer

Form removal opening may extend from edge of deck to edge of deck with approval of the Engineer. Lap small longitudinal deck bars as shown on Section E 11

PART PLAN - DECK SHOWING FORM REMOVAL OPENING

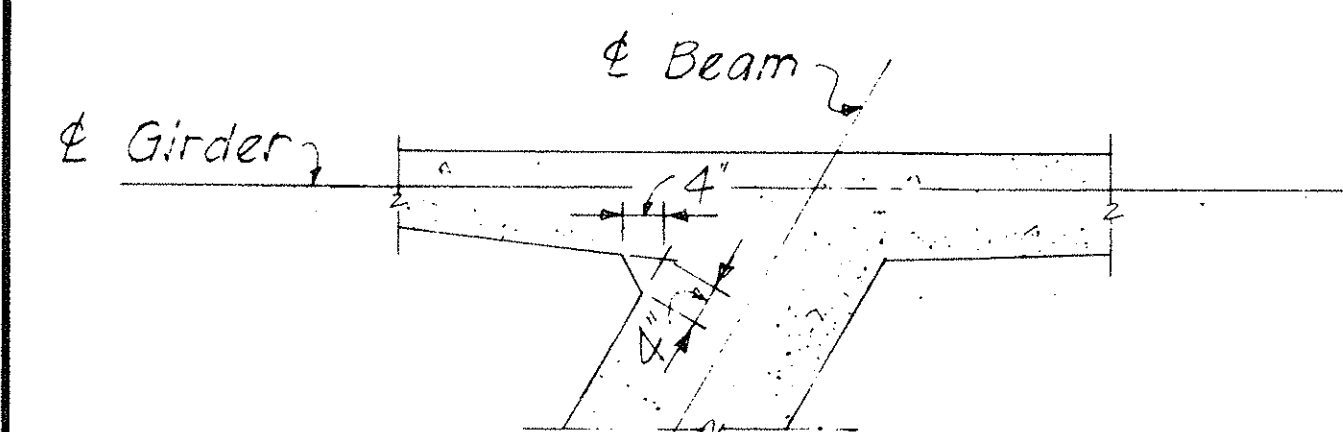


TYPICAL DETAIL OF VERTICAL CHAMFER AT ACUTE INTERSECTION OF SKEWED CONCRETE MEMBER

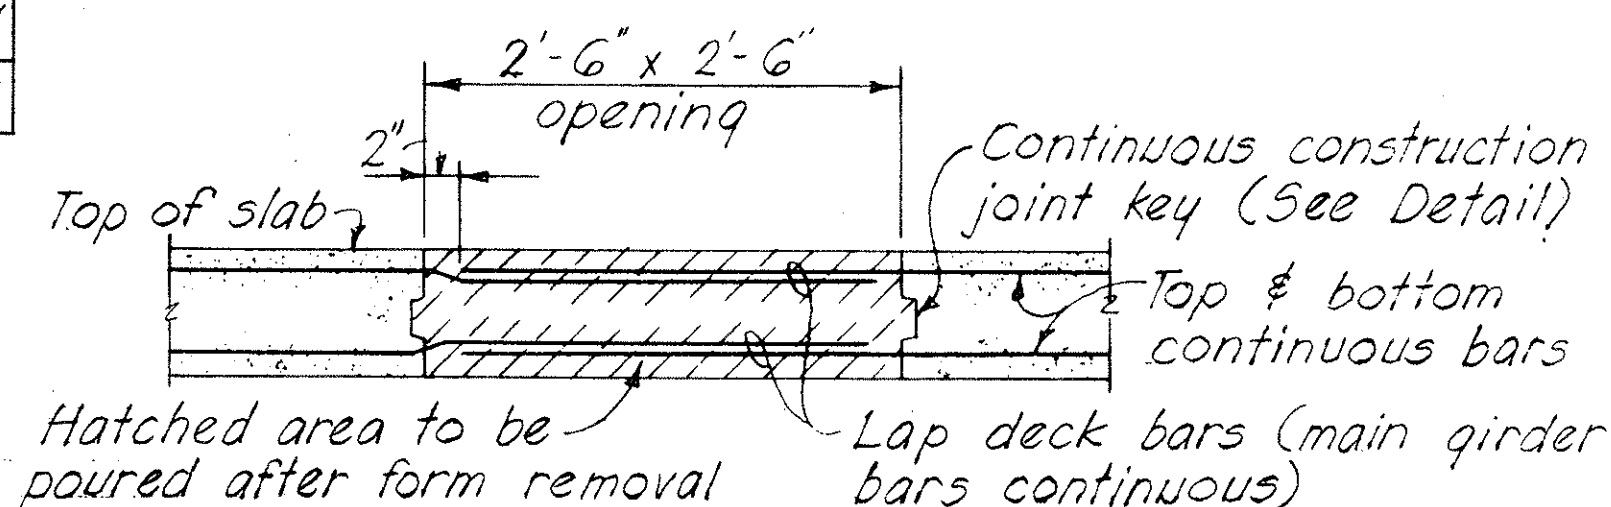

SECTION E 11

Note: Form removal opening at top slab shall not be located where main girder bars occur.

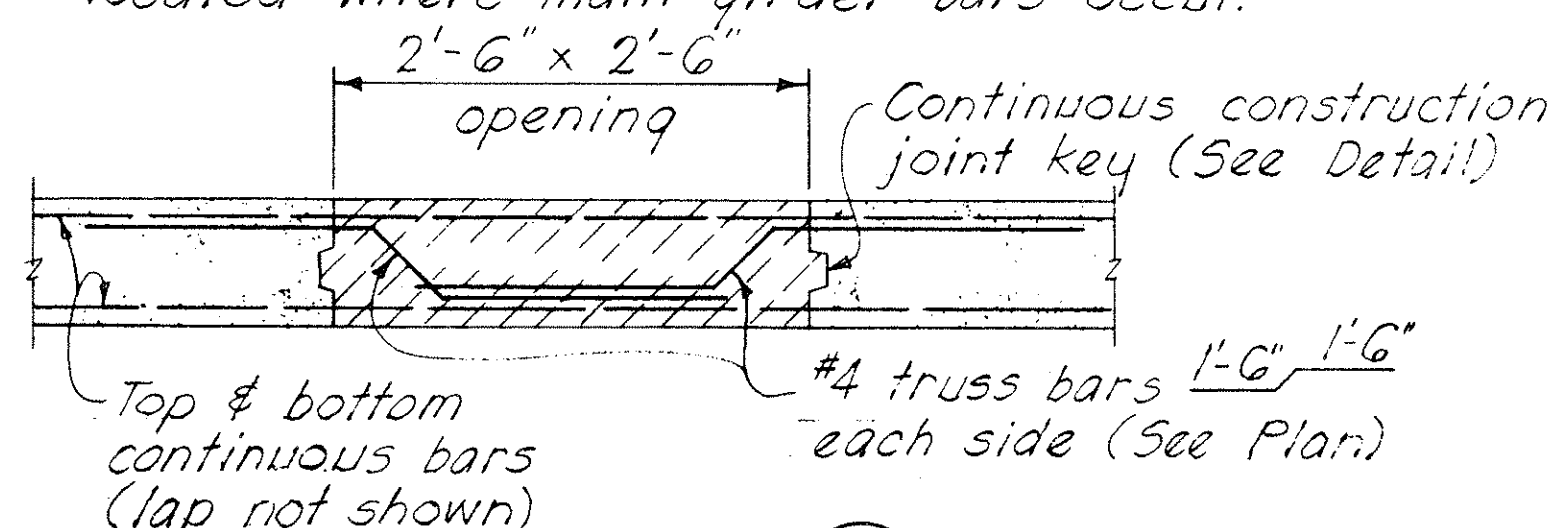

SECTION F 11

STATE OF HAWAII
DEPARTMENT OF TRANSPORTATION
HIGHWAYS DIVISION

STANDARD DETAILS CONCRETE BOX GIRDER

F.A.I. Proj. No. I-H3-1(7):13, I-H3-1(2):8

SCALE AS NOTED DATE: Oct. 1968

SHEET No. 11 OF 13 SHEETS

53 136

REVISION

Jan. '67
Feb. '67
Apr. 67

END POST GROOVE DETAIL Scale: 3" = 1'-0"

GENERAL NOTES

Elastometric Pads: Top & bottom of bridge bearing pads shall be secured against displacement with adhesives approved by the Engineer. Pads shall be incidental to concrete and will not be paid for separately.

- The Contractor shall verify the location of all existing utility lines and notify the respective owners before commencing excavation work.
- All concrete shall be Class A-1 unless otherwise noted.
- Clearance for reinforcing bars shall be as follows, unless otherwise noted:
 - 1 1/2" For stirrups of beams & pier caps.
 - 2" For ties of columns.
 - 2" For formed walls.
 - 3" For footings.
- Concrete seats receiving steel plates, lead plates or neoprene pads shall be poured monolithically with supporting structures & top surfaces of the concrete seats shall be finished with a steel trowel to a smooth level at the elevation shown on the plans.
- Reinforcing shall be detailed in accordance with A.C.I. Manual of Standard Practice for Detailing Reinforced Concrete Highway Structures unless otherwise noted.
- Reinforcing bars shall be securely tied at all intersections & lap splices & shall be held in place during pouring to maintain their proper locations as shown on plans.
- Splices of reinforcing - See Special Provisions.

Waterstop to have 5 or more pairs of raised ribs to provide 0.1 sq. in. min. rib cross-section area on each half of the waterstop. Height of ribs to be 3/32" min.

Nailing Strip:
Nail or staple to form or premolded joint filler.

Holes will be permitted in the outer 1/2" of the web for wires, rings, etc. Tie web to #3 reinforcing bars at 12" max. intervals to support the waterstop in proper position during concrete placement. Alternative detail may be submitted for approval of the Engineer.

SECTION "A-A" TYPICAL EXPANSION JOINT DETAIL

- Minimum spacing between parallel bars shall be 2 1/2 times the diameter of bars, but in no case shall the clear distance between the bars be less than 1 1/2 times the maximum size of the coarse aggregate.
- All dimensions relating to reinforcing are to centers of bars unless otherwise noted.
- Forms for all exposed surfaces of separation structures and surfaces of retaining walls visible from a traveled way or from a populated area shall be plywood except that metal forms may be permitted provided a surface finish satisfactory to the Engineer can be obtained and the use of such forms is approved in writing by the Engineer. Forms for round columns shall be made of materials that will give a smooth finish and true dimensions as given in the plans. Forms for prestressed concrete members shall be either metal or plywood.
- Vertical column bars shall be arranged in such a manner as to miss pier cap bars above as directed by the Engineer.
- Except as otherwise noted on drawings, all exterior corners & re-entrant angles in concrete work shall be chamfered 3/4" x 3/4". See Standard Specifications.
- Concrete Finish - See Special Provisions.
- All welders and welding procedures shall be qualified according to the requirements of the Special Provisions.
- Gothic letters and figures approximating dimensions shown will be acceptable if approved by the Engineer.

NOTE: In case of over excavation, the contractor shall backfill this area with minimum class D-1 concrete at his own expense.

TYPICAL EXCAVATION FOR CONTINUOUS FOOTING STEP-UP

TYPICAL DETAIL OF LETTERS & FIGURES AT CONCRETE END POST

NOTE: Refer to corresponding detail drawings for placement of such names & dates at end post. Exact details & spacing of letters & figures shall be as directed by the Engineer. See Note #15.

CONTROL JOINT DETAIL

Cont. vertical control joint
Wall face 3/4" chamfer
Front Face
Back Face
Flashings compound back face only
Joint may be formed with 1/2" masonite & cut back to the root of the chamfer on the exposed face.
Wall thickness
Vent. control joint on each face of wall to top of footing. See adjacent detail and as directed by the Engineer.

DRIP DET.

Provide opening or sufficient size to insert head of bolt.

SECTION "G-G"

TYPICAL DRAINAGE DETAILS

Cast Iron ASTM A43 Class N° 30.
Contractor to take proper precautions to prevent the concrete from flowing into the opening of the inserts.
Joint may be formed with 1/2" masonite & cut back to the root of the chamfer on the exposed face.
Wall thickness
Front Face
Back Face
Flashings compound back face only
Joint may be formed with 1/2" masonite & cut back to the root of the chamfer on the exposed face.
Wall thickness
Front Face
Back Face
Flashings compound back face only

INSERT DETAIL

Cast Iron Insert (Incidental to Class A-1 concrete)
Bolt
Drip Detail (above)

DETAIL of PIPE HANGERS & INSERTS

Expansion joint width and continuous premolded joint filler, see contract drawings.

ELEVATION

SECTION "Z-Z"

PLAN

PLAN



Depress drain 1/2" below gutter grade.
Gutter grade
Nearing surface
Slab
6" std. steel pipe
2'-0" width
9" depth
3/4" plain bars
Weld
6" Standard pipe
2 1/2" cl.
3/4" plain bars
Weld
6" Std. pipe
I.D. of pipe
Z-Z

Uniform slope all around
Gutter grade
Slab
6" std. steel pipe
Variable
3/4" plain bars
Girder
2'-0" width
9" depth
3/4" plain bars
Weld
6" Standard pipe
2 1/2" cl.
3/4" plain bars
Weld
6" Std. pipe
I.D. of pipe
Z-Z


Continuous waterstop where required, see adjacent detail.
Continuous joint seal thruout.
Reference edge of concrete deck.
Sidewalk or Curb
Outline continuous premolded joint filler thruout. See corresp. bridge detail drawings for depth.
12" width
3/4" plain bars
6" Standard pipe
Z-Z

DATE
SURVEY PLOTTED BY
DRAWN BY
CHECKED BY
NOTE BOOK
No.


FED. ROAD DIST. NO.	STATE	FED. AID PROJ. NO.	FISCAL YEAR	SHEET NO.	TOTAL SHEETS
HAWAII	HAW.	I-H3-(7)-13 I-H3-(2)-8	1968	55	86

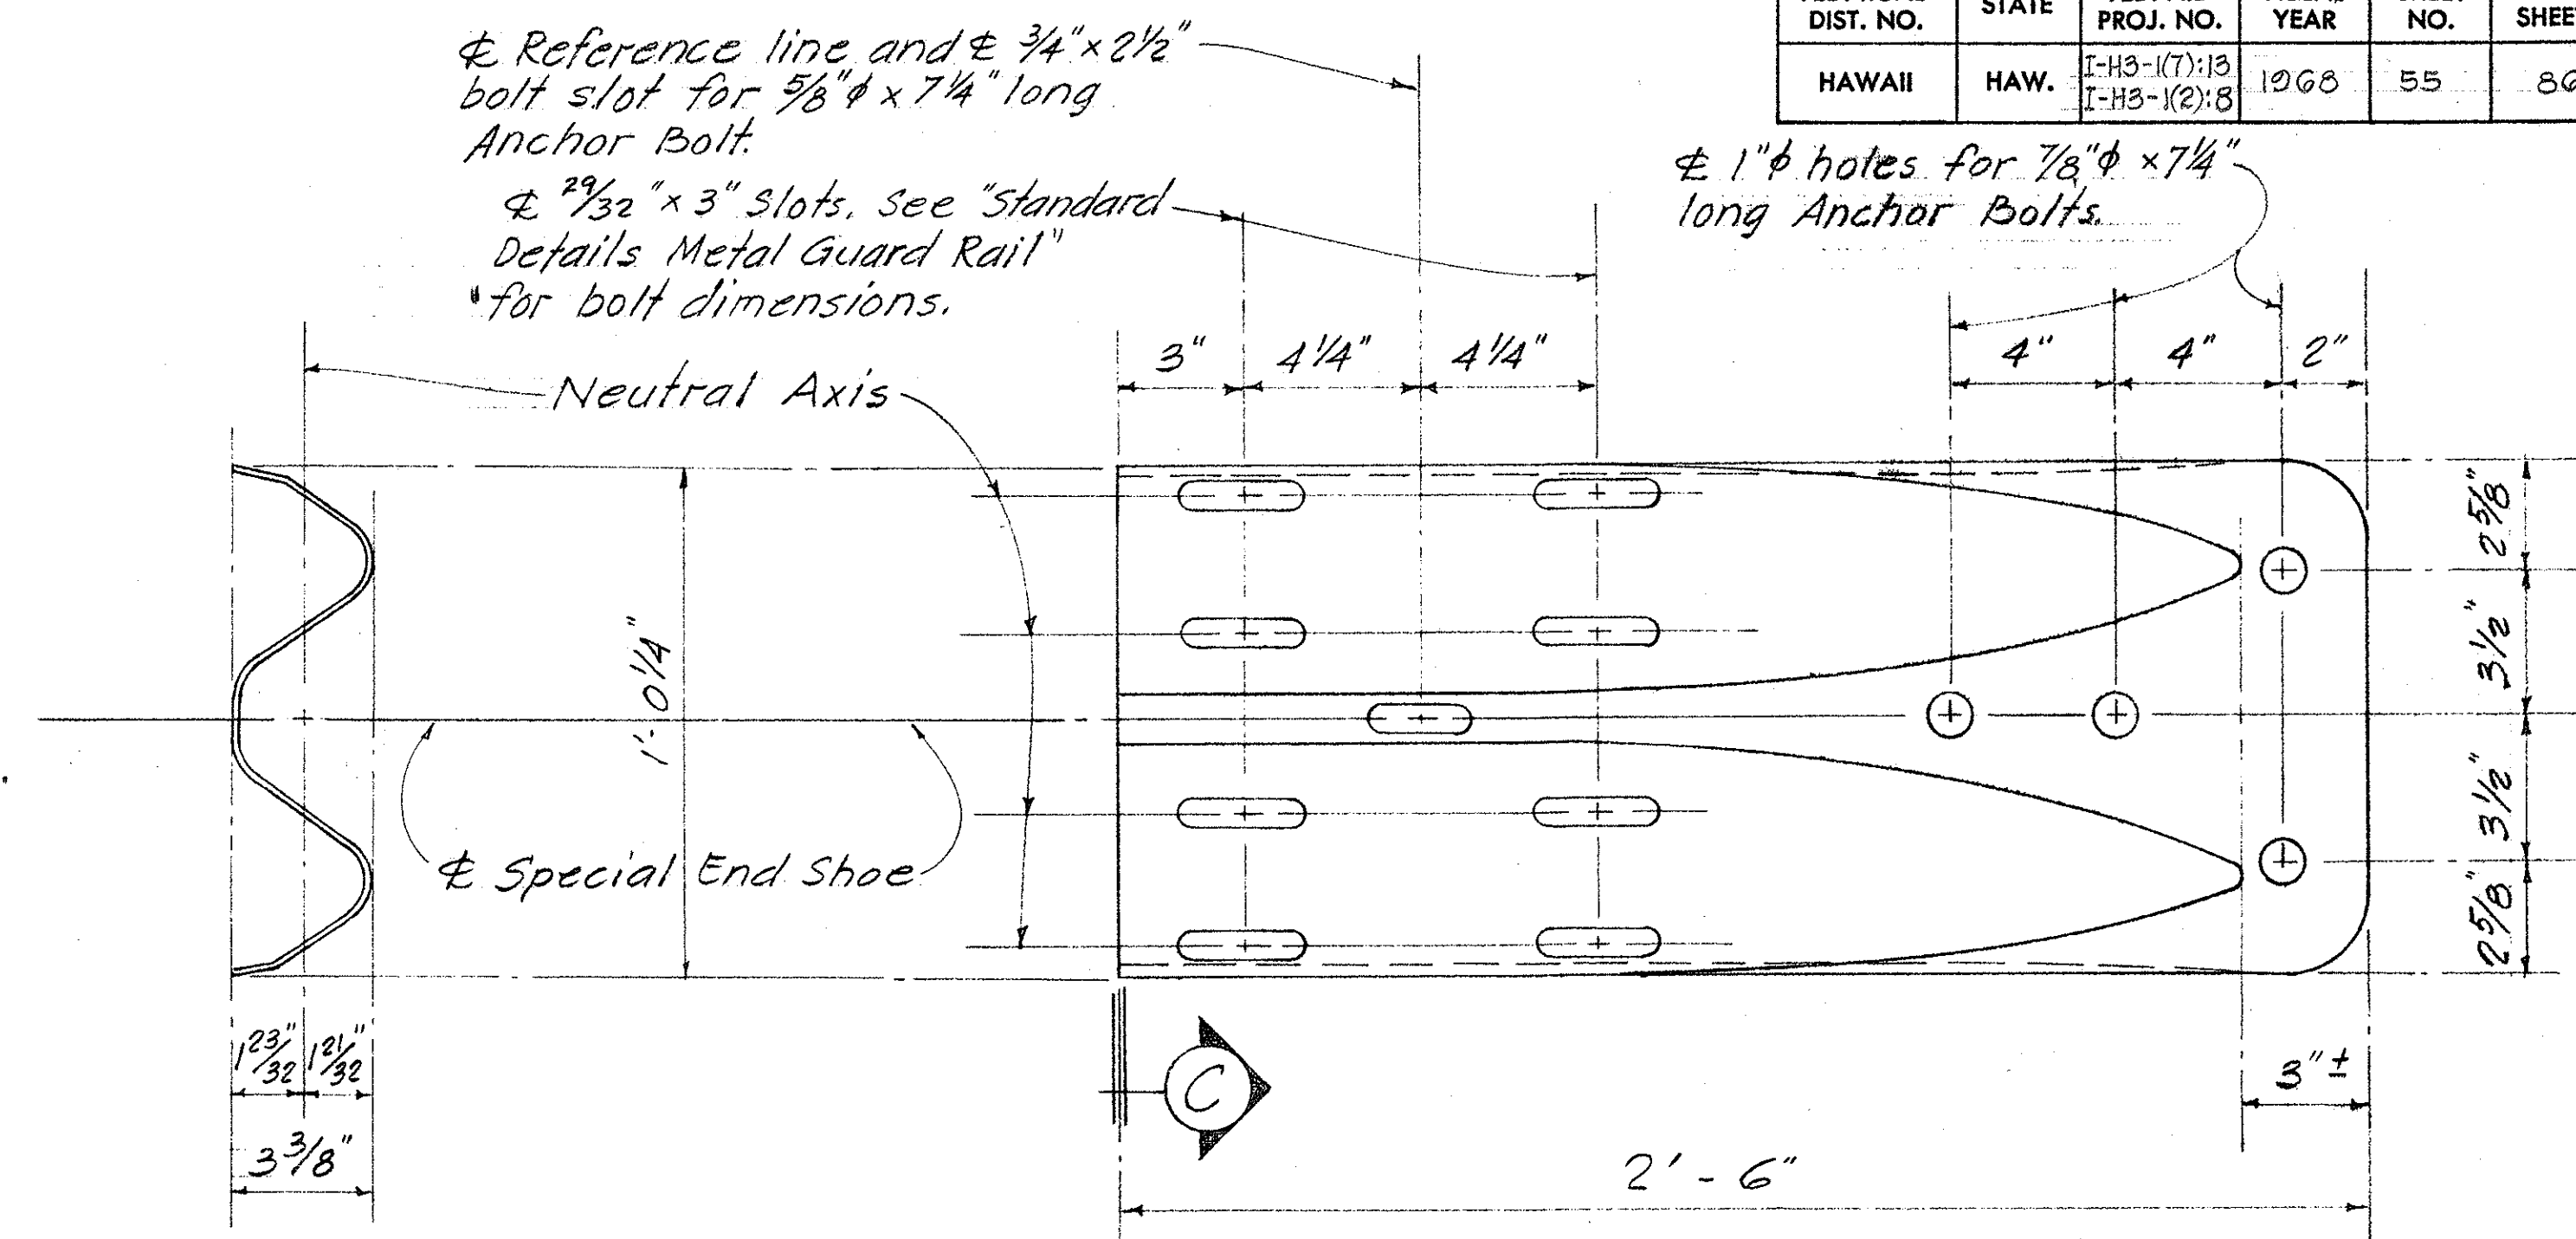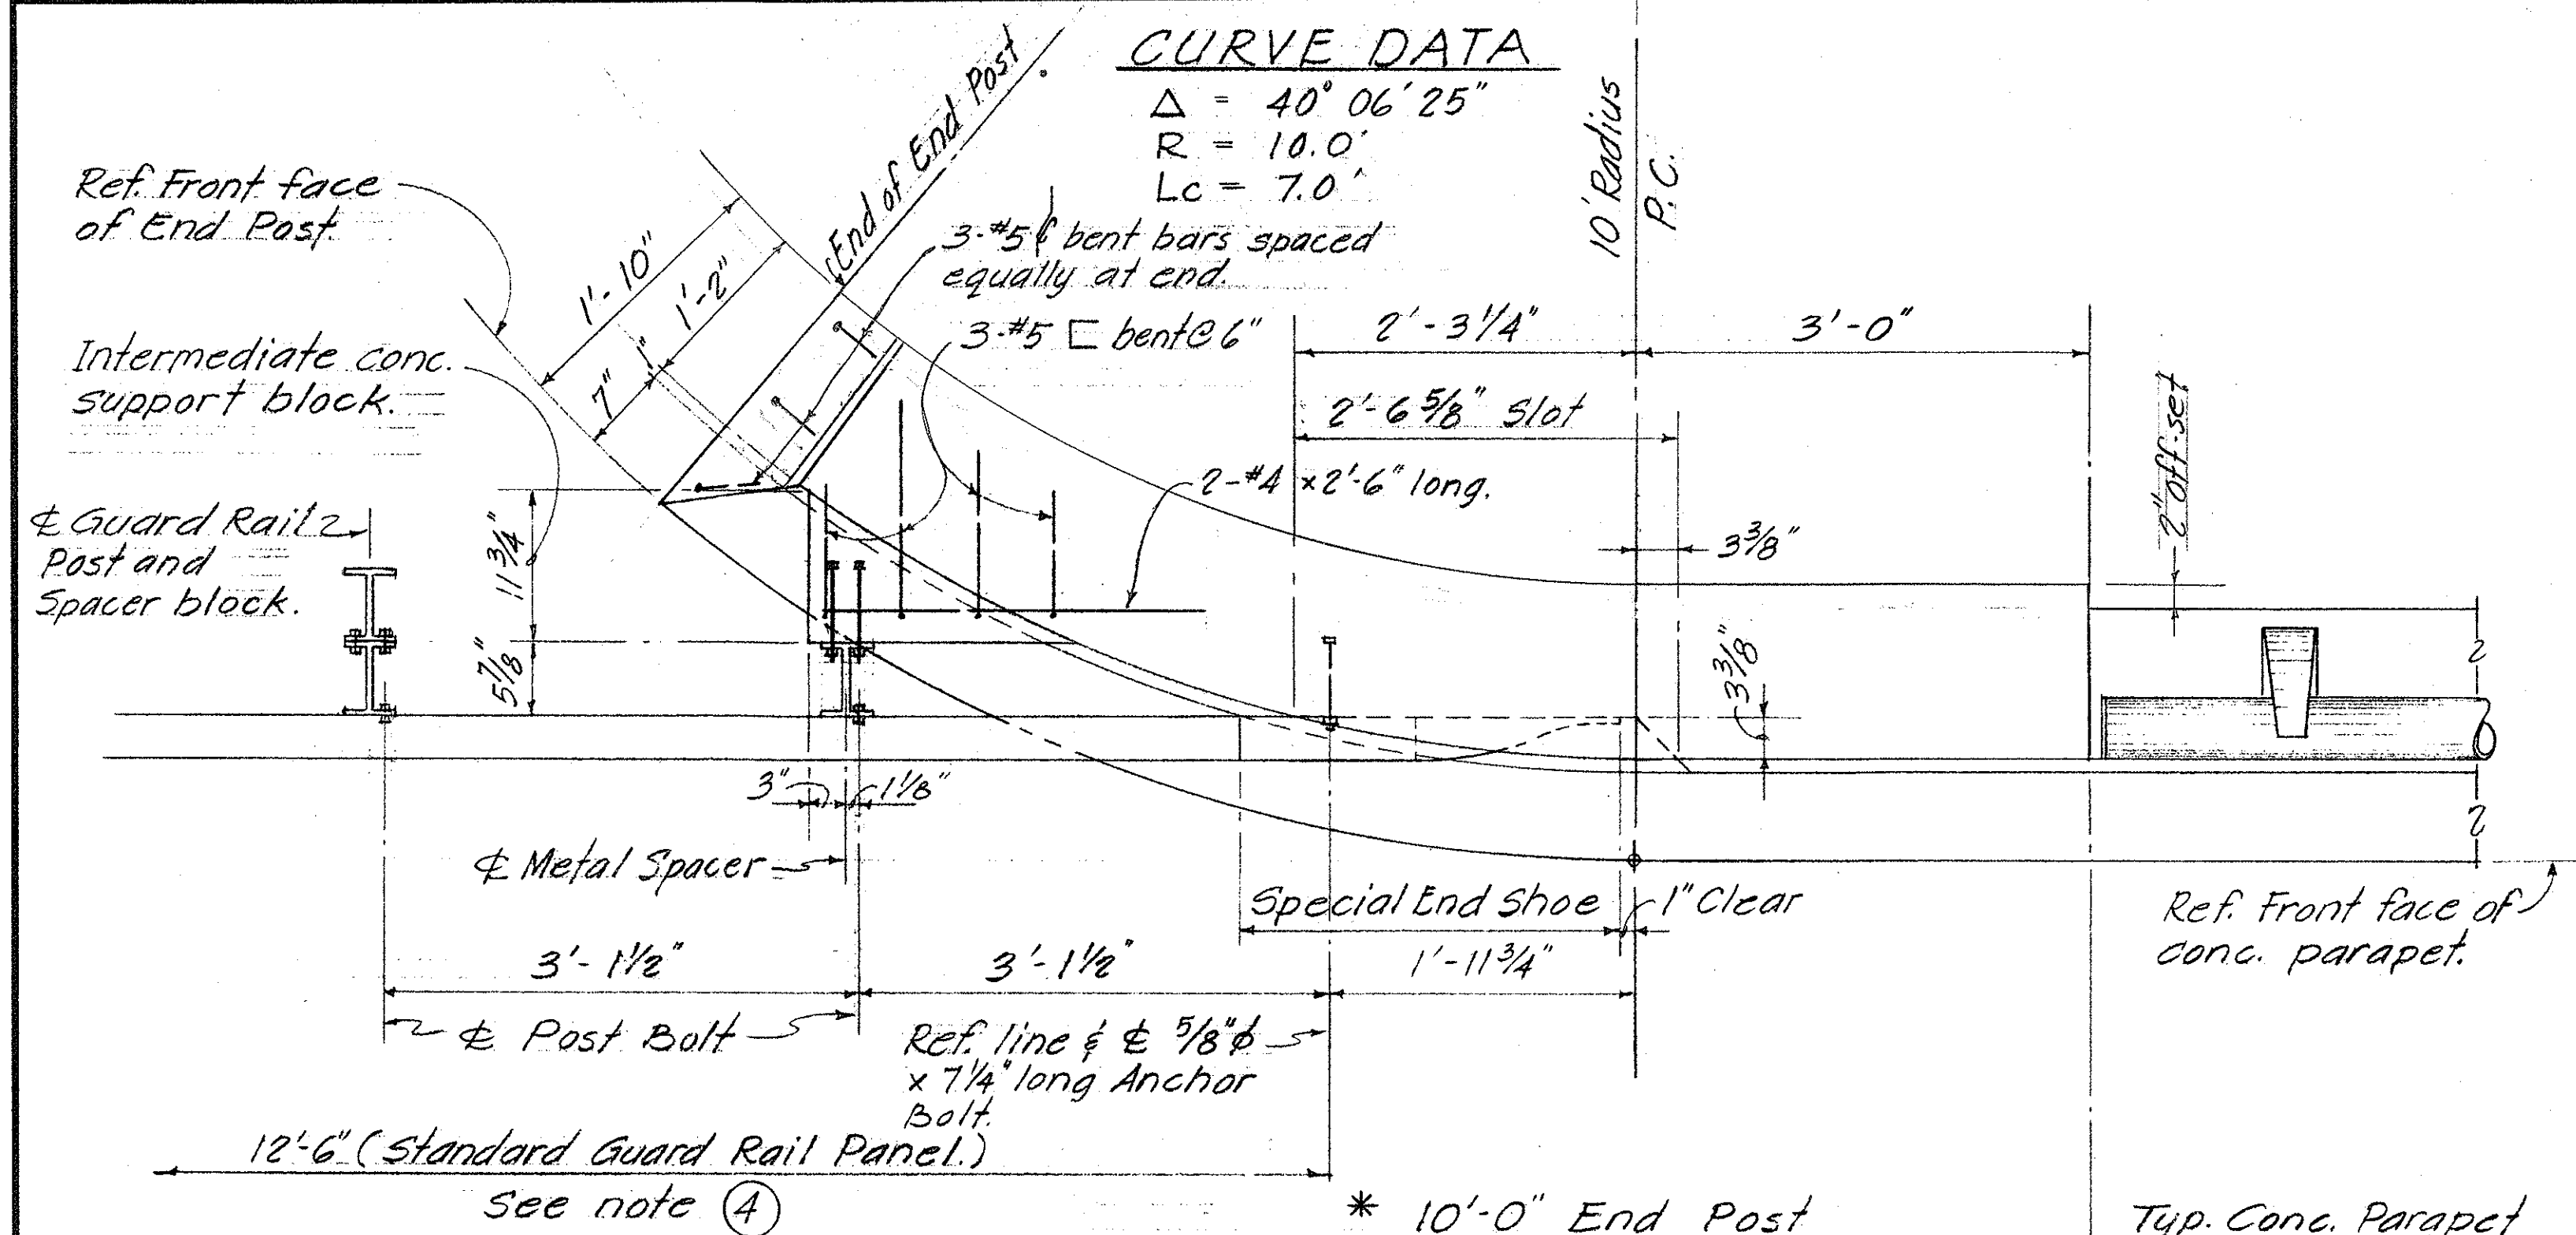

SECTION (C)
SPECIAL END SHOE DETAILS
 Scale: 3" = 1'-0"

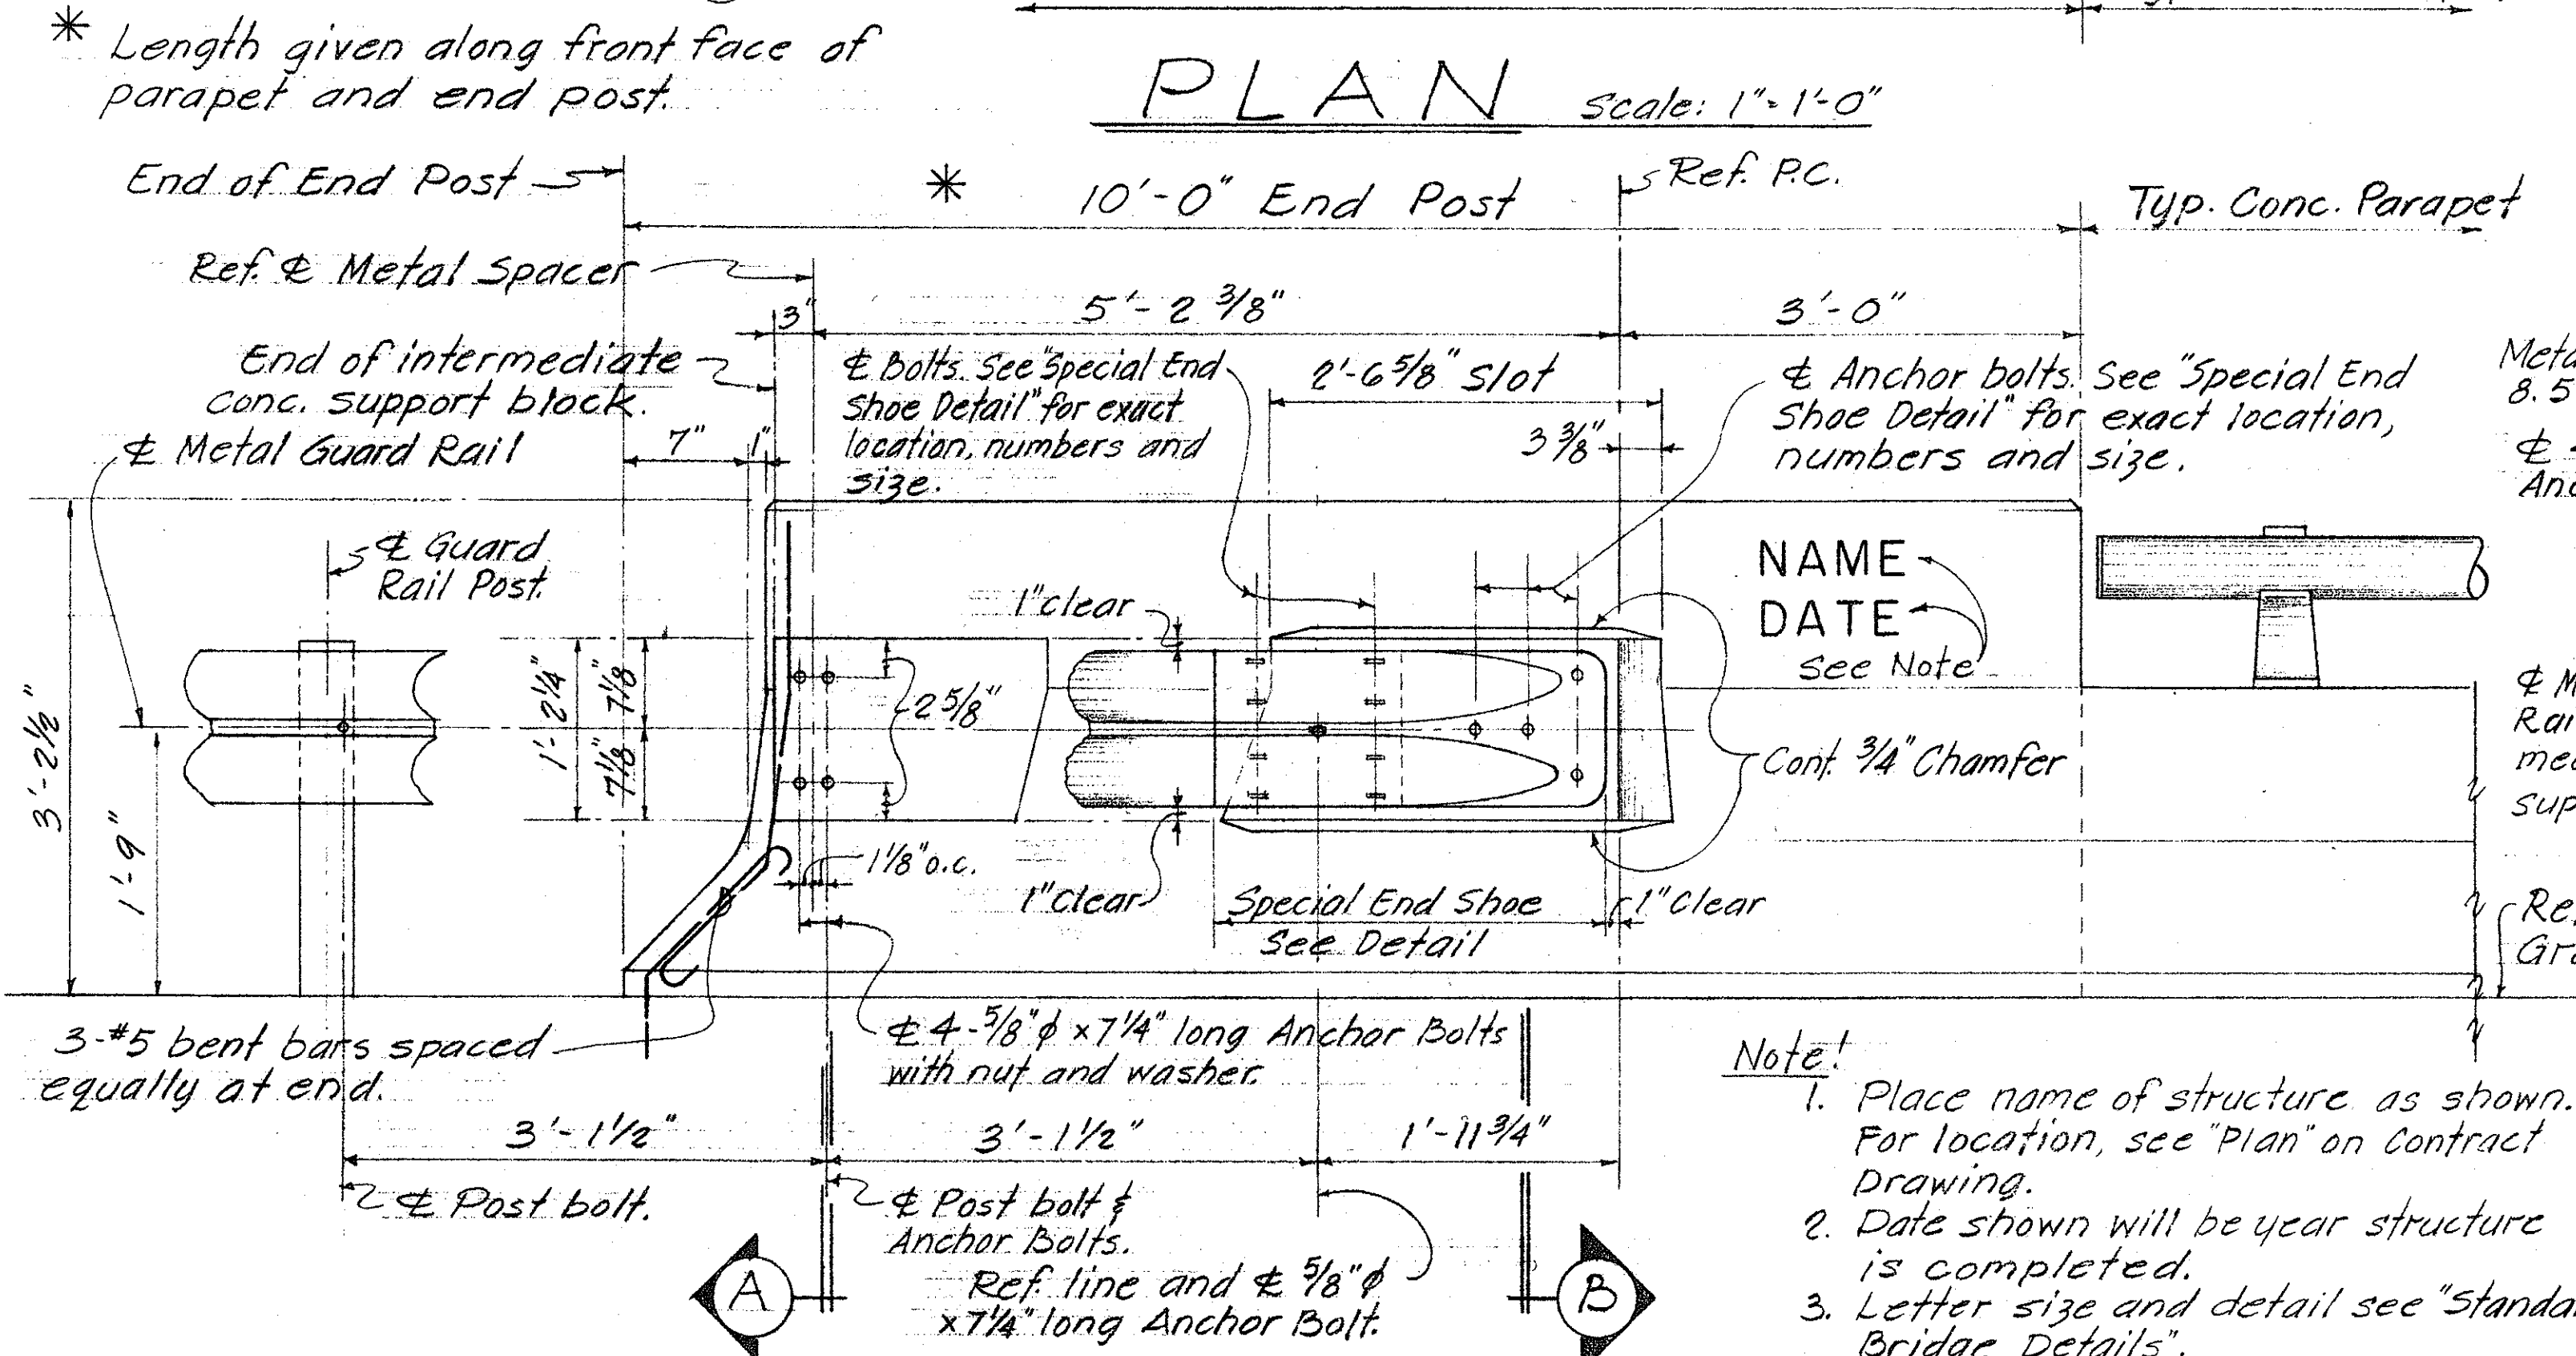

ELEVATION Scale: 1" = 1'-0"

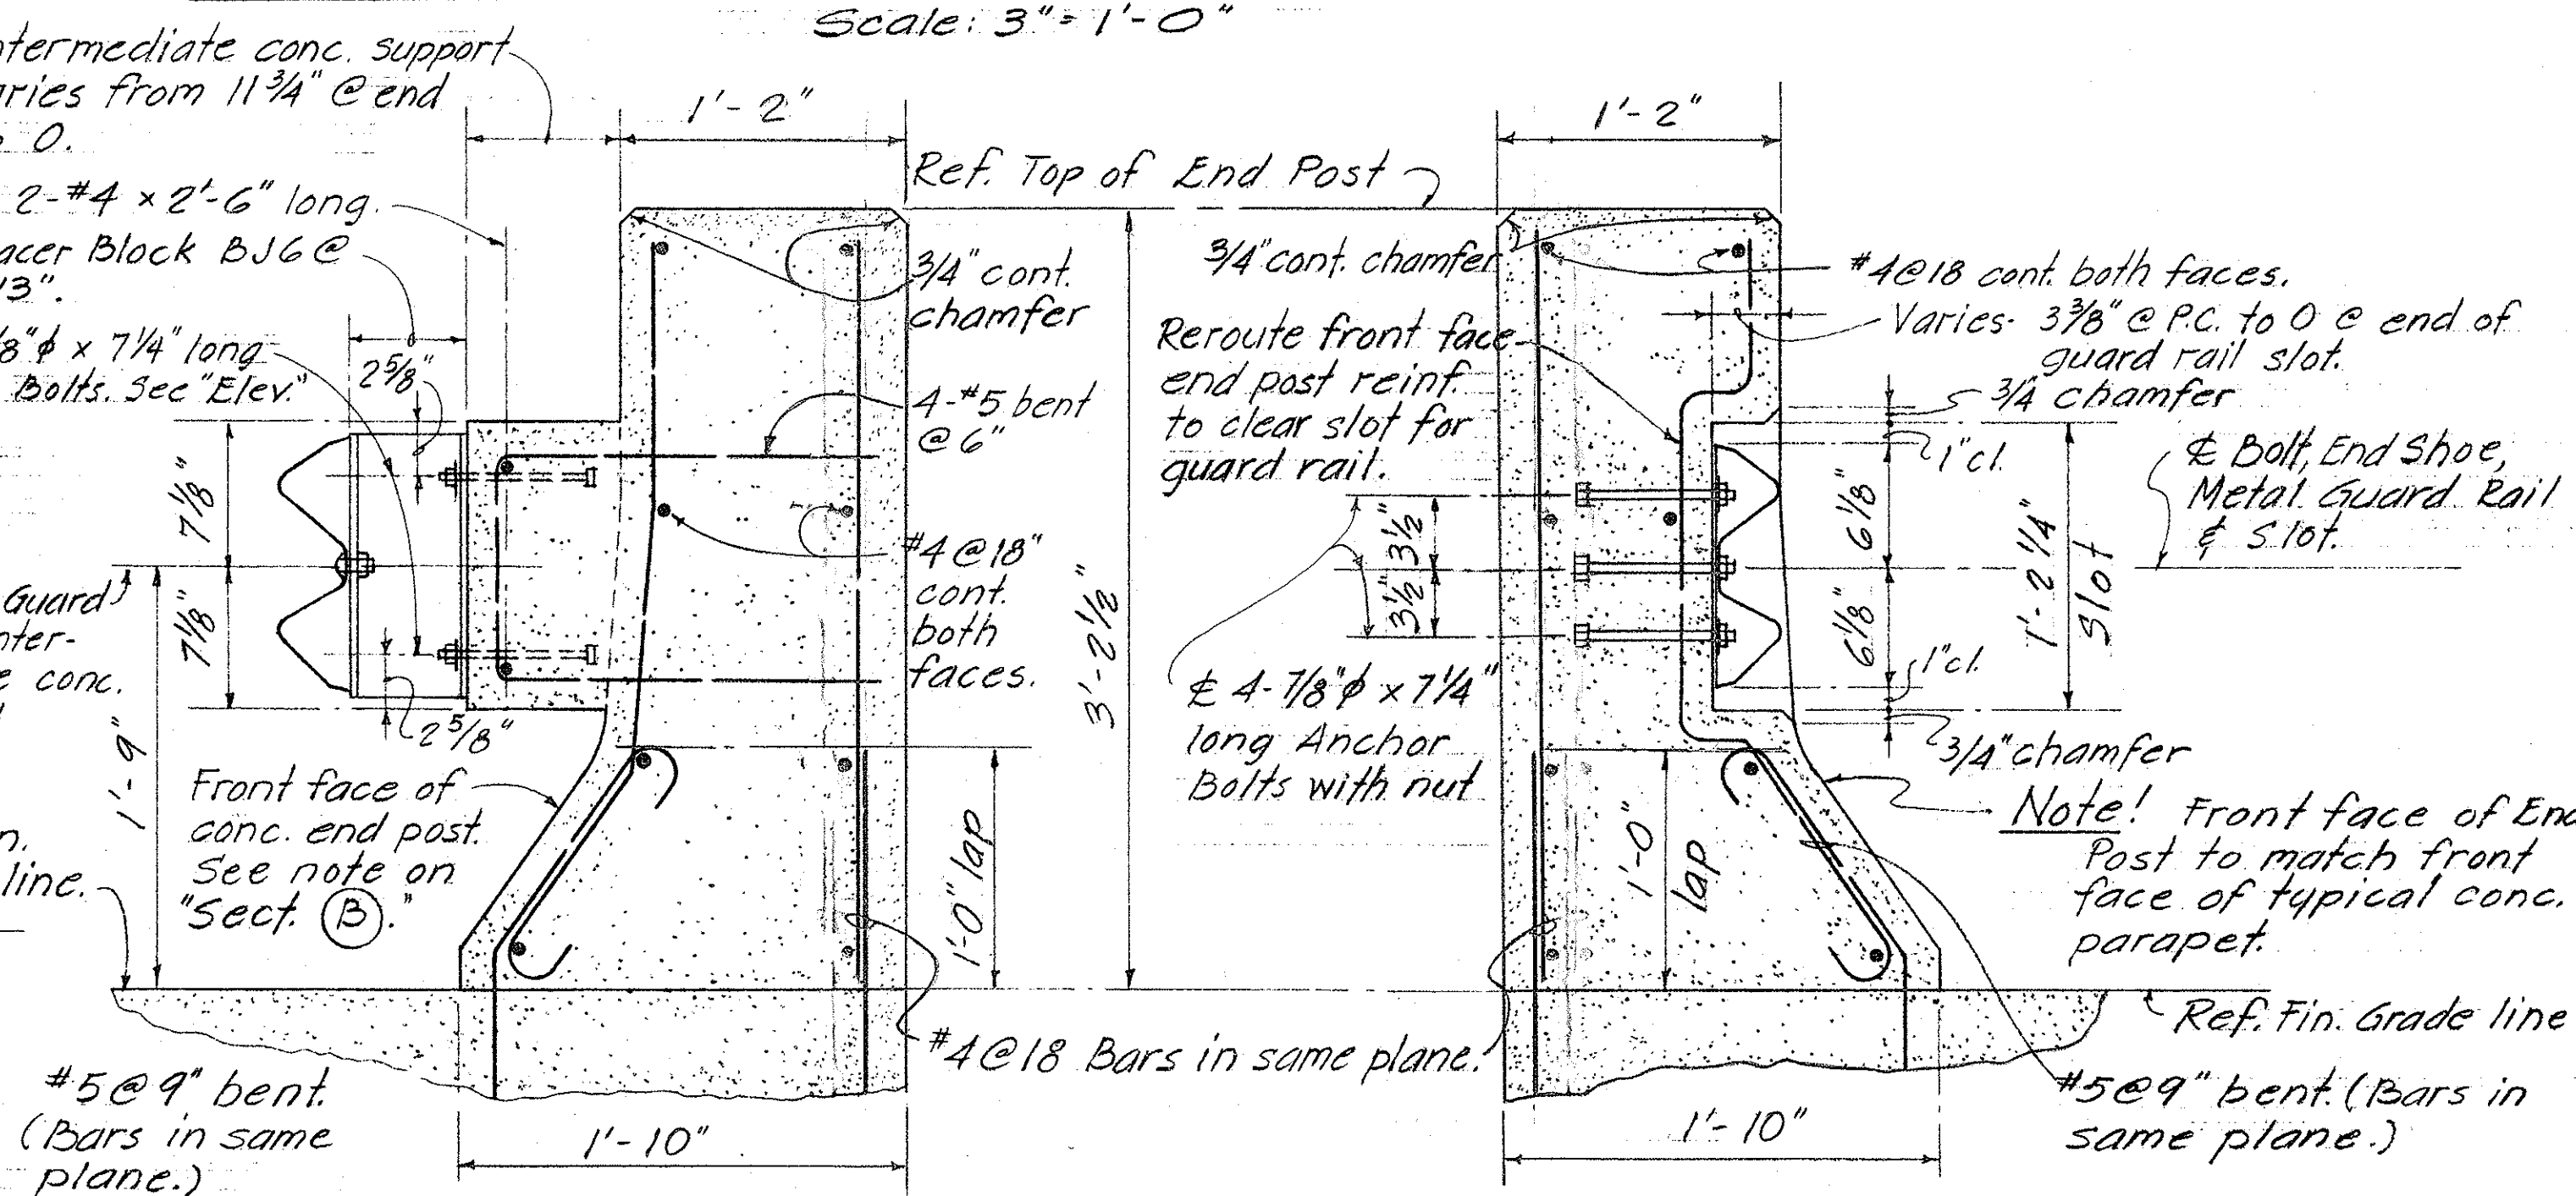

SECTION (A)
 Scale: 1 1/2" = 1'-0"

SECTION (B)
 Scale: 1 1/2" = 1'-0"

NOTES

- All Anchor Bolts shall be High Strength bolts conforming to the requirements of ASTM A-325.
- All Shoe assembly, including anchor bolts, nuts and washers, shall be galvanized.
- Special End Shoe shall be fabricated from 10 gage steel conforming to the requirements of AASHTO 180.
- First Guard Rail Panel adjoining "Special End Shoe" shall be of galvanized steel. See Special Provisions for requirements.
- Anchor Bolt length given from under bolt head.

STATE OF HAWAII
 DEPARTMENT OF TRANSPORTATION
 HIGHWAYS DIVISION

END POST
CONNECTION TO METAL
GUARD RAIL DETAILS
 (SINGLE RAIL TYPE)
 SCALE AS SHOWN DATE: MARCH, 1968
 SHEET No. 13 OF 13 SHEETS

DATE	_____
SURVEY PLANNED BY	_____
DRAWN BY	_____
DESIGNED BY	_____
QUANTITIES BY	_____
CHECKED BY	_____
ORIGINAL PLAN	_____
NOTE BOOK	_____
No.	_____