


[illegible]

| FED. ROAD<br>DIST. NO. | STATE | FED. AID<br>PROJ. NO. | FISCAL<br>YEAR | SHEET<br>NO. | TOTAL<br>SHEETS |
|------------------------|-------|-----------------------|----------------|--------------|-----------------|
| HAWAII                 | HAW.  | IR-H3-1(56)           | 1987           | 1            | 40              |

STATE OF HAWAII  
DEPARTMENT OF TRANSPORTATION  
HIGHWAYS DIVISION  
"AS-BUILT"  
PLANS FOR  
INTERSTATE ROUTE H-3 REHABILITATION  
HALEKOU INTERCHANGE TO KAILUA INTERCHANGE  
FEDERAL AID INTERSTATE PROJECT NO. IR-H3-1(56)  
DISTRICT OF KOOLAUPOKO  
ISLAND OF OAHU

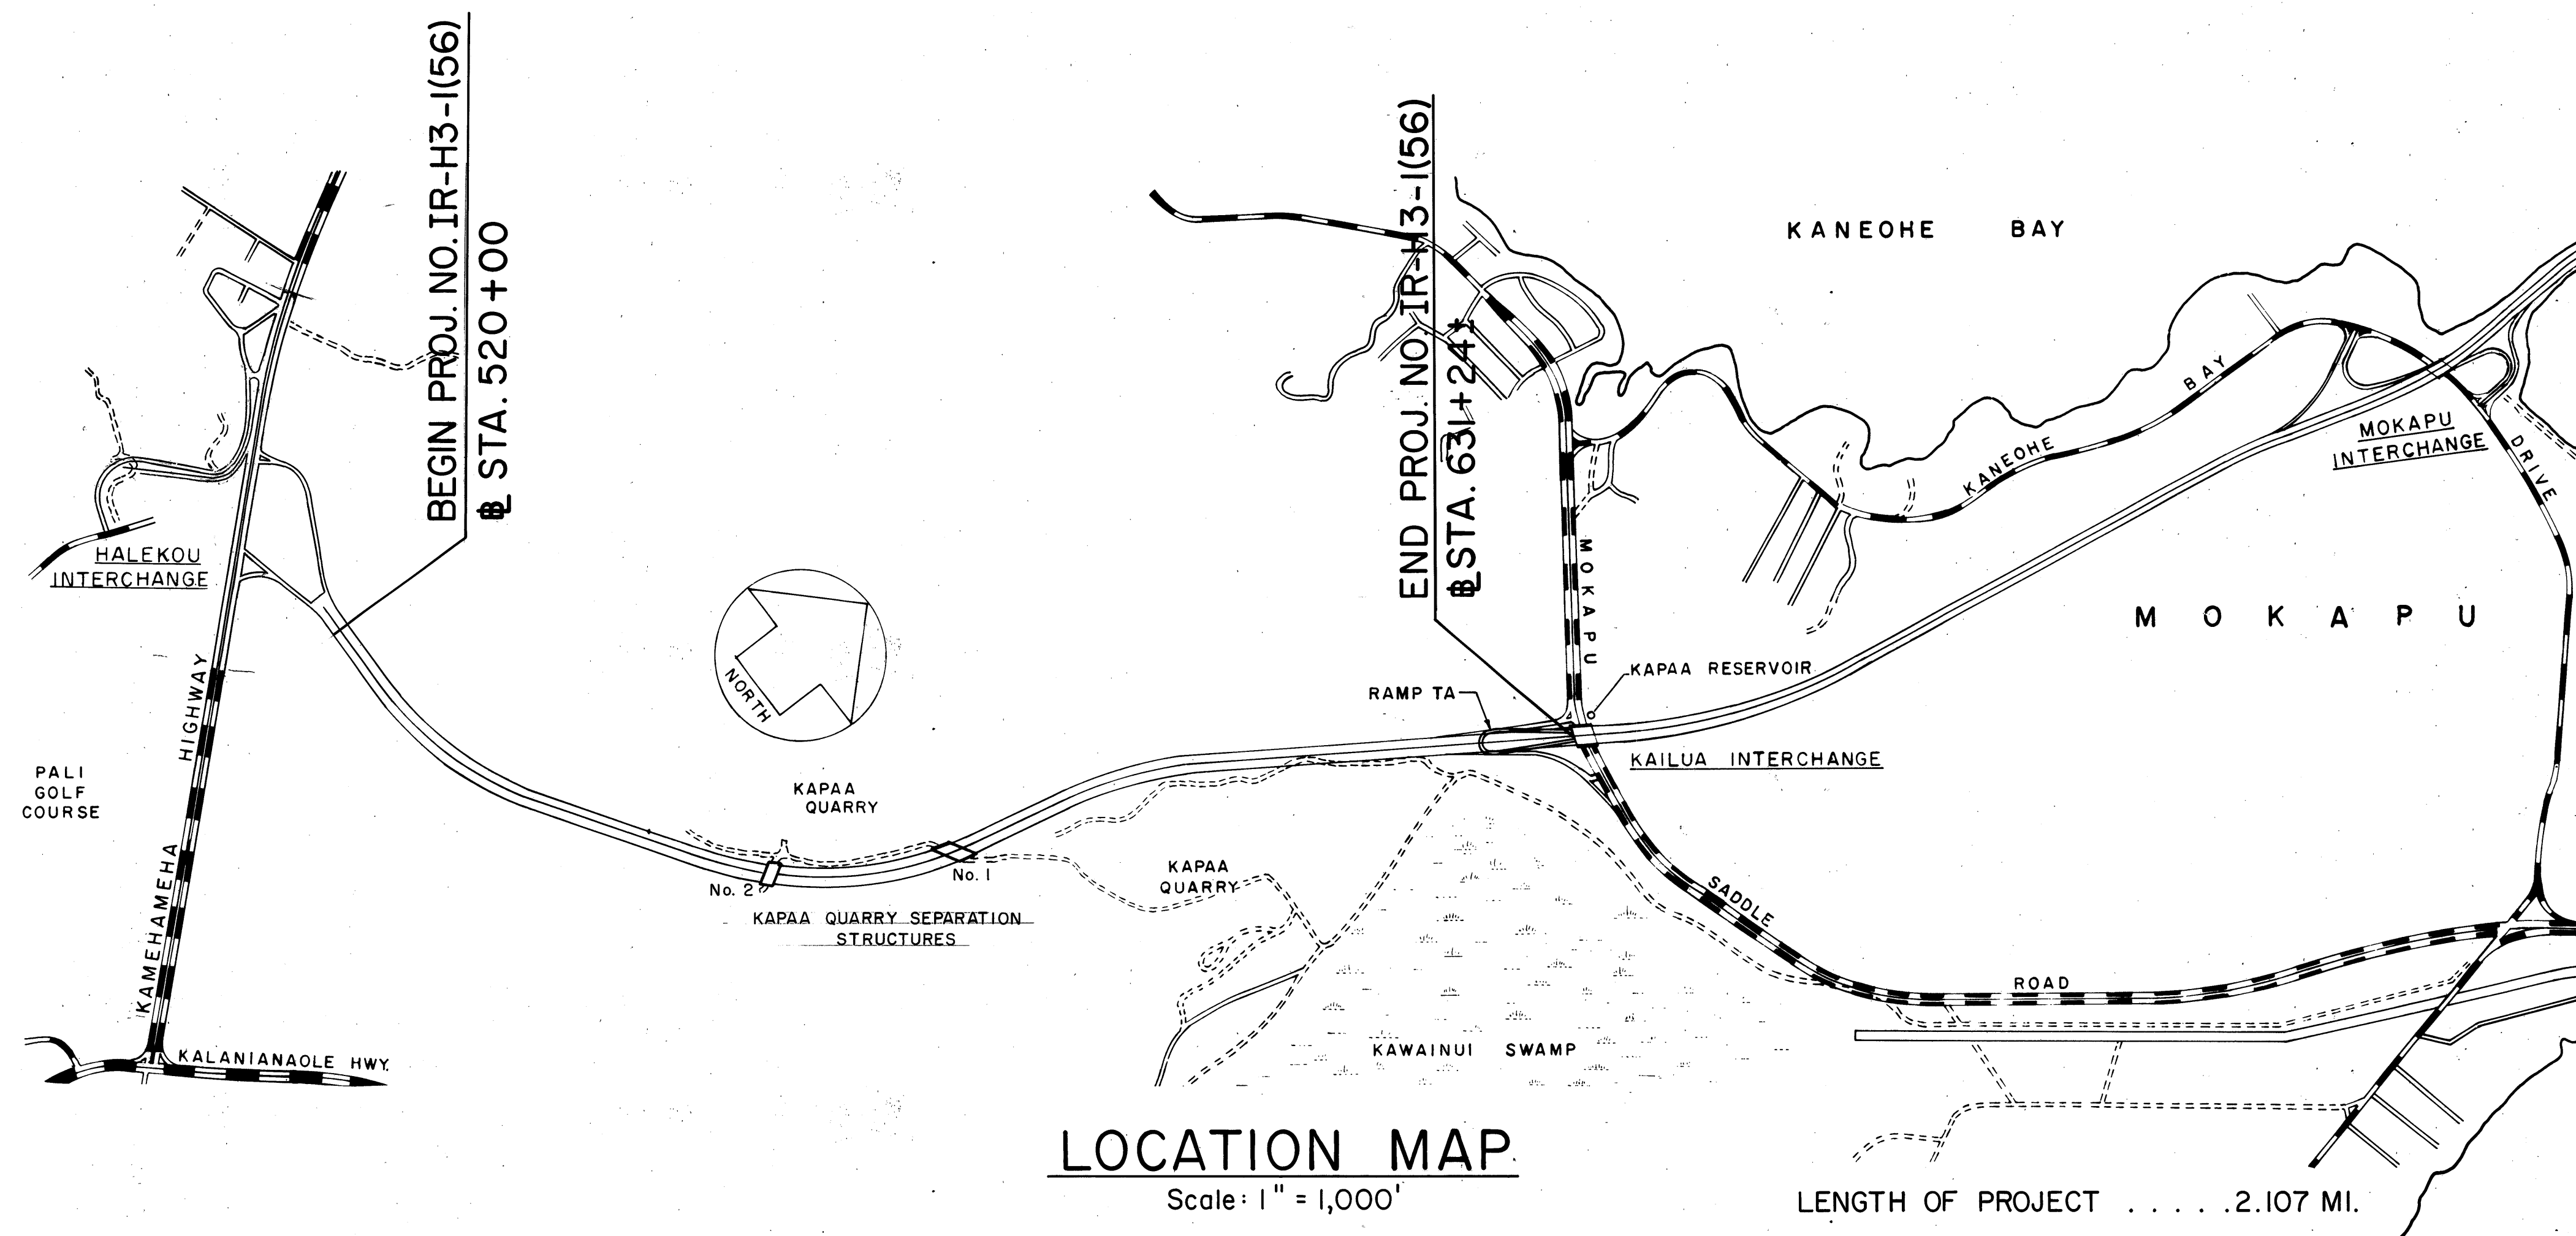

## DESIGN DESIGNATION

CHANGES MADE DURING CONSTRUCTION HAVE  
BEEN INCORPORATED ON THESE PLANS EXCEPT  
CHANGES IN THE ORIGINAL THEORETICAL  
QUANTITIES. FOR ACTUAL QUANTITIES, REFER TO  
PROJECT LEDGER AND/OR COMPUTATION BOOK.

RESIDENT ENGINEER

DEPARTMENT OF TRANSPORTATION  
FEDERAL HIGHWAY ADMINISTRATION

DEPARTMENT OF TRANSPORTATION  
STATE OF HAWAII