

FED. ROAD DIST. NO.	STATE	FED. AID PROJ. NO.	FISCAL YEAR	SHEET NO.	TOTAL SHEETS
HAWAII	HAW.	I-H3-1(24):11	1983	202	328

DESIGN SPECIFICATIONS:

STANDARD SPECIFICATIONS FOR HIGHWAY BRIDGES (AASHTO 12th EDITION)
INCL. SUBSEQUENT INTERIM SPECIFICATIONS.

DESIGN LIVE LOAD:

HS 20-44

MATERIALS:

POST-TENSIONED CONG. GIRDER - $f'_c = 5,000$ P.S.I.

(TENSIONING STRENGTH) $f'_c = 4,000$ P.S.I.


TRANSVERSE BEAM, PIER COLUMNS - $f'_c = 5,000$ P.S.I.

FOOTINGS, ABUTMENTS & WALLS - $f'_c = 3,000$ P.S.I.

REINFORCING STEEL SHALL CONFORM TO ASTM A615.

FOR GIRDER, TRANSVERSE BEAM & PIER COLUMNS - BARS #8 & LARGER $f_y = 60$ K.S.I.
BARS #7 & SMALLER OR AS OTHERWISE NOTED $f_y = 40$ K.S.I.

FOR FOOTINGS, ABUTMENTS & WINGWALLS - ALL BARS $f_y = 40$ K.S.I.

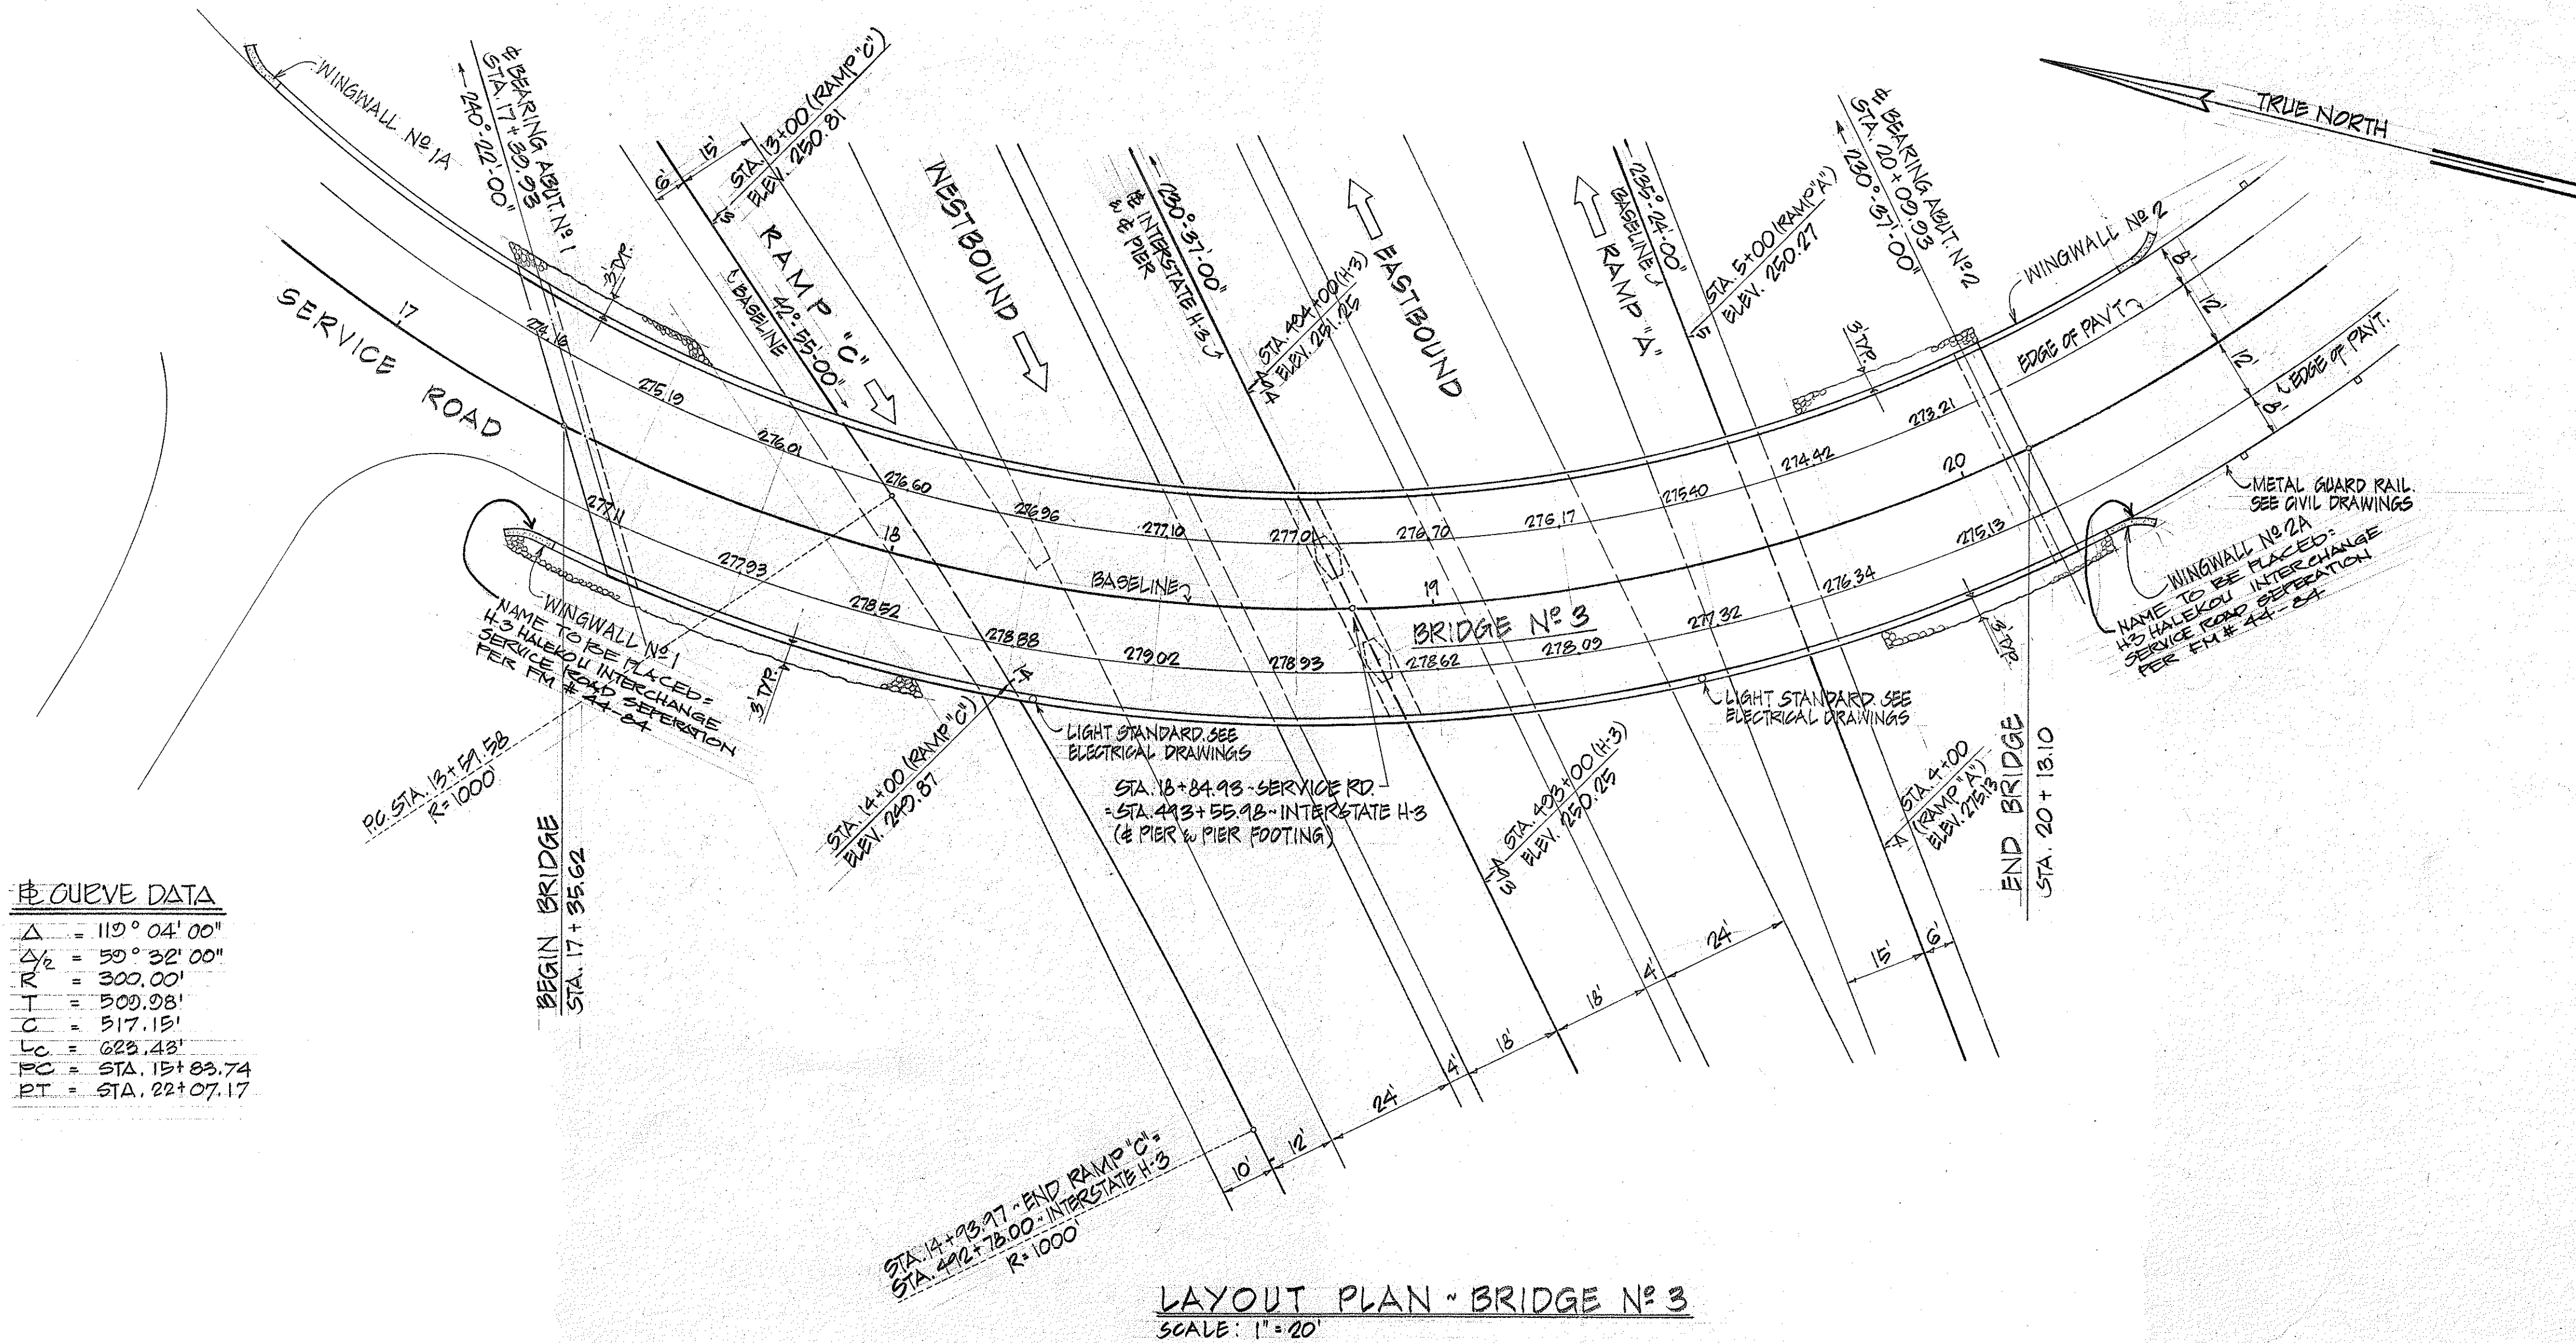


LAYOUT PLAN - BRIDGE No 3

SCALE: 1" = 20'

CURVE DATA

$\Delta = 112^\circ 04' 00''$
 $\Delta/2 = 56^\circ 02' 00''$
 $R = 300.00'$
 $T = 509.98'$
 $C = 517.15'$
 $L_c = 625.48'$
 $PC = STA. 15+83.74$
 $PT = STA. 22+07.17$

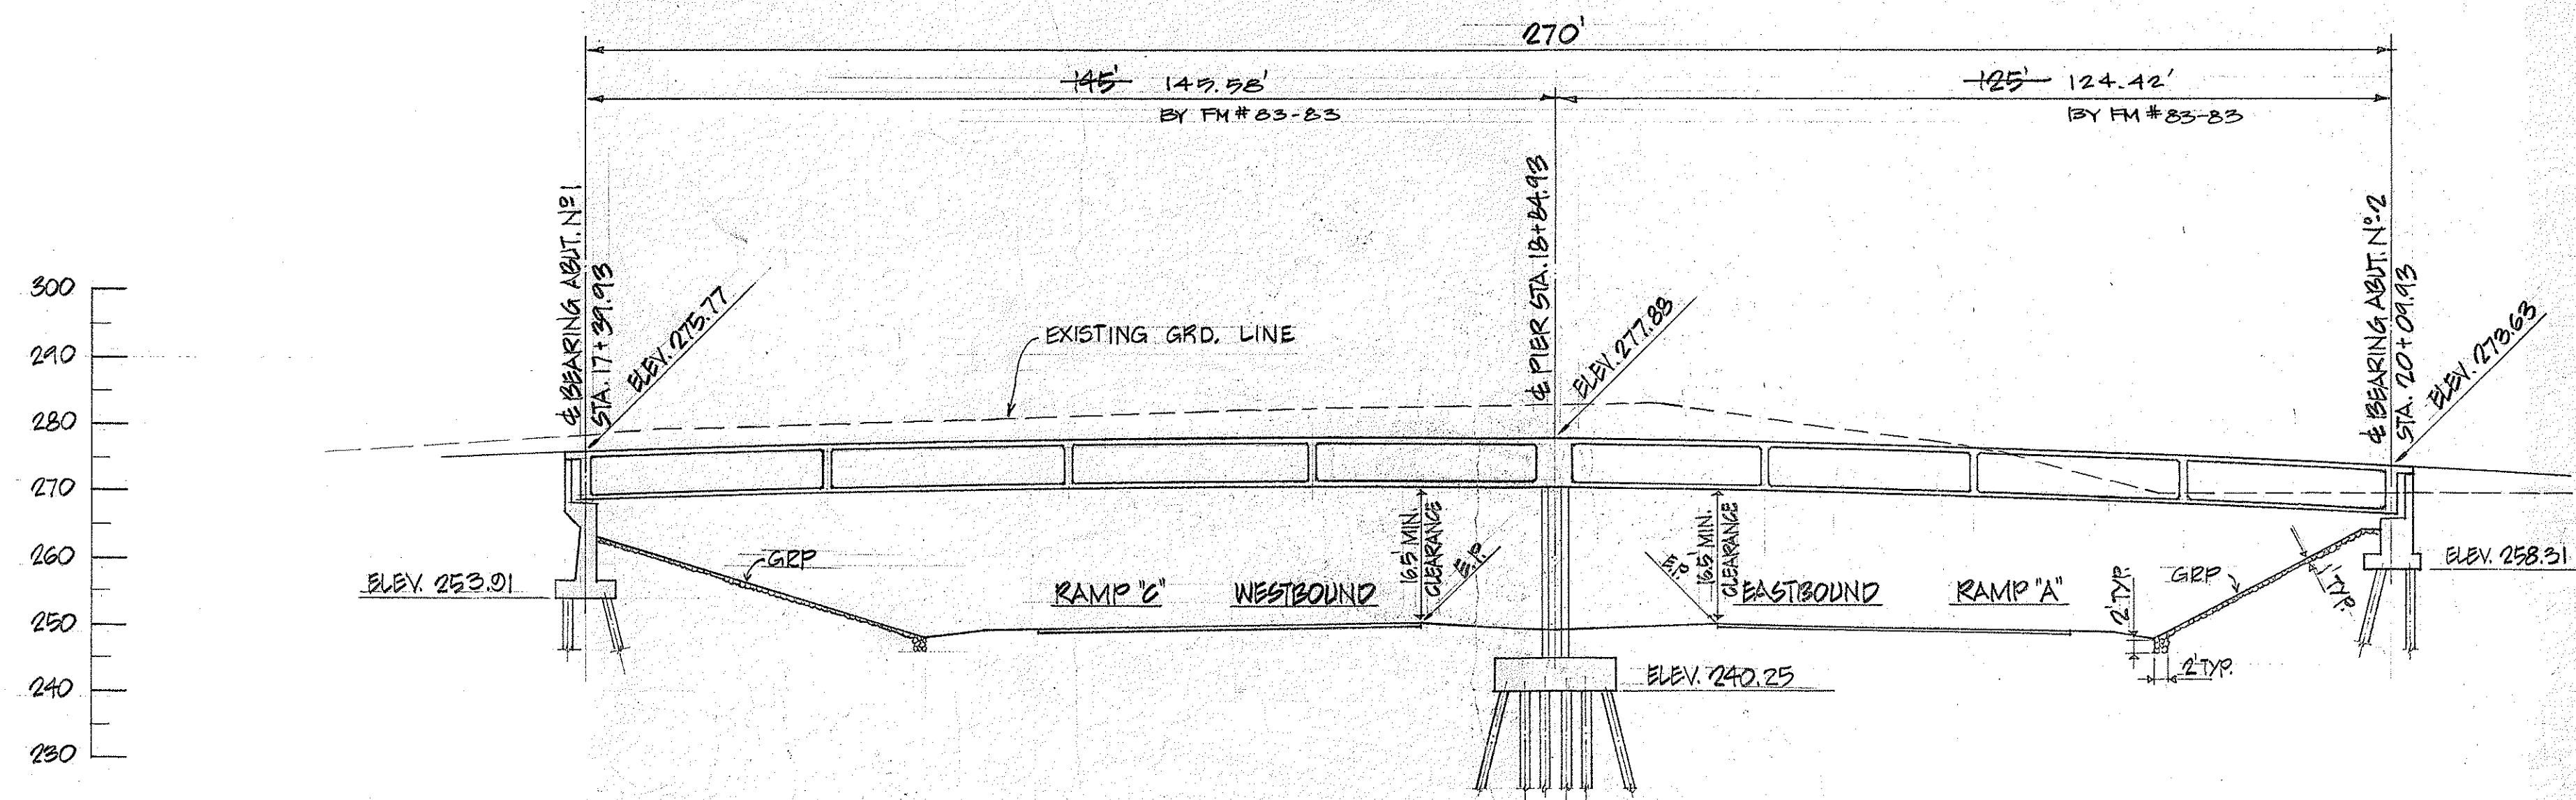

PROFILE ALONG BASELINE - BRIDGE No 3

SCALE: 1" = 20'

STATE OF HAWAII
DEPARTMENT OF TRANSPORTATION
HIGHWAYS DIVISION

PLAN & PROFILE
BRIDGE No 3

HALEKOU INTERCHANGE

F.A.I. Proj. No. I-H3-1(24):11

Scale: As Noted


DATE: SEPT. 1982

SHEET No. 14 OF 20 SHEETS

"AS BUILT"

202

FED. ROAD DIST. NO.	STATE	FED. AID PROJ. NO.	FISCAL YEAR	SHEET NO.	TOTAL SHEETS
HAWAII	HAW.	I-H3-1(24):11	1983	203	328

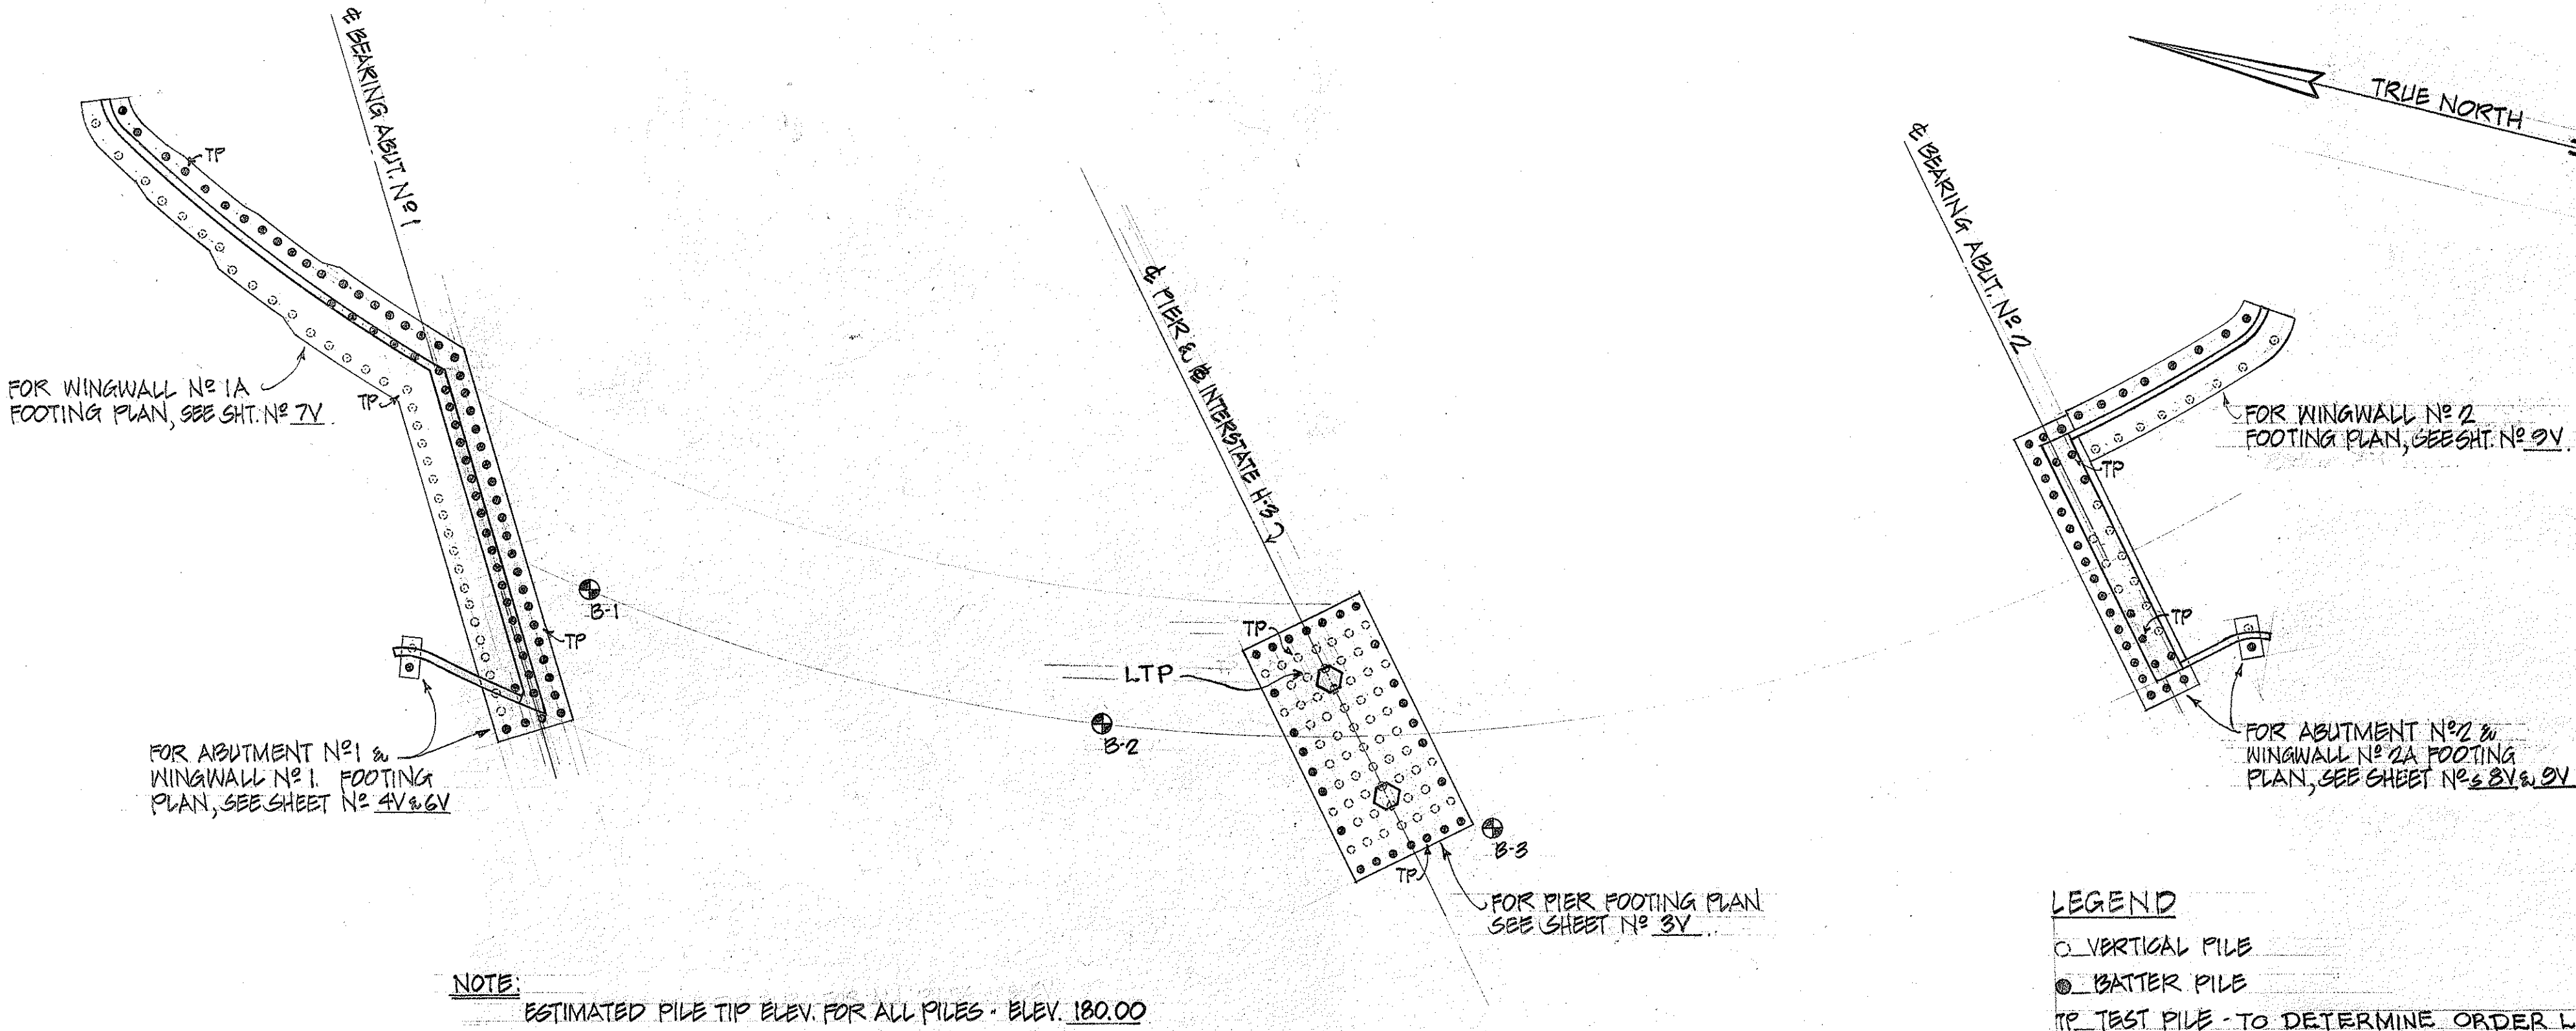

SEQUENCE OF CONSTRUCTION FOR PILE DRIVING IN ABUTMENT EMBANKMENT

1. DRIVE PILE DOWN TO FINAL TIP ELEVATION.
2. FILL VOID AROUND PILE WITH LOOSE DRY SAND, SEE STANDARD SPECS.

ESTIMATED QUANTITIES - BRIDGE NO. 3

ITEM NO.	ITEM	UNIT	QUANTITY
206.6000	STRUCTURAL EXCAVATION FOR BRIDGE	C.Y.	1,399
206.7010	STRUCTURAL BACKFILL FOR BRIDGE	C.Y.	243
206.8200	FILTER MATERIAL FOR STRUCTURE	C.Y.	73
503.1093	CONCRETE IN BRIDGE NO. 3 (EXCEPT FOOTING)	L.S.	(1,270 C.Y.)
505.0410	TYPE I - PRESTRESSED CONG. PILES, FURNISHED	L.F.	18,342
505.4100	TYPE I - PRESTRESSED CONG. PILES, DRIVEN	L.F.	16,817
507.1500	METAL BRIDGE RAILING, TWO RAILS ON PARAPET	L.F.	660
507.7010	CONCRETE BRIDGE PARAPET INCLUDING END POST - BRIDGE NO. 3	L.F.	700
602.0092	REINFORCING STEEL IN BRIDGE NO. 3	L.S.	(433,000 LBS.)
504.5100	POST-TENSIONING OPERATION FOR CAST-IN-PLACE STRUCTURES - BRIDGE NO. 3	L.S.	(80,000 LBS.)
612.0200	GROUTED RUBBLE PAVING, SLOPE PROTECTION	C.Y.	272
505.9100	PILE DRIVING EQUIPMENT EXPENSE (NOT TO EXCEED \$8,000)	L.S.	
505.1097	CONCRETE IN FOOTINGS FOR BRIDGE NO. 3	L.S.	462
505.0012	PILE LOAD TESTS, BRIDGE NO. 3	EA.	1
505.0022	TEST PILES, DRIVEN - BRIDGE NO. 3	L.F.	666

ORIGINAL PLAN	DATE
DESIGNED BY	
TRACED BY	
DESIGNED BY	
QUANTITIES BY	
CHECKED BY	
NO.	

STATE OF HAWAII
DEPARTMENT OF TRANSPORTATION
HIGHWAYS DIVISION




FOUNDATION PLAN
BRIDGE NO. 3
HALEKOU INTERCHANGE
F.A.I. Proj. No. I-H3-1(24):11

Scale: As Noted
Date: SEPT. 1982
SHEET No. 2V OF 20 SHEETS

FED. ROAD DIST. NO.	STATE	FED. AID PROJ. NO.	FISCAL YEAR	SHEET NO.	TOTAL SHEETS
HAWAII	HAW.	I-HS-1(24)11	1983	204	328



FED. ROAD DIST. NO.	STATE	FED. AID PROJ. NO.	FISCAL YEAR	SHEET NO.	TOTAL SHEETS
HAWAII	HAW.	I-H3-1(24)-11	1983	205	328

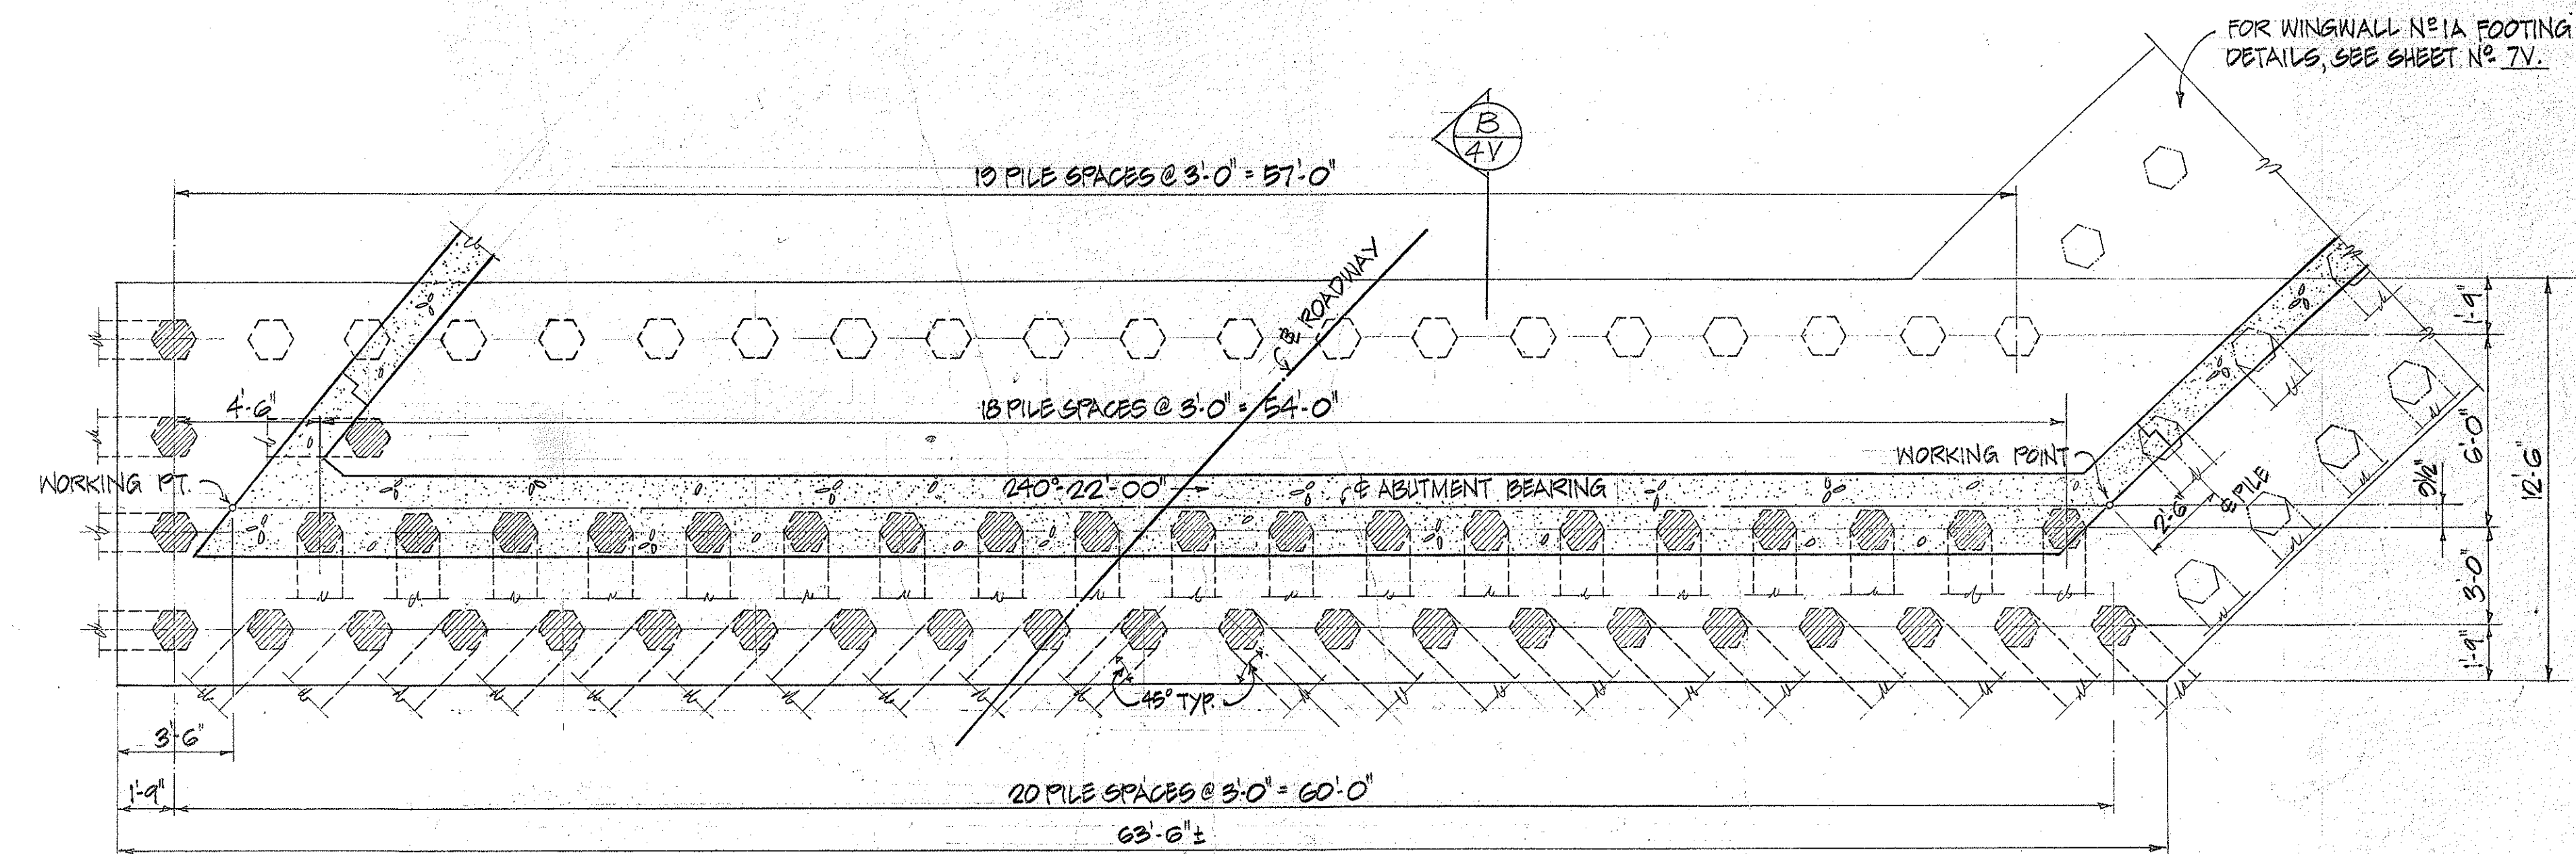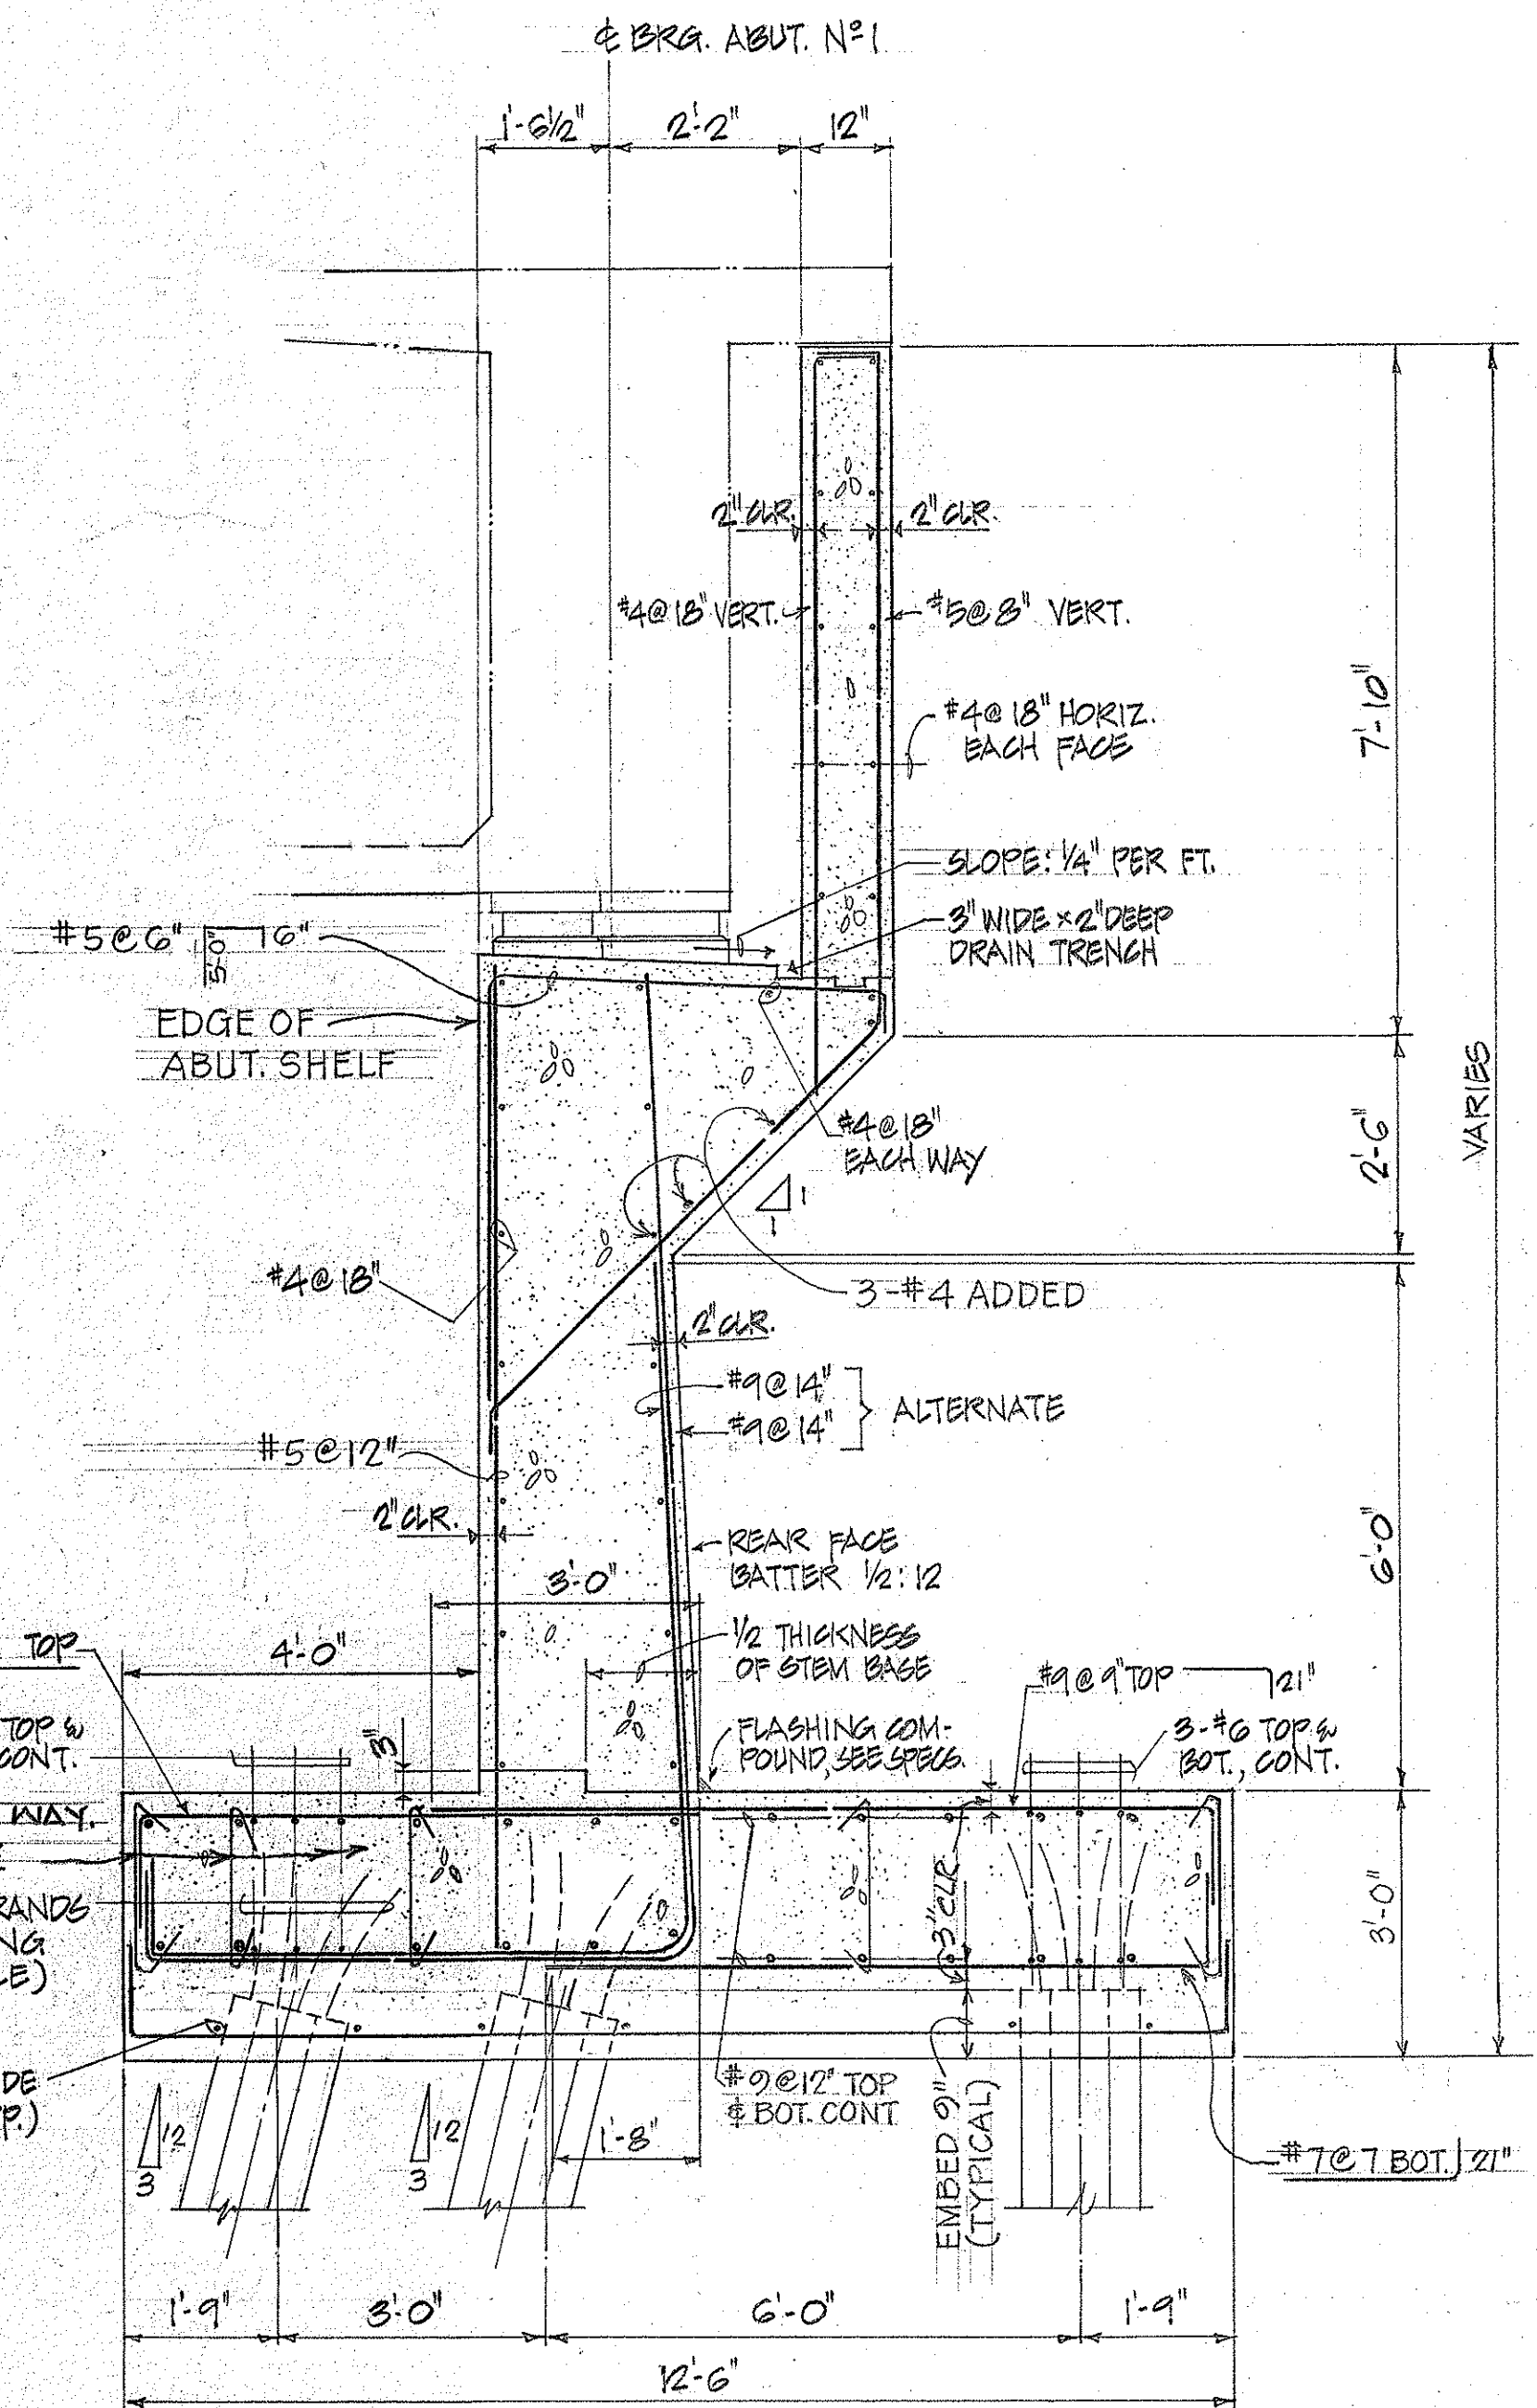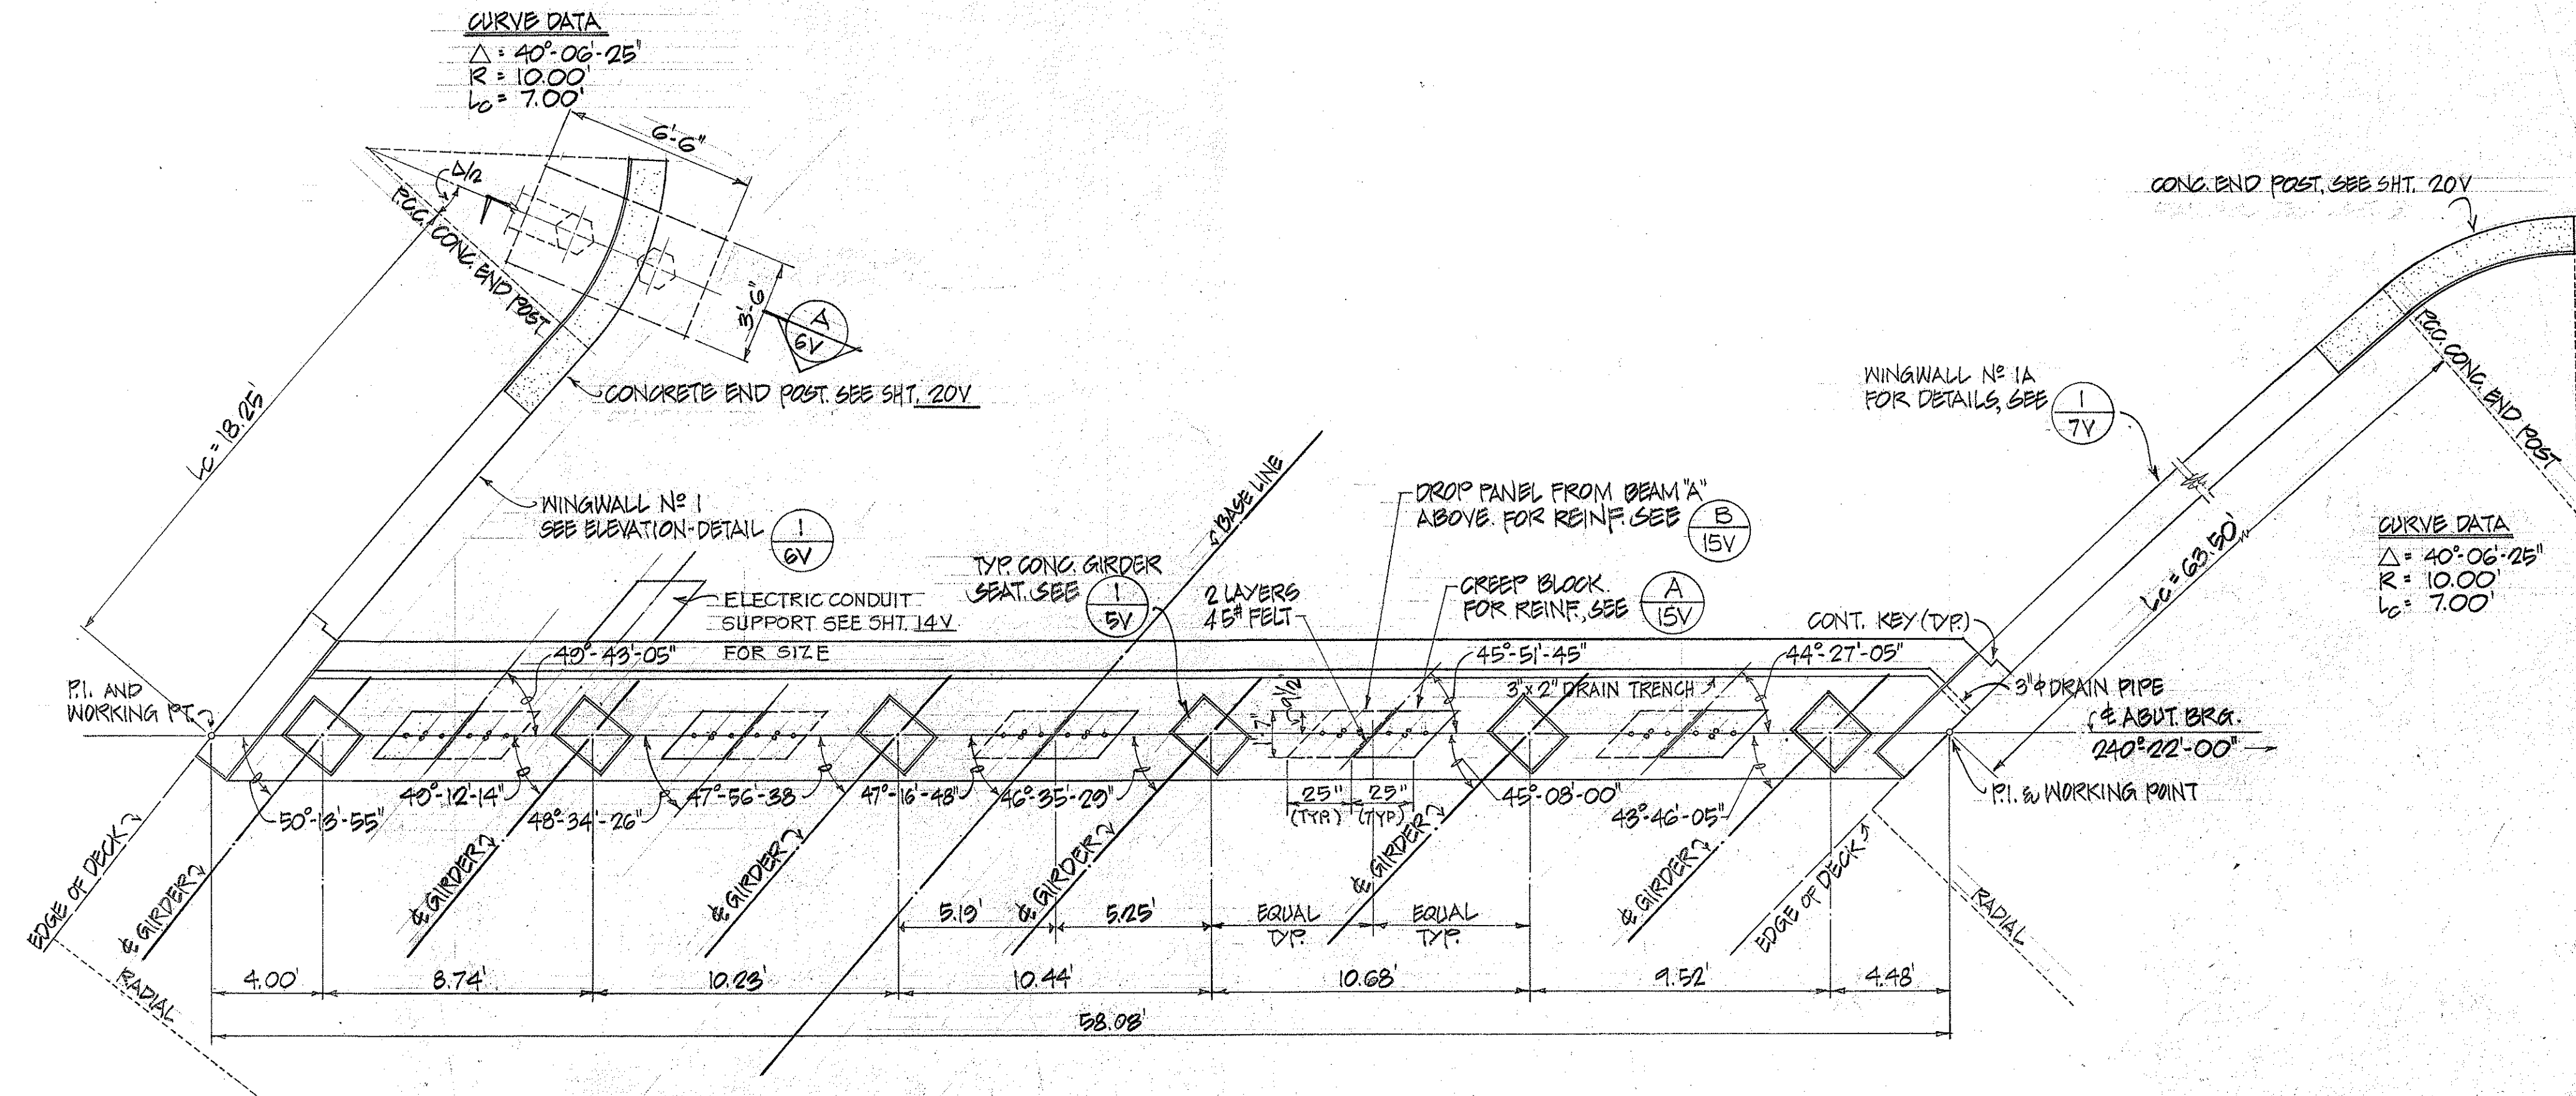

LEGEND
 ○ VERTICAL PILE (NO BATTER)
 ▽ BATTER PILE 3:1/2 IN DIRECTION SHOWN ON PLAN

STATE OF HAWAII
 DEPARTMENT OF TRANSPORTATION
 HIGHWAYS DIVISION


PLAN & DETAILS - ABUTMENT NO. 1
 BRIDGE NO. 3

HALEKOU INTERCHANGE
 F.A.I. Proj. No. I-H3-1(24)-11


Scale: As Noted Date: SEPT. 1982

SHEET No. 4V OF 20 SHEETS


FED. ROAD DIST. NO.	STATE	FED. AID PROJ. NO.	FISCAL YEAR	SHEET NO.	TOTAL SHEETS
HAWAII	HAW.	I-HS-1(24)11	1983	206	328

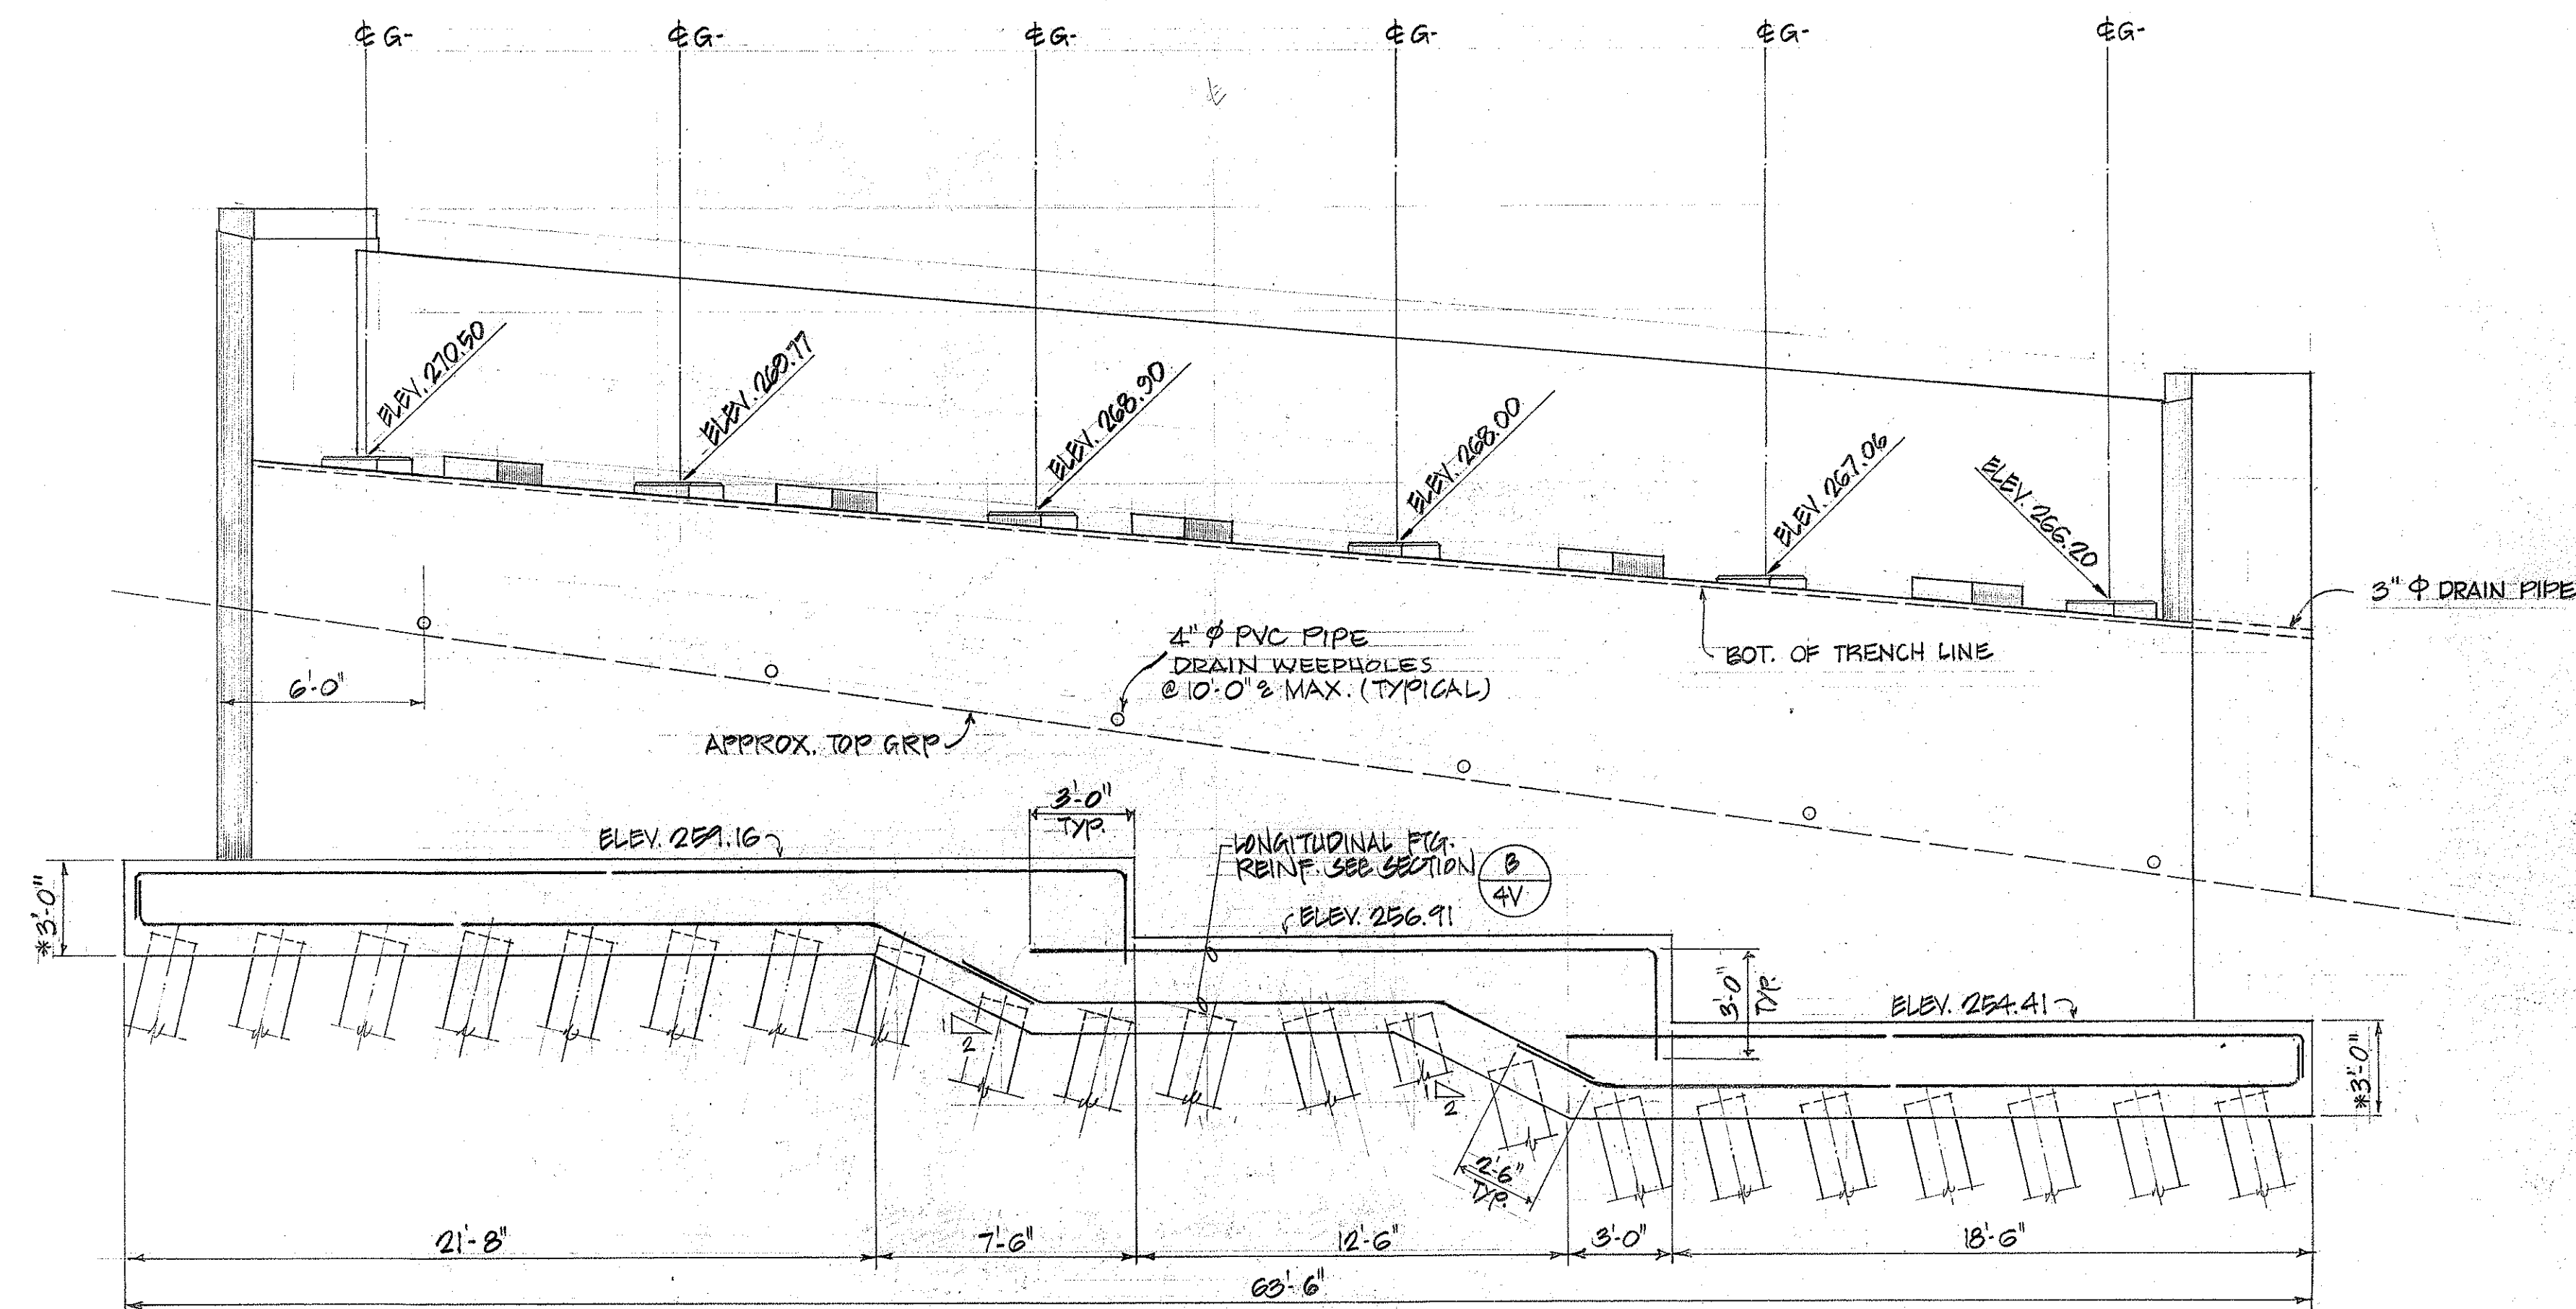

ELEVATION ~ ABUTMENT NO. 1
SCALE: $\frac{1}{4}" = 1'-0"$

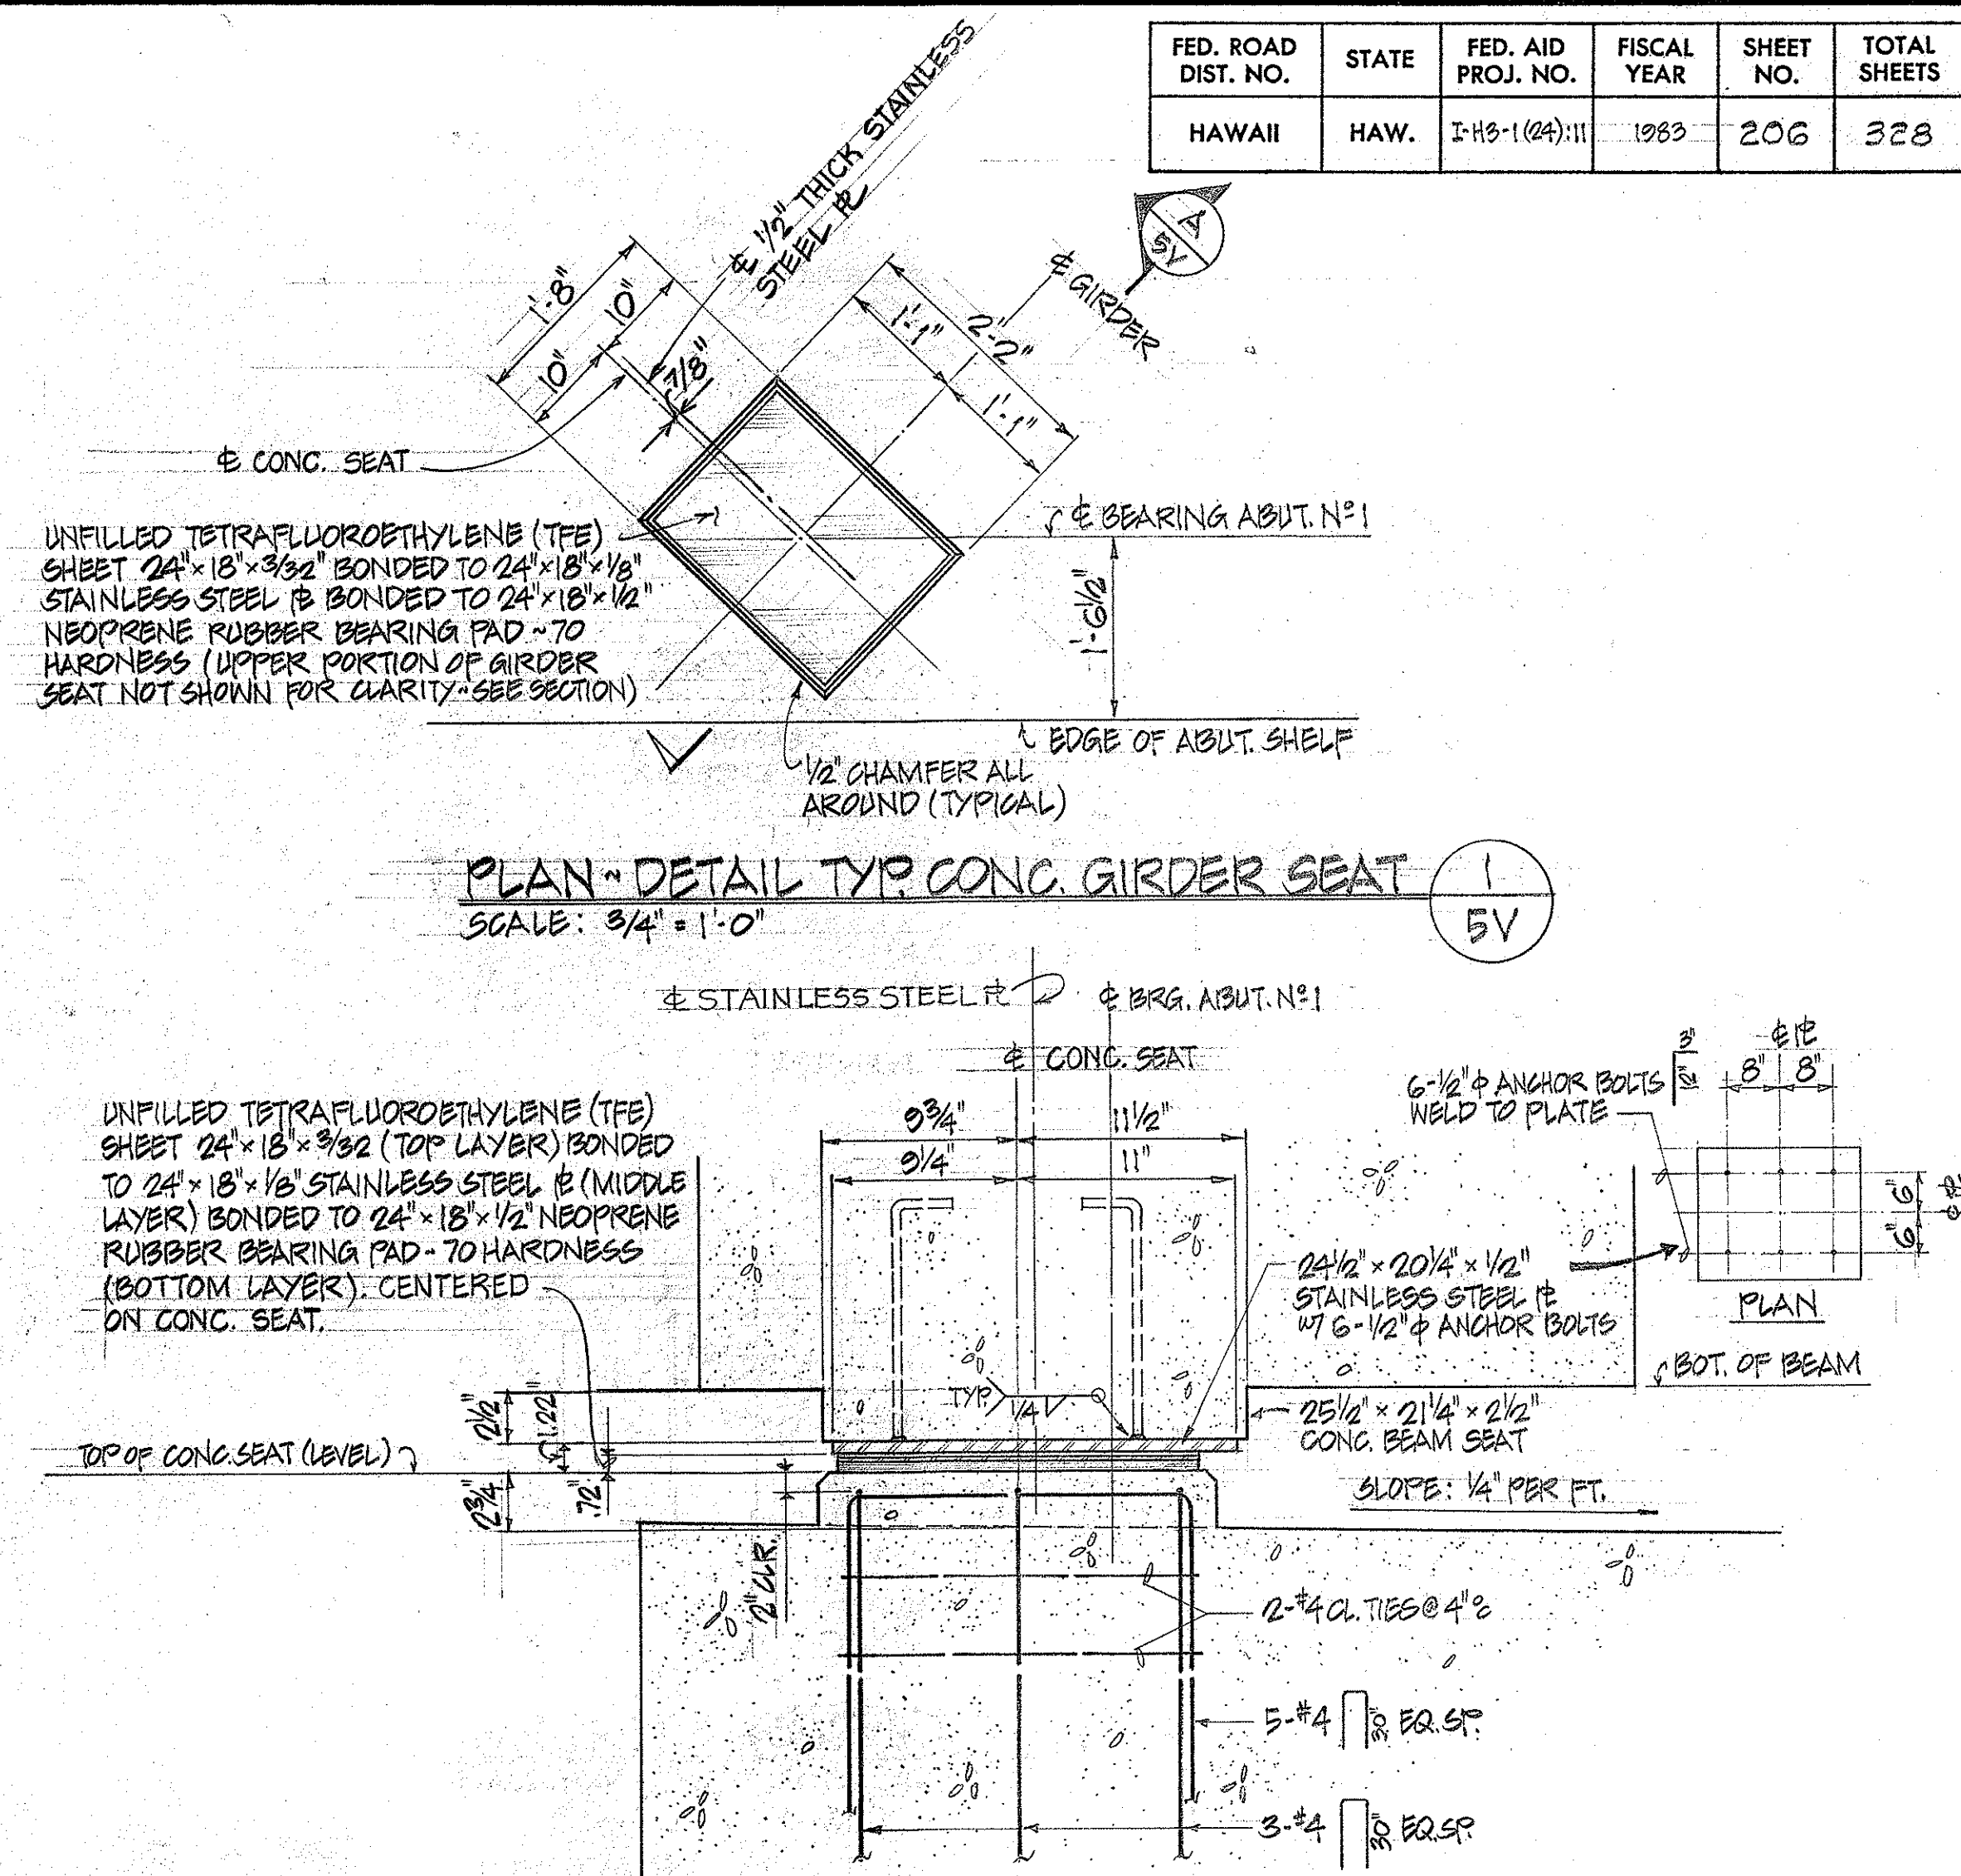

SECTION A
SCALE: 1 1/2" = 1'-0" 5V

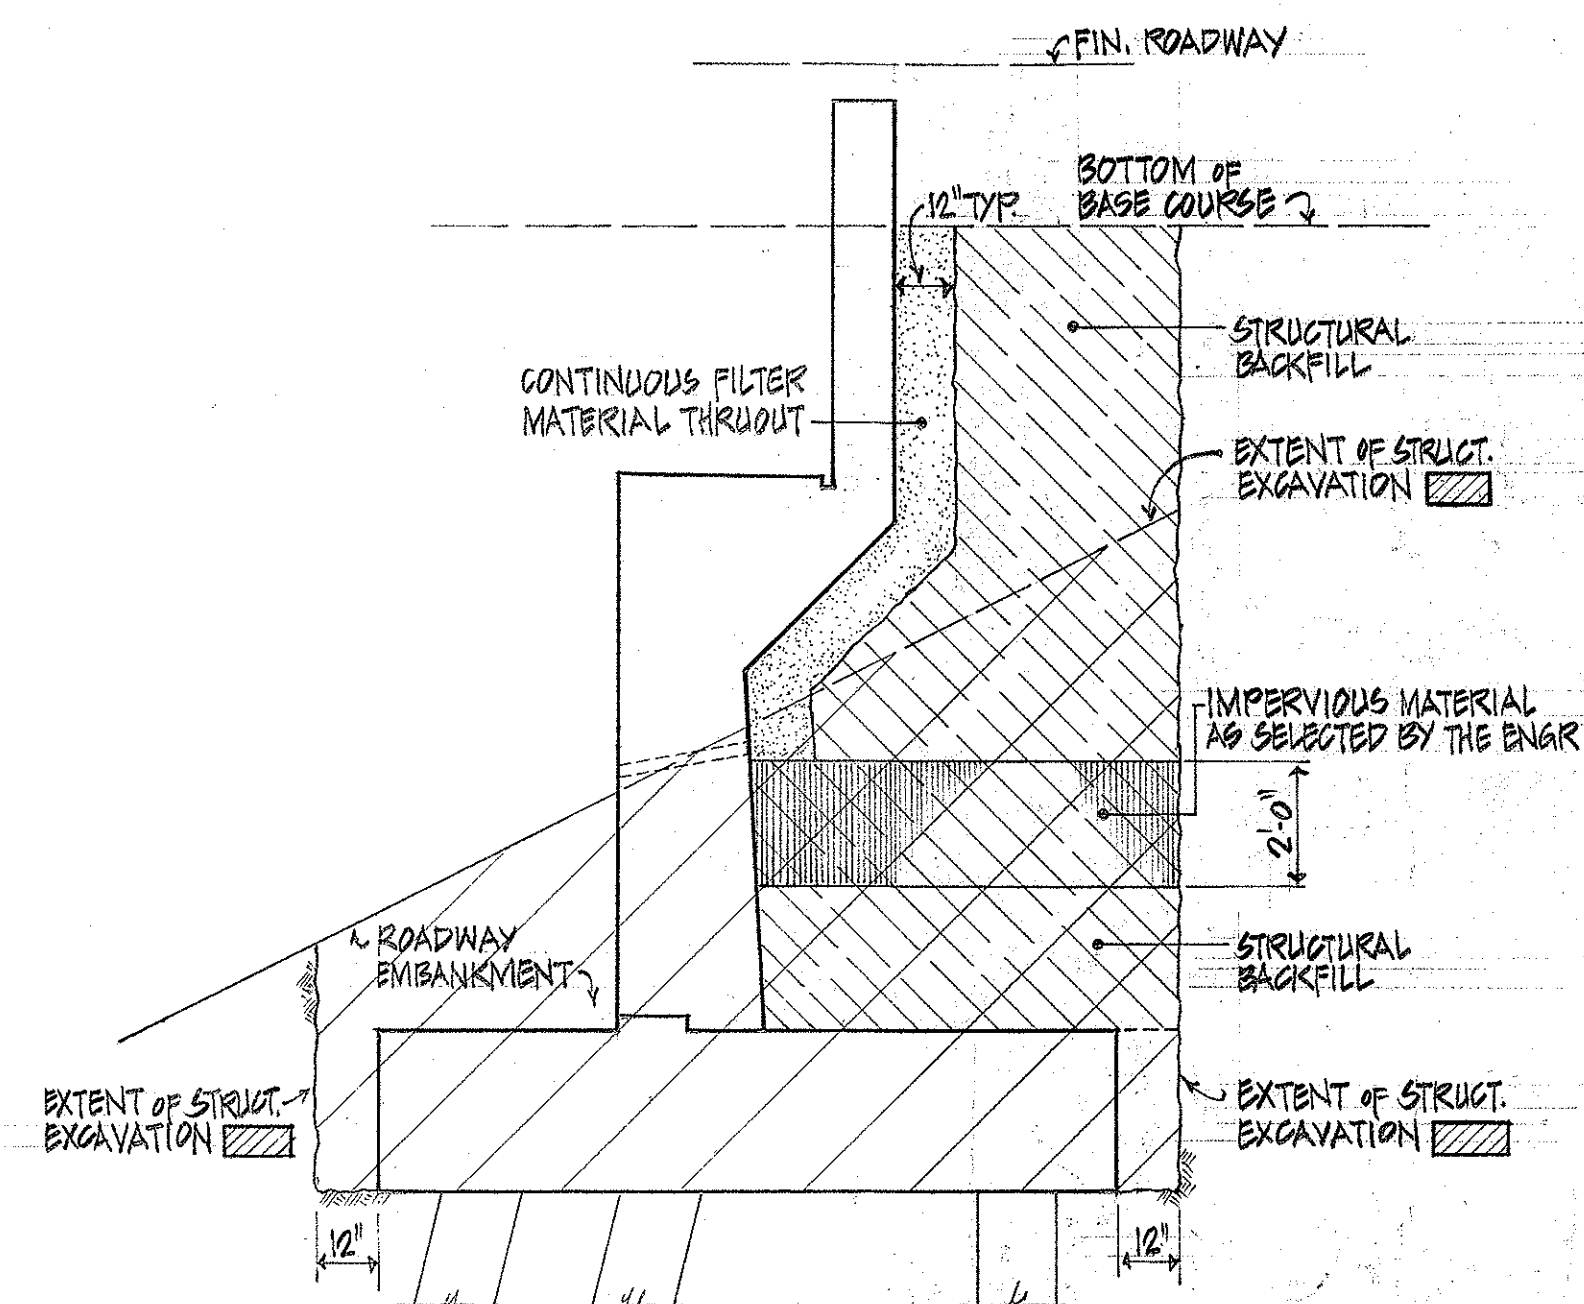

TYPICAL ABUTMENT NO 1 BACKFILL
(ABUTMENT NO 2 SIMILAR)
NO SCALE

ORIGINAL PLAN	SURVEY PLOTTED BY _____	DATE _____
NOTE BOOK	DRAWN BY _____	" _____
	TRACED BY _____	" _____
	DESIGNED BY _____	" _____
	QUANTITIES BY _____	" _____
No. _____	CHECKED BY _____	

K&E CRYSTALEND® LA 388
TRACER BASE

STATE OF HAWAII
DEPARTMENT OF TRANSPORTATION
HIGHWAYS DIVISION


ELEVATION ~ ABUTMENT N^o 1
BRIDGE N^o 3

HALEKOU INTERCHANGE
E.A.I. Proj. No. I-H3-1(24):11


Scale: As Noted Date: SEPT. 1982

SHEET No. 5V OF 20 SHEETS


FED. ROAD DIST. NO.	STATE	FED. AID PROJ. NO.	FISCAL YEAR	SHEET NO.	TOTAL SHEETS
HAWAII	HAW.	I-H3-1(24):11	1983	207	328

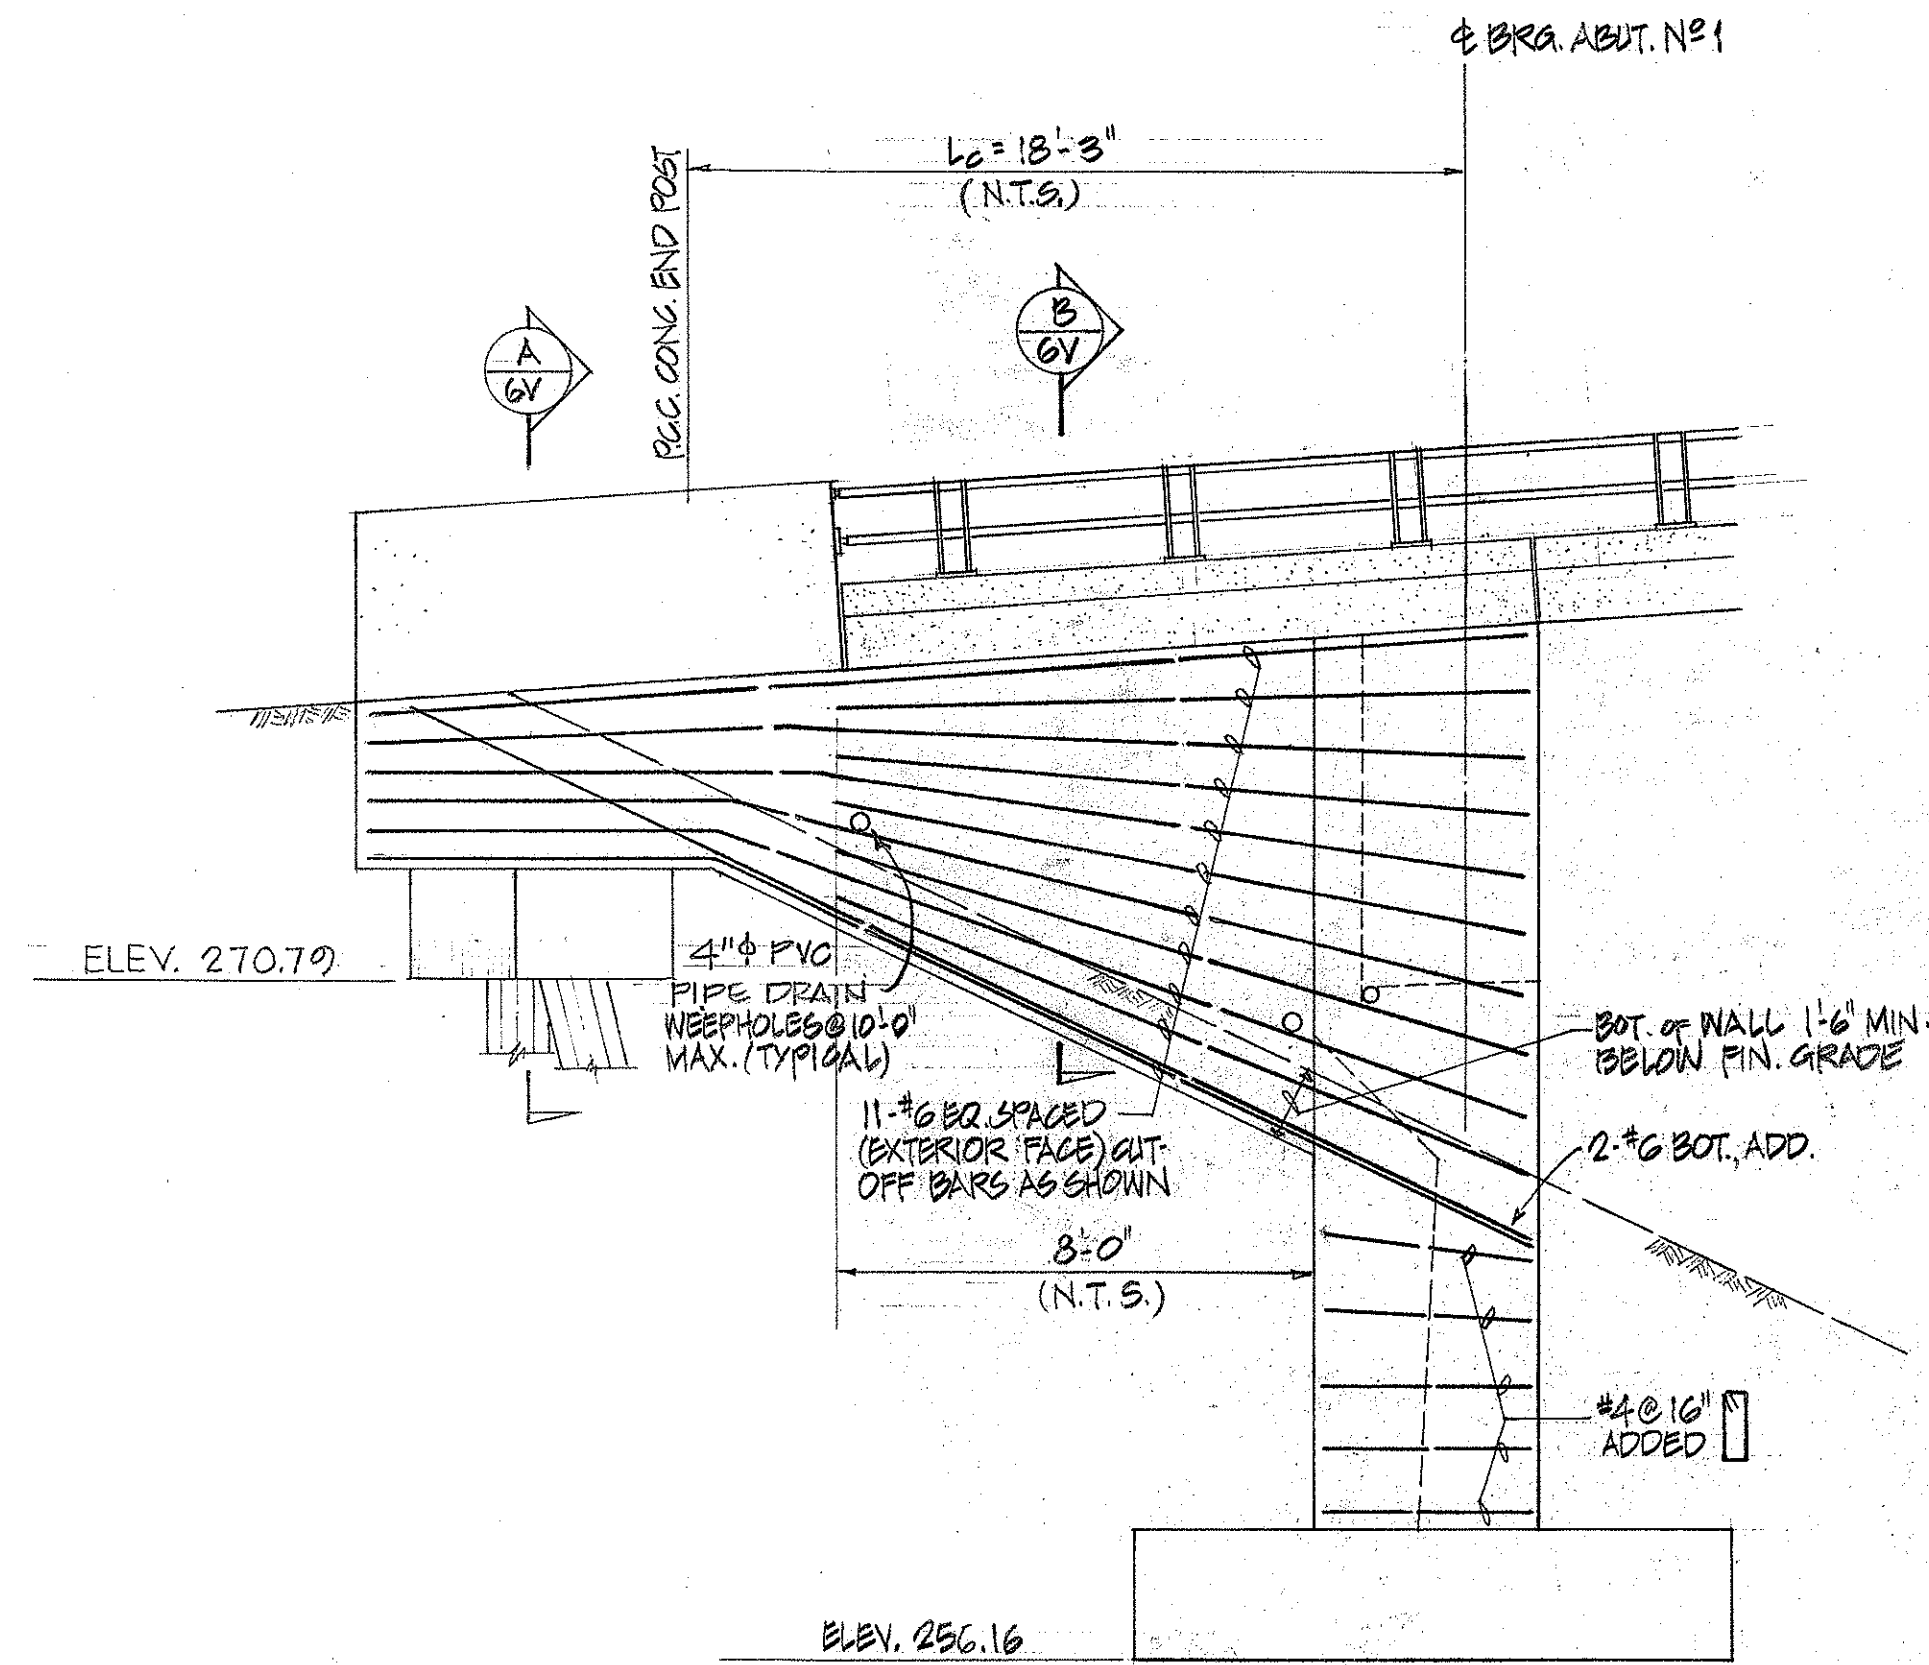

WINGWALL NO. 1 ELEVATION-DETAIL
SCALE: 1/4" = 1'-0"

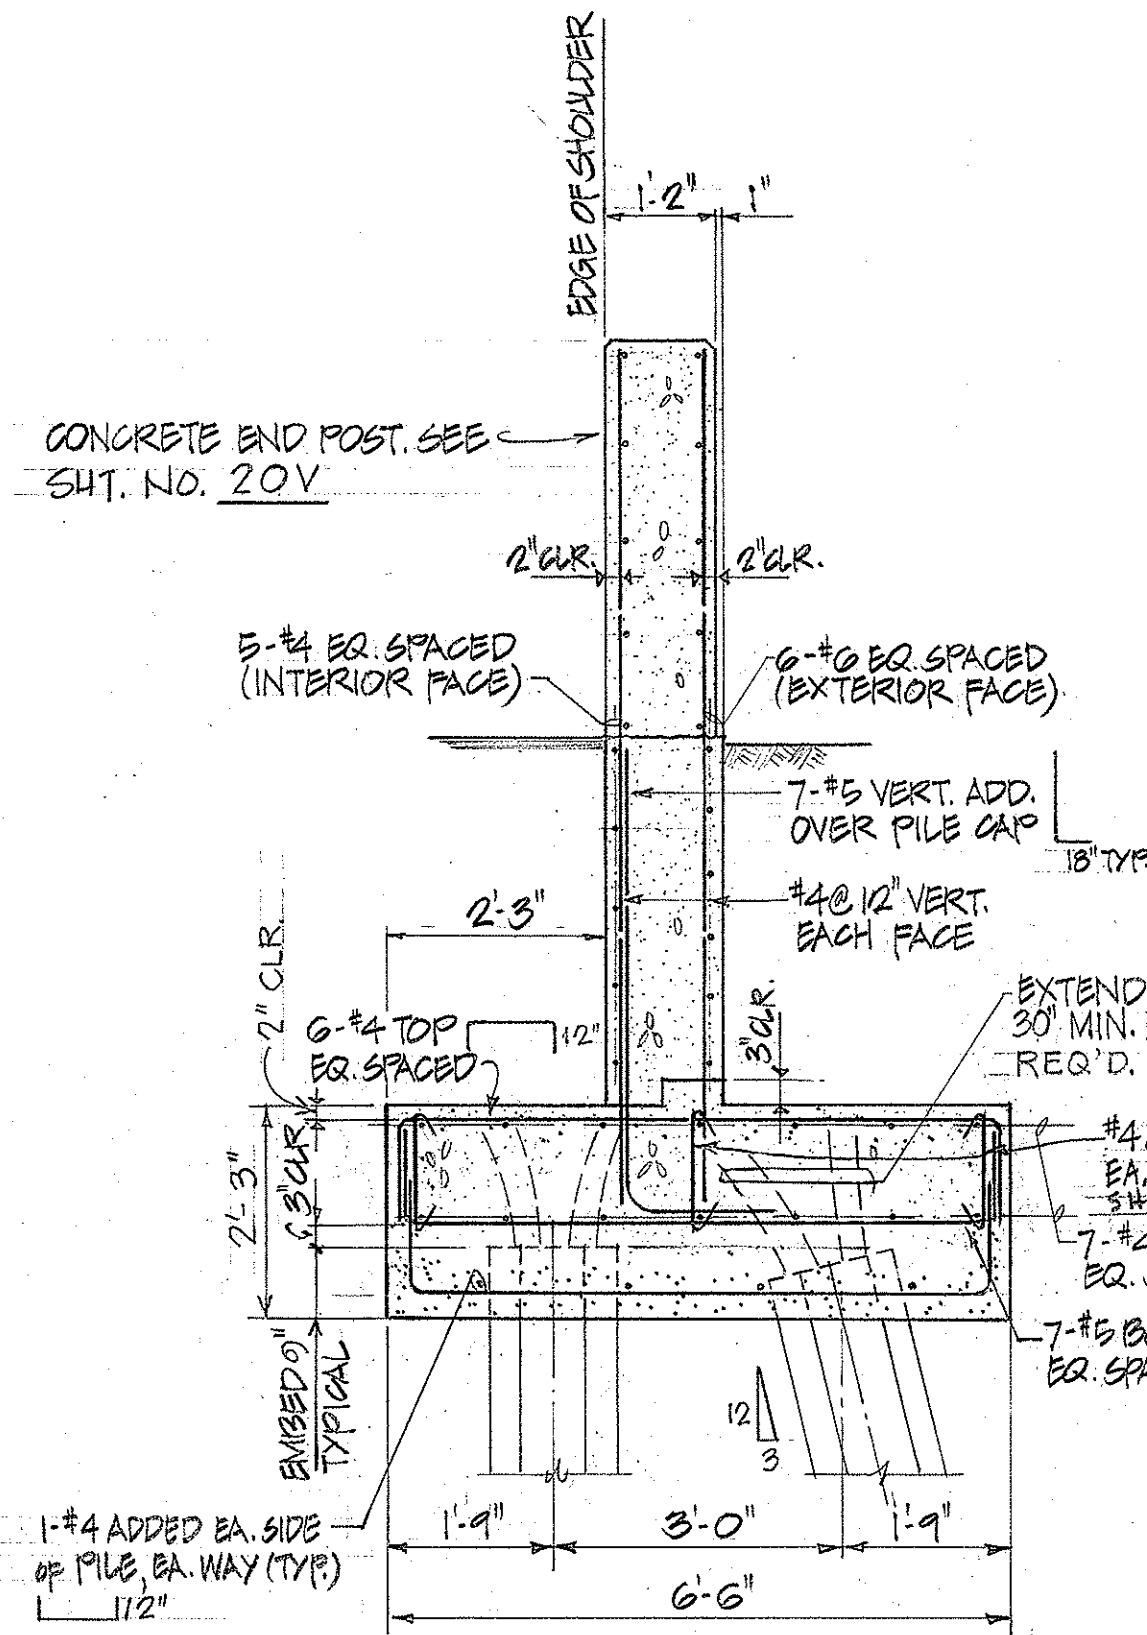

SECTION A
SCALE: 1/2" = 1'-0"

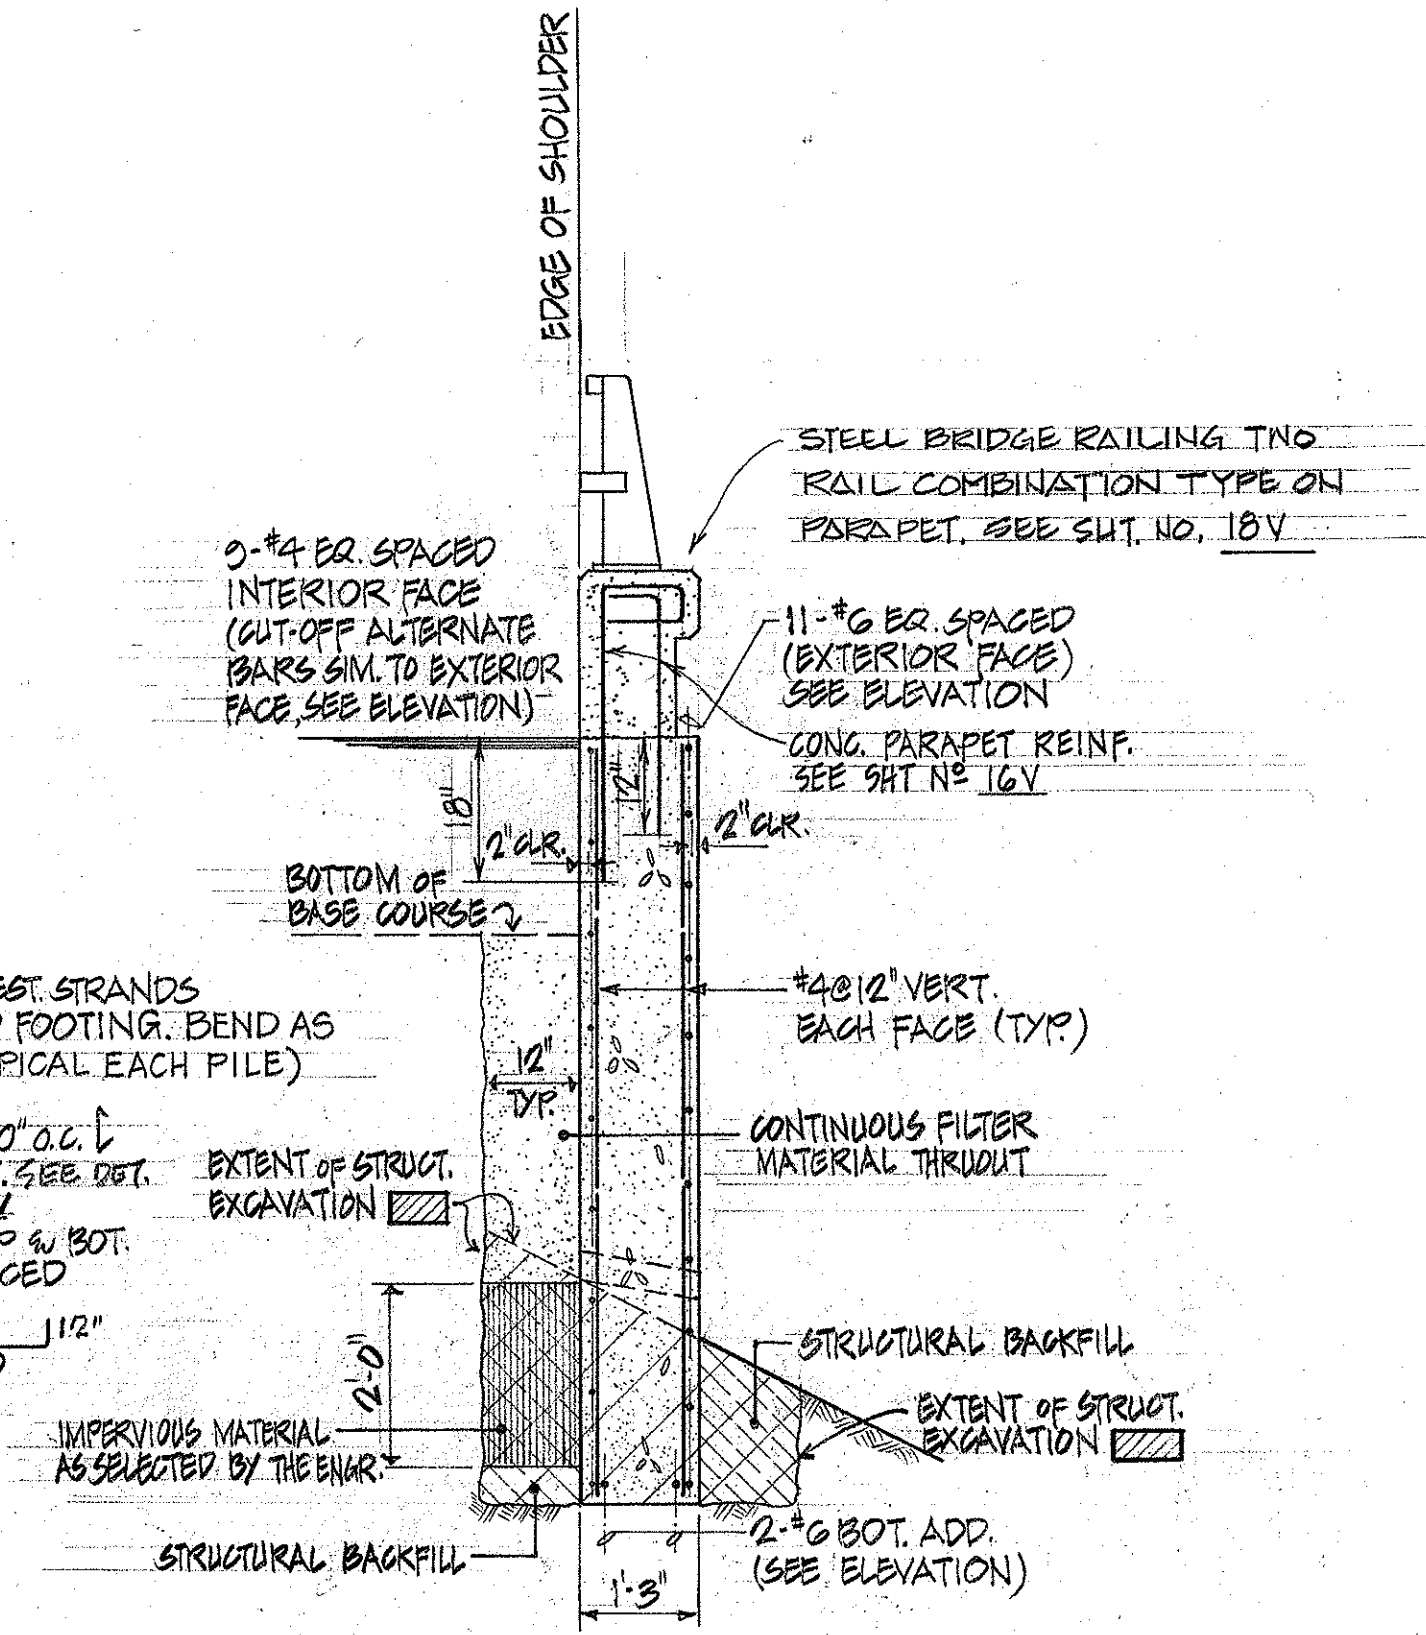

SECTION B
SCALE: 1/2" = 1'-0"

ORIGINAL PLAN	DATE
SURVEY PLOTTED BY	
DRAWN BY	
CHECKED BY	
NOTE BOOK	
NO.	


STATE OF HAWAII
DEPARTMENT OF TRANSPORTATION
HIGHWAYS DIVISION

WINGWALL NO. 1 DETAILS
BRIDGE NO. 3


HALEKOU INTERCHANGE
F.A.I. Proj. No. I-H3-1(24):11

Scale: As Noted Date: SEPT. 1982
SHEET NO. 6V OF 20 SHEETS


FED. ROAD DIST. NO.	STATE	FED. AID PROJ. NO.	FISCAL YEAR	SHEET NO.	TOTAL SHEETS
HAWAII	HAW.	I-13-1(24)-11	1983	208	328

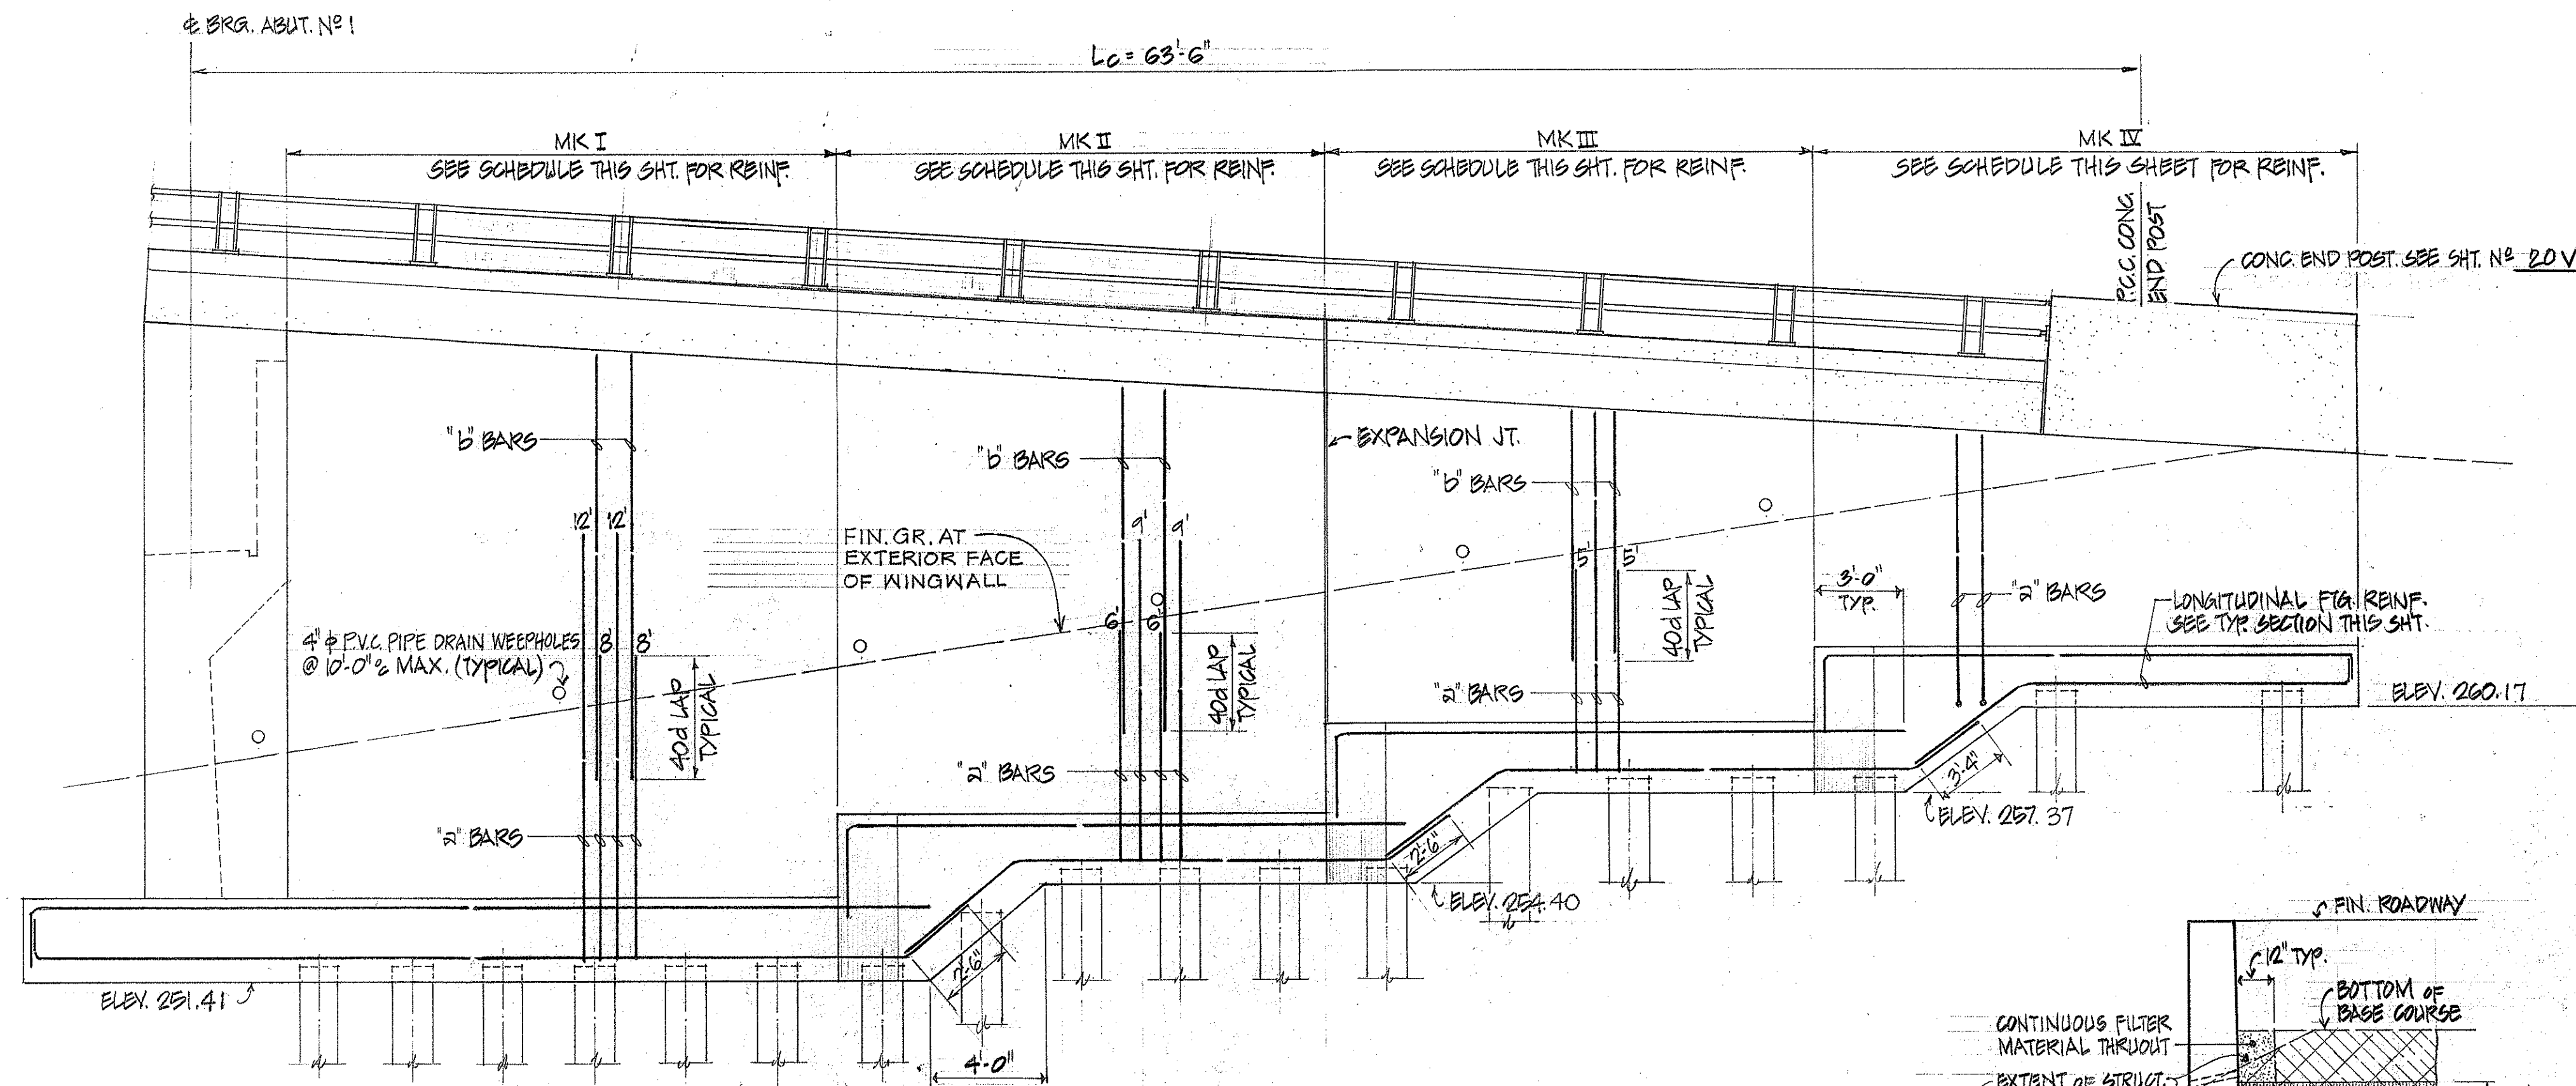


WINGWALL NO. 1A ELEVATION - DETAIL
SCALE: 1/4" = 1'-0"

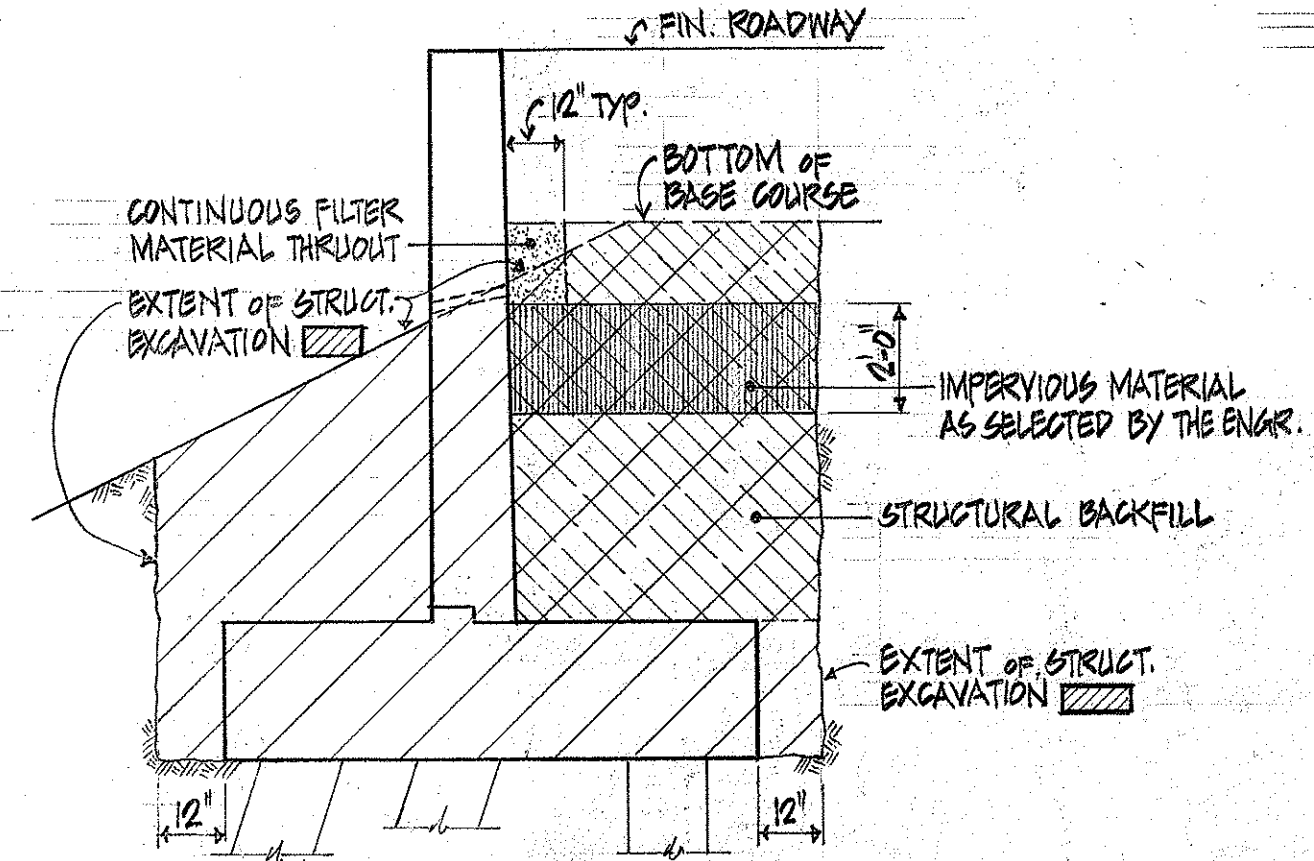

TYPICAL WINGWALL NO. 1A BACKFILL
(WINGWALL NO. 2 SIMILAR)
NO SCALE

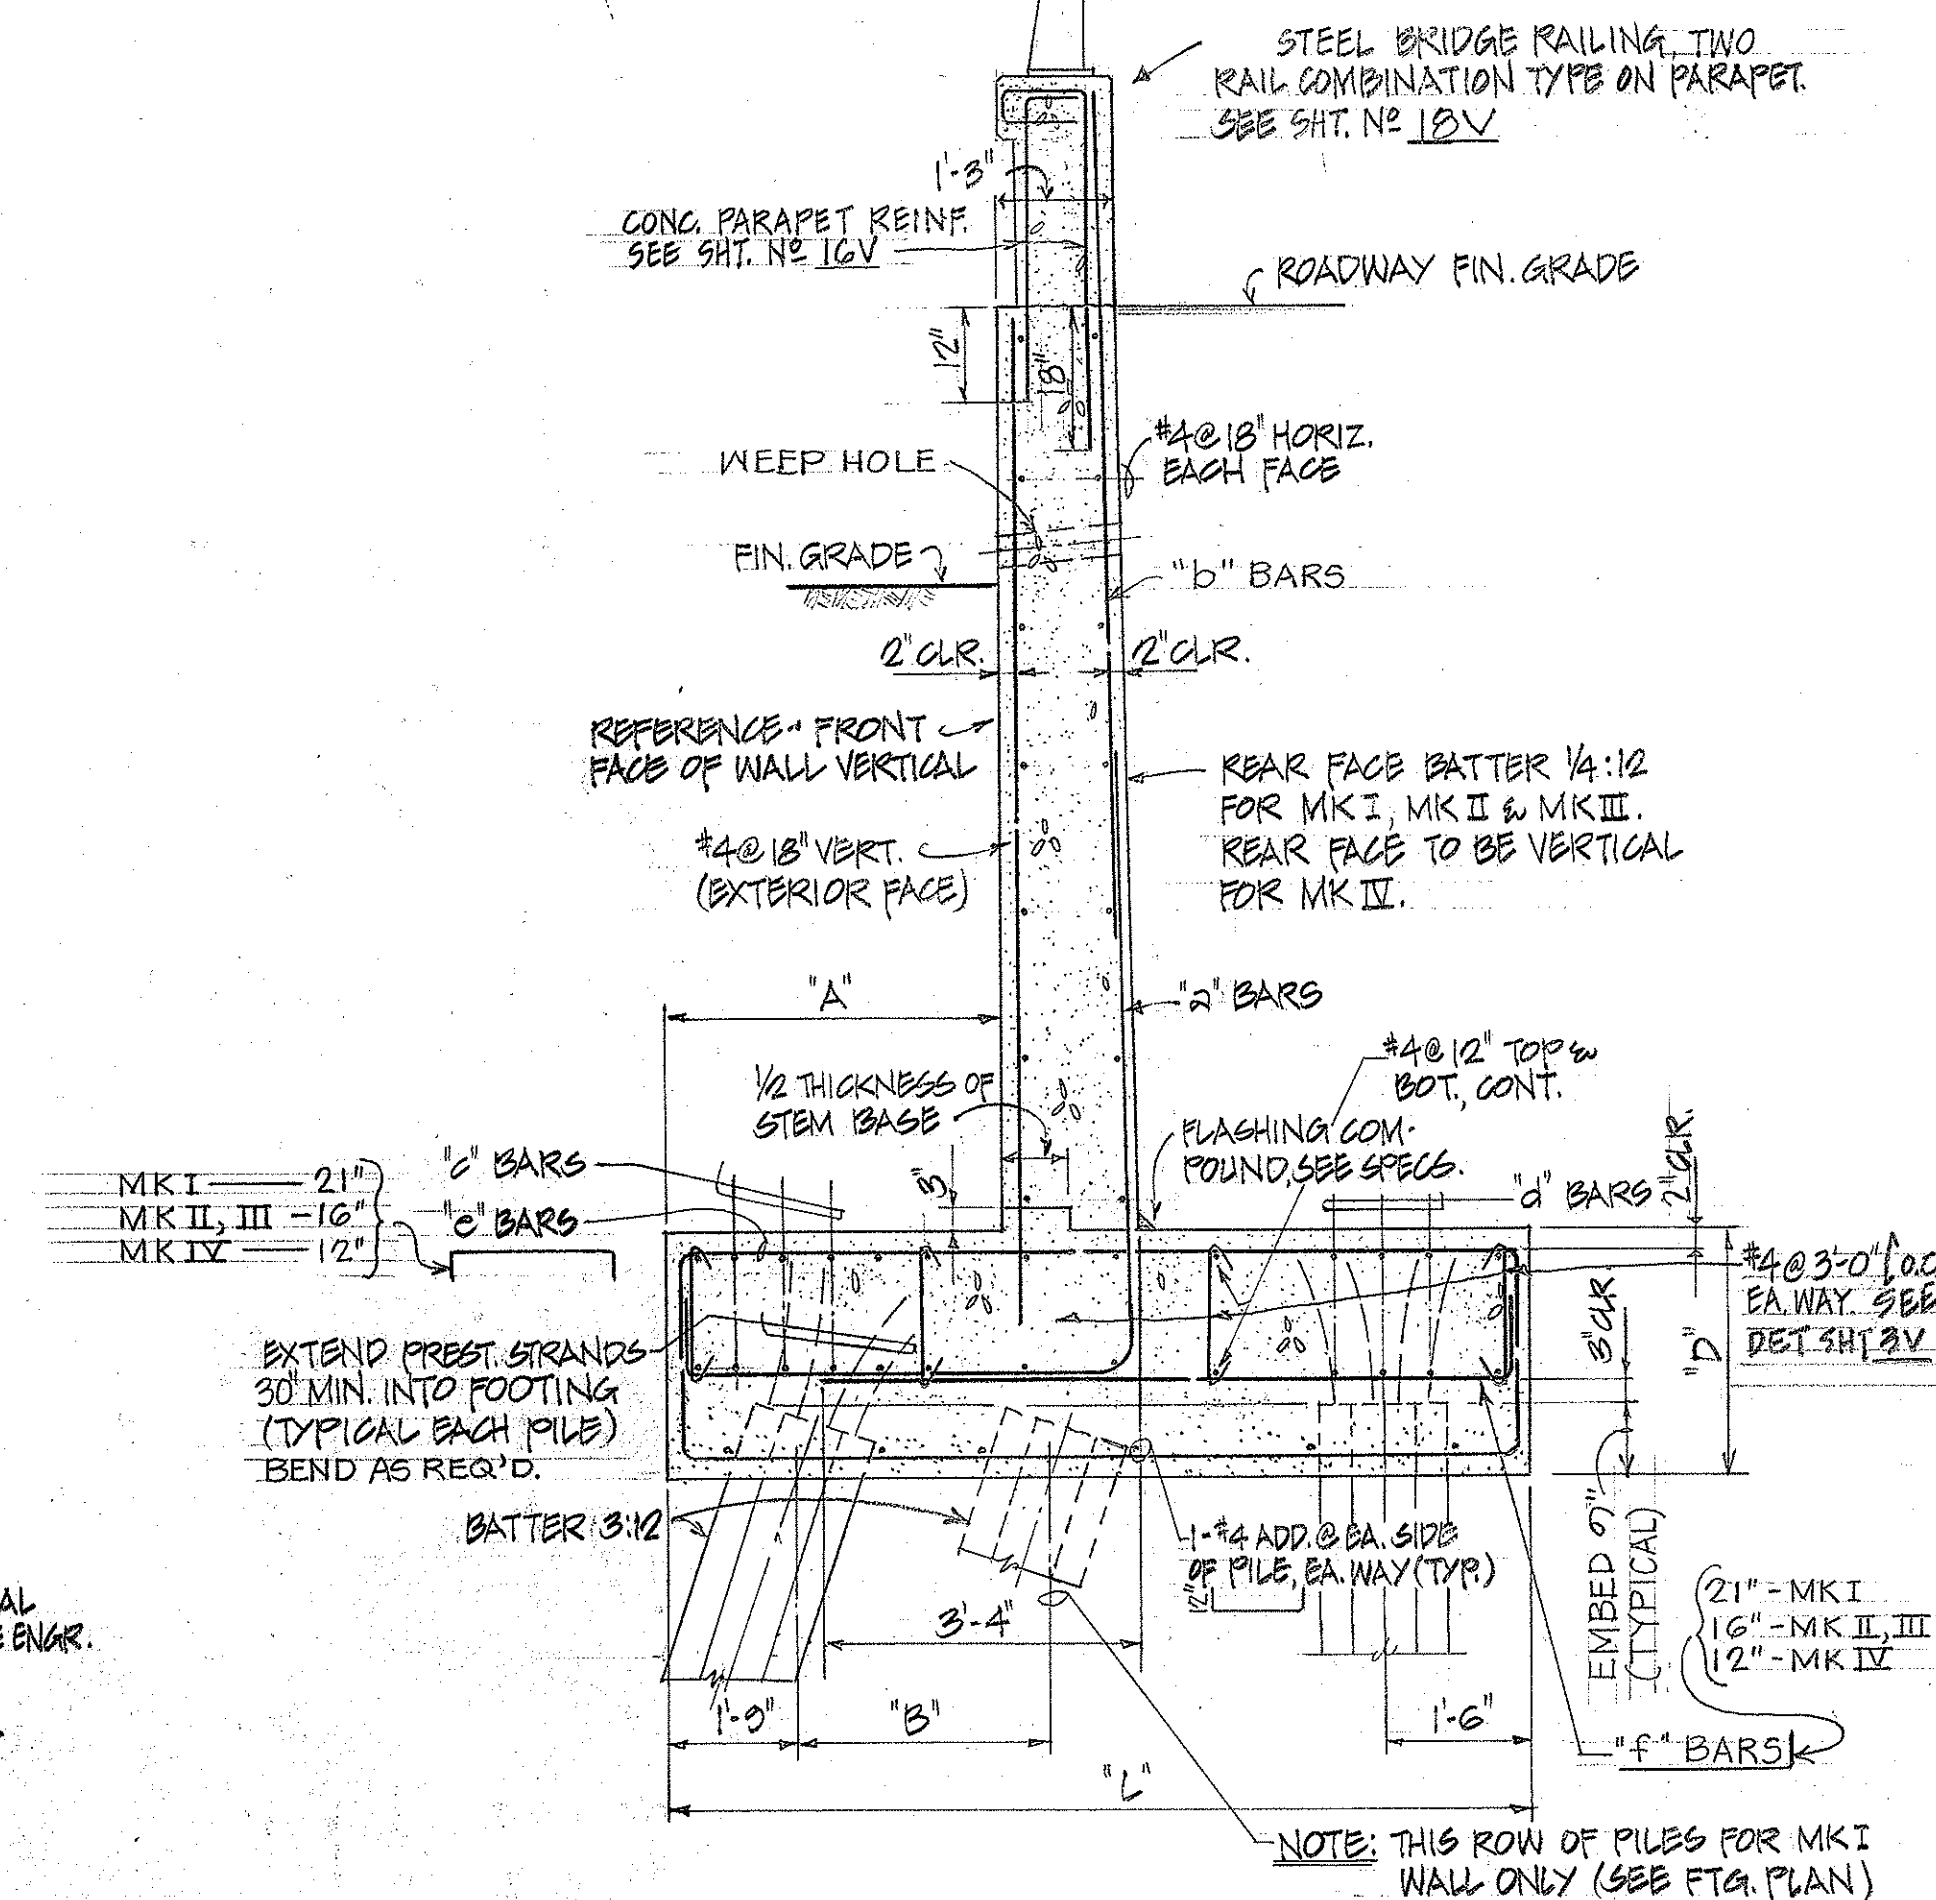

TYPICAL SECTION - WINGWALL NO. 1A
SCALE: 1/2" = 1'-0"

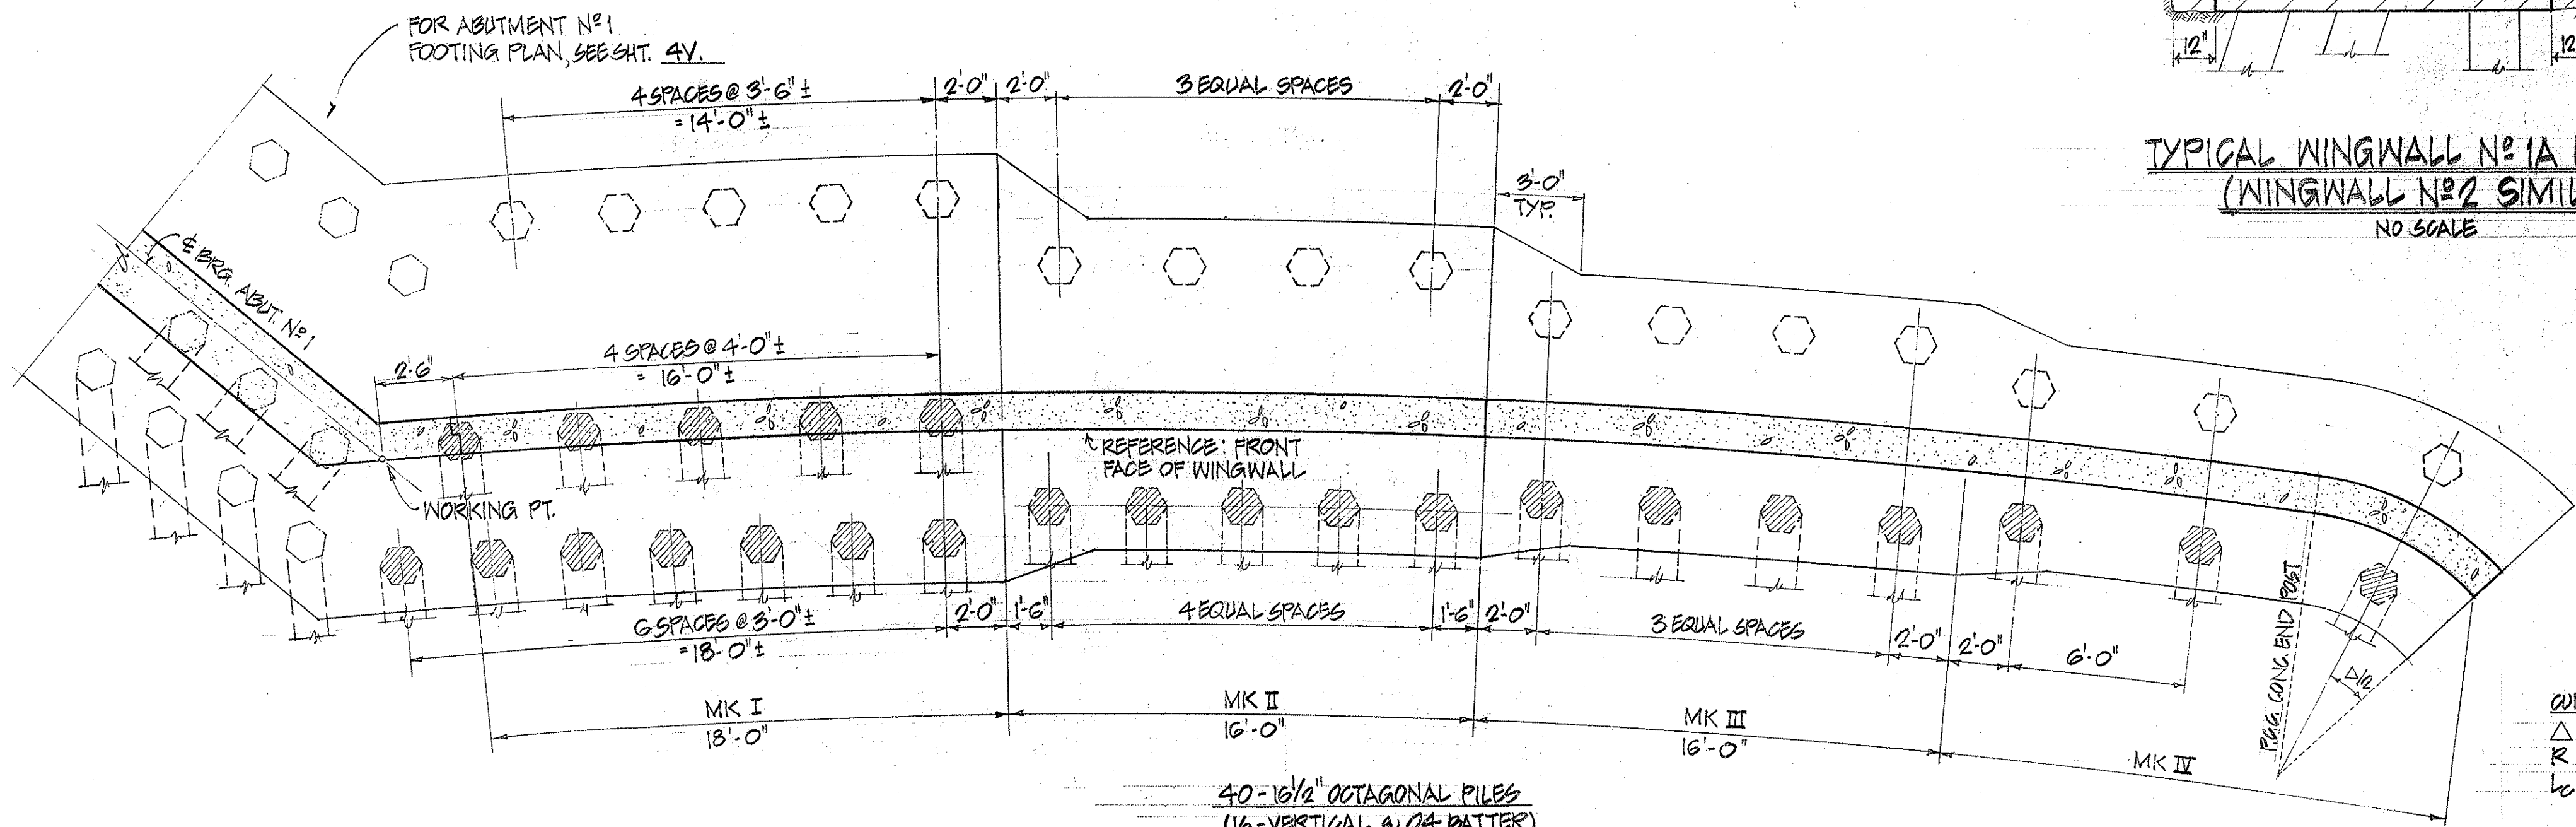

WINGWALL NO. 1A FOOTING PLAN
SCALE: 1/4" = 1'-0"

CURVE DATA
Δ = 40° 06' 25"
R = 10.00'
L = 7.00'

- LEGEND
- VERTICAL PILE (NO BATTER)
 - ⊙ BATTER PILE 3:12

WINGWALL NO. 1A SCHEDULE										
	"L"	"A"	"B"	"D"	"a" BARS	"b" BARS	"c" BARS	"d" BARS	"e" BARS	"f" BARS
MK I	14'-9"	5'-7"	4'-3"	36"	#10 @ 6"	#8 @ 12"	6-#6	6-#6	#10 @ 9"	#9 @ 9"
MK II	11'-3"	4'-3"	"	31"	#8 @ 6"	#7 @ 12"	6-#6	6-#6	#8 @ 12"	#7 @ 12"
MK III	9'-3"	3'-9"	"	31"	#7 @ 8 1/2"	#7 @ 17"	8-#6	6-#6	#6 @ 12"	#5 @ 12"
MK IV	7'-9"	3'-3"	"	27"	#6 @ 10"	"	8-#8	6-#8	#5 @ 12"	#5 @ 12"

STATE OF HAWAII
DEPARTMENT OF TRANSPORTATION
HIGHWAYS DIVISION






WINGWALL NO. 1A DETAILS
BRIDGE NO. 3

HALEKOU INTERCHANGE
F.A.I. Proj. No. I-13-1(24)-11

Scale: As Noted Date: SEPT. 1982

SHEET NO. 7V OF 20 SHEETS

FED. ROAD DIST. NO.	STATE	FED. AID PROJ. NO.	FISCAL YEAR	SHEET NO.	TOTAL SHEETS
HAWAII	HAW.	I-H3-1(24):11	1983	209	328

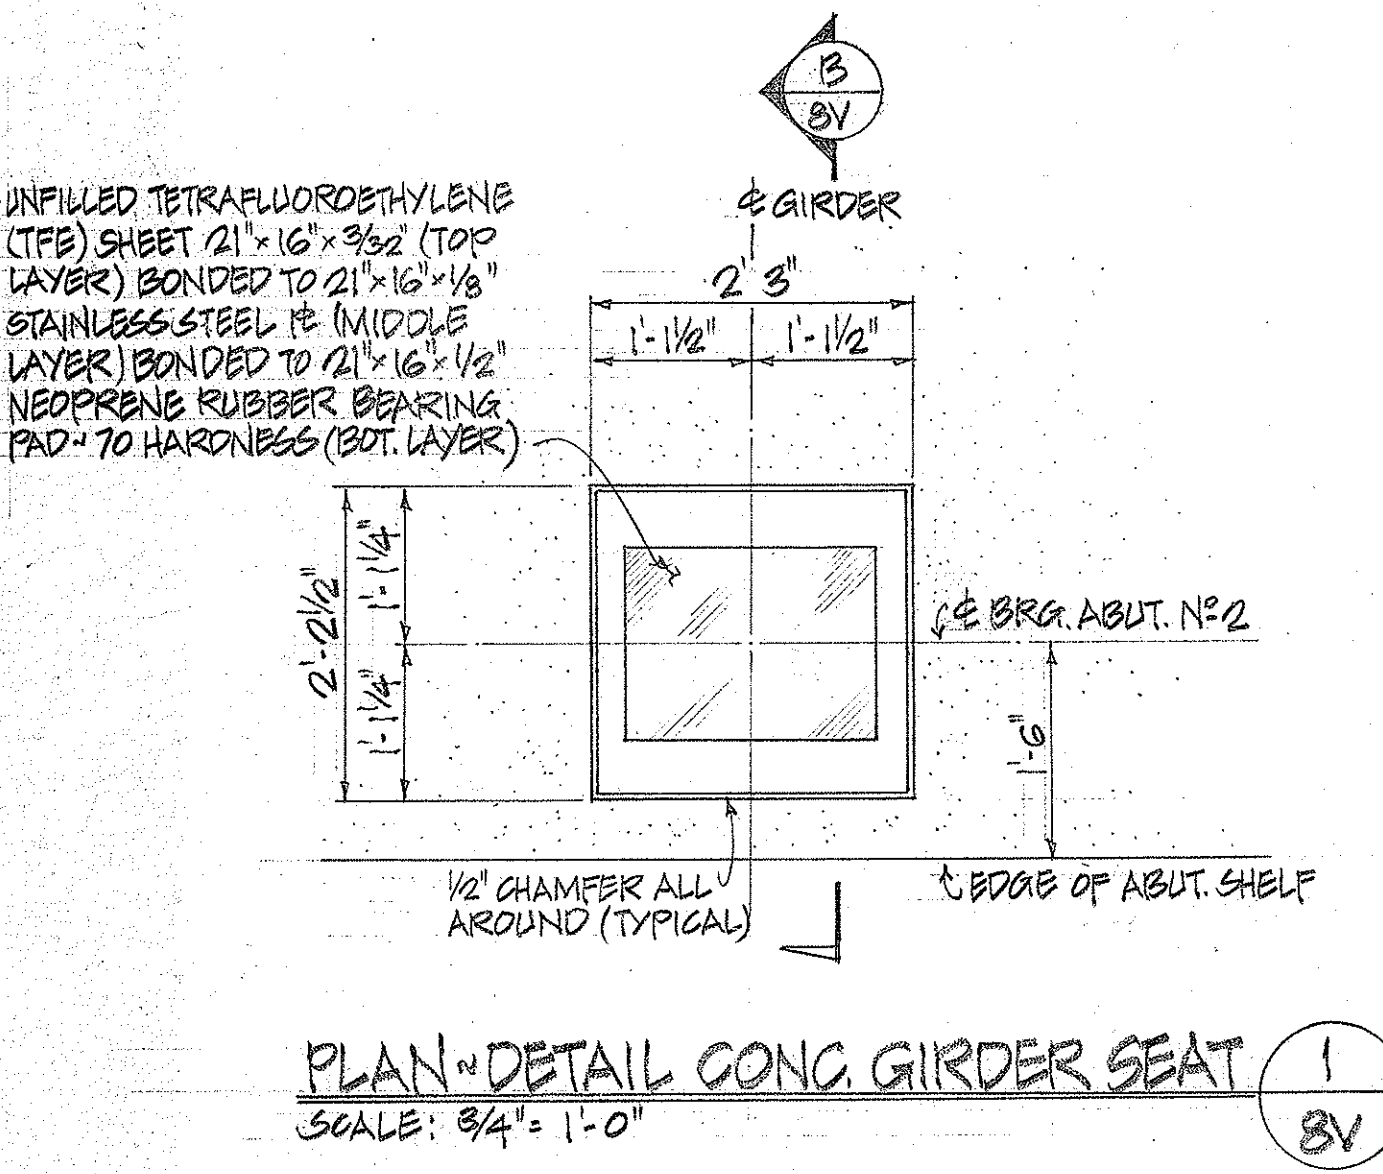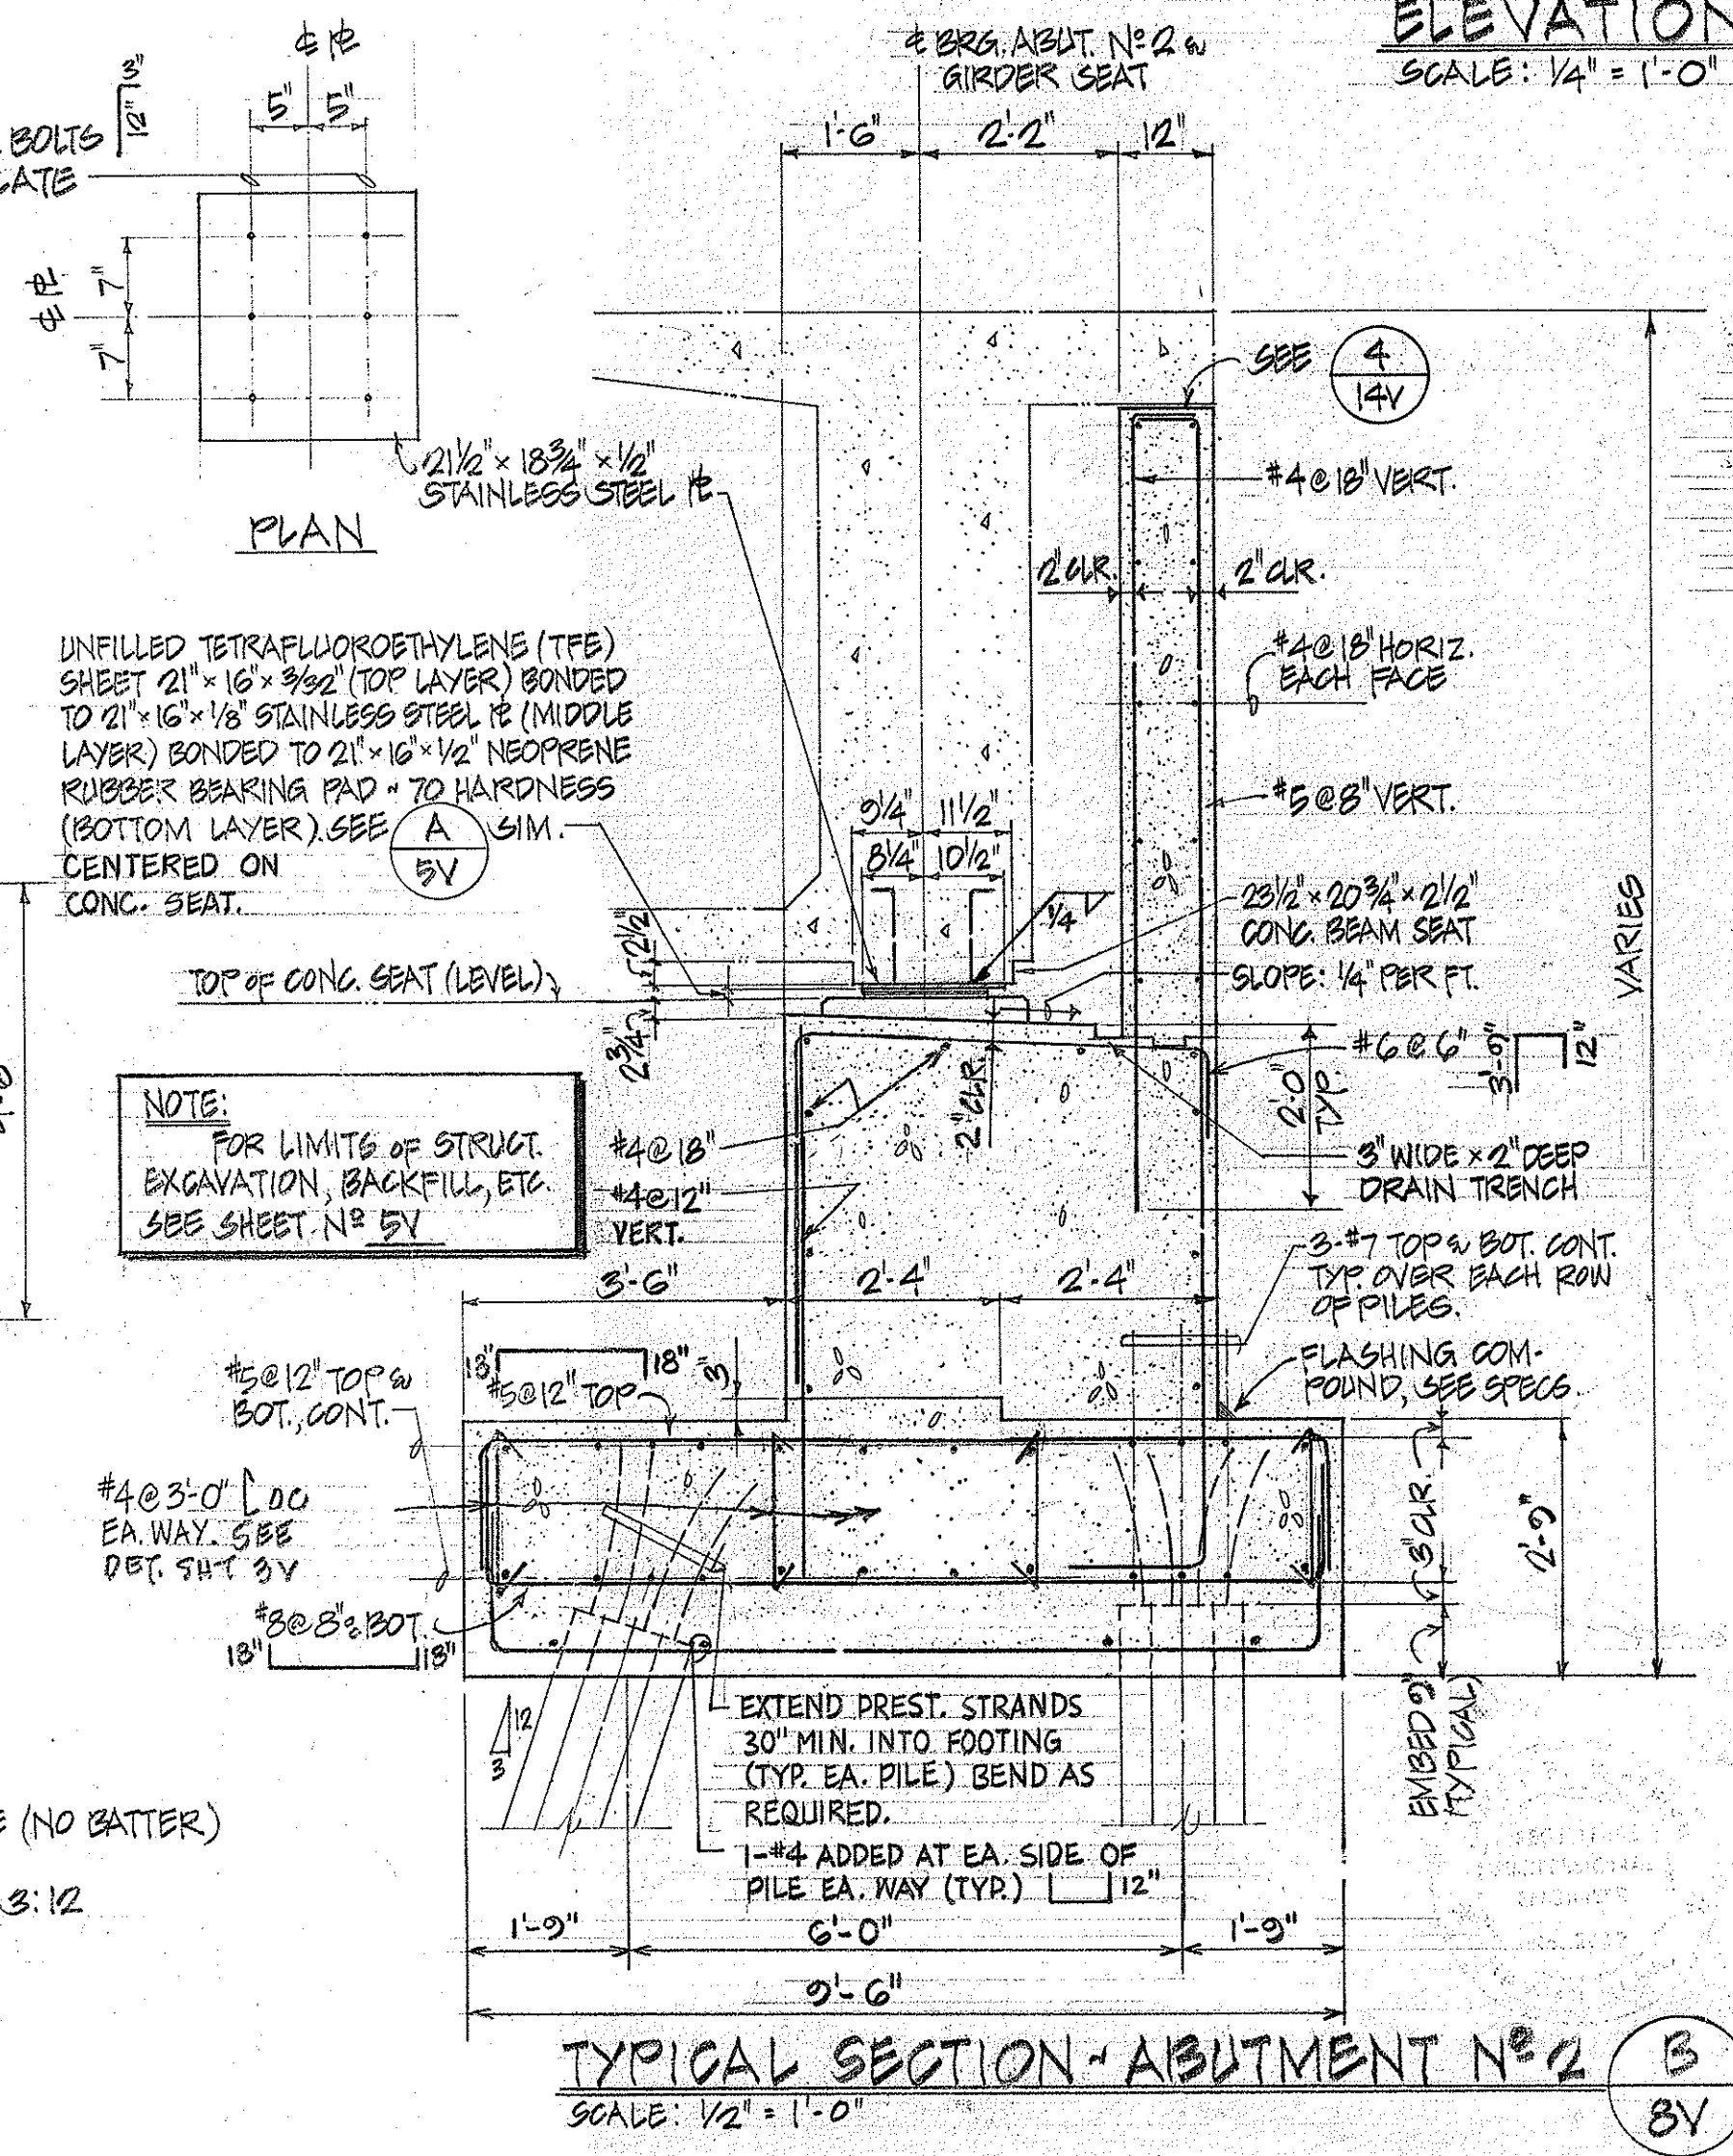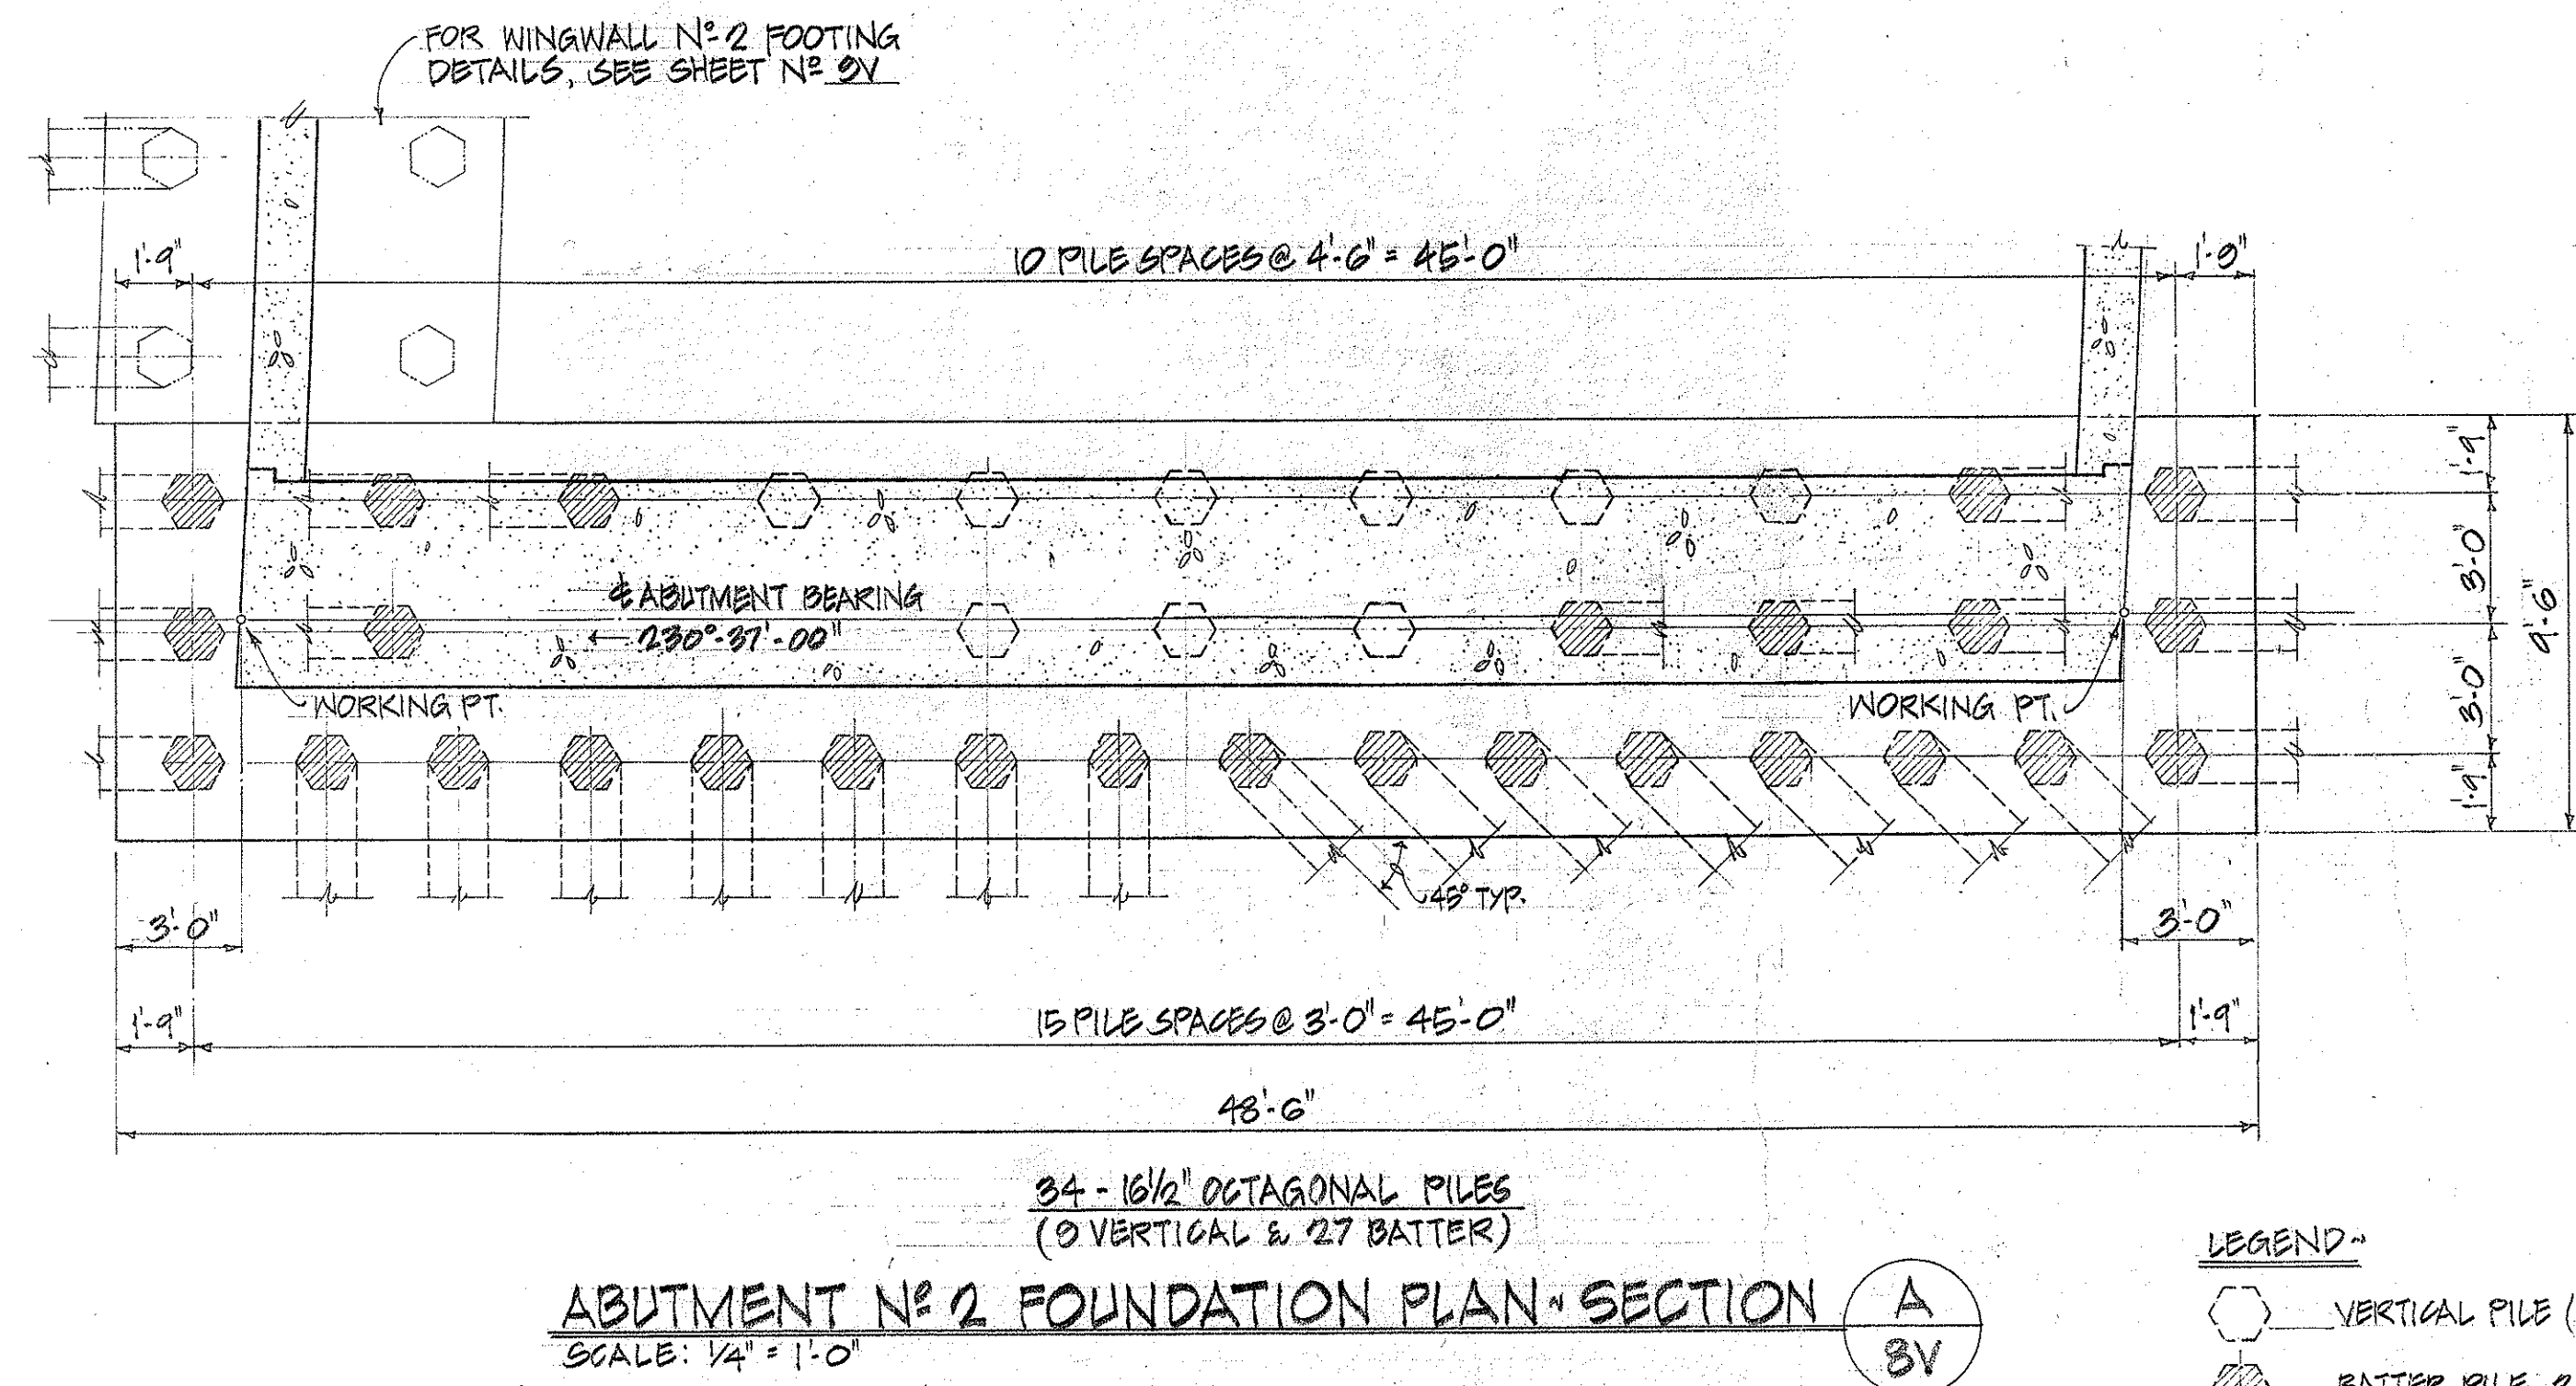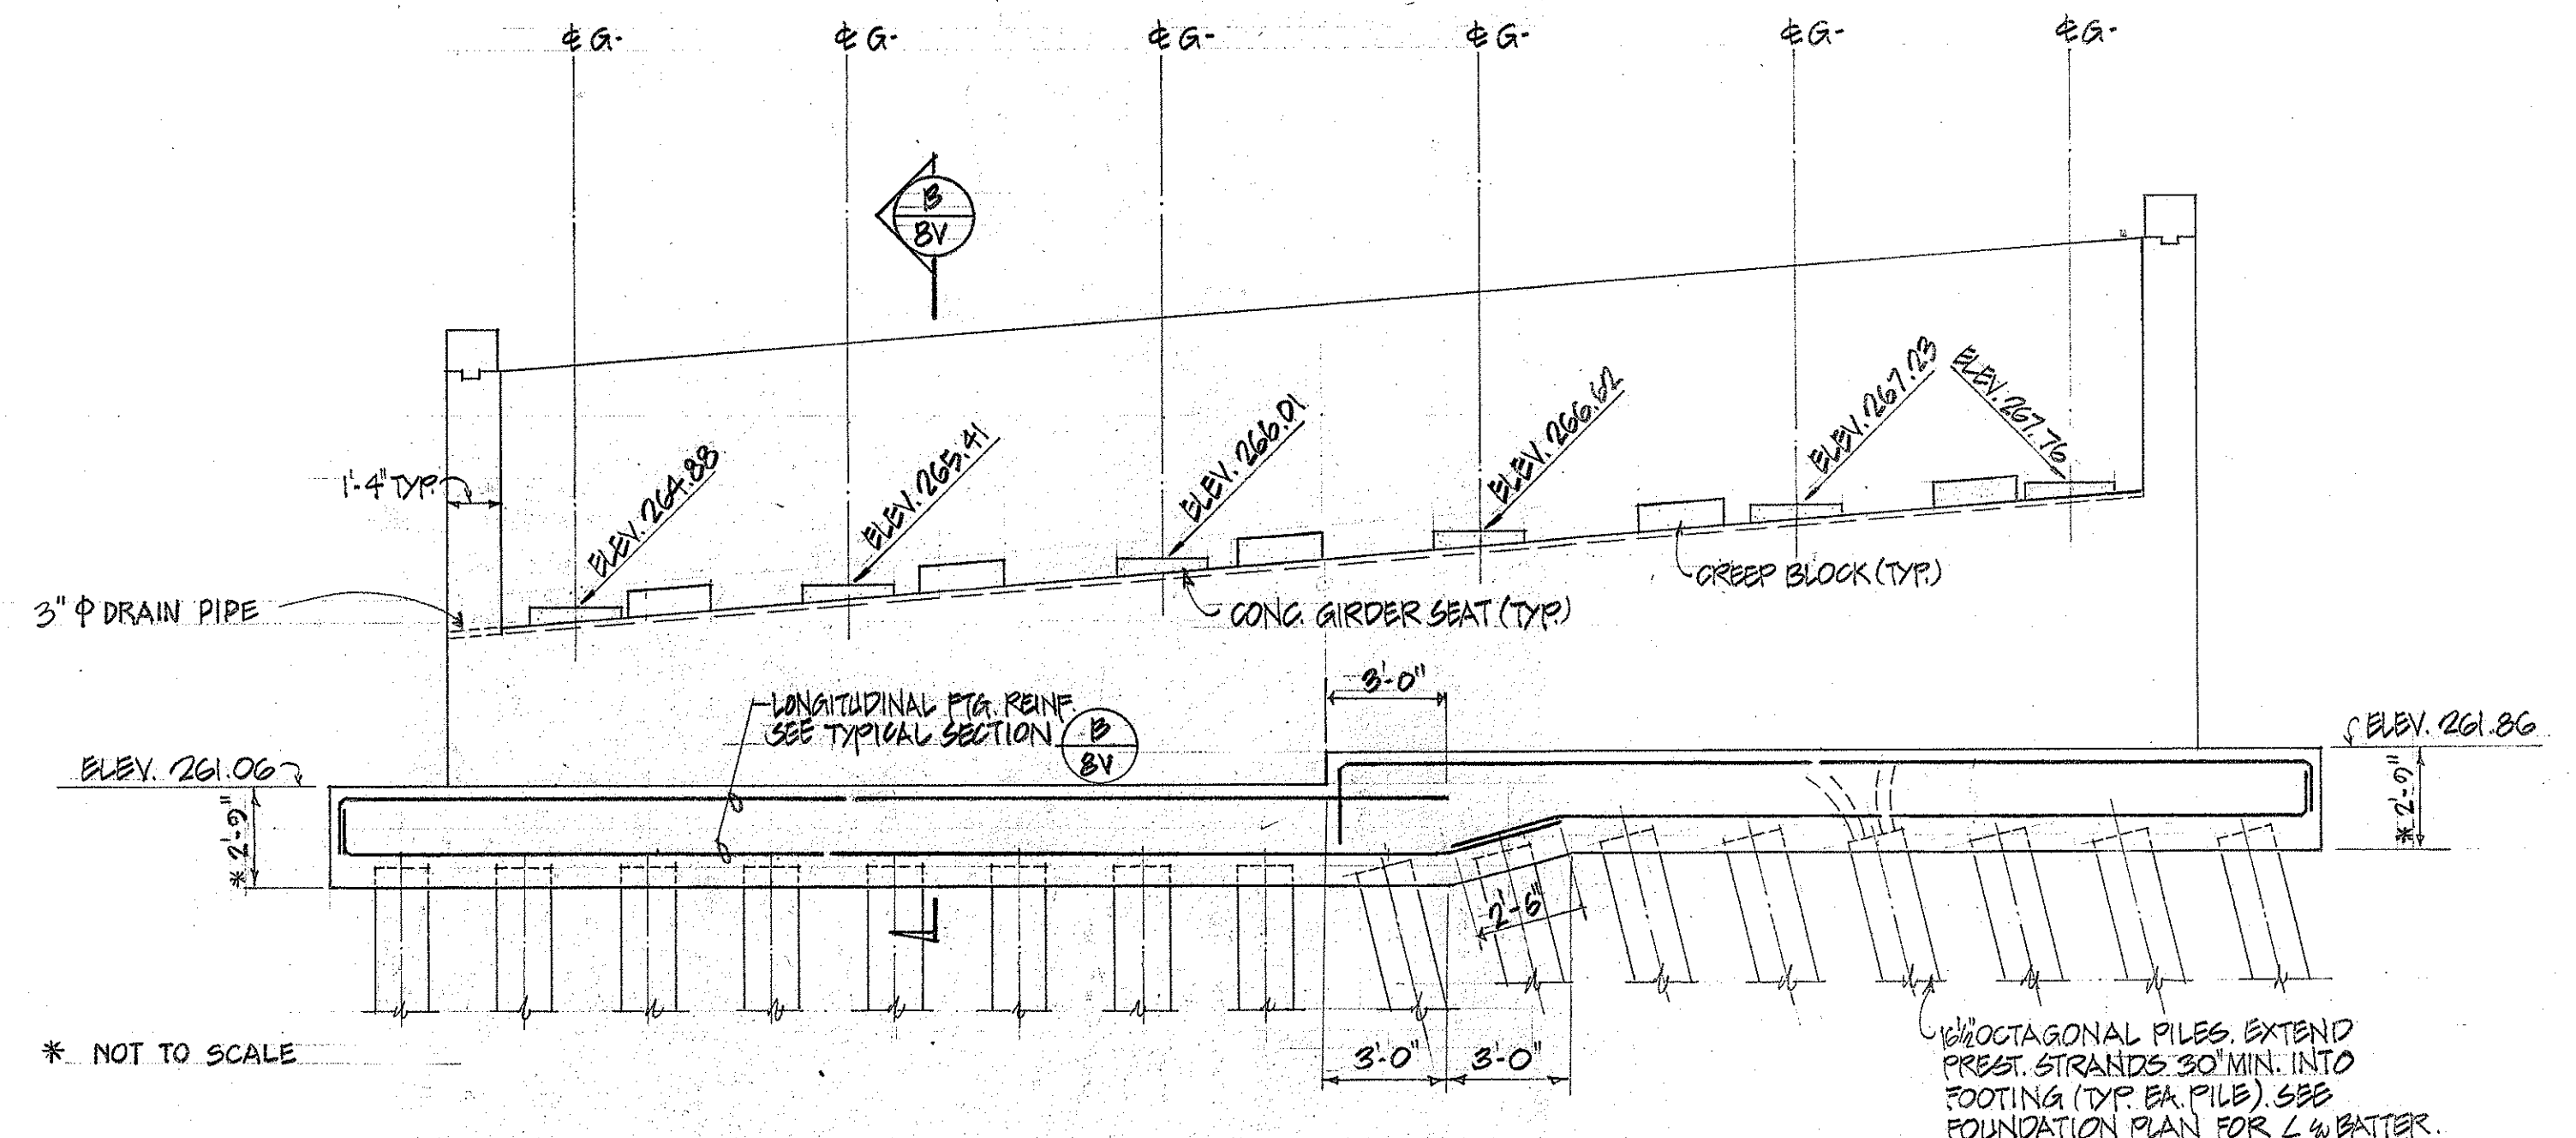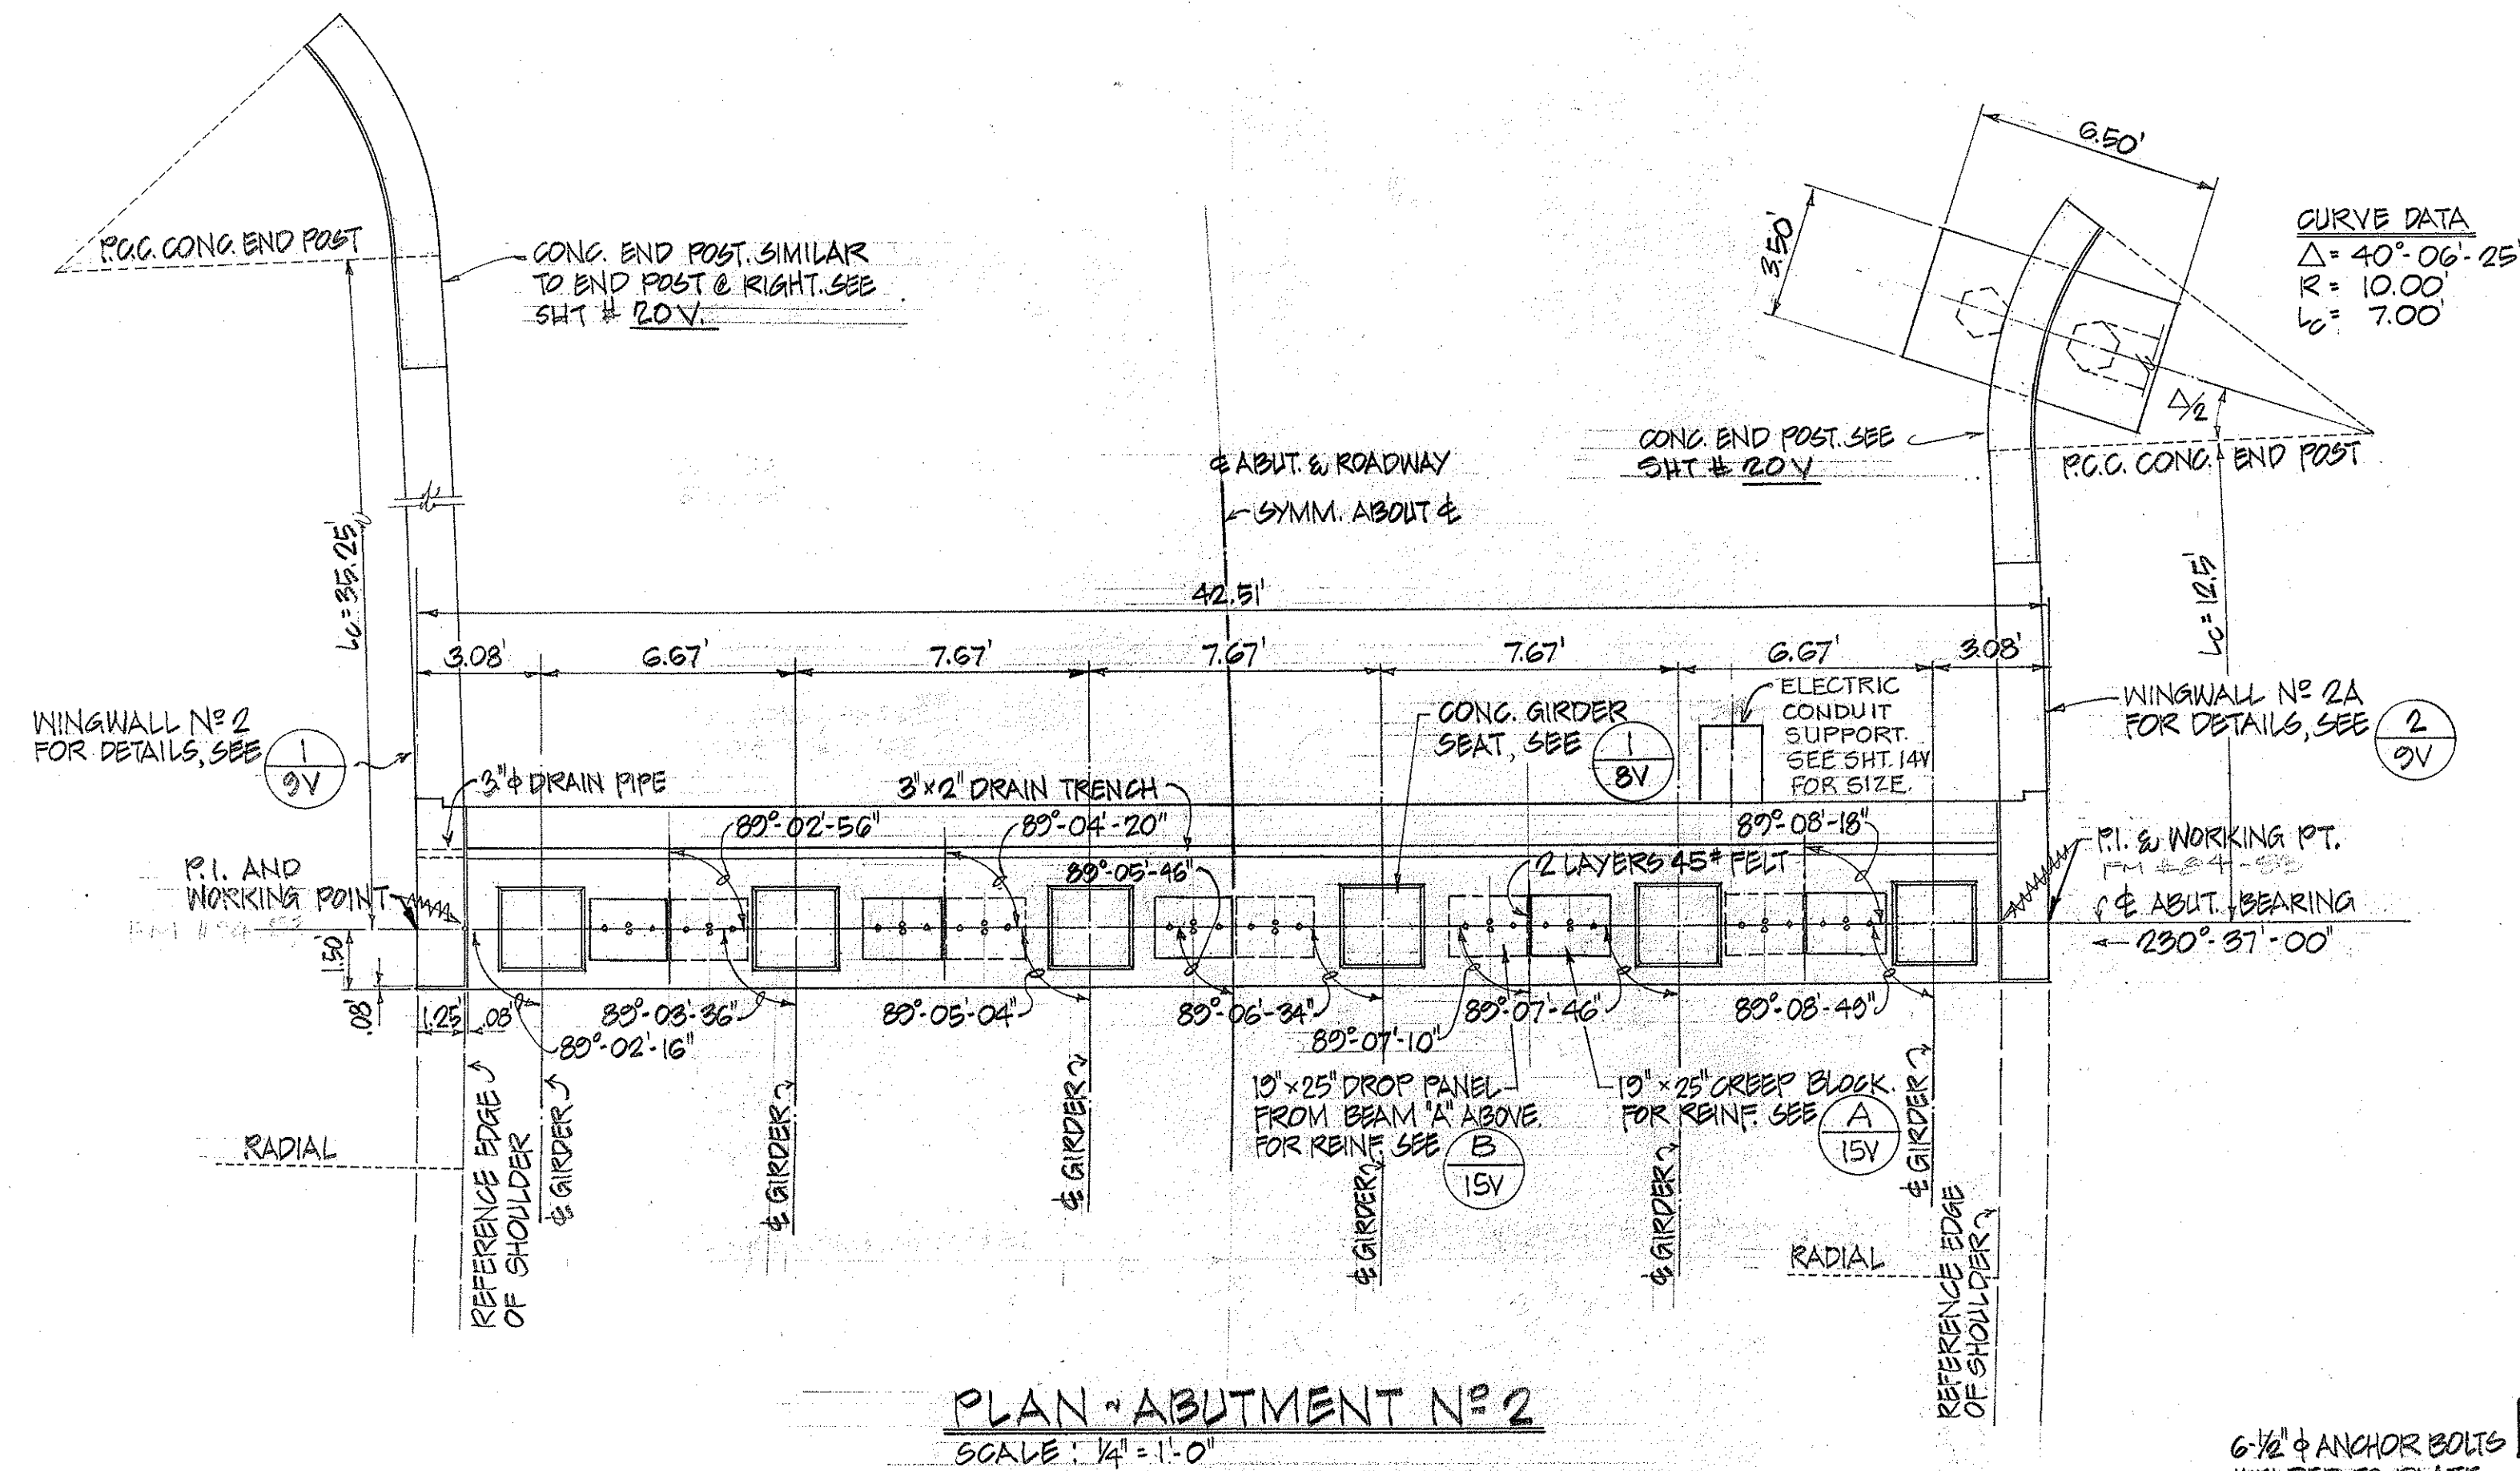

STATE OF HAWAII
DEPARTMENT OF TRANSPORTATION
HIGHWAYS DIVISION


PLAN & DETAILS - ABUTMENT NO 2
BRIDGE NO 3

HALEKOU INTERCHANGE
F.A.I. Proj. No. I-H3-1(24):11


Scale: As Noted Date: SEPT. 1982
SHEET No. 8V OF 20 SHEETS

DATE	_____
SURVEY PLOTTED BY	_____
DRAWN BY	_____
DESIGNED BY	_____
NOTED BY	_____
CHECKED BY	_____
ORIGINAL PLAN	_____
NOTE BOOK	_____
NO.	_____

FED. ROAD DIST. NO.	STATE	FED. AID PROJ. NO.	FISCAL YEAR	SHEET NO.	TOTAL SHEETS
HAWAII	HAW.	I-H3-1(24)-11	1983	210	328

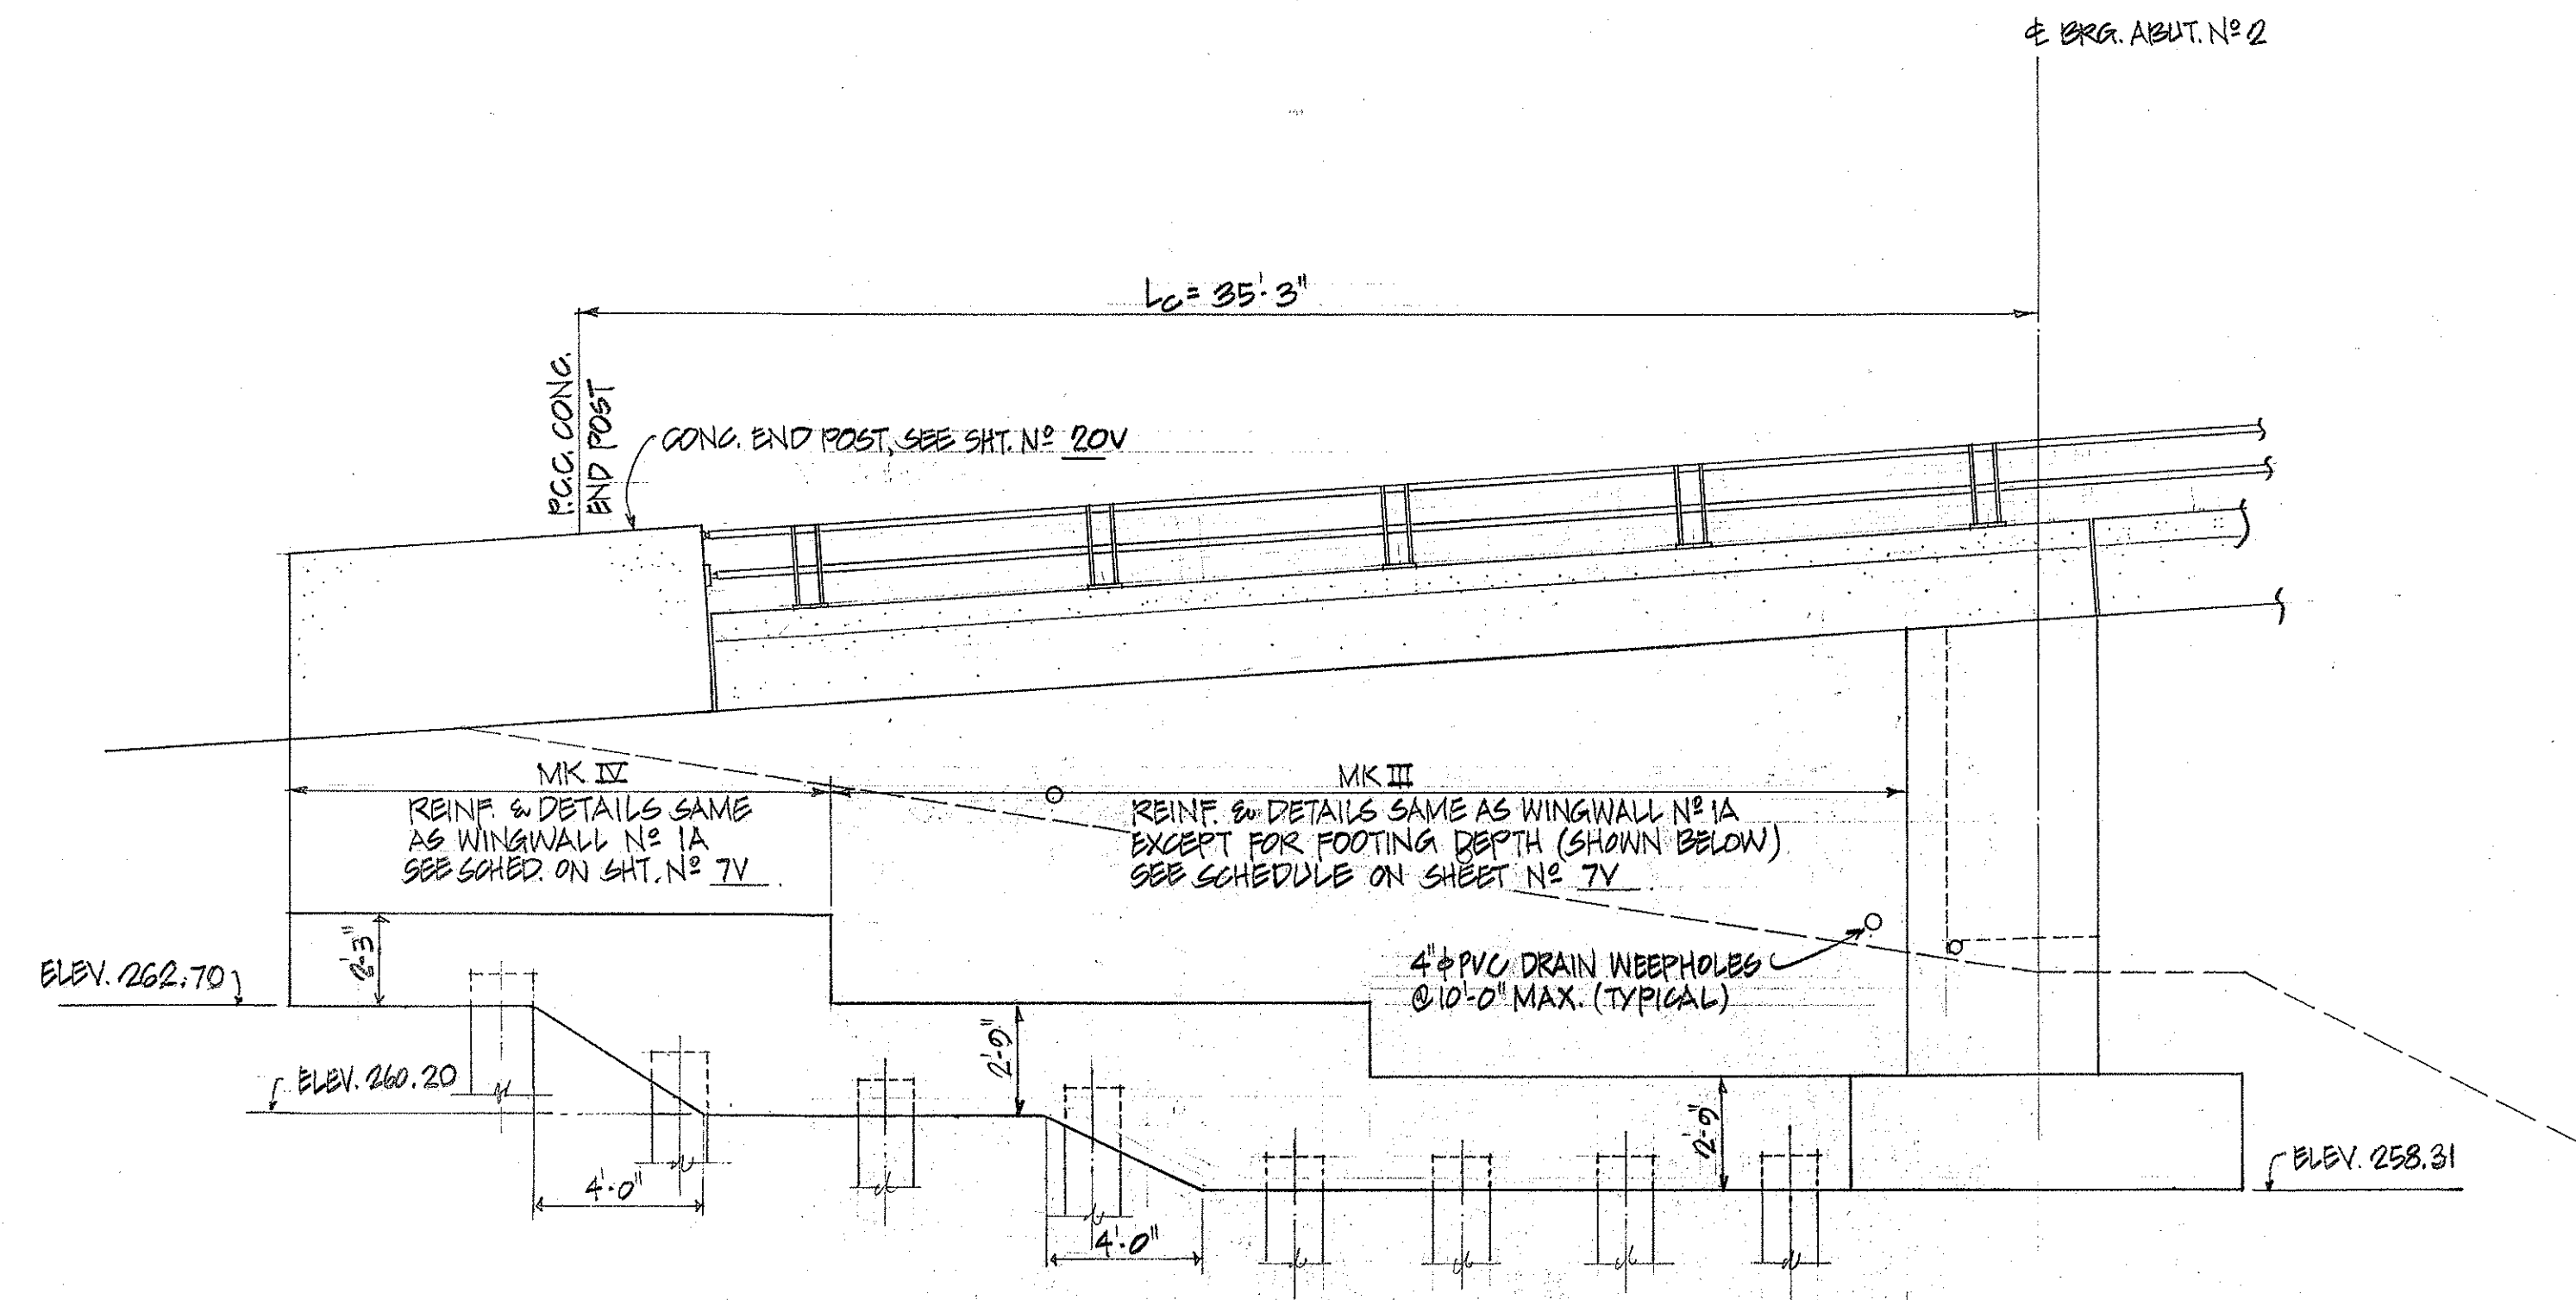


WINGWALL NO 2 ELEVATION - DETAIL 1
SCALE: 1/4" = 1'-0"

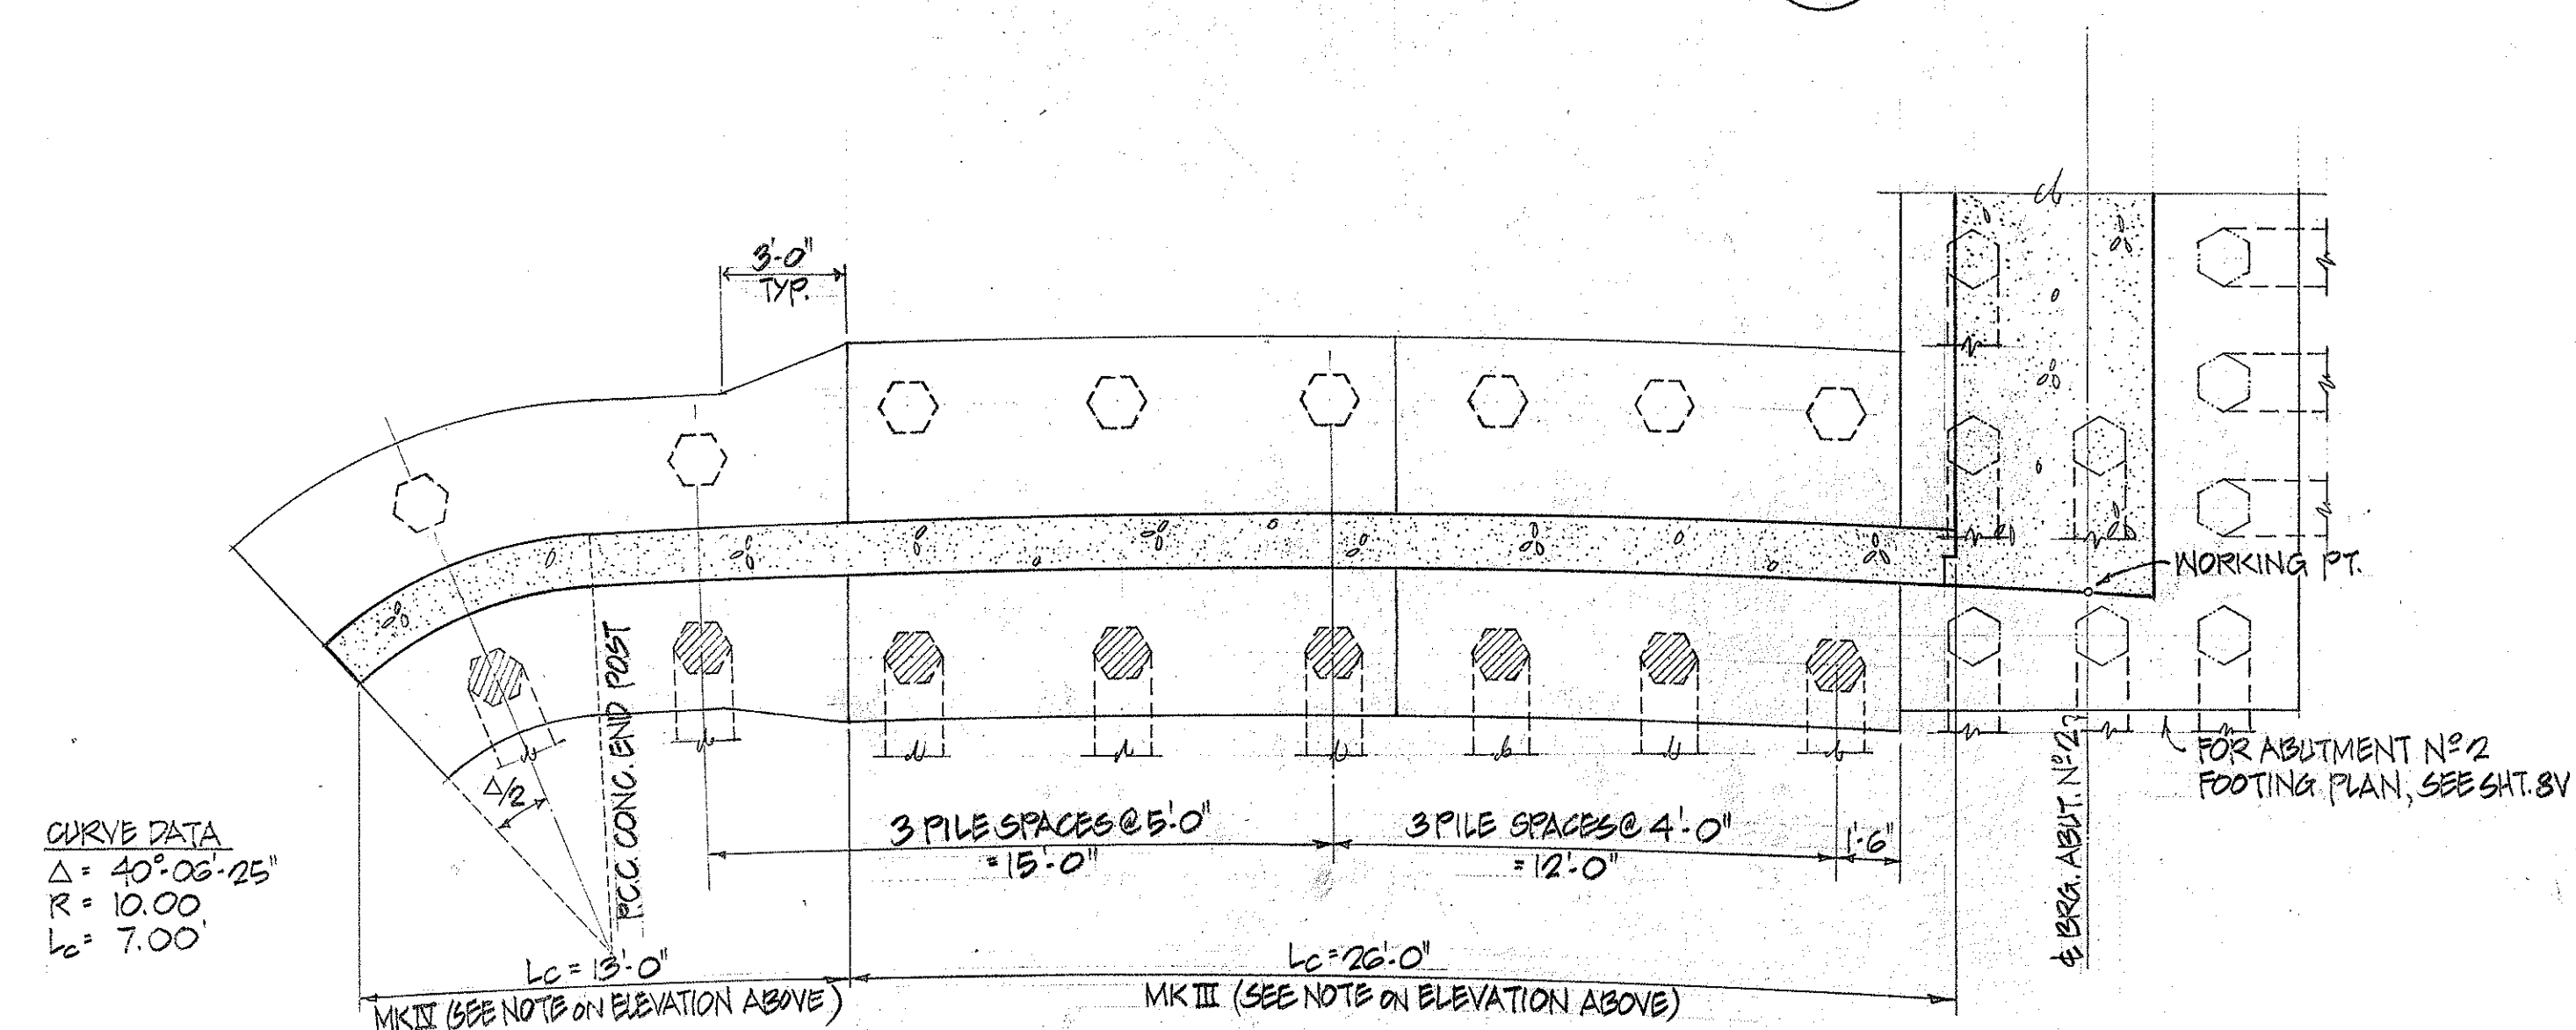


16-16 1/2" OCTAGONAL PILES
(8 VERTICAL & 8 BATTER)
WINGWALL NO 2 FOOTING PLAN
SCALE: 1/4" = 1'-0"

LEGEND:
○ VERTICAL PILE (NO BATTER)
◐ BATTER PILE 3:12

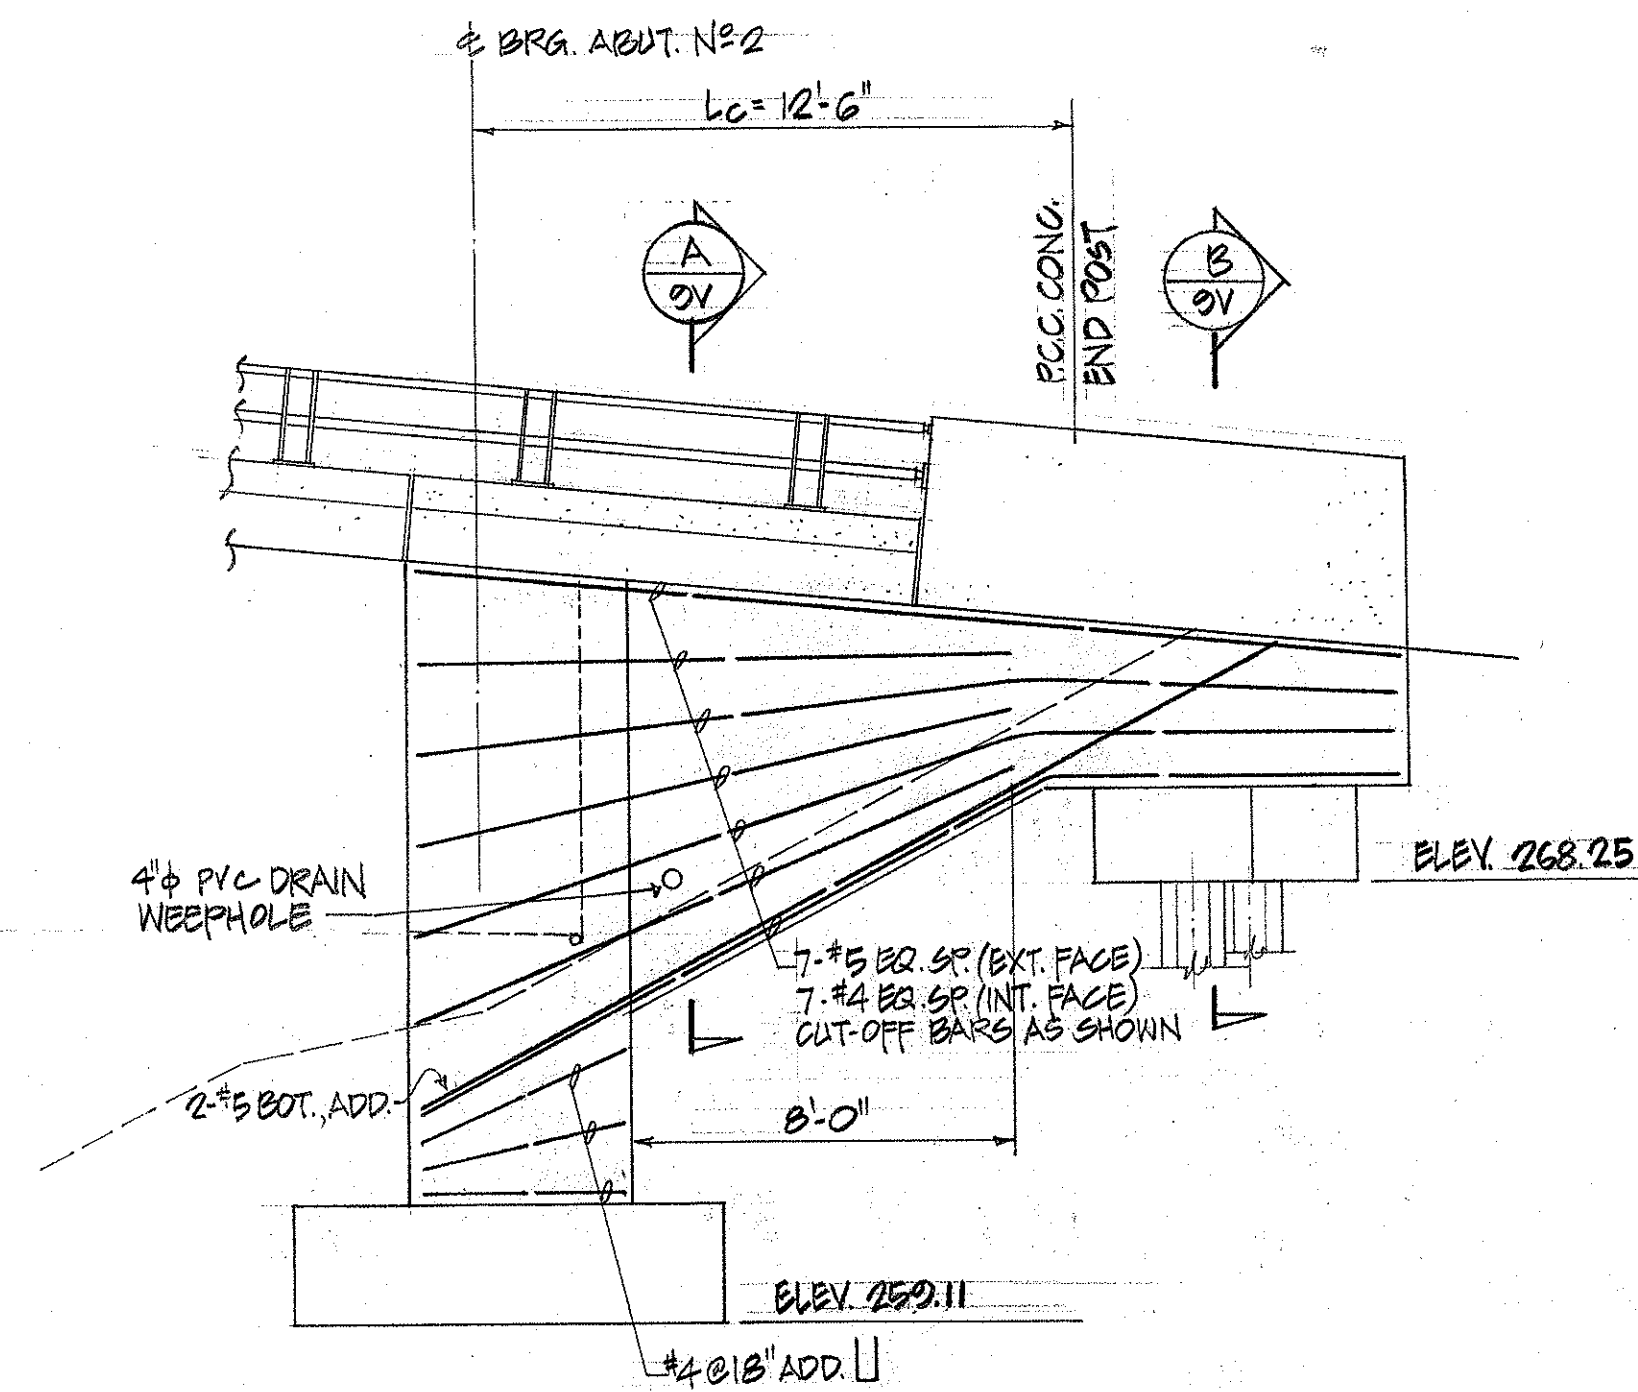

WINGWALL NO 2A ELEVATION - DETAIL 2
SCALE: 1/4" = 1'-0"

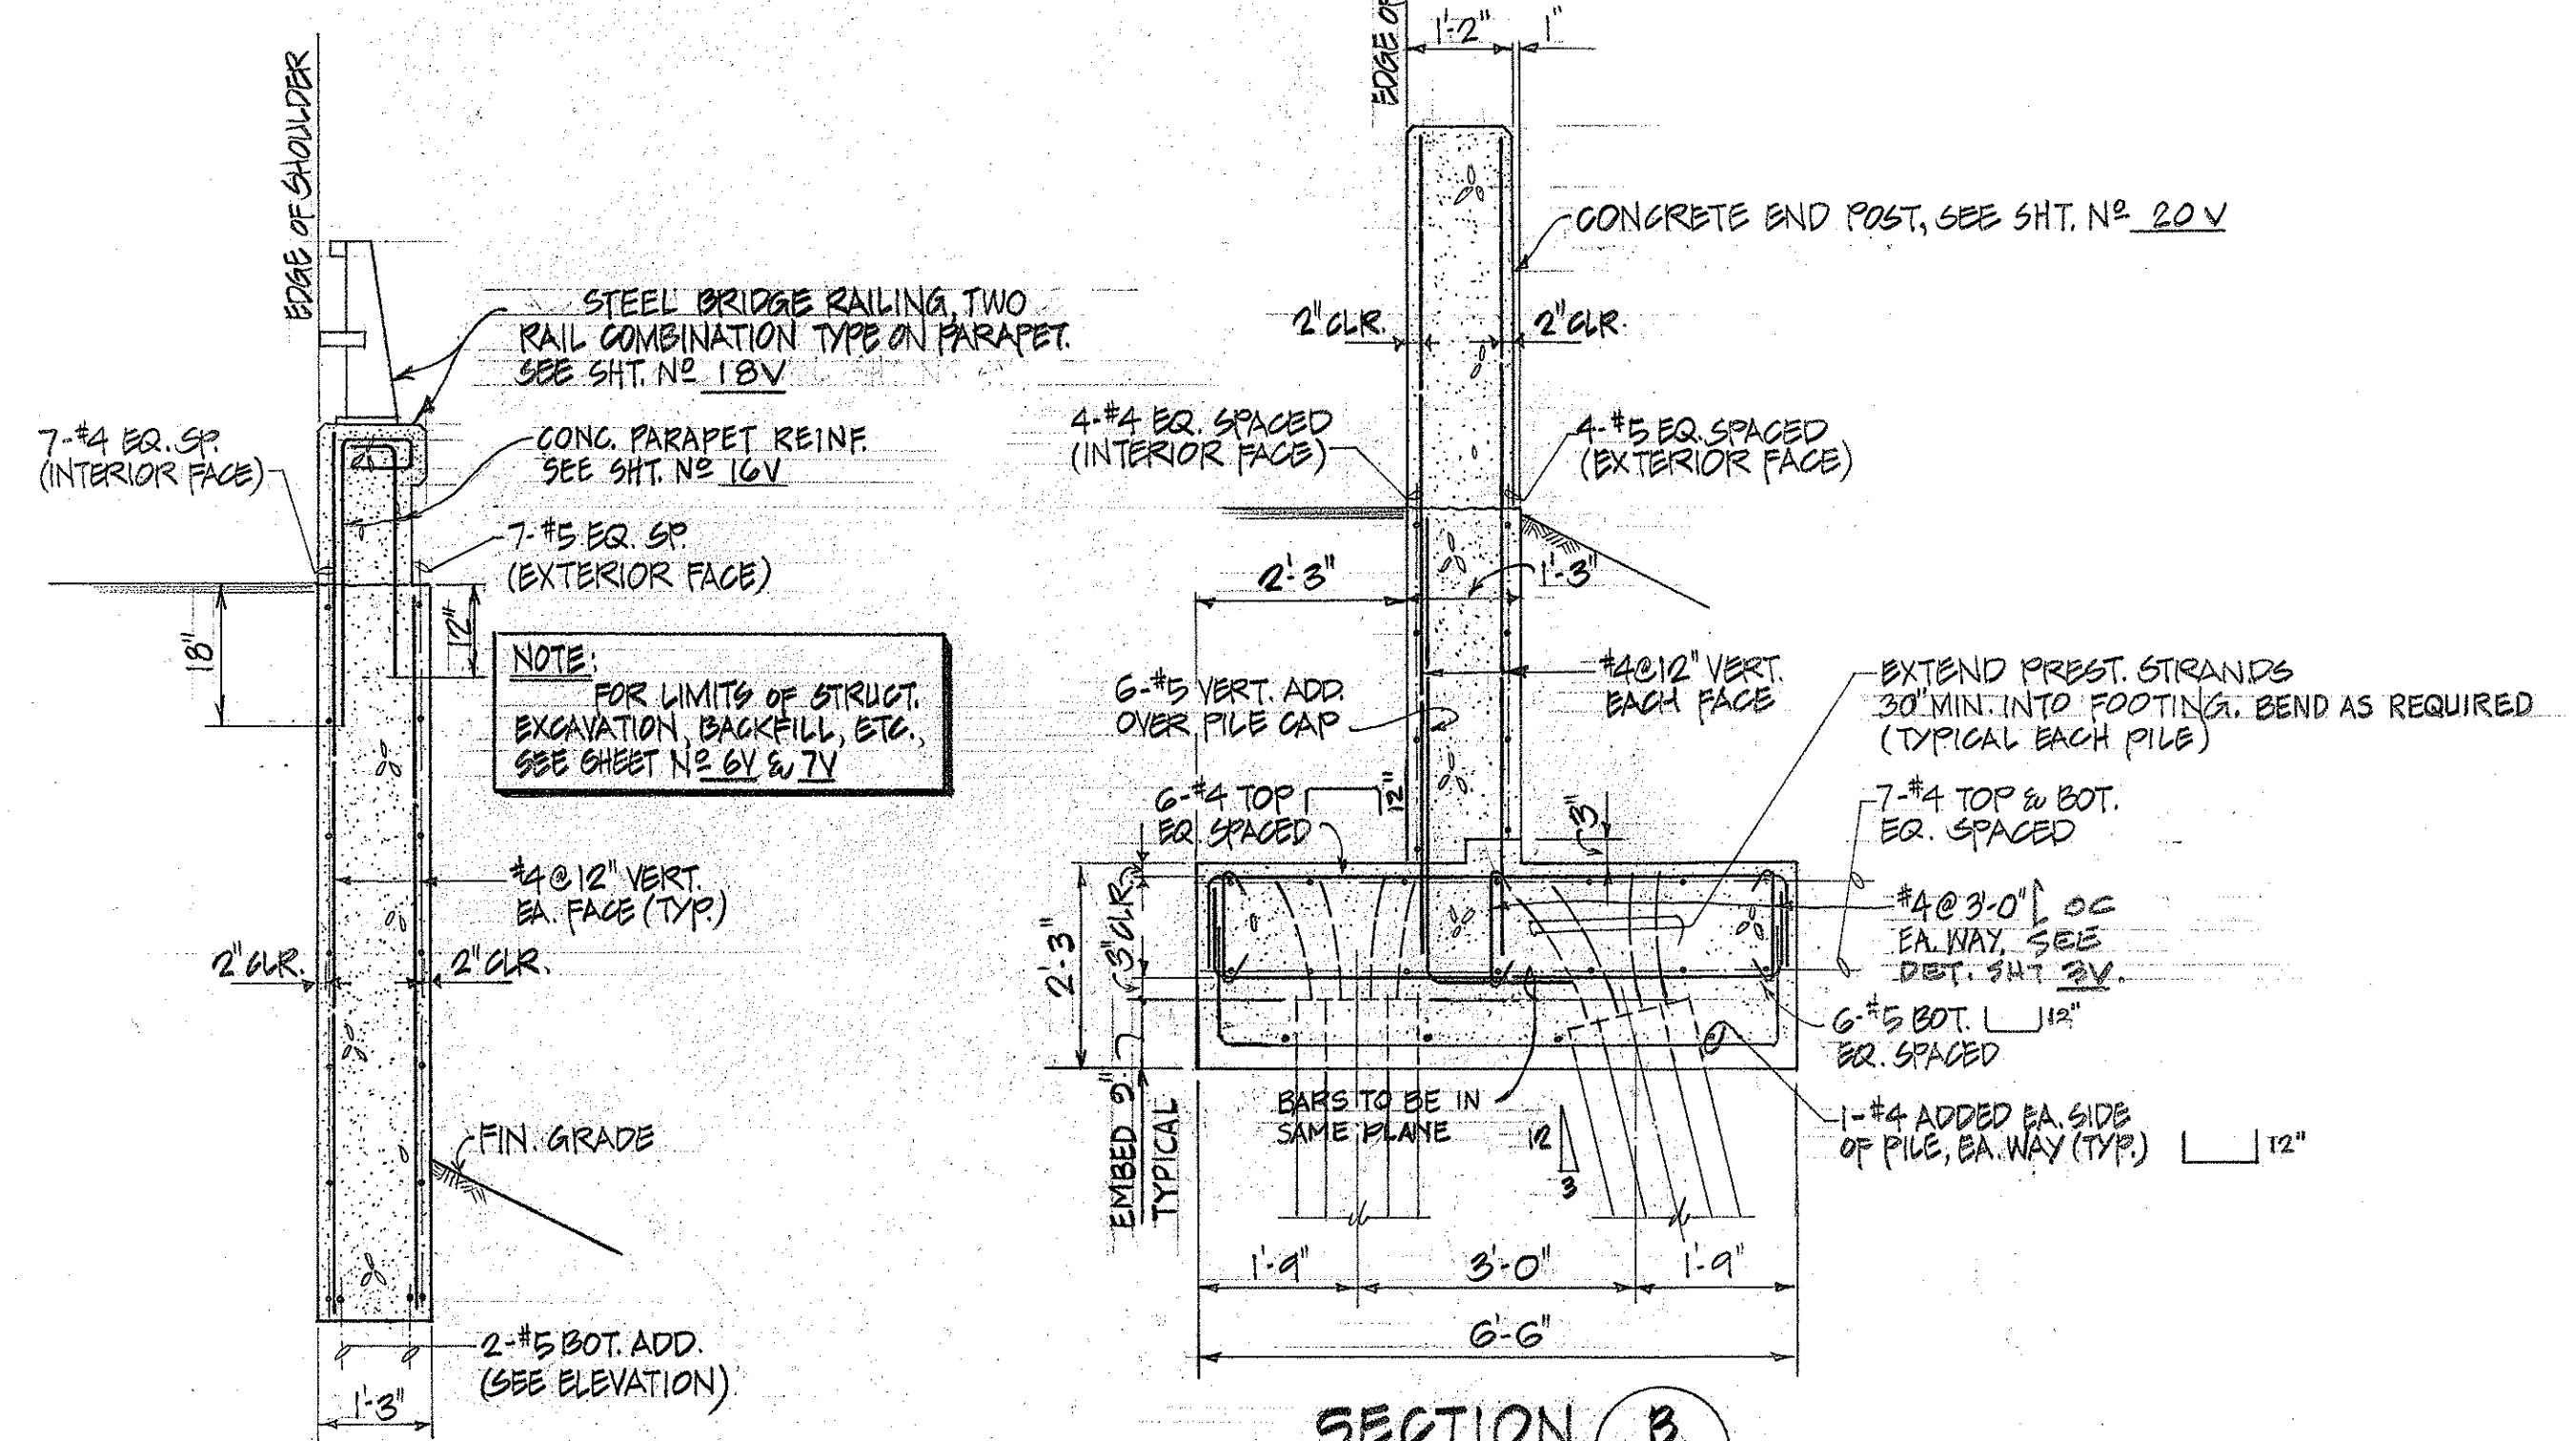

SECTION B
SCALE: 1/2" = 1'-0"

SECTION A
SCALE: 1/2" = 1'-0"

STATE OF HAWAII
DEPARTMENT OF TRANSPORTATION
HIGHWAYS DIVISION


WINGWALL NO 2 & 2A DETAILS
BRIDGE NO 3

HALEKOU INTERCHANGE
F.A.I. Proj. No. I-H3-1(24)-11

Scale: As Noted Date: SEPT. 1982

SHEET NO. 210 OF 20 SHEETS

FED. ROAD DIST. NO.	STATE	FED. AID PROJ. NO.	FISCAL YEAR	SHEET NO.	TOTAL SHEETS
HAWAII	HAW.	I-H3-1(24):11	1982	211	328

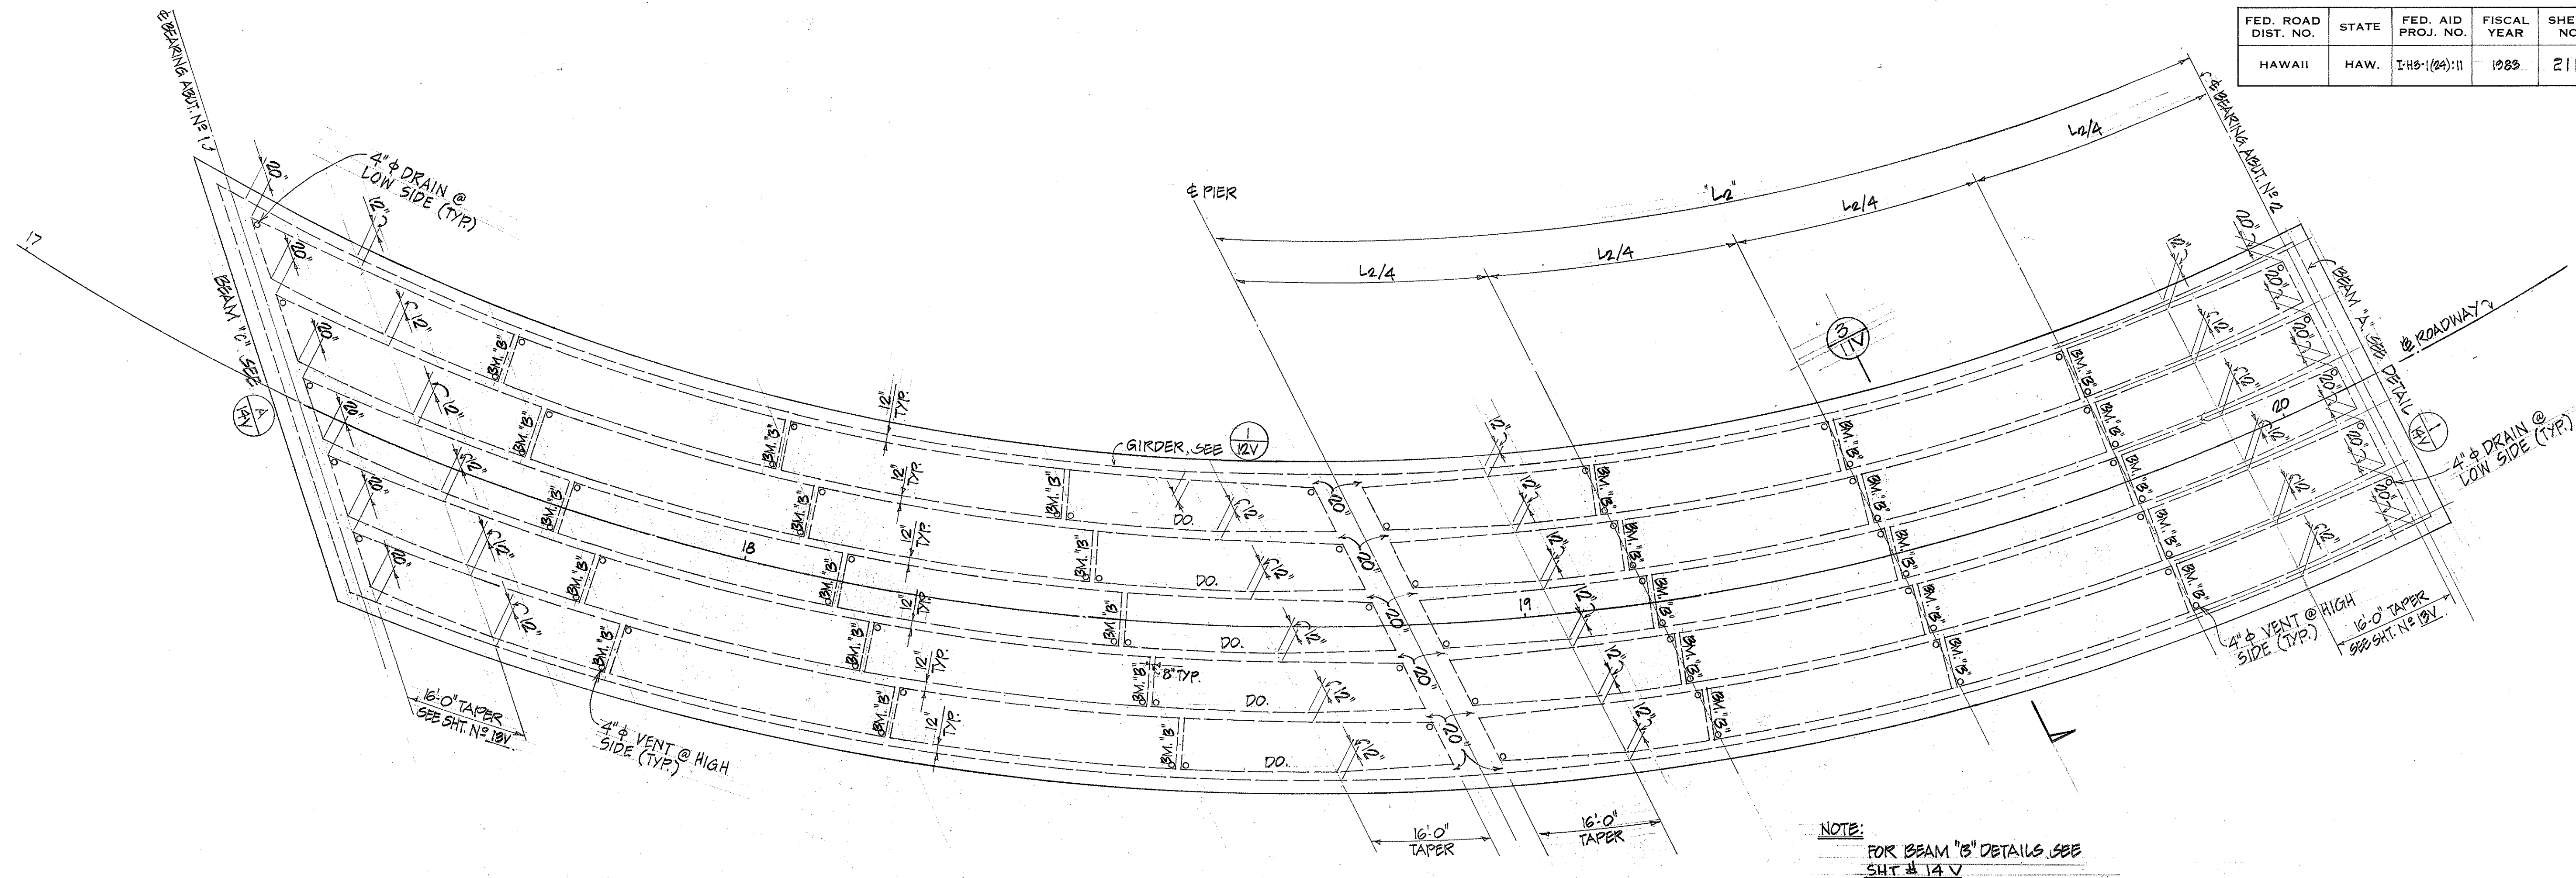

ORIGINAL PLAN	SURVEY PLOTTED BY	DATE
TRACED BY		
DESIGNED BY		
CHECKED BY		
NO.		

STATE OF HAWAII
DEPARTMENT OF TRANSPORTATION
HIGHWAYS DIVISION



FRAMING PLAN
BRIDGE NO. 3

HALEKOU INTERCHANGE
F.A.I. Proj. No. I-H3-1(24):11

Scale: As Noted
Date: SEPT. 1982

SHEET No. 10V OF 20 SHEETS


FED. ROAD DIST. NO.	STATE	FED. AID PROJ. NO.	FISCAL YEAR	SHEET NO.	TOTAL SHEETS
HAWAII	HAW.	I-H3-1(24)-11	1983	212	328

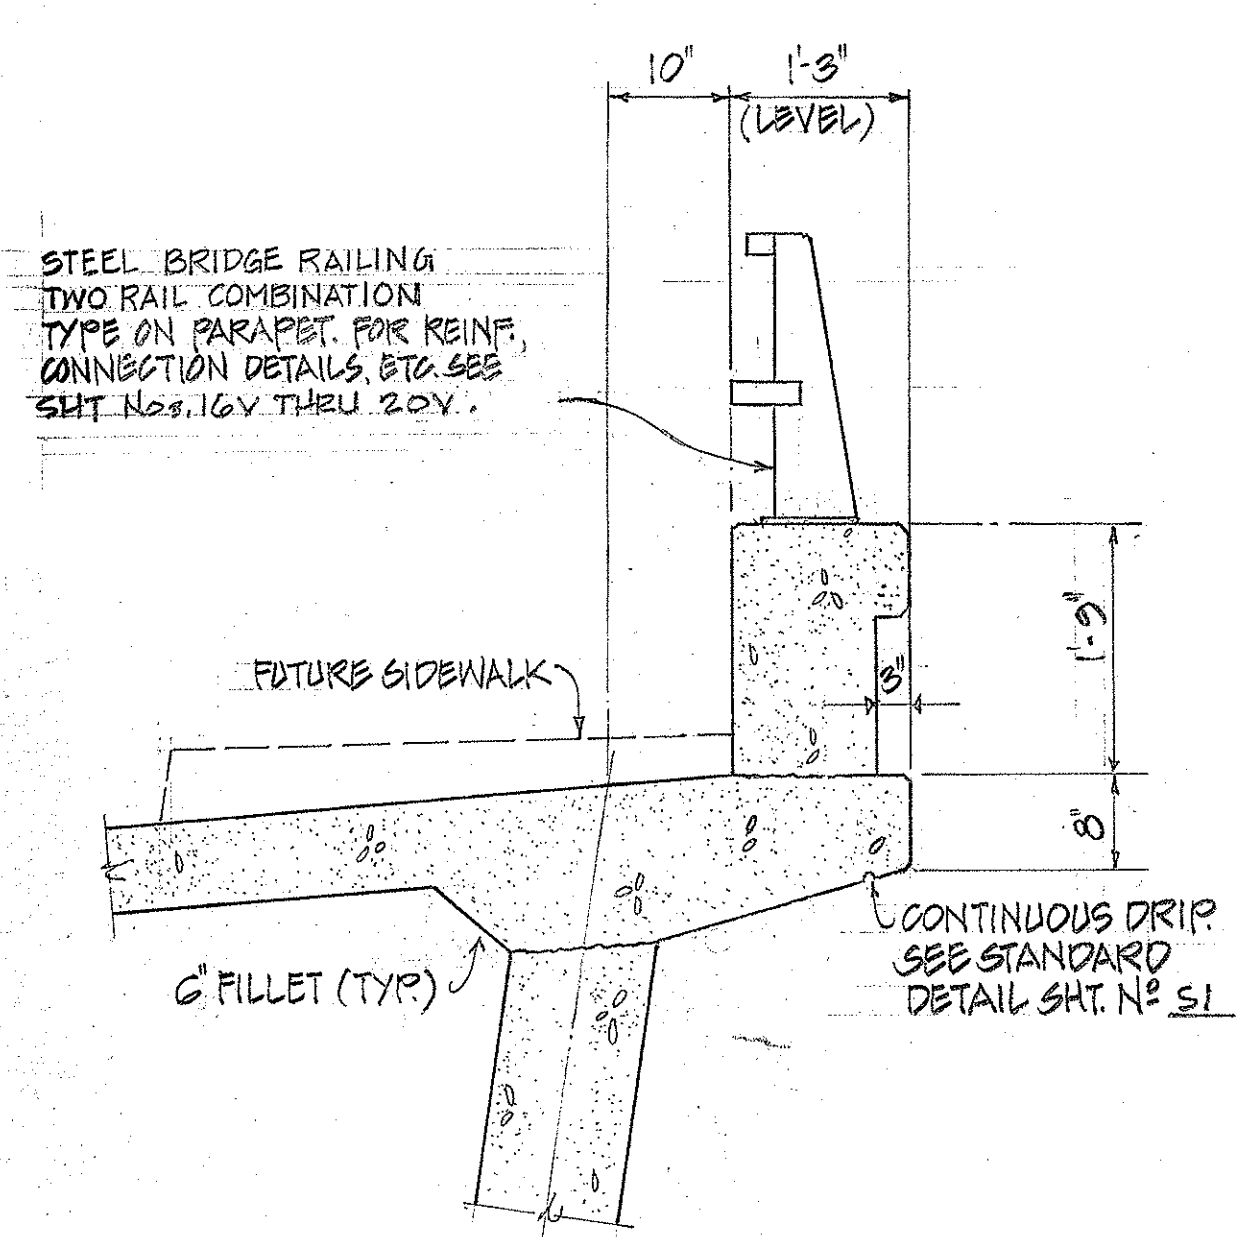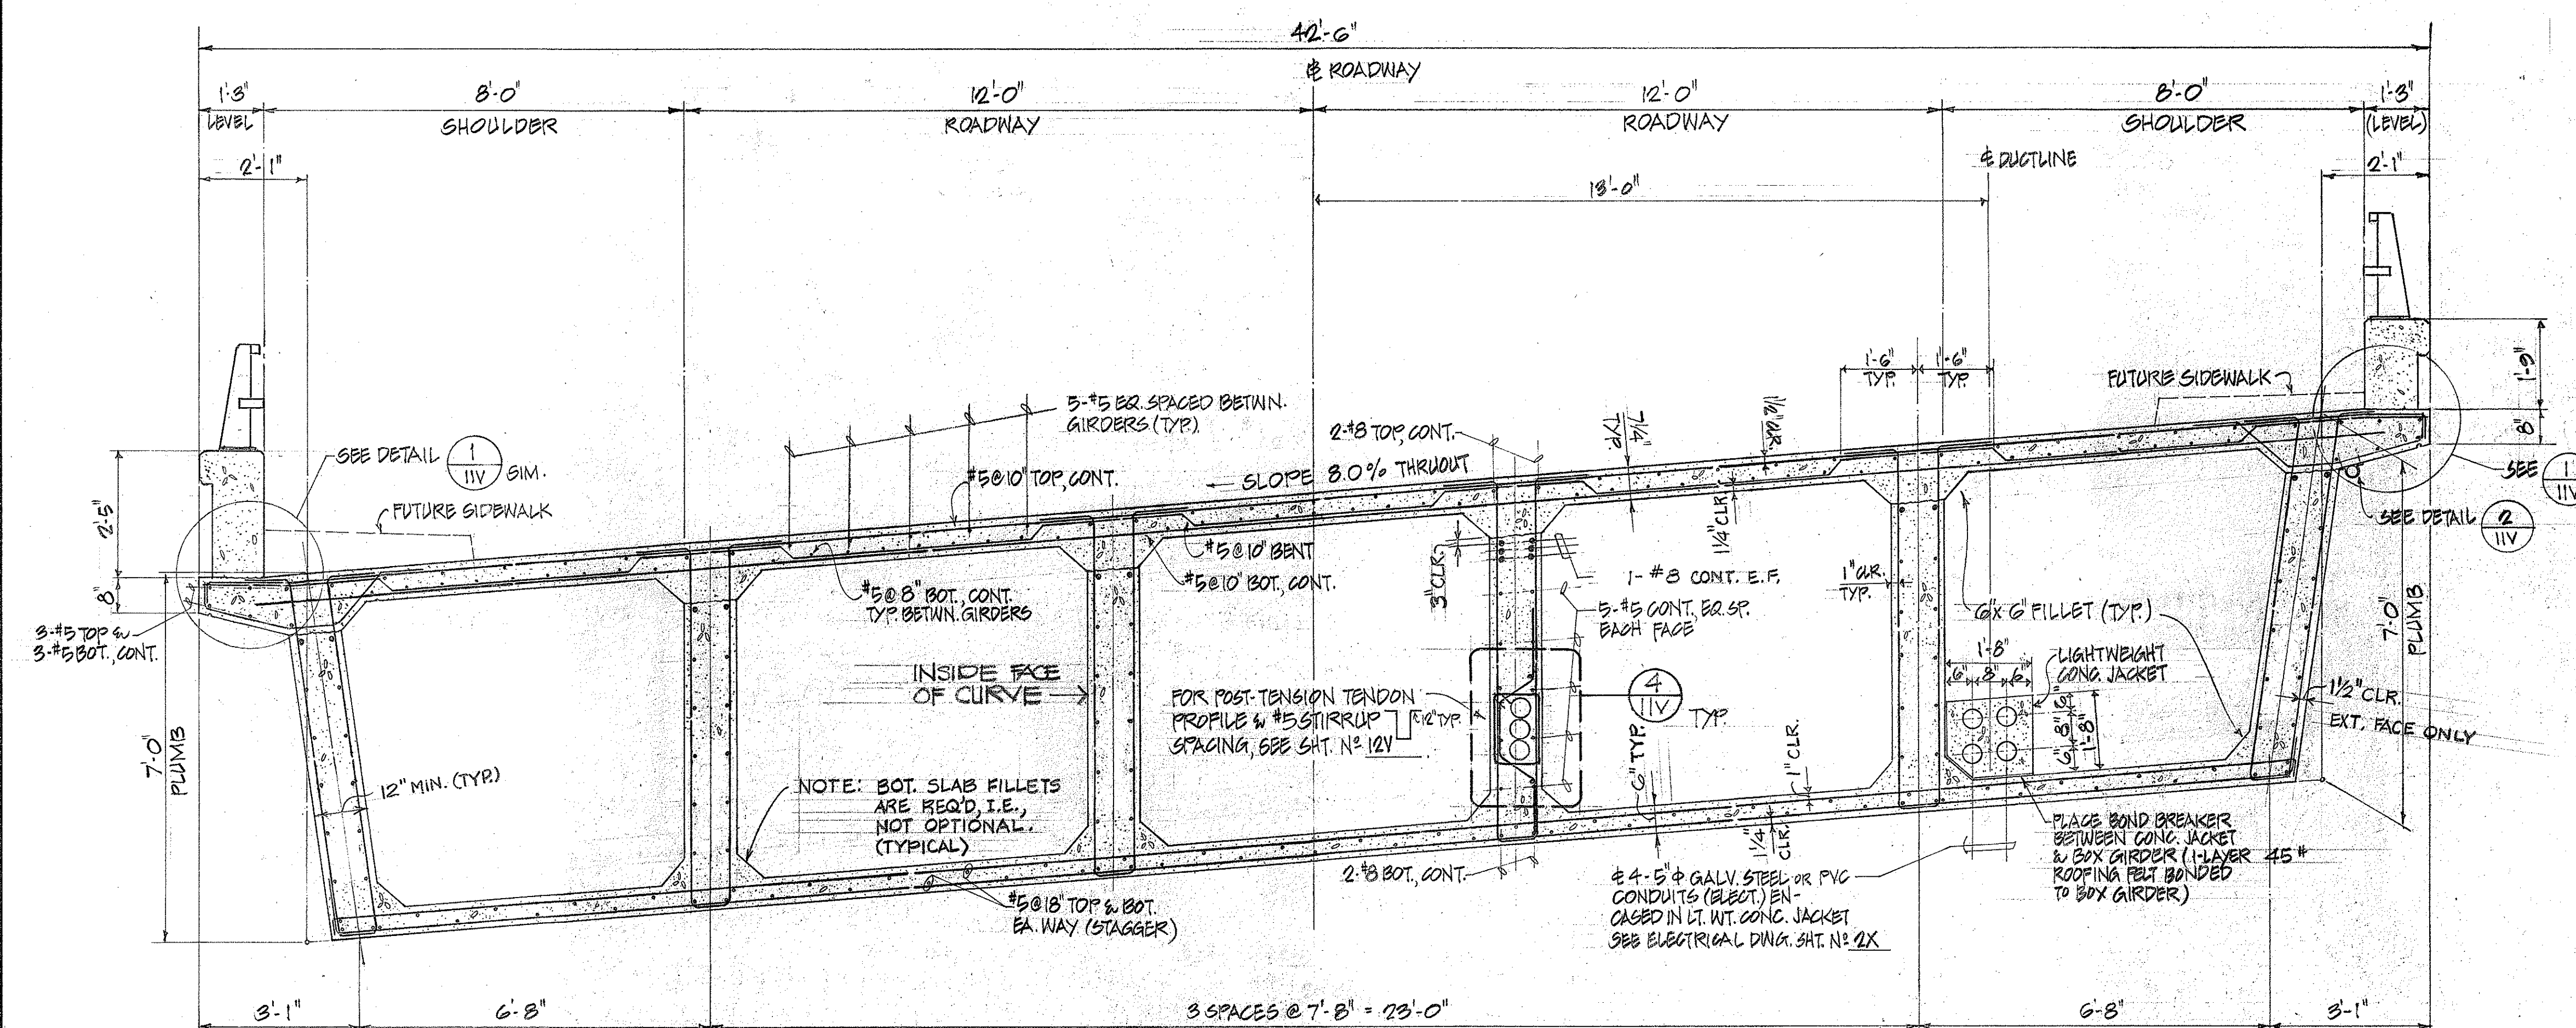


BRIDGE RAIL CURB DETAIL 1
SCALE: 3/4" = 1'-0"

- NOTES:
1. TRANSVERSE REINF. SHALL BE PLACED RADIALLY. SPACINGS SHOWN ARE MAX.
 2. LONGITUDINAL REINF. TO FOLLOW HORIZ. CURVE.
 3. SEE SHT. 12J FOR DET. AT SKEWED ABUT. & PIER (SIMILAR).


NORMAL DECK SECTION 3
SCALE: 1/2" = 1'-0"

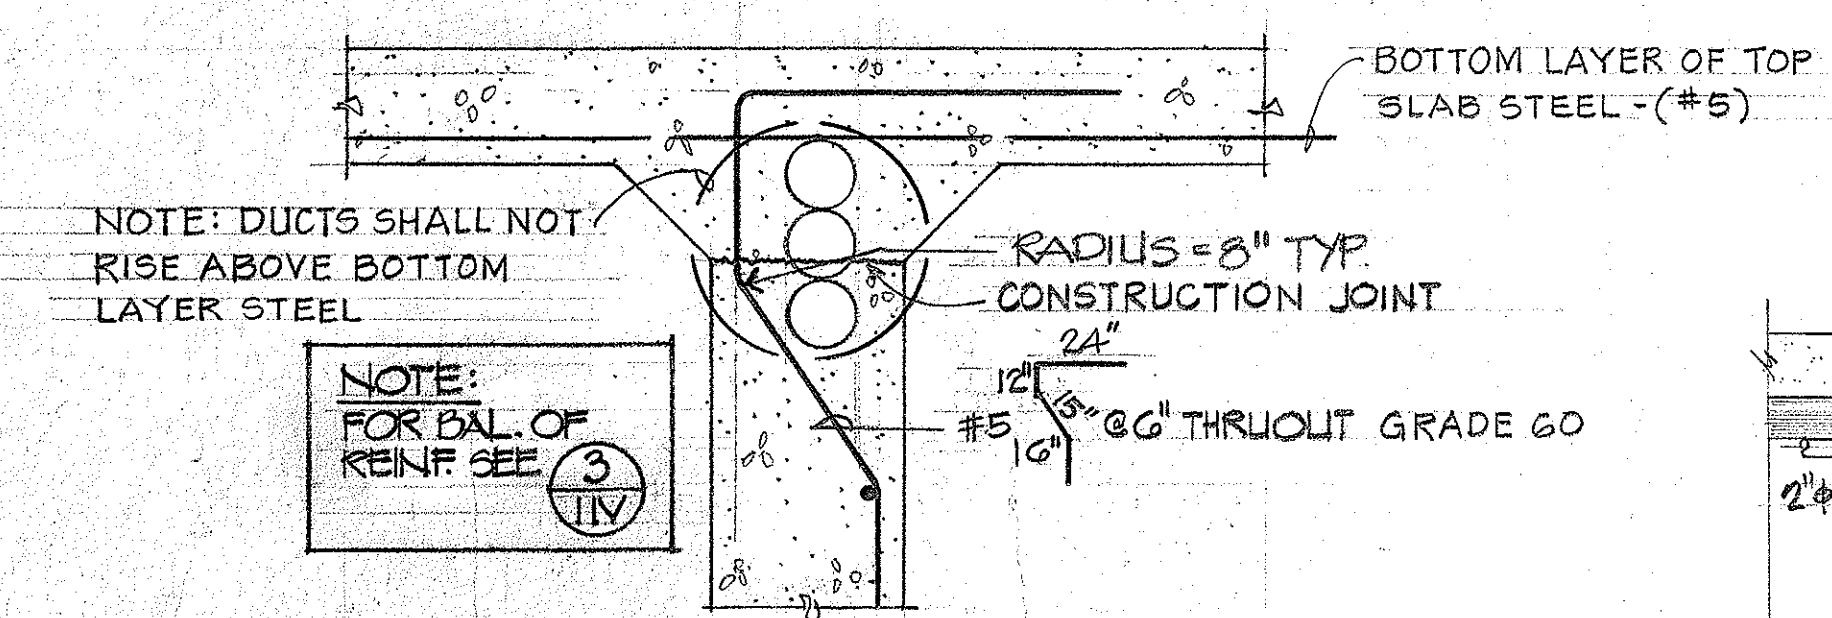


CONDITION AT TOP SLAB
NOT TO SCALE

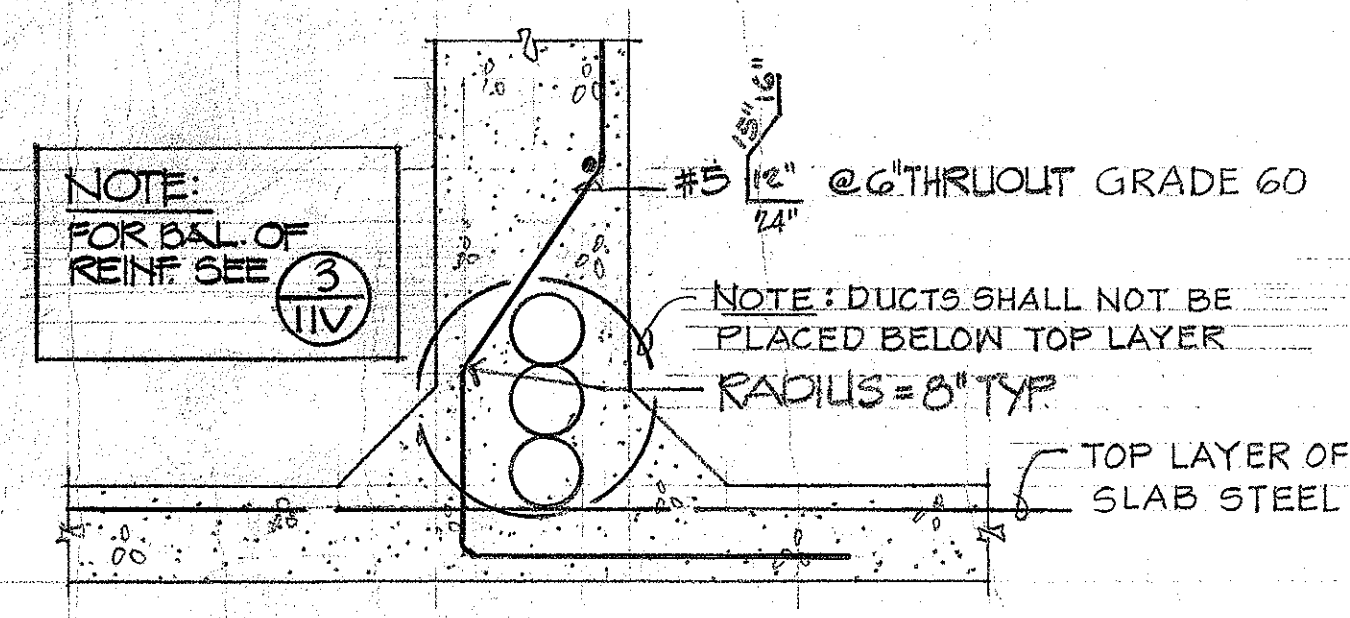


CONDITION AT BOTTOM SLAB
SCALE: 1" = 1'-0"

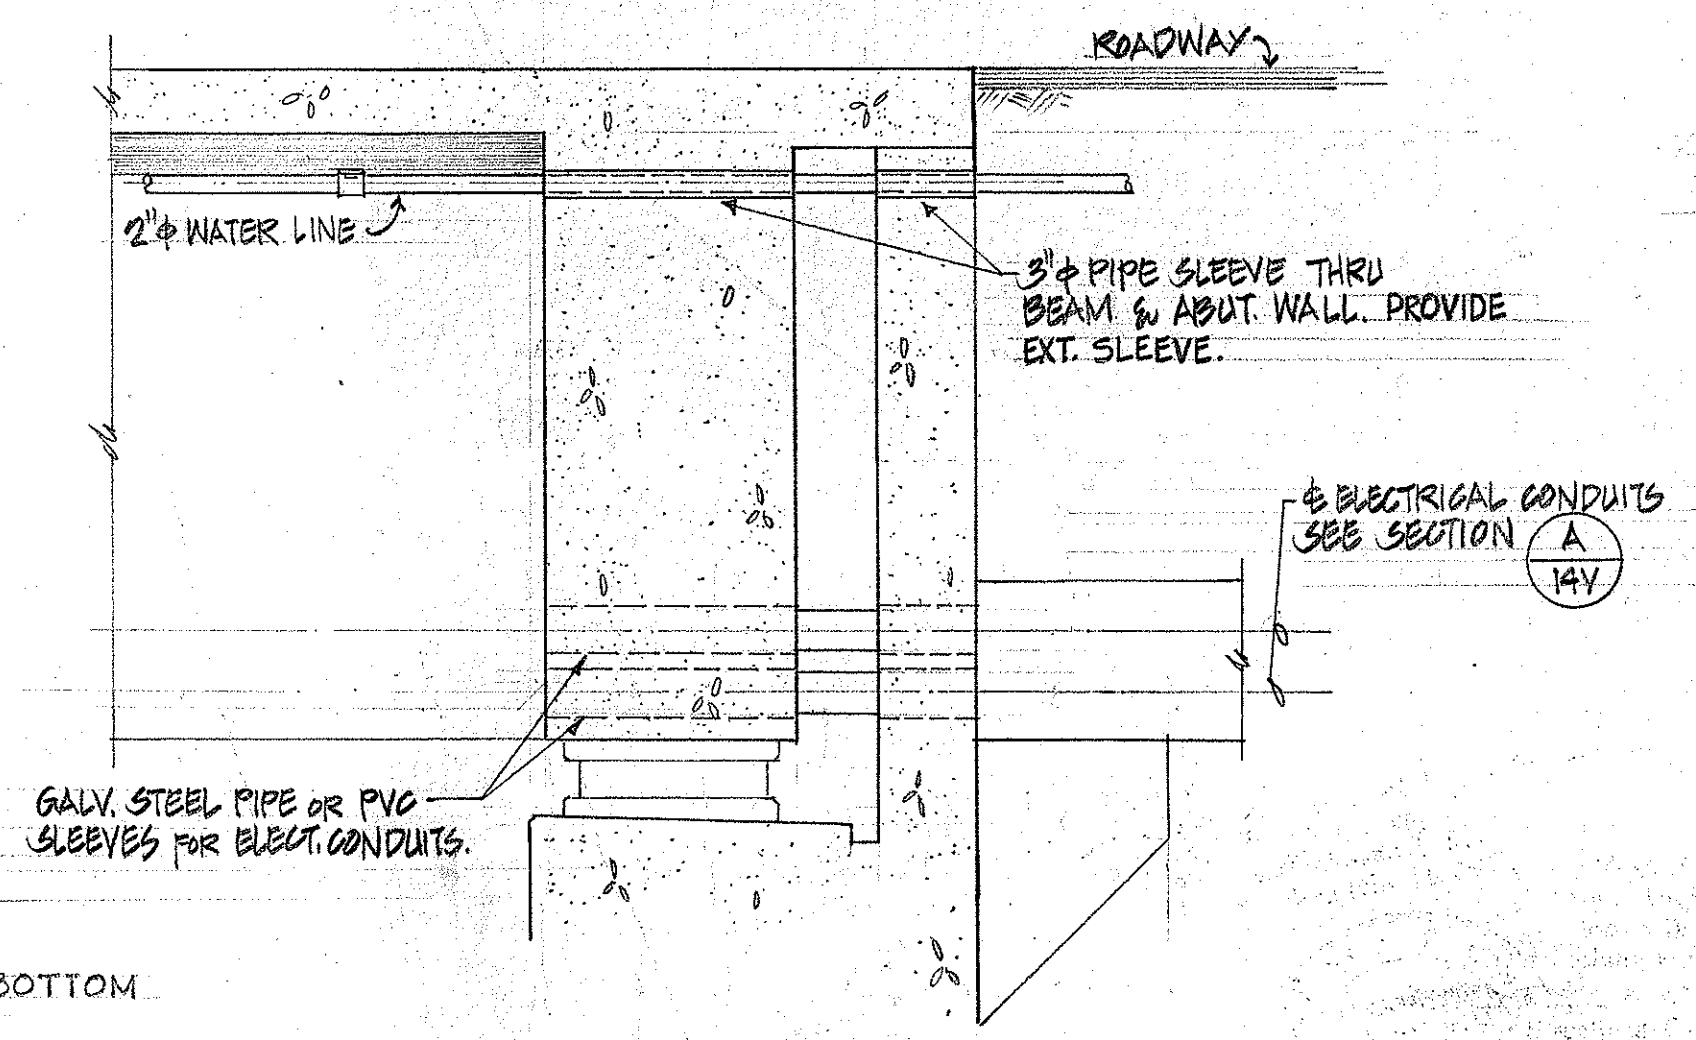

SLEEVE THRU ABUT WALL & DIAPHRAM BEAM
SCALE: 1/2" = 1'-0"

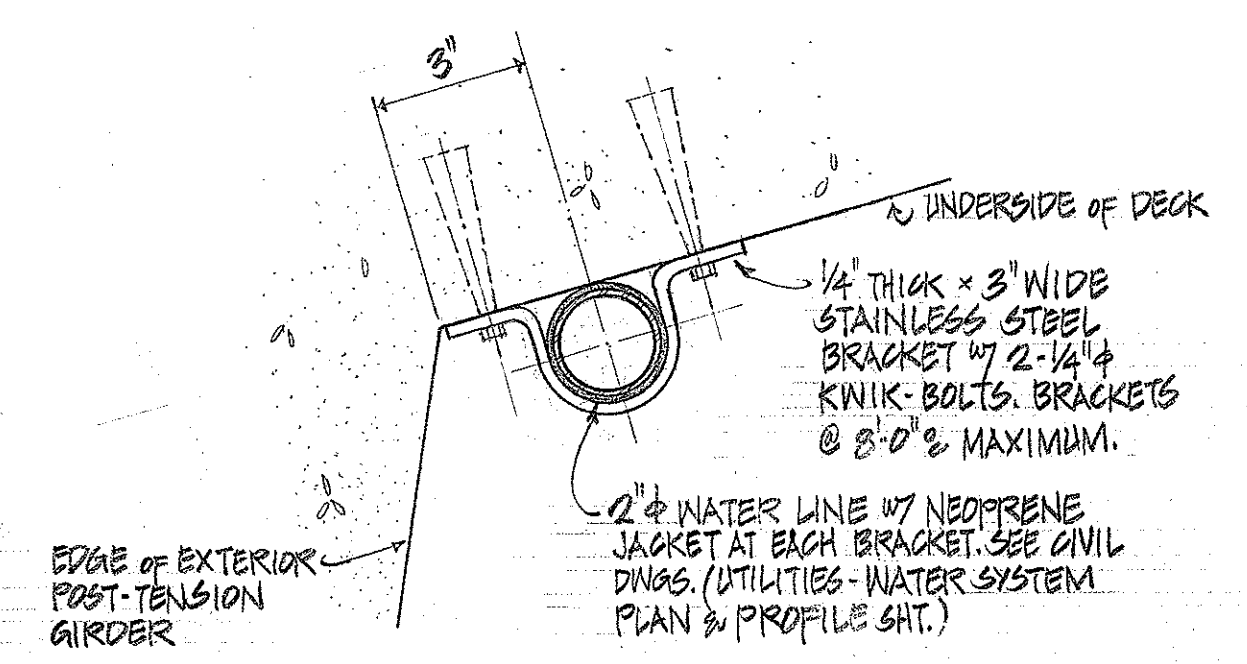

PIPE HANGER DETAIL 2
SCALE: 3" = 1'-0"

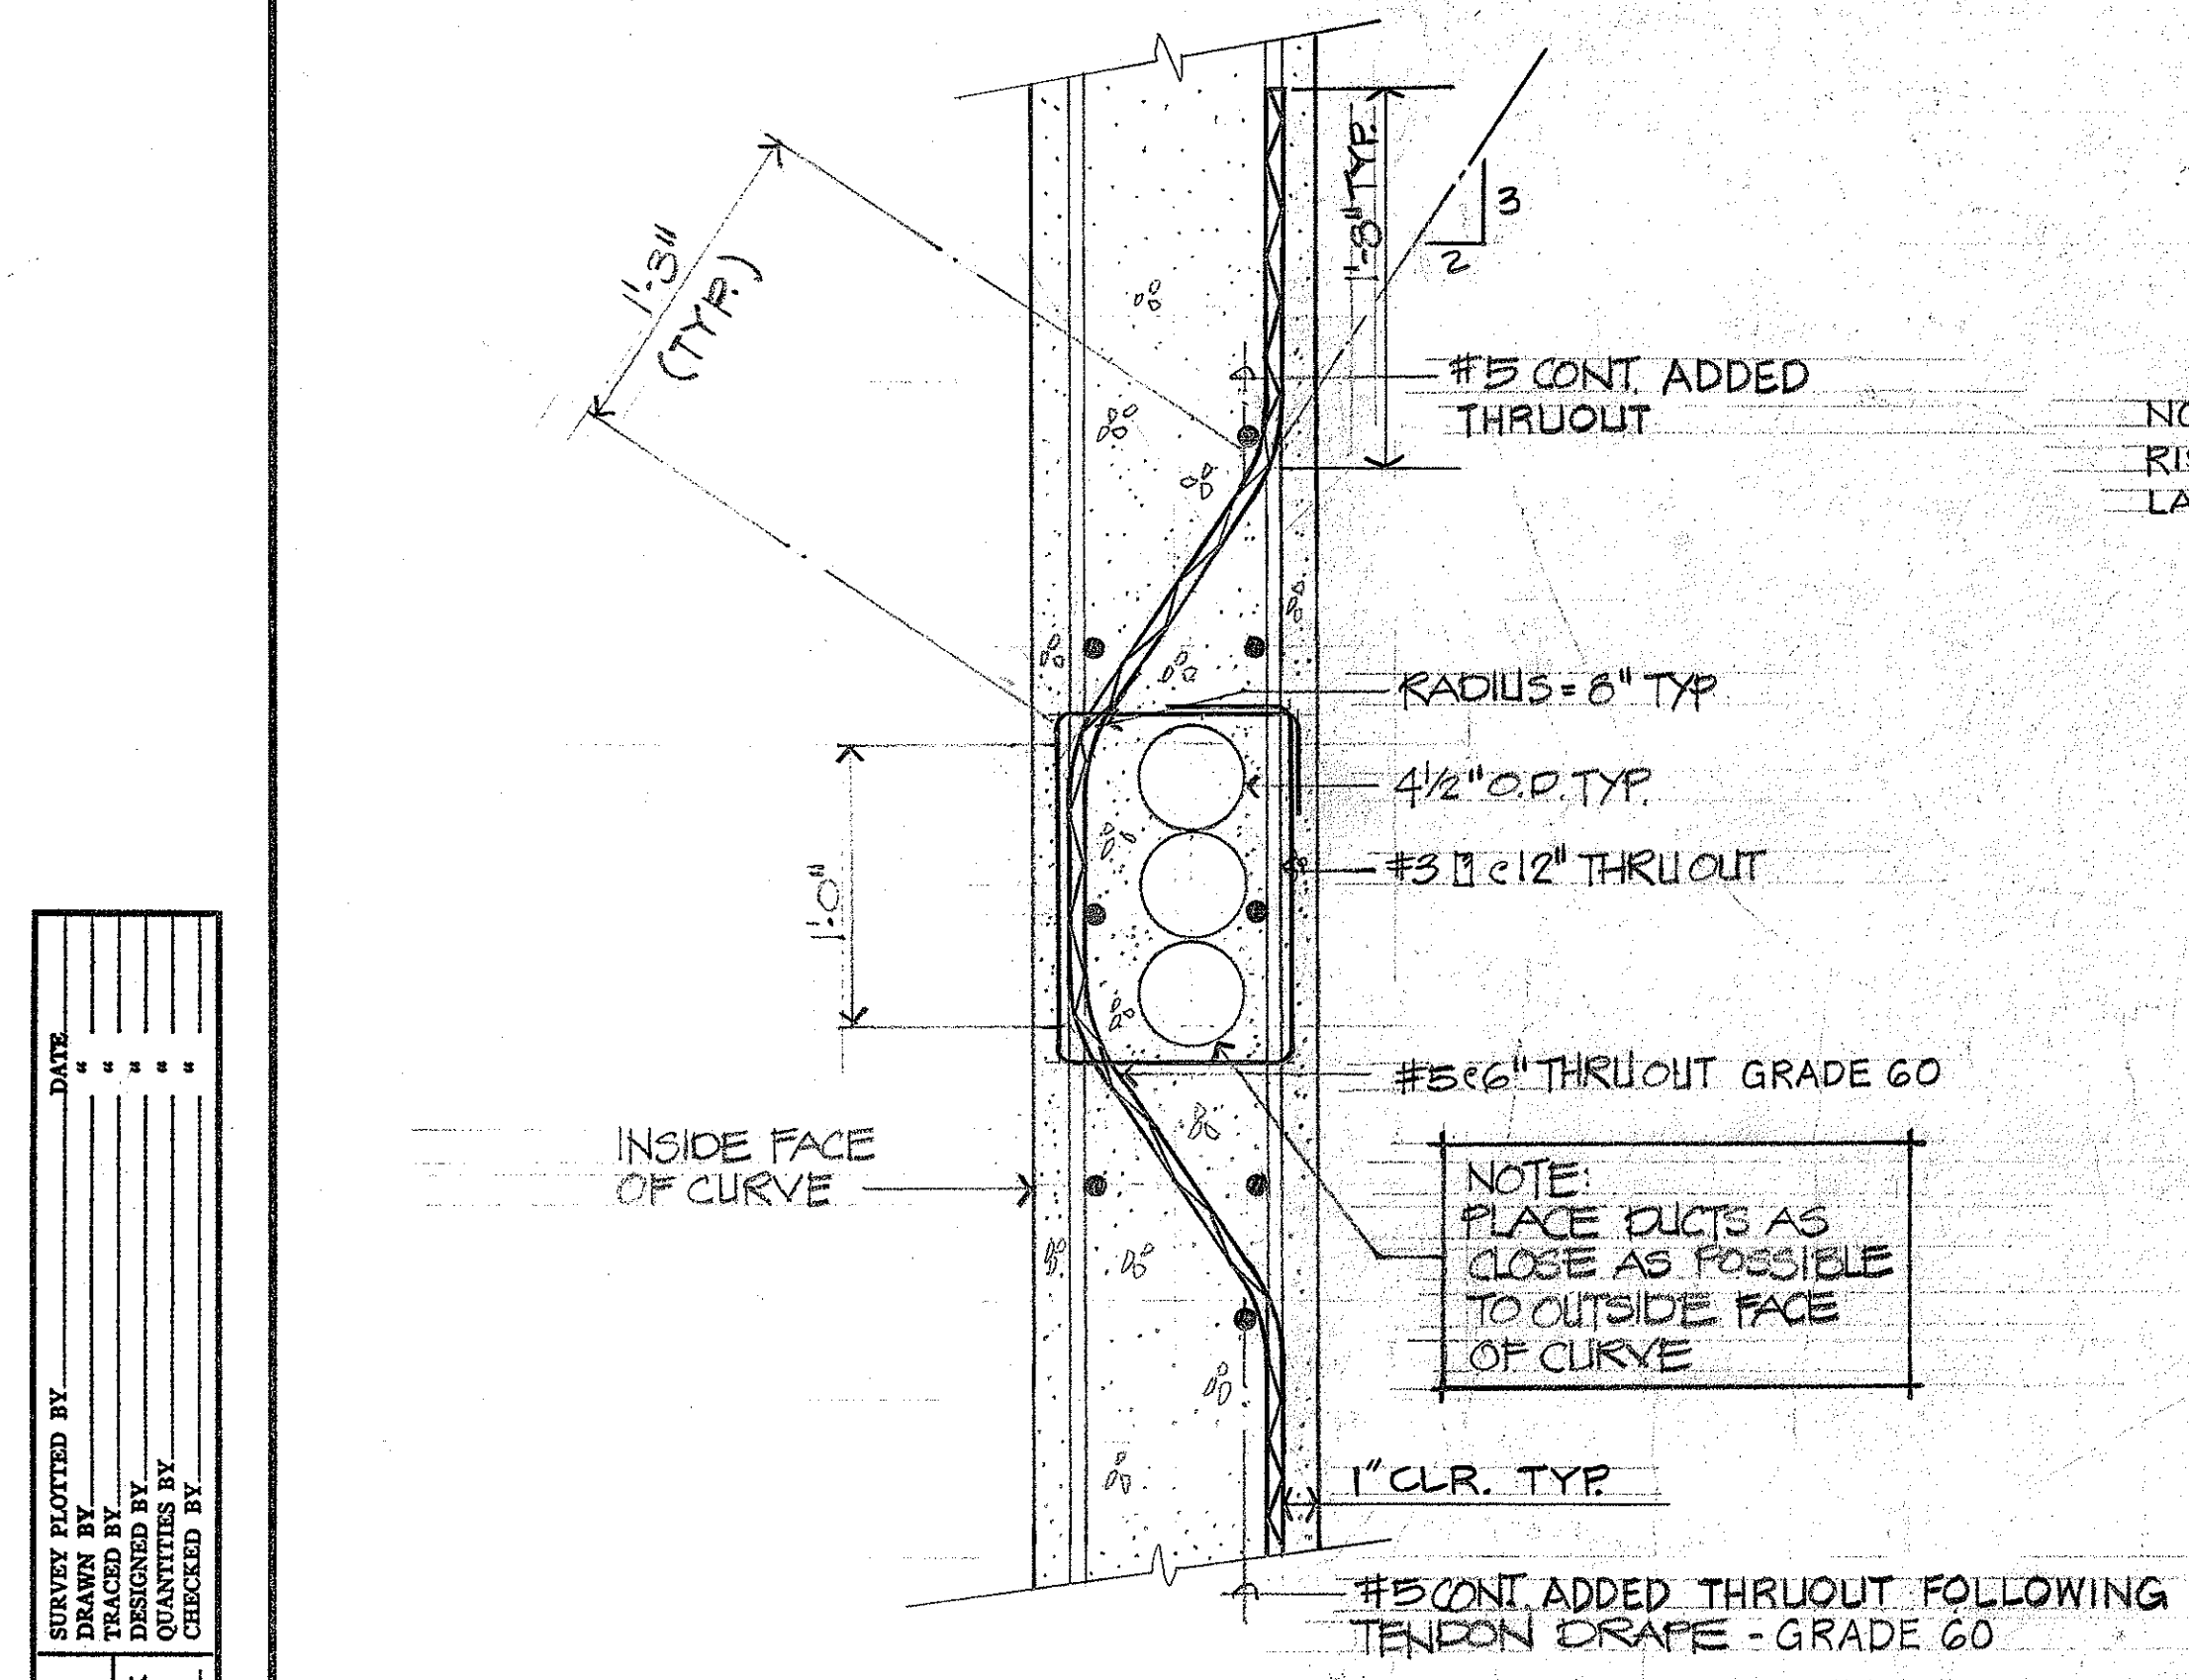

TYPICAL DETAIL 4
SCALE: 1 1/2" = 1'-0"

12/22/82 Revised reinf. steel in Detail 3, per Addendum No. 1.

DATE	REVISION
------	----------

STATE OF HAWAII
DEPARTMENT OF TRANSPORTATION
HIGHWAYS DIVISION

NORMAL DECK SECTION
BRIDGE No. 3

HALEKOU INTERCHANGE
F.A.I. Proj. No. I-H3-1(24)-11

Scale: As Noted Date: SEPT. 1982






SHEET No. 11V OF 20 SHEETS

APPROVED:
HAWAIIAN ELECTRIC CO., INC. DATE

APPROVED
Assistant Chief Engineer, B.W.S. 9/9/85

DATE	
SURVEY PLOTTED BY	
DRAWN BY	
CHECKED BY	
NOTE BOOK	
CHECKED BY	
No.	

FED. ROAD DIST. NO.	STATE	FED. AID PROJ. NO.	FISCAL YEAR	SHEET NO.	TOTAL SHEETS
HAWAII	HAW.	I-H3-1(24):11	1983	212AR	328

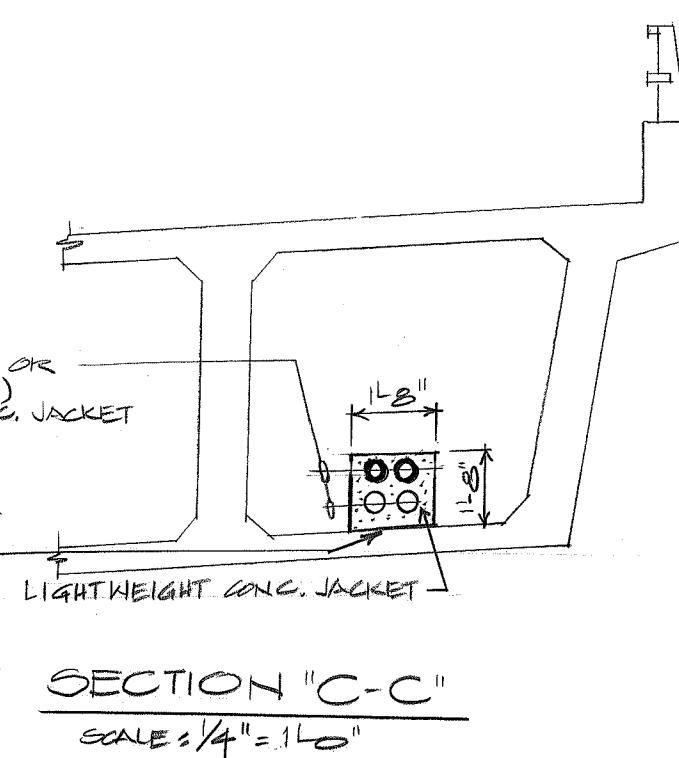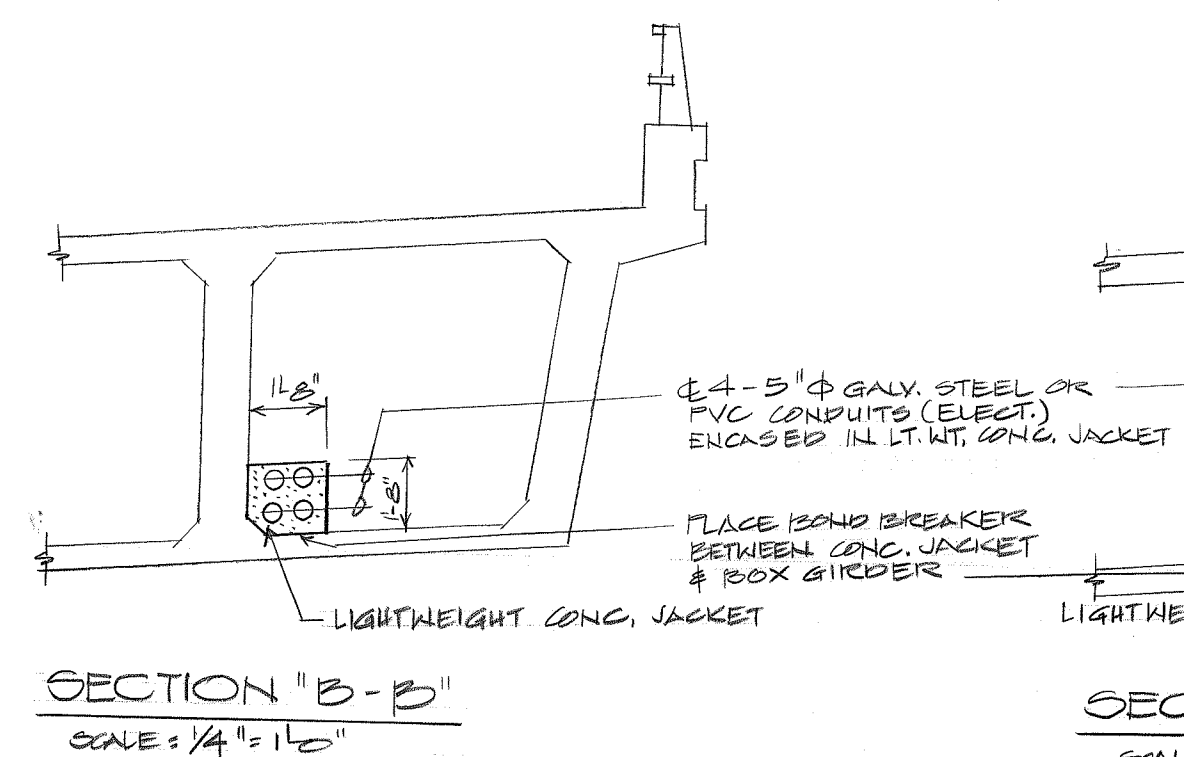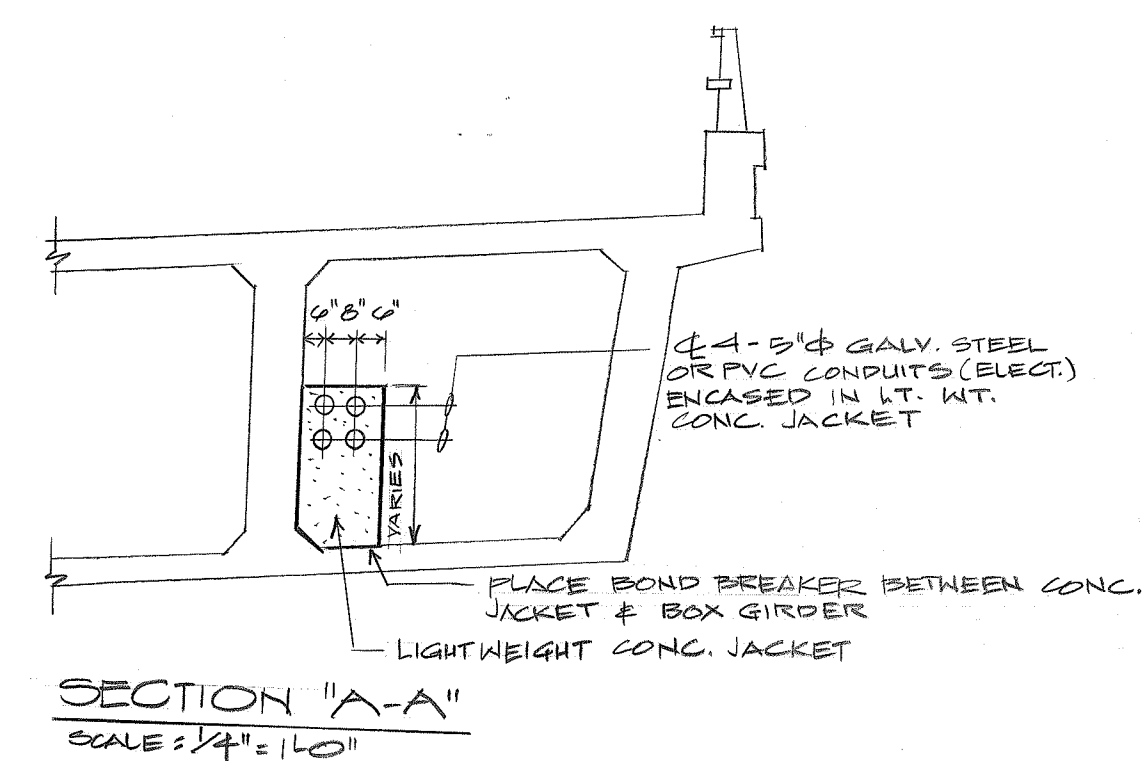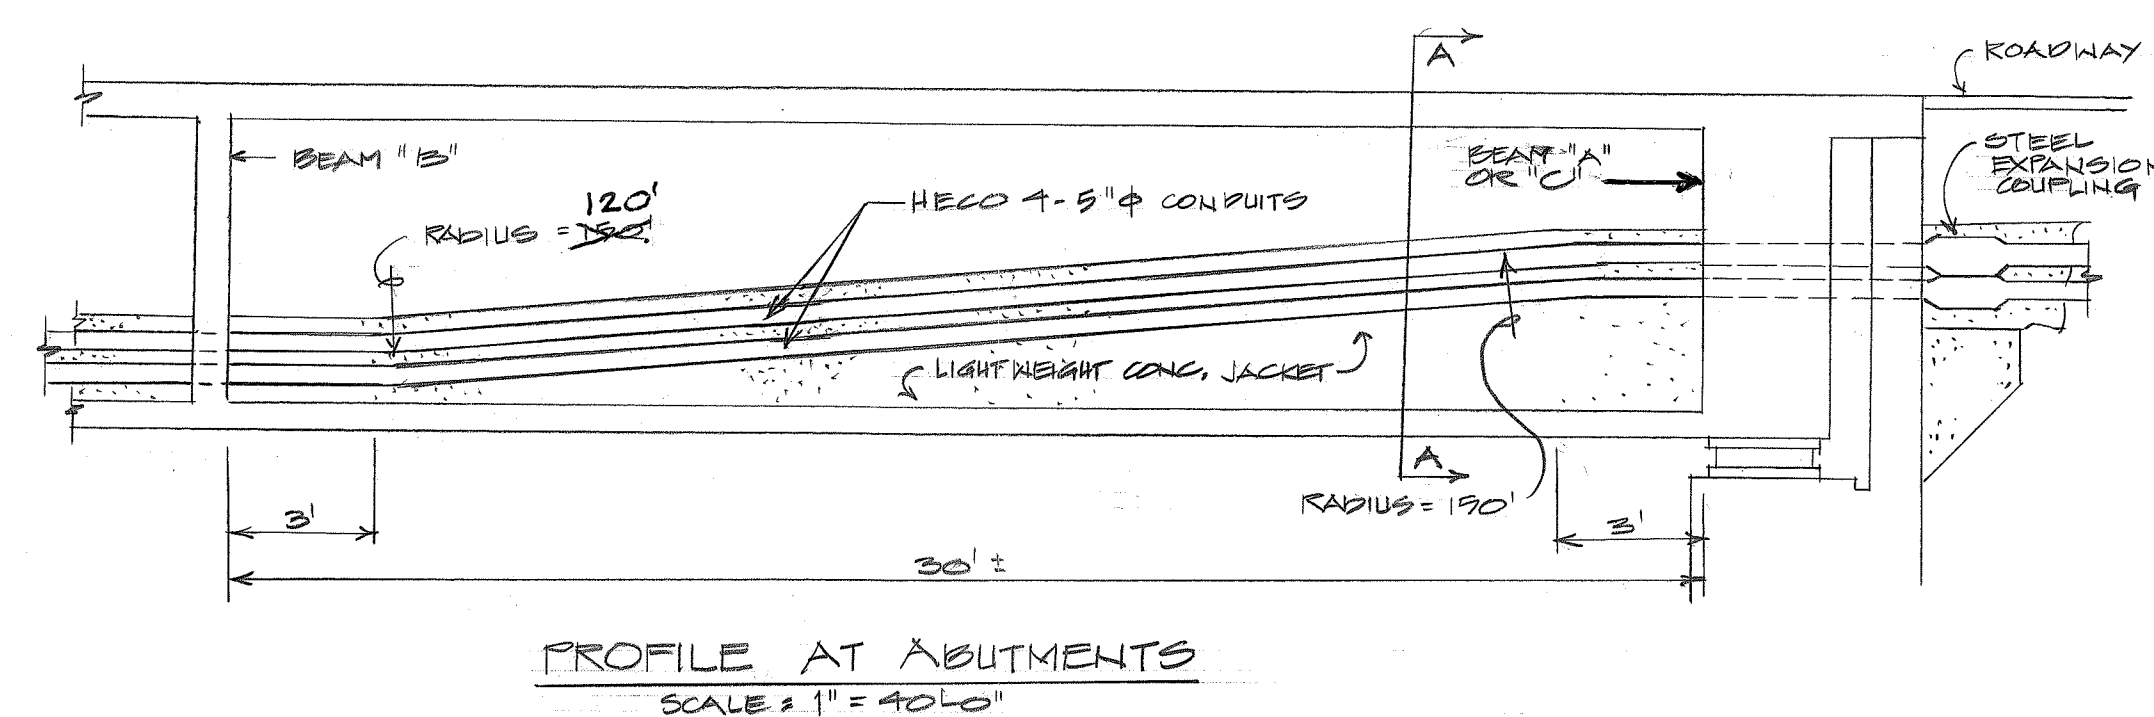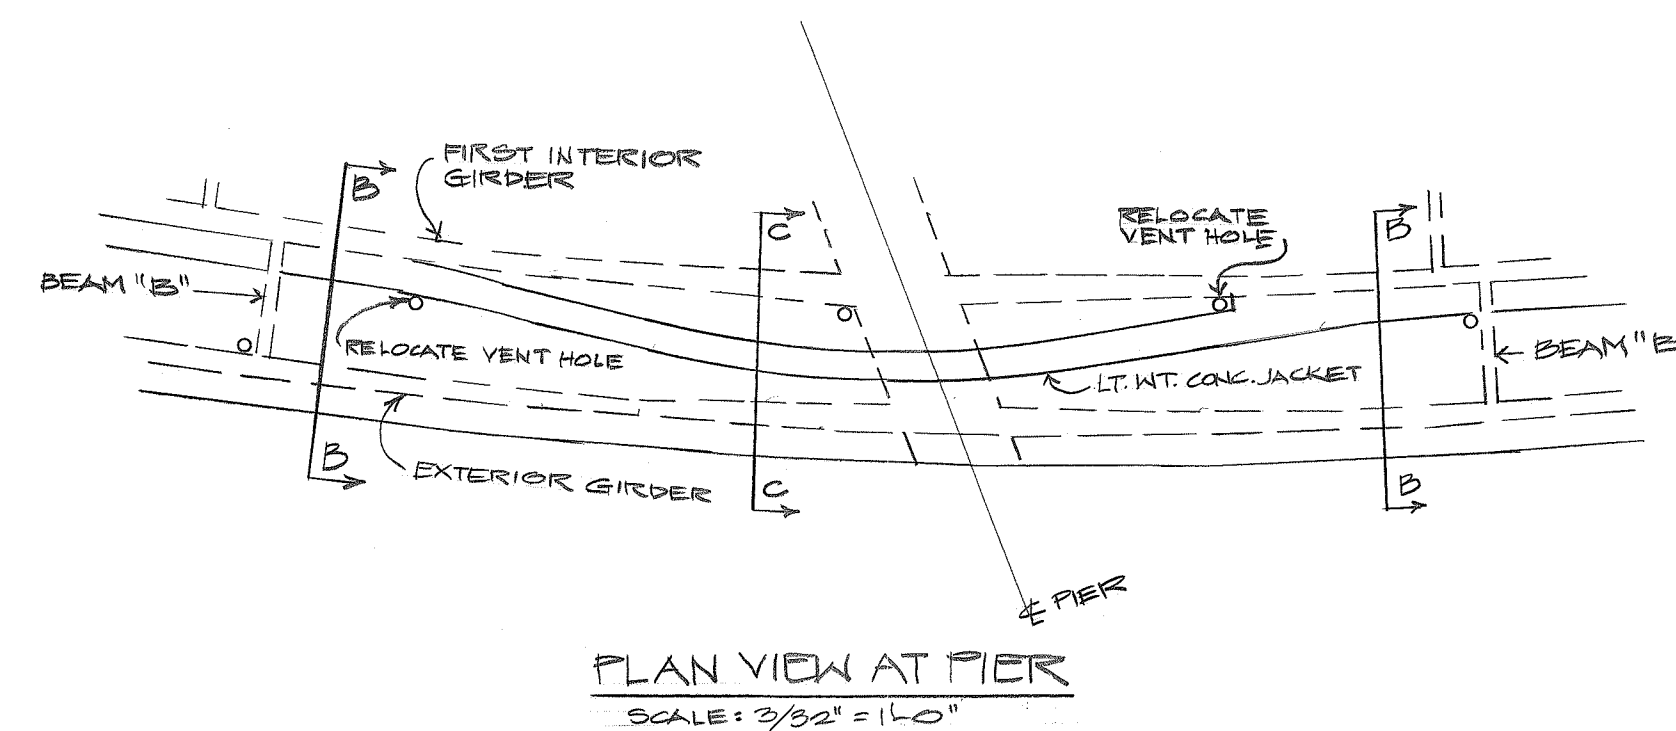

Note: This tracing prepared during
"As Built" posting.

ORIGINAL PLAN	SURVEY PLOTTED BY _____ DATE _____	
	DRAWN BY _____	_____
NOTE BOOK	TRACED BY _____	_____
	DESIGNED BY _____	_____
	QUANTITIES BY _____	_____
	CHECKED BY _____	_____
No. _____		

STATE OF HAWAII
DEPARTMENT OF TRANSPORTATION
HIGHWAYS DIVISION

ELECTRICAL CONDUITS
P BRIDGE NO 3

HALEKOU INTERCHANGE
F.A.I. Proj. No. I-H3-1(24):11





Scale: As Noted DATE: JAN. 95

SHEET NO. 11 OF 21 SHEETS

"AS-BUILT"

212AIR

FED. ROAD DIST. NO.	STATE	FED. AID PROJ. NO.	FISCAL YEAR	SHEET NO.	TOTAL SHEETS
HAWAII	HAW.	I-43-1(24)11	1983	213	323

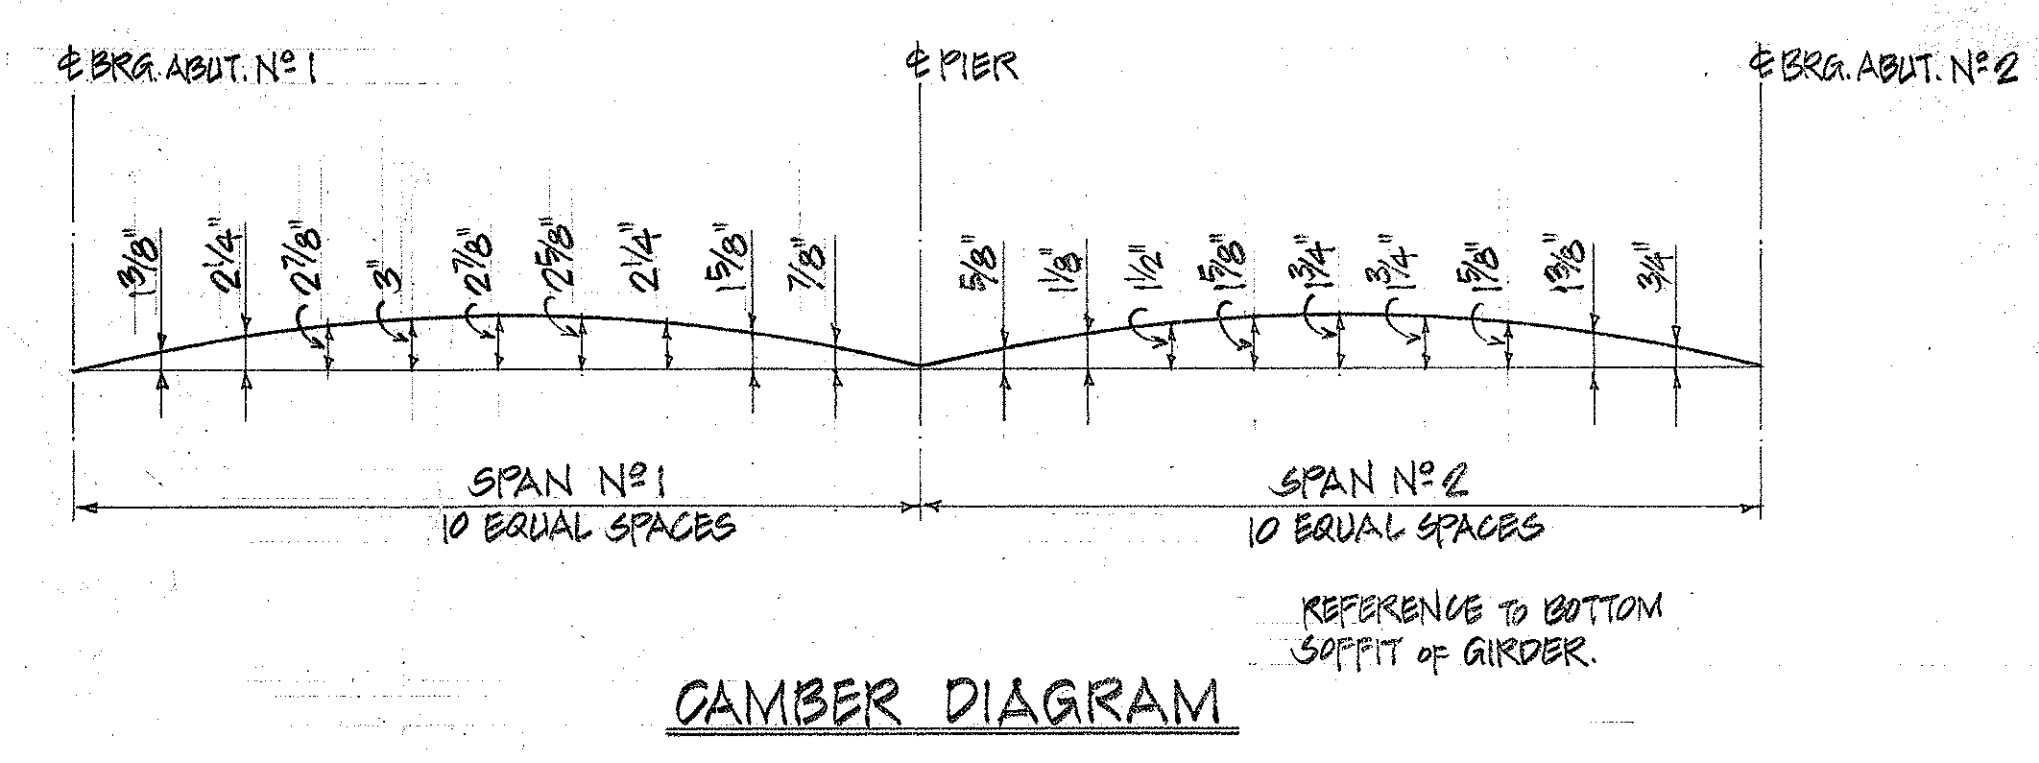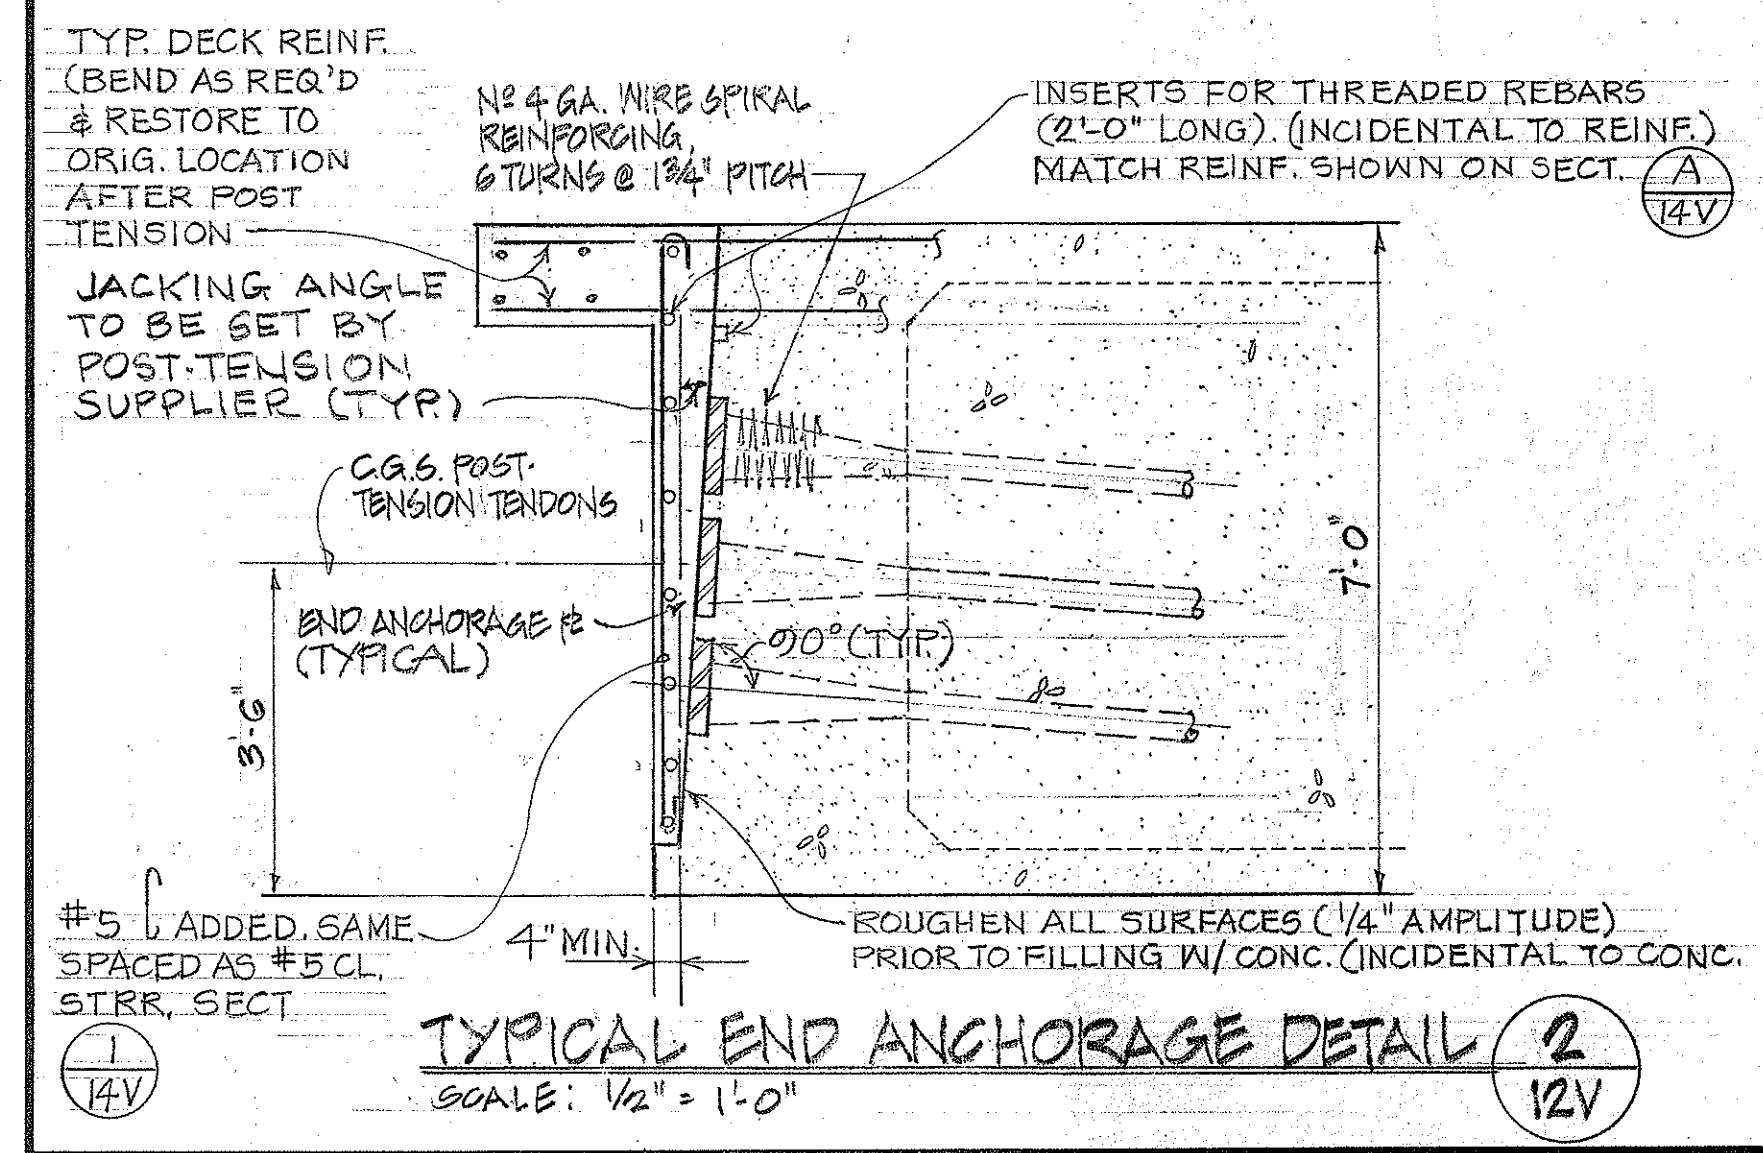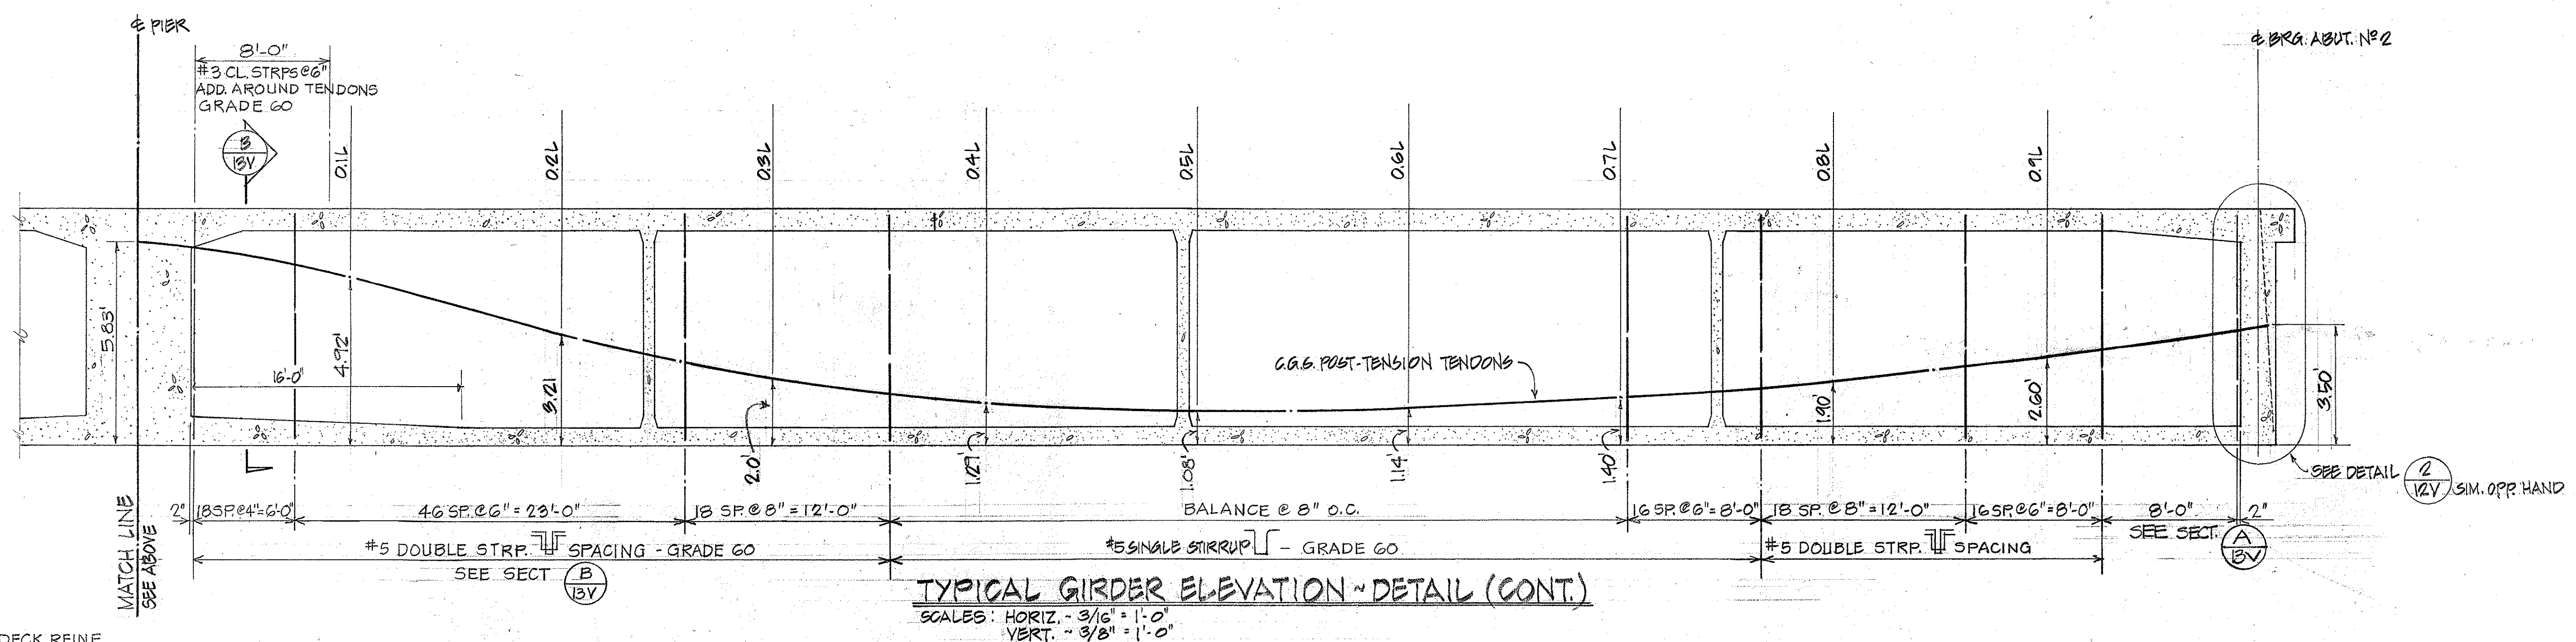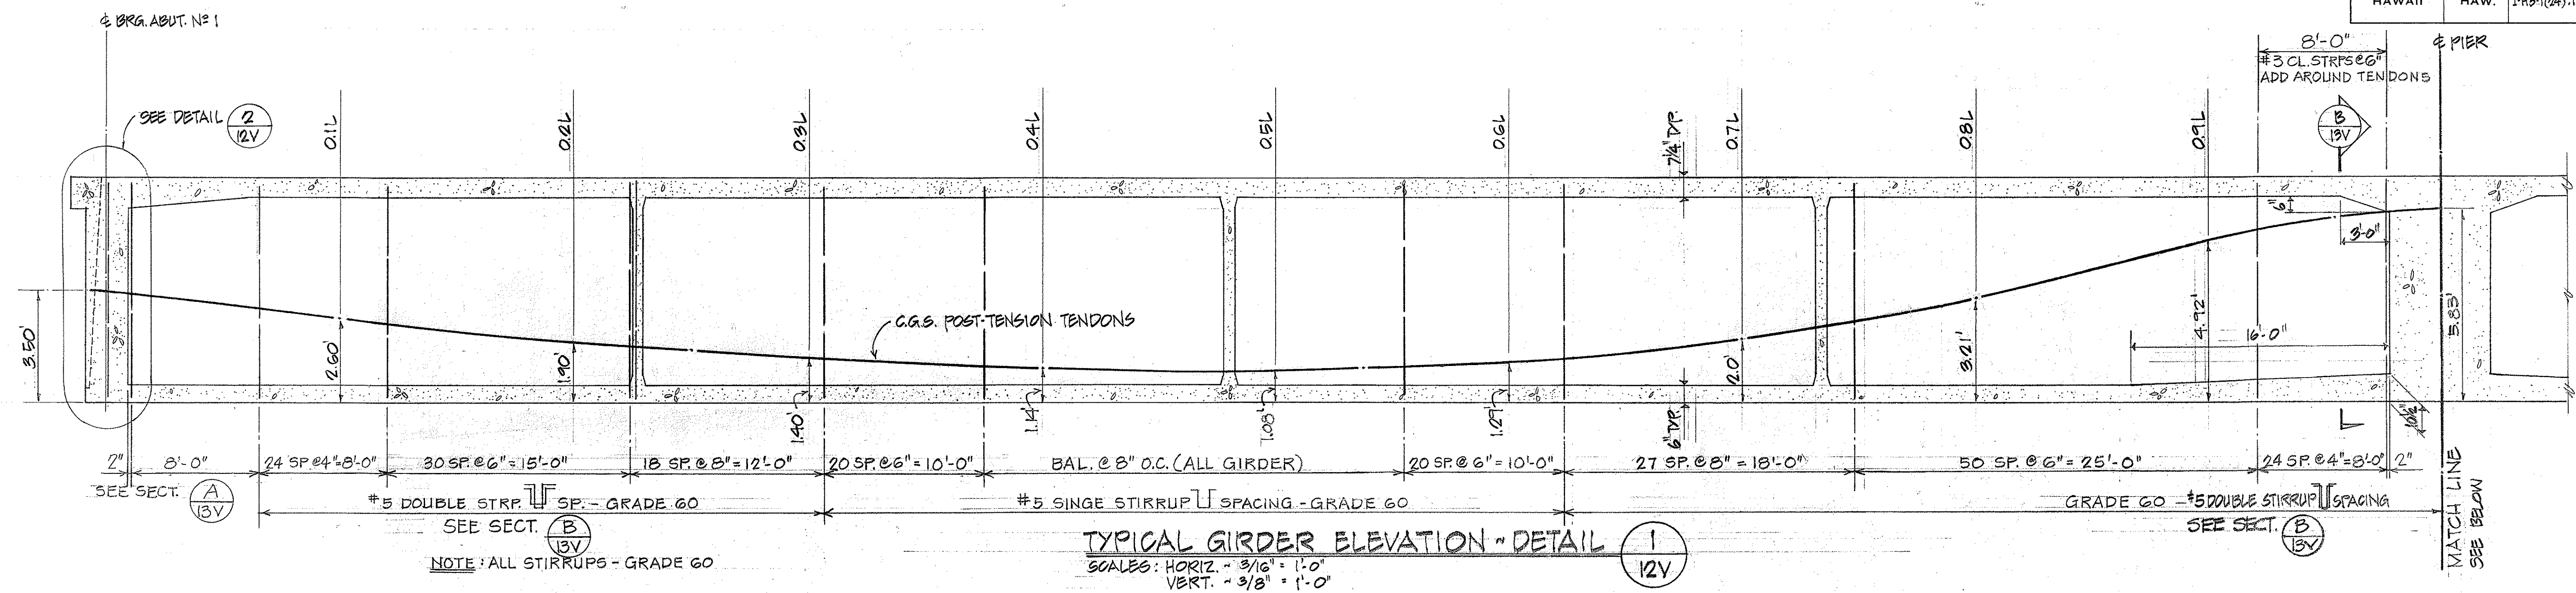

STATE OF HAWAII
DEPARTMENT OF TRANSPORTATION
HIGHWAYS DIVISION

**TYPICAL GIRDER ELEVATION
BRIDGE NO. 3**

HALEKOU INTERCHANGE
F.A.I. Proj. No. I-43-1(24)11







Scale: As Noted Date: SEPT. 1982

SHEET No. 12V OF 20 SHEETS

DATE	_____
SURVEY PLOTTED BY	_____
ORIGINAL PLAN	_____
DESIGNED BY	_____
NOTE BOOK	_____
CHECKED BY	_____
NO.	_____


ORIGINAL PLAN	SURVEY PLOTTED BY _____	DATE _____
NOTE BOOK	DRAWN BY _____	" "
	TRACED BY _____	" "
	DESIGNED BY _____	" "
	QUANTITIES BY _____	" "
NO. _____	CHECKED BY _____	" "

FED. ROAD DIST. NO.	STATE	FED. AID PROJ. NO.	FISCAL YEAR	SHEET NO.	TOTAL SHEETS
HAWAII	HAW.	I-H3-1(24)-11	1983	215	328

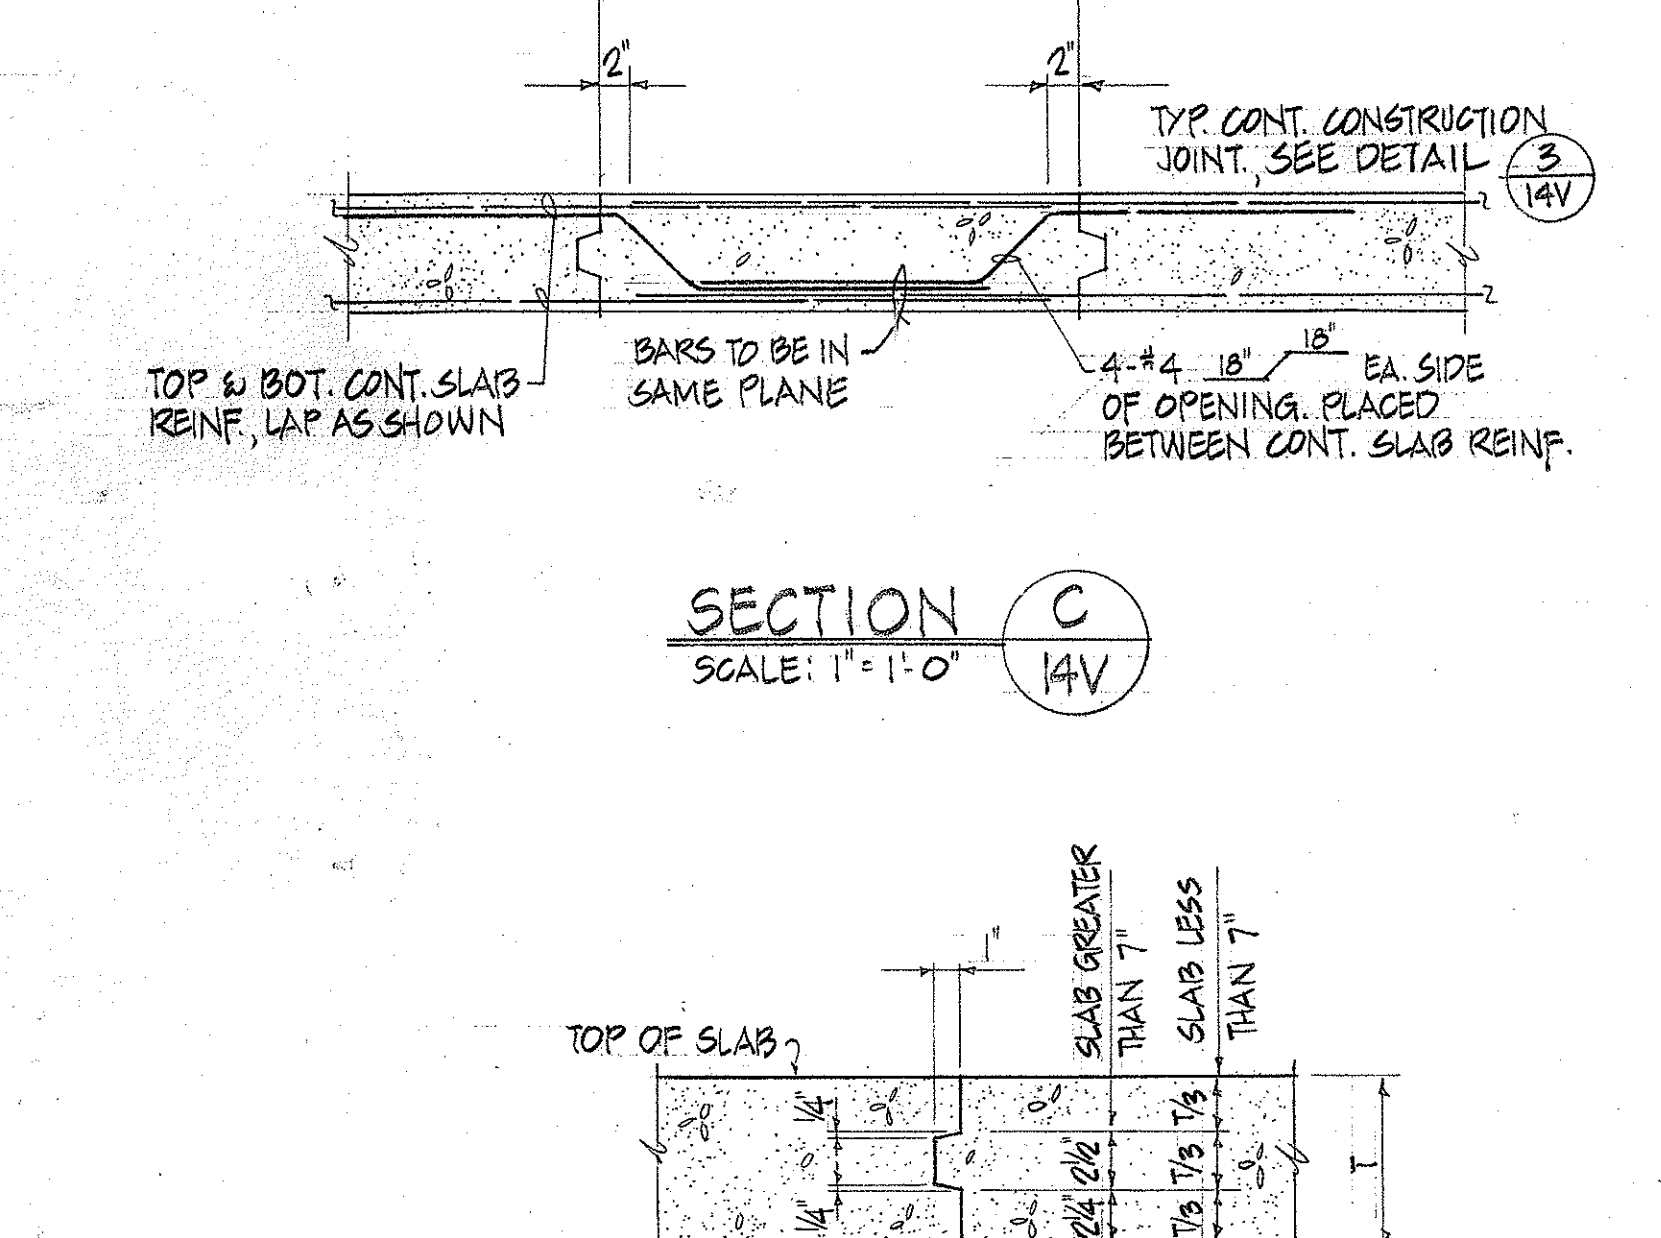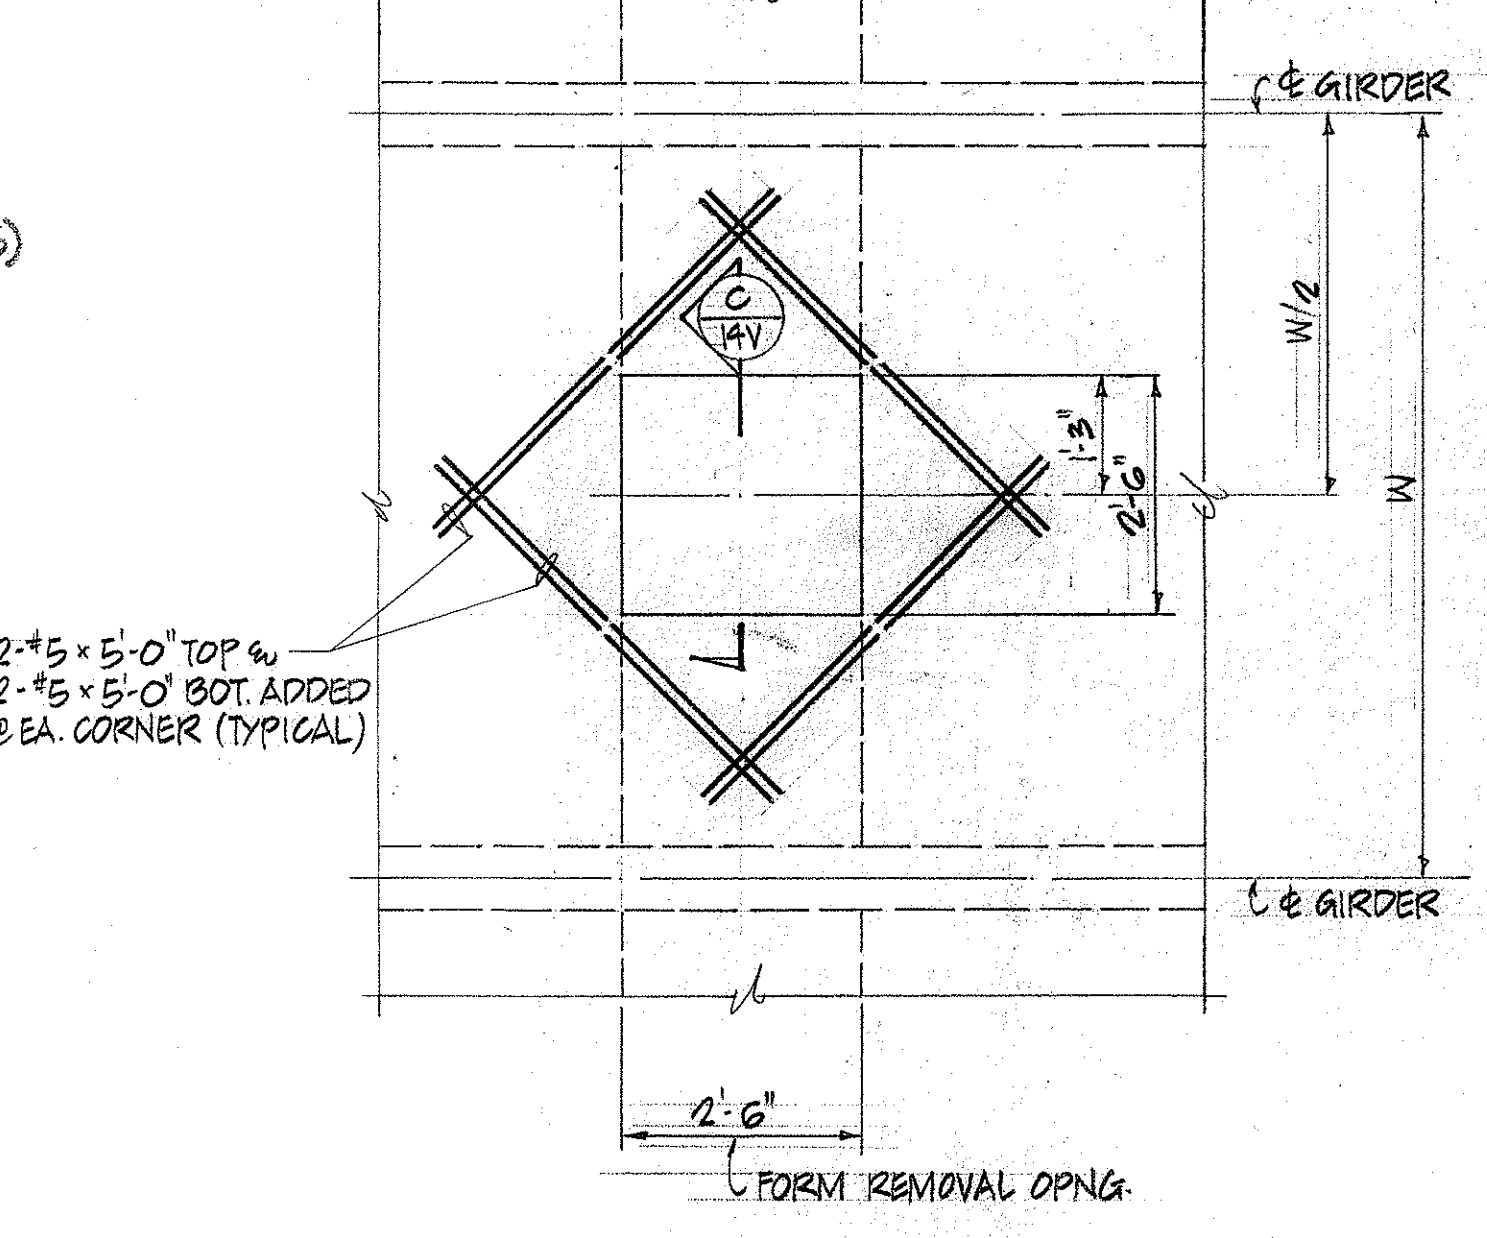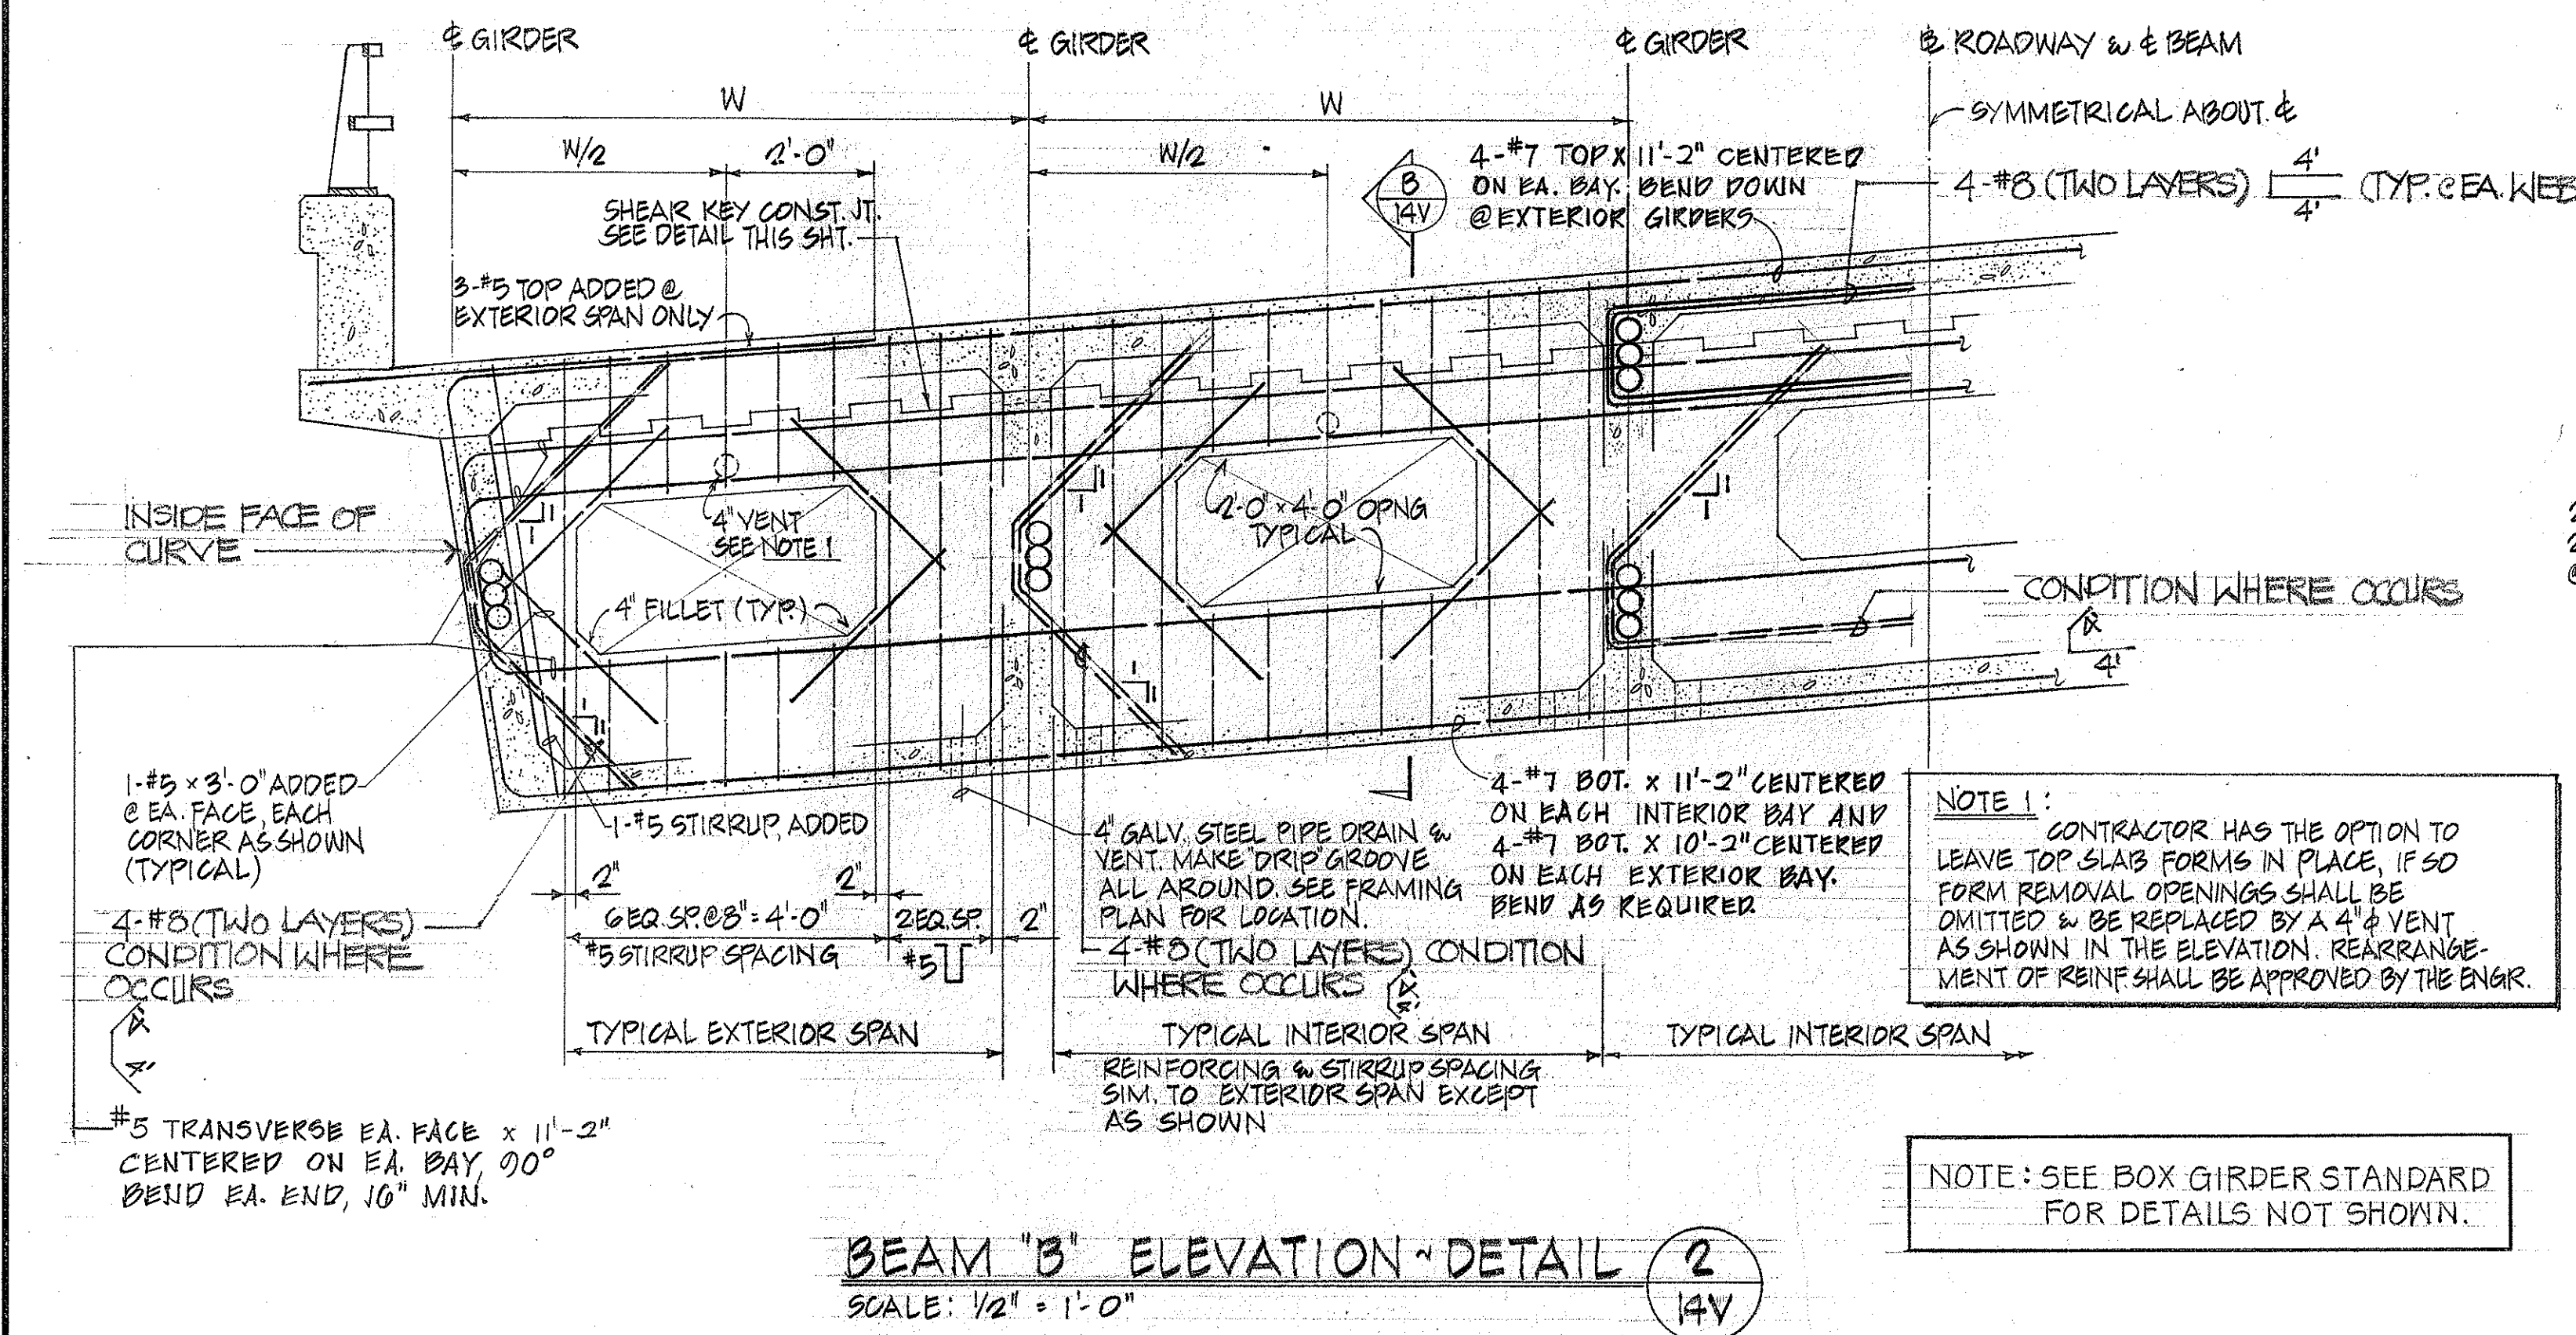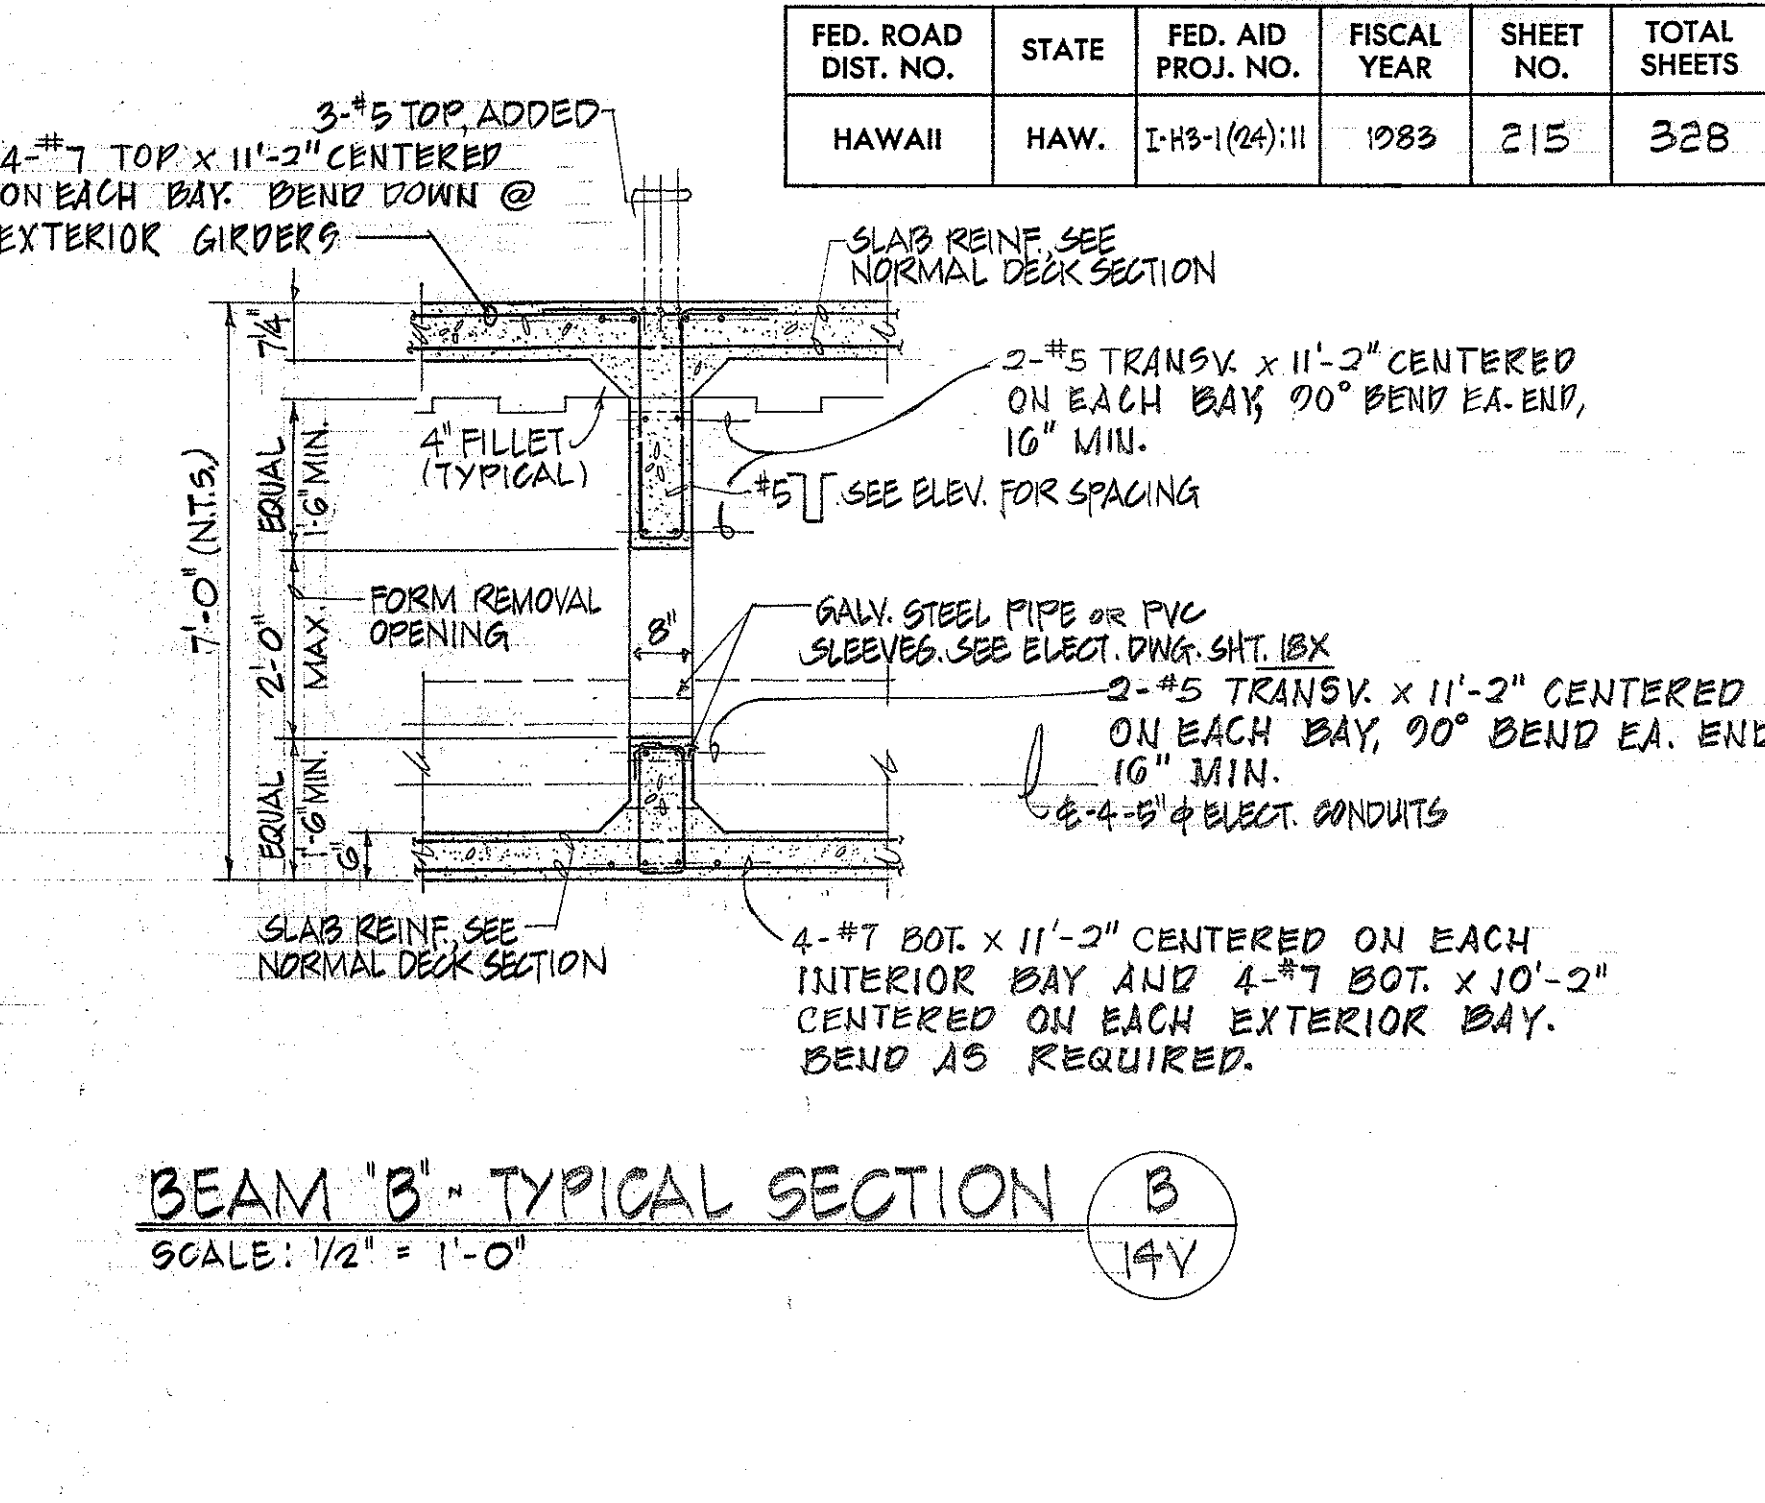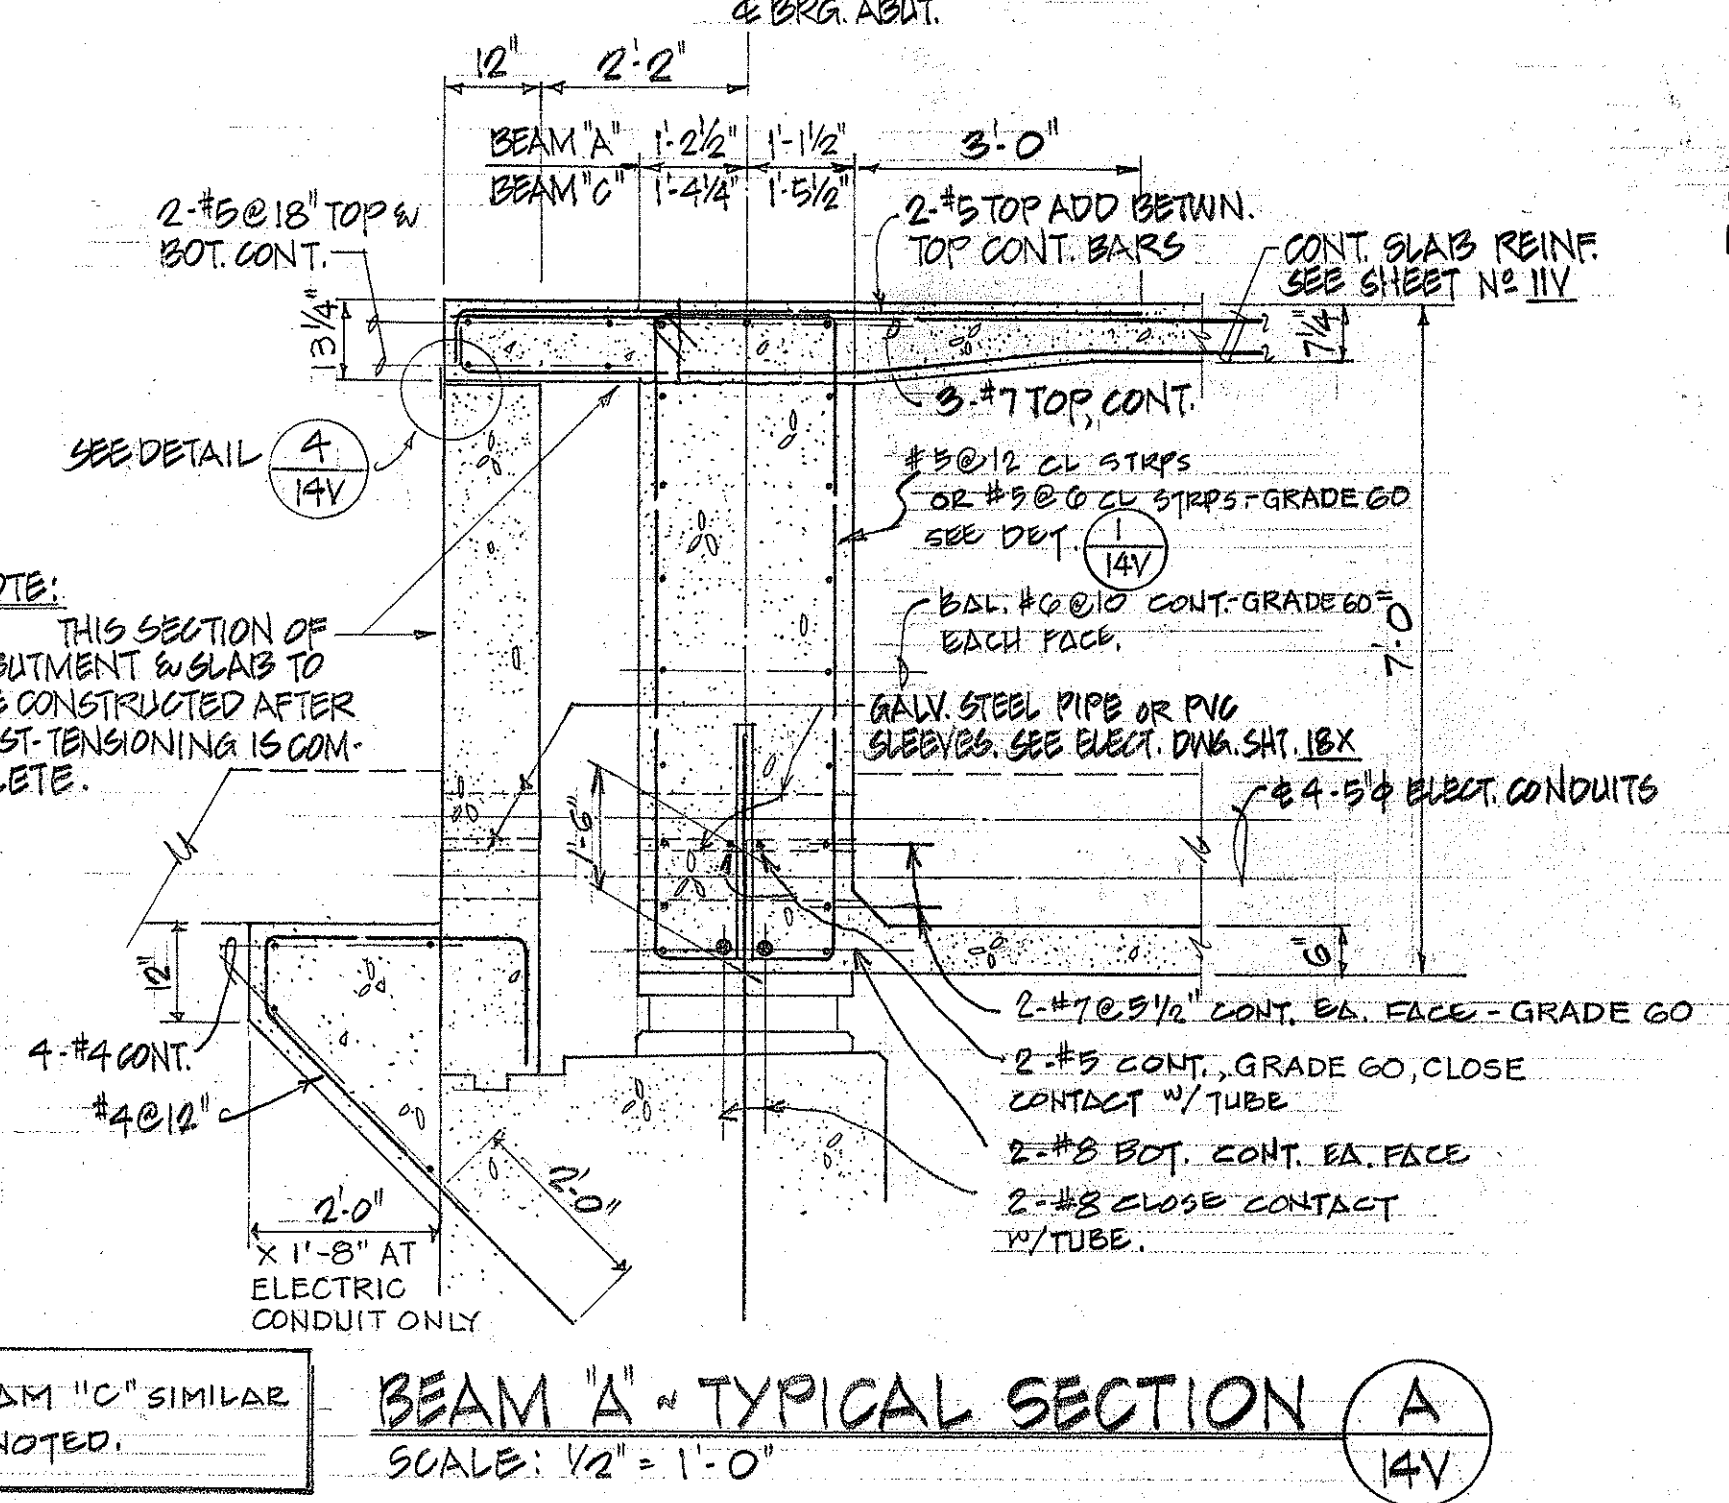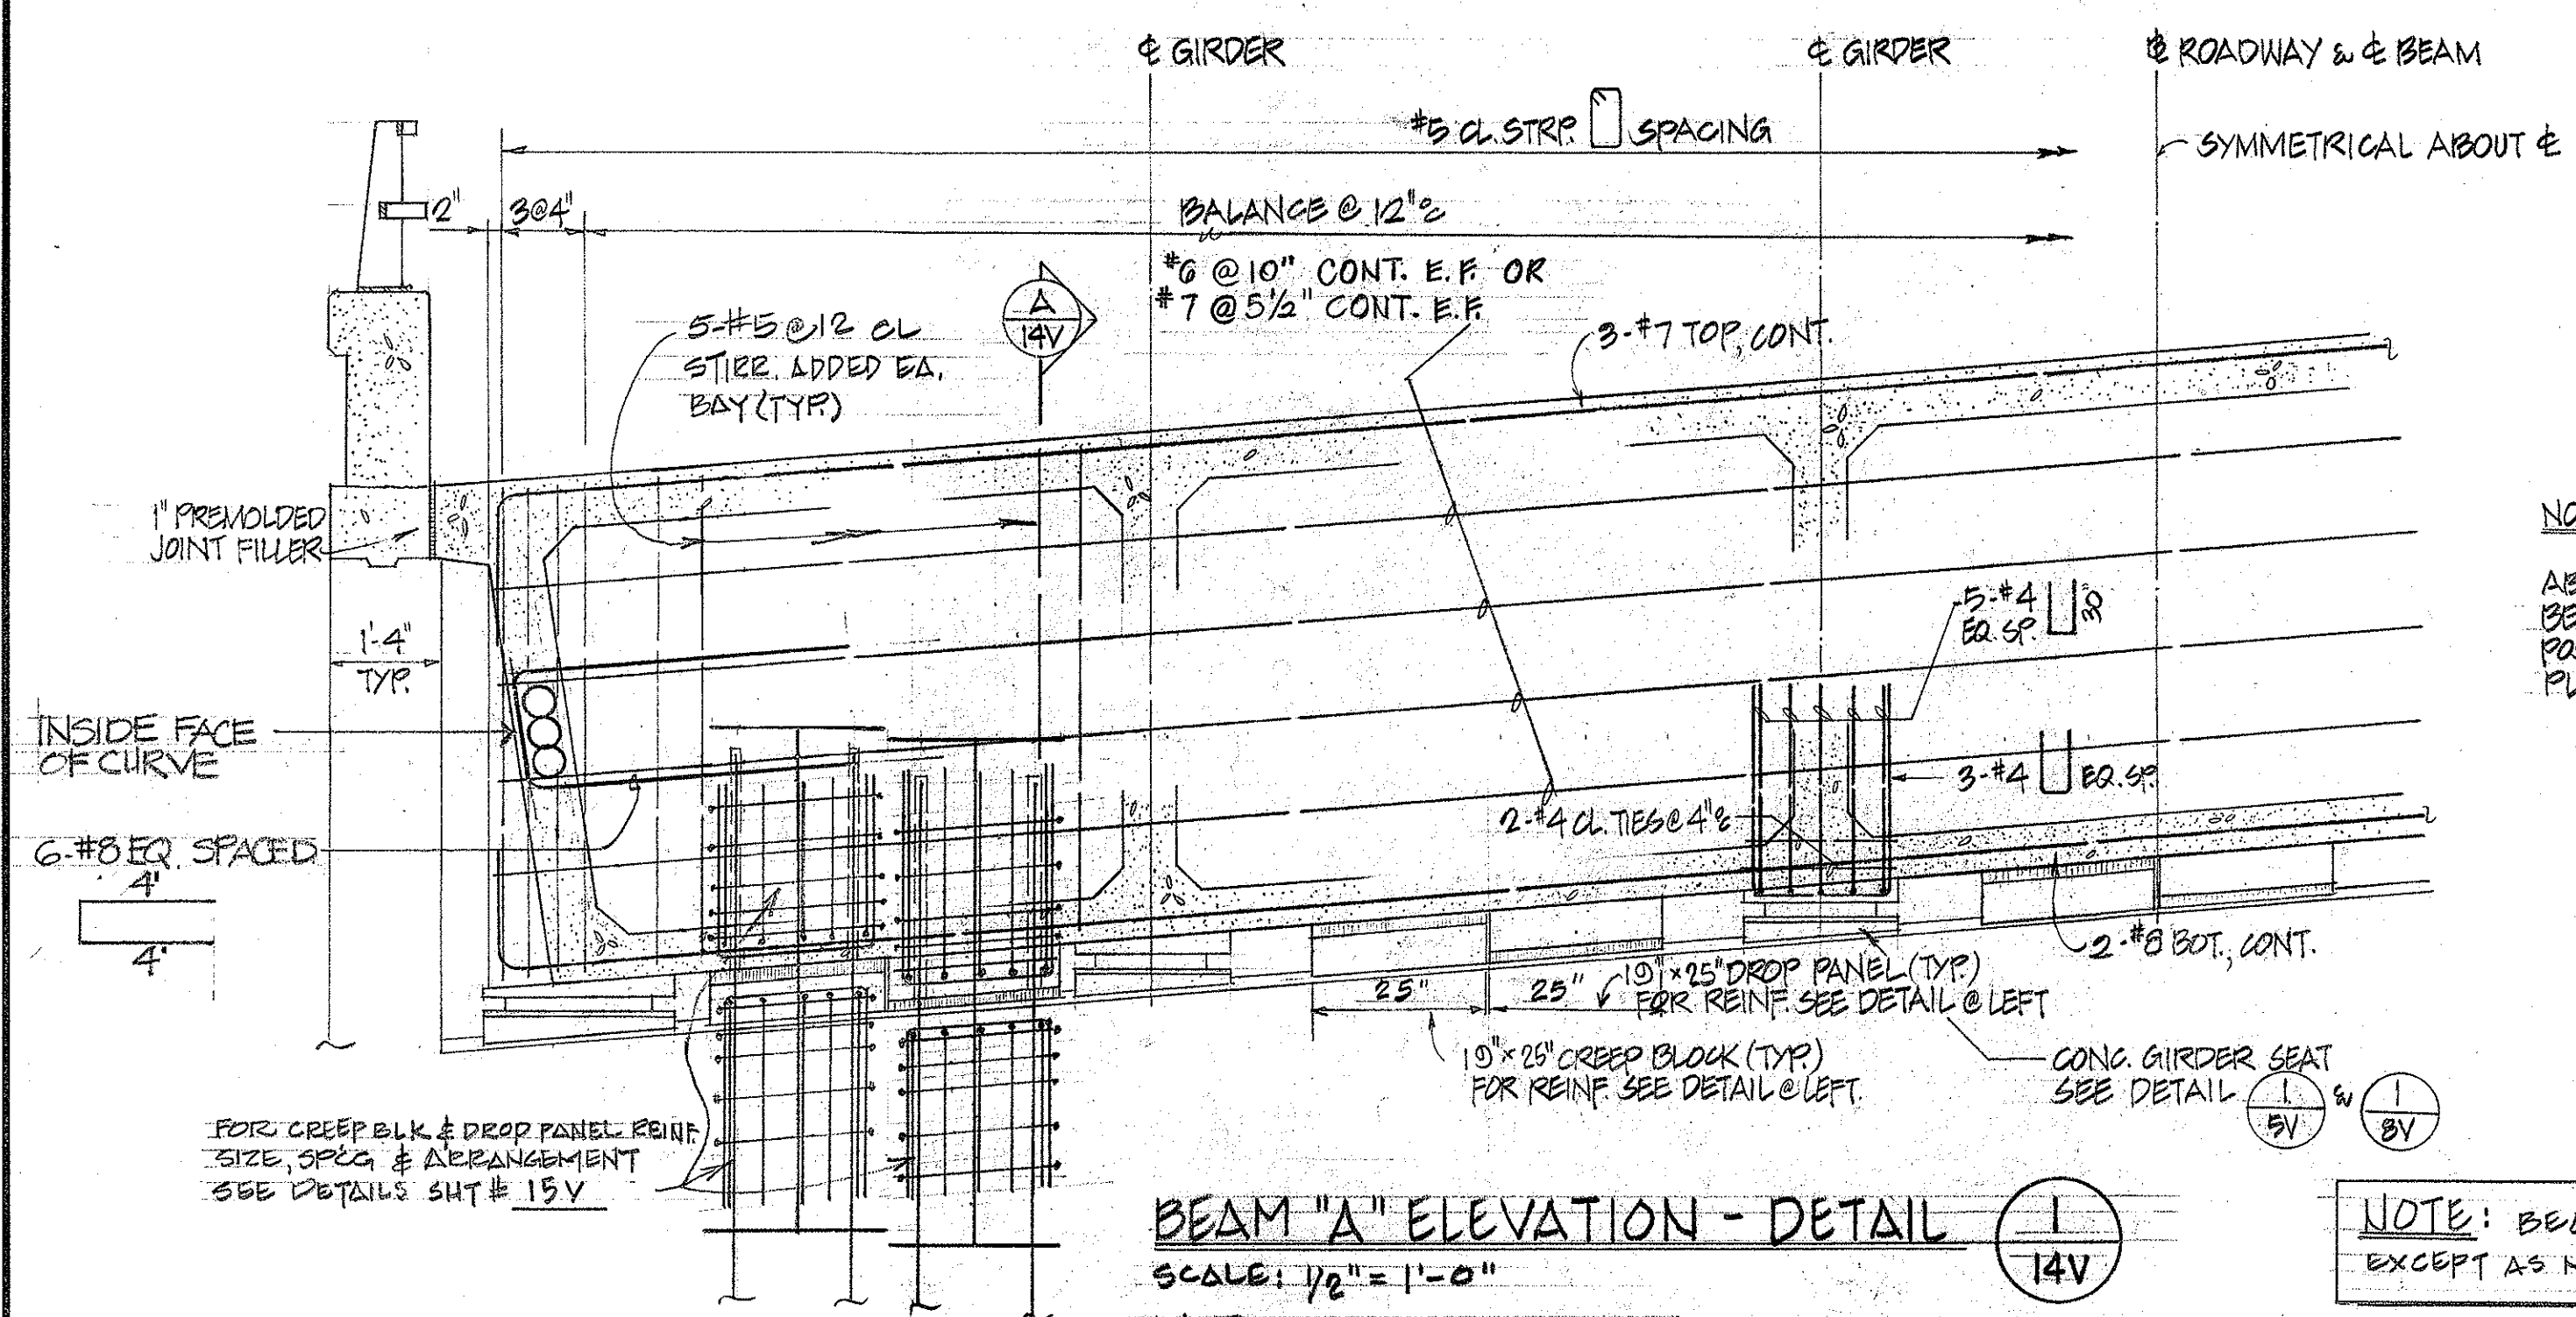

PLAN - FORM REMOVAL OPNG. IN TOP SLAB
SCALE: 1/2" = 1'-0"

TYPICAL CONSTRUCTION JOINT DETAIL 3
SCALE: 1/2" = 1'-0"

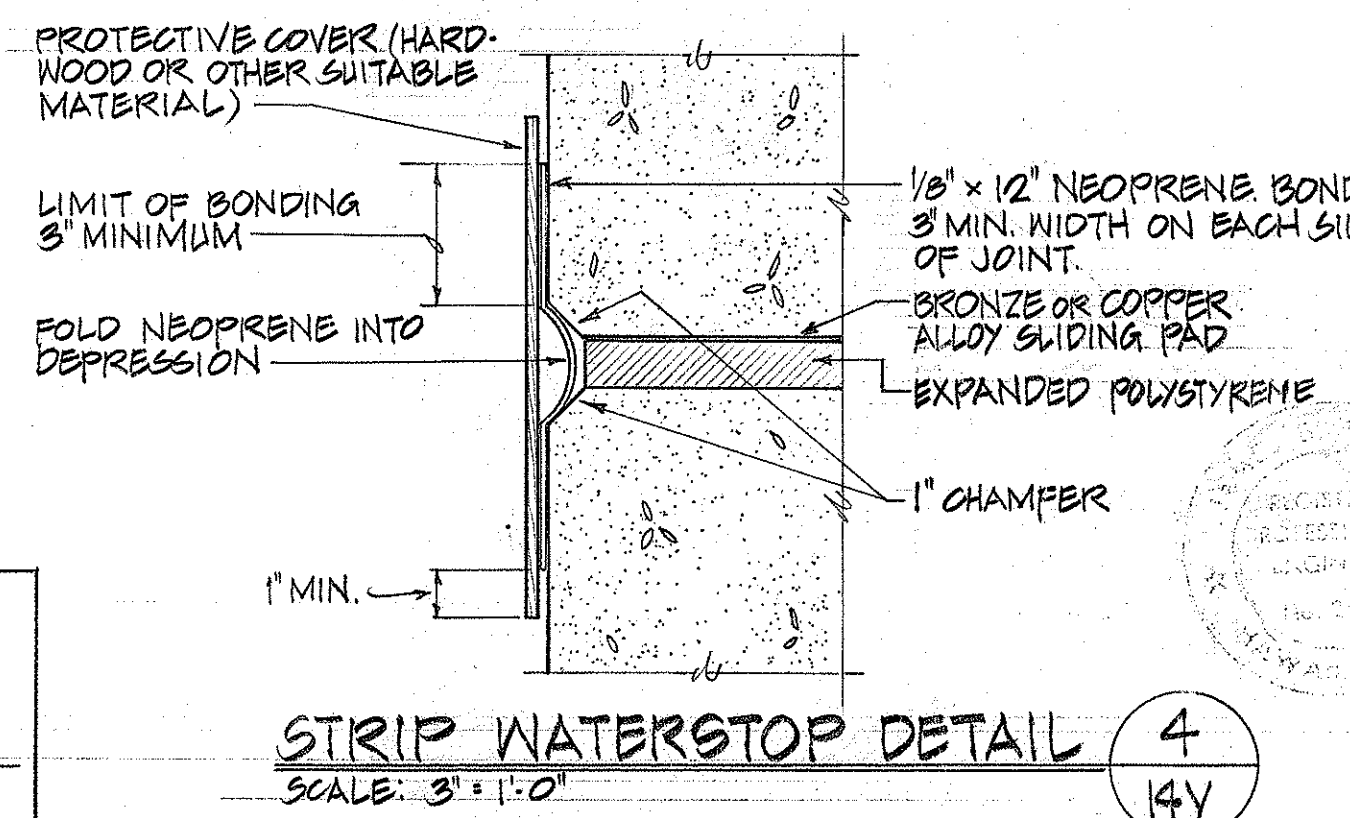

DATE	
SURVEY PLOTTED BY	
DRAWN BY	
TRACED BY	
NOTE BOOK	
CHECKED BY	
No.	

12/22/82	Revised reinf. steel in Details 1, 2, 3, 4 & 5 per Addendum No. 1.
DATE	REVISION

APPROVED:	
HAWAIIAN ELECTRIC CO., INC.	DATE




STATE OF HAWAII
DEPARTMENT OF TRANSPORTATION
HIGHWAYS DIVISION

BEAM 'A' & 'B' ELEVATION & DETAILS
BRIDGE NO. 3

HALEKOU INTERCHANGE
F.A.I. Proj. No. I-H3-1(24)-11


Scale: As Noted Date: SEPT. 1982

SHEET No. 14V OF 20 SHEETS

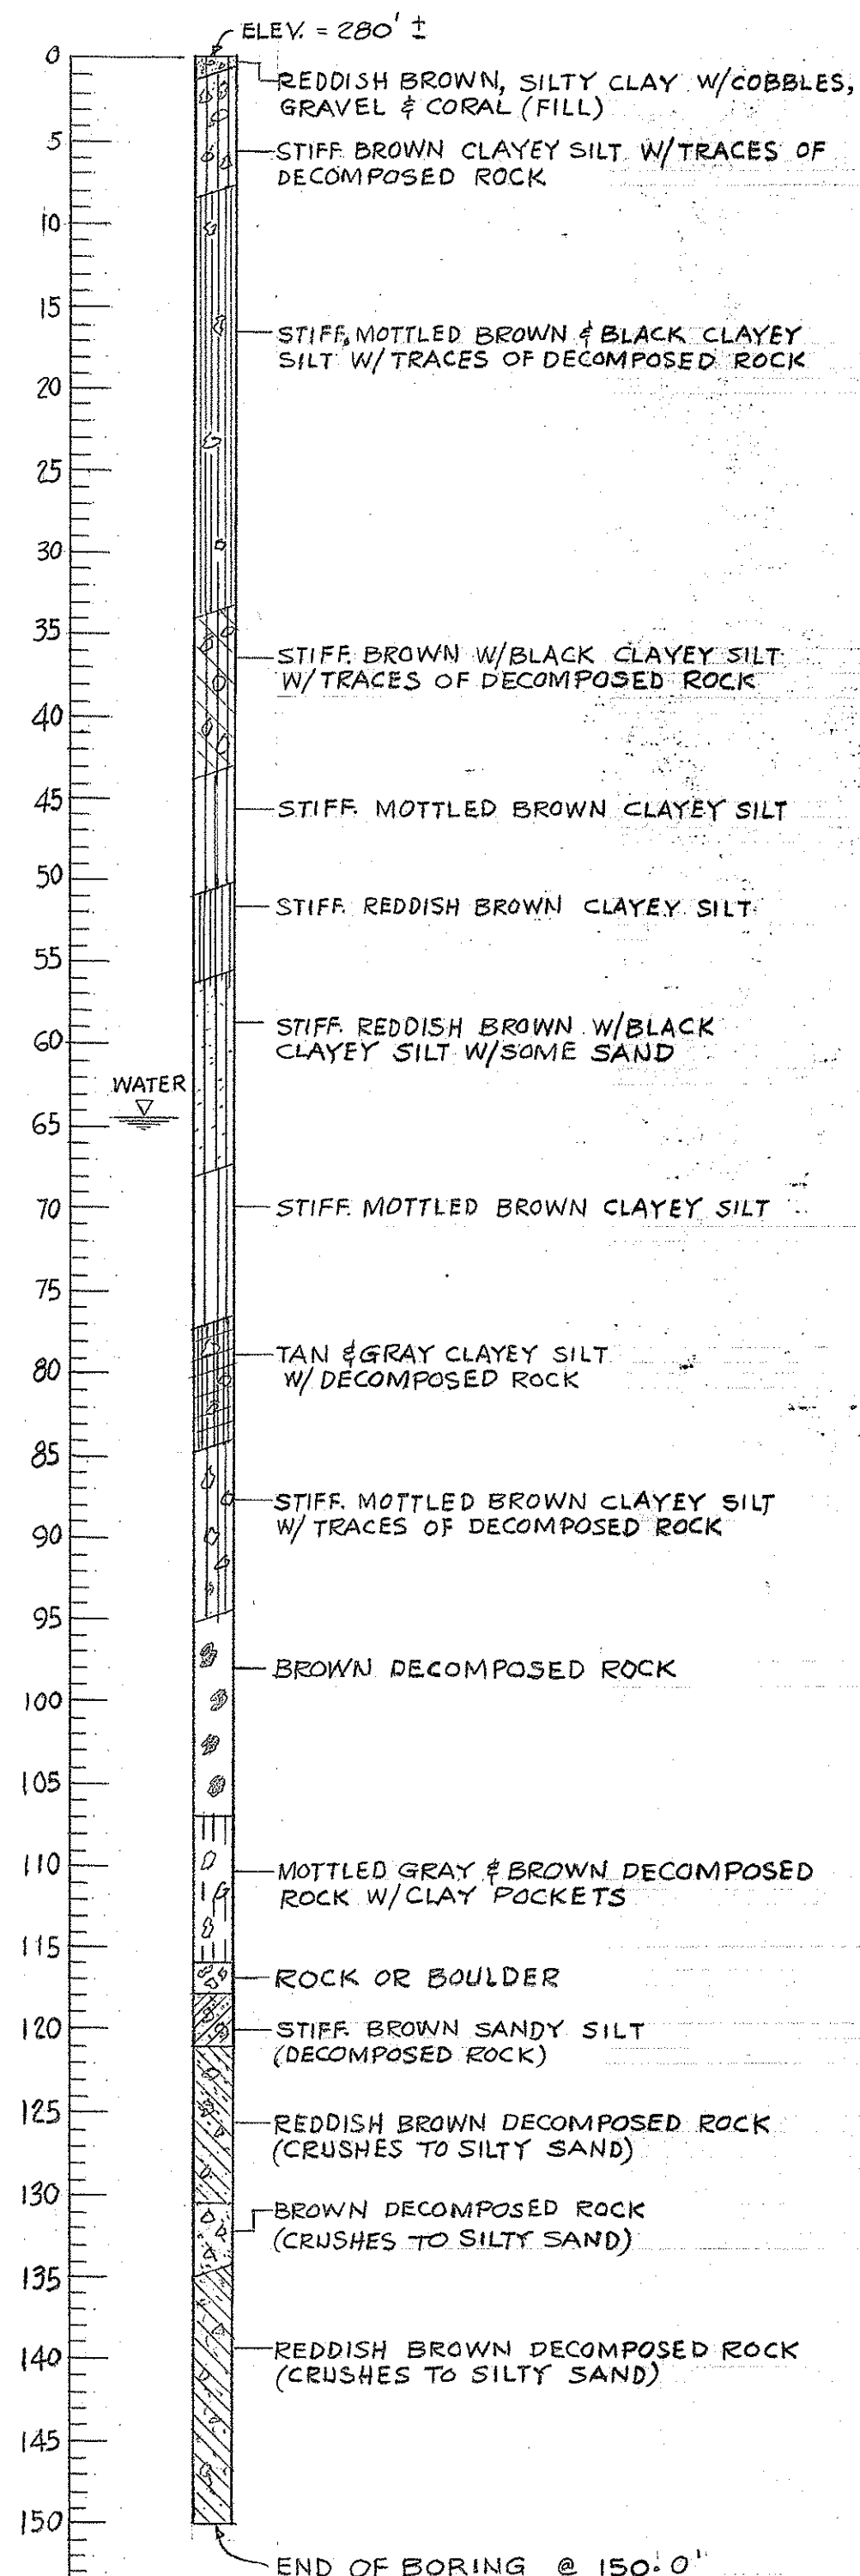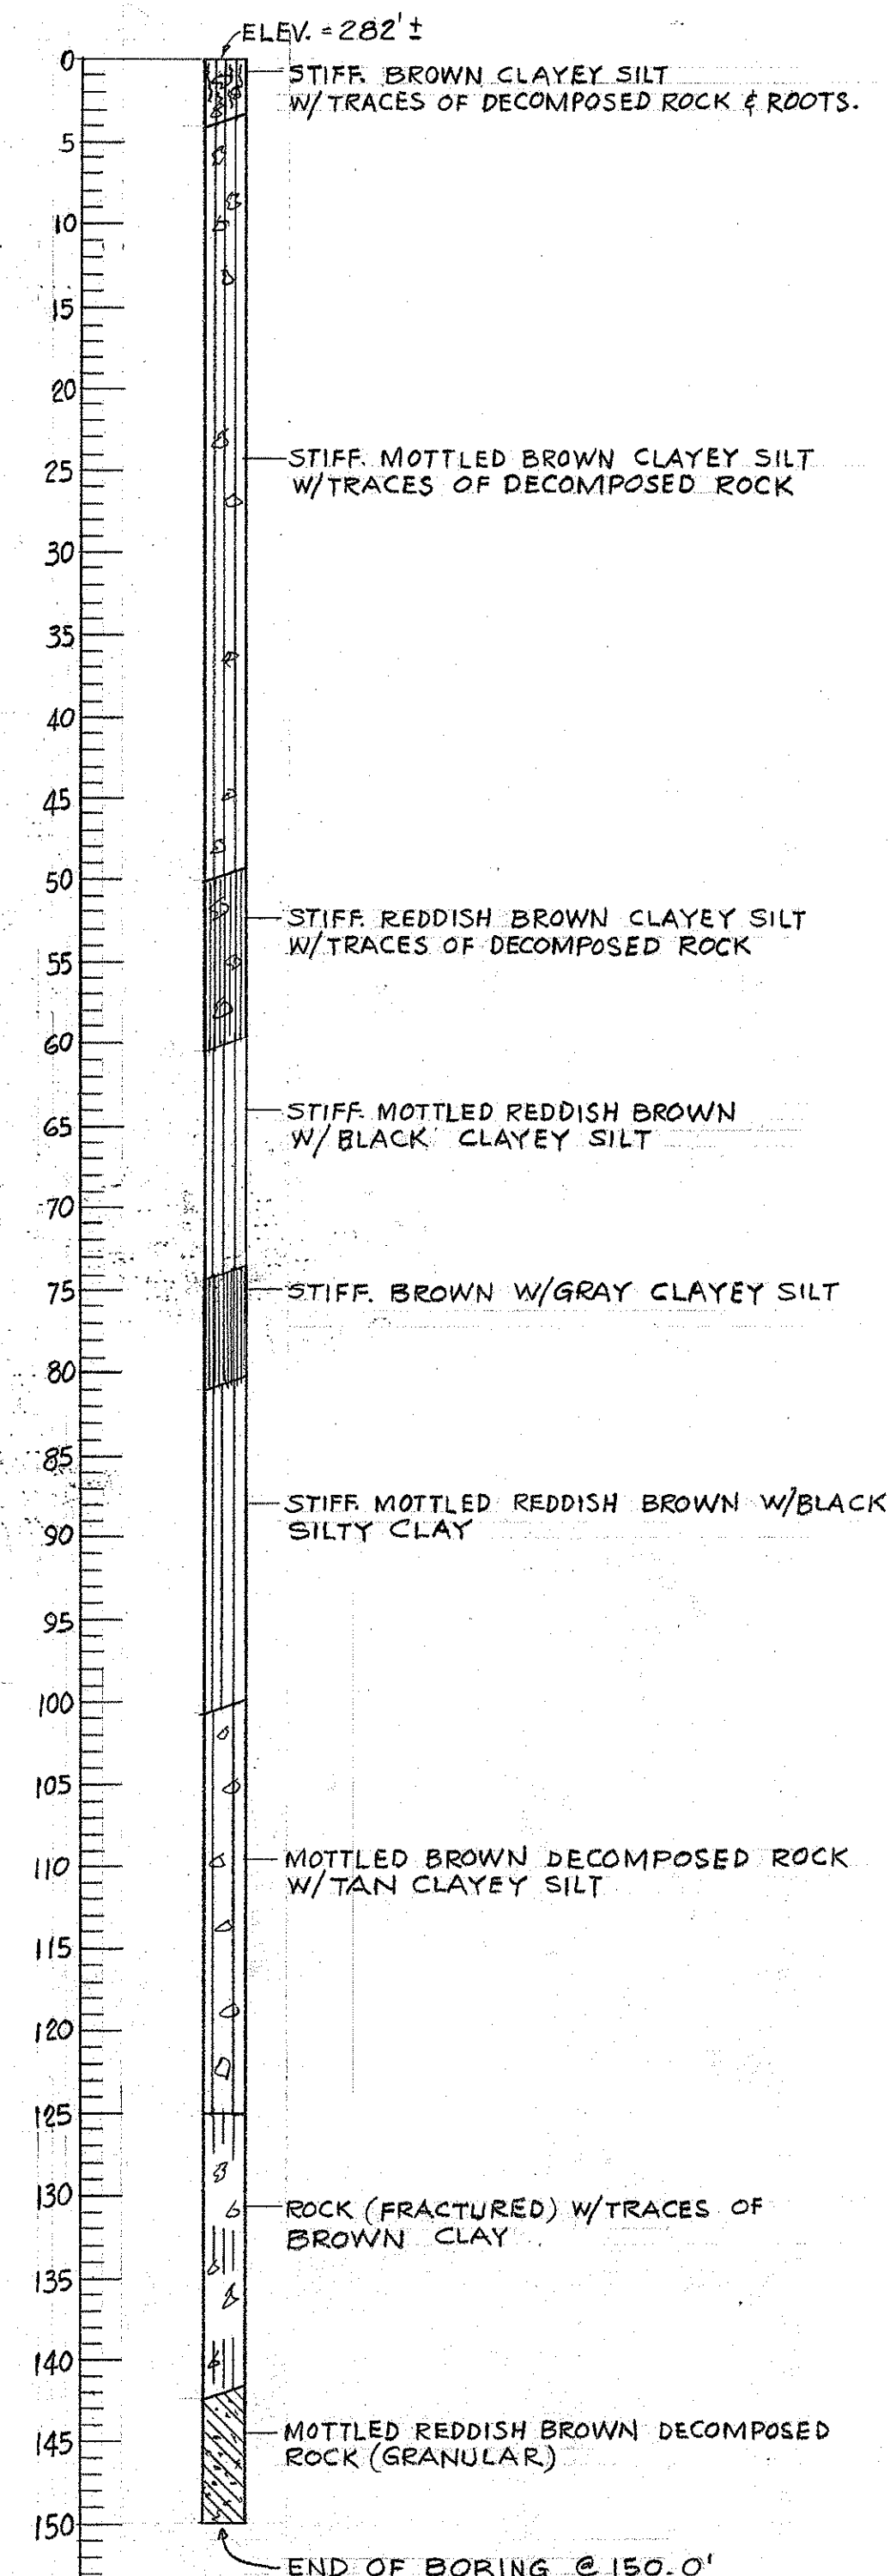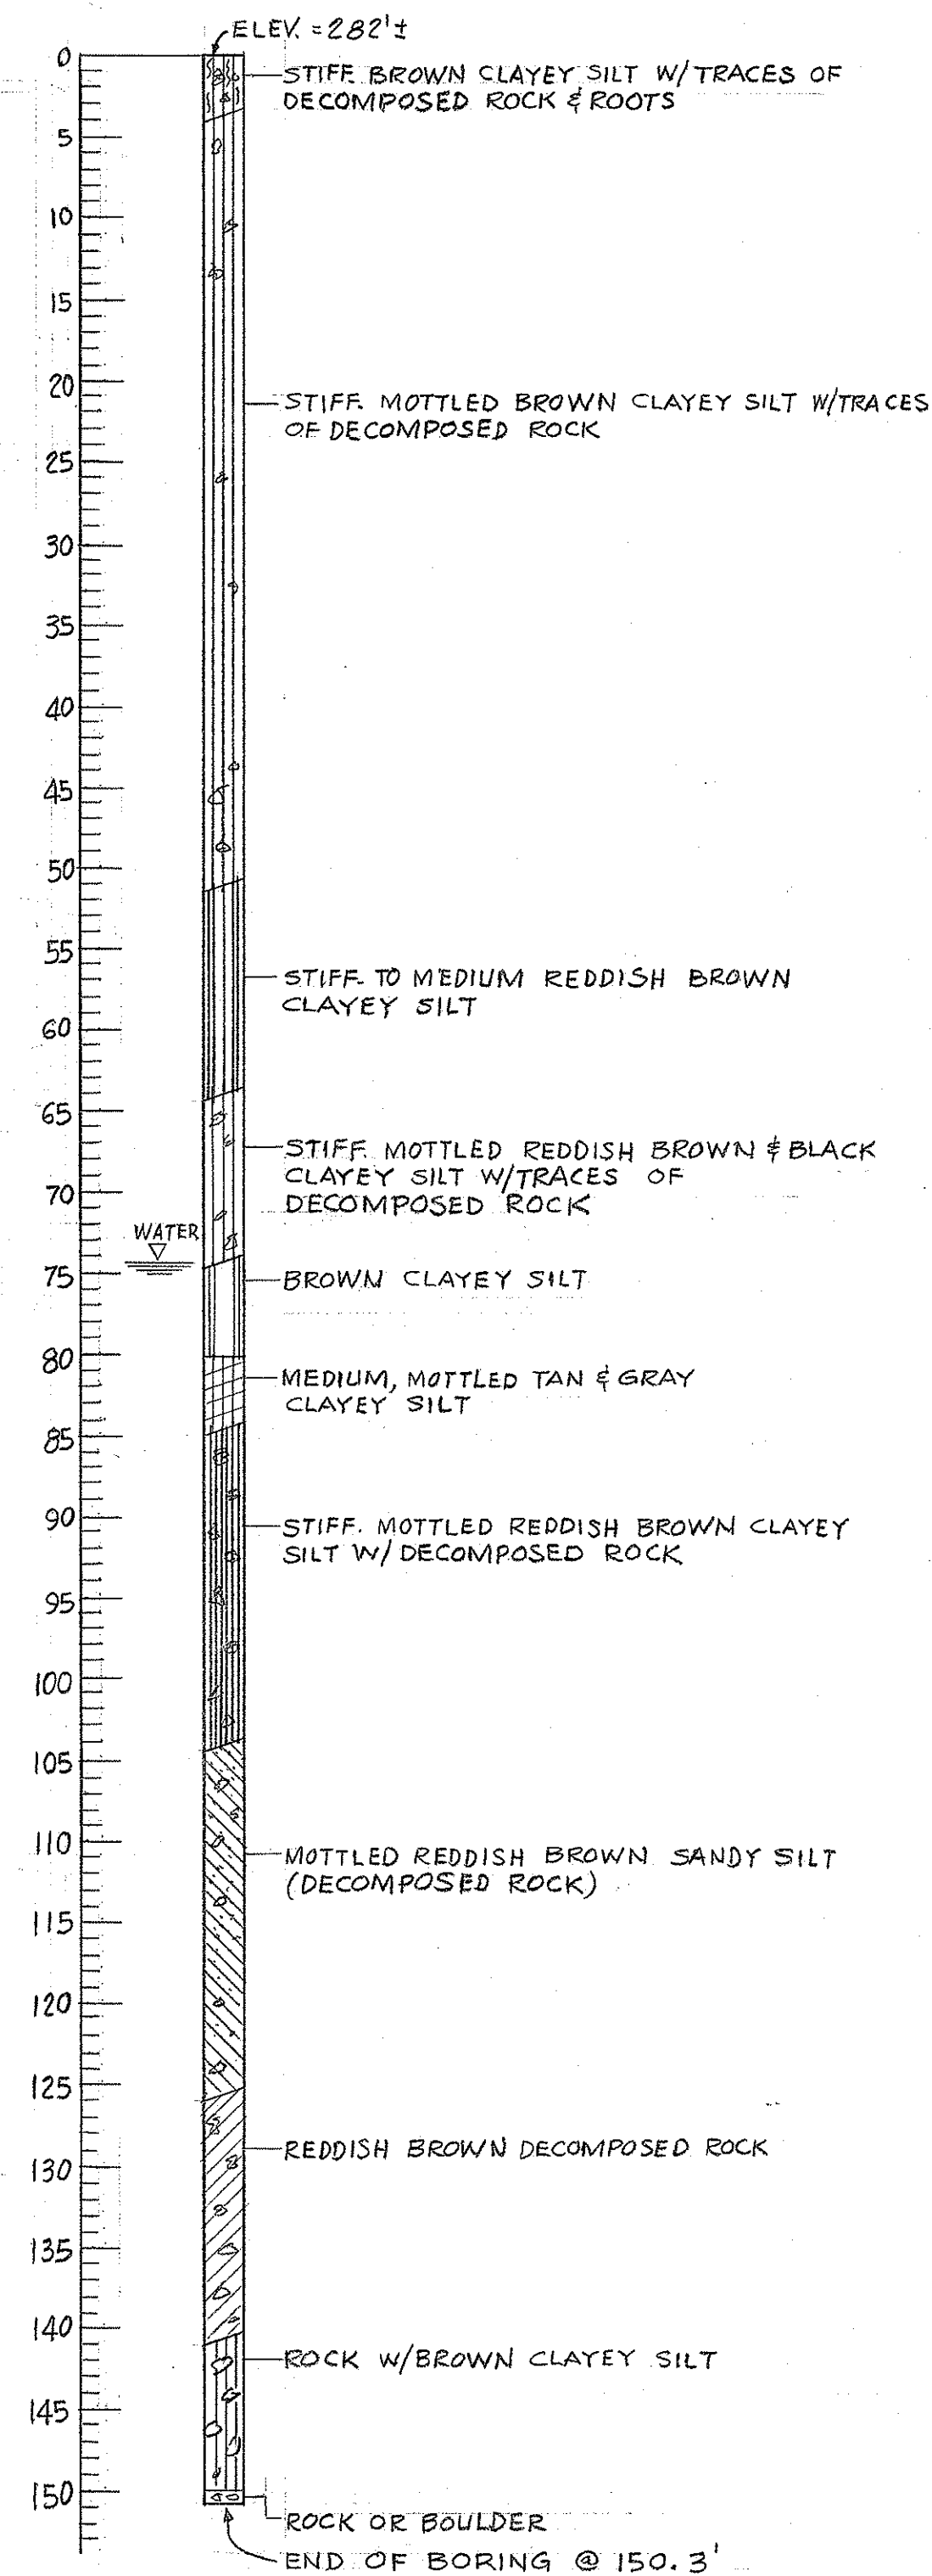BORING N^o 1BORING N^o 2BORING N^o 3

NOTE:

COMPLETE SOIL REPORT AVAILABLE
AT STATE OF HAWAII DOT MATERIALS
TESTING OFFICE.

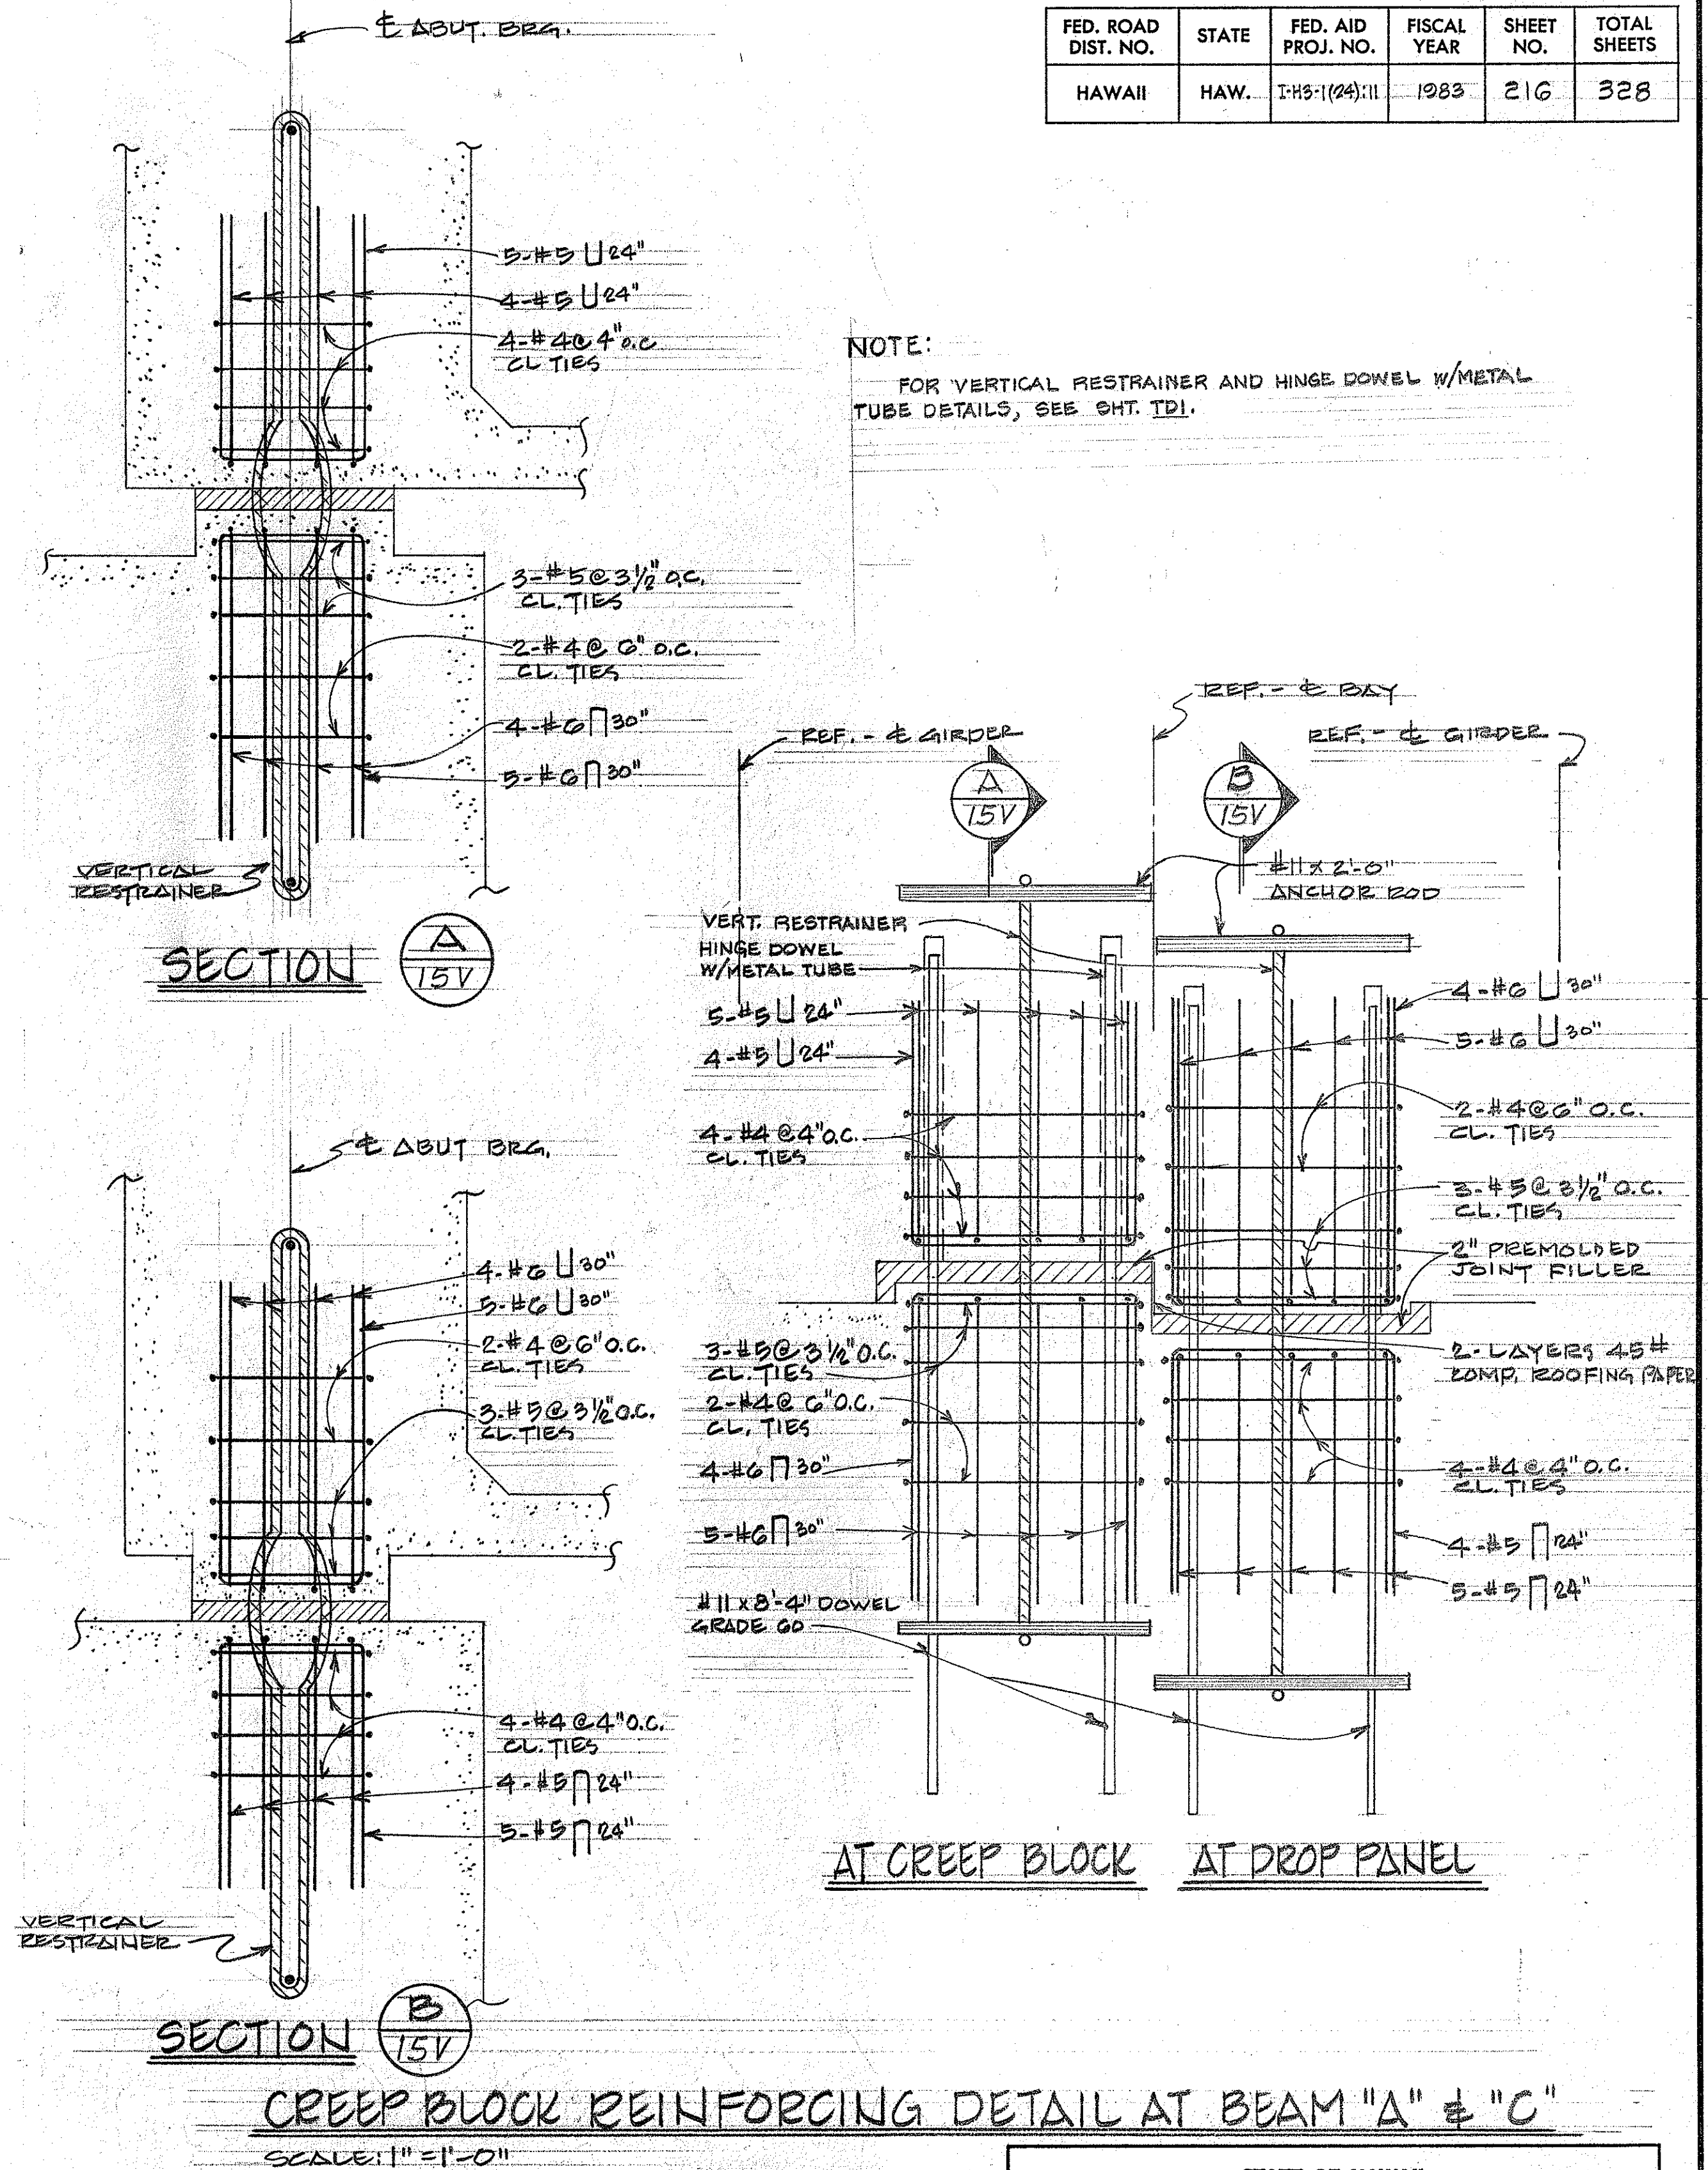

FED. ROAD DIST. NO.	STATE	FED. AID PROJ. NO.	FISCAL YEAR	SHEET NO.	TOTAL SHEETS
HAWAII	HAW.	I-H3-1(24):11	1983	216	328

DATE	BY
DESIGNED BY	CHECKED BY
NOTED BY	
ORIGINAL PLAN	
NOTE BOOK	
No.	

STATE OF HAWAII
DEPARTMENT OF TRANSPORTATION
HIGHWAYS DIVISION

BORING LOG
BRIDGE N^o 3

HALEKOU INTERCHANGE
F.A.I. Proj. No. I-H3-1(24):11

Scale: As Noted


Date: SEPT. 1982

SHEET No. 15V OF 20 SHEETS


FED. ROAD DIST. NO.	STATE	FED. AID PROJ. NO.	FISCAL YEAR	SHEET NO.	TOTAL SHEETS
HAWAII	HAW.	I-H3-1(24):11	1983	217	328

NOTES

1. Tubing shall be shop bent to fit horizontal curve when radius is less than 950 ft.
2. Post shall be normal to grade.
3. All tubes shall be spliced in the panel spanning deck expansion joints. Increase joint width between tube to 1 1/2" and increase sleeve length by 1" (See Tube Splice Det.)
4. Tubing shall be continuous over not less than 3 posts except as noted on plans.
5. All exposed corner of metal railing shall be ground smooth.
6. Rail assemblage shall be galvanized after fabrication.
7. All anchor bolts, bolts, nuts, plates and washers shall be galvanized.
8. Welding shall meet the requirement of Section 501 of the Standard Specification.
9. Material shall conform to the following requirements:
 - a. Tubular steel rails ASTM A500 Grade B.
 - b. Steel posts ASTM A36.
 - c. Sleeves for tubular rails ASTM A36.
 - d. Stud bolts ASTM A108 Grades 1015 to 1020.
 - e. Anchor bolts, bolts, nuts and washers ASTM A325.
 - f. Shims commercial quality galvanized steel.
 - g. Sleeve bolts and nuts ASTM A108 Grades 1015 to 1020.

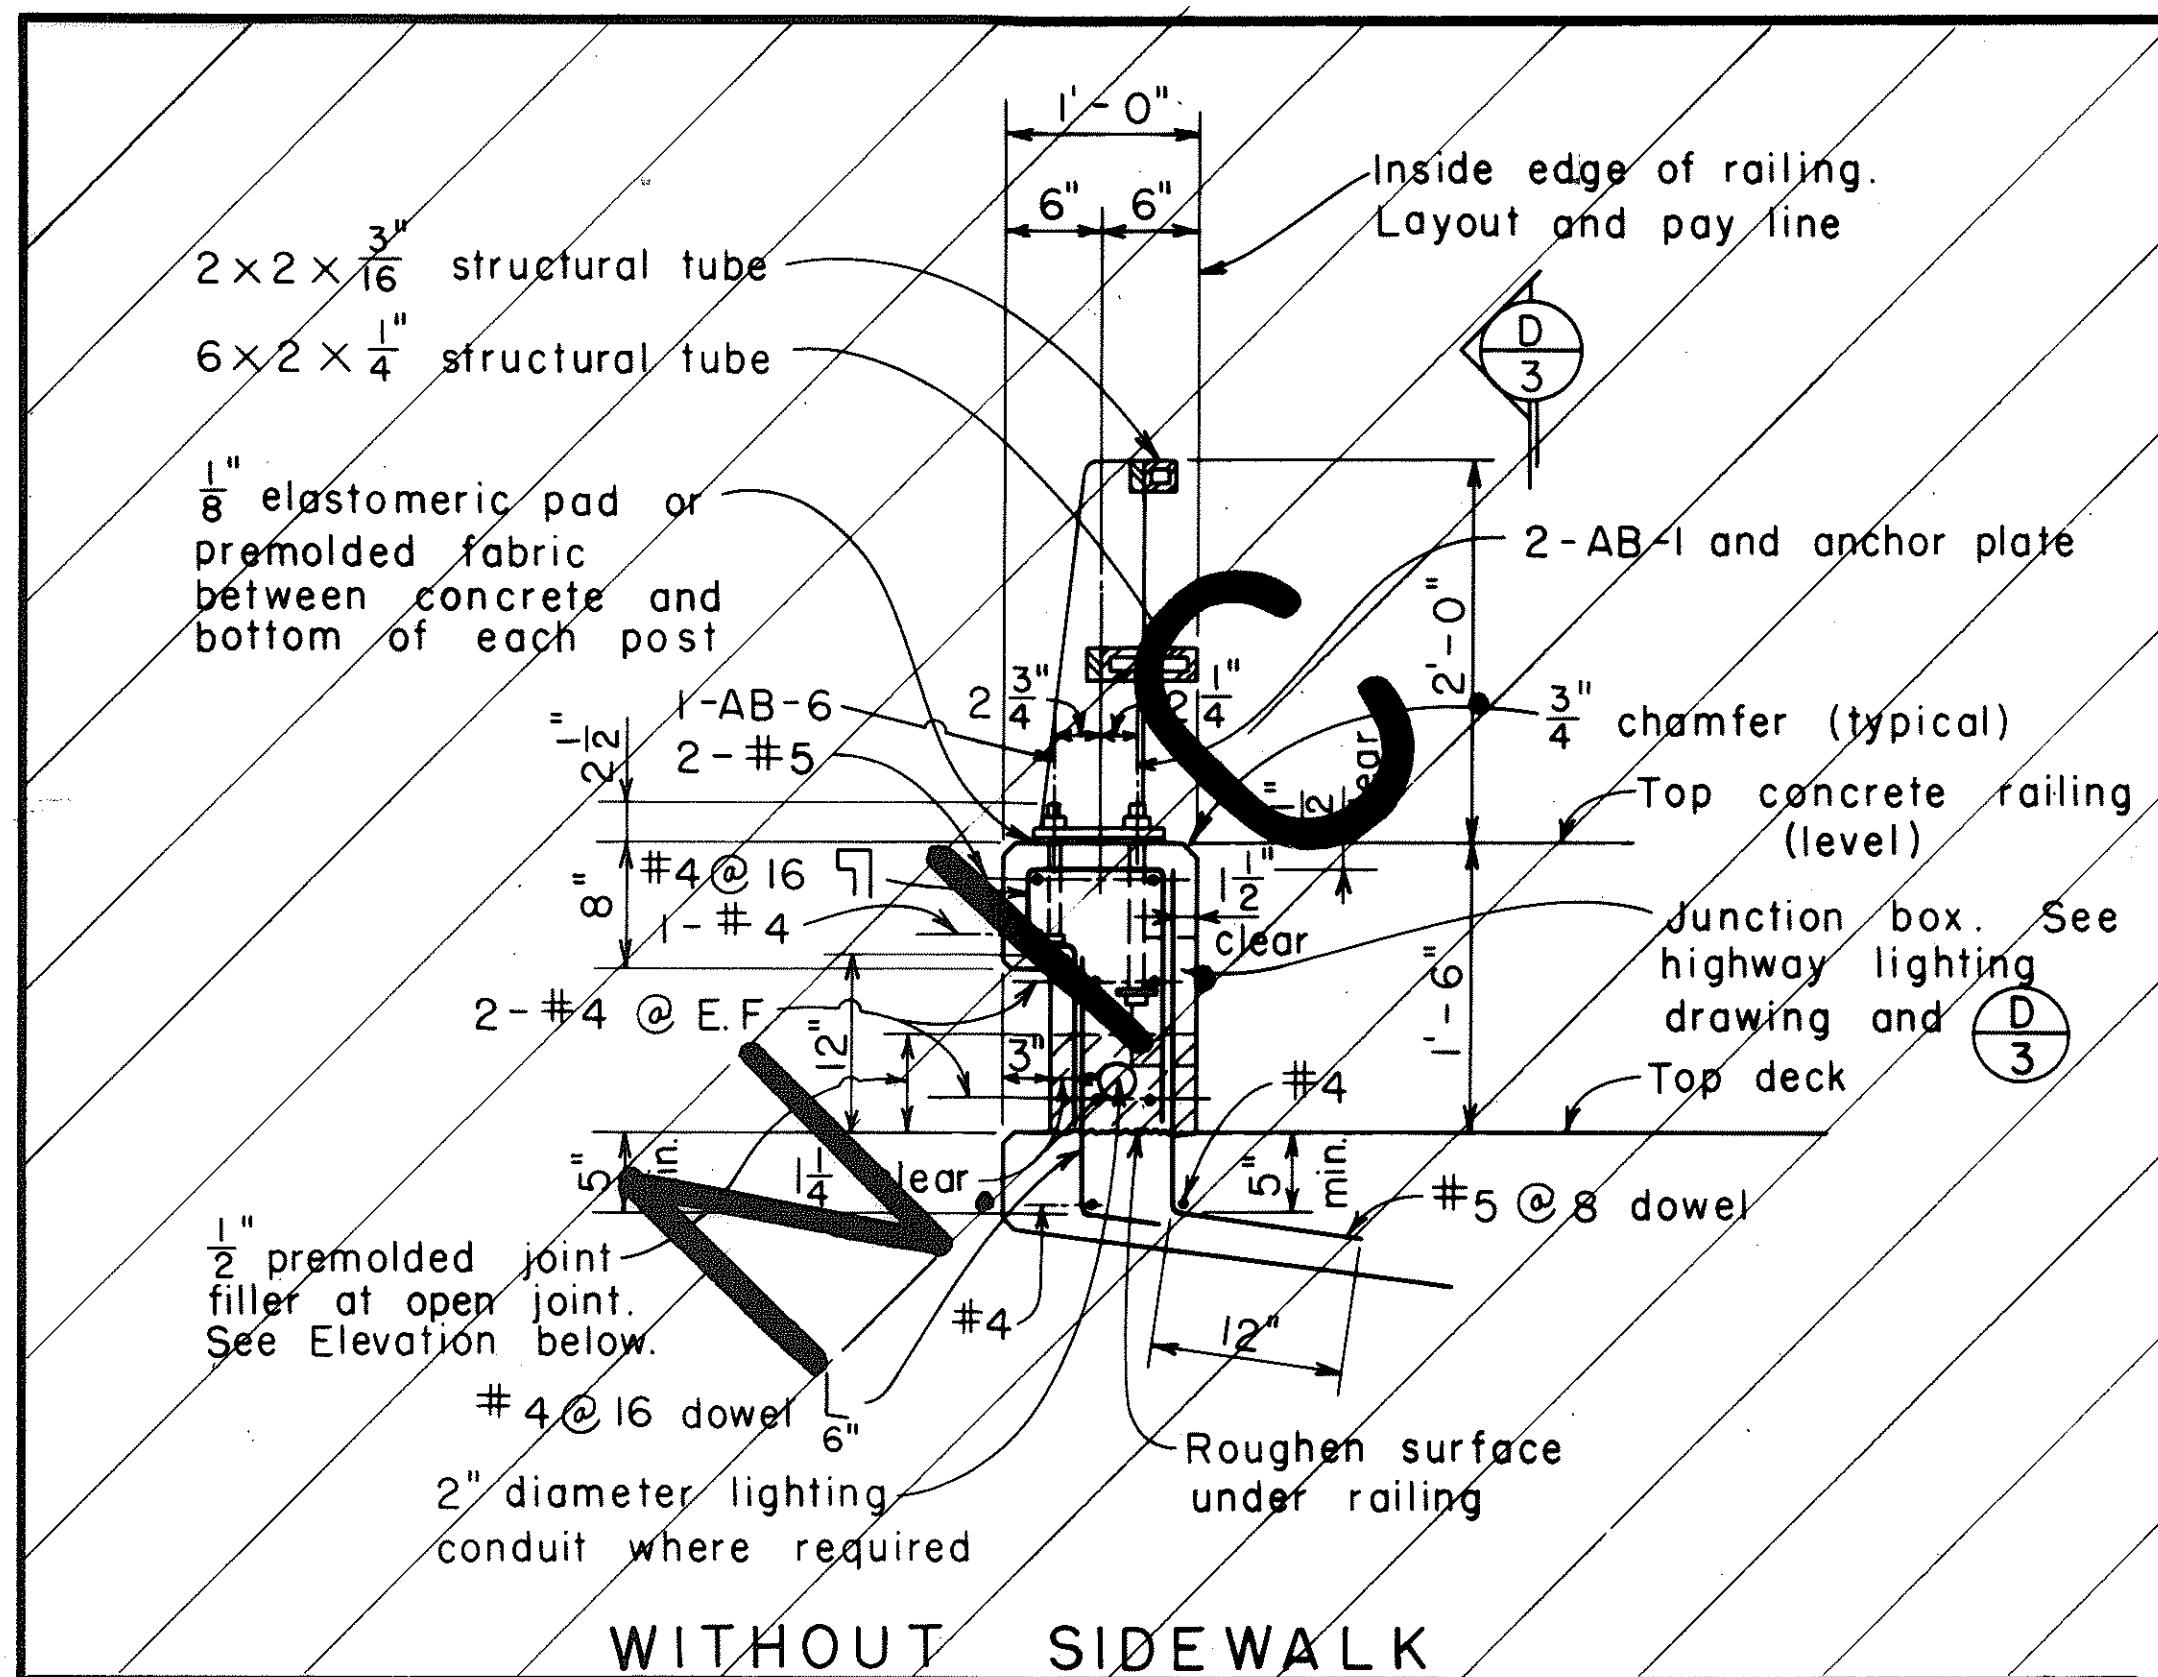


WITHOUT SIDEWALK

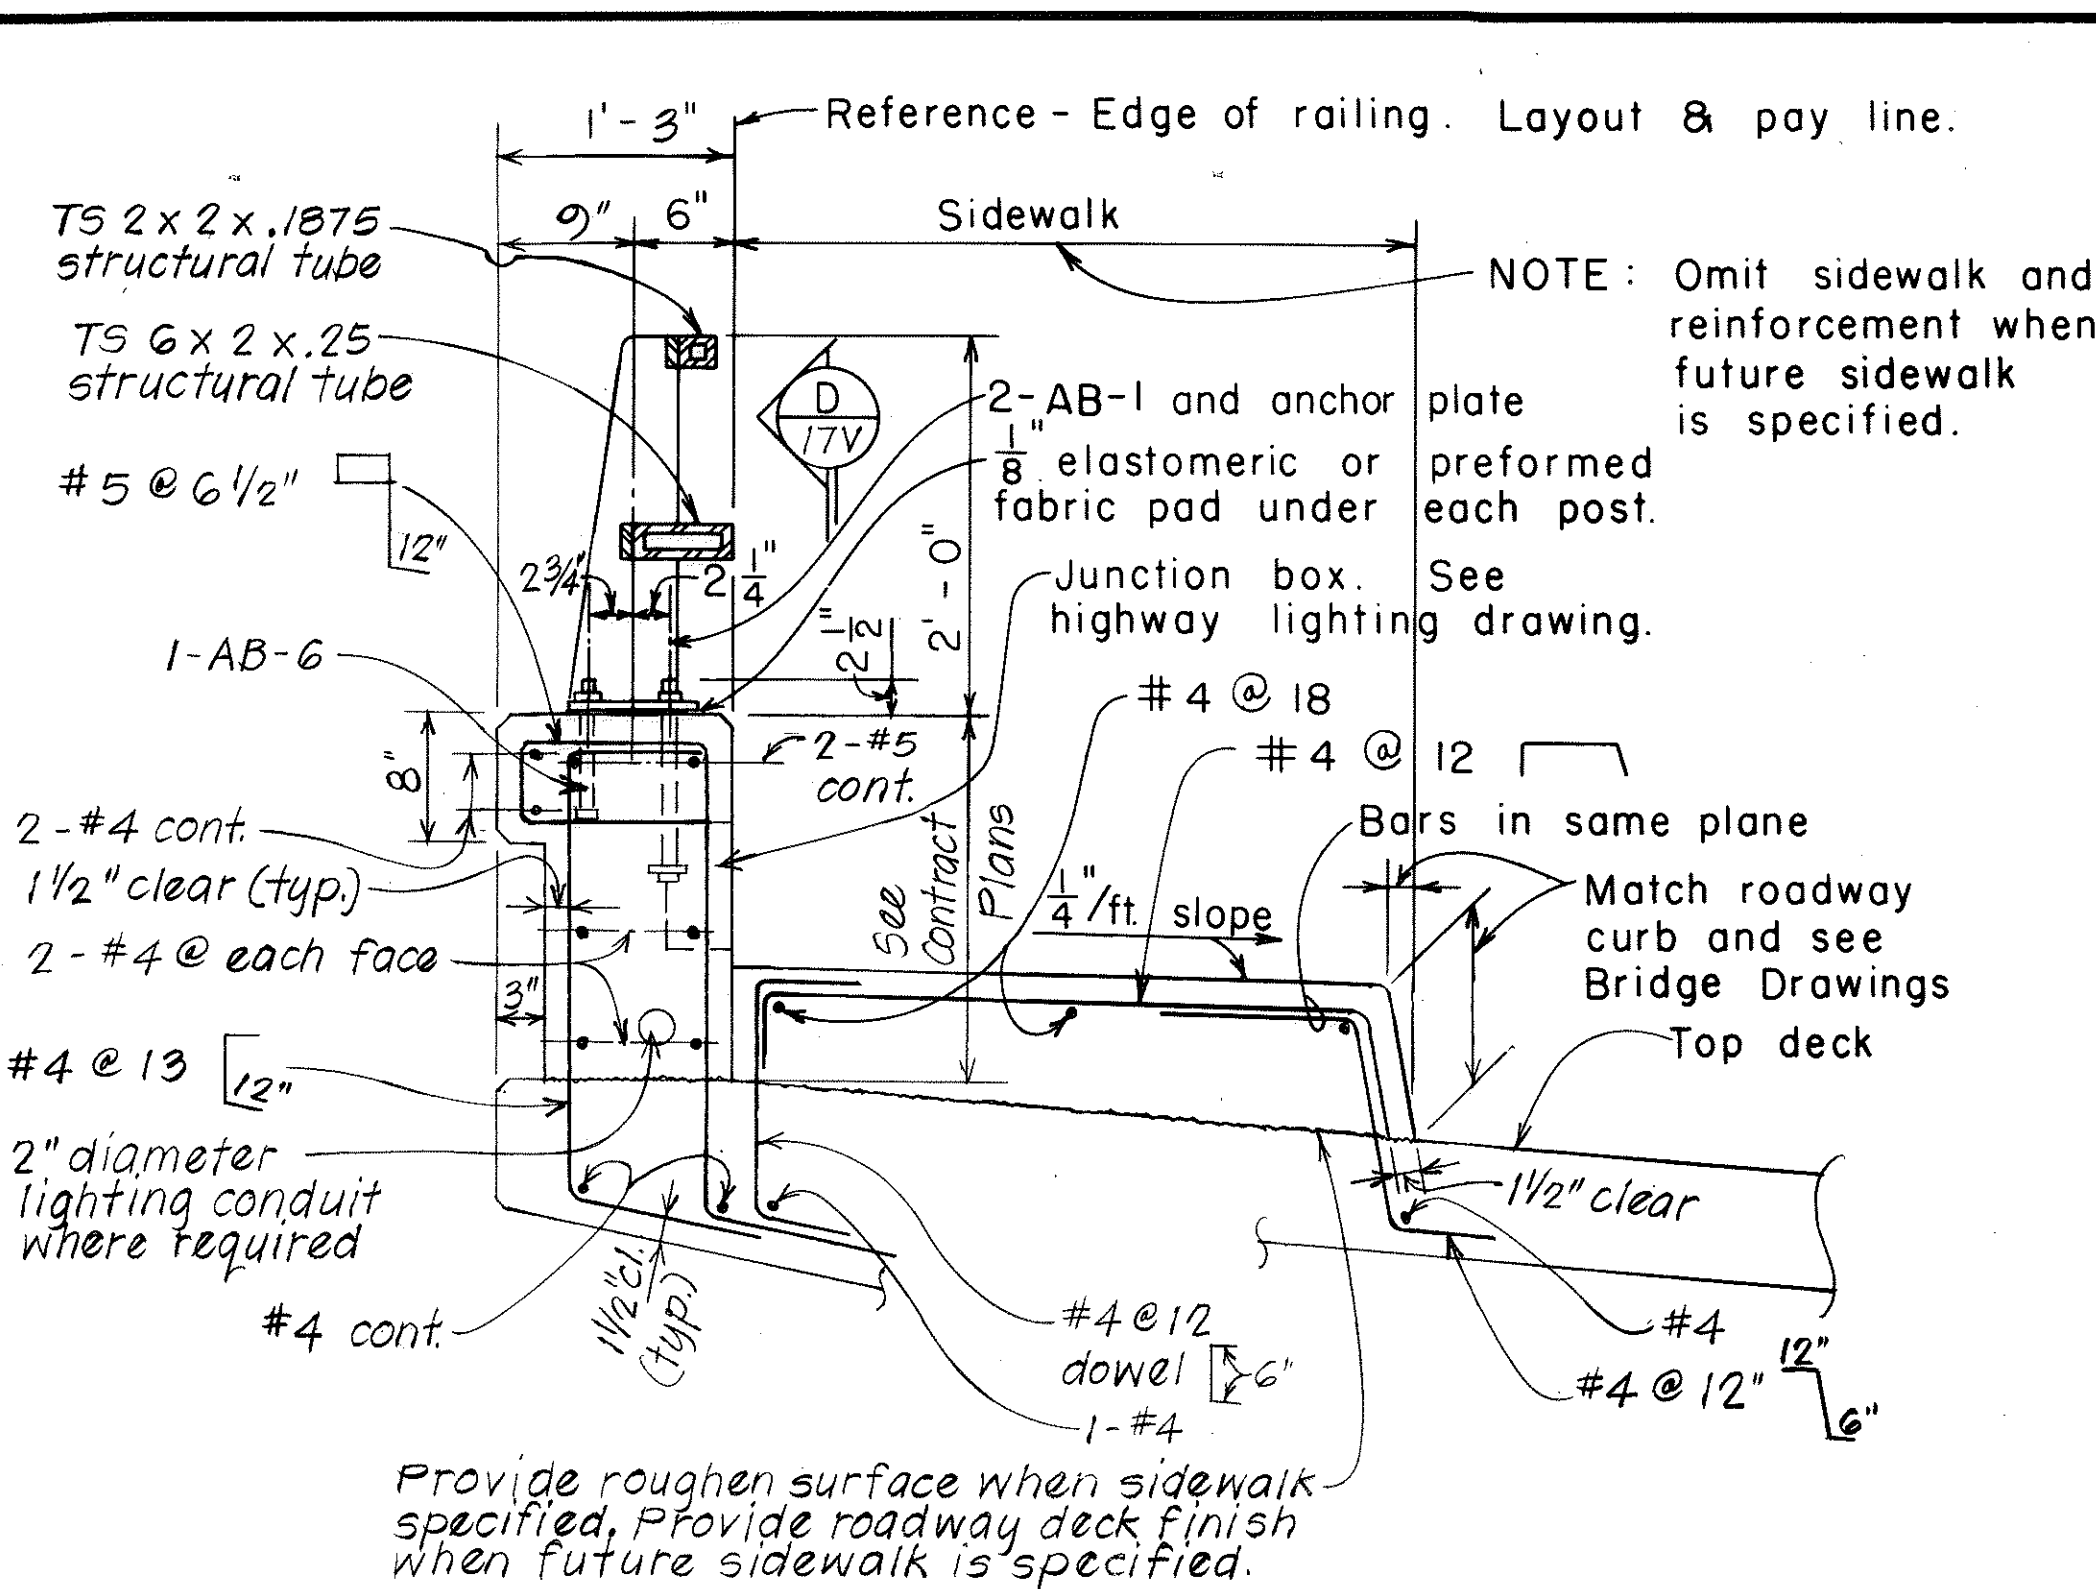

WITH SIDEWALK OR FUTURE SIDEWALK

TYPICAL SECTION

Scale: 1" = 1'-0"

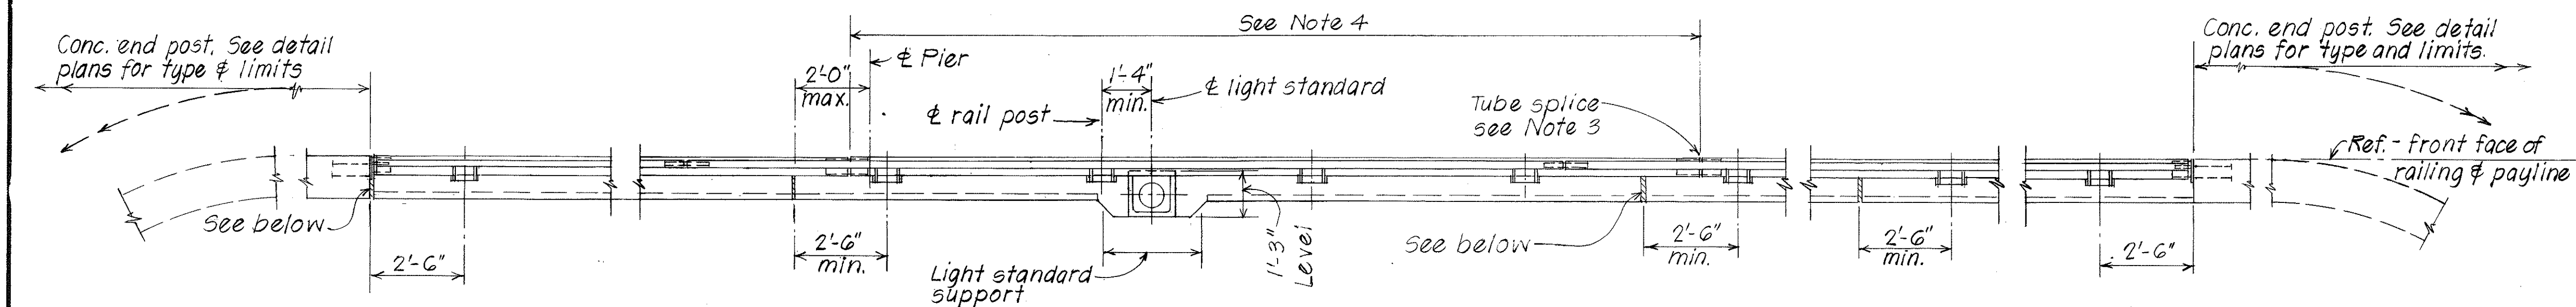


AT BRIDGE END POST

INTERMEDIATE RAILING PLAN

Scale: 3/8" = 1'-0"

AT RETAINING WALL OR WING WALL END POST

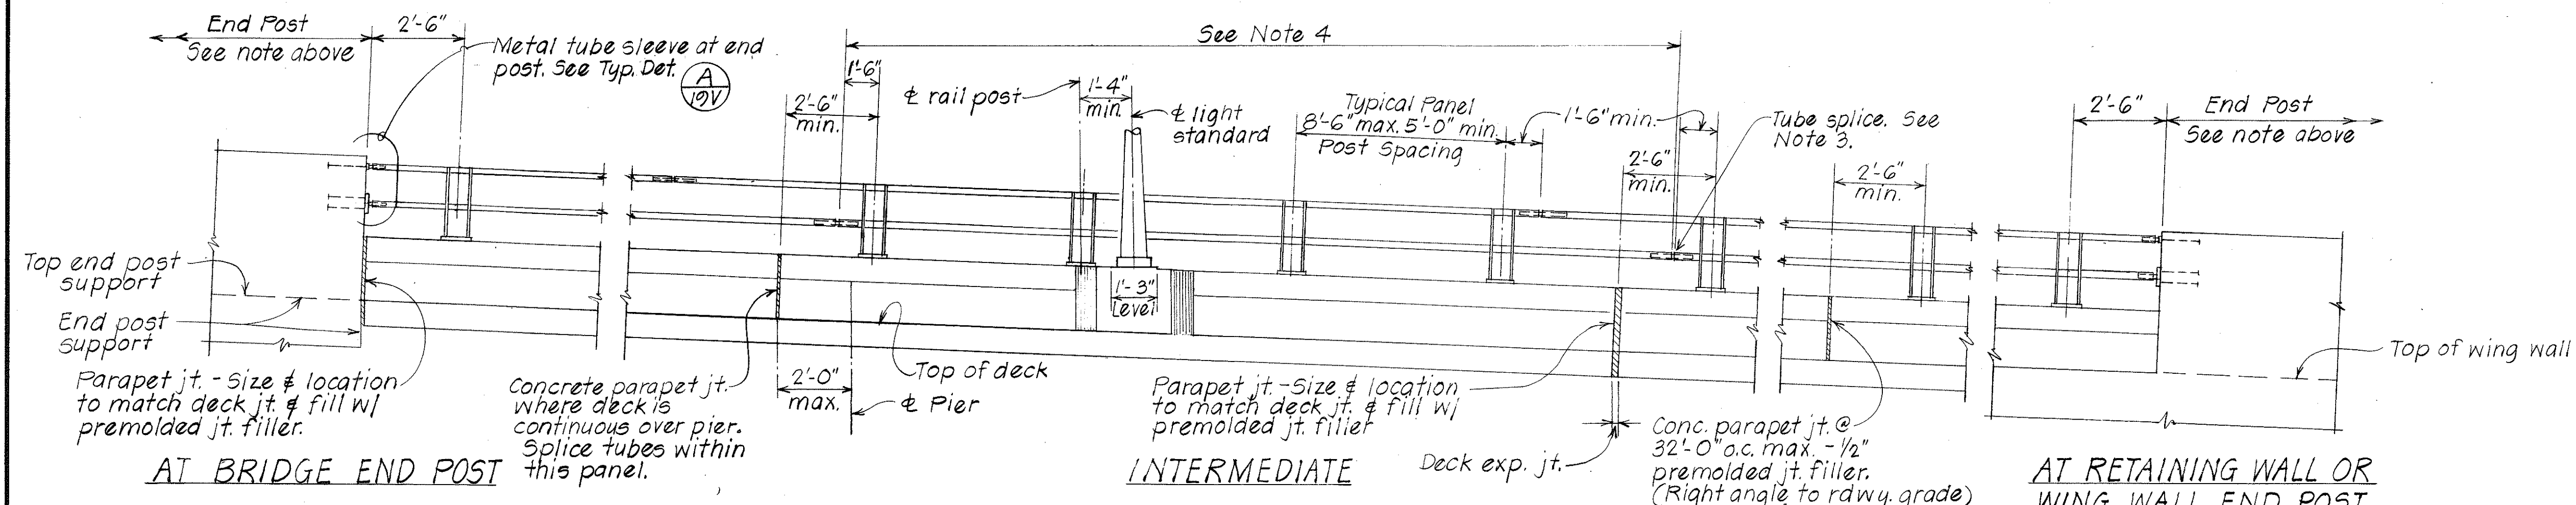

AT BRIDGE END POST


EXTERIOR RAILING ELEVATION

Scale: 3/8" = 1'-0"

AT RETAINING WALL OR WING WALL END POST


STATE OF HAWAII DEPARTMENT OF TRANSPORTATION HIGHWAYS DIVISION	
STEEL BRIDGE RAILING (TUBULAR) TWO RAIL COMBINATION TYPE ON PARAPET	
BRIDGE NO. 3 HALEKOU INTERCHANGE F.A.I. Proj. No. I-H3-1(24):11	
Scale: As Noted	Date: Sept. 1982
SHEET No. 16 V OF 20 SHEETS	

FED. ROAD DIST. NO.	STATE	FED. AID PROJ. NO.	FISCAL YEAR	SHEET NO.	TOTAL SHEETS
HAWAII	HAW.	I-H3-1(24)-11	1983	218	328

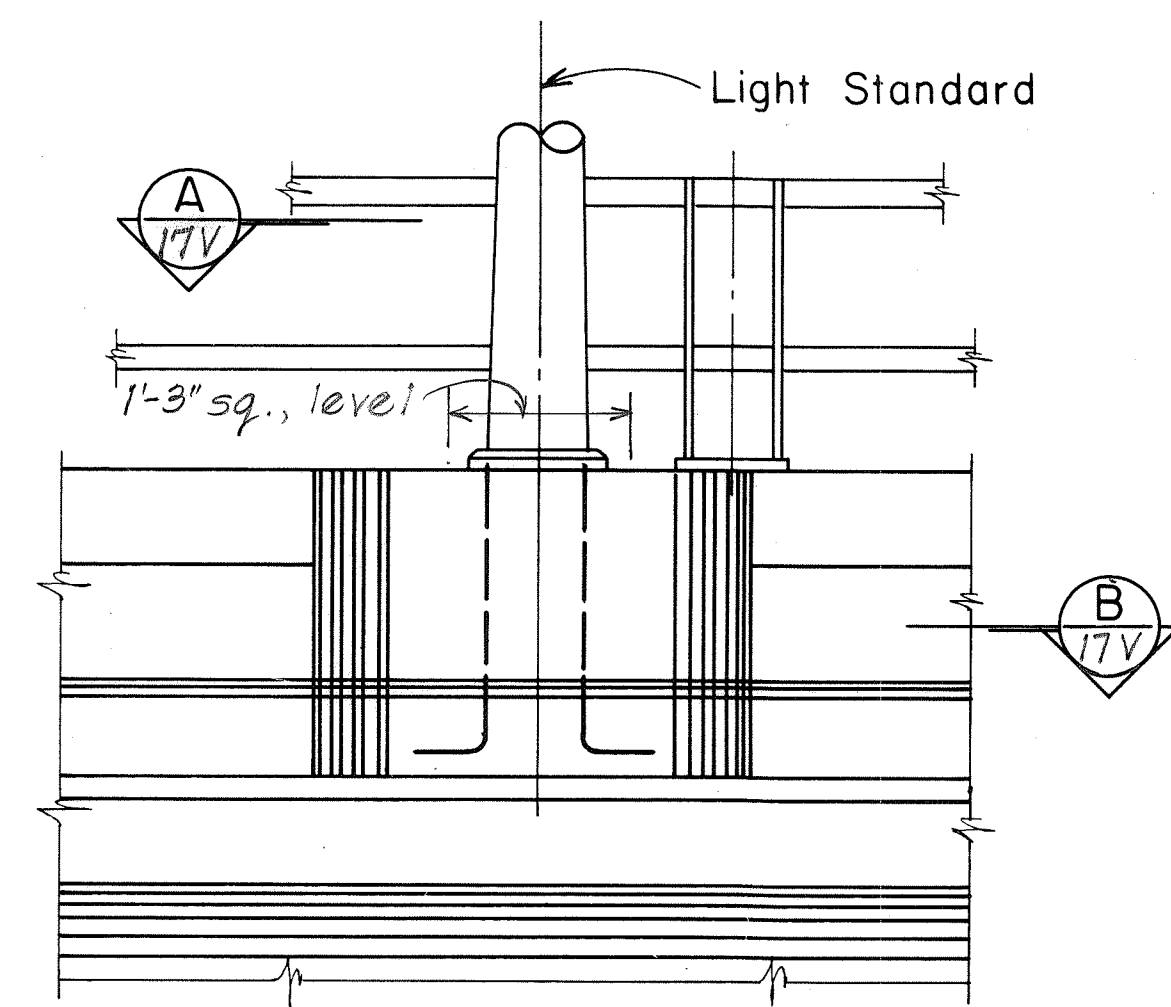


EXTERIOR ELEVATION

Scale : $\frac{3}{4}'' = 1' - 0''$

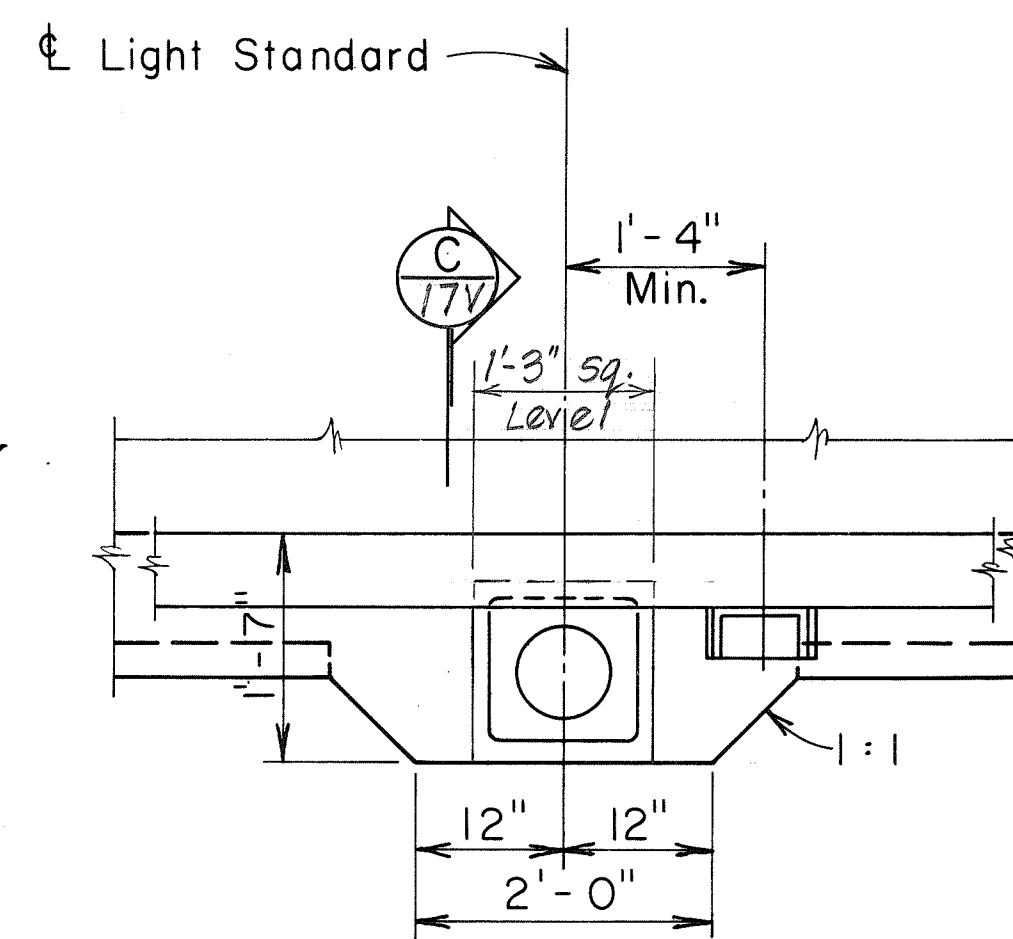

PLAN

Scale : $\frac{3}{4}'' = 1' - 0''$

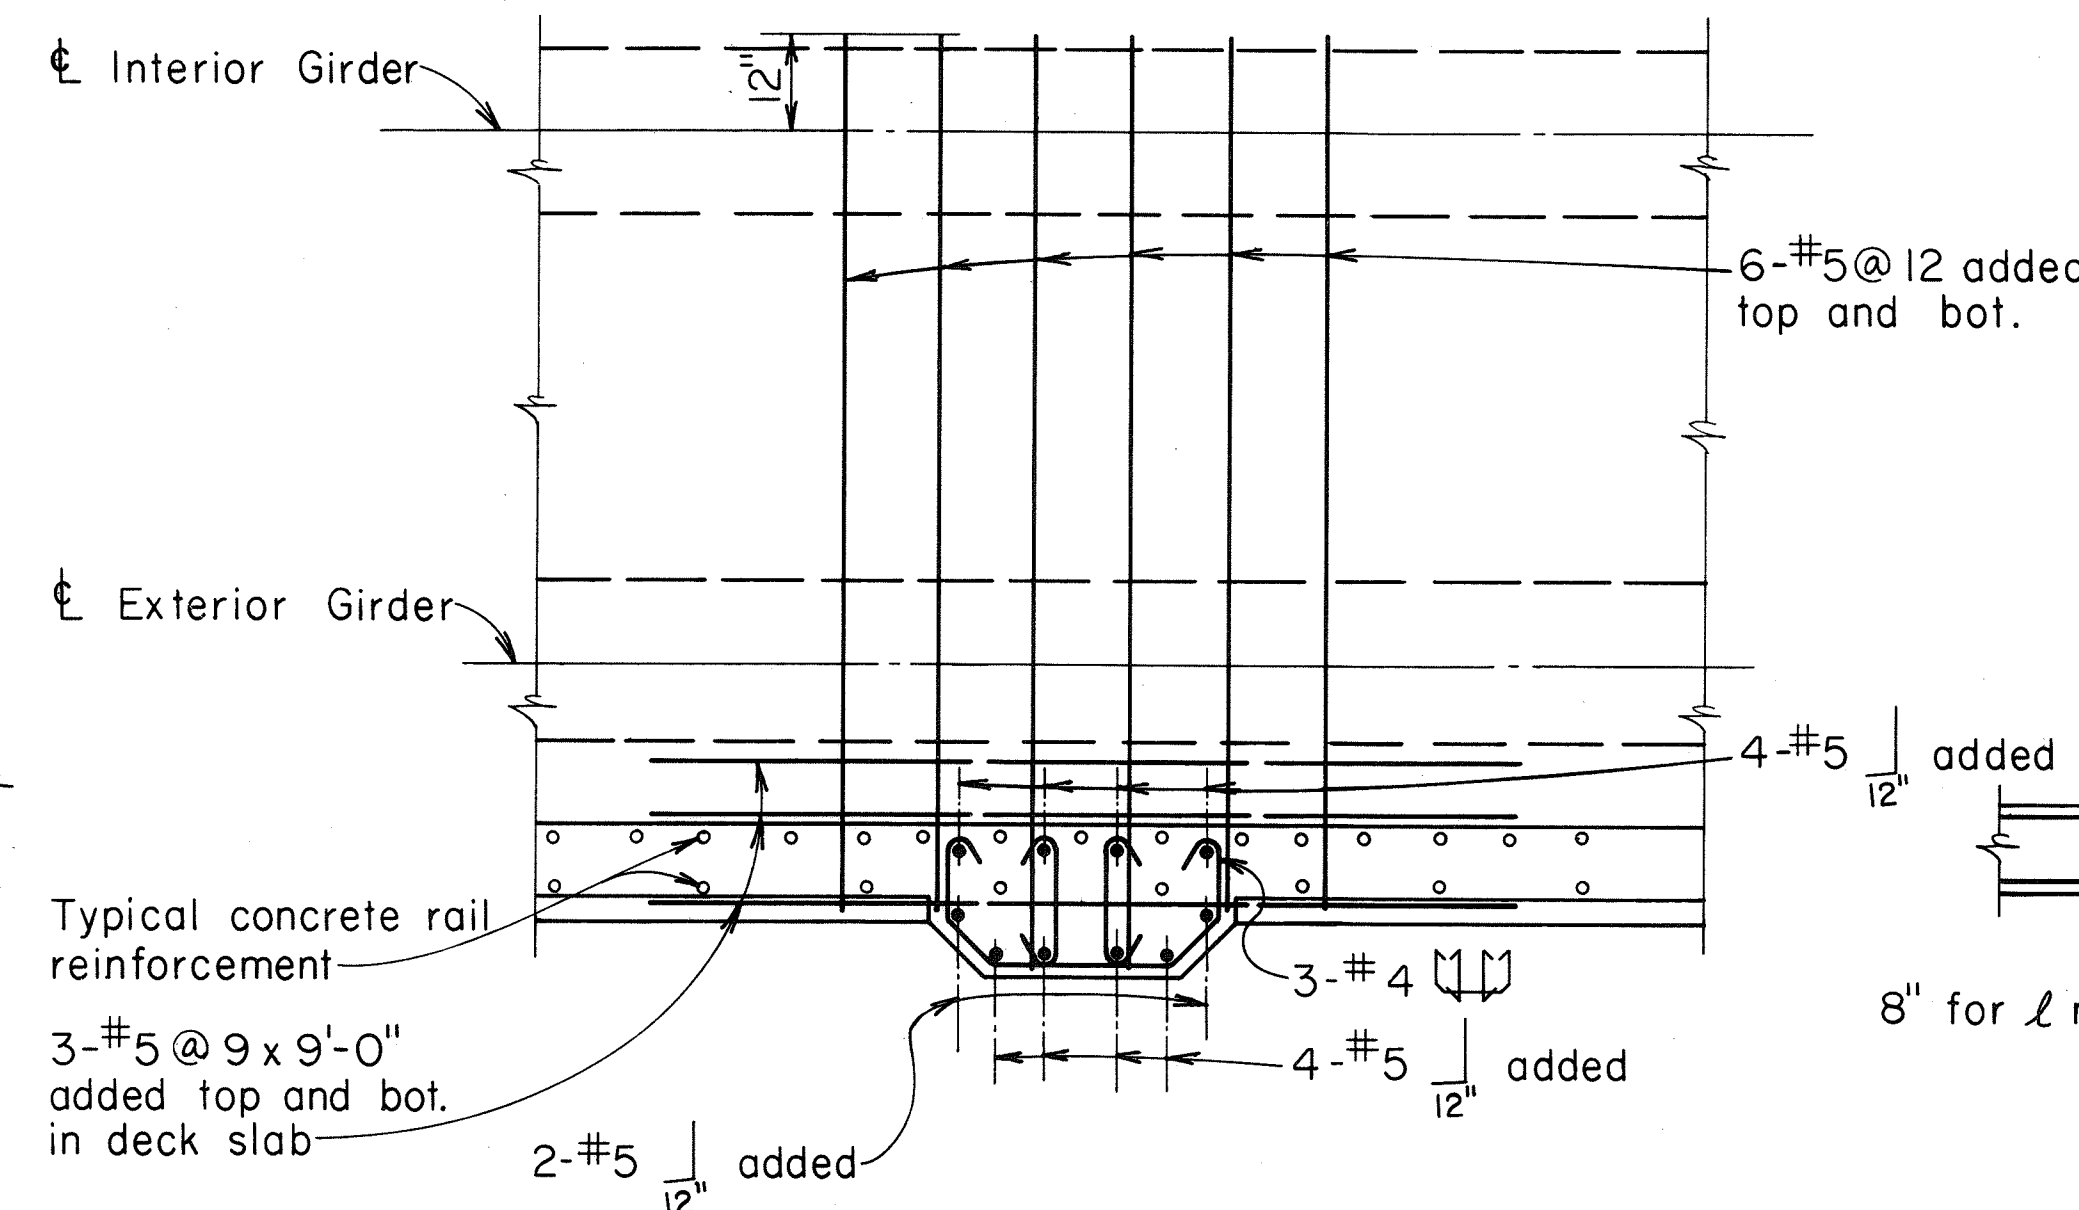


SECTION

Scale : $\frac{1}{2}'' = 1' - 0''$


DETAILS AT LIGHT STANDARD

Scale : As Noted

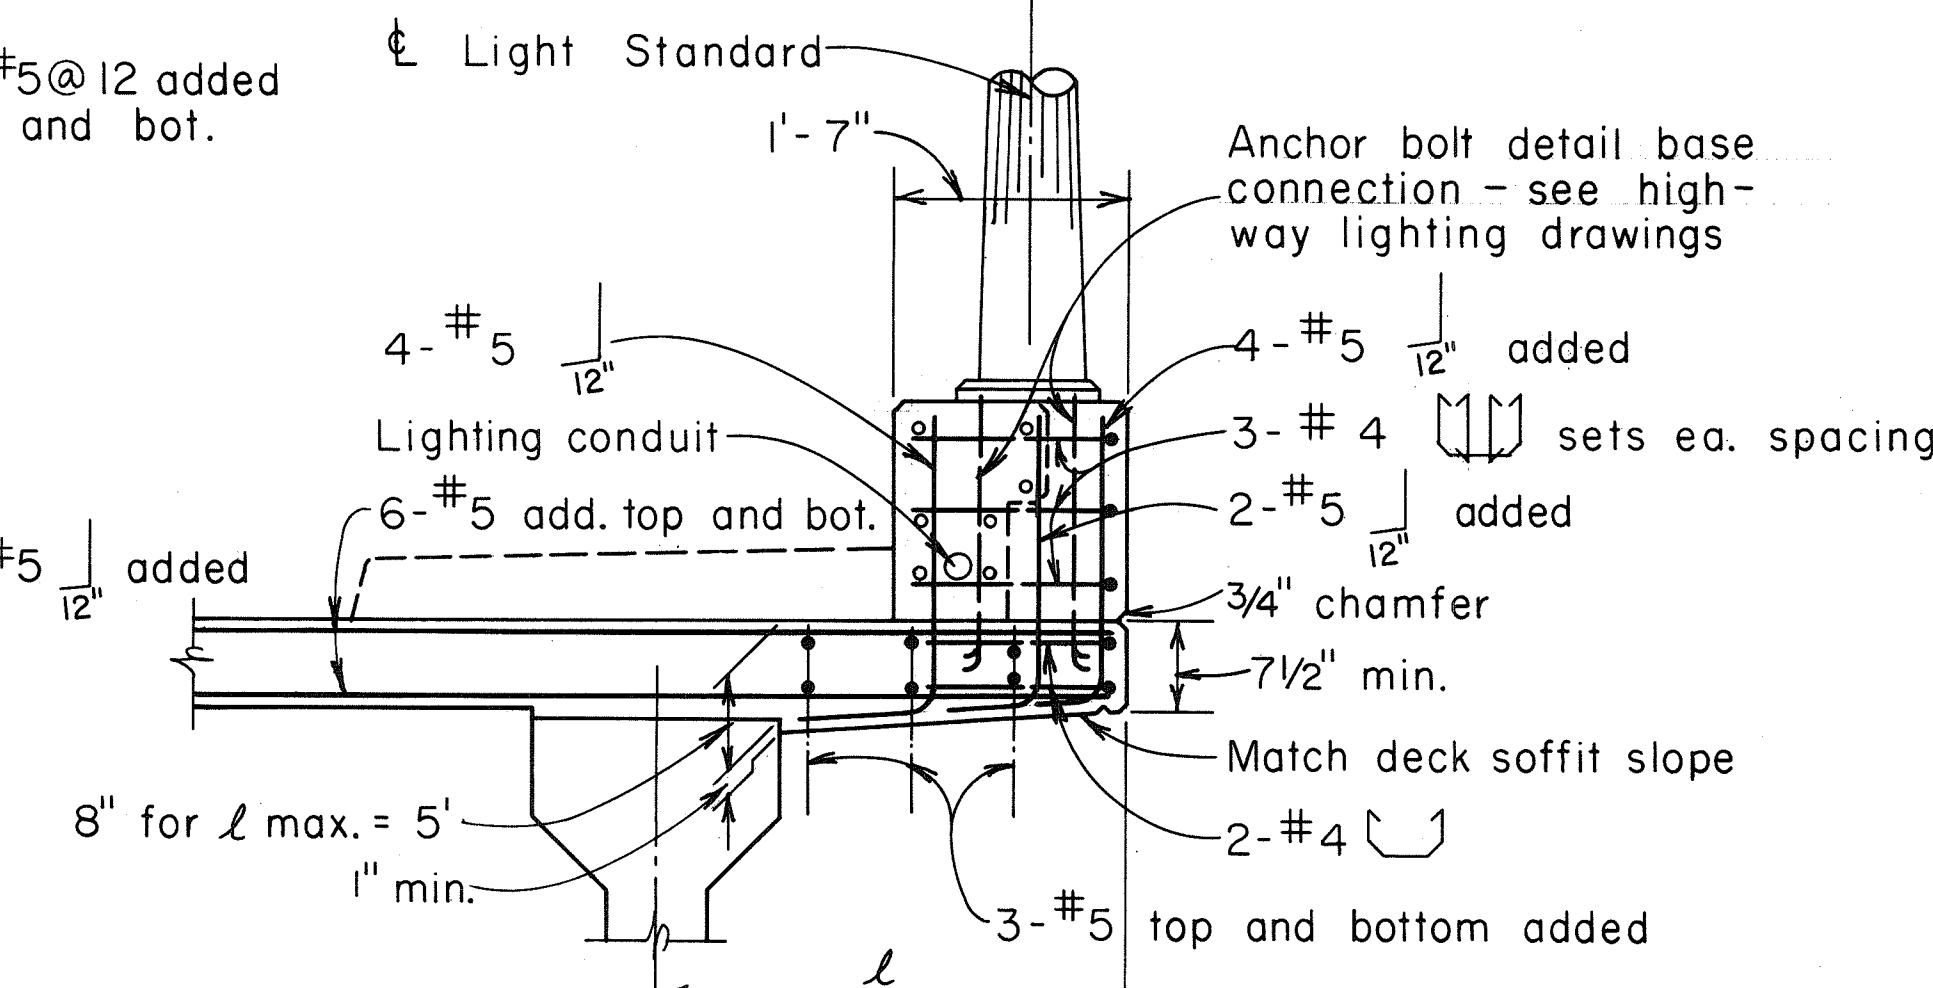

SECTION


Scale : $\frac{3}{4}'' = 1' - 0''$

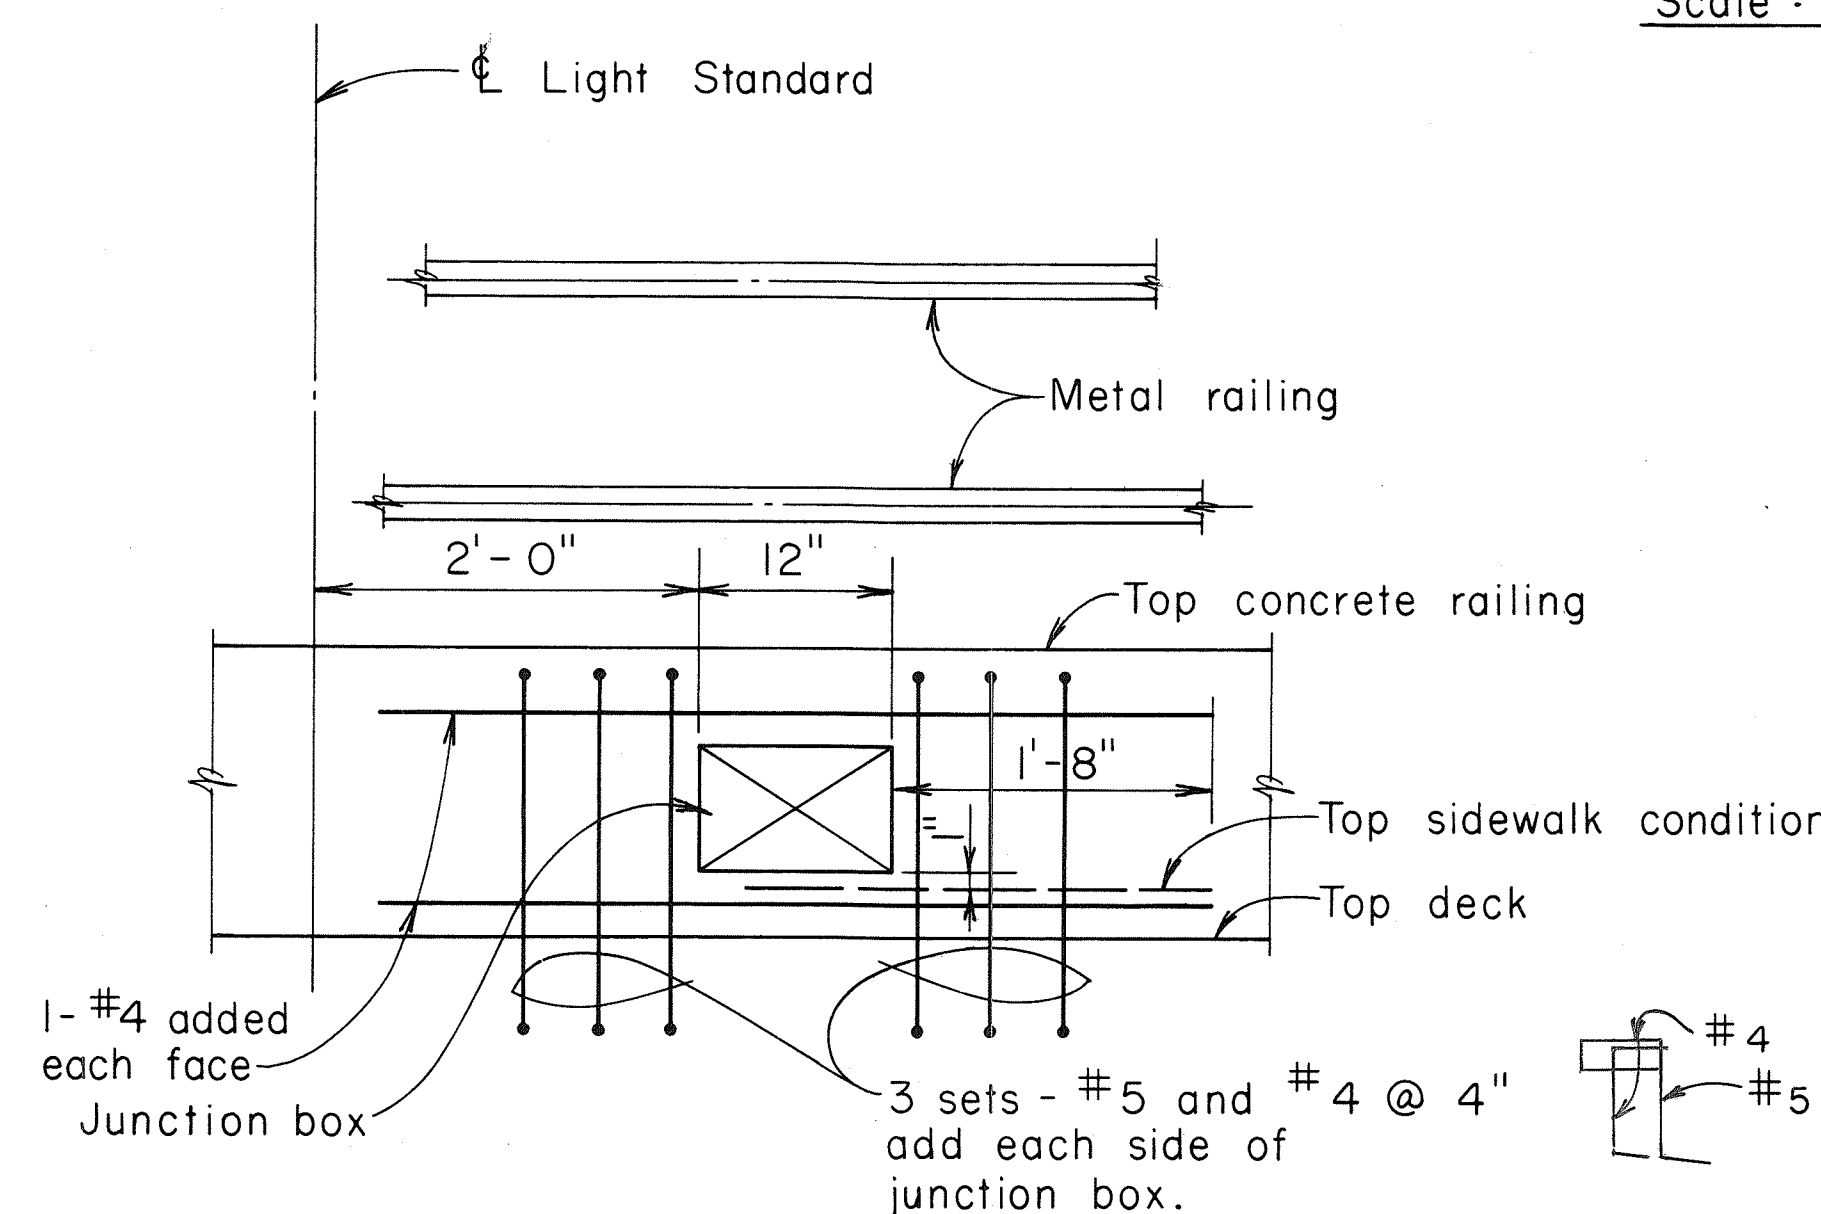

ELEVATION

REINFORCEMENT AT JUNCTION BOX

Scale : $1'' = 1' - 0''$

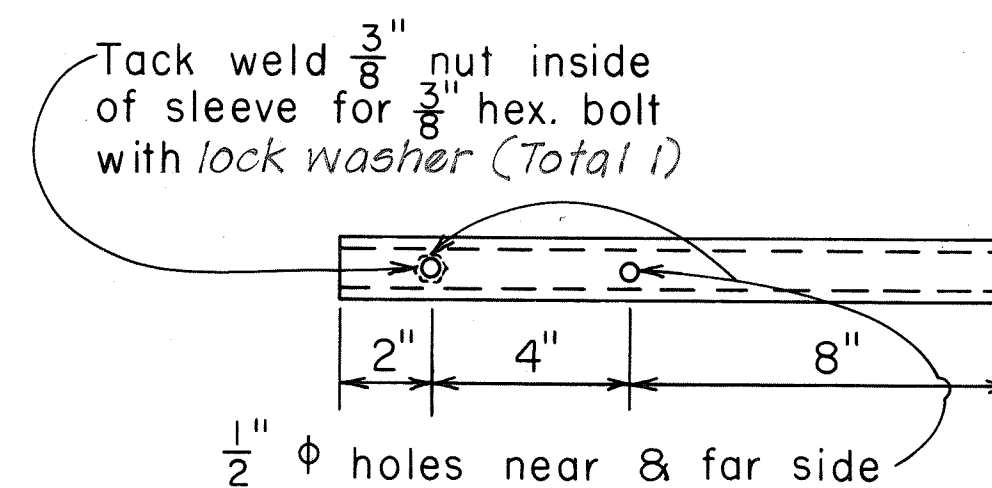


Sleeve formed of $\frac{3}{16}''$ PL, bent thus : for sliding fit inside of rail tube.


SLEEVE

6 x 2 TUBE SPLICE DETAILS


Scale : $3'' = 1' - 0''$

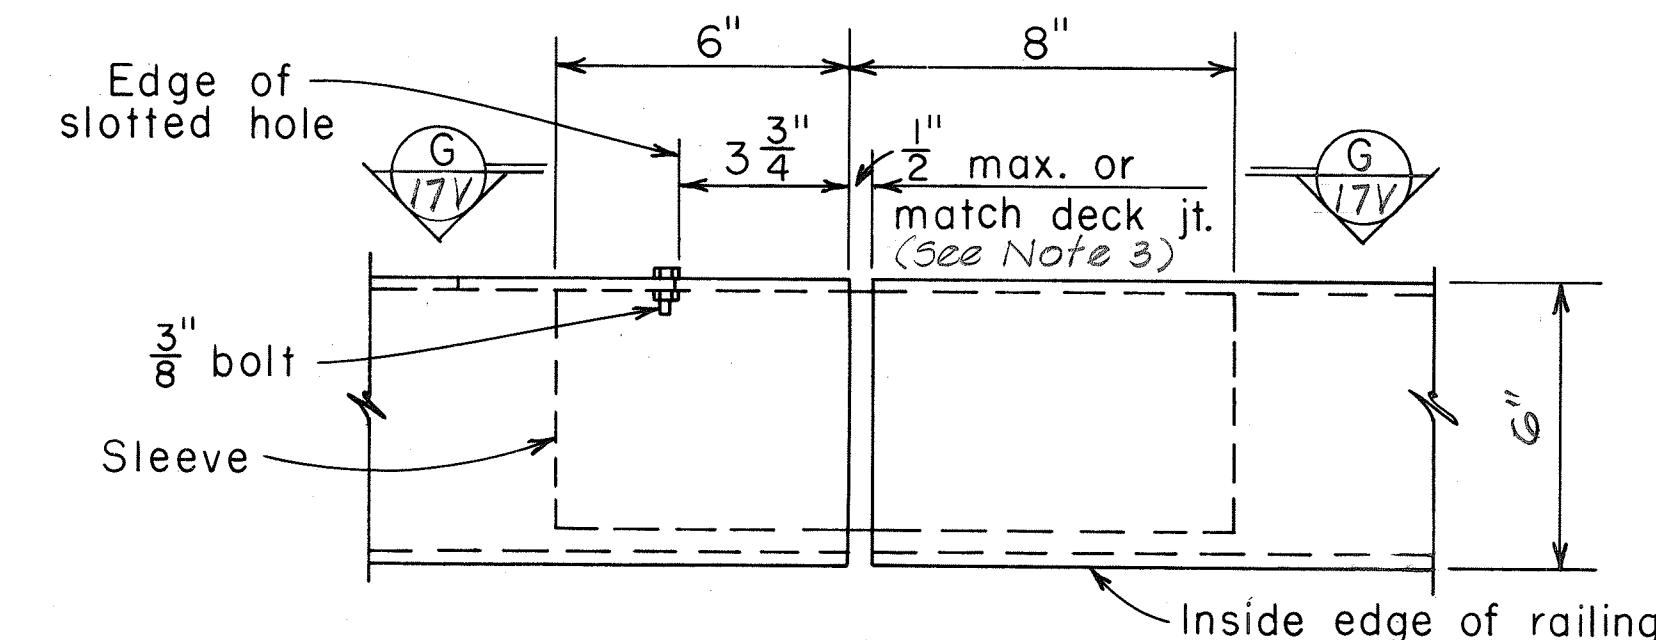

PLAN

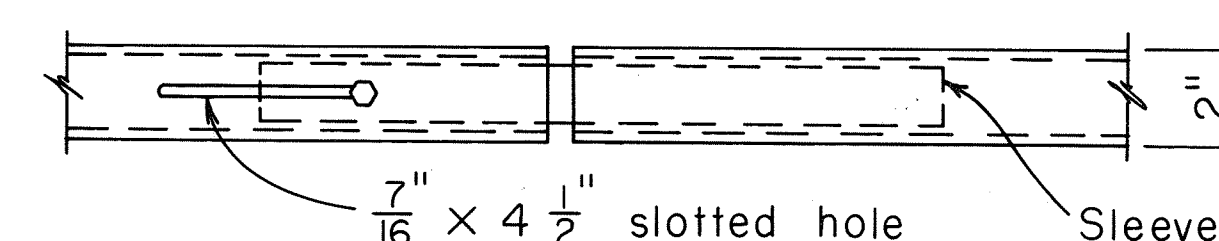

VIEW

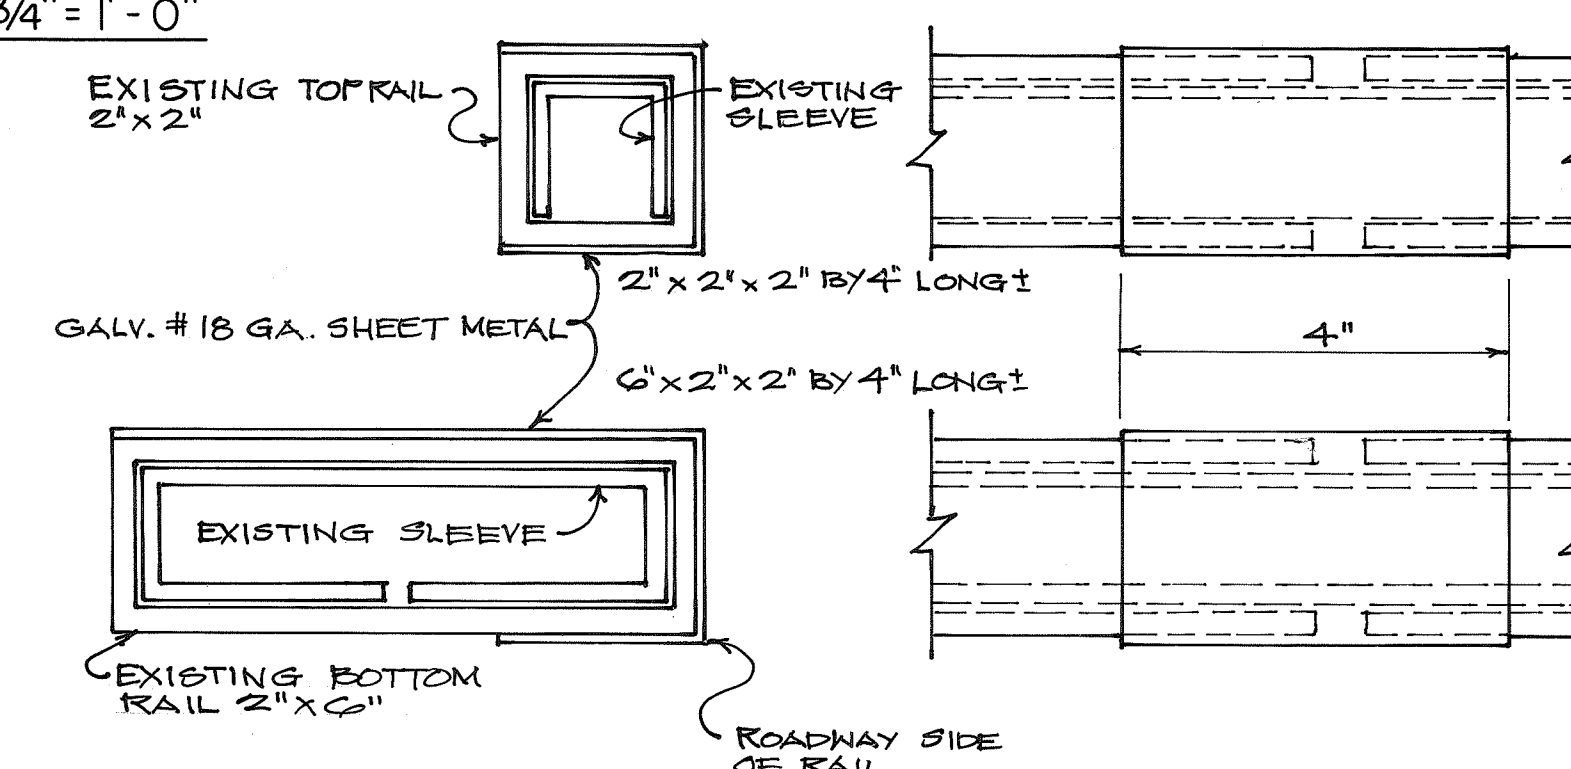

NOTE : # 18 GA. SHEET METAL COVER
1. GALVANIZED AFTER FABRICATION
2. TO BE ATTACHED TO ONE END OF RAIL ONLY WITH EPOXY
(CALLS FOR EXPANSION/CONTRACTION OF RAIL ELEMENTS)

TUBULAR STEEL BRIDGE RAILING CORRECTION DETAIL @ RAIL JOINT SPICE

FM # 3-80








STATE OF HAWAII
DEPARTMENT OF TRANSPORTATION
HIGHWAYS DIVISION
STEEL BRIDGE RAILING (TUBULAR)
TWO RAIL COMBINATION TYPE ON PARAPET
BRIDGE NO. 3
HALEKOU INTERCHANGE
F.A.I. Proj. No. I-H3-1(24)-11
Scale : As Noted Date : Sept. 1982
SHEET No. 17V OF 20 SHEETS

"AS-BUILT"

218

DATE	
SURVEY PLOTTED BY	
DESIGNED BY	
QUANTITIES BY	
CHECKED BY	
ORIGINAL PLAN	
NOTE BOOK	
No.	

FED. ROAD DIST. NO.	STATE	FED. AID PROJ. NO.	FISCAL YEAR	SHEET NO.	TOTAL SHEETS
HAWAII	HAW.	I-H3-1(24)	1983	219	328

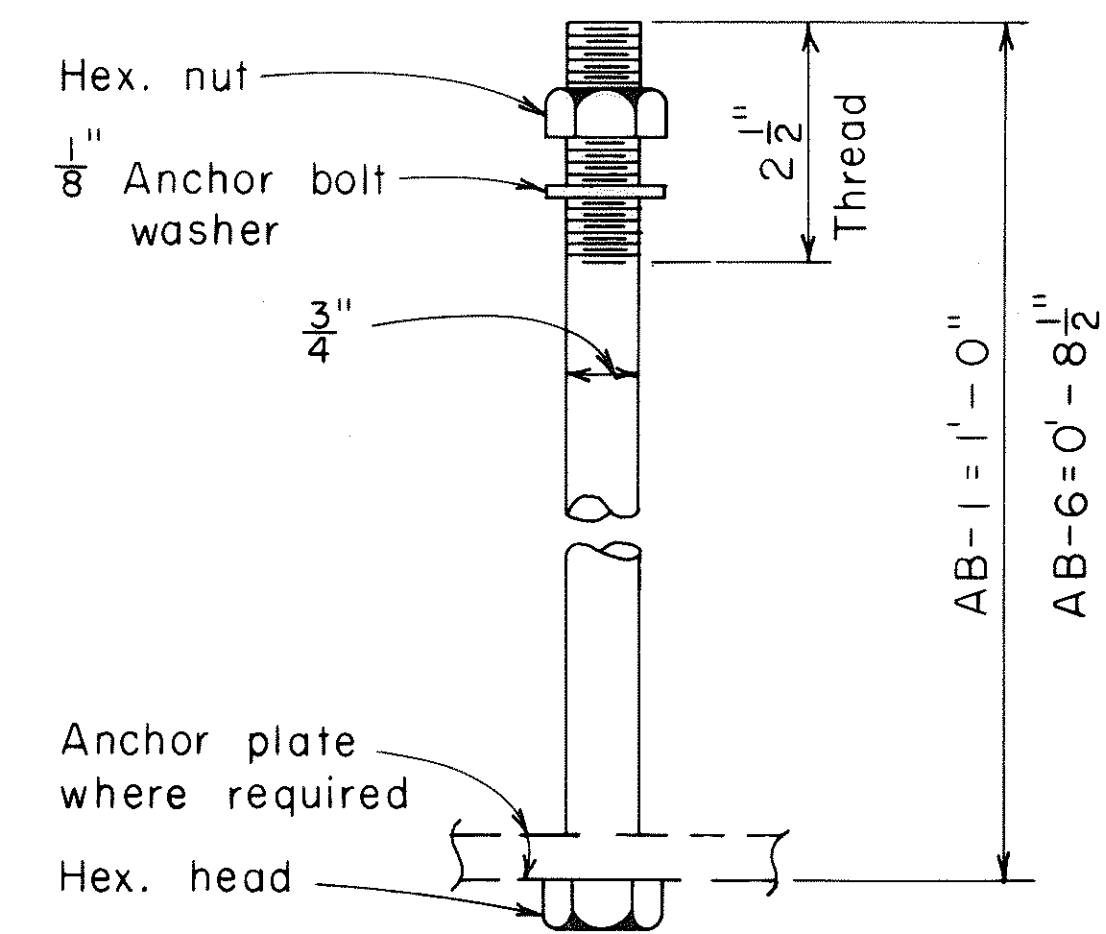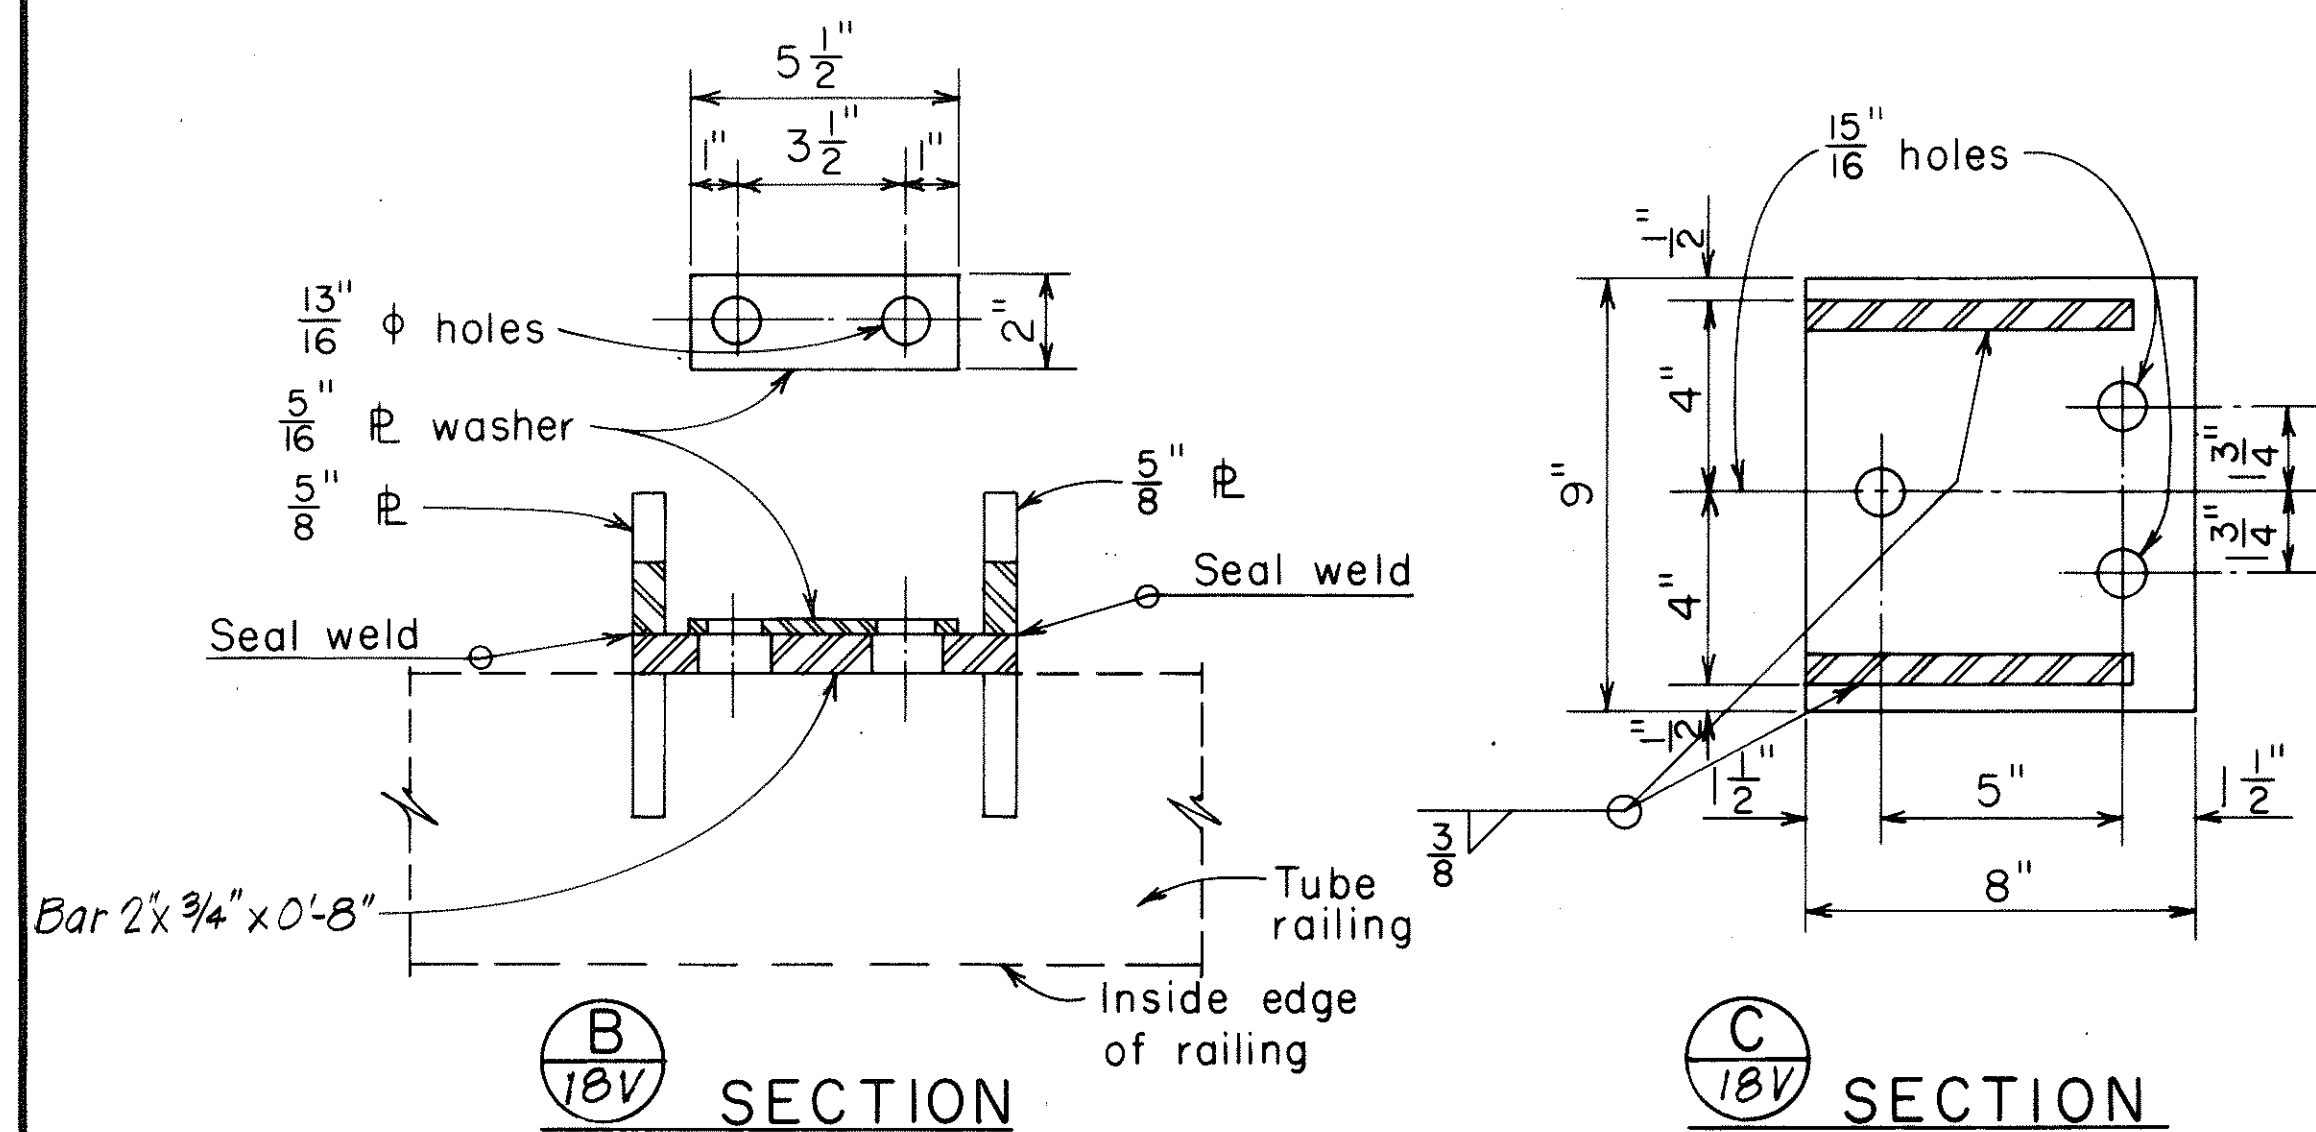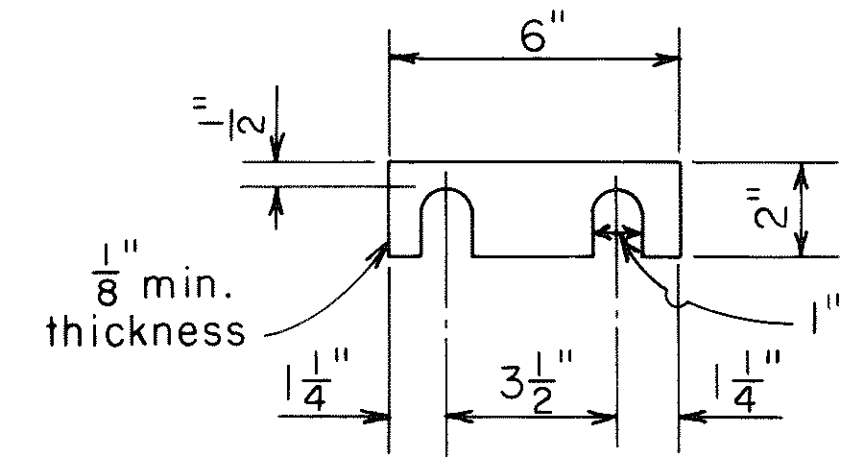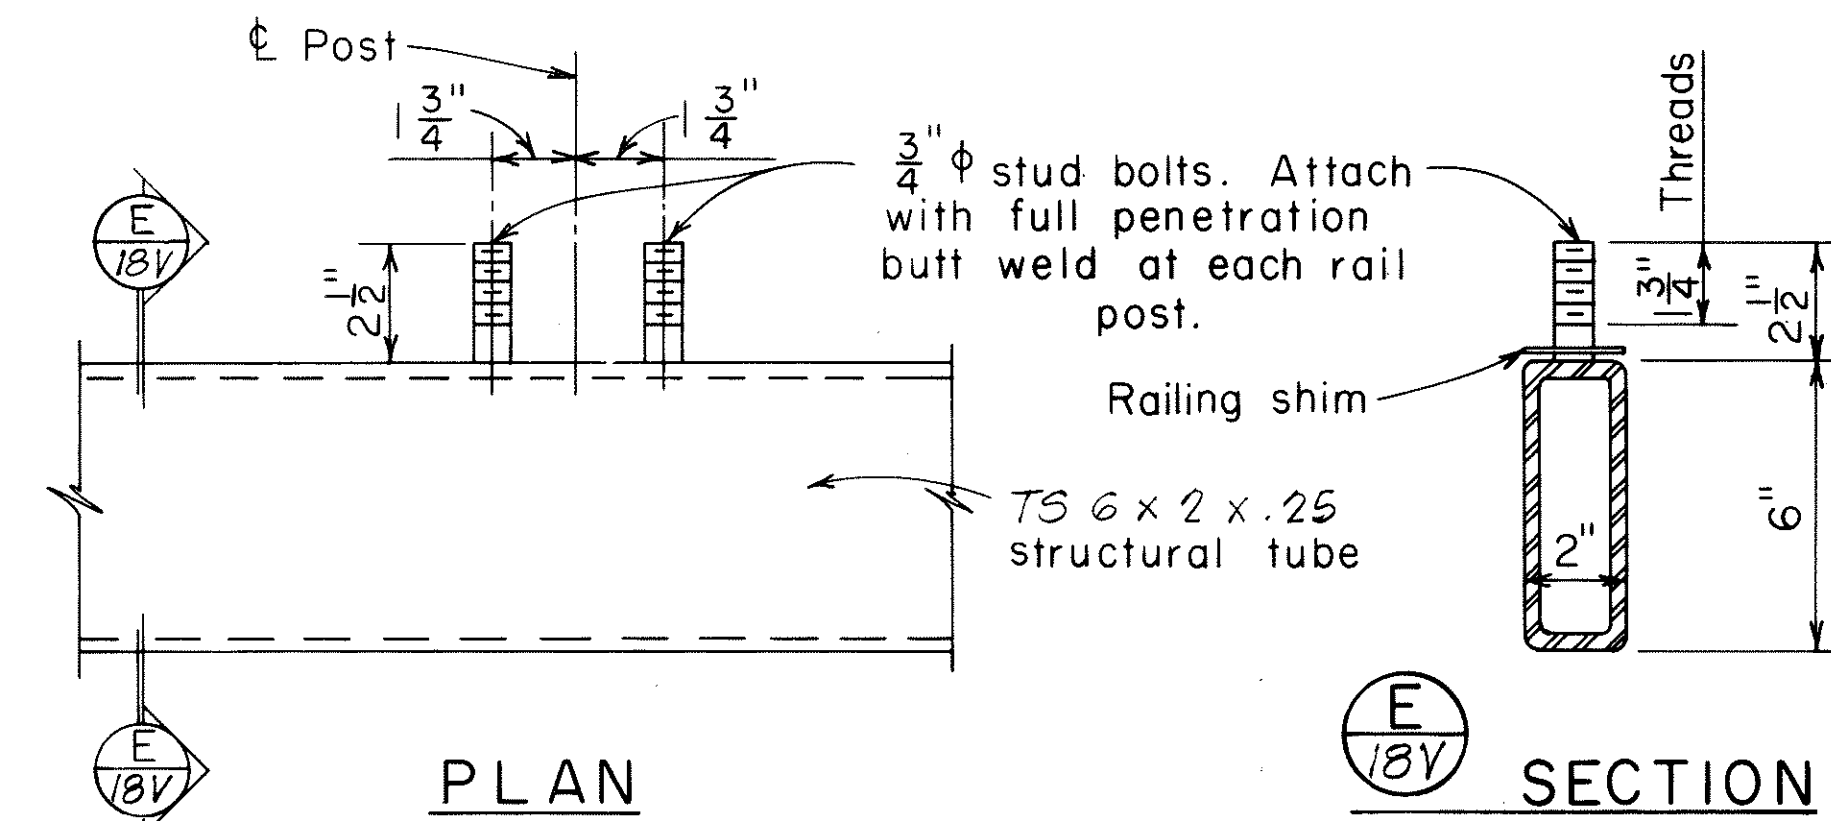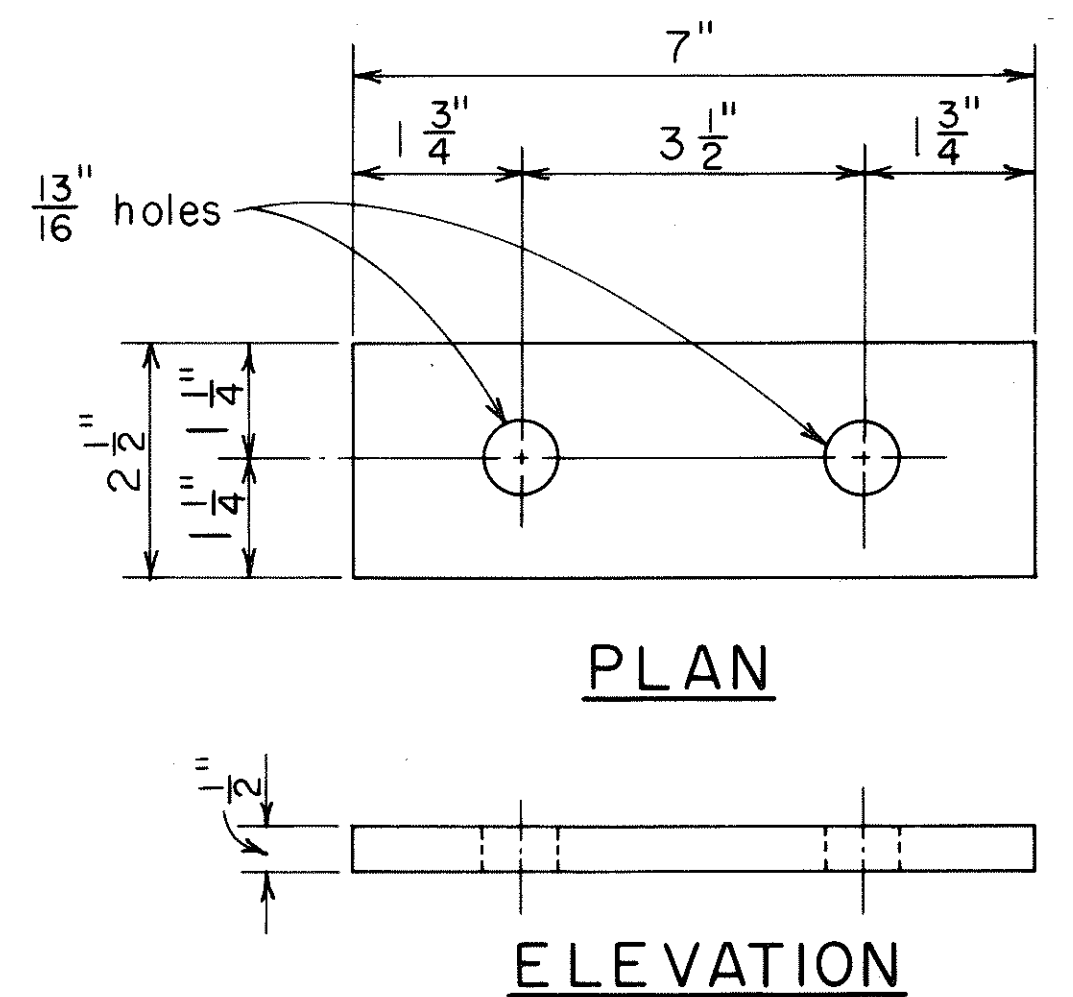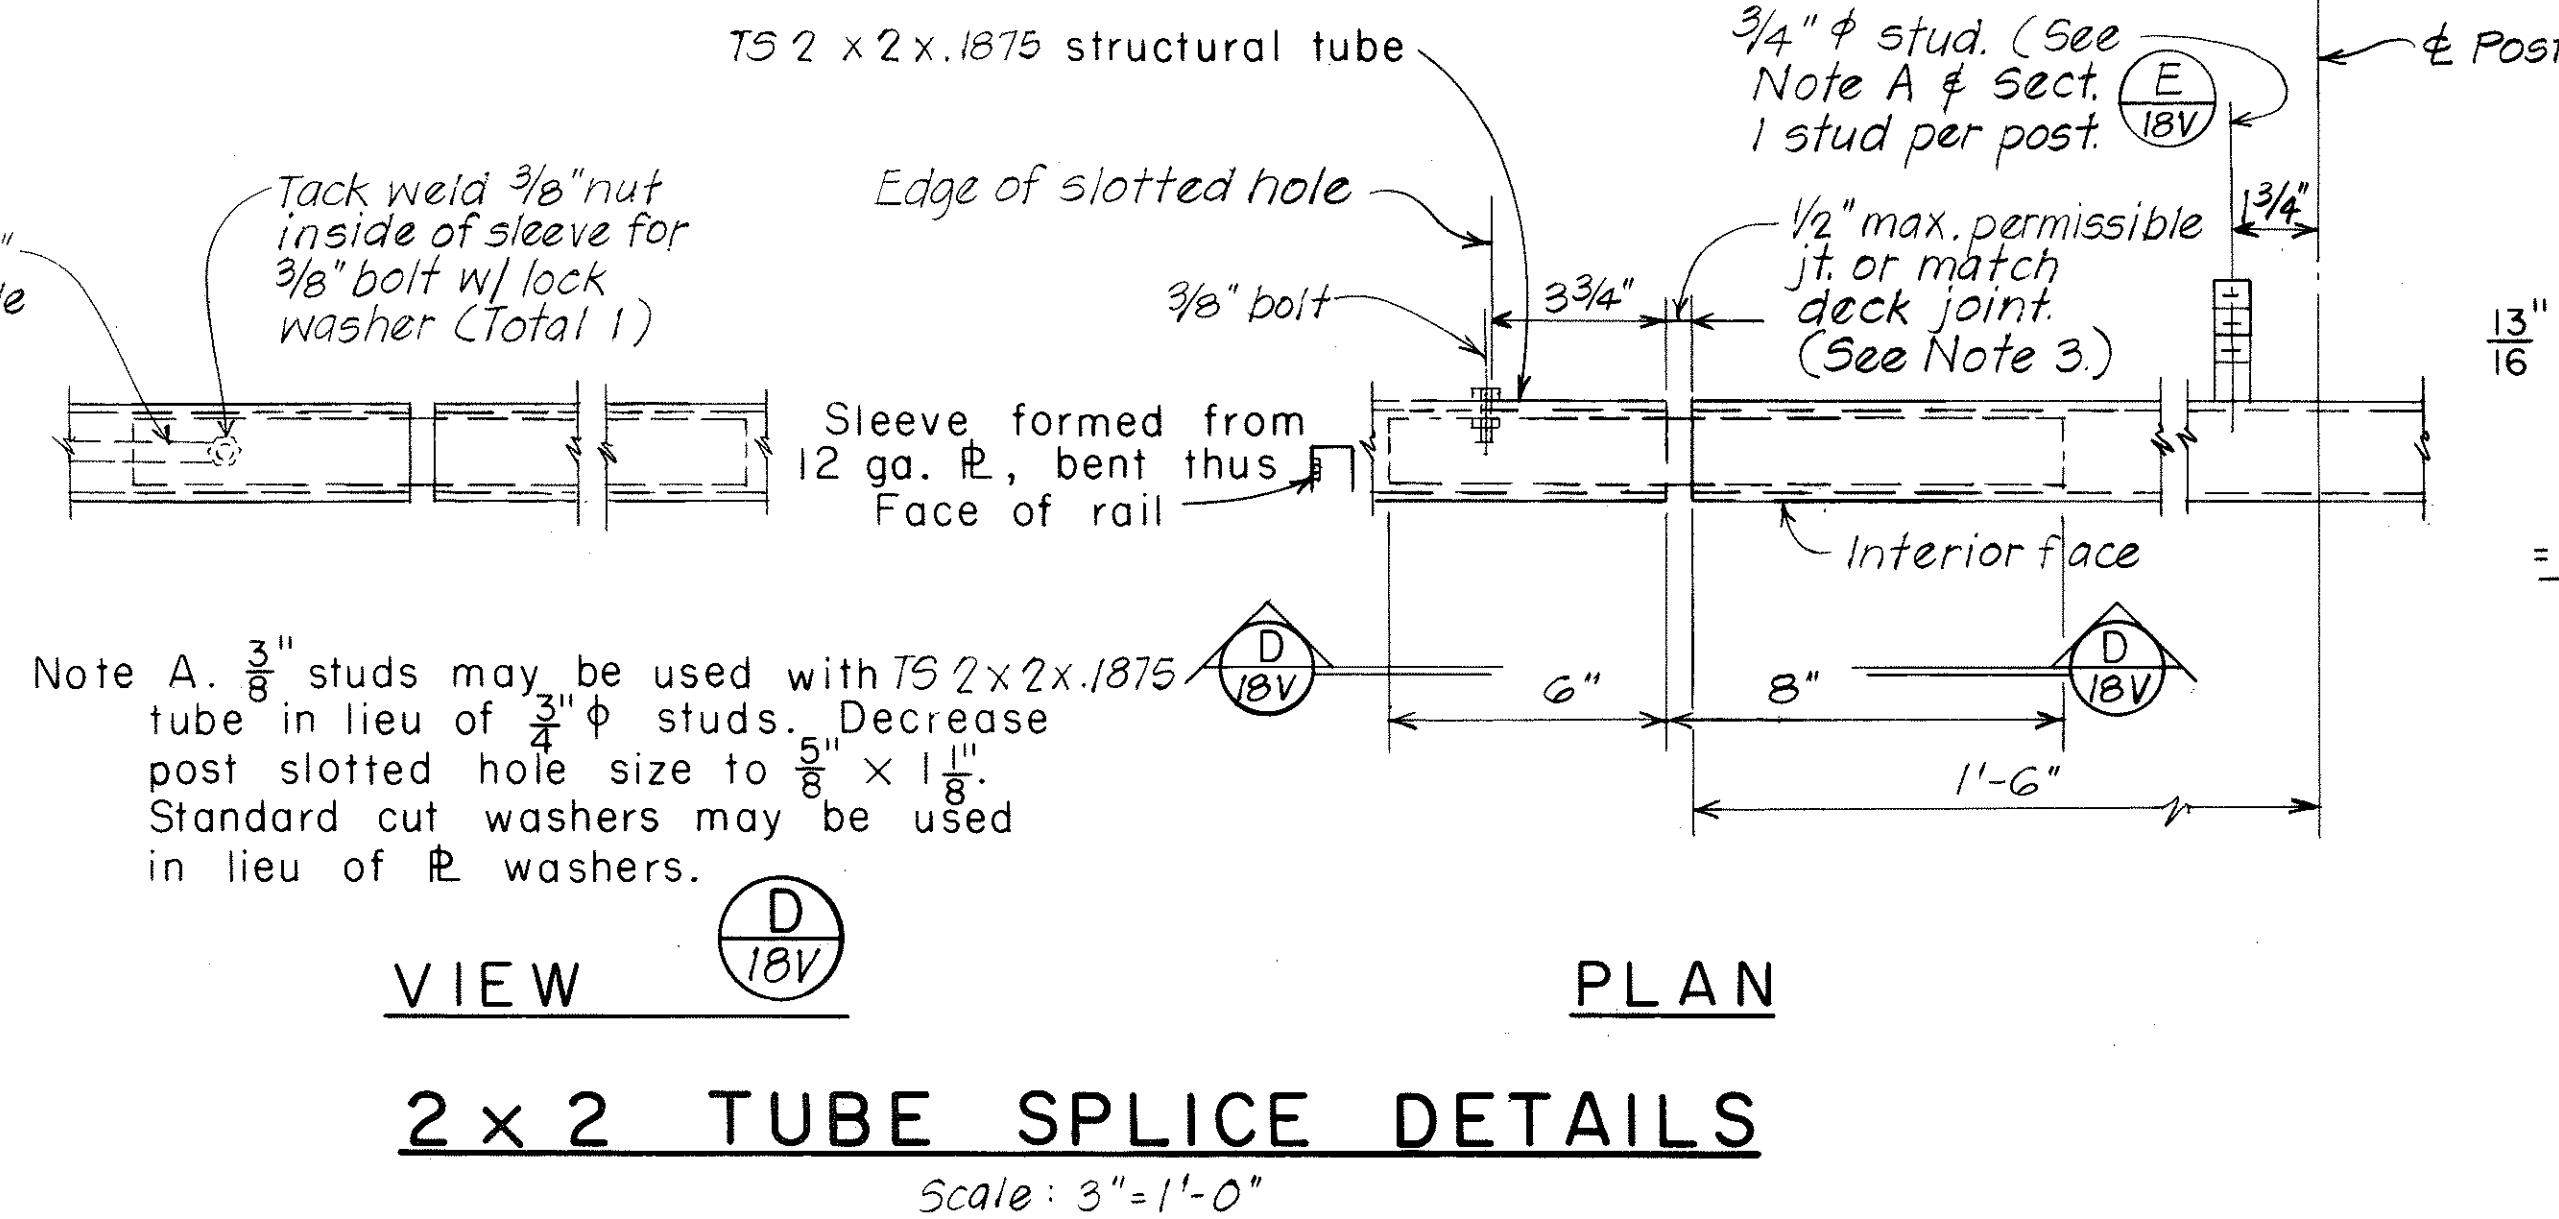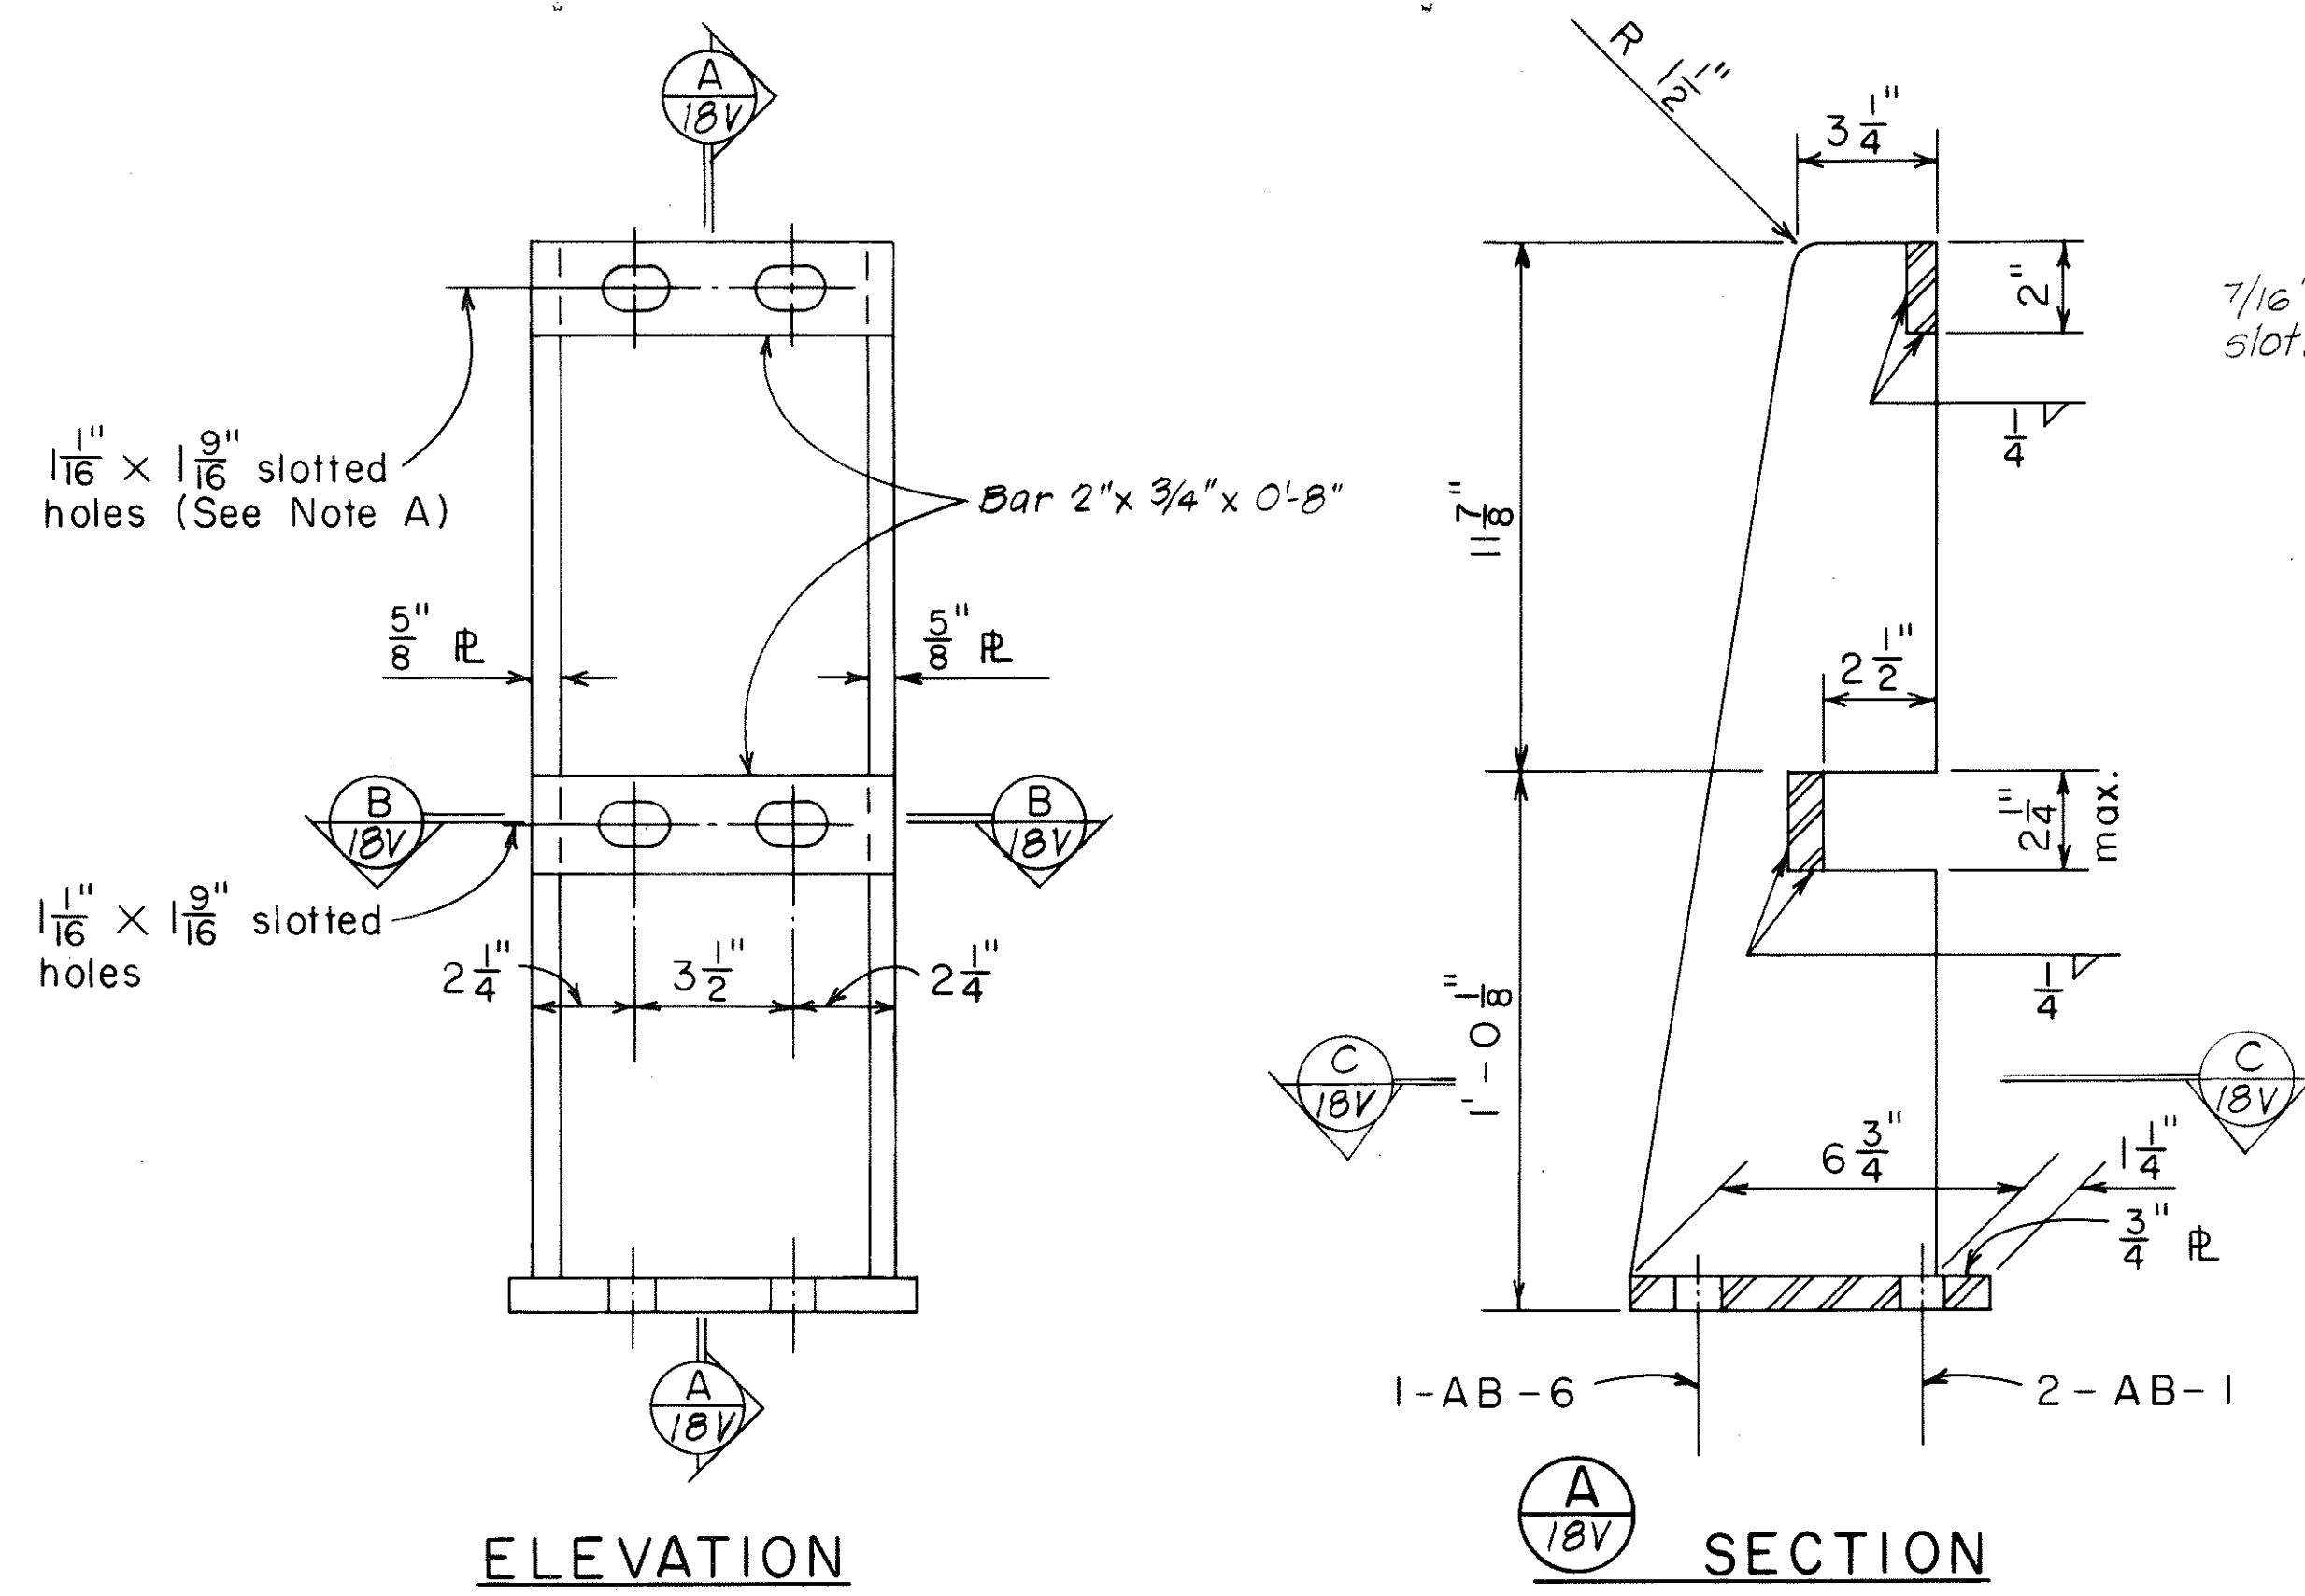

STATE OF HAWAII
DEPARTMENT OF TRANSPORTATION
HIGHWAYS DIVISION

STEEL BRIDGE RAILING (TUBULAR)
TWO RAIL COMBINATION TYPE ON PARAPET

BRIDGE NO. 3
HALEKOU INTERCHANGE
F.A.I. Proj. No. I-H3-1(24):11

Scale: As Noted Date: Sept. 1982

SHEET No. 18V OF 20 SHEETS

SURVEY PLOTTED BY	DATE
DESIGNED BY	
TRACED BY	
NOTE BOOK	
QUANTITIES BY	
CHECKED BY	

