
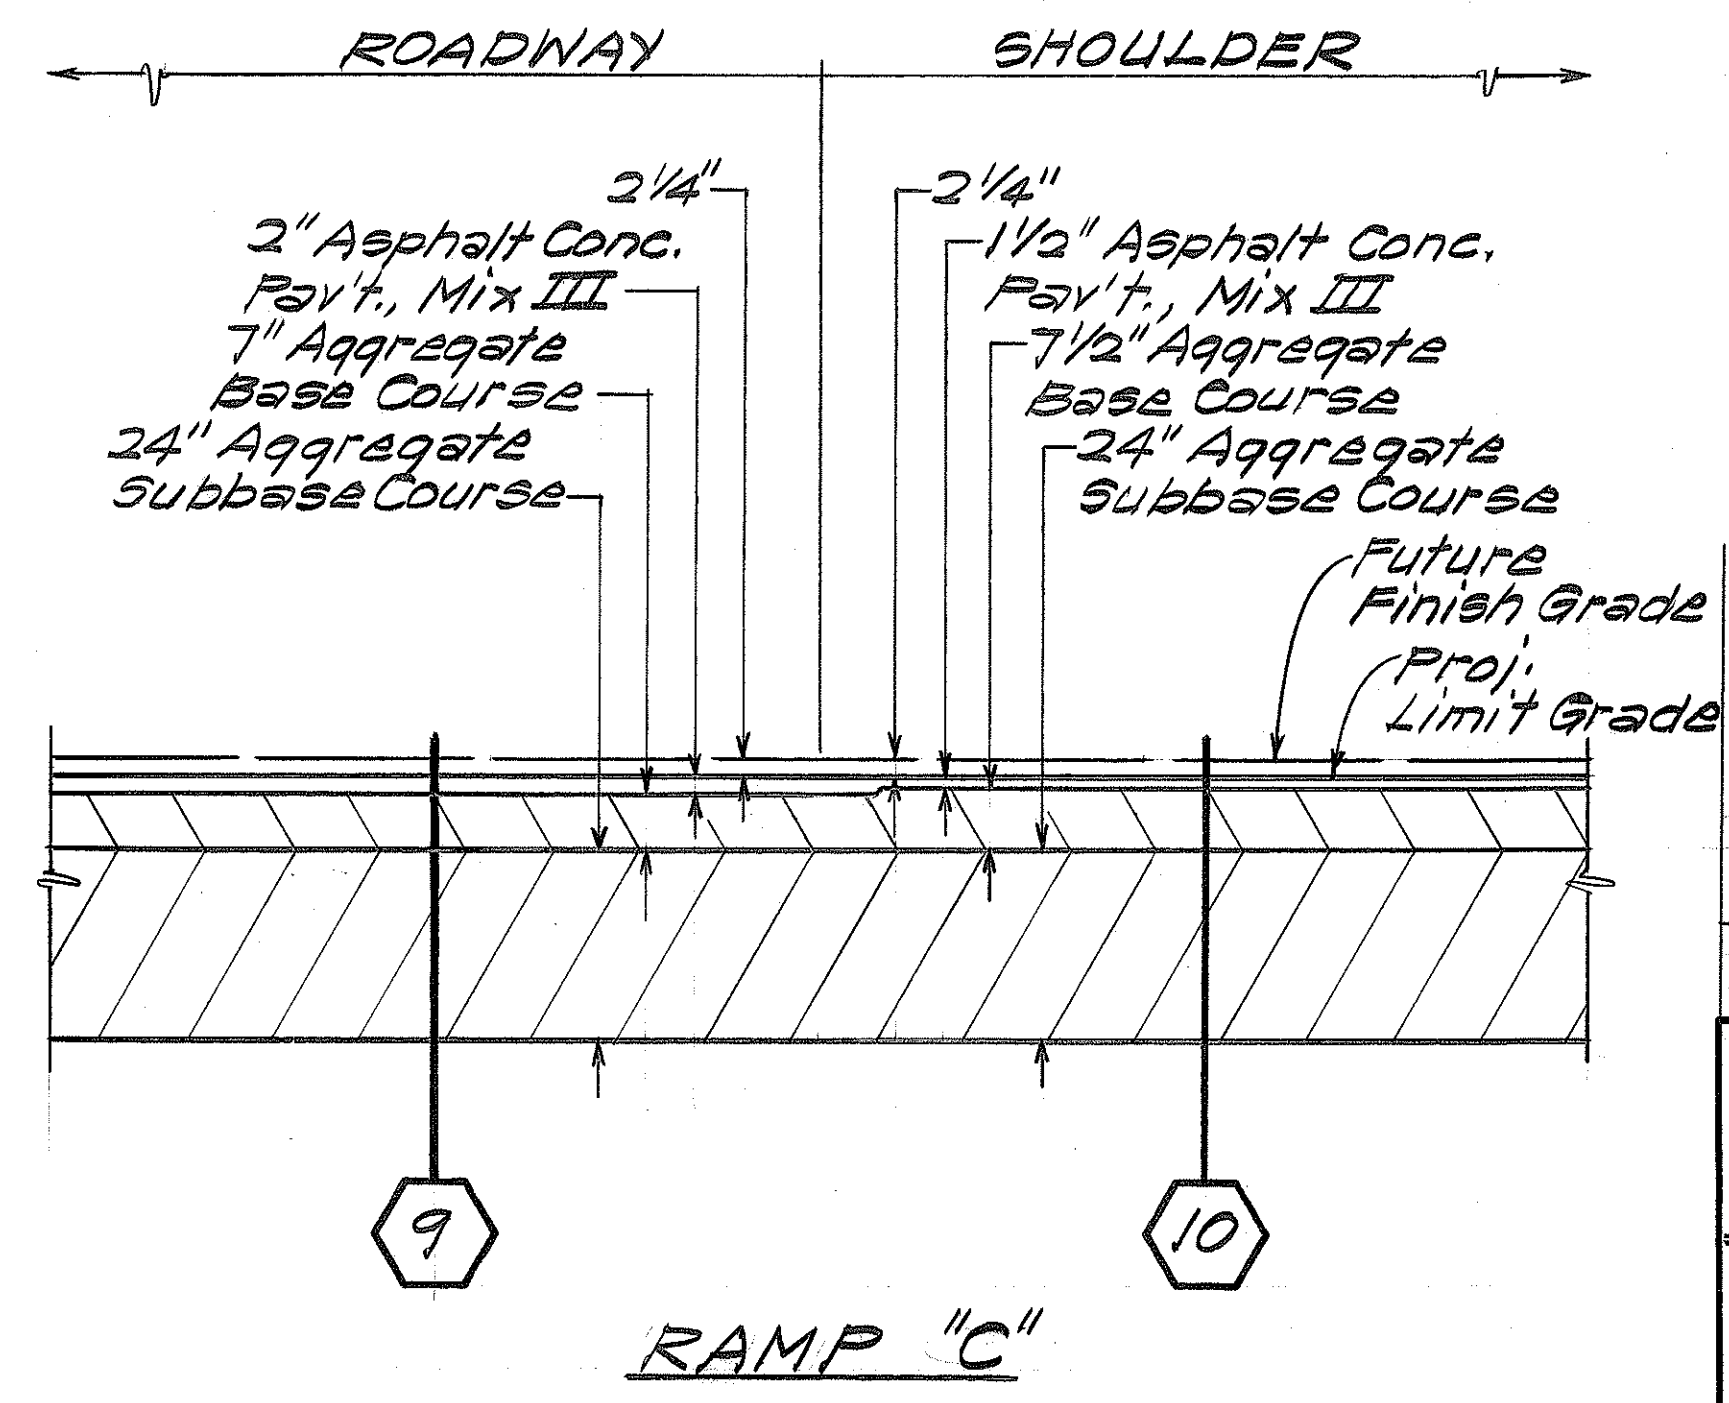
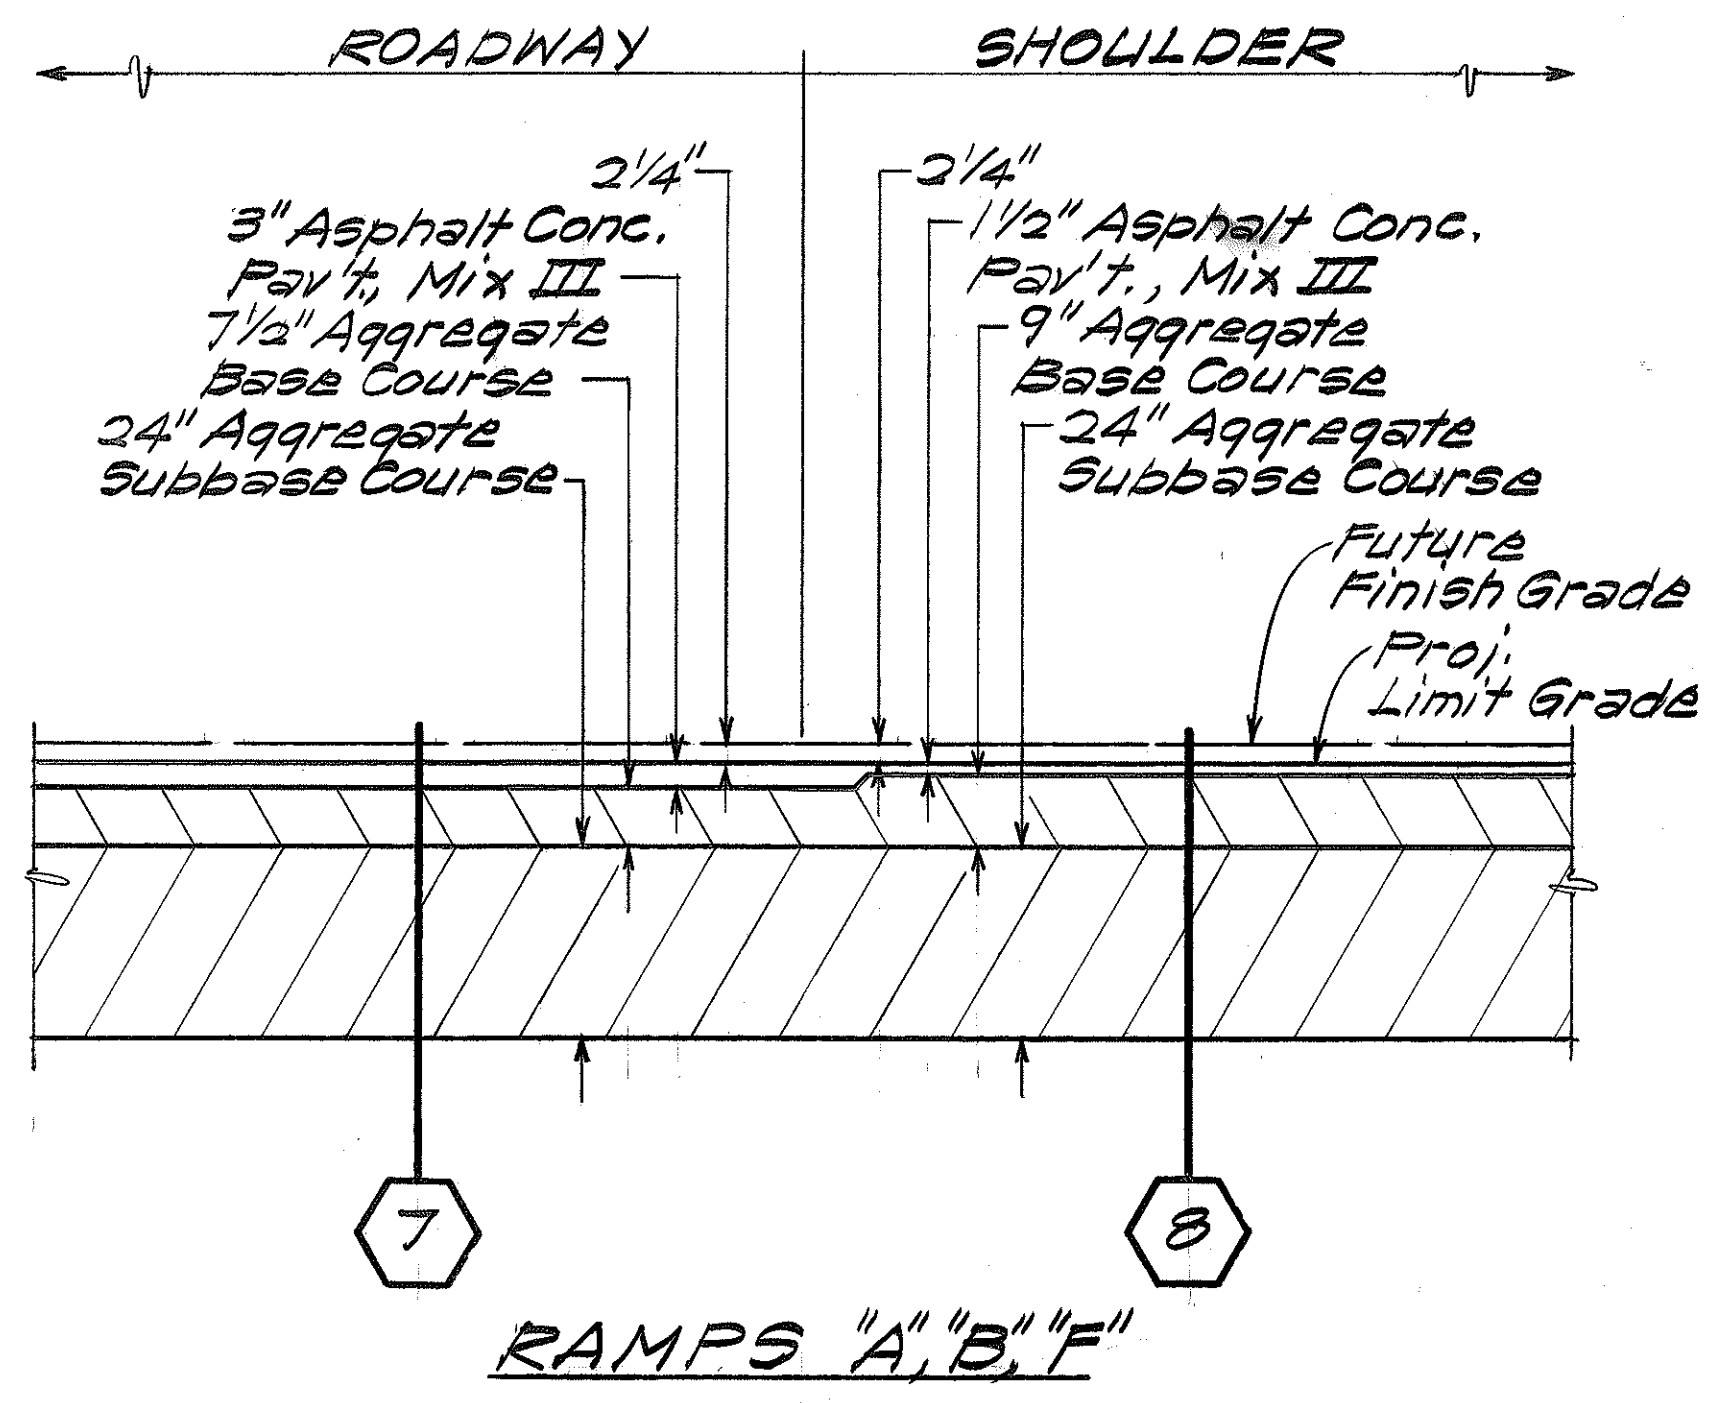
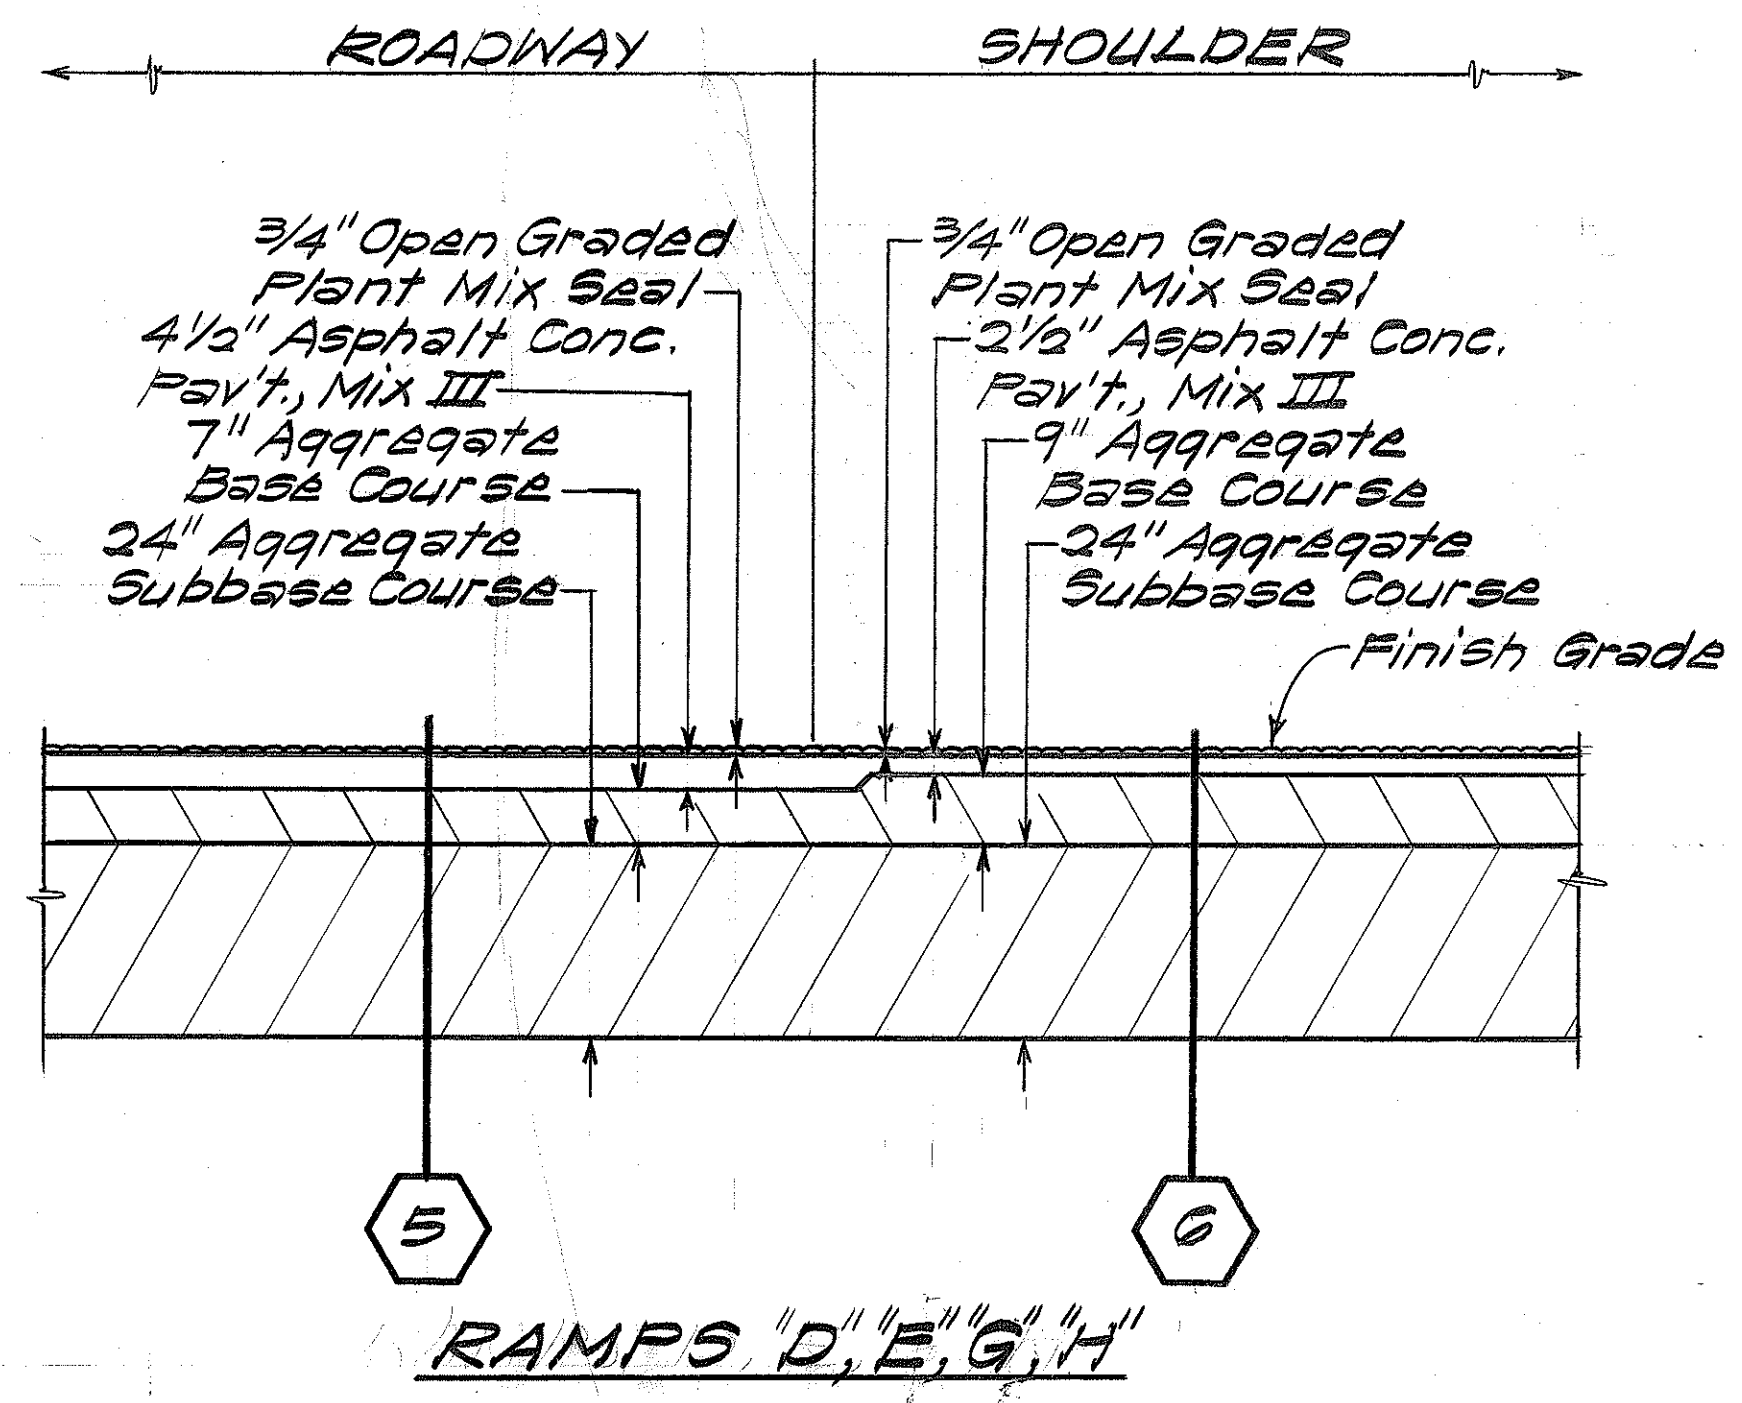
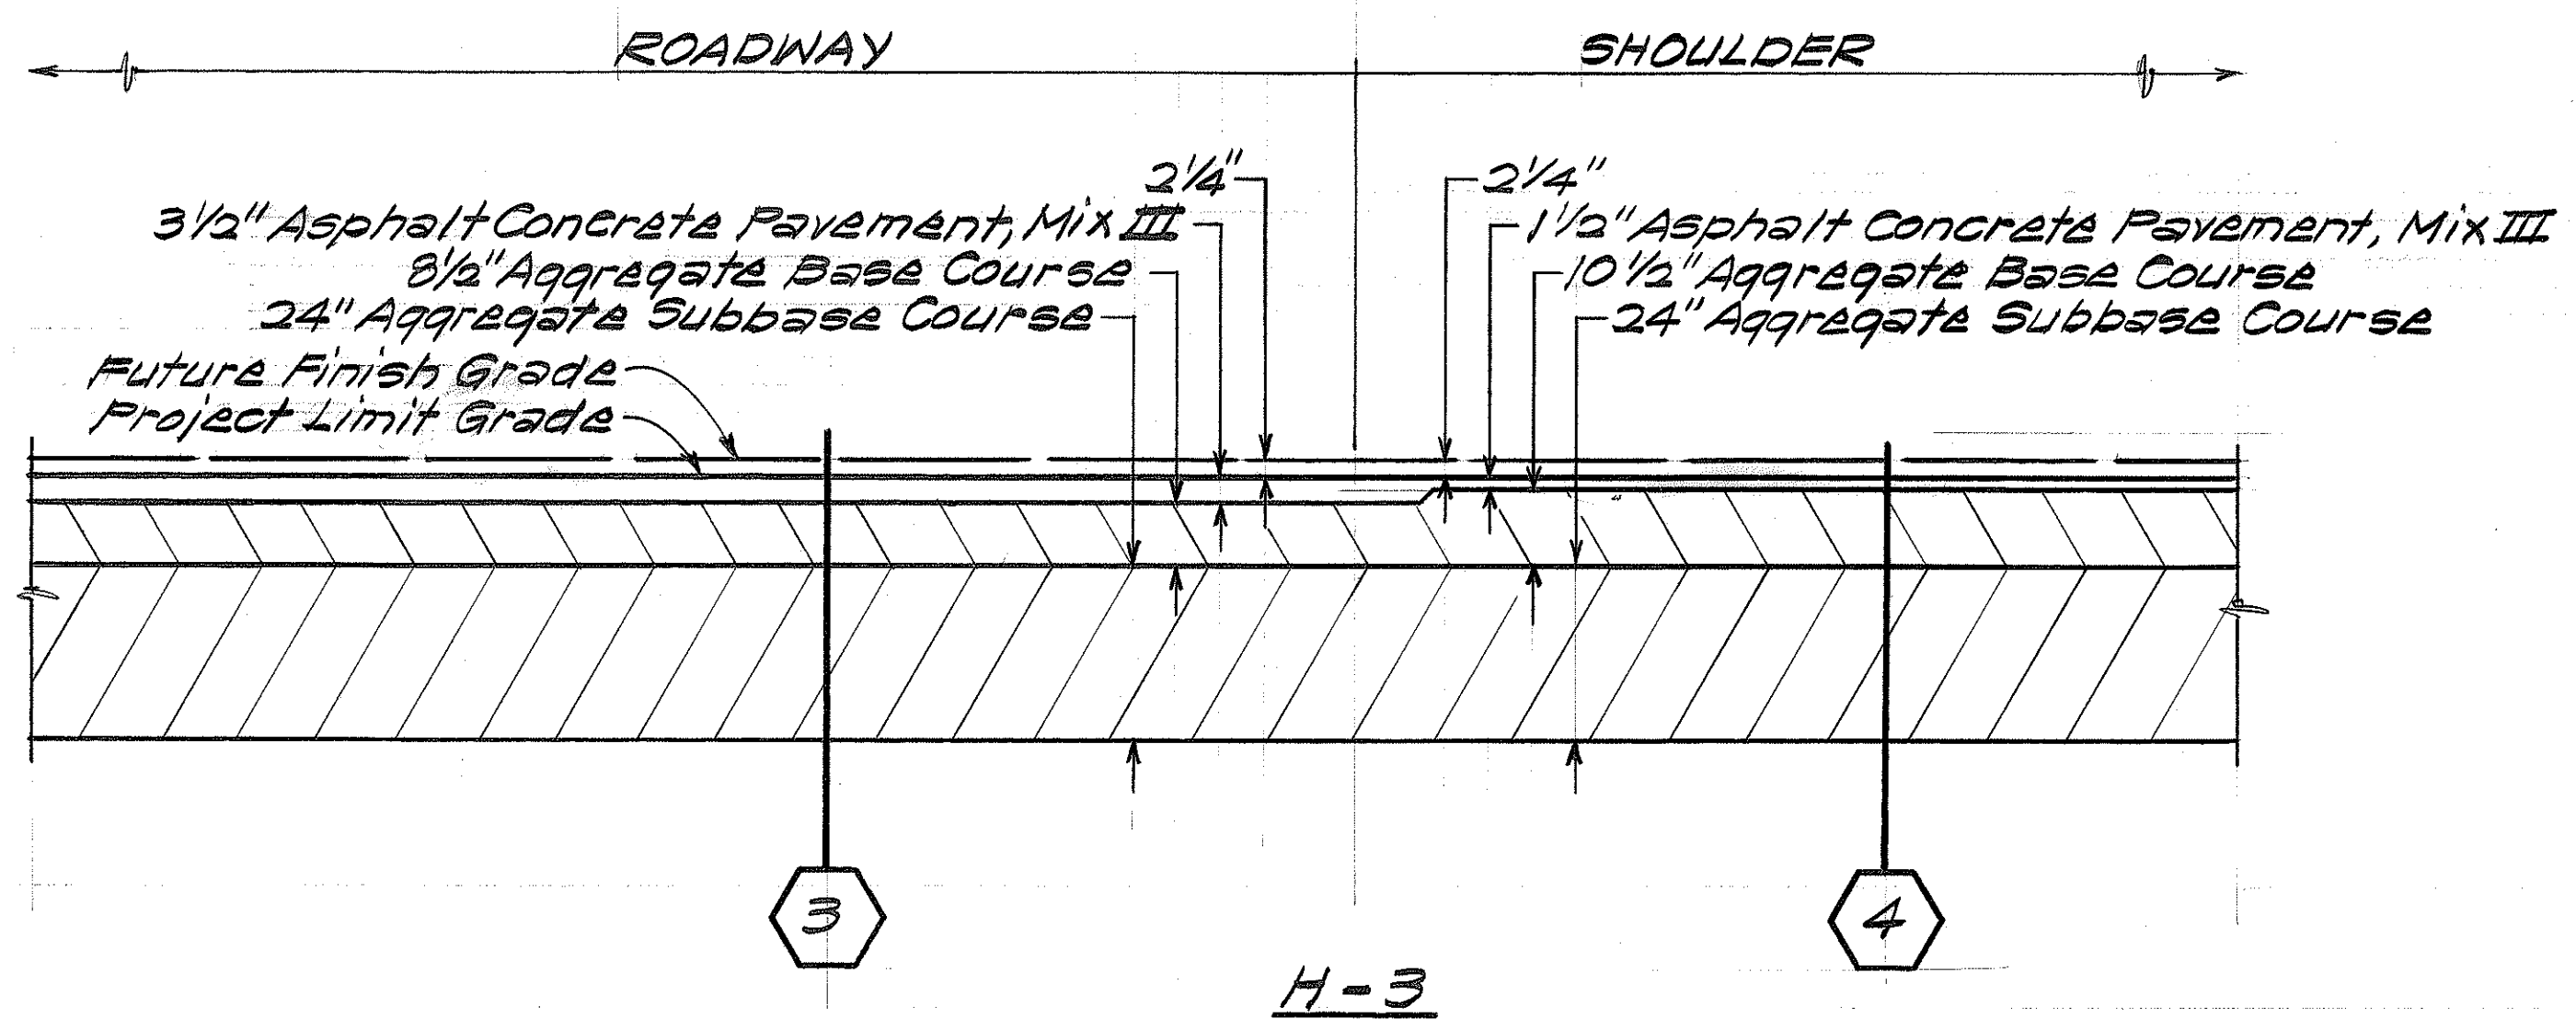


FED. ROAD DIST. NO.	STATE	FED. AID PROJ. NO.	FISCAL YEAR	SHEET NO.	TOTAL SHEETS
HAWAII	HAW.	I-H3-1(24):11	1983	2	328

NOTES


- The following roadway sections shall be constructed to finish grades:
 - H-3 ~ Sta. 515+00 to Sta. 526+00
 - Ramps "D," "E," "G," "H"
 - Entire Kamehameha Highway
 - Service Roads
 - Private Driveways
- The remaining H-3 roadway and Ramps "A," "B," "C," "F" shall be constructed to Project Limit Grades; all grade control points shall be taken from the Future Finish Grades.
- Filter material to be placed between shoulder and fill slope shall be paid for as Filter Material for Underdrains.
- Type 1 Seal Coat (MC-30) to be placed on the shoulders of the Service Road shall be incidental to Aggregate Subbase.

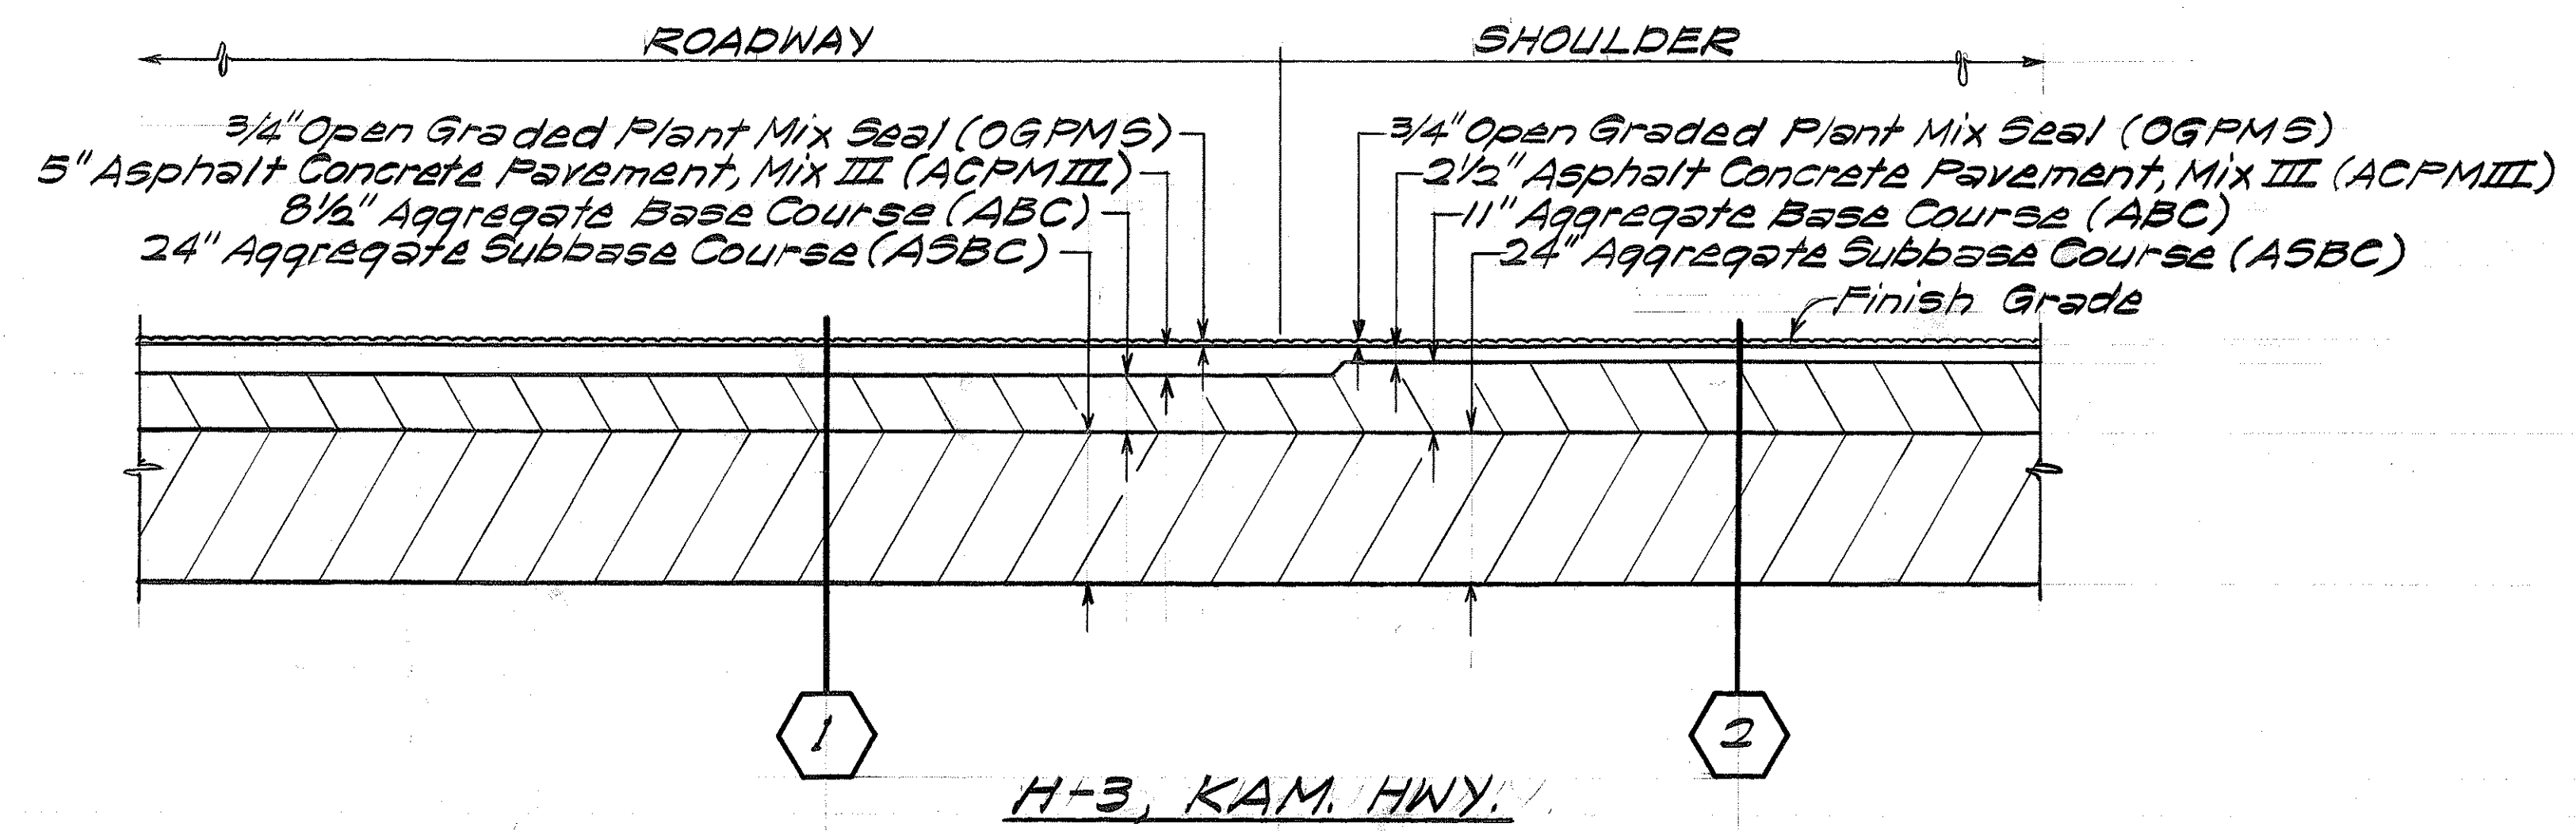

TYPICAL ROADWAY SECTIONS PAVEMENT DESIGNS Not to Scale


12/22/82	Added Note Nos. 3 and 4 per Addendum No. 1.
DATE	REVISION
STATE OF HAWAII DEPARTMENT OF TRANSPORTATION LAND TRANSPORTATION FACILITIES DIVISION TYPICAL ROADWAY SECTIONS PAVEMENT DESIGNS HALEKOU INTERCHANGE F.A.I. PROJECT NO. I-H3-1(24):11 Scale: As Shown Date: Oct, 1982 SHEET No. 1R OF 5 SHEETS	

FED. ROAD DIST. NO.	STATE	FED. AID PROJ. NO.	FISCAL YEAR	SHEET NO.	TOTAL SHEETS
HAWAII	HAW.	143-1(24):11	1983	3	328

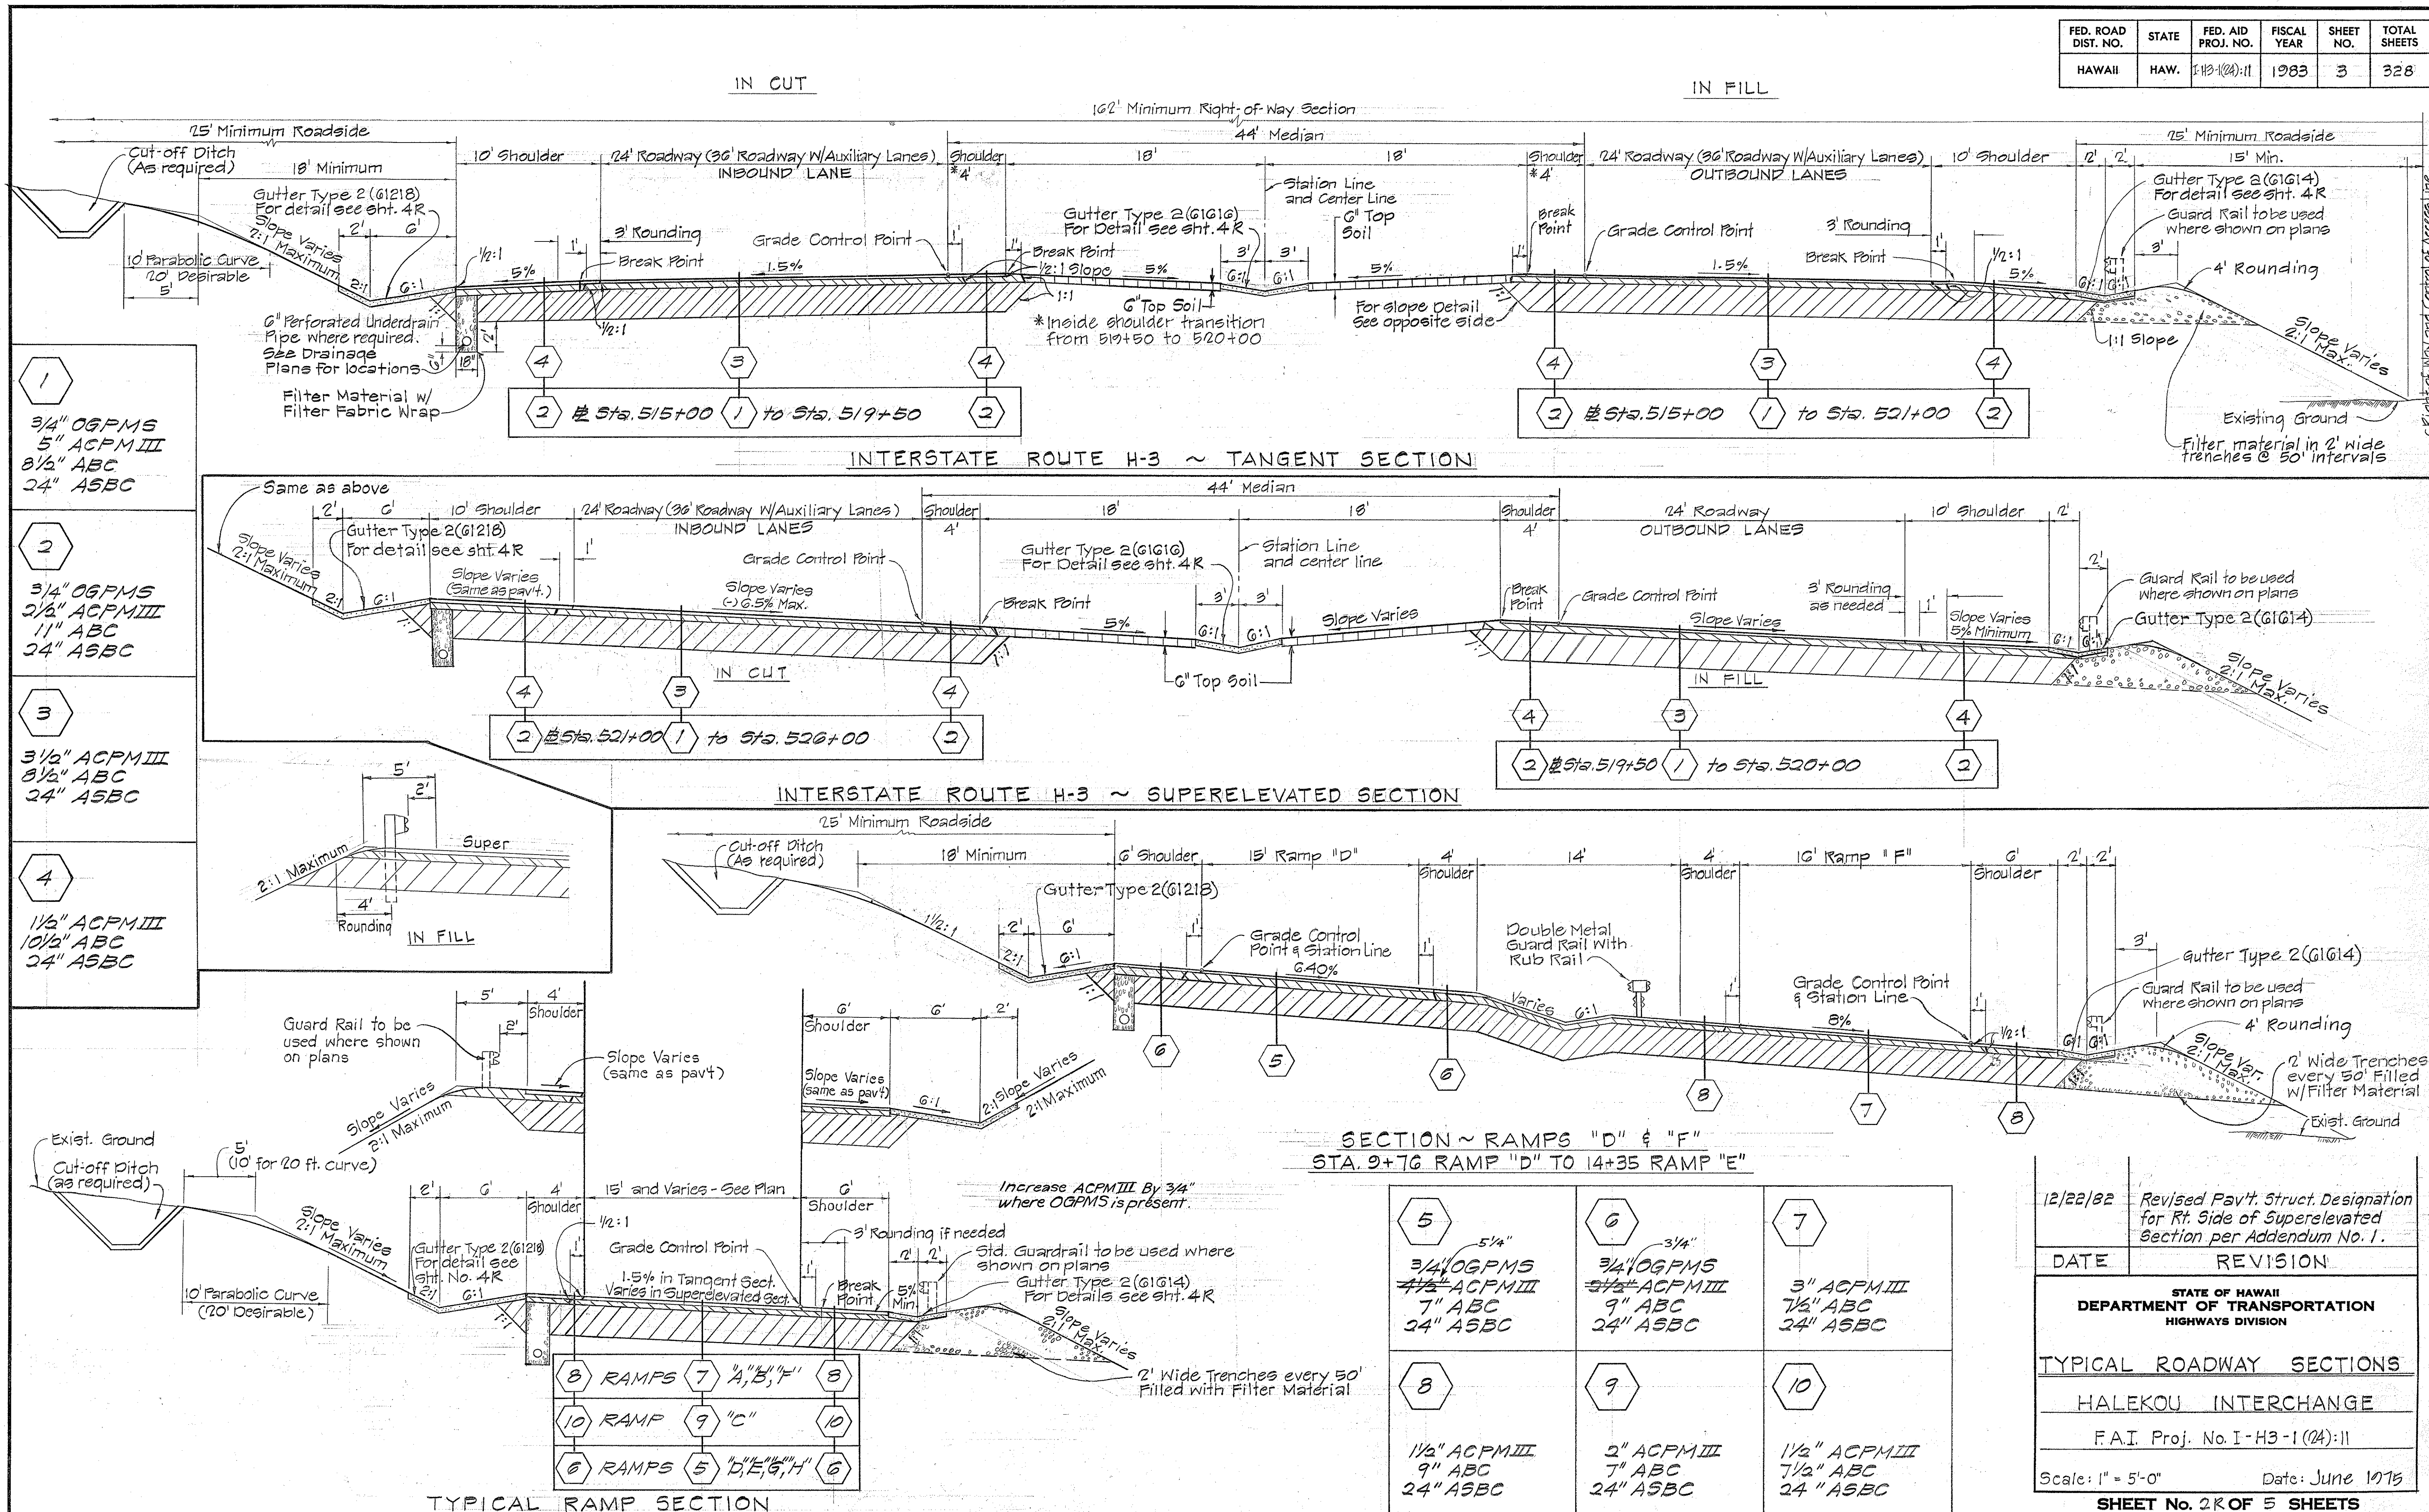


12/22/82	Revised Pav't. Struct. Designation for Rt. Side of Superelevated Section per Addendum No. 1.
DATE	REVISION
STATE OF HAWAII DEPARTMENT OF TRANSPORTATION HIGHWAYS DIVISION	
TYPICAL ROADWAY SECTIONS	
HALEKOU INTERCHANGE	
F.A.I. Proj. No. I-H3-1(24):11	
Scale: 1" = 5'-0" Date: June 1975	
SHEET No. 2 OF 5 SHEETS	




FED. ROAD DIST. NO.	STATE	FED. AID PROJ. NO.	FISCAL YEAR	SHEET NO.	TOTAL SHEETS
HAWAII	HAW.	I-H3-1(24)-11	1983	5	328

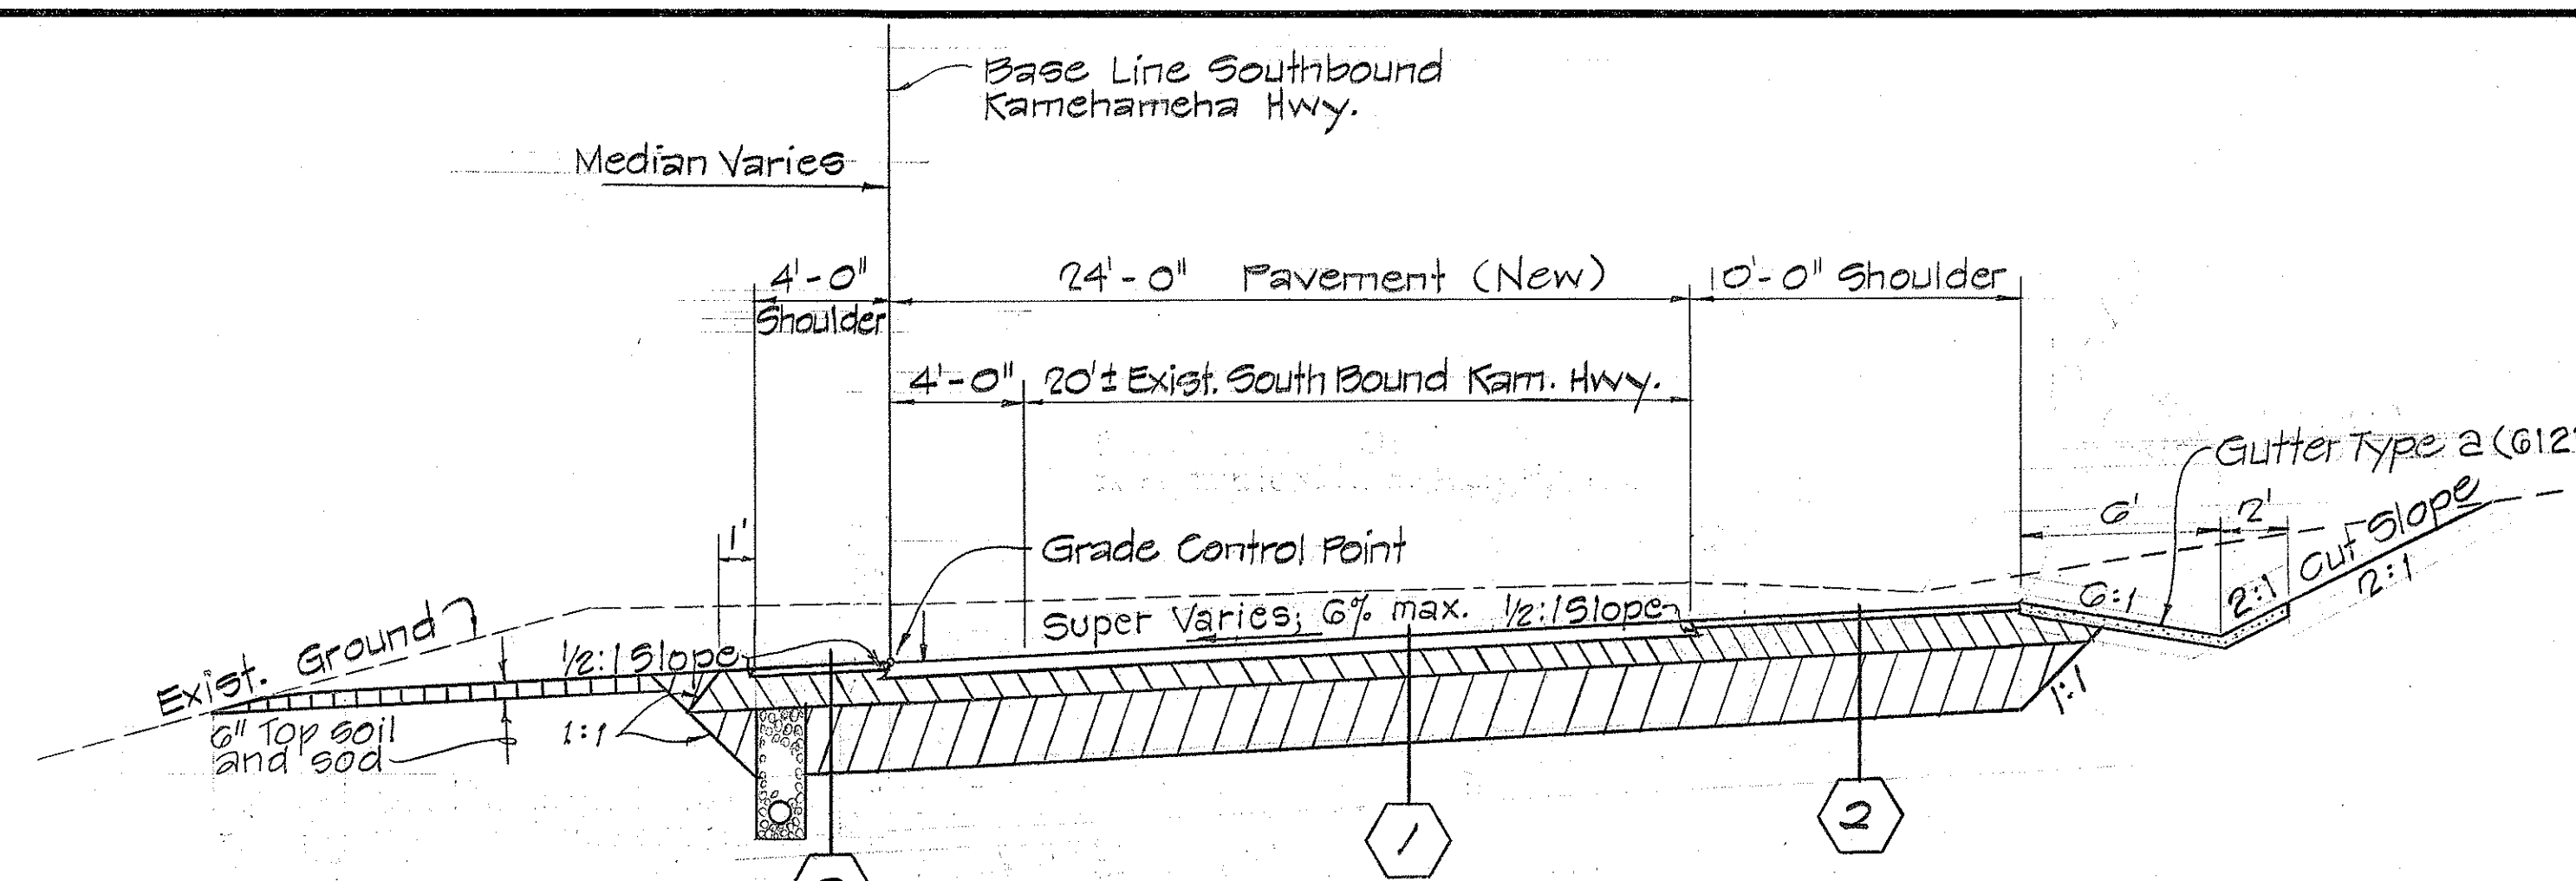


**SOUTH BOUND IN CUT
KAMEHAMEHA HIGHWAY**
(STA. 96+30 TO STA. 101+2.84)
Scale: 1" = 5'

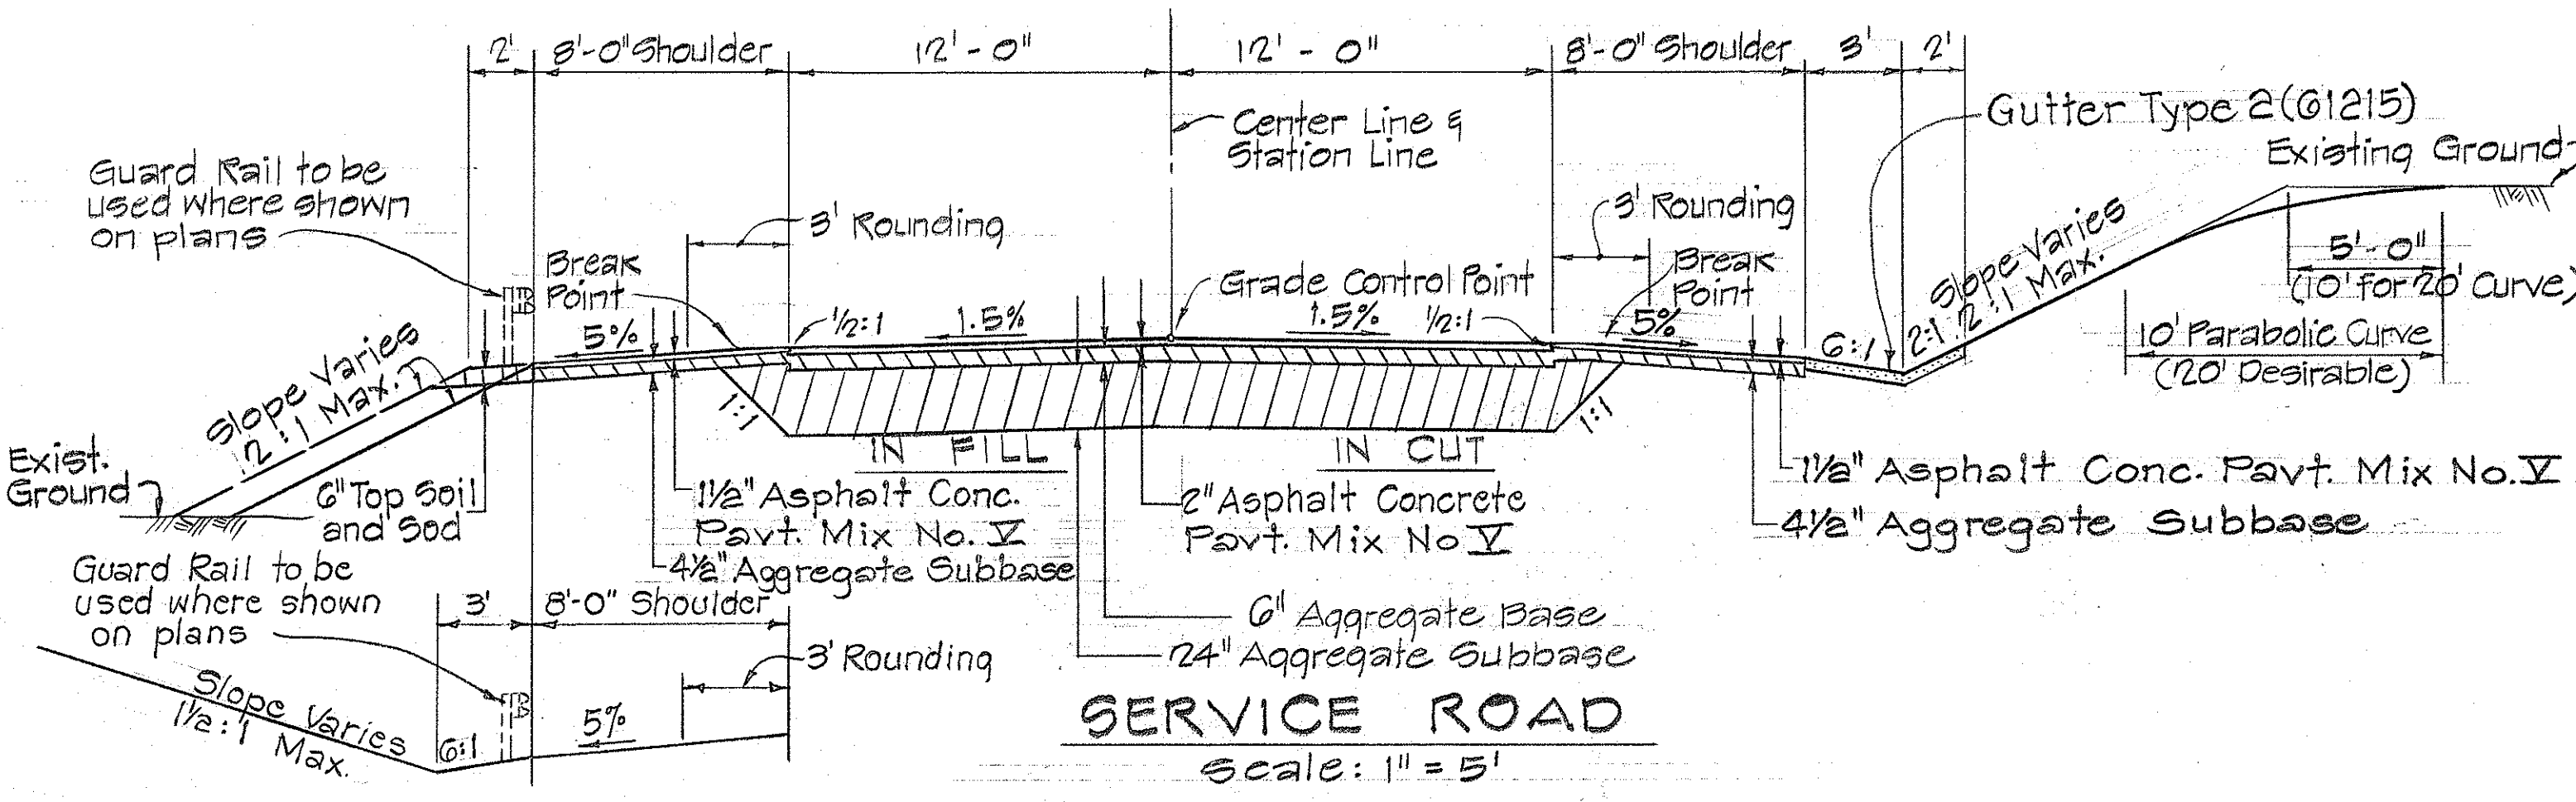



GUTTER, TYPE 2 (G1218)

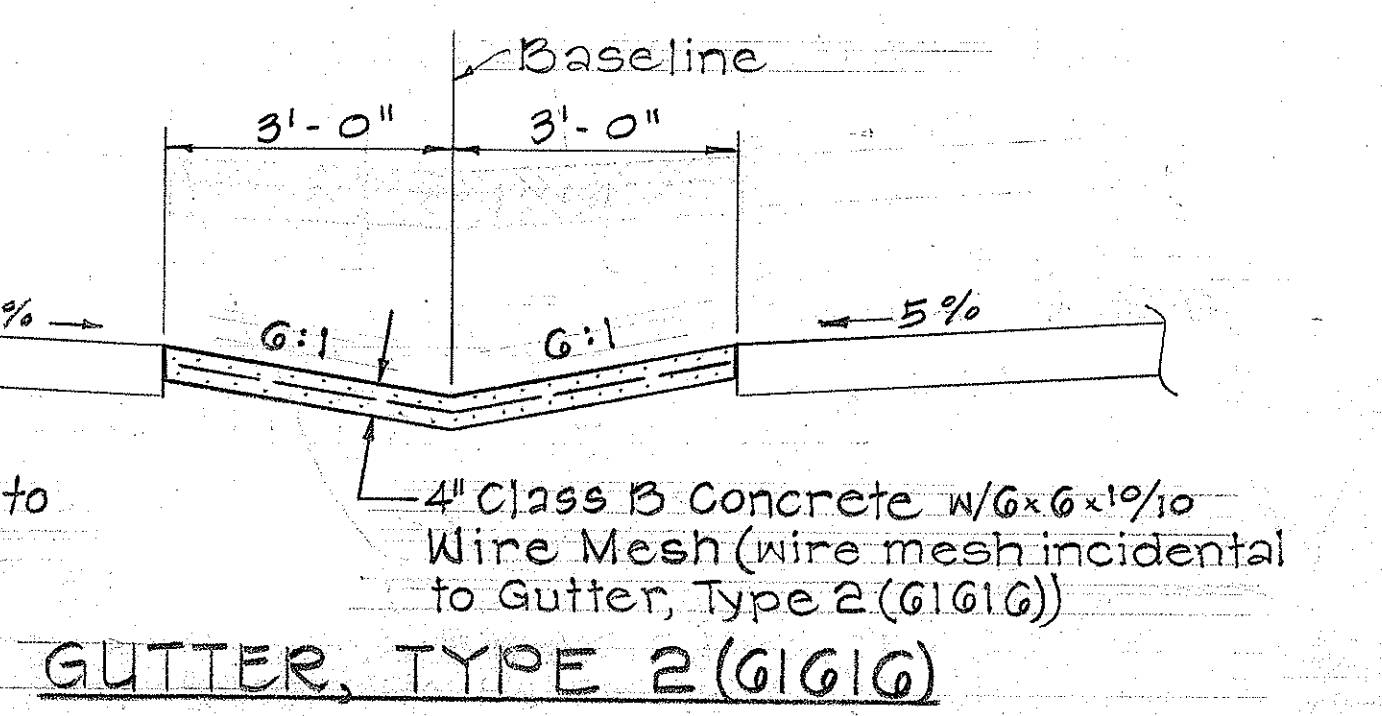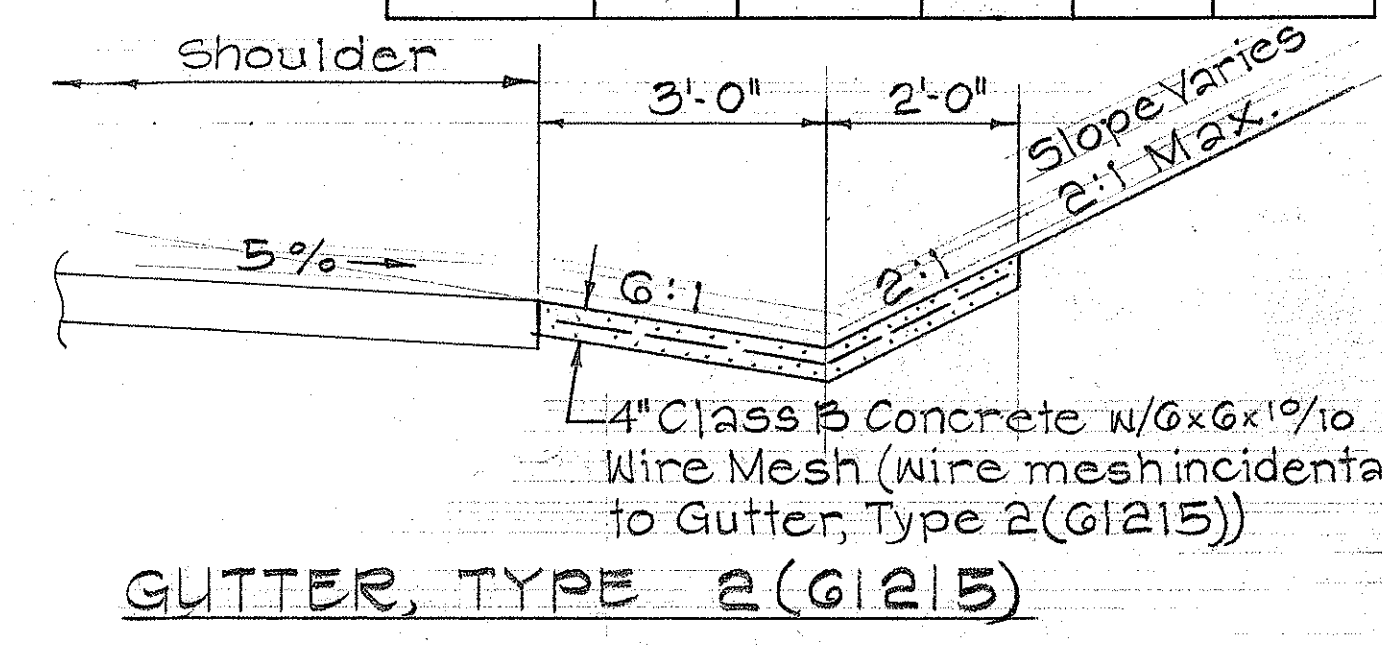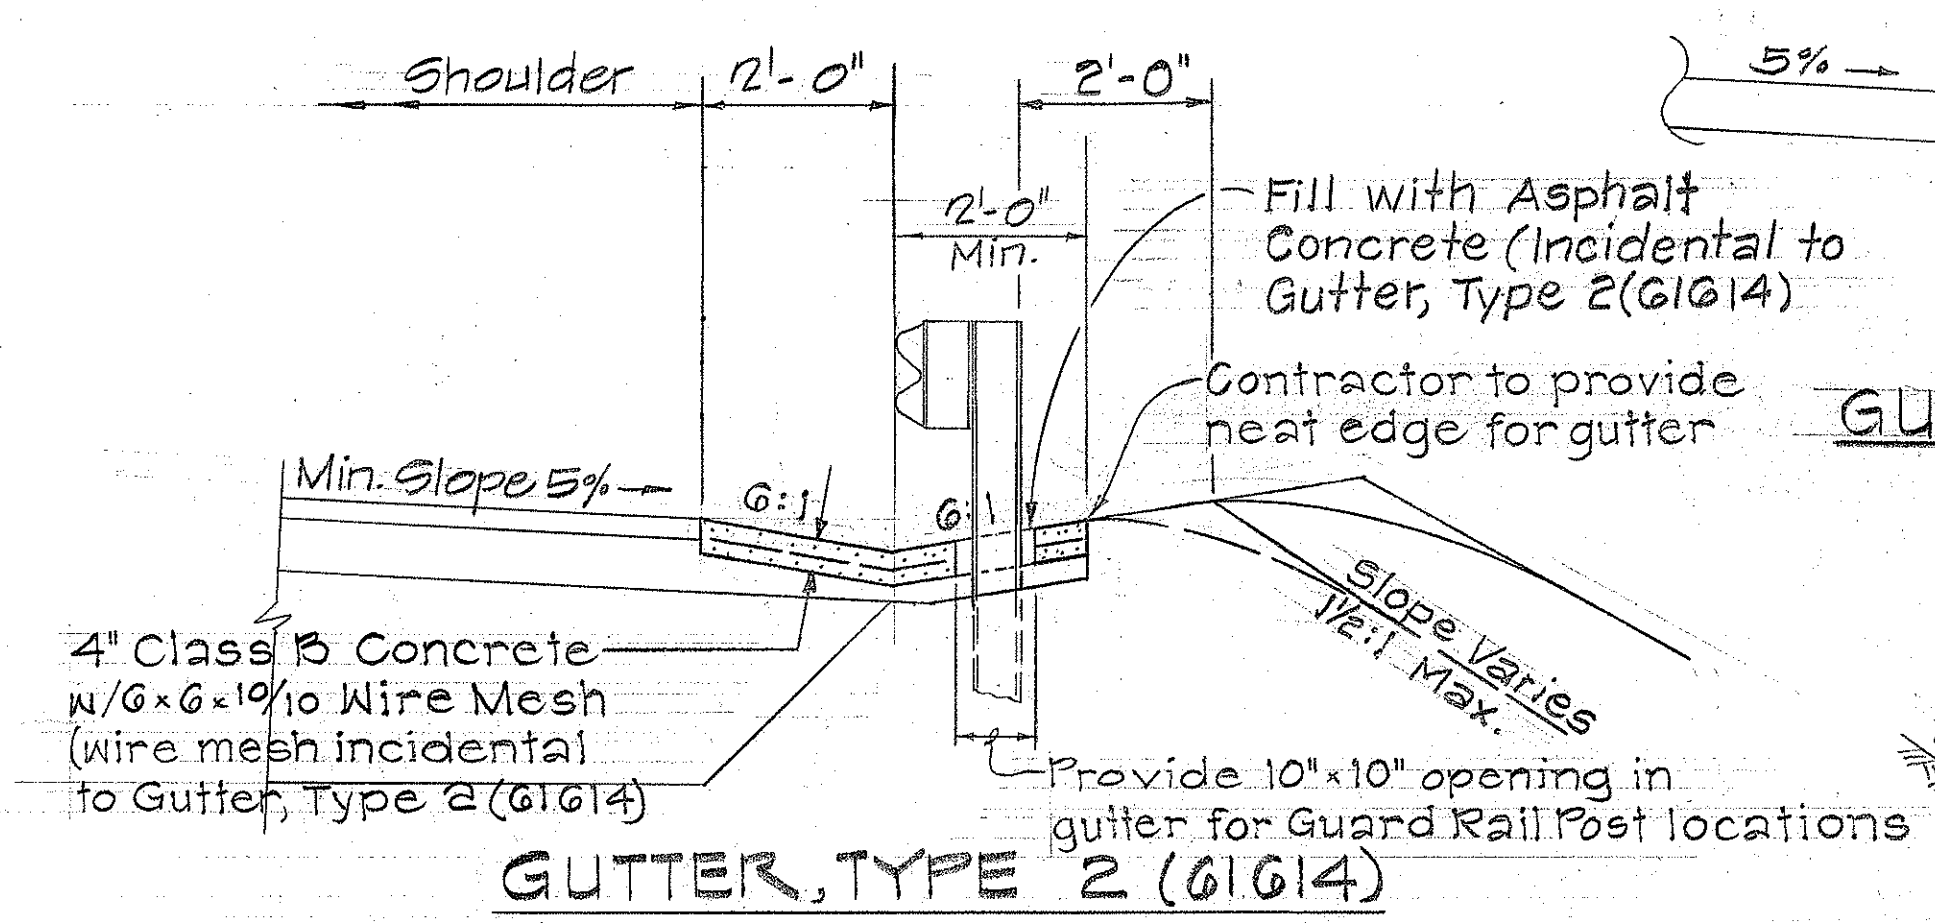

NOTE:
FOR DETAILS OF DOWELS AT CONSTRUCTION JOINTS FOR CONCRETE GUTTERS, SEE SH. NO.

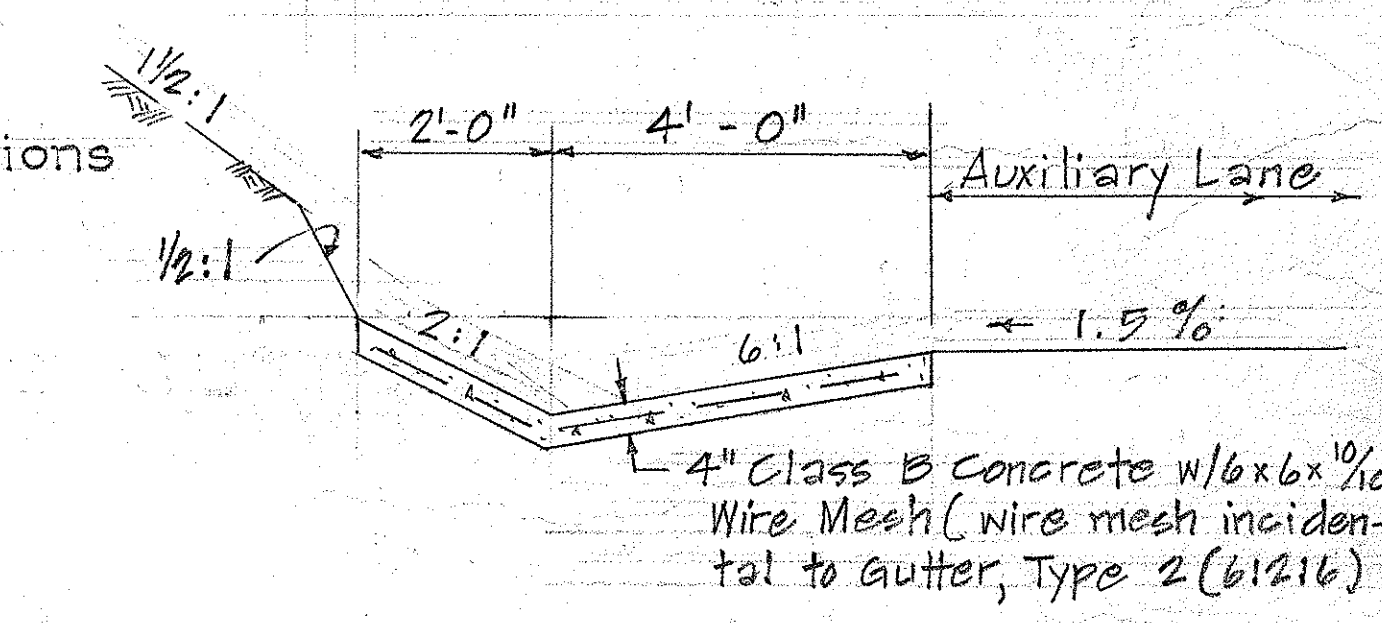


DETAILS OF TYPE 2 GUTTERS
Scale: 1/2" = 1'-0"



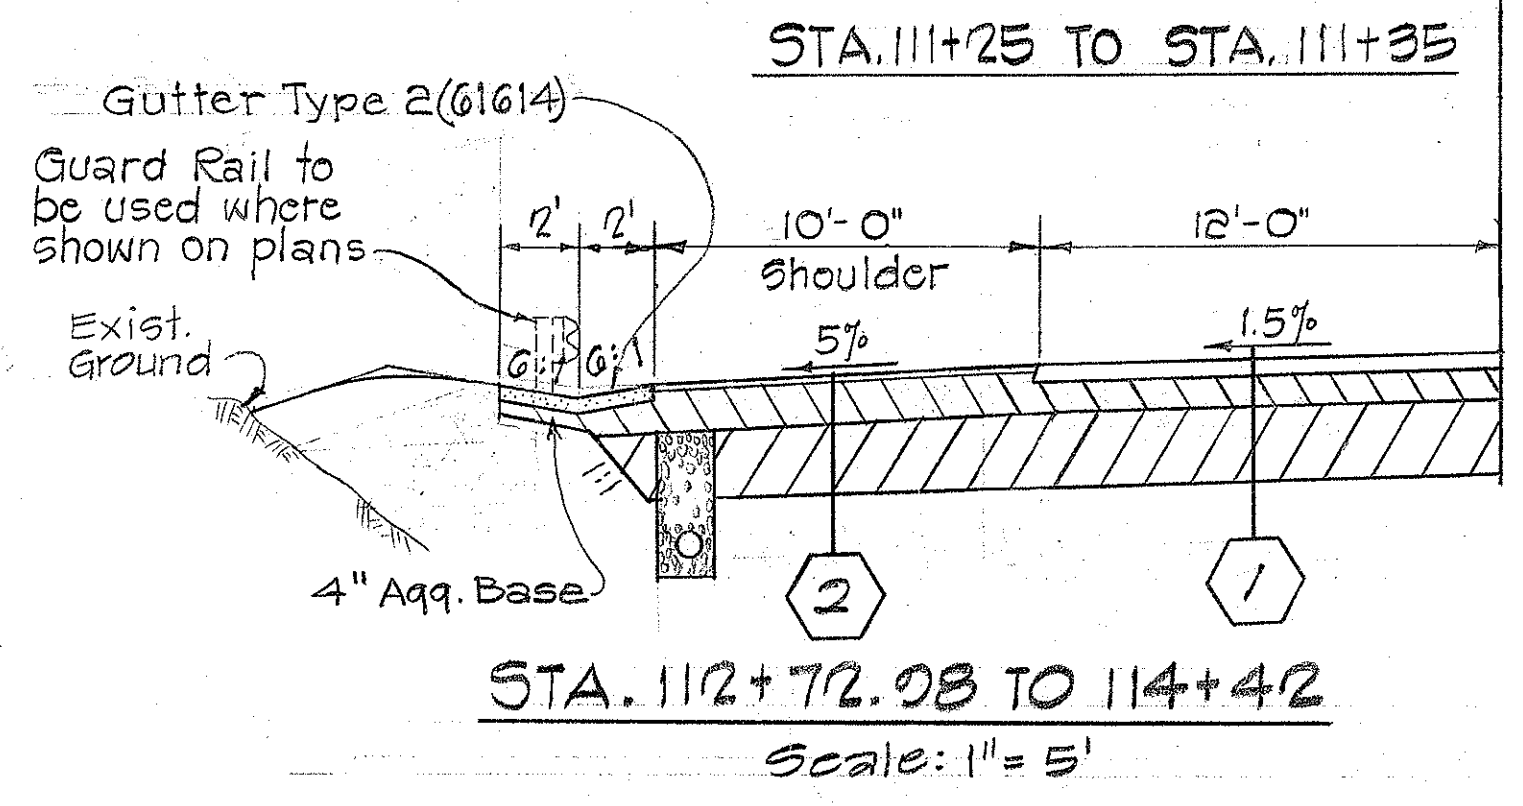
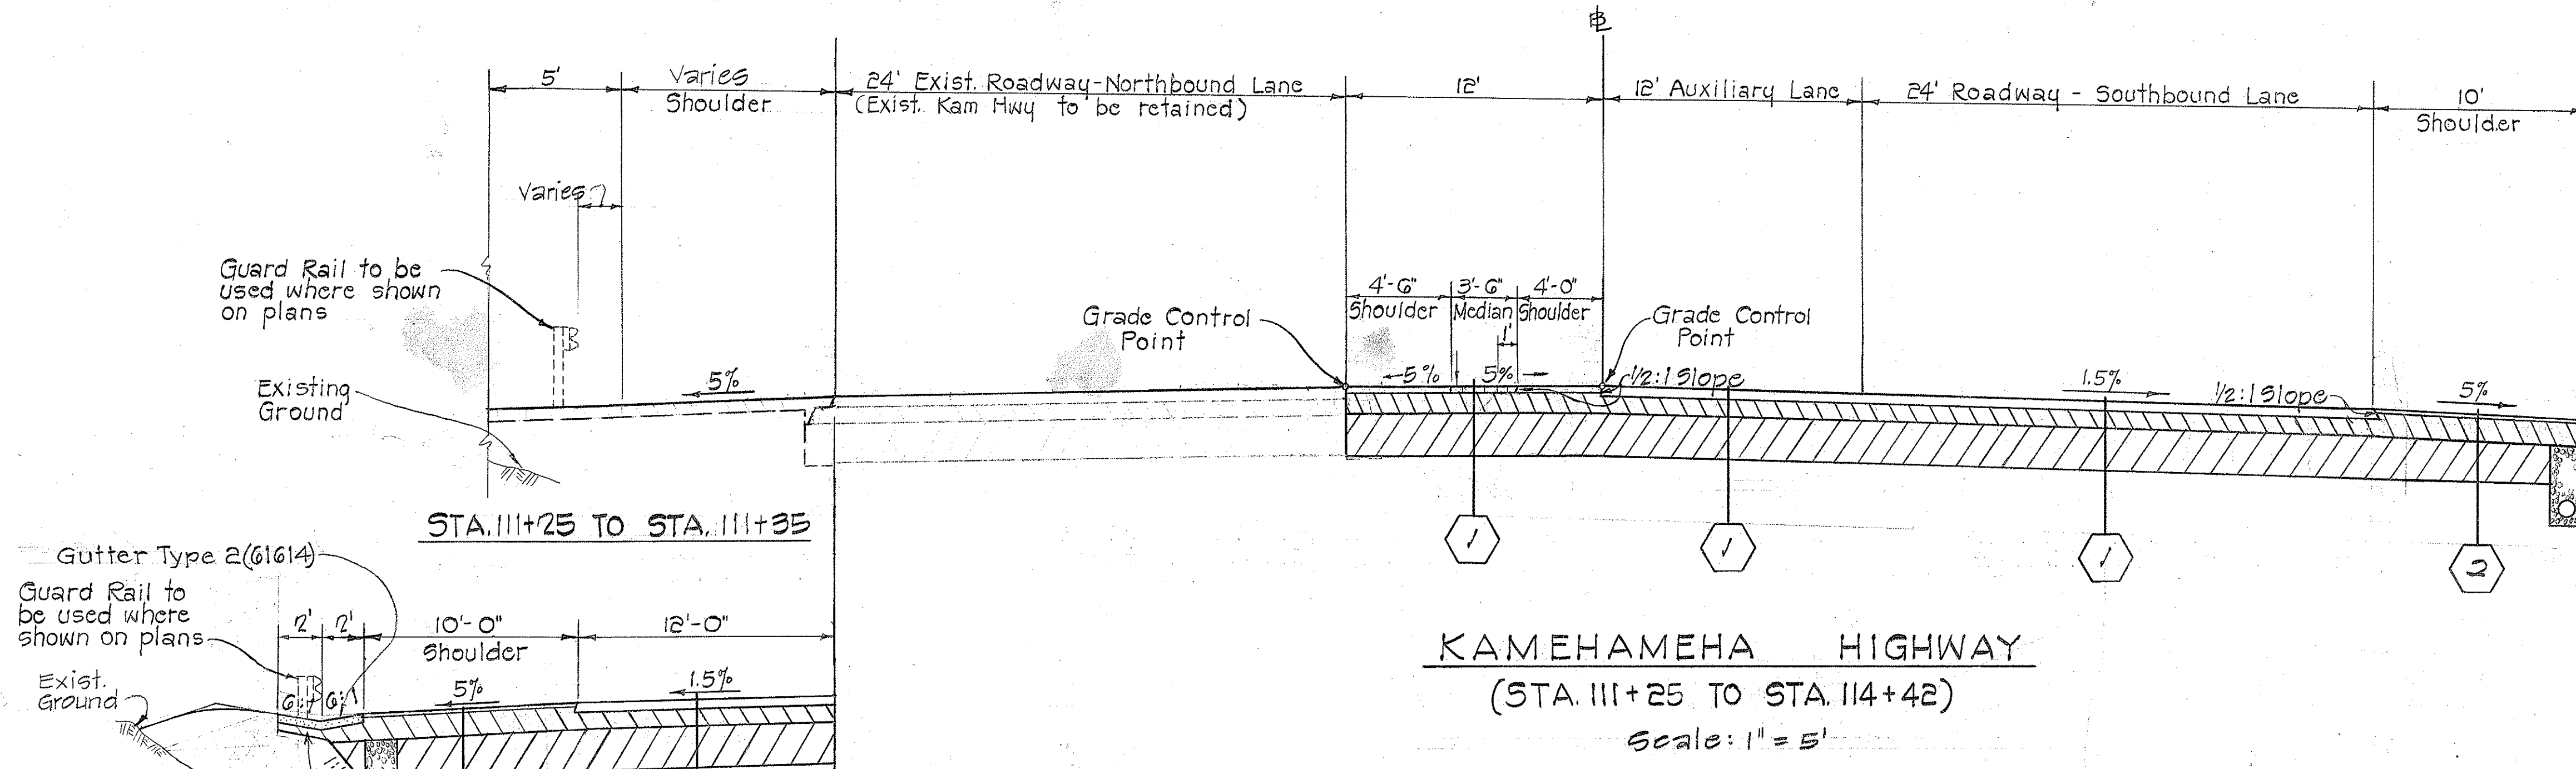


4-1-85	Revised Shoulder Pavement Design of Service Road
DATE	REVISION
STATE OF HAWAII DEPARTMENT OF TRANSPORTATION HIGHWAYS DIVISION	
TYPICAL ROADWAY SECTIONS DETAILS OF TYPE 2 GUTTERS	
HALEKOU INTERCHANGE	
F.A.I. Proj. No. I-H3-1(24)-11	
Scale: As Shown	Date: June 1975
SHEET No. 4 OF 5 SHEETS	

FED. ROAD DIST. NO.	STATE	FED. AID PROJ. NO.	FISCAL YEAR	SHEET NO.	TOTAL SHEETS
HAWAII	HAW.	I-H3-1(24):11	1983	C.O.6	328

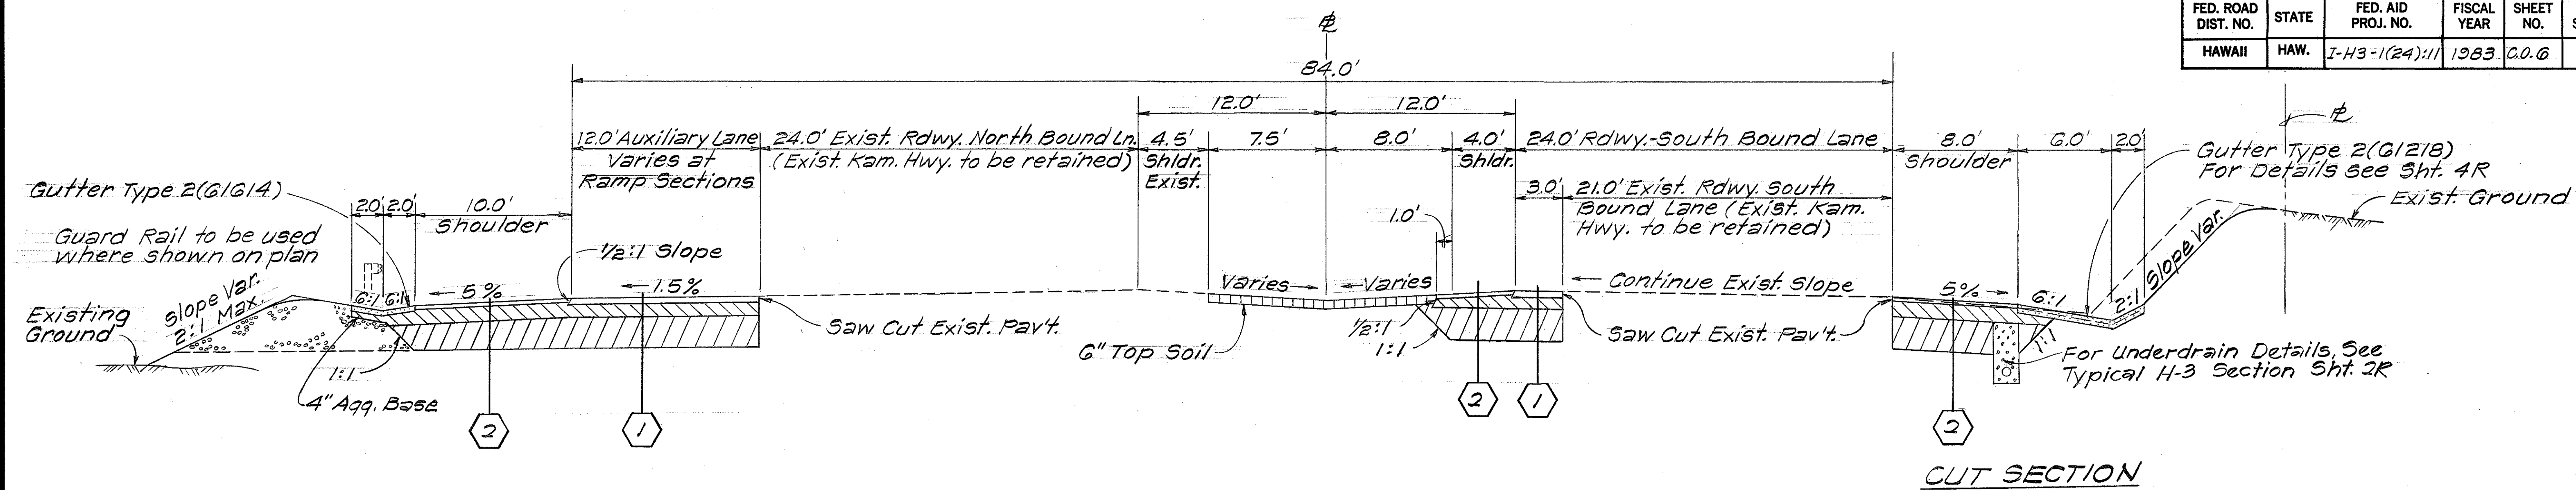

KAMEHAMEHA HIGHWAY (STA. 116+25.31 TO STA. 127+00)
Scale: 1"=5'-0"

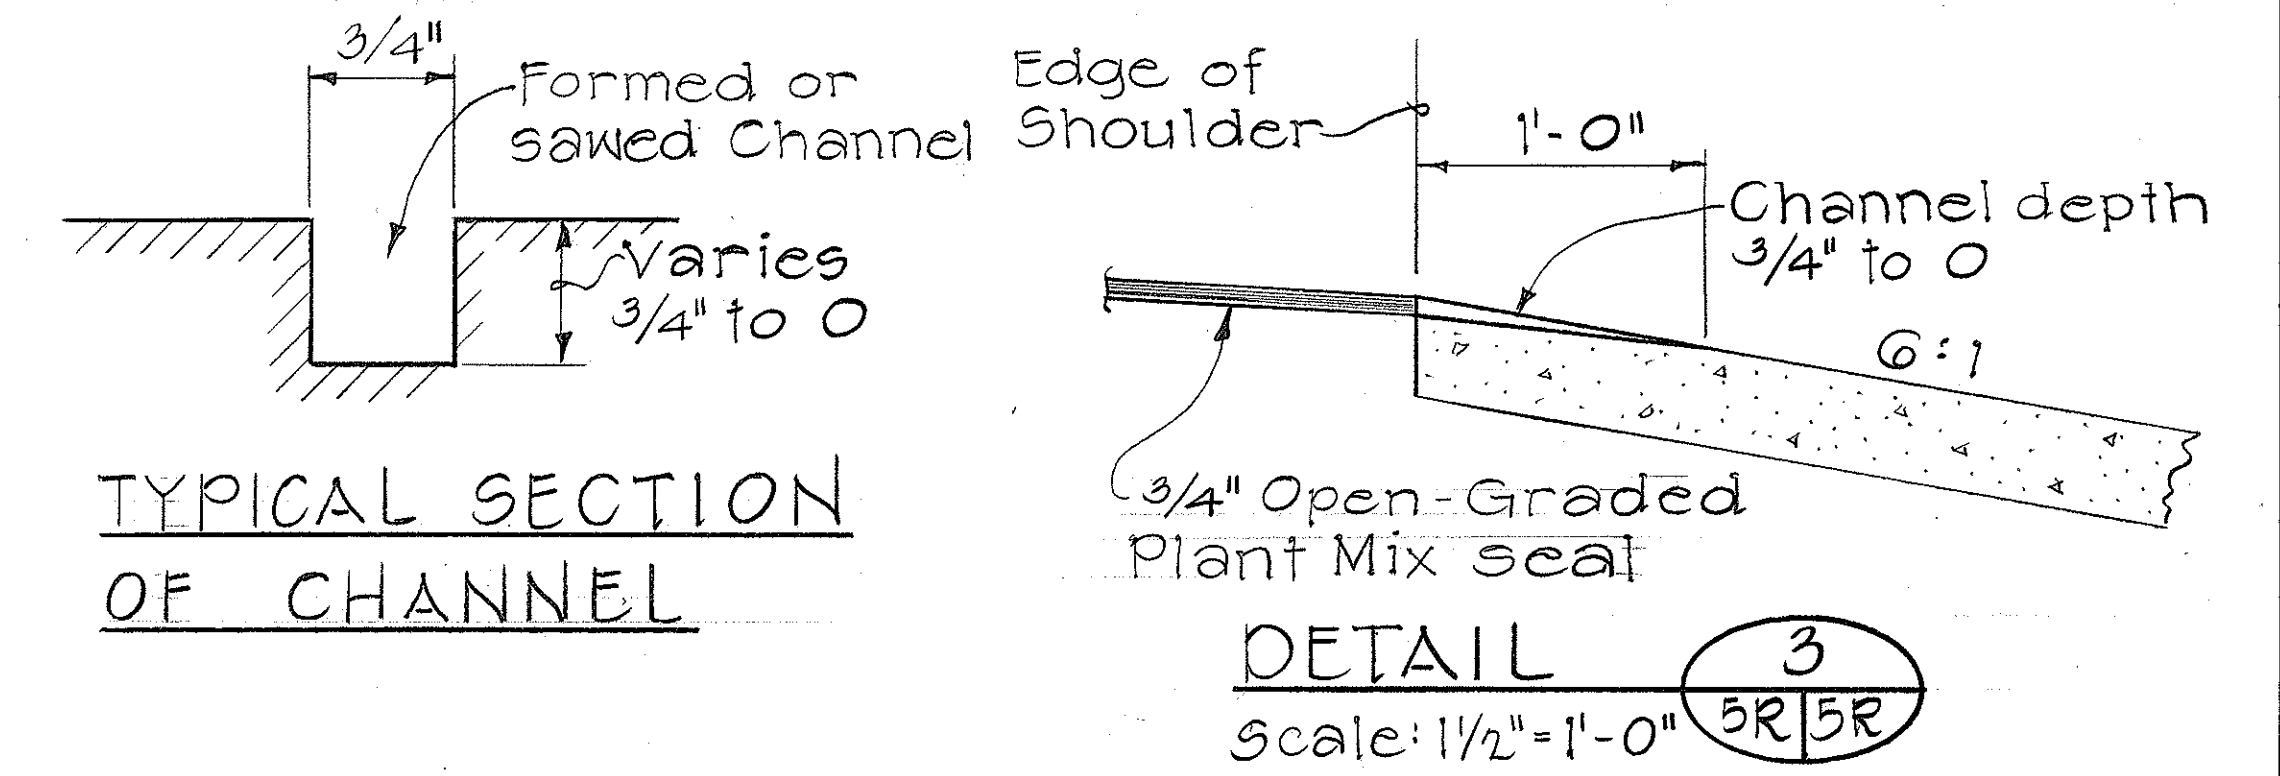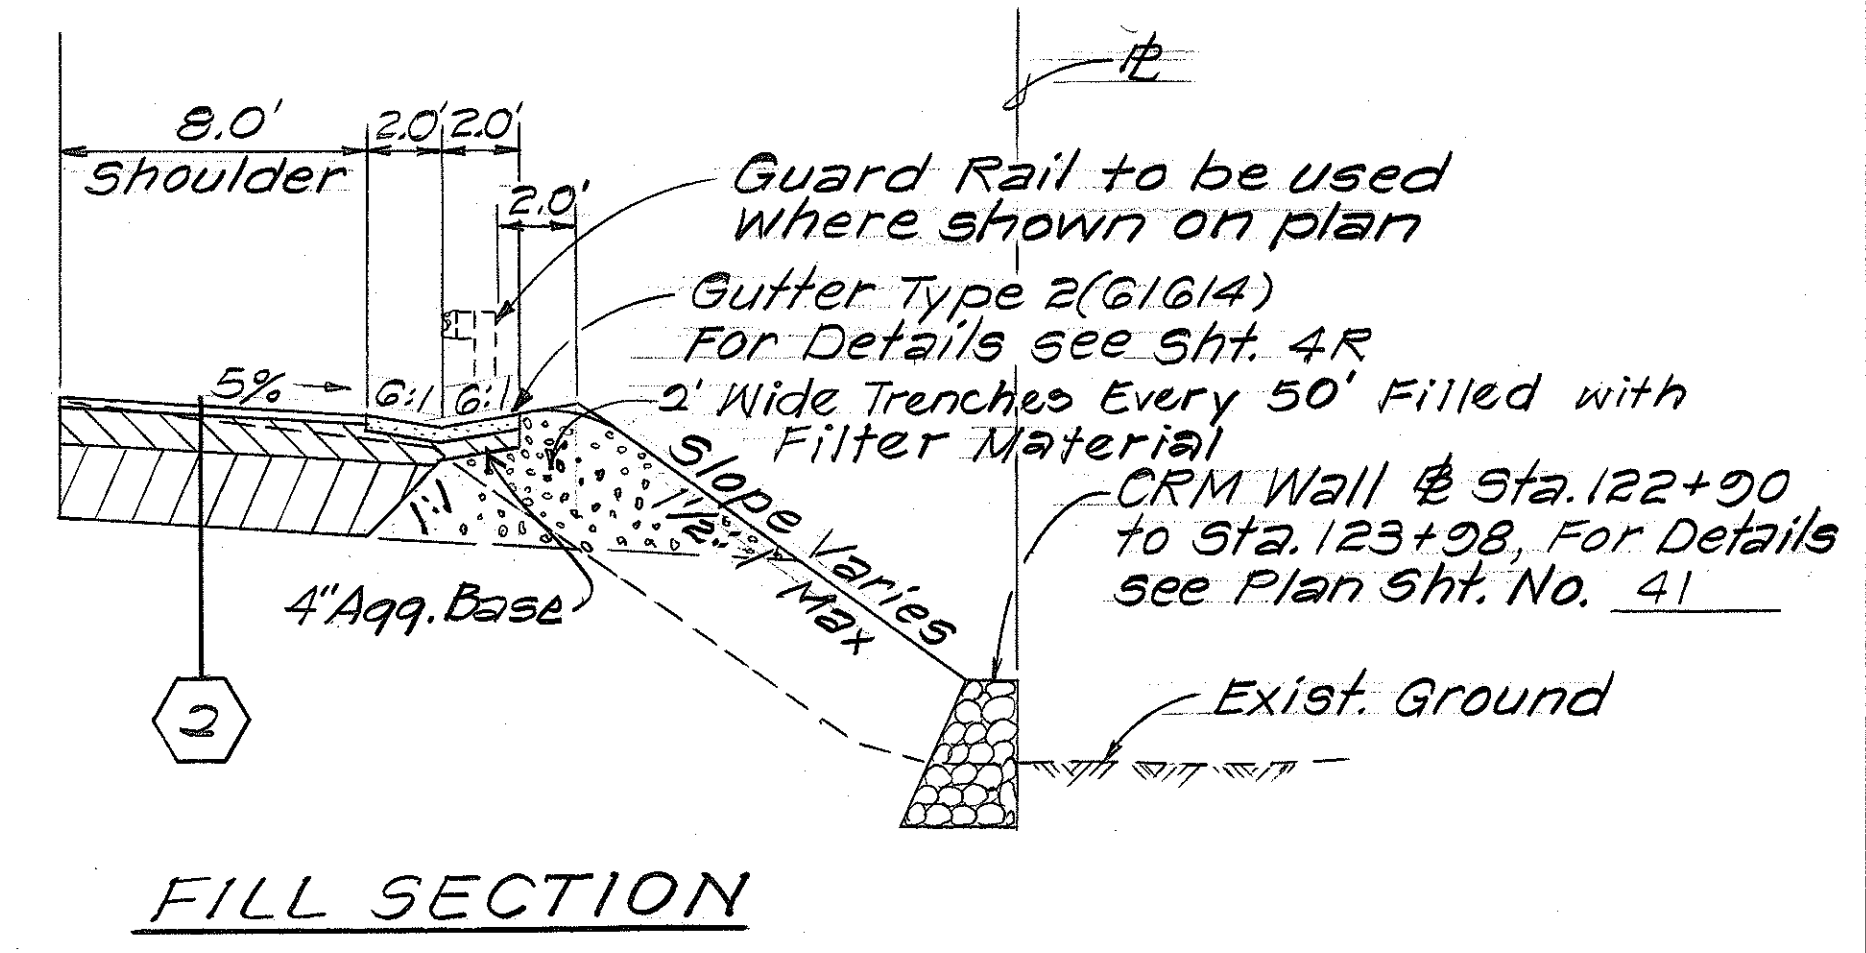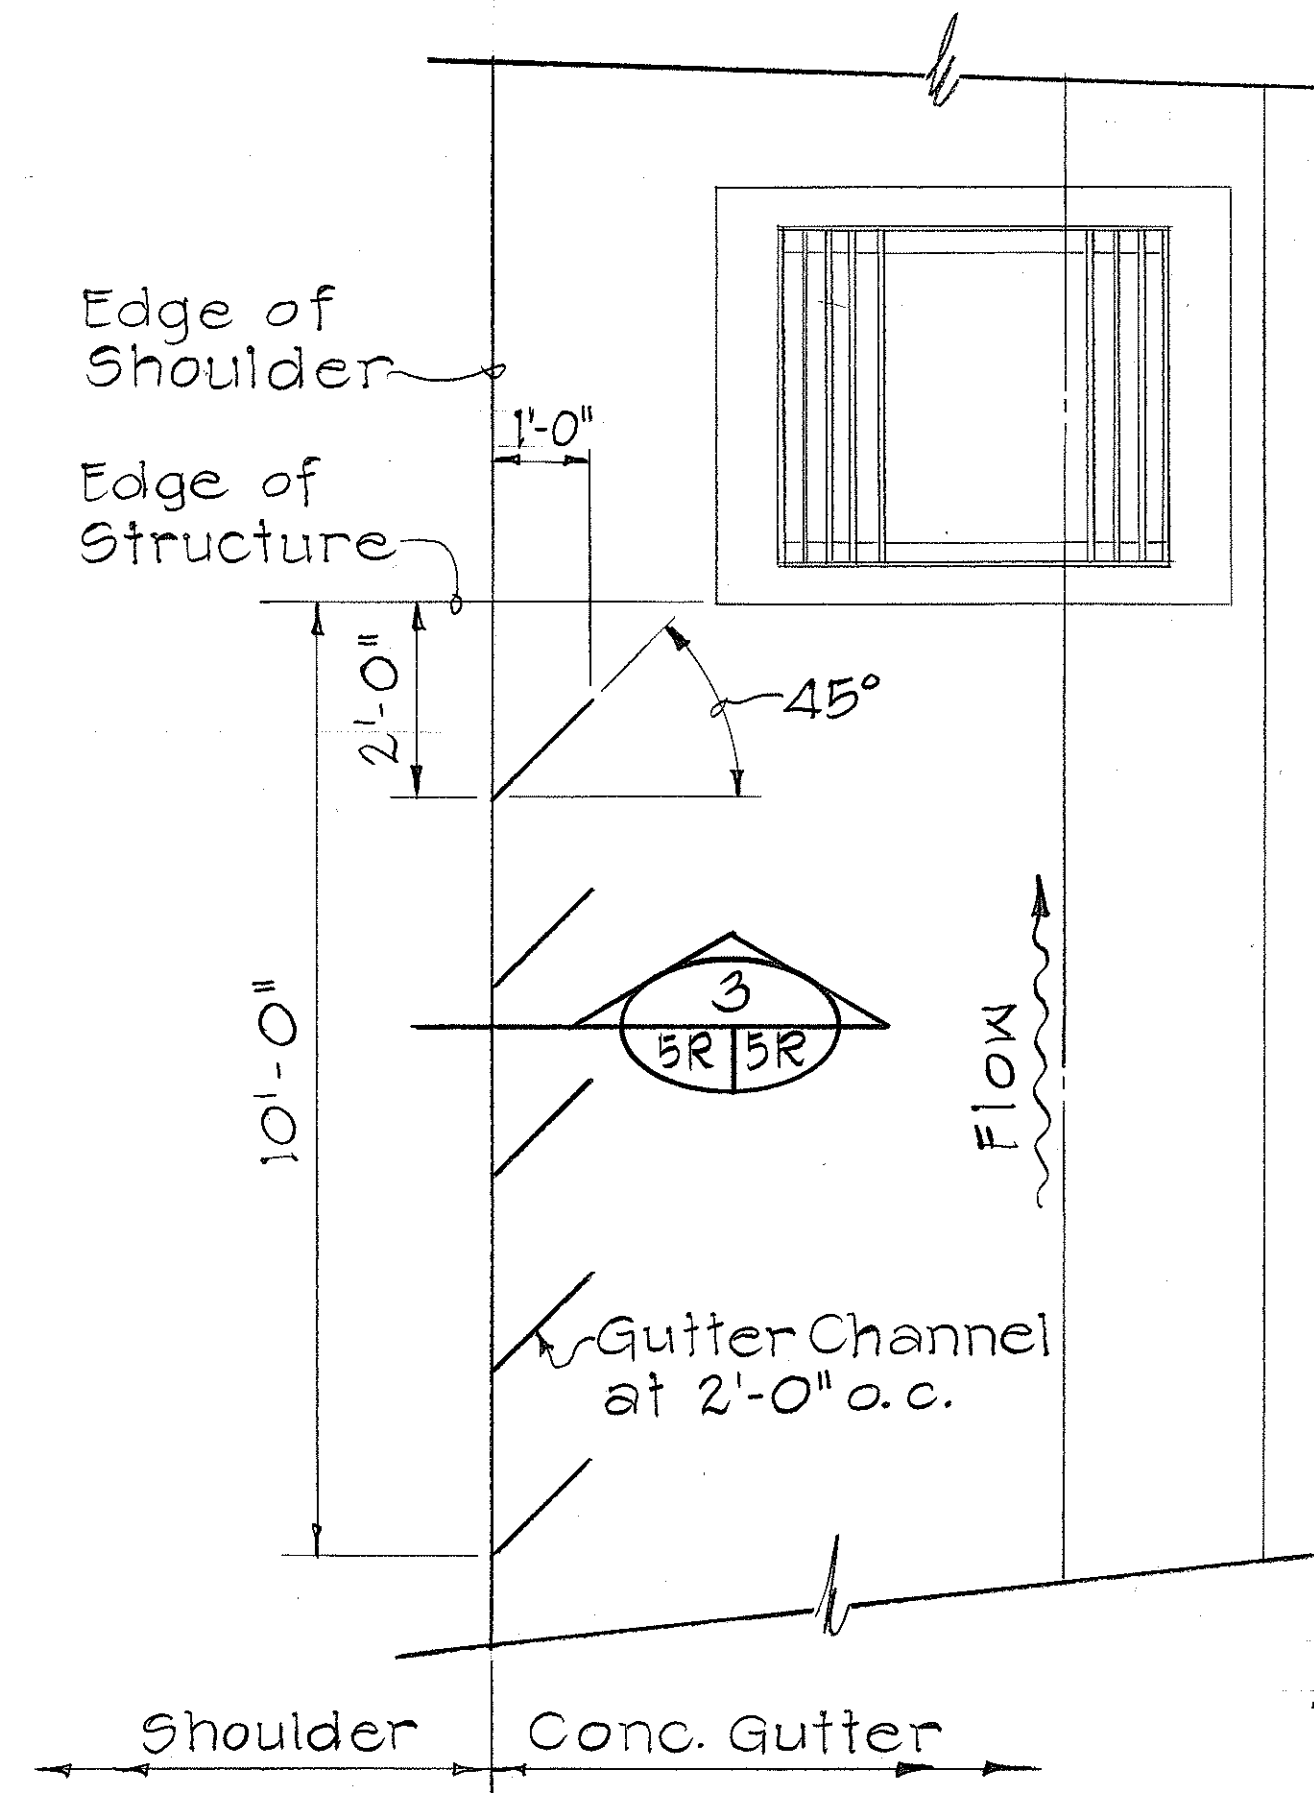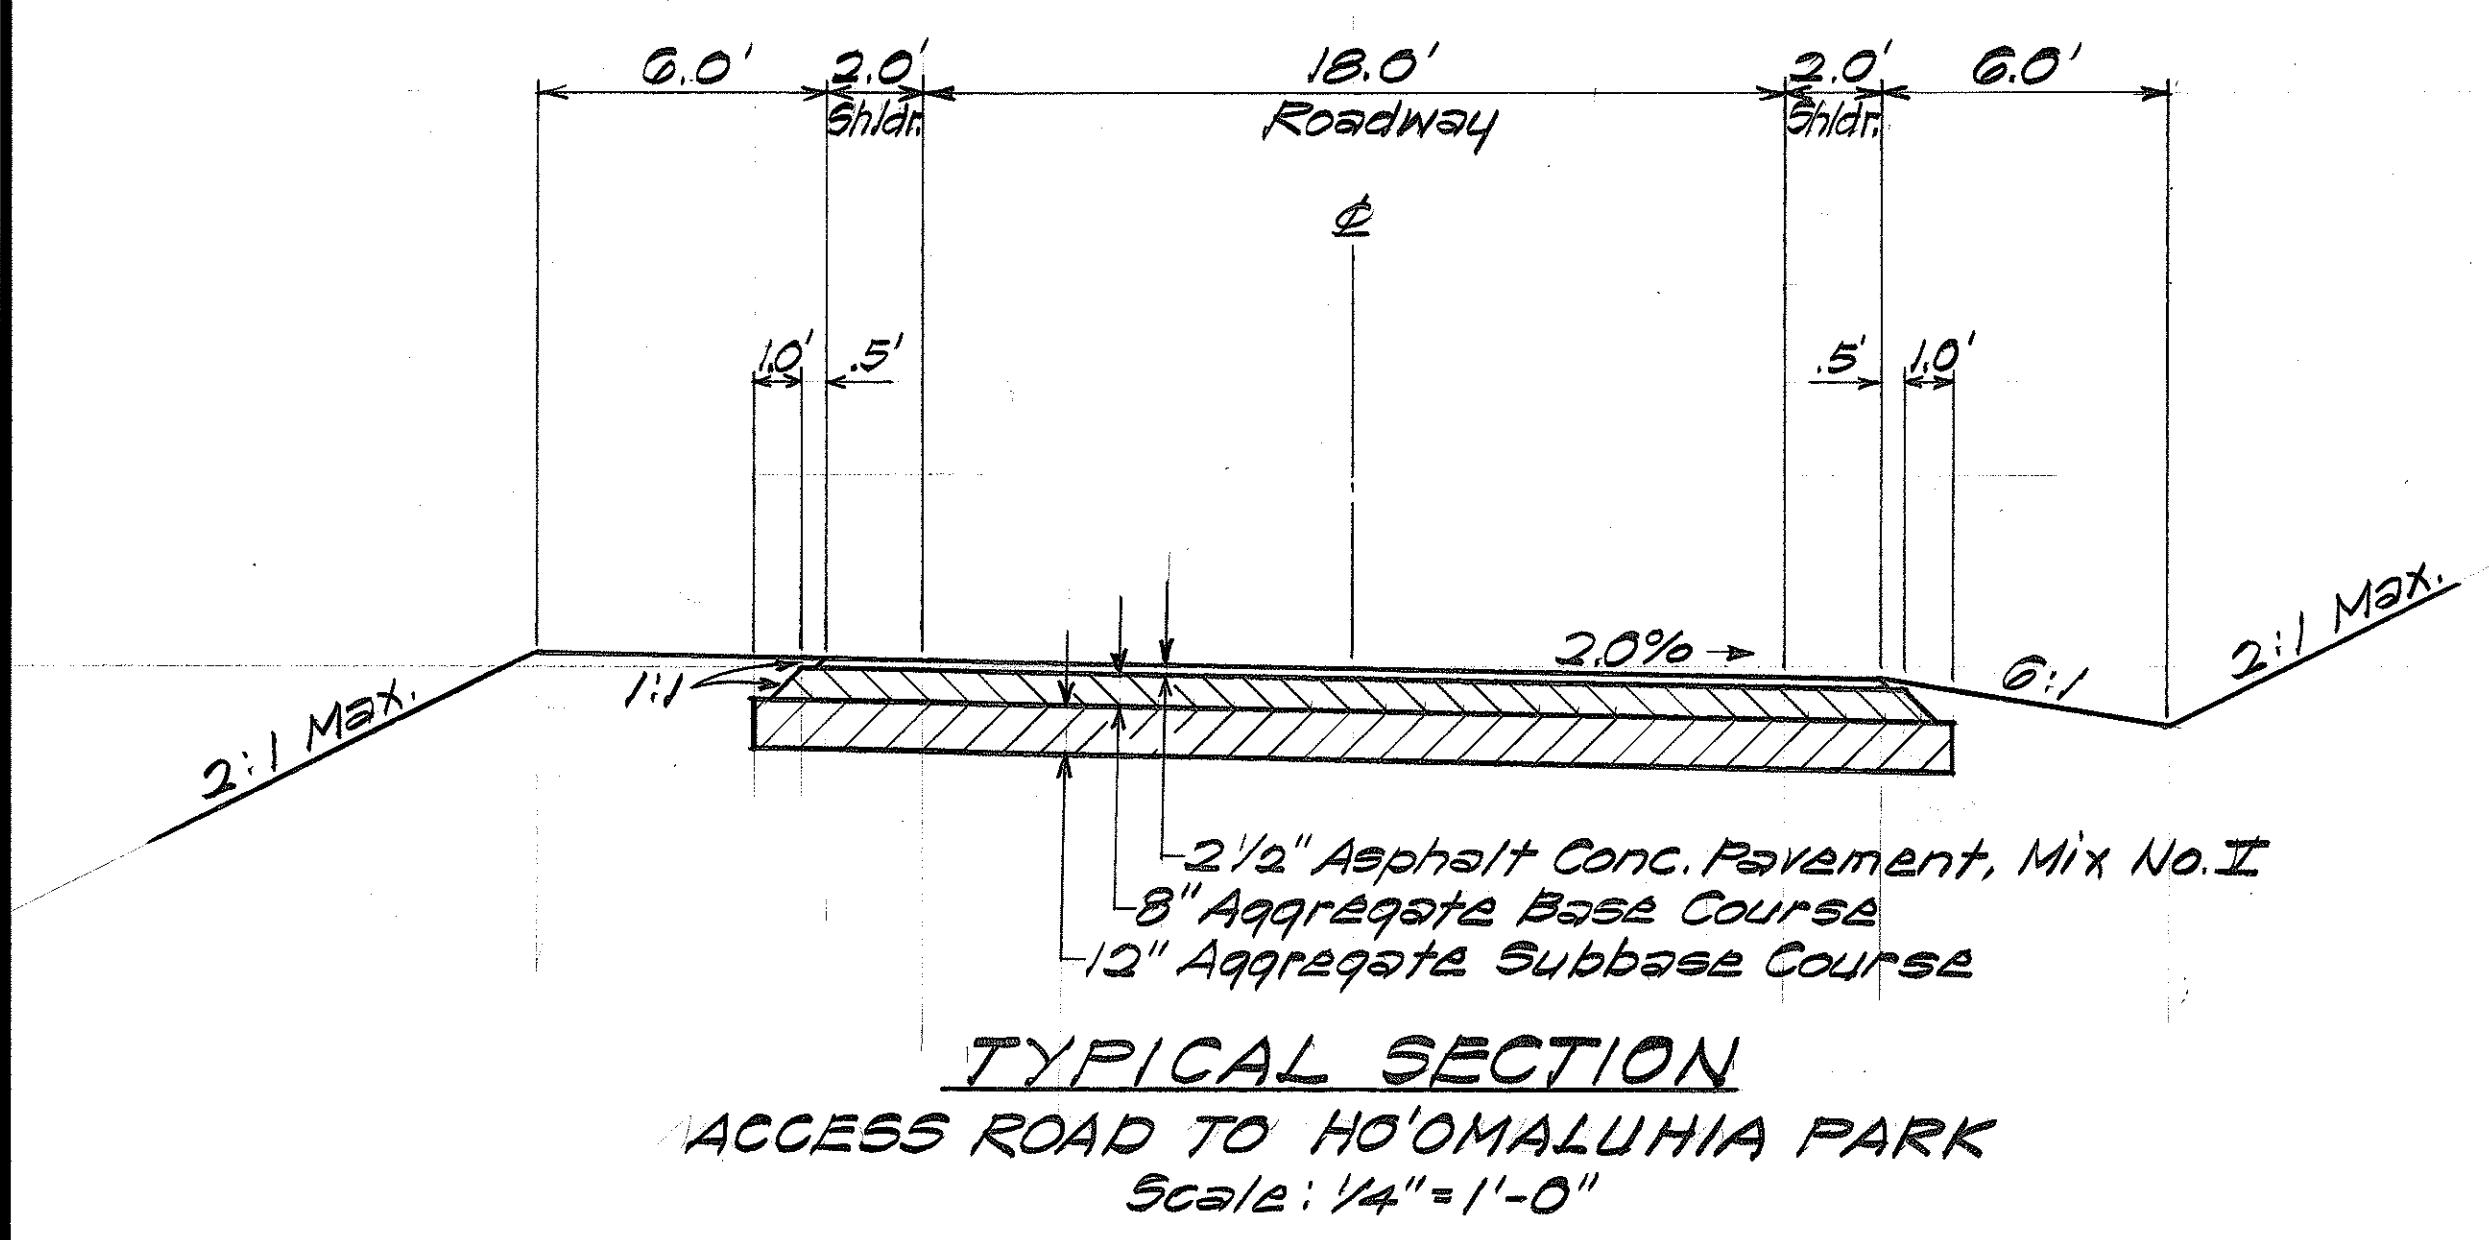

DETAILS OF GUTTER CHANNEL

1/27/84		Tracing revised to show Detail of Gutter Channel.
DATE	REVISION	

STATE OF HAWAII
DEPARTMENT OF TRANSPORTATION
LAND TRANSPORTATION FACILITIES DIVISION


TYPICAL ROADWAY SECTIONS

HALEKOU INTERCHANGE
F.A.I. Proj. No. I-H3-1(24):11
Scale: 1"=5'-0" Date: Sept, 1982


SHEET NO. 5R OF 5 SHEETS

SURVEY PLOTTED BY	DATE
DRAWN BY	
DESIGNED BY	
QUANTITIES BY	
CHECKED BY	


FED. ROAD DIST. NO.	STATE	FED. AID PROJ. NO.	FISCAL YEAR	SHEET NO.	TOTAL SHEETS
HAWAII	HAW.	I-H3-1(24):11	1983	C065-1	328

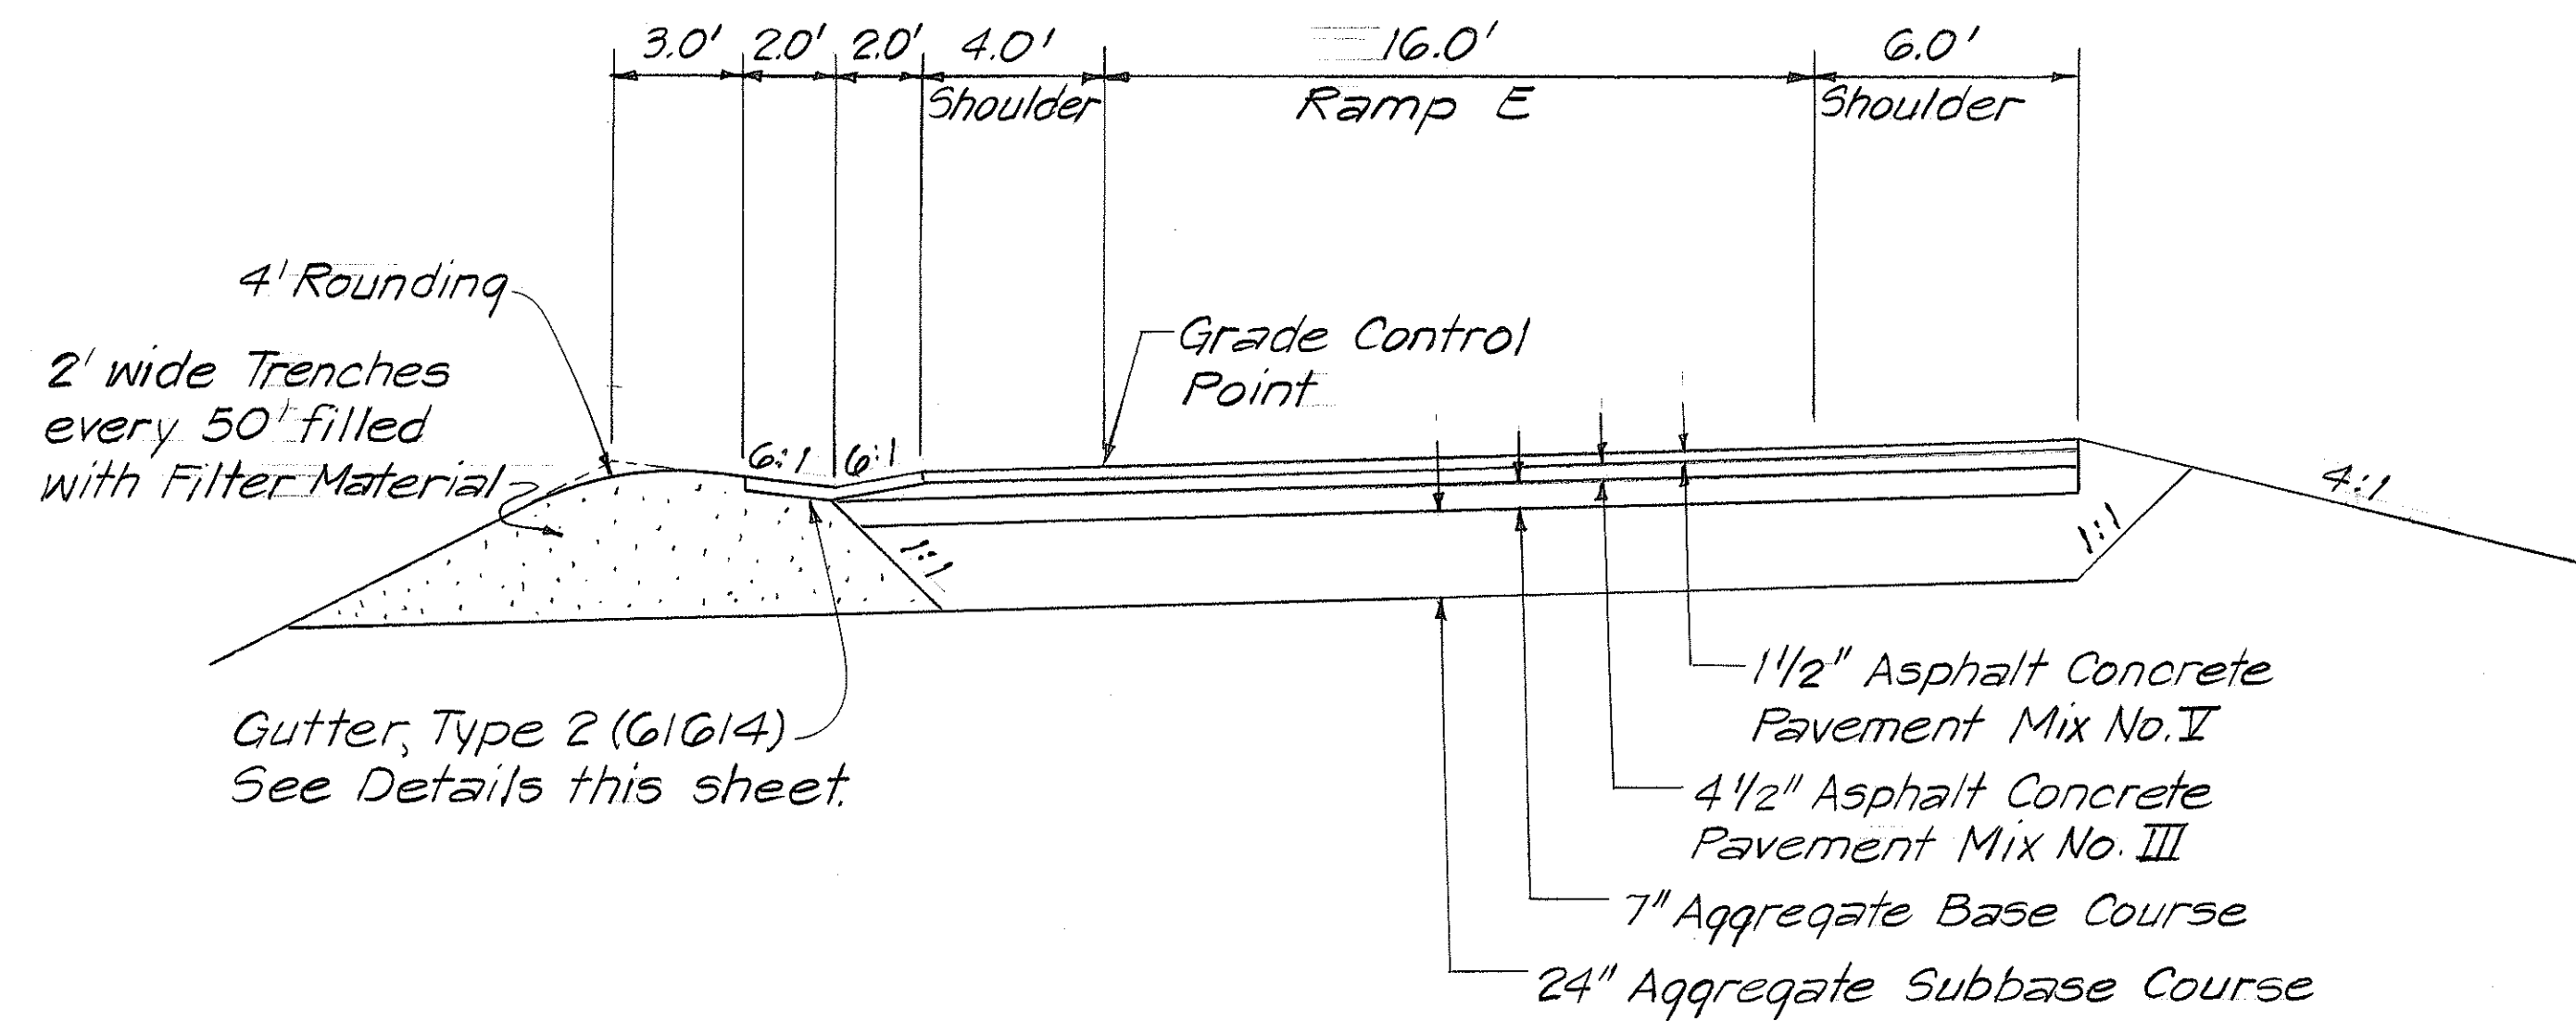

TYPICAL SECTION - RAMP E
Scale: 1/4" = 1'-0"

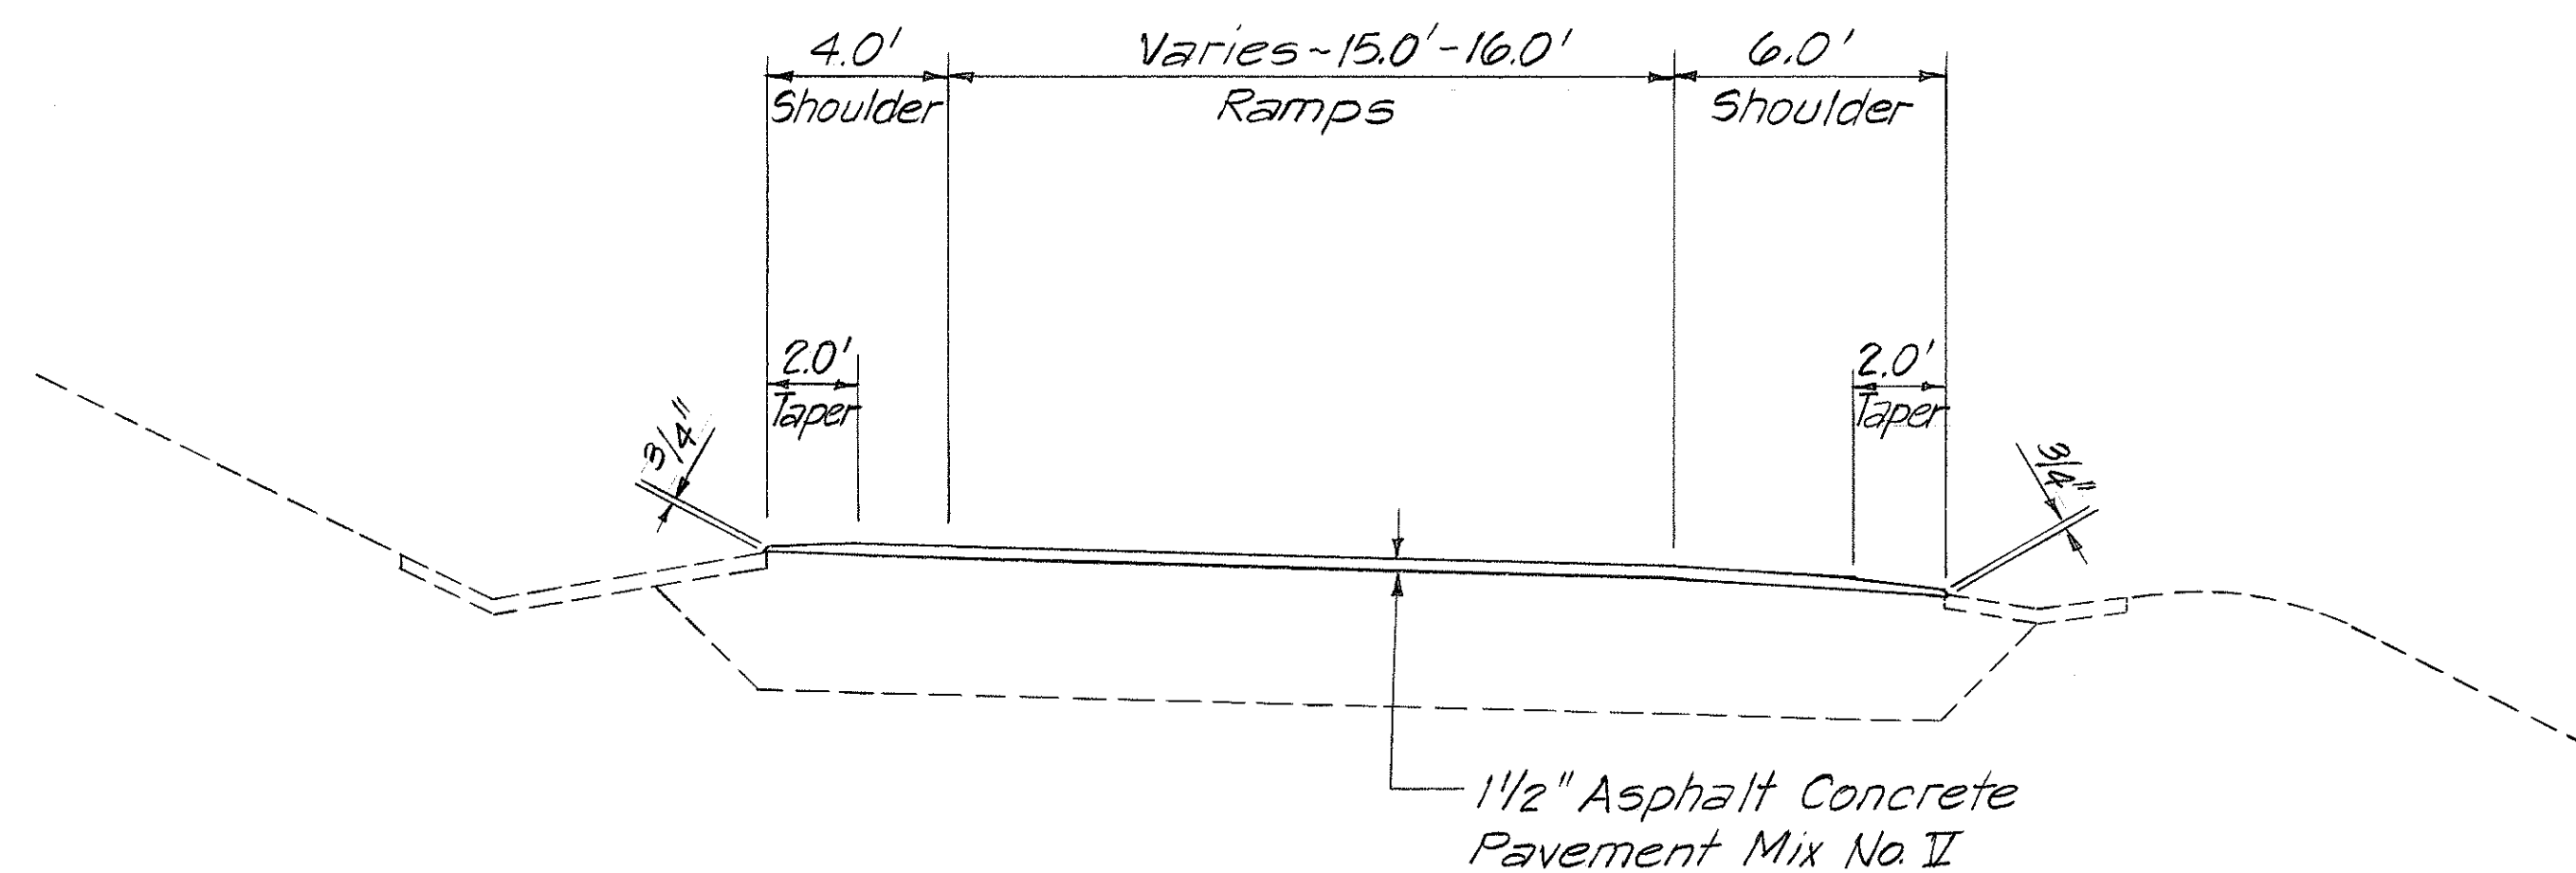

TYPICAL SECTION
RESURFACING RAMPS D, G & F
Scale: 1/4" = 1'-0"

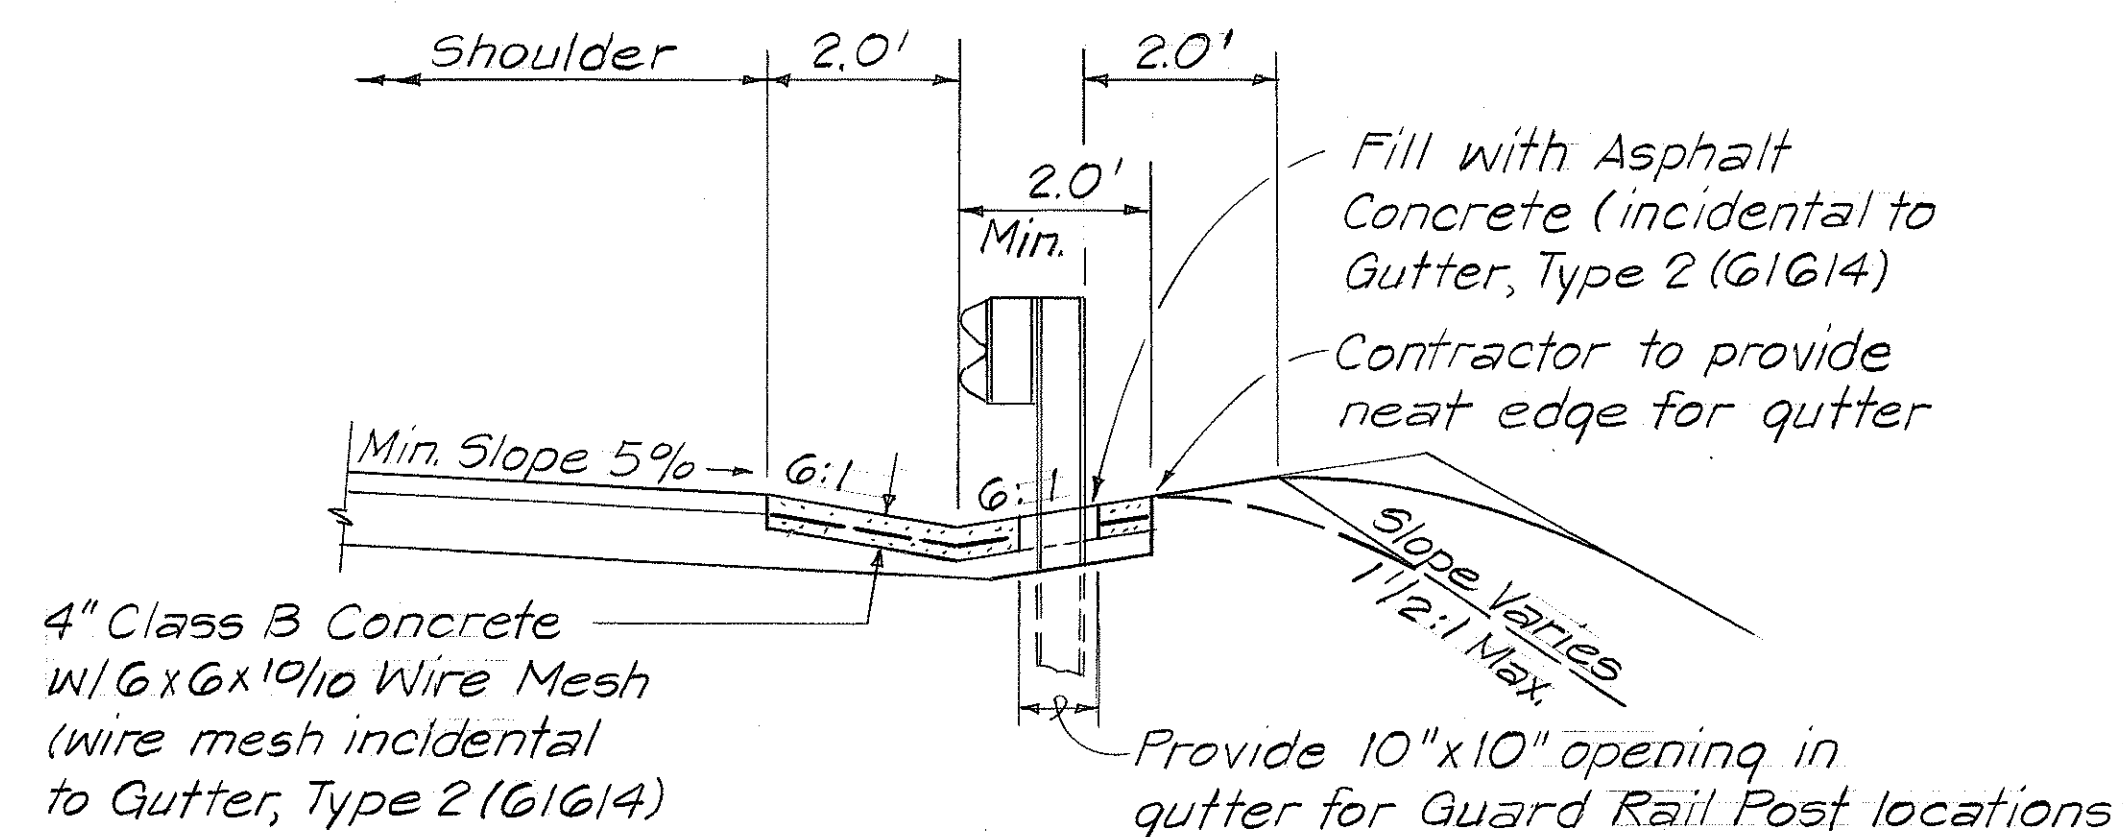

GUTTER, TYPE 2 (G1G14)
Scale: 1/2" = 1'-0"

STATE OF HAWAII
DEPARTMENT OF TRANSPORTATION
HIGHWAYS DIVISION

TYPICAL RAMP SECTIONS

HALEKOU INTERCHANGE
FAI. PROJECT NO. I-H3-1(24):11

Scale: As Shown Date: Oct., 1986

SHEET NO. OF SHEETS

C.O. 6 S-1

C.O. 6 S-1

SURVEY PLOTTED BY	DATE
DRAWN BY	
DESIGNED BY	
QUANTITIES BY	
CHECKED BY	
ORIGINAL PLAN	
NOTE BOOK	
No.	