
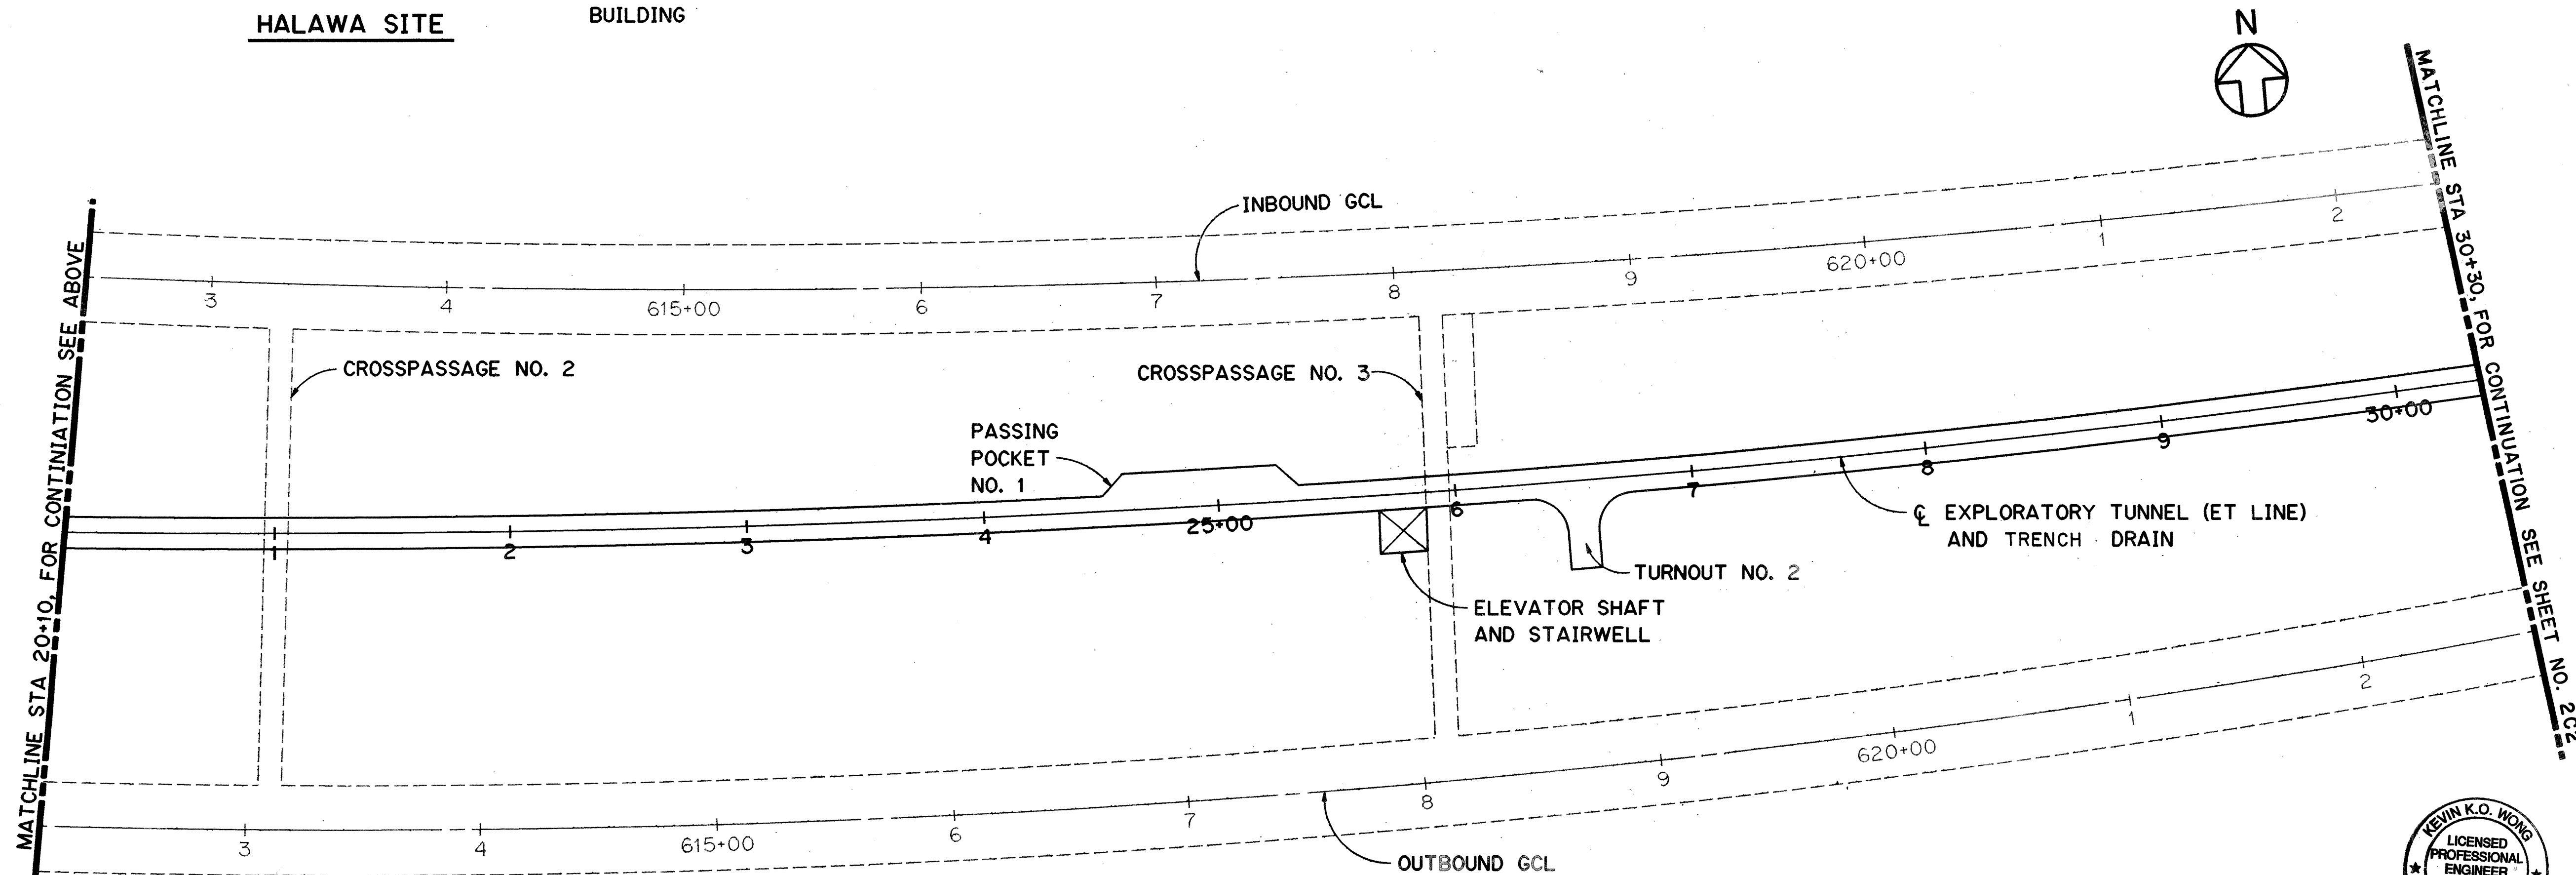




FED. ROAD DIST. NO.	STATE	FED. AID PROJ. NO.	FISCAL YEAR	SHEET NO.	TOTAL SHEETS
HAWAII	HAW.	1-H3-1(75) UNIT III	1994	17	353

NOTES:

- FOR CIVIL ABBREVIATIONS, SYMBOLS AND GENERAL NOTES SEE SHEET NO. 1011.
- FOR TYPICAL TUNNEL SECTION, SEE SHEET NO. 2C3.
- FOR DETAILS SEE STRUCTURAL PLANS.
- TUNNEL EXCAVATION, STA 10+68 TO 14+88 IS CONSIDERED "TYPE C", EXTREMELY WEATHERED BASALTIC ROCK. MATERIAL NOT ELIGIBLE FOR USE AS SELECT FILL.

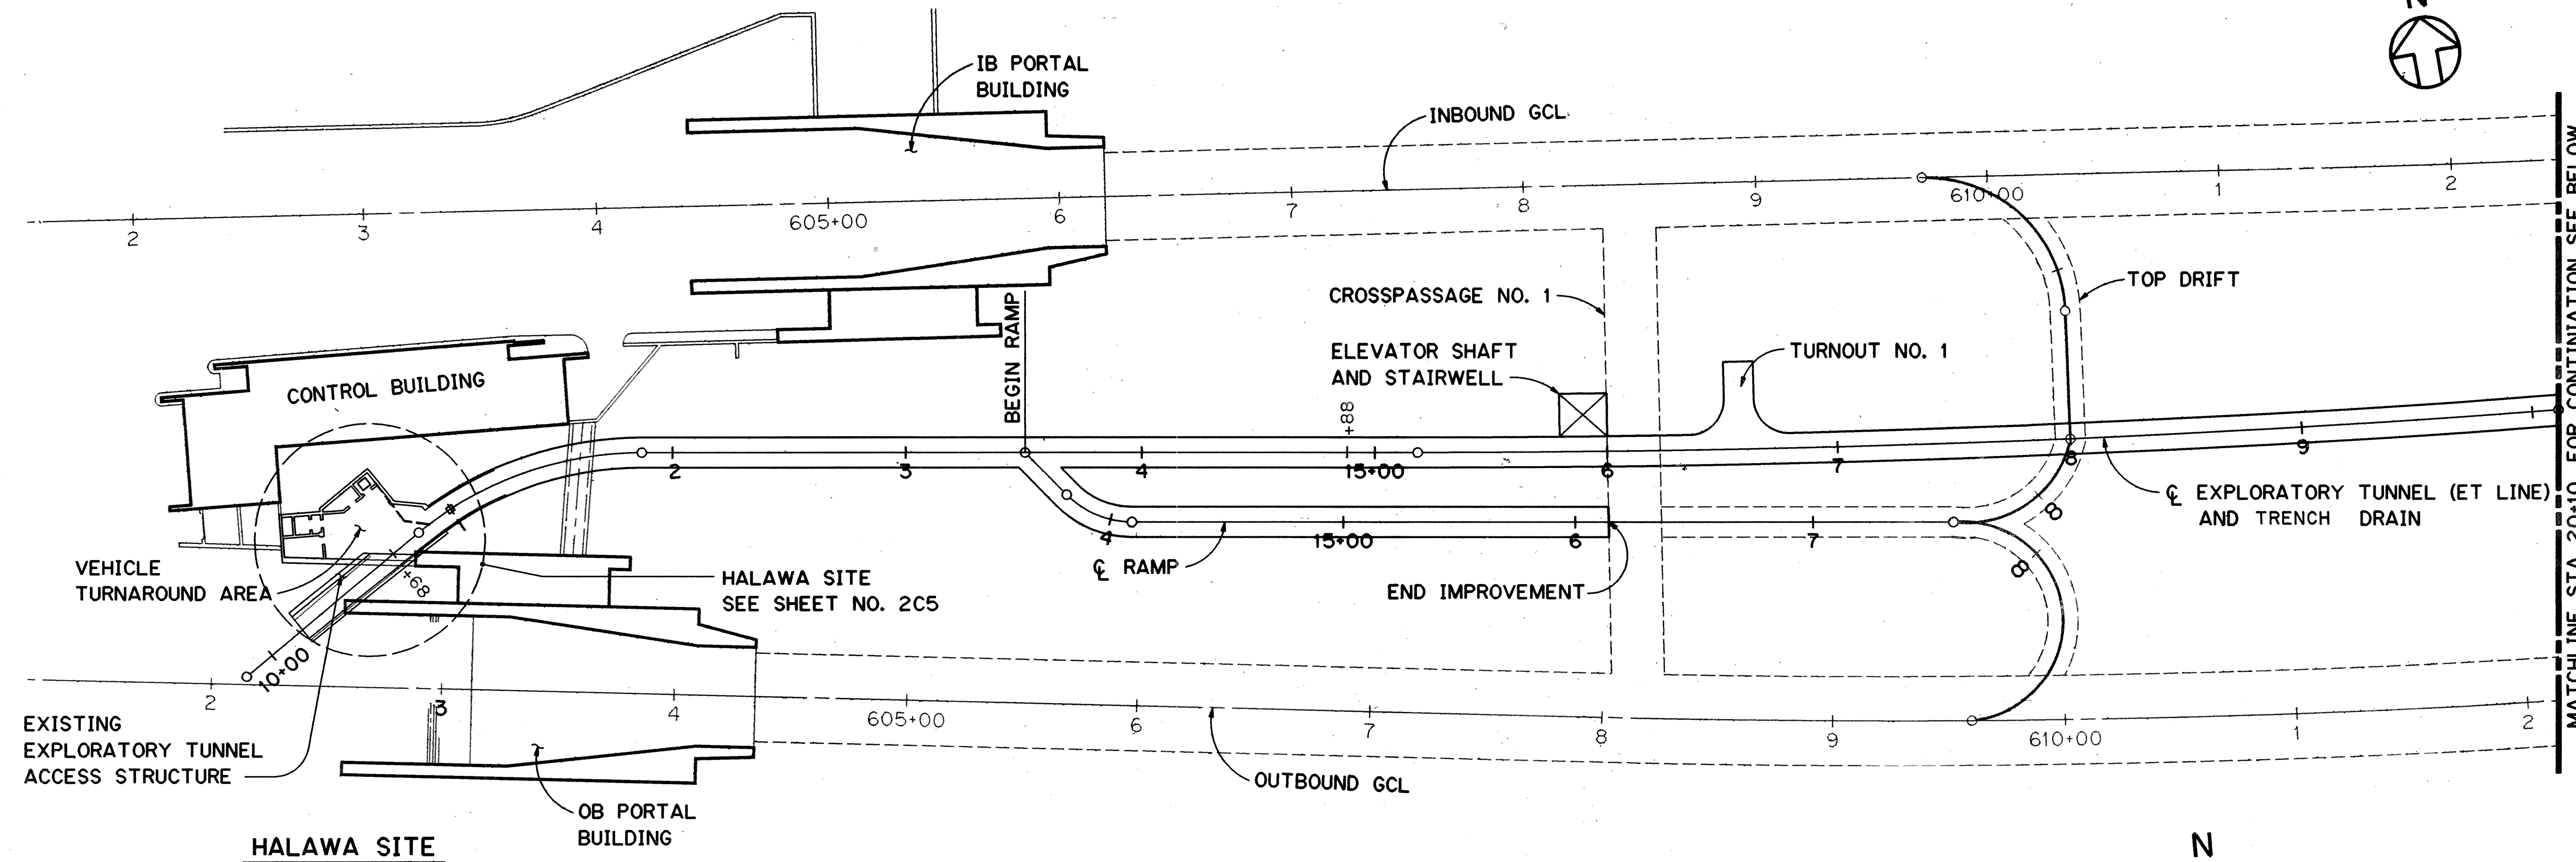

ORIGINAL PLAN	DATE
NO.	JAN 95
NOTE BOOK	JAN 95
CHECKED BY	D. MANITI
DESIGNED BY	G. TE BUCKHART
TRACED BY	B. VUONG
SURVEY PLOTTED BY	JAN 95

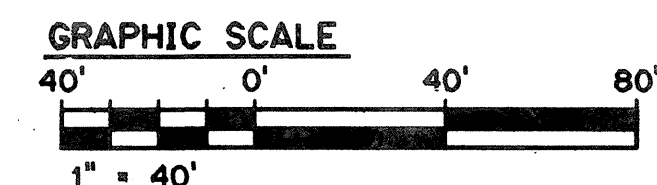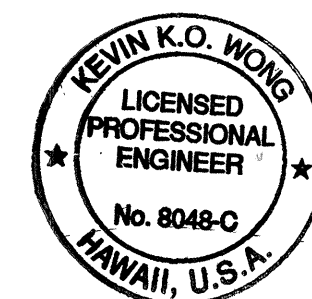

THIS WORK WAS PREPARED BY ME OR UNDER MY SUPERVISION.

Kevin K.O. Wong

DATE	REVISION
9/3/96	DCN 75-007: CHANGED SLOTTED DRAIN TO TRENCH DRAIN

STATE OF HAWAII
DEPARTMENT OF TRANSPORTATION
HIGHWAYS DIVISION

GENERAL PLAN - 1

EXPLORATORY TUNNEL IMPROVEMENTS



H-3 FINISH (UNIT III)
FAIP NO. 1-H3-1(75), UNIT III
T.K. TUNNEL / ACCESS ROADS

SCALE: 1"=40'-0" DATE: JUN 1995



SHEET NO. 2C1 OF 15 SHEETS

FED. ROAD DIST. NO.	STATE	FED. AID PROJ. NO.	FISCAL YEAR	SHEET NO.	TOTAL SHEETS
HAWAII	HAW.	I-H3-1(75) UNIT III	1994	18	353

NOTE:
FOR NOTES, SEE SHEET NO. 2C1.

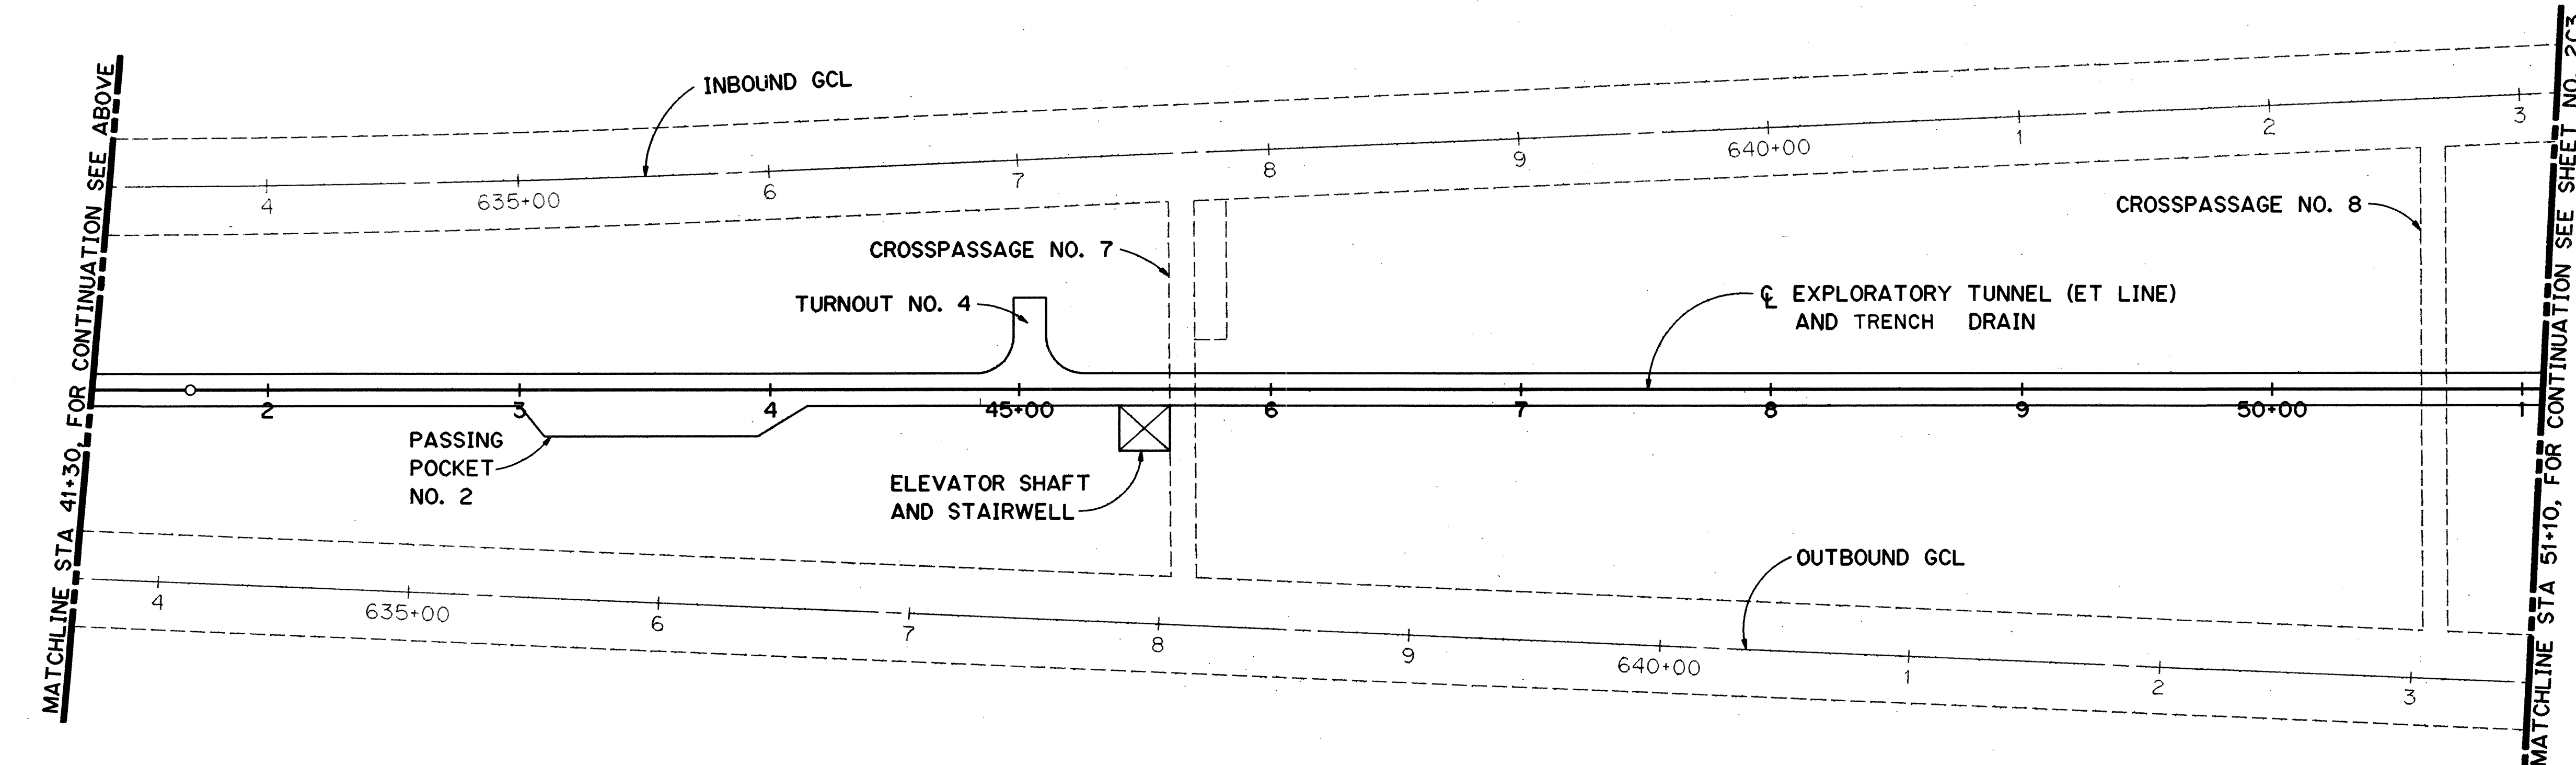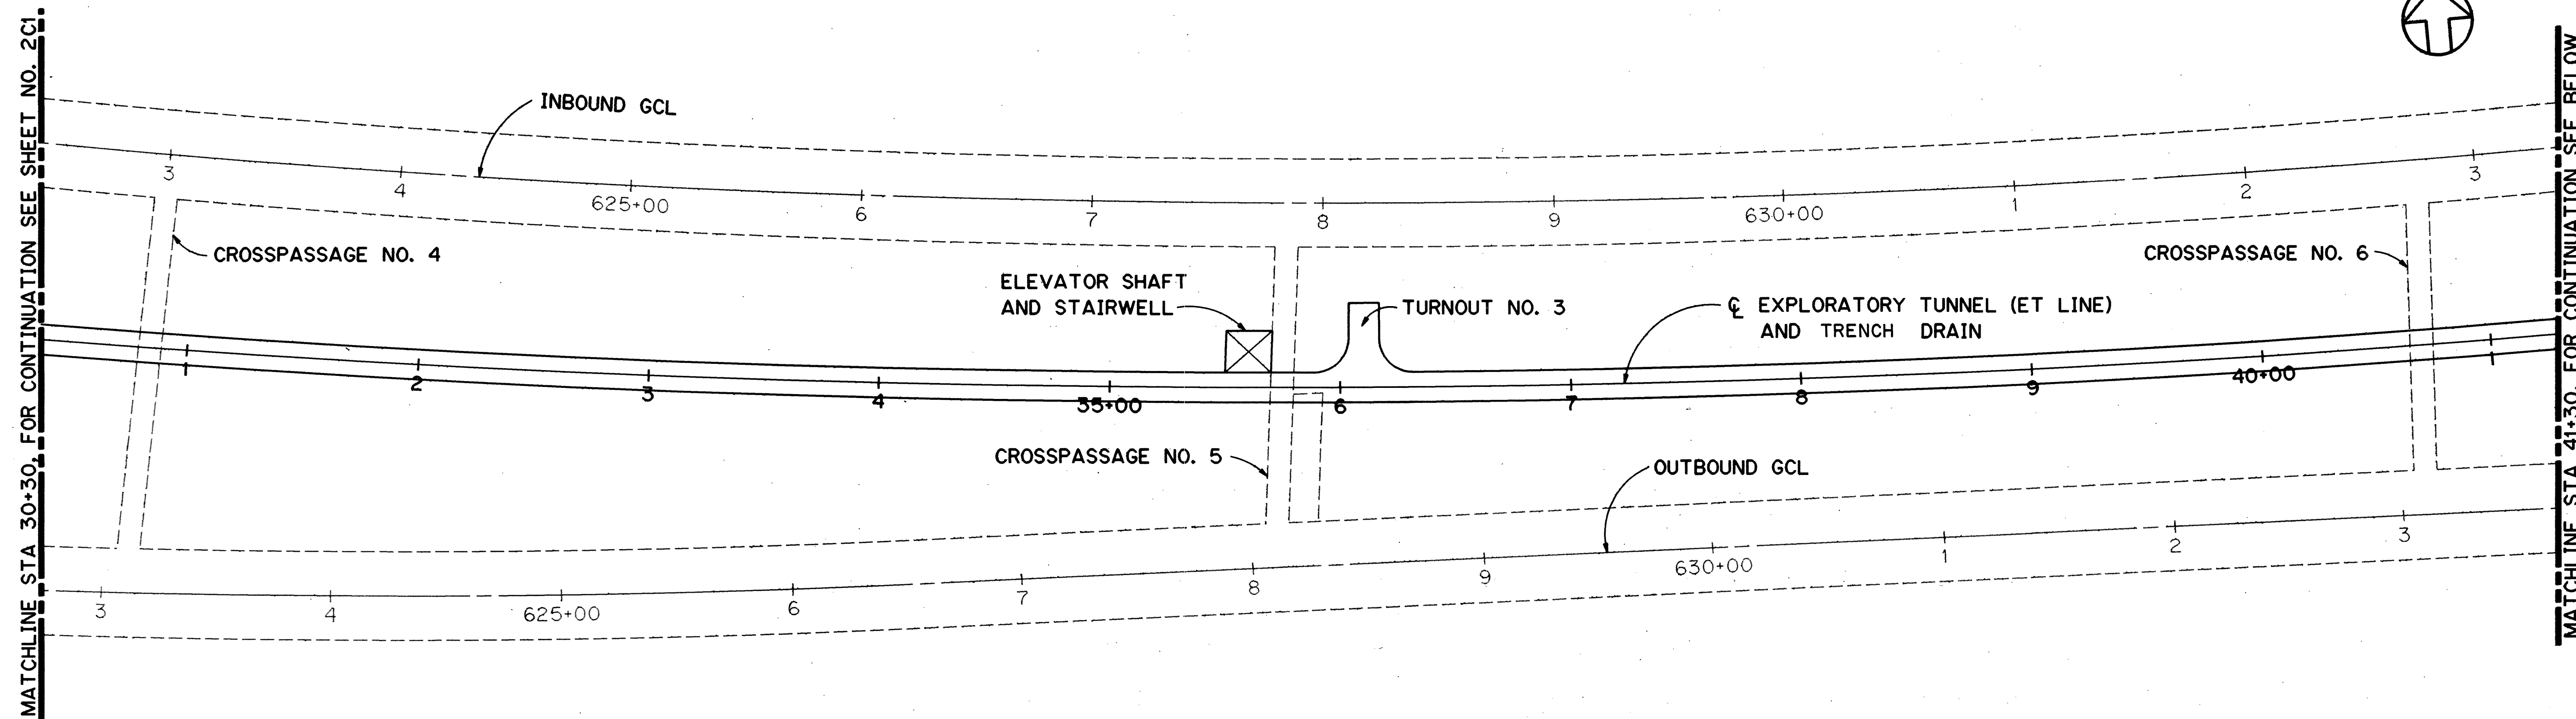

ORIGINAL PLAN	NO.
SURVEY PLOTTED BY	DATE
DRAWN BY	JAN 95
TRACED BY	JAN 95
DESIGNED BY	JAN 95
QUANTITIES BY	JAN 95
CHECKED BY	JAN 95

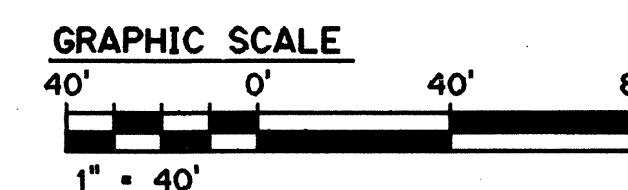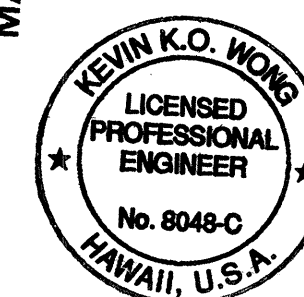

THIS WORK WAS PREPARED BY ME
OR UNDER MY SUPERVISION


Kevin K.O. Wong

DATE	REVISION
9/3/96	DCN 75-007: CHANGED SLOTTED DRAIN TO TRENCH DRAIN




STATE OF HAWAII DEPARTMENT OF TRANSPORTATION HIGHWAYS DIVISION
GENERAL PLAN - 2
EXPLORATORY TUNNEL IMPROVEMENTS
H-3 FINISH (UNIT III)
FAIP NO. I-H3-1(75), UNIT III
T.K. TUNNEL / ACCESS ROADS
SCALE: 1"=40'-0" DATE: JUN 1995
SHEET NO. 2C2 OF 15 SHEETS

FED. ROAD DIST. NO.	STATE	FED. AID PROJ. NO.	FISCAL YEAR	SHEET NO.	TOTAL SHEETS
HAWAII	HAW.	I-H3-1(75) UNIT III	1994	19	353

NOTE:
FOR NOTES, SEE SHEET NO. 2C1.

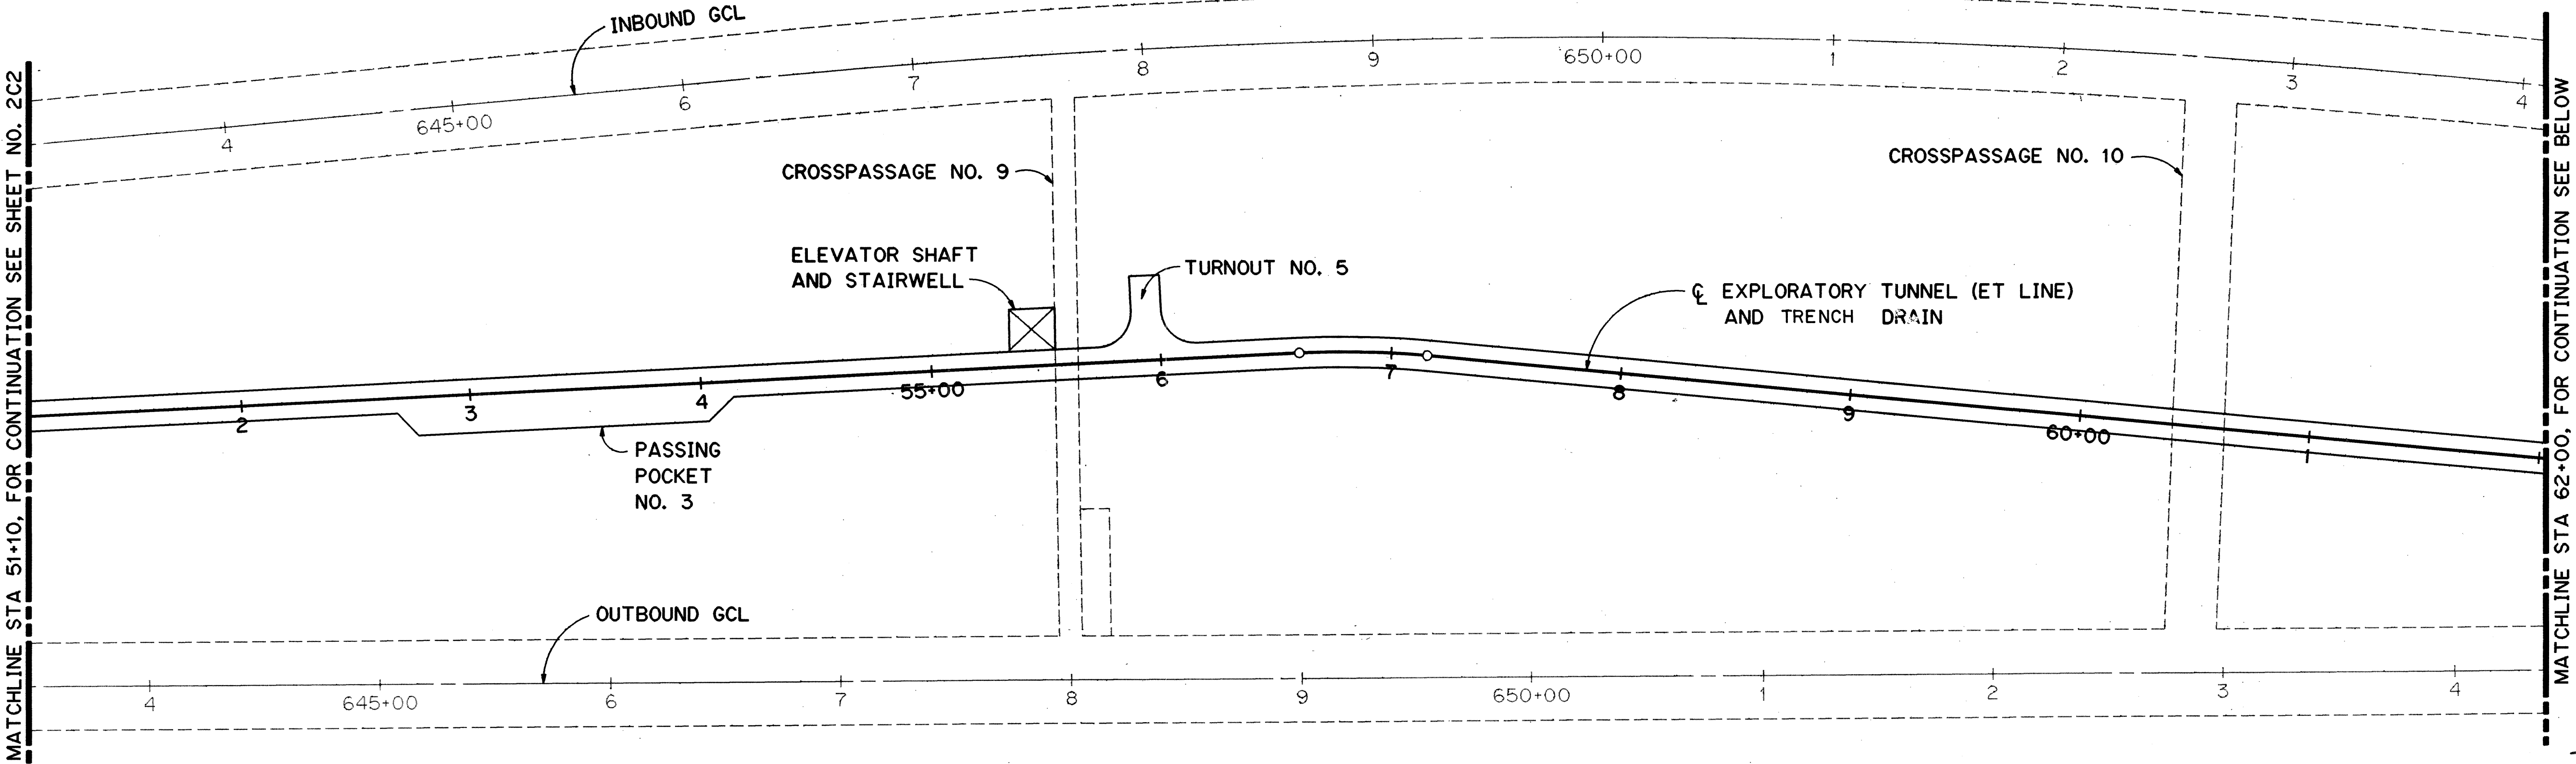

PLAN
SCALE: 1" = 40'

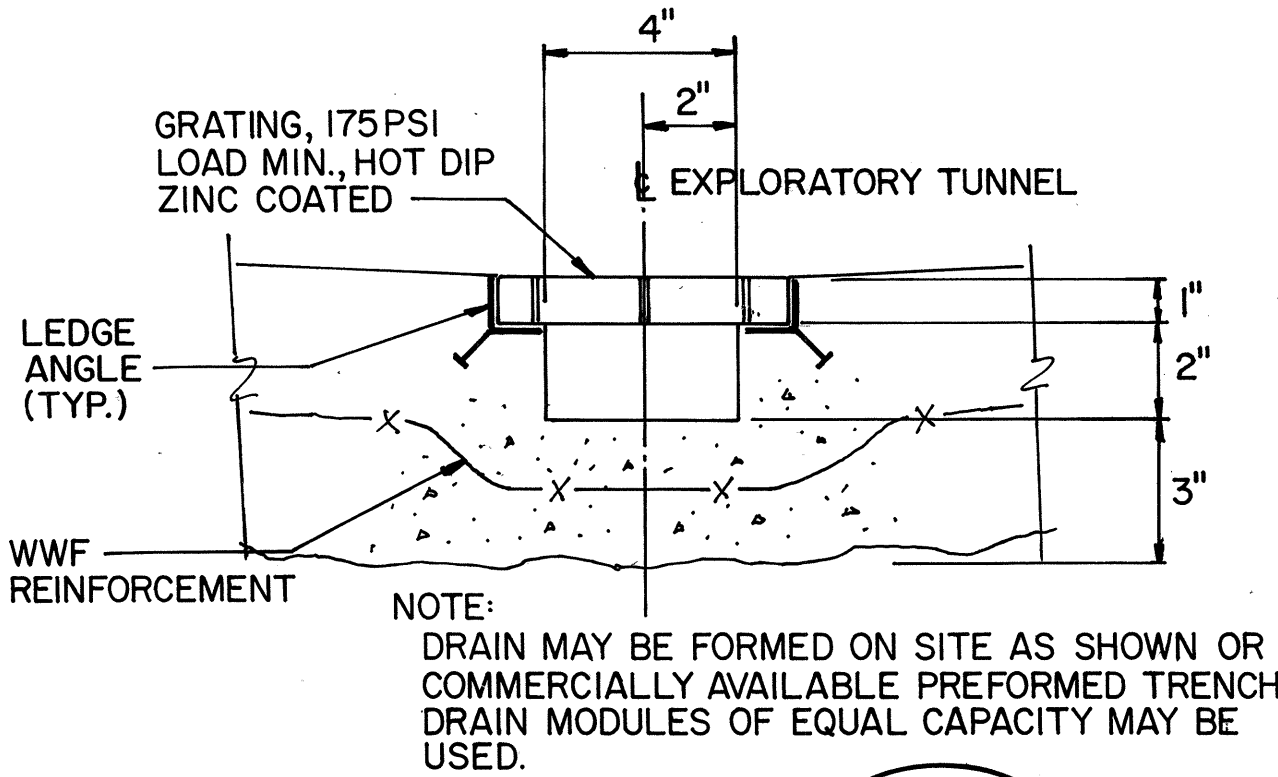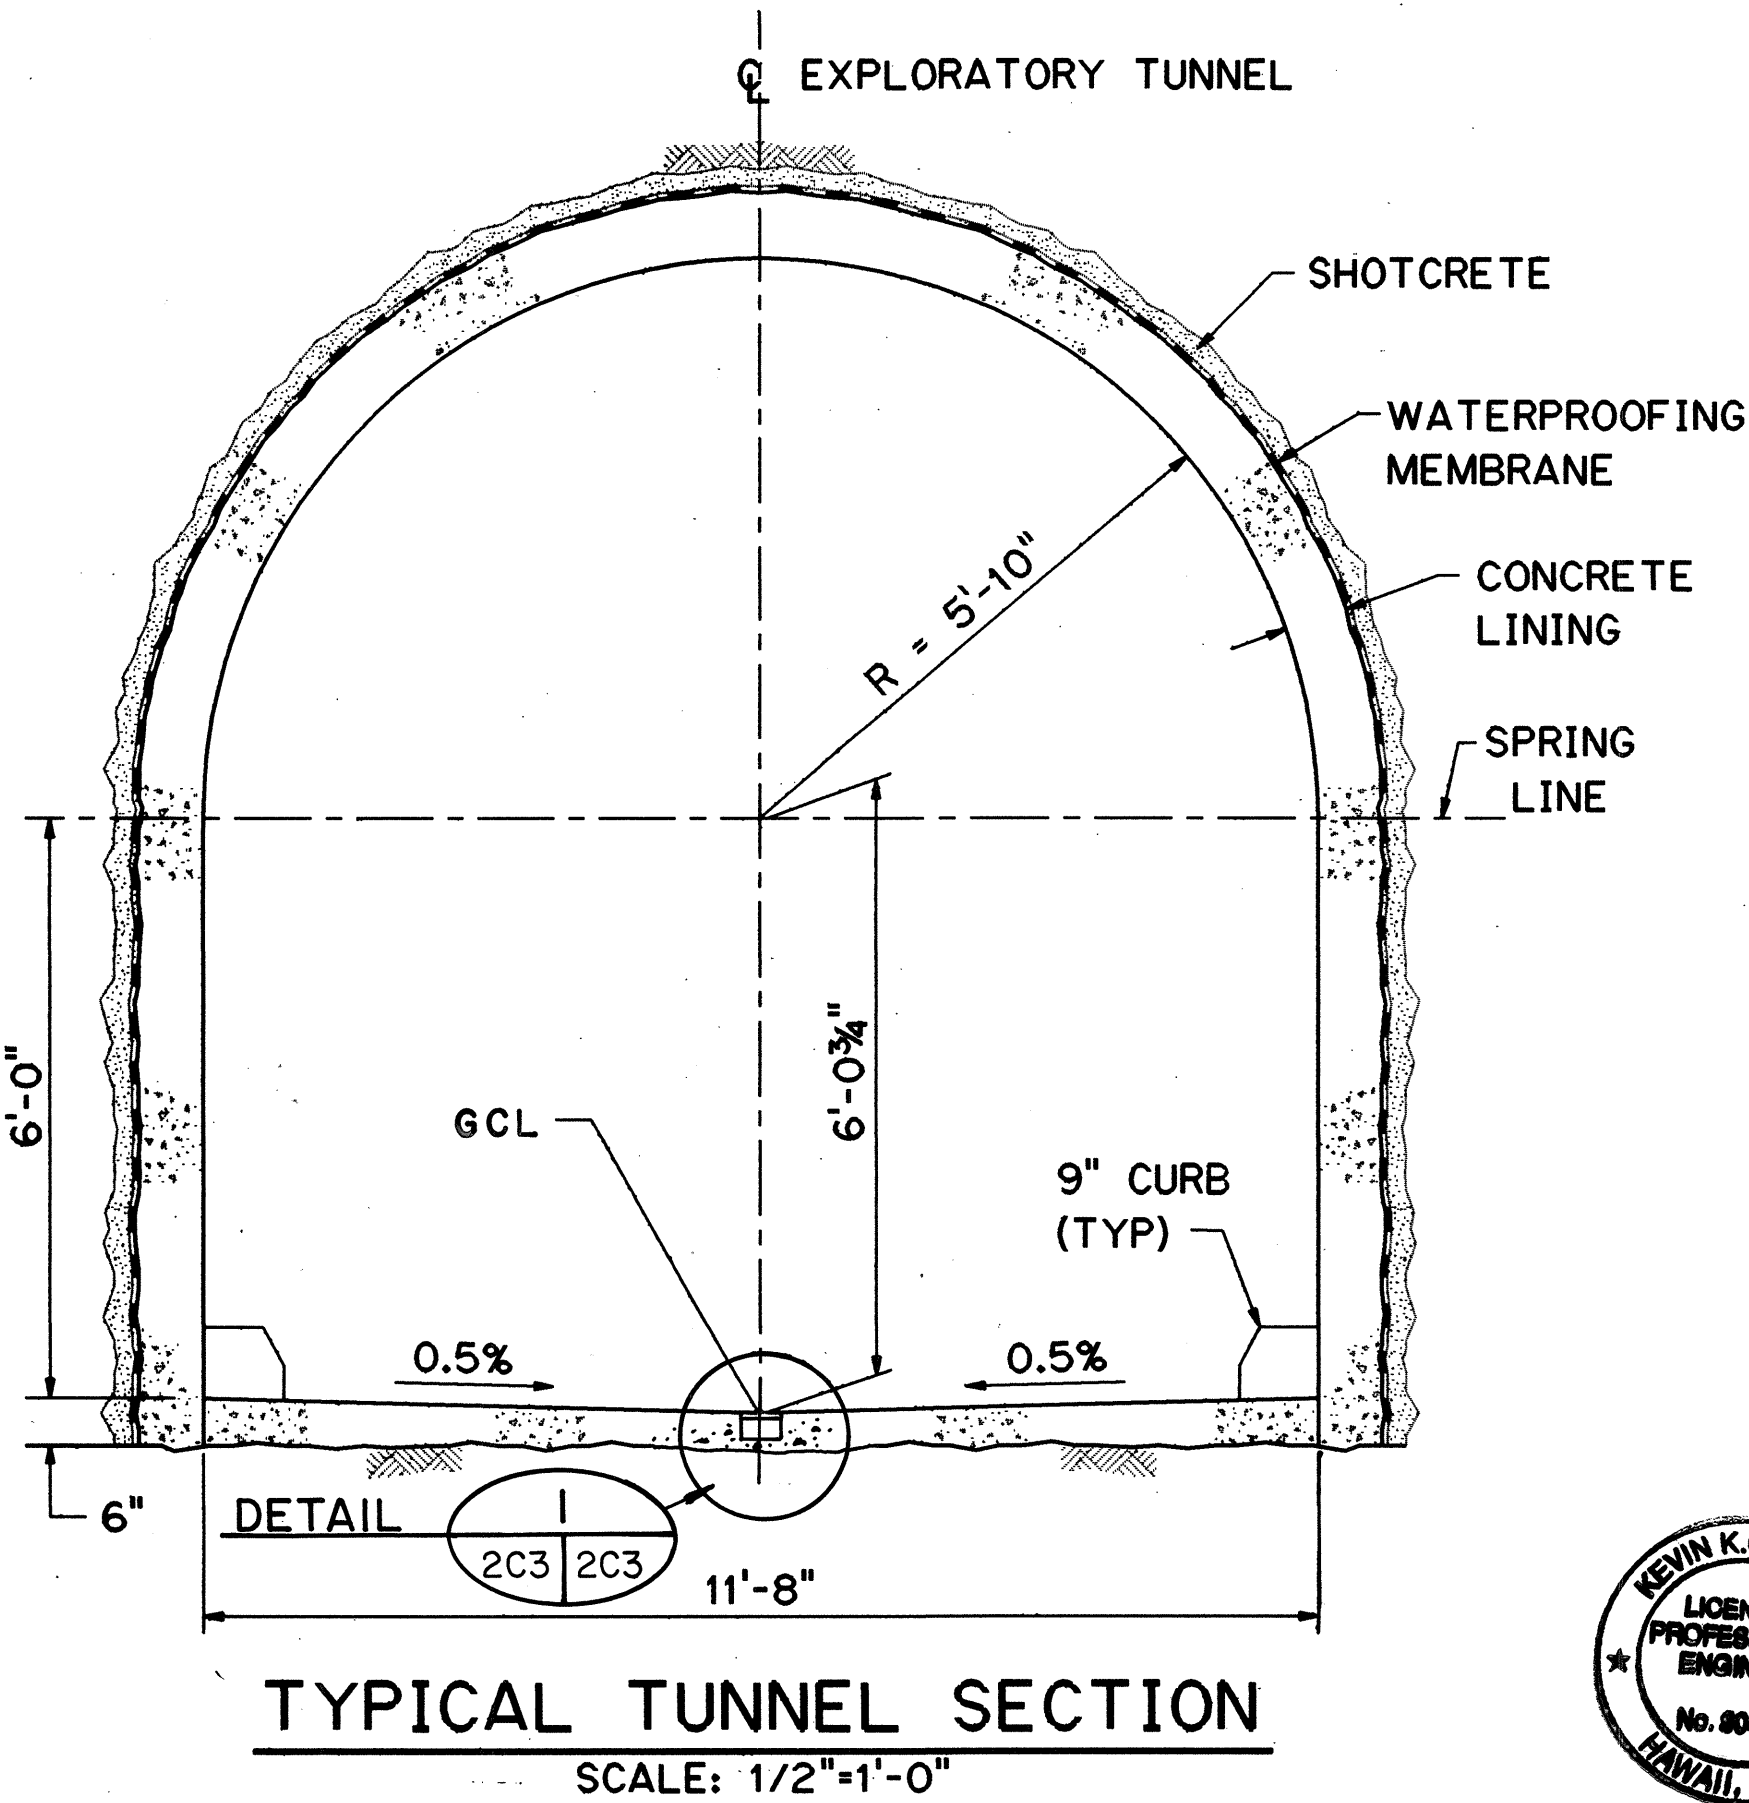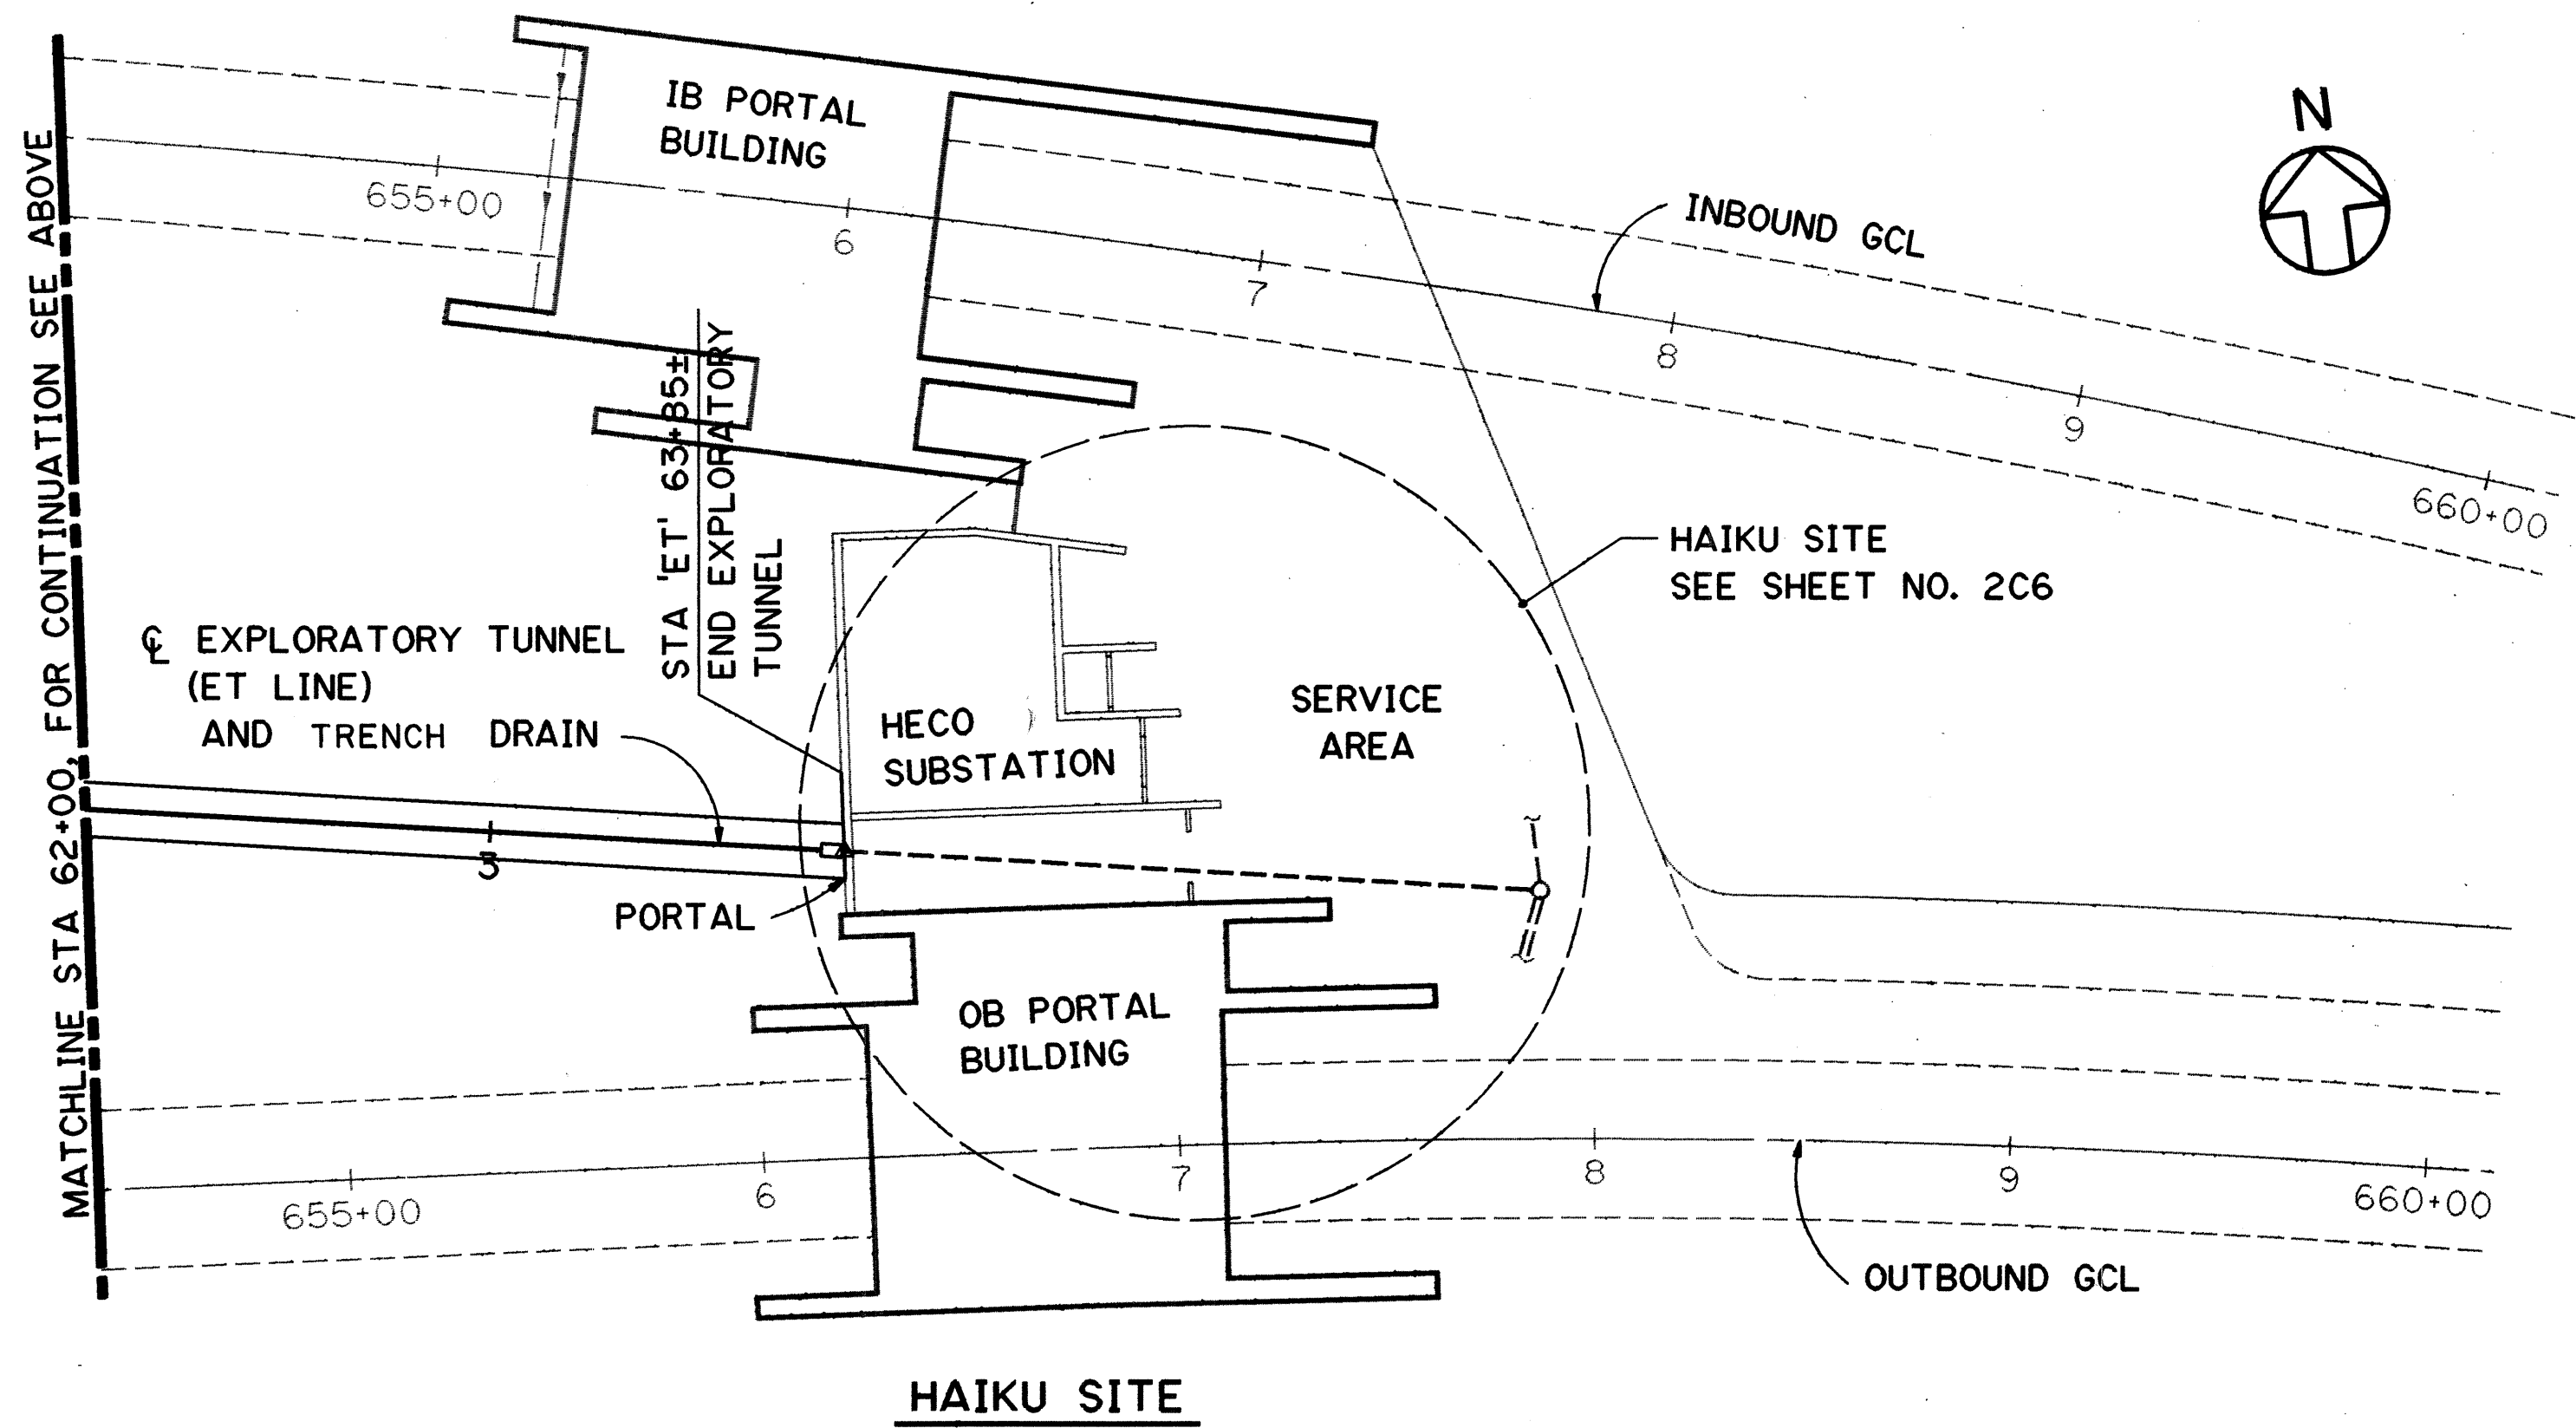

DETAIL
NO SCALE
2C3 2C3

DATE	REVISION
9 / 3 / 96	DCN 75-007: DELETED SLOTTED DRAIN, ADDED TRENCH DRAIN

STATE OF HAWAII

DEPARTMENT OF TRANSPORTATION

HIGHWAYS DIVISION

GENERAL PLAN - 3

AND TYPICAL SECTION

EXPLORATORY TUNNEL IMPROVEMENTS

H-3 FINISH (UNIT III)


FAIP NO. I-H3-1(75), UNIT III

T.K. TUNNEL / ACCESS ROADS

SCALE: AS NOTED


DATE: JUN 1995

SHEET NO. 2C3 OF 15 SHEETS

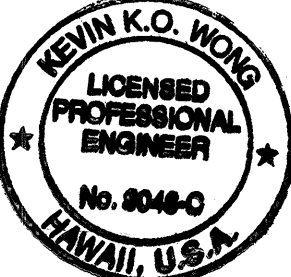


THIS WORK WAS PREPARED BY ME
OR UNDER MY SUPERVISION

Kevin K.O. Wong

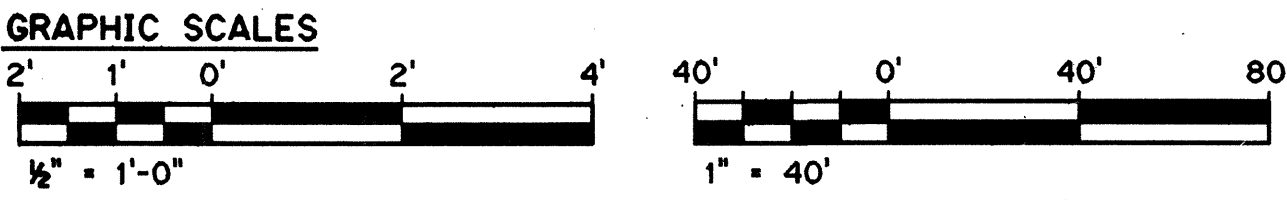

DATE	JAN 95
SURVEY PLOTTED BY	B. VUONG
DESIGNED BY	G. TE BOECKHOEST
QUANTITIES BY	D. MANITI
CHECKED BY	
NO.	

FED. ROAD DIST. NO.	STATE	FED. AID PROJ. NO.	FISCAL YEAR	SHEET NO.	TOTAL SHEETS
HAWAII	HAW.	I-H3-1(75) UNIT III	1994	20	353


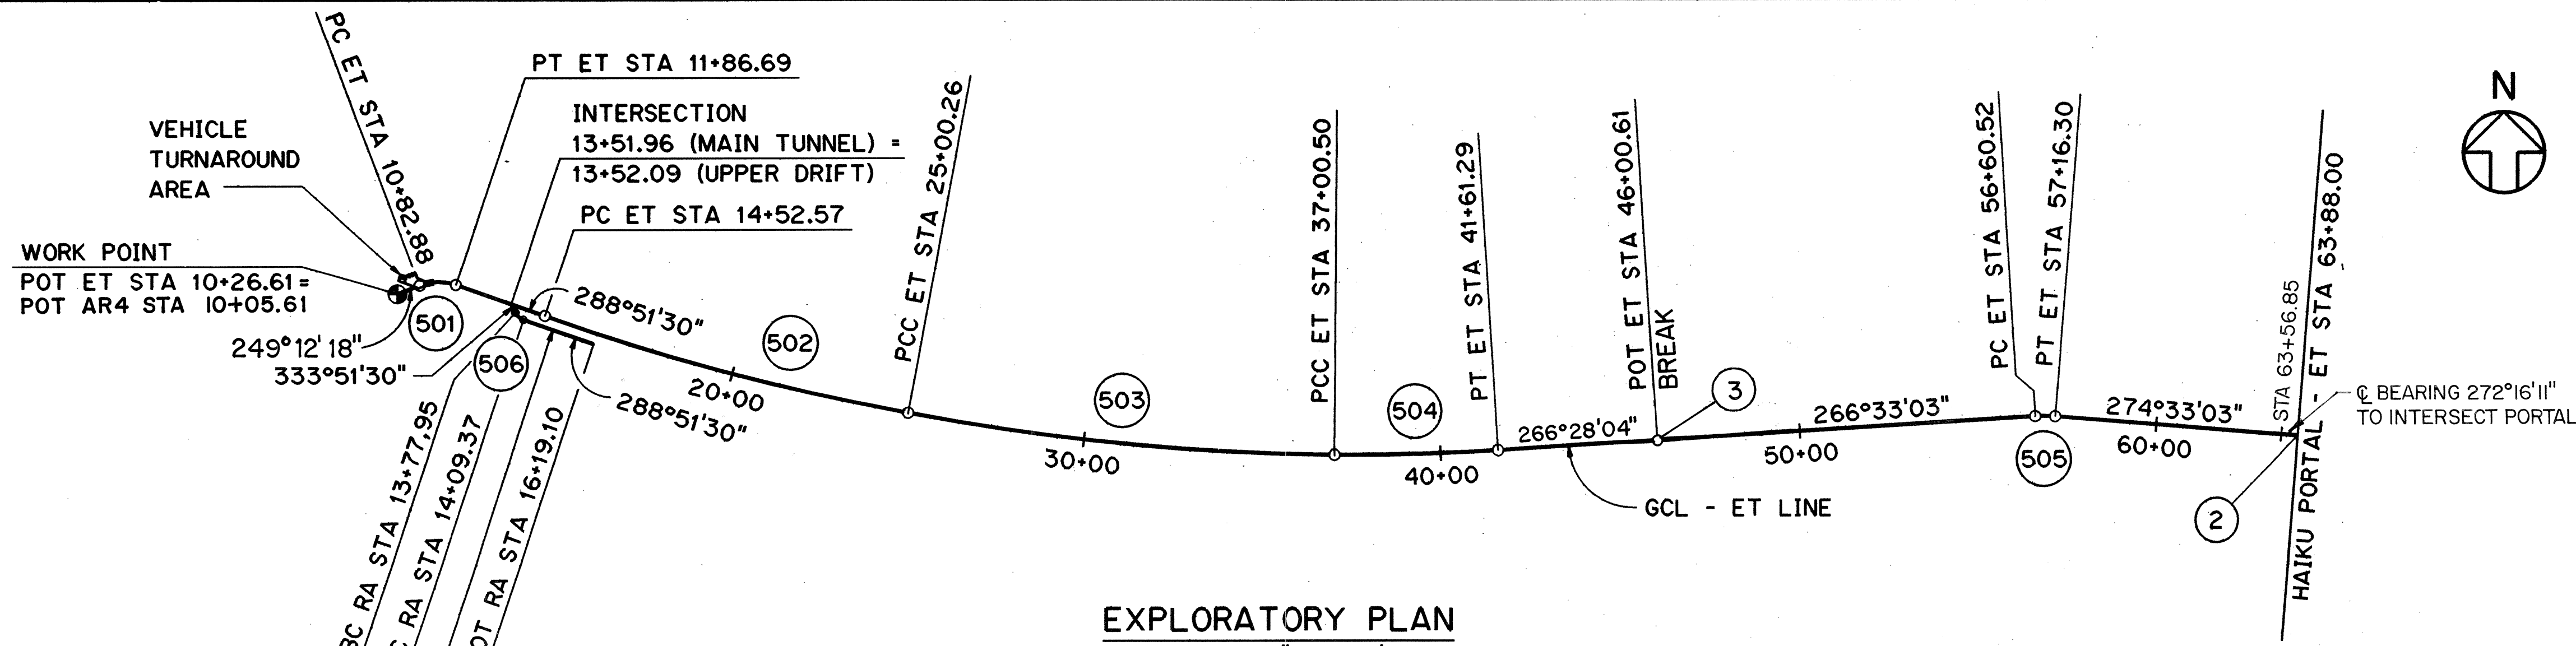


CURVE DATA - GCL LINES				
CURVE	NORTHING	EASTING	DATA	
(503)	PC	87277.41	551255.59	$\Delta = 10^{\circ}06'38''$
	PT	87161.36	552448.64	$R = 6801.75'$
	CC	93962.85	552508.08	$LC = 1200.24'$
	PI	87166.62	551846.98	$TAN. = 601.68'$
(504)	PC	87161.36	552448.64	$\Delta = 04^{\circ}01'58''$
	PT	87173.55	552909.17	$R = 6546.46'$
	CC	93707.57	552505.85	$LC = 460.78'$
	PI	87159.35	552679.12	$TAN. = 230.49'$
(505)	PC	87264.38	554405.65	$\Delta = 08^{\circ}00'00''$
	PT	87263.84	554461.38	$R = 399.50'$
	CC	86865.60	554429.68	$LC = 55.78'$
	PI	87266.06	554433.53	$TAN. = 27.94'$
(506)	PC	87559.38	550161.29	$\Delta = 45^{\circ}00'00''$
	PT	87539.15	550184.27	$R = 40.00'$
	CC	87577.01	550197.20	$LC = 31.42'$
	PI	87544.51	550168.59	$TAN. = 16.57'$

POINT	STATION	ELEV.	COORDINATES	
			NORTHING	EASTING
WP	10+26.61	1004.46	87614.32	549839.16
1	16+19.10	-	87471.36	550382.74
2	63+88.00	-	87210.55	555130.96
3	46+00.61	-	87200.61	553347.66

CURVE DATA - GCL LINES				
CURVE	NORTHING	EASTING	DATA	
(501)	PC	87634.30	549891.77	$\Delta = 39^{\circ}39'12''$
	PT	87636.01	549993.50	$R = 150.00'$
	CC	87494.07	549945.02	$LC = 103.81'$
	PI	87653.50	549942.32	$TAN. = 54.08'$
(502)	PC	87550.07	550245.11	$\Delta = 8^{\circ}58'45''$
	PT	87277.41	551255.59	$R = 6685.28'$
	CC	93848.37	552486.63	$LC = 1047.69'$
	PI	87374.07	550739.65	$TAN. = 524.92'$

NOTE:
FOR NOTES, SEE SHEET NO. 2C1.

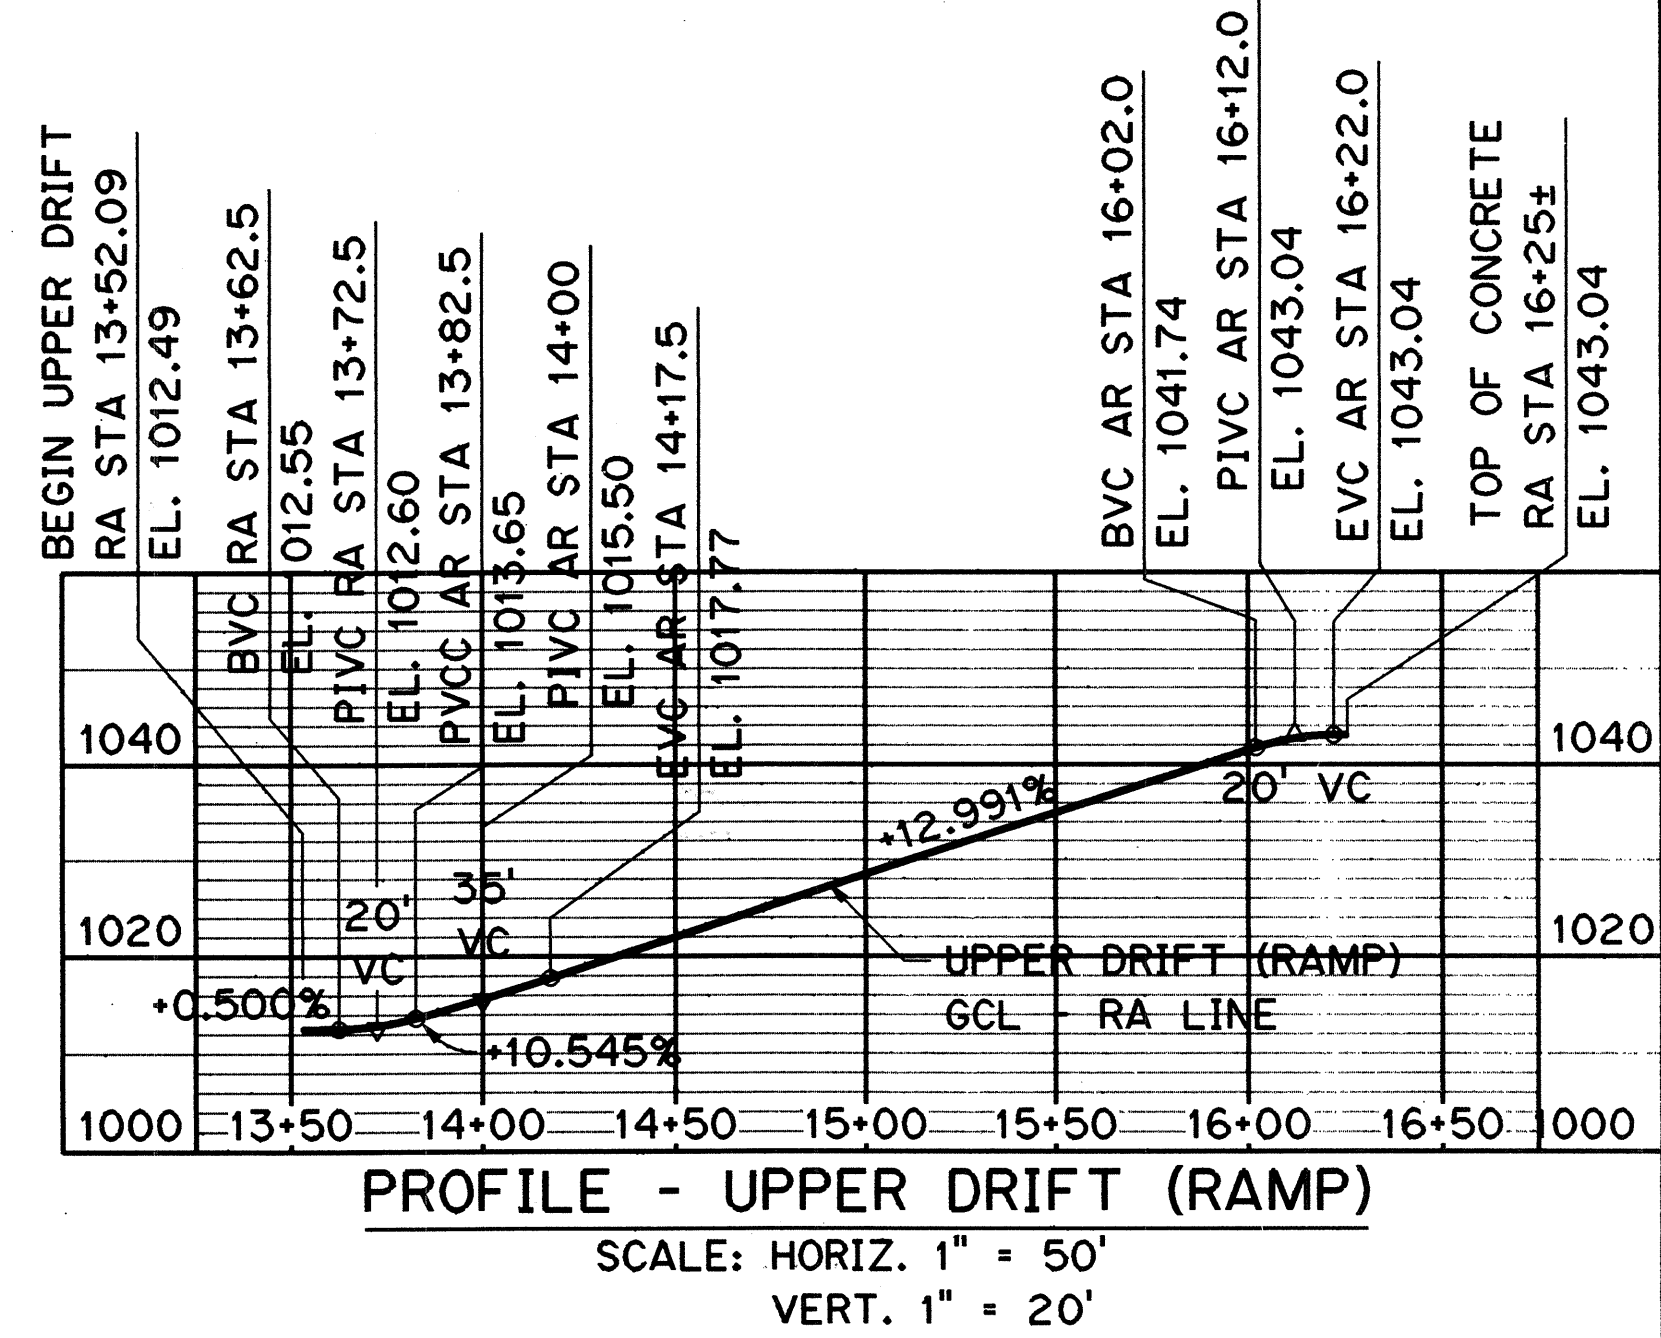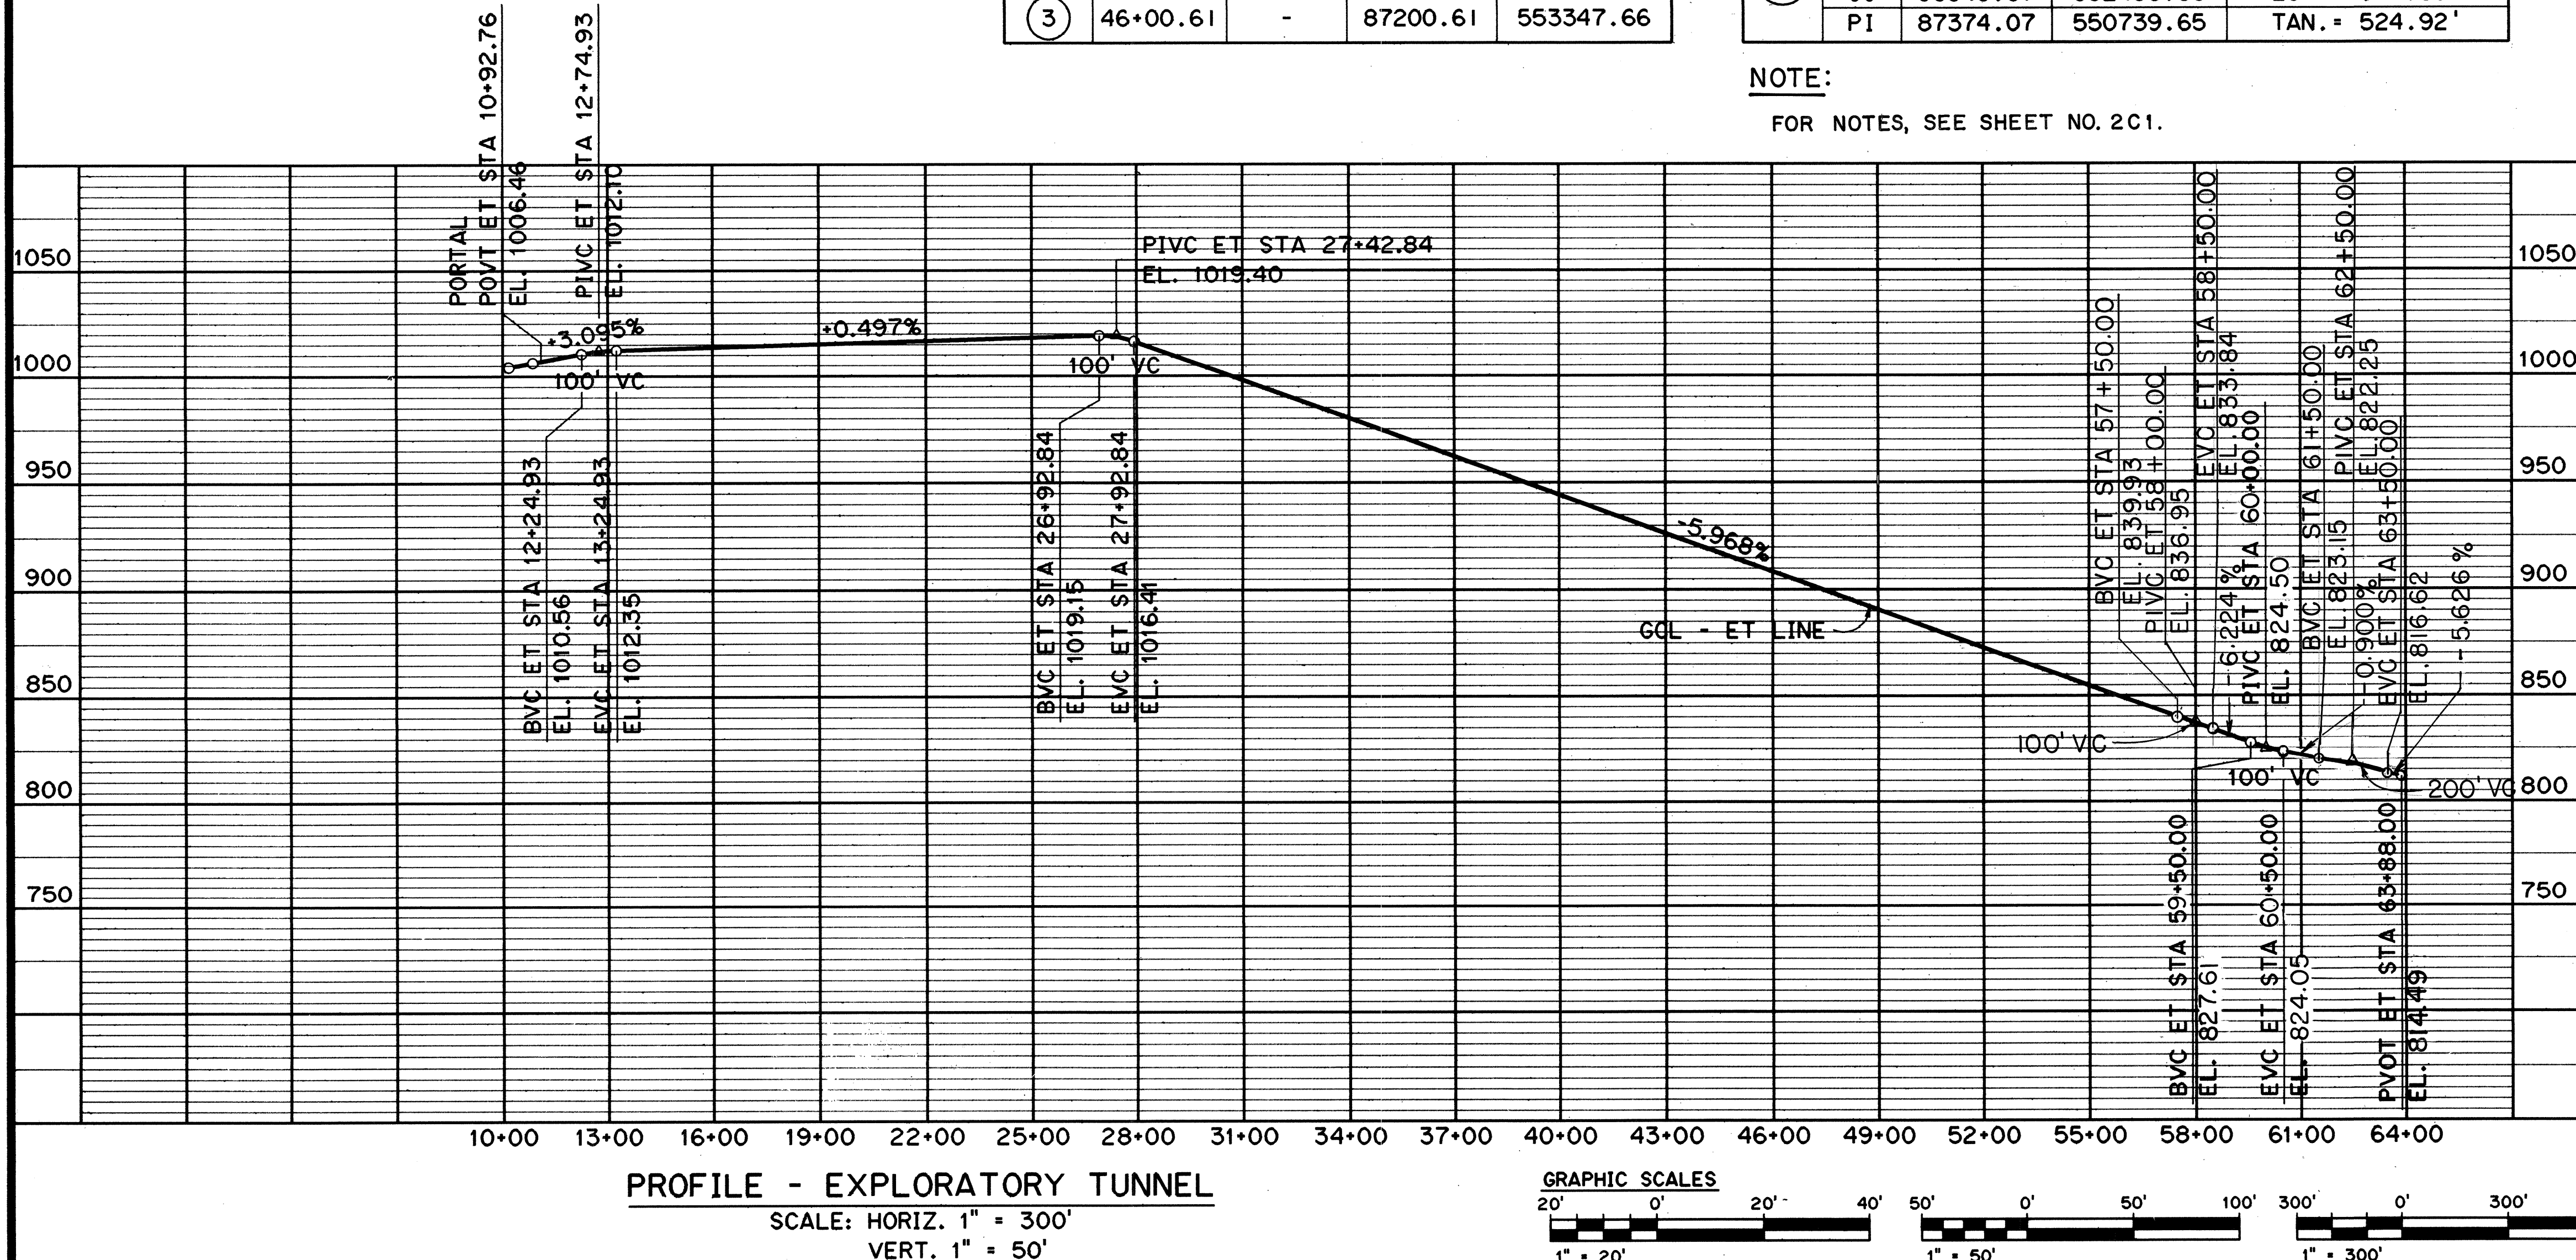

SURVEY PLOTTED BY	DATE
B. VONG	JAN 95
TRACED BY	DATE
G. TE BUEKHORST	JAN 95
QUANTITIES BY	DATE
D. MANITI	JAN 95
CHECKED BY	DATE
ORIGINAL PLAN	
NOTE BOOK	
NO.	

FOR DETAIL AS-BUILT INFORMATION
REFER TO CONSTRUCTION SUBMITTALS



THIS WORK WAS PREPARED BY ME
OR UNDER MY SUPERVISION



DATE	REVISION
17/12/96	DCN 75-006: REVISED ET PROFILE FROM STA 57+50.00 TO STA 63+88.00
4/18/96	DCN 75-001: REVISED PER RESPONSES TO RFI NO. 4097-02 AND 4097-22.
ALIGNMENT PLAN AND PROFILE	
EXPLORARY TUNNEL IMPROVEMENTS	
H-3 FINISH (UNIT III)	
FAIP NO. I-H3-1(75), UNIT III	
T.K. TUNNEL / ACCESS ROADS	
SCALE: AS NOTED	DATE: JUN 1995
SHEET NO. 2C4	OF 15 SHEETS

FED. ROAD DIST. NO.	STATE	FED. AID PROJ. NO.	FISCAL YEAR	SHEET NO.	TOTAL SHEETS
HAWAII	HAW.	I-H3-1(75) UNIT III	1994	21	353


NOTES:

- SEE NOTE 1 ON SHEET NO. 2C1.
- THIS PLAN FOR TOP OF SLAB ELEVATIONS AND DRAINAGE IN VEHICLE TURN AROUND AREA AND 8" FW CONNECTION, AND EXISTING CONTOUR ELEVATIONS ALONG SERVICE ROAD.
- INSTALL 2-32LB ANOTES, APPLY COATING AND BAND JOINTS. SURFACE MOUNT TEST BOX IN STAIR WELL NEXT TO WHERE FIRE WATER LINE DAY LIGHTS. WORK TO CONFORM TO DETAILS SHOWN ON SHEET NOS. 2C10, 2C11 AND 2C12. SPECIFICATION SECTION 647 APPLIES.

DATE	JAN 95
SURVEY PLOTTED BY	B. VUONG
DESIGNED BY	G. TE BOKHOFST
CHECKED BY	D. MANITI
NO.	

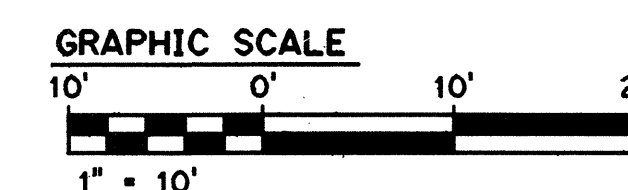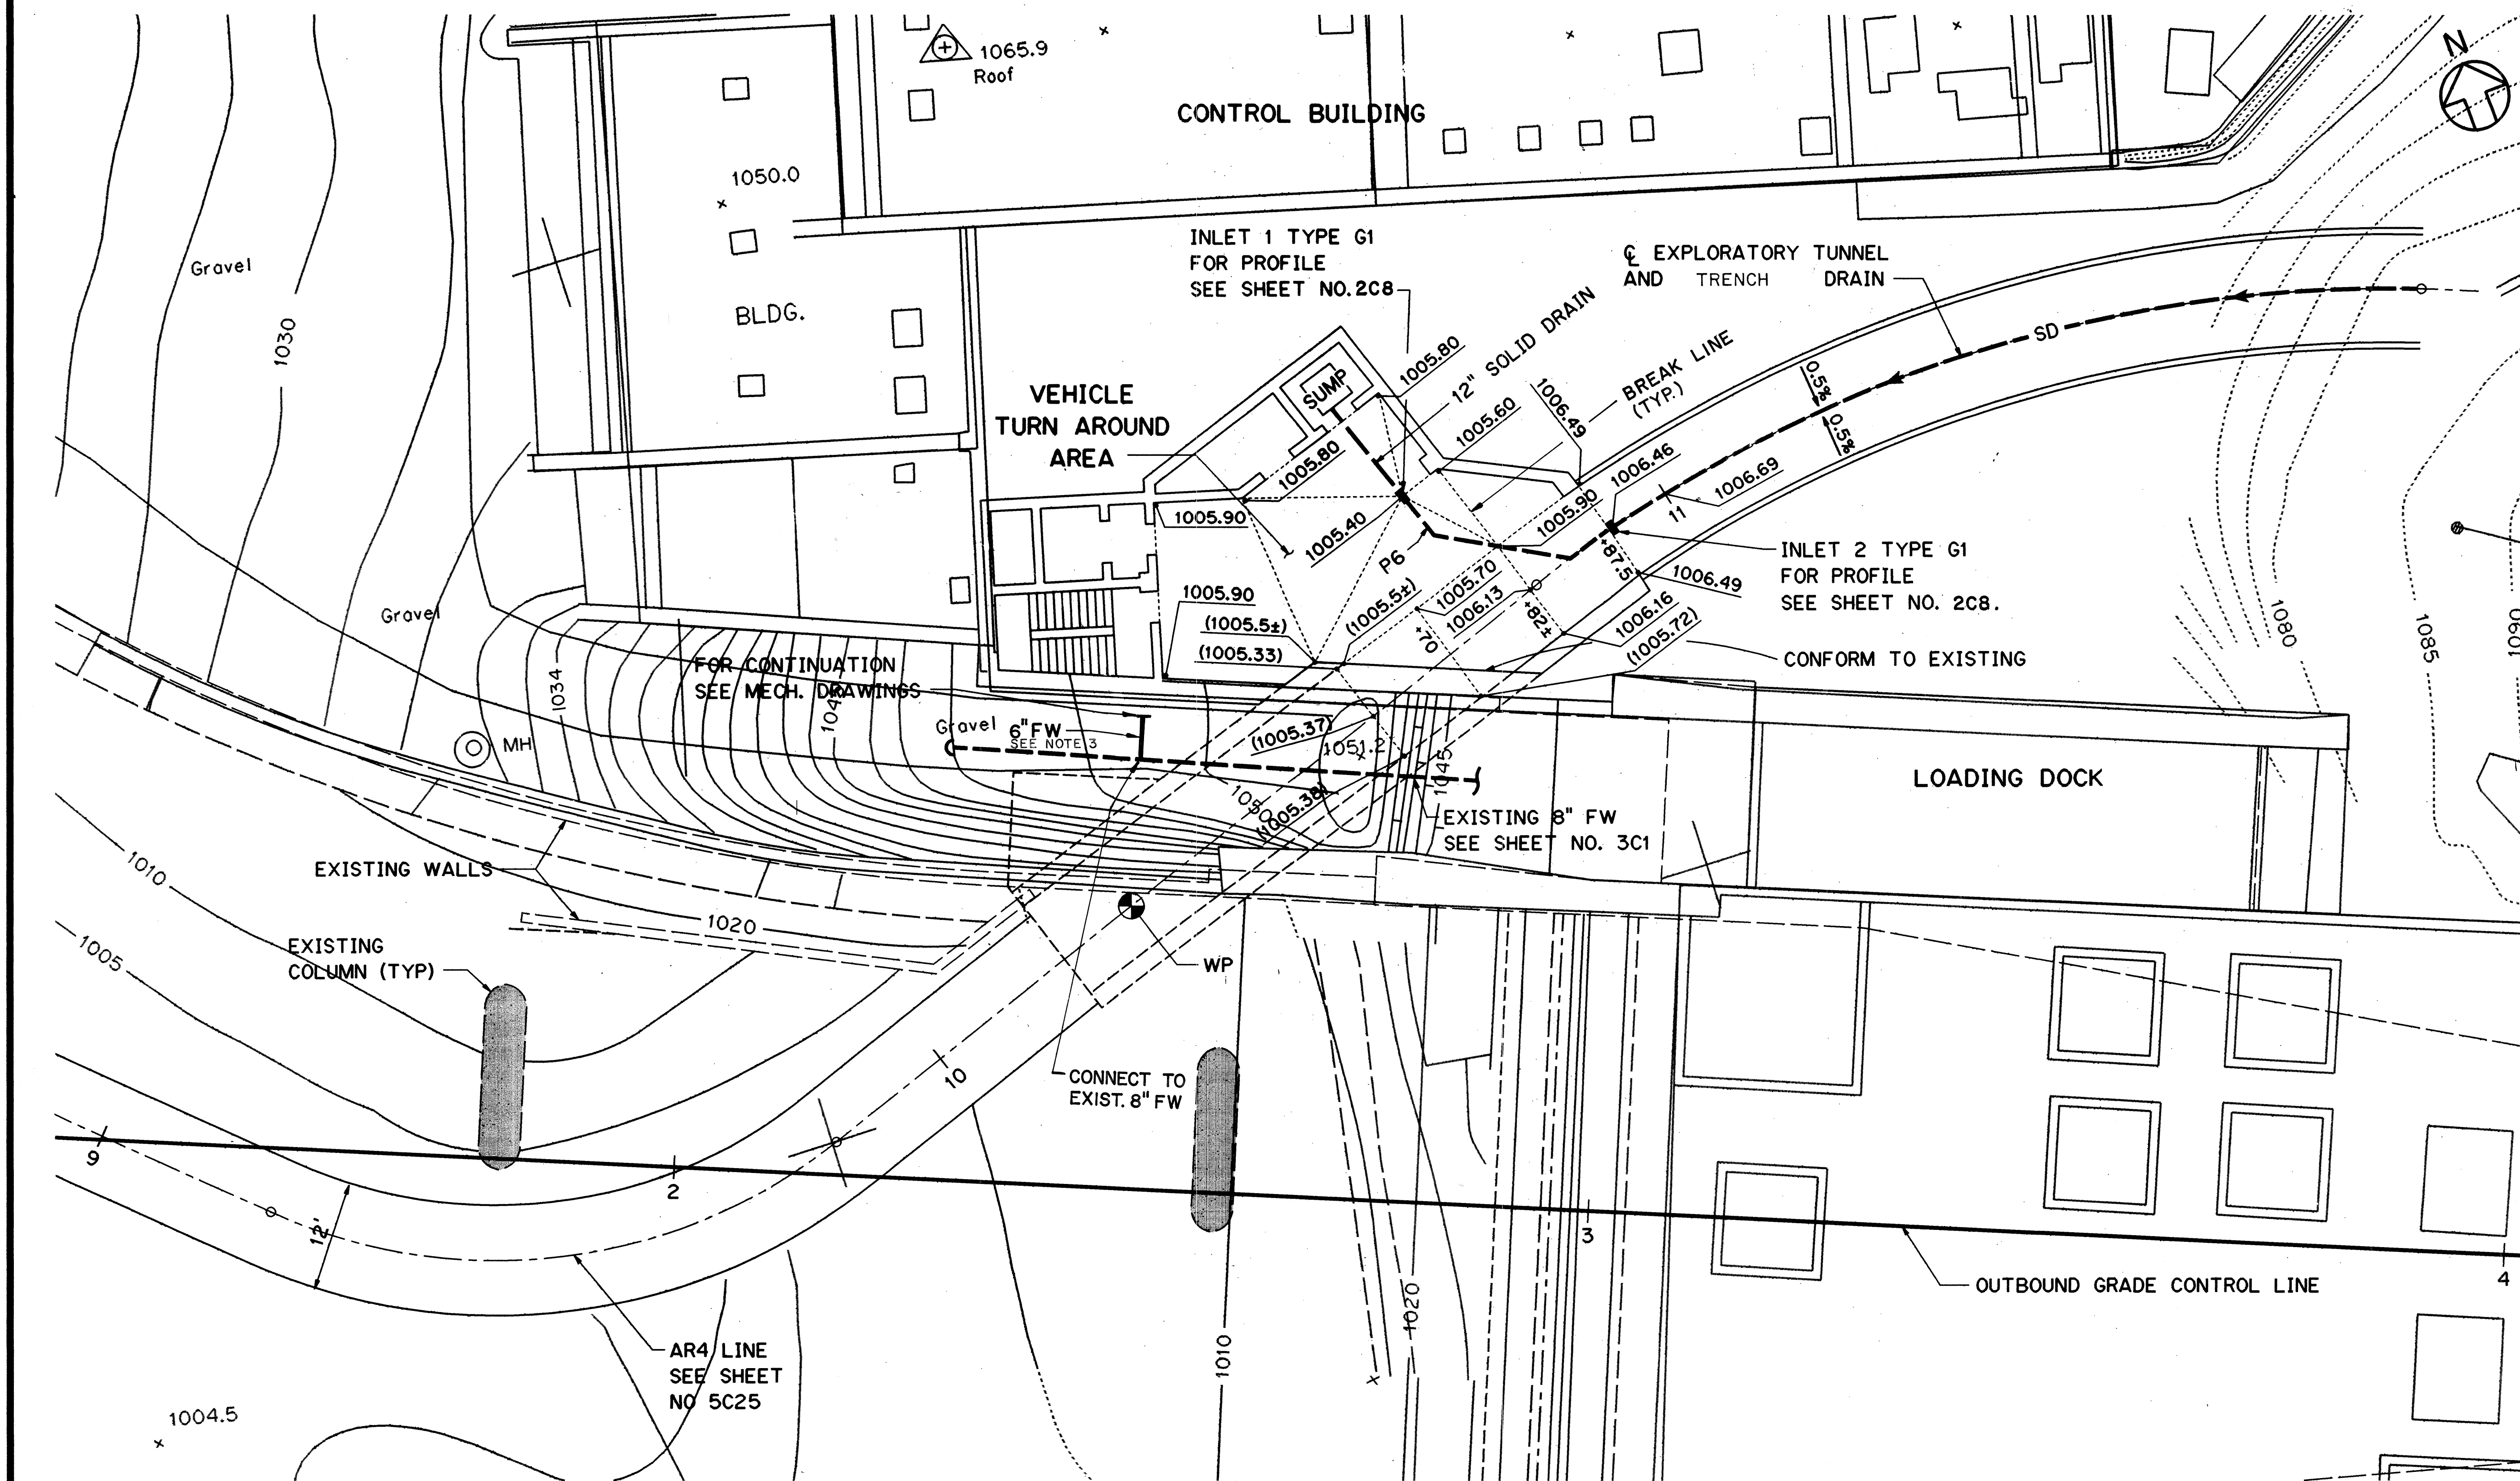


THIS WORK WAS PREPARED BY ME
OR UNDER MY SUPERVISION

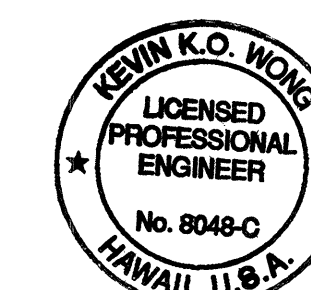

10/27/95	ADDENDUM 2-REVISED NOTE 2 AND ELEV. AT SW CORNER OF CONTROL BLDG.
DATE	REVISION
STATE OF HAWAII DEPARTMENT OF TRANSPORTATION HIGHWAYS DIVISION	
HALAWA SITE PLAN	
EXPLORATORY TUNNEL IMPROVEMENTS	
H-3 FINISH (UNIT III)	
FAIP NO. I-H3-1(75), UNIT III	
T.K. TUNNEL / ACCESS ROADS	
SCALE: 1"=10'-0"	DATE: JUN 1995
SHEET NO. 2C5	OF 15 SHEETS

ADD.21

FED. ROAD DIST. NO.	STATE	FED. AID PROJ. NO.	FISCAL YEAR	SHEET NO.	TOTAL SHEETS
HAWAII	HAW.	I-H3-1(75) UNIT III	1994	22	353

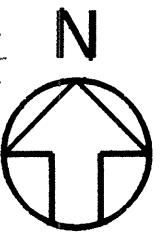

NOTES:

- SEE NOTE 1 ON SHEET NO. 2C1
- FOR TYPICAL PAVEMENT SECTIONS, SEE SHEET NO. 6C8.
- FOR GRADING INFORMATION, SEE SHEET NO. 6C5.
- FOR CATHODIC PROTECTION, SEE SHEET NO. 2C9.
- THIS PLAN FOR DRAINAGE AND FIRE WATER CONNECTIONS FOR EXPLORATORY TUNNEL ONLY. SEE SHEET NO. 6C5 FOR GRADING AND DRAINAGE INFORMATION FOR SERVICE AREA.
- FOR DRAINAGE PROFILES P1 & P2, SEE SHEET NO. 2C8.

STORM DRAIN DATA

SD MH-1 - TYPE F	
OB STA. 657+97.50-41' LT	
RIM EL. 809.67	
INV. EL. 805.42 (12")	
INV. EL. 807.00 (6")	

DATE	REVISION

STATE OF HAWAII

DEPARTMENT OF TRANSPORTATION

HIGHWAYS DIVISION

HAIKU SITE PLAN

EXPLORATORY TUNNEL IMPROVEMENTS


H-3 FINISH (UNIT III)

FAIP NO. I-H3-1(75), UNIT III

T.K. TUNNEL / ACCESS ROADS


SCALE: 1"=20.0'

DATE: JUN. 1995

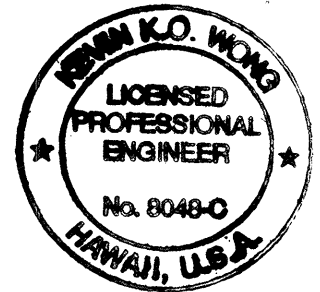


THIS WORK WAS PREPARED BY ME OR UNDER MY SUPERVISION





K. K. Wong

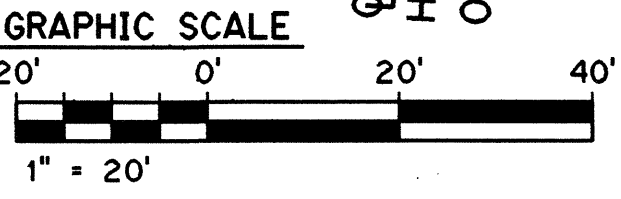

DATE	BY
JAN 95	B. YUONG
JAN 95	G. TE BOREKORST
JAN 95	D. MANITI

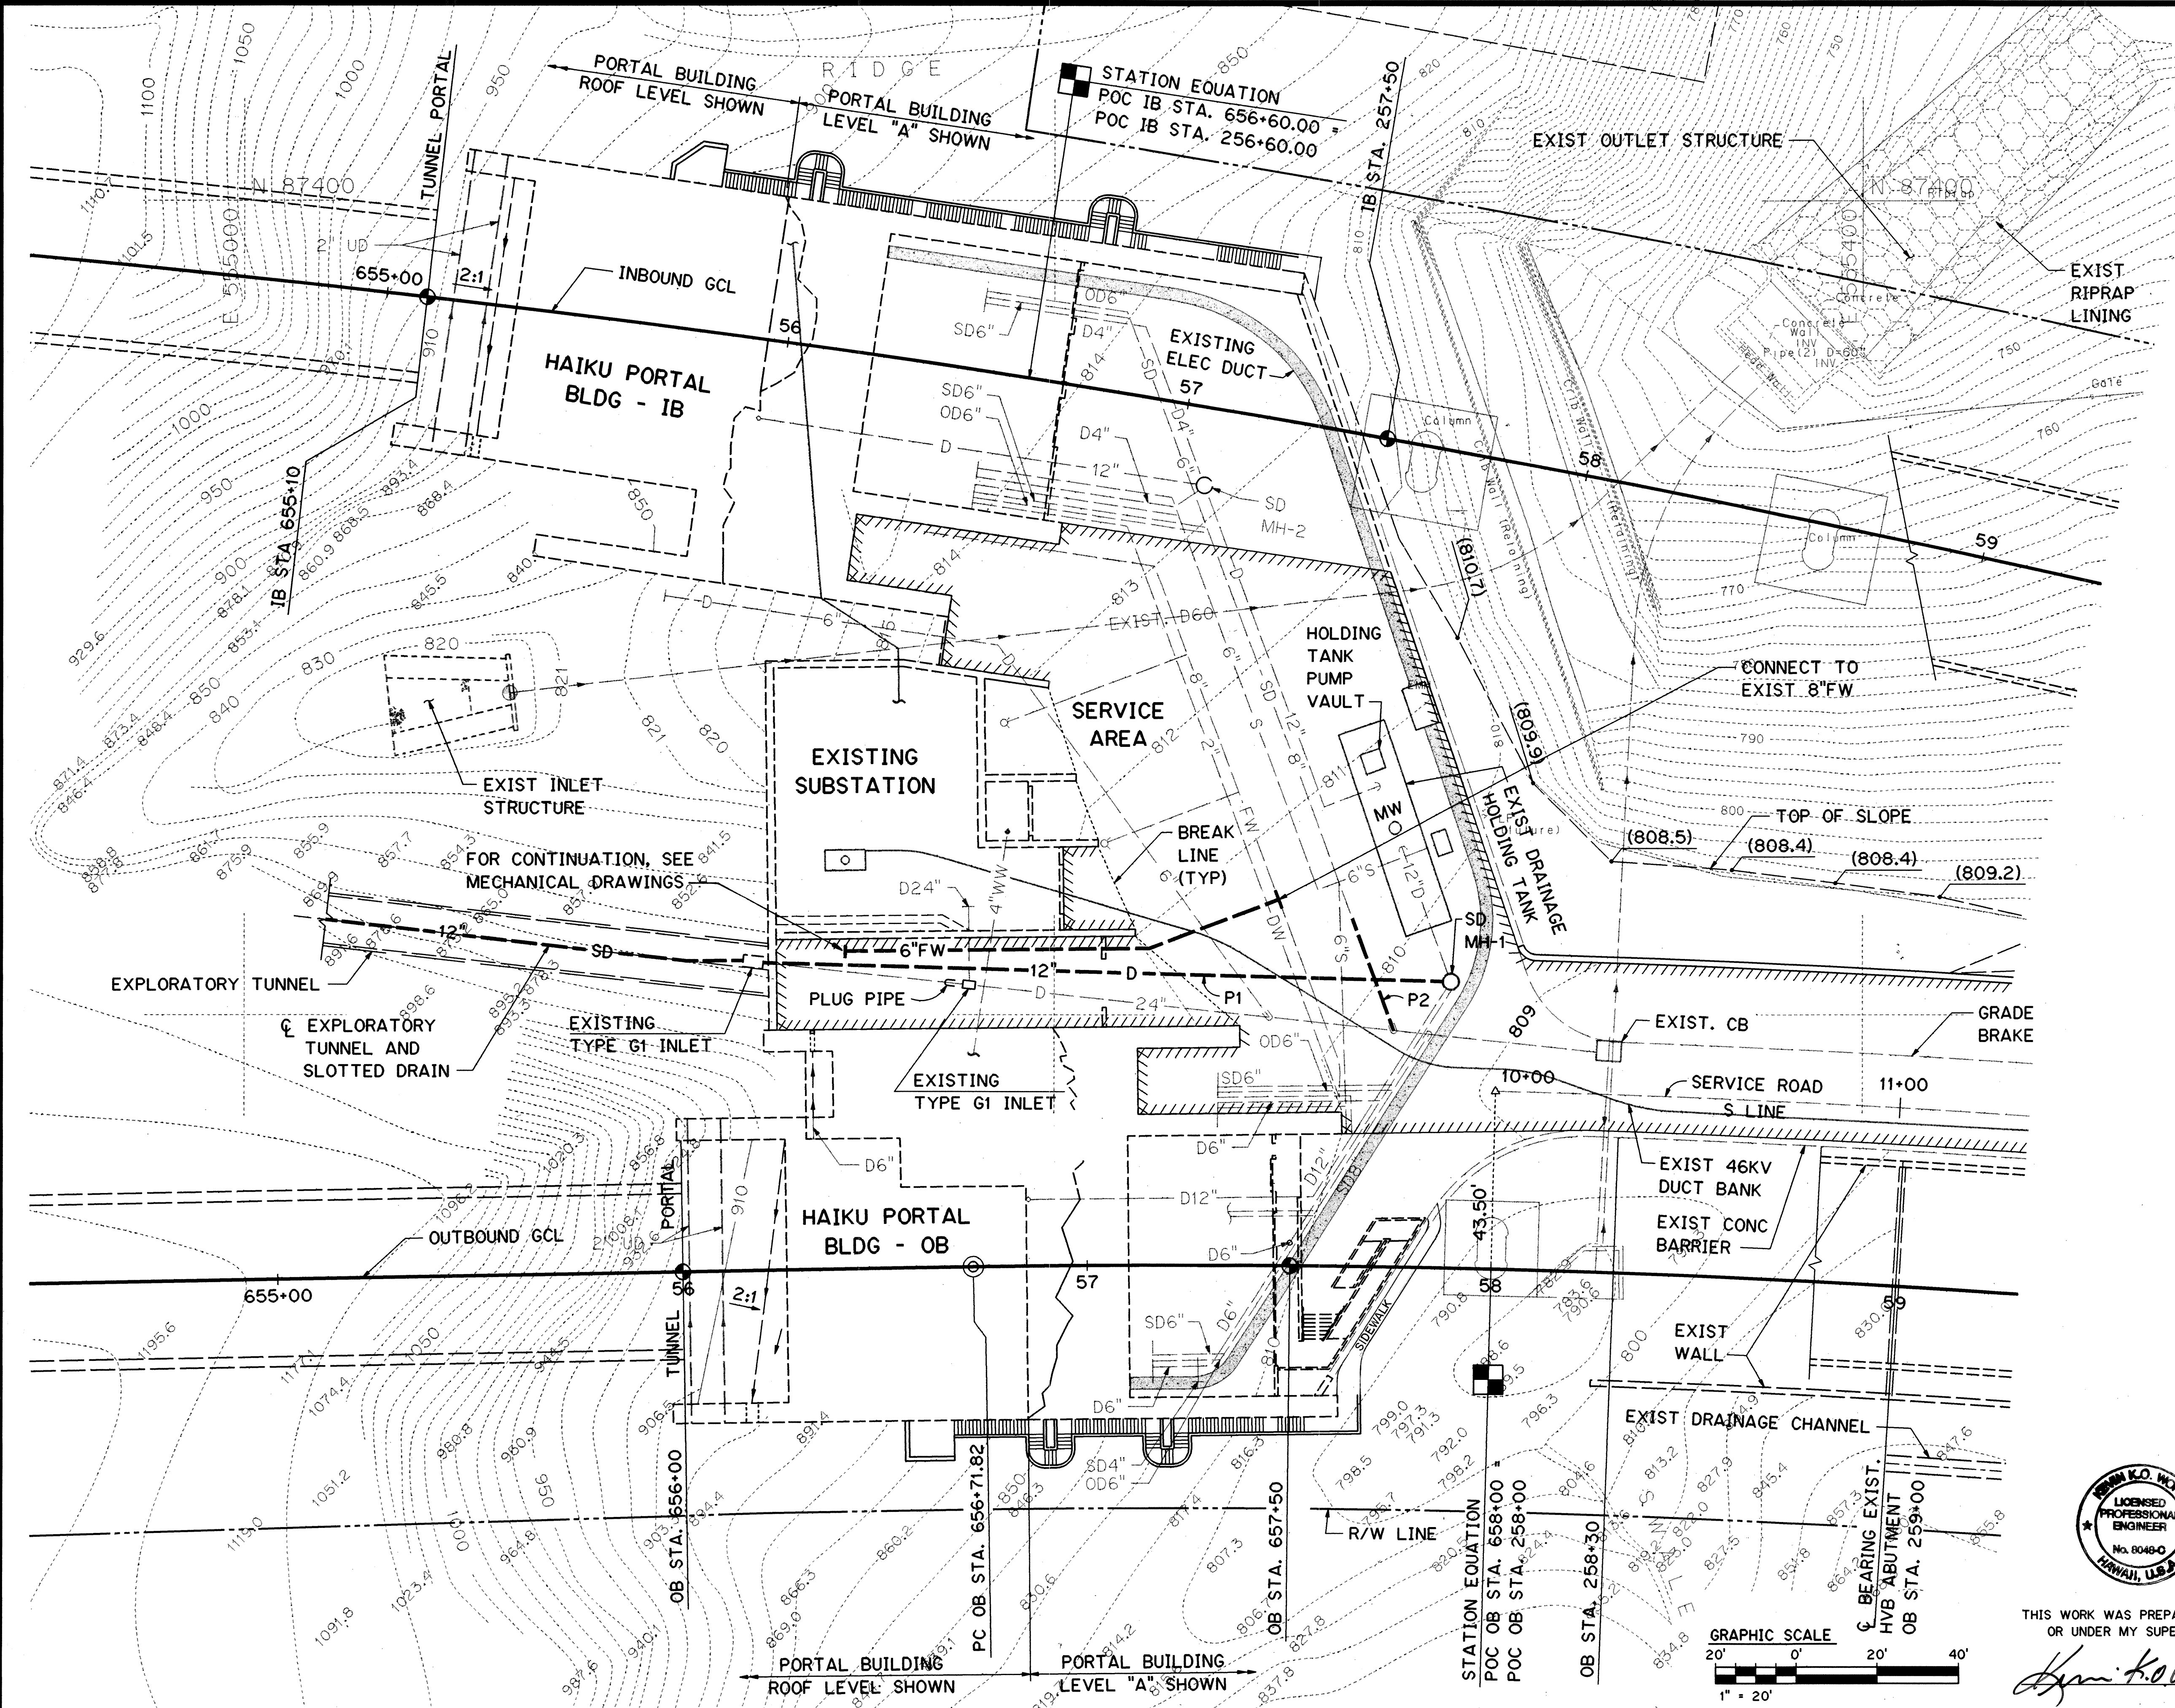

FED. ROAD DIST. NO.	STATE	FED. AID PROJ. NO.	FISCAL YEAR	SHEET NO.	TOTAL SHEET
HAWAII	HAW.	I-H3-1(75) UNIT III	1994	24	353

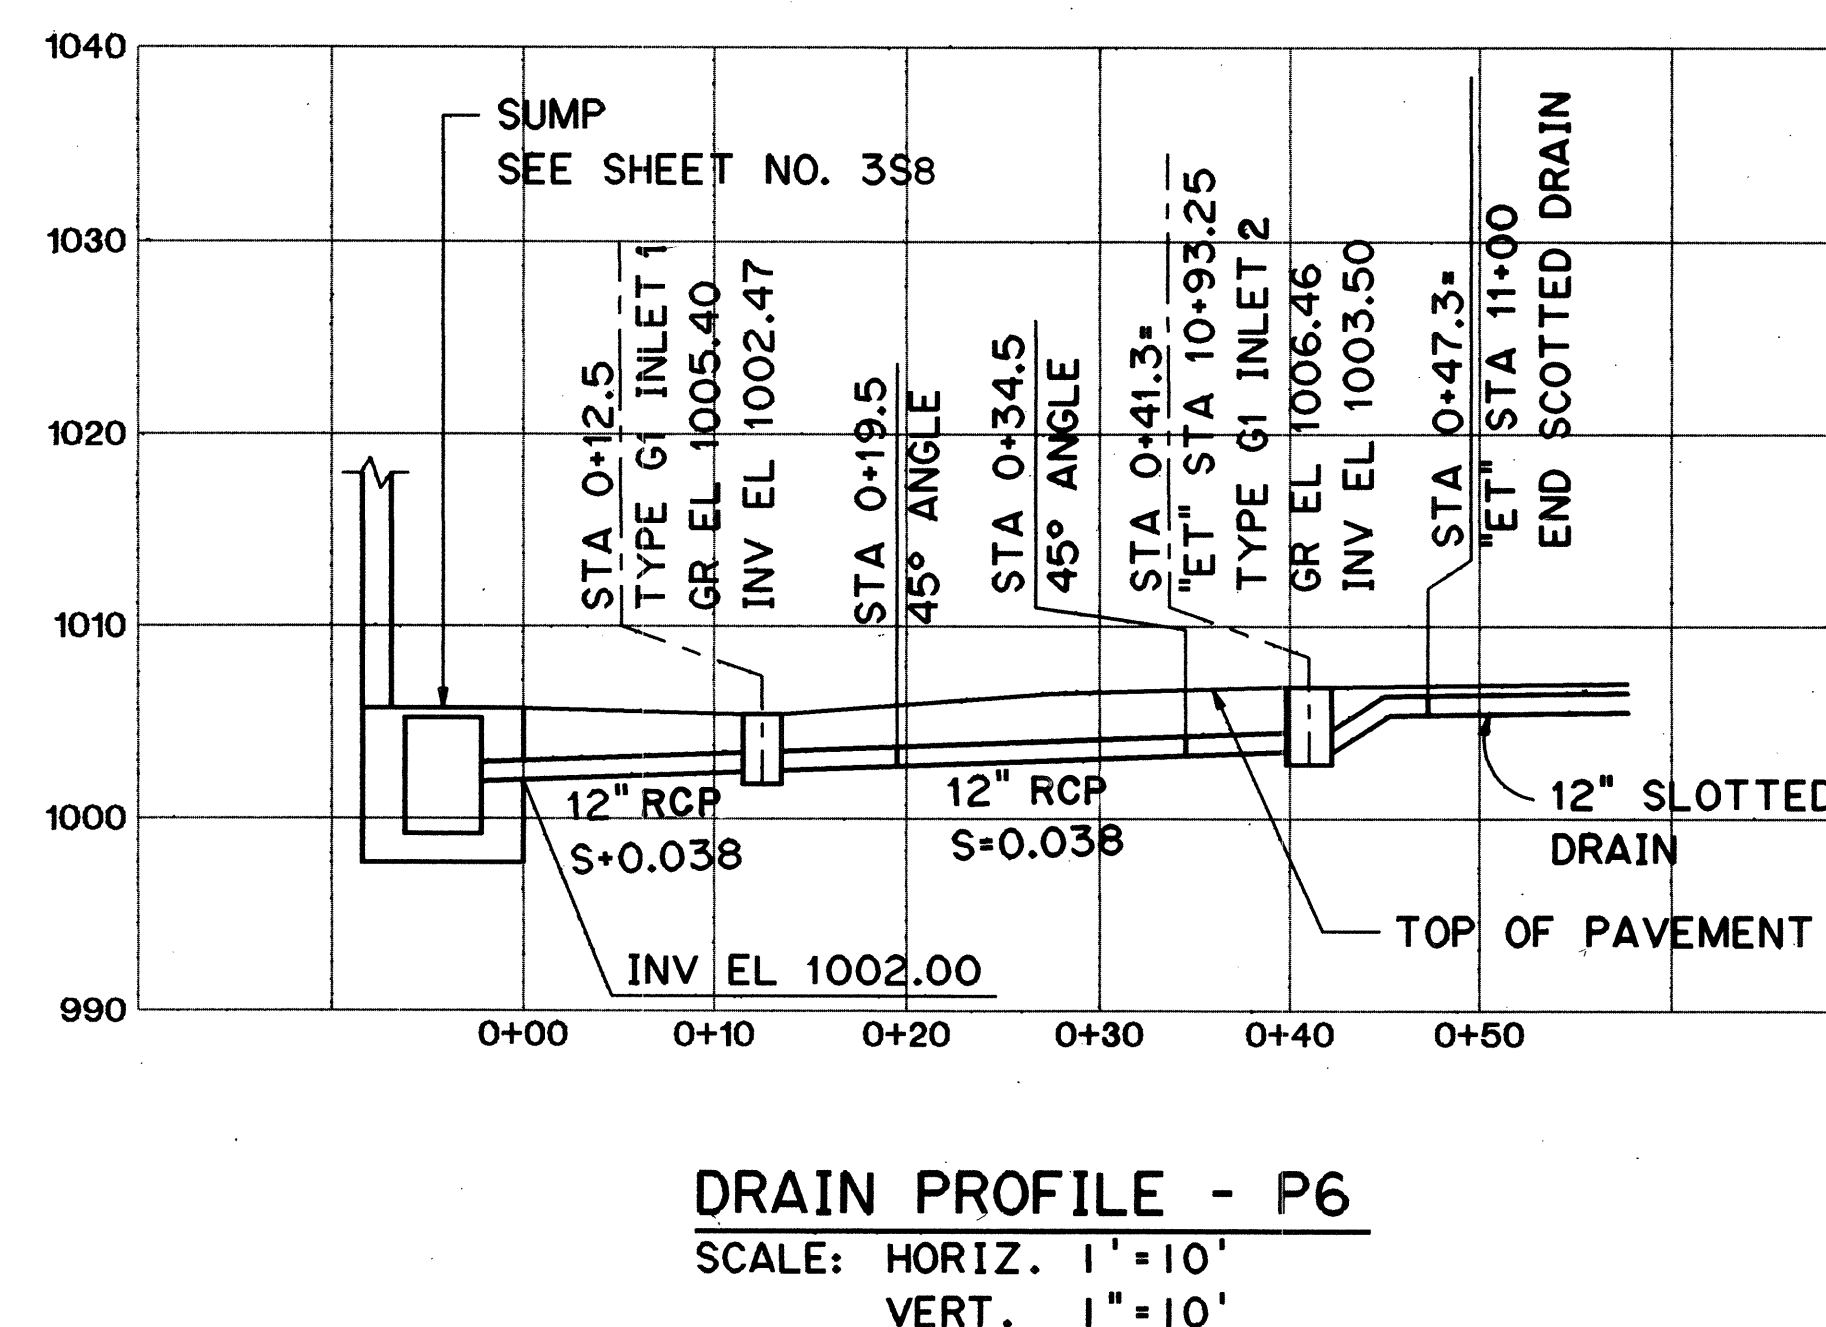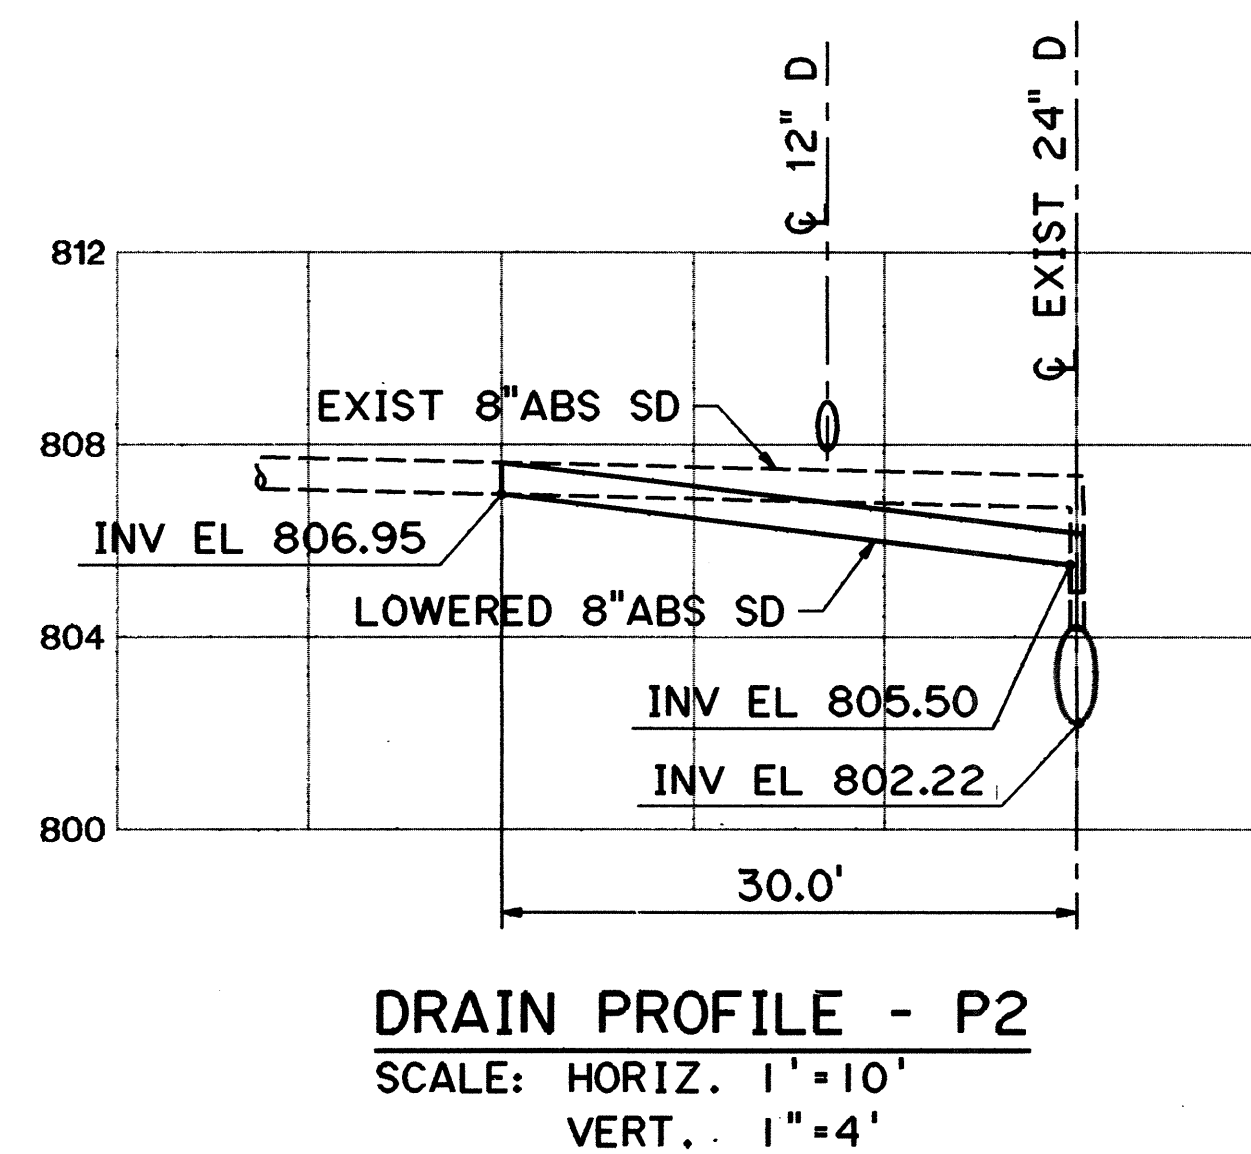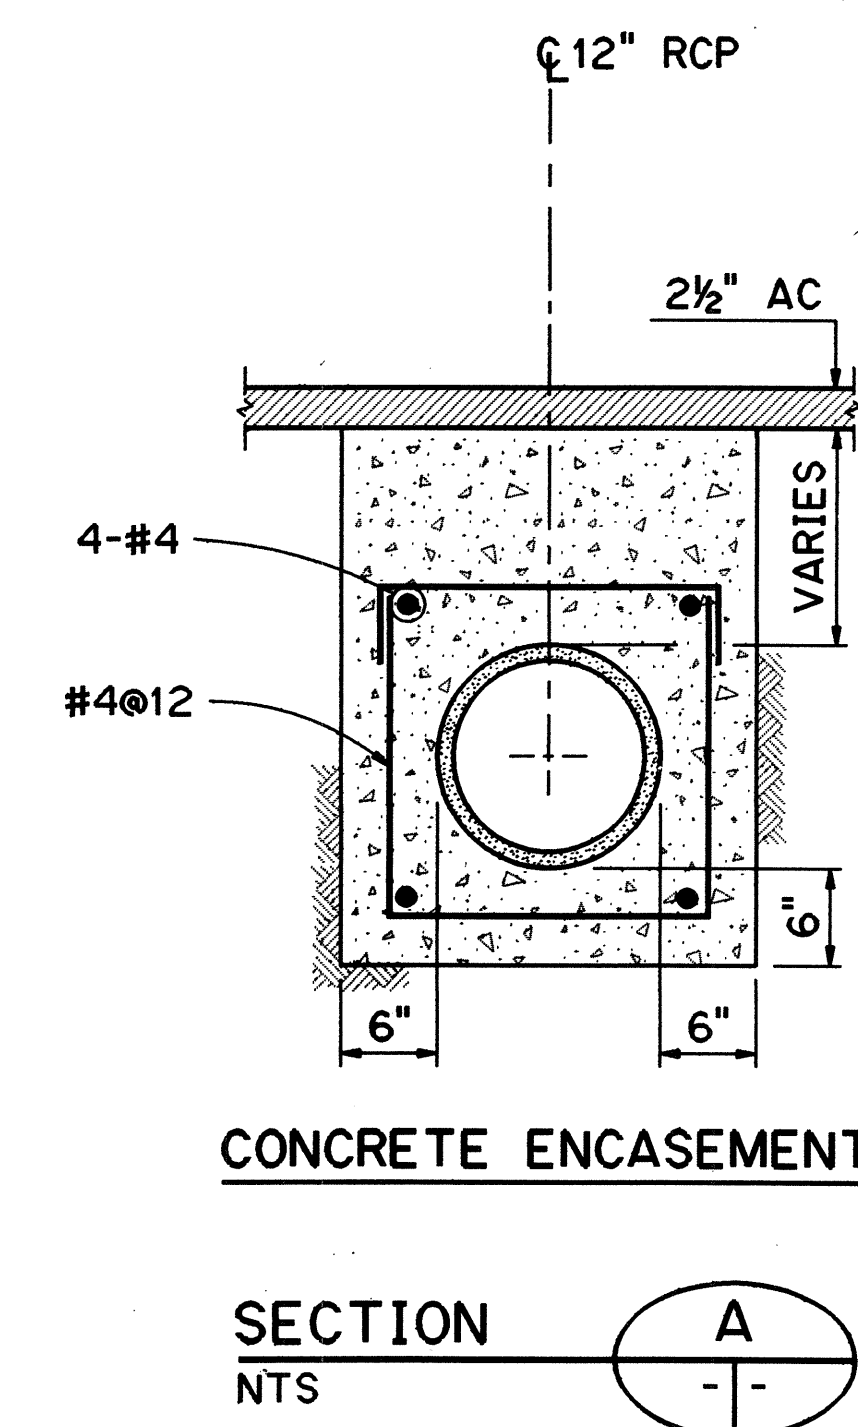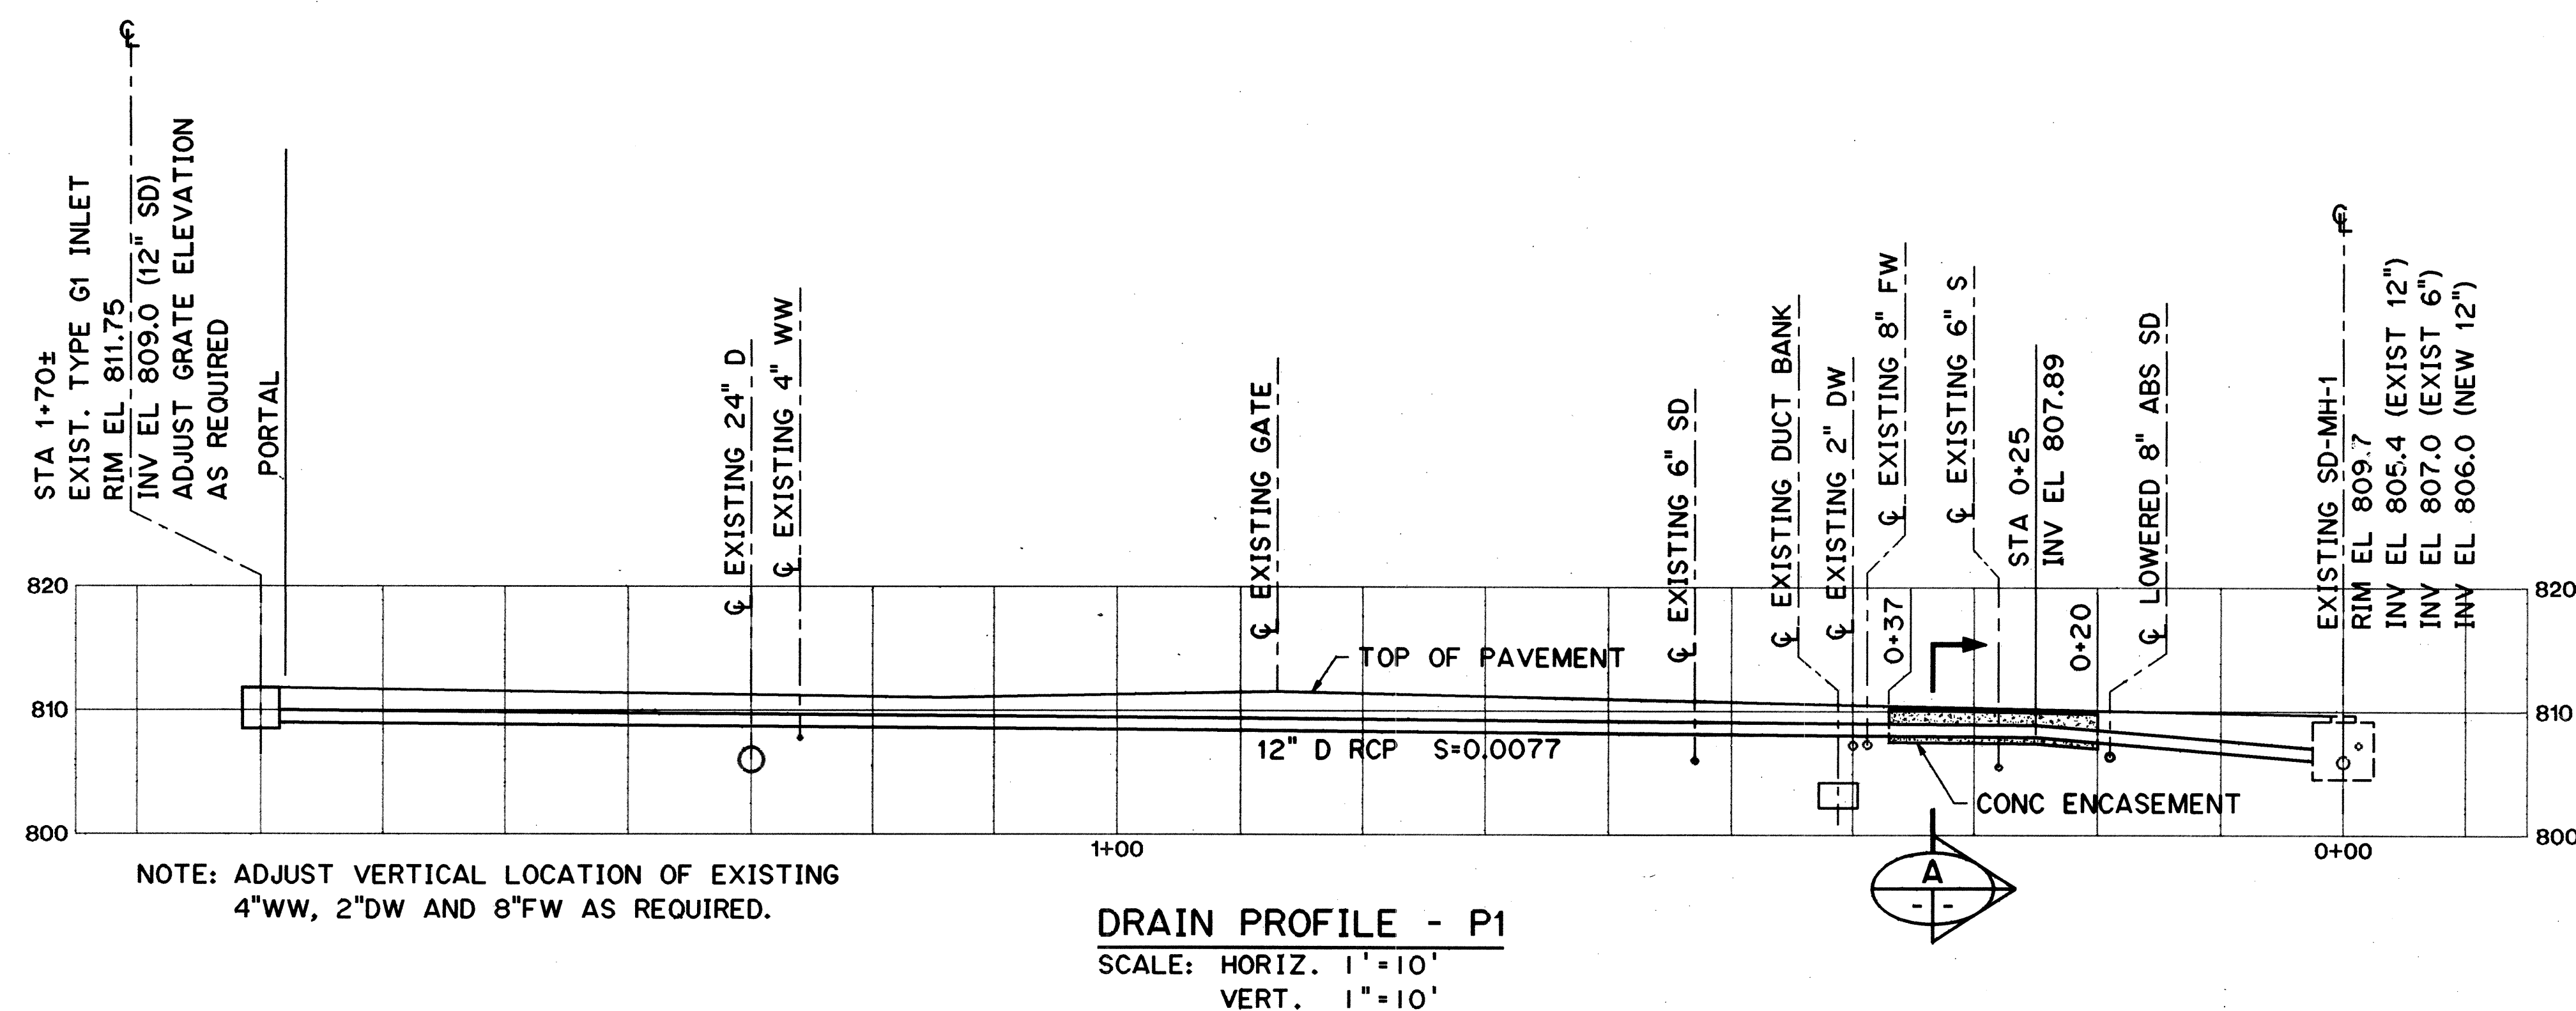

NOTE:
SEE NOTE 1 ON SHEET NO. 2C1

10/27/95	ADDENDUM 2 - CHANGED SUMP REF. SHT. NO. FROM 3S9 TO 3S8 IN PROFILE P6
DATE	REVISION

STATE OF HAWAII
DEPARTMENT OF TRANSPORTATION
HIGHWAYS DIVISION


DRAINAGE PROFILES

EXPLORATORY TUNNEL IMPROVEMENT:

H-3 FINISH (UNIT III)
FAIP NO. I-H3-1(75), UNIT III
T.K. TUNNEL / ACCESS ROADS


SCALE: AS NOTED DATE: JUN 1995

SHEET NO. 2C8 OF 15 SHEETS

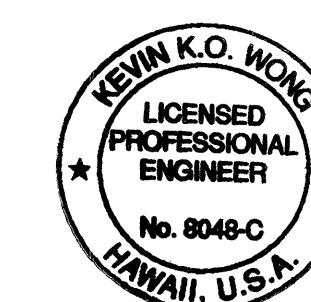


THIS WORK WAS PREPARED BY M
OR UNDER MY SUPERVISION

Ken K. Wong

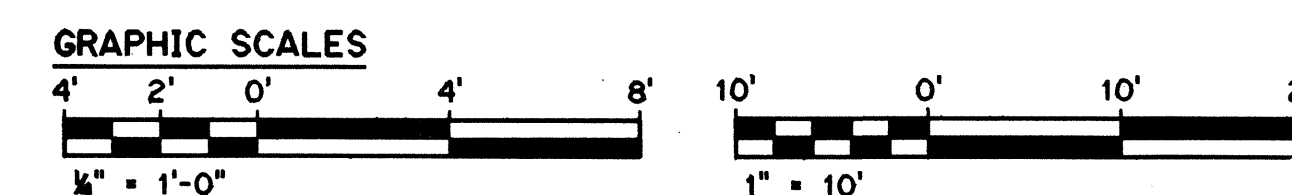


FED. ROAD DIST. NO.	STATE	FED. AID PROJ. NO.	FISCAL YEAR	SHEET NO.	TOTAL SHEETS
HAWAII	HAW.	I-H3-1(75) UNIT III	1994	26	353

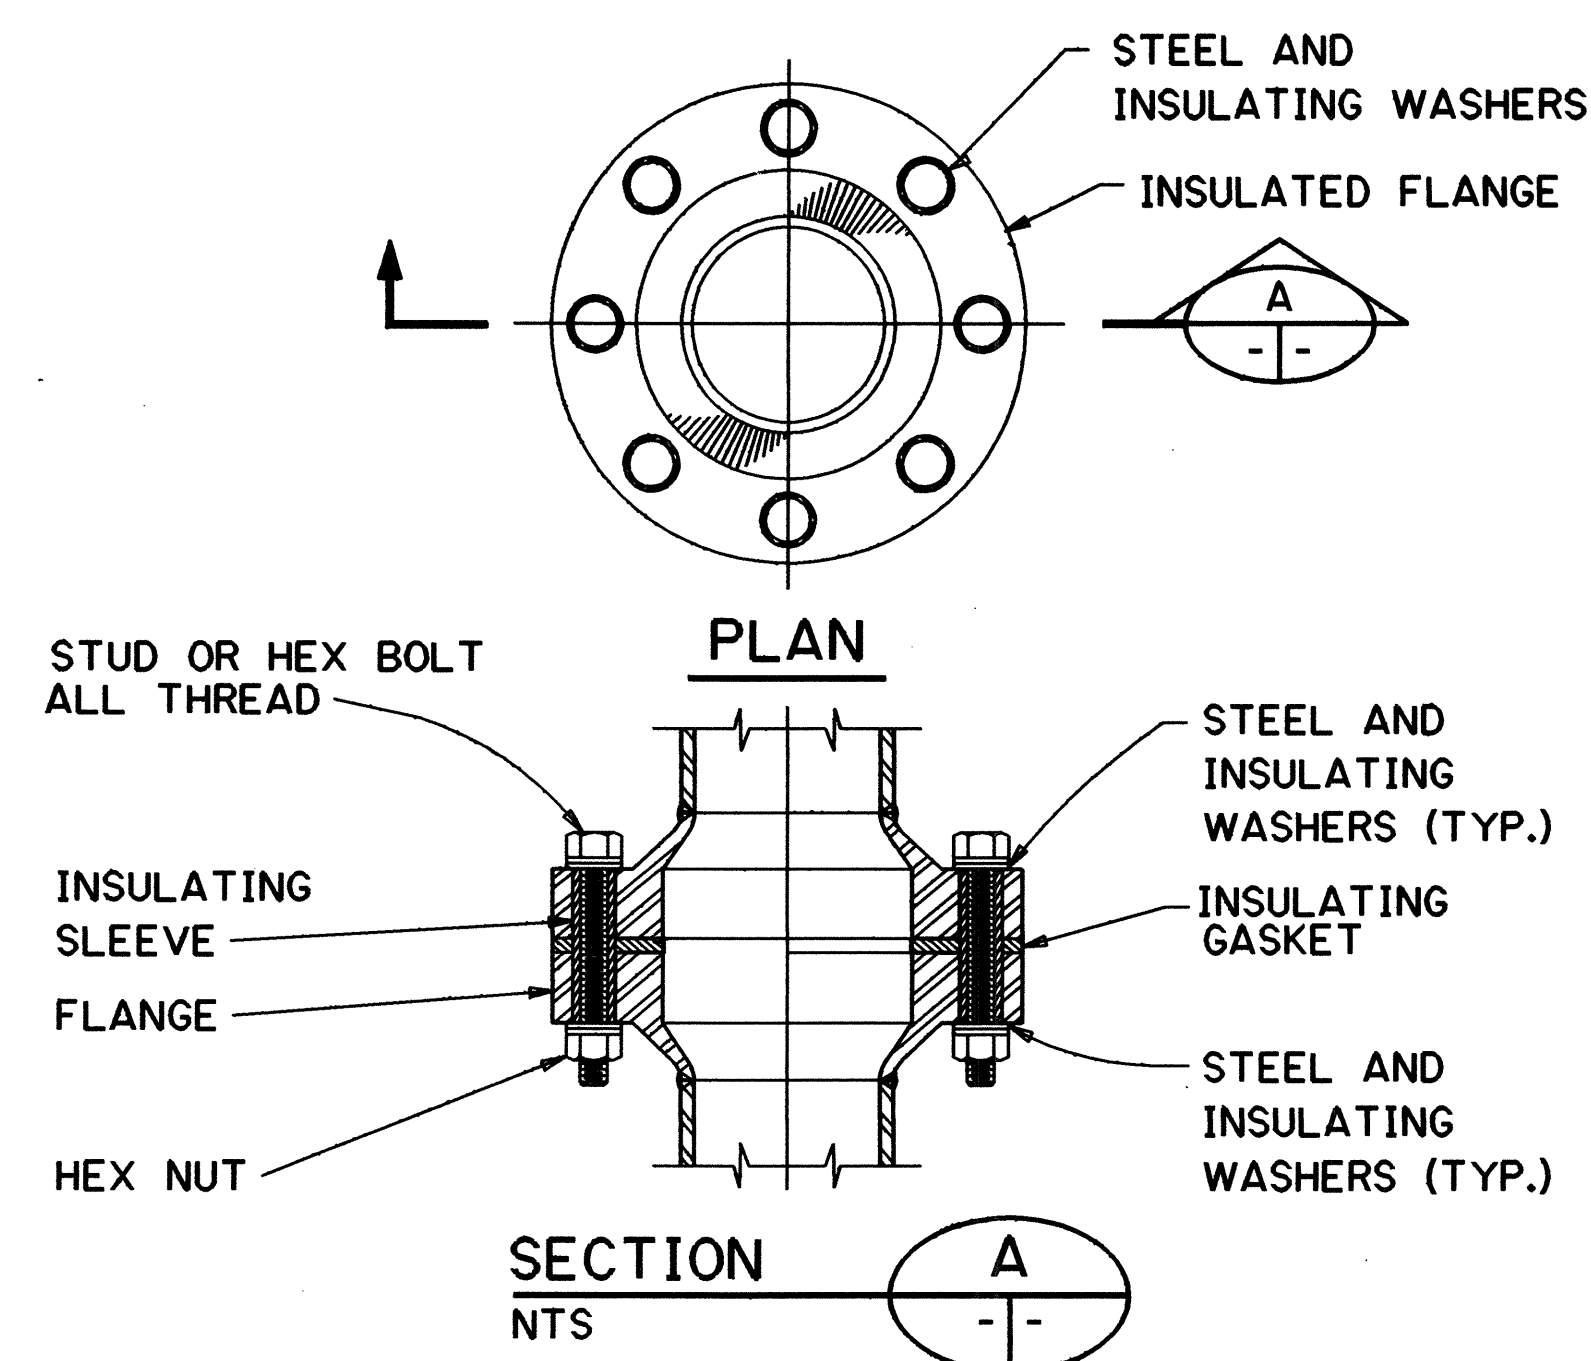


1. PROVIDE TEST FACILITIES FOR ALL BURIED AND EXPOSED INSULATED FLANGES.
- 2 THE FLANGE SHOWN IS DRAWN SCHEMATICALLY, SEE MECHANICAL PLANS FOR THE ACTUAL SHAPE AND SIZE.

INSULATED FLANGE

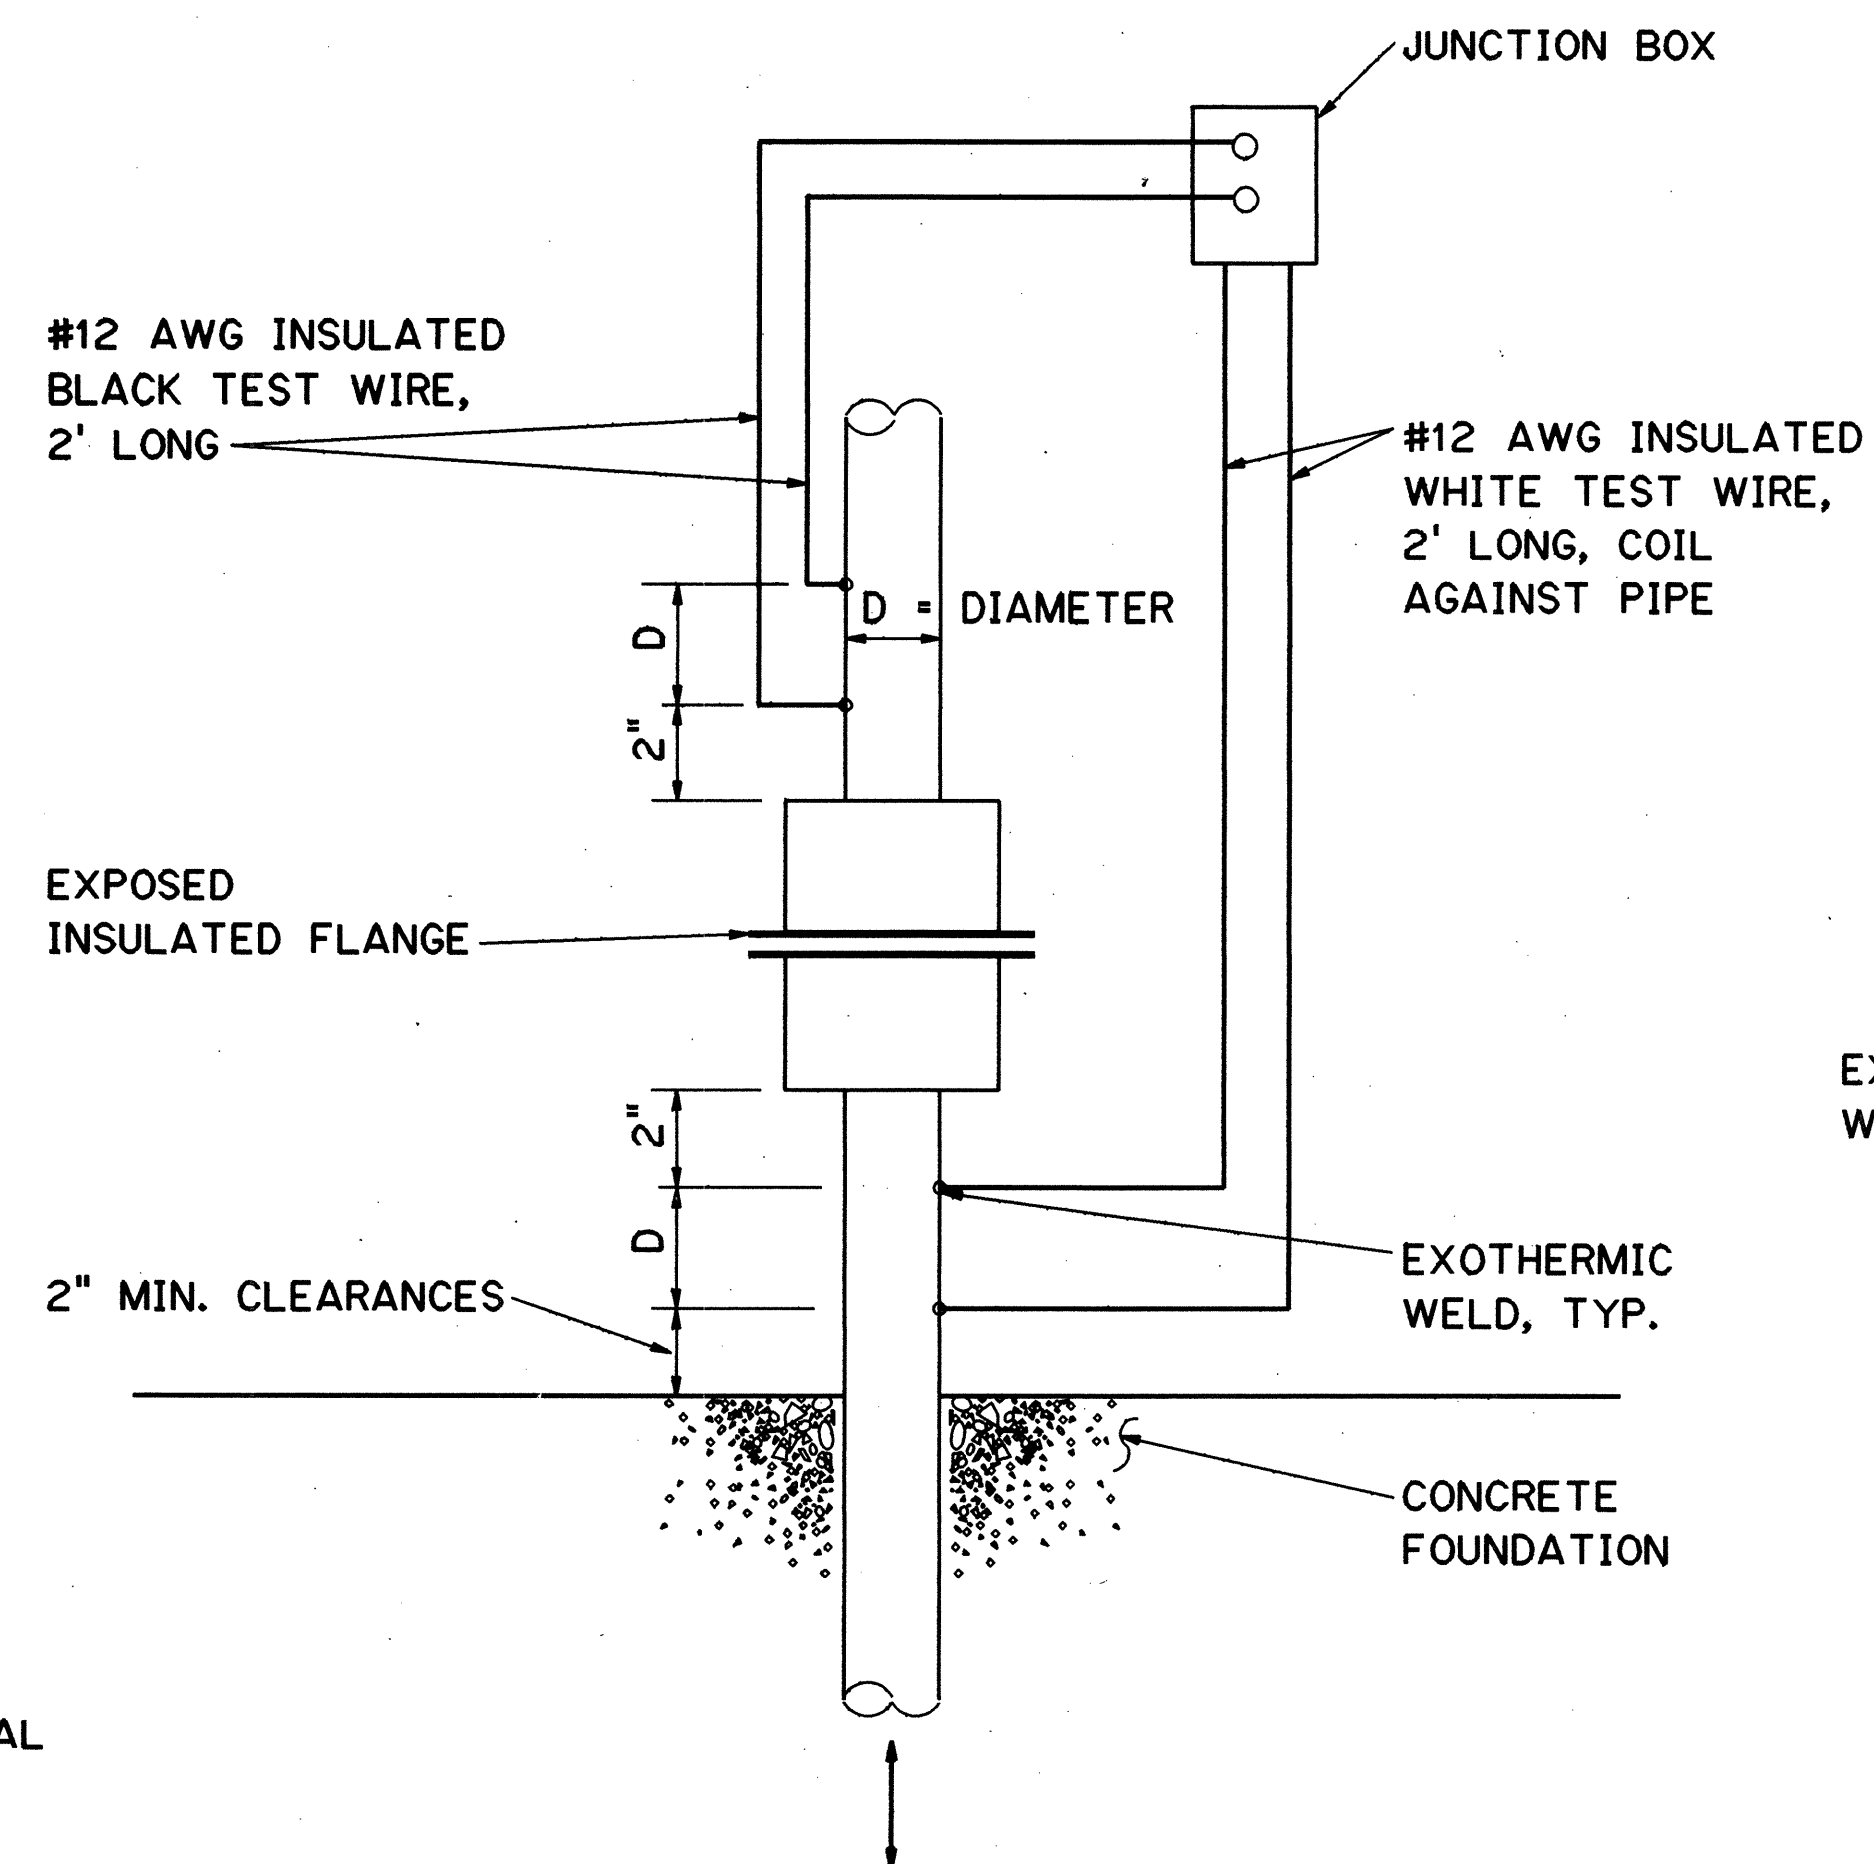

EXPOSED INSULATOR

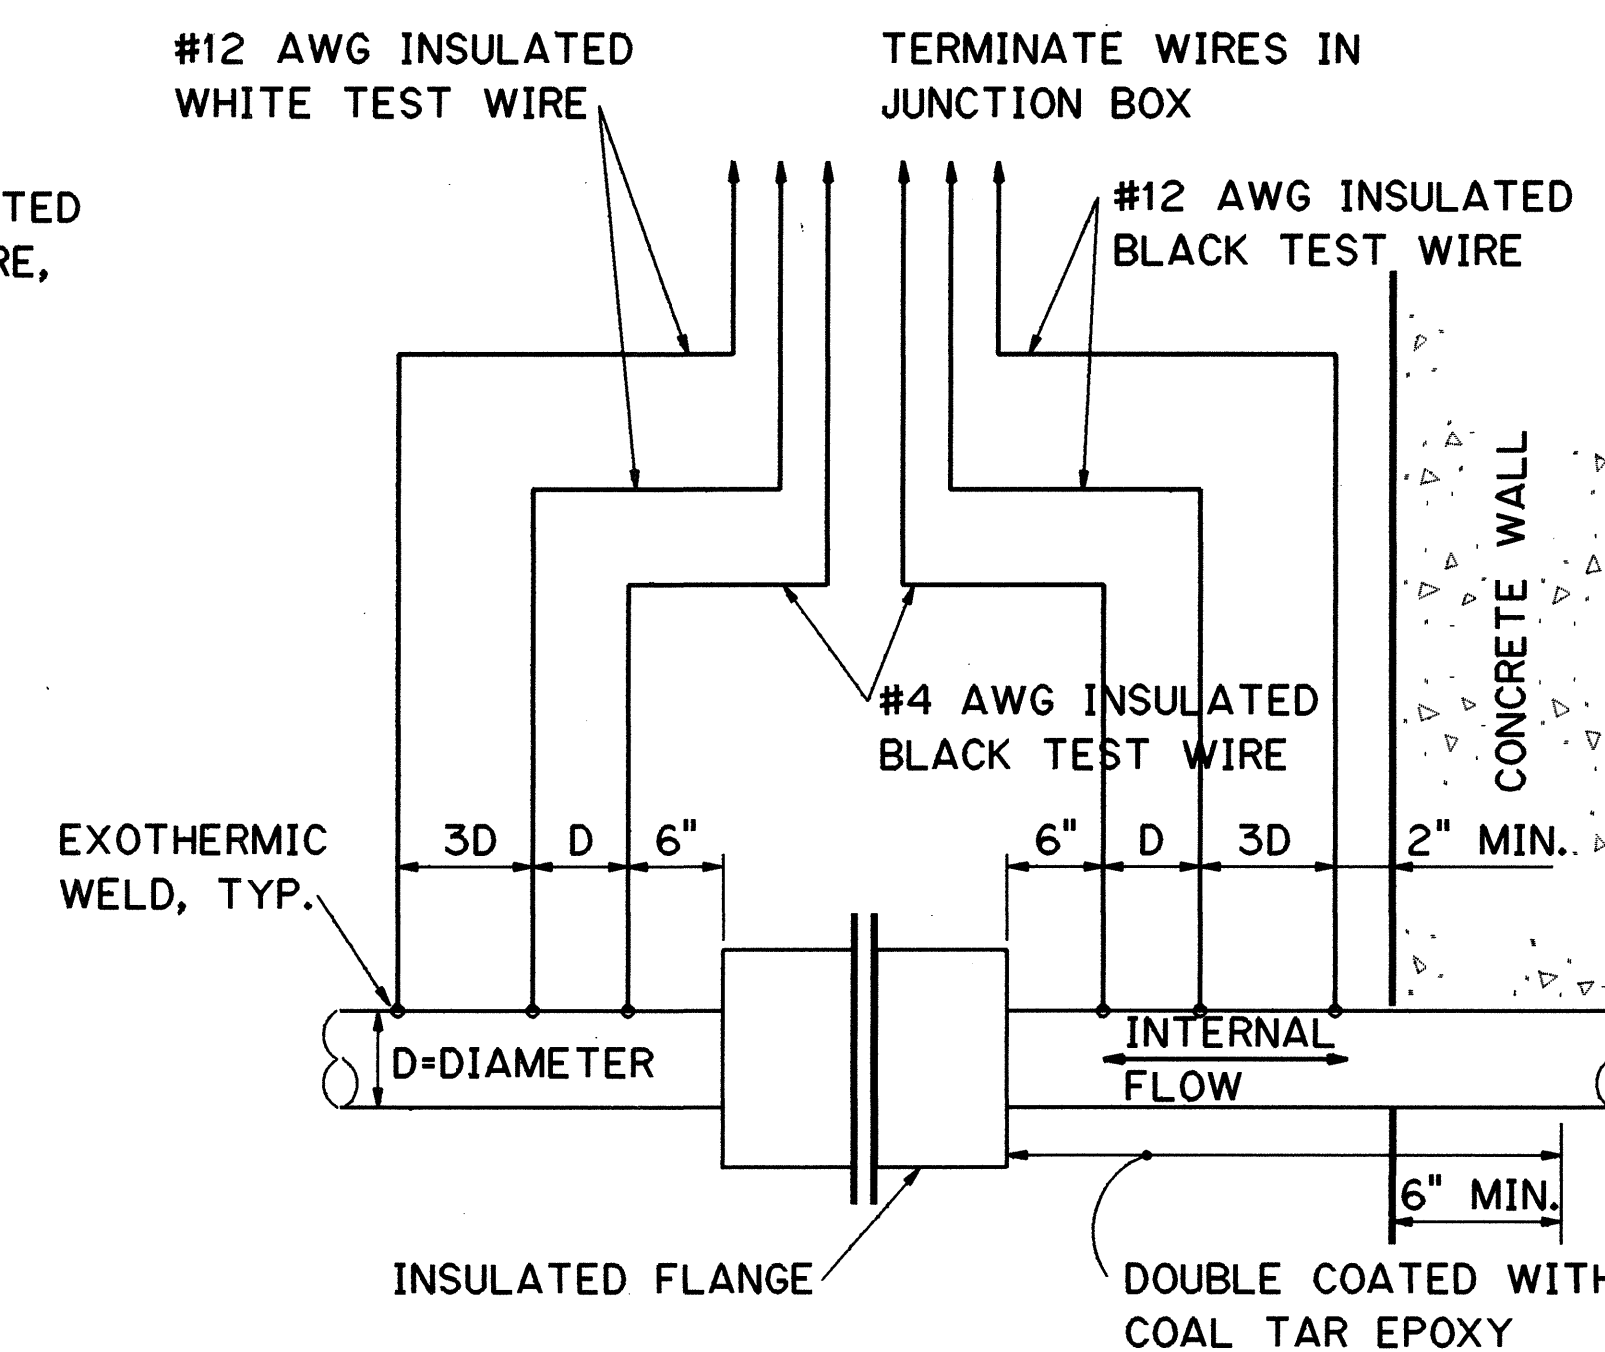


BURIED INSULATOR

DIELECTRIC INSULATORS FOR FIRE WATER LINES

NOTES FOR BURIED DIELECTRIC INSULATOR:

1. ALL BURIED TEST WIRES SHALL BE LOOSE LAID WITH SLACK TO PREVENT DAMAGE.
2. CAREFULLY BACKFILL AROUND TEST WIRES.
3. PLACE WHITE TEST WIRES ON THE NORTH OR THE EAST SIDE OF THE INSULATED FITTING.
4. EXTEND TEST WIRES TO TERMINAL BLOCK IN TEST BOX. DO NOT INTERCONNECT ANY TEST WIRES.
5. BURIED INSULATORS SHALL NOT BE COATED AND BACKFILLED BEFORE ELECTRICAL TESTS BY THE ENGINEER.

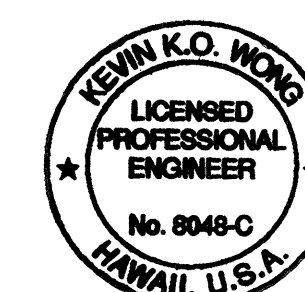[illegible]

THIS WORK WAS PREPARED BY ME
OR UNDER MY SUPERVISION

Keri K. A. Wong

STATE OF HAWAII
DEPARTMENT OF TRANSPORTATION
HIGHWAYS DIVISION


CATHODIC PROTECTION
TYPICAL DETAILS - 1

EXPLORATORY TUNNEL IMPROVEMENTS

H-3 FINISH (UNIT III)
FAIP NO. I-H3-1(75), UNIT III
T.K. TUNNEL / ACCESS ROADS

SCALE: NTS DATE: JUN 1999

NOTE:
FOR GENERAL NOTES, SEE SHEET NO. 2C9.

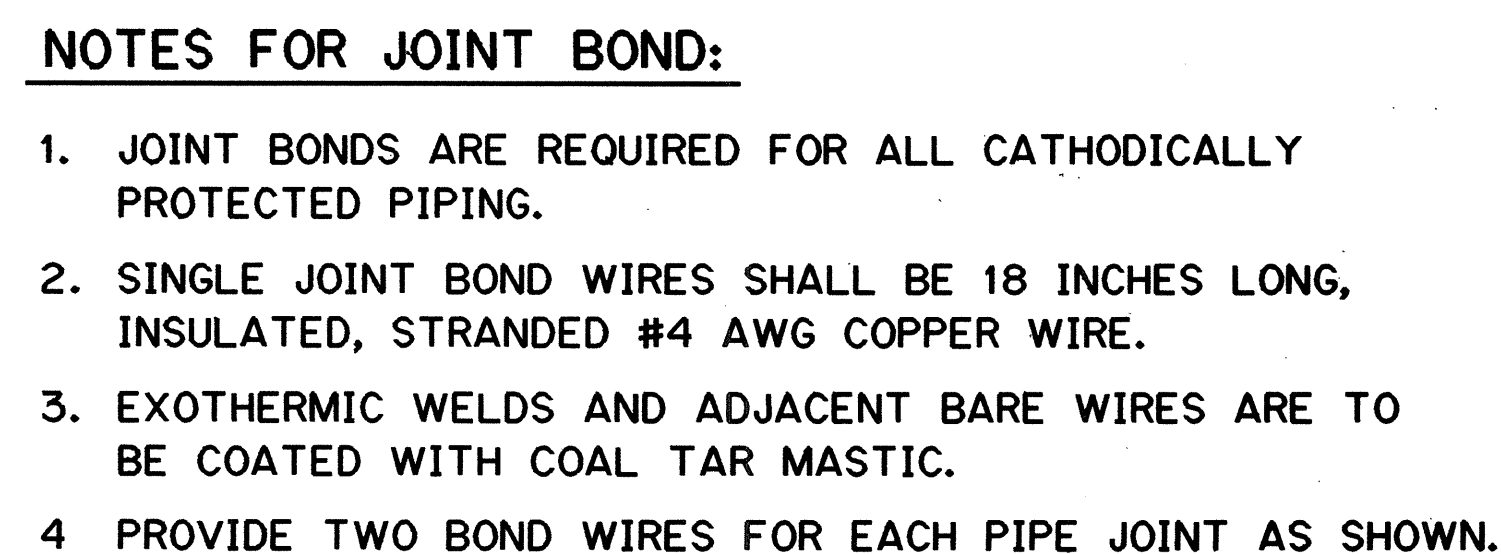

The drawing consists of two views: an Elevation view and a Section view.

ELEVATION View:


- Shows a horizontal **TEST BOX** at the top right.
- A **#12 AWG TEST WIRE** runs from the test box, through an **EXOTHERMIC WELD**, and along the top of a **METAL PIPE**.
- A **#8 AWG INSULATED (HMMWPE) HEADER CABLE** runs horizontally below the metal pipe.
- A **SPLICE (TYP.)** connects the header cable to the metal pipe.
- A **MAGNESIUM ANODE, TYP.** is shown connected to the metal pipe via an **ANODE LEAD**.
- The **GRADE** line is indicated at the top.

SECTION View:


- Shows a cross-section of the **METAL PIPE** with a diameter of **1'-0"**.
- The **TOP OF ANODE** is located **1'-0"** below the bottom of the pipe.
- The **HEADER CABLE CONNECTION** and **ANODE LEAD** are shown entering the pipe.

Section line markers **B** and **- -** are present at the top and bottom of the drawing.


MAGNESIUM ANODE INSTALLATION

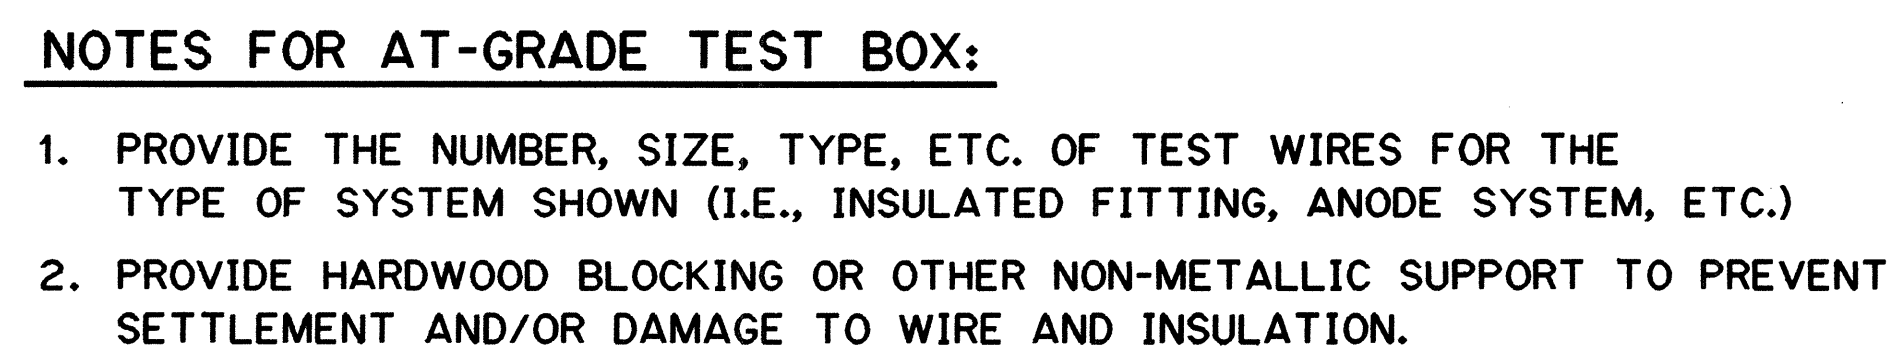

AT-GRADE TEST BOX

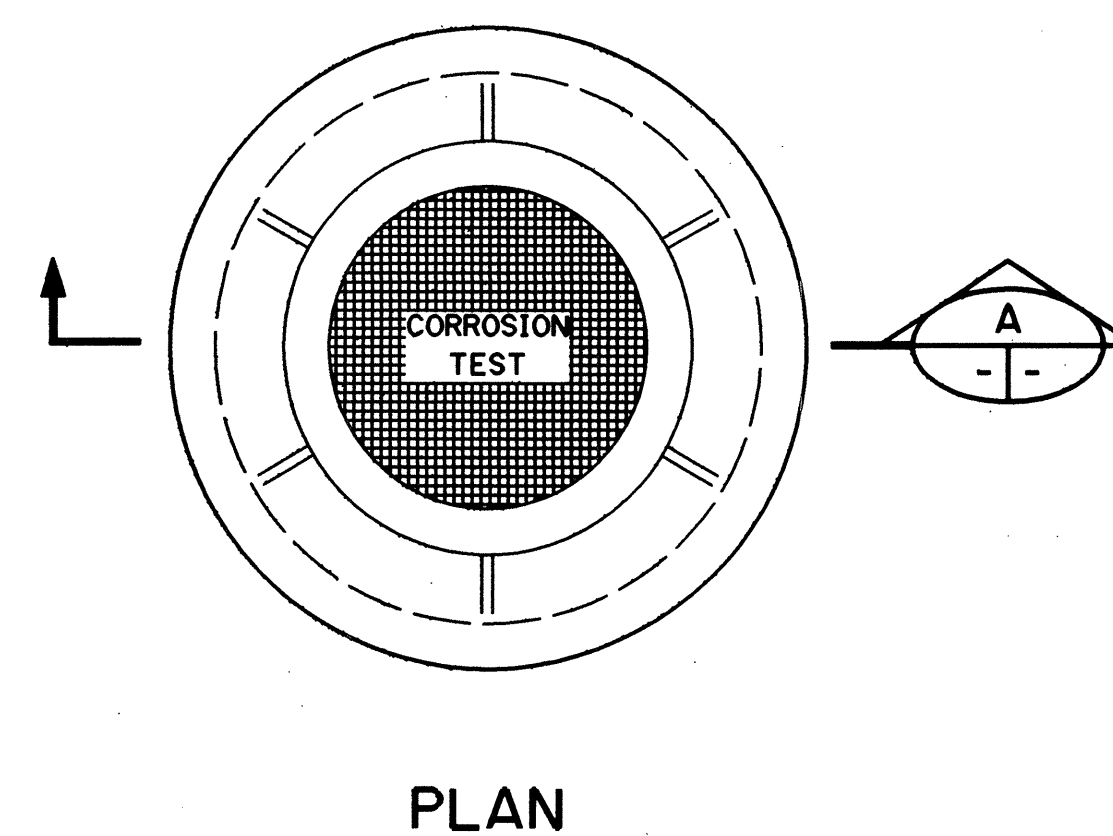

NOTES FOR TYPICAL FITTING BONDS:

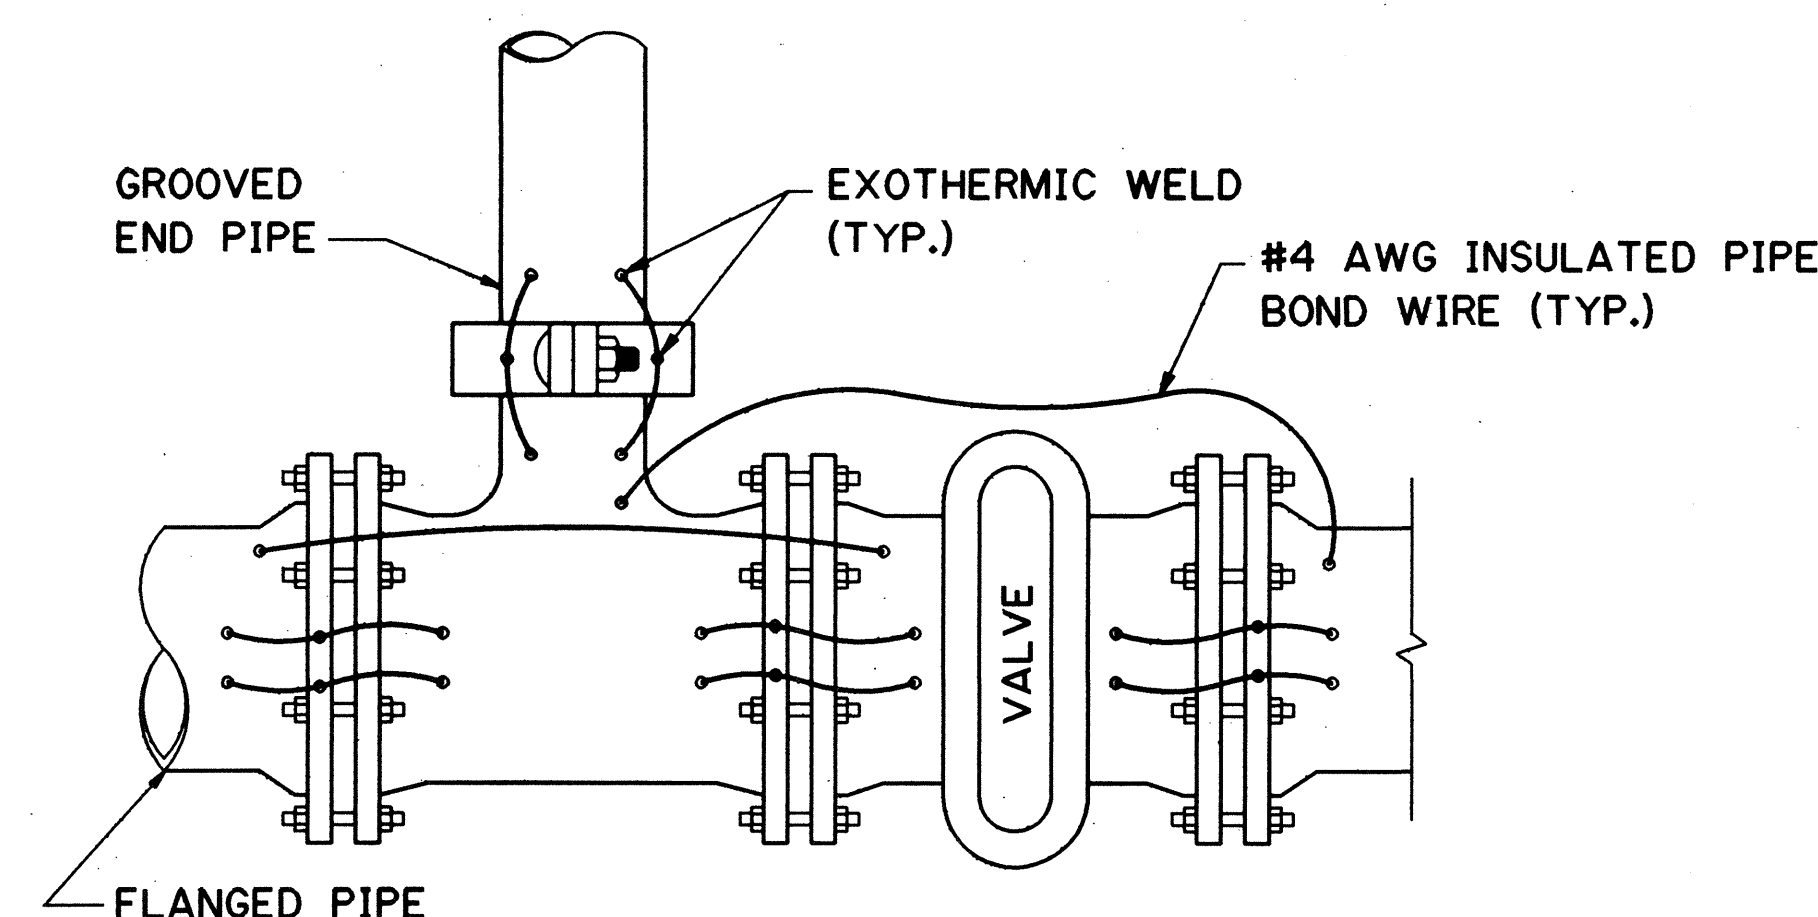


FITTING BONDS

THIS WORK WAS PREPARED BY ME
OR UNDER MY SUPERVISION

DATE	REVISION
STATE OF HAWAII DEPARTMENT OF TRANSPORTATION HIGHWAYS DIVISION	
<u>CATHODIC PROTECTION</u> <u>TYPICAL DETAILS - 2</u> <u>EXPLORATORY TUNNEL IMPROVEMENTS</u> <u>H-3 FINISH (UNIT III)</u> <u>FAIP NO. I-H3-1(75), UNIT III</u> <u>T.K. TUNNEL / ACCESS ROADS</u>	
SCALE: NTS	DATE: JUN 1995
SHEET NO. 2C11	OF 15 SHEETS

FED. ROAD DIST. NO.	STATE	FED. AID PROJ. NO.	FISCAL YEAR	SHEET NO.	TOTAL SHEETS
HAWAII	HAW.	I-H3-1(75) UNIT III	1994	28	353


NOTE:
FOR GENERAL NOTES, SEE SHEET NO. 2C9.

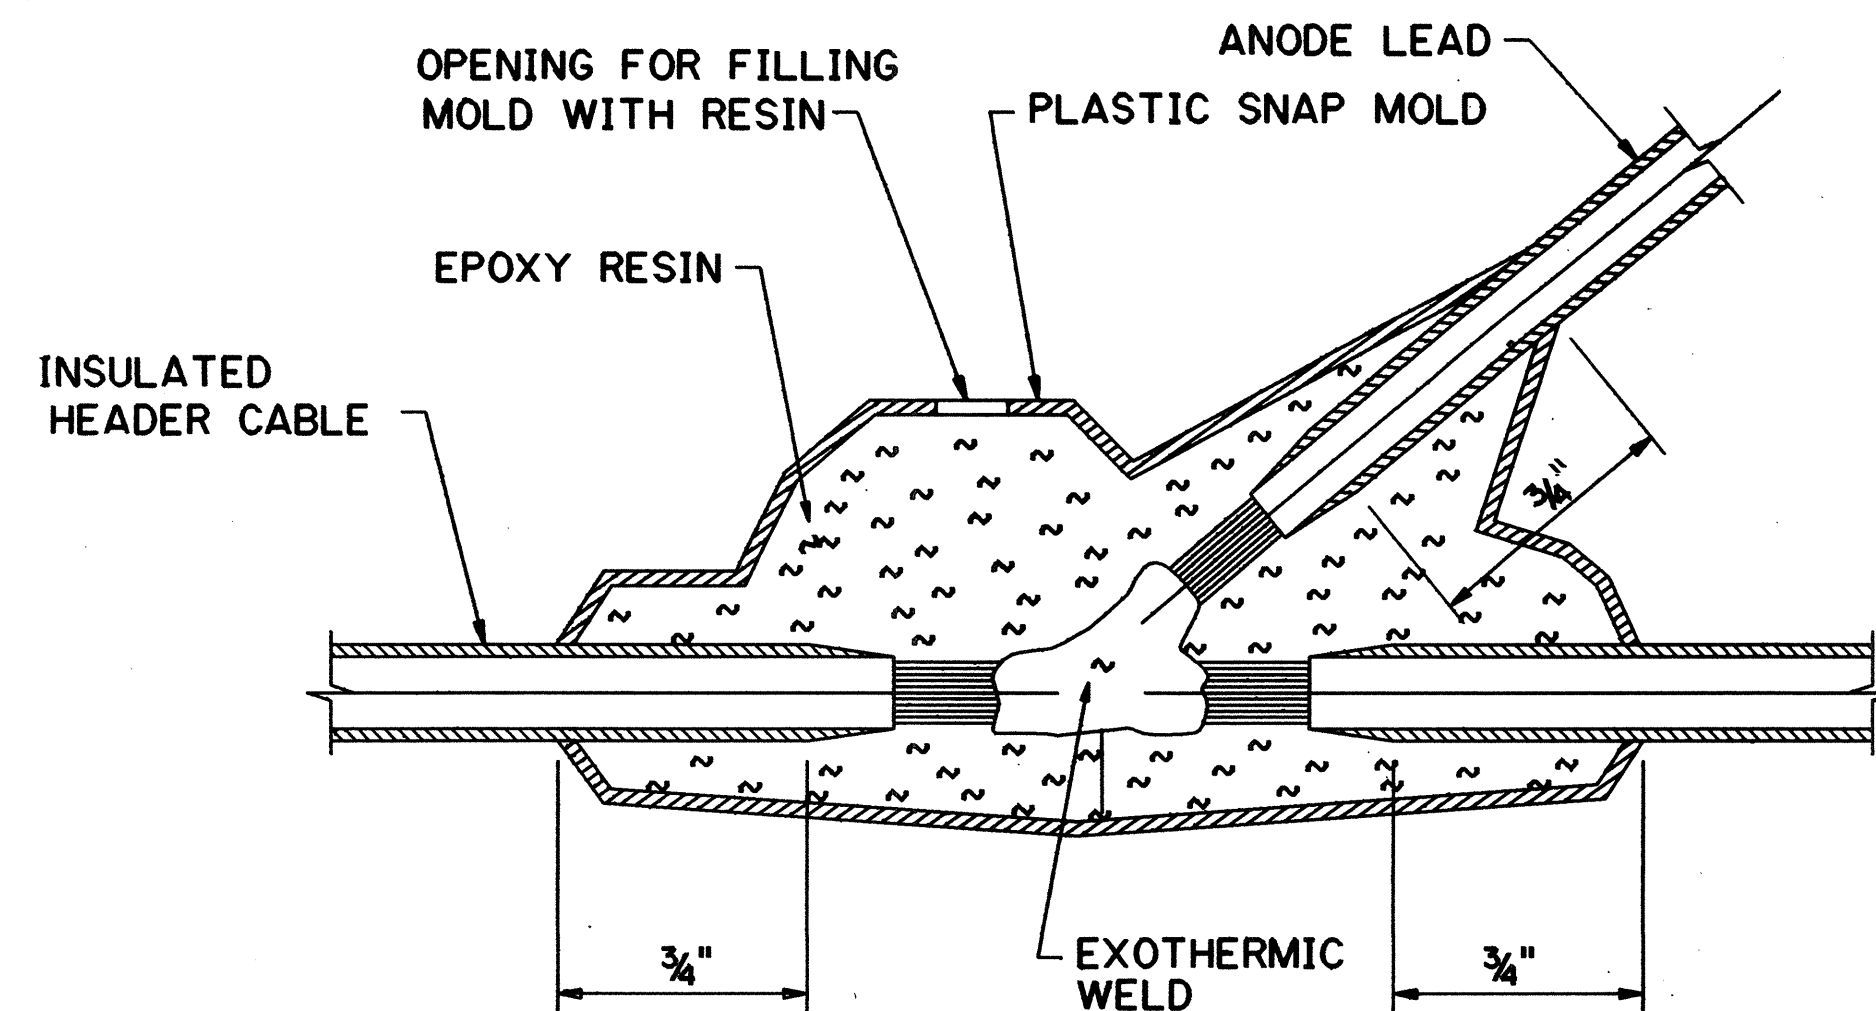

NOTES FOR SPLICE KIT AND WIRE CONNECTION:

1. WIRE INSULATION SHALL EXTEND WITHIN THE MOLD AS SHOWN AND ALL BARE COPPER AND CONNECTIONS ARE TO BE COMPLETELY ENCAPSULATED BY EPOXY RESIN.
2. CLEAN AND DRY EXOTHERMIC CONNECTION PRIOR TO INSTALLATION OF SNAP MOLD AND EPOXY RESIN.


SPLICE KIT AND WIRE CONNECTION

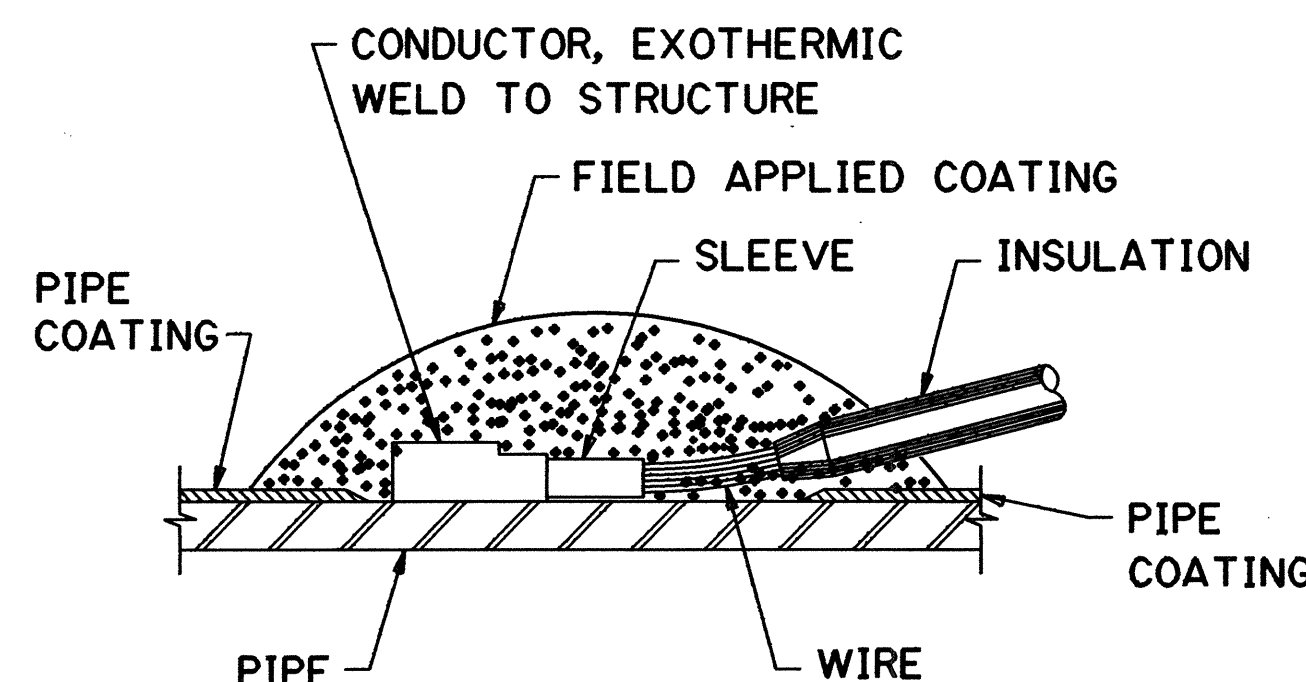

NOTES FOR EXOTHERMIC CONNECTION:

1. POWER GRIND, CLEAN AND DRY CONTACT SURFACE BEFORE MAKING EXOTHERMIC CONNECTION.
2. AFTER WELD HAS COOLED, REMOVE ALL SLAG AND TEST THE CONNECTION BY STRIKING WITH A HAMMER PRIOR TO COATING.
3. ALL EXOTHERMIC WELDS SHALL BE COATED WITH COAL TAR TAPE PER THE TAPE MANUFACTURER'S INSTRUCTIONS.


EXOTHERMIC CONNECTION

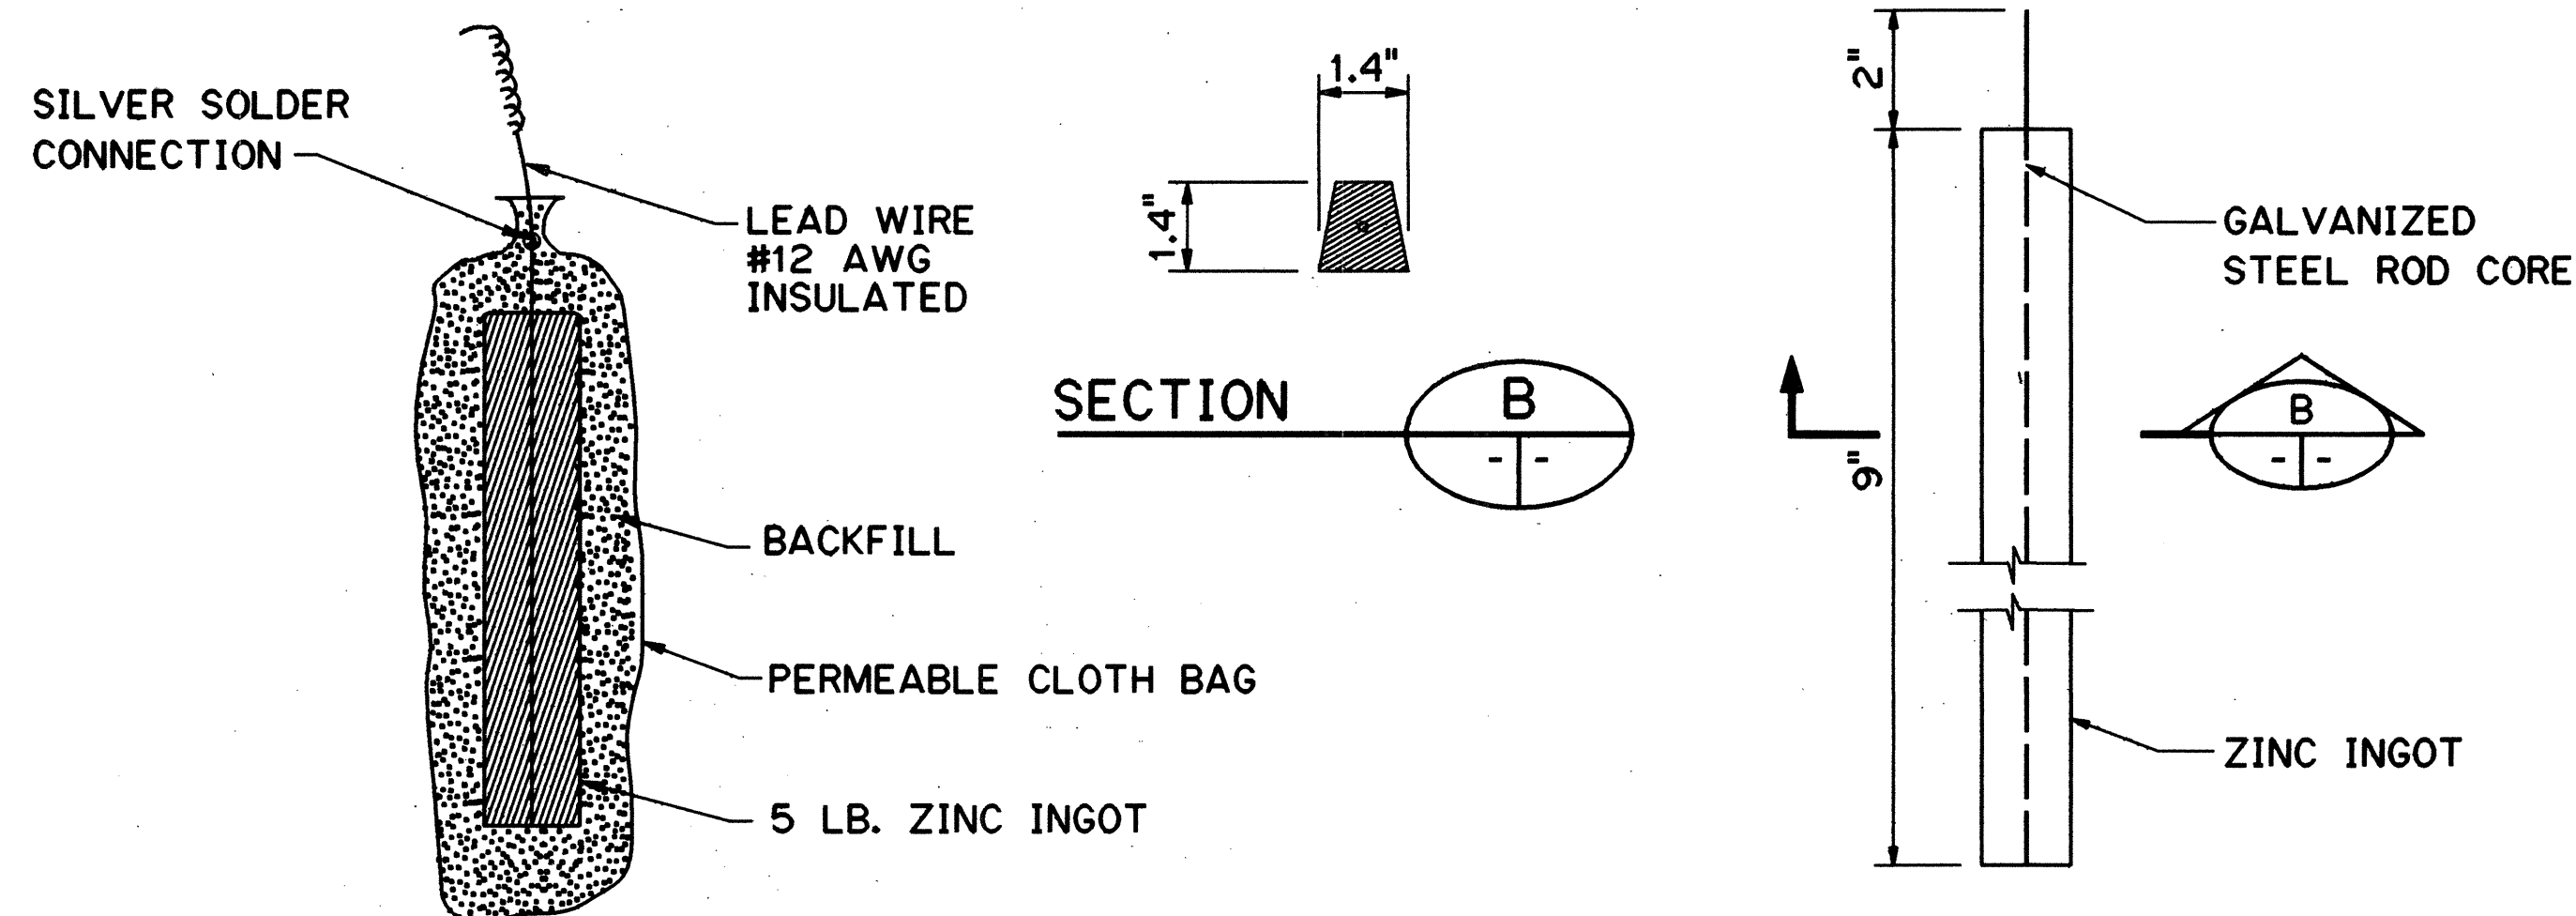

NOTES FOR REFERENCE ANODE:

1. BACKFILL MATERIAL WITHIN THE PREPACKAGED REFERENCE ANODE SHALL BE 50 PERCENT BENTONITE AND 50 PERCENT HYDRATED GYPSUM. NO SODIUM SULFATE SHALL BE PERMITTED.
2. LEAD WIRE/CORE CONNECTION SHALL BE A PERMANENT SILVER SOLDER CONNECTION.
3. REFERENCE ANODE SHALL BE INSTALLED AT THE SAME DEPTH AS THE BOTTOM OF THE PROTECTED STRUCTURE.
4. REFERENCE ANODE SHALL BE INSTALLED 10 TO 12 INCHES FROM THE PROTECTED STRUCTURE AND MUST NOT CONTACT THE PROTECTED STRUCTURE, OTHER ANODES OR METAL OBJECTS.


REFERENCE ANODE

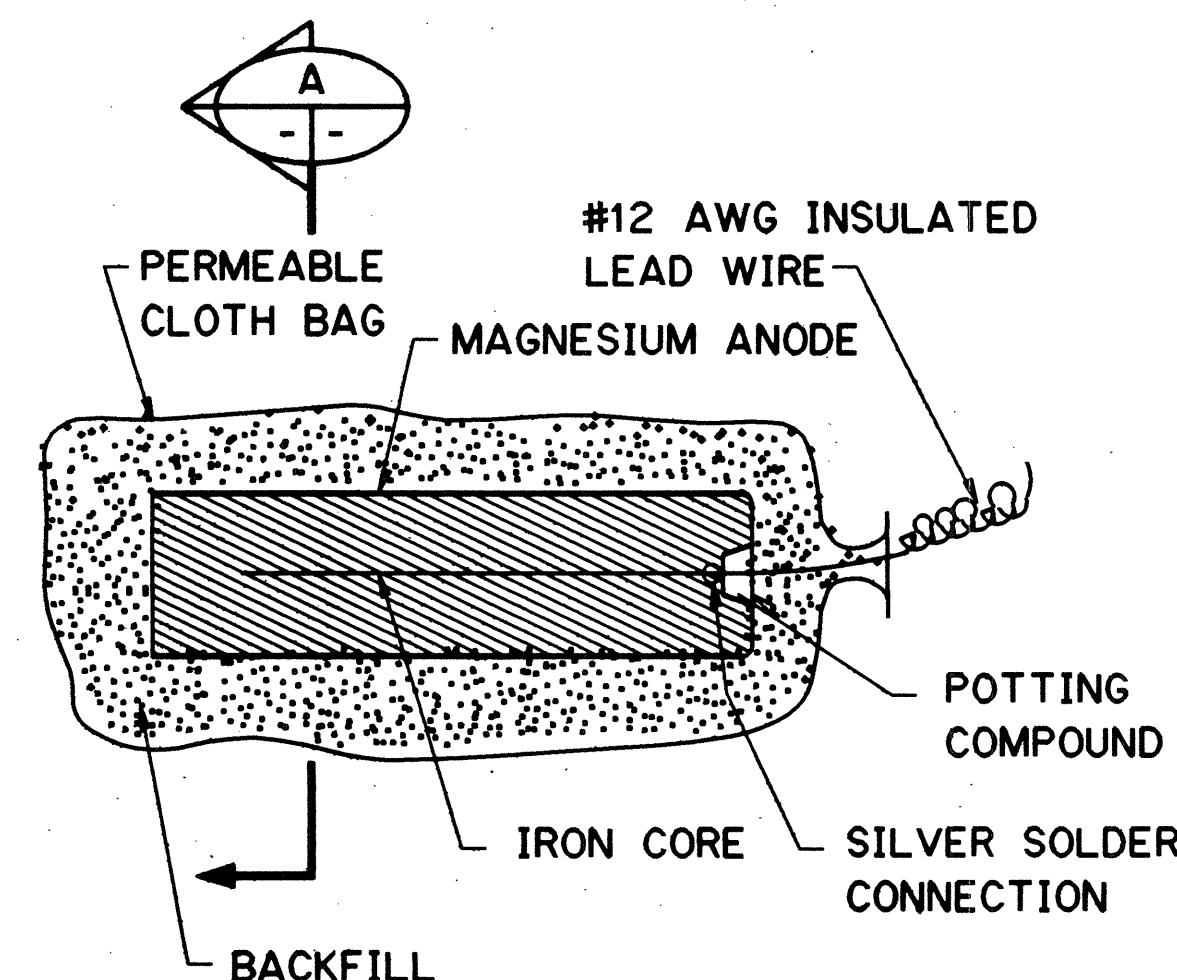

GENERAL NOTE FOR MAGNESIUM ANODE:

ANODE WITH CLOTH BAG AND BACKFILL SHALL BE REMOVED FROM ANY OTHER EXTERNAL PACKAGING SUCH AS PAPER BAGS OR CARDBOARD BOXES BEFORE INSTALLATION.

MAGNESIUM ANODE

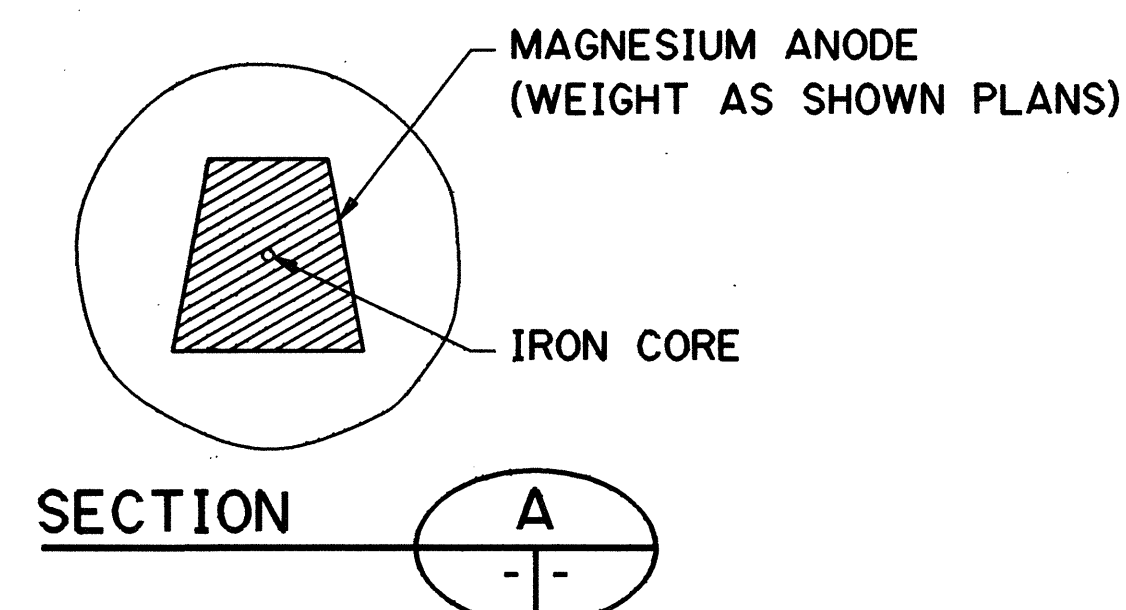

DATE	JAN 95
DESIGNED BY	B. VUONG
DRAWN BY	G. T. BUCKHORN
CHECKED BY	D. MANITI
NO.	



THIS WORK WAS PREPARED BY ME
OR UNDER MY SUPERVISION

Kevin K.O. Wong

DATE	REVISION

STATE OF HAWAII DEPARTMENT OF TRANSPORTATION HIGHWAYS DIVISION	
CATHODIC PROTECTION TYPICAL DETAILS - 3	
EXPLORATORY TUNNEL IMPROVEMENTS	
H-3 FINISH (UNIT III)	
FAIP NO. I-H3-1(75), UNIT III	
T.K. TUNNEL / ACCESS ROADS	
SCALE: NTS	DATE: JUN. 1995
SHEET NO. 2C12	OF 15 SHEETS

The diagrams illustrate the use of concrete thrust blocks in different pipe configurations:

- Top Left:** A vertical pipe with a horizontal pipe crossing it. A concrete thrust block is shown at the top of the vertical pipe, between the two horizontal pipes.
- Top Right:** A vertical pipe with a horizontal pipe crossing it. A concrete thrust block is shown at the top of the vertical pipe, between the two horizontal pipes.
- Middle Left:** A vertical pipe with a horizontal pipe crossing it. A concrete thrust block is shown at the bottom of the vertical pipe, between the two horizontal pipes.
- Middle Right:** A vertical pipe with a horizontal pipe crossing it. A concrete thrust block is shown at the bottom of the vertical pipe, between the two horizontal pipes.
- Bottom Left:** A vertical pipe with a horizontal pipe crossing it. A concrete thrust block is shown at the bottom of the vertical pipe, between the two horizontal pipes.
- Bottom Right:** A vertical pipe with a horizontal pipe crossing it. A concrete thrust block is shown at the bottom of the vertical pipe, between the two horizontal pipes.

Legend:

- UNDISTURBED SOIL, TYP.
- CONCRETE THRUST BLOCK CLASS B, TYP.

1. THE SIZE OF THE THRUST BLOCK MAY BE ADJUSTED BY THE ENGINEER IN THE FIELD ACCORDING TO ACTUAL SOIL CONDITION.
2. NO HORIZONTAL THRUST BLOCK IS NEEDED FOR LINES SMALLER THAN 3" AND WITH LESS THAN 50 psi OPERATING PRESSURE.

GENERAL NOTES:

1. ITEMS OF WORK AND MATERIALS REQUIRED BUT NOT COVERED BY THE STANDARD PLANS NOR THE STANDARD SPECIFICATIONS SHALL CONFORM TO THE REQUIREMENTS OF THE BOARD OF WATER SUPPLY, CITY AND COUNTY OF HONOLULU.
2. THE APPLICABLE STANDARDS ARE:
 - A. "APPROVED MATERIAL LIST AND STANDARD DETAILS FOR WATER SYSTEM CONSTRUCTION", 1985 EDITION, VOLUME 2.
 - B. "WATER SYSTEM STANDARDS", 1985 EDITION, VOLUME 1.

BY: DEPARTMENT OF WATER, COUNTY OF KAUAI
BOARD OF WATER SUPPLY, CITY AND COUNTY OF HONOLULU
DEPARTMENT OF WATER SUPPLY, COUNTY OF MAUI
DEPARTMENT OF WATER SUPPLY, COUNTY OF HAWAII

1. 12-INCH VALVE BOX FRAME AND COVER	16	-
2. HYDRANT GUARD AND VALVE MARKER	33	-
3. HORIZONTAL THRUST BLOCK, MINIMUM BEARING AREAS	105	-
4. TOP VERTICAL THRUST BLOCK SCHEDULE	106	SEE BELOW
5. TYPICAL THRUST BLOCK VERTICAL BENDS	107	SEE BELOW
6. TYPICAL THRUST BLOCK WITH STRAPS FOR CONNECTIONS AT VERTICAL BEND	108	SEE BELOW

WITH APPROVAL OF THE ENGINEER, THE CONTRACTOR MAY USE ROCK ANCHORS FOR SECURING THRUST BLOCKS AT VERTICAL BENDS TO REDUCE THE SIZE OF CONCRETE ANCHORING BLOCK. THE MINIMUM PULL OUT LOAD OF EACH ROCK ANCHOR SHOULD BE 20 KIPS. EACH LEG OF HANGERS OR STEEL STRAPS SHOULD BE SECURELY BONDED/FASTENED TO A ROCK ANCHOR TO RESIST 20 KIPS MINIMUM PULL OUT FORCE. THE MINIMUM SIZE OF CONCRETE TRUST BLOCK:
A = 0, B = 0, C = 0
MINIMUM WIDTH OF CONCRETE ENCASEMENT AROUND PIPE:
D = 24"
MINIMUM LENGTH OF CONCRETE ENCASEMENT = 14"
MINIMUM REQUIREMENT OF HANGERS = 3-#5

3. UNLESS OTHERWISE STATED, THE FOLLOWING SHALL BE USED TO CALCULATE THE MINIMUM BEARING AREA FOR THRUST BLOCKS:

WATER PRESSURE = 180 PSI		
<u>SOIL CONDITION</u>	<u>LOCATION</u>	<u>LATERAL BEARING PRESSURE</u>
SOFT ROCK	TUNNEL AND CROSSPASSAGE	4000 PSF
COARSE SAND/ IMPORTED GRANULAR MATERIAL	SERVICE AREA AROUND PORTAL BLDG.	2000 PSF


ORIGINAL PLAN	SURVEY PLOTTED BY		DATE
	DRAWN BY	B. VUONG	JAN 95
NOTE BOOK	TRACED BY	C. TE BOEKHORST	JAN 95
	QUANTITIES BY		
NO.	CHECKED BY	D. MANITI	JAN 95

DATE	REVISION

STATE OF HAWAII
DEPARTMENT OF TRANSPORTATION
HIGHWAYS DIVISION

DOMESTIC & FIRE WATER
TYPICAL DETAILS
EXPLORATORY TUNNEL IMPROVEMENTS
H-3 FINISH (UNIT II)
FAIP NO. I-H3-1(75), UNIT III
T.K. TUNNEL / ACCESS ROADS






SCALE: NTS DATE: JUN 1995

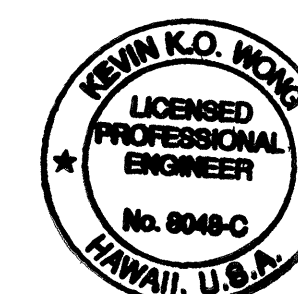

THIS WORK WAS PREPARED BY ME
OR UNDER MY SUPERVISION

Ken K.O. Wong


FED. ROAD DIST. NO.	STATE	FED. AID PROJ. NO.	FISCAL YEAR	SHEET NO.	TOTAL SHEETS
HAWAII	HAW.	1-H3-1(75) UNIT III	1994	30	353

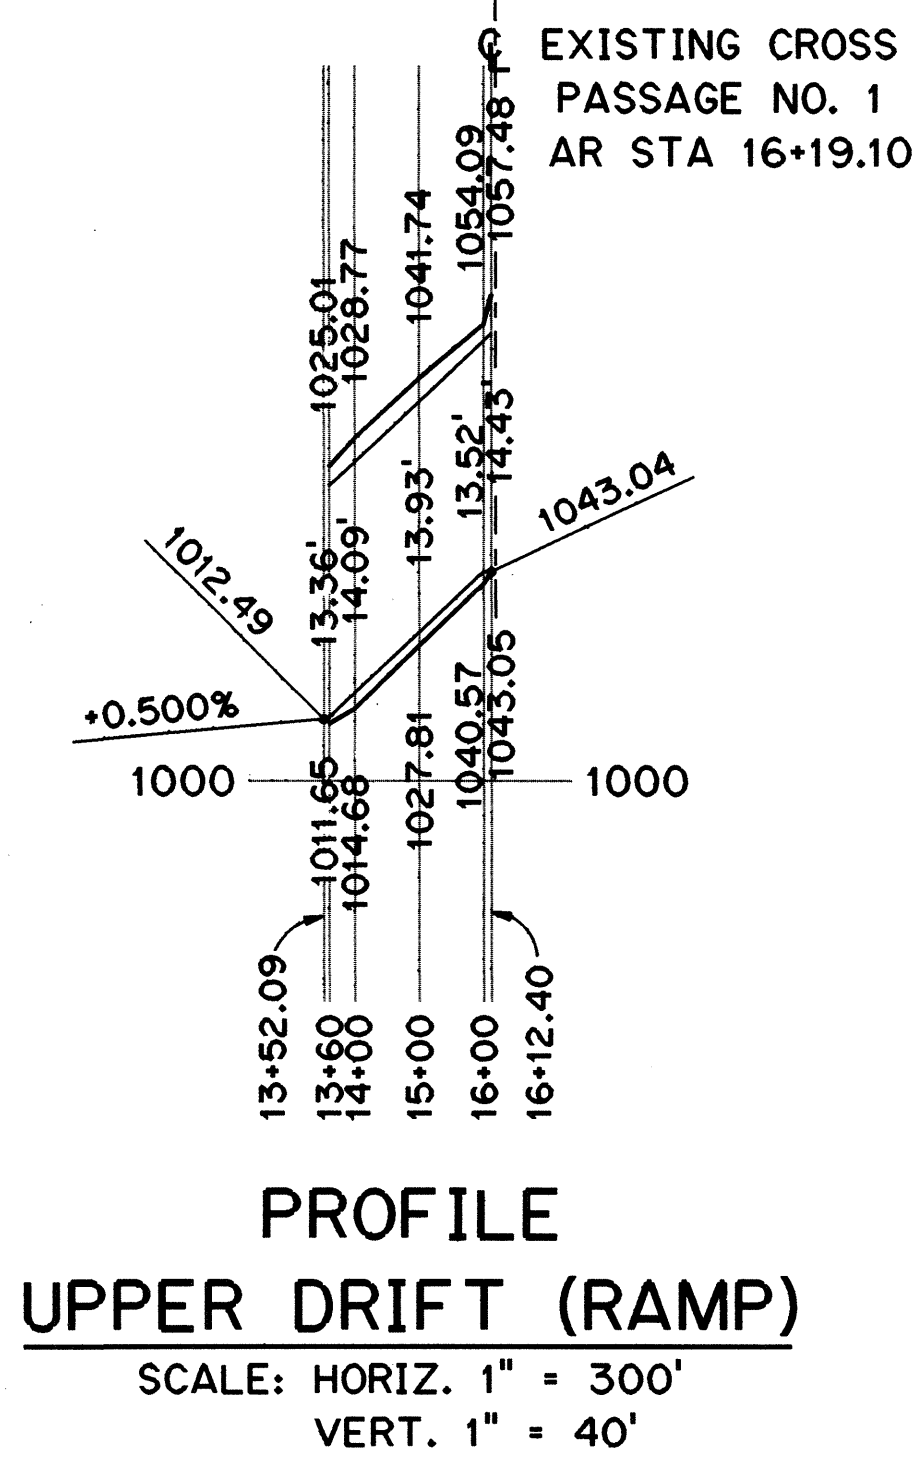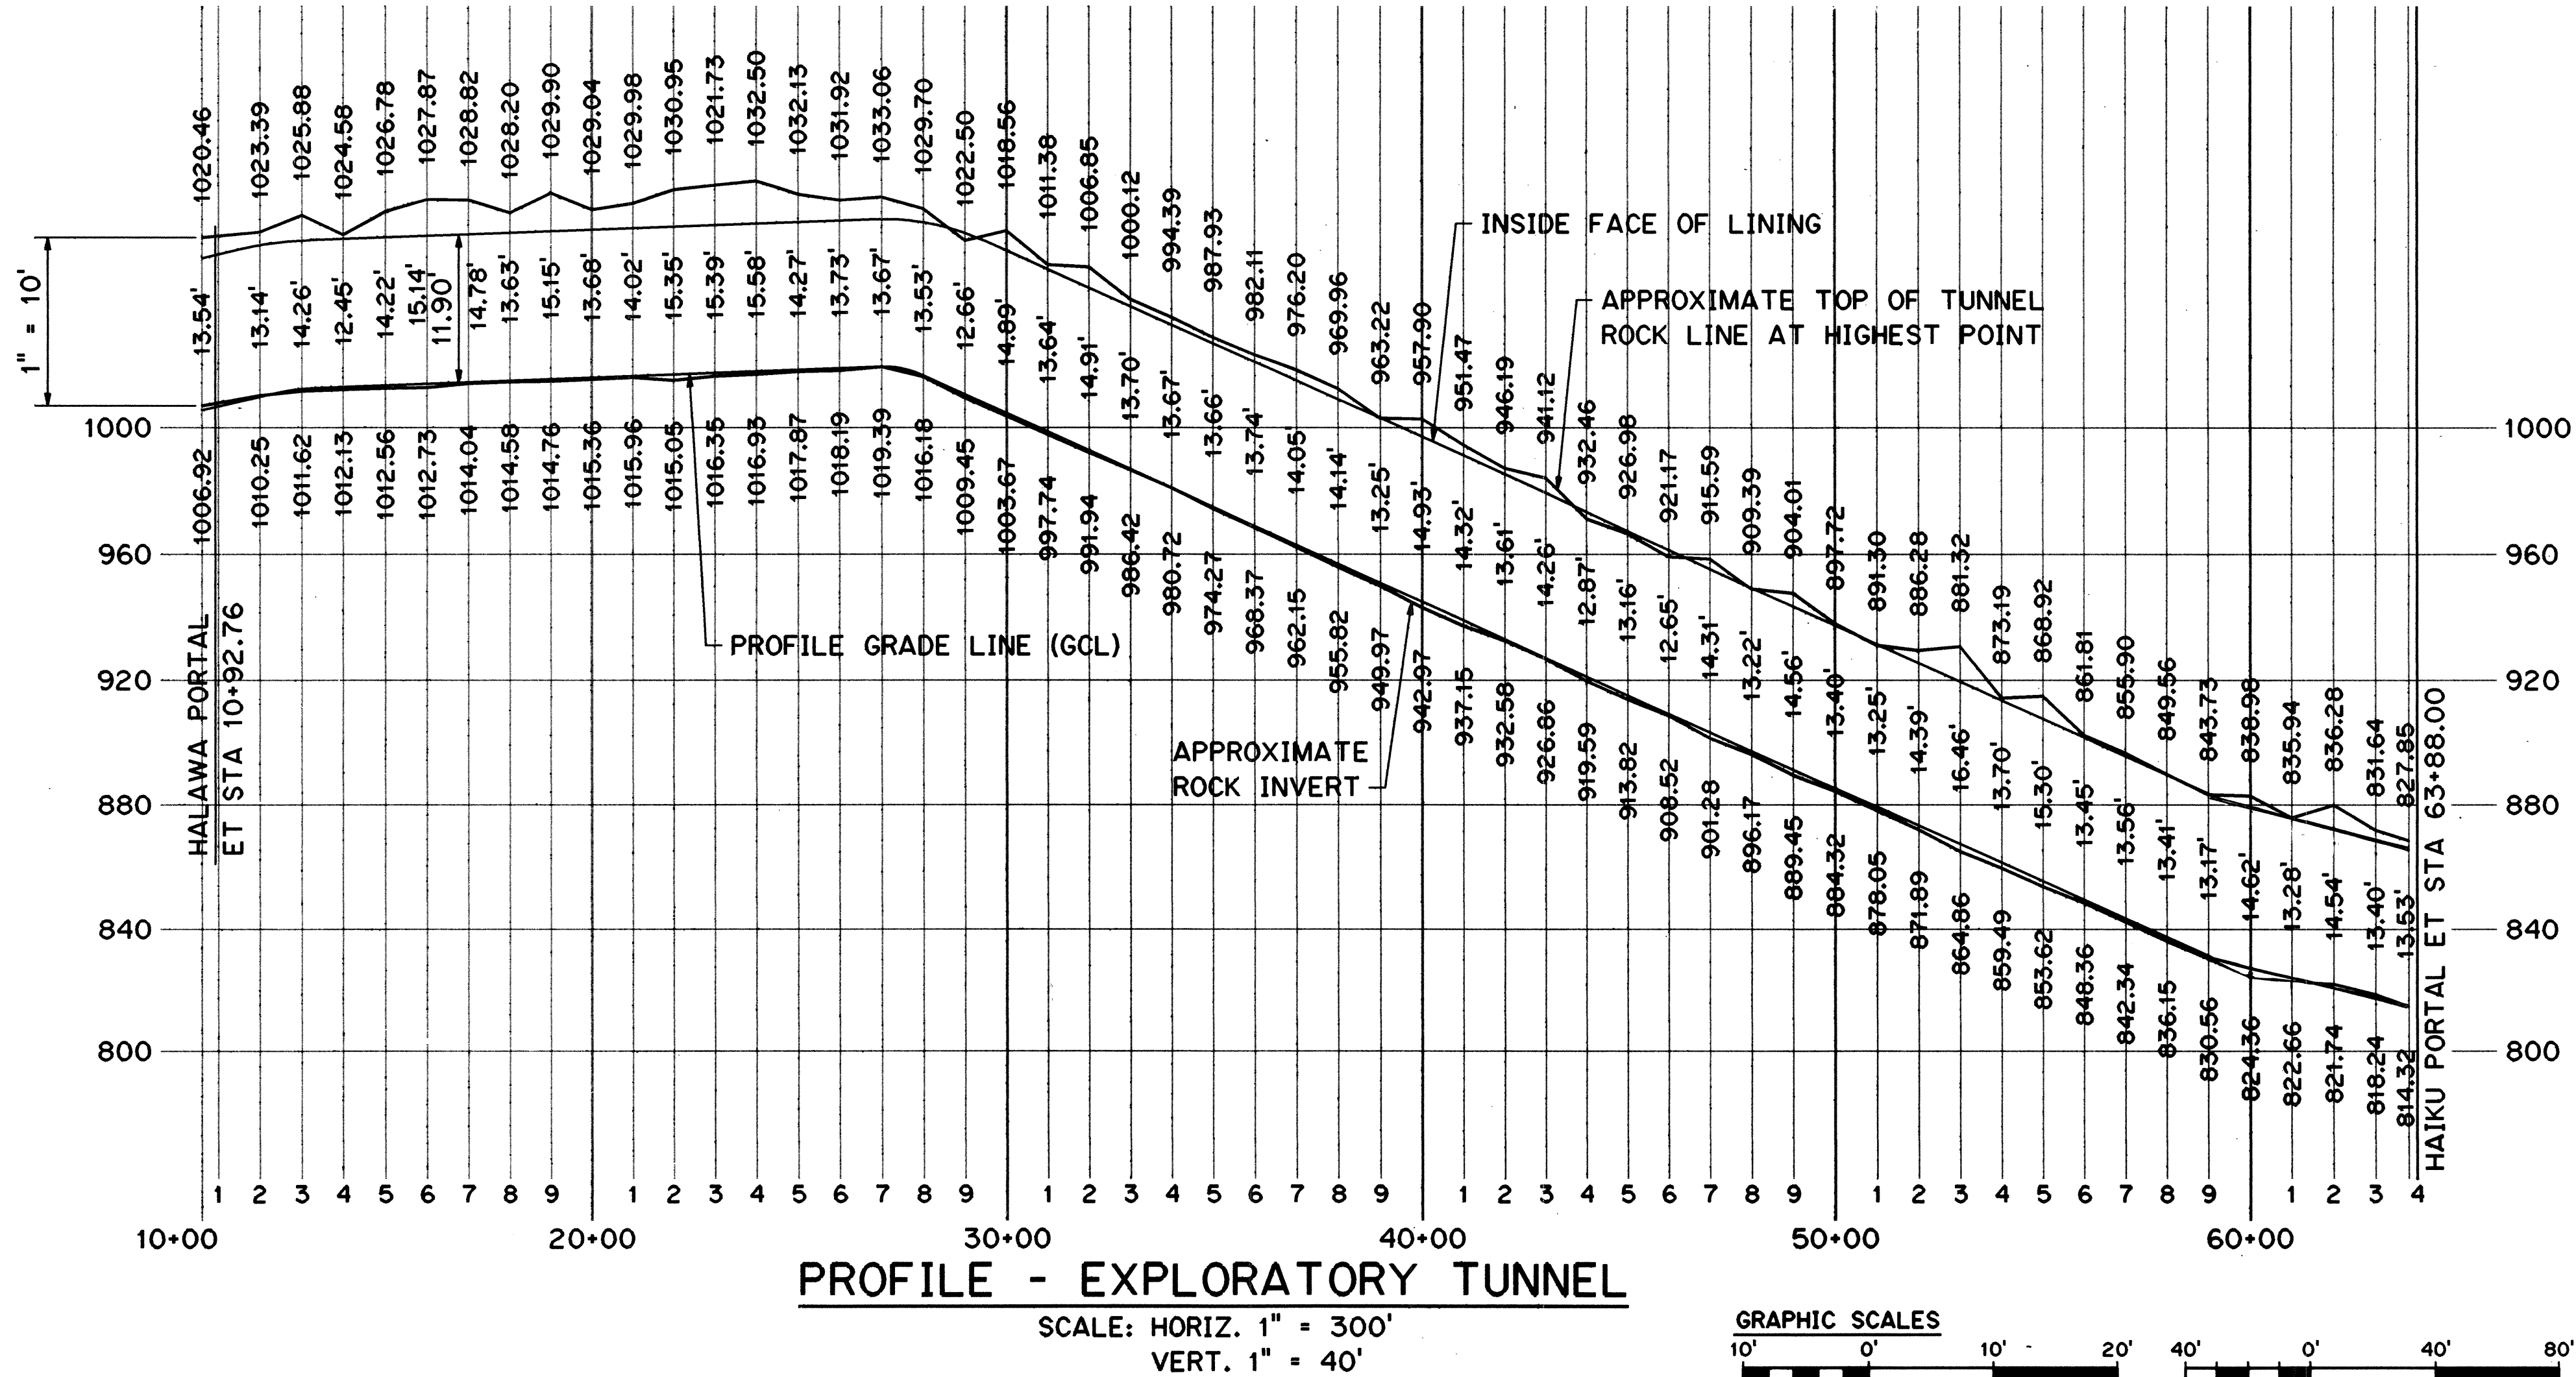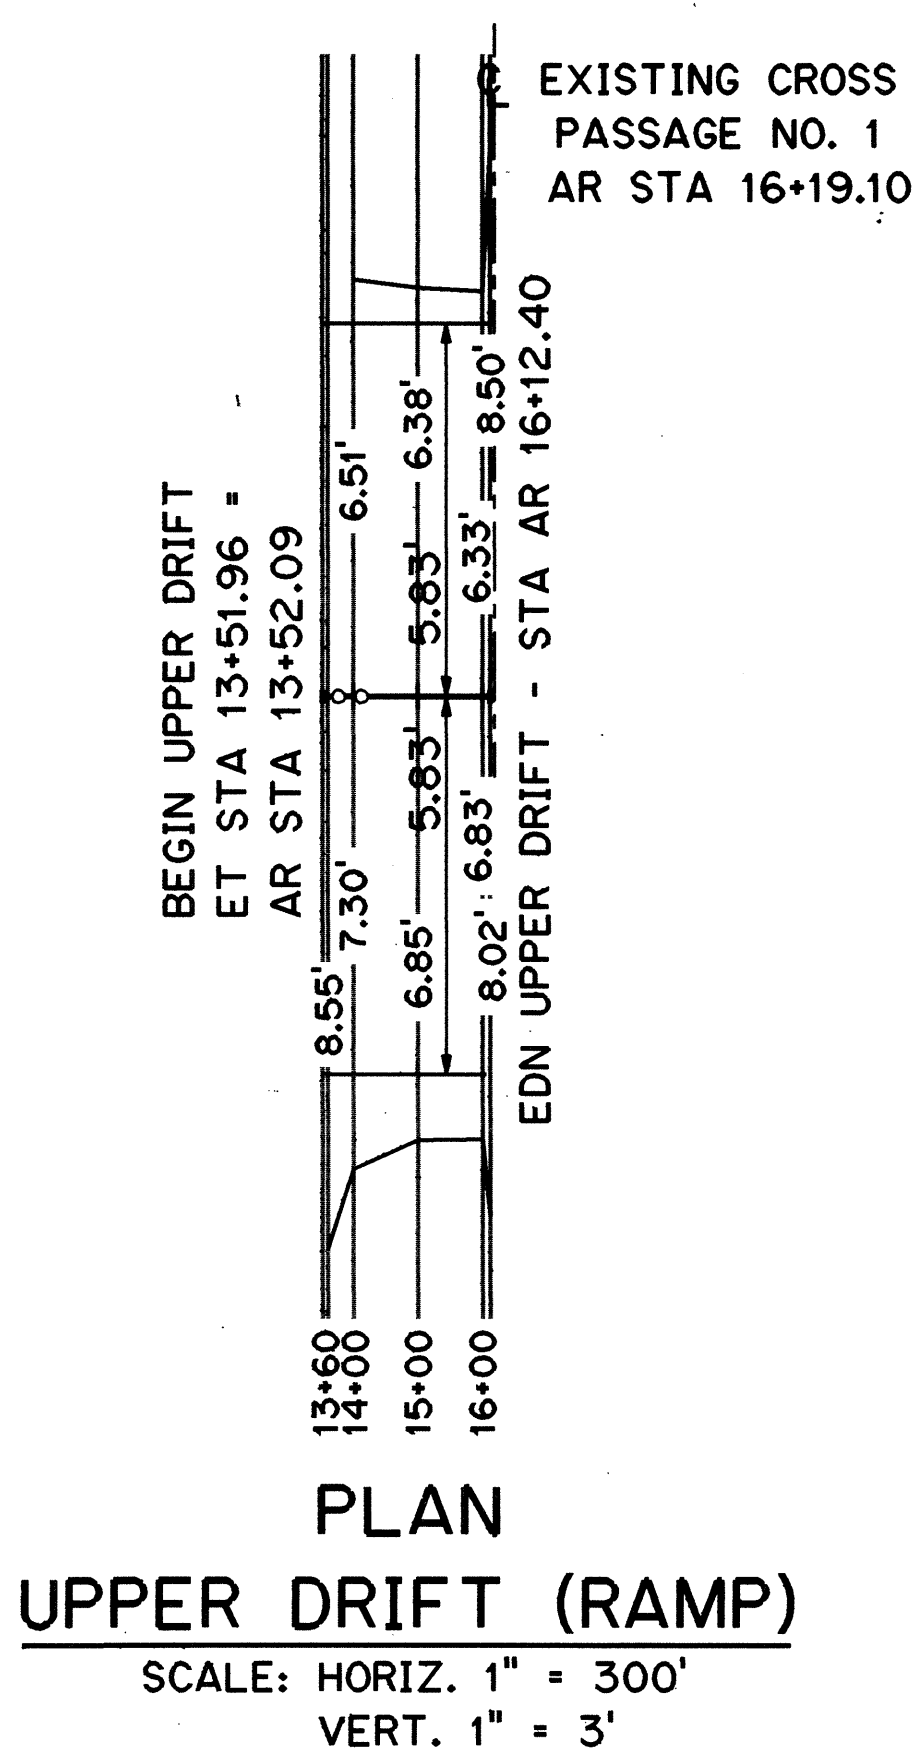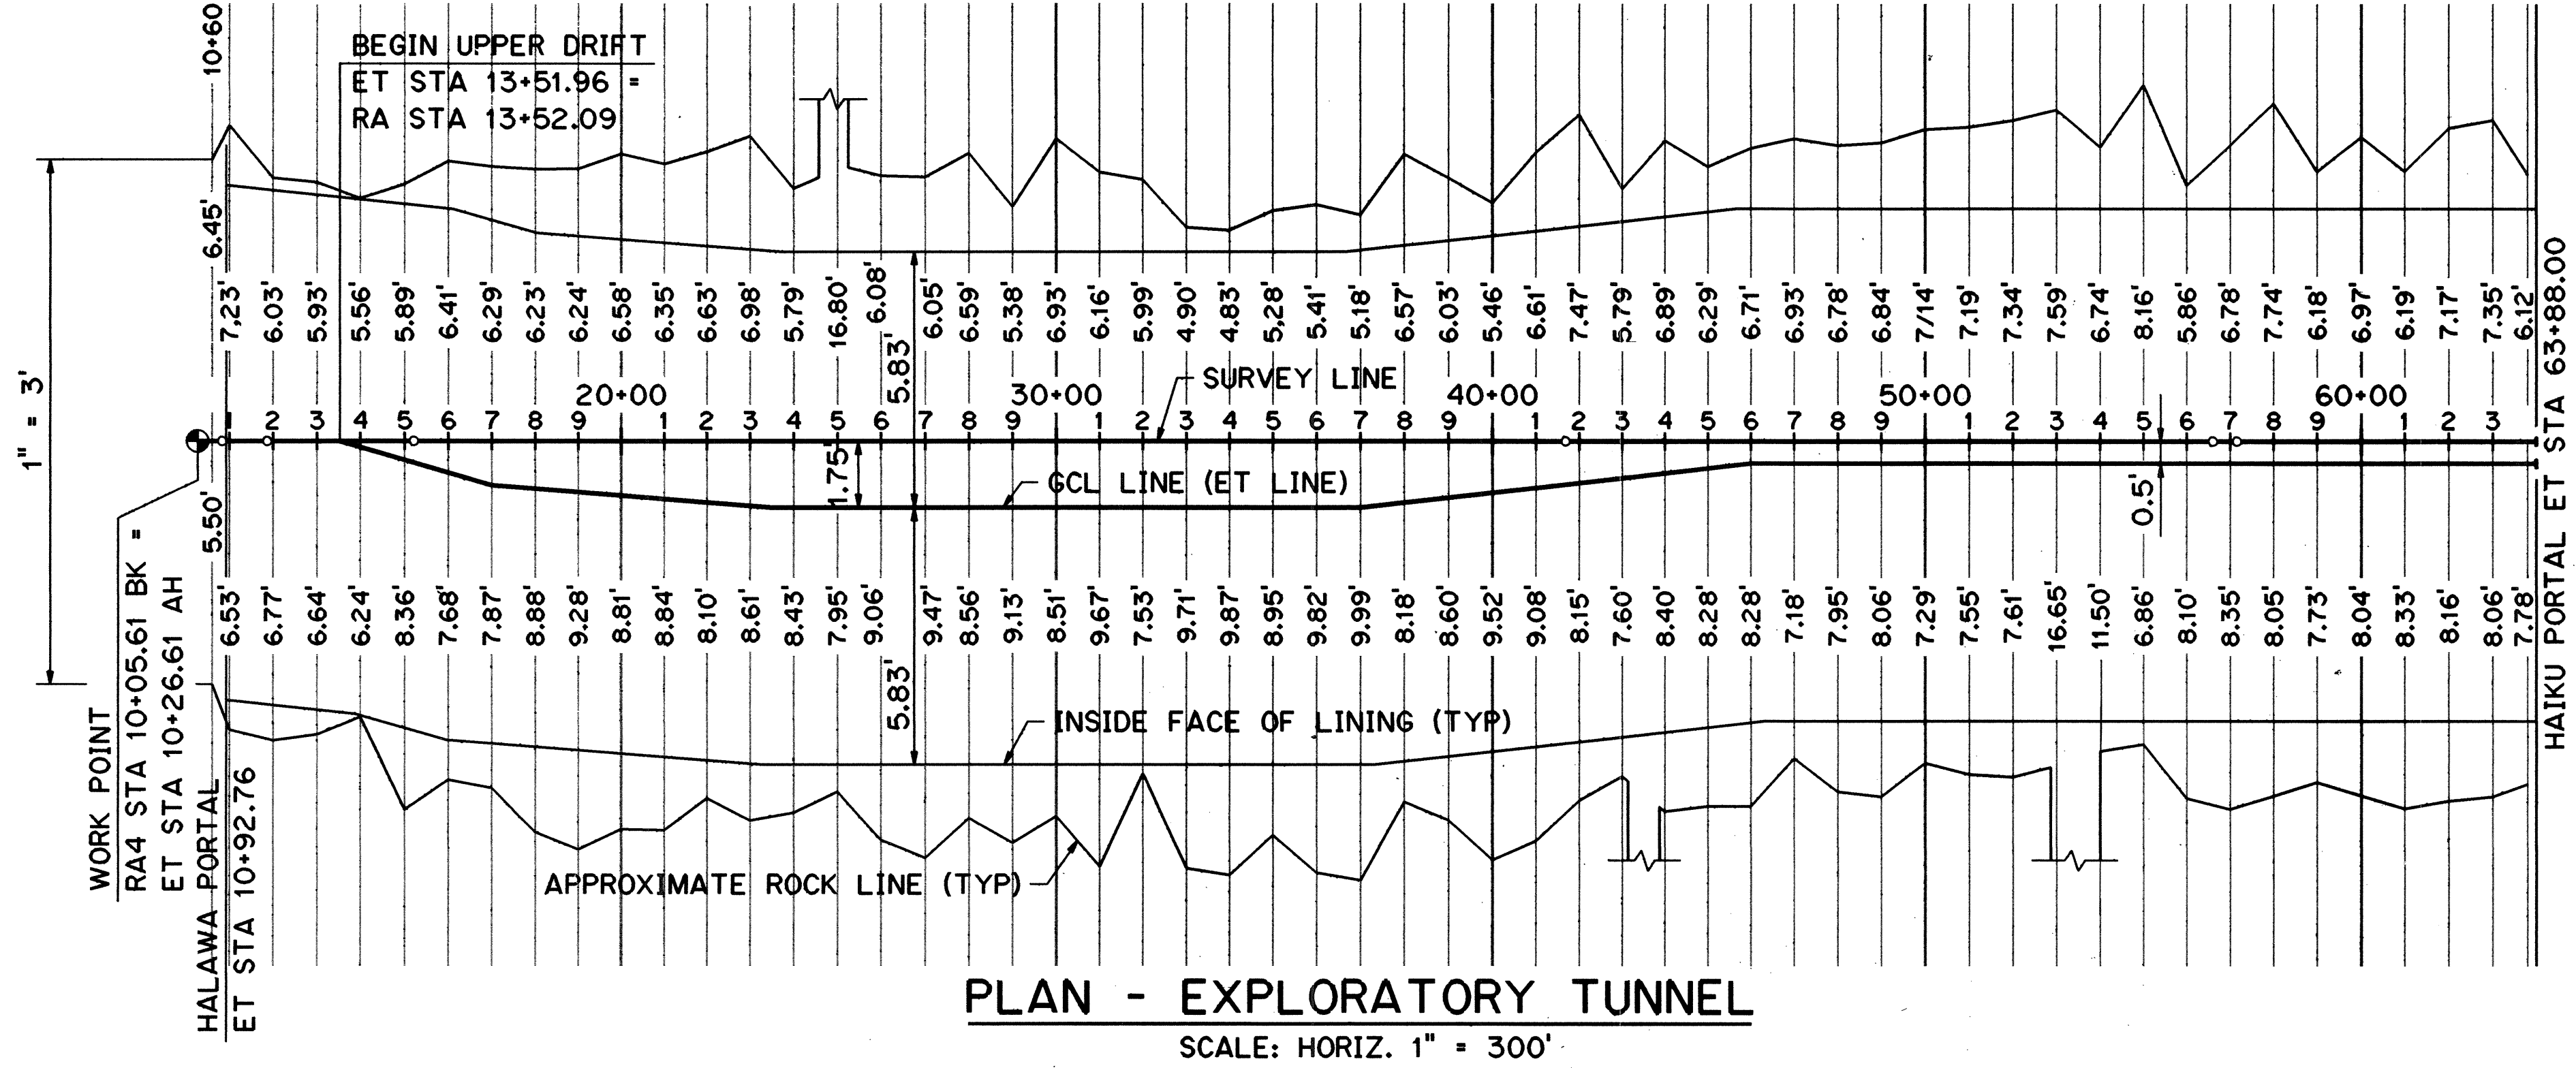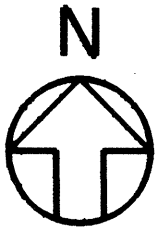

NOTES:

1. SEE NOTE 1 ON SHEET NO. 2C1.
2. FOR HORIZONTAL AND VERTICAL ALIGNMENT DATA SEE SHEET NO. 2C4.
3. FOR TYPICAL TUNNEL SECTION SEE SHEET NO. 2C3.
4. FOR SURVEY DATA SEE SPECIAL PROVISIONS SECTION 801.


SURVEY PLOTTED BY	DATE
DESIGNED BY	
NOTED BY	
CHECKED BY	

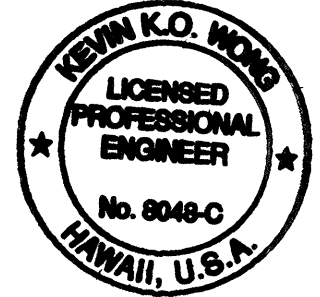


THIS WORK WAS PREPARED BY ME OR UNDER MY SUPERVISION

DATE	REVISION
STATE OF HAWAII DEPARTMENT OF TRANSPORTATION HIGHWAYS DIVISION	
AS-BUILT SURVEY DATA	
EXPLORATORY TUNNEL IMPROVEMENTS	
H-3 FINISH (UNIT III)	
FAIP NO. 1-H3-1(75), UNIT III	
T.K. TUNNEL / ACCESS ROADS	
SCALE: AS NOTED	DATE: JUN 1995
SHEET NO. 2C14 OF 15 SHEETS	


FED. ROAD DIST. NO.	STATE	FED. AID PROJ. NO.	FISCAL YEAR	SHEET NO.	TOTAL SHEETS
HAWAII	HAW.	I-H3-1(75) UNIT III	1994	32	353

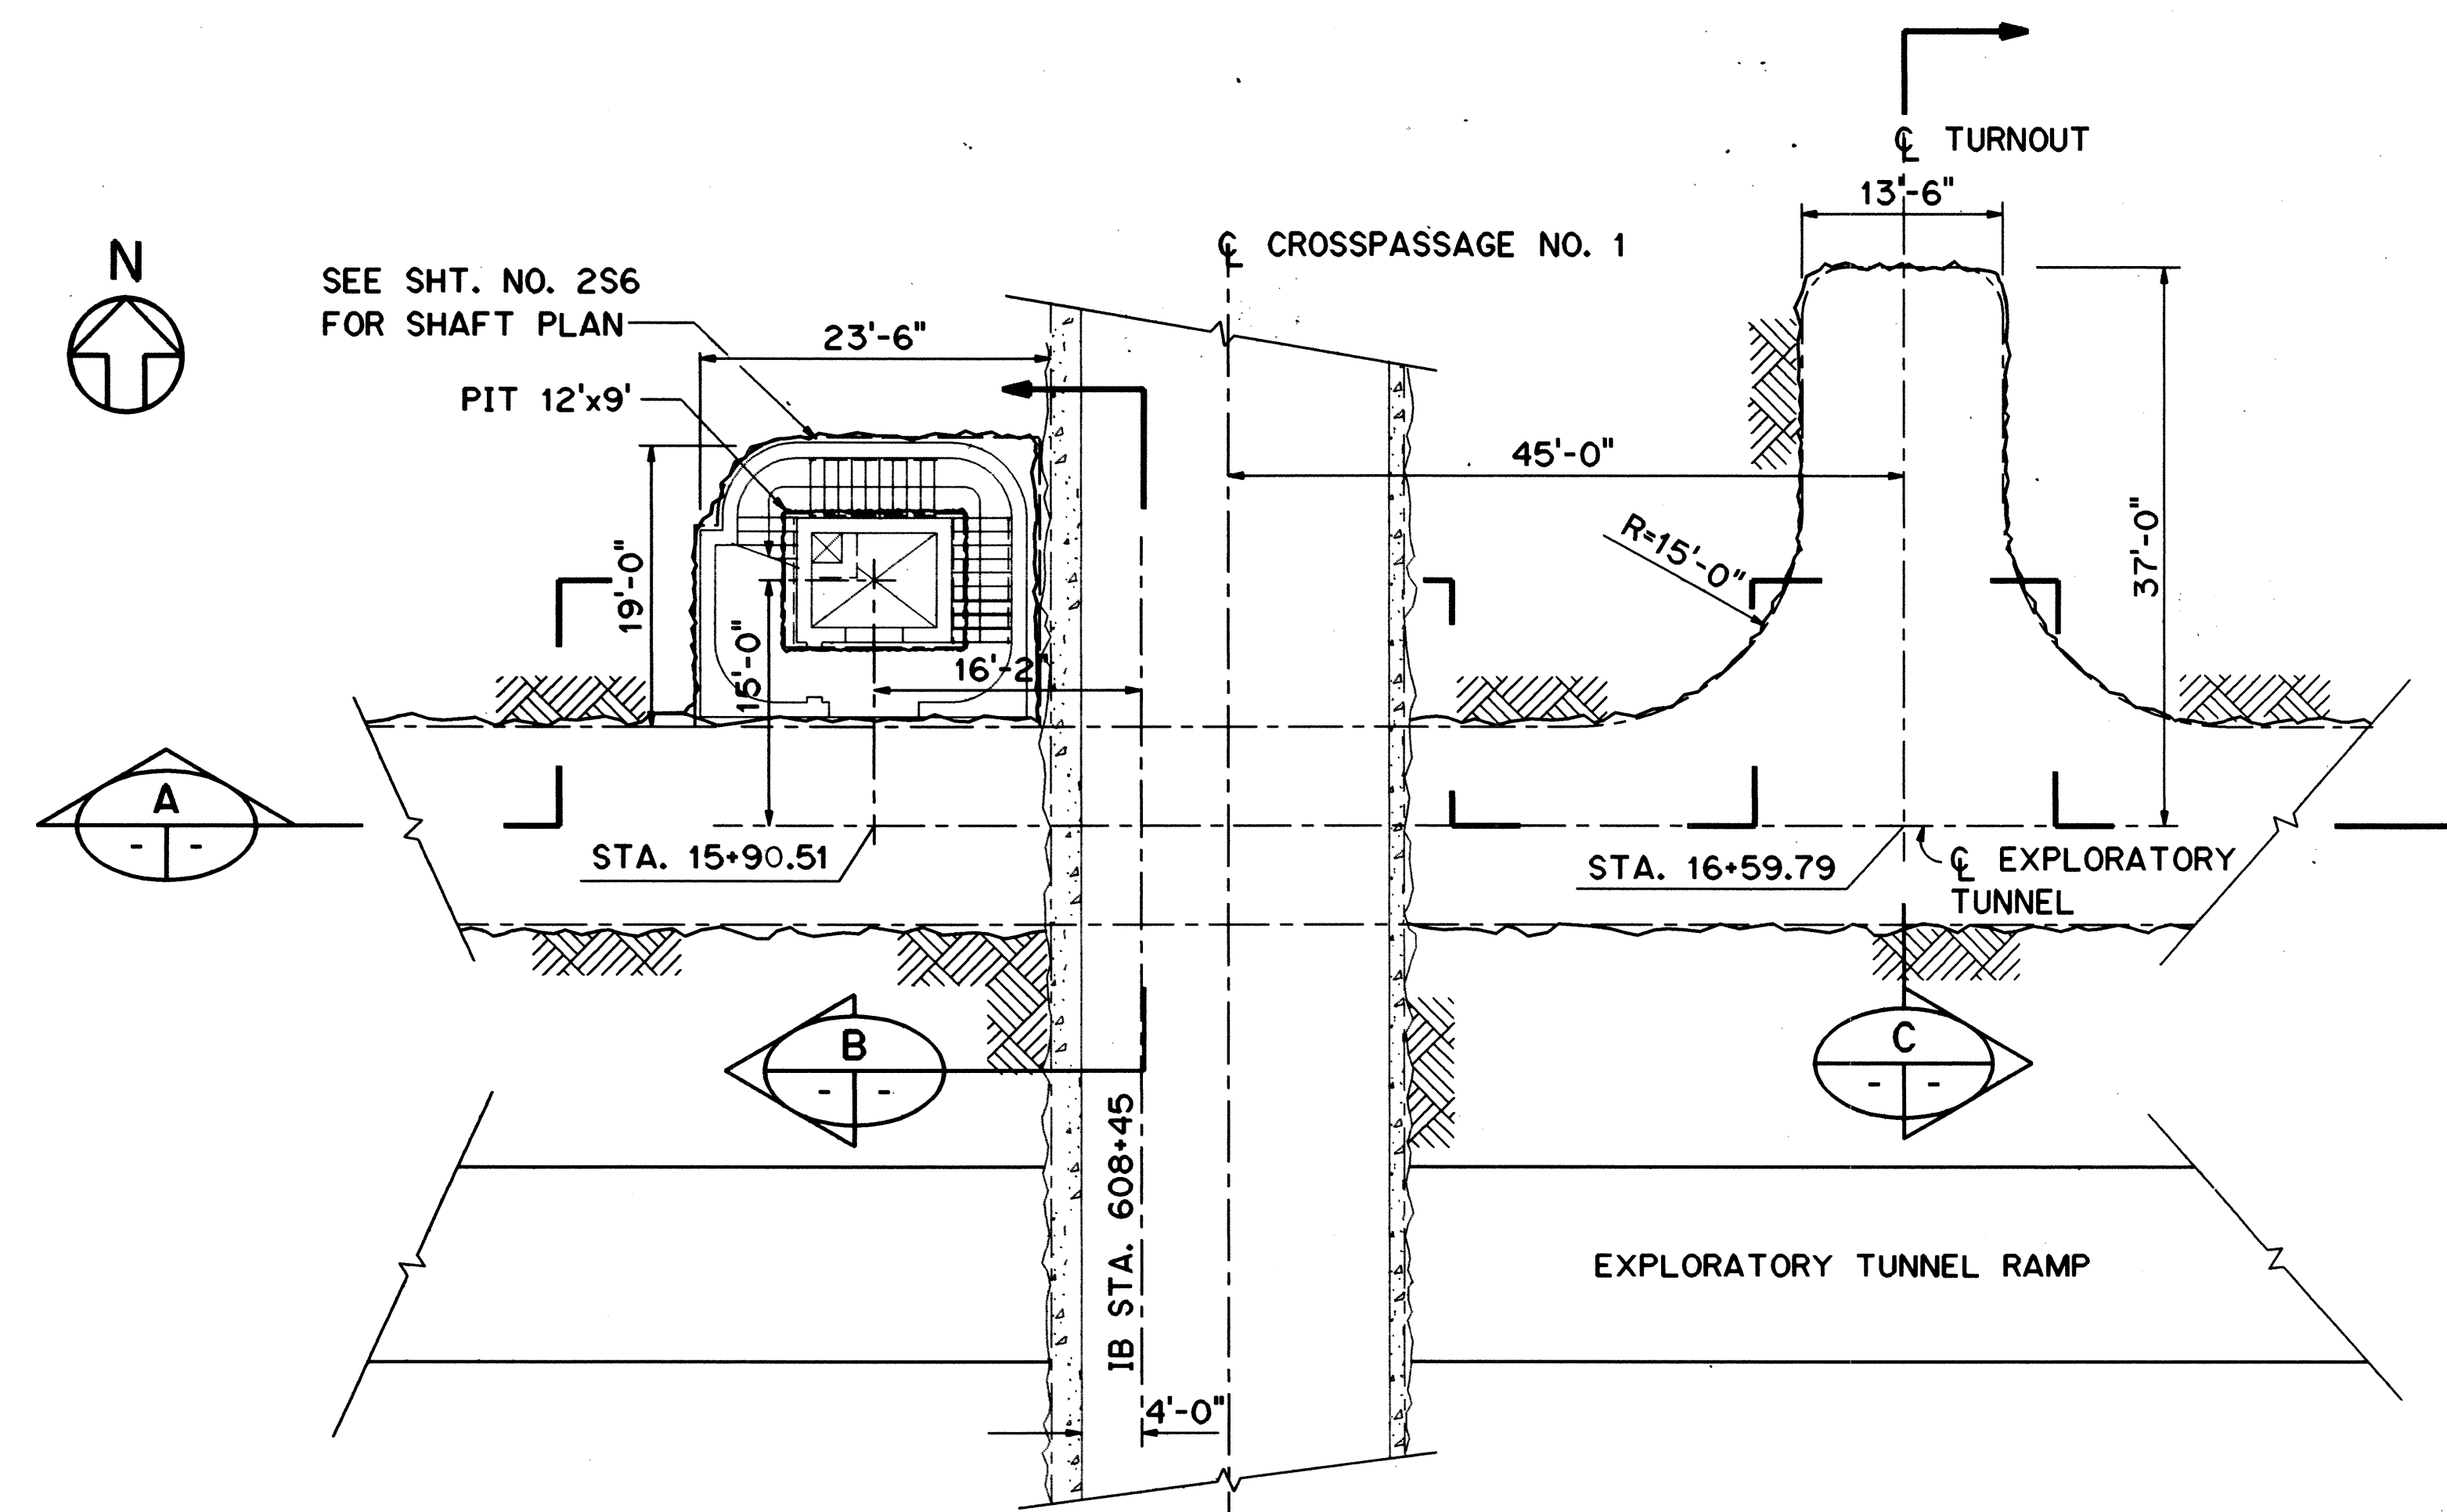


GENERAL ARRANGEMENT PLAN

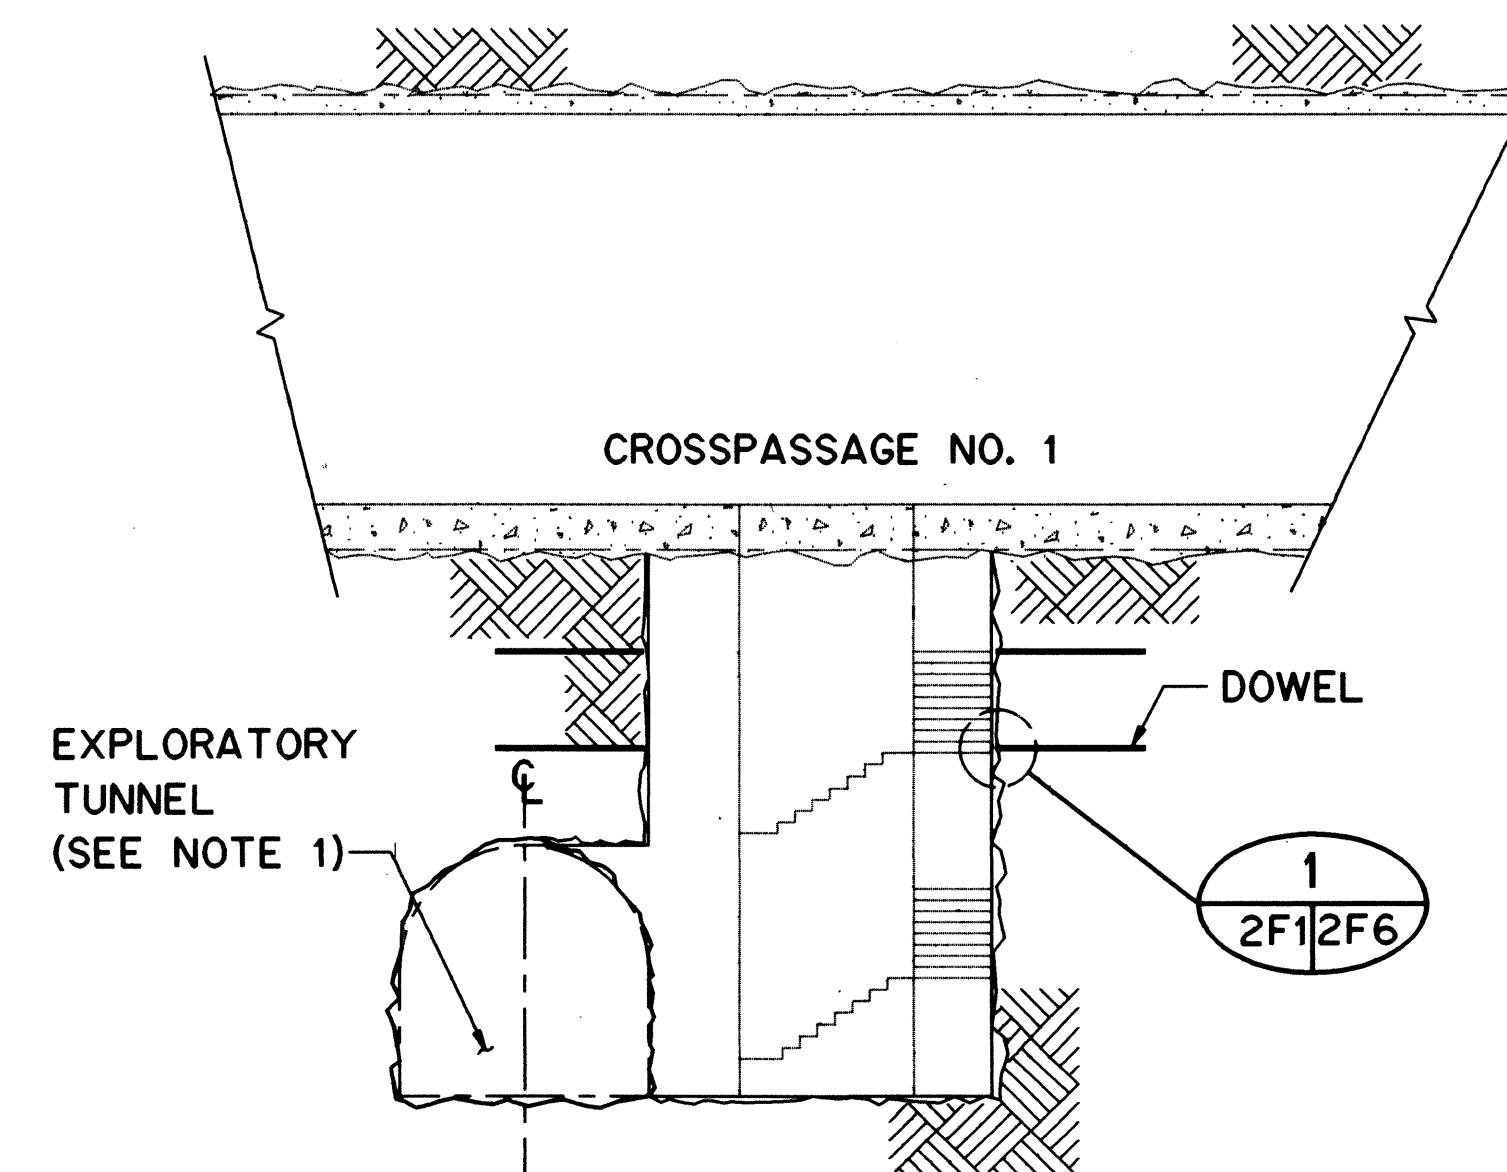


SECTION 

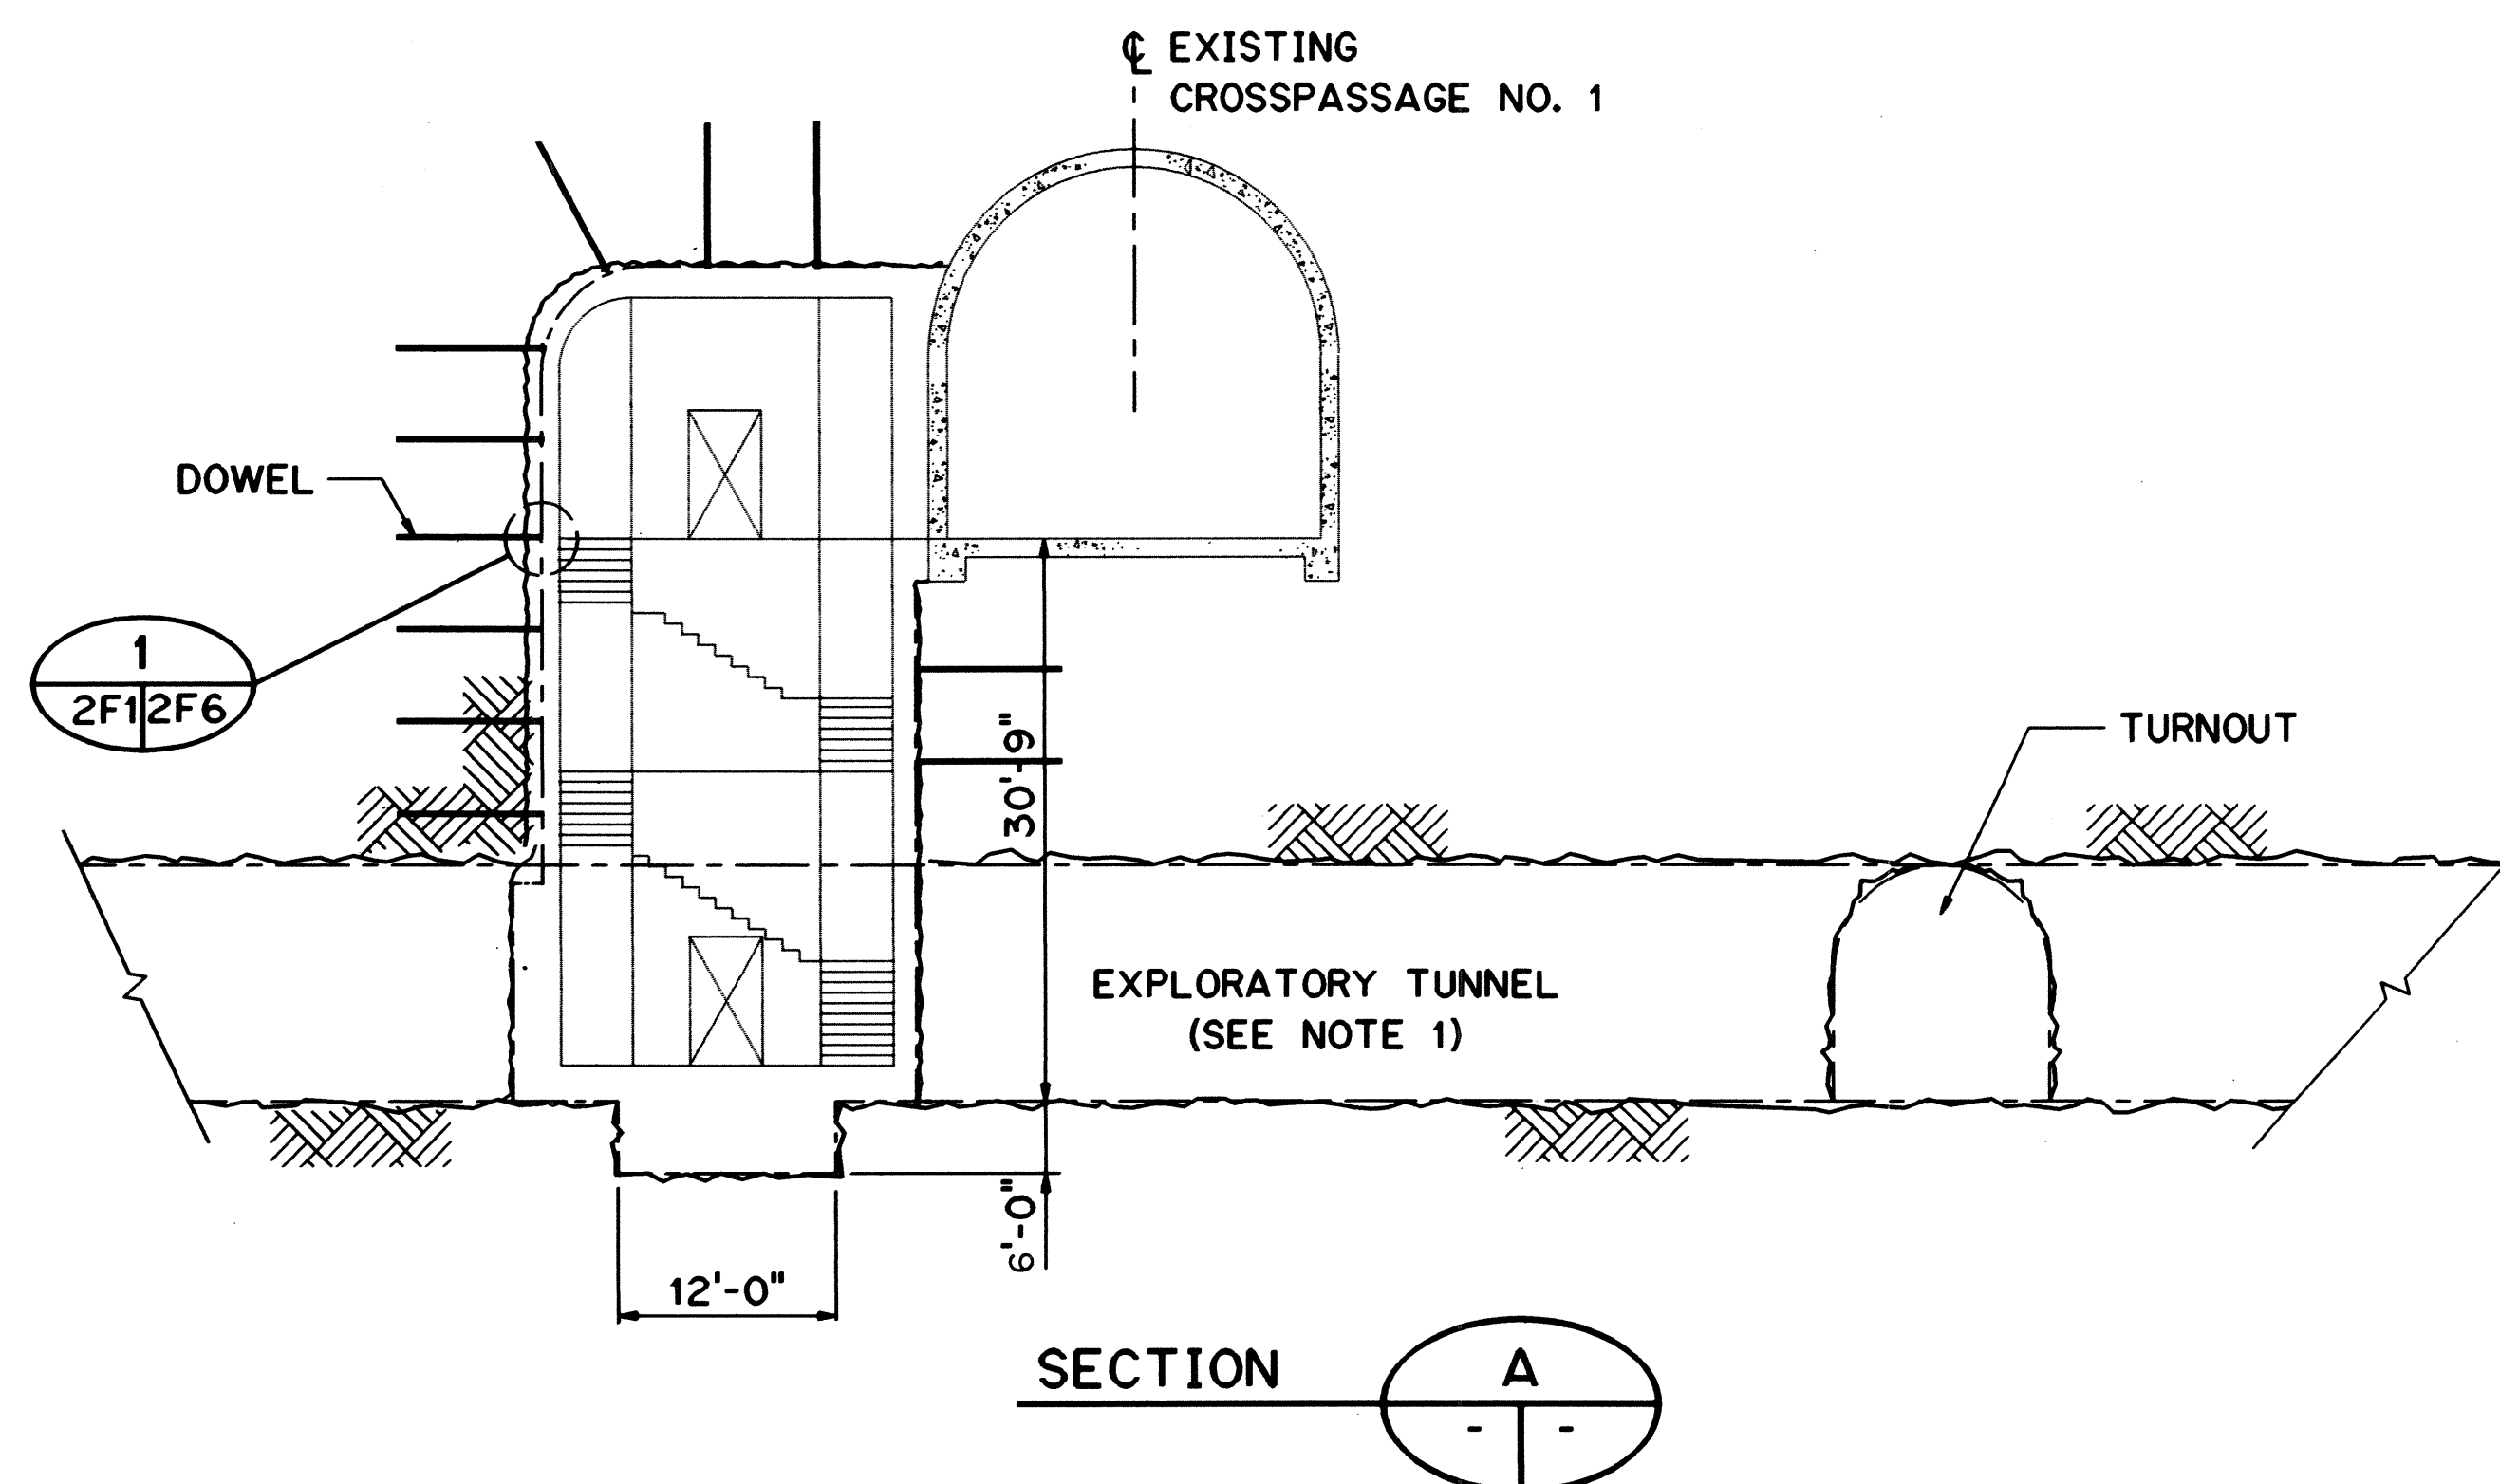

SECTION 

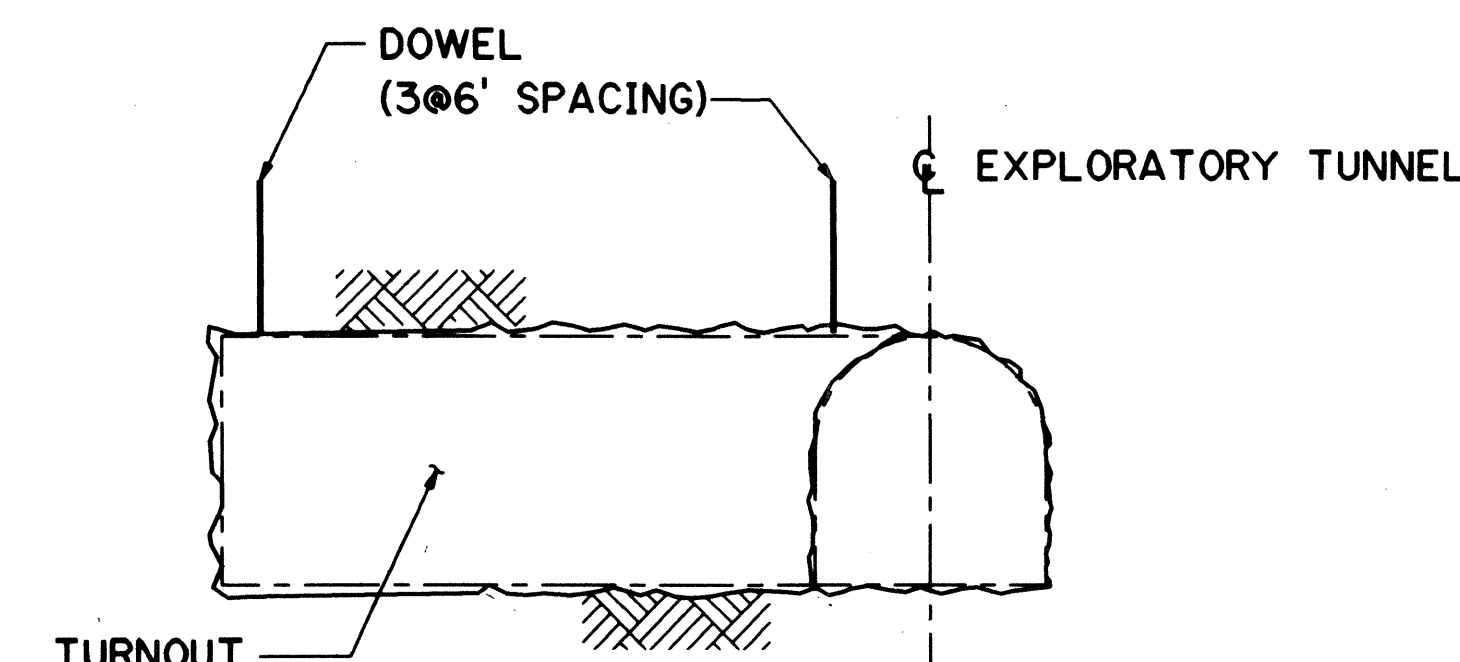

SECTION 

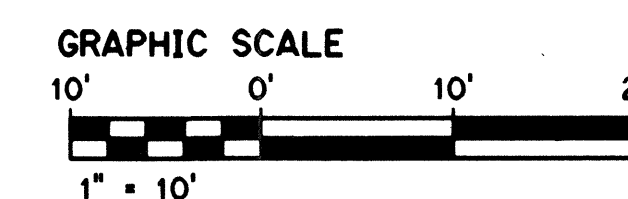

THIS WORK WAS PREPARED BY M
OR UNDER MY SUPERVISION

Clayton S. Jernigan

DATE	REVISION

STATE OF HAWAII
DEPARTMENT OF TRANSPORTATION
HIGHWAYS DIVISION

CROSSPASSAGE NO. 1
CONNECTION/TURNOUT
EXPLORATORY TUNNEL IMPROVEMENTS
H-3 FINISH (UNIT III)
FAIP NO. 1-H3-1(75), UNIT III
T.K. TUNNEL/ACCESS ROADS

SCALE: 1" = 10' DATE: JUN 1995

SHEET NO. 251 OF 13 SHEETS

REFERENCE DOCUMENTS :

EXISTING EXPLORATORY TUNNEL

- FAIP NO. I-H3-1(37)
- FAIP NO. I-H3-1(64)
- TRANS-KOOLAU EXPLORATORY TUNNEL
HAIKU APPROACH AND TUNNELS GEOLOGY
- TRANS-KOOLAU EXPLORATORY TUNNEL
HALAWA APPROACH AND TUNNELS GEOLOGY

EXISTING CROSSPASSAGE:

- FAIP NO. I-H3-1(61)
- FAIP NO. I-H3-1(64)
- GEOLOGY AND CONSTRUCTION HISTORY SUMMARY; HALAWA AND HAIKU APPROACH AND TUNNELS

NOTES:






1. EXISTING GROUND SUPPORT IN THIS AREA
CONSISTS OF THE FOLLOWING:
- TYPE B SUPPORT INSTALLED DURING
EXCAVATION OF EXPLORATORY TUNNEL;
CONSISTS OF 2 IN. CROWN SHOTCRETE AND
AND THREE 6 FT. LONG CROWN DOWELS
@ 6 FT. SPACING INSTALLED @ 40 FT.
INTERVALS.
 - ADDITIONAL SUPPORT INSTALLED AFTER
EXPLORATORY TUNNEL EXCAVATION, PRIOR
TO CONSTRUCTION OF CROSSPASSAGE NO. 1.
THIS CONSISTS OF 6 FT. LONG DOWELS IN
A 40 FT. ZONE CENTERED @ STA 16+08.

**FOR DETAIL AS-BUILT INFORMATION
REFER TO CONSTRUCTION SUBMITTALS**

FED. ROAD DIST. NO.	STATE	FED. AID PROJ. NO.	FISCAL YEAR	SHEET NO.	TOTAL SHEETS
HAWAII	HAW.	I-H3-1(75) UNIT III	1994	33	353

NOTES:

1. EXISTING GROUND SUPPORT IN THIS AREA WAS INSTALLED AFTER EXCAVATION OF THE EXPLORATORY TUNNEL, PRIOR TO CONSTRUCTION OF CROSSPASSAGE NO. 3. IT CONSISTS OF 6 FT. LONG DOWELS IN A 40 FT. ZONE CENTERED AT STA 25+92.
2. NO GROUND SUPPORT (TYPE A SUPPORT) WAS REQUIRED DURING EXCAVATION OF THE EXPLORATORY TUNNEL IN THIS AREA.

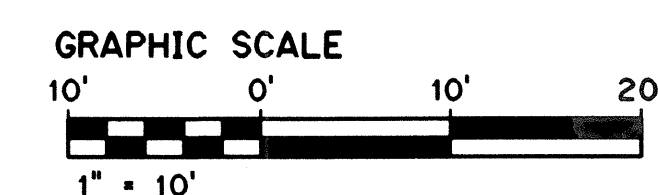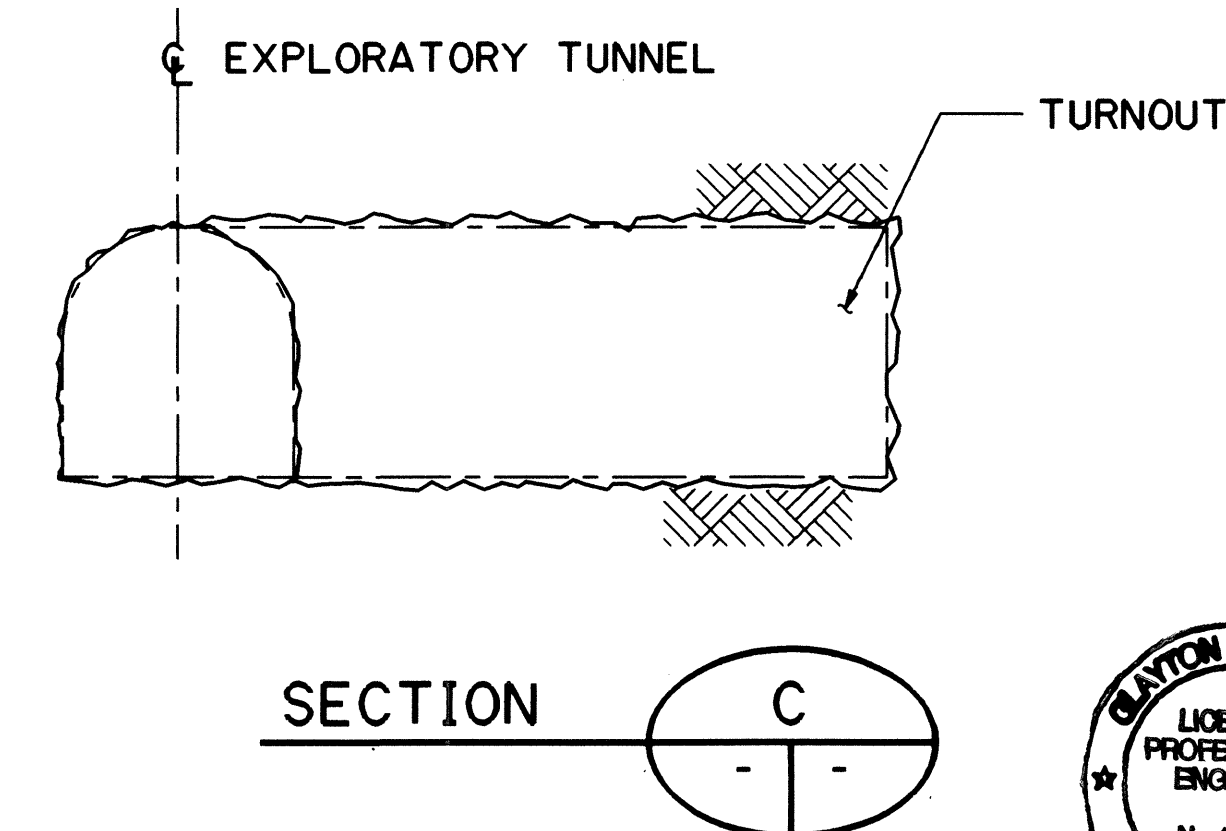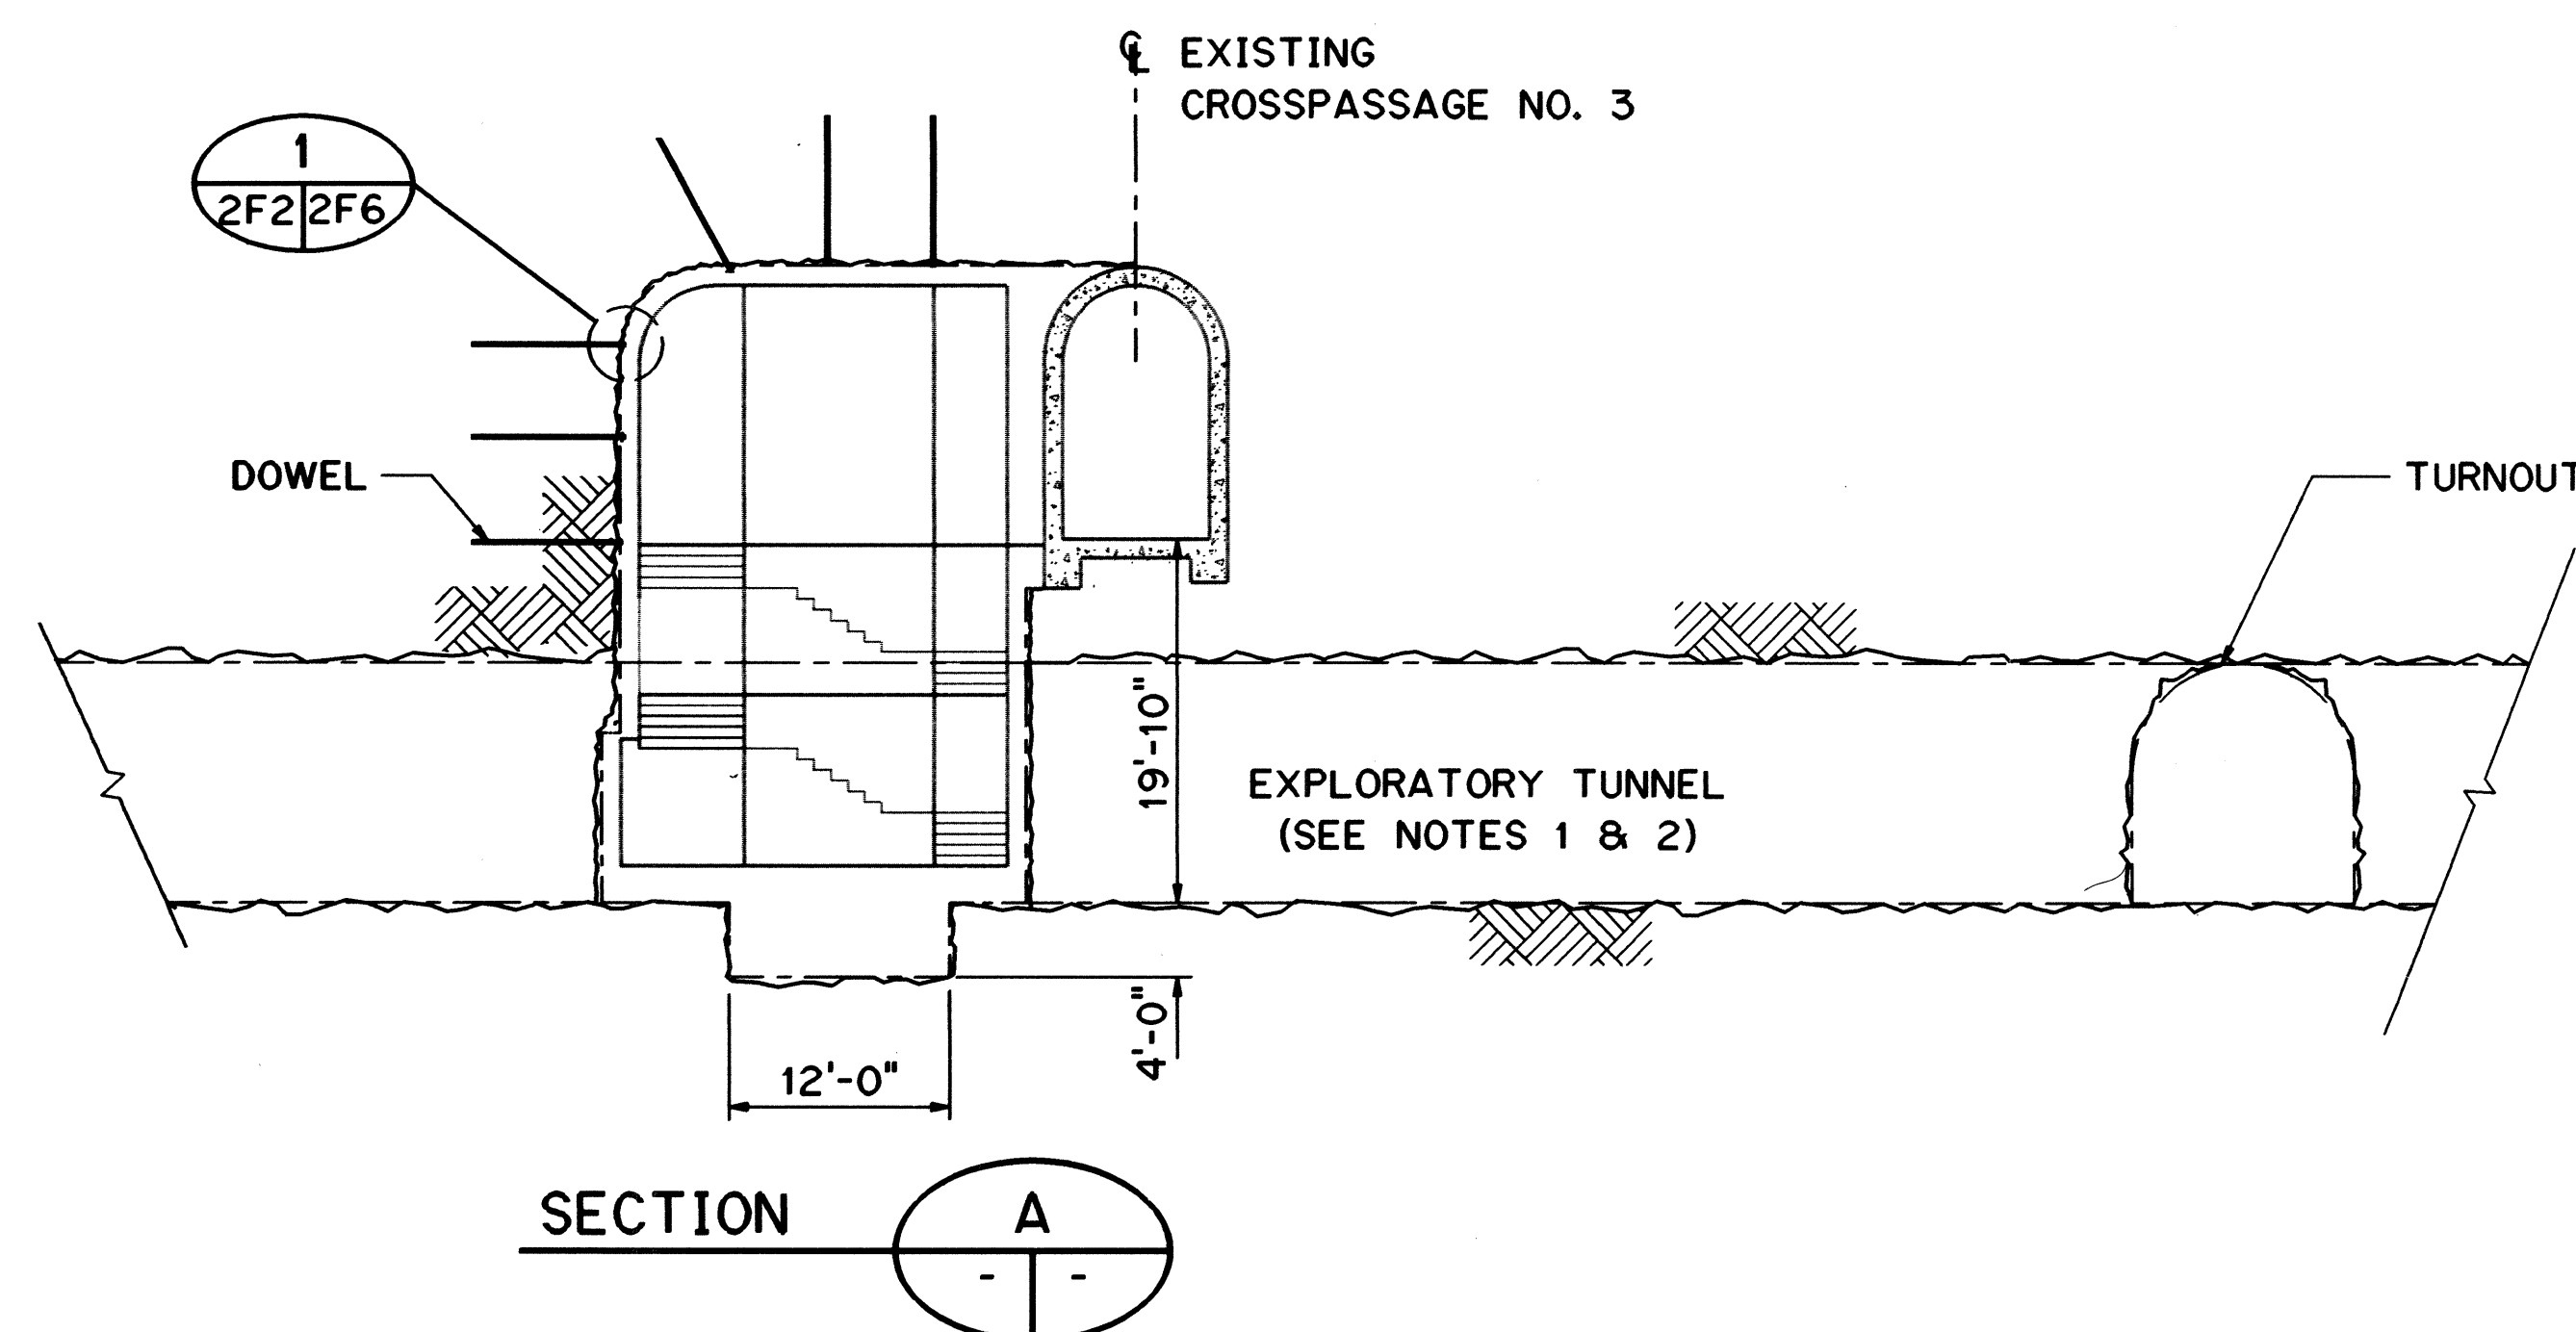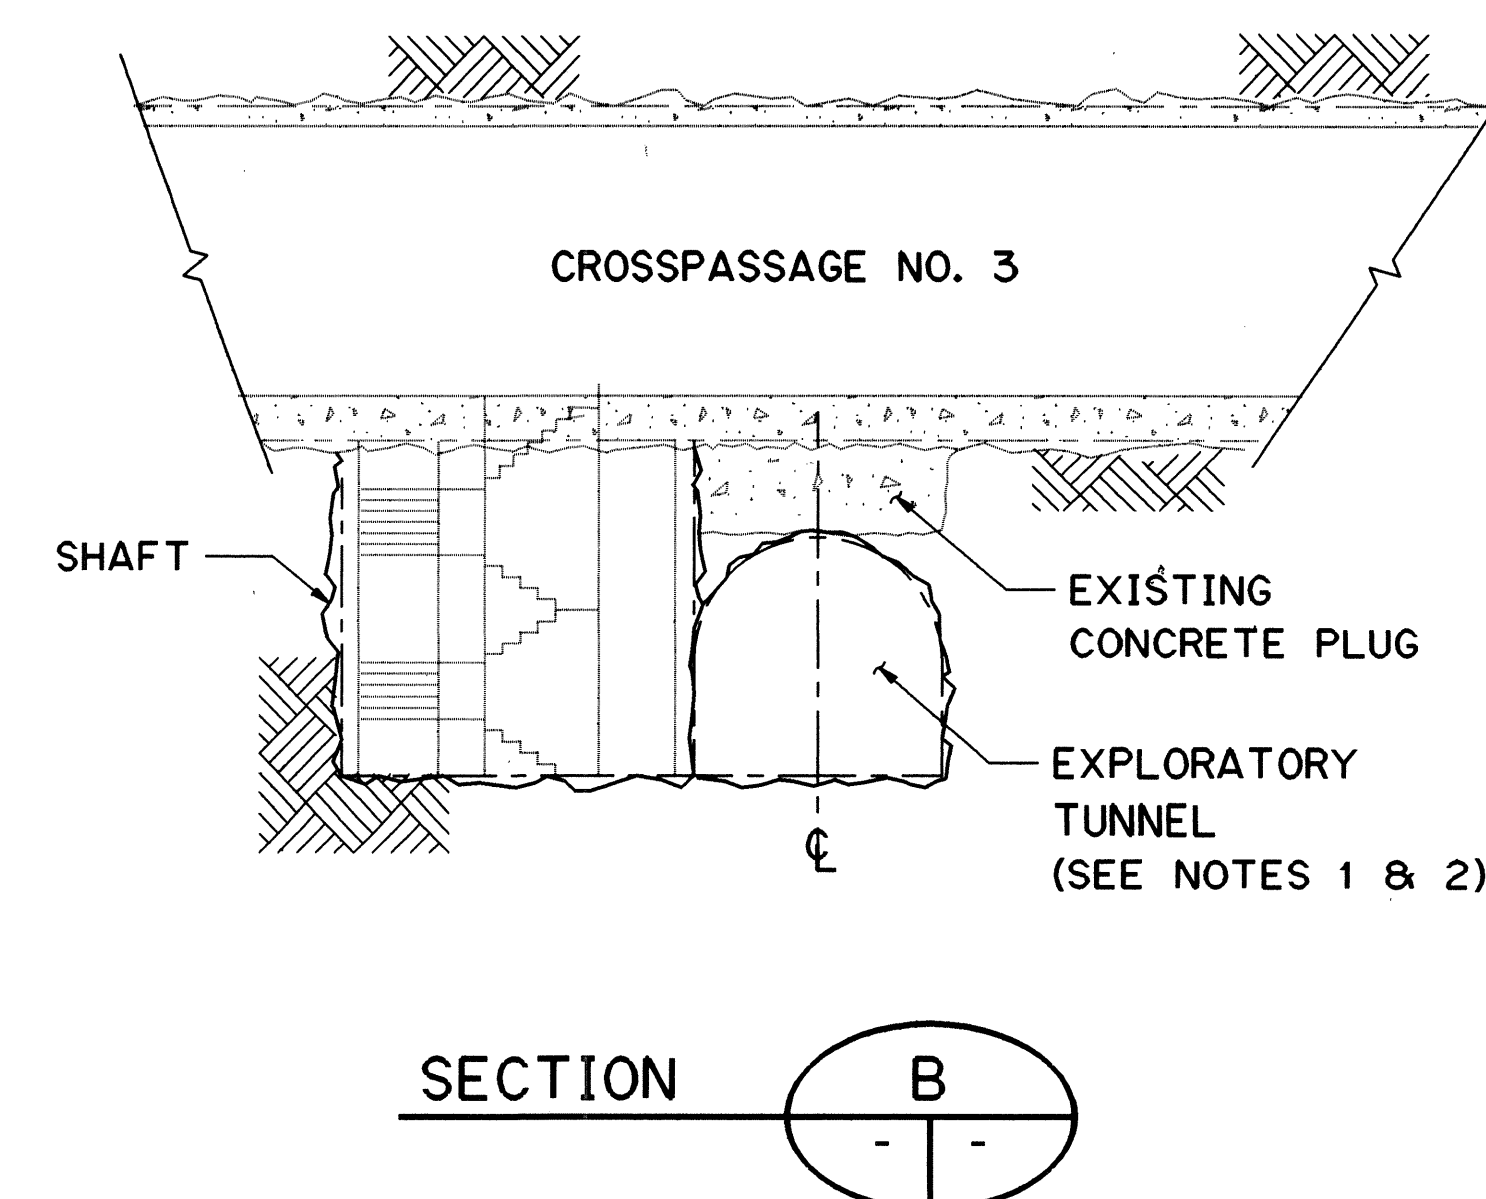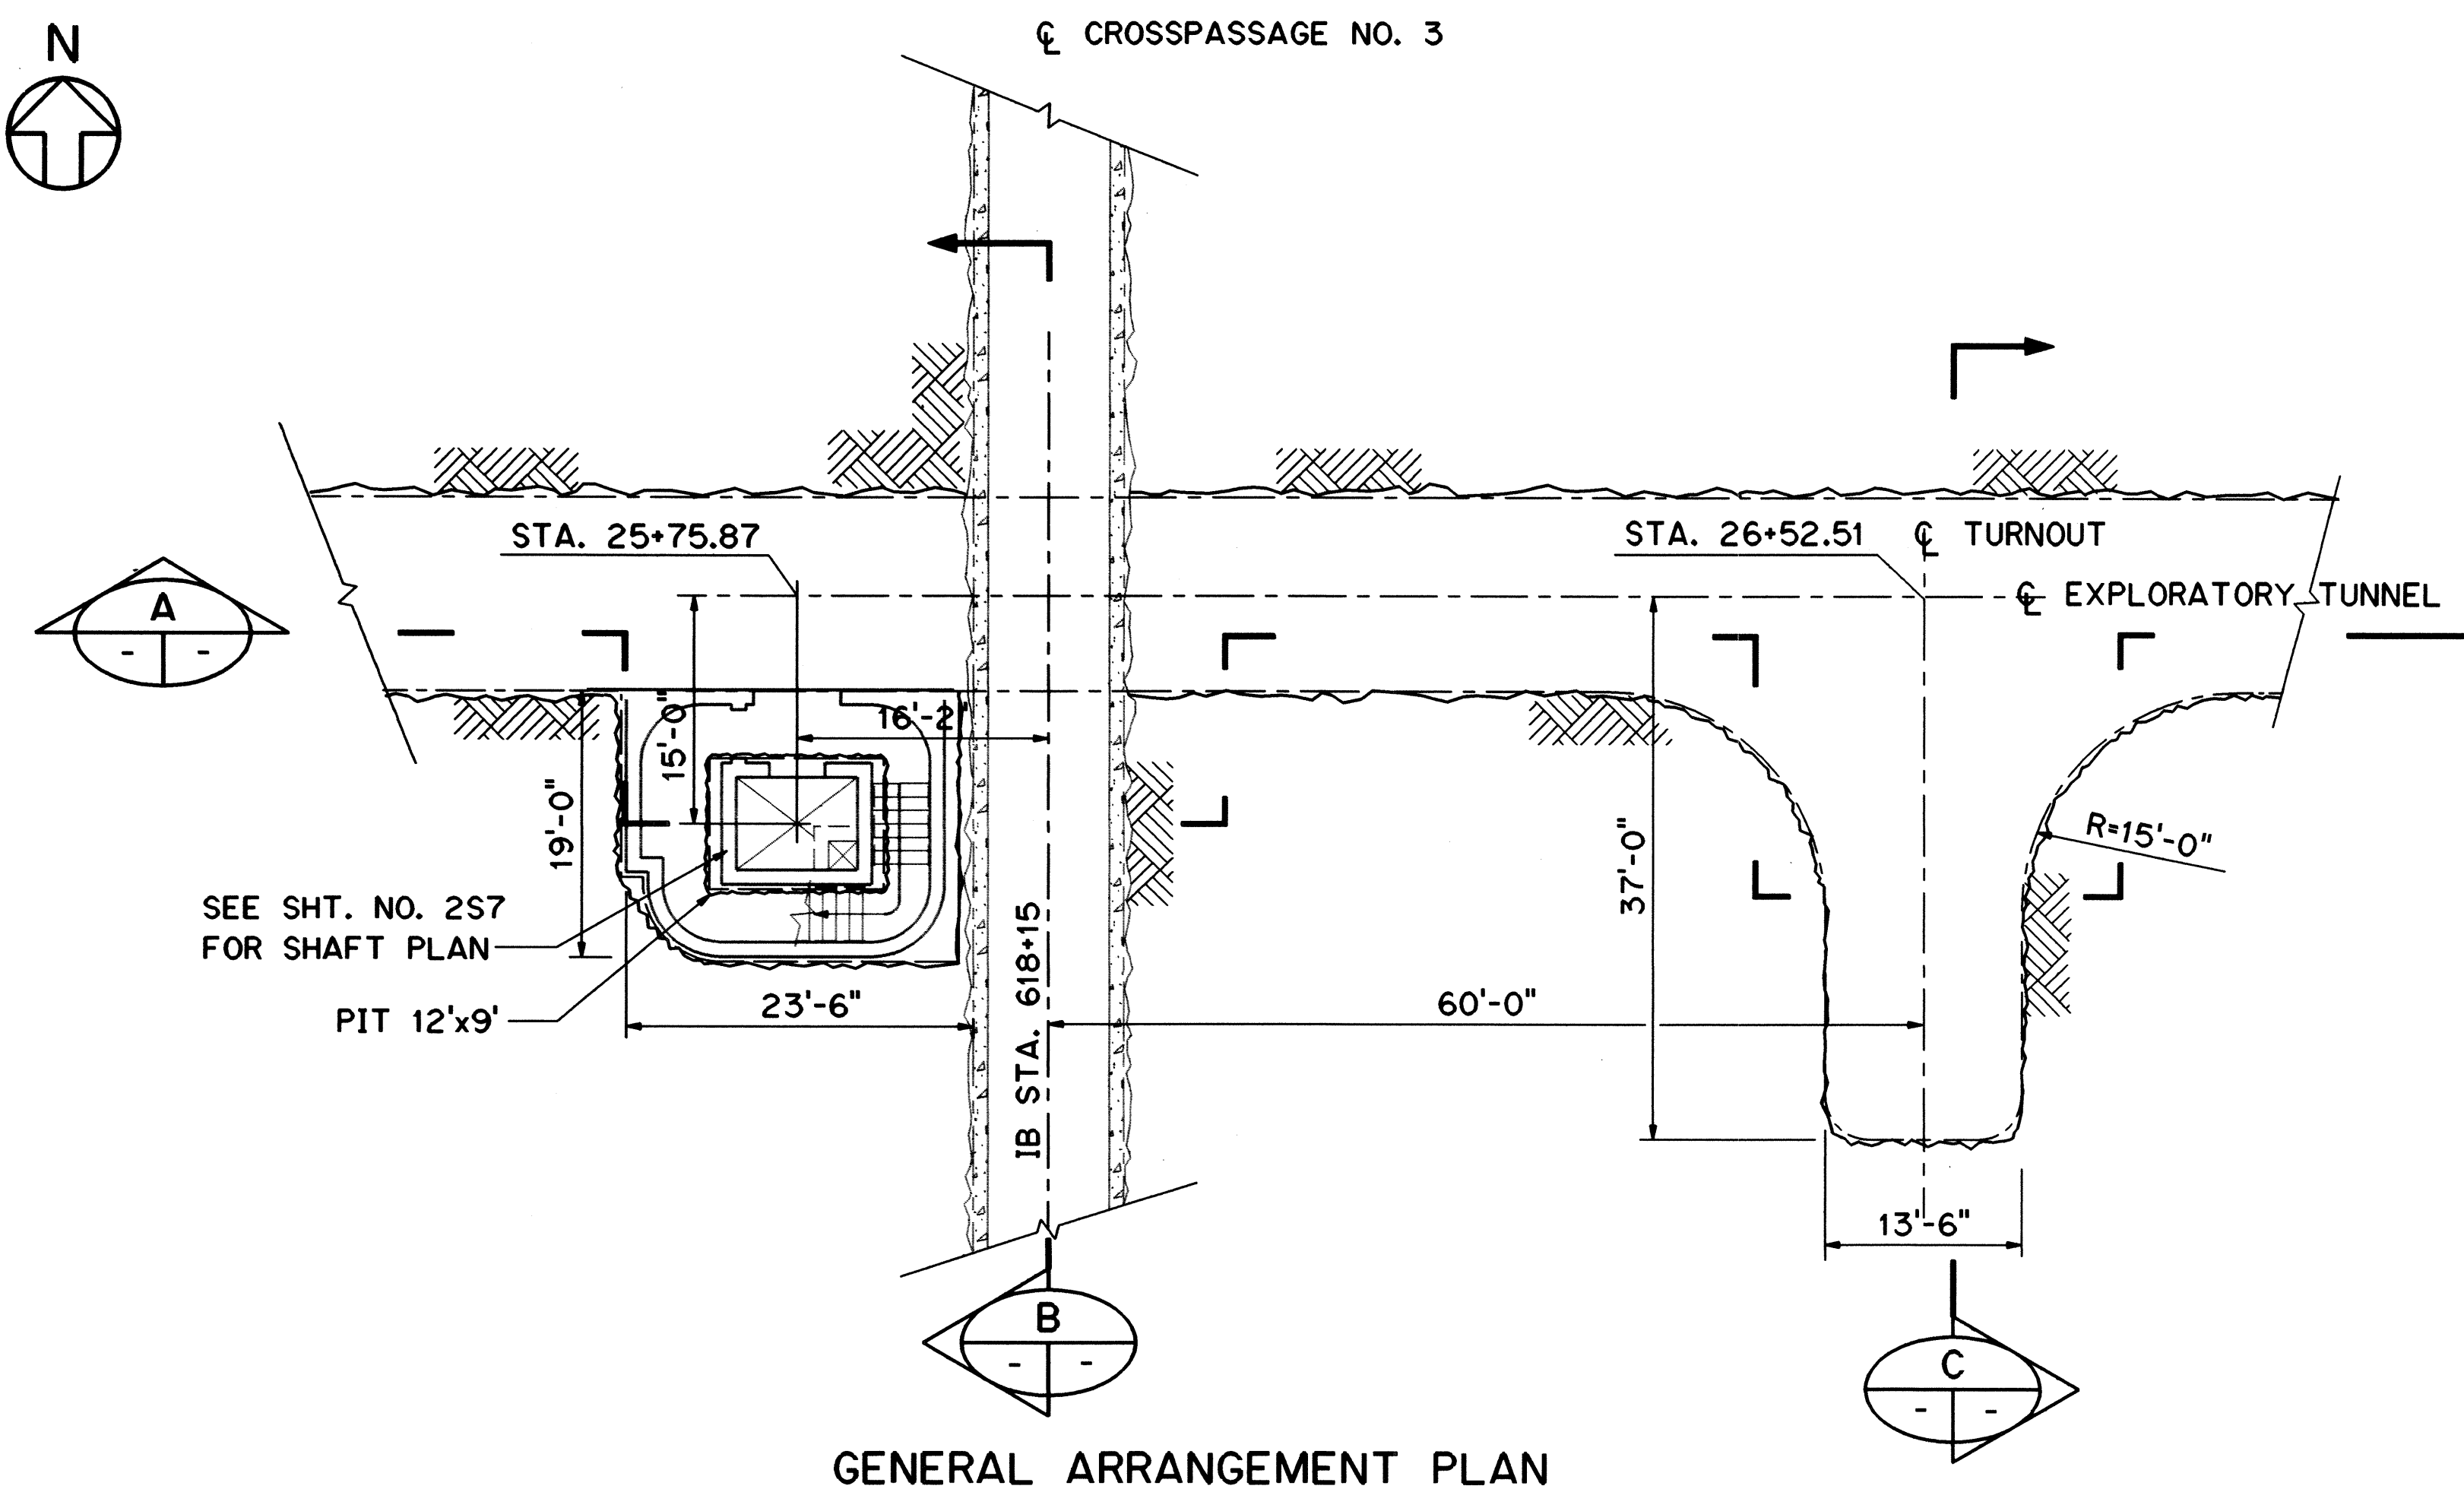

THIS WORK WAS PREPARED BY ME
OR UNDER MY SUPERVISION

Clayton S. Sumner

DATE	REVISION

STATE OF HAWAII
DEPARTMENT OF TRANSPORTATION
HIGHWAYS DIVISION

CROSSPASSAGE NO. 3
CONNECTION/TURNOUT


EXPLORATORY TUNNEL IMPROVEMENTS

H-3 FINISH (UNIT III)
FAIP NO. I-H3-1(75), UNIT III
T.K. TUNNEL/ACCESS ROADS


SCALE: 1" = 10'
DATE: JUN 199

SHEET NO. 2F2 OF 13 SHEETS

FED. ROAD DIST. NO.	STATE	FED. AID PROJ. NO.	FISCAL YEAR	SHEET NO.	TOTAL SHEETS
HAWAII	HAW.	I-H3-1(75) UNIT III	1994	34	353

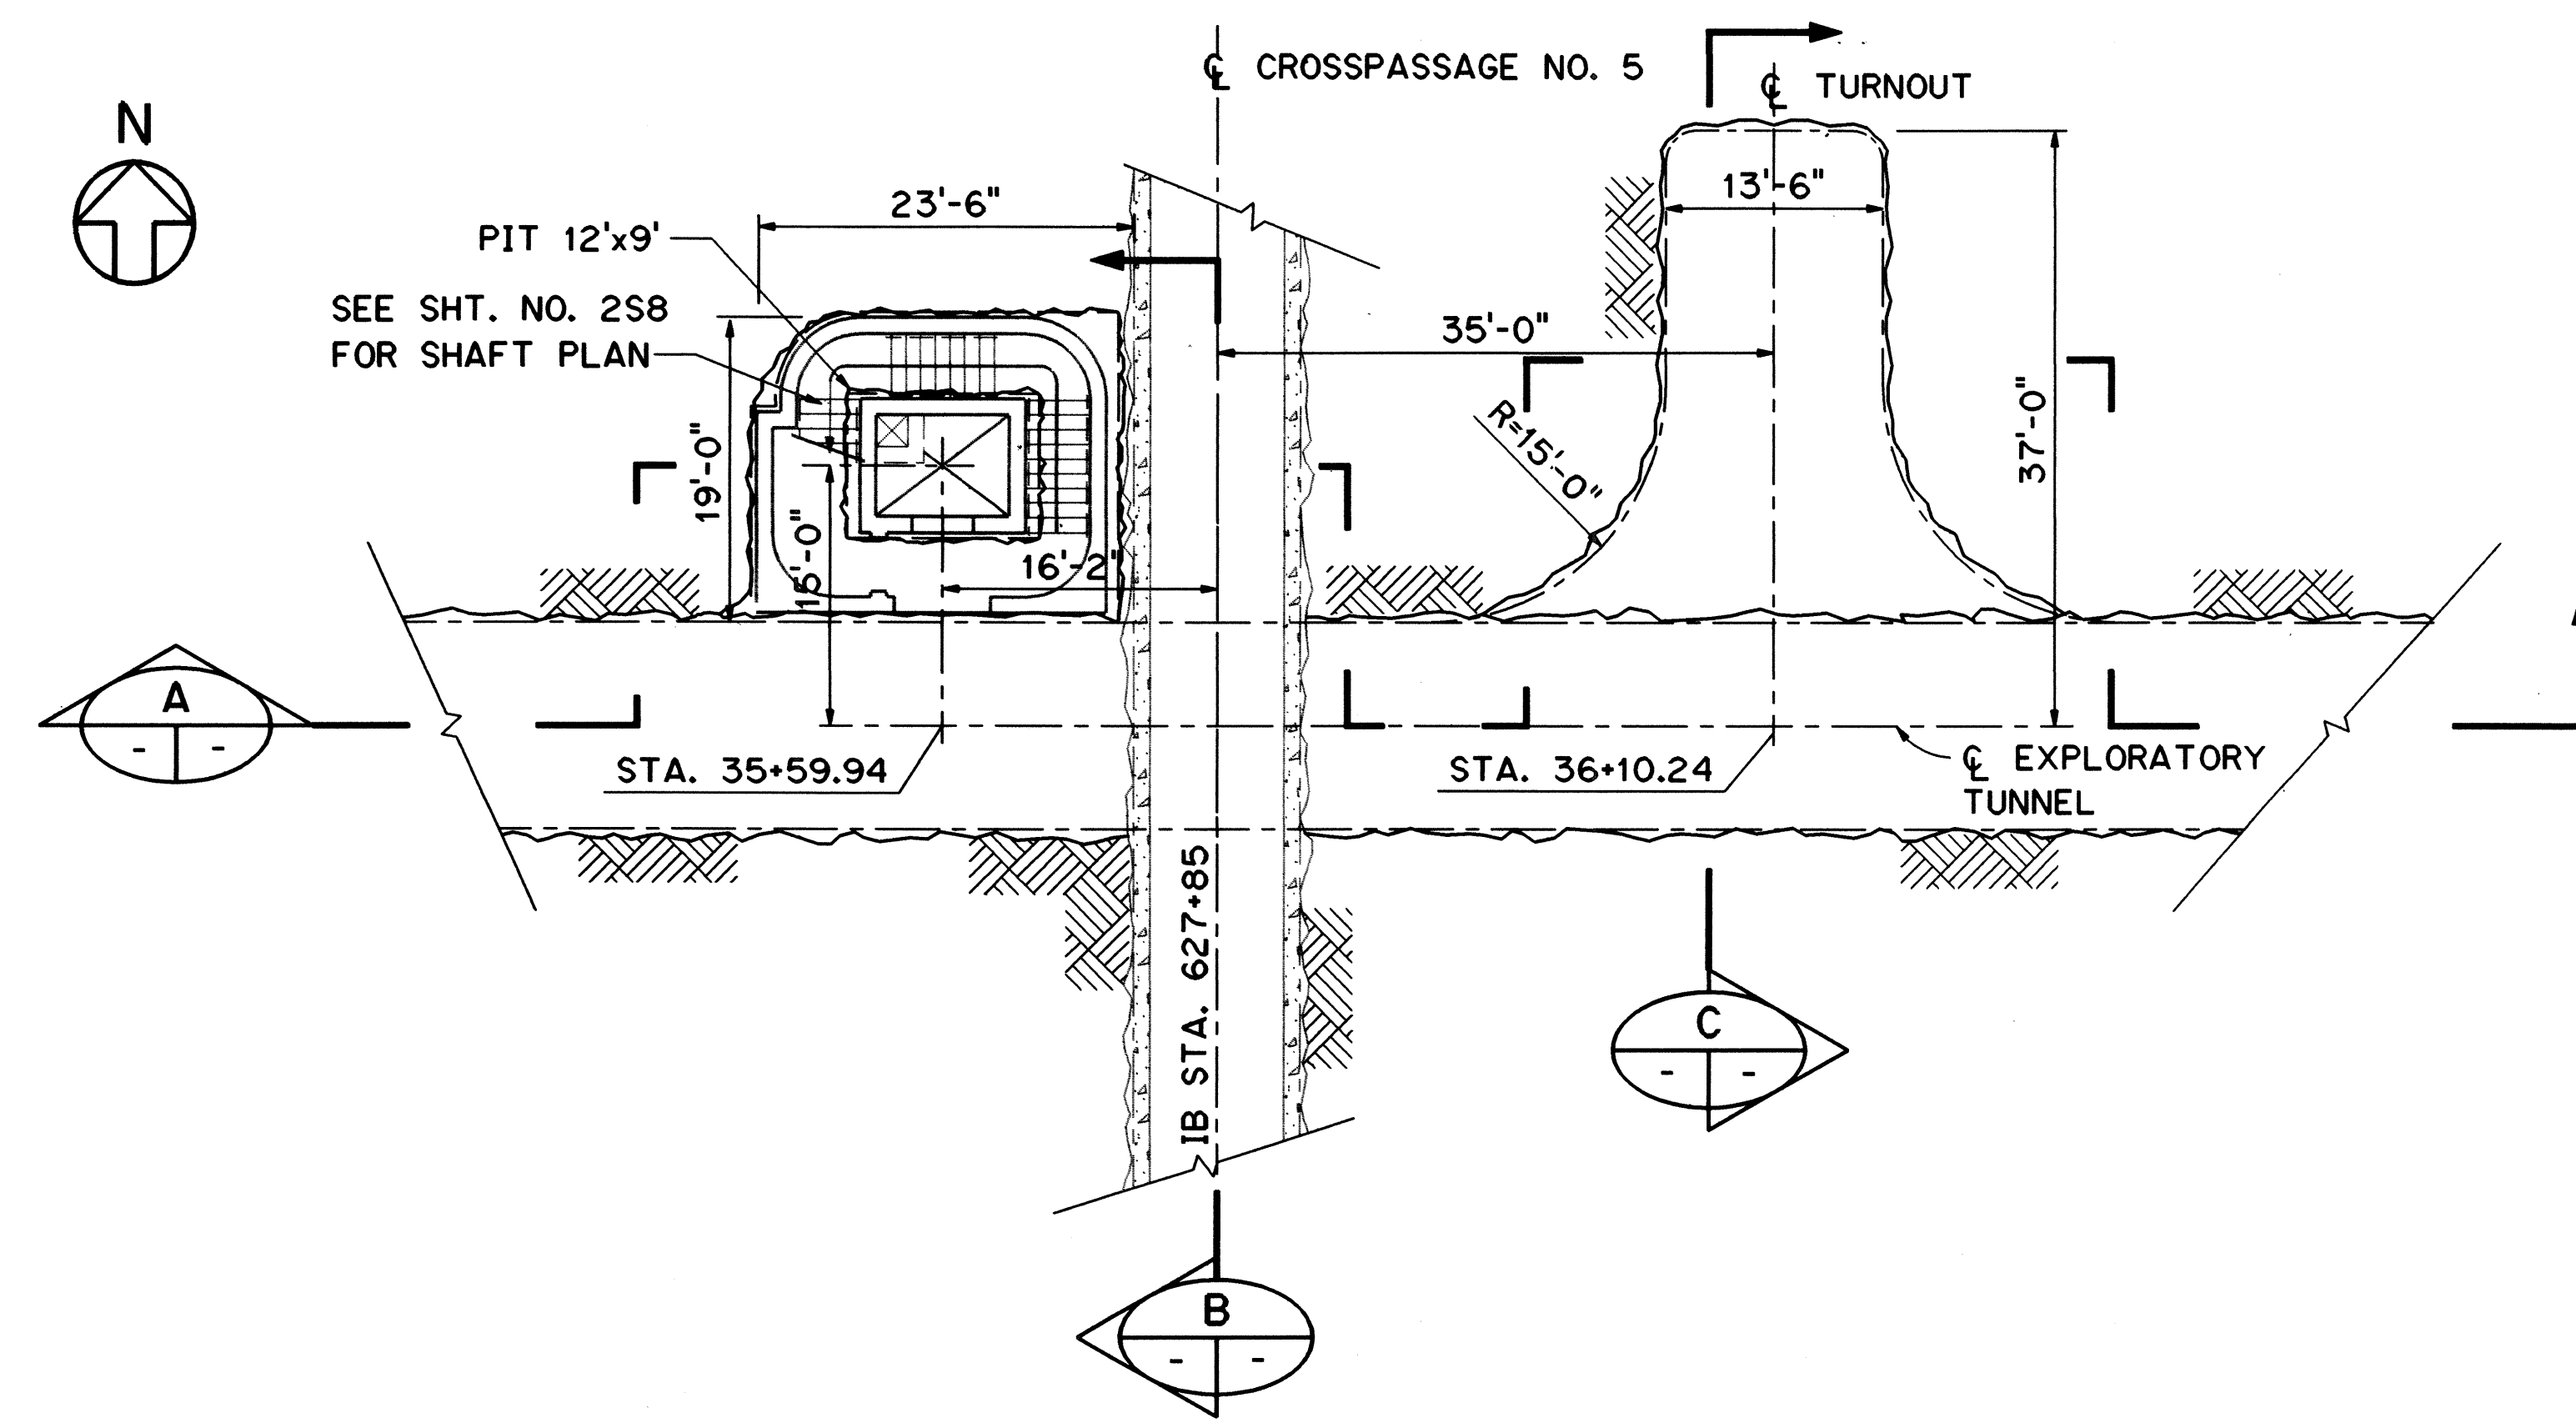


GENERAL ARRANGEMENT PLAN

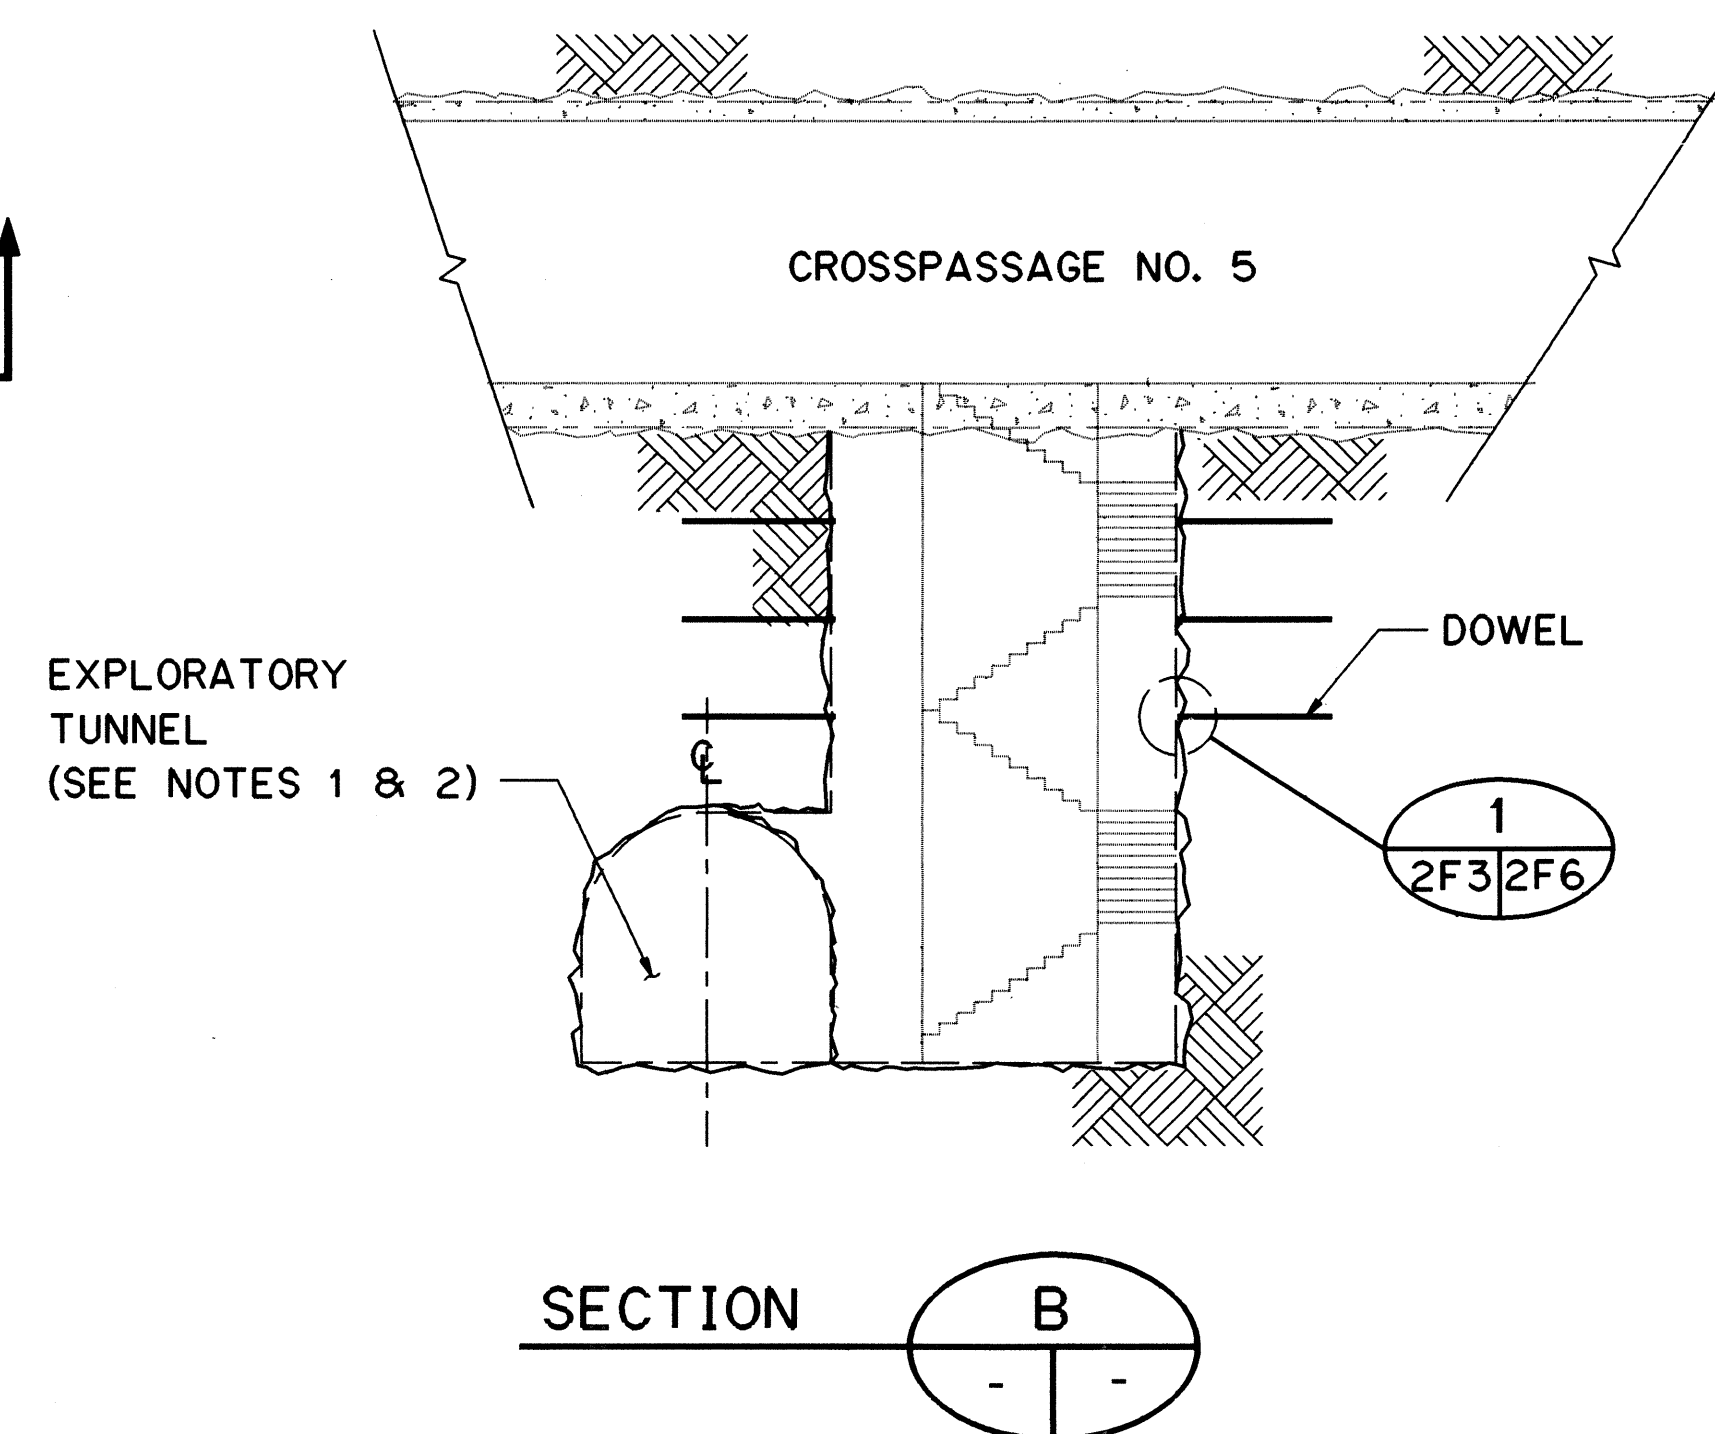


- NOTES:

1. EXISTING GROUND SUPPORT IN THIS AREA WAS INSTALLED AFTER EXCAVATION OF THE EXPLORATORY TUNNEL, PRIOR TO CONSTRUCTION OF CROSSPASSAGE-NO. 5. IT CONSISTS OF 6 FT. LONG DOWELS IN A 40 FT. ZONE CENTERED AT STA 35+75.
2. NO GROUND SUPPORT (TYPE A SUPPORT) WAS REQUIRED DURING EXCAVATION OF THE EXPLORATORY TUNNEL IN THIS AREA.

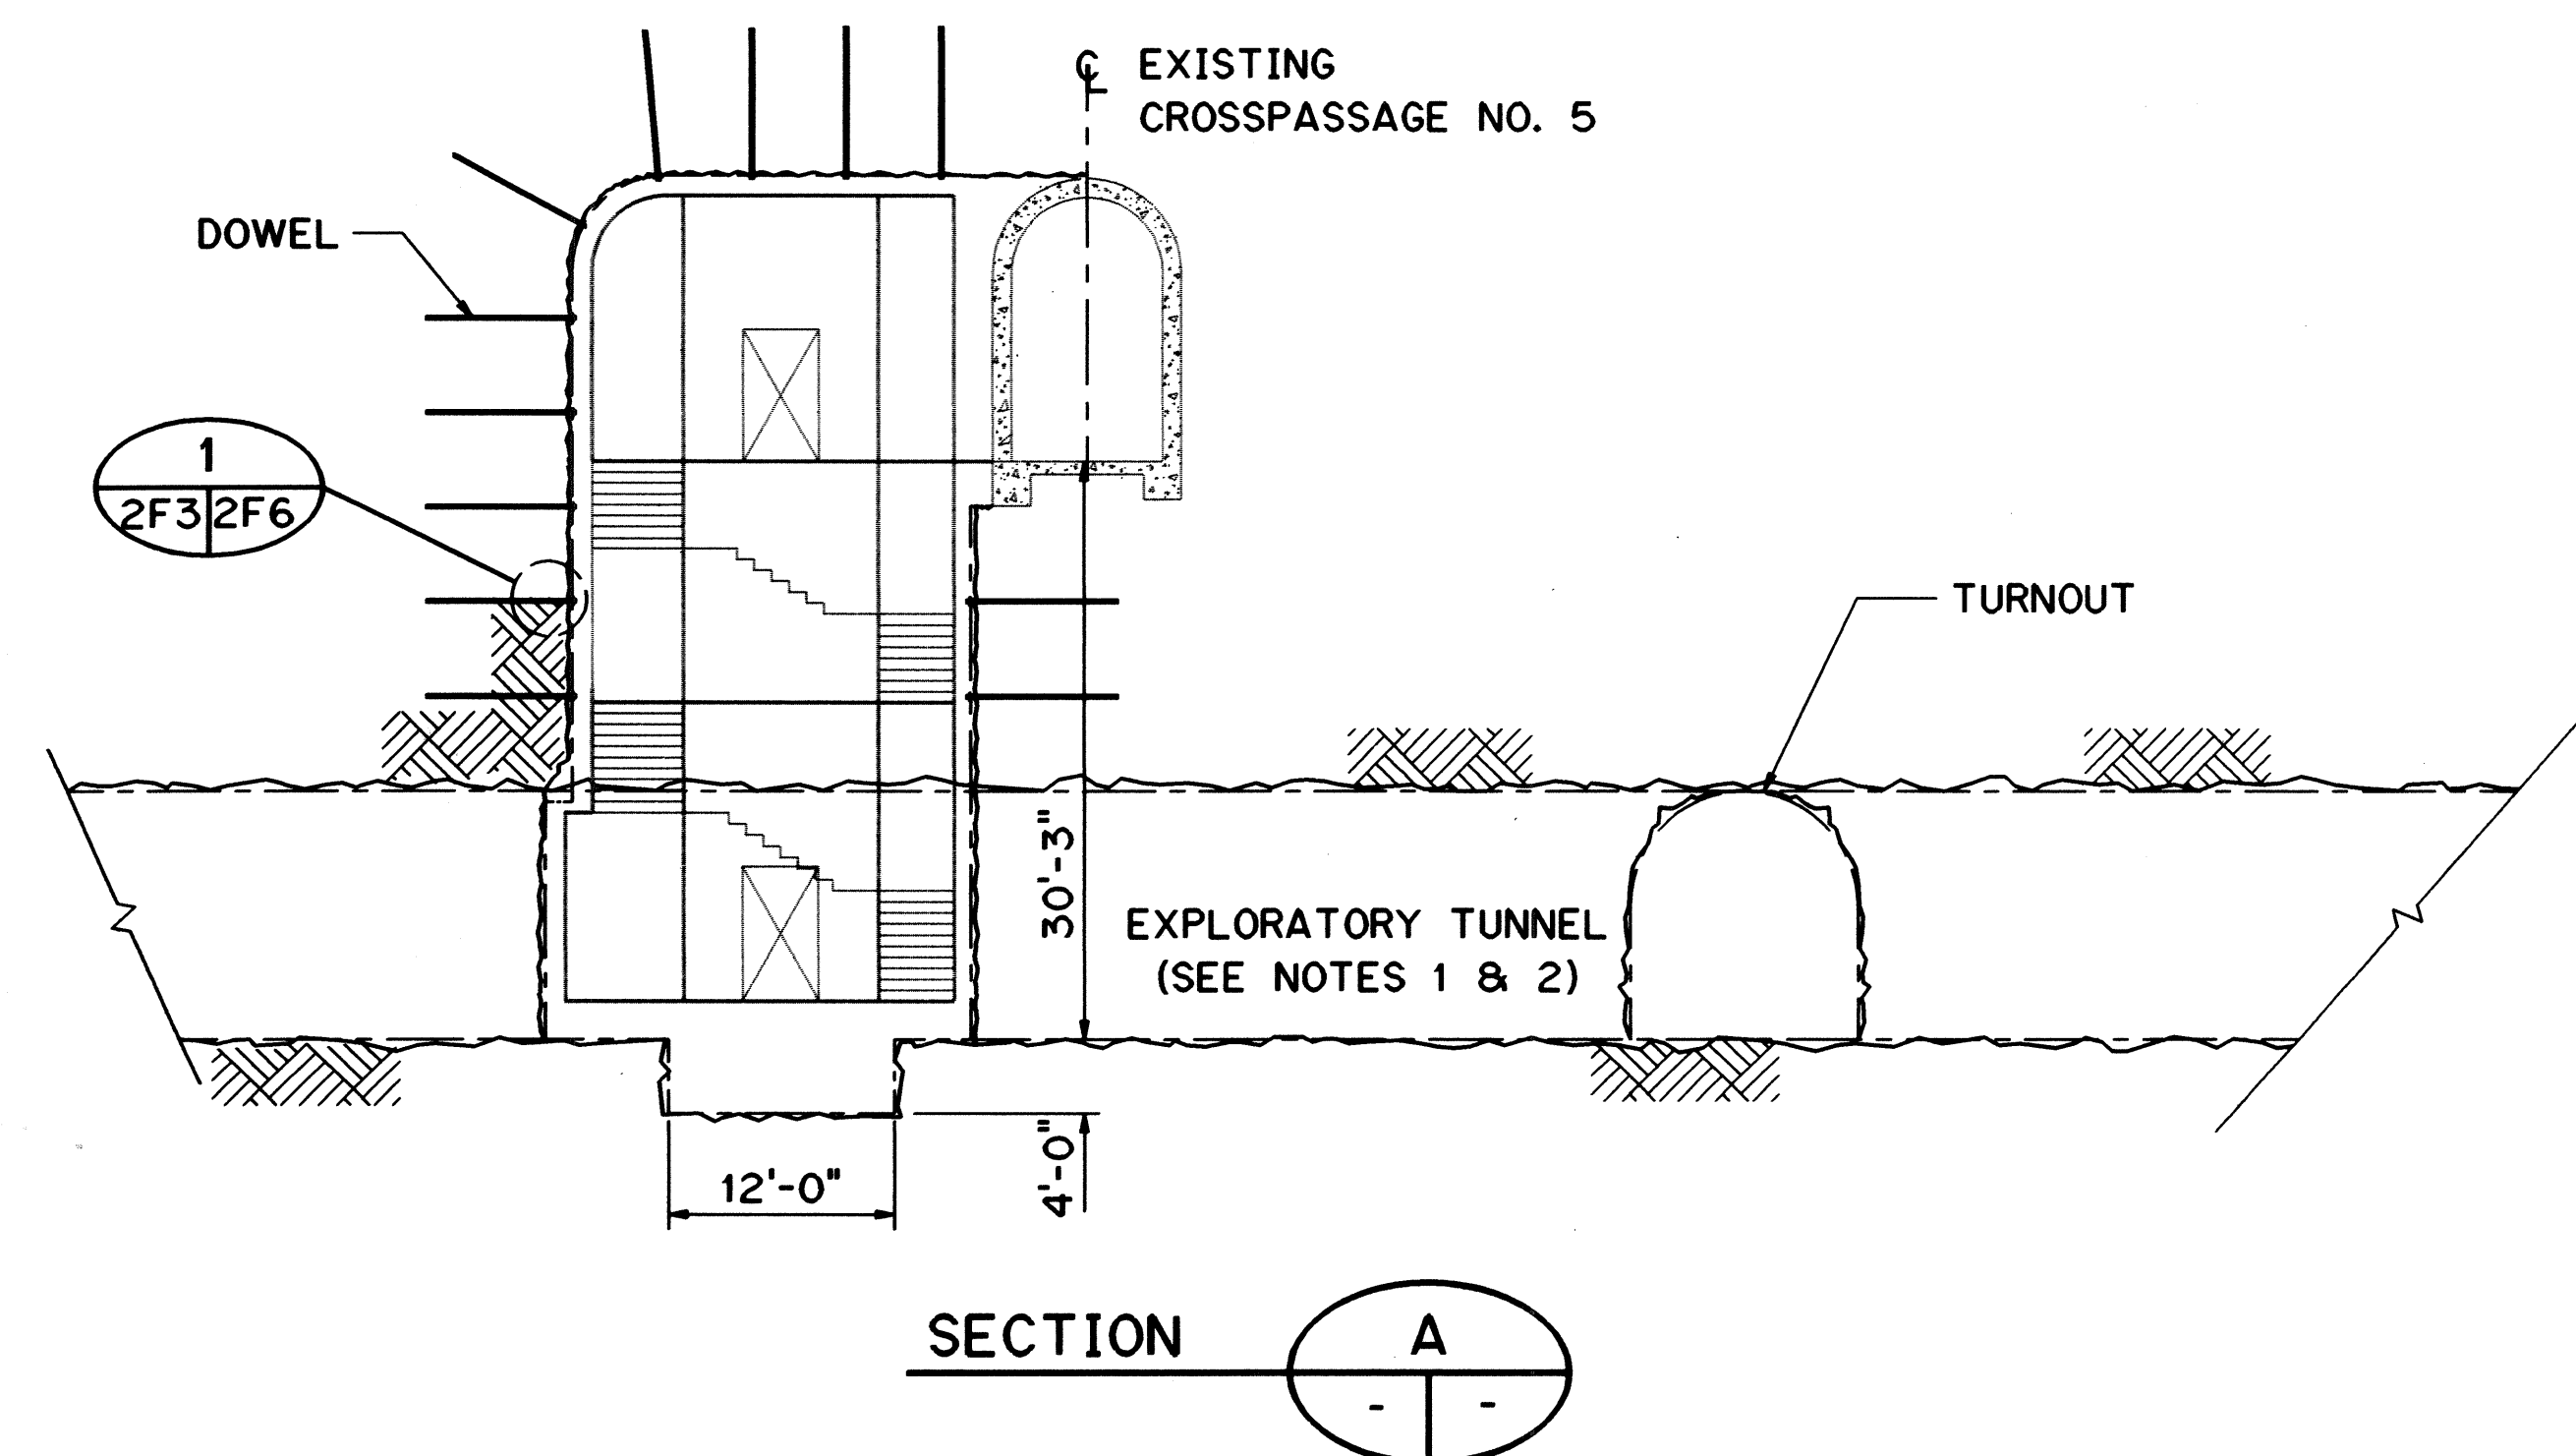

SECTION 

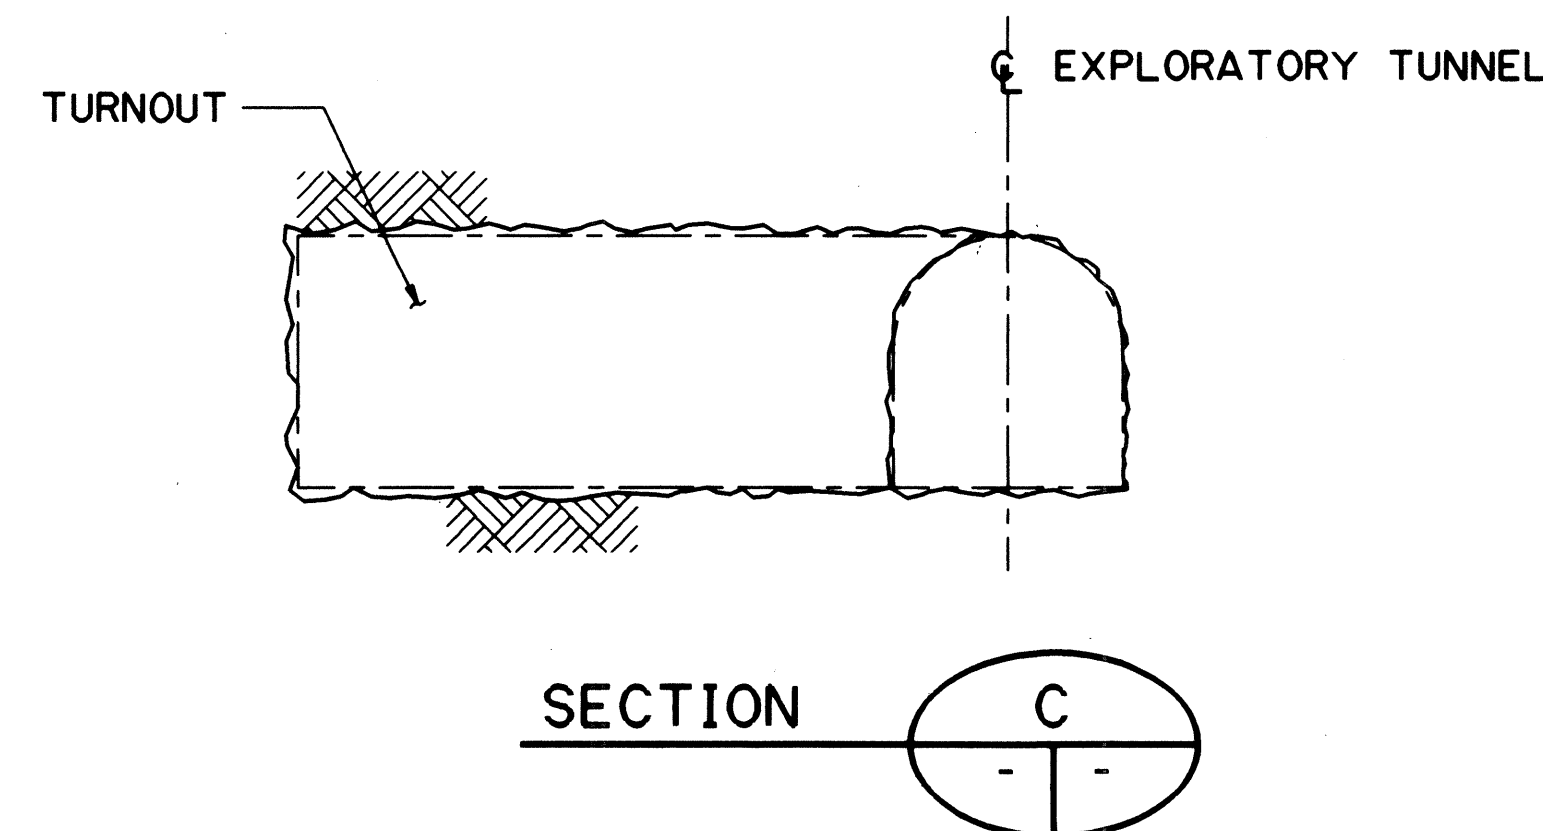

SECTION 

ORIGINAL PLAN	SURVEY PLOTTED BY _____	DATE _____
NOTE BOOK	DRAWN BY _____	_____
	DESIGNED BY _____	_____
	QUANTITIES BY _____	_____
	CHECKED BY _____	_____
NO. _____		

DATE	REVISION

STATE OF HAWAII
DEPARTMENT OF TRANSPORTATION
HIGHWAYS DIVISION

CROSSPASSAGE NO. 5
CONNECTION/TURNOUT
EXPLORATORY TUNNEL IMPROVEMENTS
H-3 FINISH (UNIT III)
FAIP NO. I-H3-1(75), UNIT III
T.K. TUNNEL/ACCESS ROADS

SCALE: 1" = 10' DATE: JUN 1995



THIS WORK WAS PREPARED BY ME
OR UNDER MY SUPERVISION

Clayton S Sumner

GRAPHIC SCALE


10' 0' 10' 20'

1" = 10'






FED. ROAD DIST. NO.	STATE	FED. AID PROJ. NO.	FISCAL YEAR	SHEET NO.	TOTAL SHEETS
HAWAII	HAW.	I-H3-1-(75) UNIT III	1994	35	353

NOTES:

- EXISTING GROUND SUPPORT IN THIS AREA WAS INSTALLED AFTER EXCAVATION OF THE EXPLORATORY TUNNEL, PRIOR TO CONSTRUCTION OF CROSSPASSAGE NO. 7. IT CONSISTS OF 6 FT. LONG DOWELS IN A 40 FT. ZONE CENTERED AT STA 45+65.
- NO GROUND SUPPORT (TYPE A SUPPORT) WAS REQUIRED DURING EXCAVATION OF THE EXPLORATORY TUNNEL IN THIS AREA.

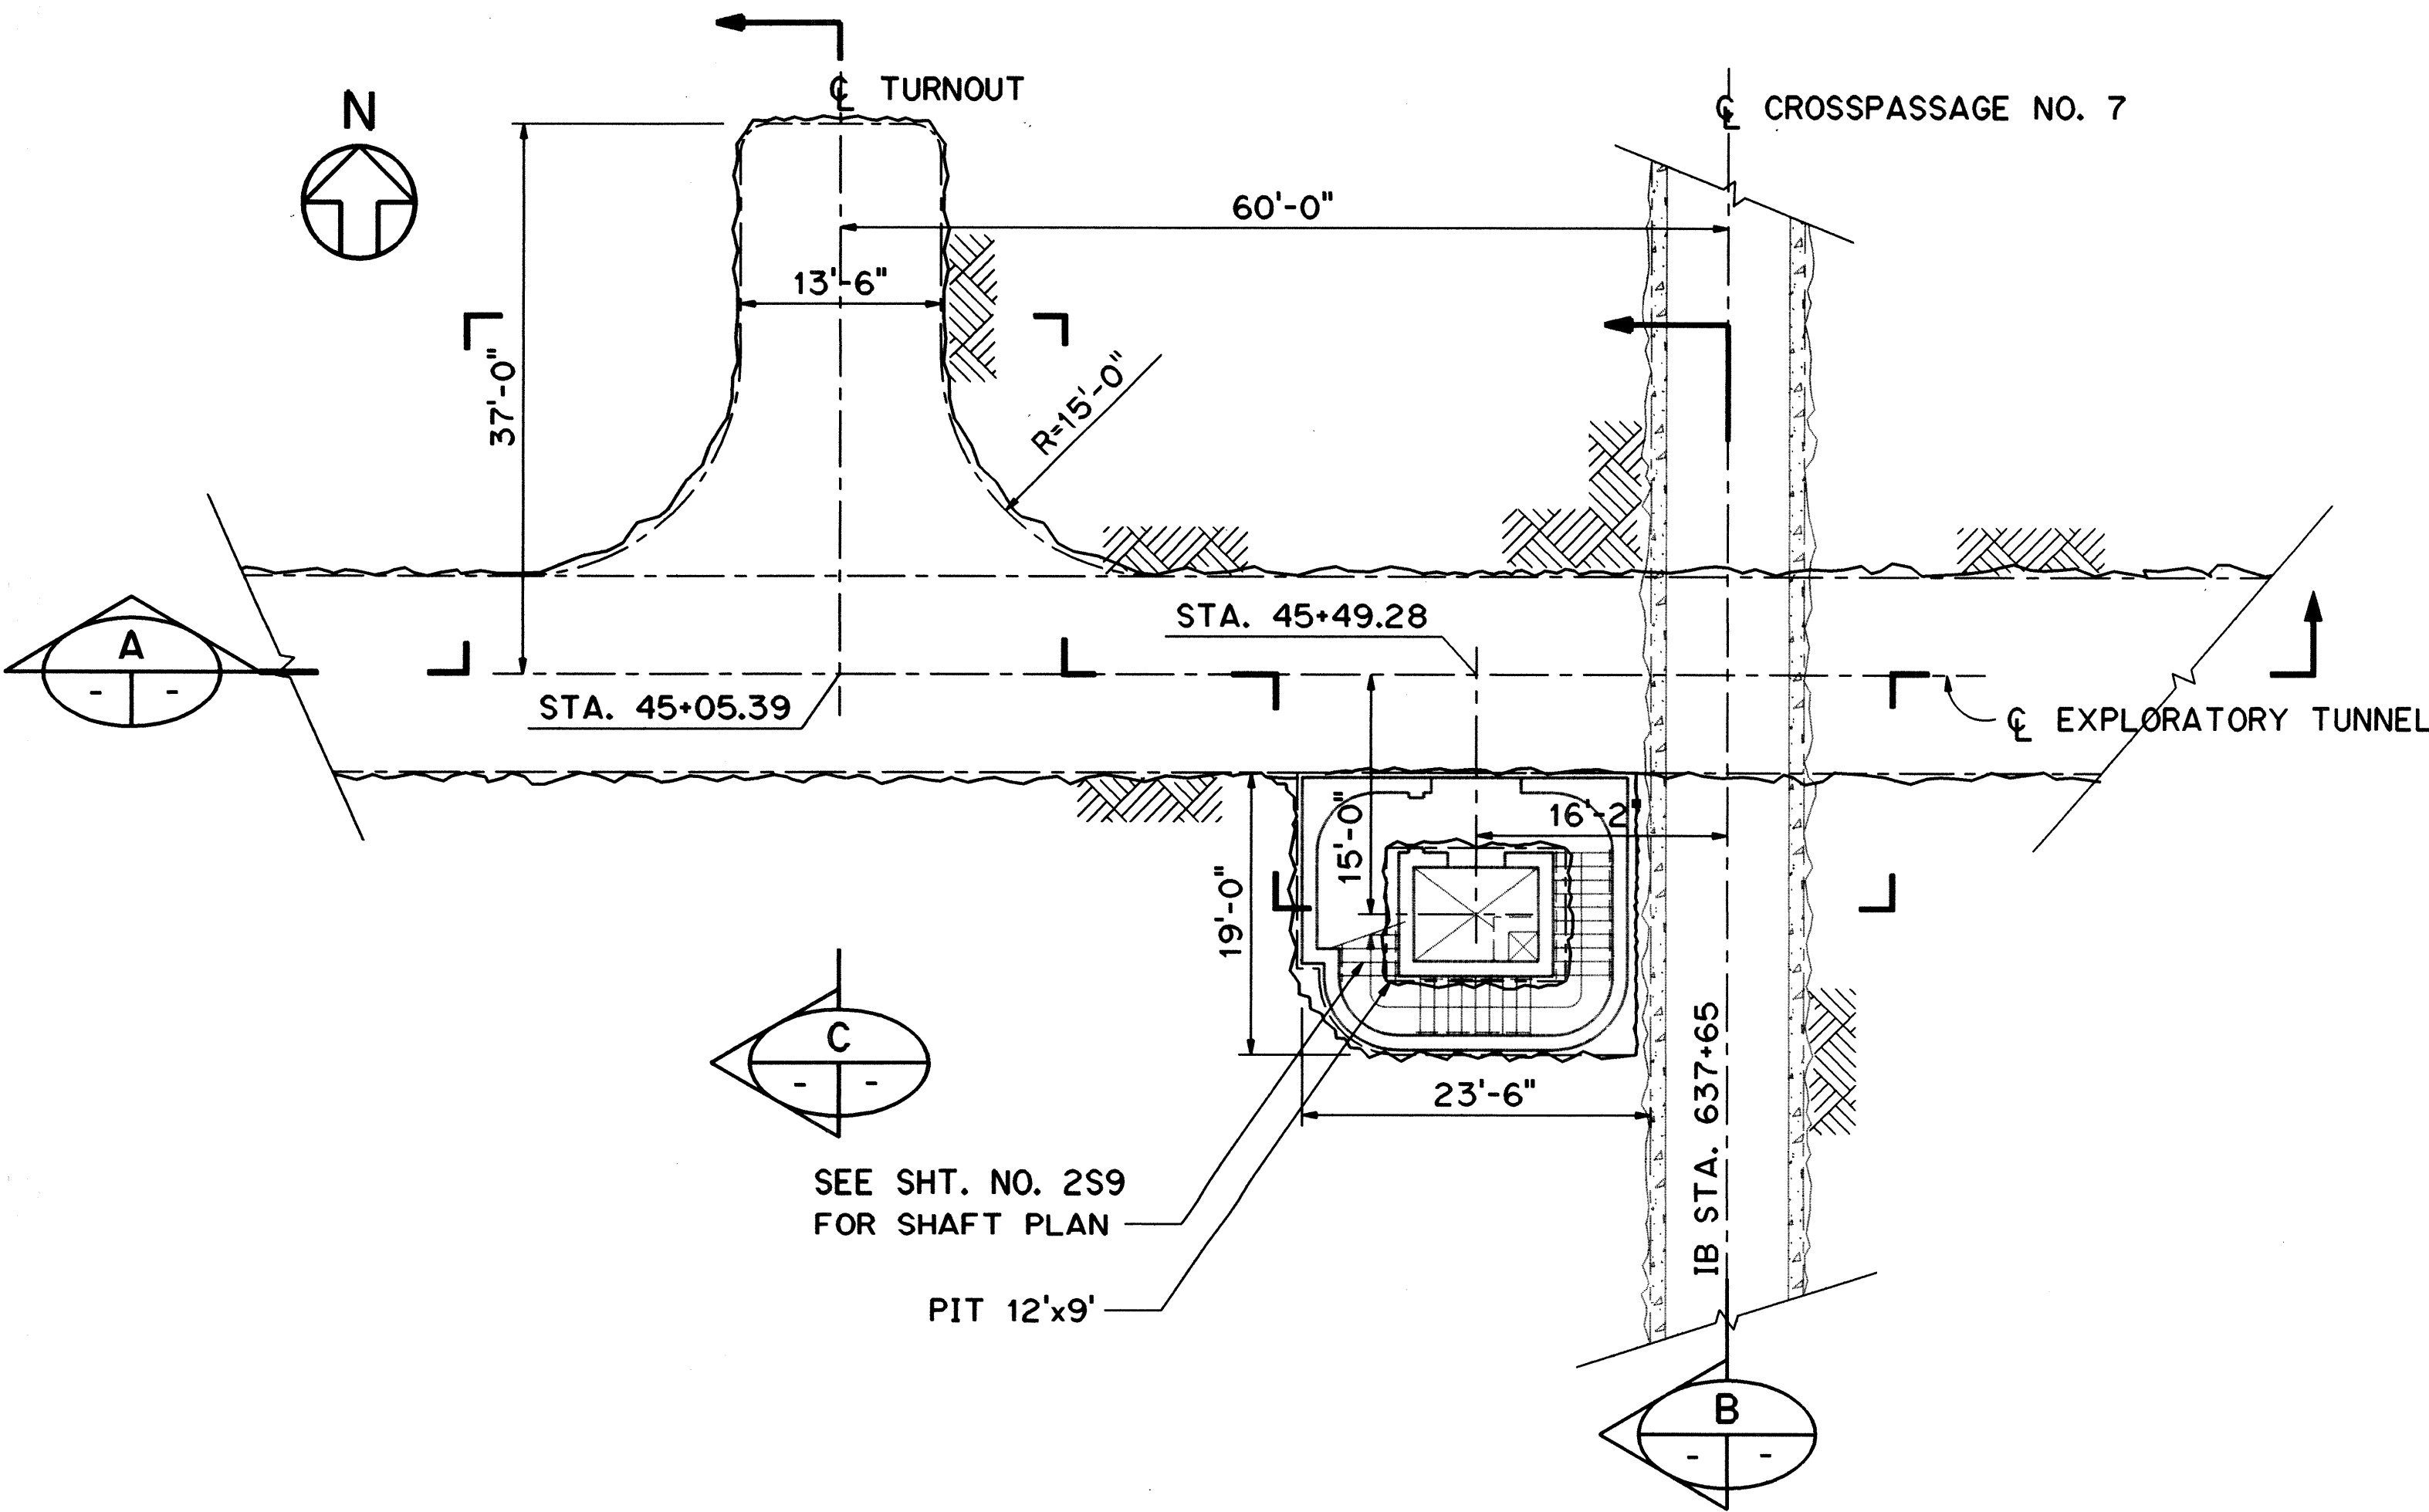

GENERAL ARRANGEMENT PLAN

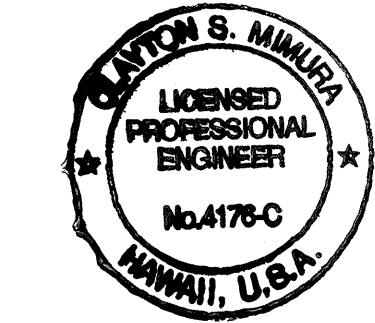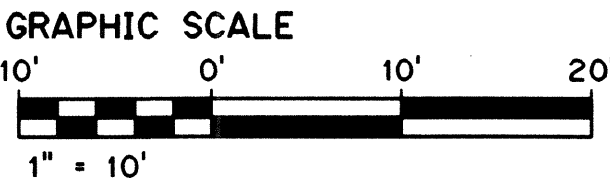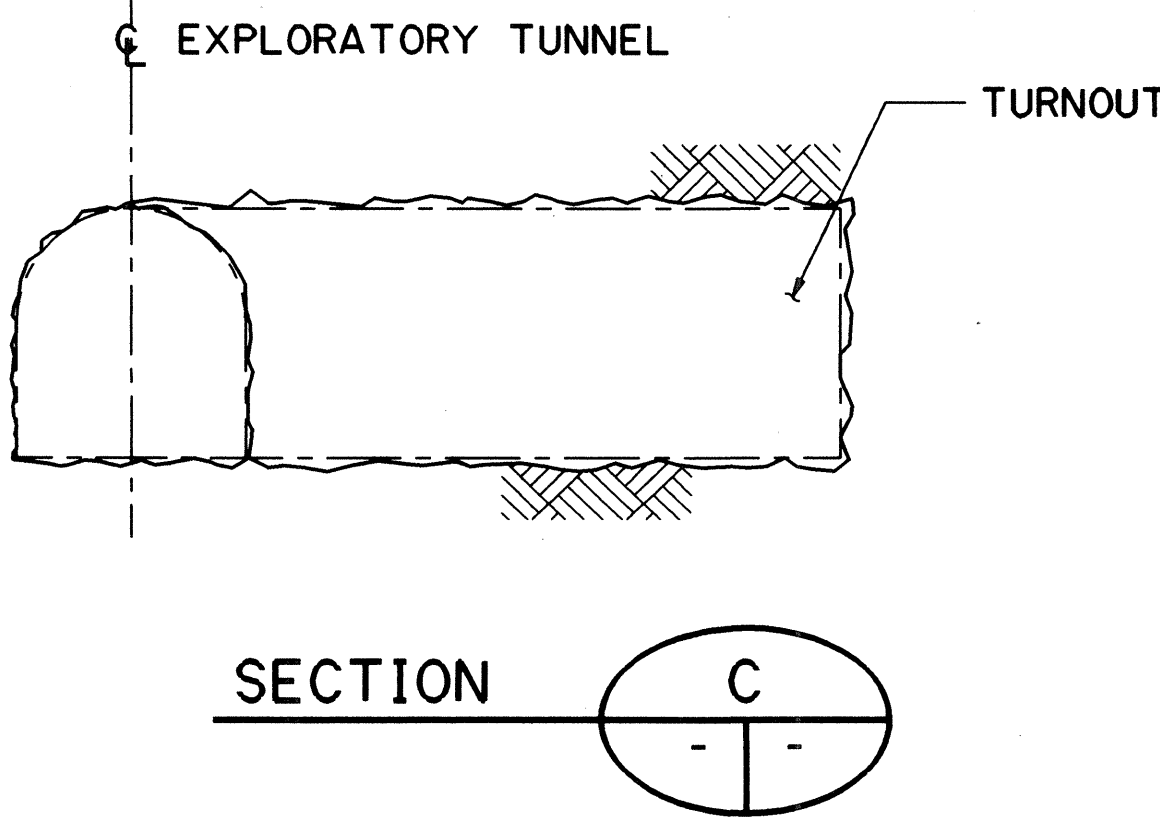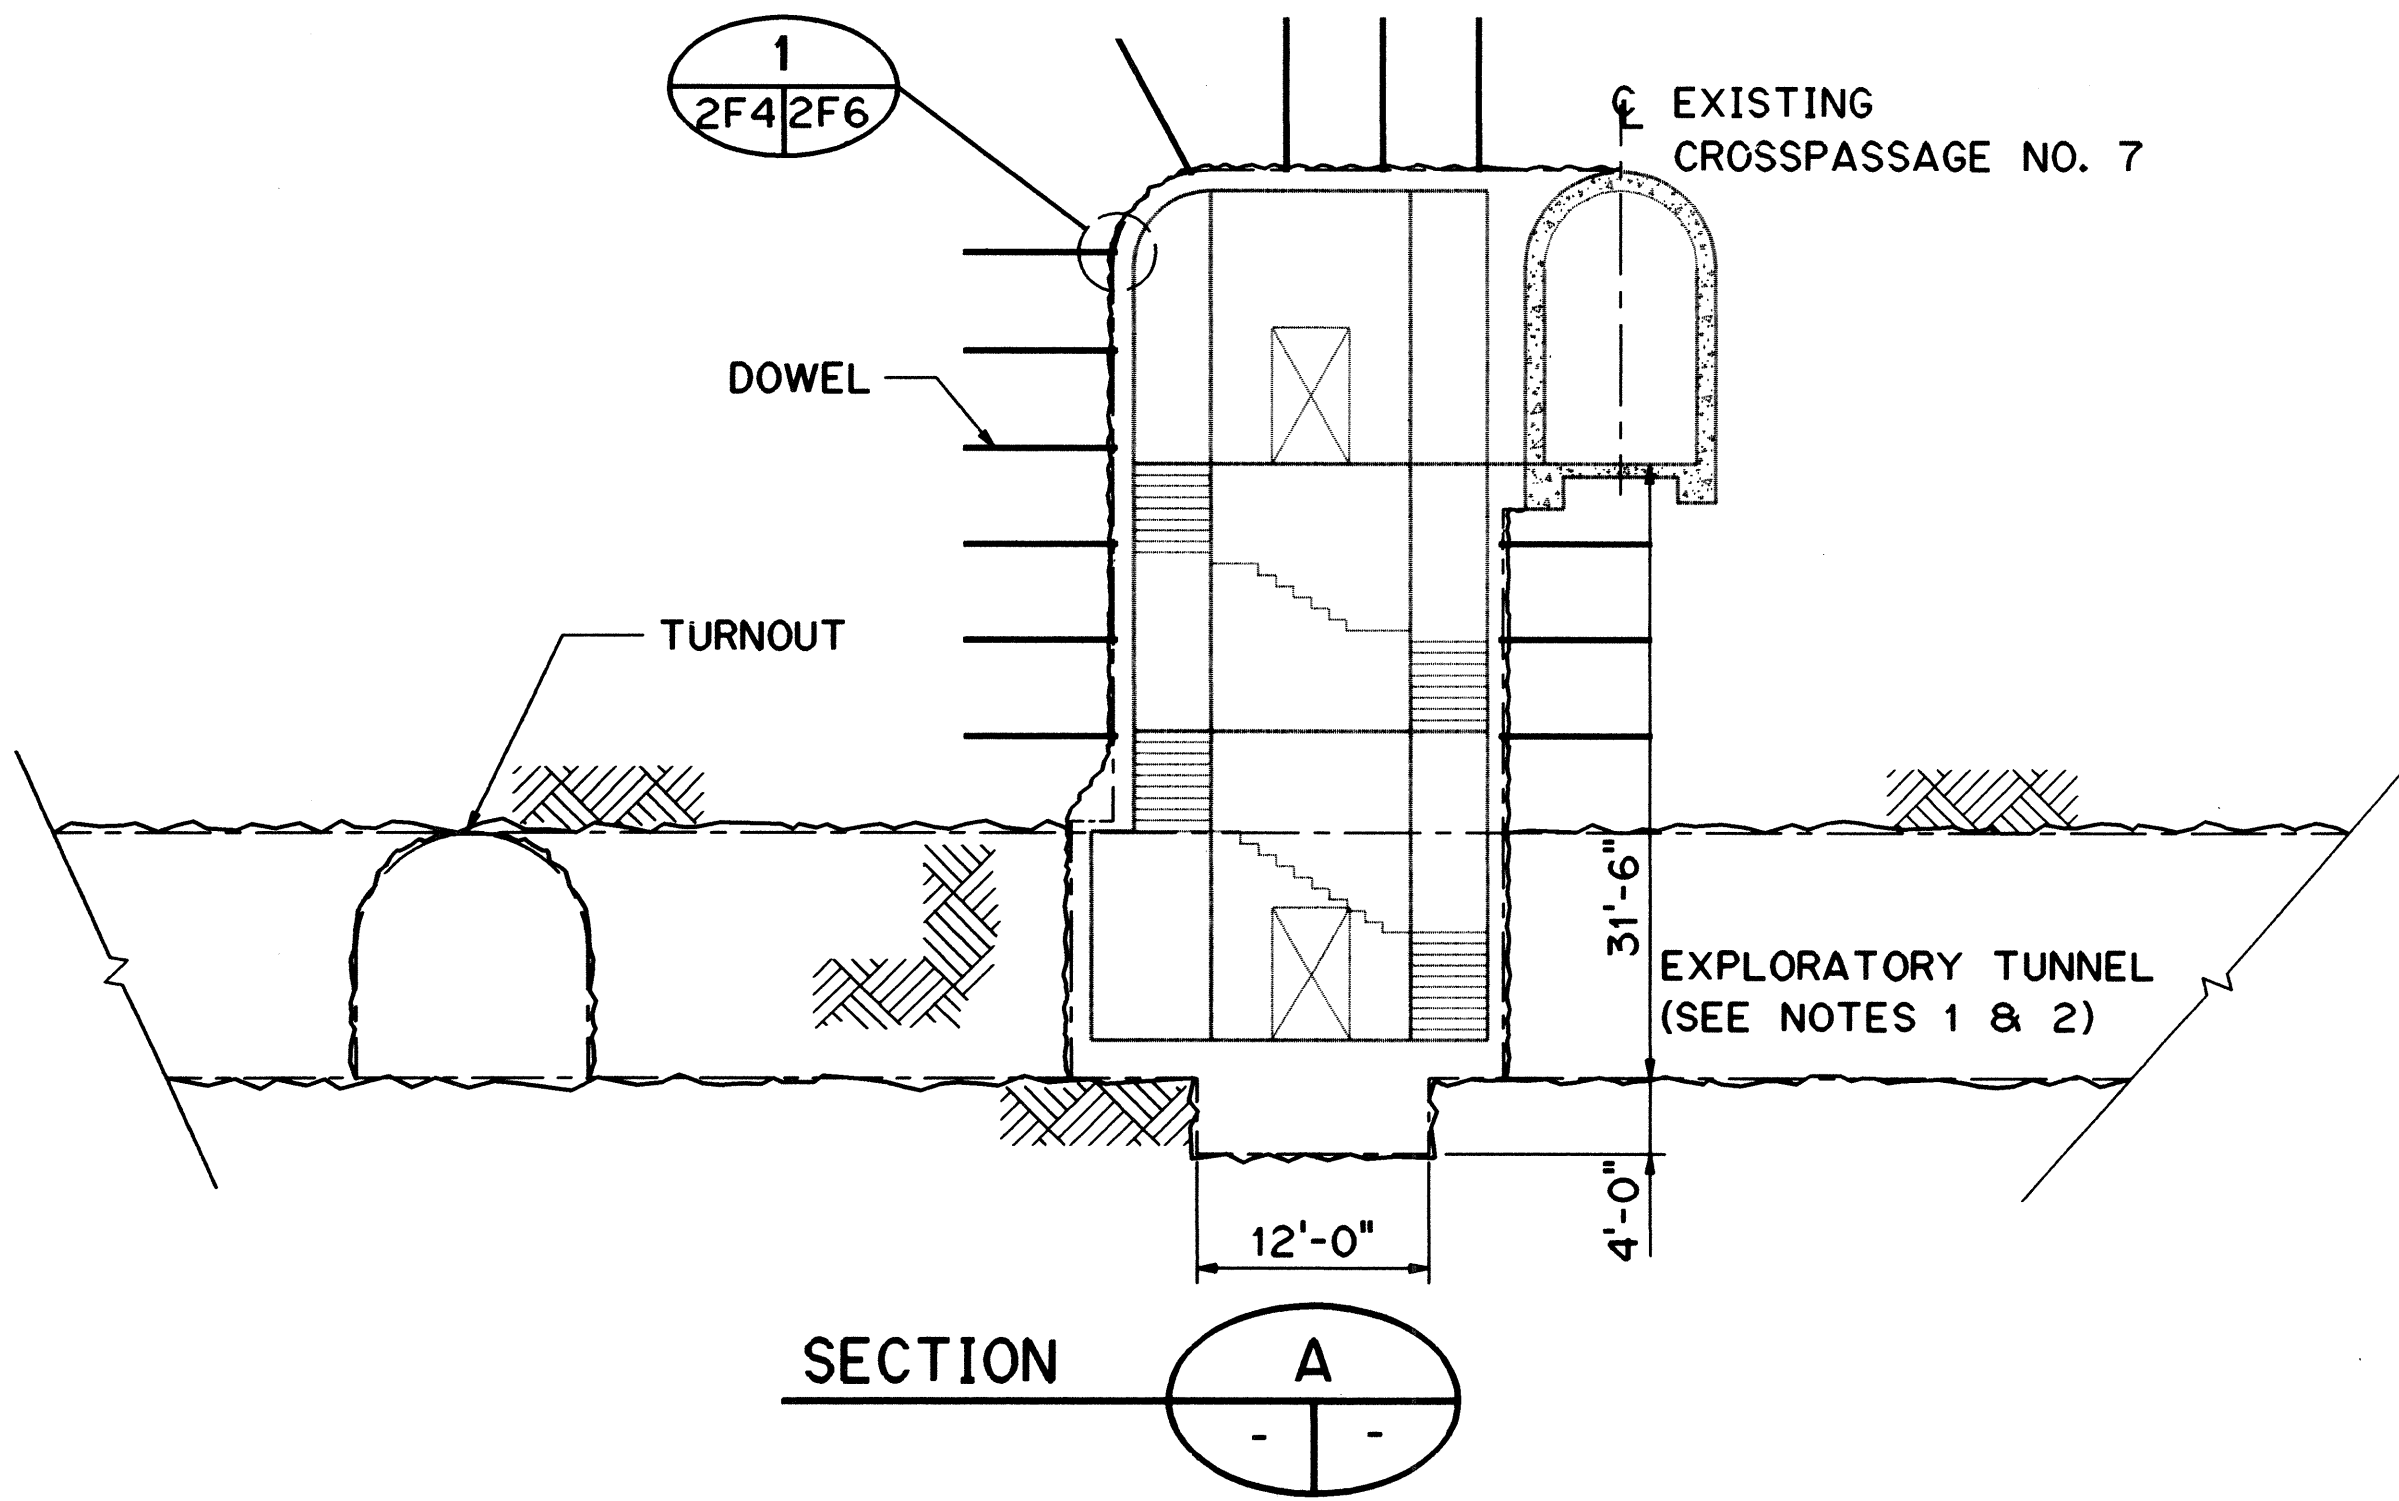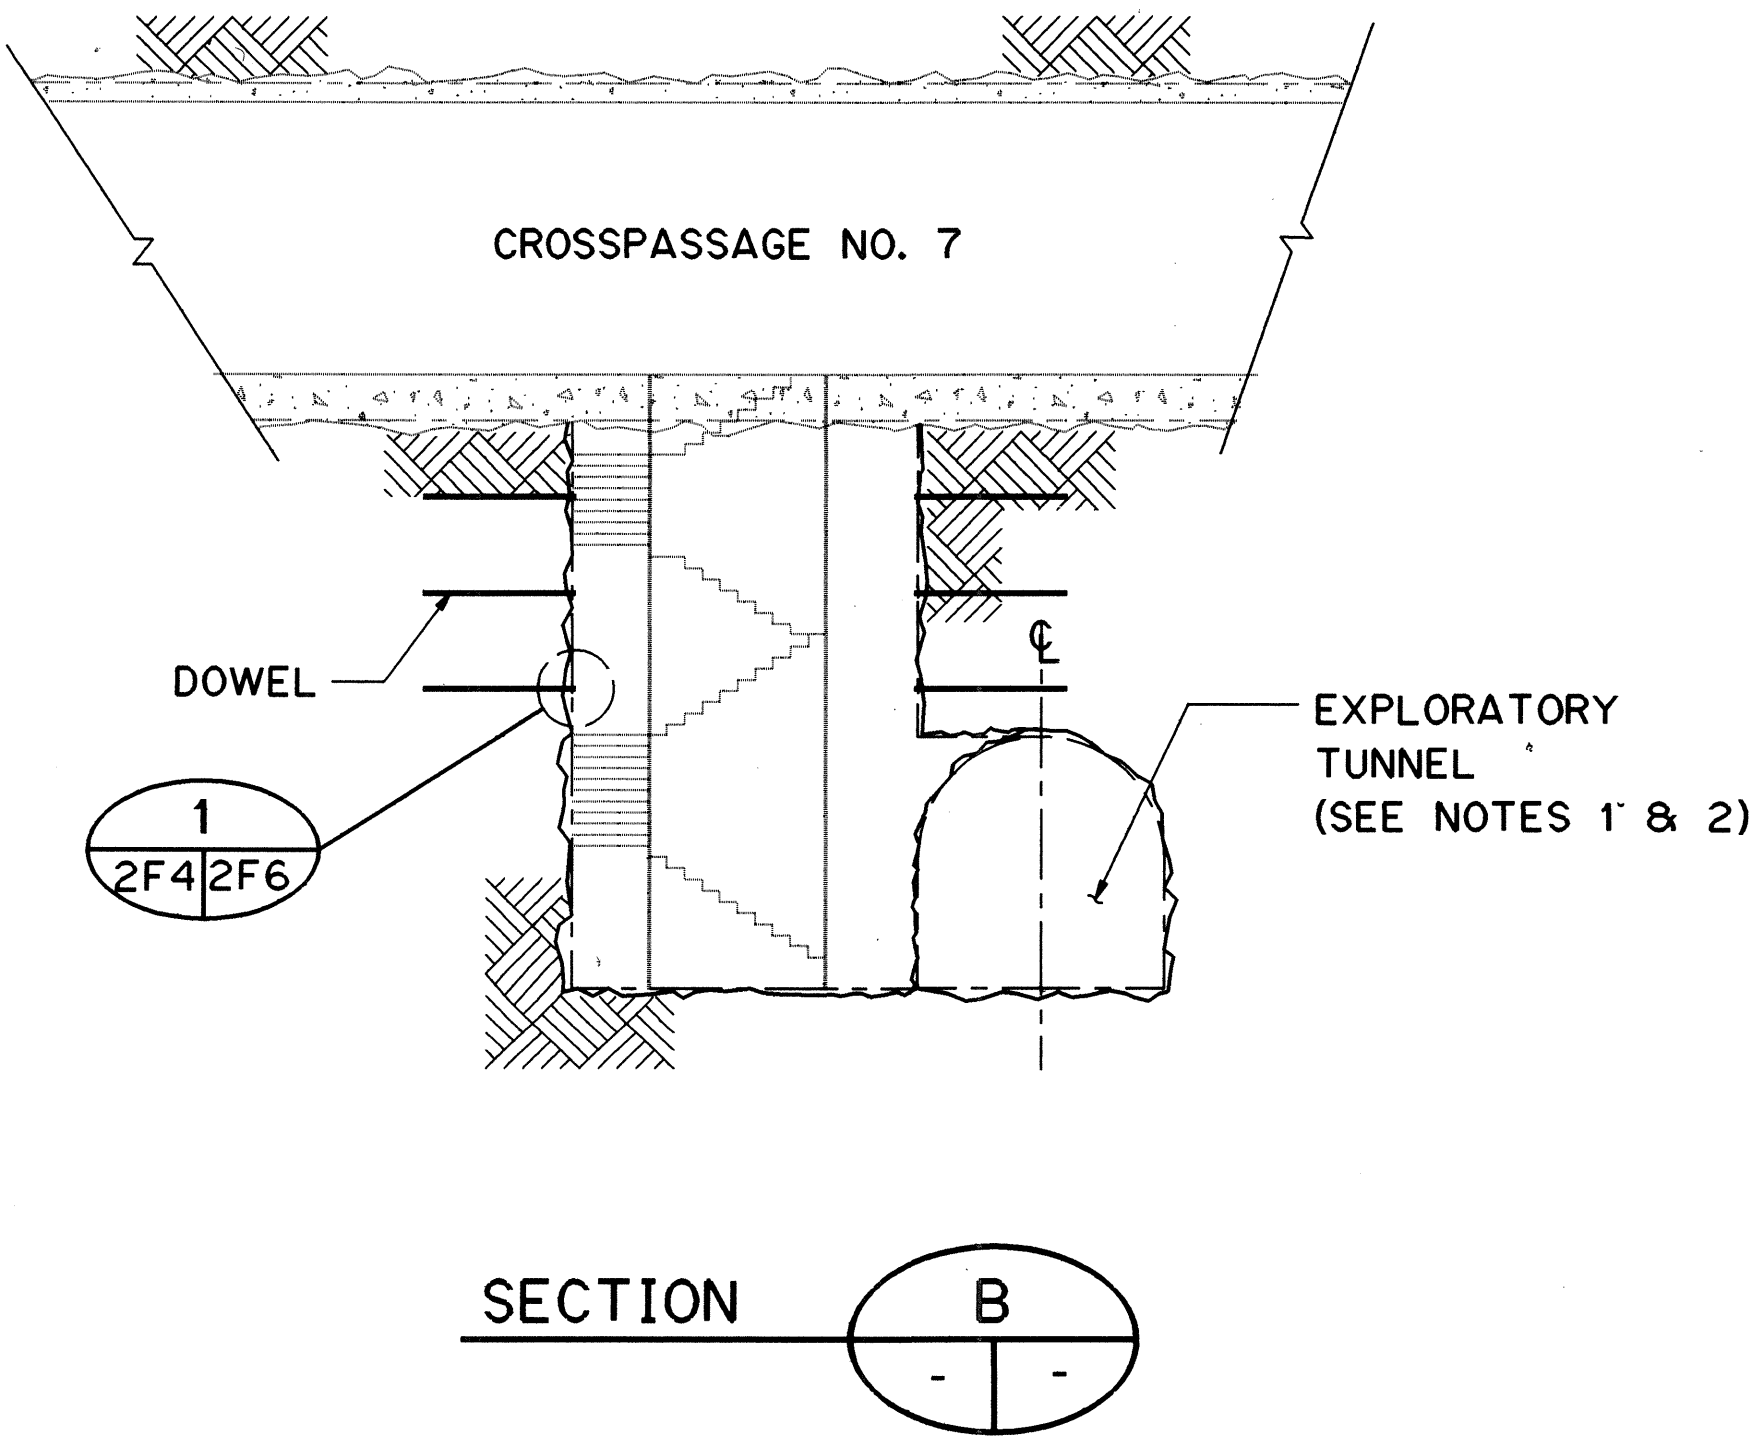

THIS WORK WAS PREPARED BY ME OR UNDER MY SUPERVISION


Clayton S. Imanaka

DATE	REVISION

STATE OF HAWAII DEPARTMENT OF TRANSPORTATION HIGHWAYS DIVISION	
CROSSPASSAGE NO. 7	
CONNECTION/TURNOUT	
EXPLORATORY TUNNEL IMPROVEMENTS	
H-3 FINISH (UNIT III)	
FAIP NO. I-H3-1(75), UNIT III	
T.K. TUNNEL/ACCESS ROADS	
SCALE: 1" = 10'	DATE: JUN 1995
SHEET NO. 2F4	OF 13 SHEETS


SURVEY PLOTTED BY	DATE
DRAWN BY	JAN 95
CHECKED BY	JAN 95
DESIGNED BY	JAN 95
NOTED BY	JAN 95
QUANTITIES BY	JAN 95
CHECKED BY	JAN 95
NO.	

FED. ROAD DIST. NO.	STATE	FED. AID PROJ. NO.	FISCAL YEAR	SHEET NO.	TOTAL SHEETS
HAWAII	HAW.	1-H3-1(75) UNIT III	1994	37	353

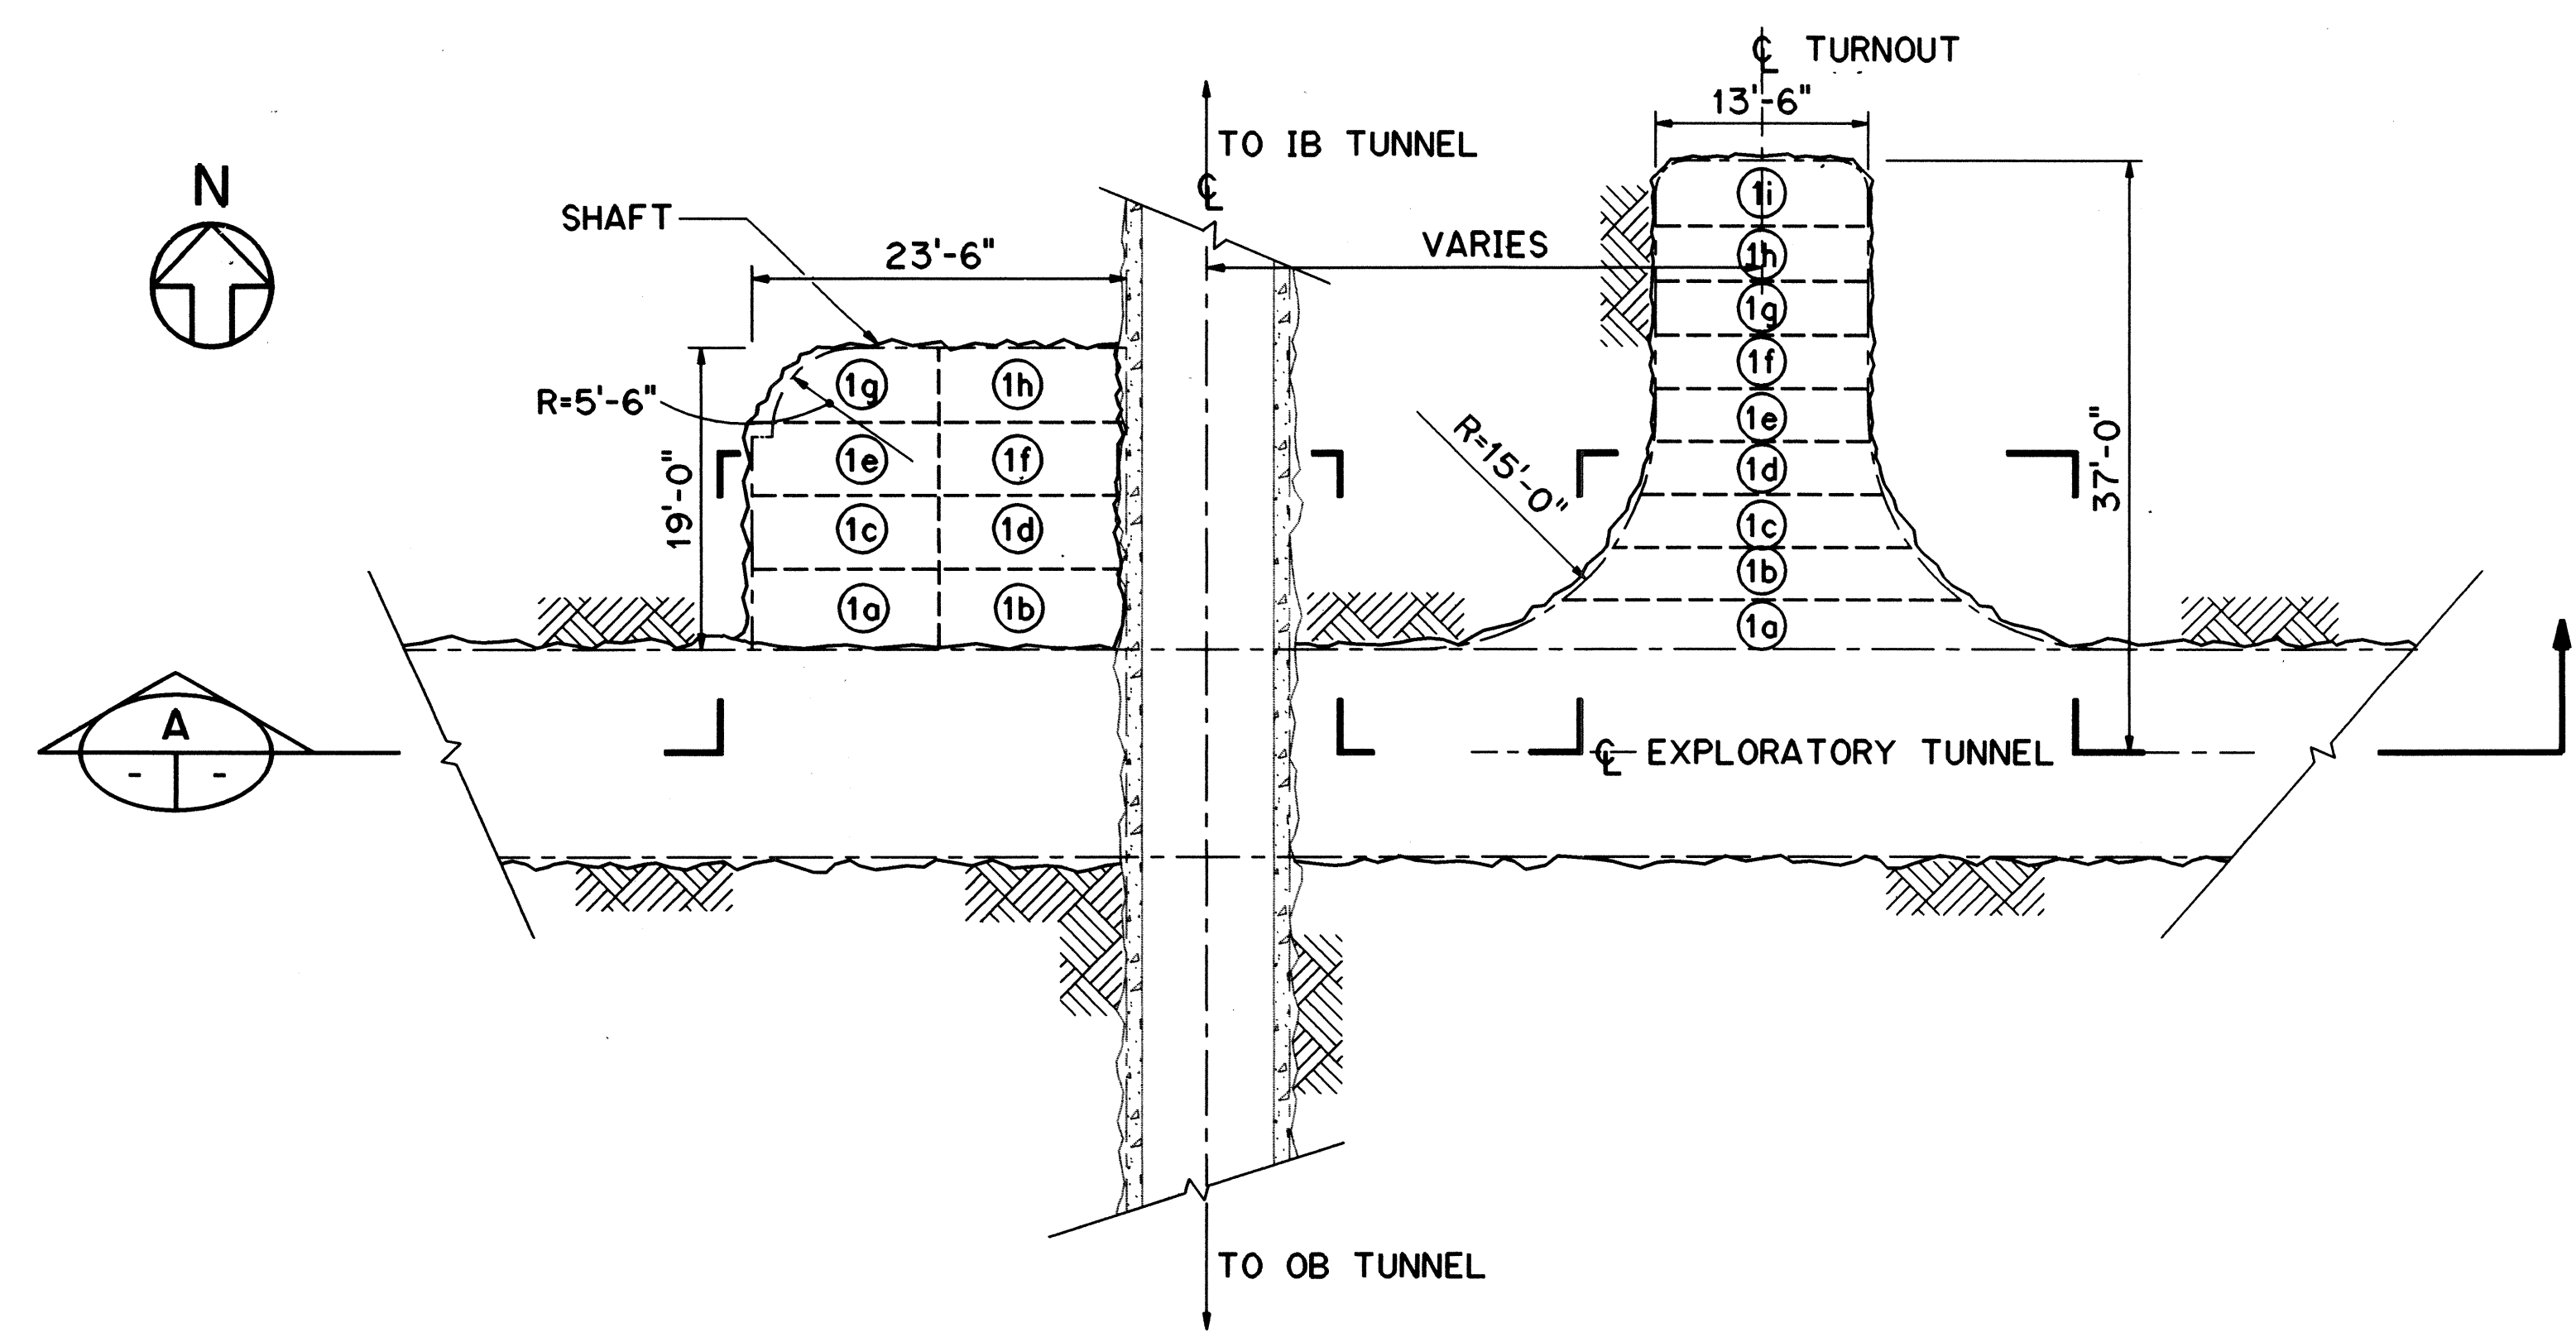



STAGE 1 - EXCAVATE AND SUPPORT ALCOVE AND TURNOUT AT EXPLORATORY TUNNEL LEVEL

PLAN


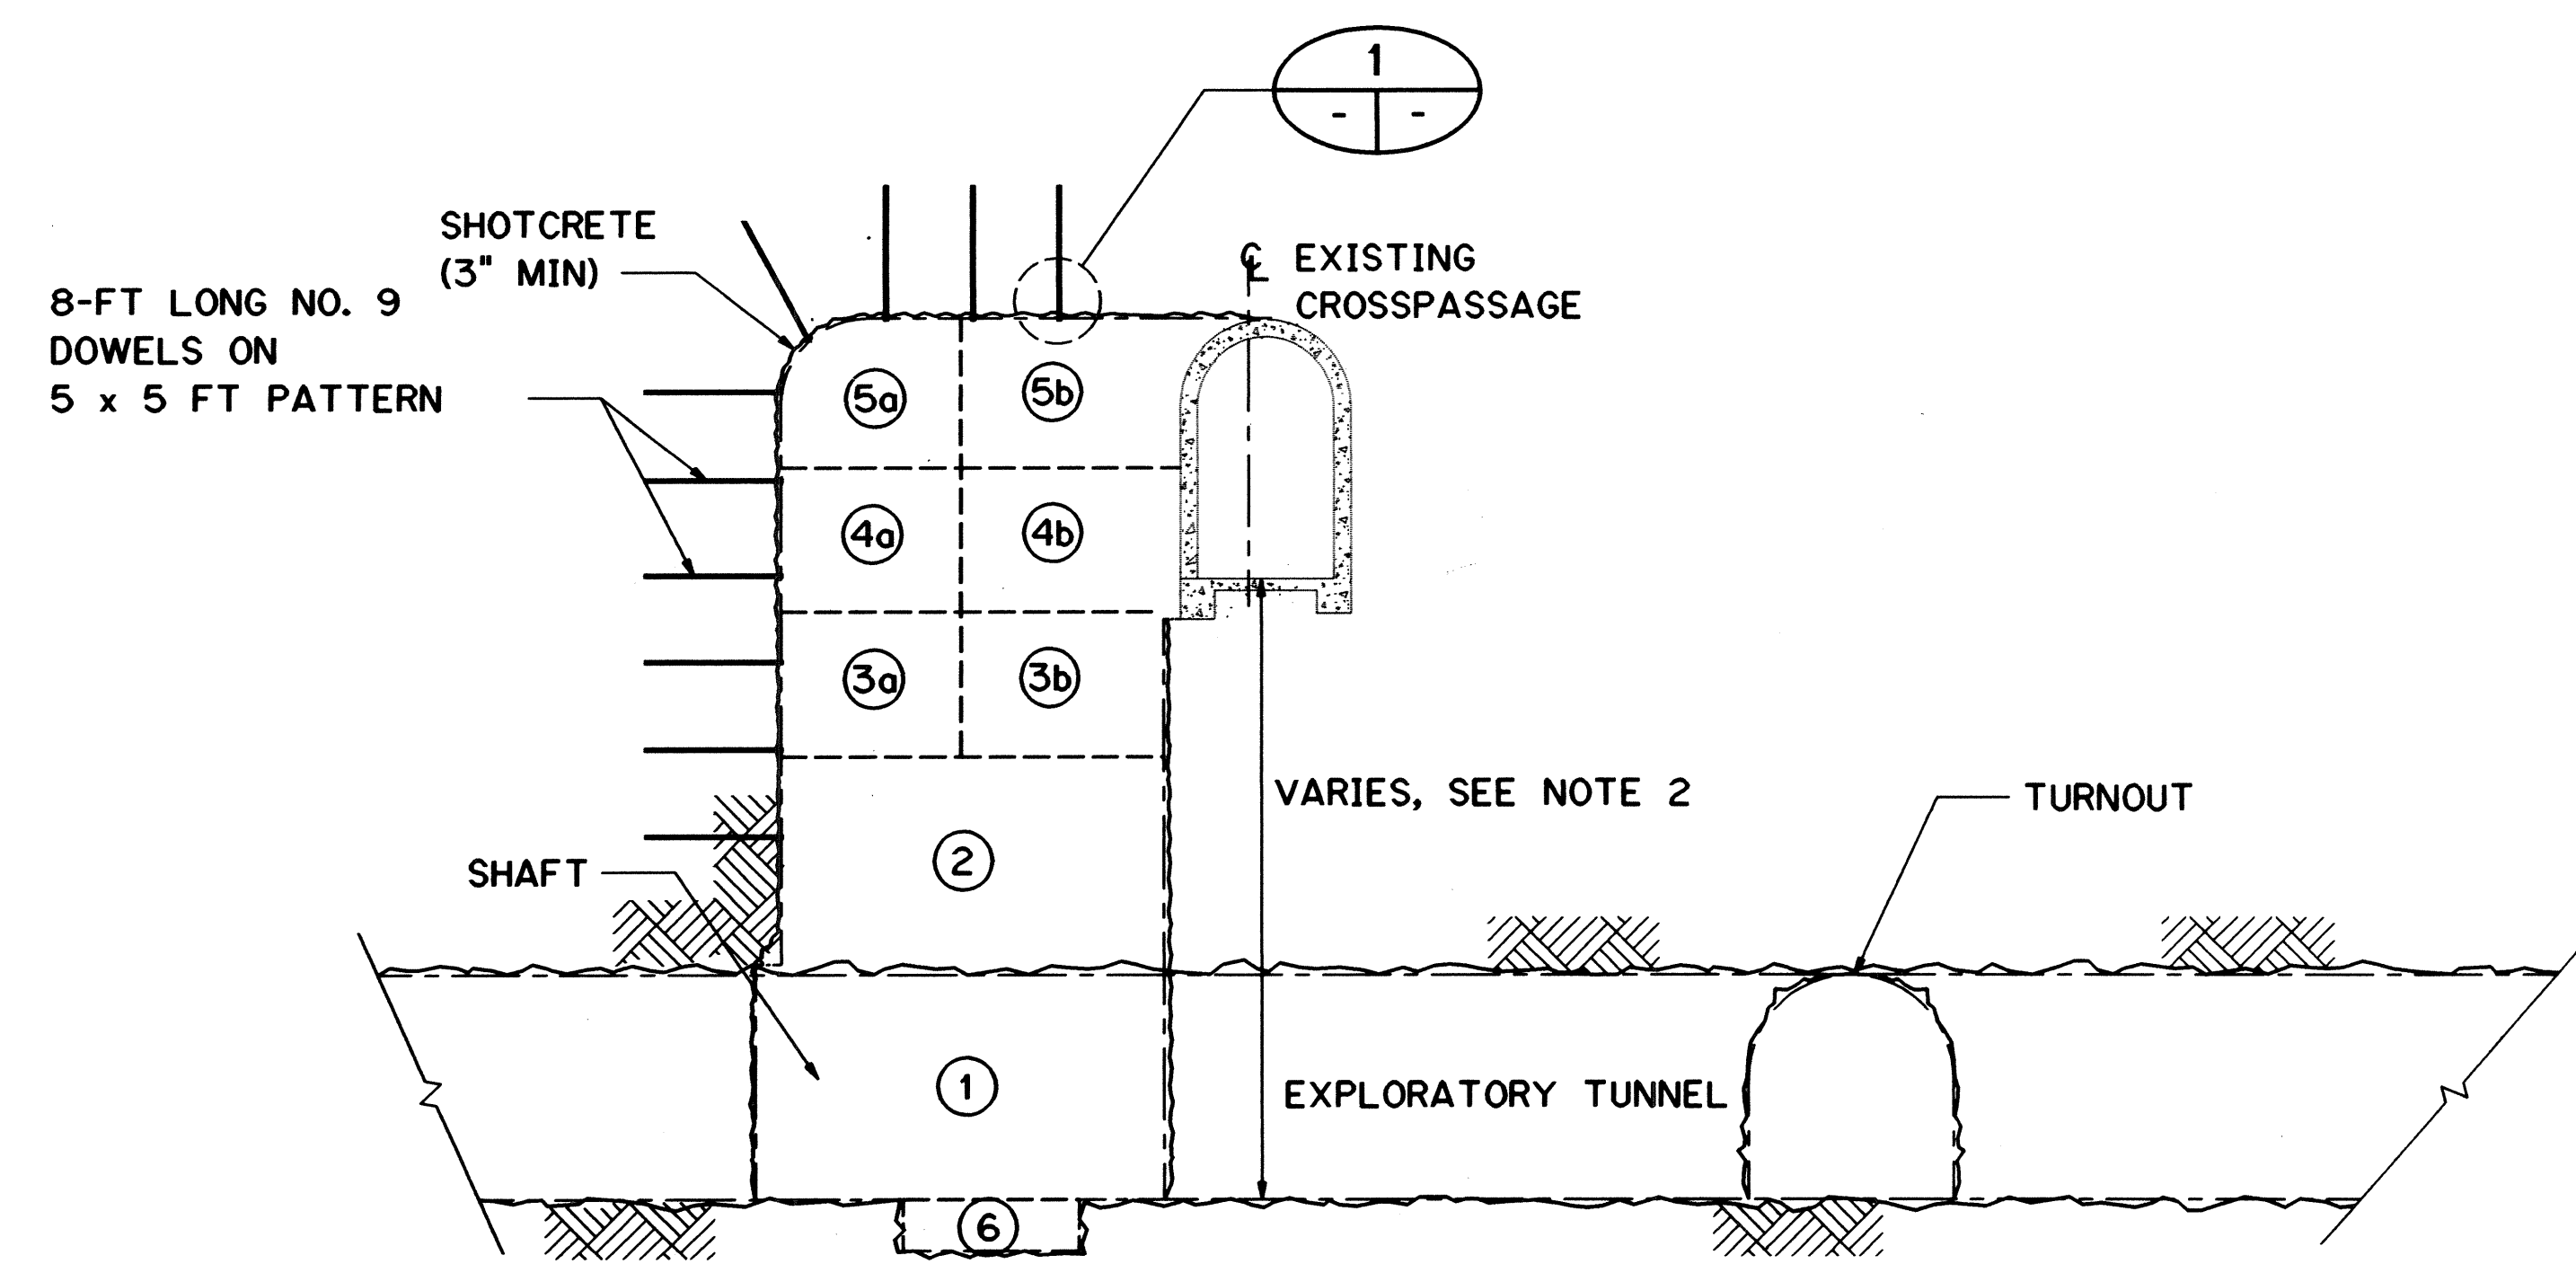


STAGE 2 - EXCAVATE AND SUPPORT VERTICAL SHAFT ABOVE EXPLORATORY TUNNEL LEVEL

SECTION

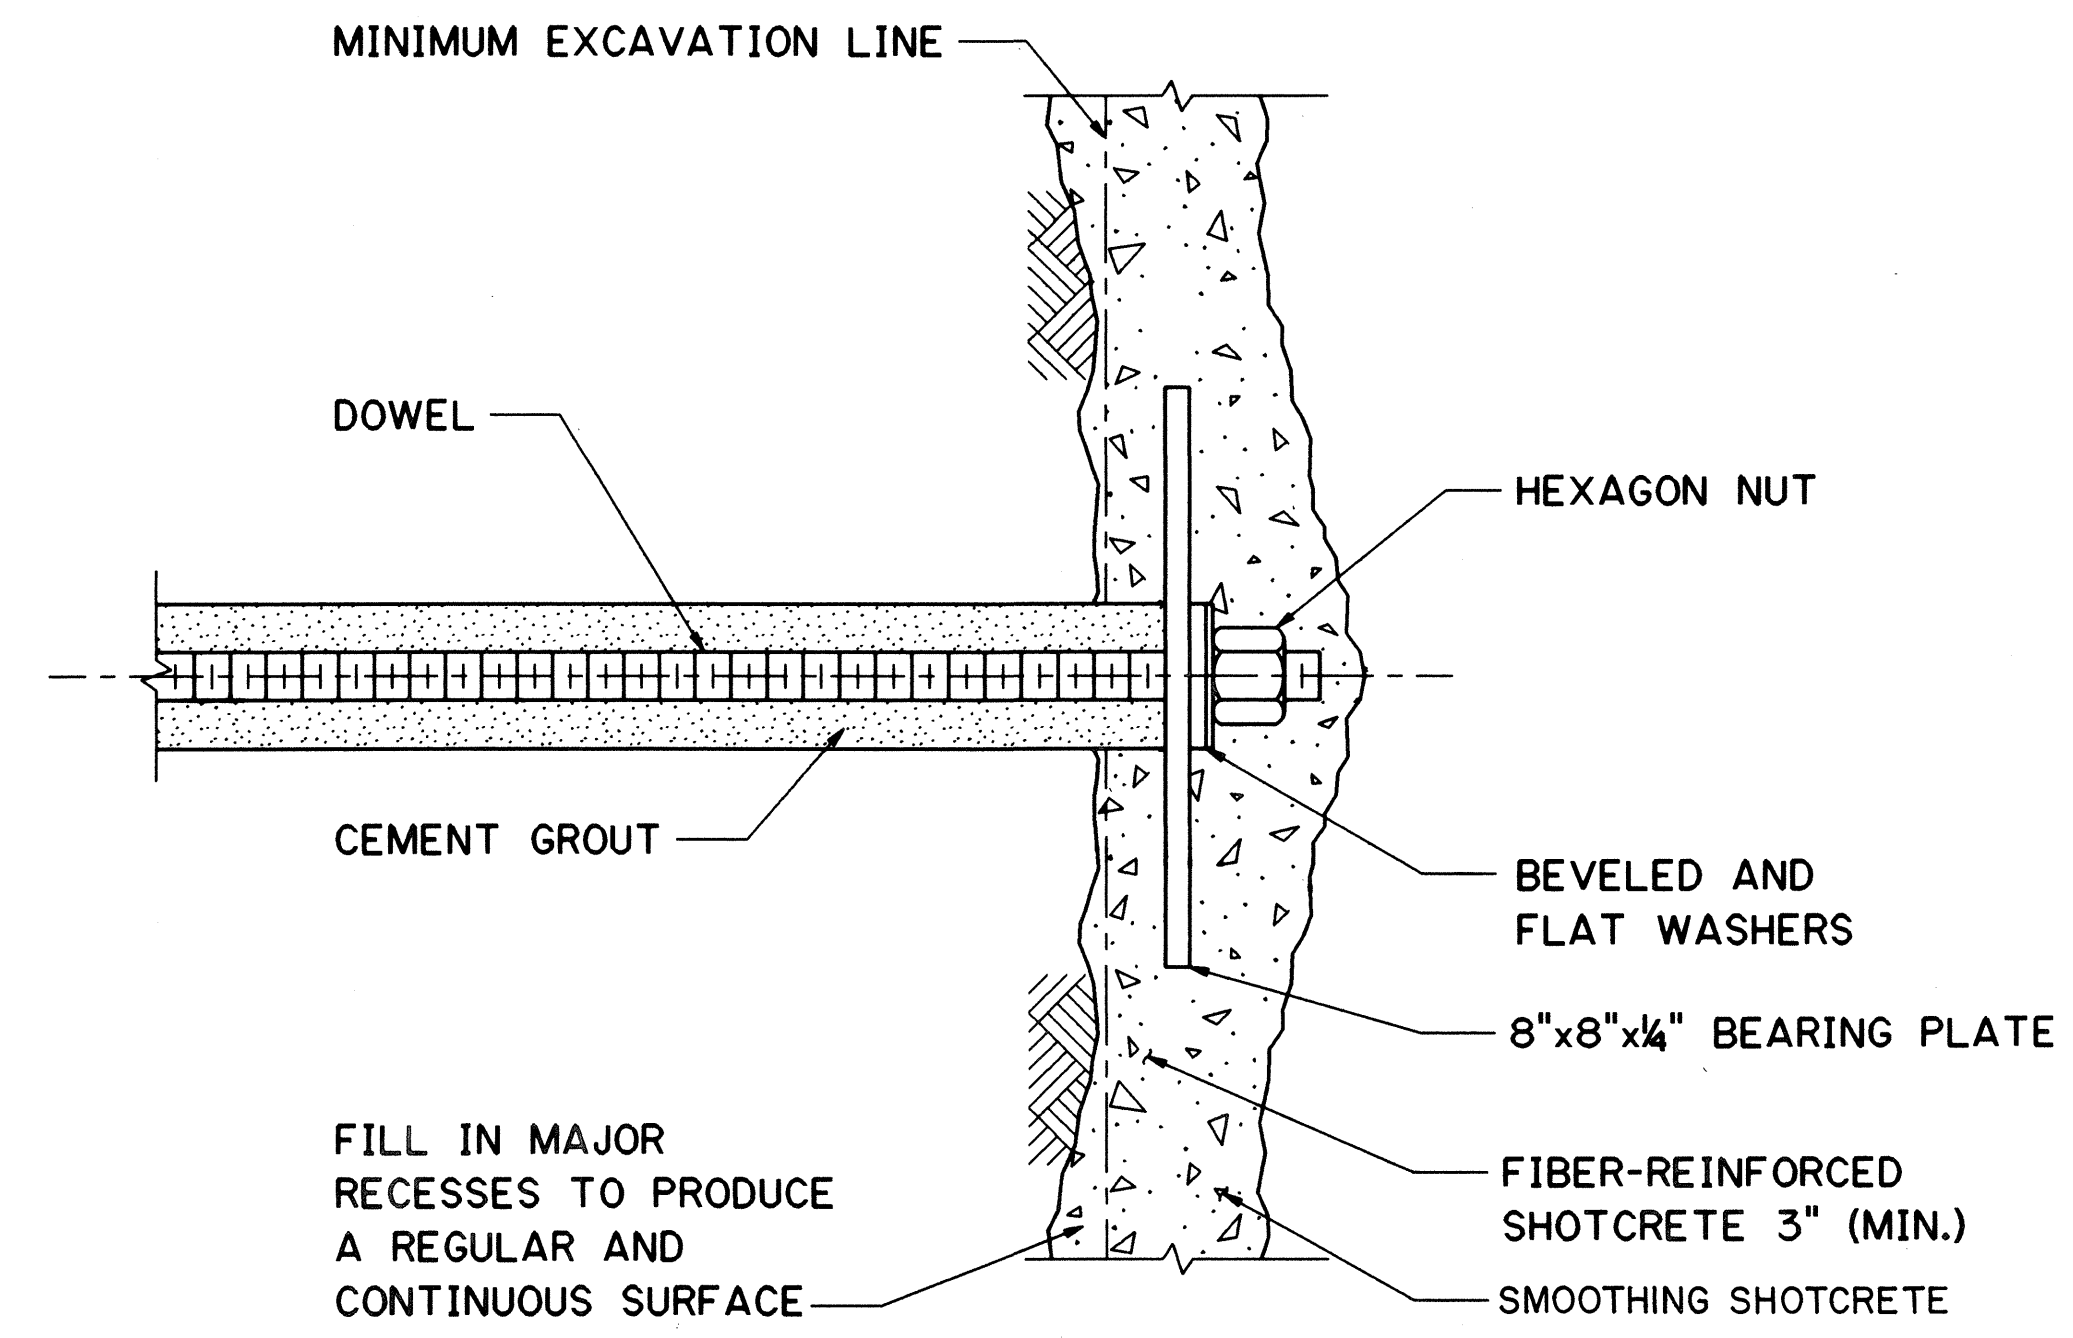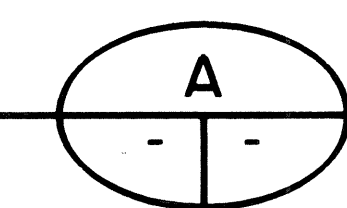

DETAIL

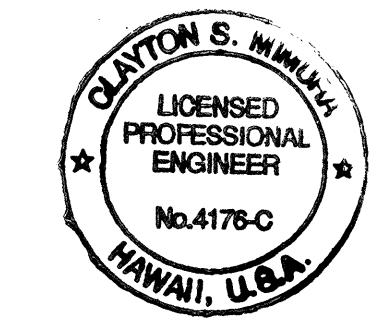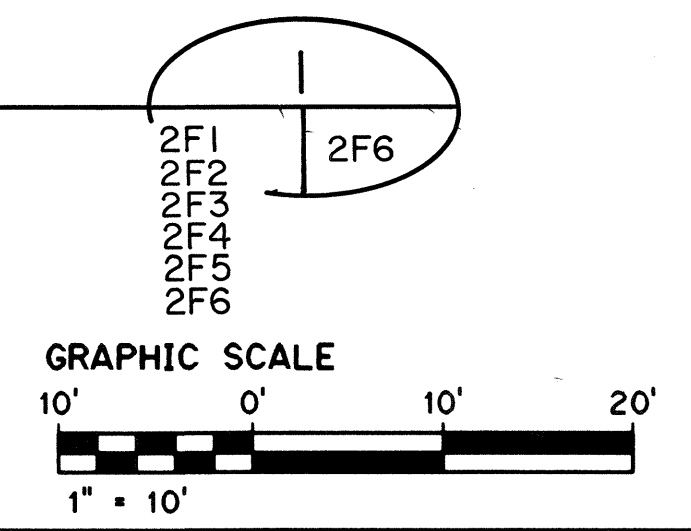

THIS WORK WAS PREPARED BY ME OR UNDER MY SUPERVISION
Clayton S. Waiwale

EXCAVATION NOTES:

1. STAGED EXCAVATION IS REQUIRED.
2. SEE GENERAL ARRANGEMENT PLANS FOR CLEARANCE BETWEEN EXPLORATORY TUNNEL AND CROSSPASSAGES.
3. EXCAVATION (5'x5'x3.5') FOR SUMP NOT SHOWN, SEE SHEET NO. 2S13 FOR SUMP DETAIL.

LEGEND:

- ① EXCAVATION STAGE


DATE	REVISION
10/27/95	ADDENDUM 2- CHANGED SECOND LAYER TO SMOOTHING SHOTCRETE IN DETAIL I
10/13/95	ADDENDUM I
STATE OF HAWAII DEPARTMENT OF TRANSPORTATION HIGHWAYS DIVISION SUGGESTED EXCAVATION & SUPPORT SEQUENCE EXPLORATORY TUNNEL IMPROVEMENTS H-3 FINISH (UNIT III) FAIP NO. I-H3-1(75), UNIT III T.K. TUNNEL/ACCESS ROADS	
SCALE: 1" = 10'	DATE: JUN 1995
SHEET NO. 2F6 OF 13 SHEETS	

DATE	JAN 95
SAVED BY	A. KOREMACHER
TRACED BY	D. OYENGA
QUANTITIES BY	G. BOYCE
CHECKED BY	JAN 95
ORIGINAL PLAN	
NOTE BOOK	
NO.	

FED. ROAD DIST. NO.	STATE	FED. AID PROJ. NO.	FISCAL YEAR	SHEET NO.	TOTAL SHEETS
HAWAII	HAW.	I-H3-1(75) UNIT III	1994	38	353


NOTES:

- GROUND SUPPORT SELECTION FOR THE EXISTING EXPLORATORY TUNNEL WAS MADE IN THE HEADING DURING CONSTRUCTION AND CONSISTS OF THE FOLLOWING TYPES:
 - TYPE A NO SUPPORT
 - TYPE B CROWN SHOTCRETE AND DOWELS
 - TYPE C FULL-PERIMETER SHOTCRETE AND DOWELS
- SEE:
 - FAIP NO. I-H3-1(64)
 - GEOLOGY AND CONSTRUCTION HISTORY SUMMARY, HALAWA & HAIKU APPROACH AND TUNNELS
 - TRANS-KOOLAU EXPLORATORY TUNNEL HALAWA APPROACH AND TUNNELS GEOLOGY
 - TRANS-KOOLAU EXPLORATORY TUNNEL HAIKU APPROACH AND TUNNELS GEOLOGY
- WATERPROOFING MEMBRANE SHALL CONFORM TO THE ROCK. NO DRAPING OR LOOSE MEMBRANE WILL BE ALLOWED.
- SPACE DISK ATTACHMENTS IN ACCORDANCE WITH THE SPECIAL PROVISIONS.
- FOR THE PORTION OF THE EXPLORATORY TUNNEL WITH EXISTING TYPE C GROUND SUPPORT (STA. 10+68 TO STA. 14+88), THE CONTRACTOR SHALL:
 - TRIM TUNNEL TIGHTS, TRIM TUNNEL SIDES, AND REMOVE THE EXISTING CONCRETE INVERT. TUNNEL SIDES SHALL BE TRIMMED IN SECTIONS; EACH SECTION SHALL NOT BE GREATER THAN 10 FT.
 - INSTALL NEW SHOTCRETE PRIOR TO PLACING TUNNEL WATERPROOFING.
- IN AREAS WHERE NO SHOTCRETE WAS USED FOR GROUND SUPPORT AND FULL PERIMETER WATERPROOFING IS REQUIRED, A 1-INCH MINIMUM LAYER OF SHOTCRETE SHALL BE PLACED FOR INSTALLATION OF THE WATER-PROOFING MEMBRANE.
- SMOOTHING SHOTCRETE REQUIRED TO MEET SHOTCRETE SMOOTHNESS CRITERIA.
- THE WATERPROOFING MEMBRANE WITHIN THE EXPLORATORY TUNNEL SHOULD BE WELDED TO THE CROSSPASSAGE CONNECTION WATERPROOFING MEMBRANE WHENEVER THE TWO COINCIDE.

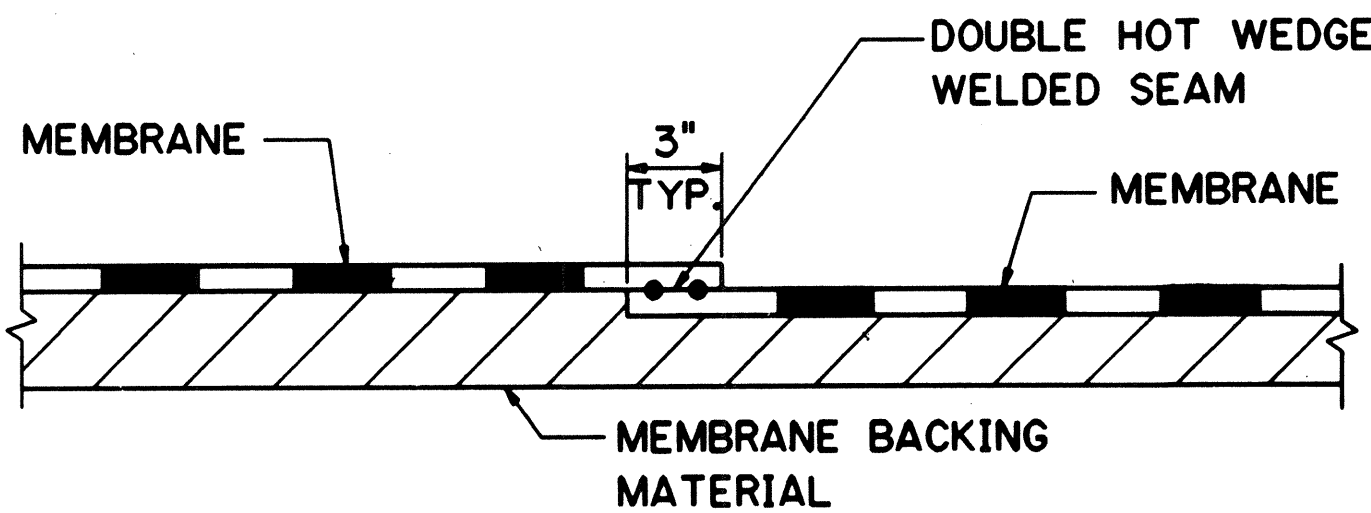

WATERPROOFING MEMBRANE JOINT DETAIL


N.T.S.

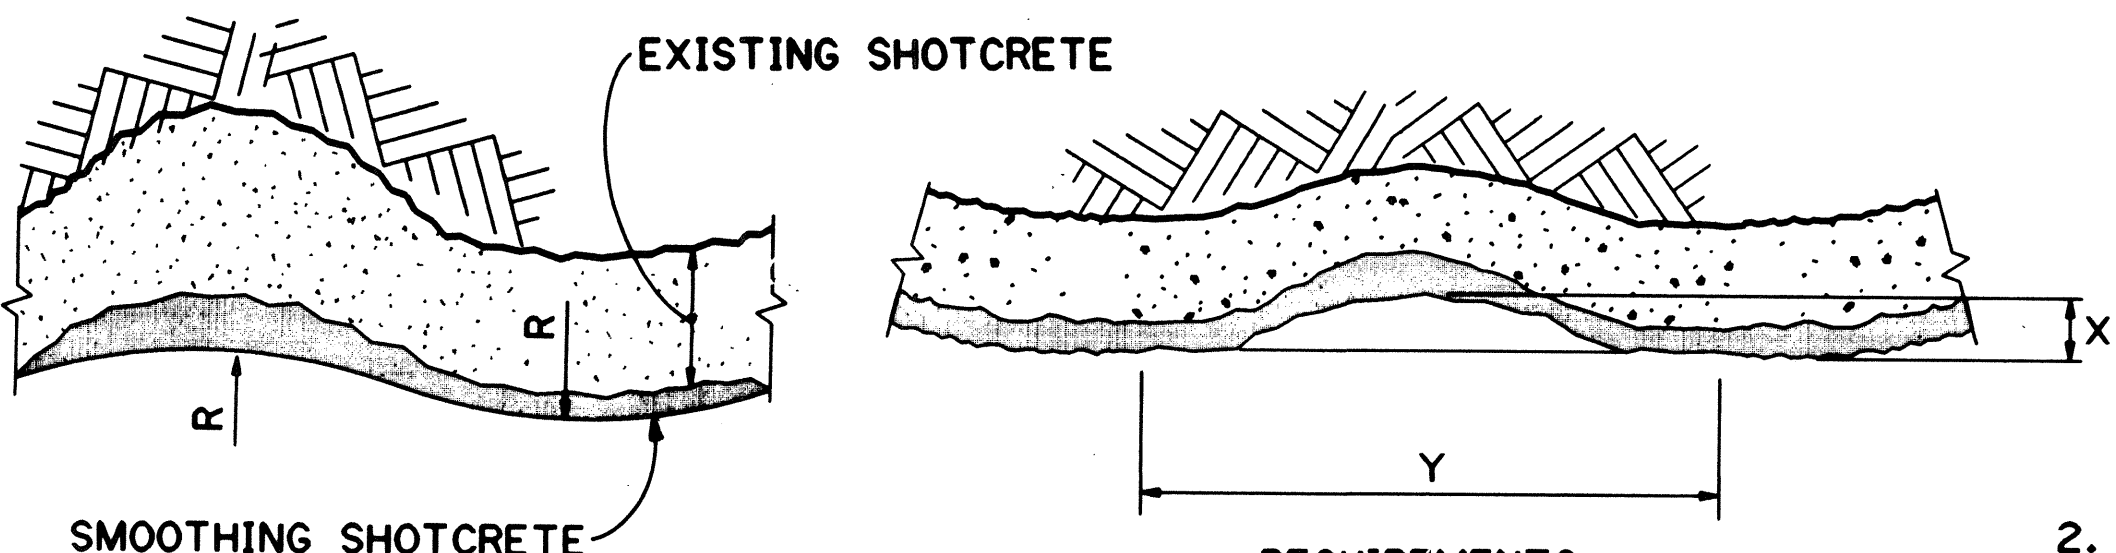

SHOTCRETE SMOOTHNESS CRITERIA


N.T.S.

- REQUIREMENTS**
- $R \geq 12"$
 - $X \leq 12"$; $X \leq \frac{Y}{5}$

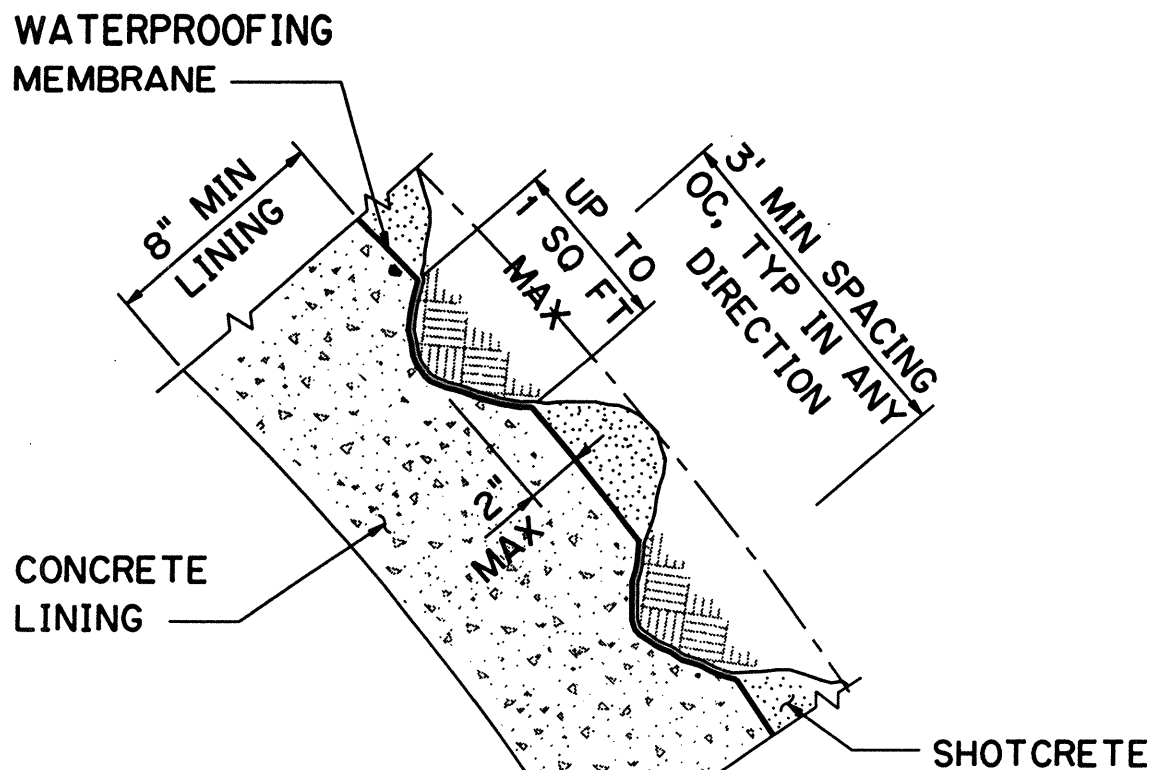




TIGHT AREA & TRIMMING ACCEPTANCE CRITERIA

NO SCALE

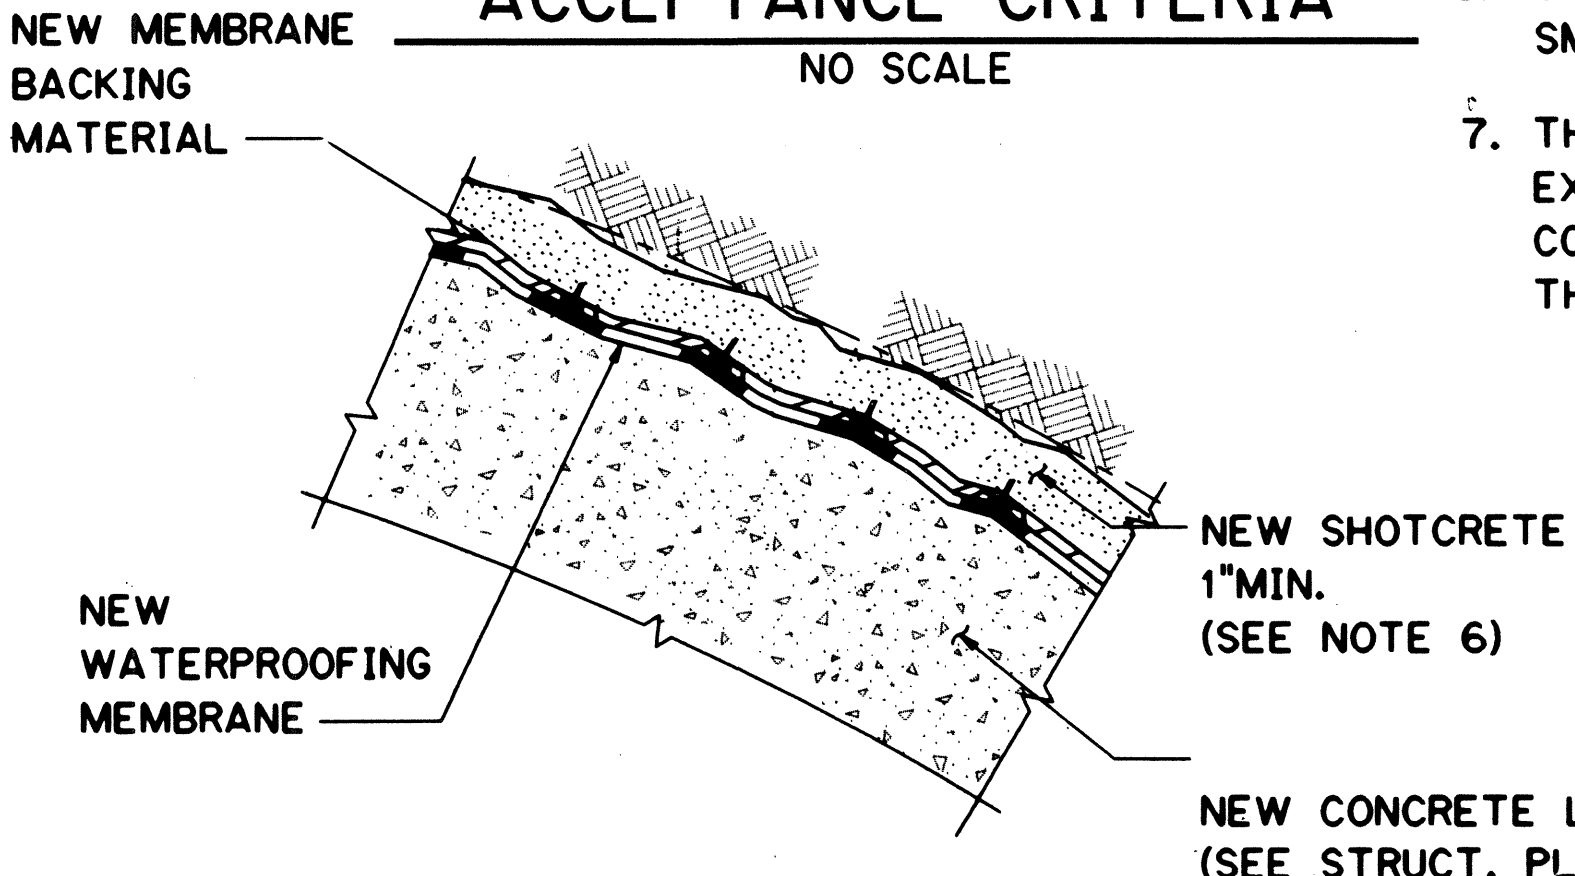


TREATMENT IN PORTIONS OF TUNNEL SUPPORT TYPE A

DETAIL N.T.S.

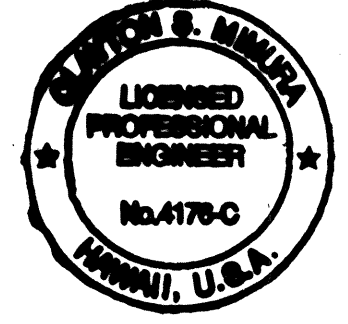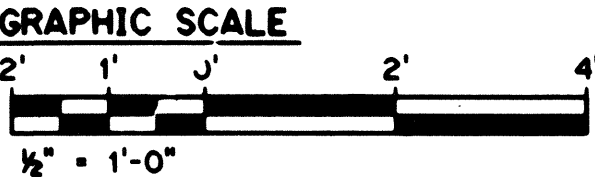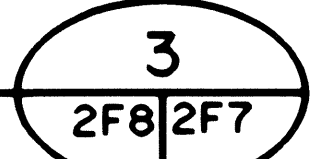


THIS WORK WAS PREPARED BY ME OR UNDER MY SUPERVISION
Clayton S. Furumasa

10/27/95	ADDENDUM 2- ADDED 'TIGHT AREA & TRIMMING ACCEPTANCE CRITERIA'
10/13/95	ADDENDUM 1
DATE	REVISION
STATE OF HAWAII DEPARTMENT OF TRANSPORTATION HIGHWAYS DIVISION TUNNEL WATERPROOFING EXPLORATORY TUNNEL IMPROVEMENTS H-3 FINISH (UNIT III) FAIP NO. I-H3-1(75), UNIT III T.K. TUNNEL/ACCESS ROADS SCALE: AS NOTED DATE: JUN 1995	
SHEET NO. 2F7 OF 13 SHEETS	

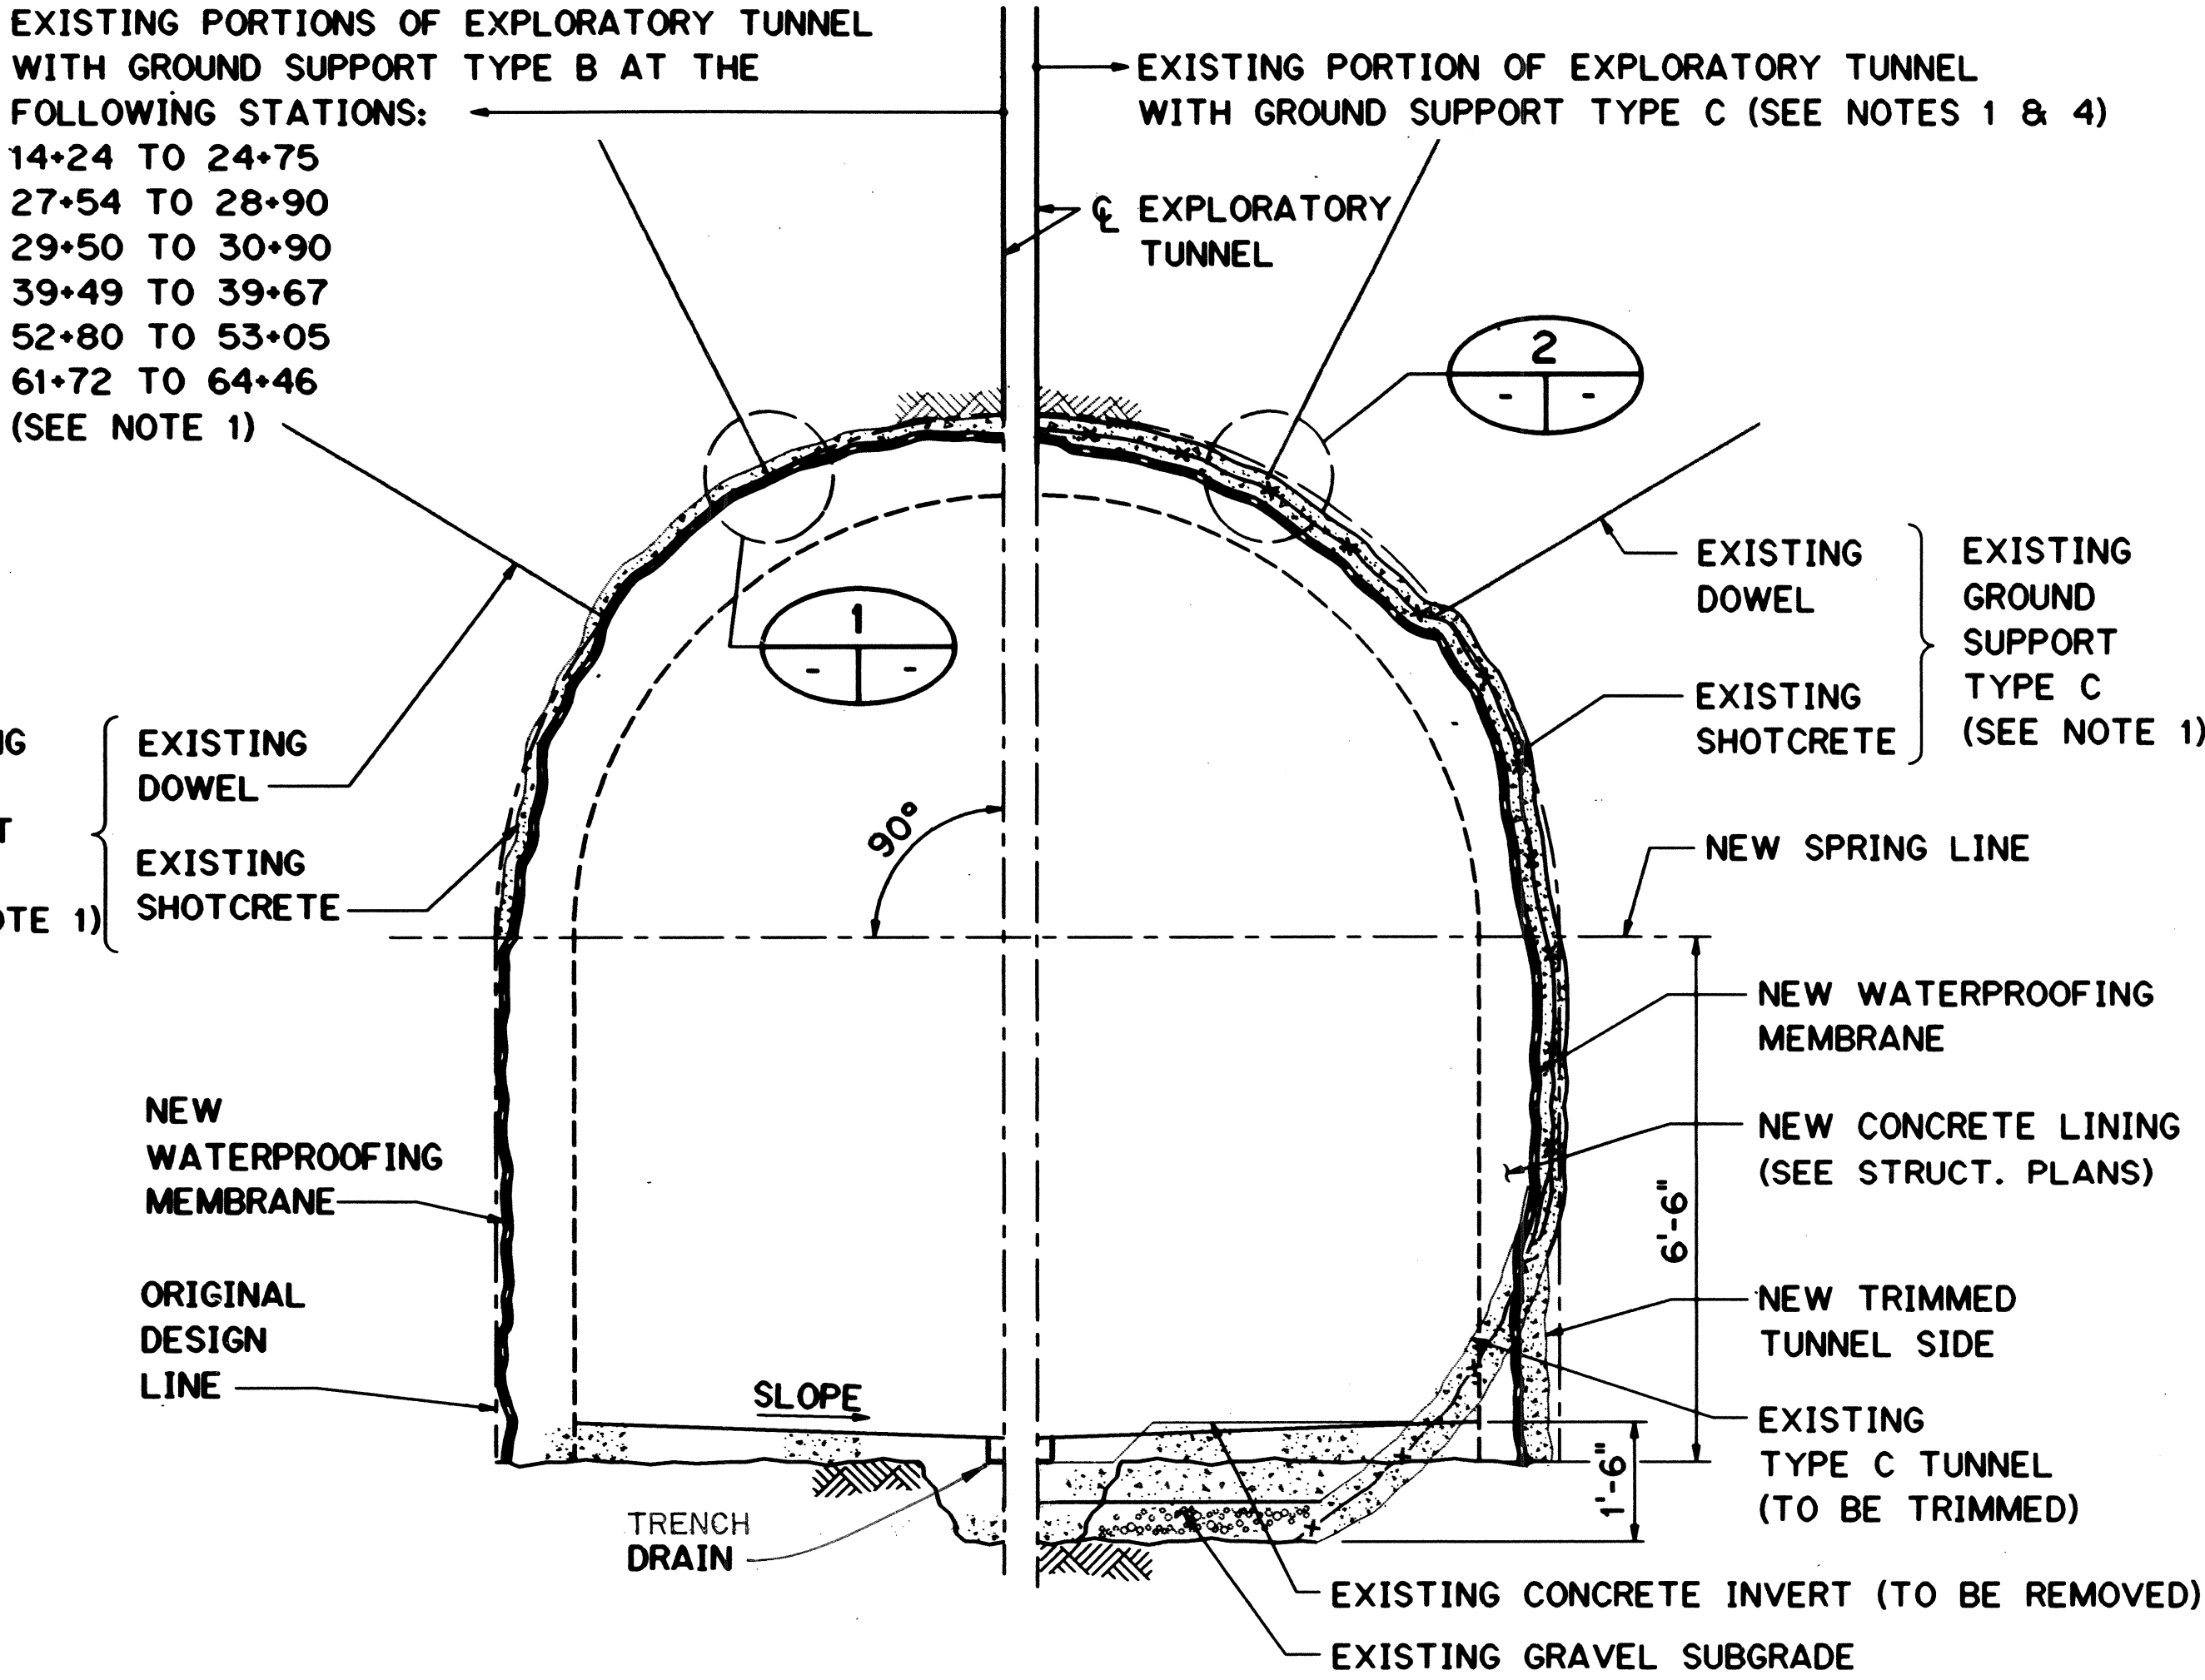



EXPLORATORY TUNNEL WATERPROOFING

SCALE: 1/2" = 1'-0"

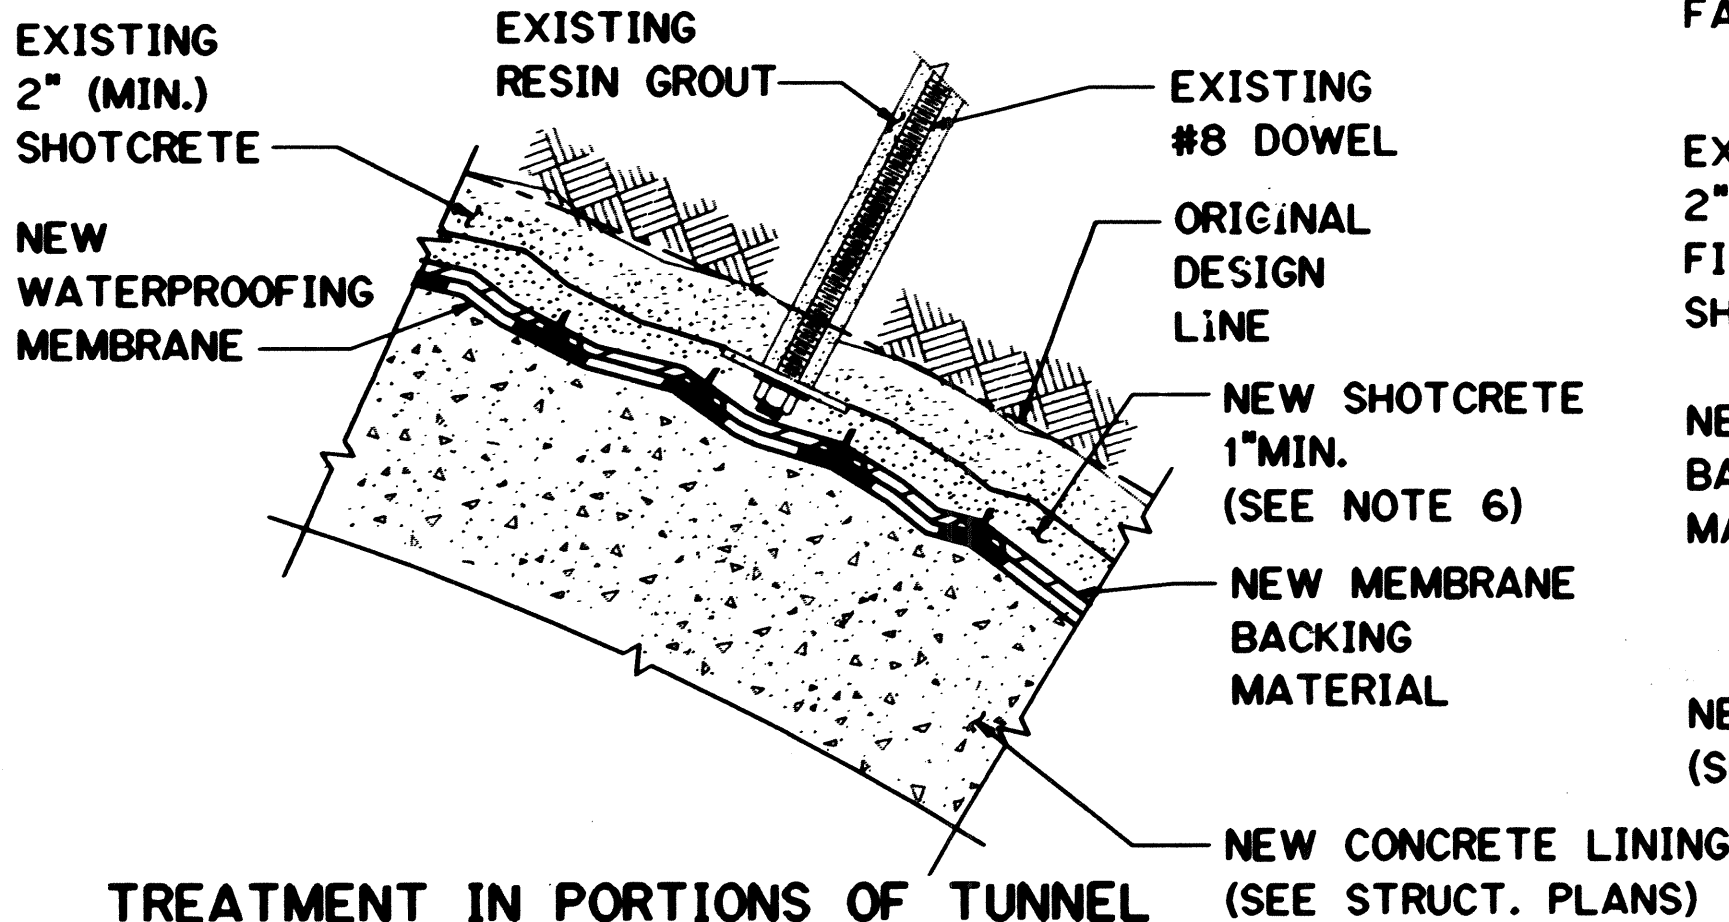


TREATMENT IN PORTIONS OF TUNNEL SUPPORT TYPE B

DETAIL N.T.S.

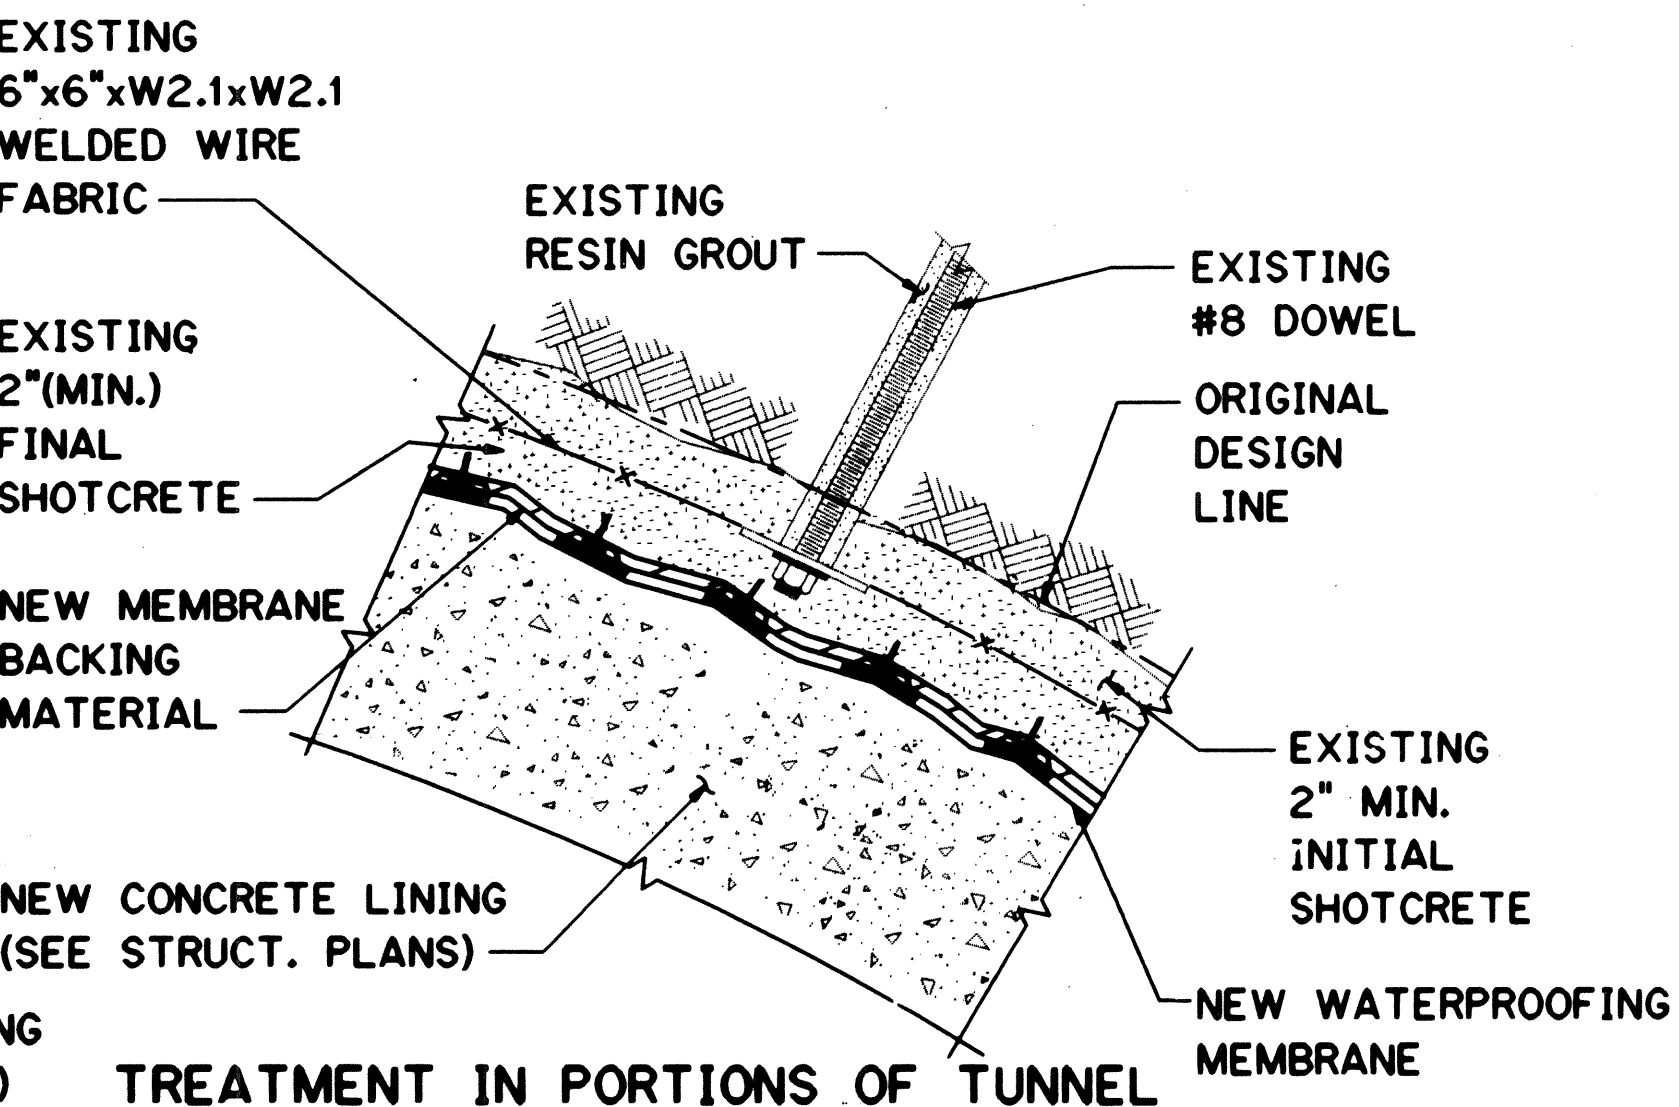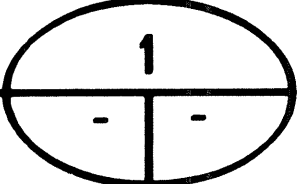

TREATMENT IN PORTIONS OF TUNNEL SUPPORT TYPE C

DETAIL N.T.S.

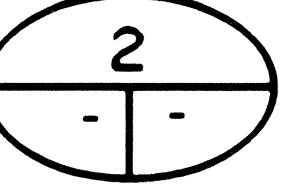


SURVEY PLOTTED BY	DATE
DRAWN BY	JAN 95
CHECKED BY	JAN 95
NOTE BOOK	JAN 95
NO.	

FED. ROAD DIST. NO.	STATE	FED. AID PROJ. NO.	FISCAL YEAR	SHEET NO.	TOTAL SHEETS
HAWAII	HAW.	1-H3-1(75) UNIT III	1994	39	353

NOTES:

- SEE SHT. NOS. 2C1, 2C2 AND 2C3, FOR GENERAL PLAN.
- SEE SHT. NO. 2C4, FOR ALIGNMENT PLAN AND PROFILE.
- SEE SHT. NO. 2C14, FOR AS-BUILT SURVEY DATA.
- SEE SHT. NO. 2S5 FOR DETAILS OF PASSING POCKET LINING.
- WATERPROOFING SHALL FOLLOW THE DETAILS SHOWN ON SHT. NO. 2F7 DEPENDING ON EXISTING GROUND SUPPORT TYPE (A, B OR C) INSTALLED IN THE PASSING POCKET.


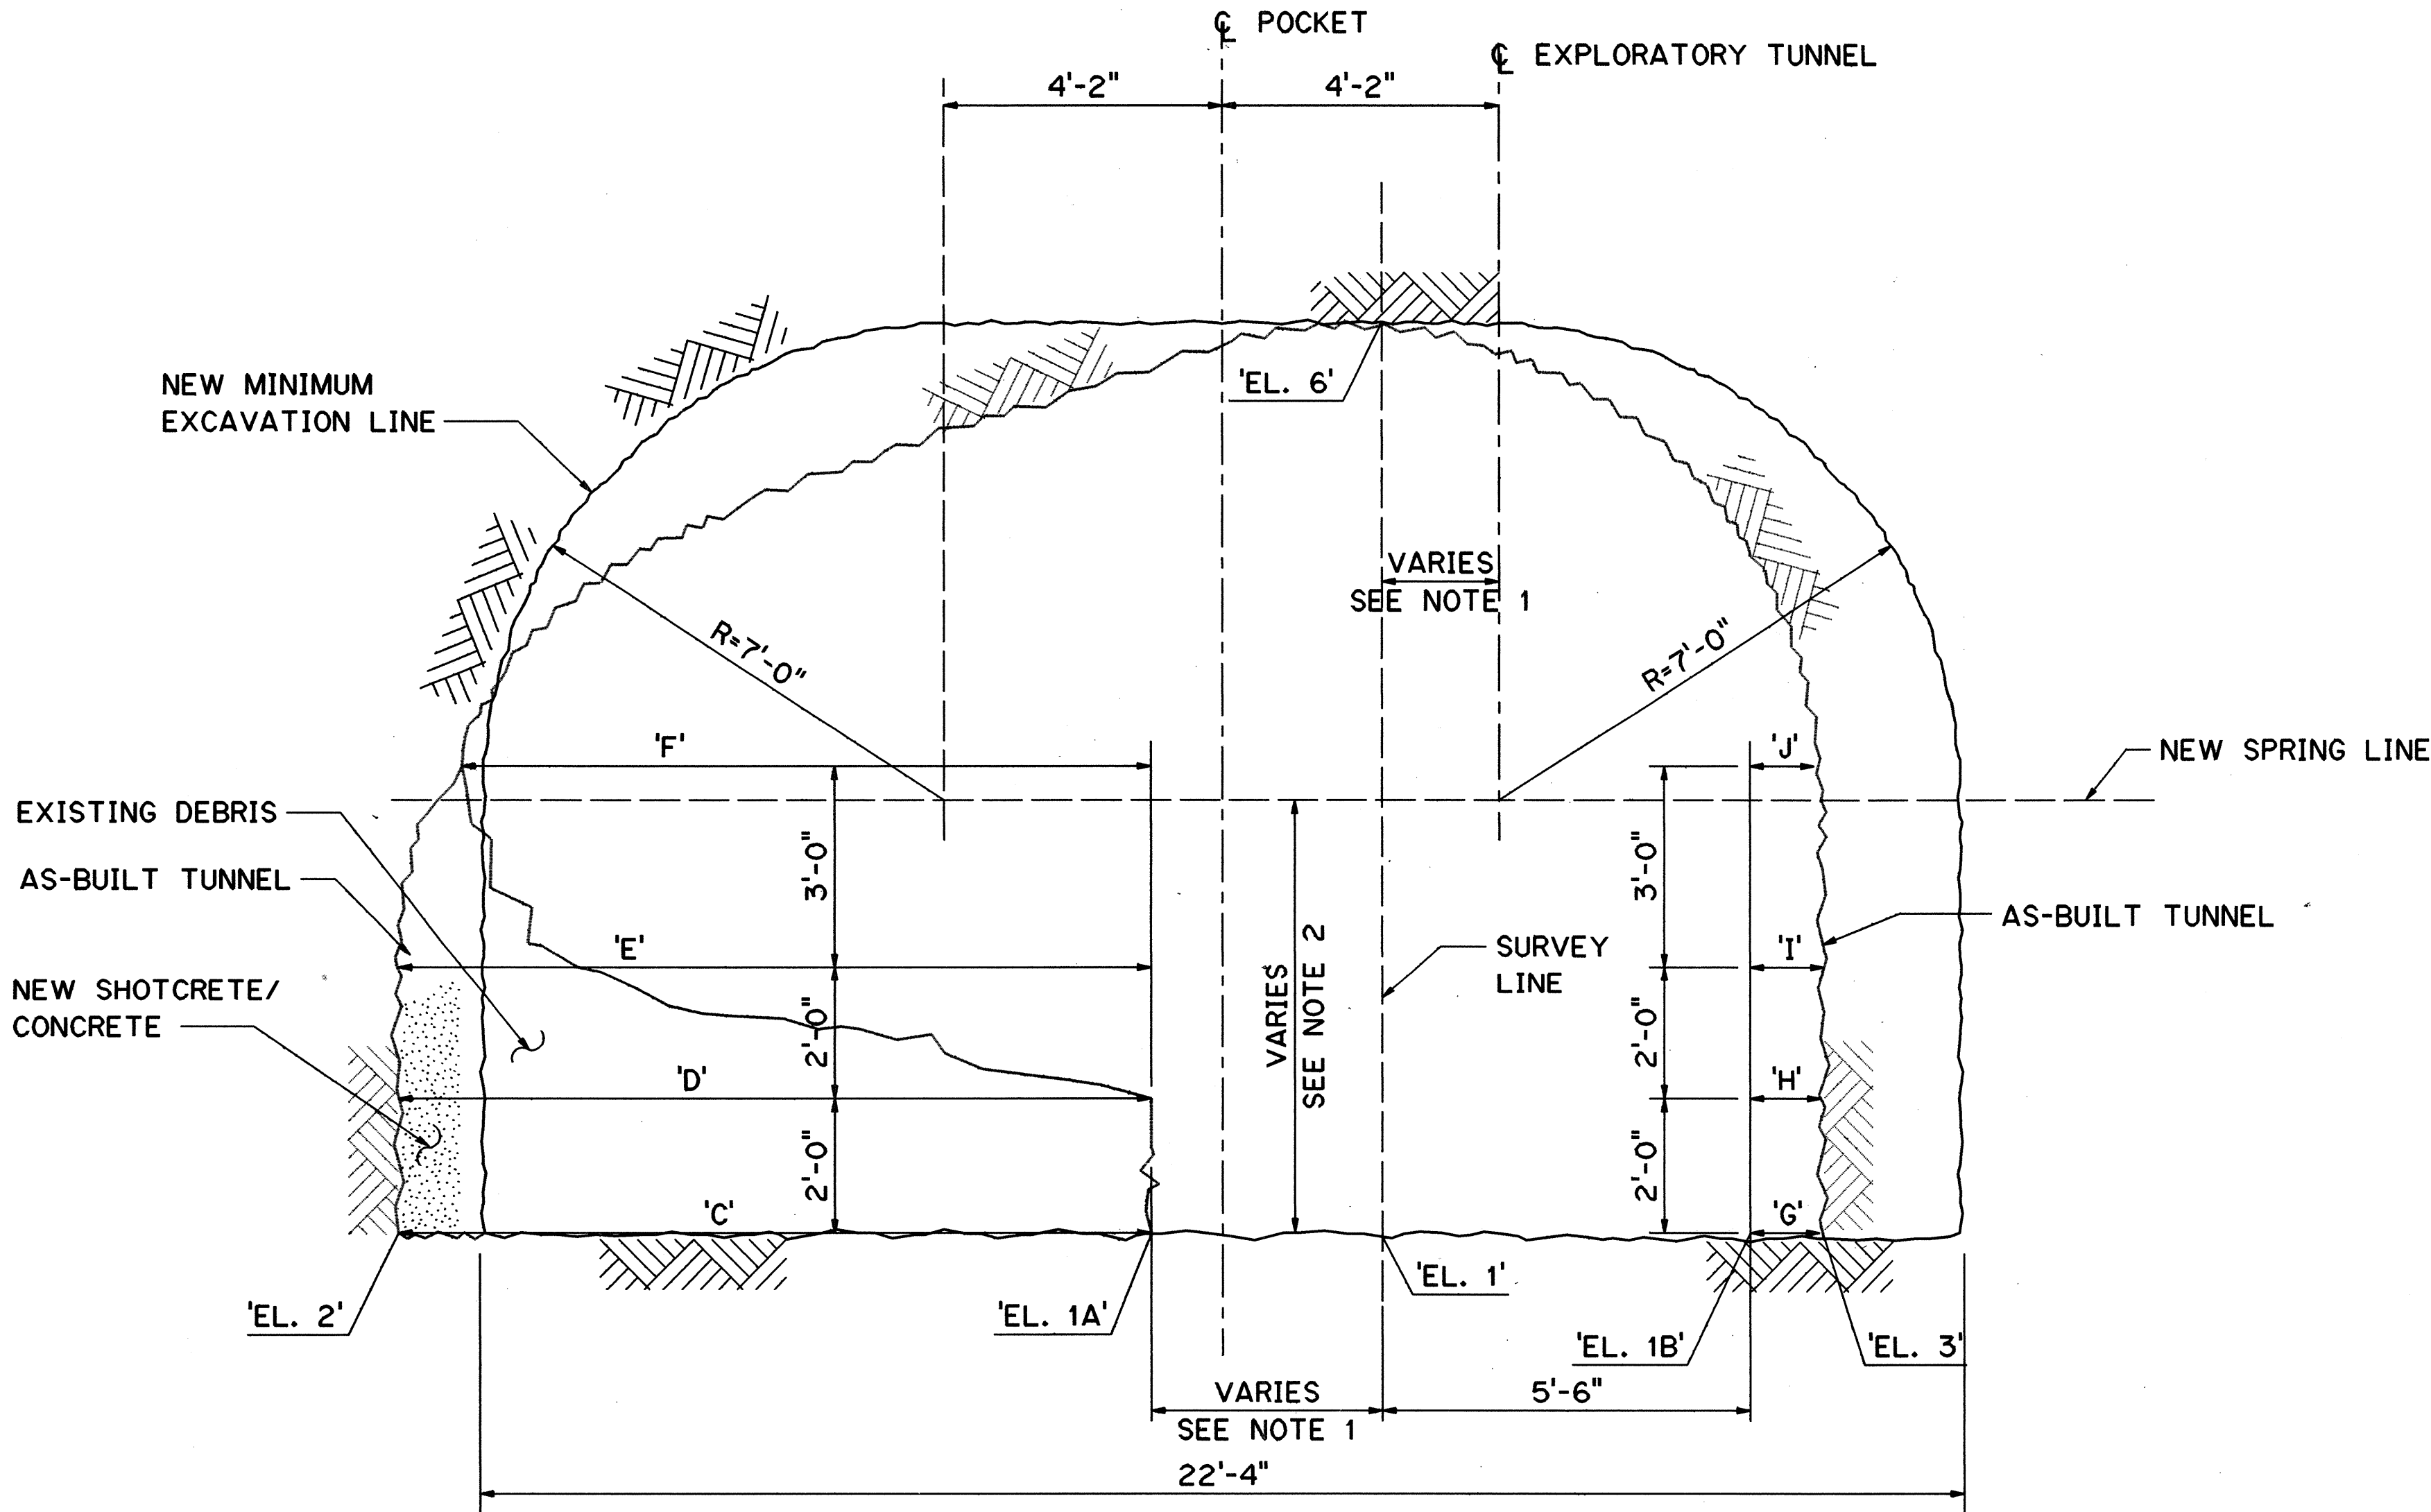


SECTION OF PASSING POCKET NO. 1
STA. 24+63 TO 25+23 (LEFT SIDE)

AS-BUILT DATA SCHEDULE

STA.	EL. 1	EL. 1A	EL. 1B	EL. 2	EL. 3	EL. 6	C	D	E	F	G	H	I	J
24+60	1017.28	1017.48	1017.21	1017.56	1016.89	1031.79	1.15	1.40	0.32	0.50	2.58	3.86	3.25	3.35
24+70	1017.63	1017.83	1017.40	1017.99	1017.22	1031.69	2.96	3.28	4.15	4.67	2.90	3.36	3.60	3.75
24+80	1017.89	1017.92	1017.70	1018.20	1017.67	1033.02	5.50	6.38	7.30	6.05	1.82	2.88	3.27	2.92
24+90	1017.95	1018.43	1017.76	1018.43	1017.71	1032.44	0.00	0.00	9.45	7.55	2.02	2.80	2.77	3.00
25+00	1017.84	1018.04	1017.69	1018.04	1017.67	1032.13	0.00	0.00	11.30	10.35	1.77	2.75	3.13	2.79
25+10	1017.69	1017.96	1017.54	1017.96	1017.39	1032.71	0.00	0.00	10.95	8.24	2.42	2.72	3.02	2.93
25+20	1017.67	1017.84	1017.42	1017.84	1017.10	1032.46	0.00	0.00	9.82	9.10	2.80	3.30	3.45	3.35
25+25	1017.67	1018.26	1017.42	1018.26	1017.24	1032.34	0.34	0.38	0.54	0.25	2.45	3.43	3.60	3.70

DATE	JAN 95
SURVEY PLOTTED BY	A. KORMACHER
DRAWN BY	D. OYENUGA
NOTED BY	G. BOYCE
CHECKED BY	
NO.	

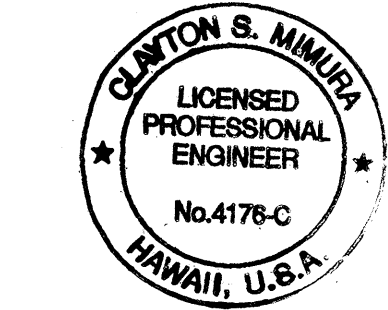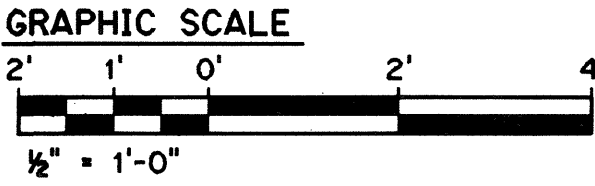

THIS WORK WAS PREPARED BY ME
OR UNDER MY SUPERVISION
Clayton S. Minura

DATE	REVISION

STATE OF HAWAII
DEPARTMENT OF TRANSPORTATION
HIGHWAYS DIVISION

PASSING POCKET
NO.1 CONNECTION
EXPLORATORY TUNNEL IMPROVEMENTS
H-3 FINISH (UNIT III)
FAIP NO. 1-H3-1(75), UNIT III
T.K. TUNNEL/ACCESS ROADS

SCALE: 1/2" = 1'-0" DATE: JUN 1995

SHEET NO. 2F8 OF 13 SHEETS

NOTE:
SEE SHEET NO. 2F8 FOR NOTES.




STA.	EL. 1	EL. 1A	EL. 1B	EL. 2	EL. 3	EL. 6	C	D	E	F	G	H	I	J
43+10	926.53	925.35	926.46	926.23	926.79	939.81	0.45	1.05	1.77	1.45	3.22	3.40	3.20	3.18
43+20	925.53	925.35	925.81	925.35	926.38	940.09	0.95	1.50	1.50	1.60	5.20	6.40	7.68	8.45
43+30	924.83	924.90	924.84	924.90	925.18	939.48	0.20	1.13	0.97	0.80	13.05	13.00	12.86	11.85
43+40	924.06	924.16	924.17	924.39	924.56	938.60	1.20	2.20	1.98	1.15	12.91	13.25	13.32	11.80
43+50	923.21	923.13	923.53	923.13	923.34	938.02	1.00	1.25	1.57	0.35	12.30	12.72	13.20	12.60
43+60	922.41	922.08	922.72	922.08	922.74	935.78	1.10	1.20	1.23	0.65	10.35	11.32	12.10	11.97
43+70	921.75	921.38	921.88	921.38	922.25	934.16	0.55	0.96	1.10	0.30	8.40	8.77	10.00	8.00
43+80	920.94	920.47	921.15	920.47	921.23	933.89	0.68	1.12	0.98	1.40	6.87	6.87	6.89	5.90
43+90	920.20	919.88	920.50	919.94	920.60	923.61	1.05	1.45	0.93	0.75	4.42	4.73	4.54	4.11
44+00	919.55	919.28	919.90	919.32	919.88	932.46	0.97	1.30	1.80	1.40	2.35	2.70	3.45	3.15

STATE OF HAWAII
DEPARTMENT OF TRANSPORTATION
HIGHWAYS DIVISION

PASSING POCKET
NO. 2 CONNECTION
EXPLORATORY TUNNEL IMPROVEMENTS
H-3 FINISH (UNIT III)
FAIP NO. 1-H3-1(75), UNIT III
T.K. TUNNEL/ACCESS ROADS

SCALE $\frac{1}{2}" = 1'-0"$ DATE: JUN 1999

SHEET NO. 2F9 OF 13 SHEETS

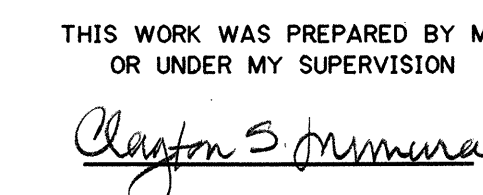

GRAPHIC SCALE

2' 1' 0' 2'

$\frac{1}{2}" = 1'-0"$

NOTE:
SEE SHT. NO. 2F8 FOR NOTES.




STA.	EL. 1	EL. 1A	EL. 1B	EL. 2	EL. 3	EL. 6	C	D	E	F	G	H	I	J
52+90	865.24	865.18	865.35	865.55	865.53	880.91	1.90	2.10	3.08	2.70	11.14	11.17	11.60	10.44
53+00	864.82	864.85	864.88	865.23	865.12	881.32	0.98	1.88	3.20	2.70	10.85	11.27	11.45	11.04
53+10	864.28	864.27	864.43	864.44	864.71	879.56	1.34	2.39	2.89	1.97	12.30	13.20	12.62	11.49
53+20	863.90	863.81	863.01	863.87	864.40	879.20	1.94	2.20	2.16	1.74	12.36	12.36	12.23	11.28
53+30	863.64	863.66	863.64	863.76	864.02	878.10	0.10	1.81	2.18	2.22	11.20	11.64	11.35	10.24
53+40	863.32	863.20	863.31	863.20	863.63	878.77	0.22	1.38	2.30	1.85	11.68	12.20	11.69	12.40
53+50	862.93	862.73	862.82	862.83	863.21	878.48	1.70	2.05	1.77	0.75	12.12	12.25	12.55	11.65
53+60	862.25	861.98	862.17	862.14	862.93	877.84	1.58	2.30	2.57	1.45	10.97	11.35	11.80	11.17
53+70	861.58	861.22	861.63	861.30	862.48	875.62	1.14	2.14	2.01	2.60	10.42	11.37	11.74	11.65
53+80	860.83	860.67	860.96	860.95	861.74	875.63	1.40	1.70	1.70	1.90	9.01	9.55	9.65	10.14
53+90	860.05	859.68	860.31	859.68	861.11	875.02	0.40	1.24	1.55	3.25	7.45	7.53	7.94	6.85
54+00	859.38	859.14	859.84	859.14	860.38	873.19	0.63	0.92	1.84	1.65	5.35	6.30	6.35	6.65

STATE OF HAWAII
DEPARTMENT OF TRANSPORTATION
HIGHWAYS DIVISION

PASSING POCKET
NO. 3 CONNECTION
EXPLORATORY TUNNEL IMPROVEMENTS
H-3 FINISH (UNIT III)
FAIP NO. I-H3-1(75), UNIT III
T.K. TUNNEL/ACCESS ROADS

SCALE: 1" = 1'-0" DATE: JUN 1991

SHEET NO. 2E10 OF 13 SHEETS

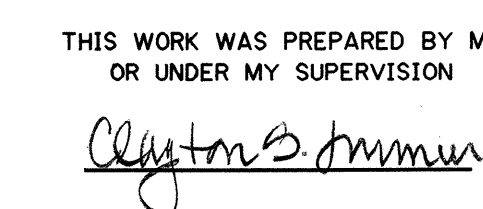

GRAPHIC SCALE

2' 1' 0' 2'

1" = 1'-0"

FED. ROAD DIST. NO.	STATE	FED. AID PROJ. NO.	FISCAL YEAR	SHEET NO.	TOTAL SHEETS
HAWAII	HAW.	I-H3-1(75) UNIT III	1994	42	353


NOTE:

SEE SHT. NO. 2F8 FOR NOTES.

LEGEND:

N/S = NO SWALE IN TUNNEL

N/F = DATA NOT SURVEYED

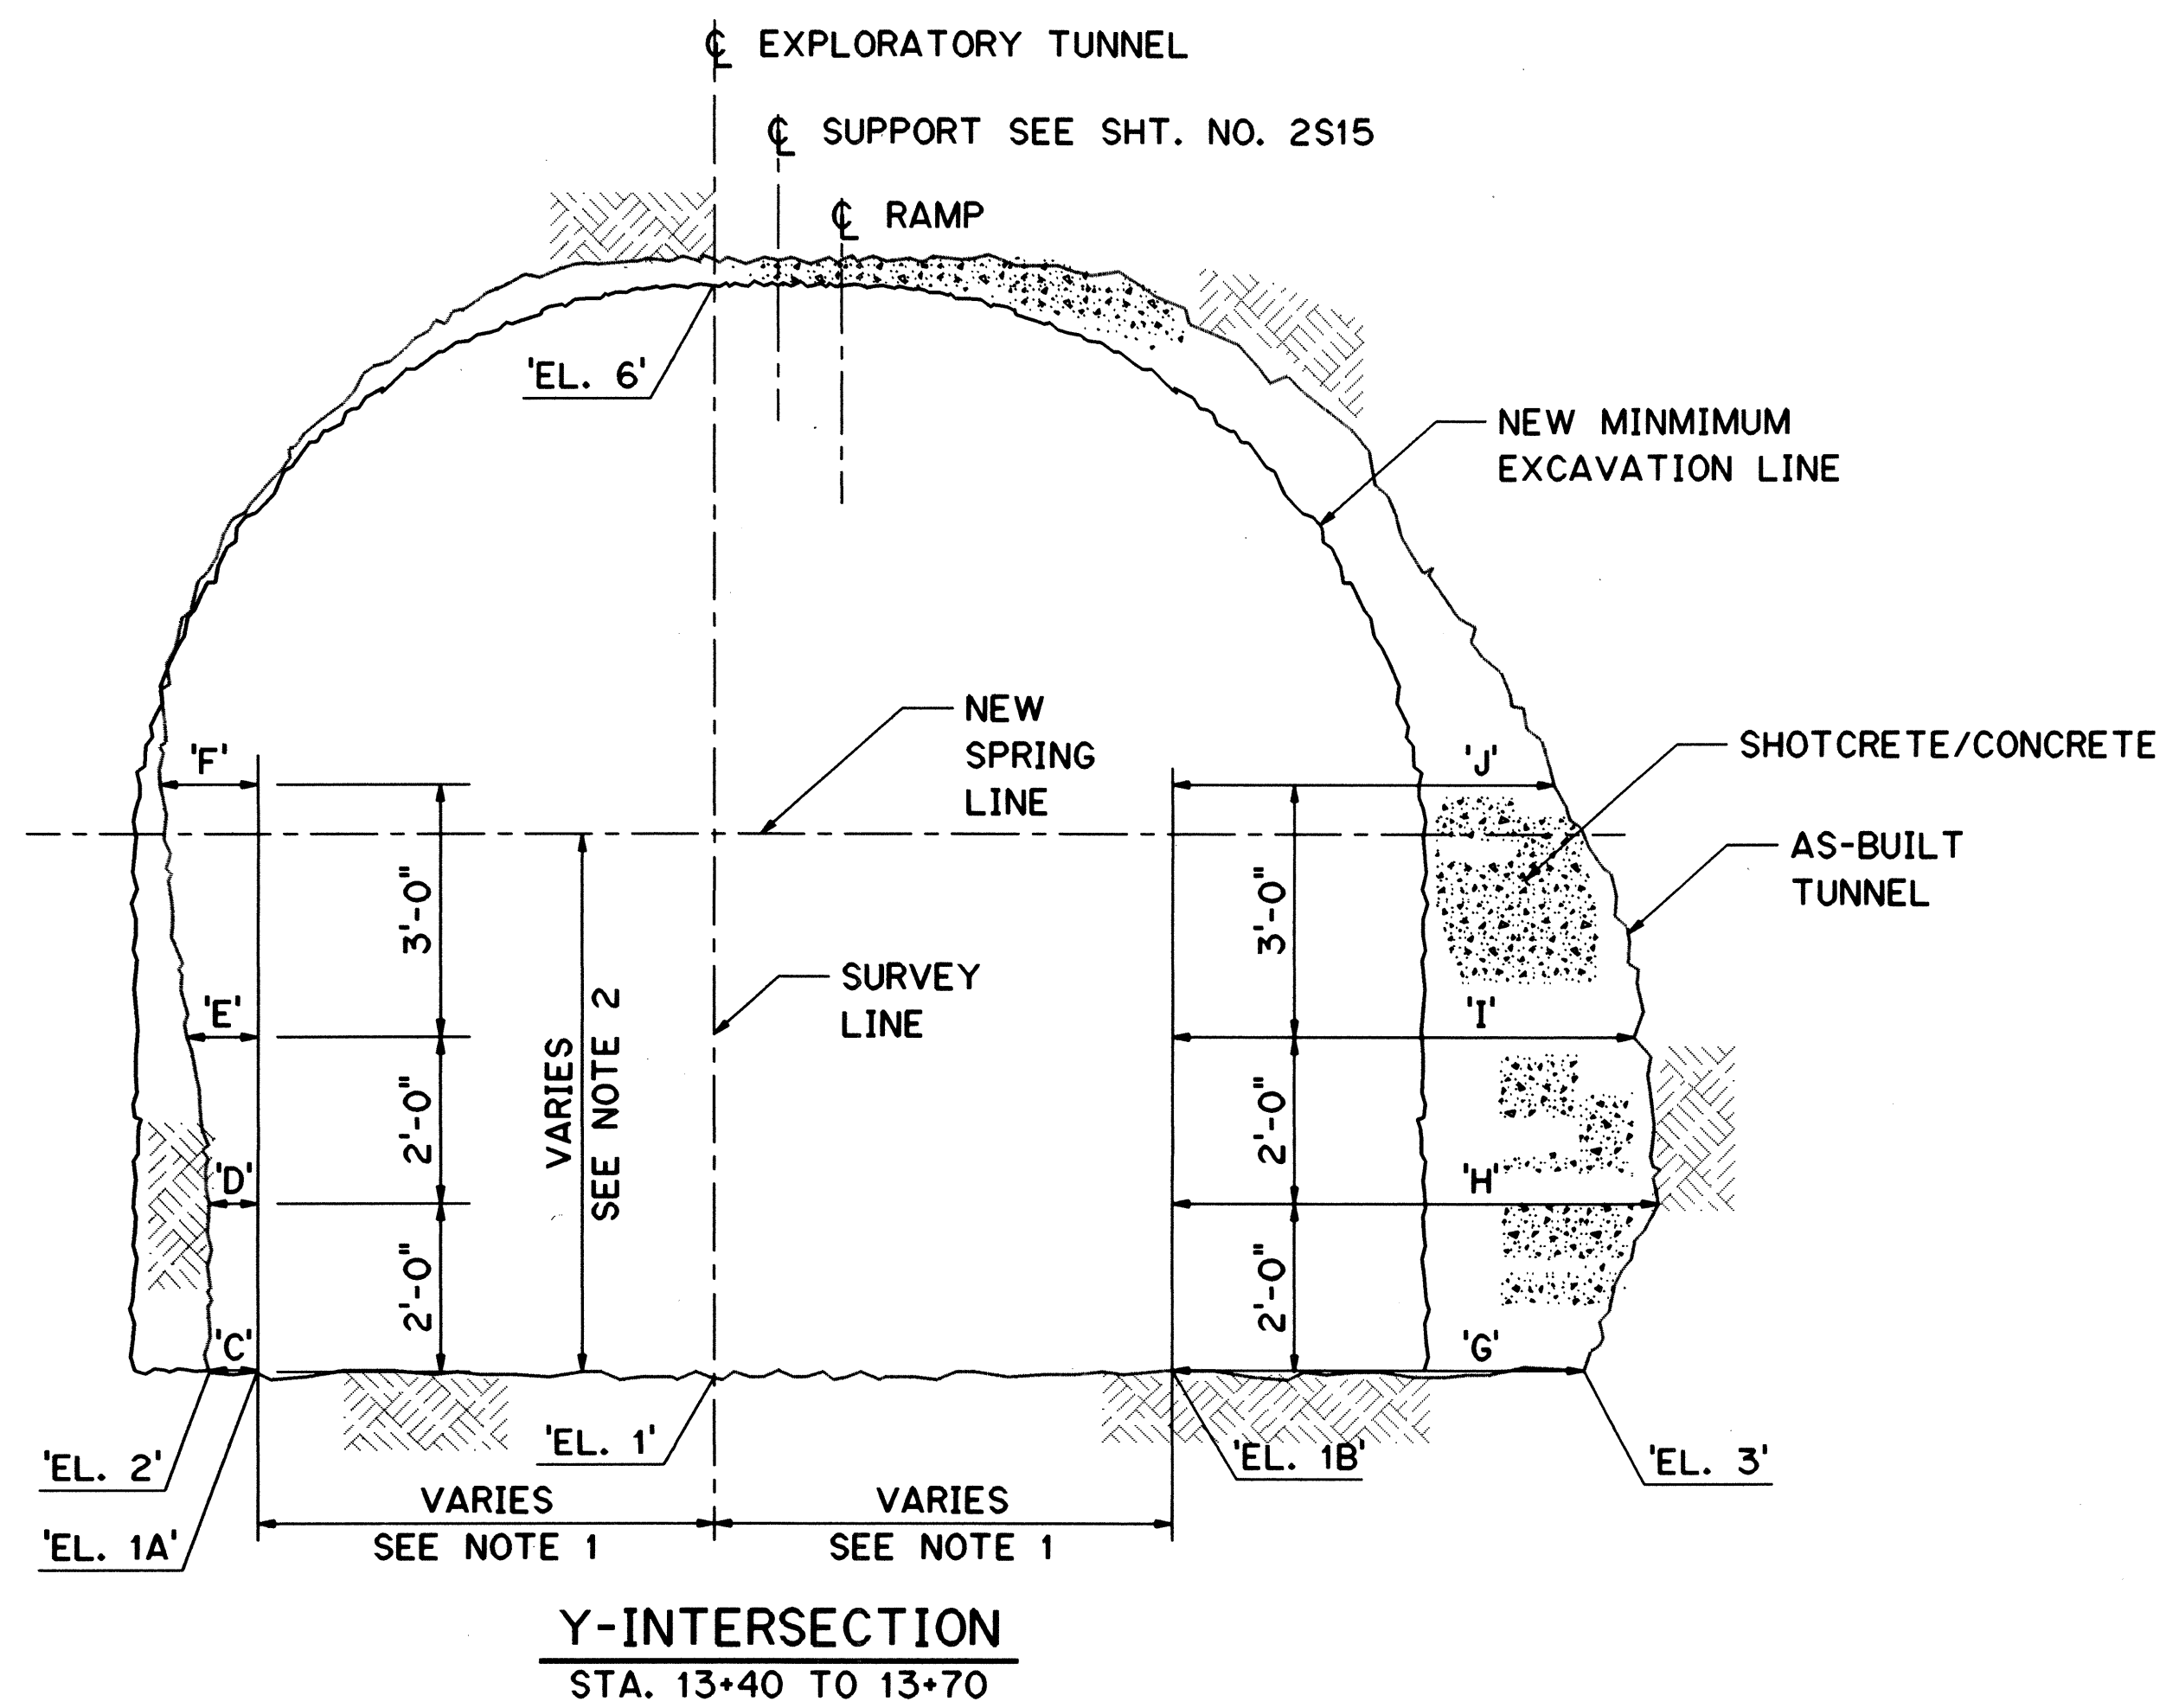

AS-BUILT DATA SCHEDULE

STA.	EL. 1	EL. 1A	EL. 2	EL. 1B	EL. 3	EL. 6	A	B	C	D	E	F	G	H	I	J
13+40	1011.38	1011.80	1011.80	1011.53	1011.53	1024.84	N/S	N/S	0.00	0.61	0.81	0.85	0.29	1.16	1.56	1.24
13+43	1011.18	1011.82	1011.82	1011.56	1011.68	1025.02	N/S	N/S	0.00	0.53	0.80	0.69	0.86	1.48	1.58	1.29
13+50	1011.43	1011.68	1011.68	1011.55	1011.82	1025.51	N/S	N/S	0.00	0.59	0.86	1.19	5.00	5.90	5.61	4.64
13+60	1011.69	1011.72	1011.72	1011.68	1012.53	1025.05	N/S	N/S	0.00	0.91	1.41	1.68	N/F	N/F	N/F	N/F
13+70	1011.74	1011.80	1011.80	1011.70	N/F	1025.61	N/S	N/S	0.00	0.74	1.31	1.40	0.15	0.95	1.63	1.90

DATE	REVISION

STATE OF HAWAII
DEPARTMENT OF TRANSPORTATION
HIGHWAYS DIVISION

Y-INTERSECTION AT EXPLORATORY TUNNEL RAMP

EXPLORATORY TUNNEL IMPROVEMENTS


H-3 FINISH (UNIT III)

FAIP NO. I-H3-1(75), UNIT III

T.K. TUNNEL/ACCESS ROADS

SCALE: 1/2" = 1'-0" DATE: JUN 1995


SHEET NO. 2F11 OF 13 SHEETS

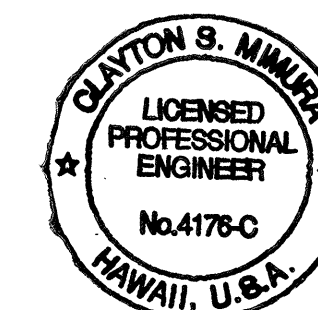

THIS WORK WAS PREPARED BY ME
OR UNDER MY SUPERVISION


Clayton S. Muma

GRAPHIC SCALE

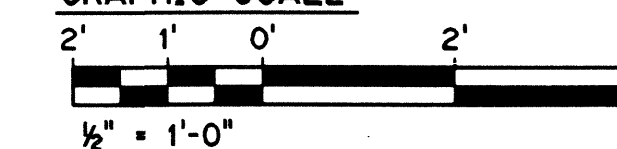

FED. ROAD DIST. NO.	STATE	FED. AID PROJ. NO.	FISCAL YEAR	SHEET NO.	TOTAL SHEETS
HAWAII	HAW.	I-H3-1(75) UNIT III	1994	43	353

STA.	EL. 1	EL. 1A	EL. 1B	EL. 2	EL. 3	EL. 6	A	B	C	D	E	F	G	H	I	J
10+90	1006.04	1006.28	1006.13	1006.70	1006.13	1019.79	N/S	N/S	1.16	1.22	1.60	1.55	0.50	1.11	1.50	1.61
11+00	1006.62	1006.95	1006.88	1007.06	1006.88	1020.46	3.20	0.00	1.19	1.72	2.26	1.95	0.44	1.03	1.61	1.42
11+10	1006.71	1007.27	1007.35	1007.48	1007.35	1020.60	3.00	0.60	1.08	1.56	1.89	1.98	0.28	0.71	1.27	1.56
11+20	1006.95	1007.53	1007.60	1007.69	1007.60	1020.85	3.00	0.70	0.98	1.84	2.15	2.18	0.10	0.81	1.42	1.45
11+30	1006.89	1007.77	1007.76	1007.86	1007.76	1021.30	2.80	0.70	0.86	1.34	1.71	1.90	0.38	1.15	1.37	1.13
11+40	1007.44	1008.14	1008.29	1008.19	1008.29	1021.56	2.20	1.00	0.94	1.35	1.88	1.70	0.15	0.77	0.78	0.73
11+50	1007.87	1008.65	1008.68	1008.71	1008.68	1022.03	2.20	1.00	0.66	1.18	1.41	1.14	0.91	1.25	1.29	1.23
11+60	1008.25	1008.85	1008.93	1008.92	1008.99	1022.24	1.60	1.50	0.70	1.05	1.06	0.90	0.95	1.34	1.60	1.40
11+70	1008.61	1009.32	1009.22	1009.35	1009.26	1022.77	2.30	1.00	1.10	1.27	1.26	0.97	1.20	1.42	1.55	1.63
11+80	1008.94	1009.58	1009.52	1009.58	1009.52	1022.88	1.80	1.00	0.44	0.95	1.04	0.66	0.77	1.00	1.39	1.44
11+90	1009.31	1009.71	1009.86	1009.71	1009.86	1023.26	1.50	1.50	0.51	1.08	1.34	0.80	0.79	1.52	1.65	1.27
12+00	1009.59	1010.16	1010.33	1010.16	1010.33	1023.39	1.40	1.60	0.31	0.65	0.74	0.63	1.10	1.32	1.43	1.37
12+10	1010.16	1010.76	1010.56	1010.76	1010.56	1023.80	1.40	1.60	0.60	1.26	1.18	0.79	1.14	1.56	1.73	1.57
12+20	1010.37	1010.99	1010.95	1010.99	1010.95	1024.11	1.50	1.60	0.25	0.60	0.49	0.25	1.18	1.60	1.61	1.38
12+30	1010.61	1011.21	1011.07	1011.21	1011.07	1023.98	1.30	1.70	0.34	0.80	0.95	0.59	1.26	1.22	1.39	1.20
12+35	1010.66	1011.25	1011.09	1011.25	1011.39	1024.08	1.40	1.60	0.15	0.64	1.11	0.83	7.80	7.83	7.92	7.60
12+40	1010.67	1011.30	1011.15	1011.30	1011.32	1023.98	1.80	1.50	0.26	0.68	0.88	0.64	8.49	8.55	8.26	7.34
12+43	1010.77	1011.33	1011.18	1011.33	1011.34	1023.78	1.30	1.40	0.29	0.70	0.94	0.58	7.90	7.81	7.82	7.64
12+50	1010.73	1011.26	1011.26	1011.26	1011.26	1024.37	1.00	1.20	0.75	1.10	1.11	0.62	1.15	1.57	1.75	1.40
12+60	1010.97	1011.40	1011.46	1011.41	1011.44	1024.58	1.80	1.10	0.76	1.24	1.39	1.13	0.93	1.33	1.56	1.22
12+70	1010.95	1011.55	1011.58	1011.59	1011.61	1024.48	1.80	1.80	0.79	1.11	1.14	0.84	1.72	1.91	1.96	1.48
12+77	1010.93	1011.64	1011.56	1011.64	1011.63	1024.40	1.01	1.58	0.00	0.62	0.82	0.71	0.79	1.30	1.73	1.54
12+80	1011.02	1011.63	1011.54	1011.63	1011.56	1024.55	1.20	1.60	0.00	0.44	0.64	0.73	0.63	1.36	1.87	1.76
12+90	1010.91	1011.78	1011.59	1011.78	1011.63	1025.06	1.20	1.55	0.00	0.64	1.00	0.71	0.70	1.43	1.64	1.01
13+00	1011.06	1011.66	1011.58	1011.06	1011.62	1025.88	1.40	1.55	0.00	0.55	0.81	0.85	0.65	1.25	1.62	1.68
13+10	1011.04	1011.72	1011.66	1011.72	1011.75	1025.05	1.30	1.70	0.00	0.53	0.77	0.58	0.84	1.33	1.44	1.22
13+20	1011.02	1011.67	1011.61	1011.67	1011.65	1025.00	1.50	1.45	0.10	0.73	0.88	0.65	0.57	1.28	1.71	1.54
13+30	1011.54	1012.10	1011.73	1012.10	1011.77	1024.76	N/S	N/S	0.00	0.19	0.68	0.65	0.53	1.50	1.69	1.65
13+40	1011.38	1011.80	1011.53	1011.80	1011.53	1024.84	N/S	N/S	0.00	0.61	0.81	0.85	0.29	1.16	1.56	1.24
13+43	1011.18	1011.82	1011.56	1011.82	1011.68	1025.02	N/S	N/S	0.00	0.53	0.80	0.69	0.86	1.48	1.58	1.29
13+50	1011.43	1011.68	1011.55	1011.68	1011.82	1025.51	N/S	N/S	0.00	0.59	0.86	1.19	5.00	5.90	5.61	4.64
13+60	1011.69	1011.72	1011.68	1011.72	1012.53	1025.05	N/S	N/S	0.00	0.91	1.41	1.68	N/F	N/F	N/F	N/F
13+70	1011.74	1011.80	1011.70	1011.80	N/F	1025.61	N/S	N/S	0.00	0.74	1.31	1.40	0.15	0.95	1.63	1.90
13+80	1011.79	1011.82	1011.79	1011.82	N/F	1024.85	N/S	N/S	0.00	0.51	0.90	1.09	0.10	1.01	1.45	1.68
13+90	1011.85	1011.87	1011.94	1011.87	N/F	1024.52	N/S	N/S	0.00	0.48	0.76	0.82	0.00	0.82	1.16	1.35
14+00	1011.88	1012.16	1012.10	1012.16	N/F	1024.58	N/S	N/S	0.00	0.44	0.62	0.62	0.30	0.97	1.18	0.92
14+10	1011.82	1012.02	1012.06	1012.01	1012.06	1025.18	N/S	N/S	0.56	1.04	1.33	1.20	0.41	0.82	0.91	0.80
14+20	1011.64	1011.90	1011.65	1012.02	1011.79	1024.95	N/S	N/S	0.44	0.73	0.71	0.69	1.35	1.69	2.04	2.02
14+30	1011.61	1012.06	1011.67	1012.23	1011.80	1025.30	N/S	N/S	0.90	0.82	1.00	0.93	1.60	2.09	2.38	2.54
14+40	1011.96	1012.22	1011.78	1012.22	1011.90	1025.70	N/S	N/S	0.00	0.67	0.87	0.95	1.10	1.88	2.27	2.21
14+50	1012.02	1012.51	1011.85	1012.51	1011.93	1026.24	N/S	N/S	0.00	0.61	0.93	0.88	1.54	2.49	2.75	2.84
14+60	1012.26	1012.72	1011.97	1012.72	1012.03	1027.14	N/S	N/S	0.15	0.23	0.41	0.46	1.88	2.41	2.76	3.00
14+70	1012.24	1012.79	1011.91	1012.79	1011.93	1025.87	N/S	N/S	0.00	0.58	0.68	0.70	2.02	2.27	2.43	2.41
14+80	1012.15	1012.62	1012.93	1012.76	1011.97	1025.75	N/S	N/S	0.46	0.83	0.87	0.72	2.16	2.27	2.17	2.18
14+90	1012.22	1012.66	1012.03	1012.66	1012.23	1025.97	N/S	N/S	0.00	0.15	0.47	0.36	1.60	2.05	2.25	2.35

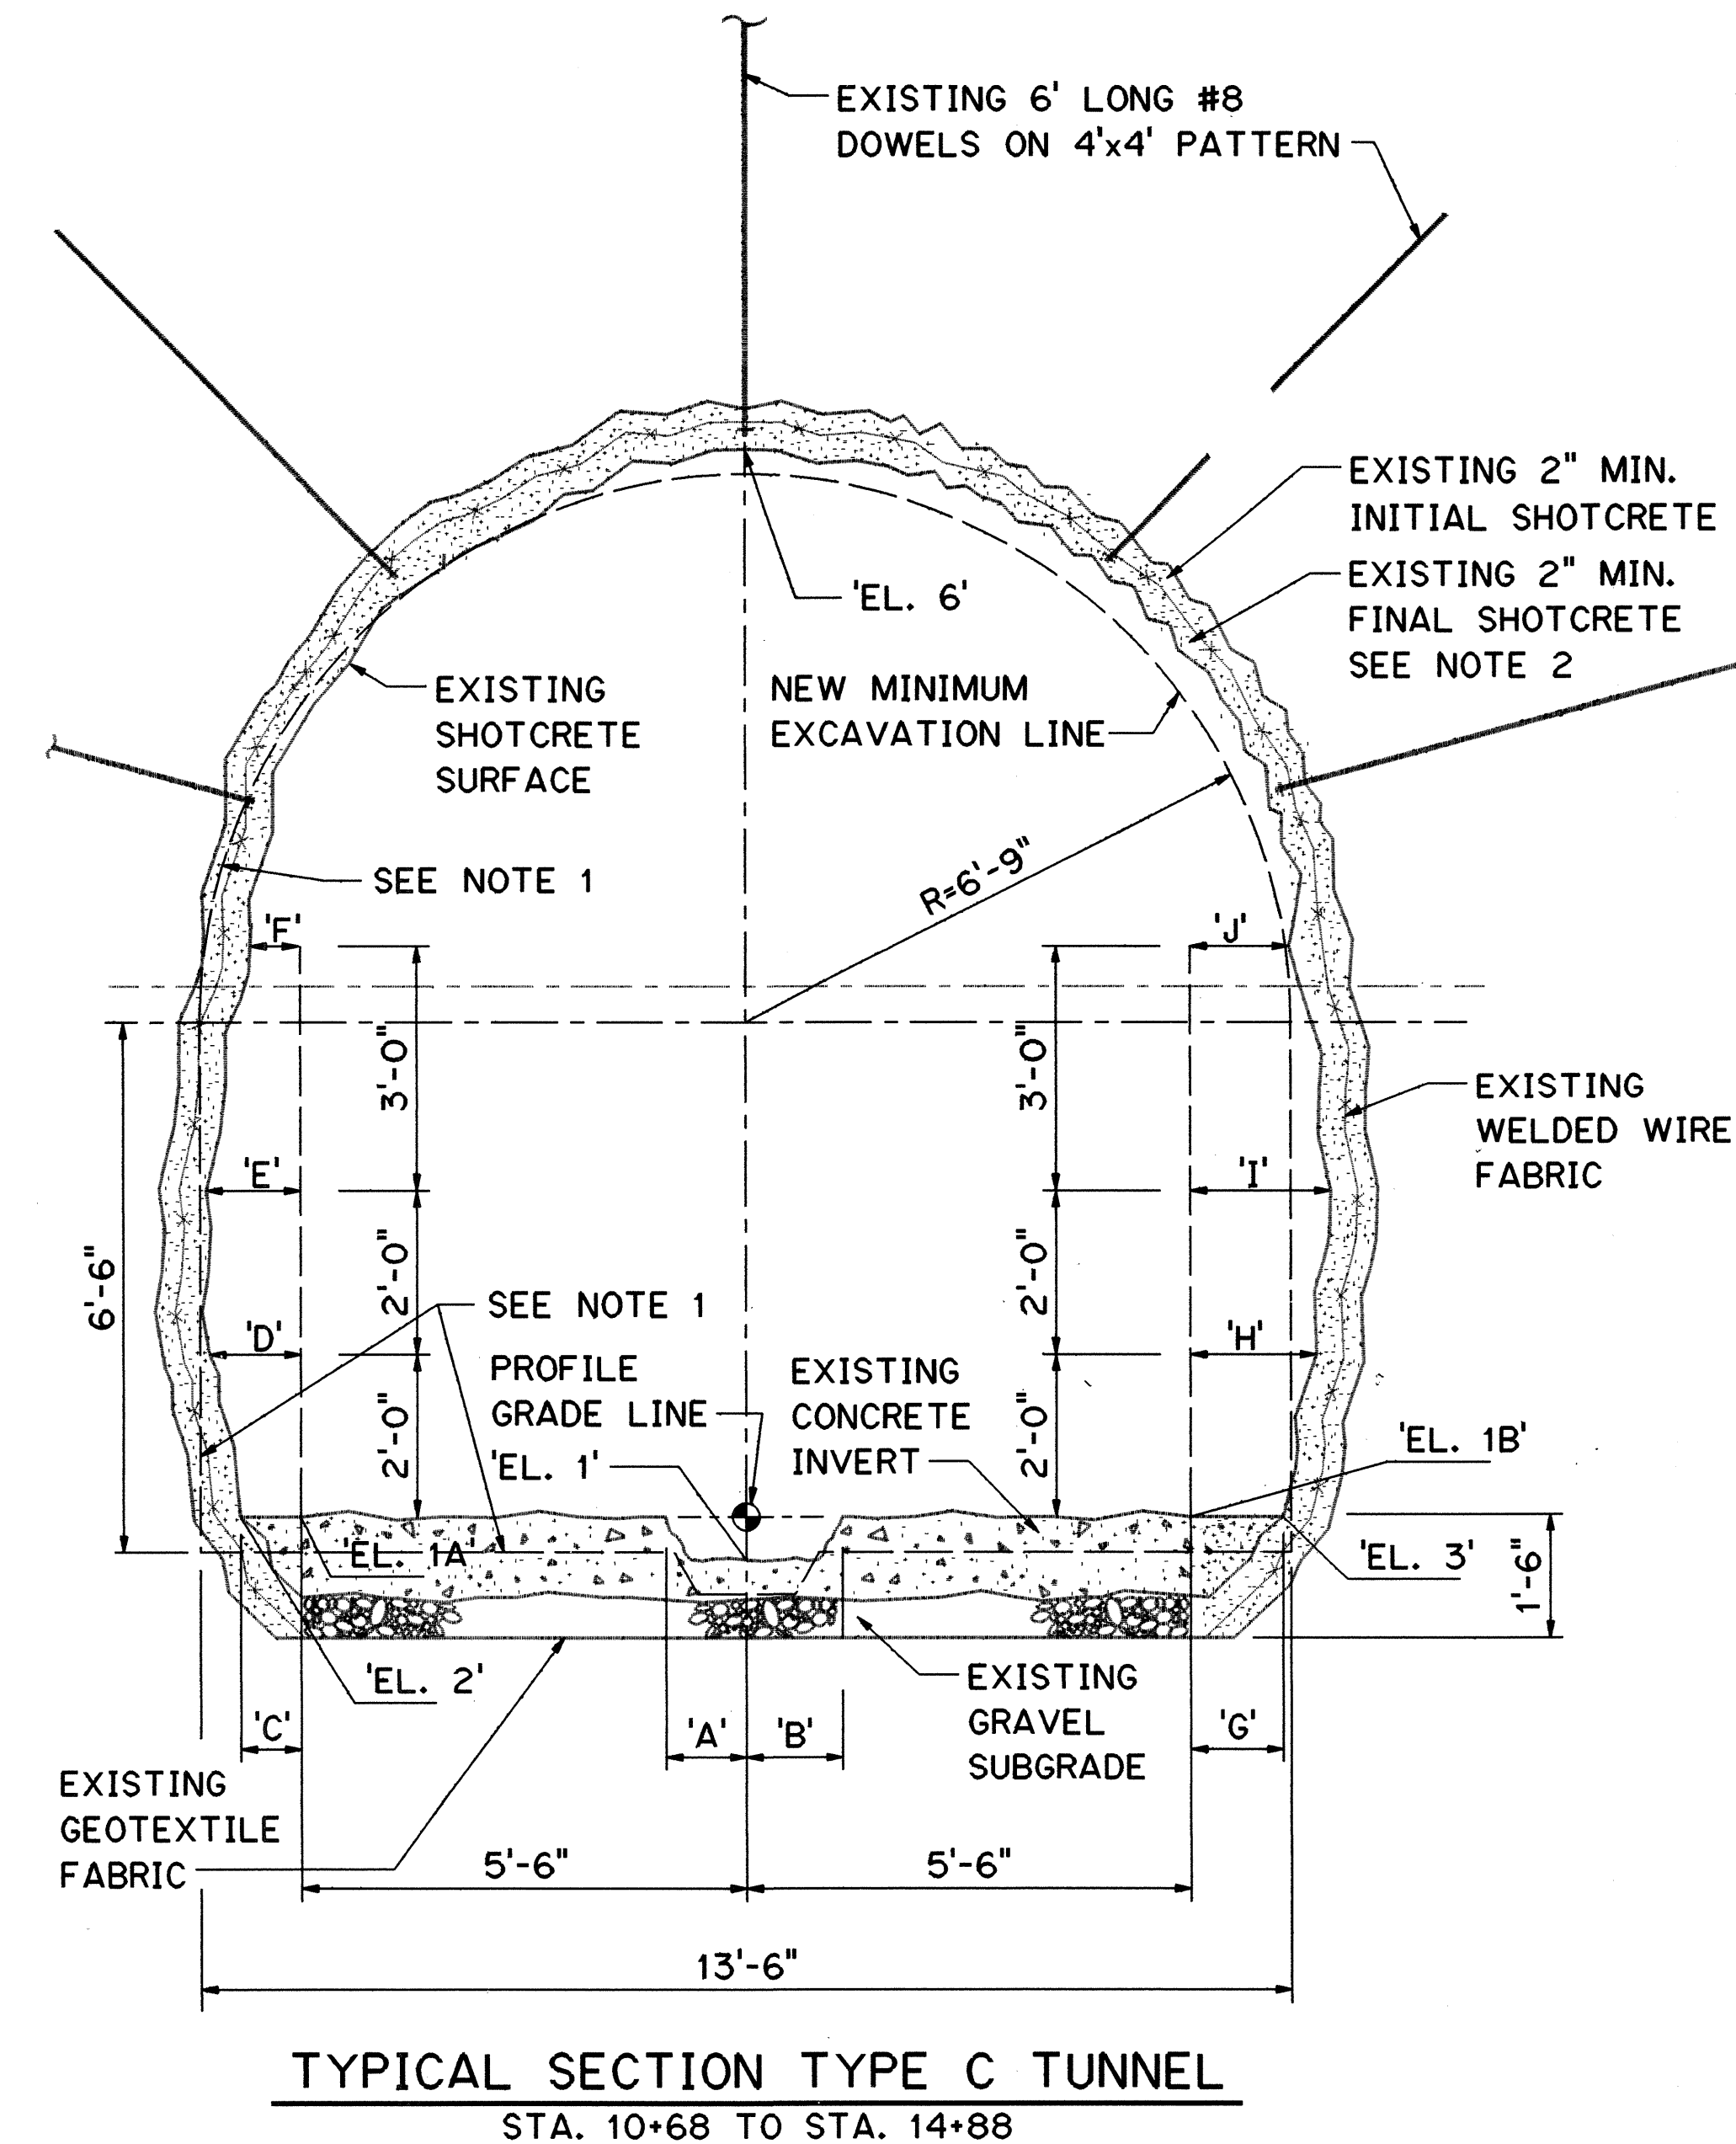

1. CONTRACTOR SHALL TRIM TUNNEL AND REMOVE EXISTING CONCRETE INVERT IN PORTIONS OF THE EXPLORATORY TUNNEL WITH GROUND SUPPORT TYPE C, IN ACCORDANCE WITH SHT. NO. 2F7 AND THE SPECIFICATIONS.
2. EXISTING SHOTCRETE THICKNESS VARIES, BUT IS GREATER THAN 4 INCHES.
3. N/S INDICATES NO SWALE IN TUNNEL.
4. N/F INDICATES DATA NOT SURVEYED.


[illegible]

STATE OF HAWAII
DEPARTMENT OF TRANSPORTATION
HIGHWAYS DIVISION

EXISTING GROUND
SUPPORT TYPE C TUNNEL
EXPLORATORY TUNNEL IMPROVEMENTS
H-3 FINISH (UNIT III)
FAIP NO. I-H3-1(75), UNIT III
T.K. TUNNEL/ACCESS ROADS


SCALE: 1/2" = 1'-0" DATE: JUN 1995

SHEET NO. 2F12 OF 13 SHEETS

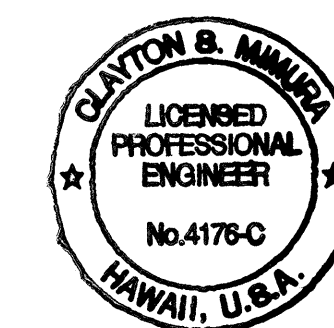

THIS WORK WAS PREPARED BY ME
OR UNDER MY SUPERVISION


Clayton Sumner

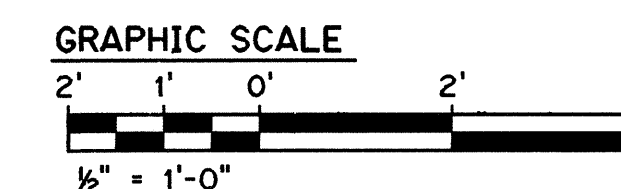


FED. ROAD DIST. NO.	STATE	FED. AID PROJ. NO.	FISCAL YEAR	SHEET NO.	TOTAL SHEETS
HAWAII	HAW.	I-H3-1(75) UNIT III	1994	44	353

NOTES:

- CONTRACTOR SHALL TRIM TUNNEL AS REQUIRED, TO NEW DESIGN LINE FOR THE FAN ENLARGEMENT AT HALAWA AND HAIKU. CONTRACTOR SHALL REMOVE EXISTING CONCRETE INVERT IN PORTIONS OF THE EXPLORATORY TUNNEL WITH GROUND SUPPORT TYPE C, IN ACCORDANCE WITH SHEET NO. 2F7 AND THE SPECIFICATIONS.
- EXISTING SHOTCRETE THICKNESS VARIES, BUT IS GREATER THAN 4 INCHES.
- N/S INDICATES NO SWALE IN TUNNEL.
- SEE SHT. NO. 2M8, FOR FAN LOCATION
- SEE SHT. NO. 2S14, SECTION C FOR FAN ENLARGEMENT GEOMETRY ALONG GCL
- GROUND SUPPORT SELECTION FOR THE EXISTING EXPLORATORY TUNNEL WAS MADE IN THE HEADING DURING CONSTRUCTION AND CONSISTS OF THE FOLLOWING TYPES:
 - TYPE A - NO SUPPORT
 - TYPE B - CROWN SHOTCRETE AND DOWELS
 - TYPE C - FULL-PERIMETER SHOTCRETE AND DOWELS

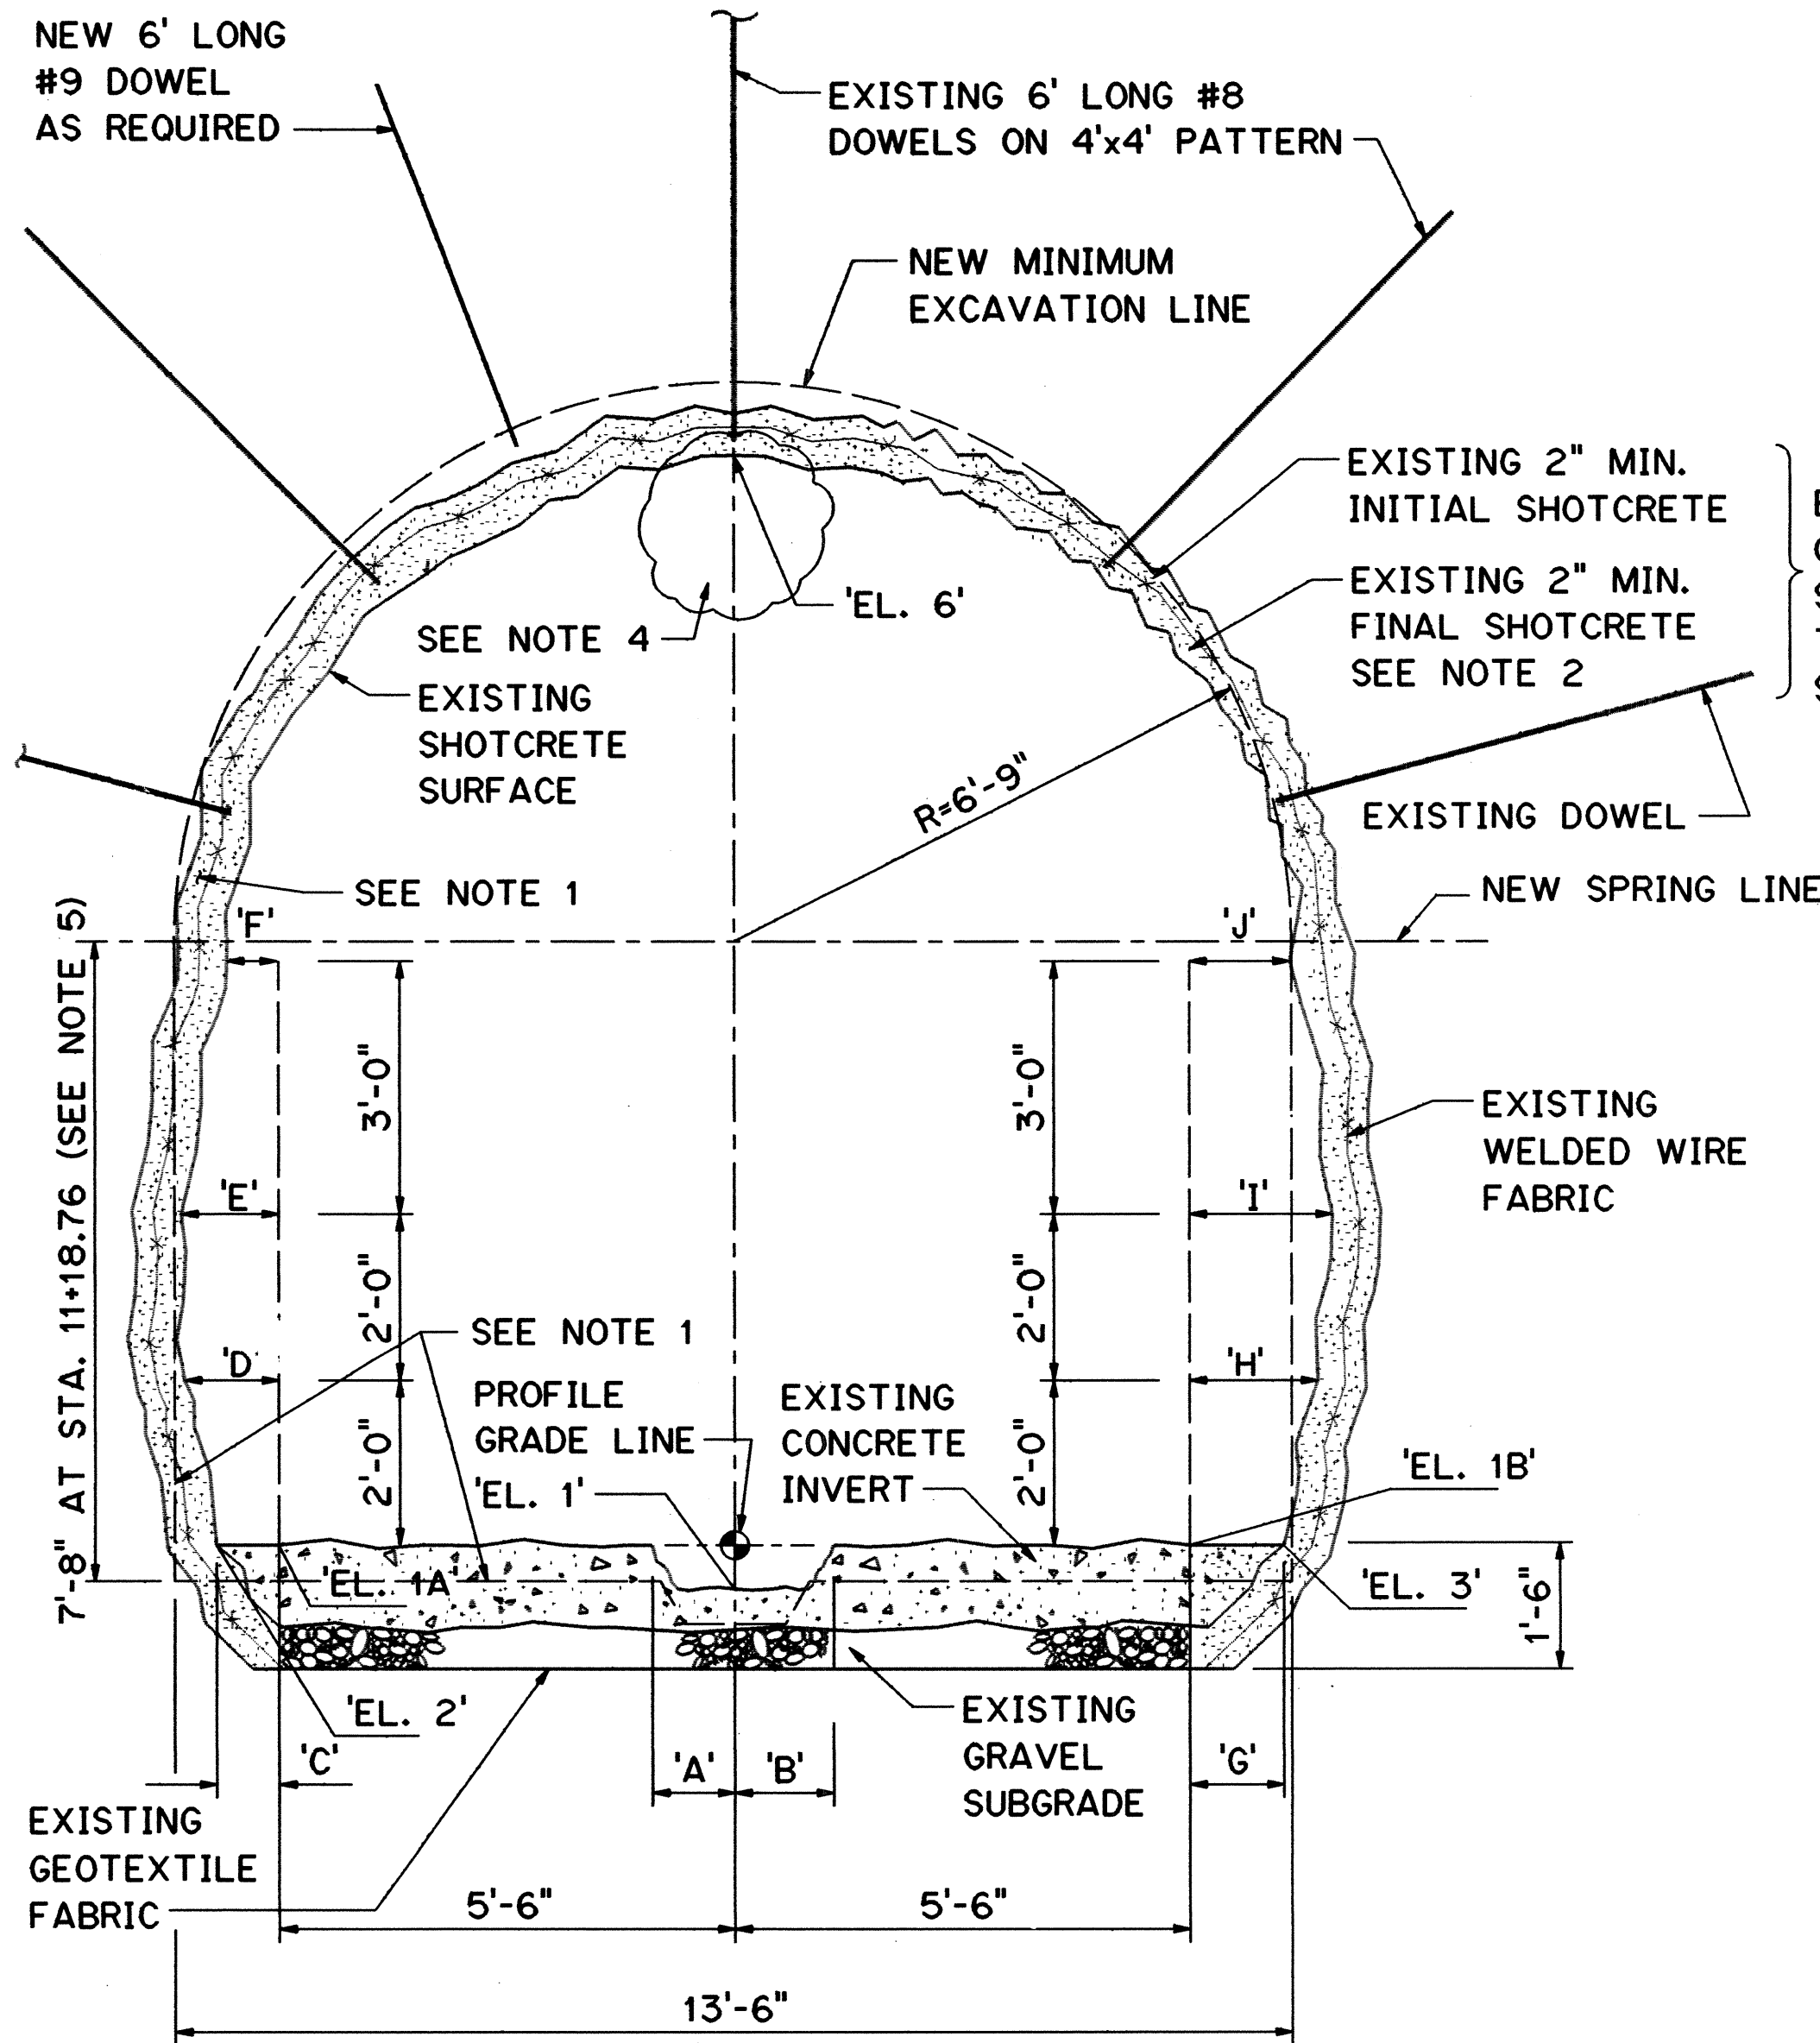

TYPICAL SECTION
HALAWA FAN ENLARGEMENT
STA. 11+12.76 TO STA. 11+24.76

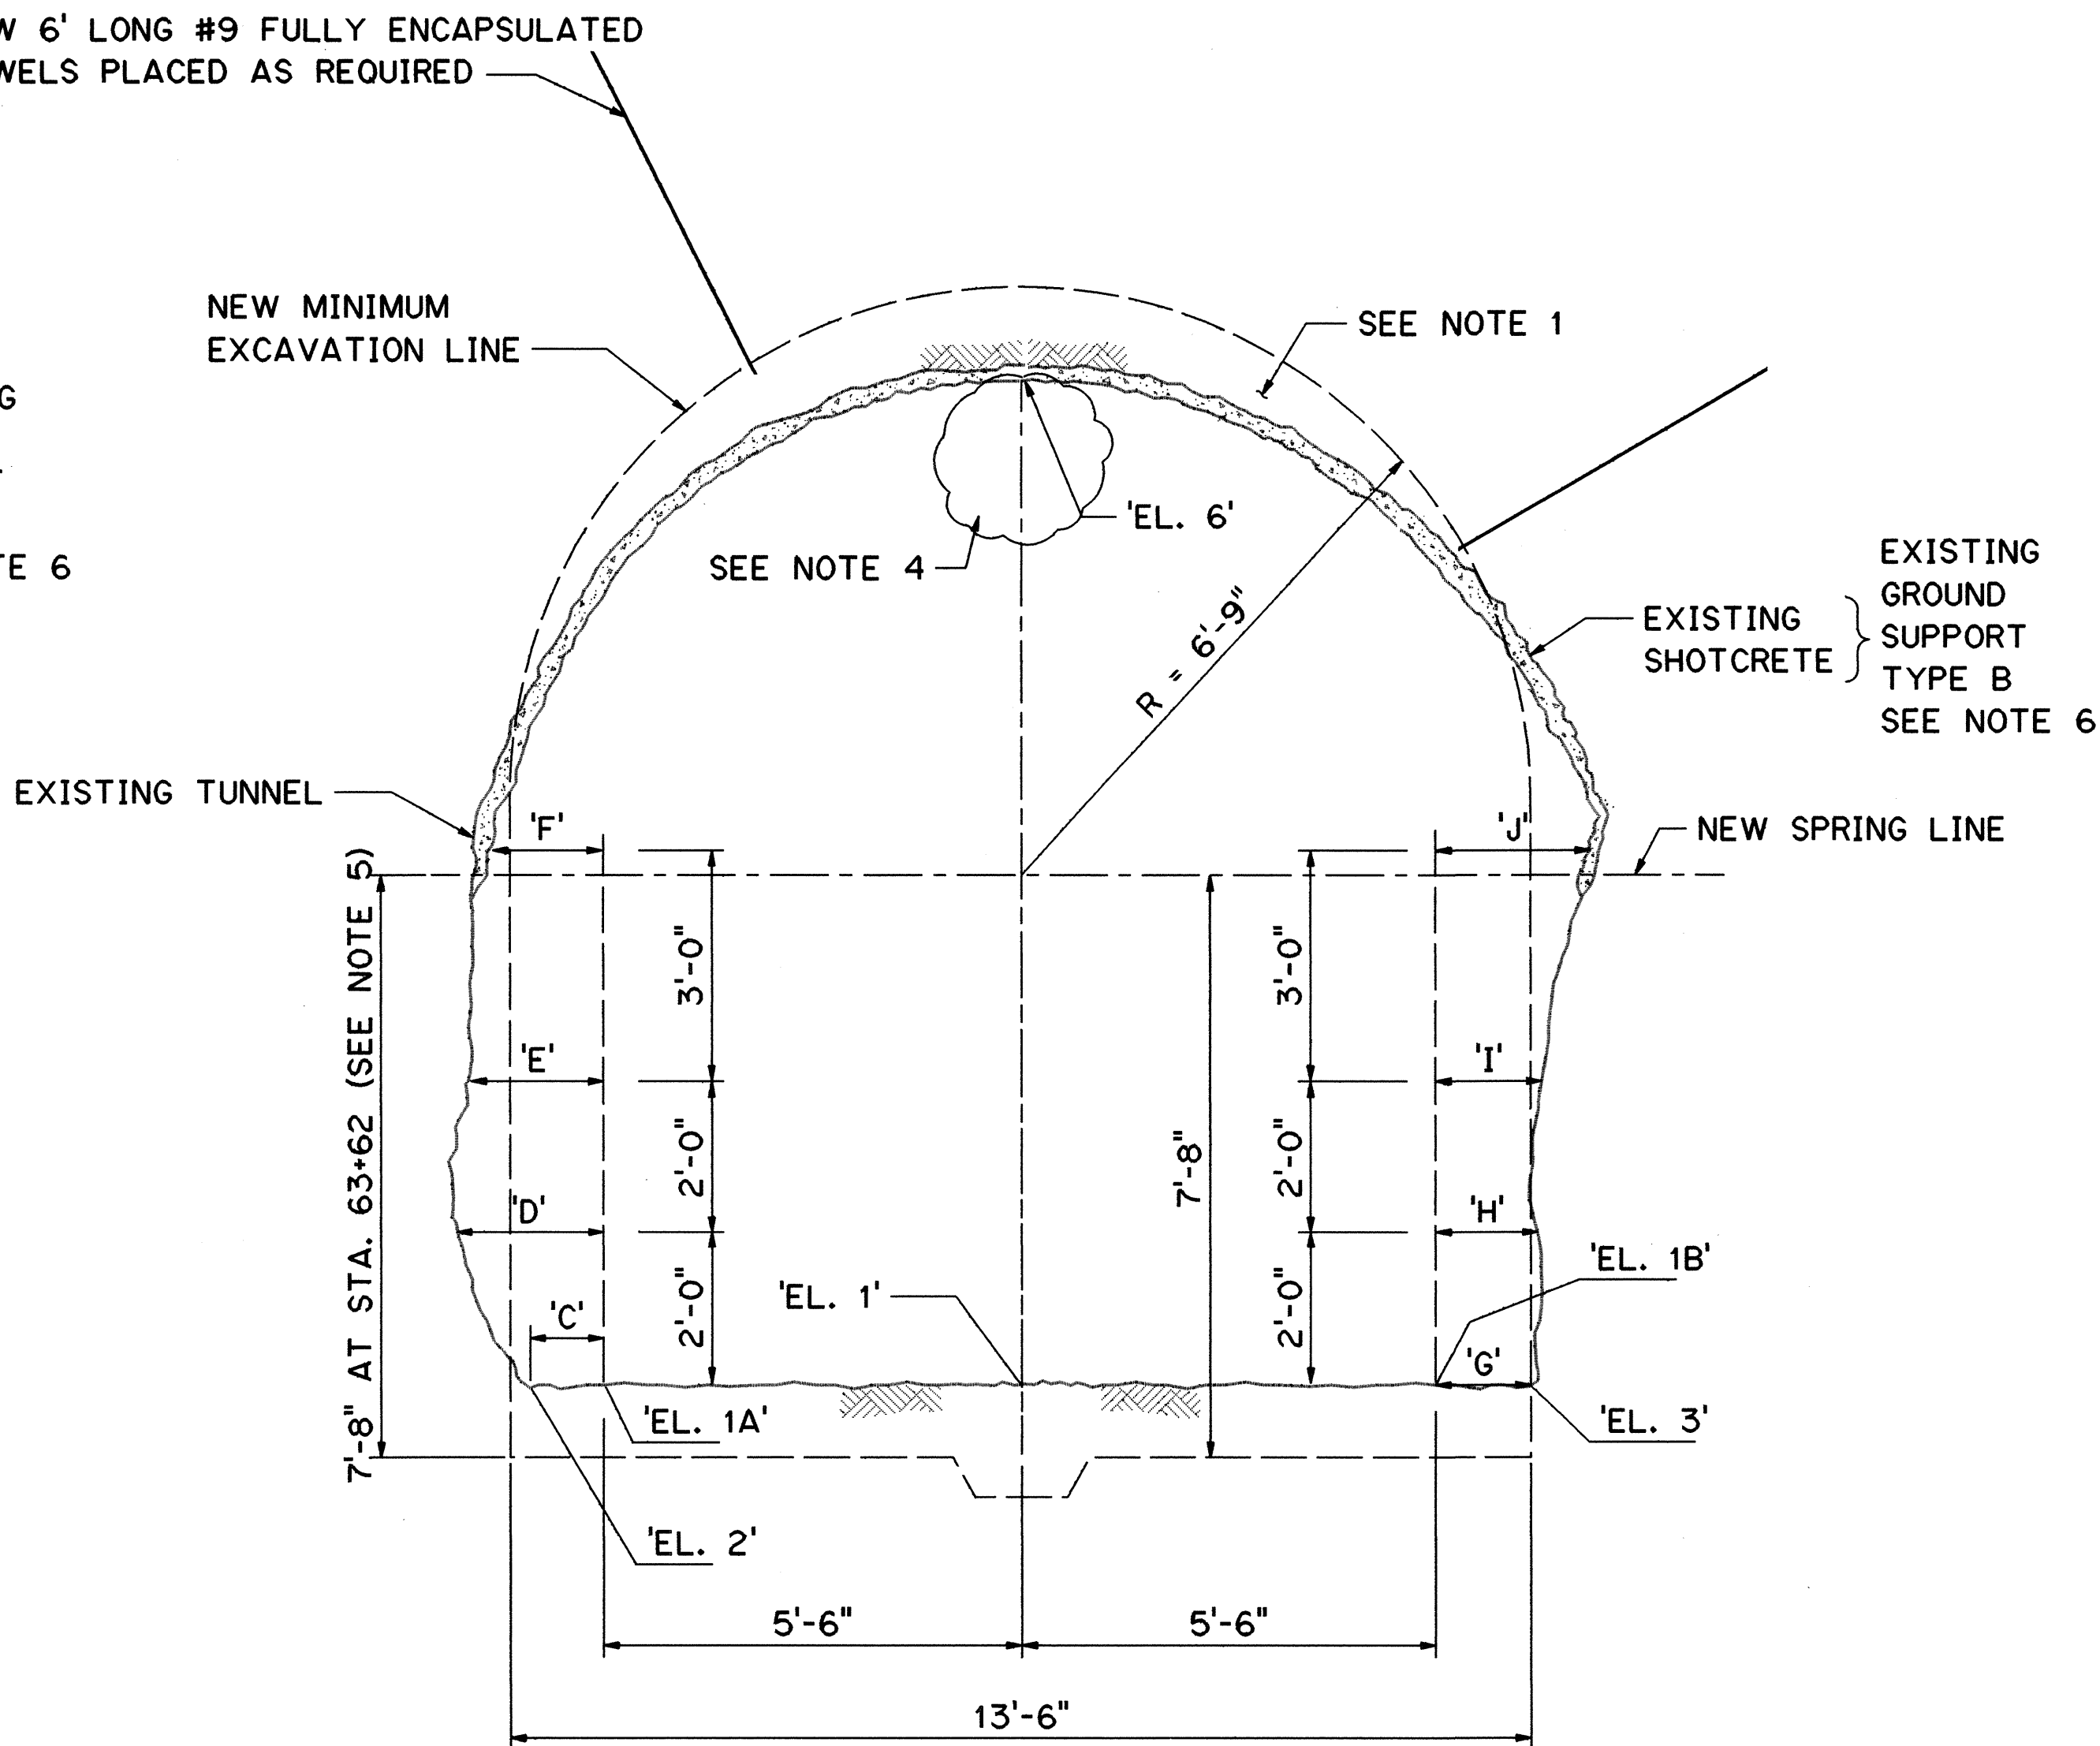


TYPICAL SECTION
HAIKU FAN ENLARGEMENT
STA. 63+56.00 TO STA. 63+68.00

AS-BUILT DATA SCHEDULE

STA.	EL. 1	EL. 1A	EL. 1B	EL. 2	EL. 3	EL. 6	A	B	C	D	E	F	G	H	I	J
HALAWA																
11+00	1006.62	1006.95	1006.88	1007.06	1006.88	1020.46	3.20	0.00	1.19	1.72	2.26	1.95	0.44	1.03	1.61	1.42
11+10	1006.71	1007.27	1007.35	1007.48	1007.35	1020.60	3.00	0.60	1.08	1.56	1.89	1.98	0.28	0.71	1.27	1.56
11+20	1006.95	1007.53	1007.60	1007.69	1007.60	1020.85	3.00	0.70	0.98	1.84	2.15	2.18	0.10	0.81	1.42	1.45
11+30	1006.89	1007.77	1007.76	1007.86	1007.76	1021.30	2.80	0.70	0.86	1.34	1.71	1.90	0.38	1.15	1.37	1.13
HAIKU																
63+50	815.87	815.85	816.22	816.43	817.08	829.81	N/S	N/S	1.45	2.34	2.45	1.89	0.56	1.34	1.78	1.70
63+60	815.61	815.68	815.87	816.52	816.07	829.04	N/S	N/S	1.08	2.02	1.77	1.69	1.32	1.24	1.50	2.17
63+70	815.53	815.40	815.58	815.73	816.15	830.16	N/S	N/S	0.90	1.05	0.82	0.82	2.05	2.19	2.20	2.24

DATE	JAN 95
SURVEY PLOTTED BY	A. KORBACH
DRAWN BY	D. OYENGA
CHECKED BY	G. BOYCE
NO.	

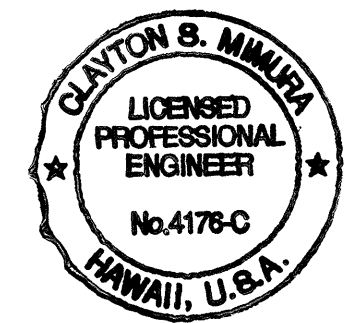


THIS WORK WAS PREPARED BY ME OR UNDER MY SUPERVISION


Clayton S. Mura

DATE	REVISION
STATE OF HAWAII DEPARTMENT OF TRANSPORTATION HIGHWAYS DIVISION HALAWA AND HAIKU FAN ENLARGEMENT EXPLORATORY TUNNEL IMPROVEMENTS H-3 FINISH (UNIT III) FAIP NO. I-H3-1(75), UNIT III T.K. TUNNEL/ACCESS ROADS SCALE: 1" = 10' DATE: JUN 1995 SHEET NO. 2F13 OF 13 SHEETS	

FED. ROAD DIST. NO.	STATE	FED. AID PROJ. NO.	FISCAL YEAR	SHEET NO.	TOTAL SHEETS
HAWAII	HAW.	1-H3-1(75) UNIT III	1994	45	353

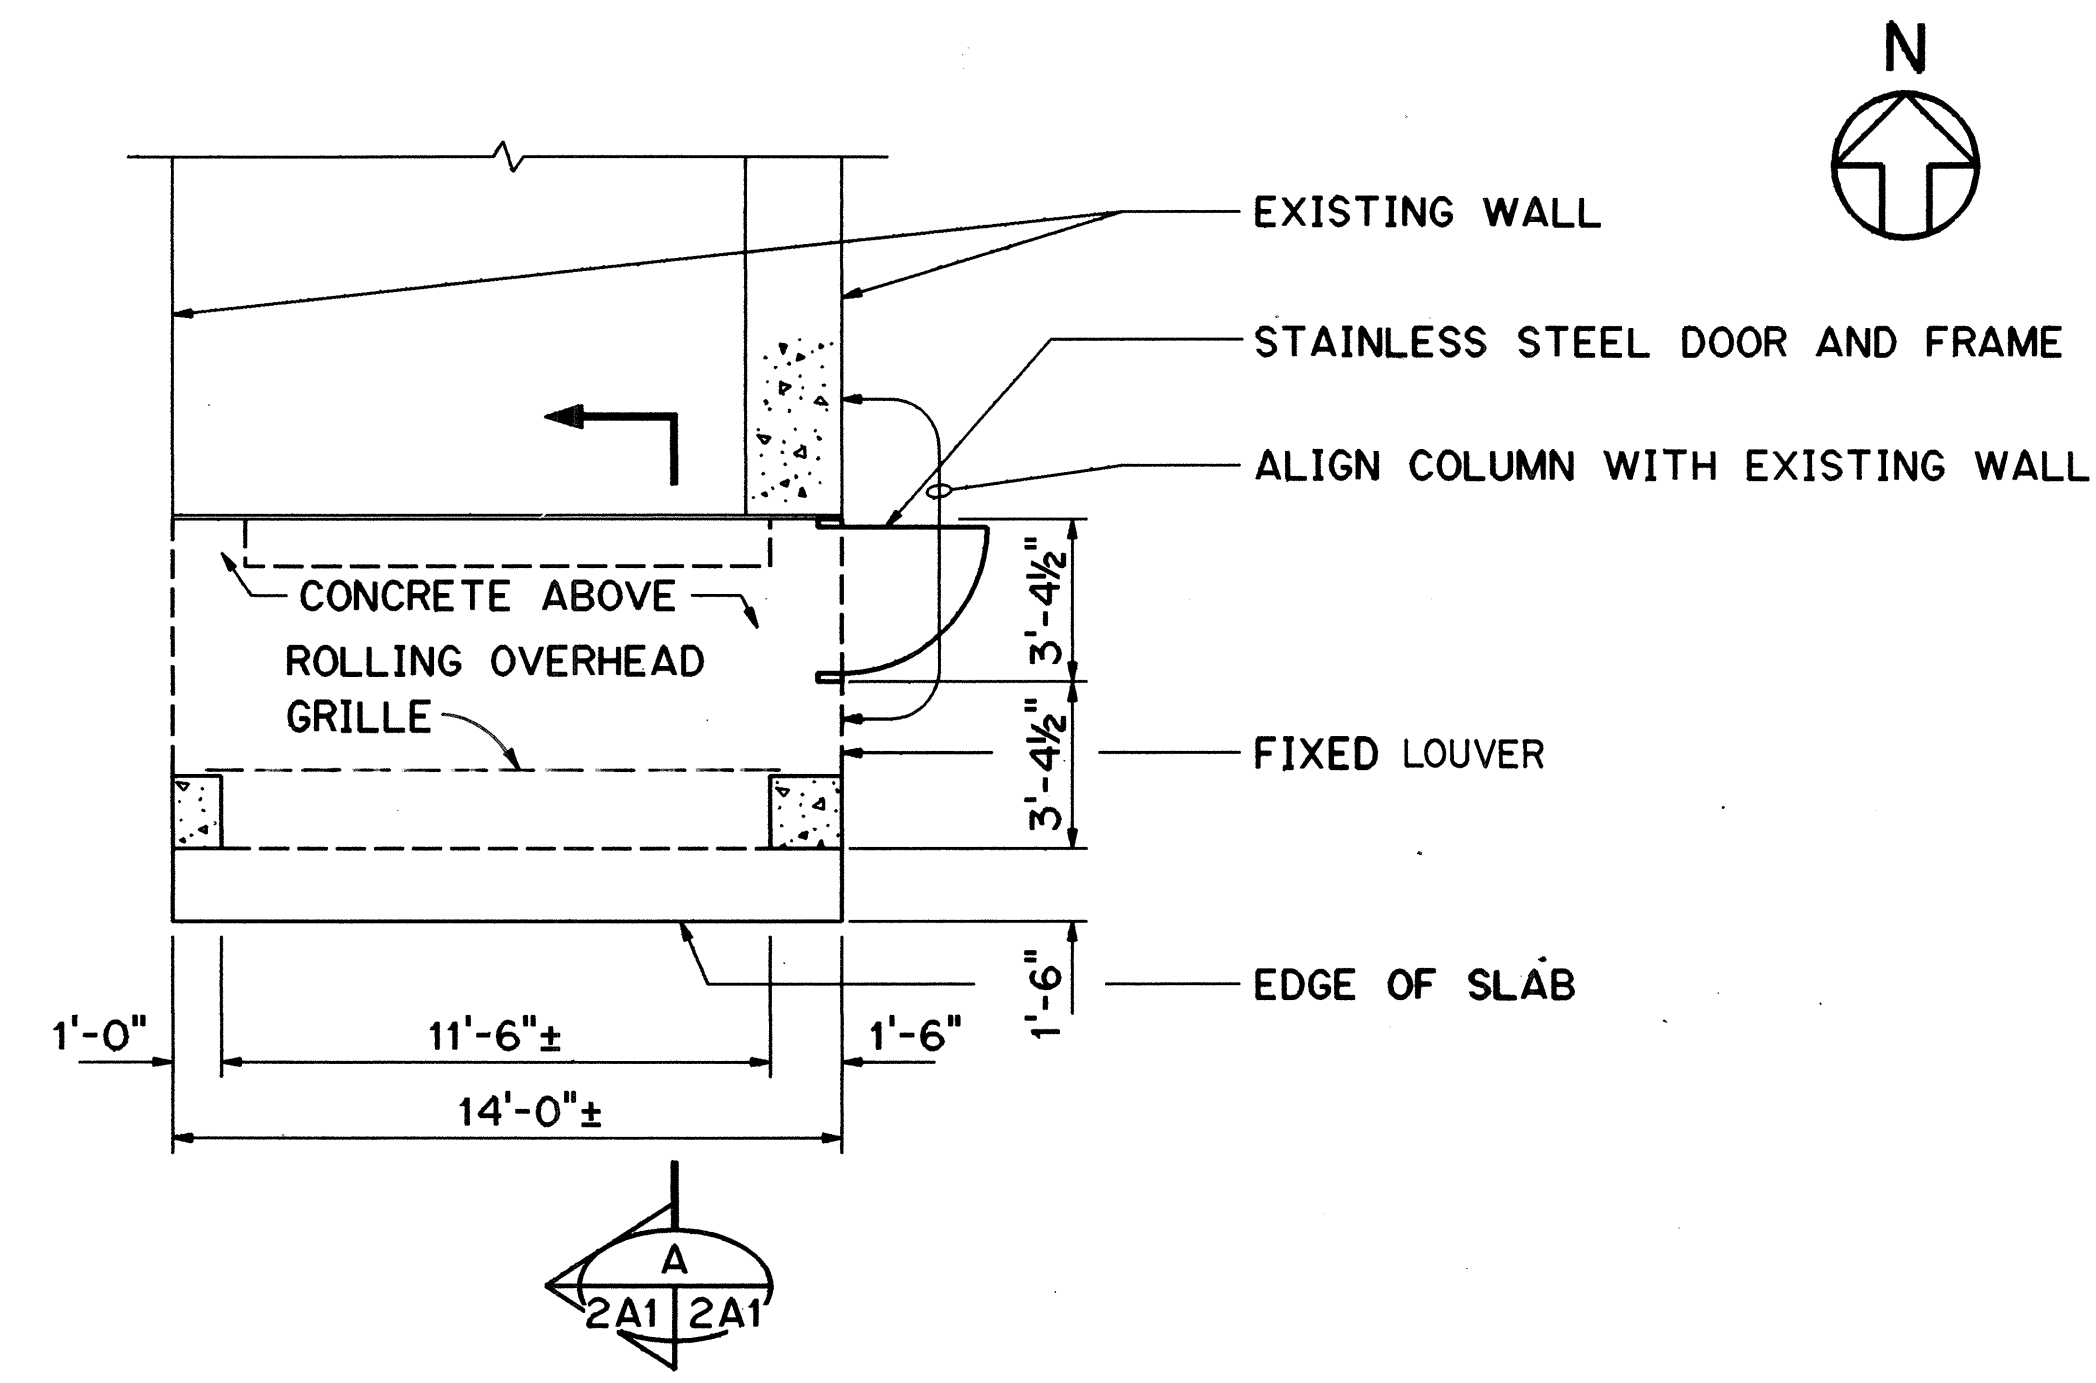


PLAN - HALAWA GATE 1
SCALE: 1/4" = 1'-0"

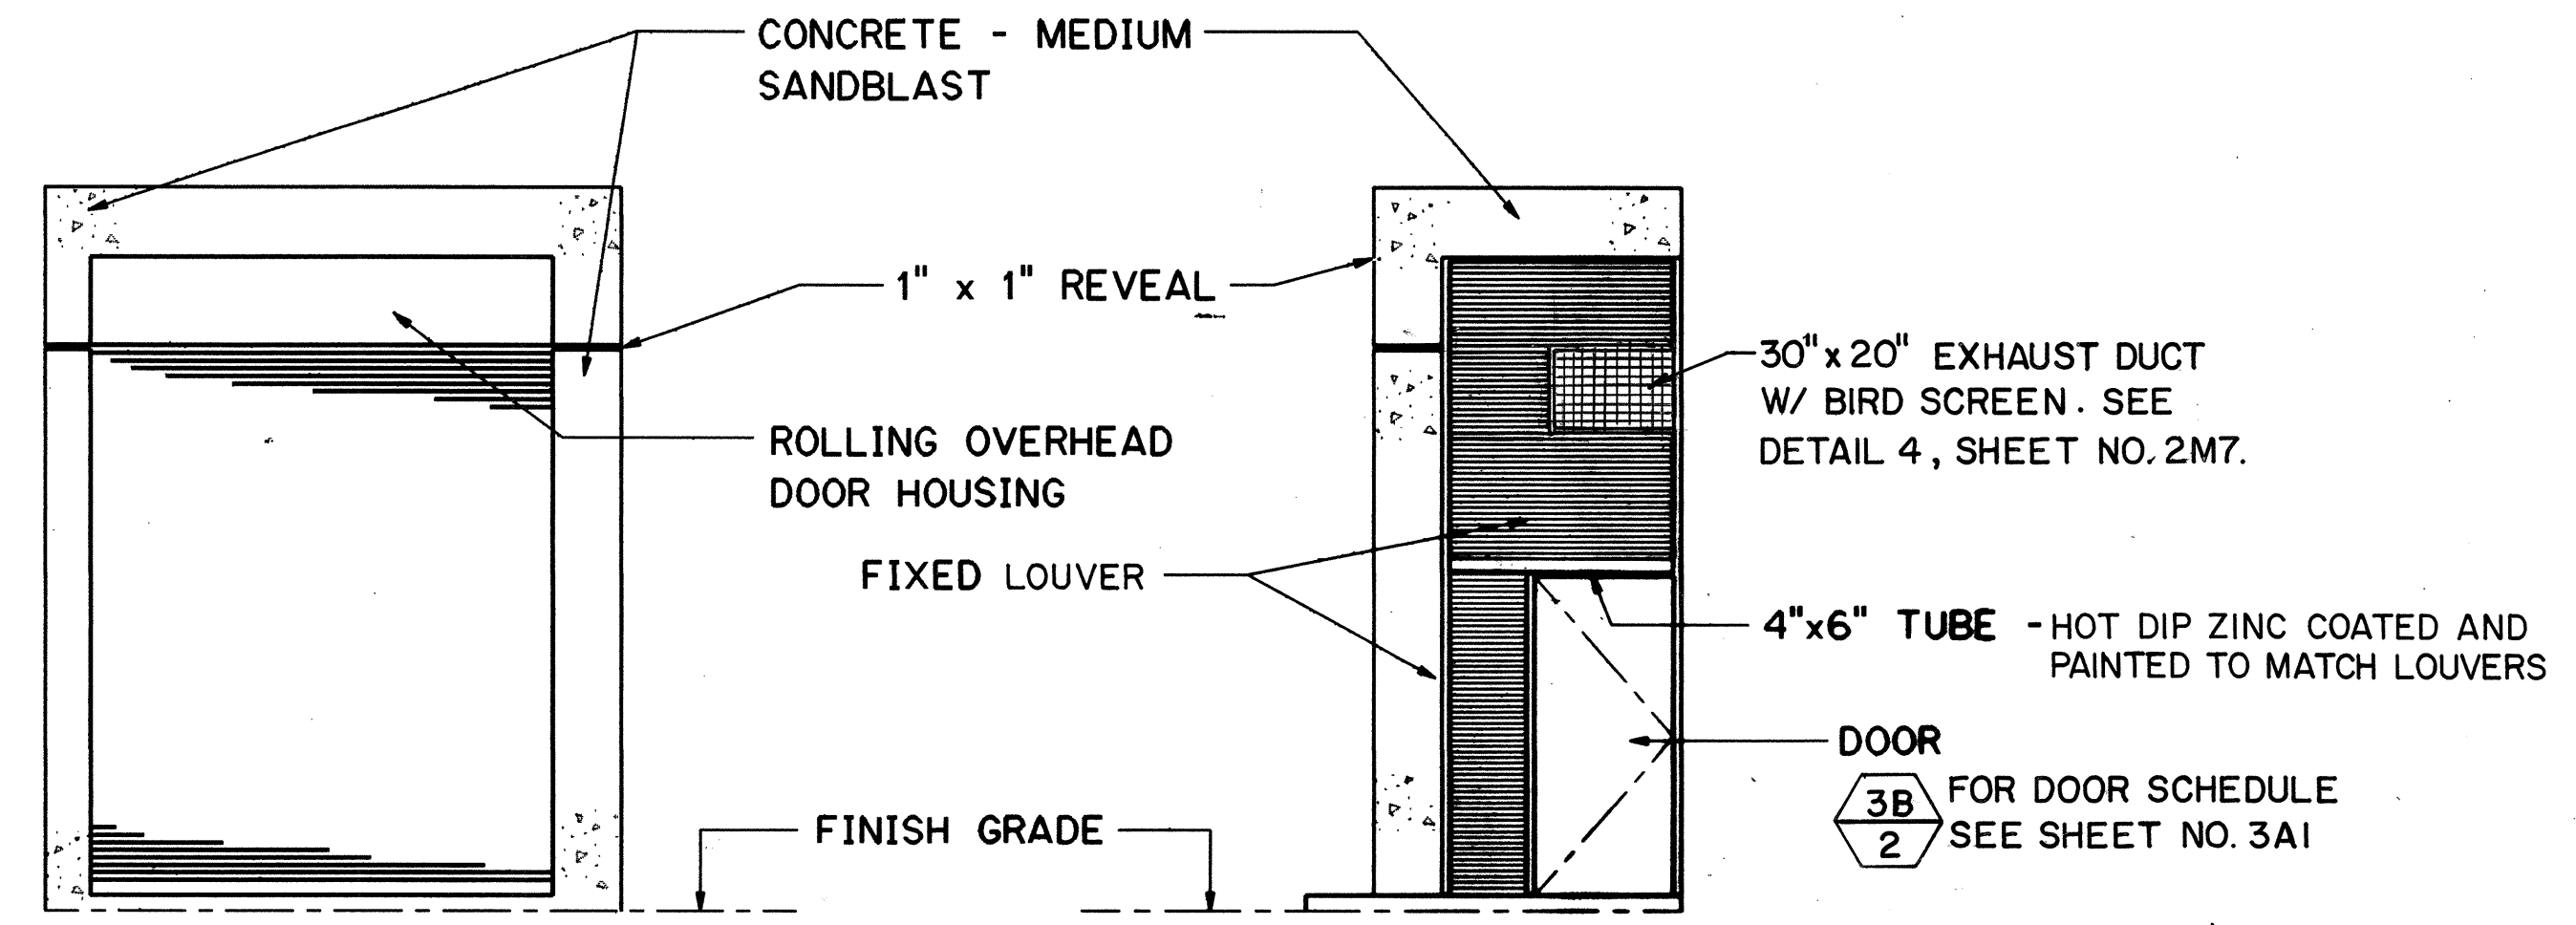


SOUTH ELEVATION - HALAWA GATE 2
SCALE: 1/4" = 1'-0"



EAST ELEVATION - HALAWA GATE 3
SCALE: 1/4" = 1'-0"

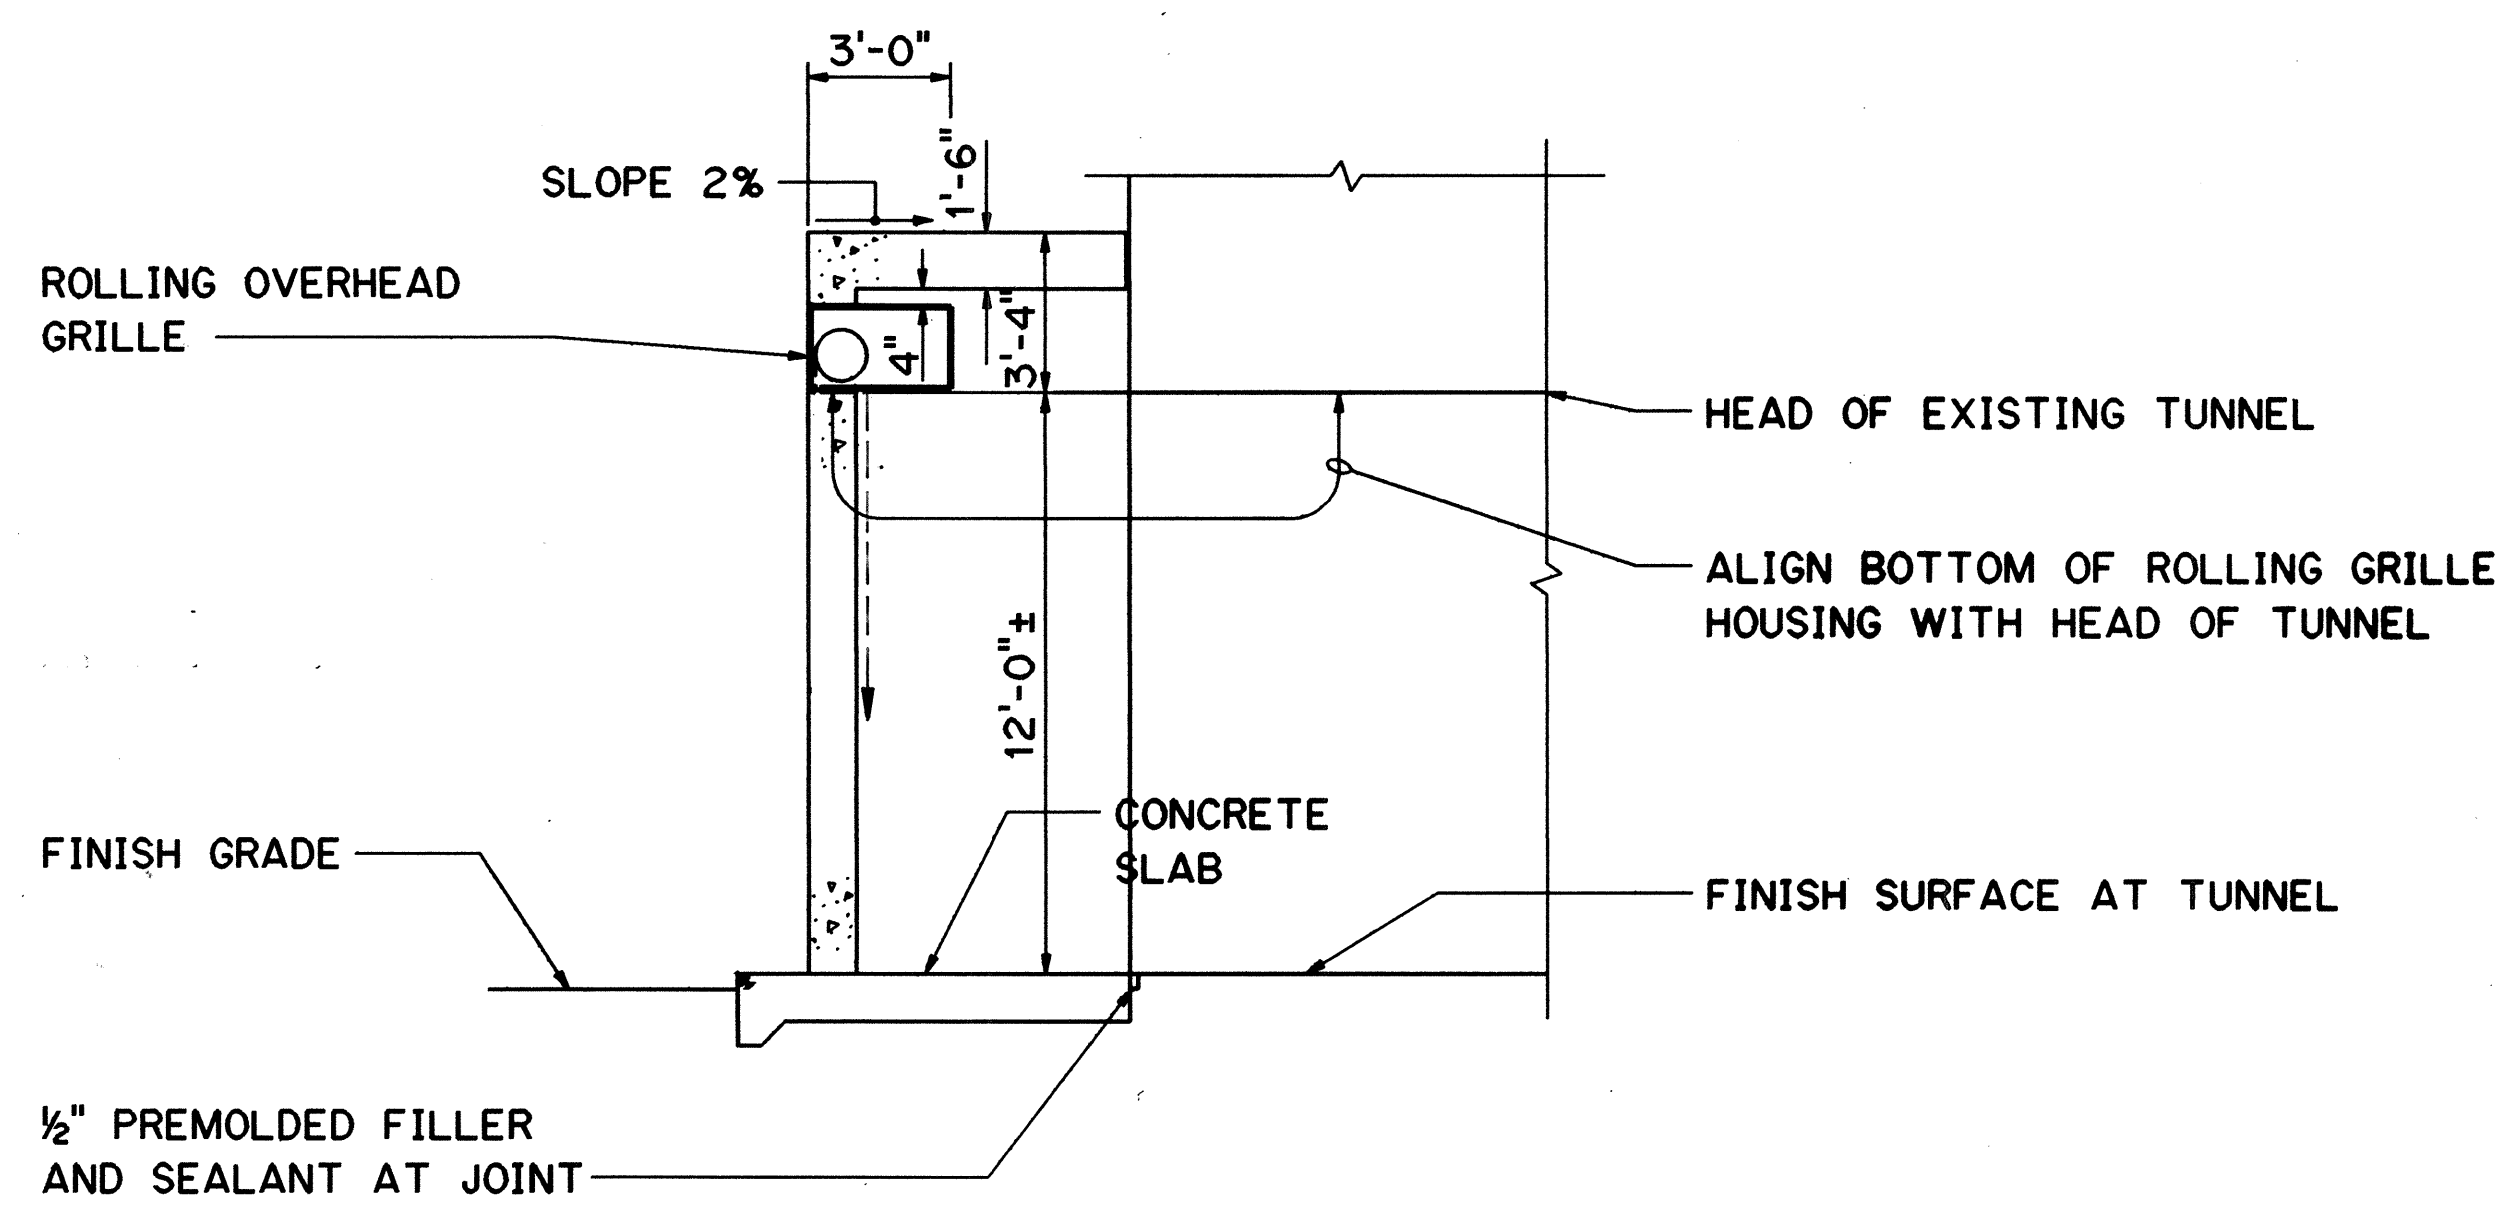

SECTION AT HALAWA A
SCALE: 1/4" = 1'-0"

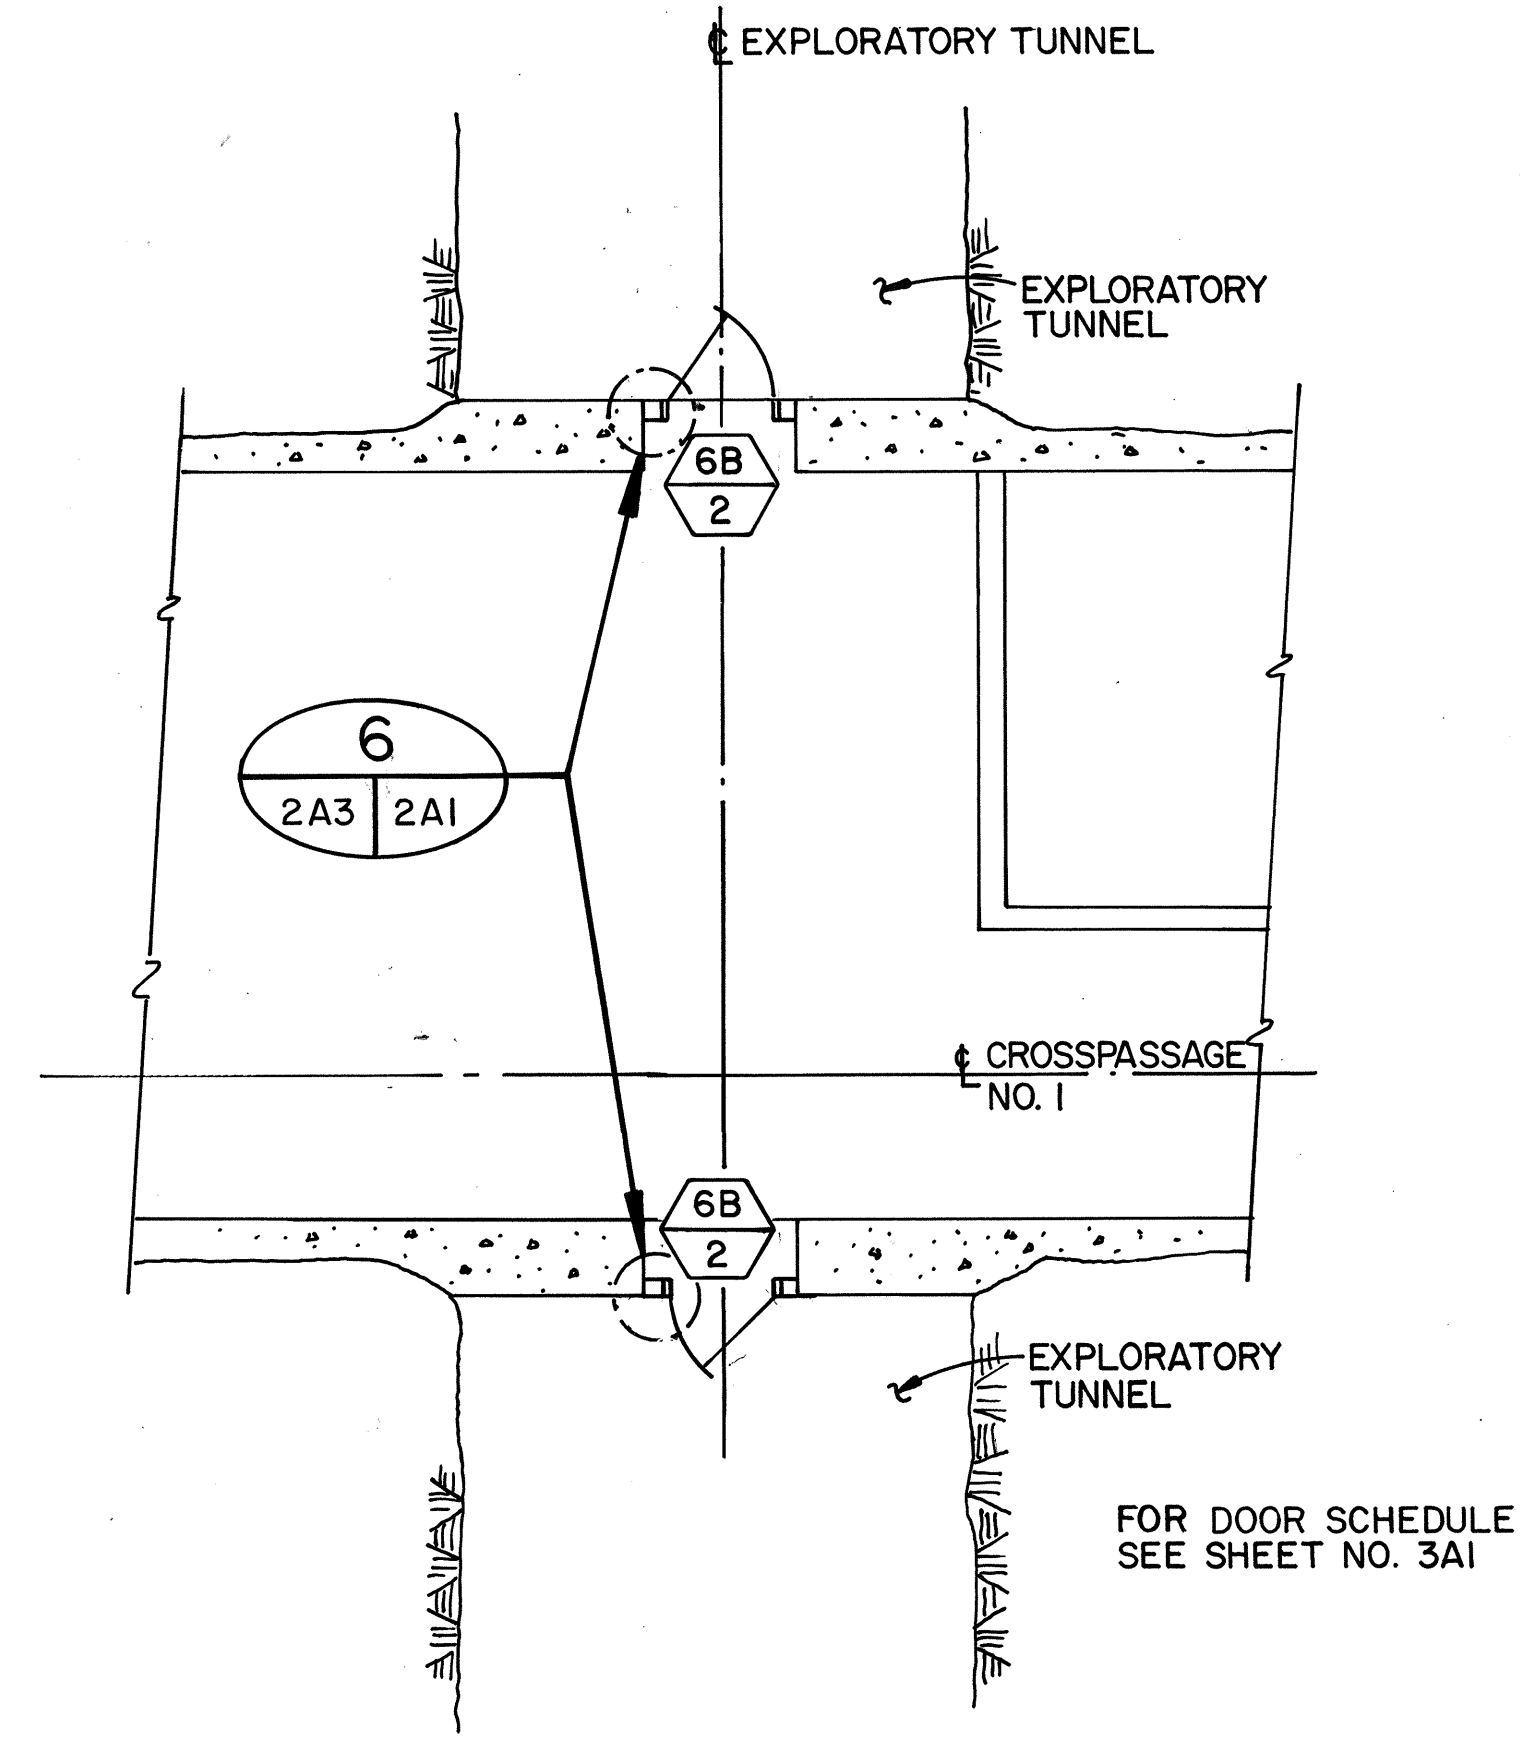

CROSSPASSAGE NO. 1 PLAN
SCALE: 3/16" = 1'-0"

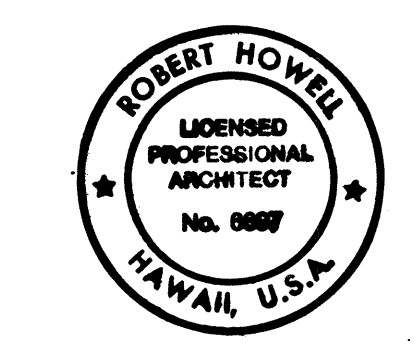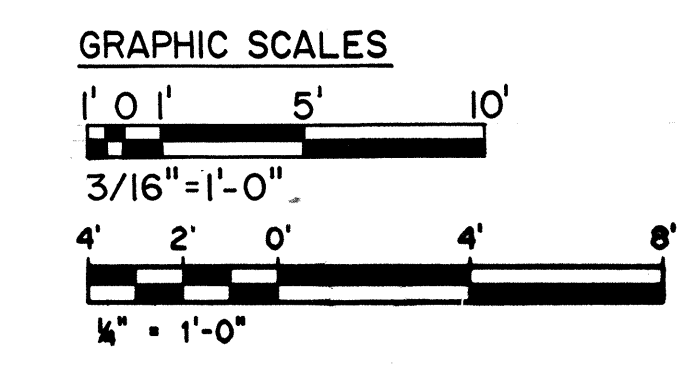


THIS WORK WAS PREPARED BY ME OR UNDER MY SUPERVISION
Robert Howell

FOR DETAIL AS-BUILT INFORMATION REFER TO CONSTRUCTION SUBMITTALS



DATE	REVISION
3/3/97	DCN 75-013: ADDED CROSSPASSAGE NO. 1 PLAN & DOORS TO EXPLORATORY TUNNEL
10/27/95	ADDENDUM 2 - REVISED FINISH NOTE FOR 4" x 6" TUBE
10/13/95	ADDENDUM 1
STATE OF HAWAII DEPARTMENT OF TRANSPORTATION HIGHWAYS DIVISION HALAWA GATE EXPLORATORY TUNNEL IMPROVEMENTS H-3 FINISH (UNIT III) FAIP NO. I-H3-1(75), UNIT III T.K. TUNNEL/ACCESS ROADS SCALE: 1/4" = 1'-0" DATE: JUN 1995	
SHEET NO. 2A1	OF 3 SHEETS

ORIGINAL PLAN	DATE
DESIGNED BY	NOT 94
TRACED BY	NOT 94
NOTED BY	NOT 94
QUANTITIES BY	NOT 94
CHECKED BY	NOT 94
NO.	


FED. ROAD DIST. NO.	STATE	FED. AID PROJ. NO.	FISCAL YEAR	SHEET NO.	TOTAL SHEETS
HAWAII	HAW.	I-H3-1(75) UNIT III	1994	46	353

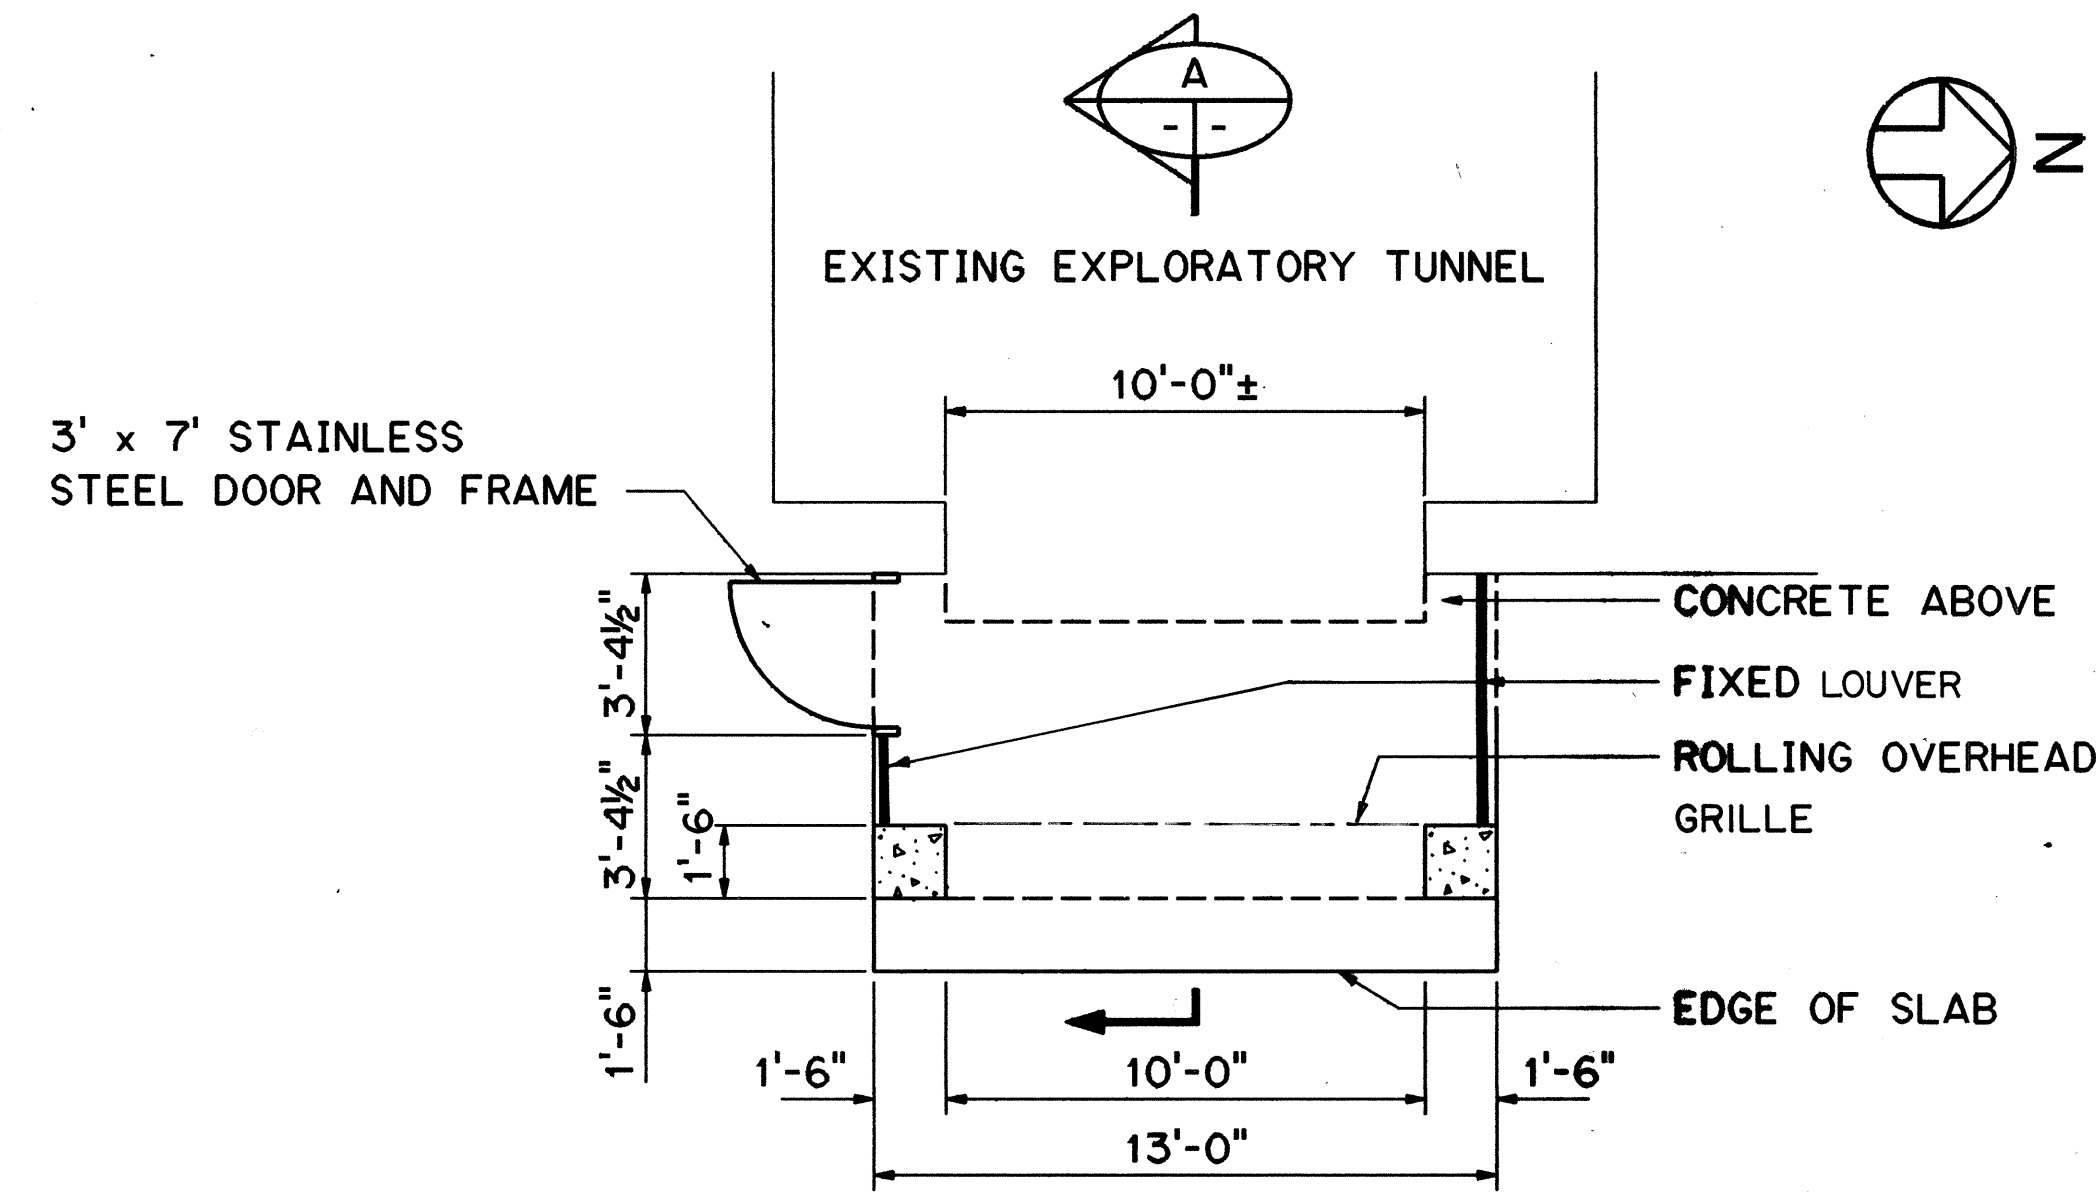



PLAN - HAIKU GATE
SCALE: 1/4" = 1'-0"

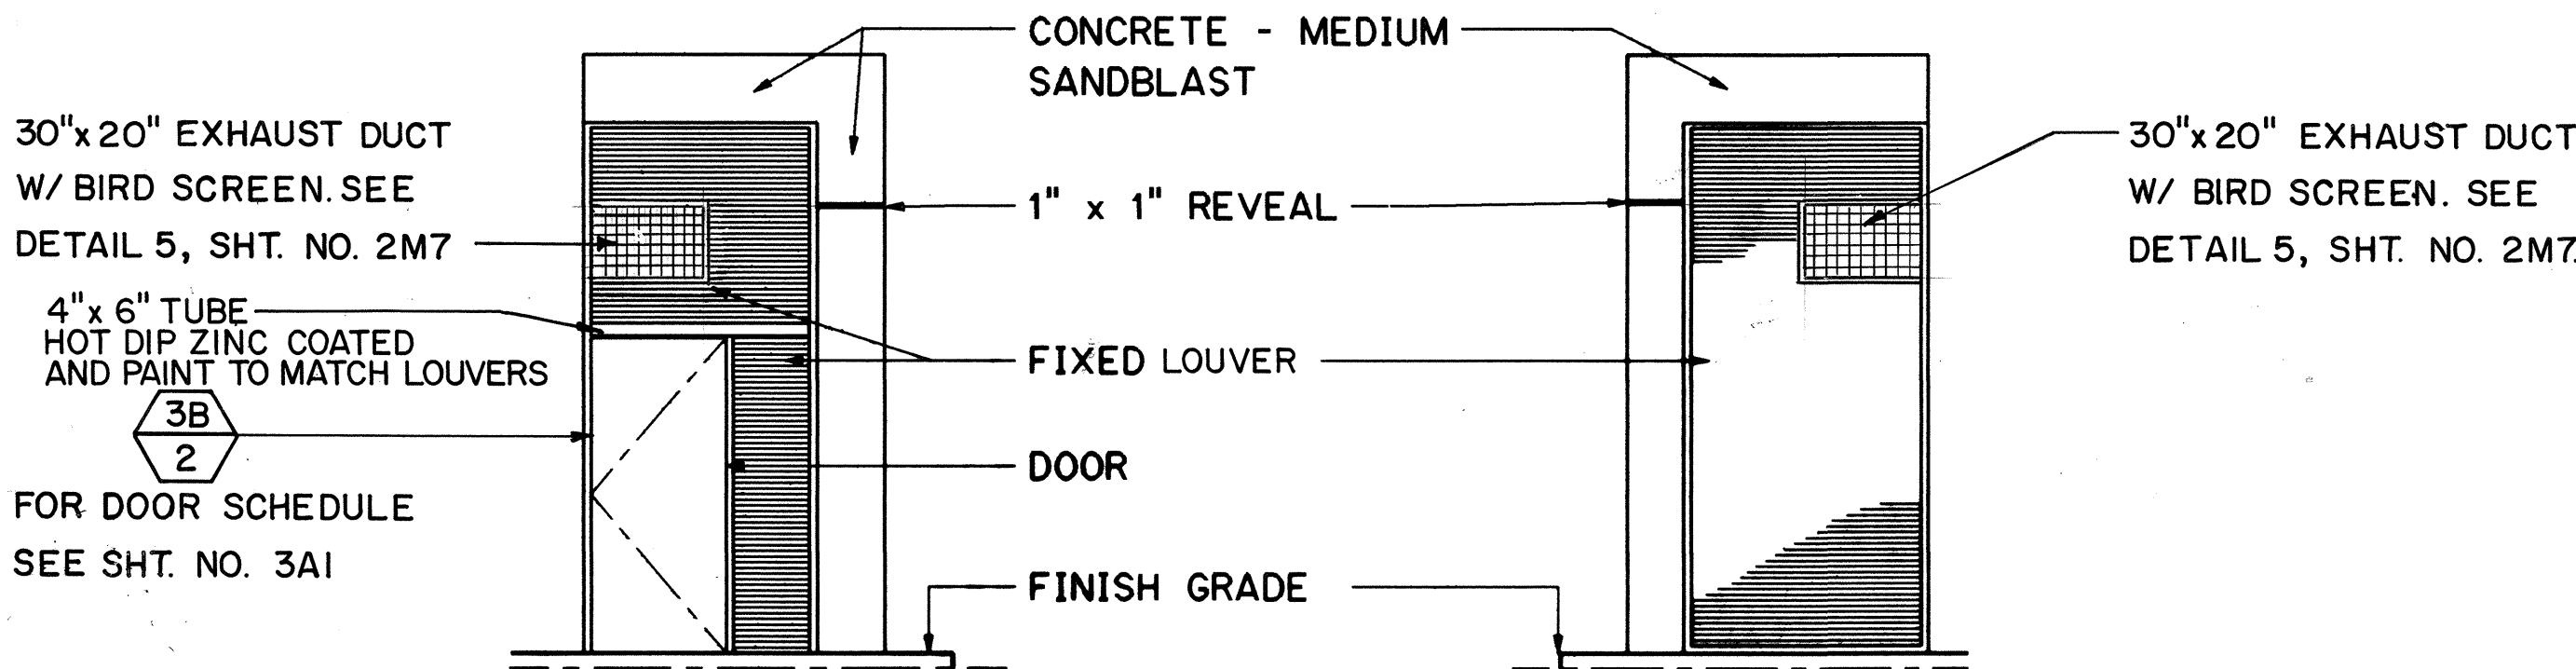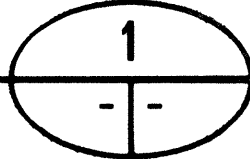



SOUTH ELEVATION -
HAIKU GATE
SCALE: 1/4" = 1'-0"

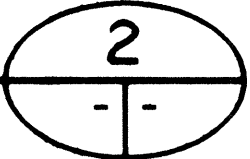




NORTH ELEVATION -
HAIKU GATE
SCALE: 1/4" = 1'-0"

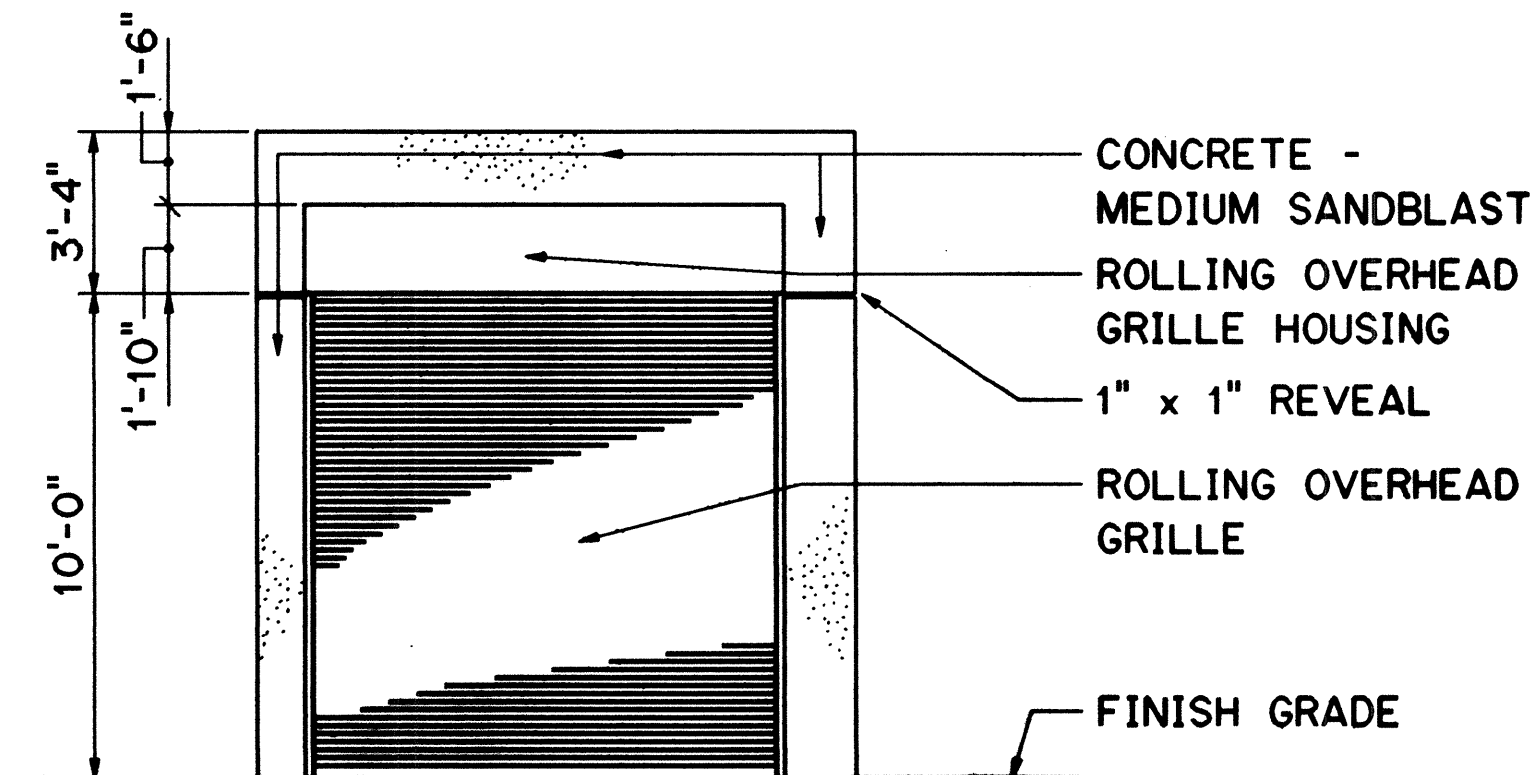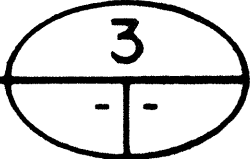

EAST ELEVATION -
HAIKU GATE
SCALE: 1/4" = 1'-0"

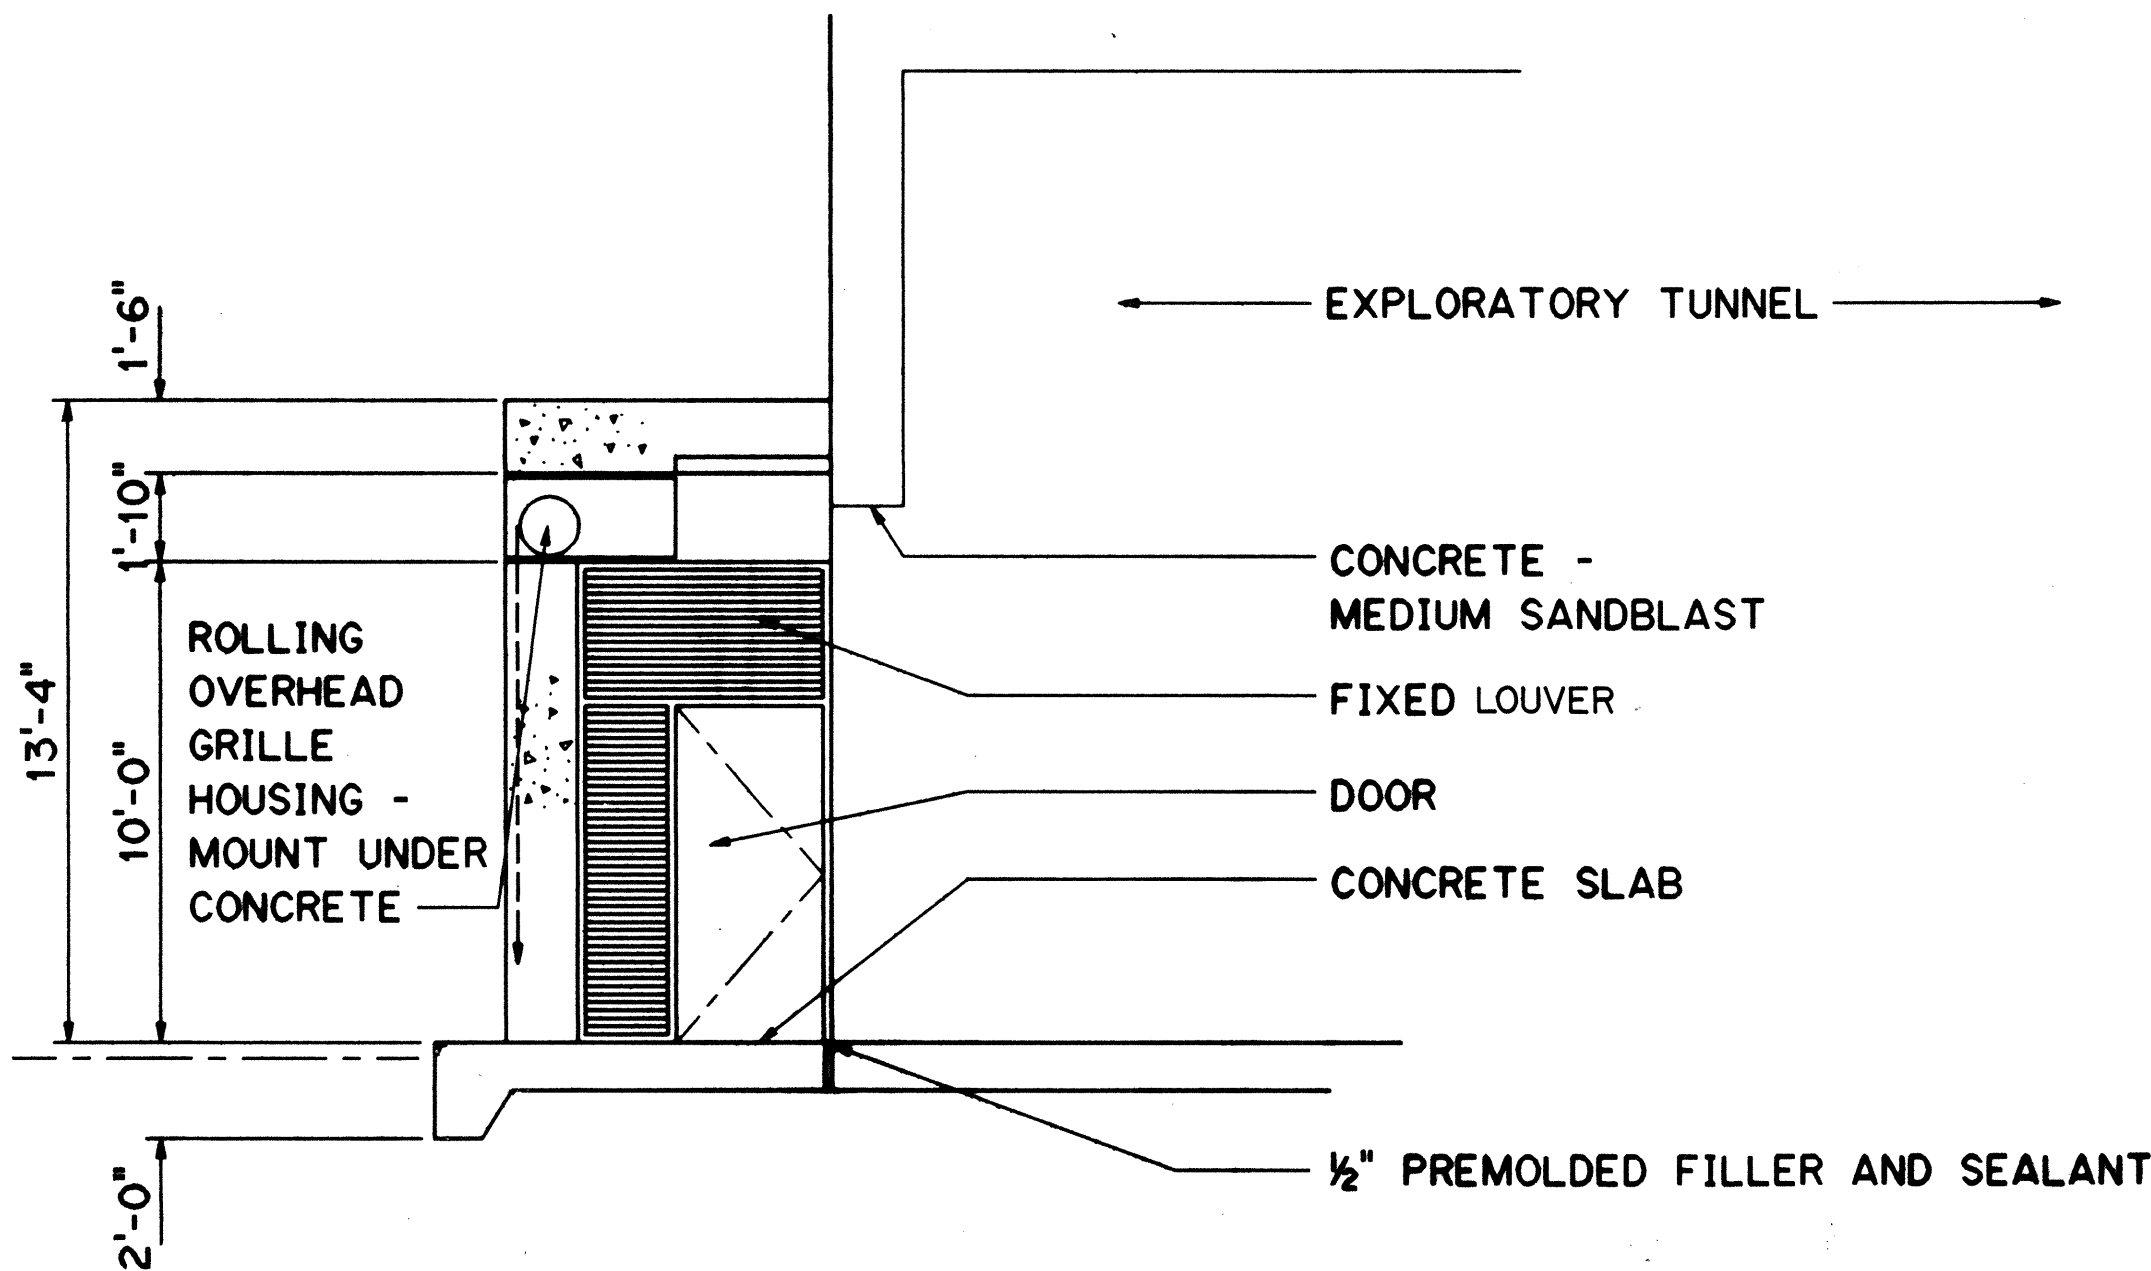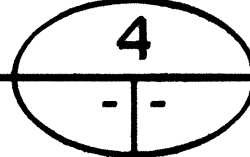

SECTION AT
HAIKU GATE
SCALE: 1/4" = 1'-0"

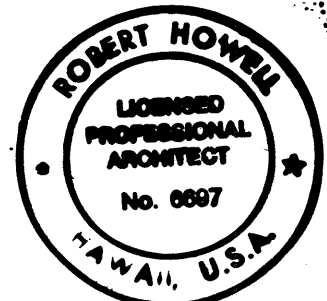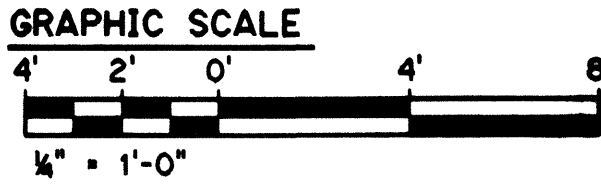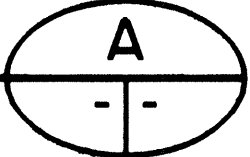

THIS WORK WAS PREPARED BY ME
OR UNDER MY SUPERVISION


Robert Howell

10/27/95	ADDENDUM 2- ADDED FINISH NOTE FOR 4"x6" TUBE
10/13/95	ADDENDUM 1
DATE	REVISION
STATE OF HAWAII DEPARTMENT OF TRANSPORTATION HIGHWAYS DIVISION HAIKU GATE EXPLORATORY TUNNEL IMPROVEMENTS H-3 FINISH (UNIT III) FAIP NO. I-H3-1(75), UNIT III T.K. TUNNEL/ACCESS ROADS SCALE: 1/4" = 1'-0" DATE: JUN 1995 SHEET NO. 2A2 OF 3 SHEETS	


DATE	NOV 94
DESIGNED BY	C. FREY
CHECKED BY	B. HOWELL
NO.	

FED. ROAD DIST. NO.	STATE	FED. AID PROJ. NO.	FISCAL YEAR	SHEET NO.	TOTAL SHEETS
HAWAII	HAW.	I-H3-1(75) UNIT III	1994	47	353

- NOTES:**
- FOR DOOR IDENTIFICATION AND LOCATION, SEE SHT. NOS. 2S6 THRU 2S10.
 - INSTALL ONE 12"x12" LOUVER EACH, BOTTOM OF LOUVER TO BE 12" ABOVE BOTTOM OF DOOR AT DOORS 14B 3 AND 10B 2.

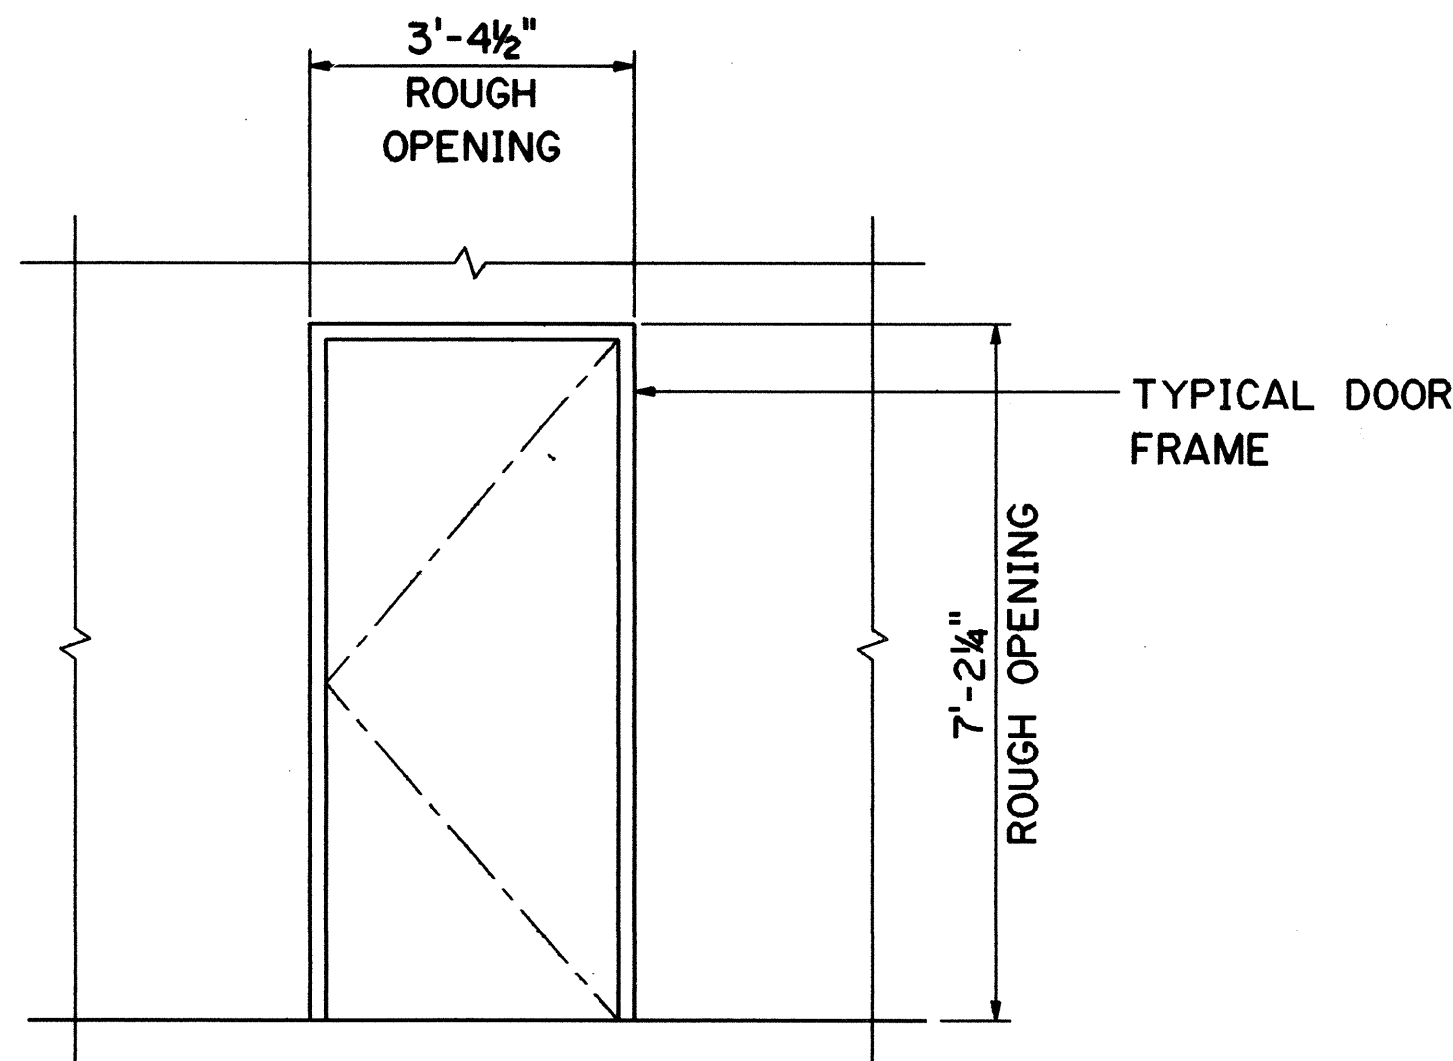


ELEVATION 1
SCALE: 1/2" = 1'-0"

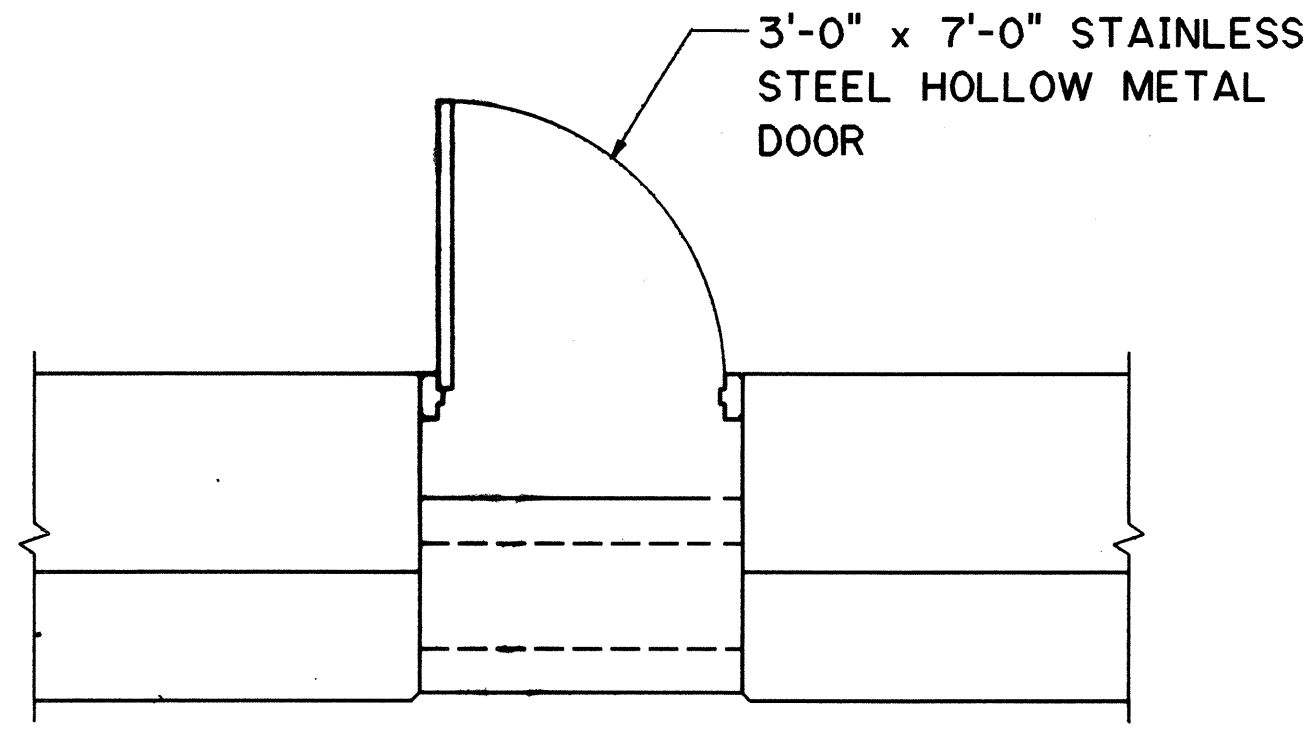


PLAN

DETAIL 2
SCALE: 1/2" = 1'-0"

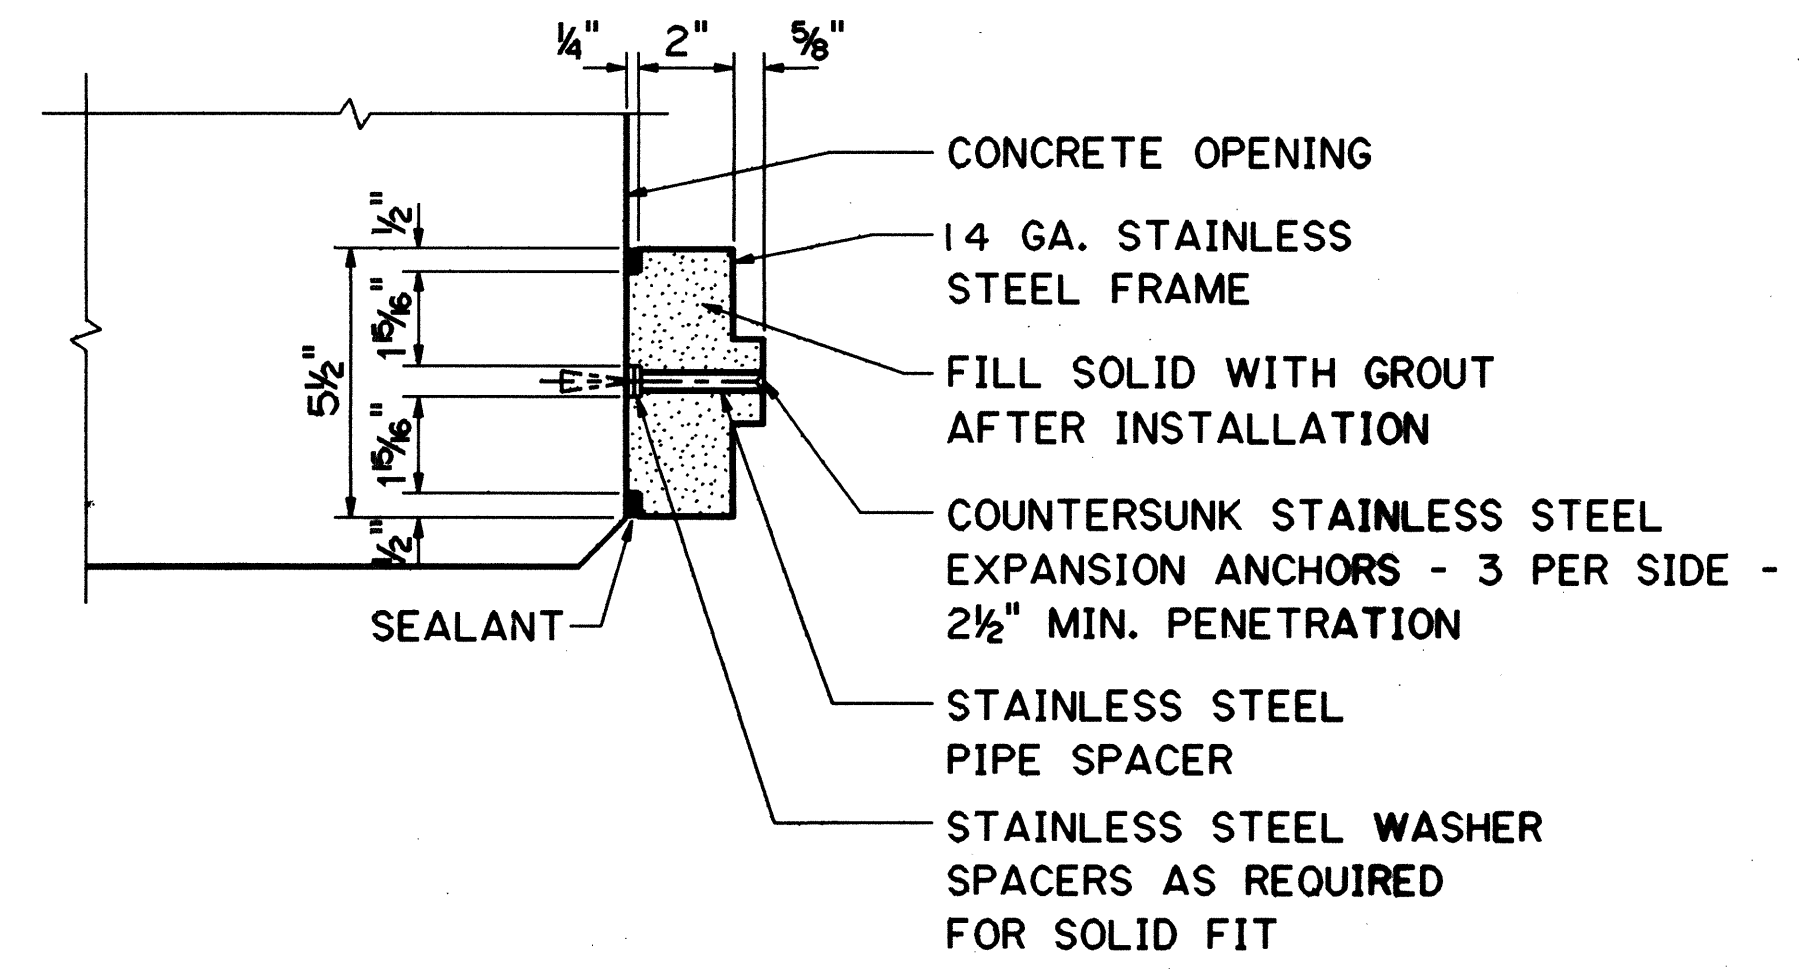



PLAN - TYPICAL DOOR JAMB

DETAIL 3
SCALE: 3" = 1'-0"

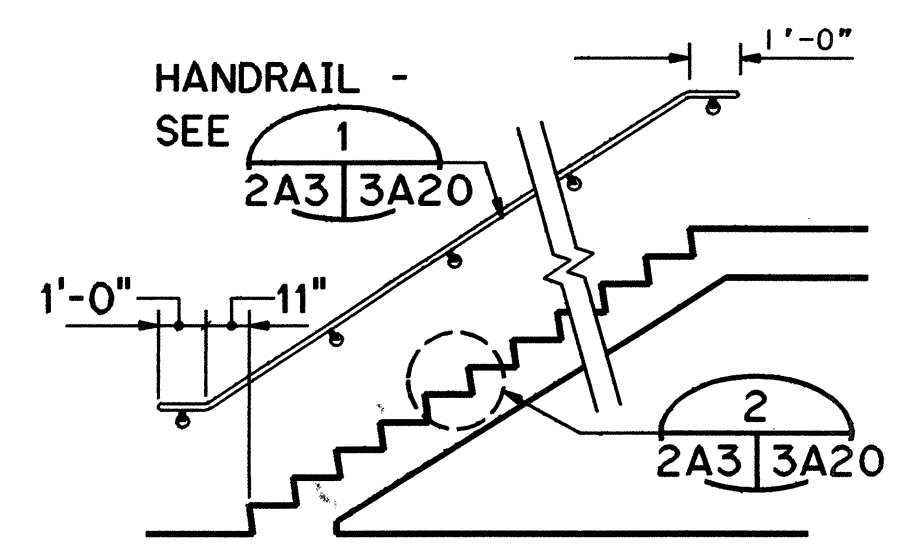


TYPICAL HANDRAIL AT STAIRS
EXPLORATORY TUNNEL TO CROSSPASSAGE CONNECTIONS

DETAIL 4
SCALE: 3" = 1'-0"
2S6 | 2A3
2S7
2S8
2S9
2S10

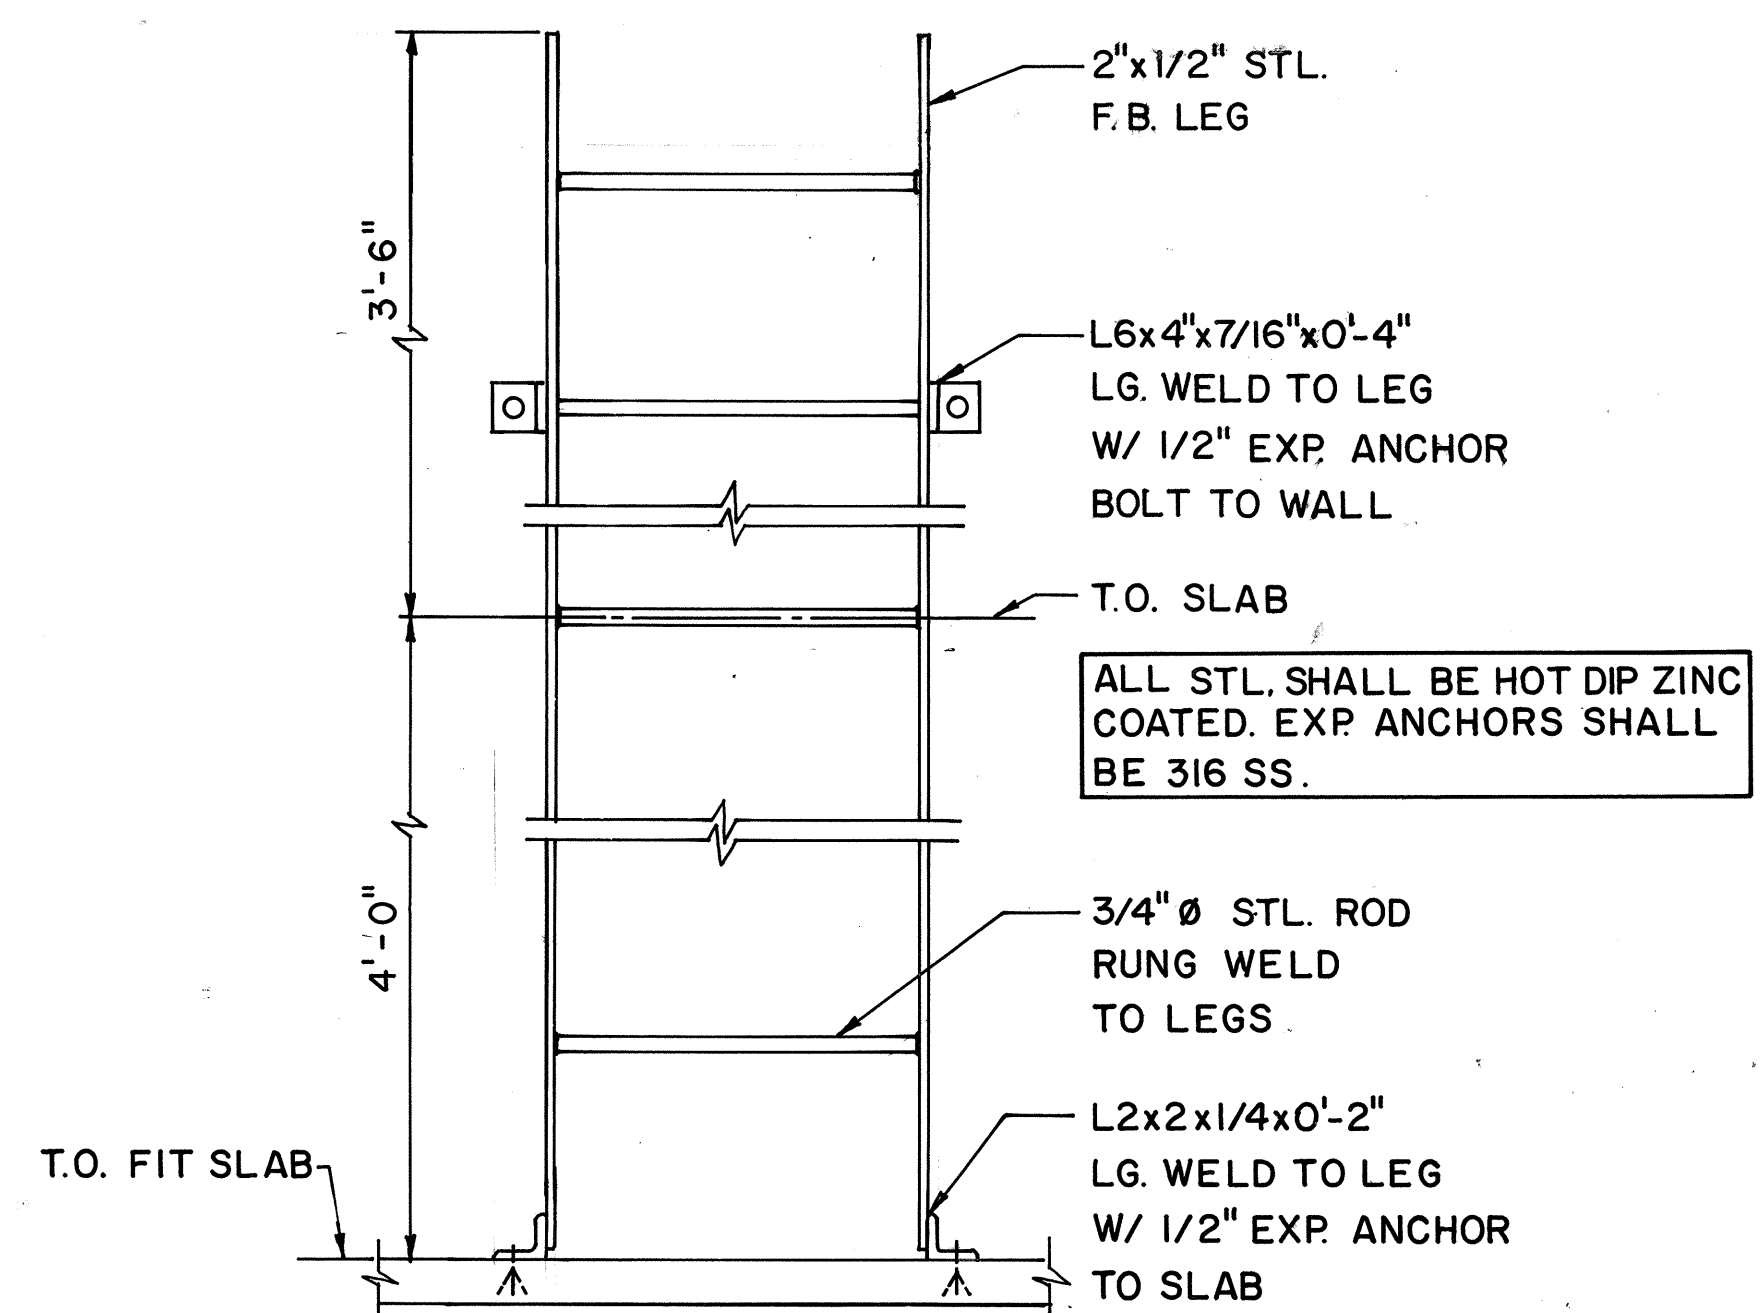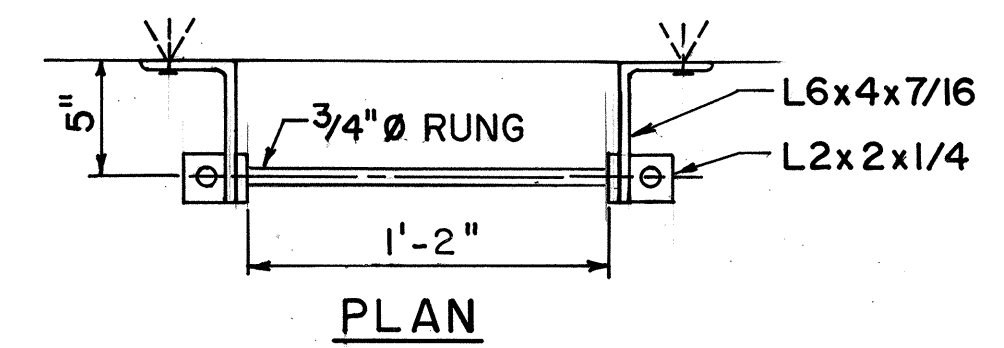

ELEVATION



PIT LADDER DETAIL 5
SCALE: 1 1/2" = 1'-0"
2S6 | 2A3
2S7
2S8
2S9
2S10, 3S18, 3A13

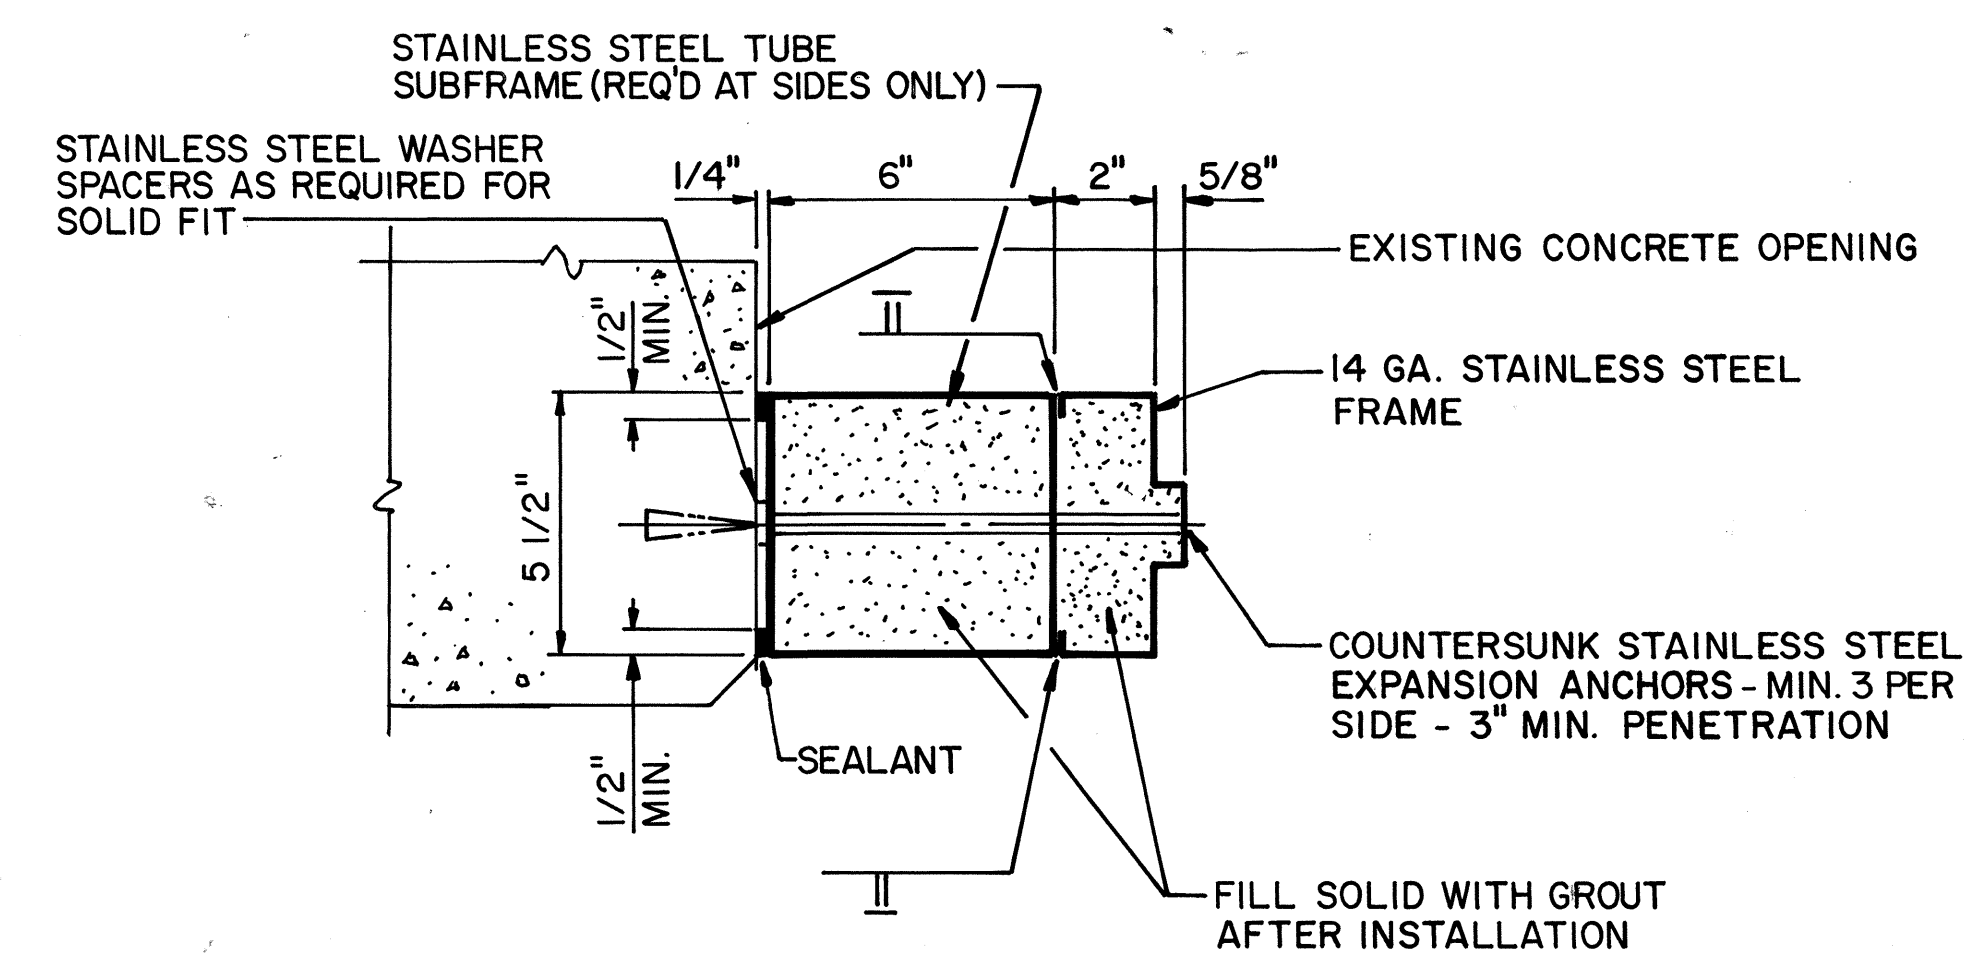

NOTE: FOR FRAME AT TOP OF DOOR SEE DETAIL 3, THIS SHEET

DOOR JAMB WITH SUBFRAME

DETAIL 6
SCALE: 3" = 1'-0"
2A3 | 2A1

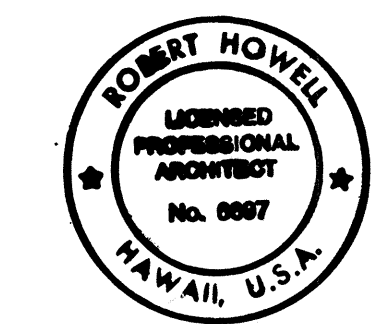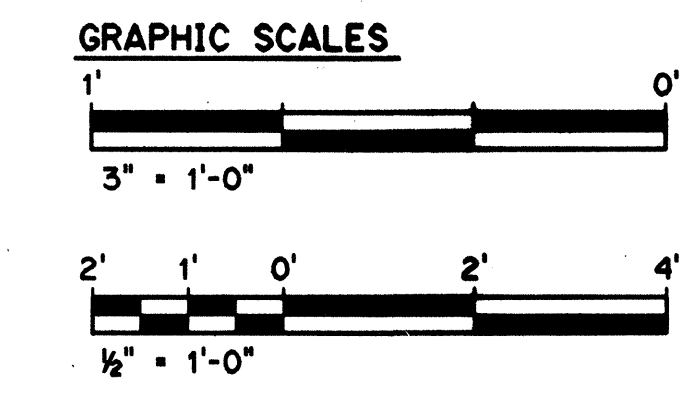

THIS WORK WAS PREPARED BY ME OR UNDER MY SUPERVISION

Robert Howell

DATE	REVISION
3/3/97	DCN 75-013: ADDED DETAIL 6
10/13/95	ADDENDUM I

STATE OF HAWAII
DEPARTMENT OF TRANSPORTATION
HIGHWAYS DIVISION

DOOR & RAILING DETAILS

EXPLORATORY TUNNEL IMPROVEMENTS
H-3 FINISH (UNIT III)
FAIP NO. I-H3-1(75), UNIT III
T.K. TUNNEL/ACCESS ROADS

SCALE: 1/4" = 1'-0" DATE: JUN 1995

SHEET NO. 2A3 OF 3 SHEETS



ADD.47

SURVEY PLOTTED BY	DATE
DESIGNED BY	NOV 94
TRACED BY	B. BUNYI
NOTED BY	NOV 94
QUANTITIES BY	C. FREY
CHECKED BY	R. HOWELL
NO.	DEC 94



FED. ROAD DIST. NO.	STATE	FED. AID PROJ. NO.	FISCAL YEAR	SHEET NO.	TOTAL SHEETS
HAWAII	HAW.	I-H3-1(75) UNIT III	1994	48	353

NOTES:

1. FOR GENERAL STRUCTURAL NOTES, SEE SHEET NO. 2S4.
2. FOR TUNNEL ALIGNMENT AND PROFILE, SEE CIVIL PLANS.
3. FOR PLAN AND SECTIONS AT THE PASSING POCKET, SEE SHEET NO. 2S5.
4. FOR PLAN AND SECTIONS AT THE TURNOUTS, SEE SHEET NO. 2S14.
5. FOR DETAIL AT ELECTRICAL NICHE, SEE SHEET NO. 2S13. FOR LOCATION OF NICHE, SEE ELECTRICAL PLANS.
6. FOR LOCATION OF TURNOUTS AND FAN ENLARGEMENTS SEE GEOTECHNICAL PLANS.

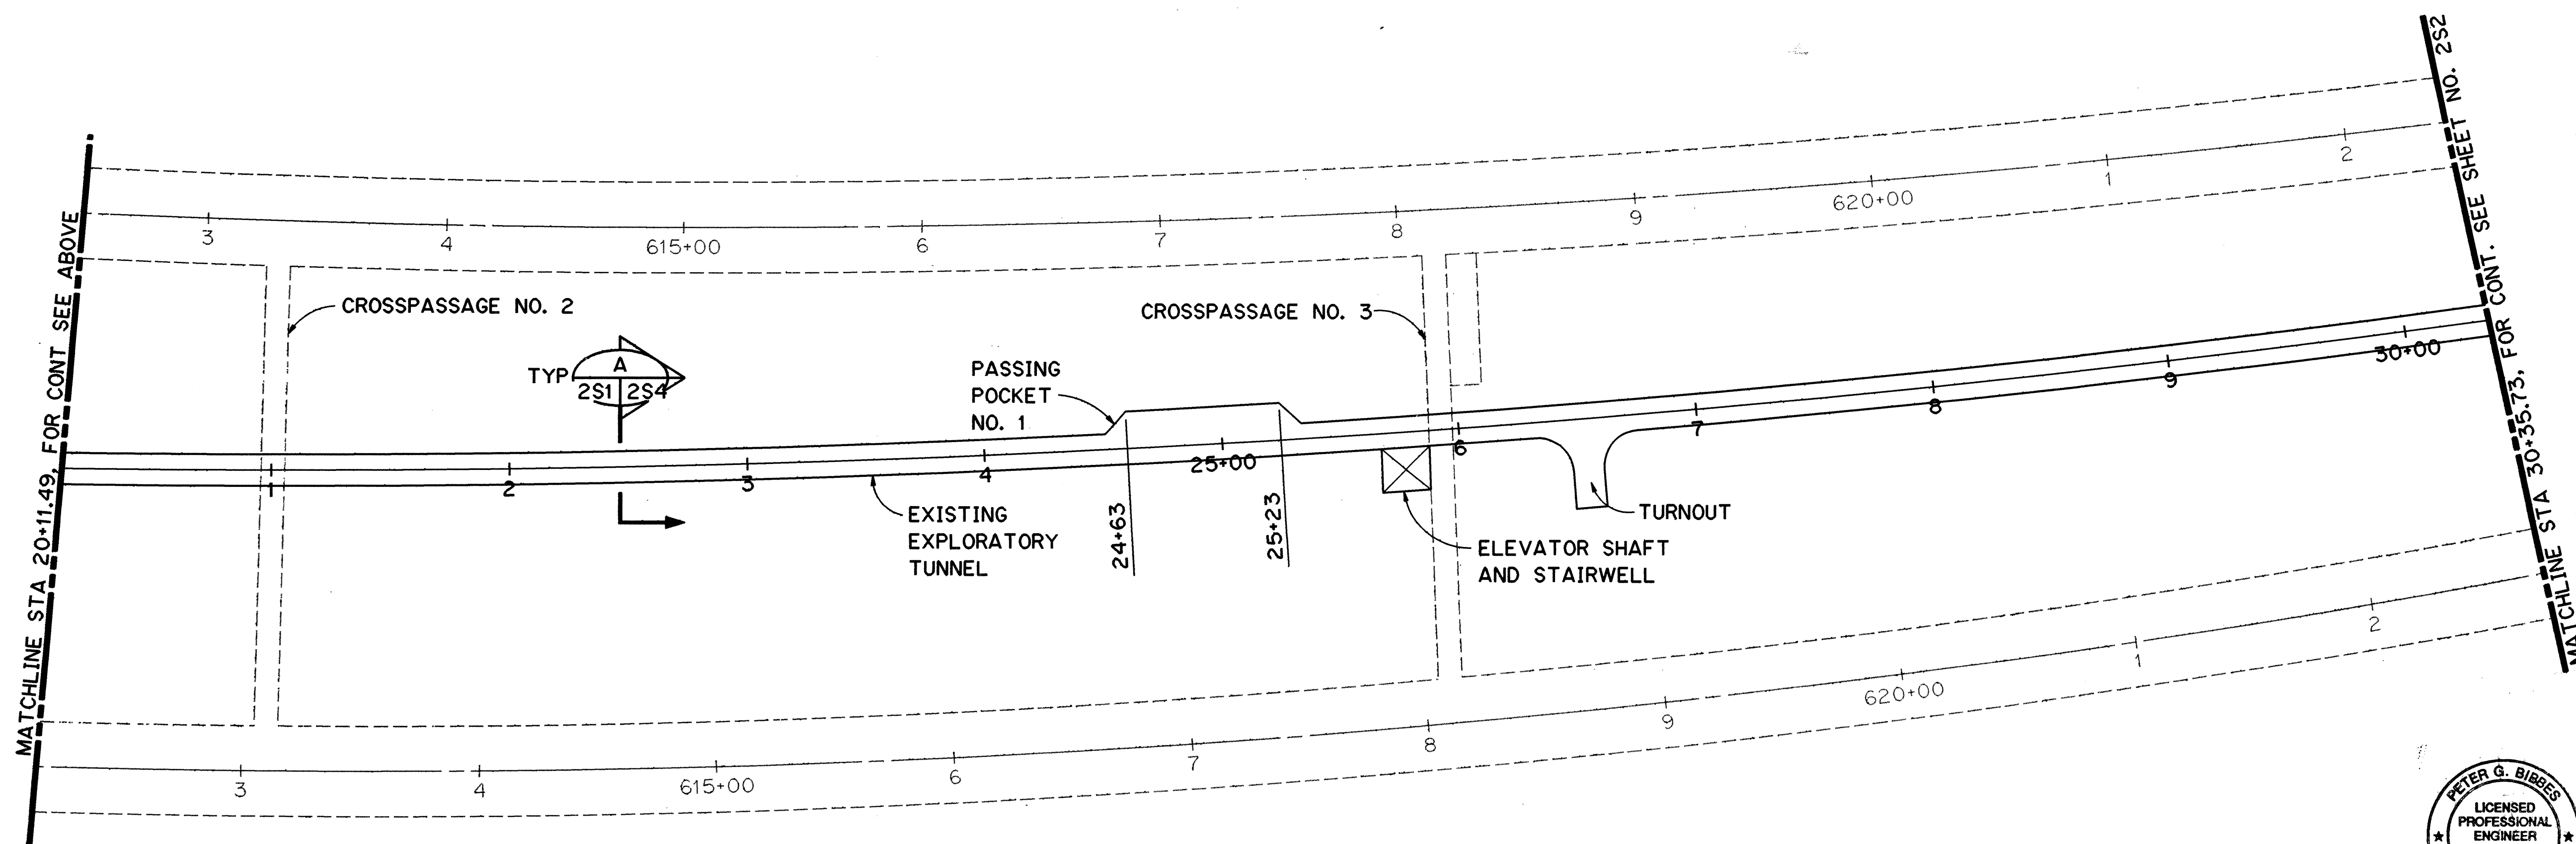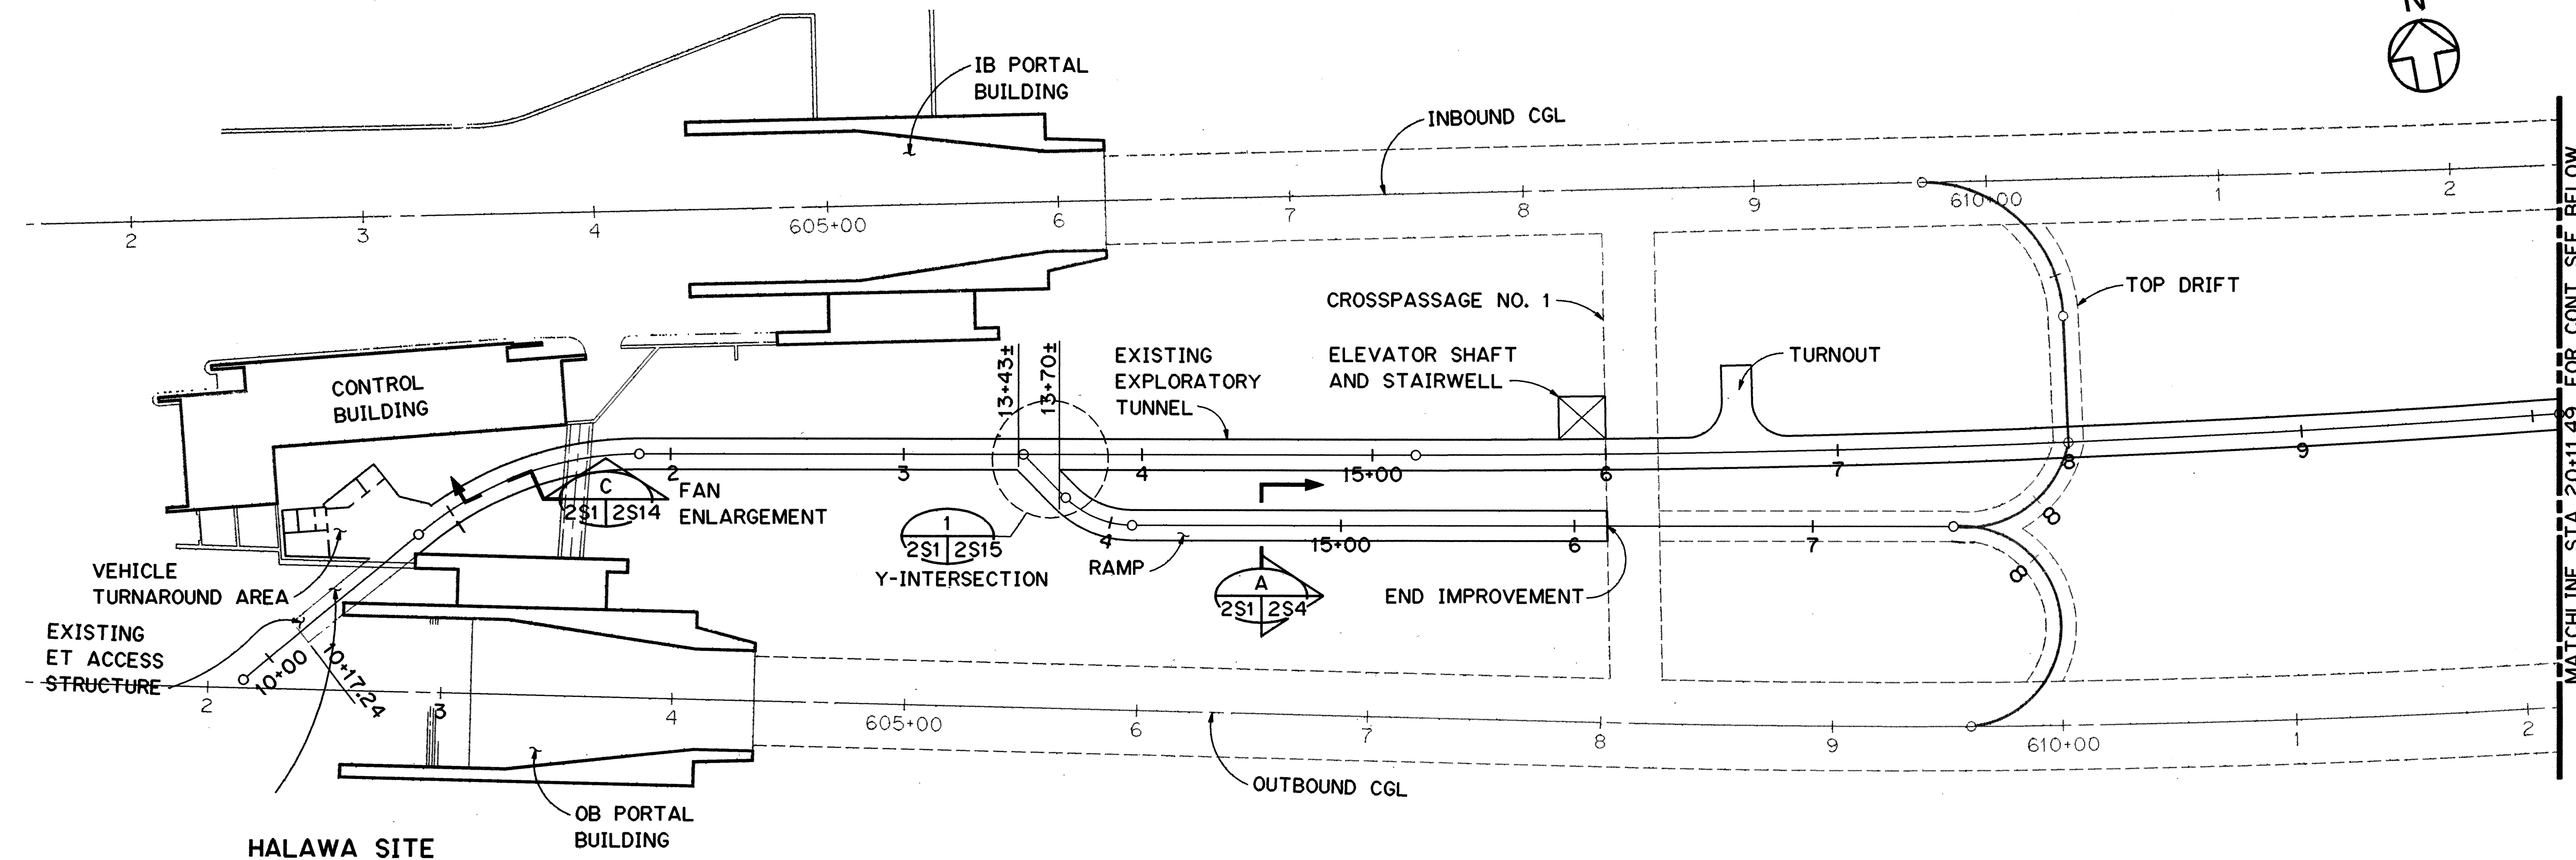

PARTIAL PLAN - EXPLORATORY TUNNEL

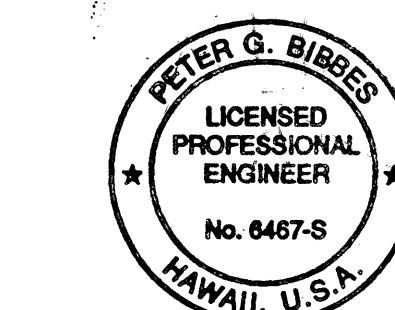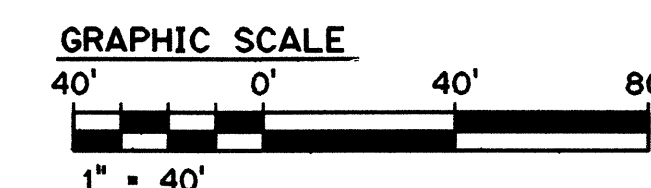

THIS WORK WAS PREPARED BY ME
OR UNDER MY SUPERVISION

Peter G. Biebes


FOR DETAIL AS-BUILT INFORMATION
REFER TO CONSTRUCTION SUBMITTALS

DATE	REVISION

STATE OF HAWAII DEPARTMENT OF TRANSPORTATION HIGHWAYS DIVISION
GENERAL PLAN - 1
EXPLORATORY TUNNEL IMPROVEMENTS
H-3 FINISH (UNIT III)
FAIP NO. I-H3-1(75), UNIT III
T.K. TUNNEL/ACCESS ROADS
SCALE: 1" = 40' DATE: JUN 1995
SHEET NO. 2S1 OF 17 SHEETS

NOTES:

1. FOR NOTES, SEE SHEET NO. 2S1.

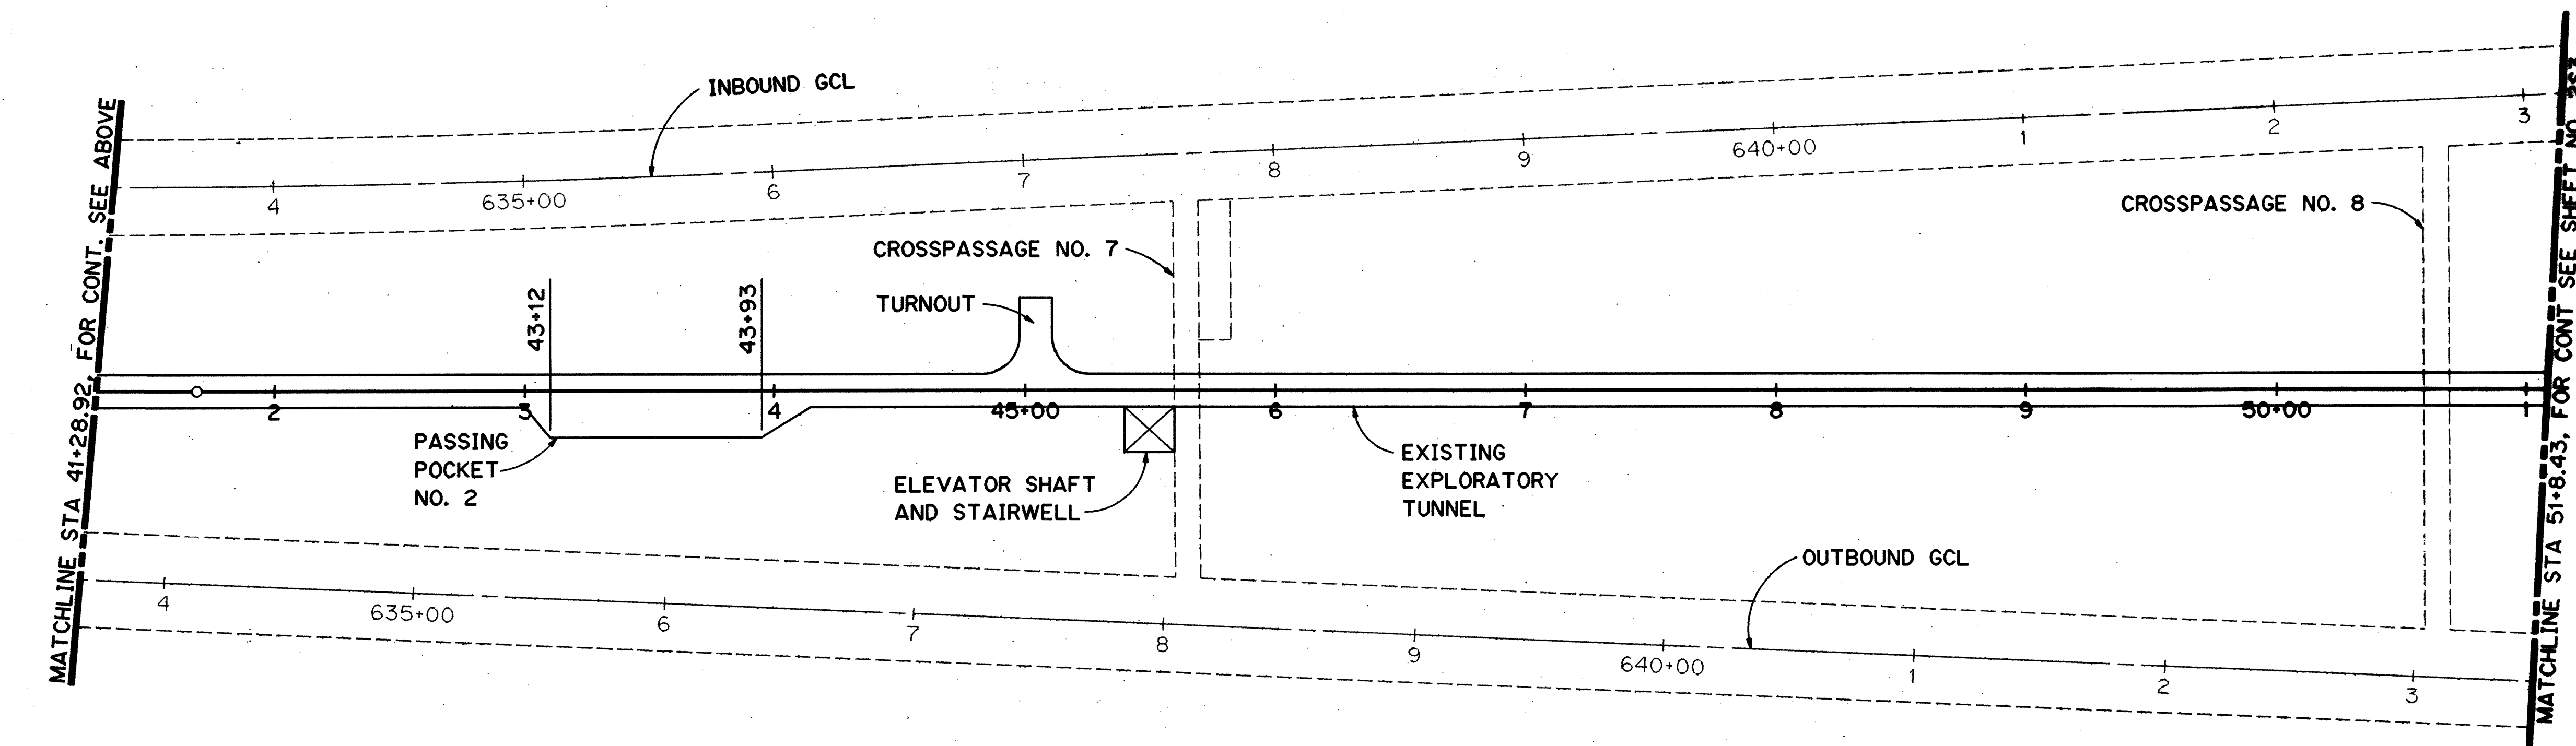

GRAPHIC SCALE

40' 0' 40'

1" = 40'

THIS WORK WAS PREPARED BY
OR UNDER MY SUPERVISION



DATE	REVISION



GENERAL PLAN - 2
EXPLORATORY TUNNEL IMPROVEMENTS
H-3 FINISH (UNIT III)
FAIP NO. I-H3-1(75), UNIT III
T.K. TUNNEL/ACCESS ROADS
SCALE: 1" = 40' DATE: JUN 1995
SHEET NO. 252 OF 17 SHEETS

FED. ROAD DIST. NO.	STATE	FED. AID PROJ. NO.	FISCAL YEAR	SHEET NO.	TOTAL SHEETS
HAWAII	HAW.	I-H3-1(75) UNIT III	1994	50	353





NOTES:

- FOR NOTES, SEE SHEET NO. 2S1.

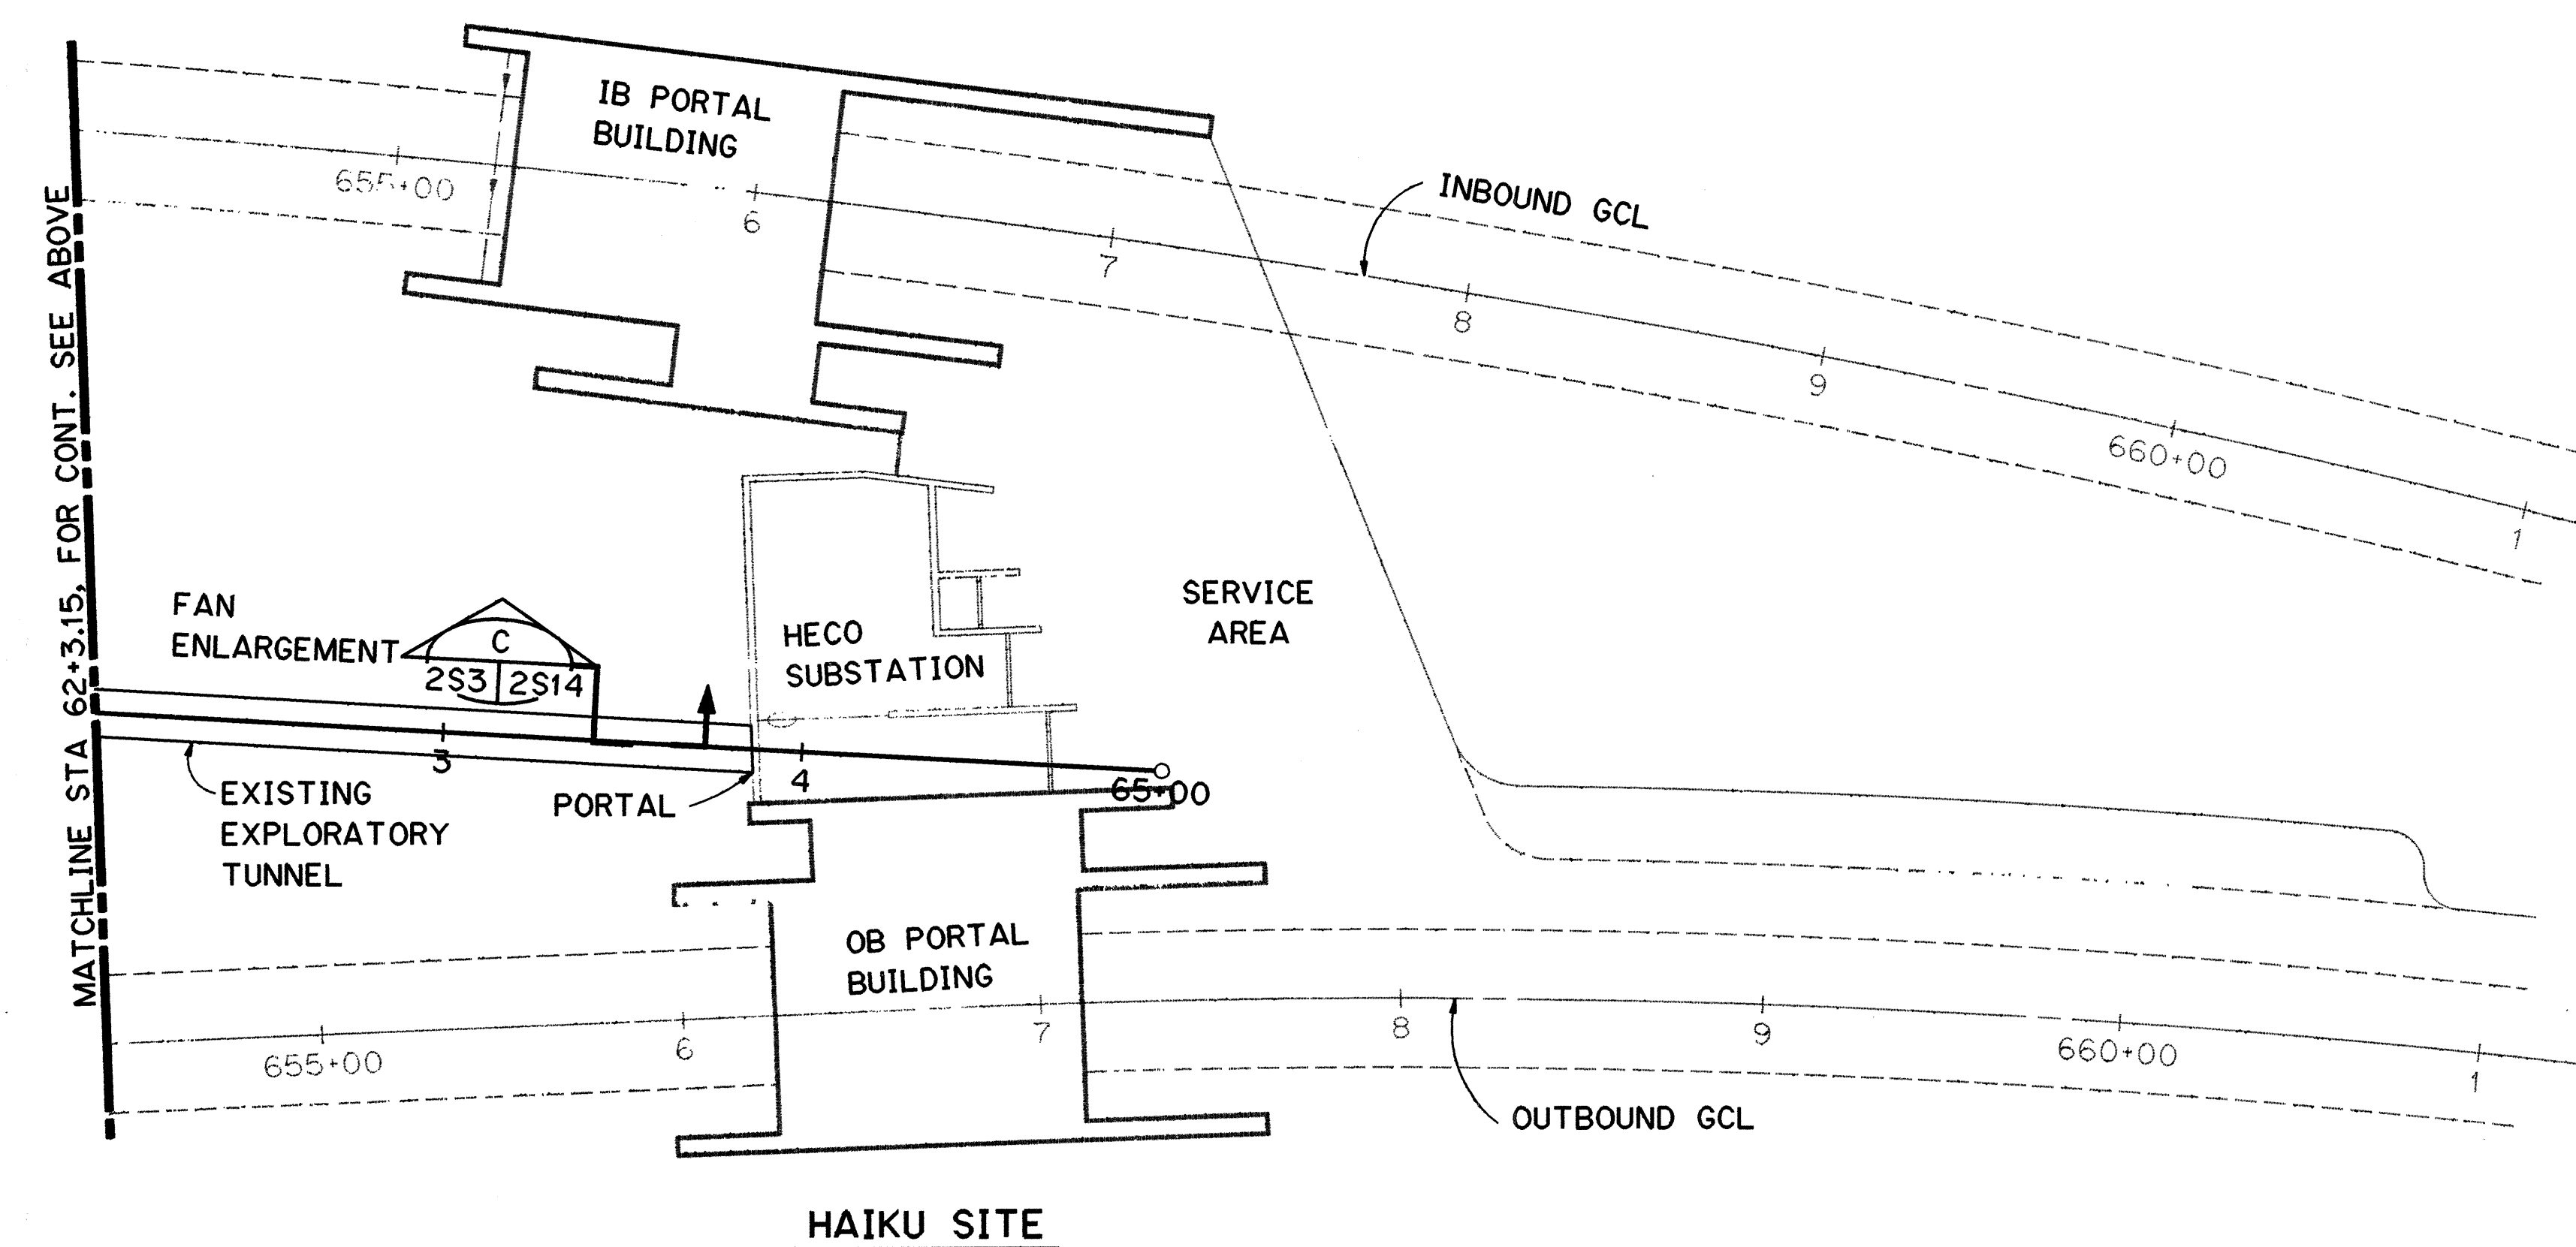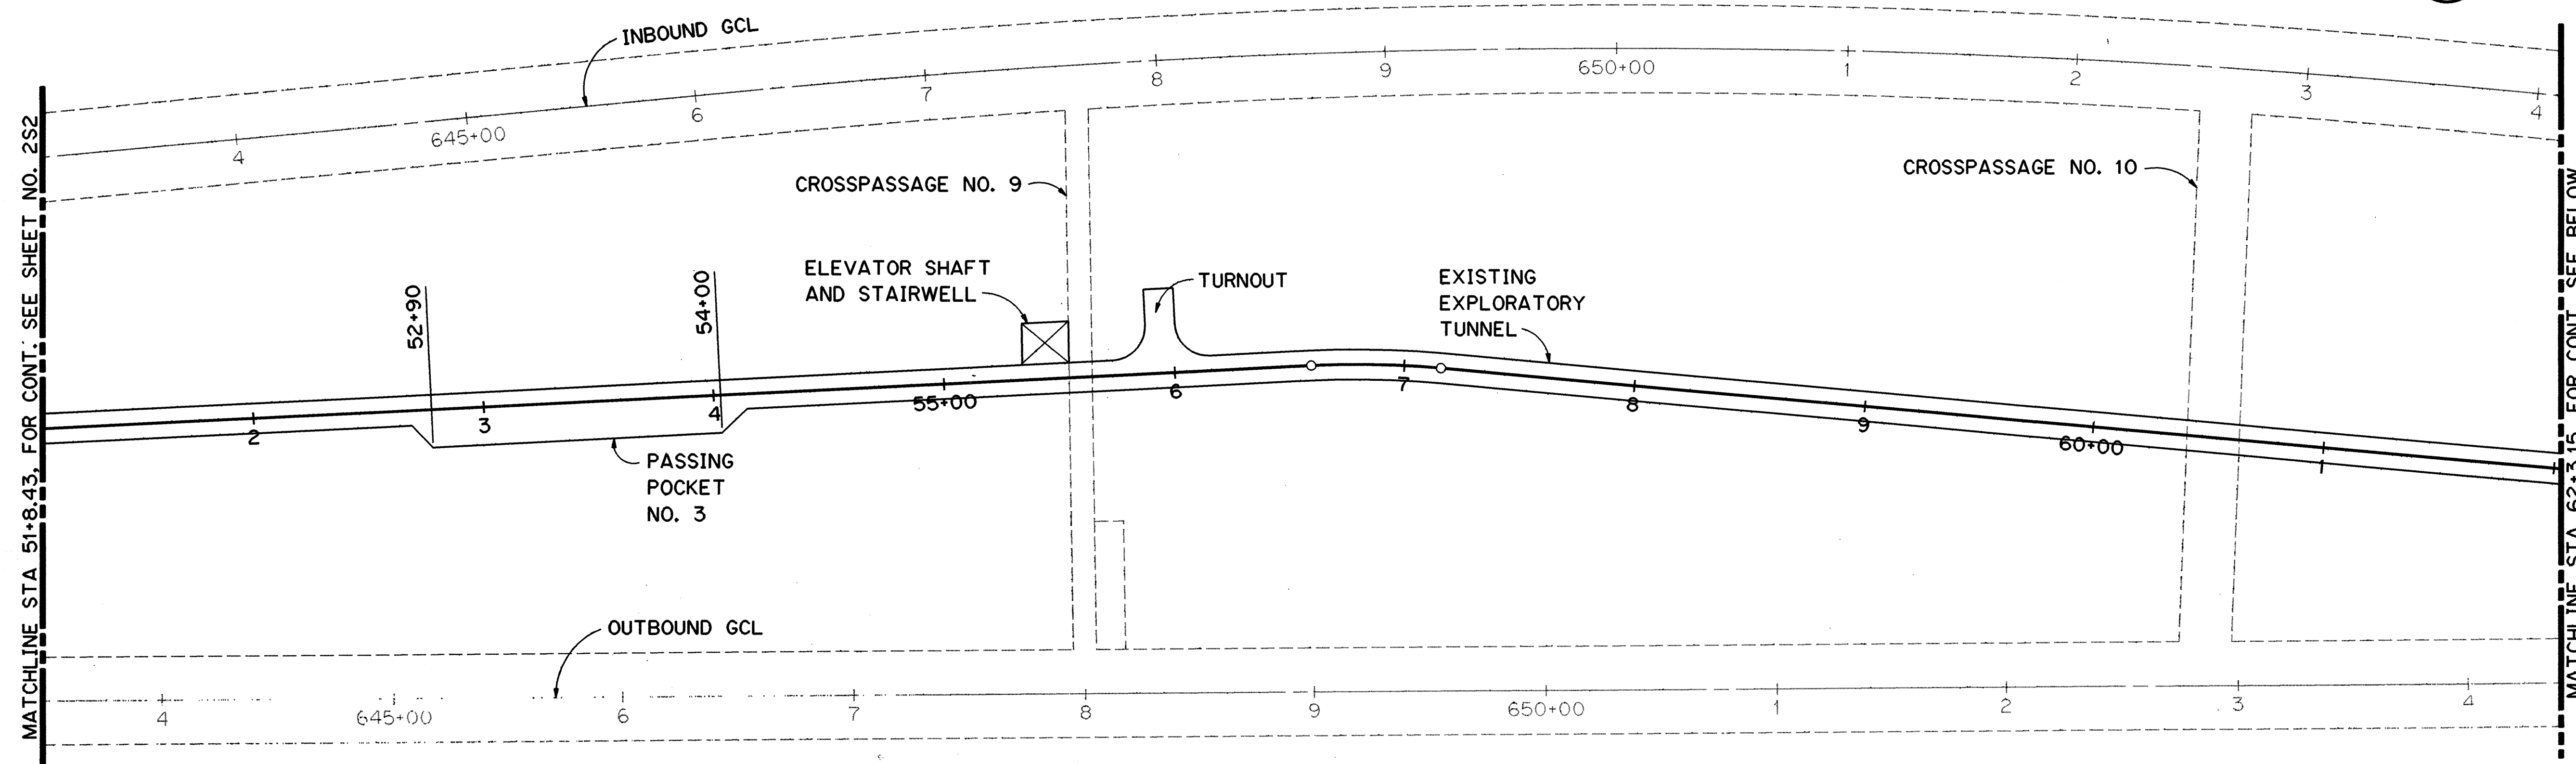

PARTIAL PLAN - EXPLORATORY TUNNEL

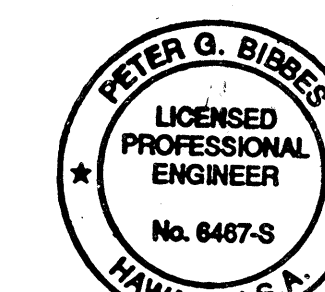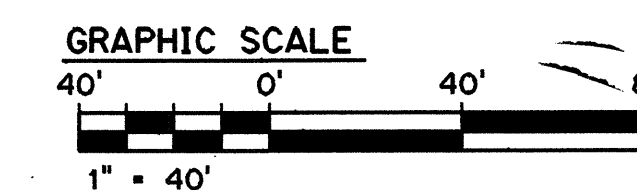

THIS WORK WAS PREPARED BY ME
OR UNDER MY SUPERVISION

Peter G. Birked

DATE	REVISION
------	----------

STATE OF HAWAII DEPARTMENT OF TRANSPORTATION HIGHWAYS DIVISION	
GENERAL PLAN - 3	
EXPLORATORY TUNNEL IMPROVEMENTS	
H-3 FINISH (UNIT III)	
FAIP NO. I-H3-1(75), UNIT III	
T.K. TUNNEL/ACCESS ROADS	
SCALE: 1" = 40'	DATE: JUN 1995
SHEET NO. 2S3	OF 17 SHEETS

DATE	NOV 94
SURVEY PLOTTED BY	R. HERNANDEZ
DRAWN BY	M.S. OWYANG
CHECKED BY	G. BENKOVICH
NO.	

NOTES:

- | | |
|-------------|--|
| | |
| | |
| | |
| 8/21/96 | DCN 75-007: REV. ET DRAIN |
| 4/18/96 | DCN 75-001: CLARIFICATION OF 'PROFILE GRADE LINE' LOCATION PER RESPONSE TO RFI NO. 4097-17, REV. I |
| DATE | REVISION |

Diagram illustrating the cross-section of a tunnel structure, showing internal and external components, dimensions, and material specifications.

Internal Components and Dimensions:

- EXPLORATORY TUNNEL:** Located at the top center, with a diameter of 2 feet (indicated by a circle with '2' over a horizontal line).
- CONCRETE LINING VARIES, 8" MIN.:** The innermost layer of the tunnel structure.
- SHOTCRETE:** The layer immediately outside the concrete lining.
- SPRING LINE:** The horizontal line separating the upper and lower halves of the tunnel structure.
- WATERPROOFING MEMBRANE:** Located between the shotcrete and the concrete slab.
- CONC SLAB 6" MIN:** The bottom horizontal slab of the tunnel structure.
- 6x6-W1.4xW1.4 WWF:** Welded Wire Fabric reinforcement in the bottom slab.
- 2" CLR.:** Clearance between the waterproofing membrane and the concrete slab.
- #5@8" and #4@12" REINFORCEMENT:** Reinforcing bars in the concrete lining and slab.
- PROFILE GRADE LINE:** The line representing the ground surface.
- SLOPE:** The angle of the ground surface relative to the horizontal.
- 6'-0" and 11'-8" DIMENSIONS:** Vertical and horizontal dimensions of the tunnel structure.
- 45° TYP.:** Typical angle of the ground surface.
- R = 5'-10":** Radius of the tunnel structure.
- 1'-6" TYP.:** Typical dimensions of the tunnel structure.
- SPlice TYP.:** Typical location of a splice in the reinforcement.
- 5" MIN. VARIES:** Minimum dimension of the tunnel structure.
- TRENCH DRAIN SEE NOTE 11:** Located at the bottom center of the tunnel structure.
- EXISTING OR EXCAVATED GRADE:** The ground surface outside the tunnel structure.

External Components and Dimensions:

- NOT USED:** Label for the top center section.
- GROUT HOLE PIPE SLEEVE AT 10'-0" O.C. TYP.:** Grout holes in the shotcrete layer.
- ROCK DOWEL TYP, WHERE OCCURS:** Rock dowels in the shotcrete layer.
- 1** (in a circle with a horizontal line): Typical reinforcement detail.

TYPICAL TUNNEL

SECTION


SCALE: 1/2"=1'-0"

A

2S1	2S4
-----	-----

2S15-1

2S14

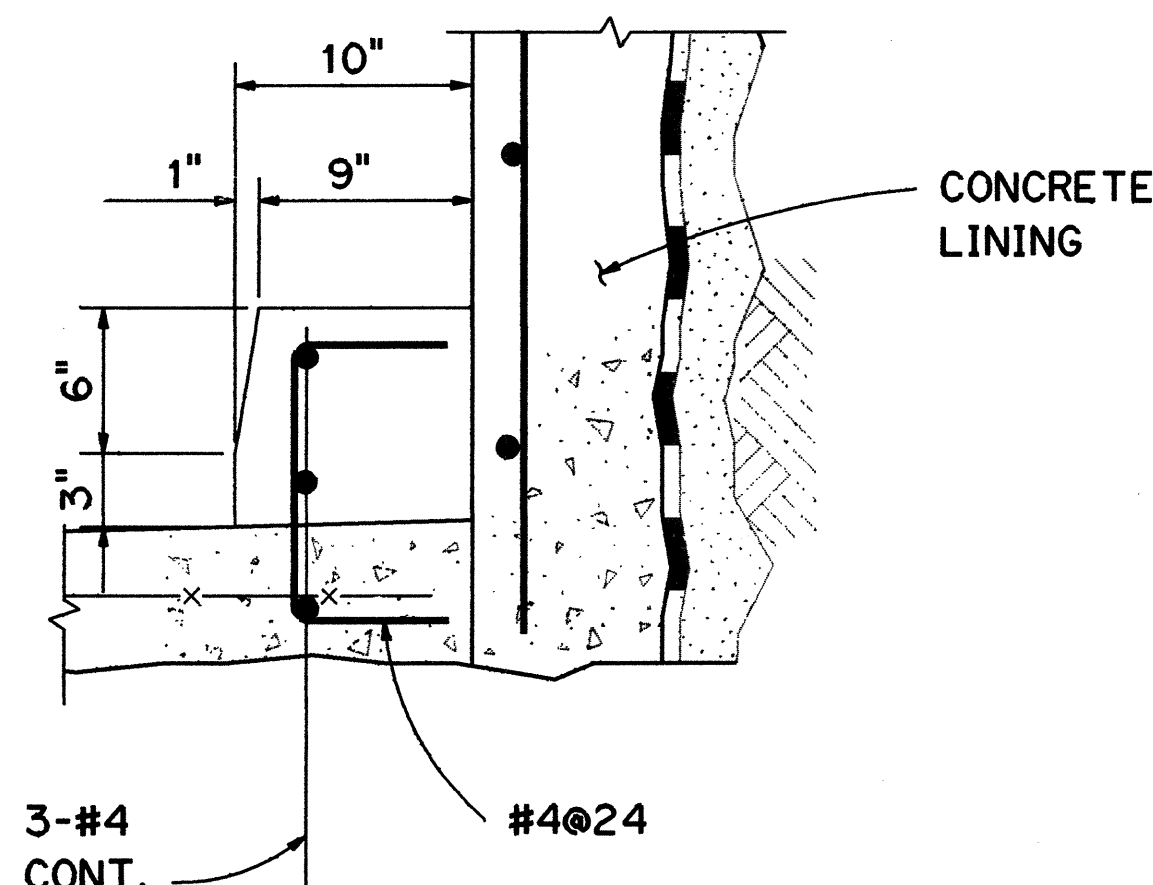

TYPICAL CURB DETAIL

DETAIL


SCALE: $1\frac{1}{2}" = 1'-0"$

1

2S5	2S4
-----	-----

2S14

2S15

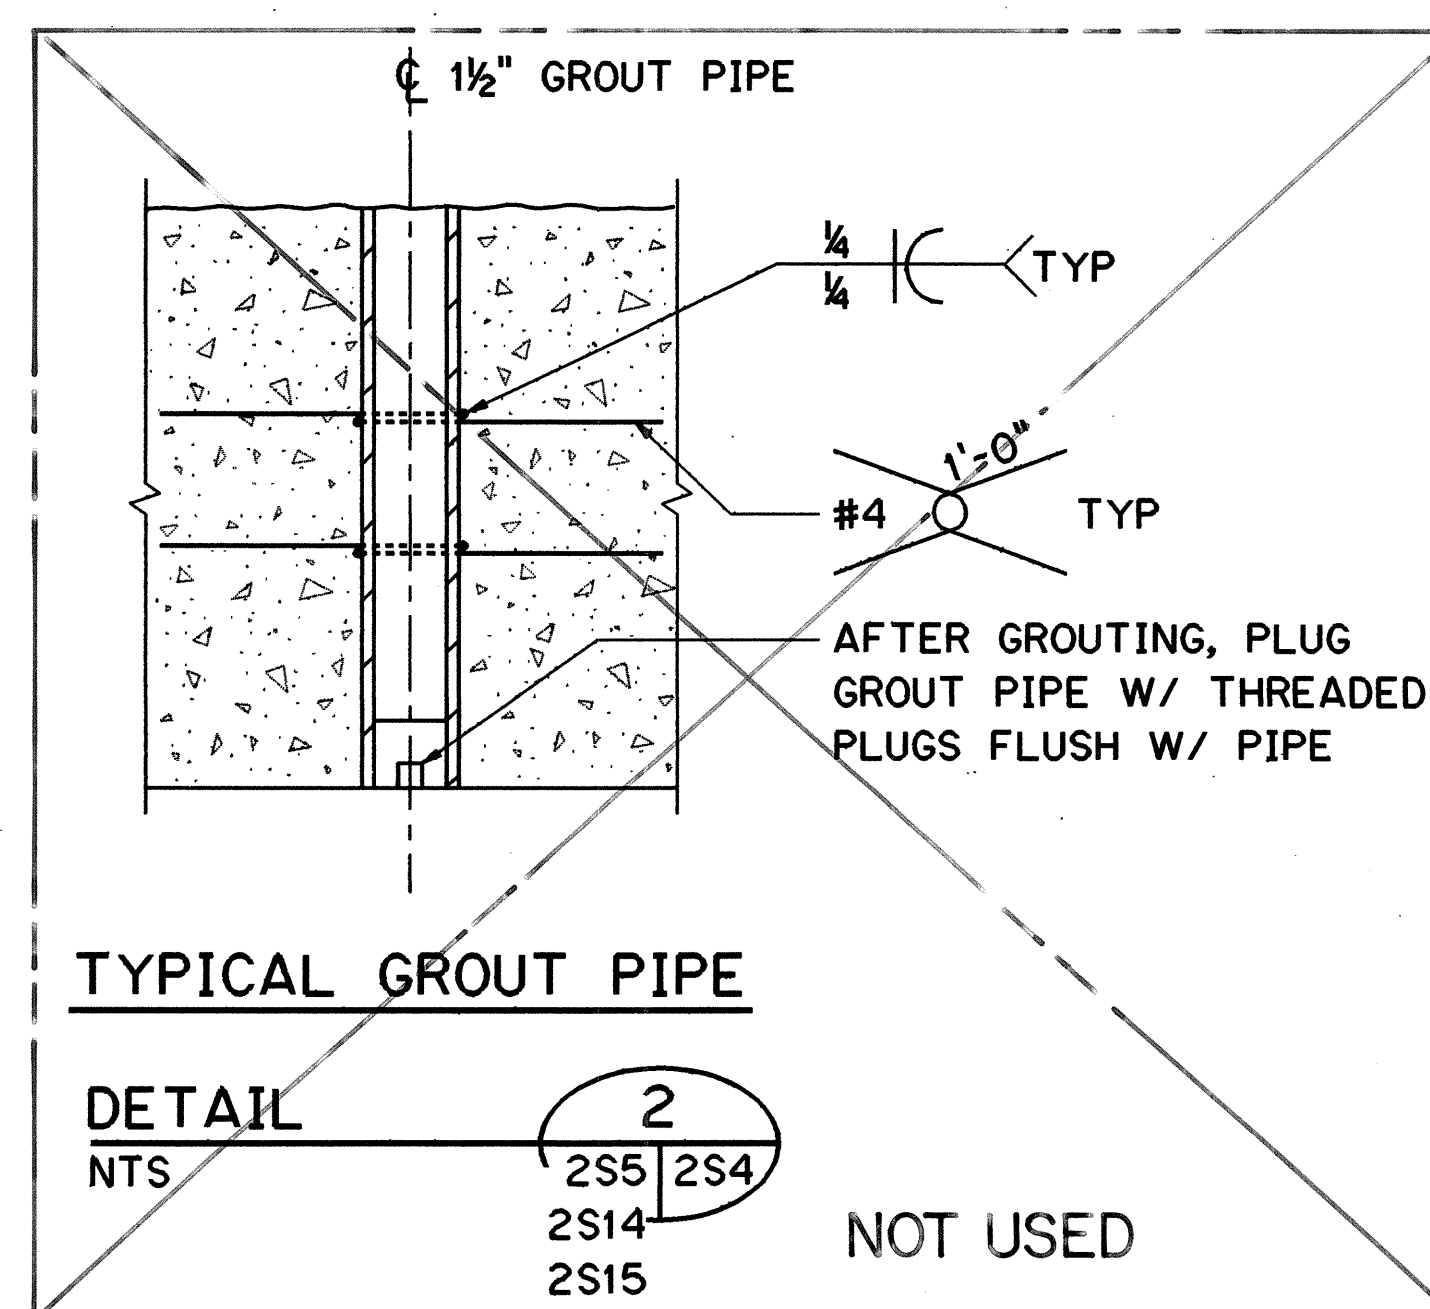


TYPICAL ~~GROUT~~ PIPE

~~DETAIL~~


NTS ✓

NOT USED

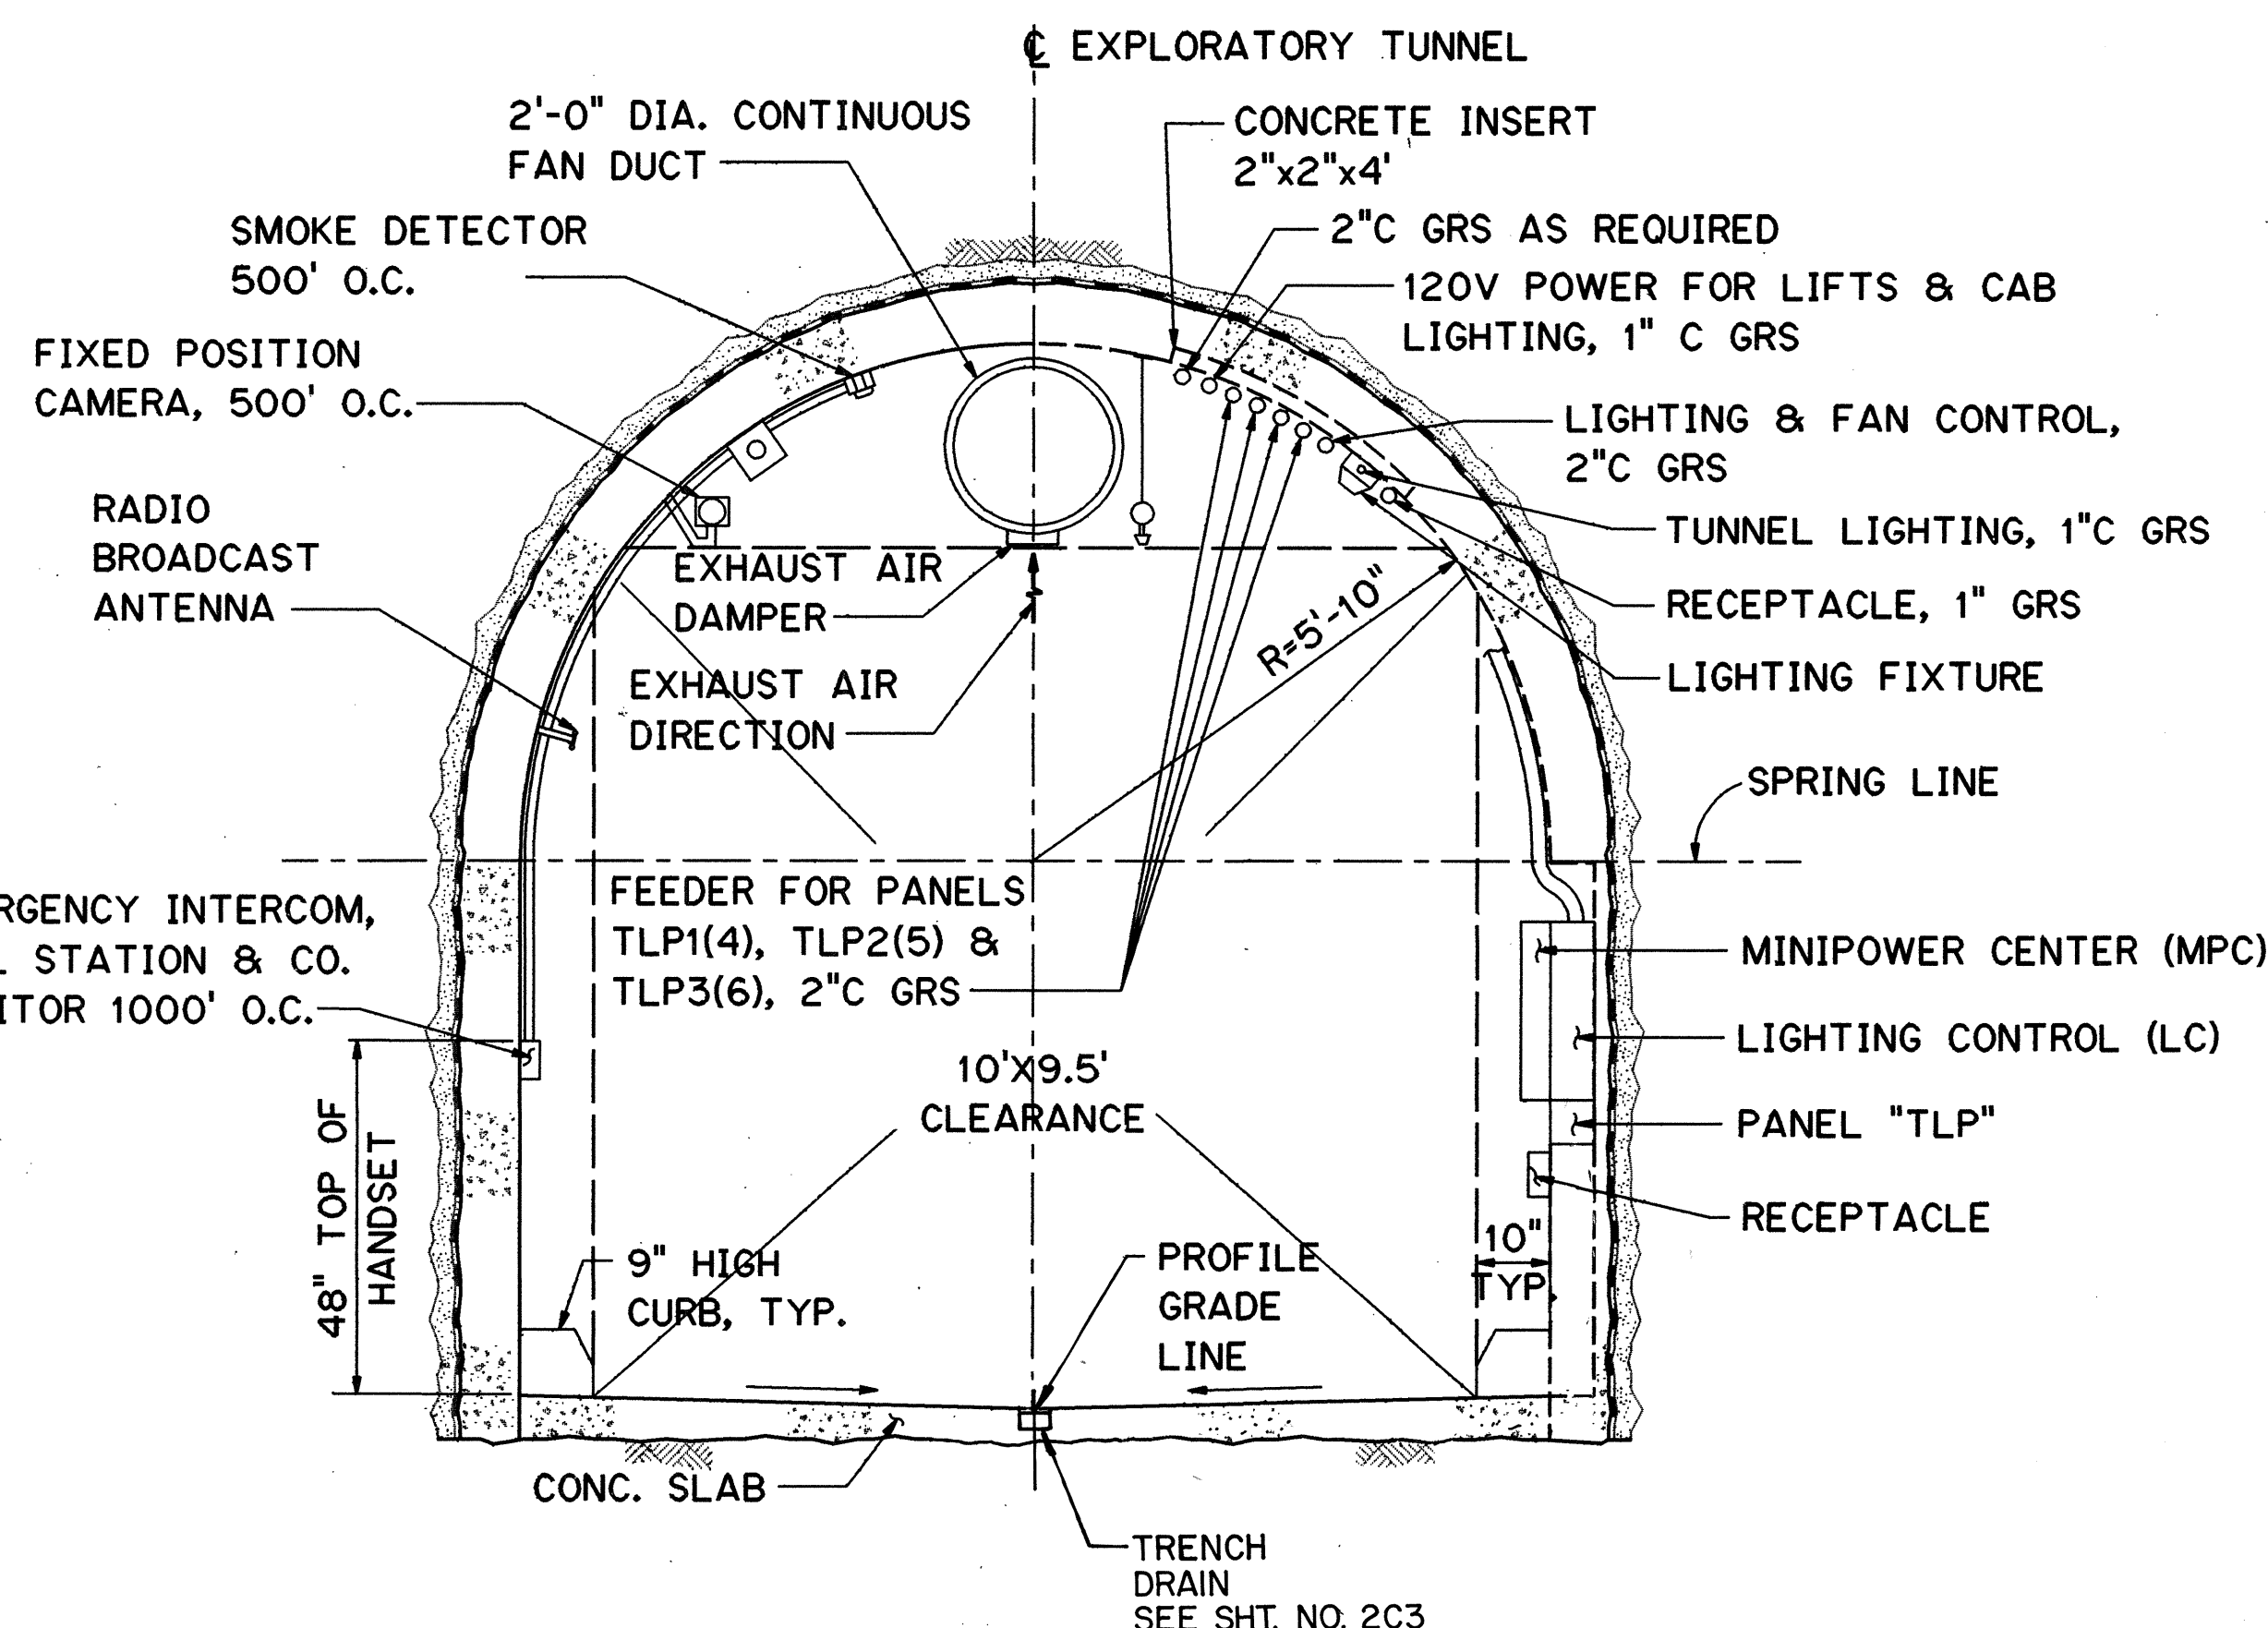

TYPICAL FIXTURE ARRANGEMENT

SCALE: $\frac{1}{2}"=1'-0"$

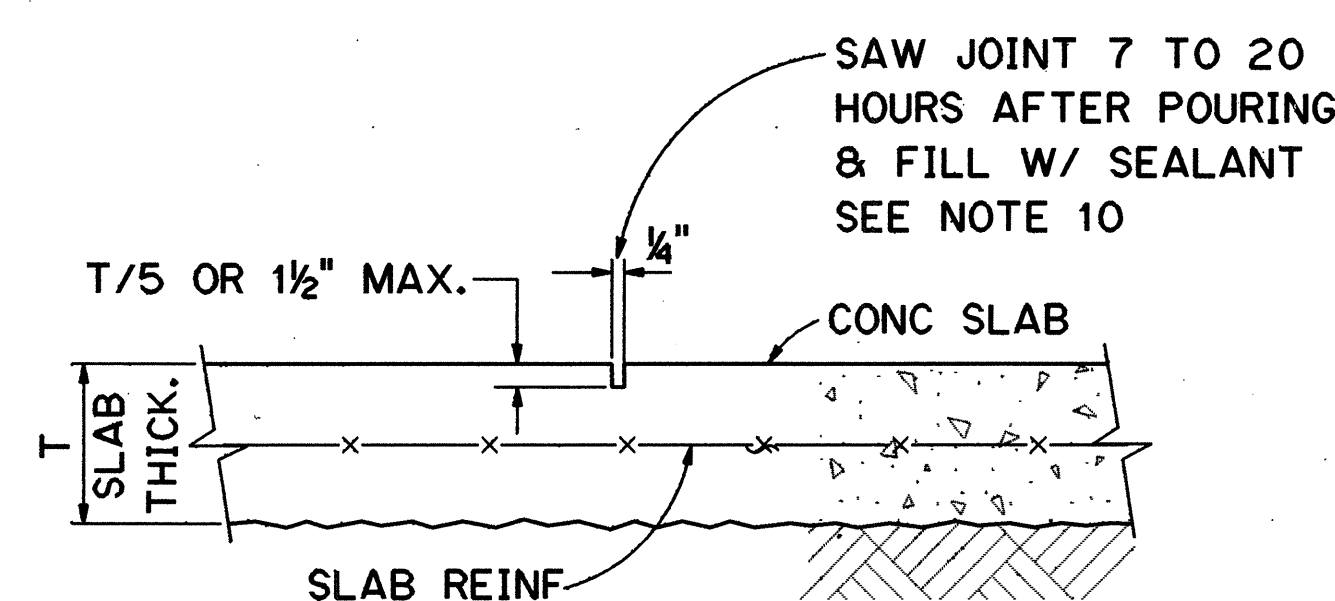




TYPICAL CONTROL JOINT

DETAIL

NTS

3



GRAPHIC SCALE

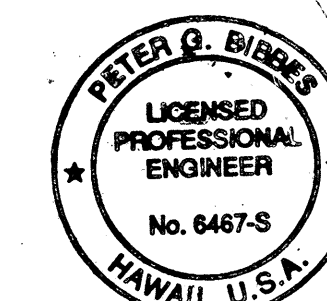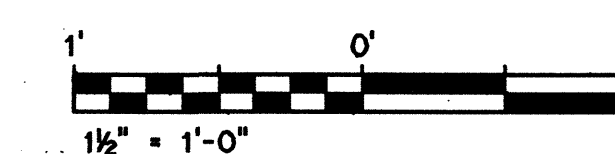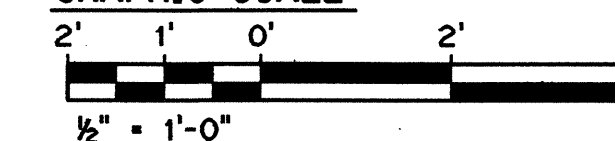

THIS WORK WAS PREPARED BY MI
OR UNDER MY SUPERVISION



Peter J. Bubba

FED. ROAD DIST. NO.	STATE	FED. AID PROJ. NO.	FISCAL YEAR	SHEET NO.	TOTAL SHEETS
HAWAII	HAW.	1-H3-1(75) UNIT III	1994	52	353

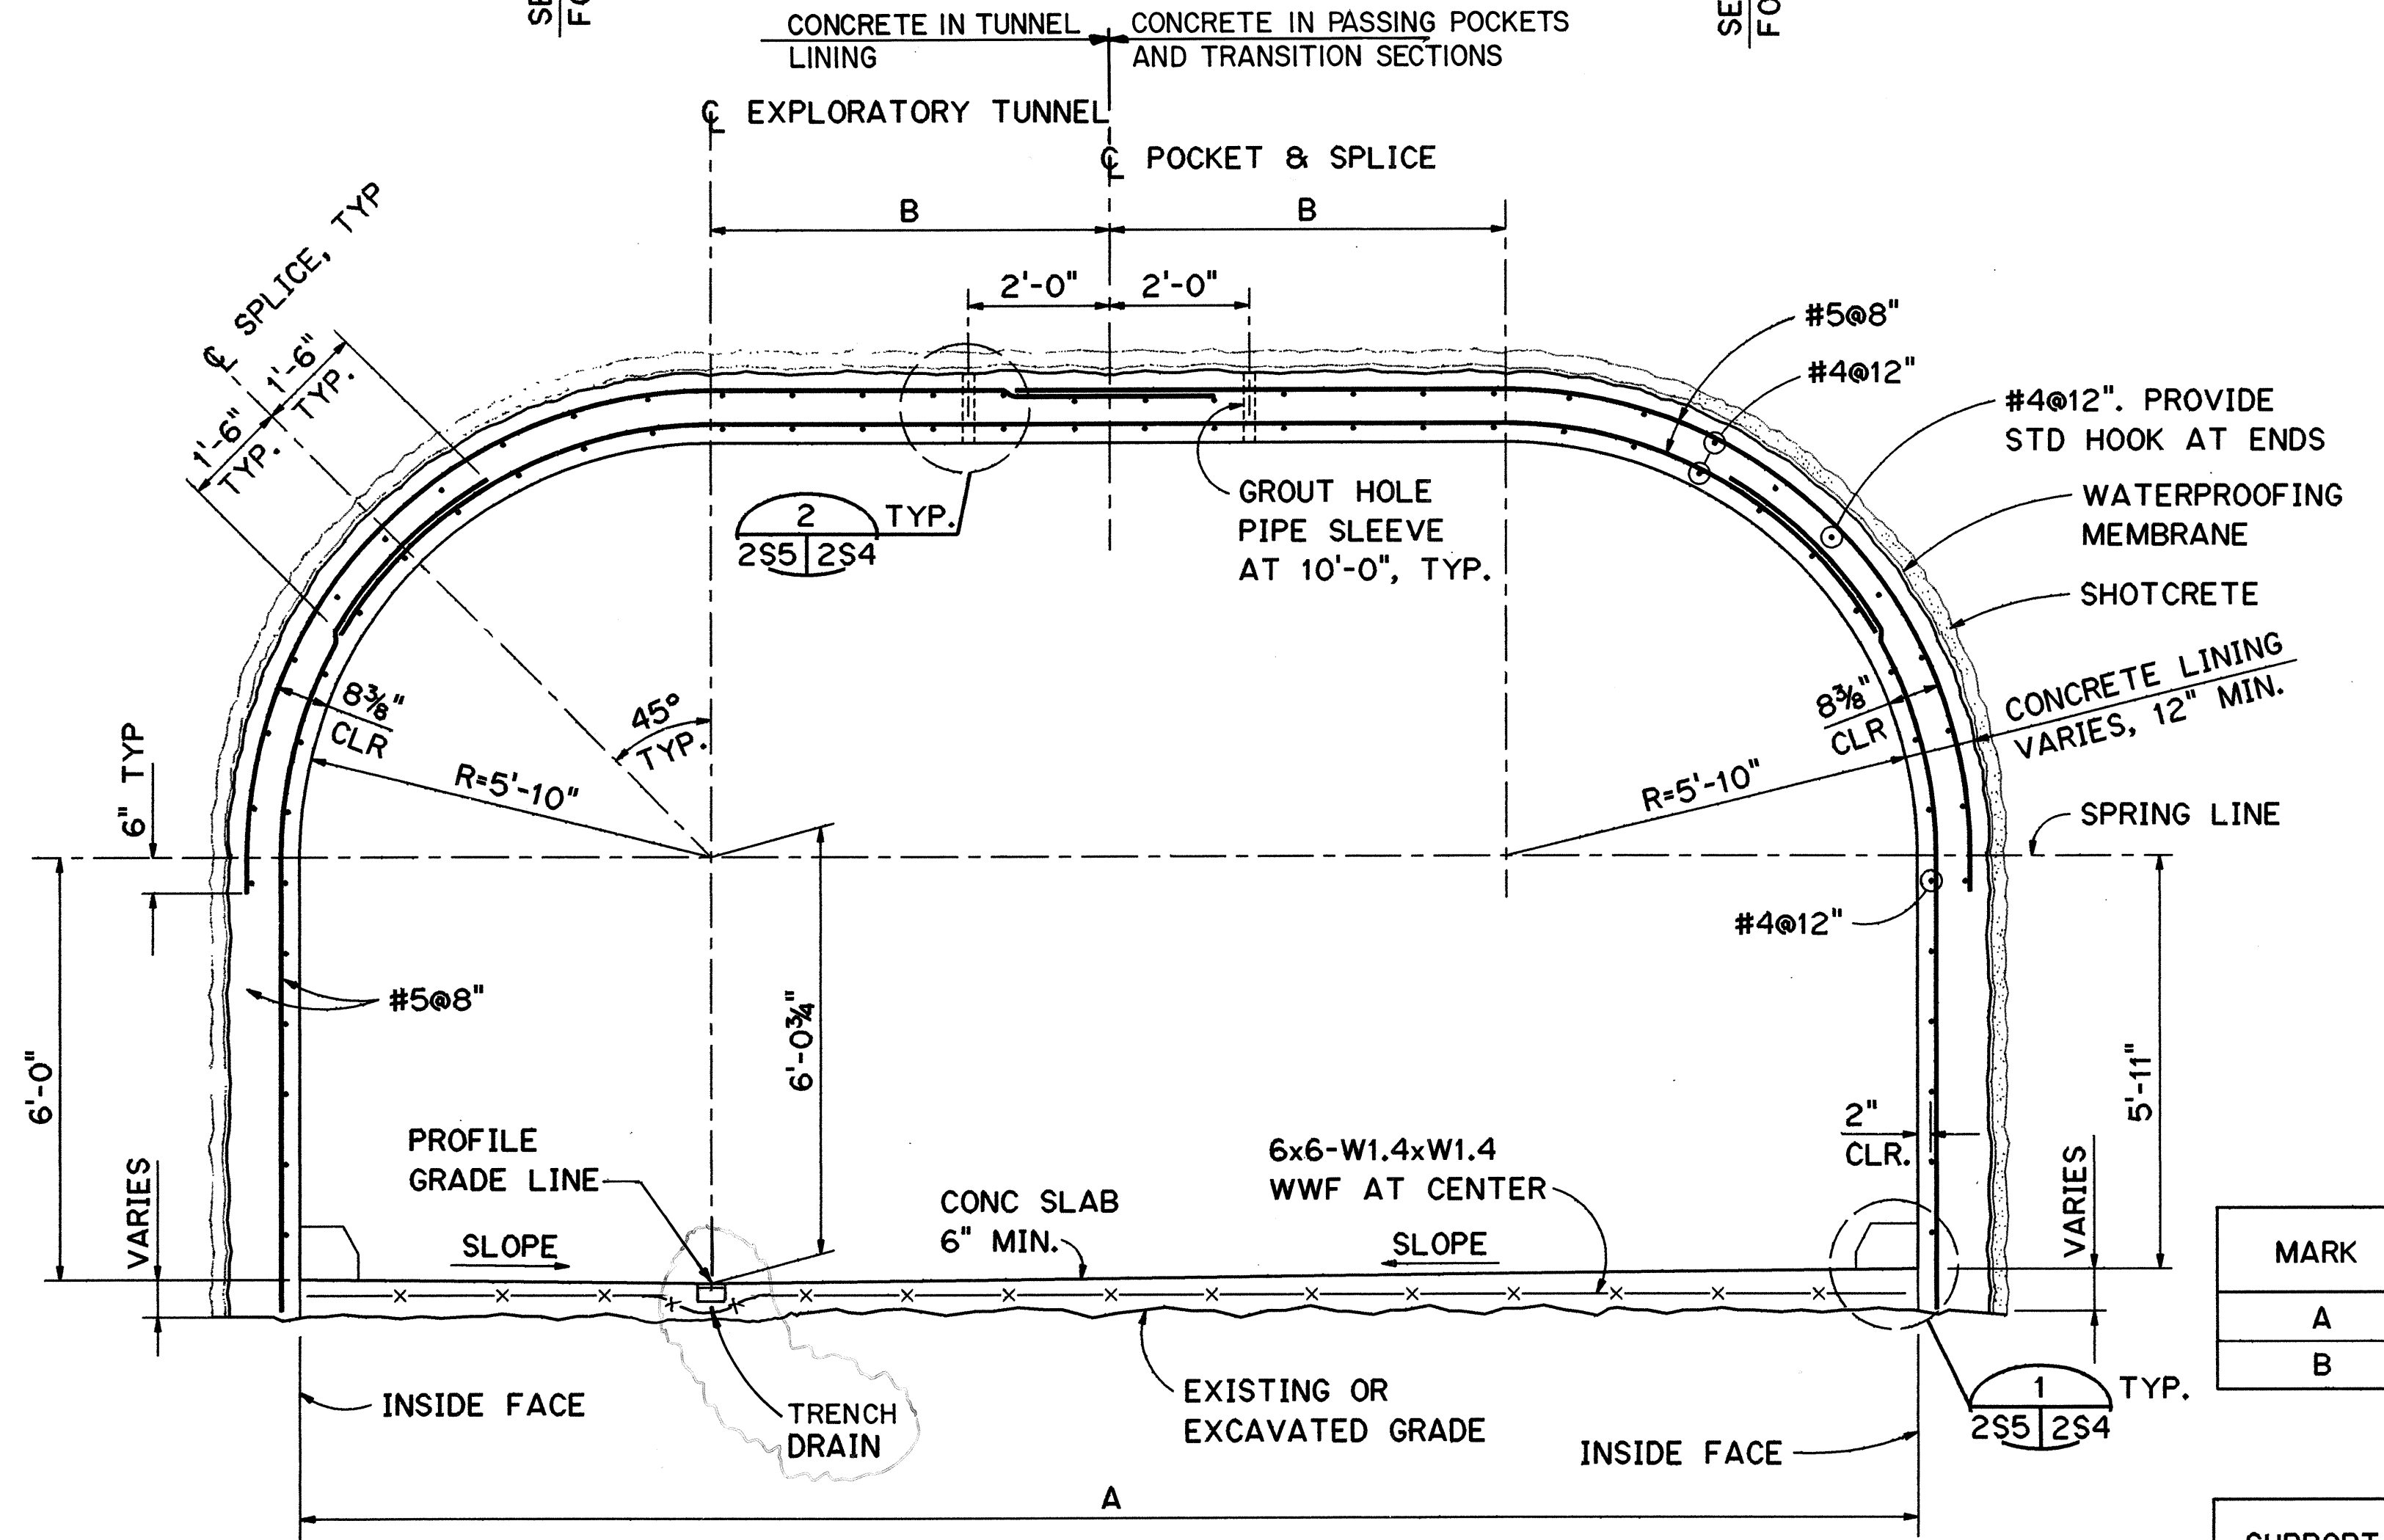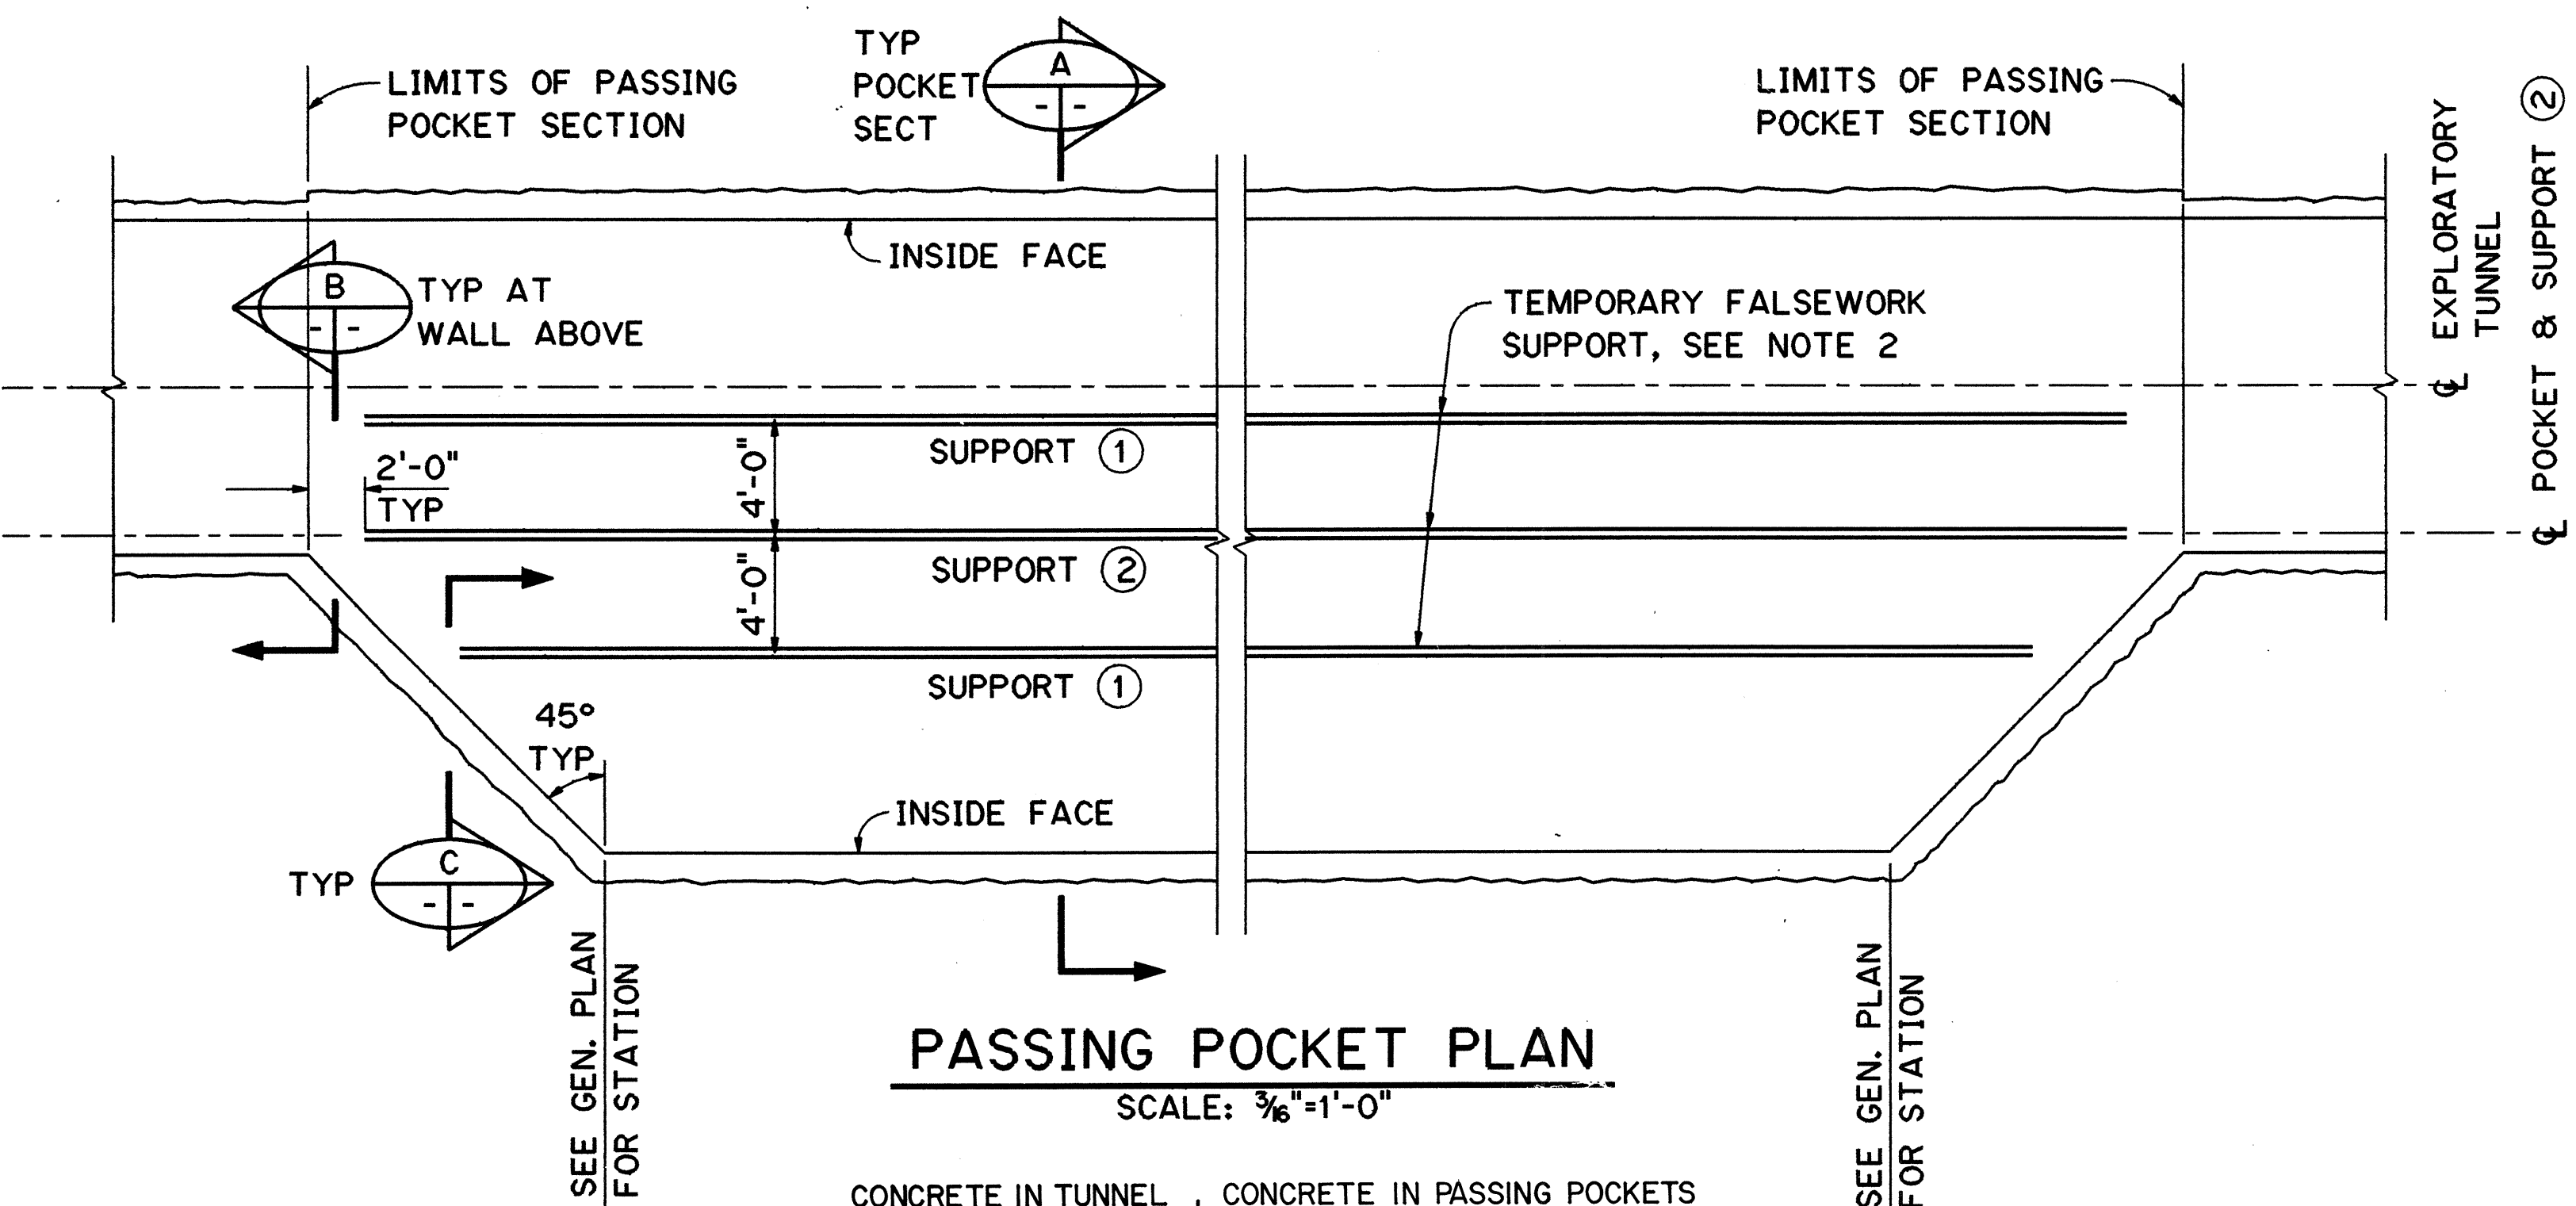

SECTION AT PASSING POCKET NO. 2 AND NO. 3
SECTION AT PASSING POCKET NO. 1 IS OPPOSITE HAND

SECTION A
SCALE: 1/2"=1'-0"

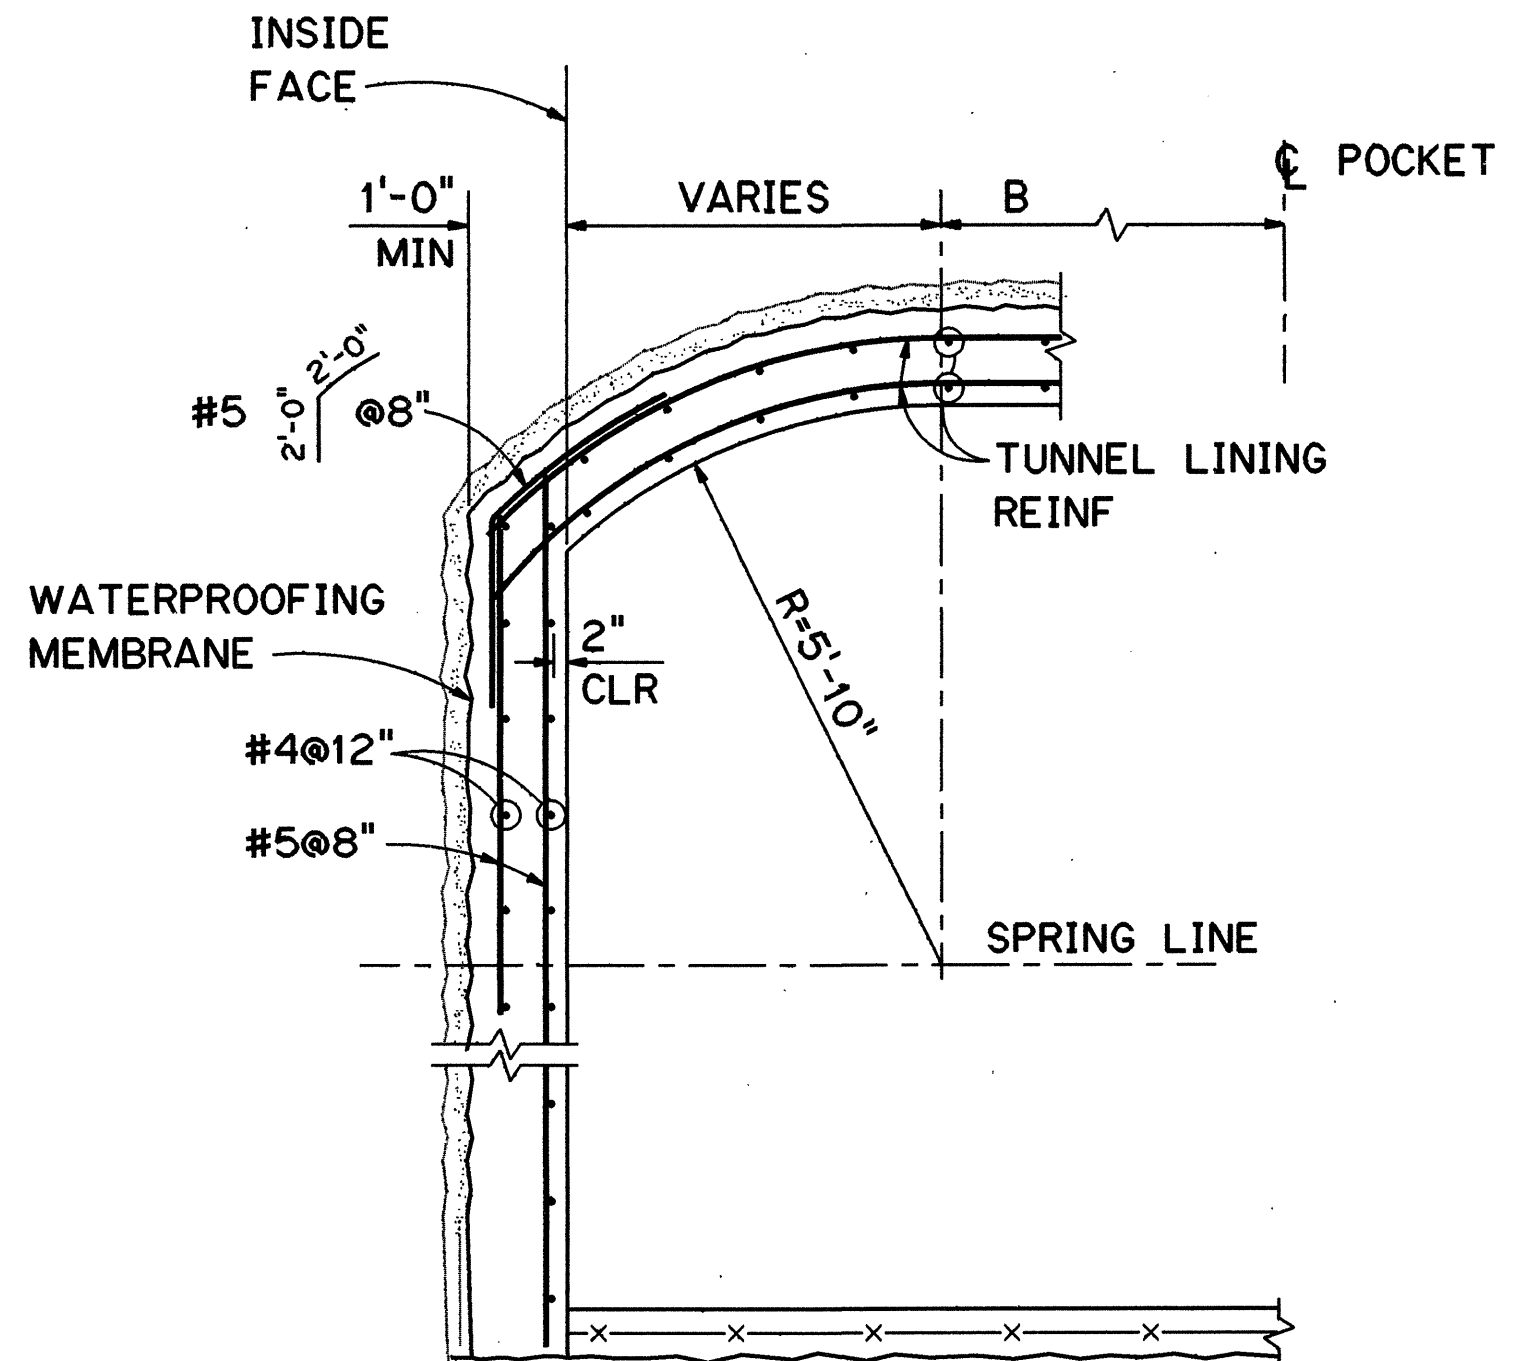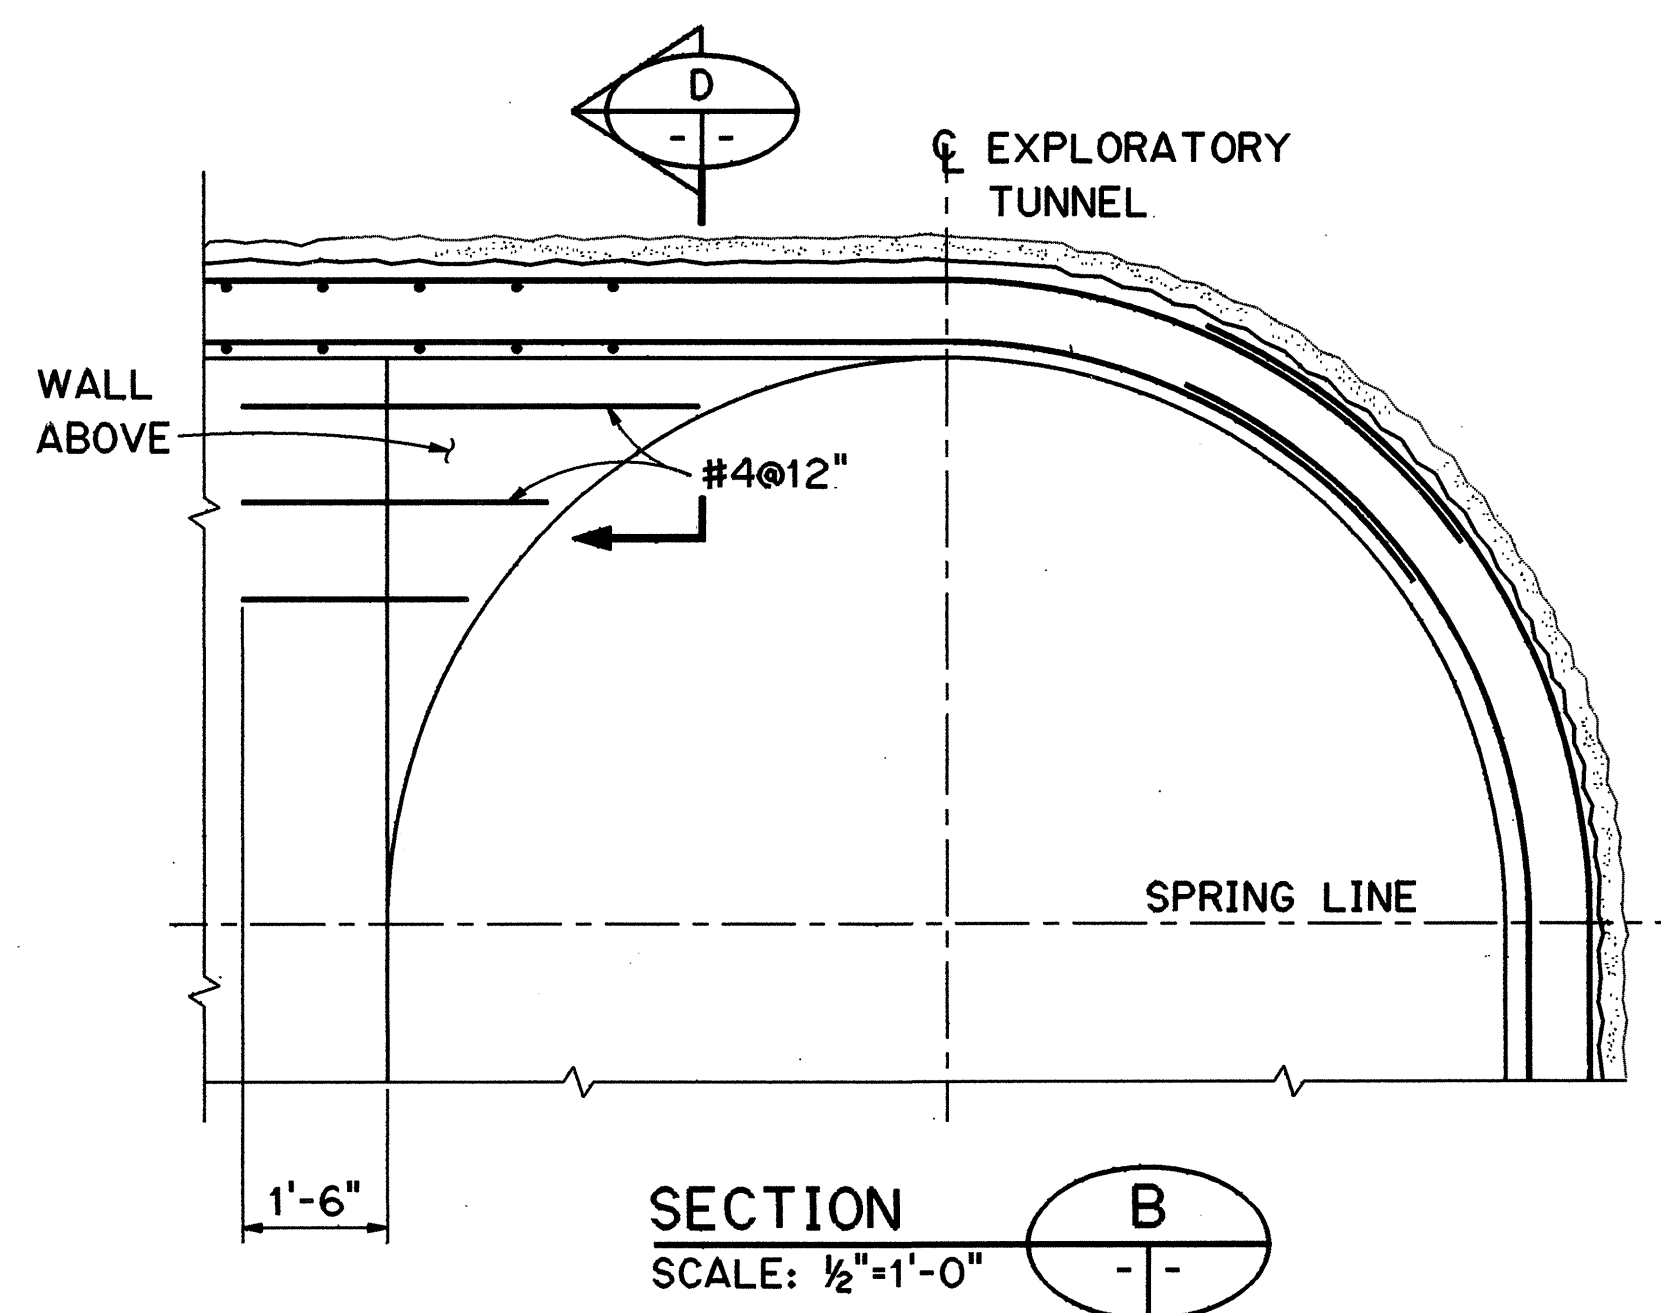


SECTION C
SCALE: 1/2"=1'-0"

TABLE A

MARK	PASSING POCKET NO. 1	PASSING POCKET NO. 2	PASSING POCKET NO. 3
A	20'-0"	23'-0"	22'-0"
B	4'-2"	5'-8"	5'-2"

TABLE B


SUPPORT	PASSING POCKET NO. 1	PASSING POCKET NO. 2	PASSING POCKET NO. 3
①	5.9 kip/ft	6.1 kip/ft	7.1 kip/ft
②	11.4 kip/ft	10.9 kip/ft	11.9 kip/ft

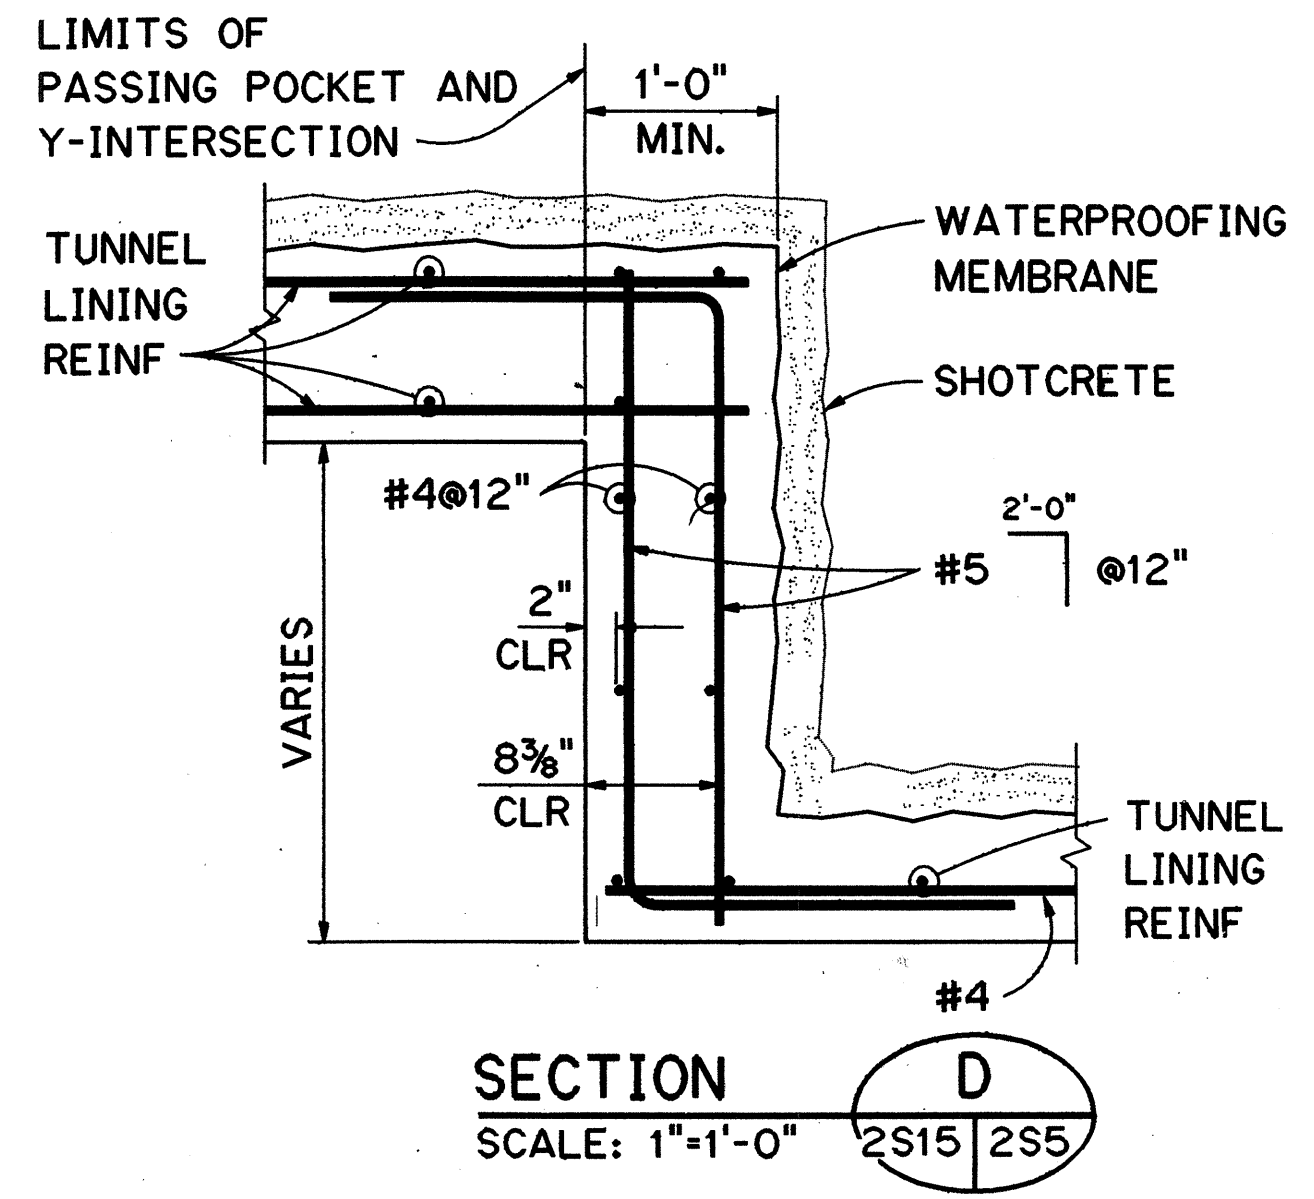

NOTES:

- FOR ADDITIONAL NOTES, SEE SHEET NO. 2S4.
- PROVIDE TEMPORARY FALSEWORK SUPPORT OF THE LINING DURING THE GROUTING OPERATION. THE SUPPORTS SHALL BE DESIGNED BY THE CONTRACTOR TO RESIST THE SERVICE LOADS SHOWN IN TABLE B.
- THE ALLOWABLE BEARING PRESSURE AT THE PASSING POCKETS IS 20,000 PSF.

DATE	NOV 94
DESIGNED BY	K. FERNANDEZ
TRACED BY	L. JOHNSON
QUANTITIES BY	G. BERGOTICH
CHECKED BY	G. BERGOTICH
NO.	

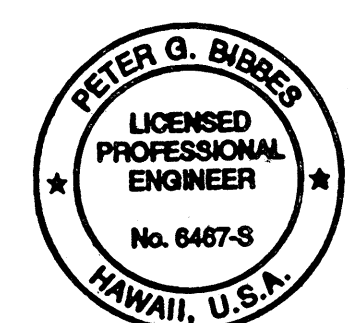

THIS WORK WAS PREPARED BY ME OR UNDER MY SUPERVISION
Peter G. Barnes

8/21/96	DCN 75-007: REV. ET DRAIN
4/18/96	DCN 75-001: CLARIFICATION OF 'PROFILE GRADE LINE' LOCATION PER RESPONSE TO RFI NO. 4097-17, REV. 1
DATE	REVISION

STATE OF HAWAII
DEPARTMENT OF TRANSPORTATION
HIGHWAYS DIVISION

TYP. SECTS AT PASSING POCKETS AND TURNOUTS


EXPLORATORY TUNNEL IMPROVEMENTS
H-3 FINISH (UNIT III)
FAIP NO. 1-H3-1(75), UNIT III
T.K. TUNNEL/ACCESS ROADS
SCALE: AS NOTED DATE: JUN 1995

SHEET NO. 2S5 OF 17 SHEETS


ORIGINAL PLAN	SURVEY PLOTTED BY _____ DRAWN BY _____ TRACED BY _____ DESIGNED BY _____ QUANTITIES BY _____ CHECKED BY _____	DATE " NOV 94 " NOV 94 " NOV 94 " DEC 94
NOTE BOOK		
NO. _____		




FED. ROAD DIST. NO.	STATE	FED. AID PROJ. NO.	FISCAL YEAR	SHEET NO.	TOTAL SHEETS
HAWAII	HAW.	I-H3-1(75) UNIT III	1994	54	353

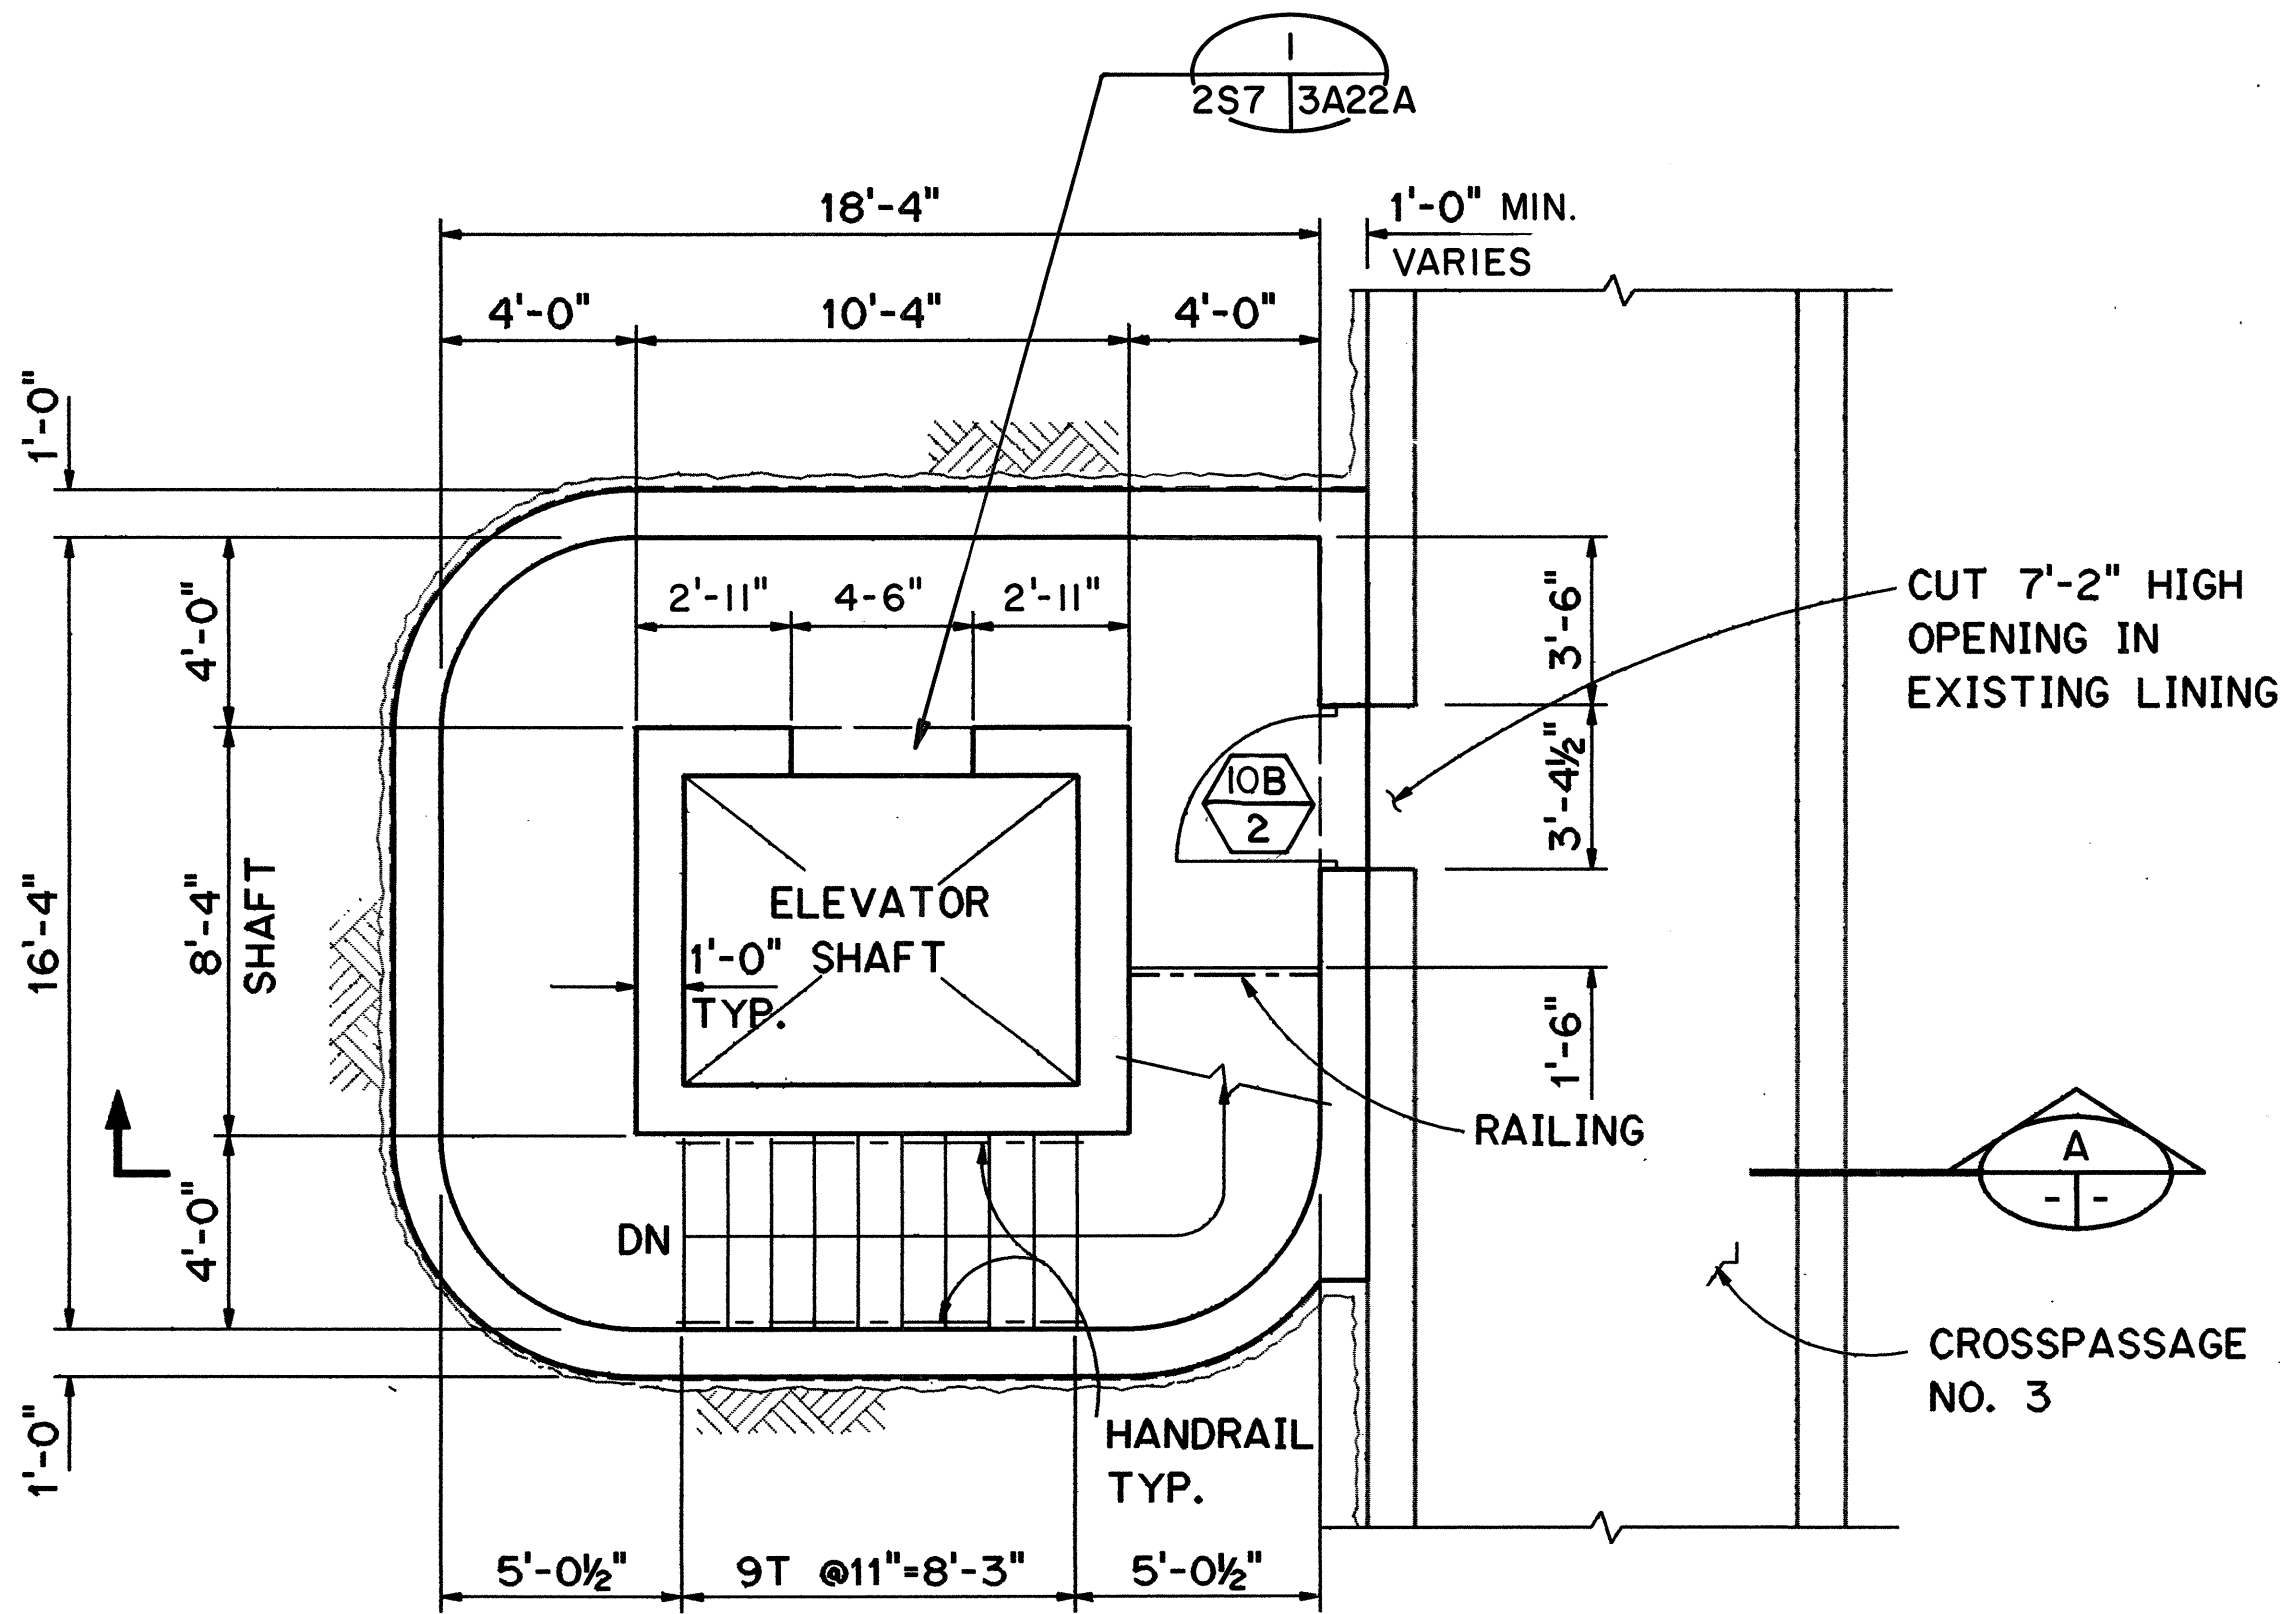


PLAN AT CROSSPASSAGE

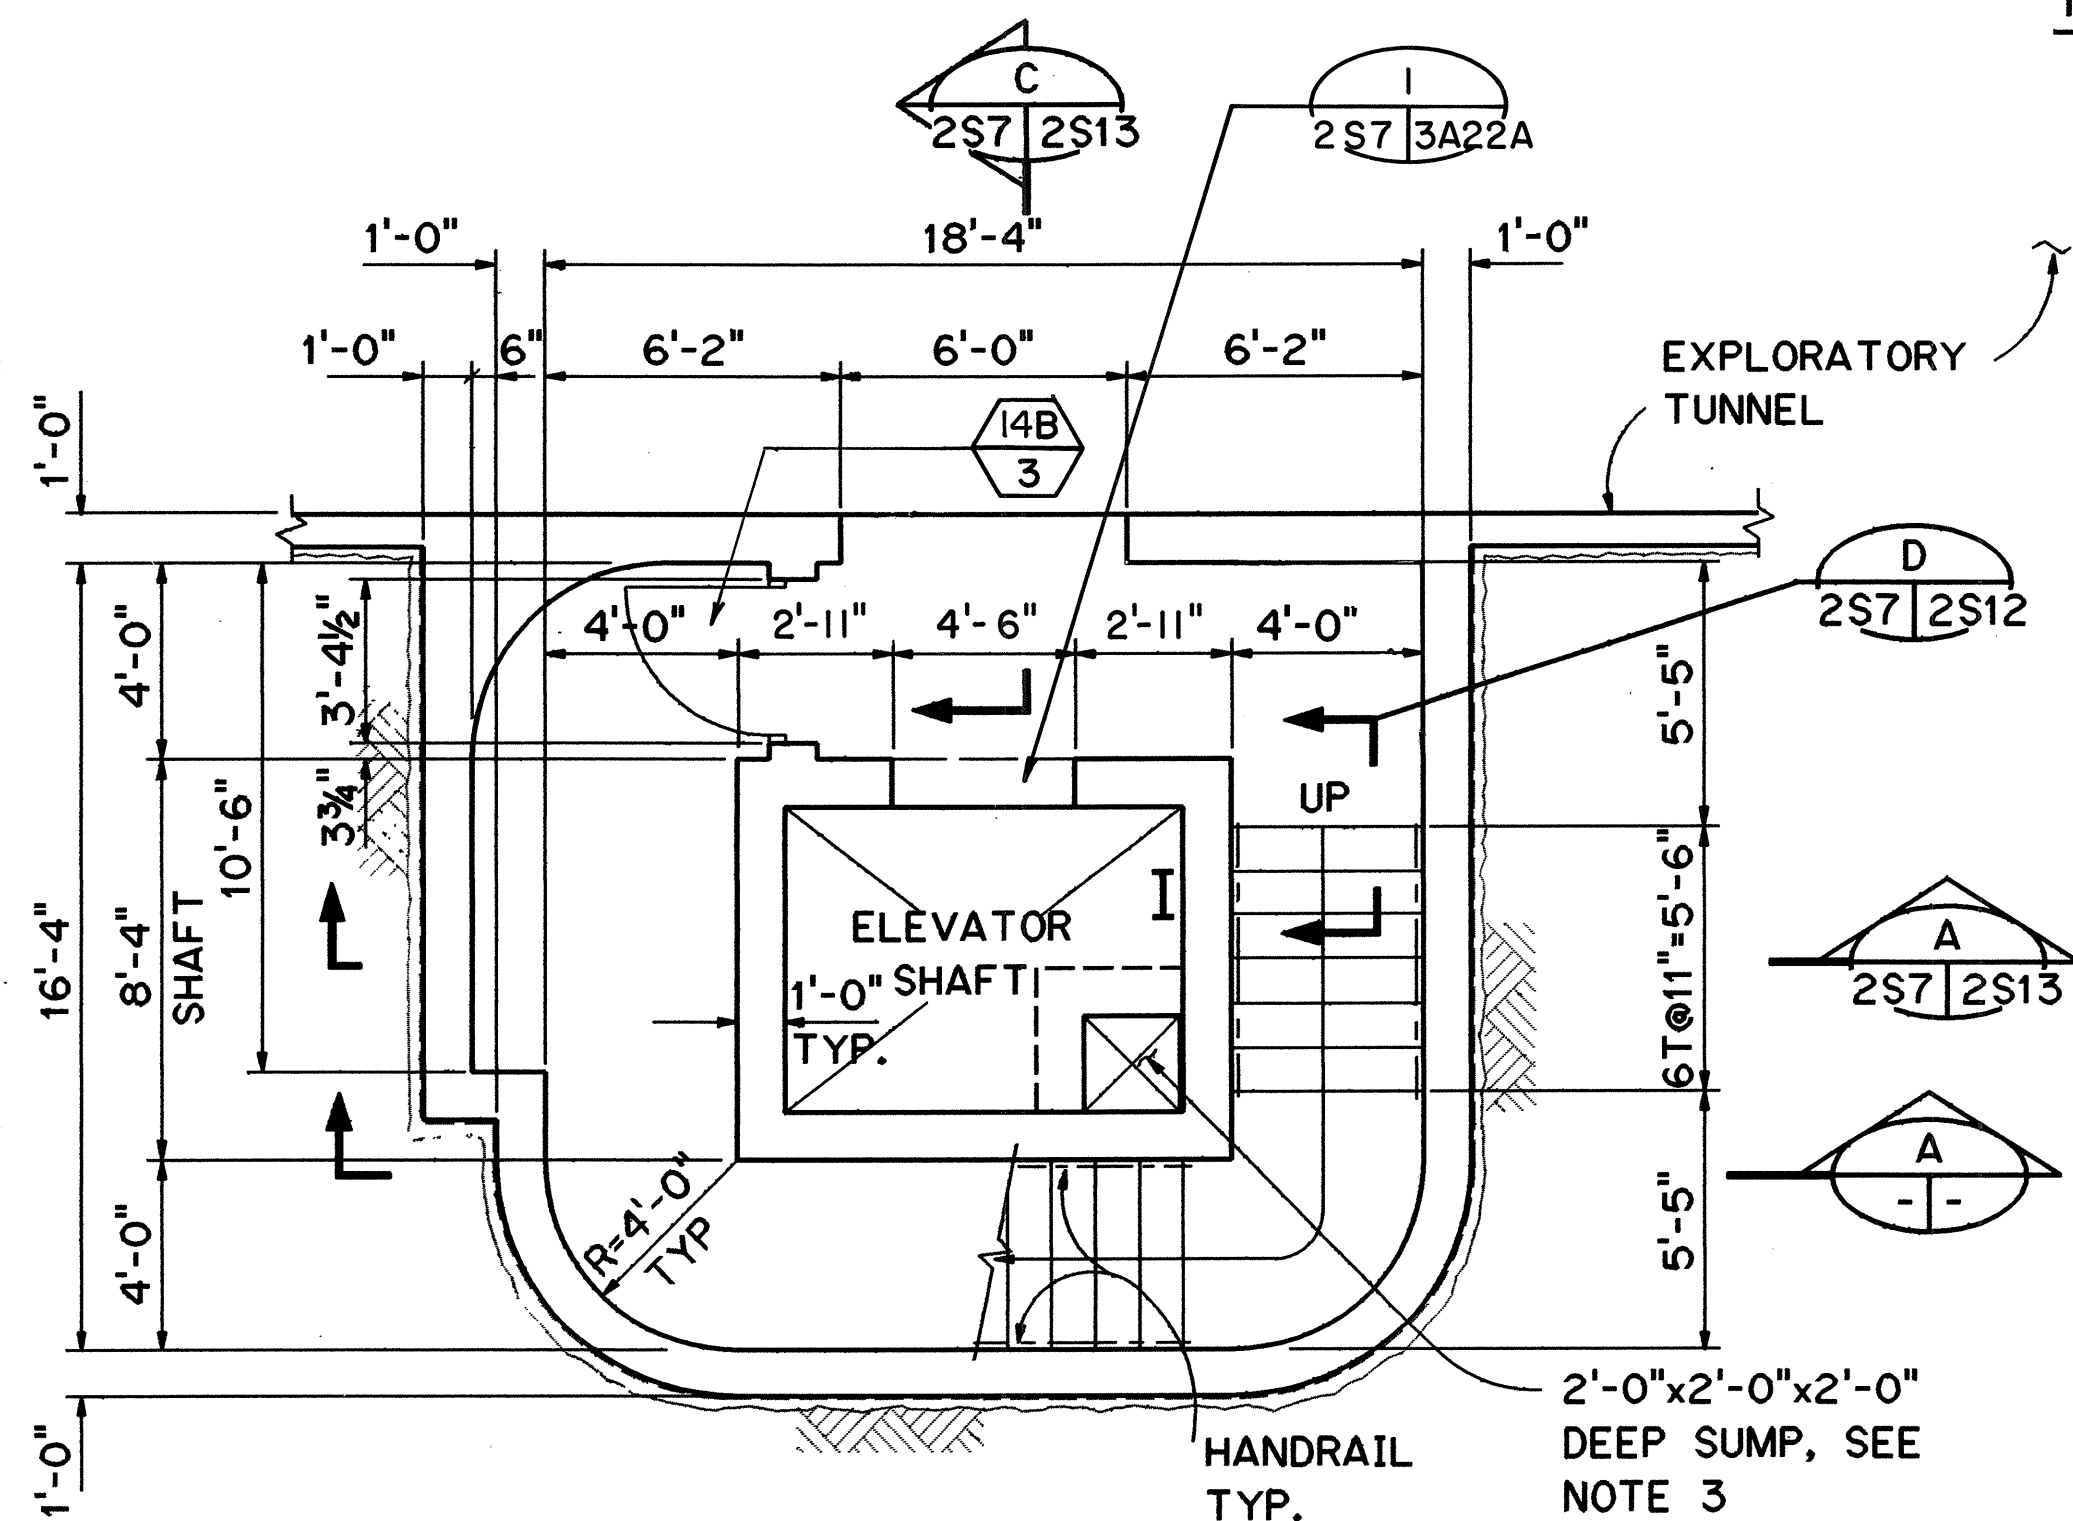

PLAN AT EXPLORATORY TUNNEL

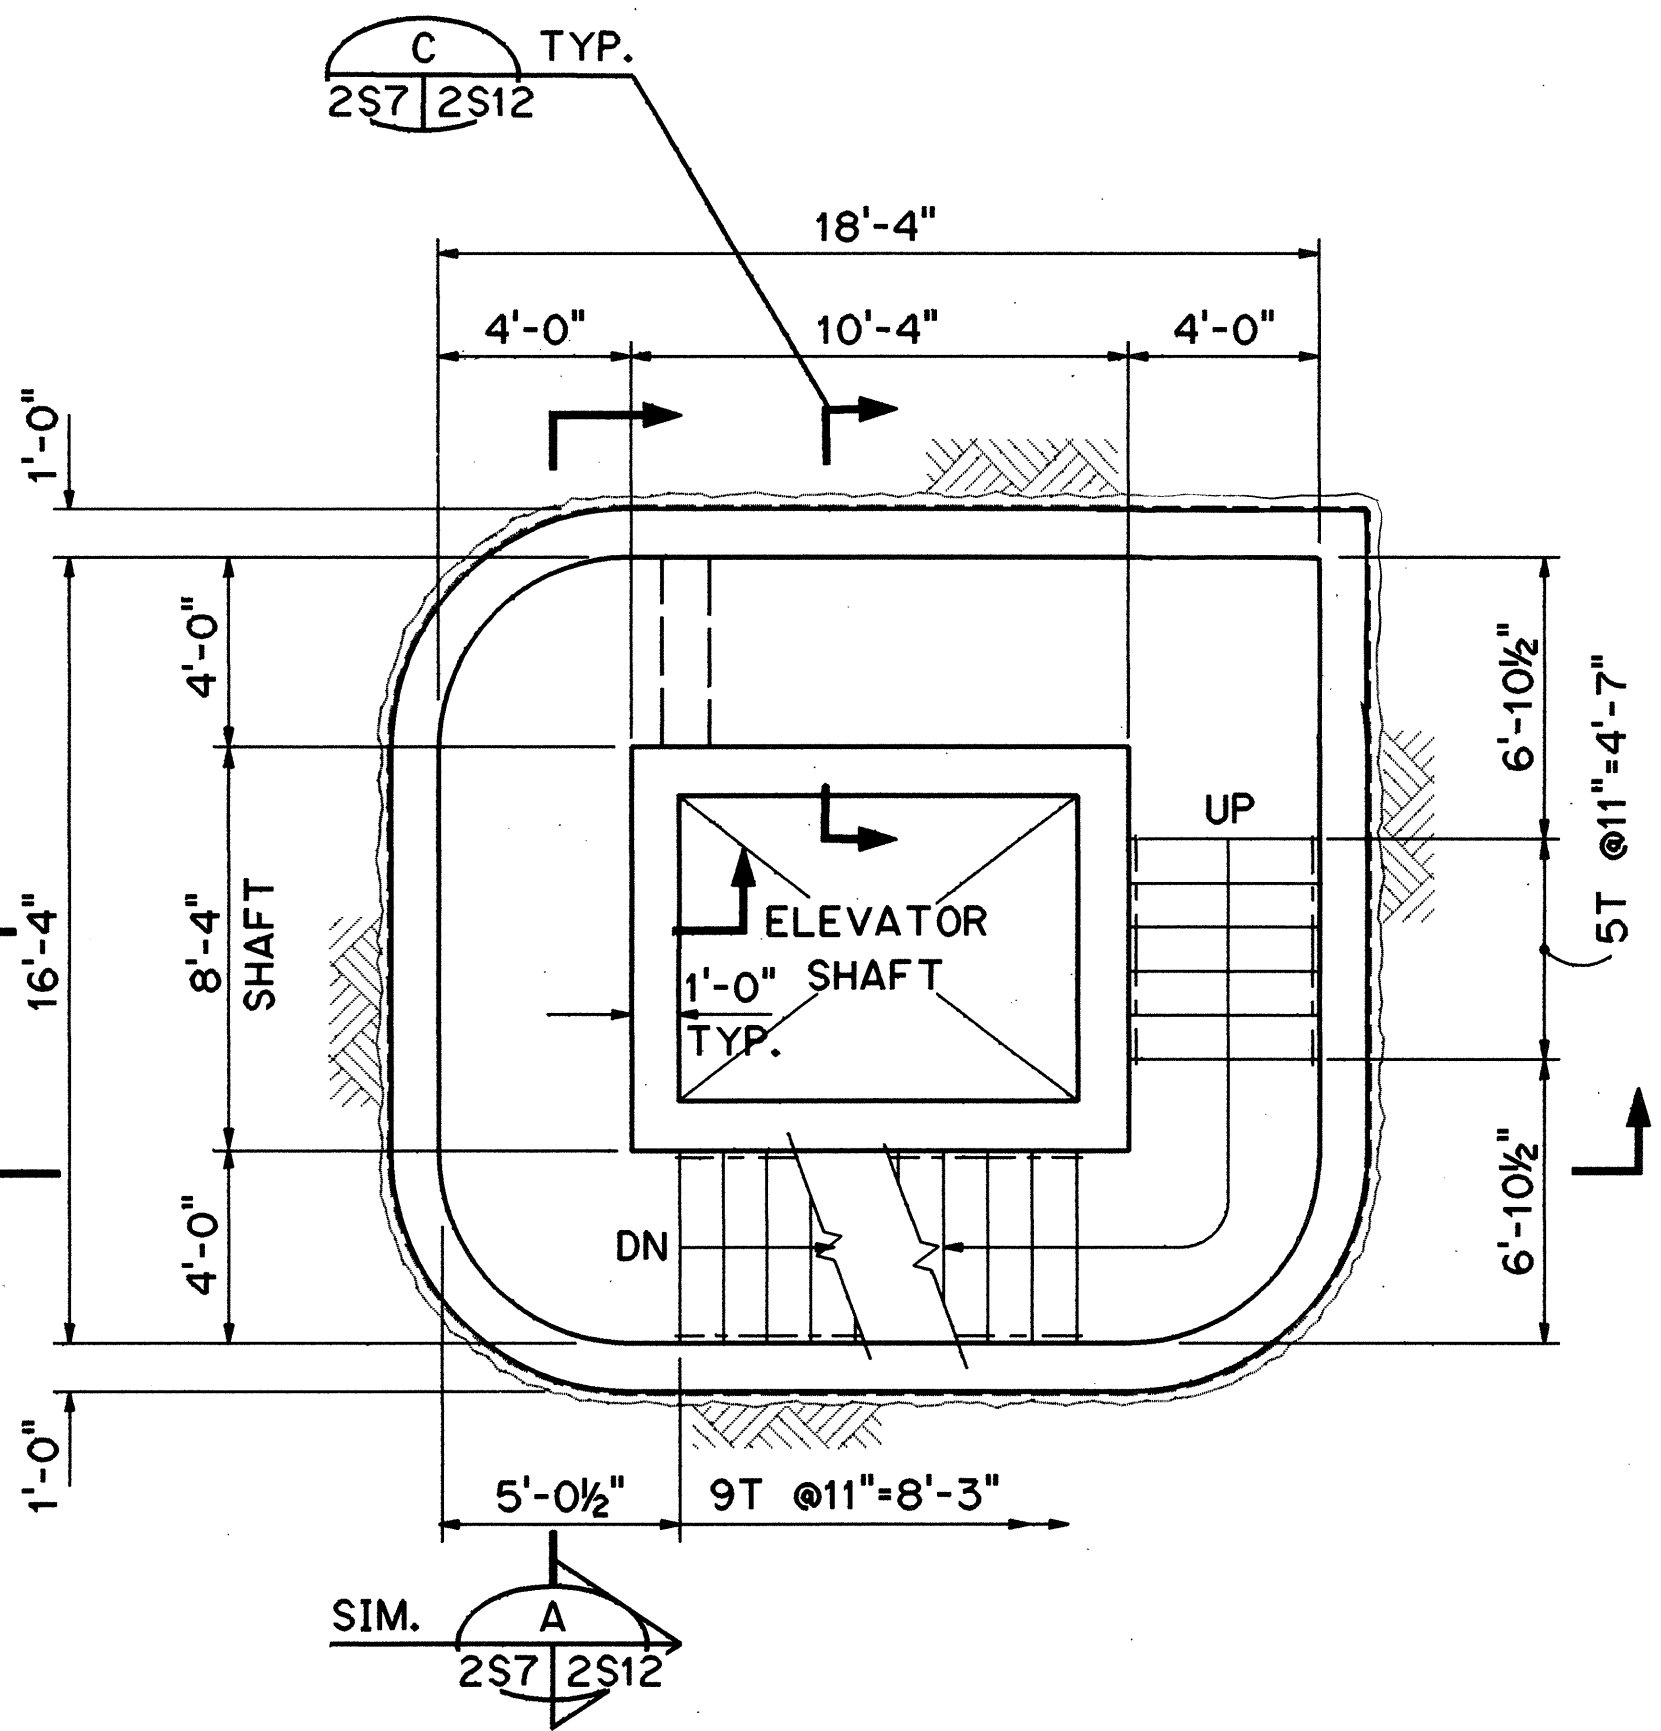

PLAN AT MIDDLE LEVEL


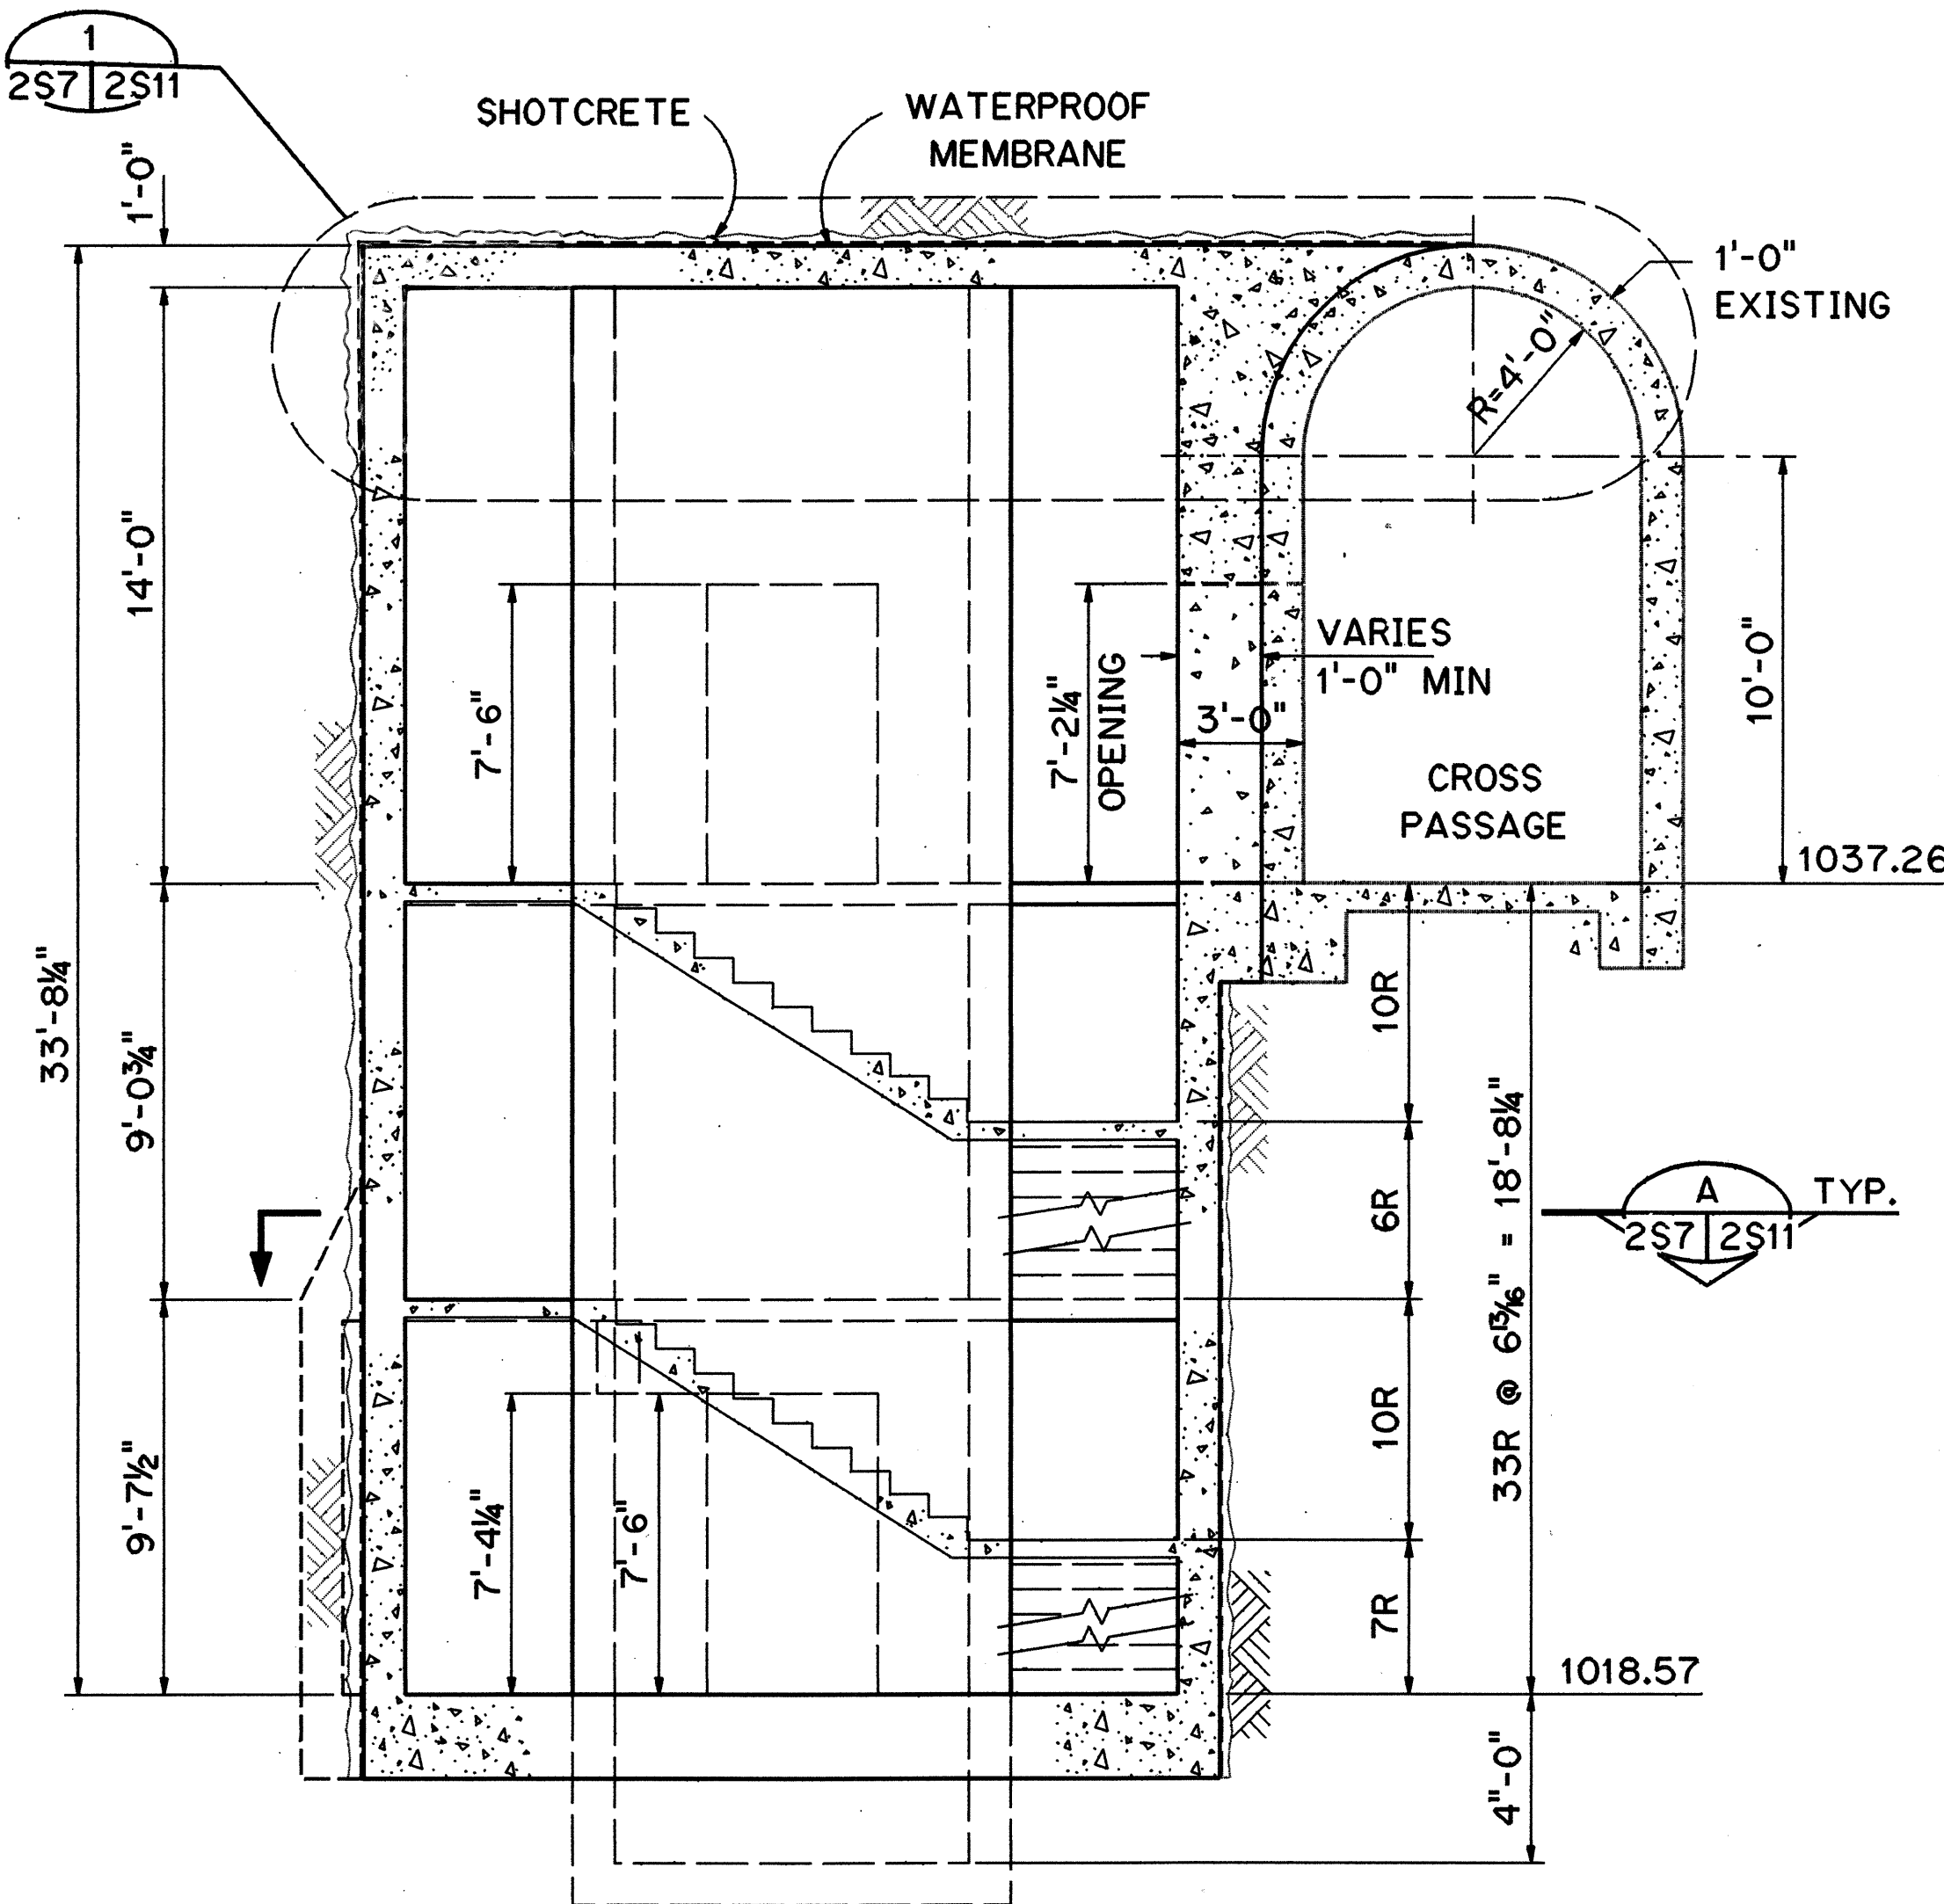


SECTION A

- FOR DOOR SCHEDULE 10B 2, 14B 3, SEE SHT. NO. 3A1.
- FOR DOOR DETAILS, SEE SHT. NO. 2A3.
- FOR ELEVATOR PIT LADDER, SEE DETAIL 5 SHT. NO. 2A3.

NOTES:

- FOR REINFORCING DETAILS, SEE SHEET NOS 2S11, 2S12 AND 2S13.
- FOR GENERAL STRUCTURAL NOTES, SEE SHEET NO. 2S4.
- FOR SUMP DETAIL, SEE SHEET NO. 2S13.
- FOR STAIR HANDRAIL, SEE DETAIL 4, SHT. NO. 2A3.

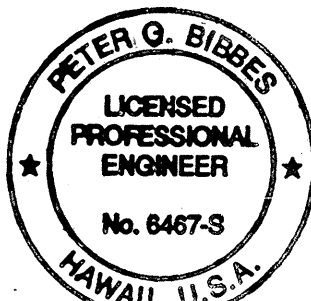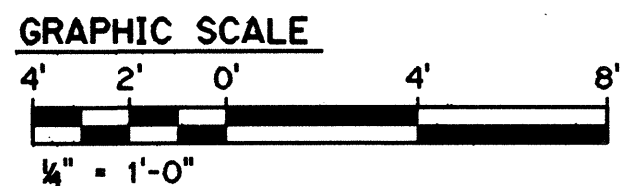


THIS WORK WAS PREPARED BY ME OR UNDER MY SUPERVISION

DATE	REVISION
10/13/95	ADDENDUM I
STATE OF HAWAII DEPARTMENT OF TRANSPORTATION HIGHWAYS DIVISION	
CROSSPASSAGE NO. 3	
CONNECTION PLANS & SECTION	
EXPLORATORY TUNNEL IMPROVEMENTS	
H-3 FINISH (UNIT III)	
FAIP NO. I-H3-1(75), UNIT III	
T.K. TUNNEL/ACCESS ROADS	
SCALE: 1/4"=1'-0" DATE: JUN 1995	
SHEET NO. 2S7 OF 17 SHEETS	


DATE	NOV 94
SURVEY PLOTTED BY	R. HERNANDEZ
DESIGNED BY	G. BENKOVICH
CHECKED BY	T.M. ST. ANGELO
NO.	

FED. ROAD DIST. NO.	STATE	FED. AID PROJ. NO.	FISCAL YEAR	SHEET NO.	TOTAL SHEETS
HAWAII	HAW.	I-H3-1(75) UNIT III	1994	55	353

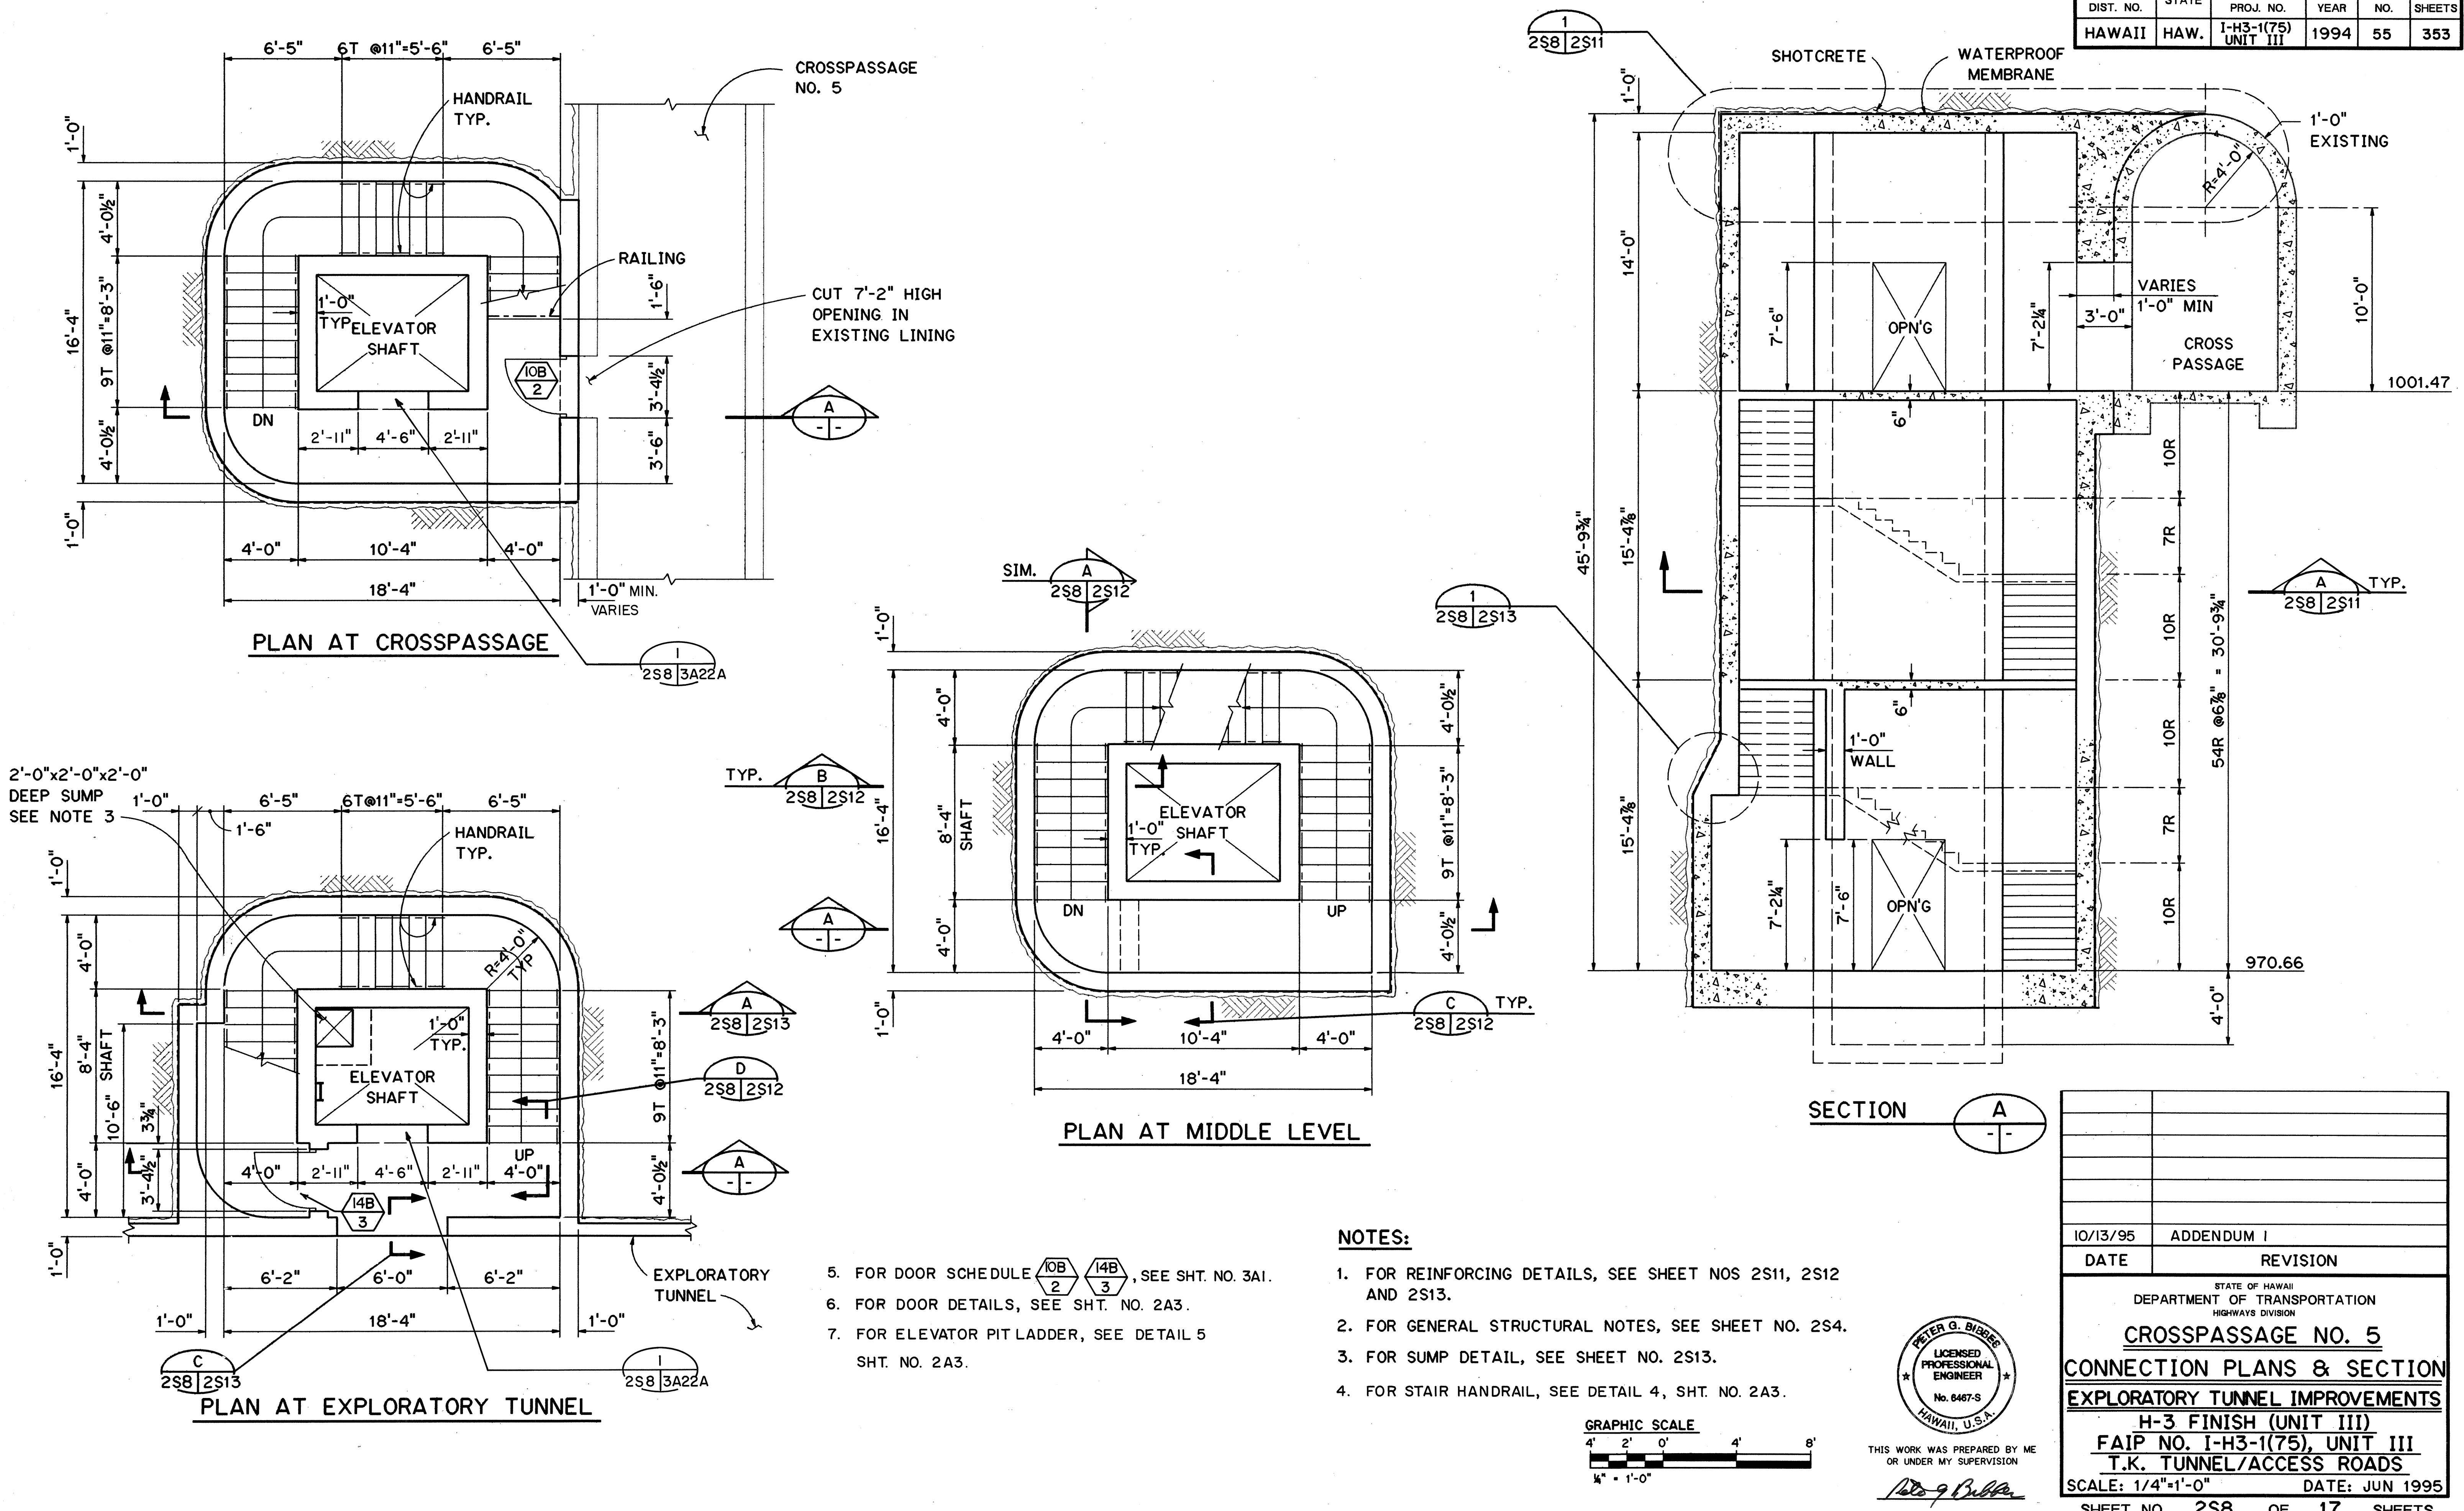


DATE	NOV 94
SURVEY PLOTTED BY	R. HERNANDEZ
DESIGNED BY	G. BENKOVICH
CHECKED BY	M.S. UWANG
NO.	


FED. ROAD DIST. NO.	STATE	FED. AID PROJ. NO.	FISCAL YEAR	SHEET NO.	TOTAL SHEETS
HAWAII	HAW.	1-H3-1(75) UNIT III	1994	56	353

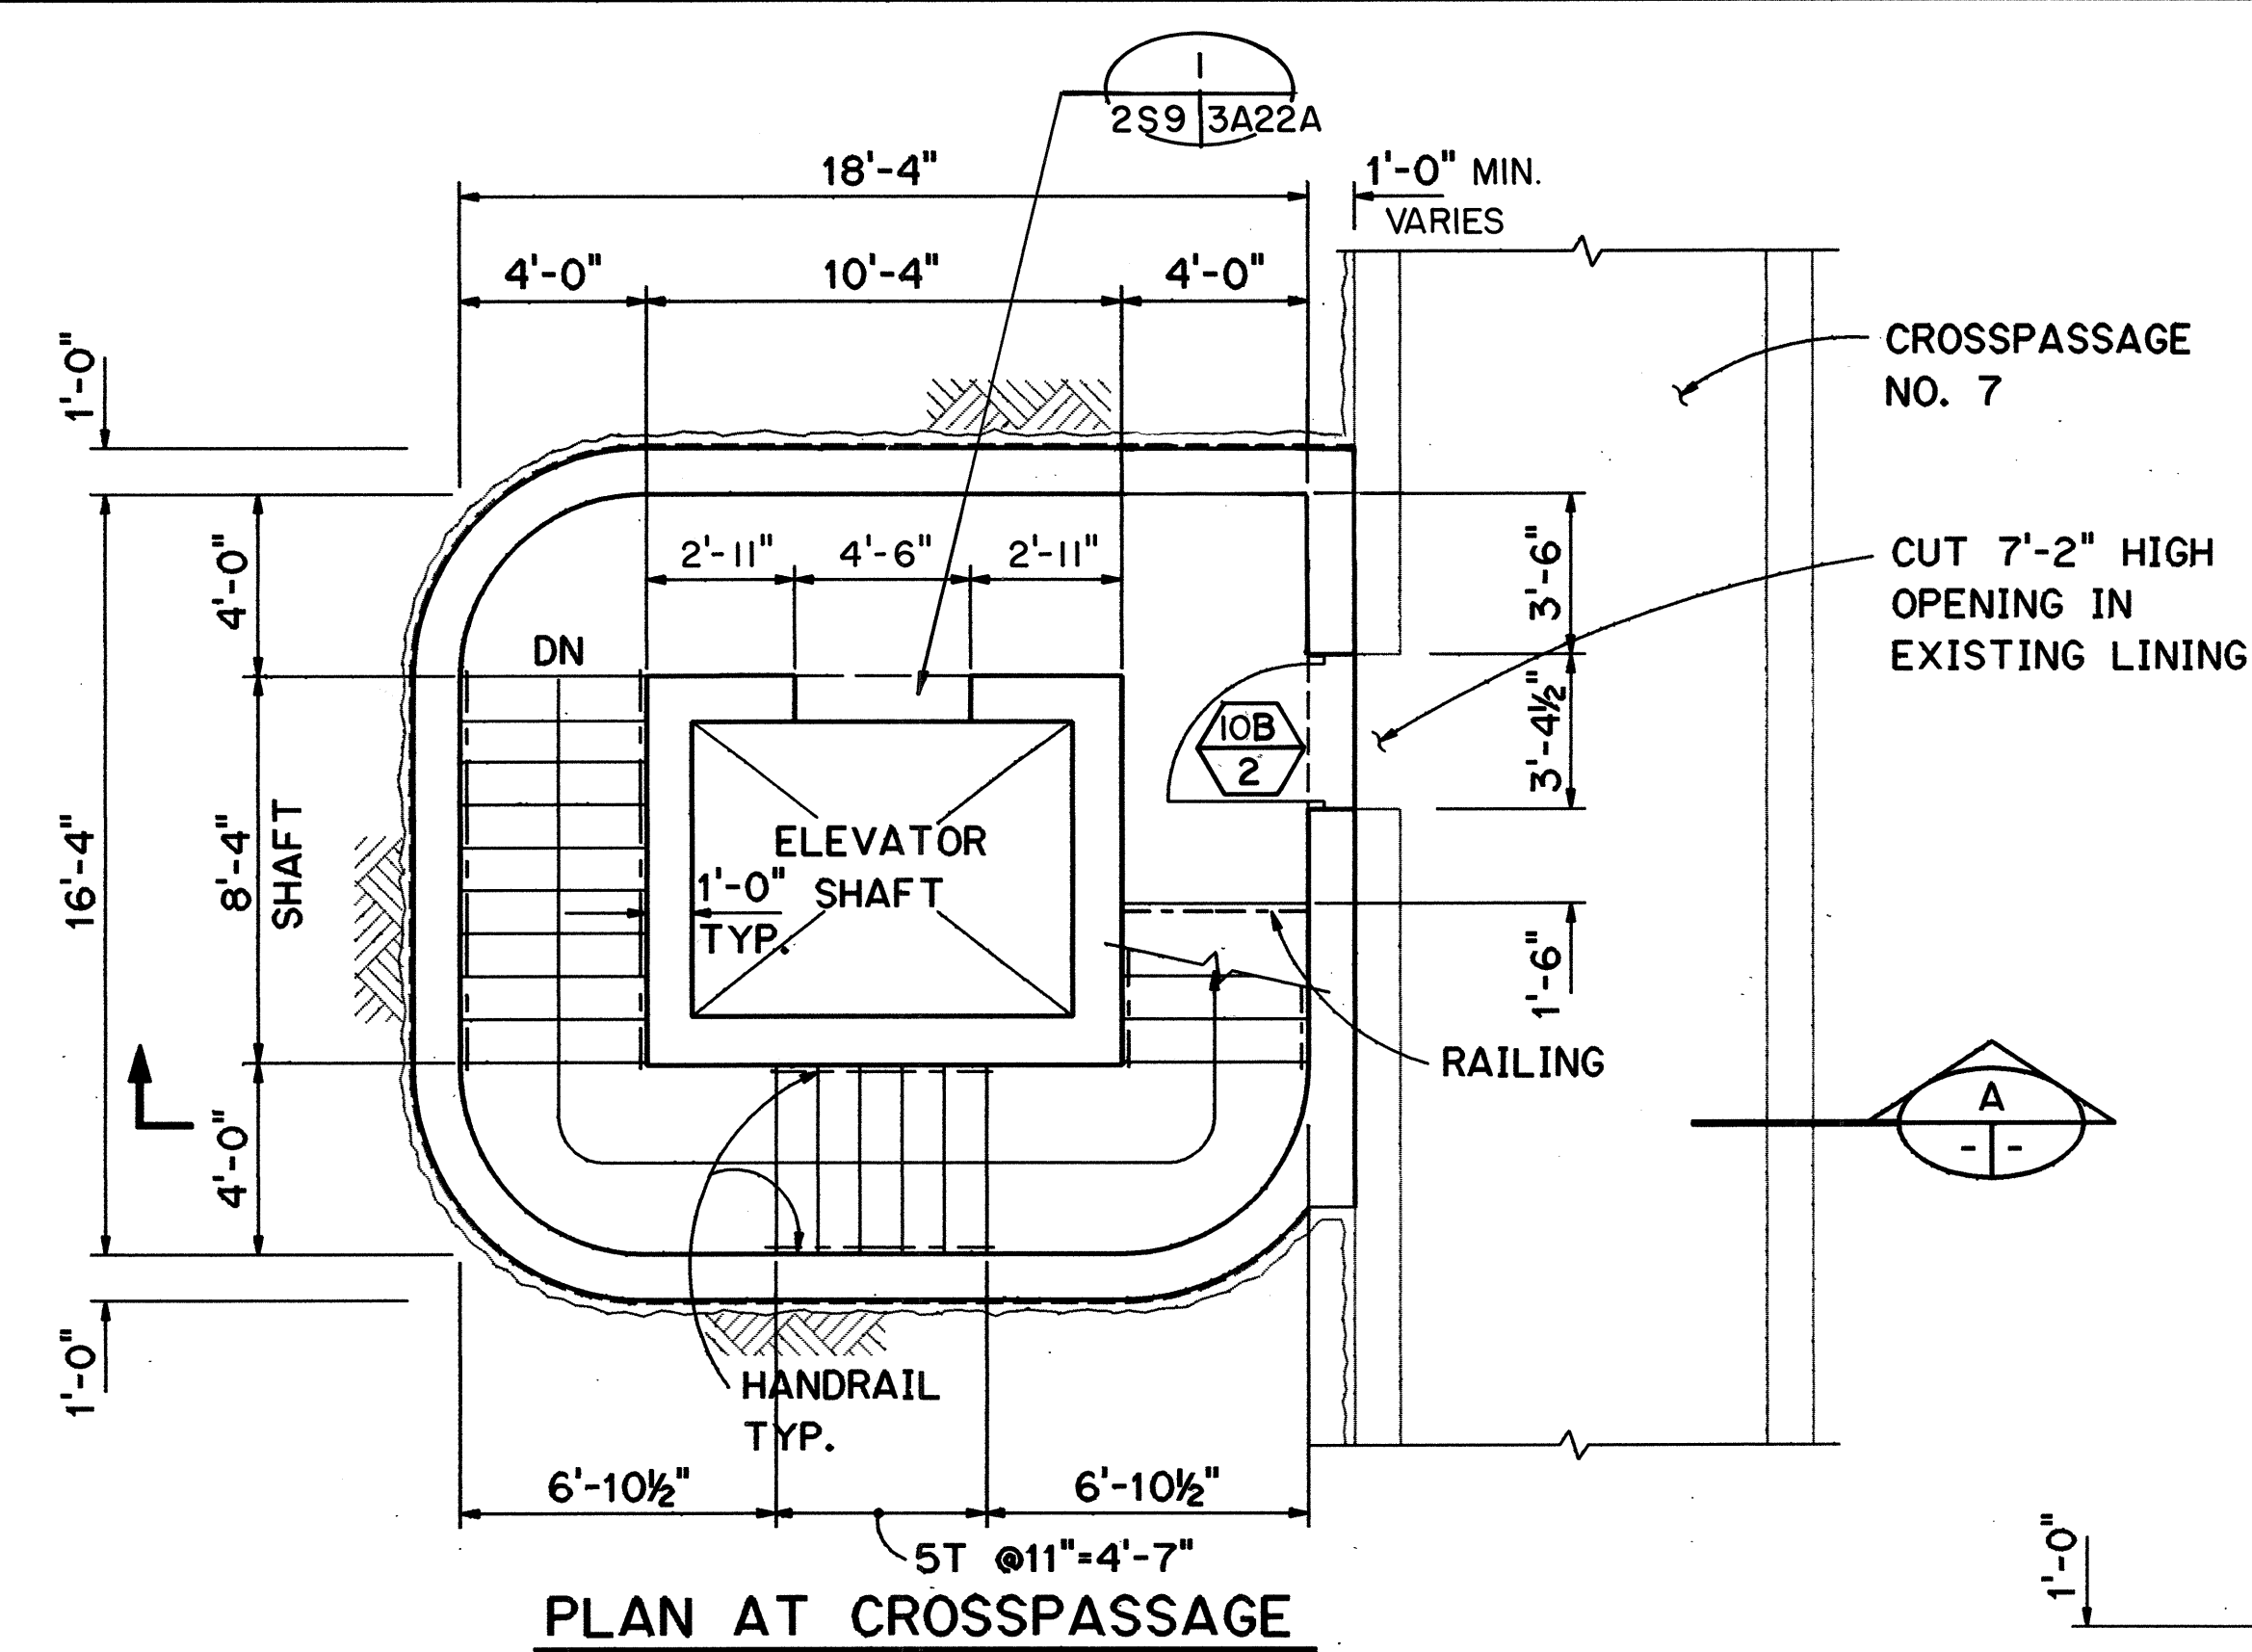


PLAN AT CROSSPASSAGE

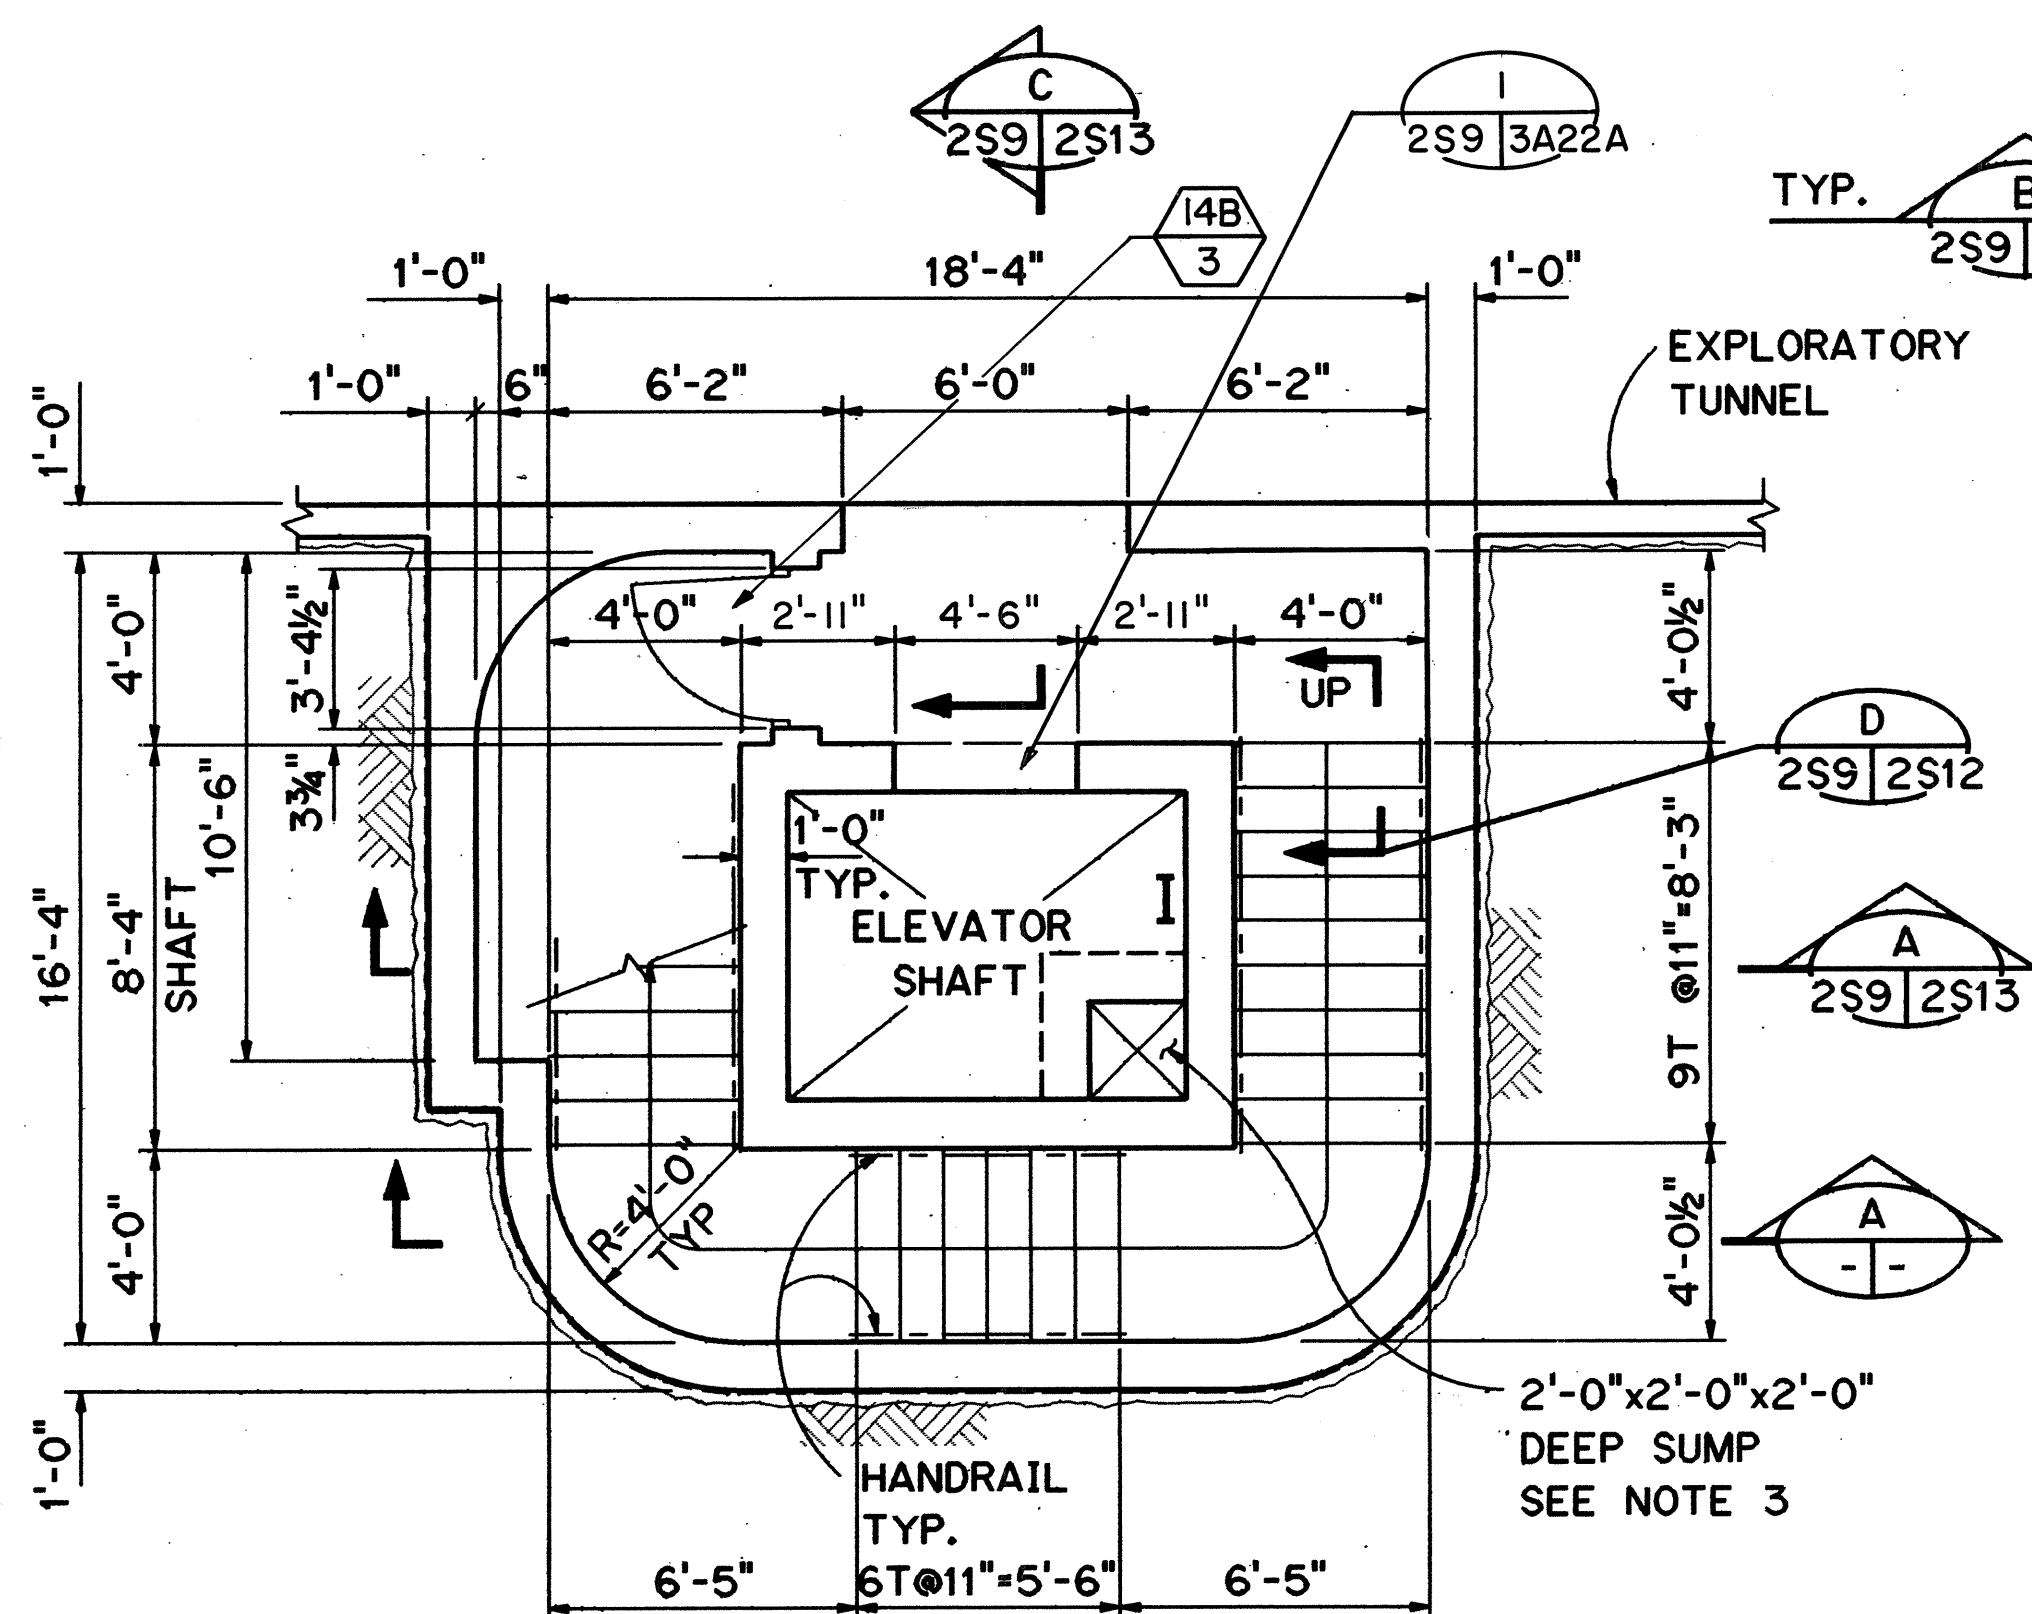

PLAN AT EXP. TUNNEL

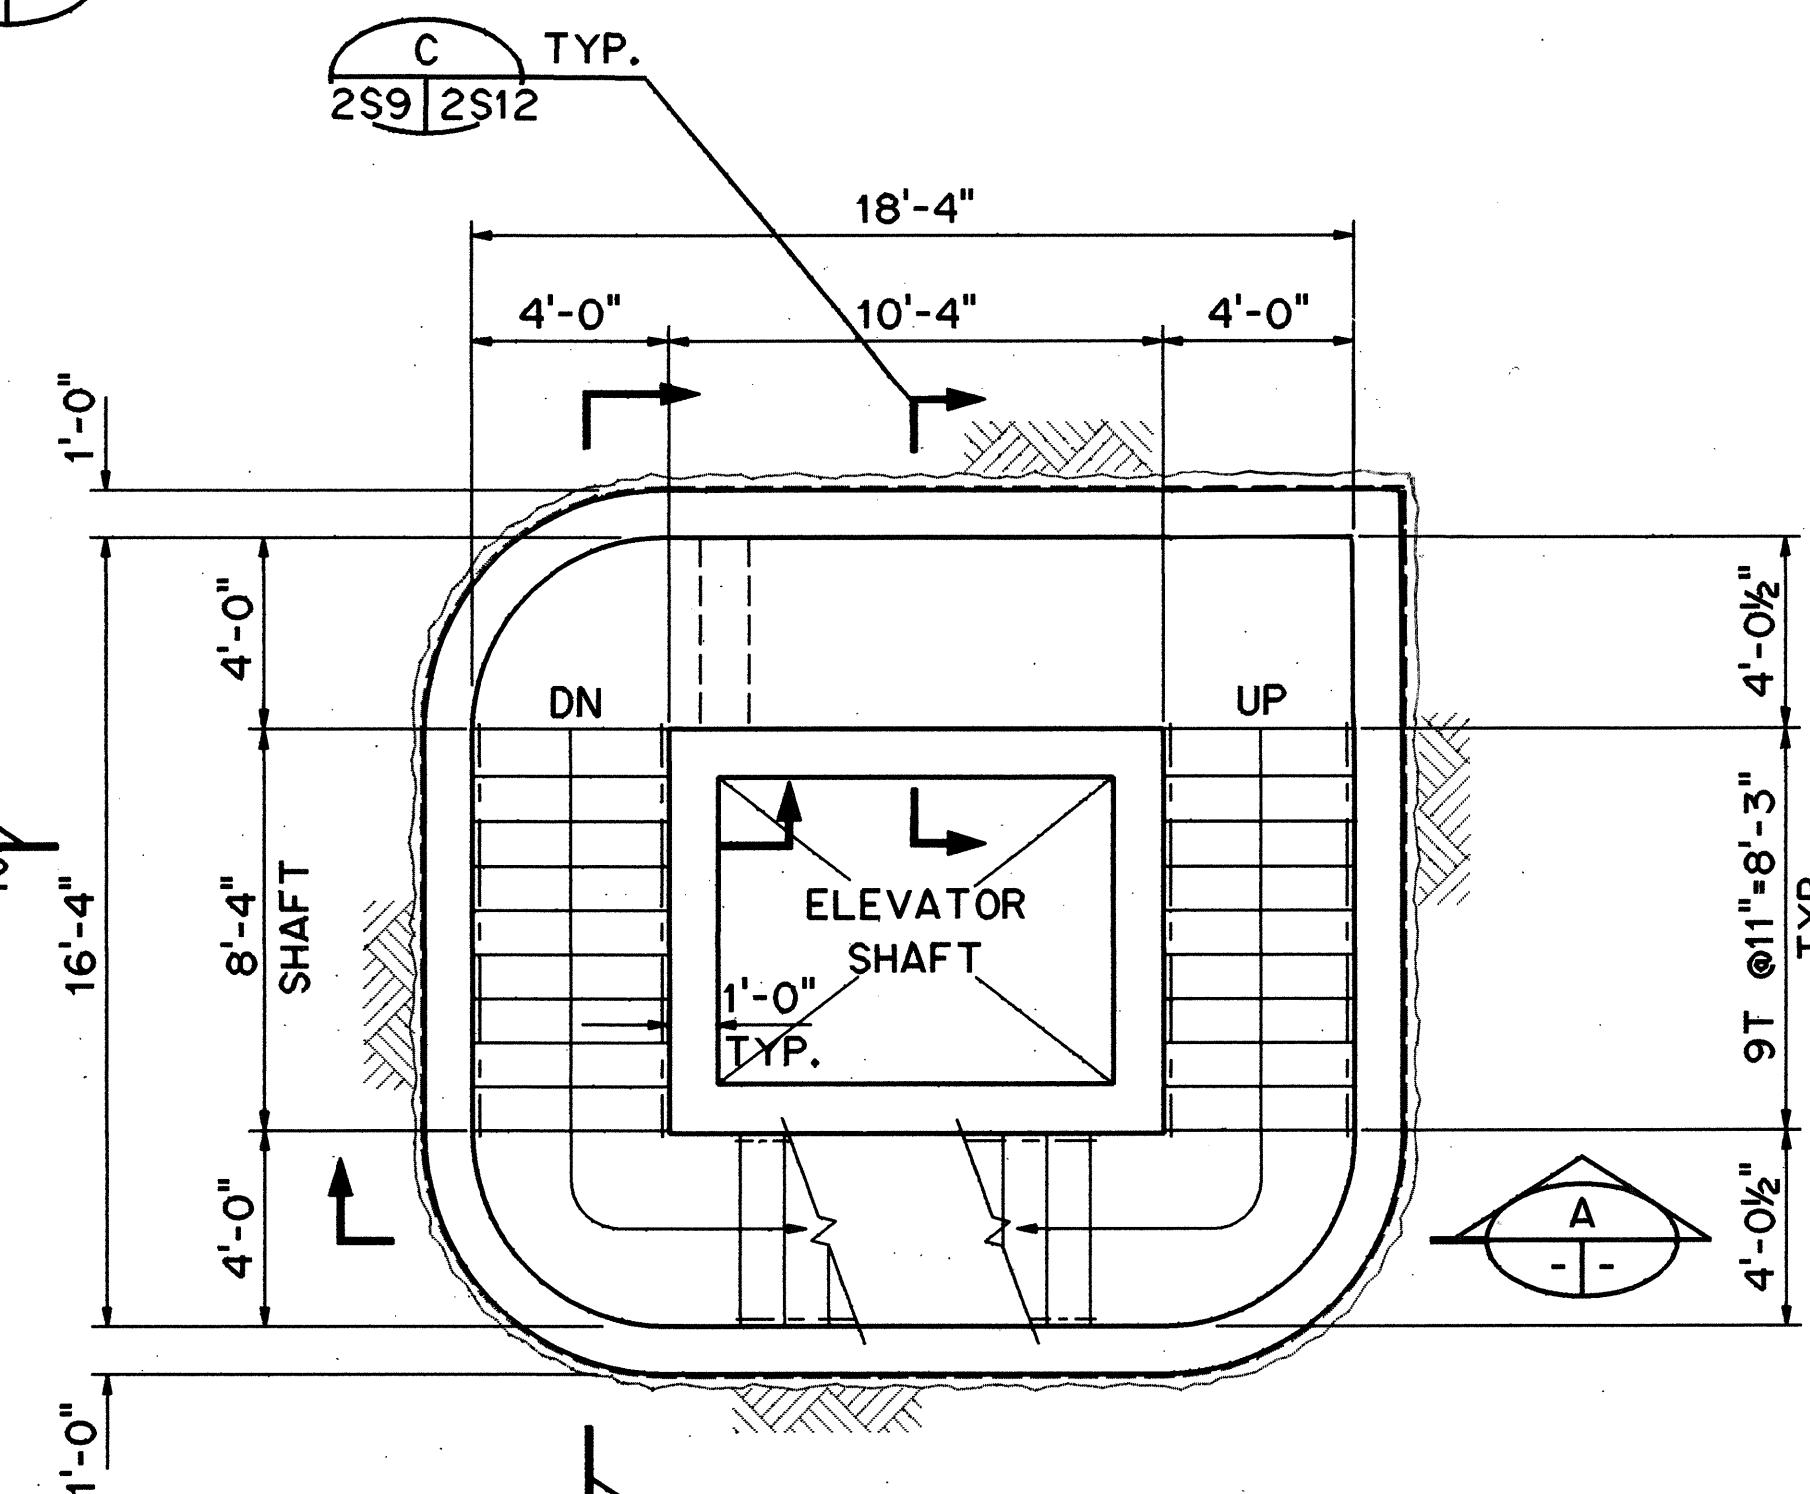



PLAN AT MIDDLE LEVEL

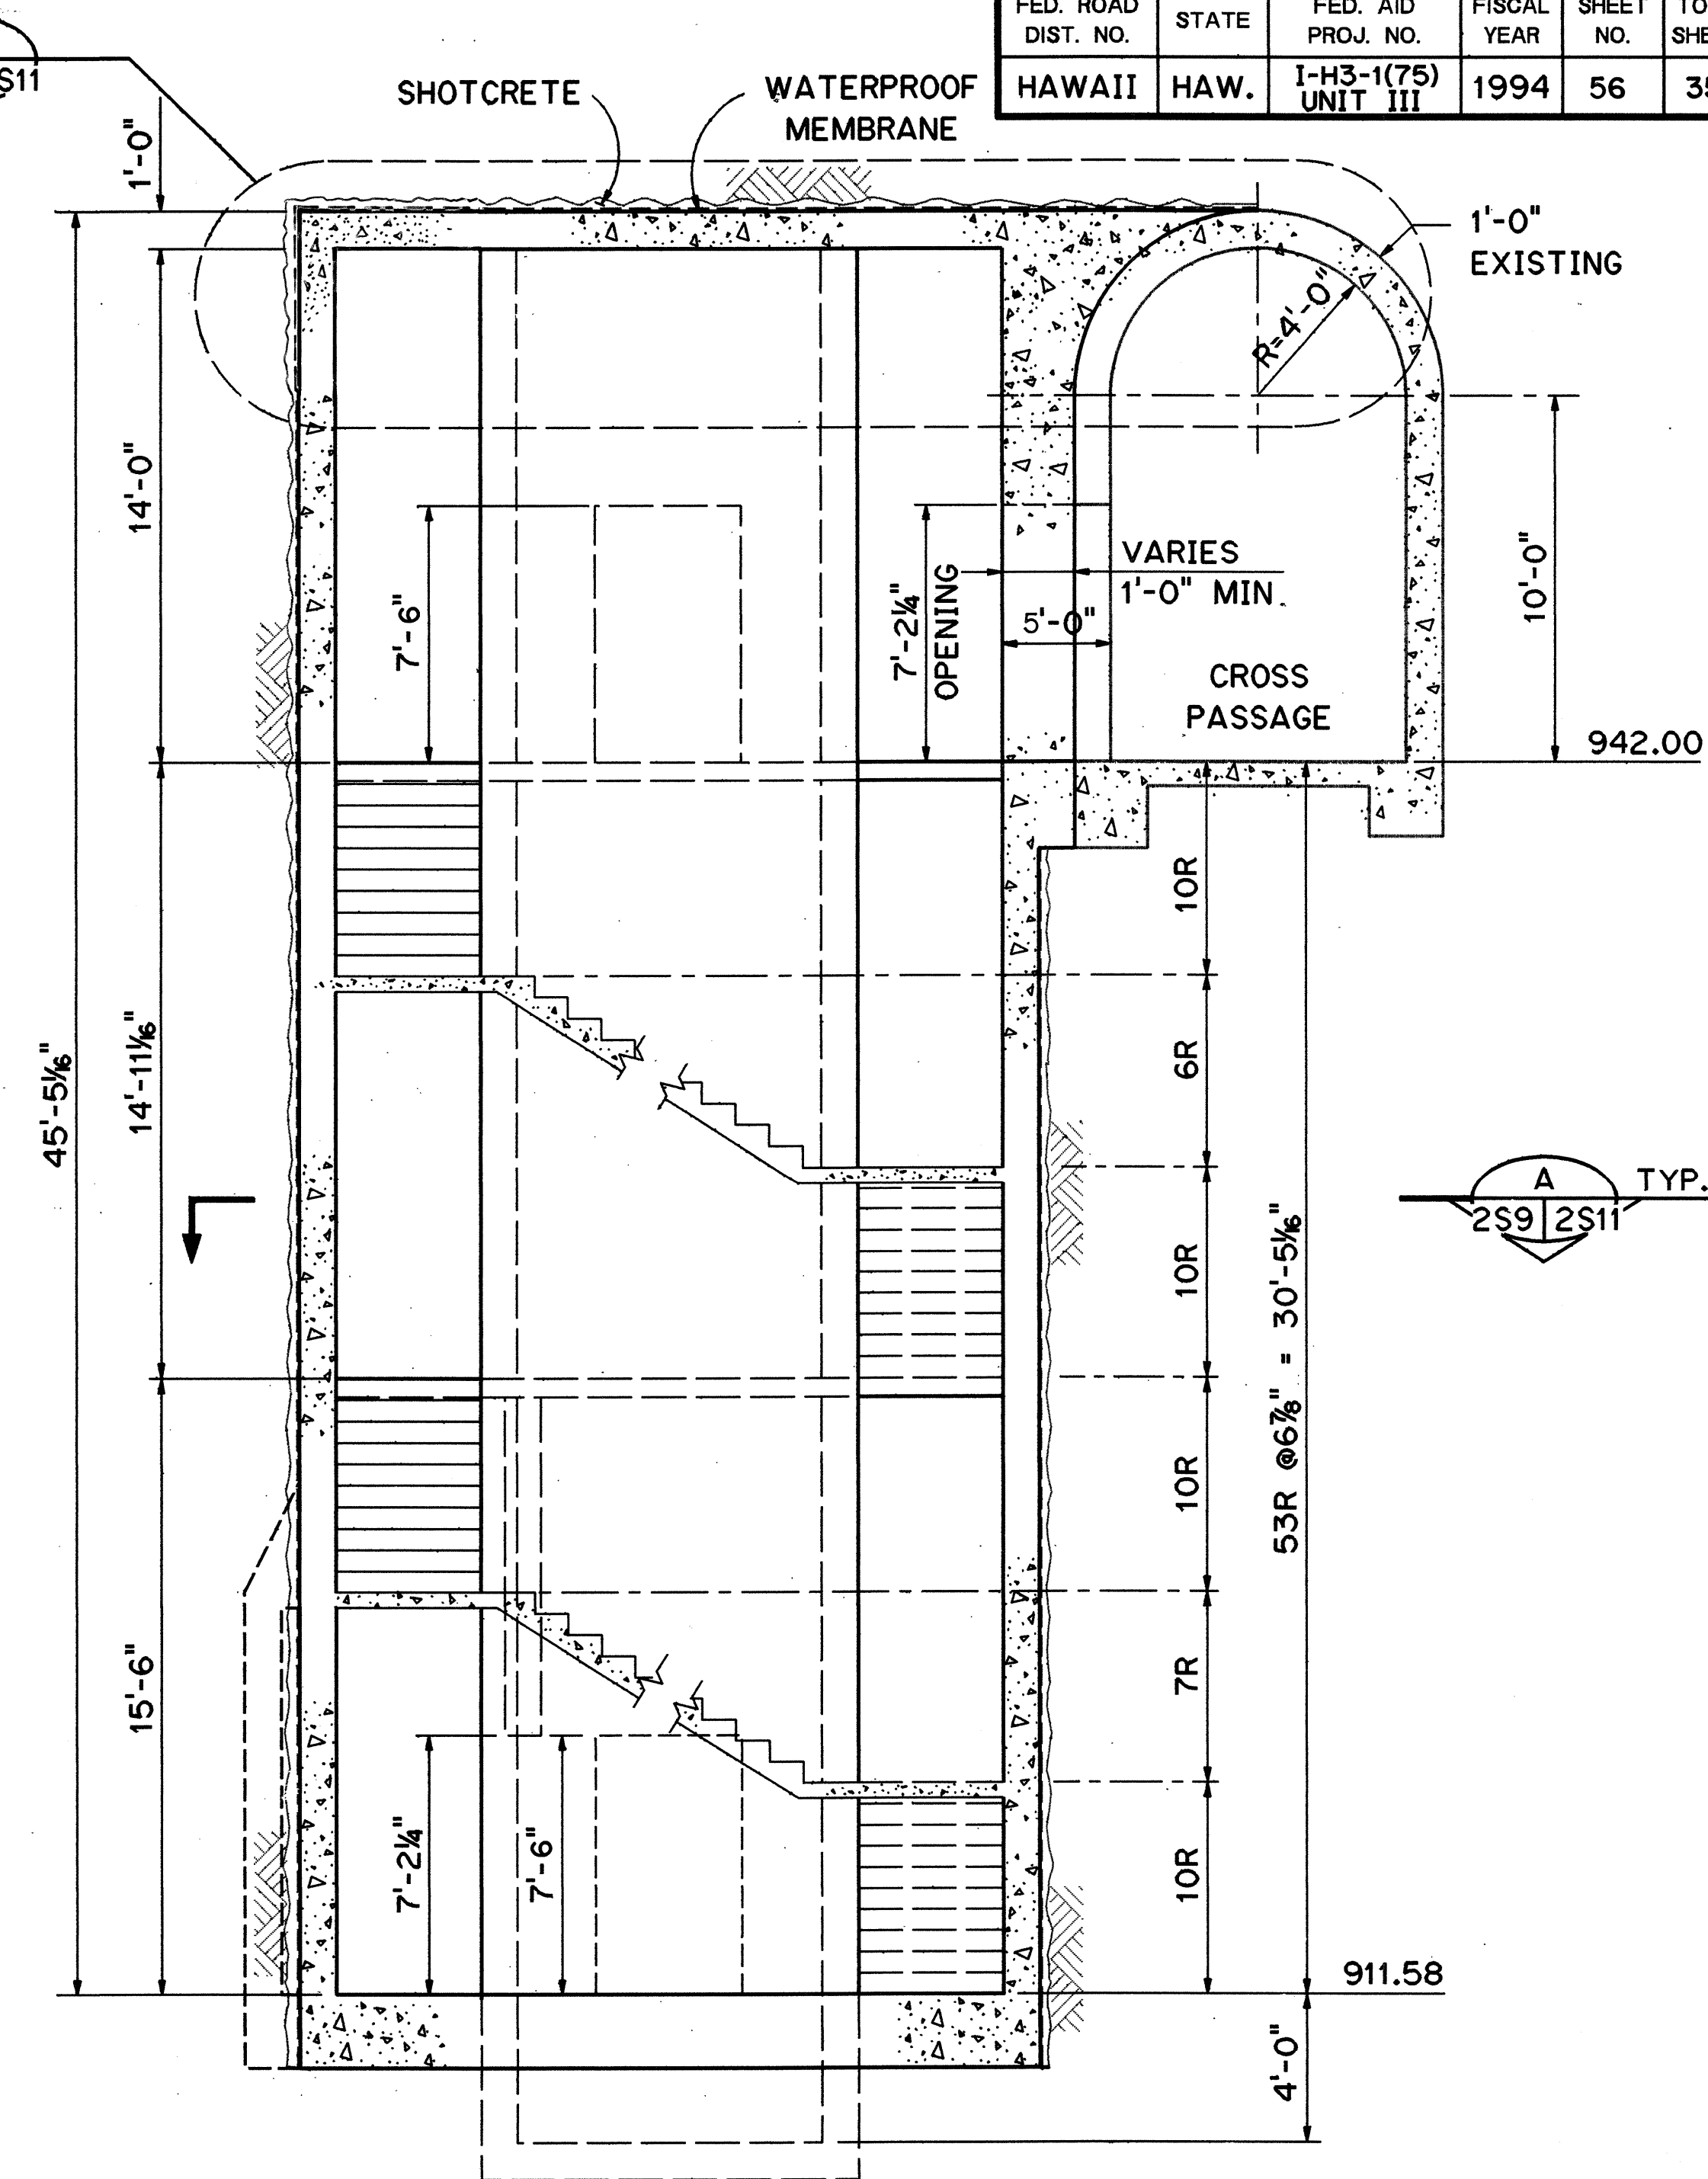

SECTION A

NOTES:


- FOR DOOR SCHEDULE (10B/2), SEE SHT. NO. 3A1.
- FOR DOOR DETAILS, SEE SHT. NO. 2A3.
- FOR ELEVATOR PIT LADDER, SEE DETAIL 5 SHT. NO. 2A3.
- FOR REINFORCING DETAILS, SEE SHEET NOS 2S11, 2S12 AND 2S13.
- FOR GENERAL STRUCTURAL NOTES, SEE SHEET NO. 2S4.
- FOR SUMP DETAIL, SEE SHEET NO. 2S13.
- FOR STAIR HANDRAIL, SEE DETAIL 4, SHT. NO. 2A3.

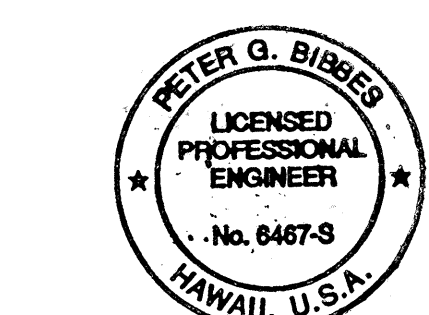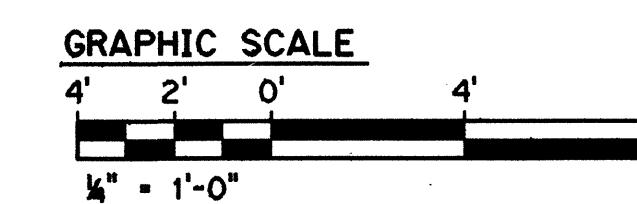

THIS WORK WAS PREPARED BY ME
OR UNDER MY SUPERVISION
Peter G. Birges

DATE	REVISION
10/13/95	ADDENDUM I
STATE OF HAWAII DEPARTMENT OF TRANSPORTATION HIGHWAYS DIVISION	
CROSSPASSAGE NO. 7	
CONNECTION PLANS & SECTION	
EXPLORATORY TUNNEL IMPROVEMENTS	
H-3 FINISH (UNIT III)	
FAIP NO. 1-H3-1(75), UNIT III	
T.K. TUNNEL/ACCESS ROADS	
SCALE: 1/4"=1'-0" DATE: JUN 1995	
SHEET NO. 2S9 OF 17 SHEETS	

FED. ROAD DIST. NO.	STATE	FED. AID PROJ. NO.	FISCAL YEAR	SHEET NO.	TOTAL SHEETS
HAWAII	HAW.	I-H3-1(75) UNIT III	1994	57	353

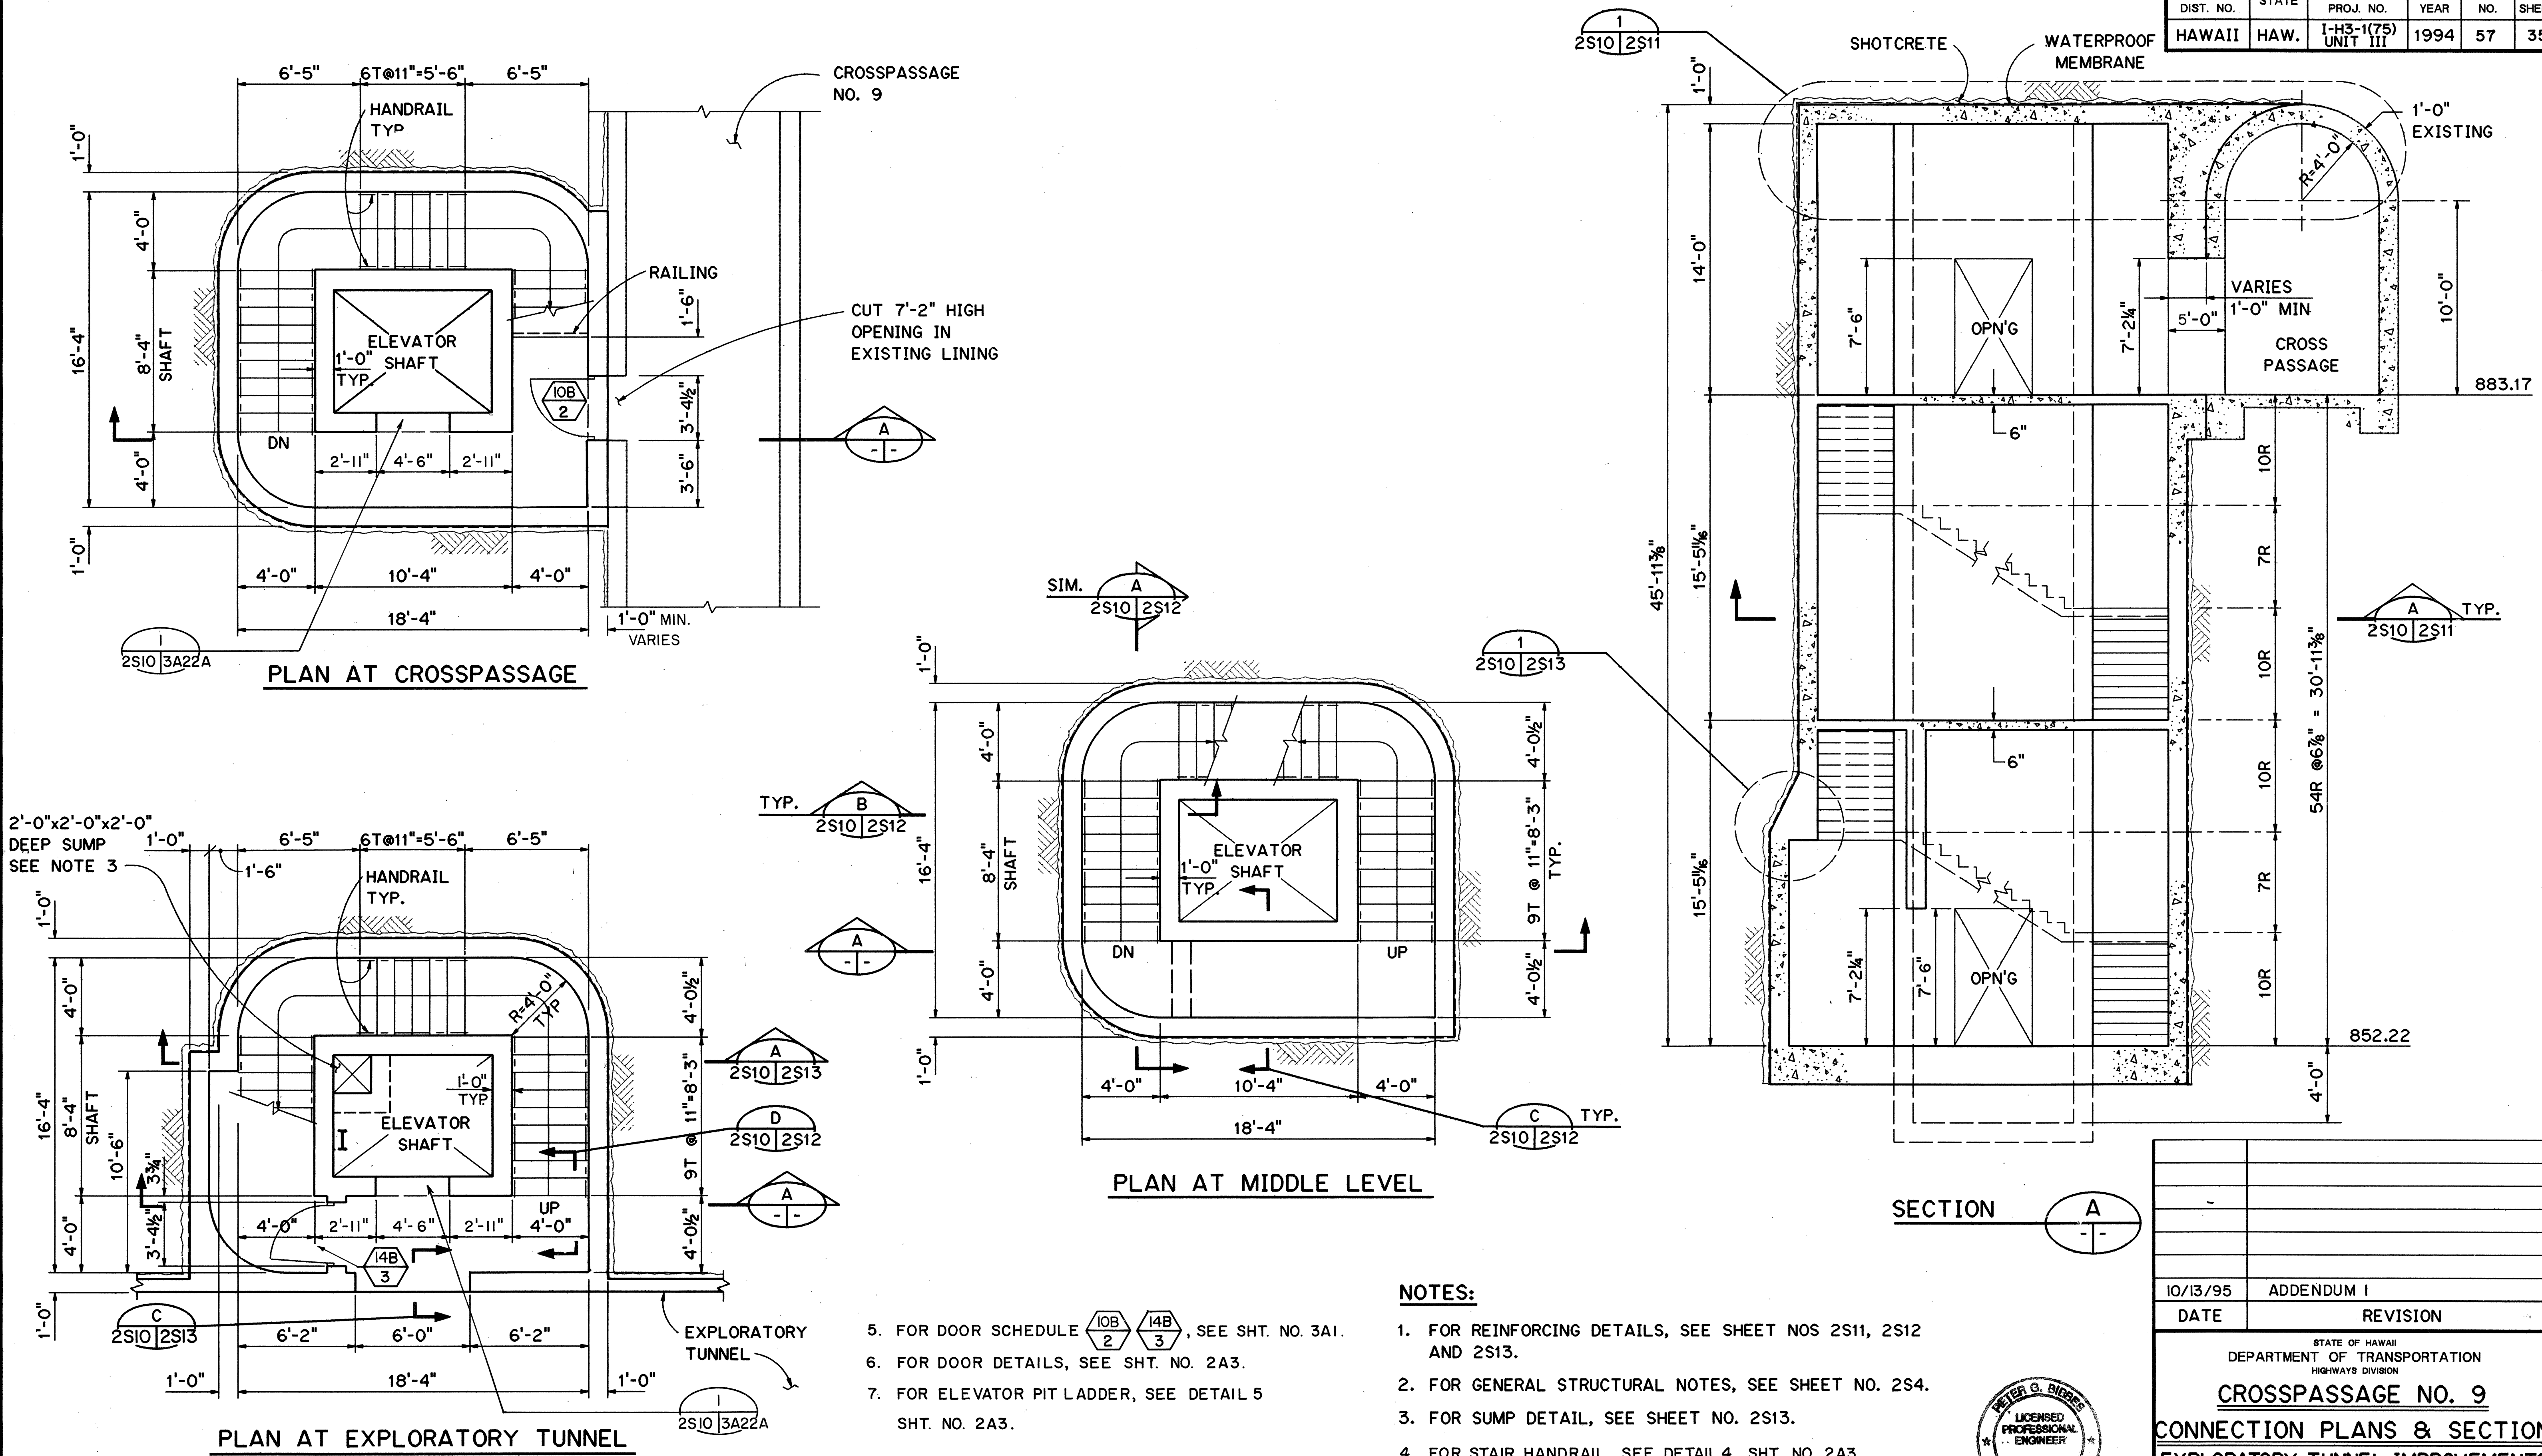




DATE	NOV 94
DESIGNED BY	N. KENNEDY
TRACED BY	NOV 94
QUANTITIES BY	G. BENKOVICH
CHECKED BY	DEC 94
NO.	

CHU 2410:CDWG,STRUCT131027.FGB71 31JAN95-07.49.10

10/13/95	ADDENDUM I
DATE	REVISION
STATE OF HAWAII DEPARTMENT OF TRANSPORTATION HIGHWAYS DIVISION	
CROSSPASSAGE NO. 9	
CONNECTION PLANS & SECTION	
EXPLORATORY TUNNEL IMPROVEMENTS	
H-3 FINISH (UNIT III)	
FAIP NO. I-H3-1(75), UNIT III	
T.K. TUNNEL/ACCESS ROADS	
SCALE: 1/4"=1'-0"	DATE: JUN 1995
SHEET NO. 2S10	OF 17 SHEETS

ADD.57

ORIGINAL PLAN	SURVEY PLOTTED BY R. HERNANDEZ	DATE NOV 94
NOTE BOOK	TRACED BY	"
	DESIGNED BY G. BENKO/CH	NOV 94
	QUANTITIES BY	"
	CHECKED BY M.S. OWANG	DEC 94
NO.		

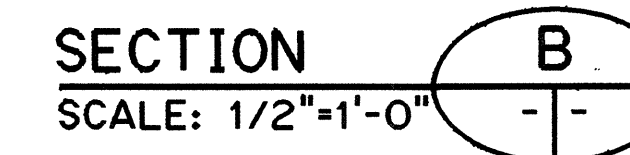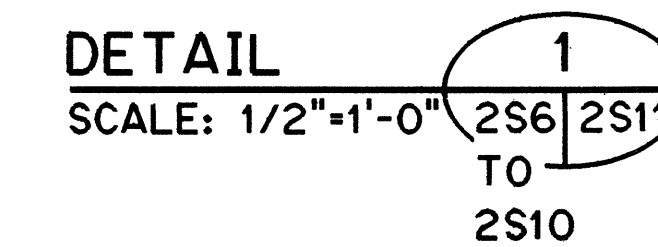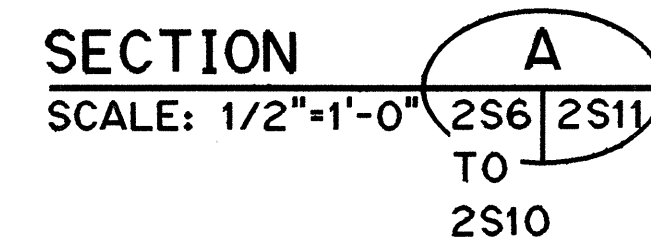

1. FOR GENERAL STRUCTURAL NOTES, SEE SHEET NO. 254.


DATE	REVISION

STATE OF HAWAII
DEPARTMENT OF TRANSPORTATION
HIGHWAYS DIVISION


SHAFT LINING
SECTIONS AND DETAIL
EXPLORATORY TUNNEL IMPROVEMENTS
H-3 FINISH (UNIT III)
FAIP NO. I-H3-1(75), UNIT III
T. K. TUNNEL

SCALE: AS NOTED DATE: JUN 1995

SHEET NO. 2S11 OF 17 SHEETS




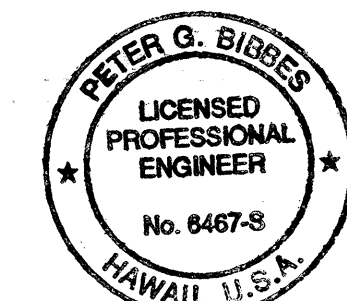


THIS WORK WAS PREPARED BY ME
OR UNDER MY SUPERVISION

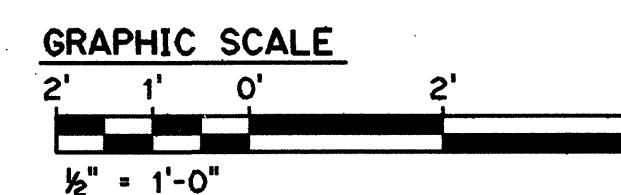

NOTES:

1. FOR GENERAL STRUCTURAL NOTES, SEE SHEET NO. 2S4.

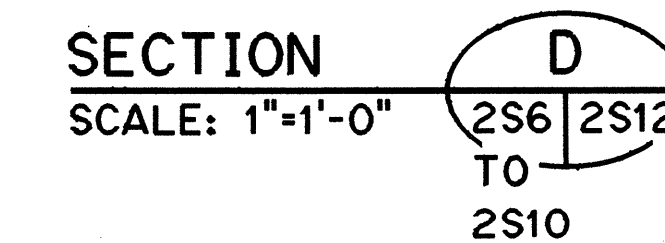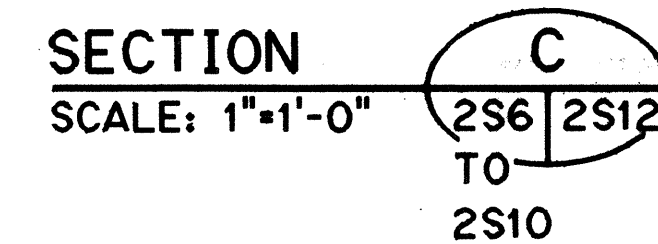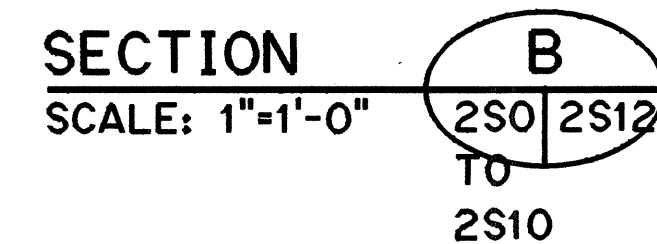
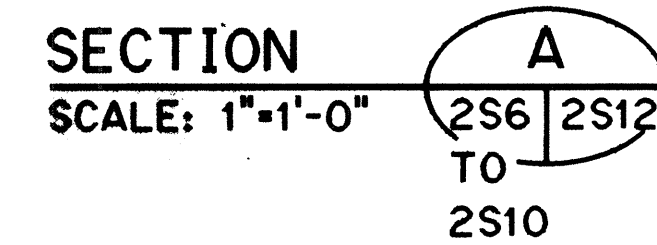


STATE OF HAWAII
DEPARTMENT OF TRANSPORTATION
HIGHWAYS DIVISION


TYPICAL STAIR SECTIONS
EXPLORATORY TUNNEL IMPROVEMENTS
H-3 FINISH (UNIT III)
FAIP NO. I-H3-1(75), UNIT III
T.K. TUNNEL/ACCESS ROADS

SCALE: AS NOTED DATE: JUN 1995

SHEET NO. 2S12 OF 17 SHEETS

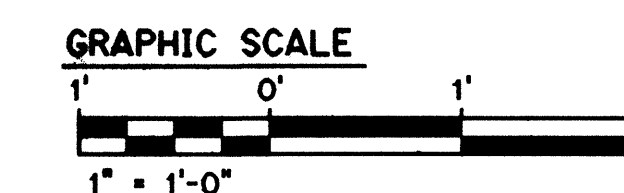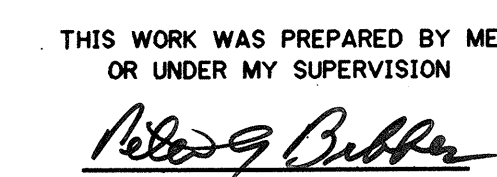


FED. ROAD DIST. NO.	STATE	FED. AID PROJ. NO.	FISCAL YEAR	SHEET NO.	TOTAL SHEETS
HAWAII	HAW.	I-H3-1(75) UNIT III	1994	60	353

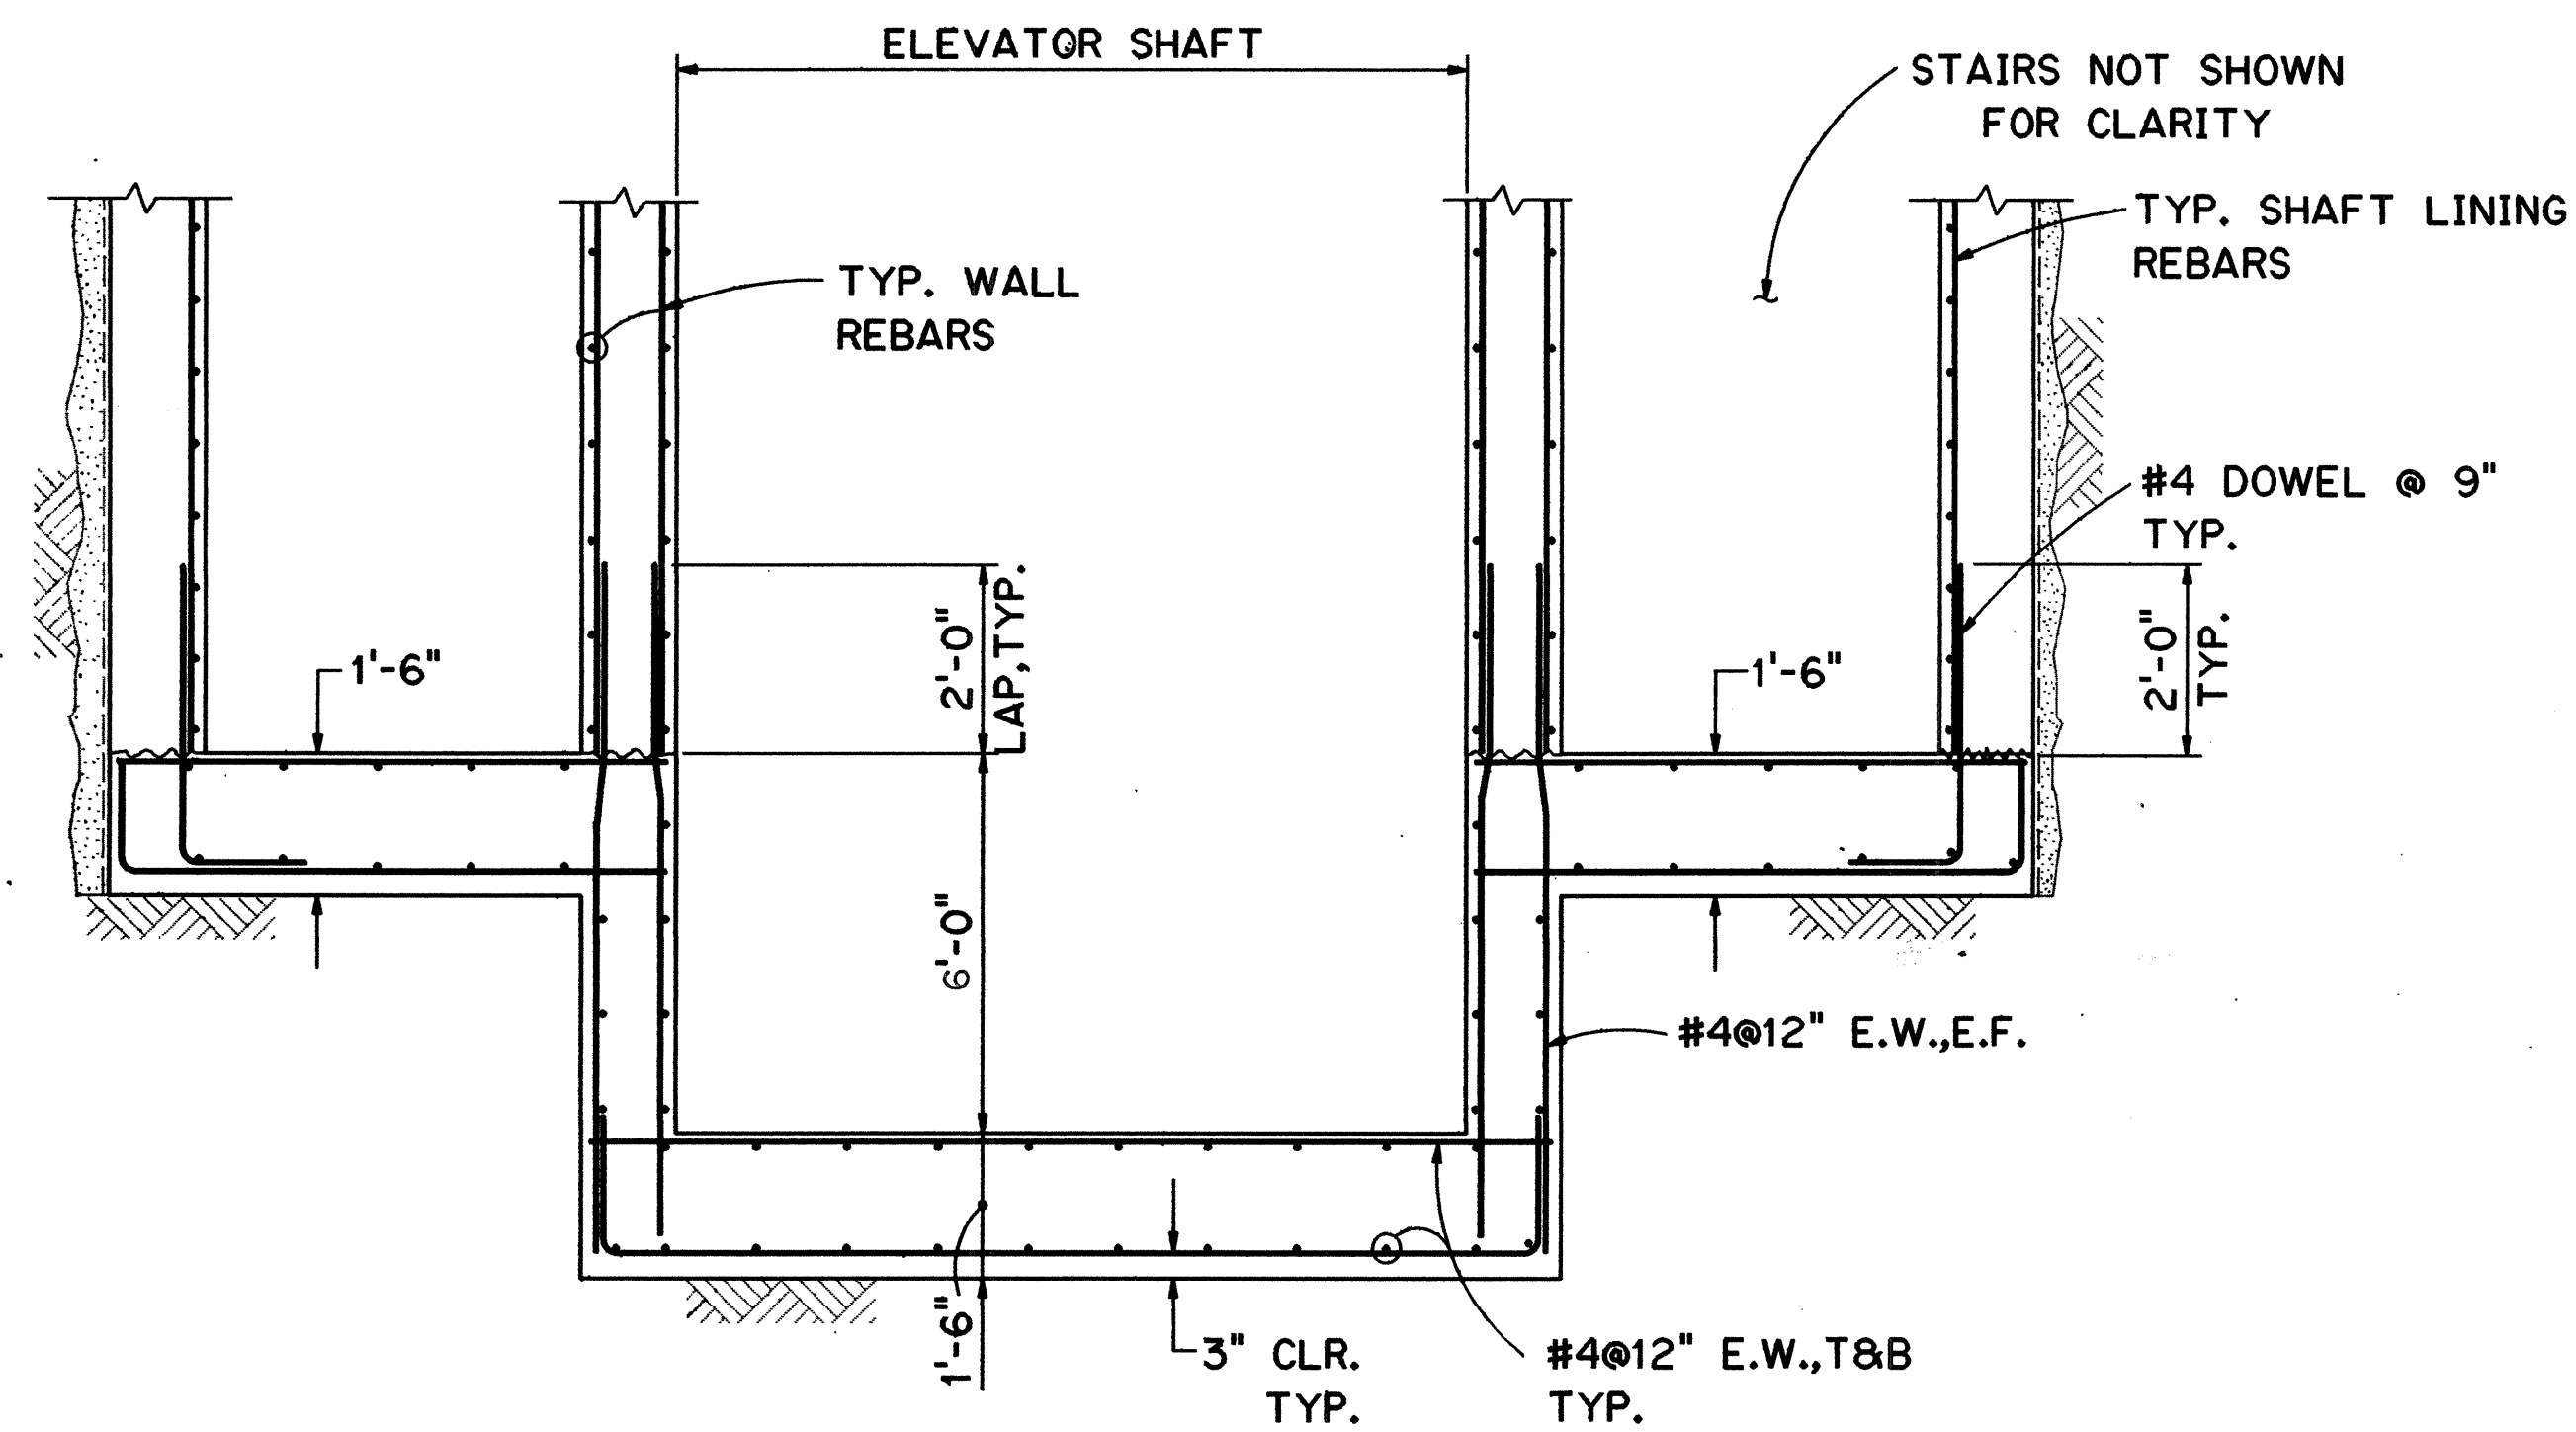

SECTION
SCALE: 1/2"=1'-0"

2S6	2S13
TO	
2S10	

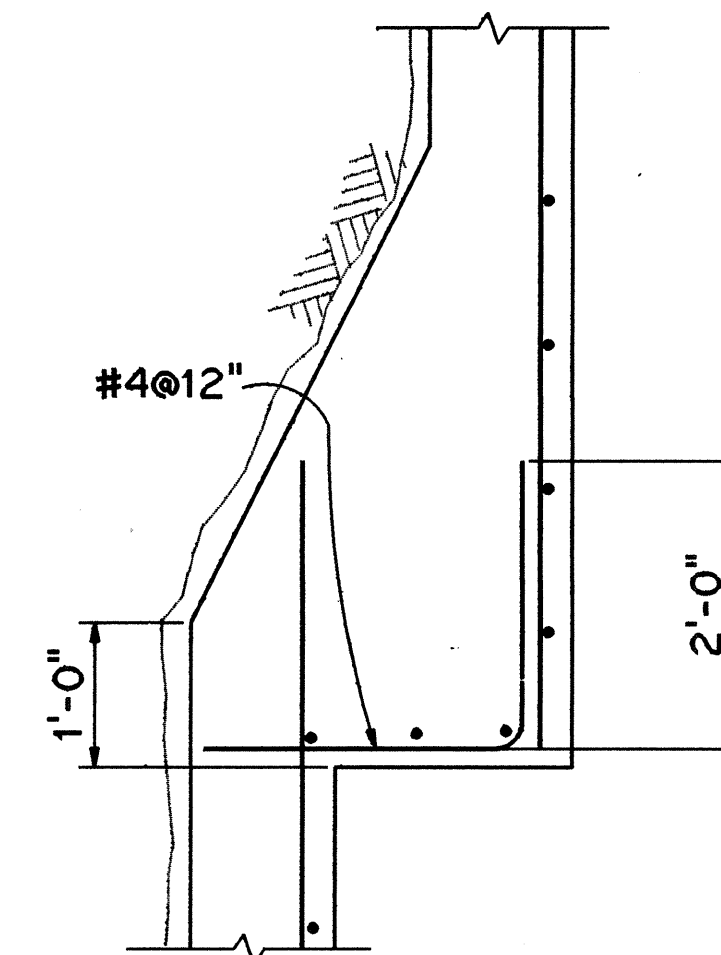


DETAIL

SCALE: $\frac{3}{4}" = 1' - 0"$

2S6 2S13

2S8


2S10

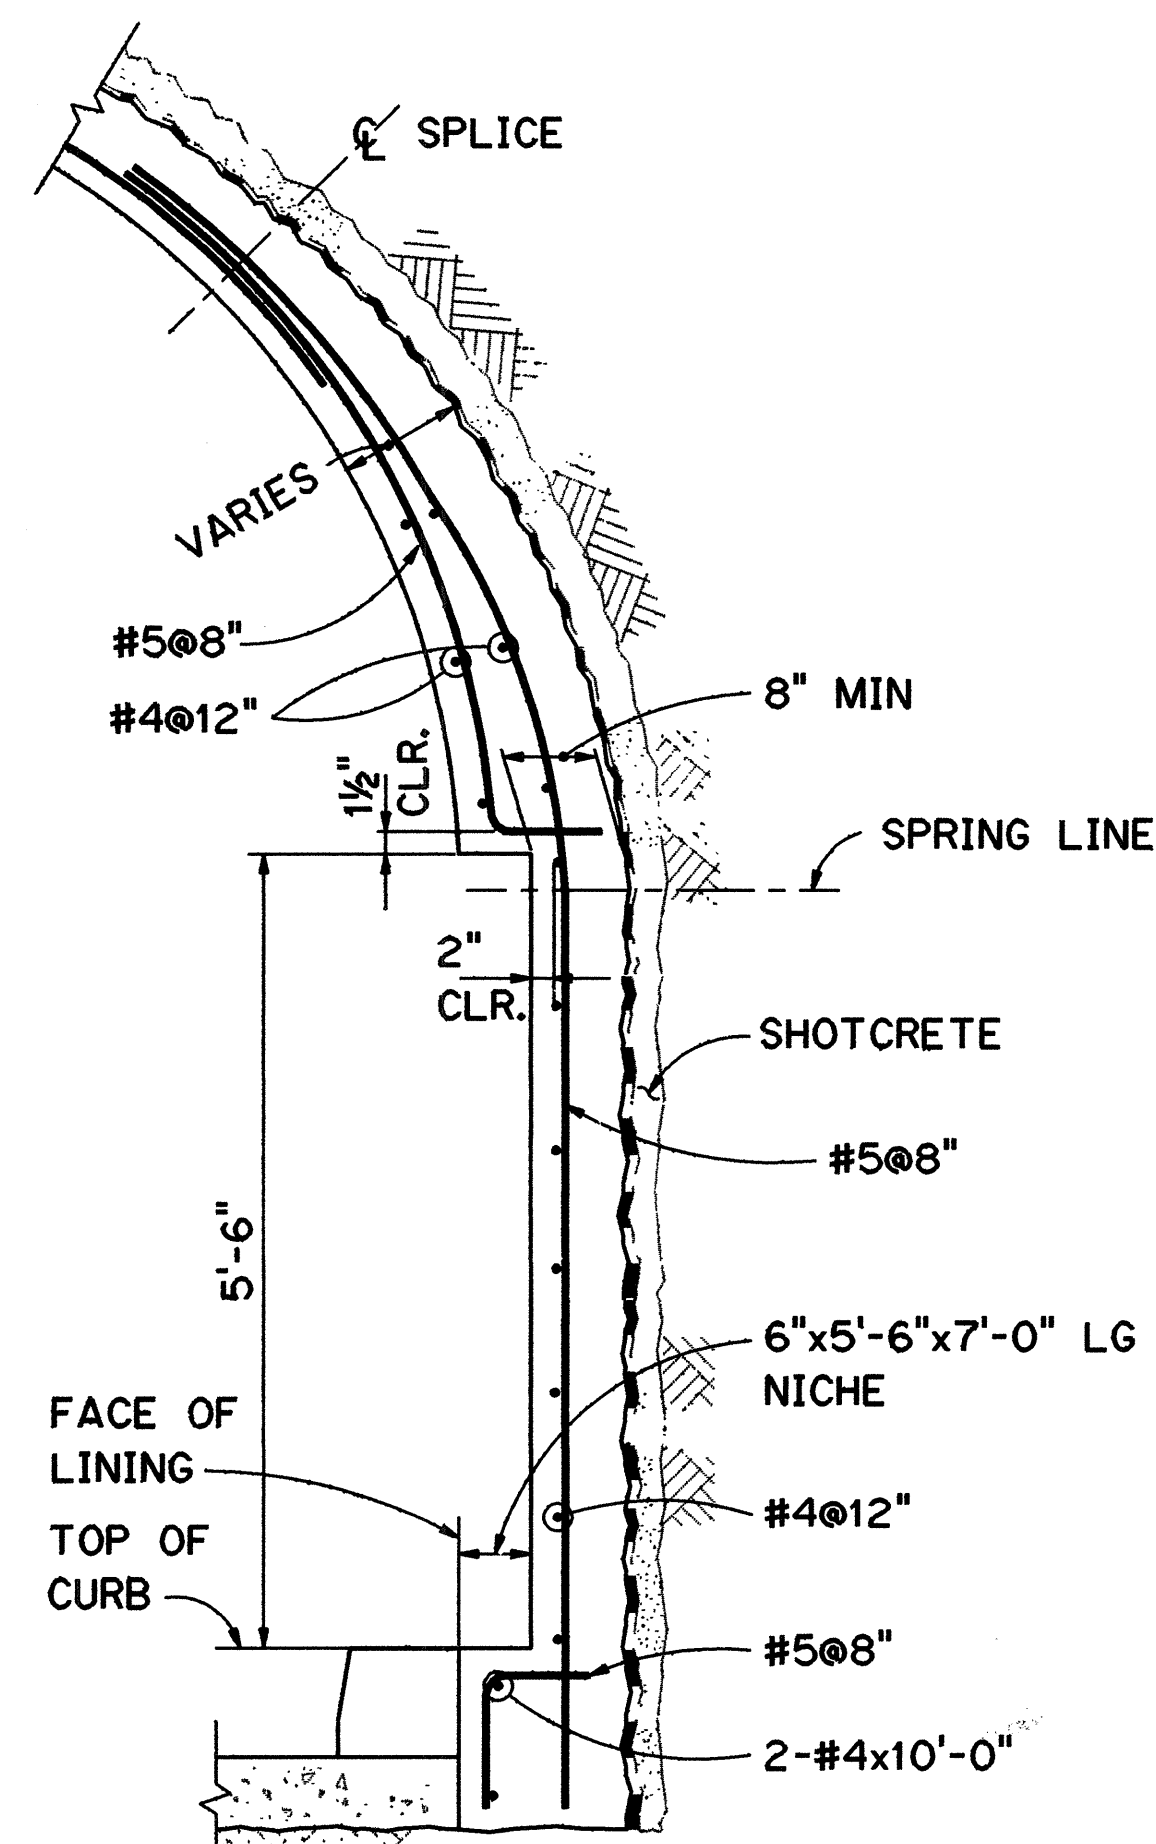

ELECTRICAL NICHE

SECTION  B

SCALE: $\frac{3}{4}" = 1' - 0"$

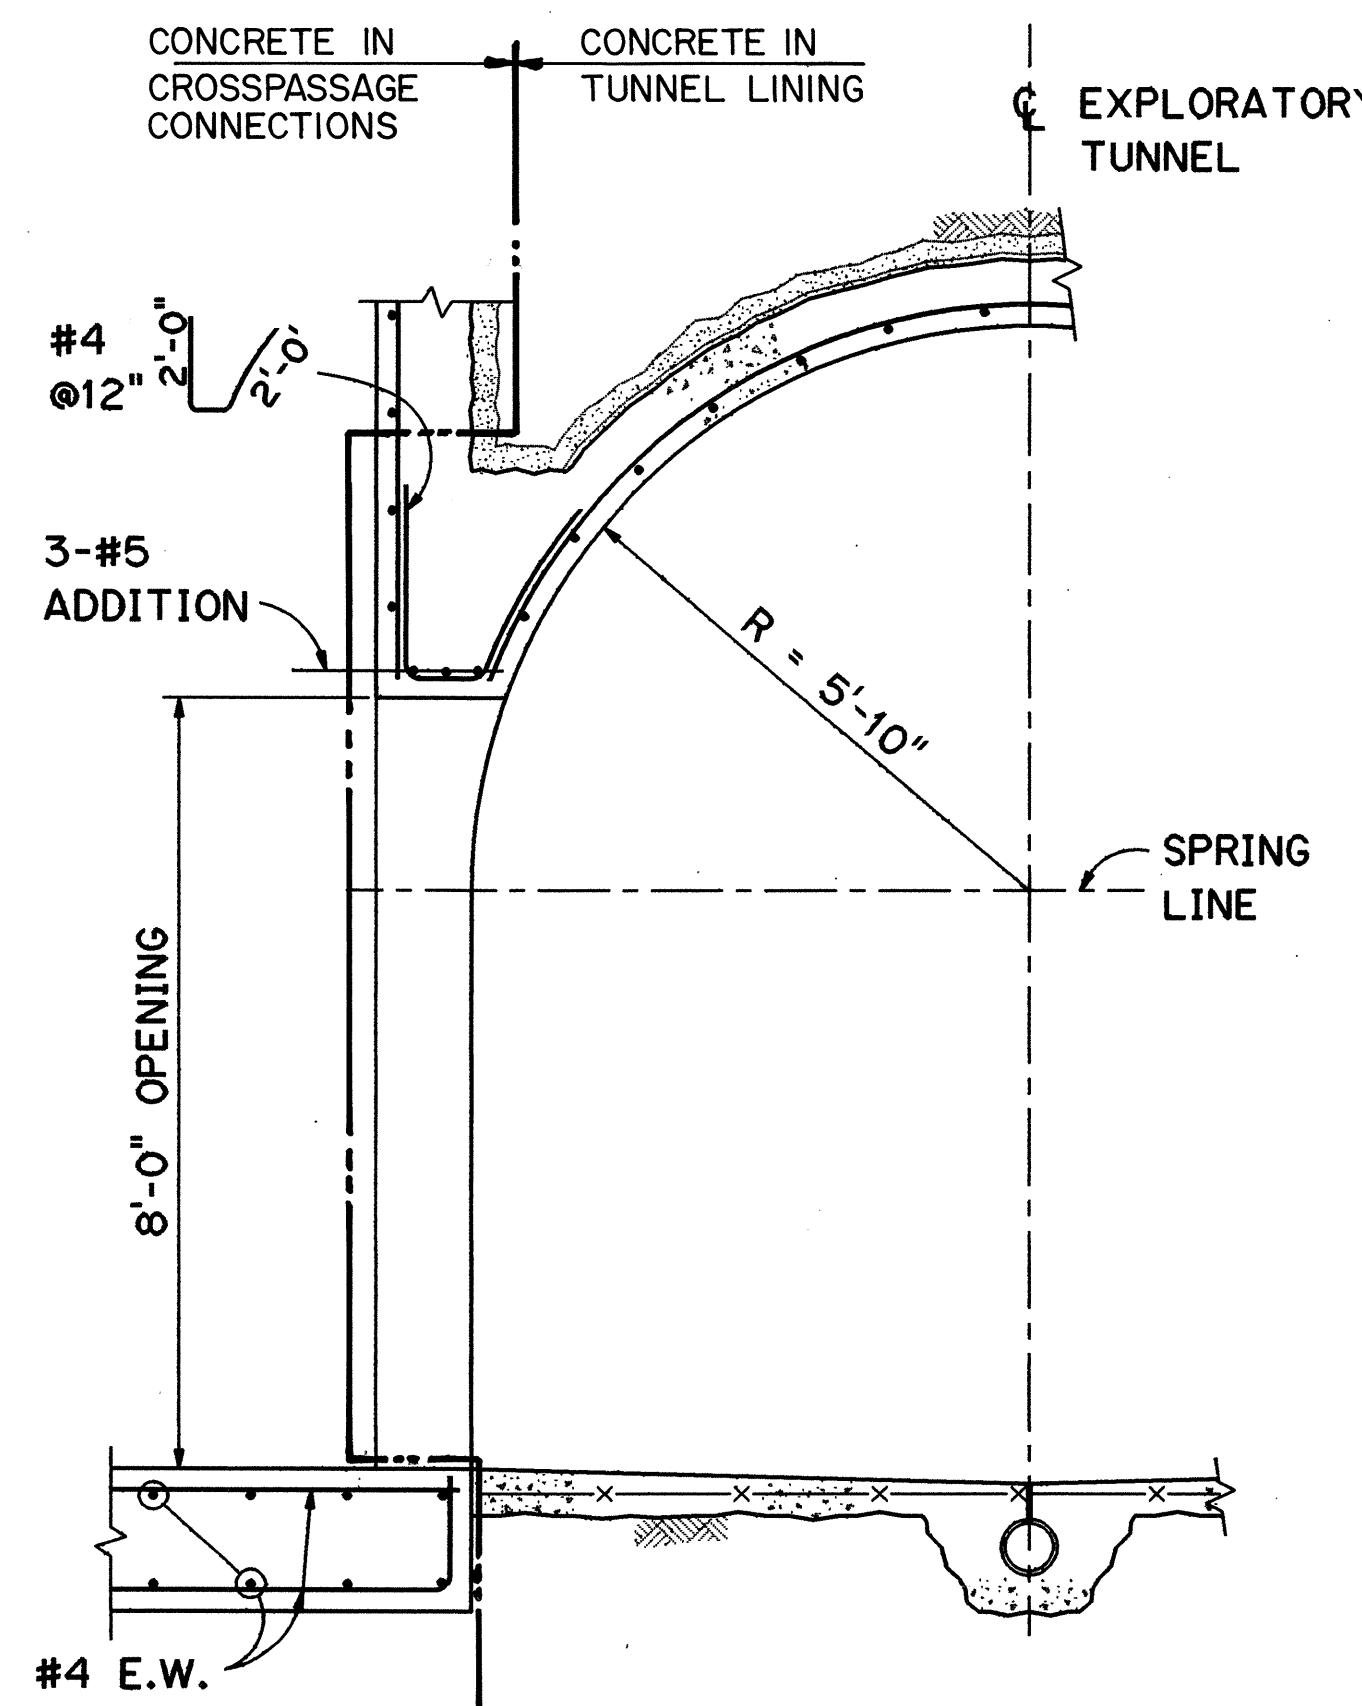


SECTION

SCALE: 1/2"=1'-0"


2S6 | 2S13

TO

2S10

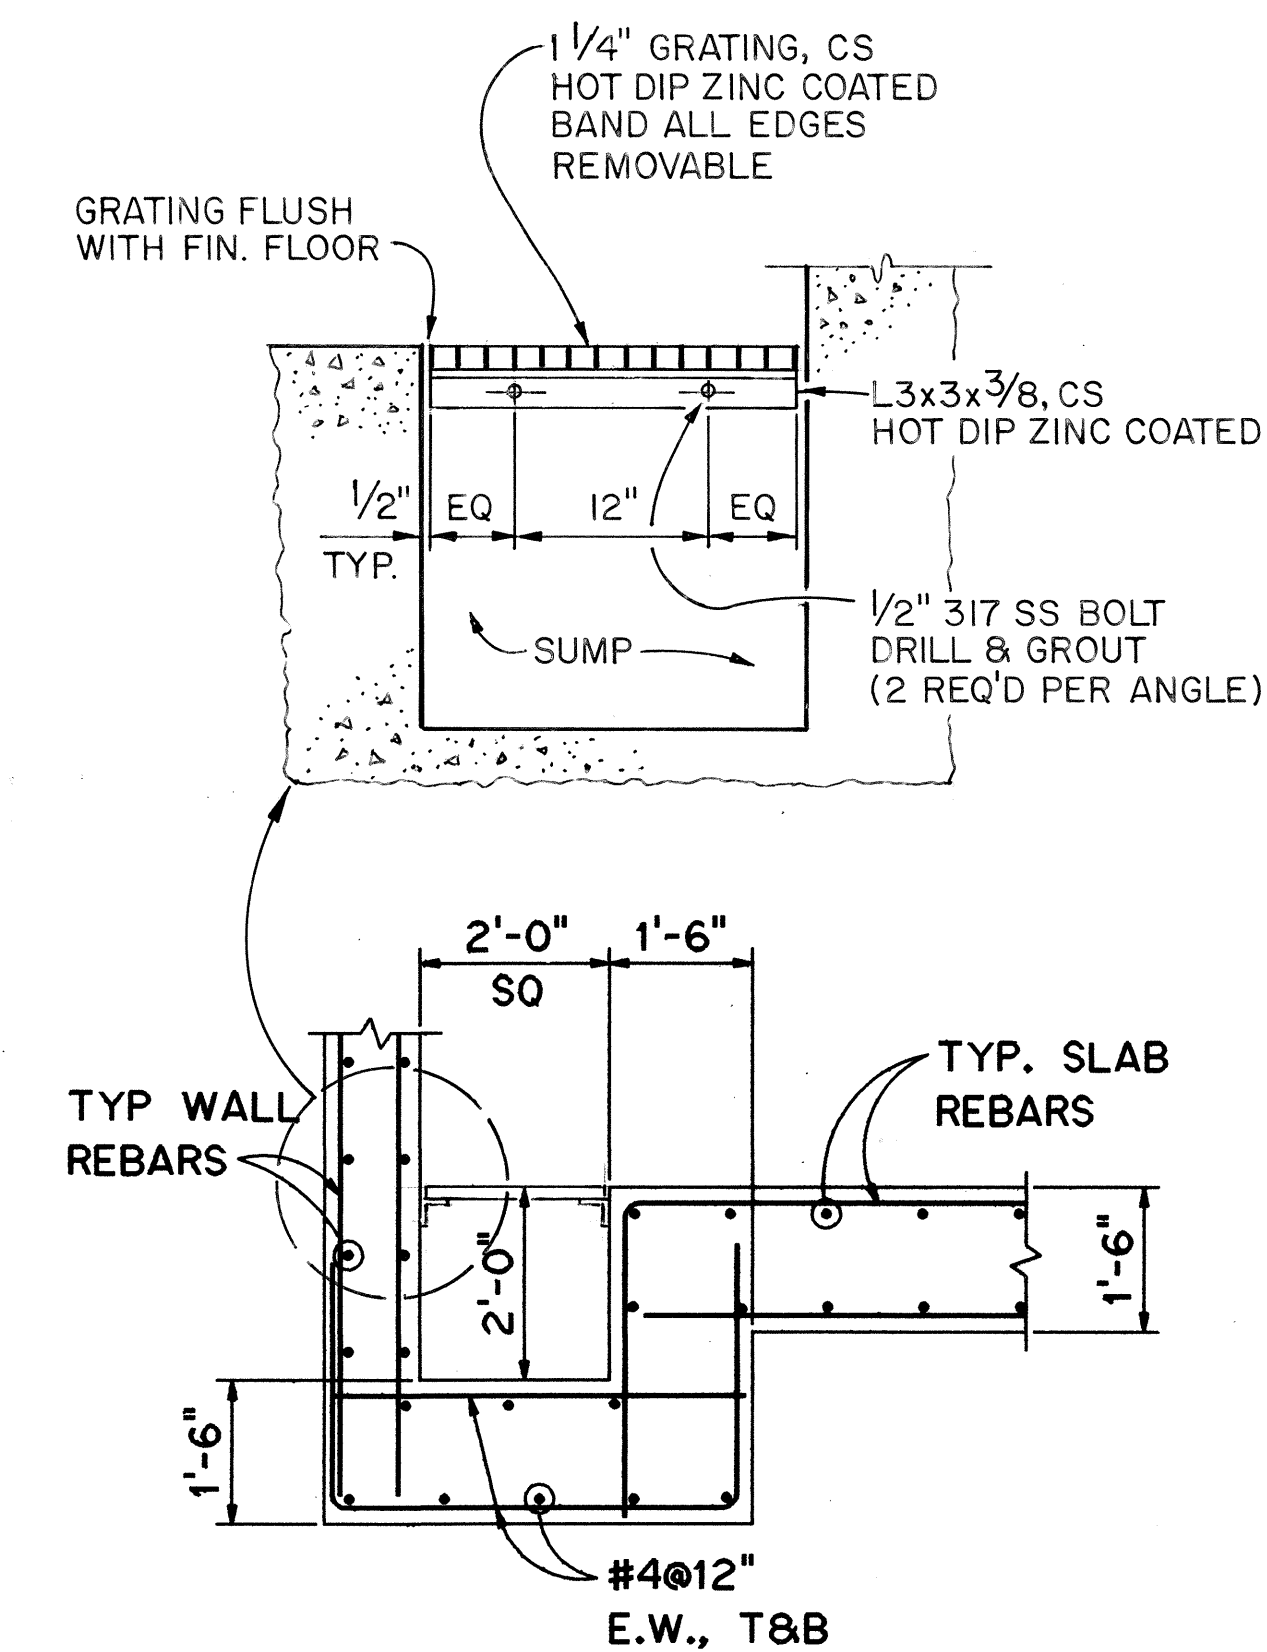

TYPICAL SECTION @ SUMP
SCALE: 1/2"=1'-0"

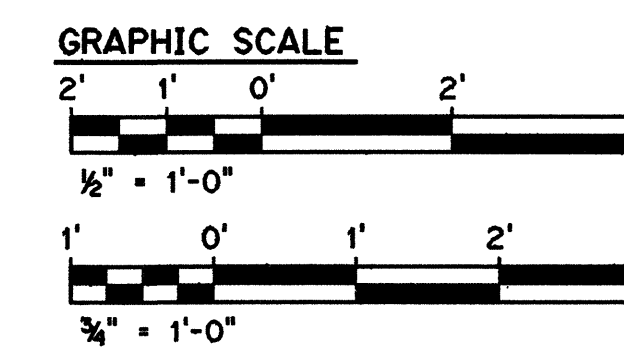

THIS WORK WAS PREPARED BY ME
OR UNDER MY SUPERVISION

NOTES:

1. FOR GENERAL STRUCTURAL NOTES, SEE SHEET NO. 2S4.

DATE	REVISION


STATE OF HAWAII
DEPARTMENT OF TRANSPORTATION
HIGHWAYS DIVISION

MISCELLANEOUS
DETAILS & SECTIONS
EXPLORATORY TUNNEL IMPROVEMENTS
H-3 FINISH (UNIT III)
FAIP NO. I-H3-1(75), UNIT III
T.K. TUNNEL/ACCESS ROADS


SCALE: AS NOTED DATE: JUN 1995

SHEET NO. 2S13 OF 17 SHEETS


FED. ROAD DIST. NO.	STATE	FED. AID PROJ. NO.	FISCAL YEAR	SHEET NO.	TOTAL SHEETS
HAWAII	HAW.	I-H3-1(75) UNIT III	1994	61	353

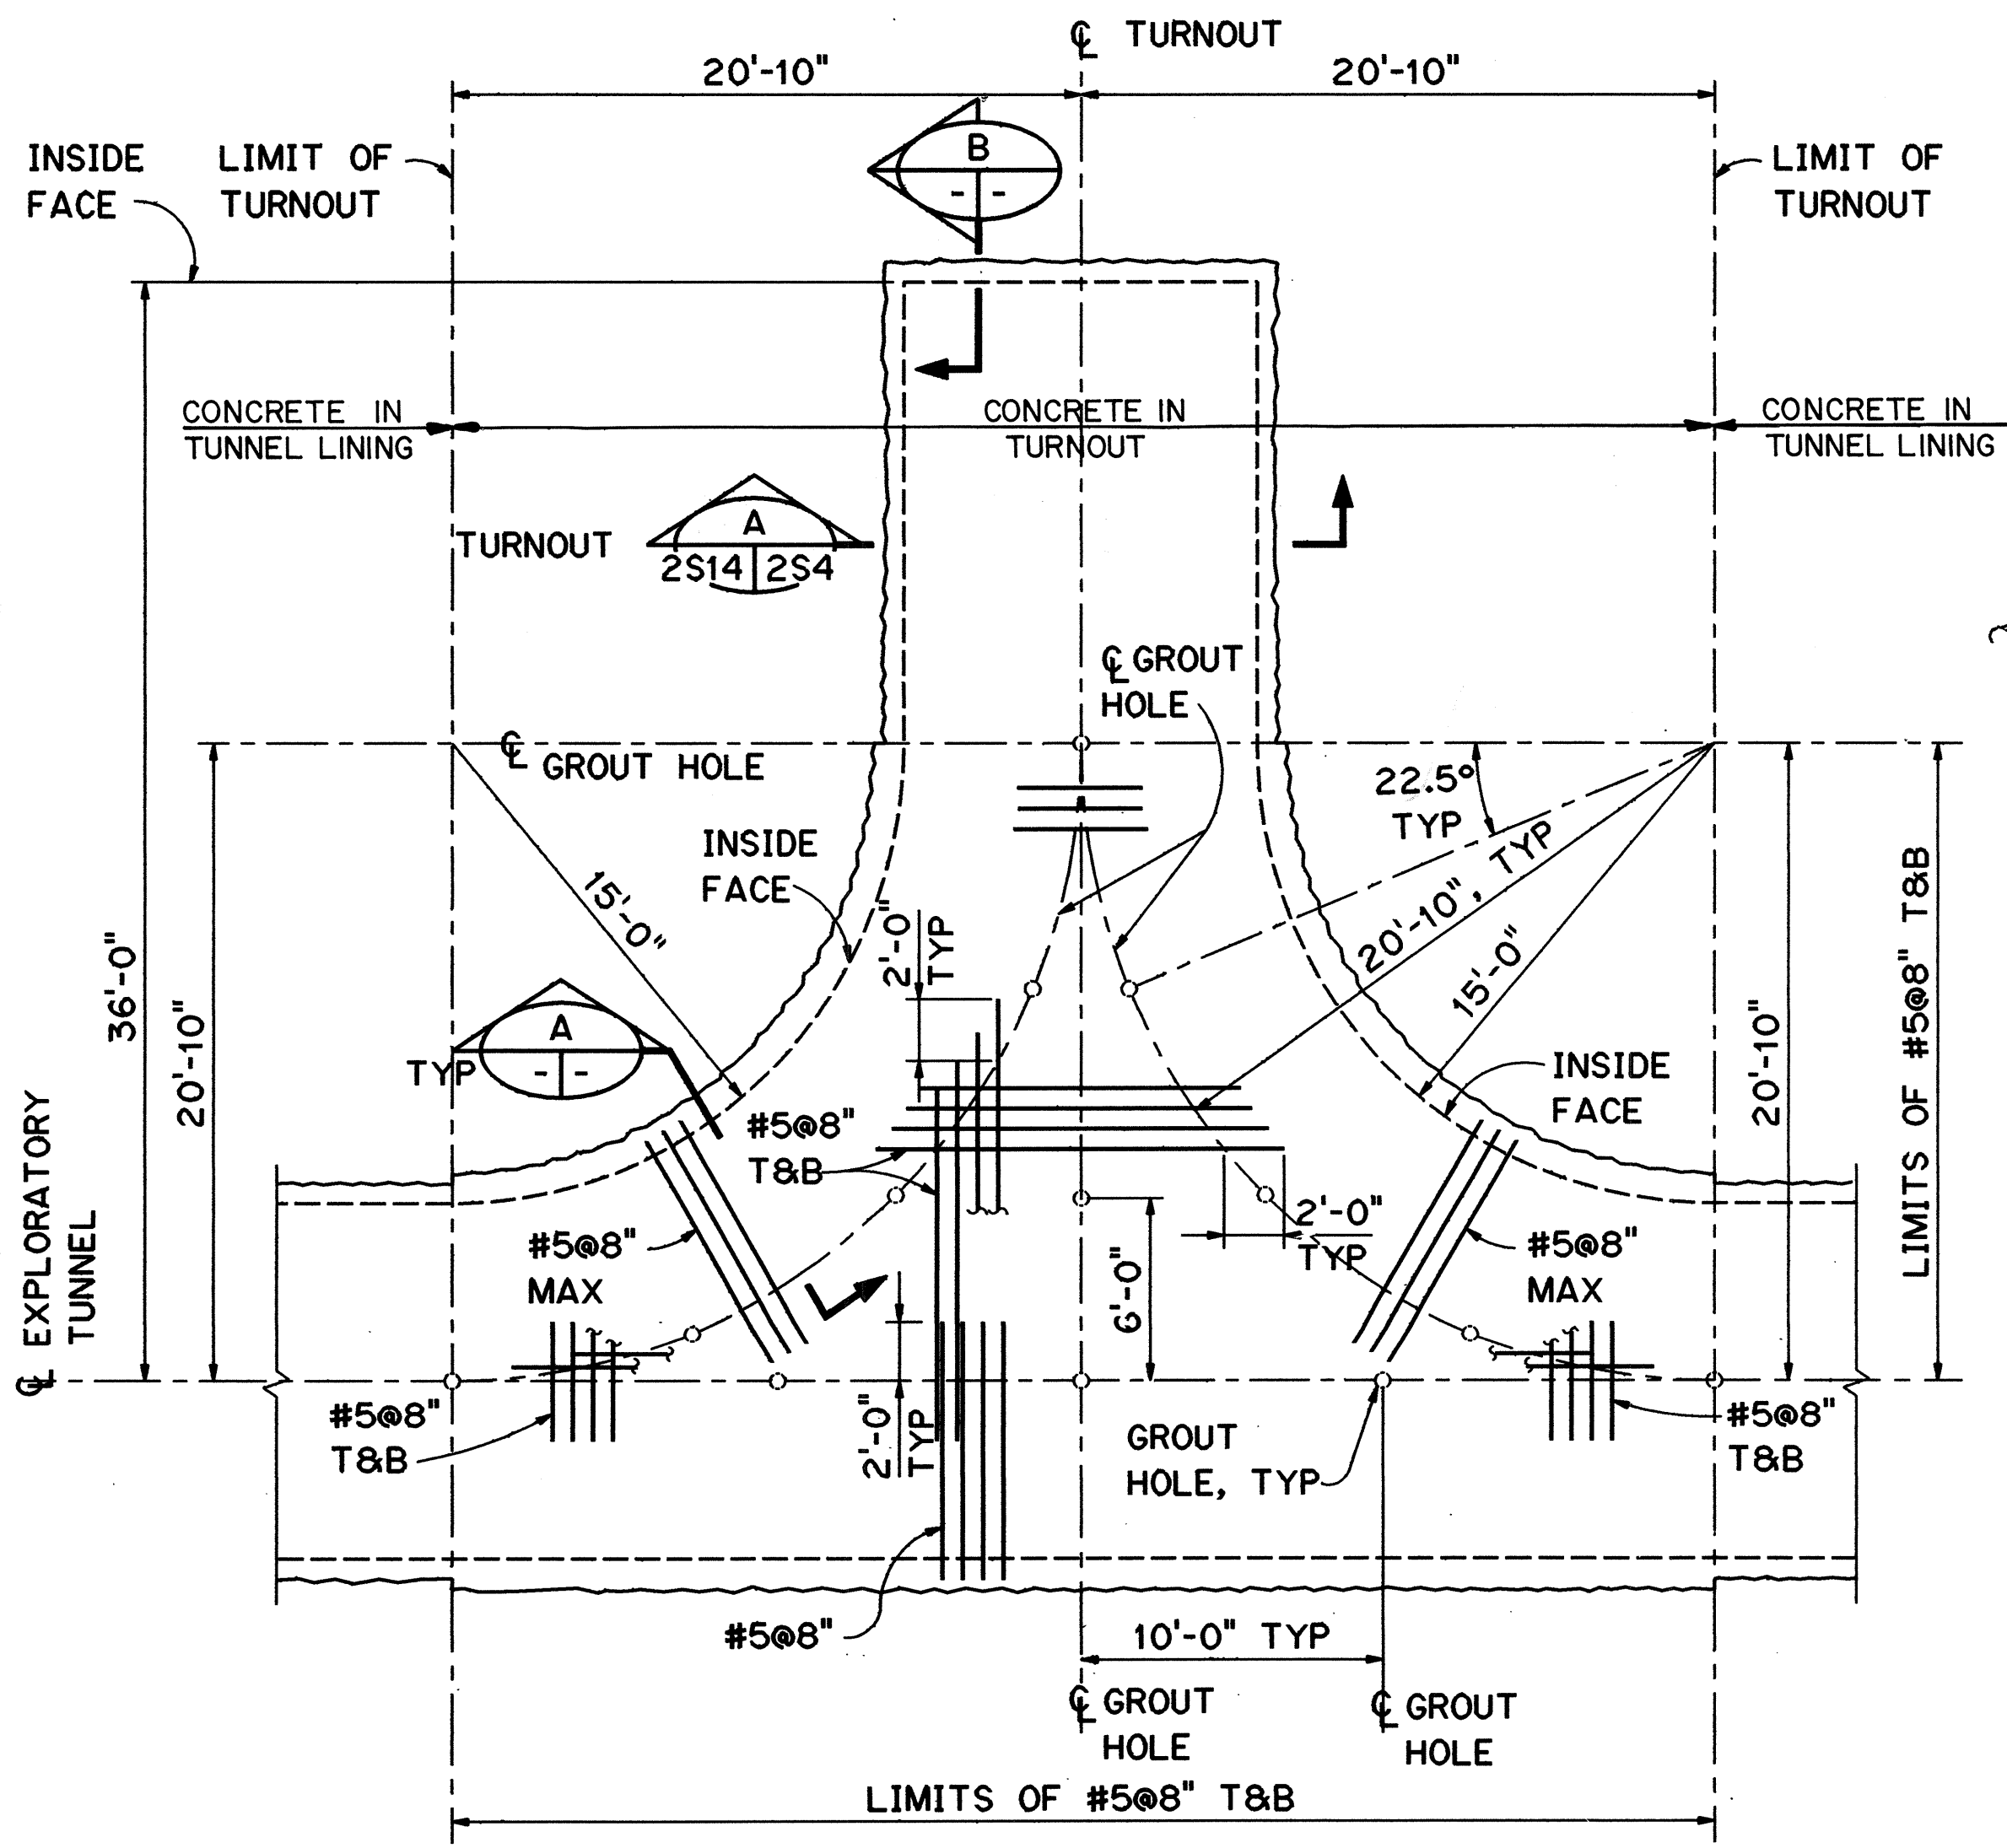


TURNOUT PLAN
SCALE: 3/8"=1'-0"

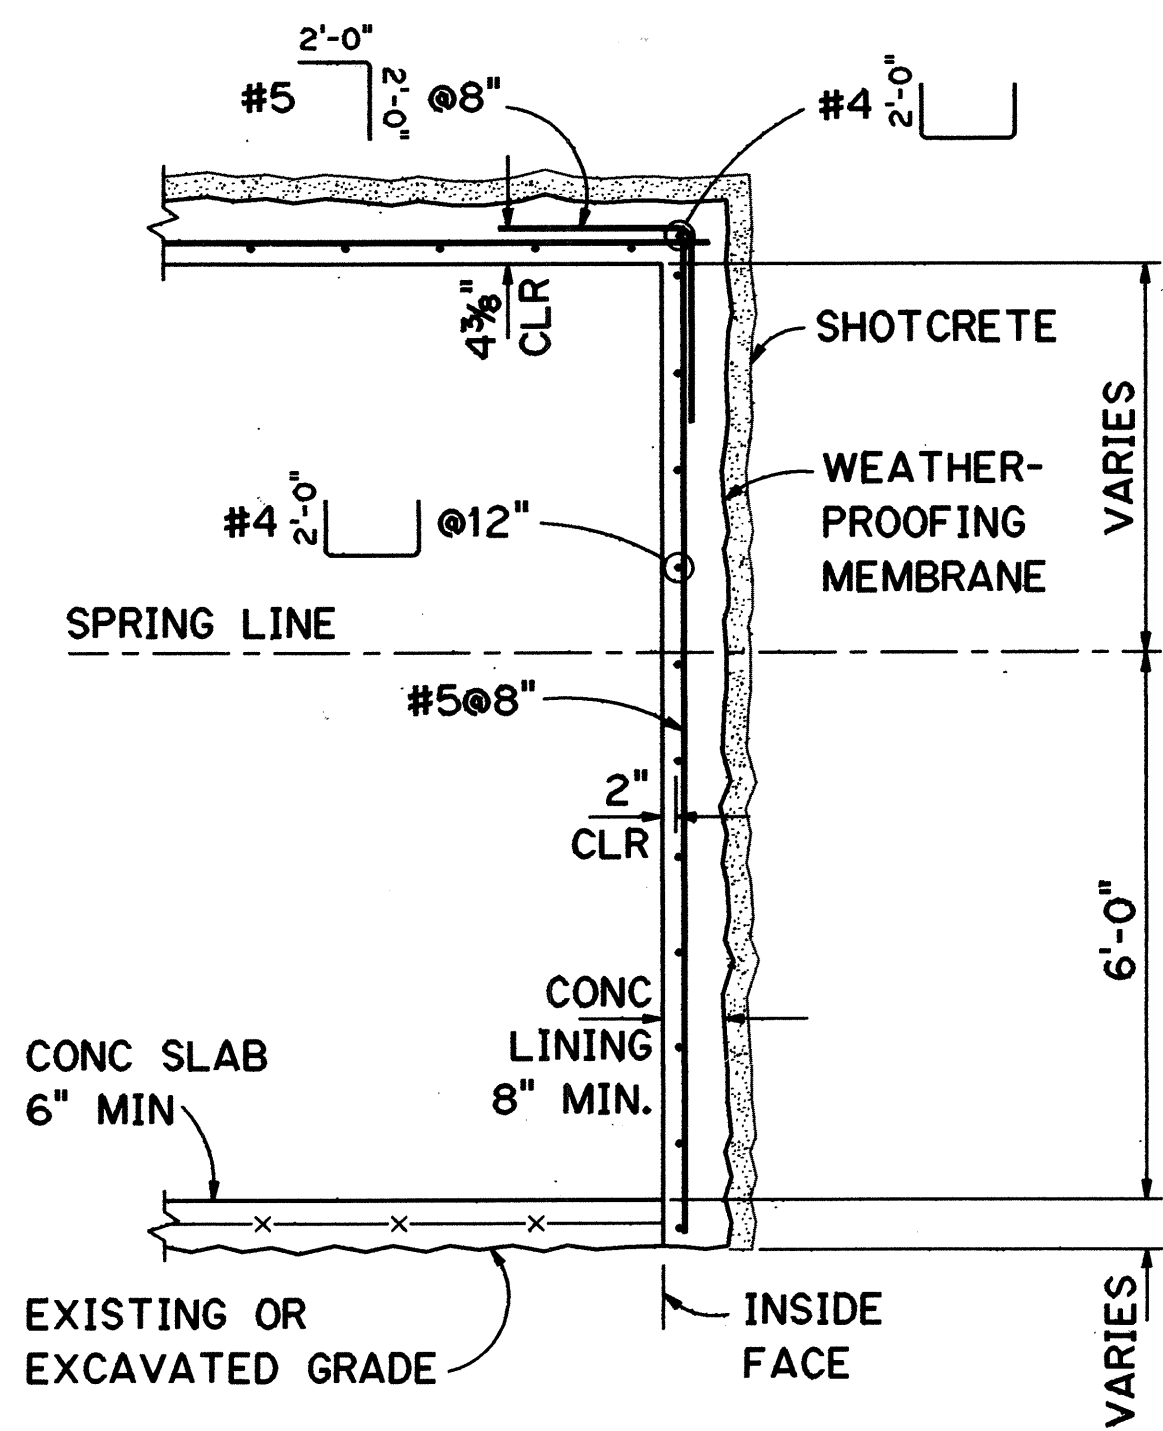

SECTION B
SCALE: 1/2"=1'-0"

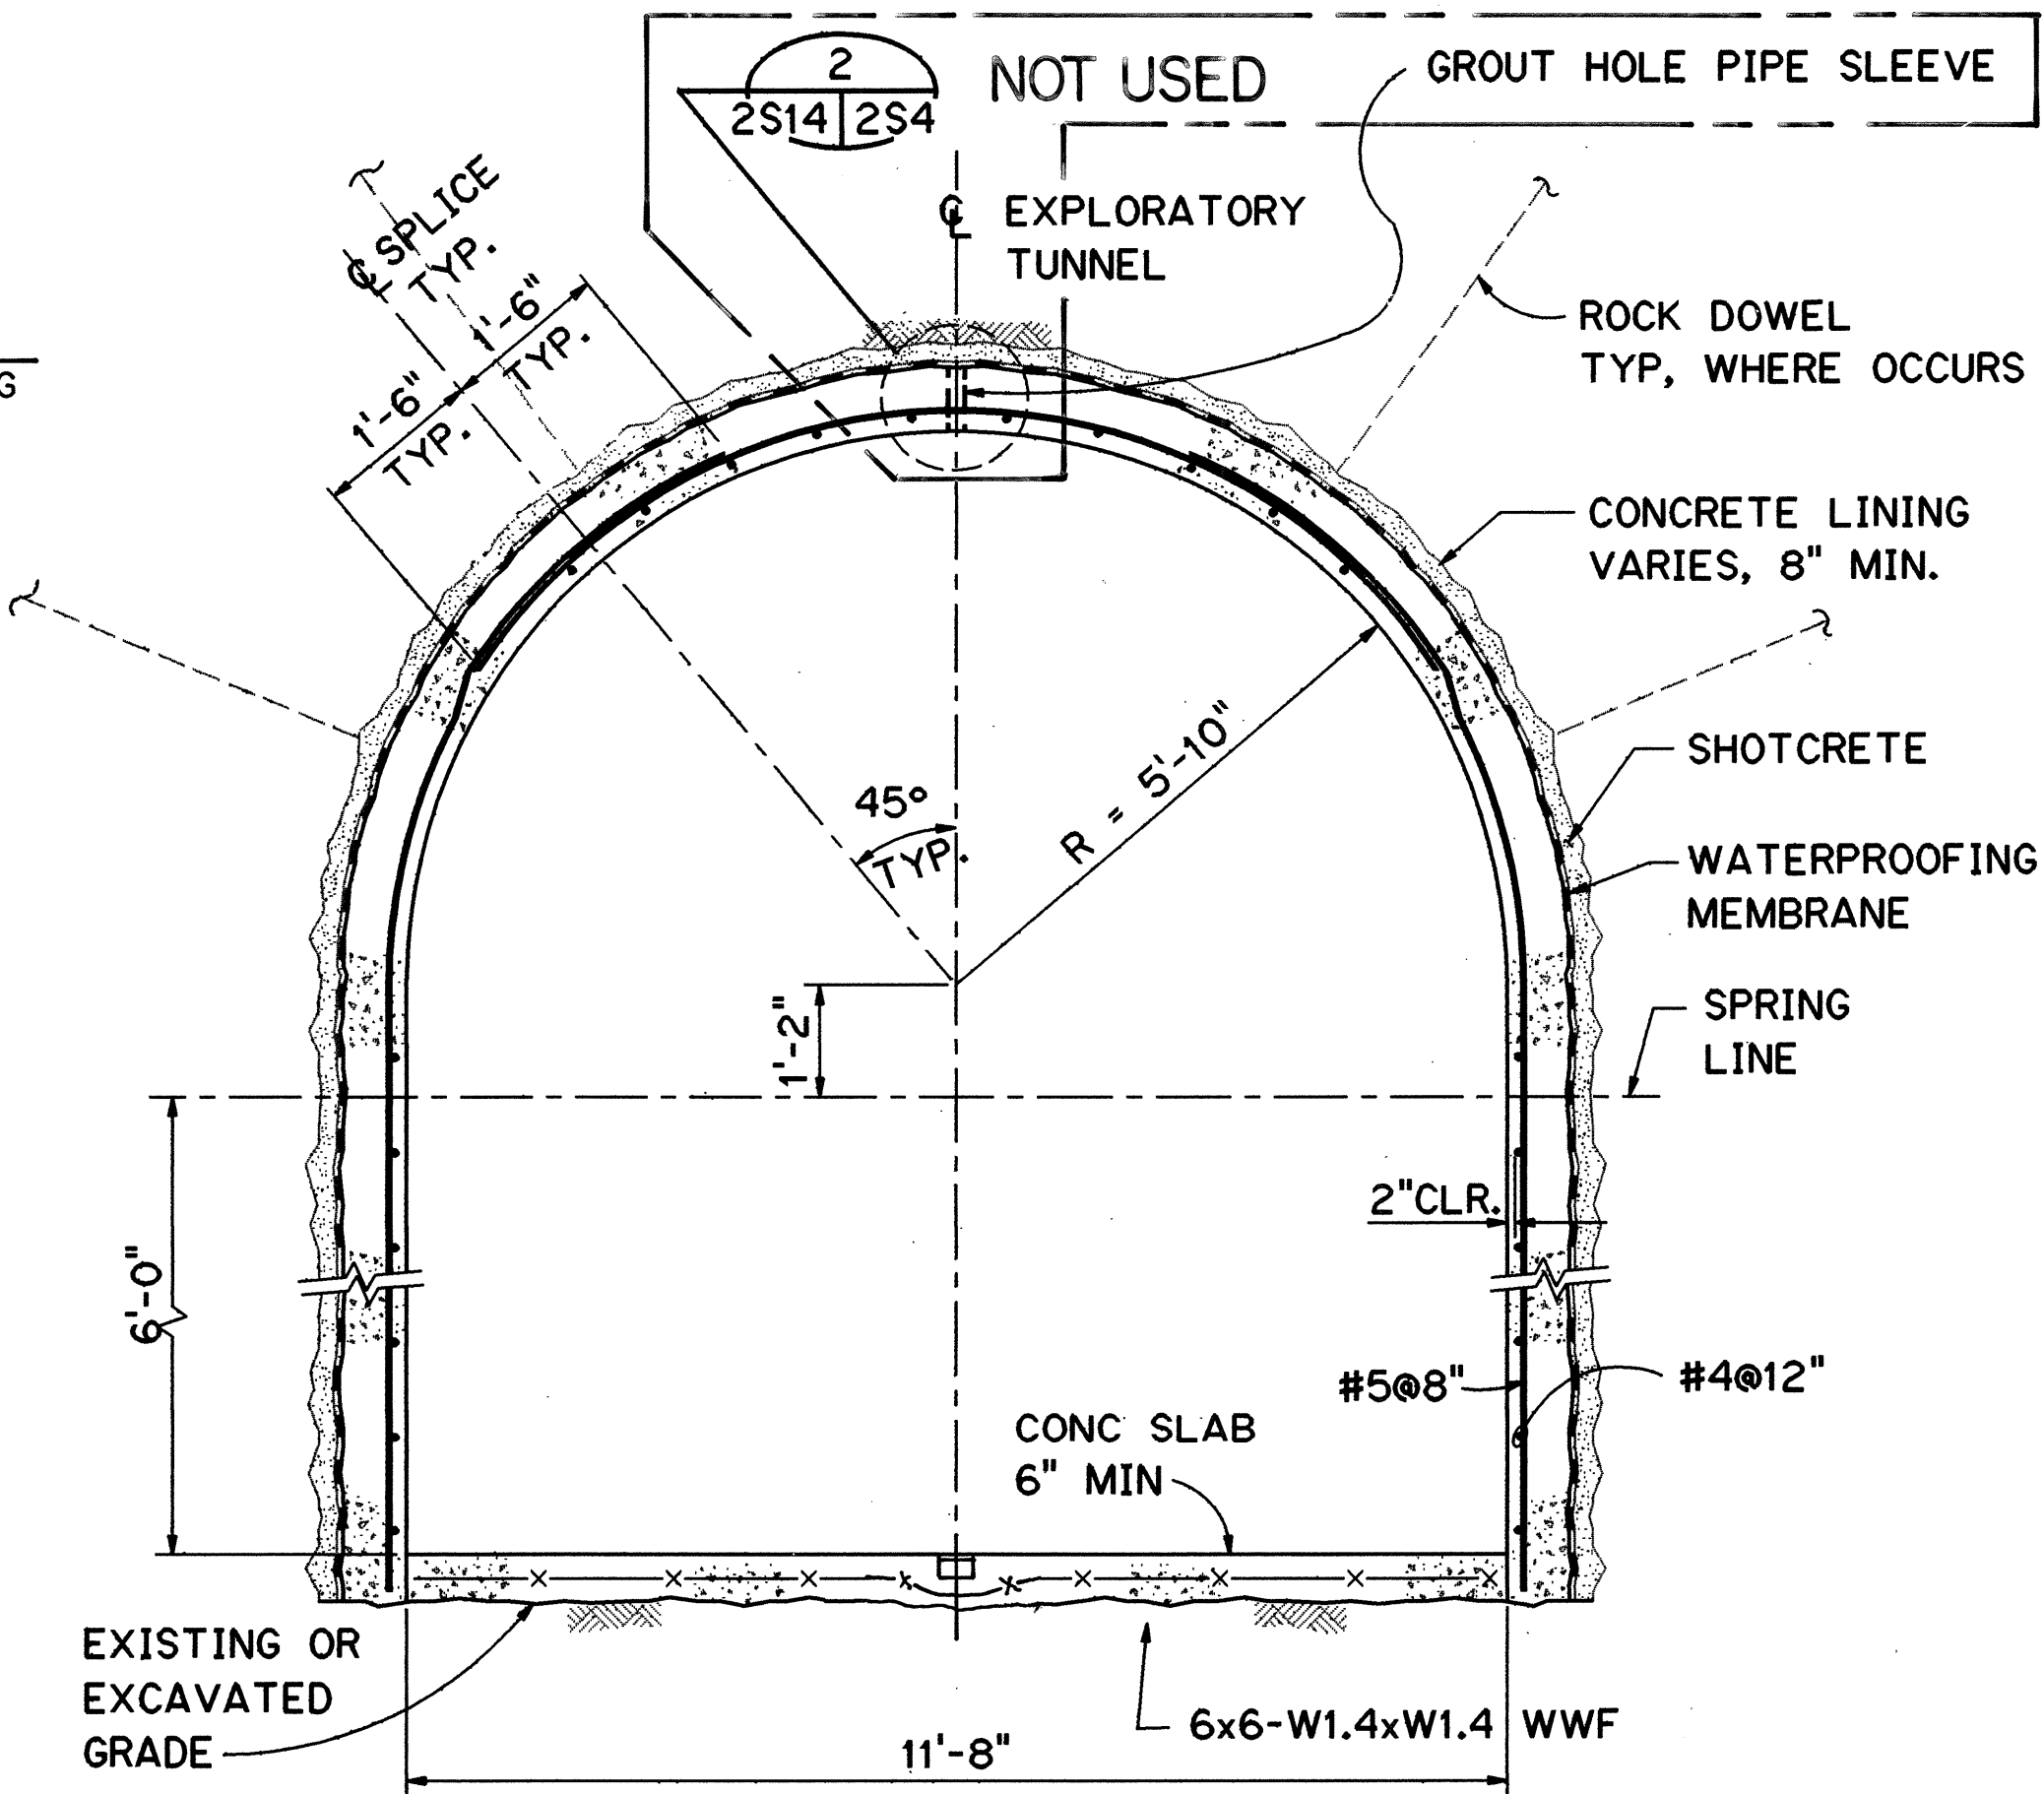


SECTION D
SCALE: 1/2"=1'-0"

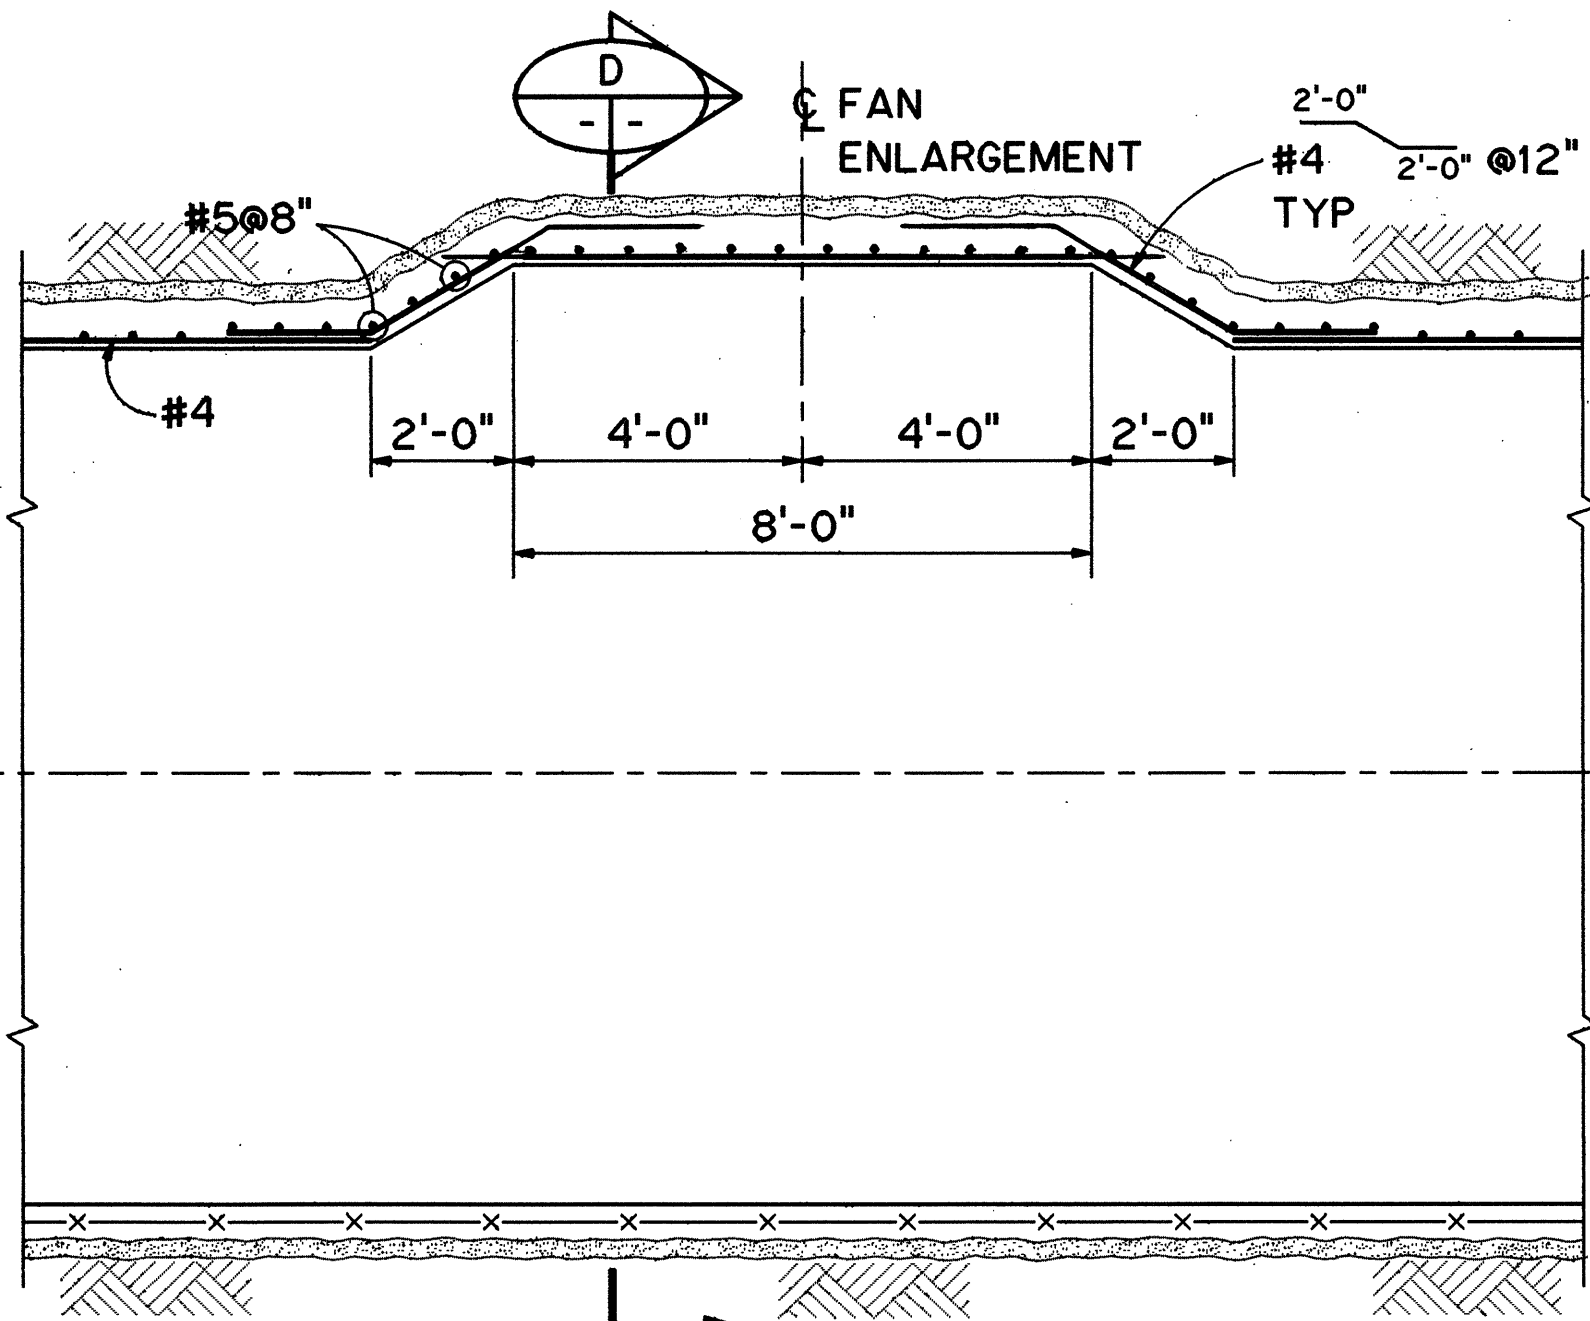

FAN ENLARGEMENT



SECTION C
SCALE: 3/8"=1'-0"

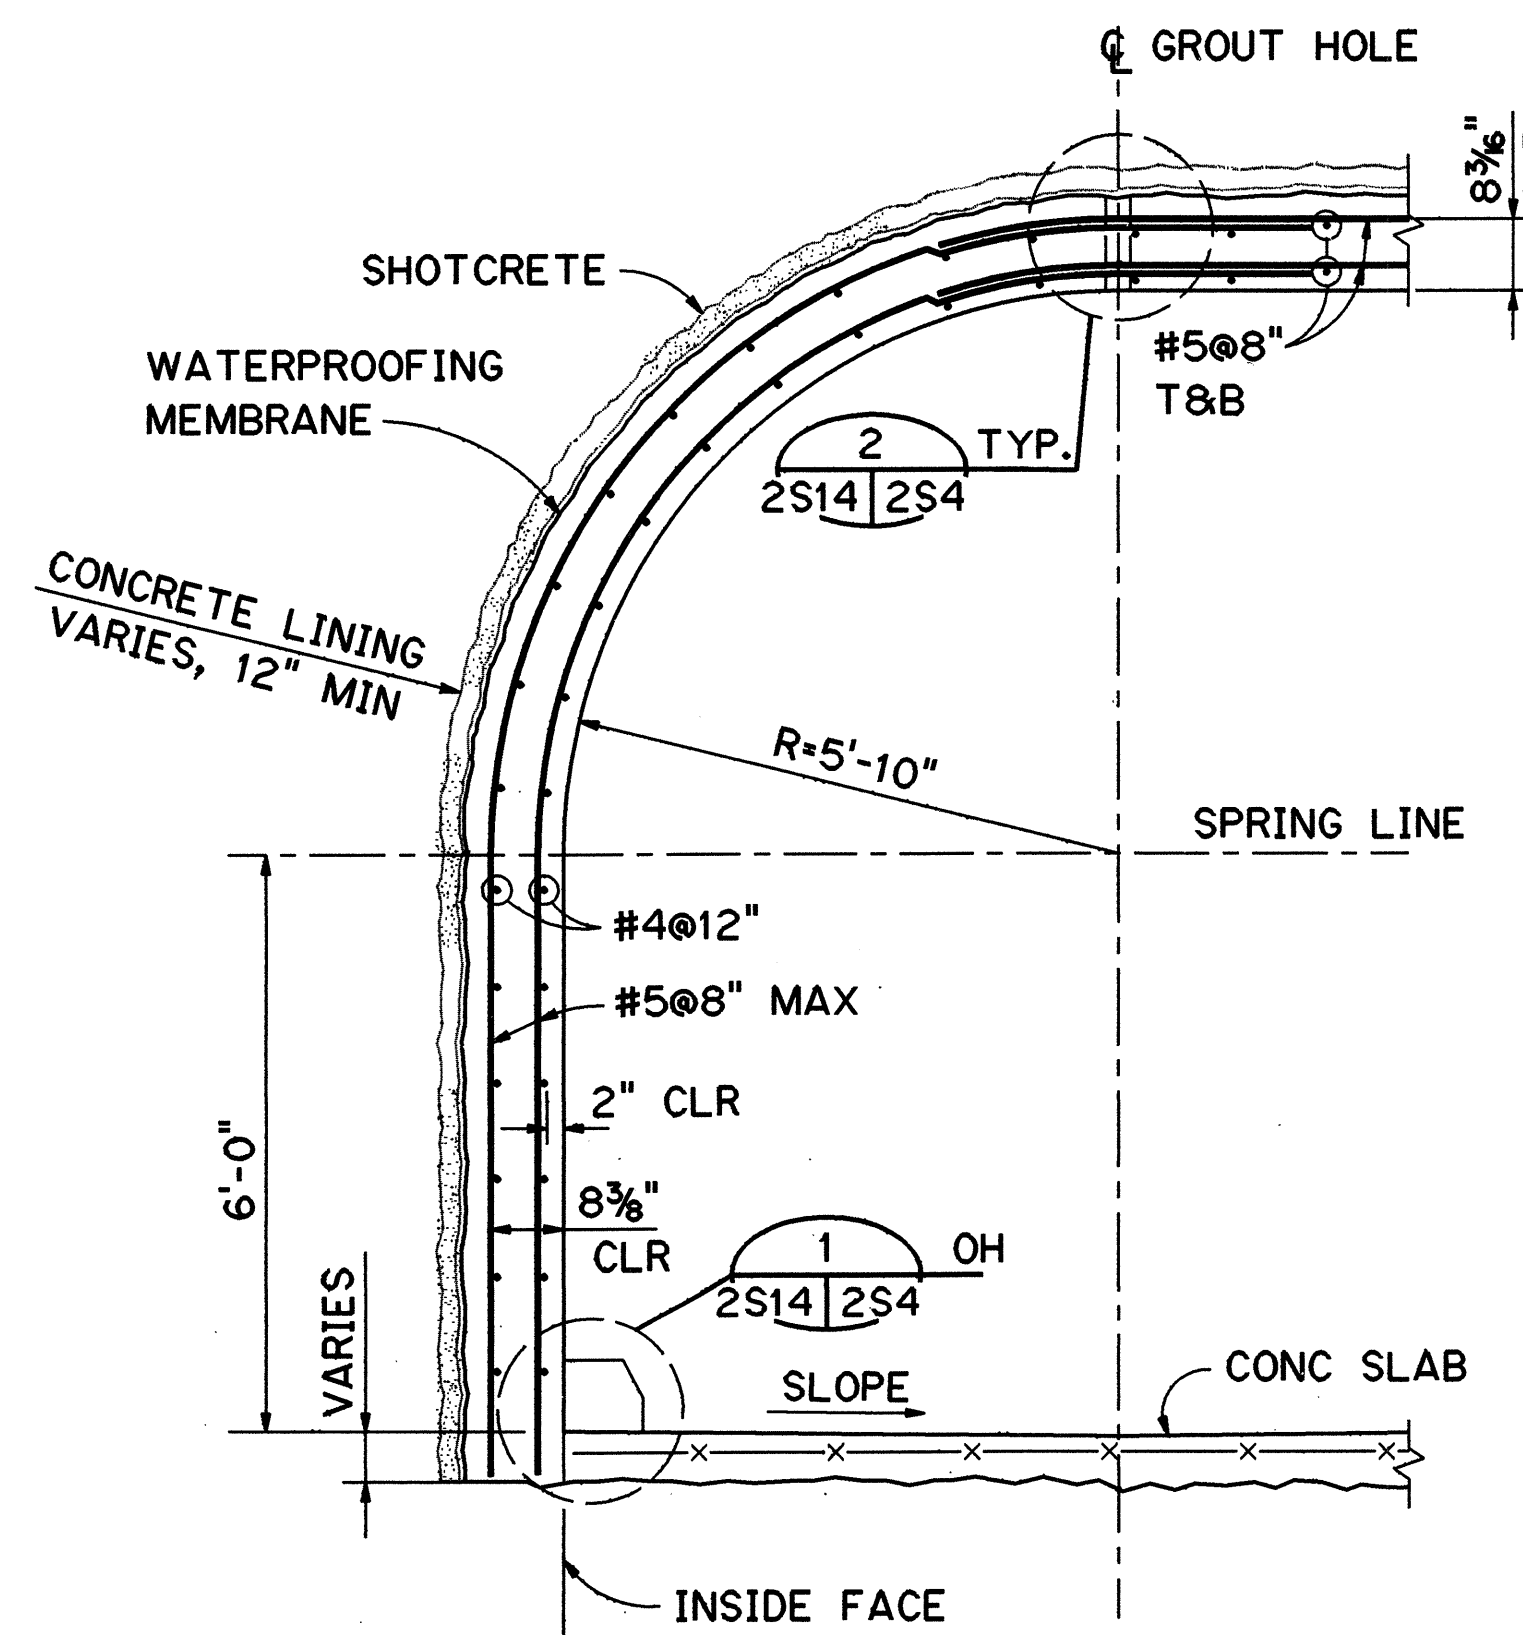

SECTION A
SCALE: 1/2"=1'-0"

- NOTES:
- FOR ADDITIONAL NOTES, SEE SHEET NO. 2S4.
 - DURING GROUTING OPERATION, PROVIDE TEMPORARY FALSEWORK SUPPORT OF THE LINING AT THE GROUT HOLE. THE SUPPORT SHALL BE DESIGNED BY THE CONTRACTOR FOR A SERVICE LOAD OF 40 KIPS.
 - THE ALLOWABLE BEARING PRESSURE AT THE TURNOUTS IS 20,000 PSF.
 - SEE MECHANICAL PLANS FOR EMBEDDED ITEMS AT FAN ENLARGEMENT.

DATE	NOV 94
DESIGNED BY	L. JOHNSON
CHECKED BY	G. BENKOVICH
NOTED BY	
ORIGINAL	

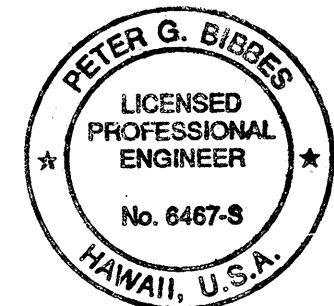
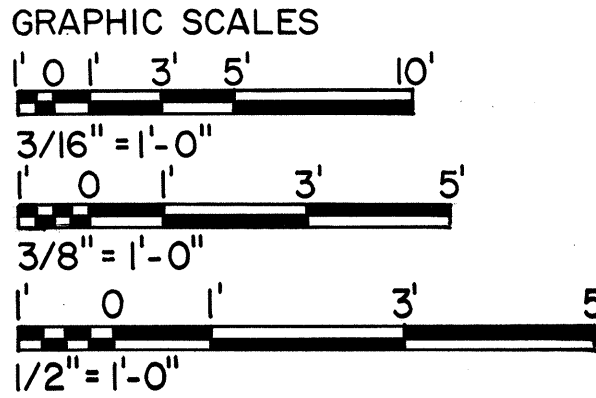


THIS WORK WAS PREPARED BY ME OR UNDER MY SUPERVISION

Peter G. Biggs

8/21/96	DCN75-007: REV. ET DRAIN
DATE	REVISION
STATE OF HAWAII DEPARTMENT OF TRANSPORTATION HIGHWAYS DIVISION	
TURNOUT PLAN, SECTIONS AND DETAILS	
EXPLORATORY TUNNEL IMPROVEMENTS	
H-3 FINISH (UNIT III)	
FAIP NO. I-H3-1(75), UNIT III	
T.K. TUNNEL/ACCESS ROADS	
SCALE: AS NOTED	DATE: JUN 1995
SHEET NO. 2S14	OF 17 SHEETS

ORIGINAL PLAN	SURVEY PLOTTED BY R. HERNANDEZ	DATE NOV 94
NOTE BOOK	TRACED BY DESIGNED BY L. JOHNSON	" " NOV 94
NO.	QUANTITIES BY CHECKED BY G. BENKOVICH	" " DEC 94

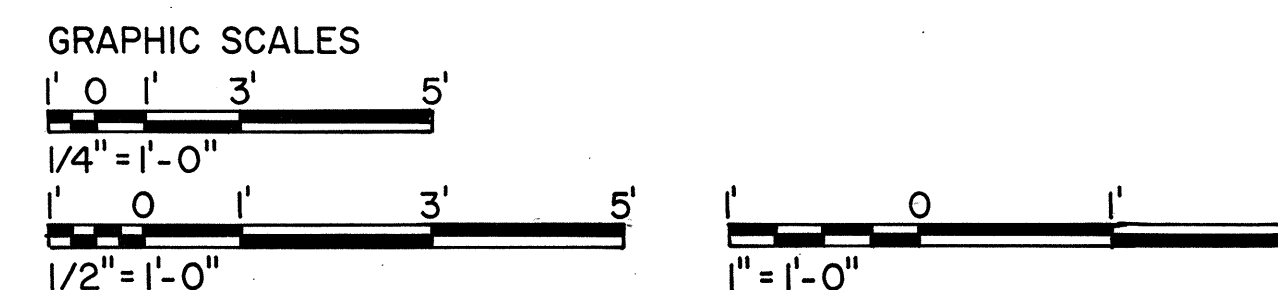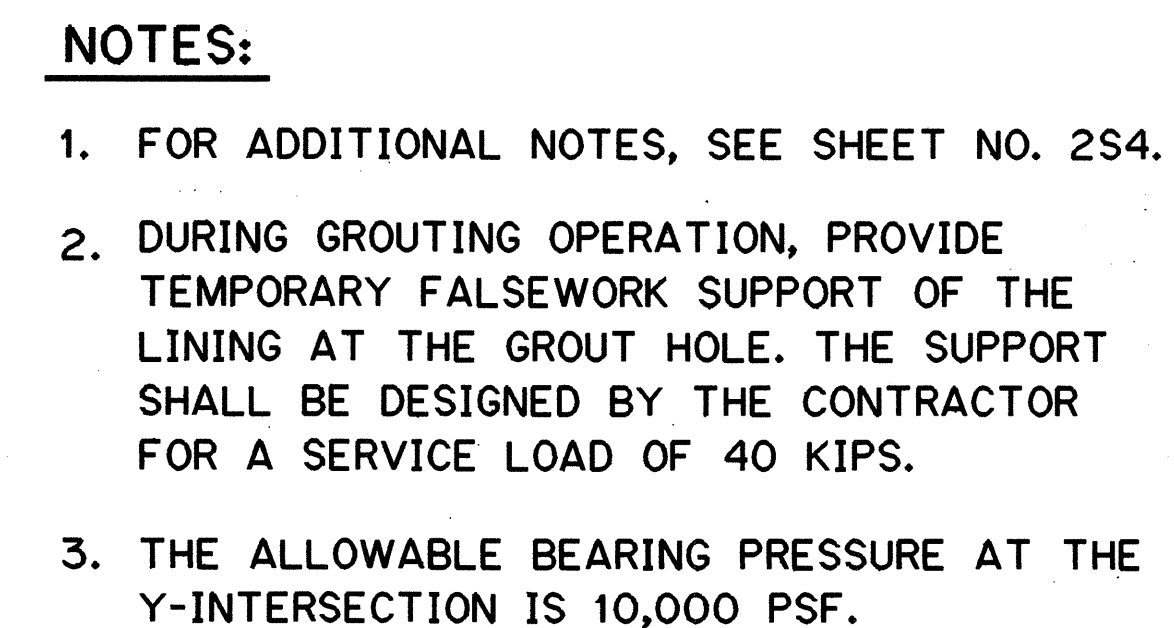


THIS WORK WAS PREPARED BY ME
OR UNDER MY SUPERVISION





Peter G. Bubb

HERNANDEZ ELWOOD::2410:[DWG,STRUCT]ST046.FGB;1 30JAN95-13.55.30






FED. ROAD DIST. NO.	STATE	FED. AID PROJ. NO.	FISCAL YEAR	SHEET NO.	TOTAL SHEETS
HAWAII	HAW.	1-H3-1(75) UNIT III	1994	63	353

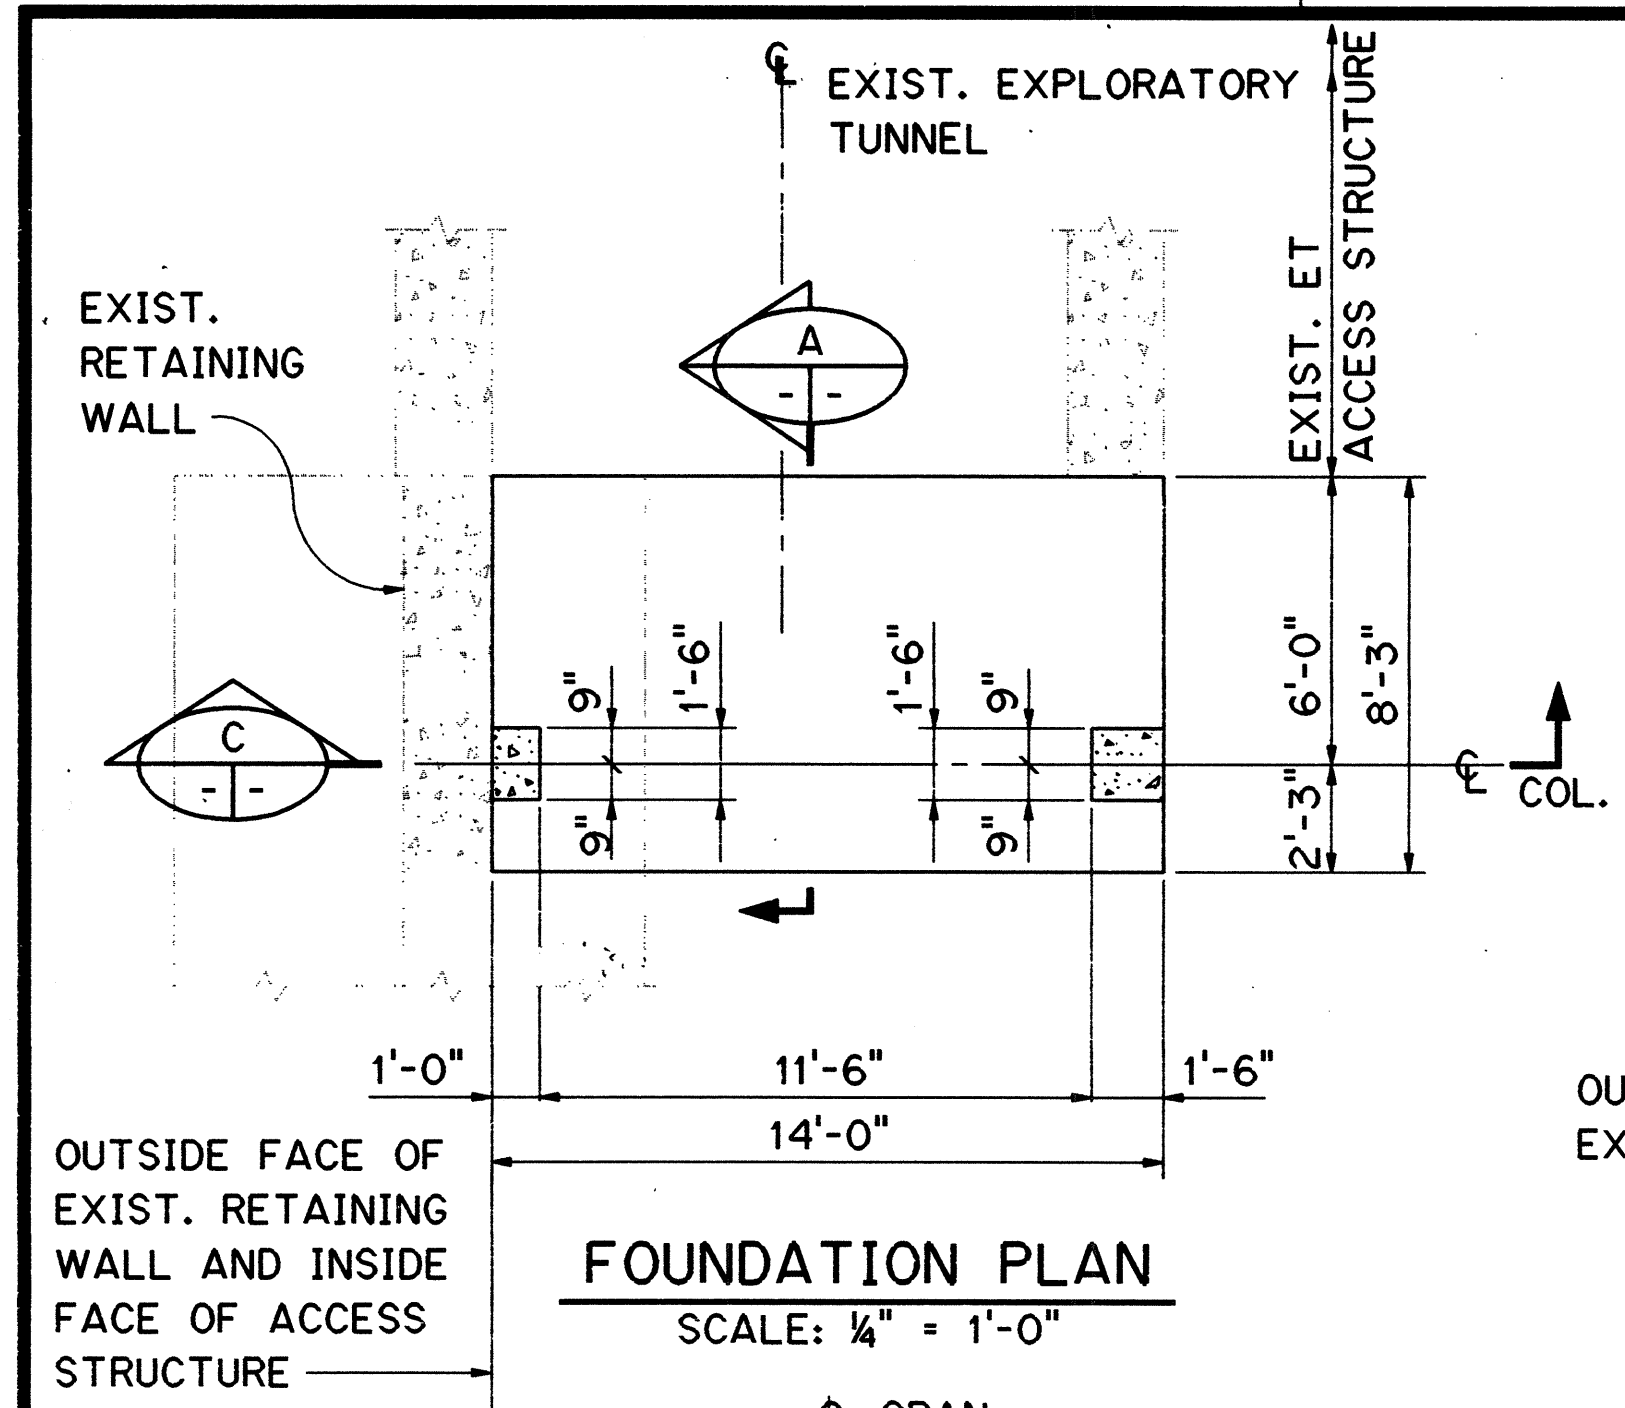

FOUNDATION PLAN
SCALE: 1/4" = 1'-0"

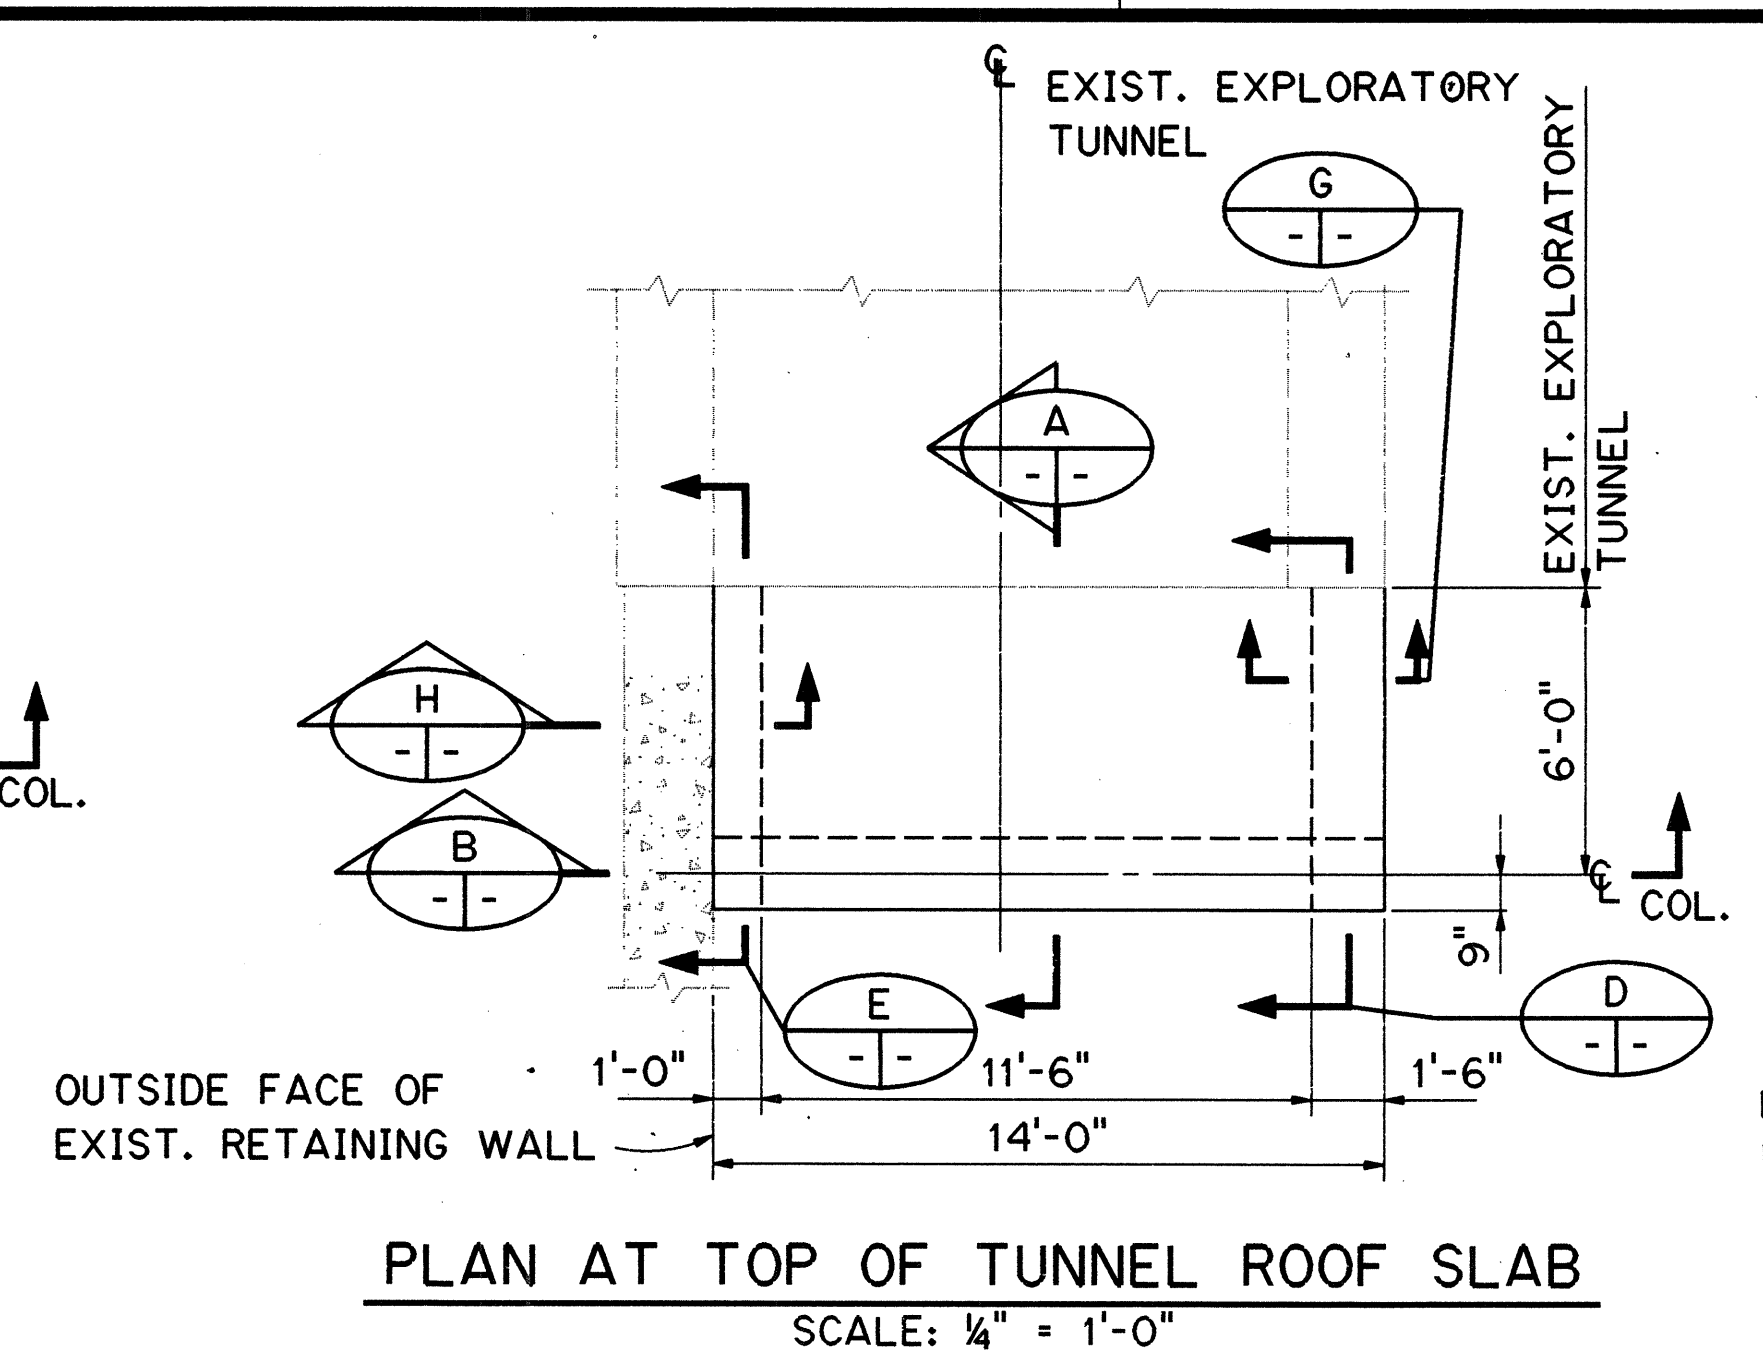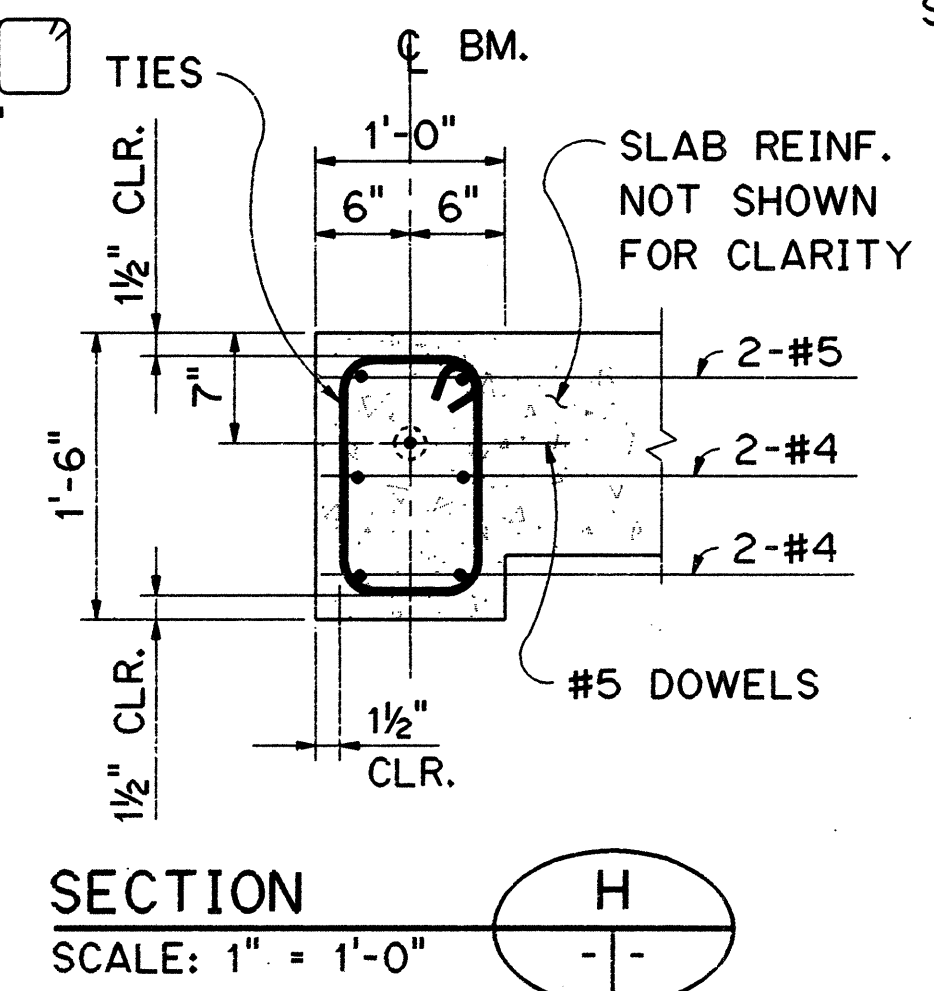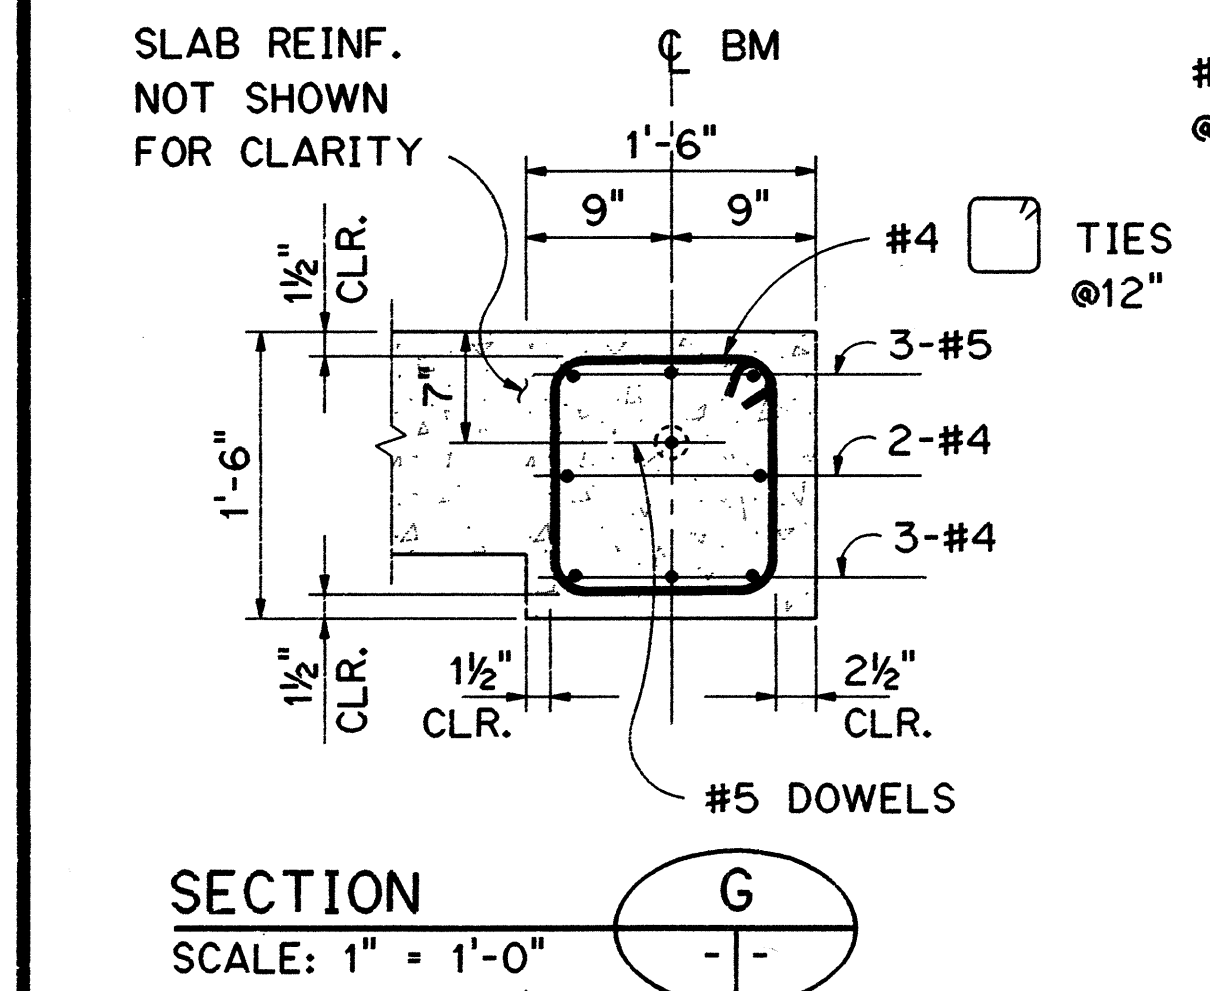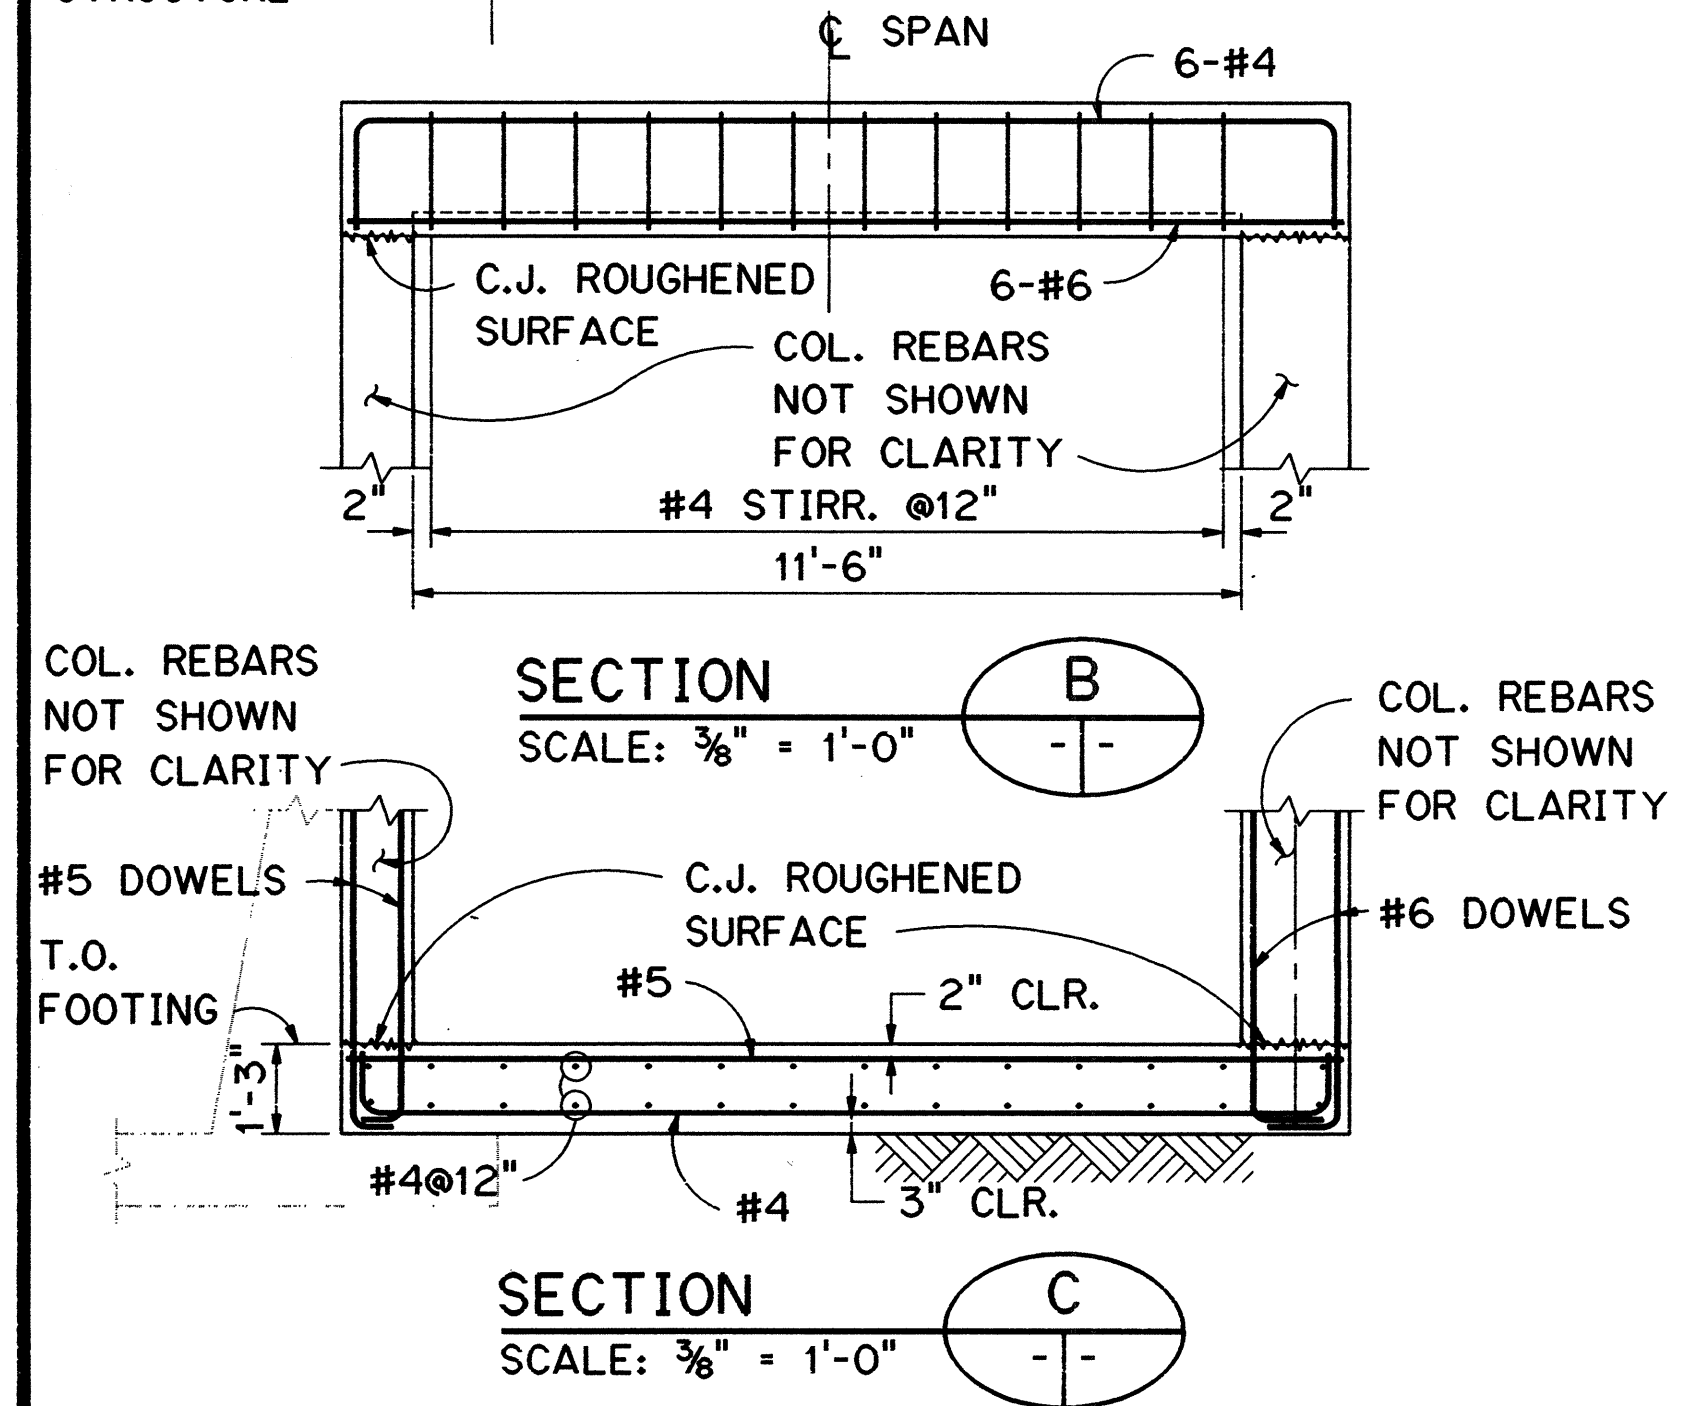


PLAN AT TOP OF TUNNEL ROOF SLAB
SCALE: 1/4" = 1'-0"

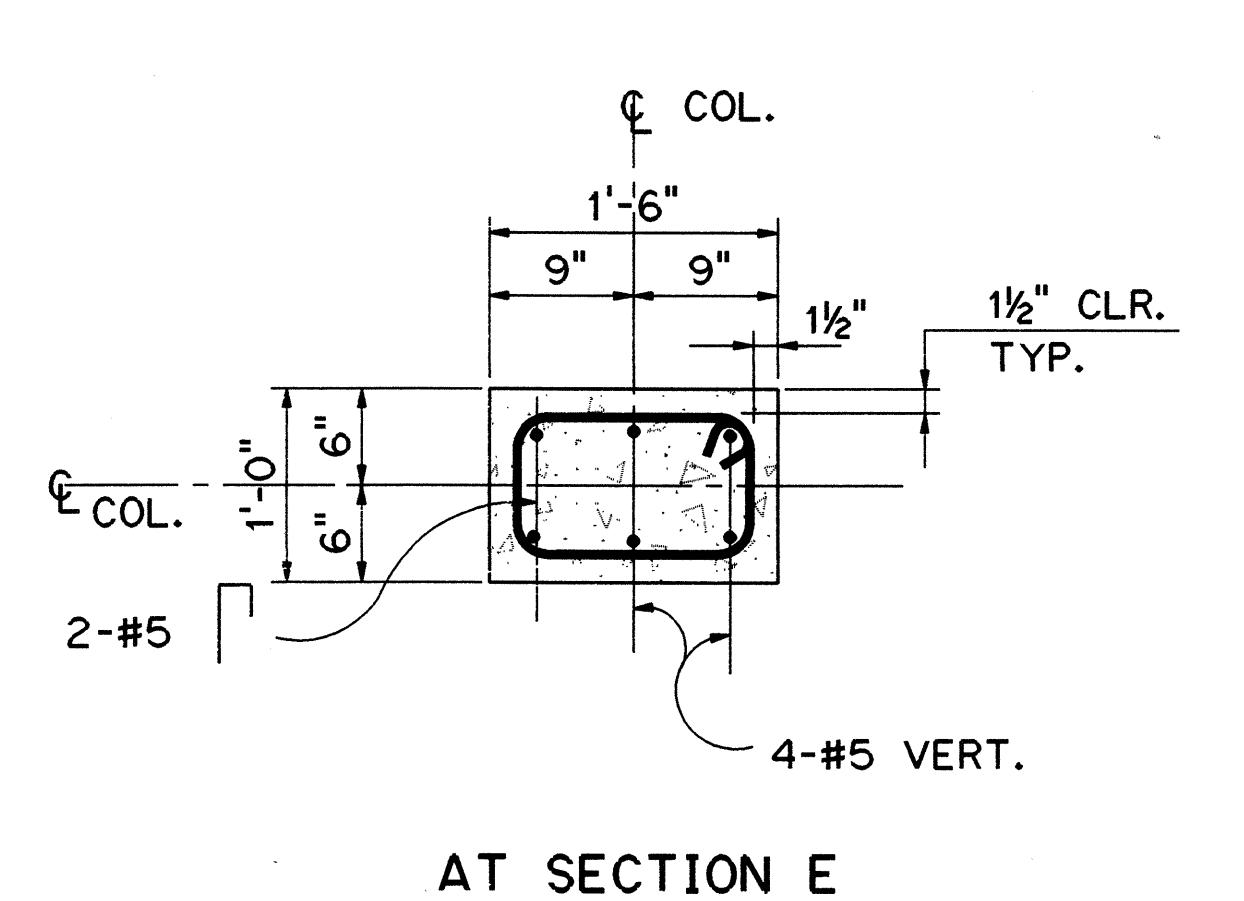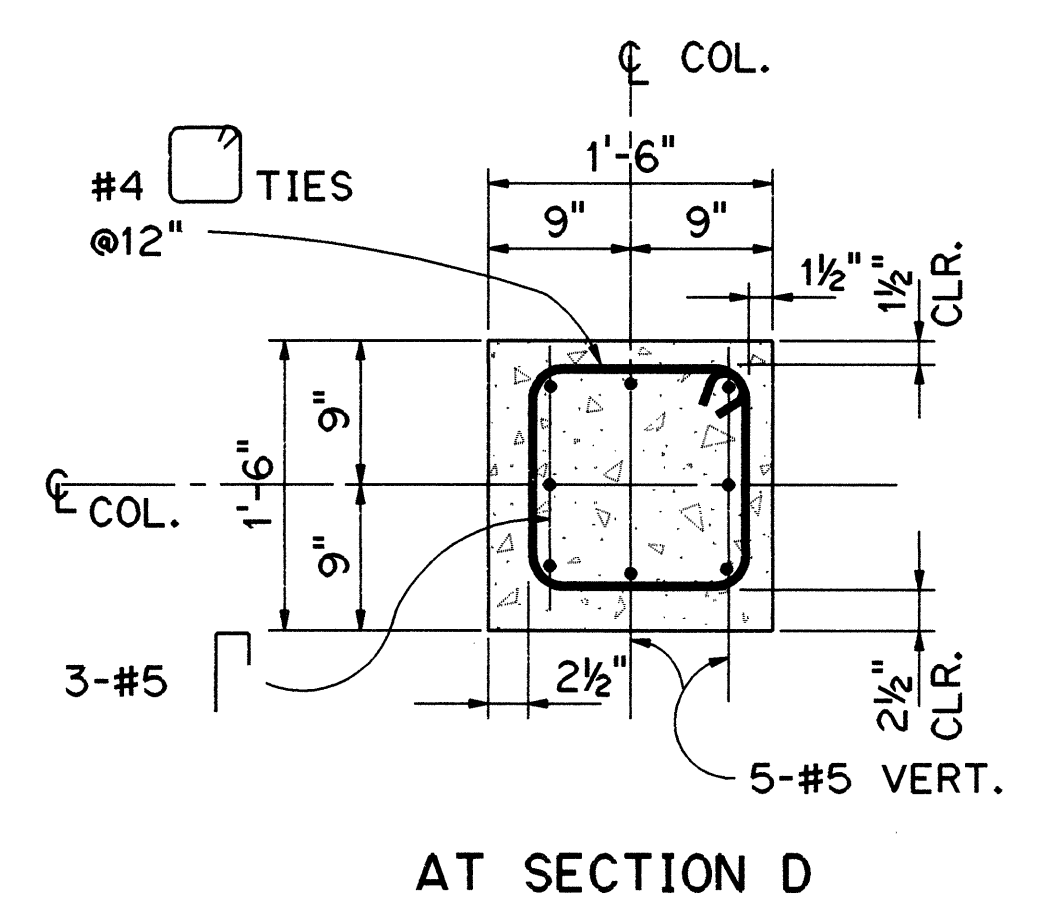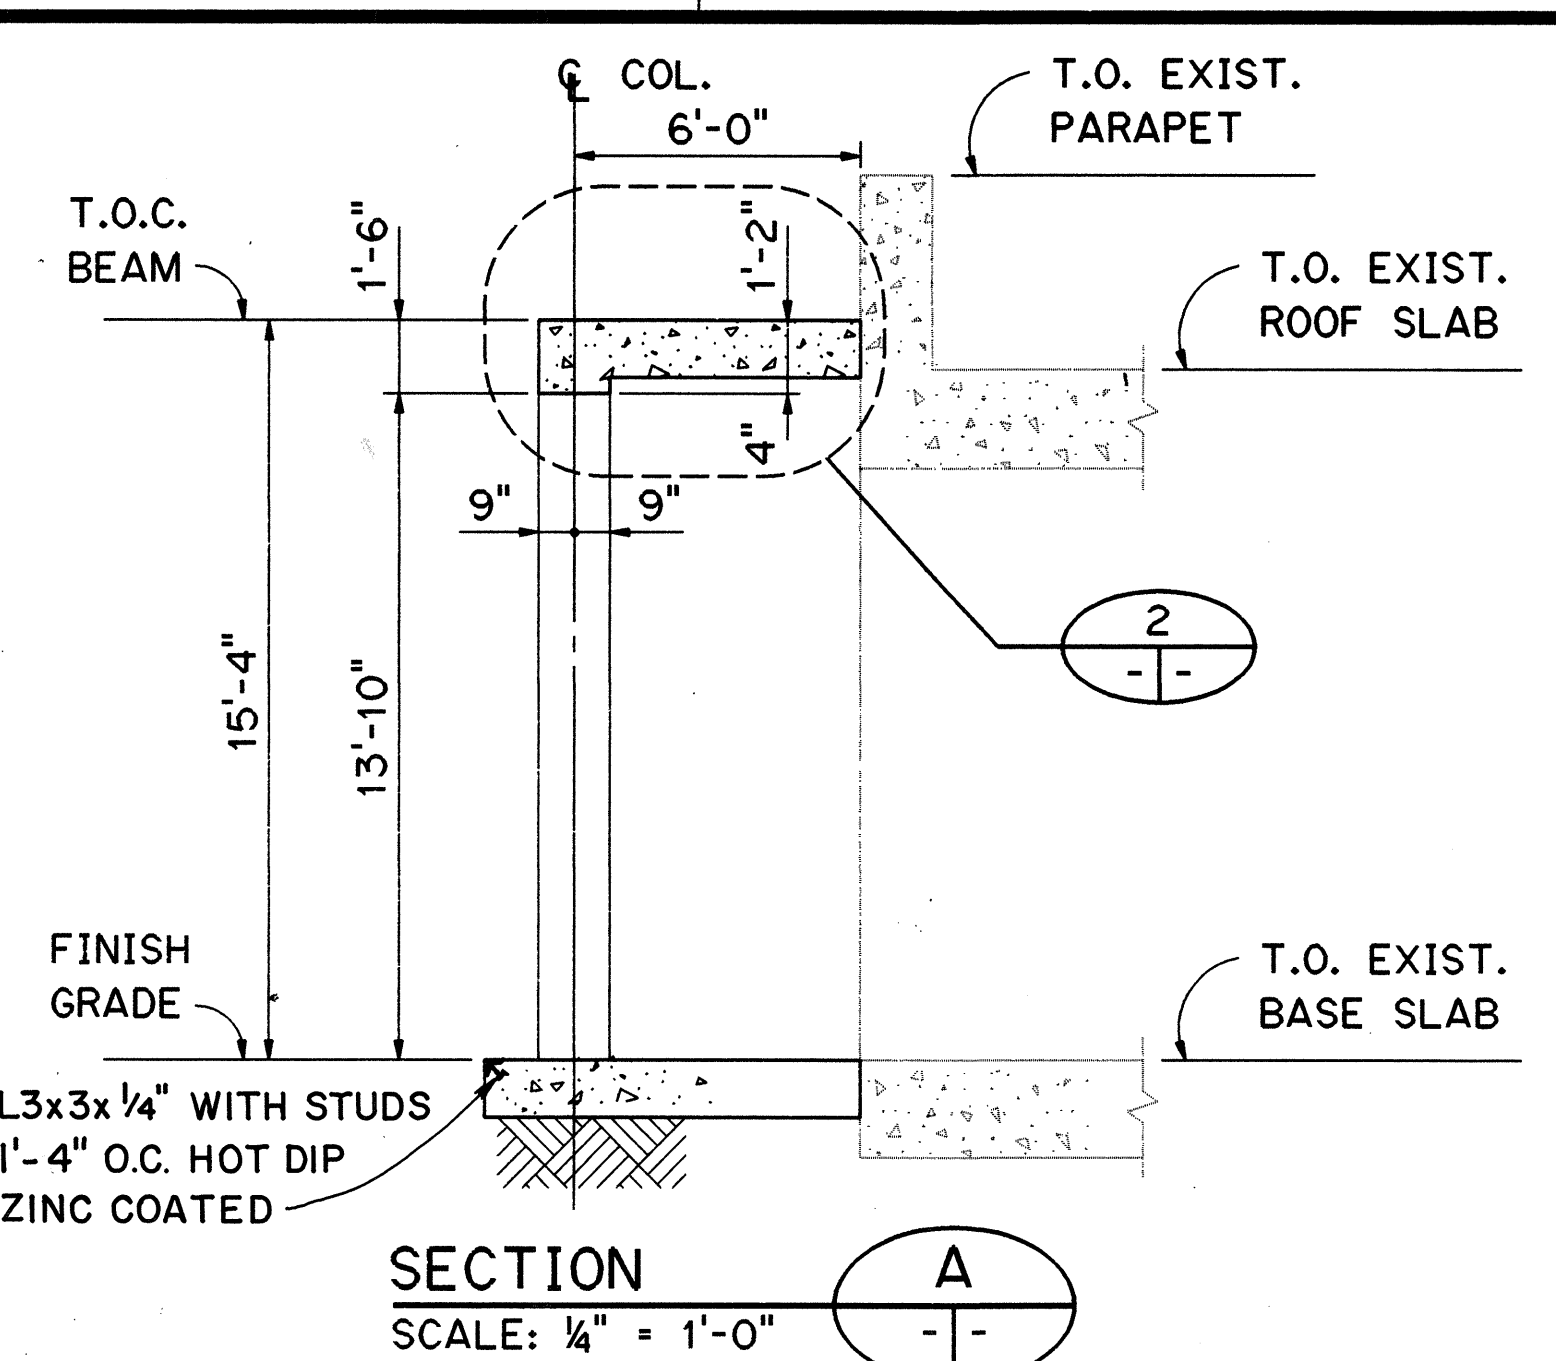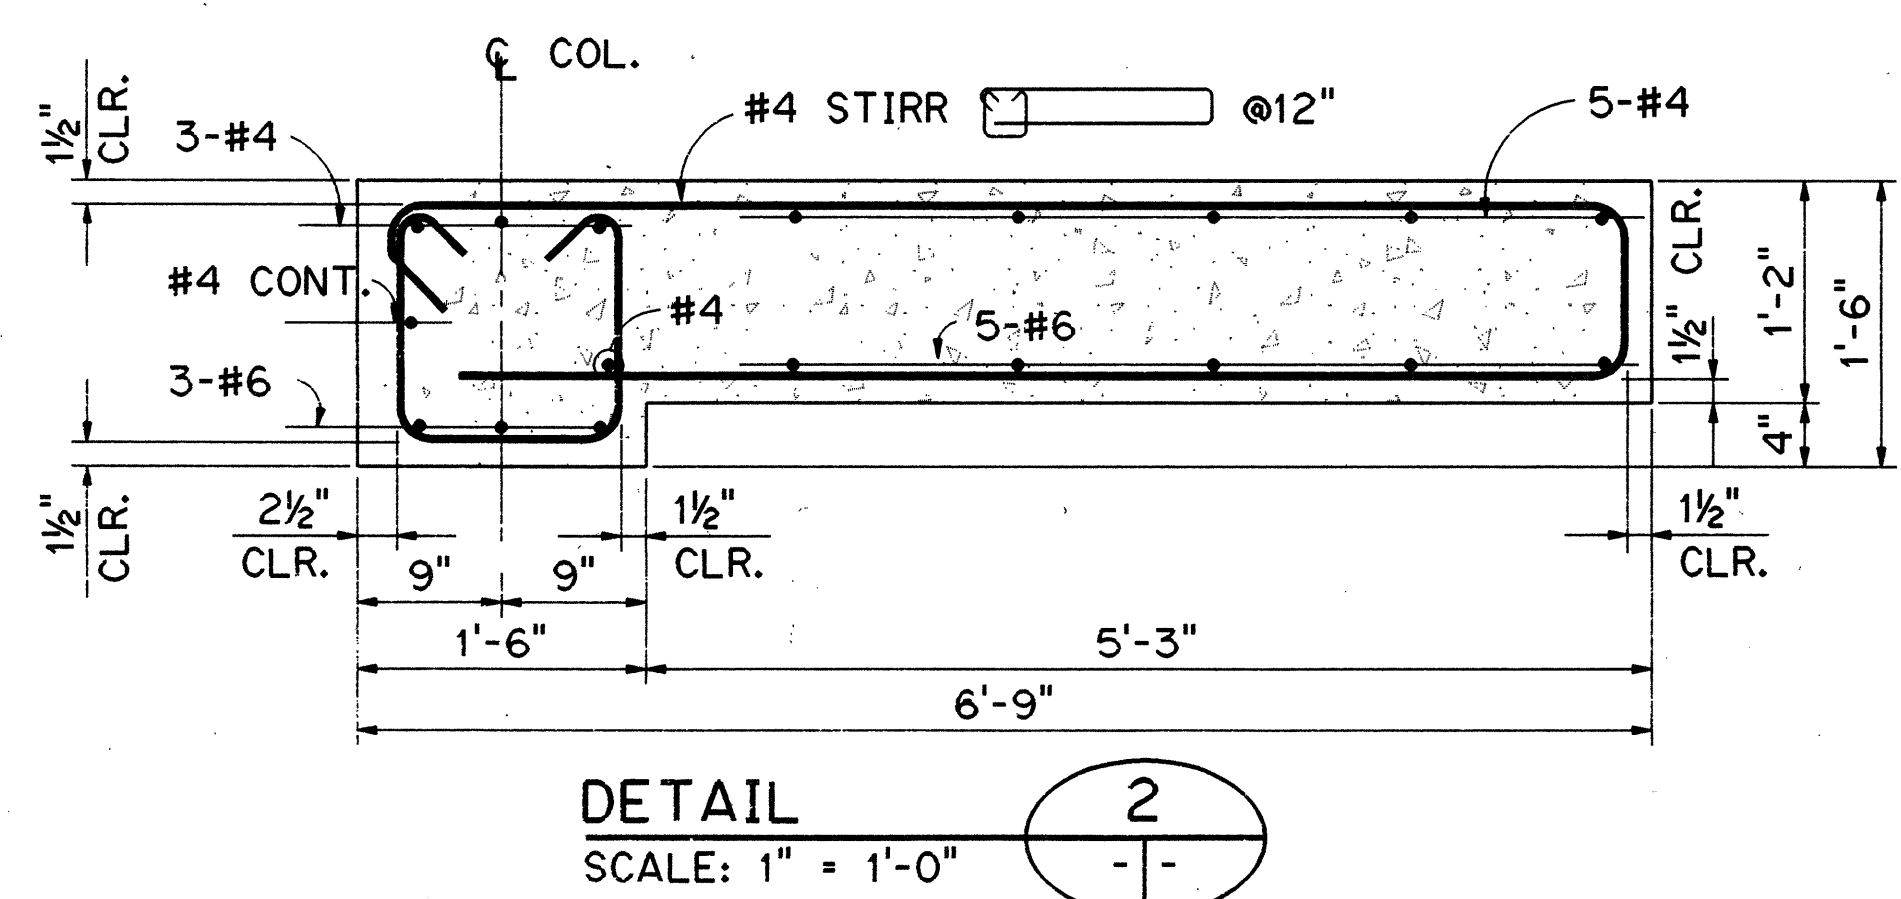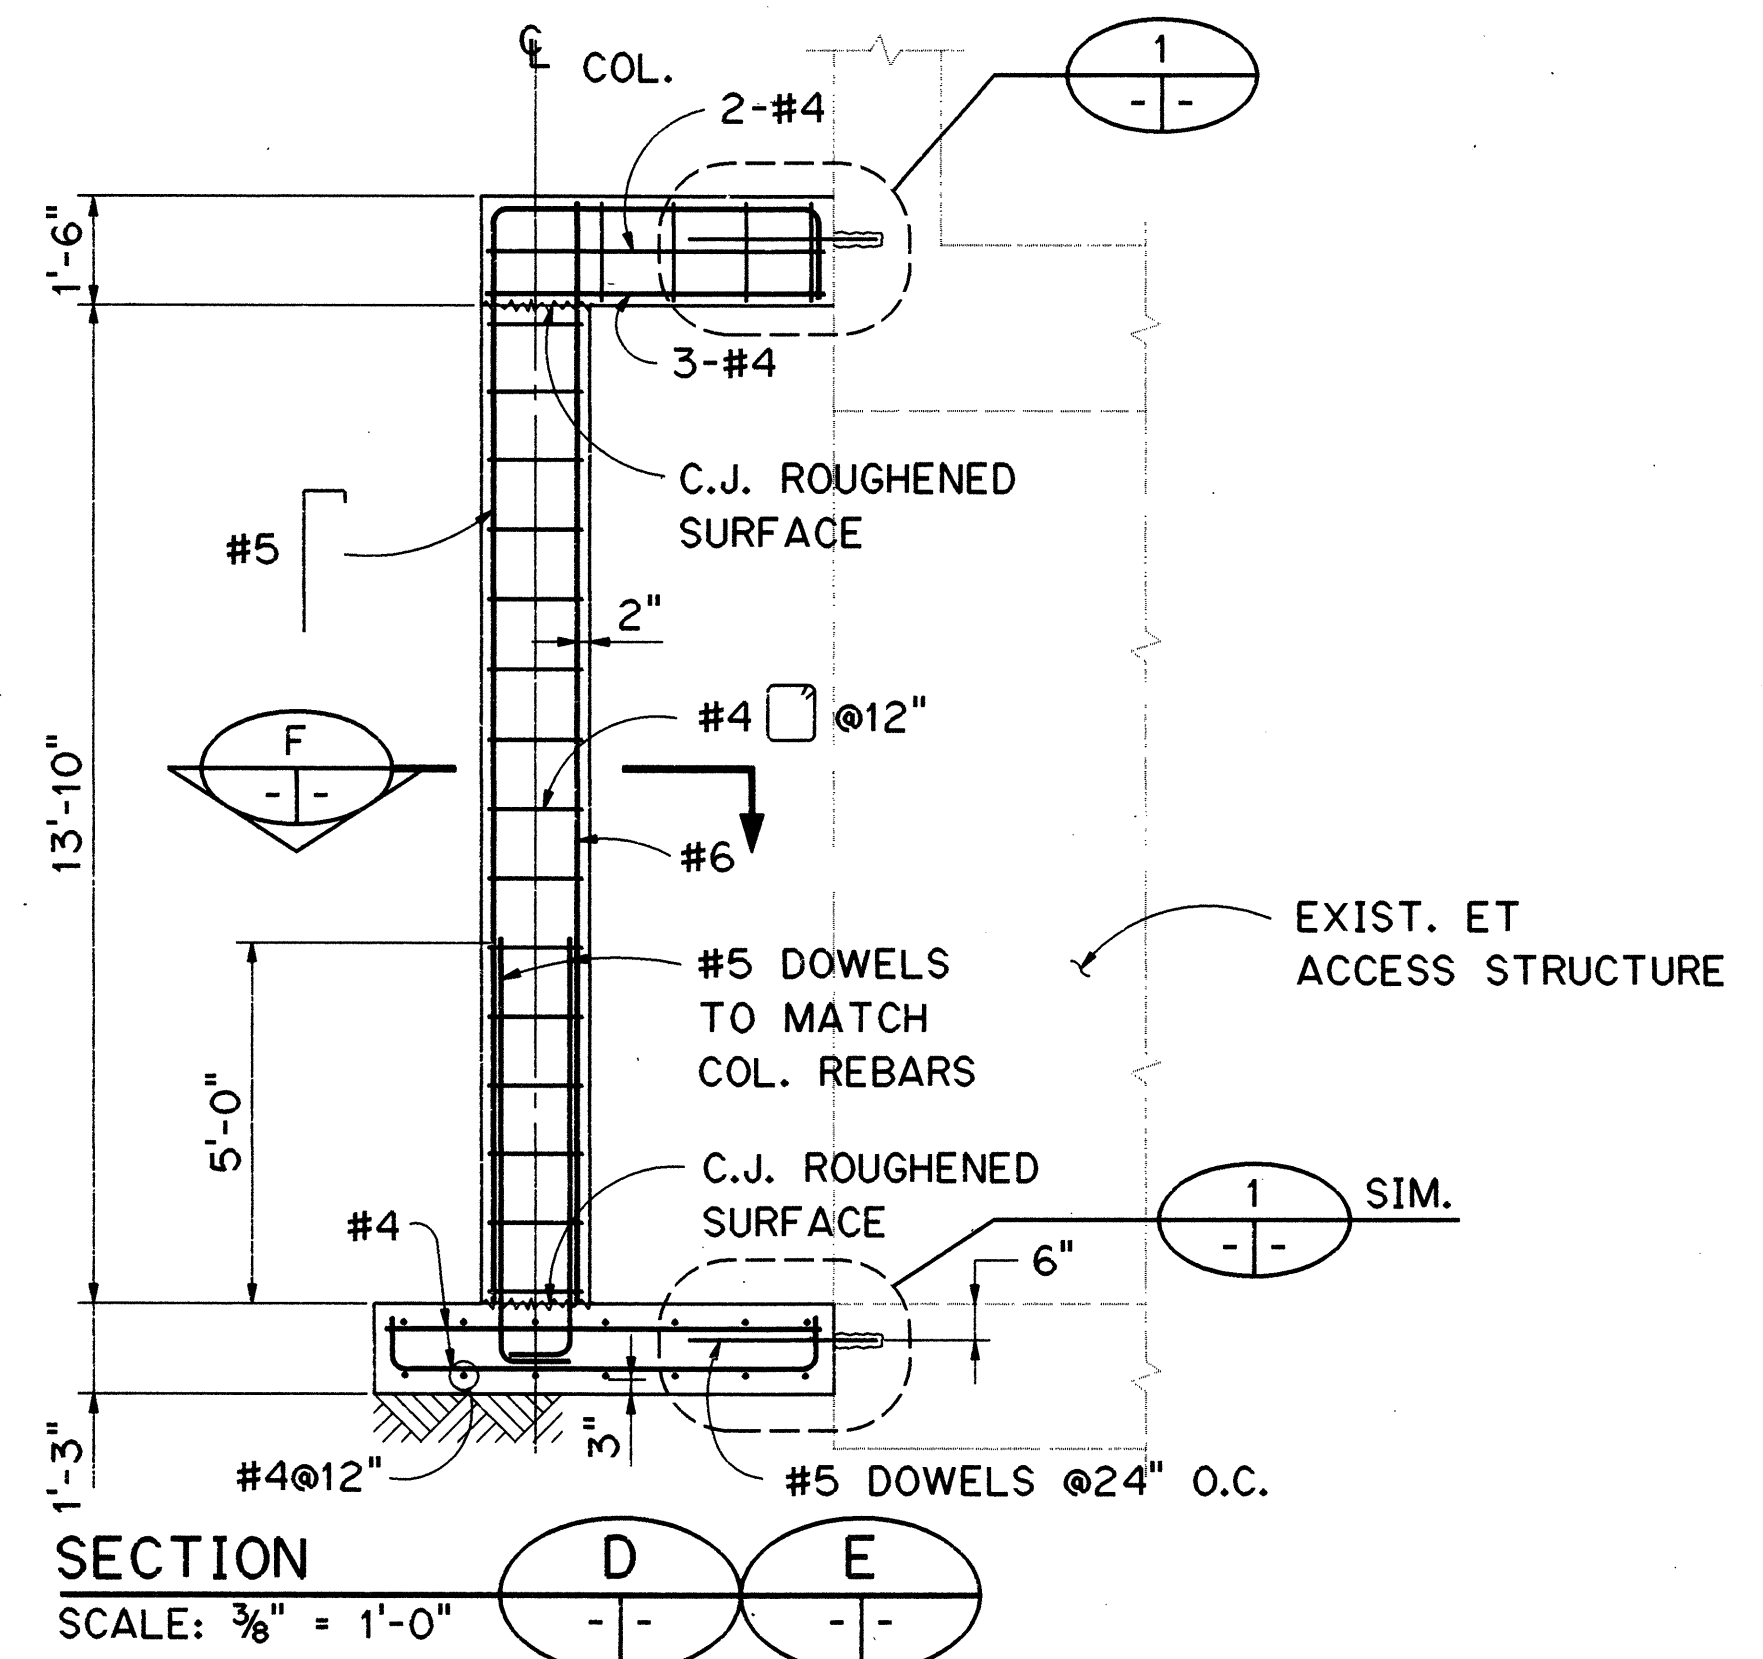

SECTION F
SCALE: 1" = 1'-0"


NOTE:
1. FOR GENERAL STRUCTURAL NOTES SEE SHEET NO. 2S4.

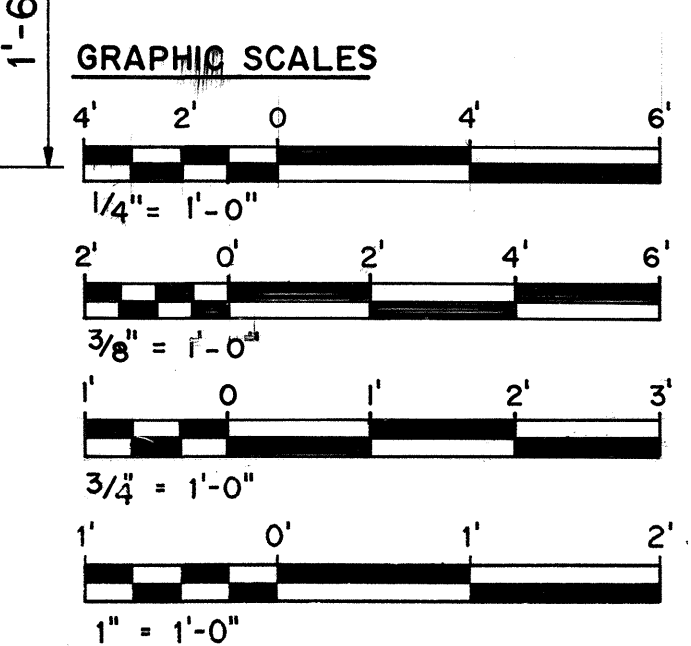


PETER G. BIERES
LICENSED PROFESSIONAL ENGINEER
No. 6467-S
HAWAII, U.S.A.
THIS WORK WAS PREPARED BY ME OR UNDER MY SUPERVISION
Peter G. Bieres

DATE	REVISION
10/13/95	ADDENDUM I
DEPARTMENT OF TRANSPORTATION HIGHWAYS DIVISION HALAWA GATE PLANS AND SECTIONS EXPLORATORY TUNNEL IMPROVEMENTS H-3 FINISH (UNIT III) FAIP NO. I-H3-1(75), UNIT III T.K. TUNNEL/ACCESS ROADS SCALE: AS SHOWN DATE: JUN 1995	
SHEET NO. 2S16	OF 17 SHEETS


FED. ROAD DIST. NO.	STATE	FED. AID PROJ. NO.	FISCAL YEAR	SHEET NO.	TOTAL SHEETS
HAWAII	HAW.	1-H3-1(75) UNIT III	1994	64	353

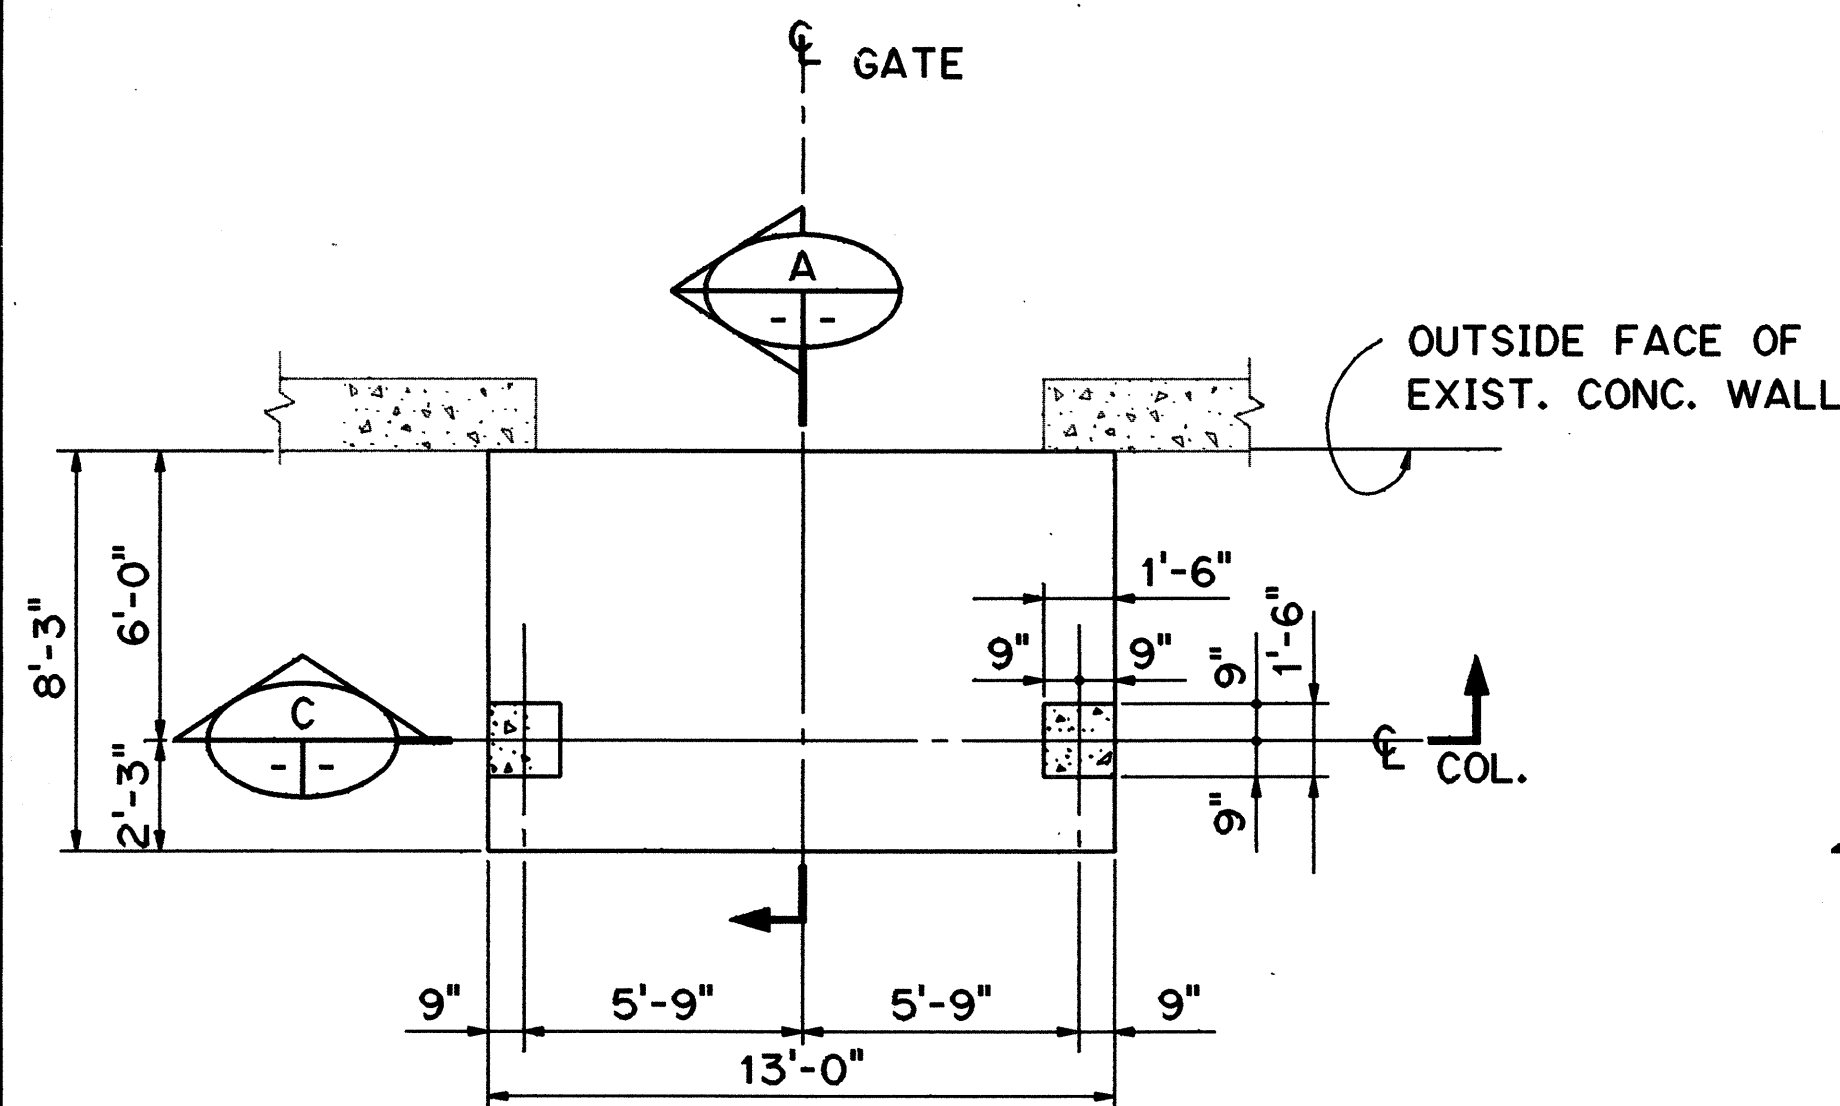


FOUNDATION PLAN
SCALE: 1/4" = 1'-0"

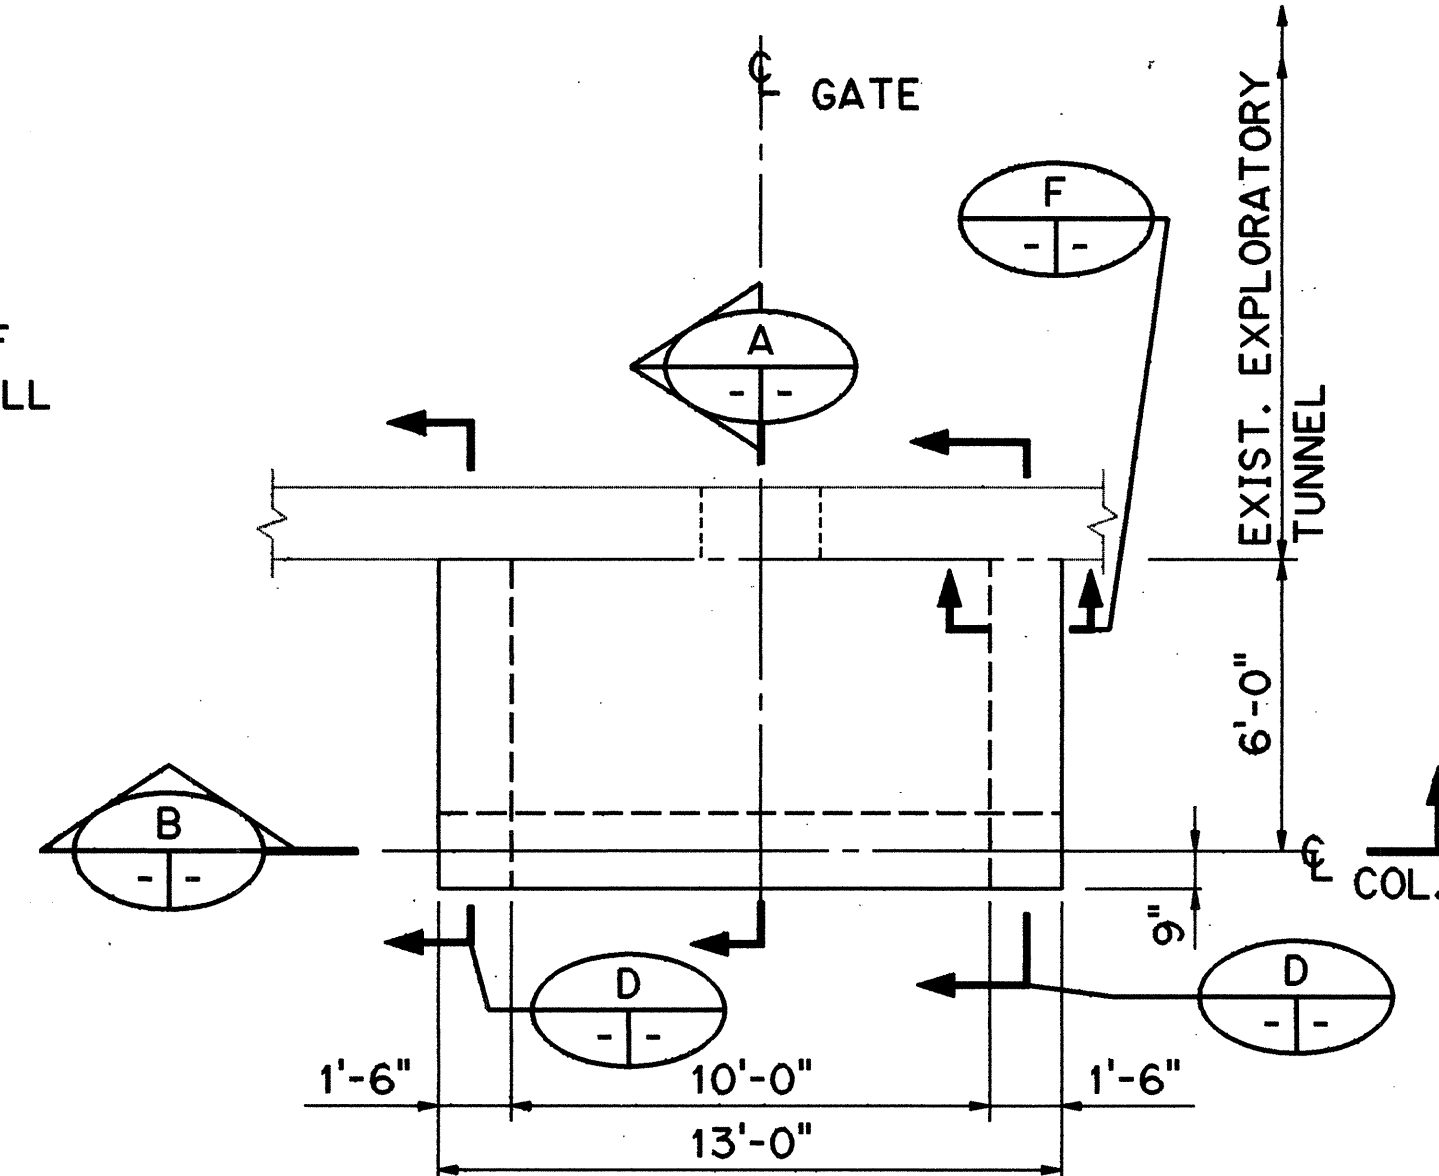


PLAN AT TOP OF CONC. BEAM
SCALE: 1/4" = 1'-0"

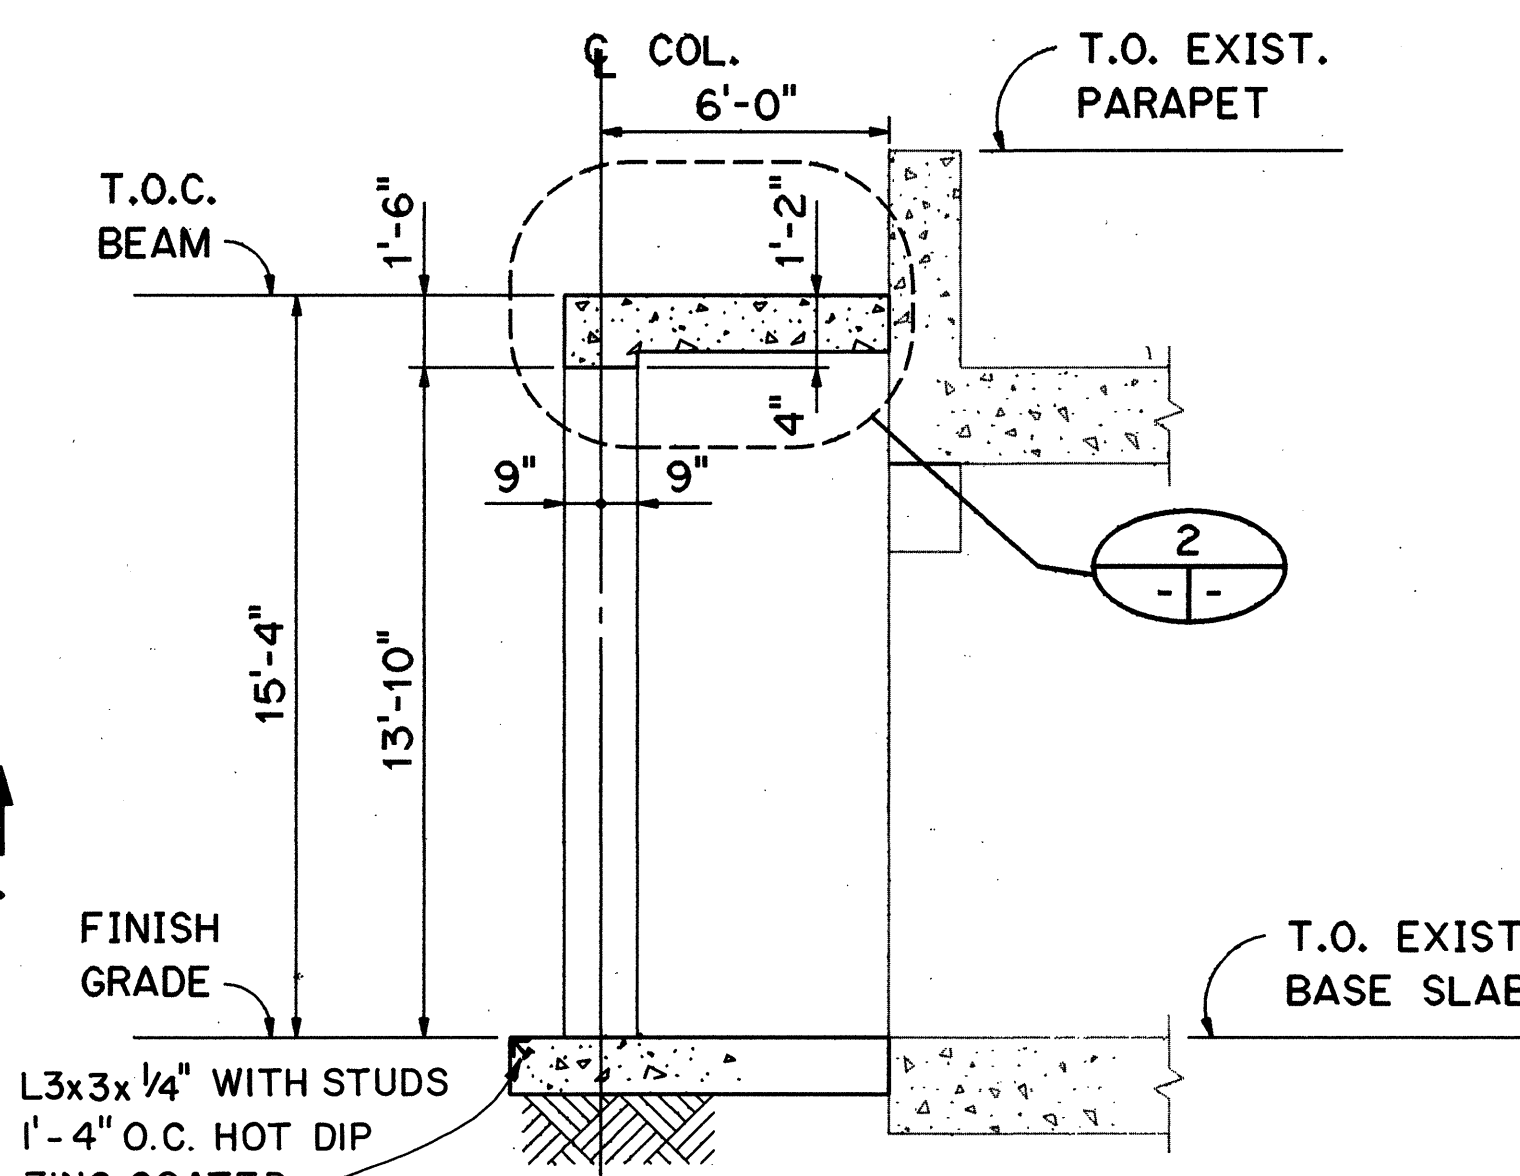


SECTION A
SCALE: 1/4" = 1'-0"

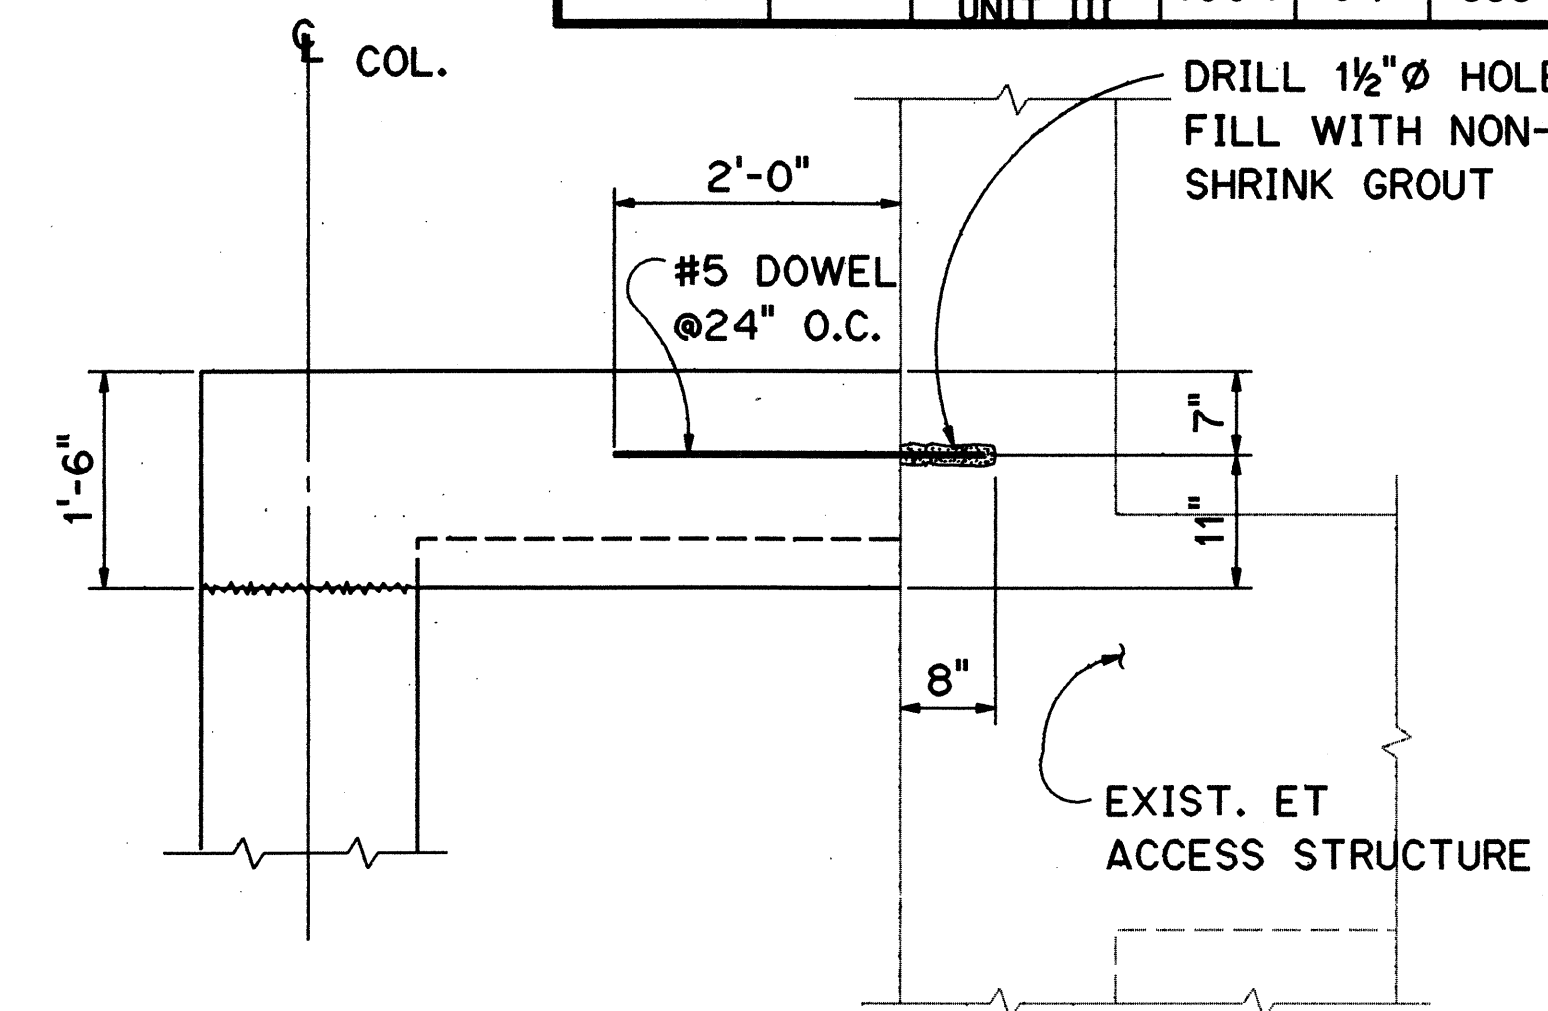


DETAIL 1
SCALE: 1/4" = 1'-0"

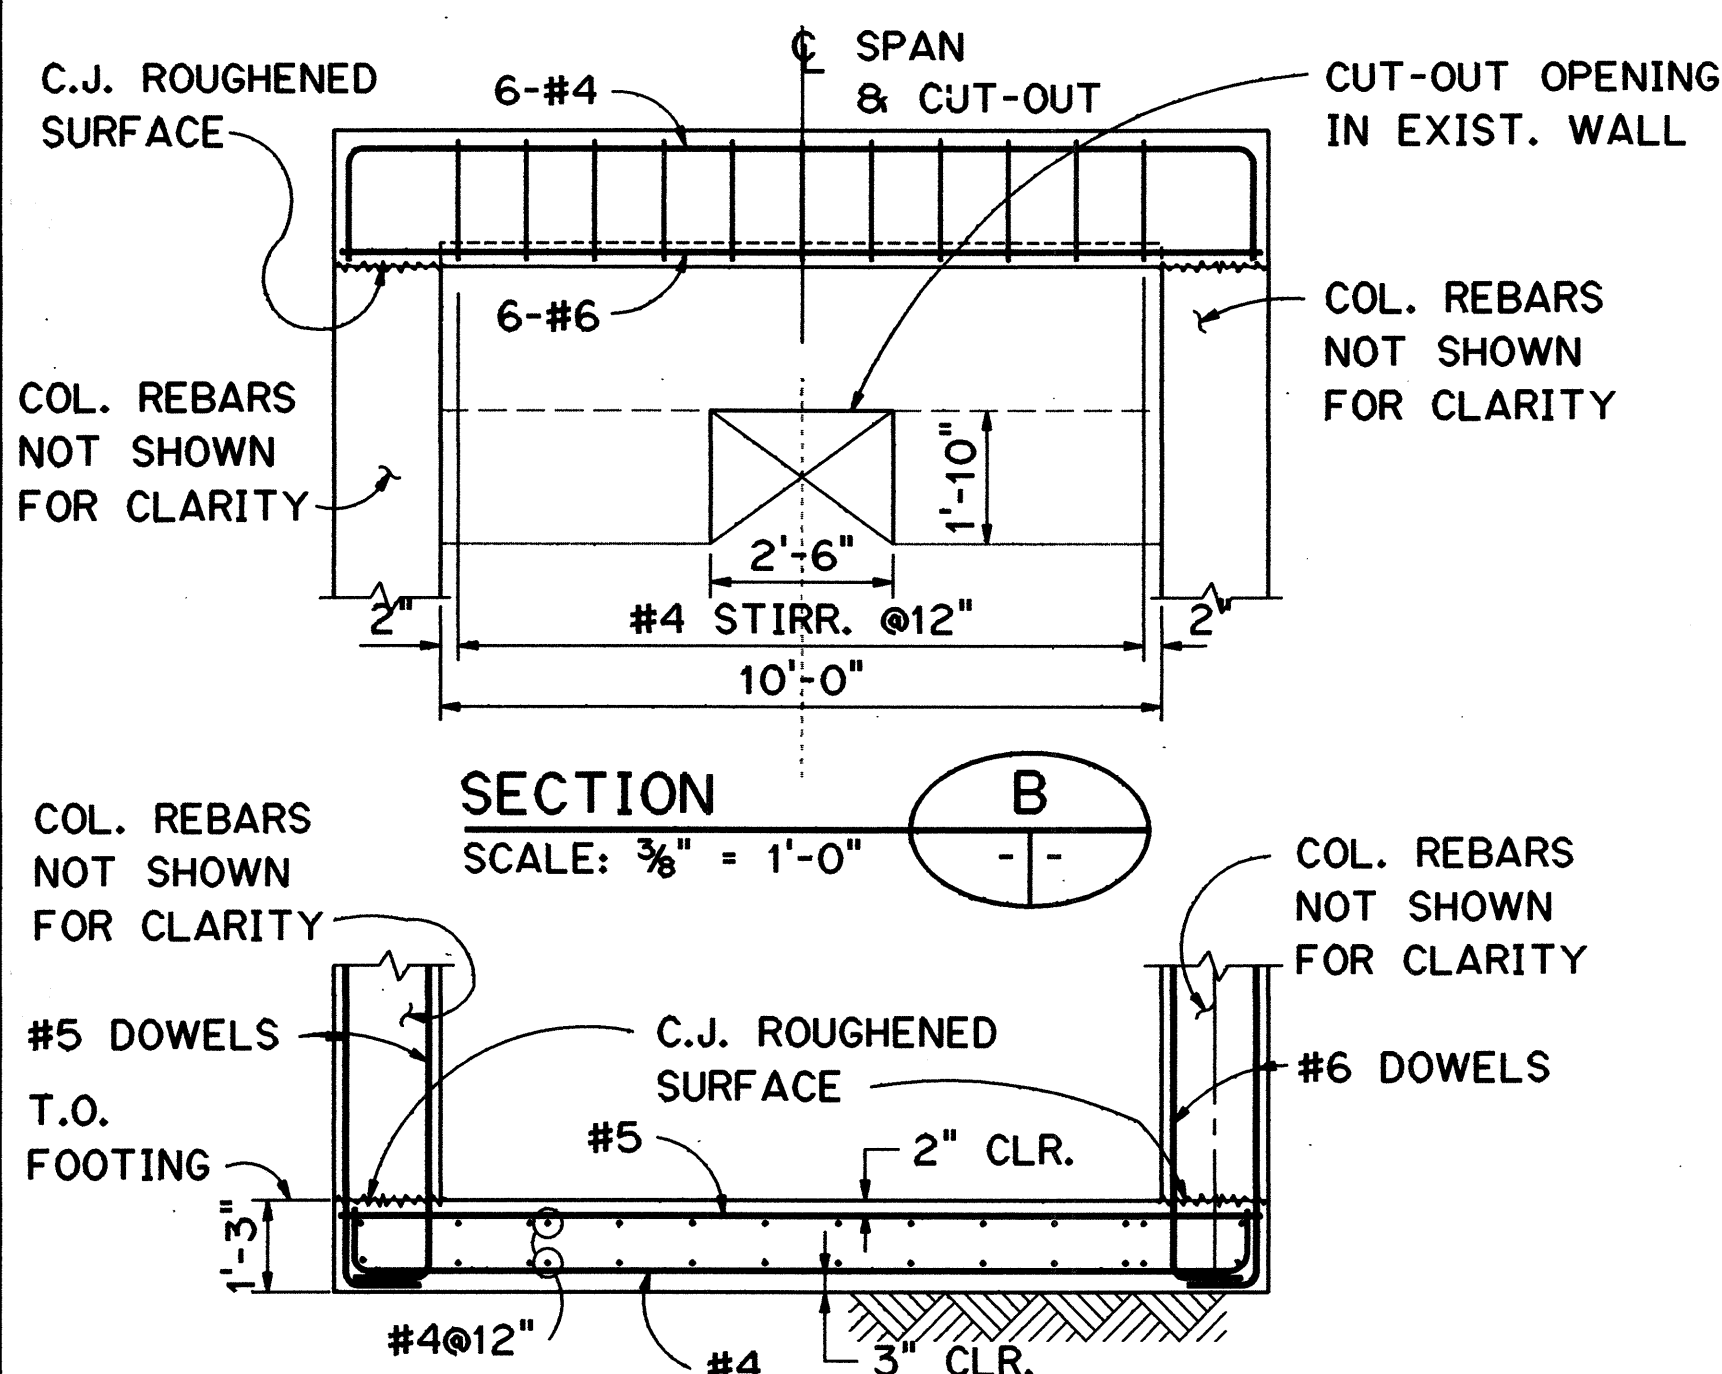


SECTION B
SCALE: 3/8" = 1'-0"

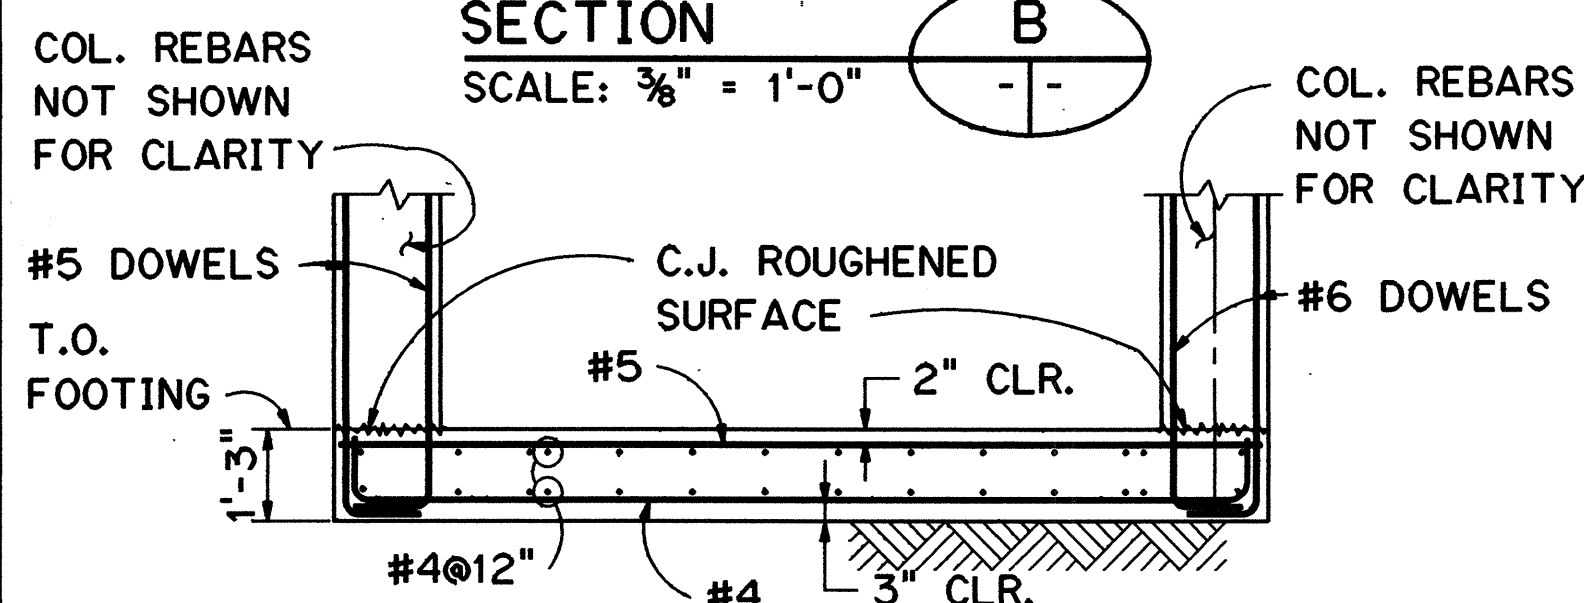

SECTION C
SCALE: 3/8" = 1'-0"

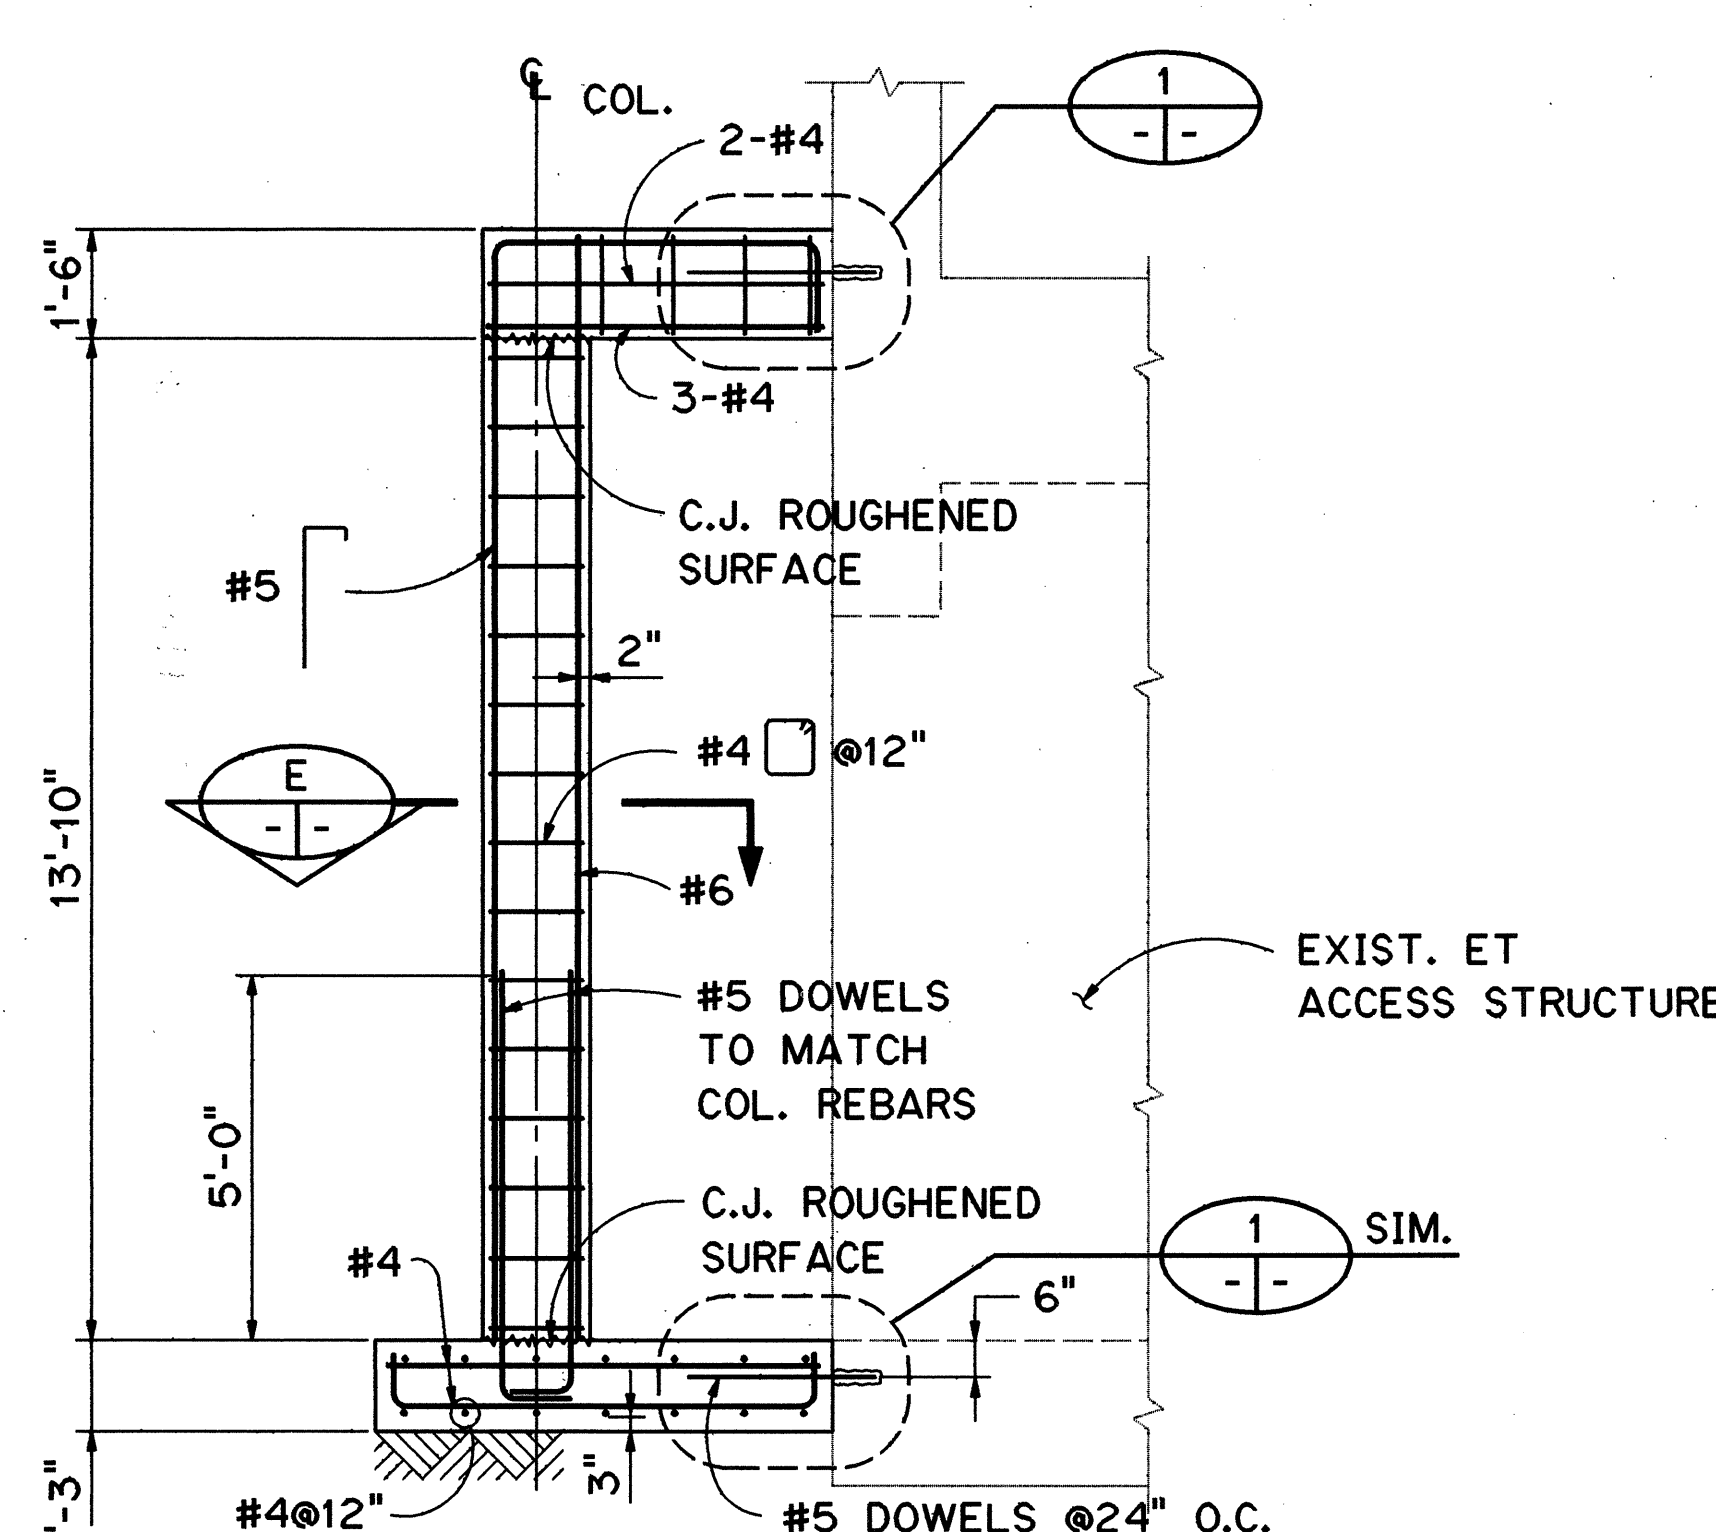


SECTION D
SCALE: 3/8" = 1'-0"

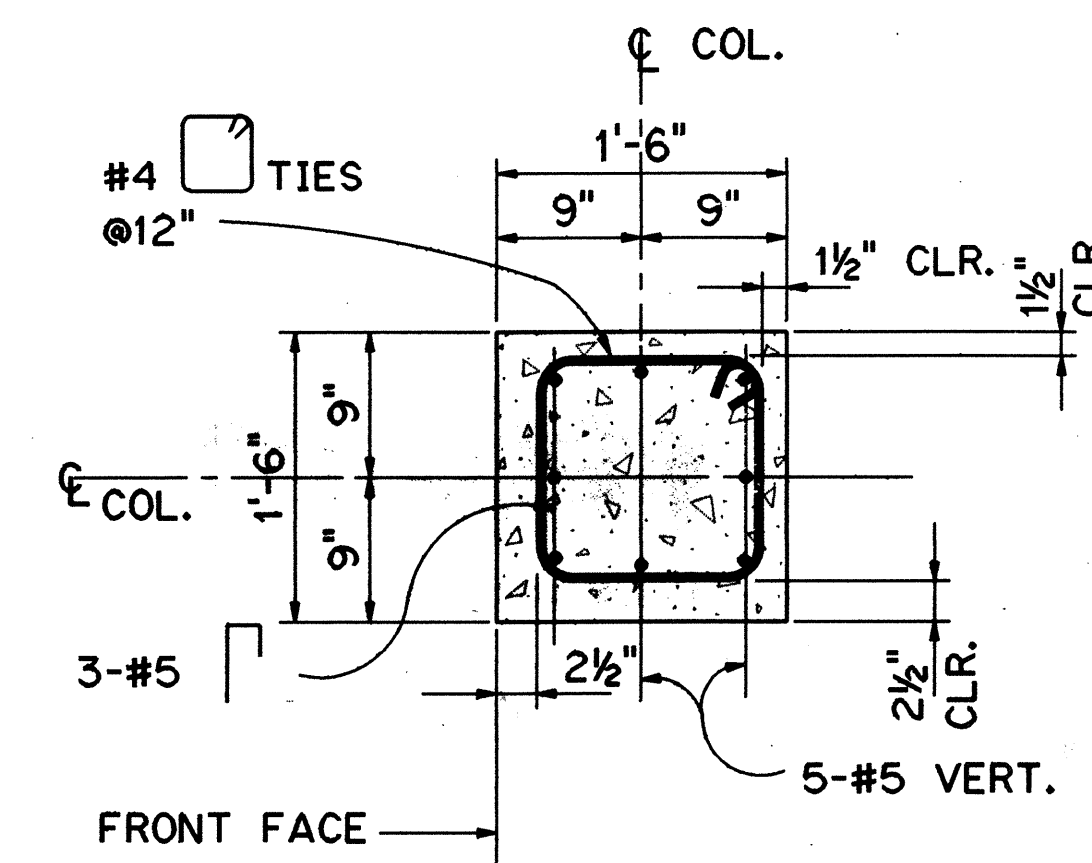


SECTION E
SCALE: 1" = 1'-0"



NOTE:
ADD PIGMENT TO CONCRETE TO MATCH COLOR OF EXISTING HAIKU PORTAL BUILDINGS!

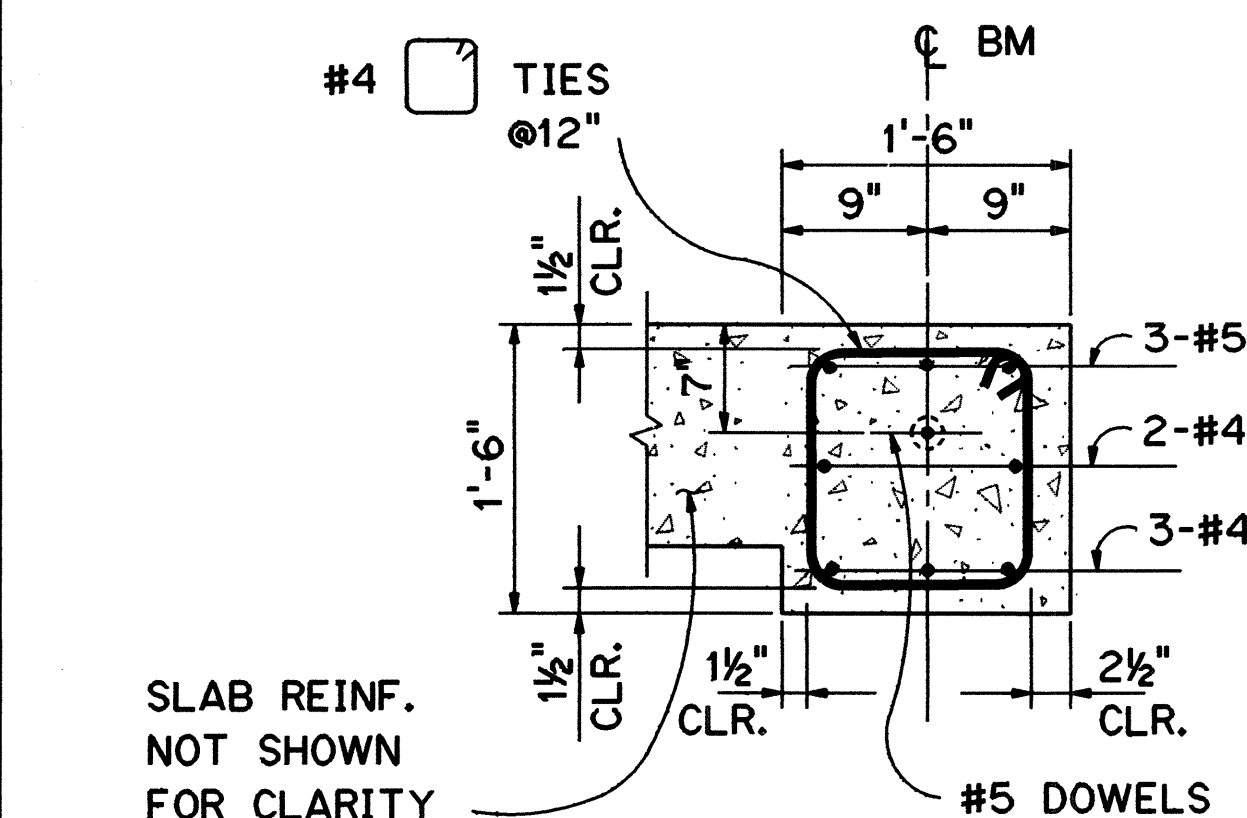

SECTION F
SCALE: 1" = 1'-0"

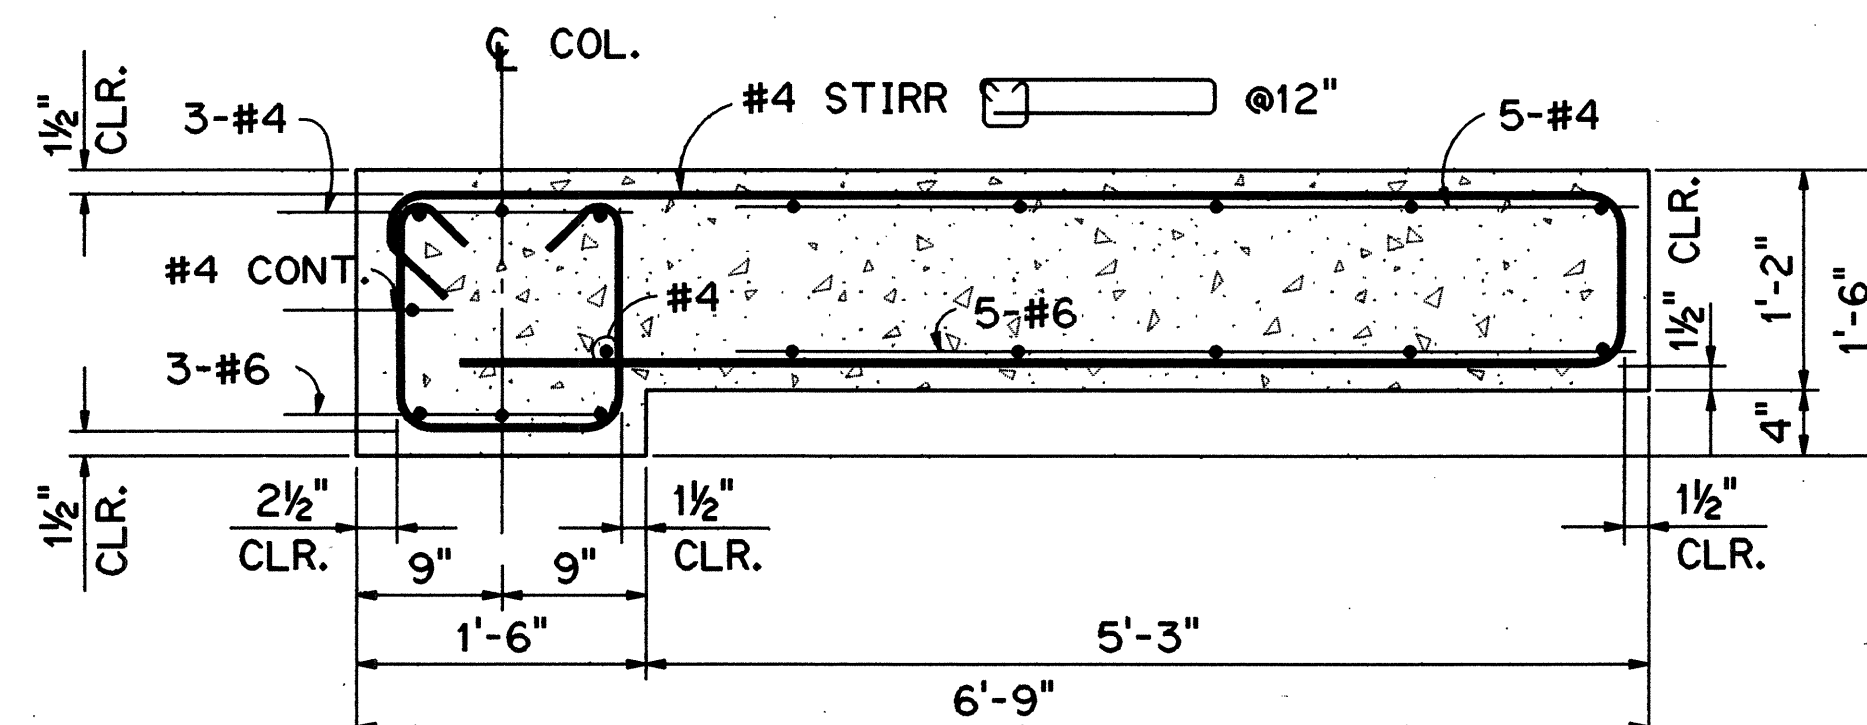

DETAIL 2
SCALE: 1" = 1'-0"

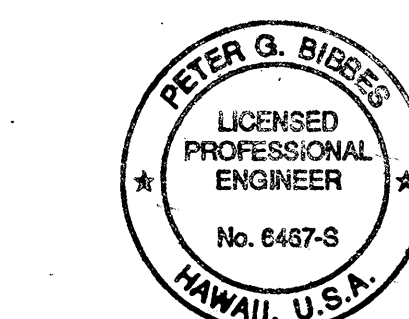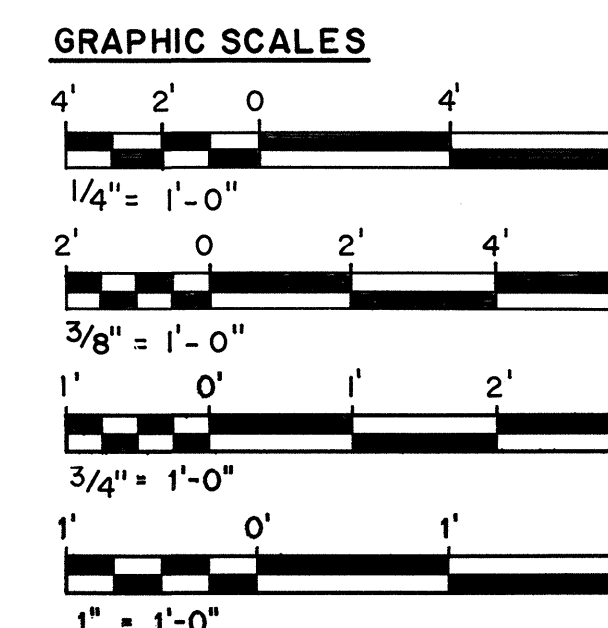

THIS WORK WAS PREPARED BY ME OR UNDER MY SUPERVISION

DATE	10/13/95	ADDENDUM I
REVISION		
DEPARTMENT OF TRANSPORTATION HIGHWAYS DIVISION HAIKU GATE PLANS AND SECTIONS EXPLORATORY TUNNEL IMPROVEMENTS H-3 FINISH (UNIT III) FAIP NO. I-H3-1(75), UNIT III T.K. TUNNEL/ACCESS ROADS SCALE: AS SHOWN DATE: JUN 1995 SHEET NO. 2S17 OF 17 SHEETS		

ADD.64

SURVEY PLOTTED BY	DATE
DRAWN BY	NOV 94
CHECKED BY	NOV 94
NOTED BY	NOV 94
QUANTITIES BY	NOV 94
CHECKED BY	NOV 94
NO.	

FED. ROAD DIST. NO.	STATE	FED. AID PROJ. NO.	FISCAL YEAR	SHEET NO.	TOTAL SHEETS
HAWAII	HAW.	I-H3-1(75) UNIT III	1994	65	353

[illegible]

FOR DETAIL AS-BUILT INFORMATION
REFER TO CONSTRUCTION SUBMITTALS

DATE	REVISION

STATE OF HAWAII
DEPARTMENT OF TRANSPORTATION
HIGHWAYS DIVISION

VENTILATION

EQUIPMENT SCHEDULE

EXPLORATORY TUNNEL IMPROVEMENTS


H-3 FINISH (UNIT III)

FAIP NO. I-H3-1(75), UNIT III

T.K. TUNNEL/ACCESS ROADS

SCALE: NONE DATE: JUN 1995


SHEET NO. **2M1** OF **8** SHEETS

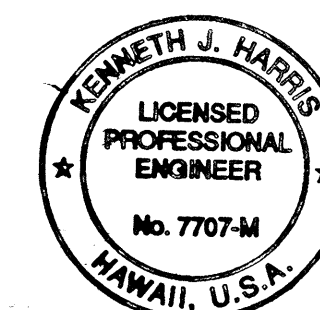

THIS WORK WAS PREPARED BY ME
OR UNDER MY SUPERVISION

Kenneth A. H.

ORIGINAL PLAN	SURVEY PLOTTED BY		DATE
NOTE BOOK	DRAWN BY	M. P. AGUIAR	OCT 94
	TRACED BY		
	DESIGNED BY	D. E. DRYDEN	OCT 94
	QUANTITIES BY		
NO.	CHECKED BY	K. J. HARRIS	JAN 95


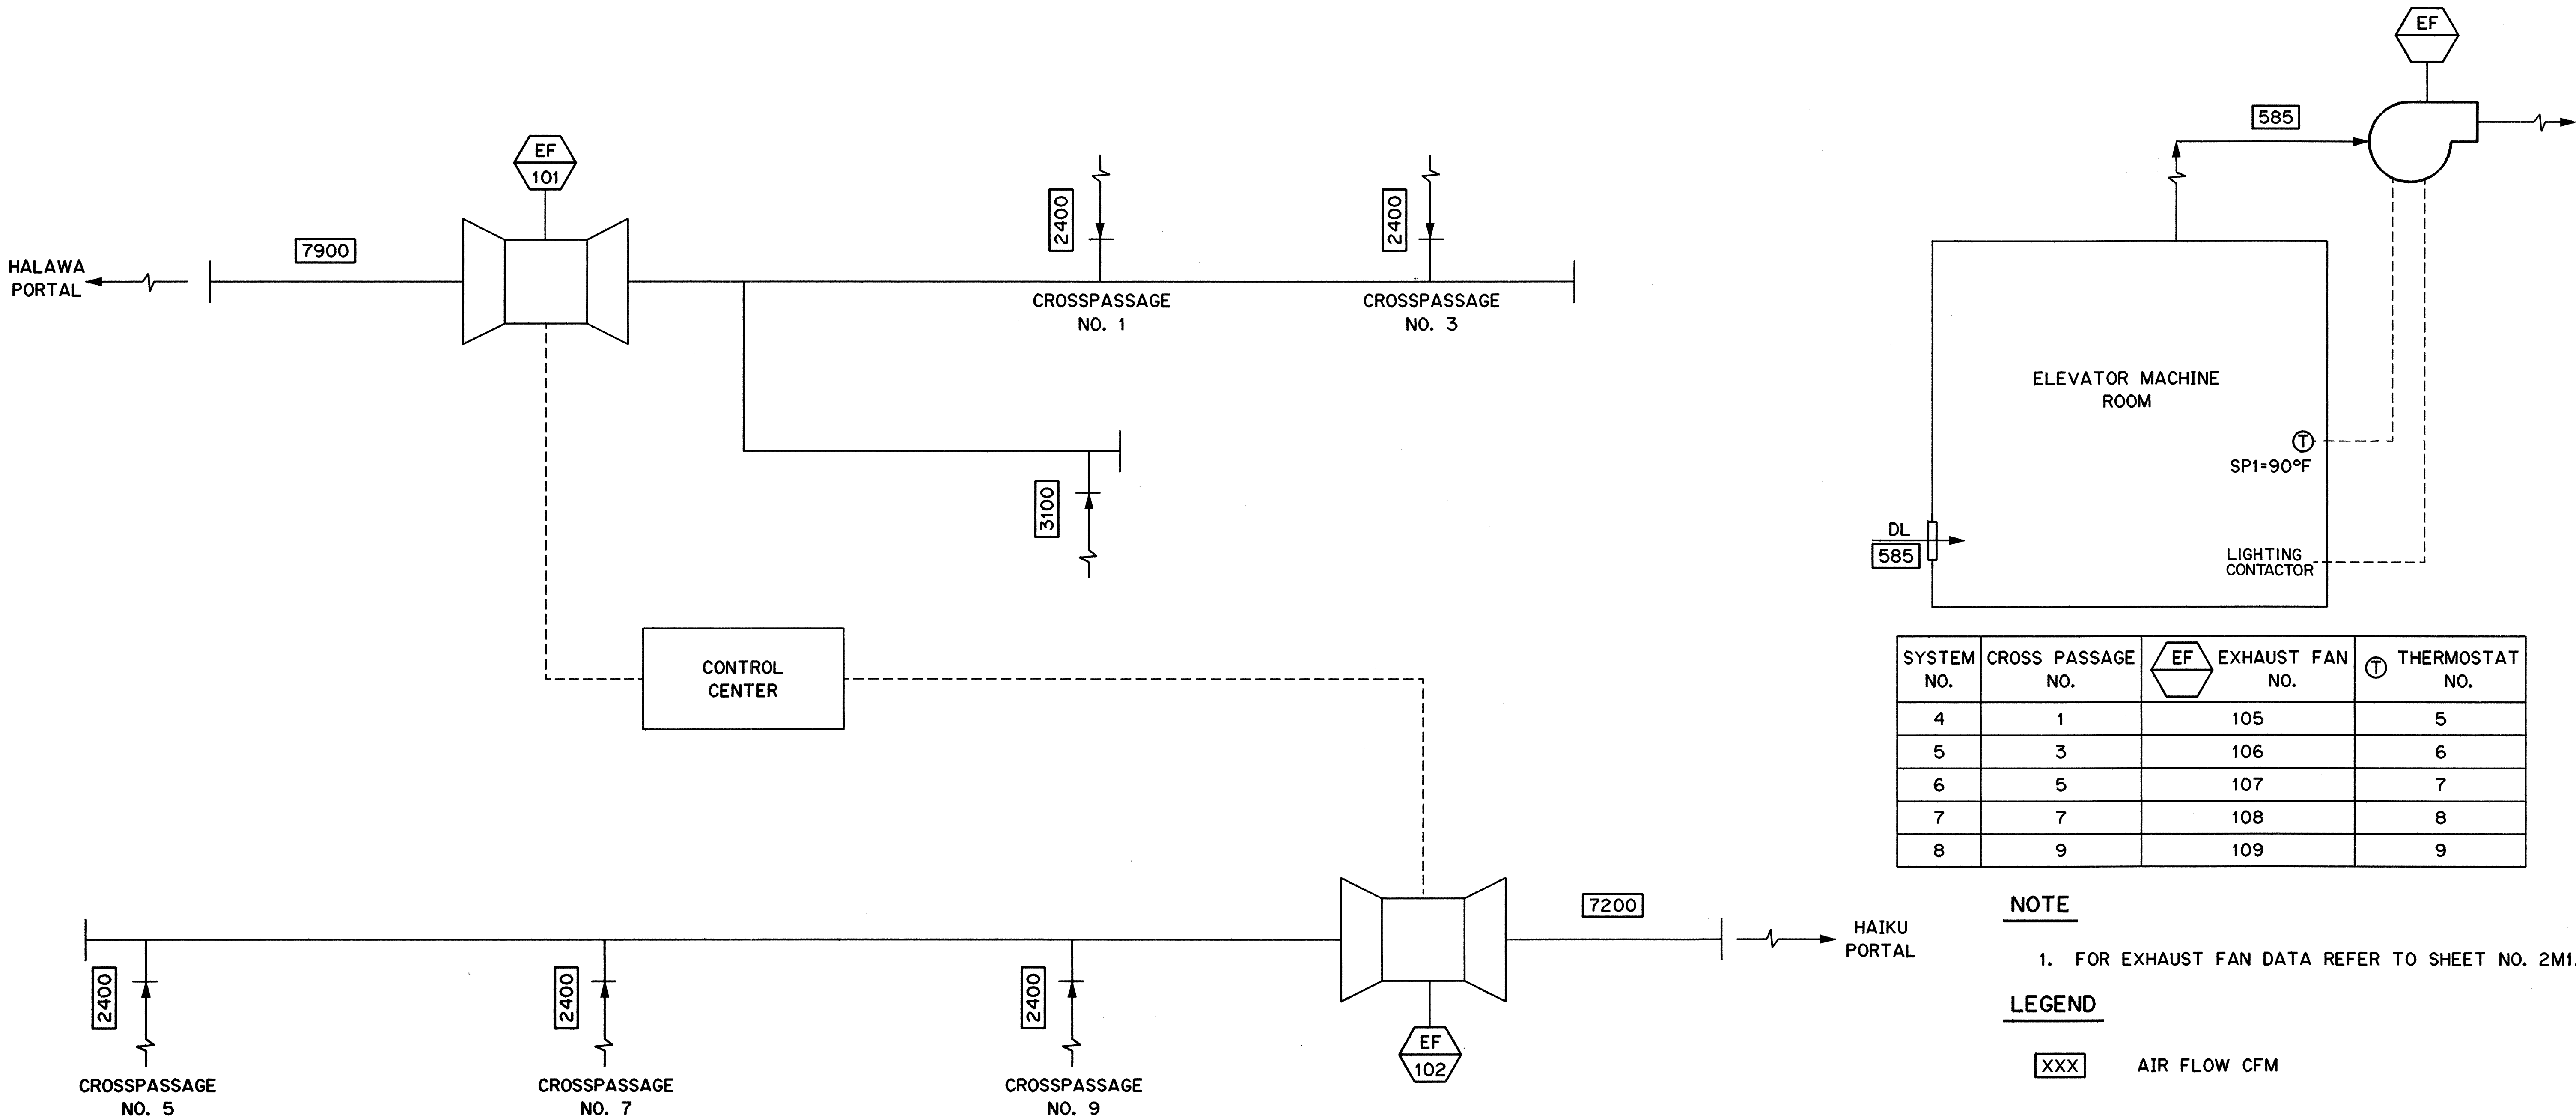


SYSTEM NO.	CROSS PASSAGE NO.	EF EXHAUST FAN NO.	THERMOSTAT NO.
4	1	105	5
5	3	106	6
6	5	107	7
7	7	108	8
8	9	109	9

NOTE
1. FOR EXHAUST FAN DATA REFER TO SHEET NO. 2M1.

LEGEND
[XXX] AIR FLOW CFM



SURVEY PLOTTED BY	DATE
DRAWN BY	OCT 94
CHECKED BY	OCT 94
DESIGNED BY	OCT 94
QUANTITIES BY	OCT 94
NO.	DEC 94

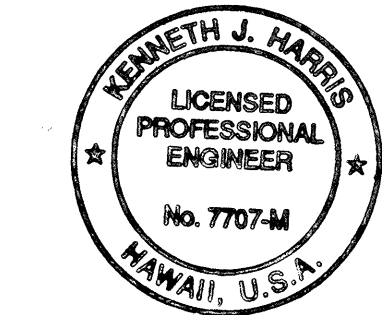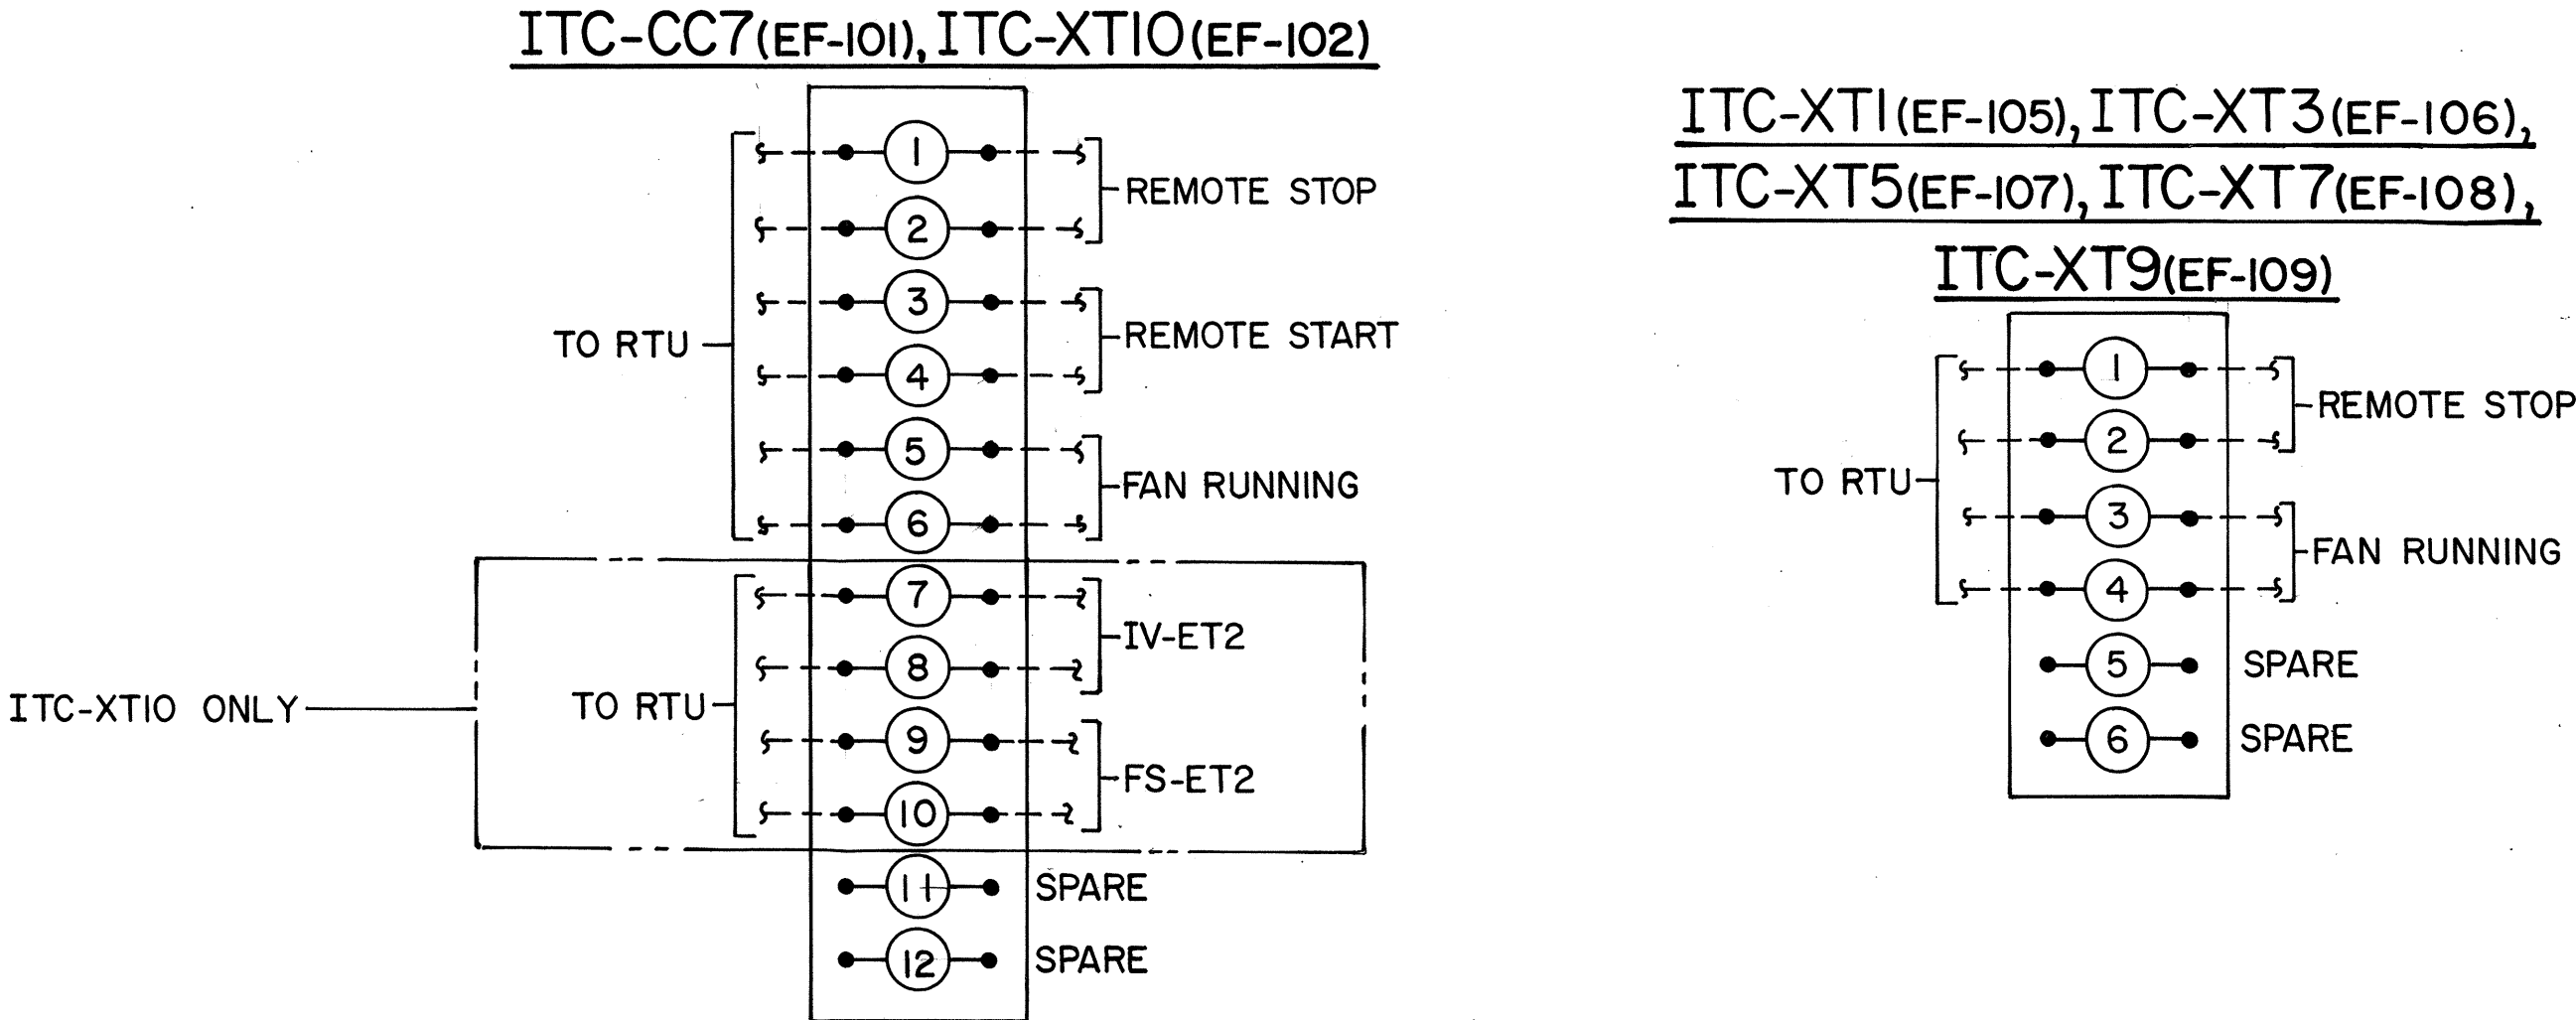



THIS WORK WAS PREPARED BY ME
OR UNDER MY SUPERVISION
Kenneth J. Harris

10/27/95	ADDENDUM 2-ADDED ITC DIAGRAMS
DATE	REVISION
STATE OF HAWAII DEPARTMENT OF TRANSPORTATION HIGHWAYS DIVISION AIR FLOW AND CONTROL DIAGRAM EXPLORATORY TUNNEL IMPROVEMENTS H-3 FINISH (UNIT III) FAIP NO. 1-H3-1(75), UNIT III T.K. TUNNEL/ACCESS ROADS SCALE: NONE DATE: JUN 1995	
SHEET NO. 2M2	OF 8 SHEETS

FED. ROAD DIST. NO.	STATE	FED. AID PROJ. NO.	FISCAL YEAR	SHEET NO.	TOTAL SHEETS
HAWAII	HAW.	I-H3-1(75) UNIT III	1994	67	353

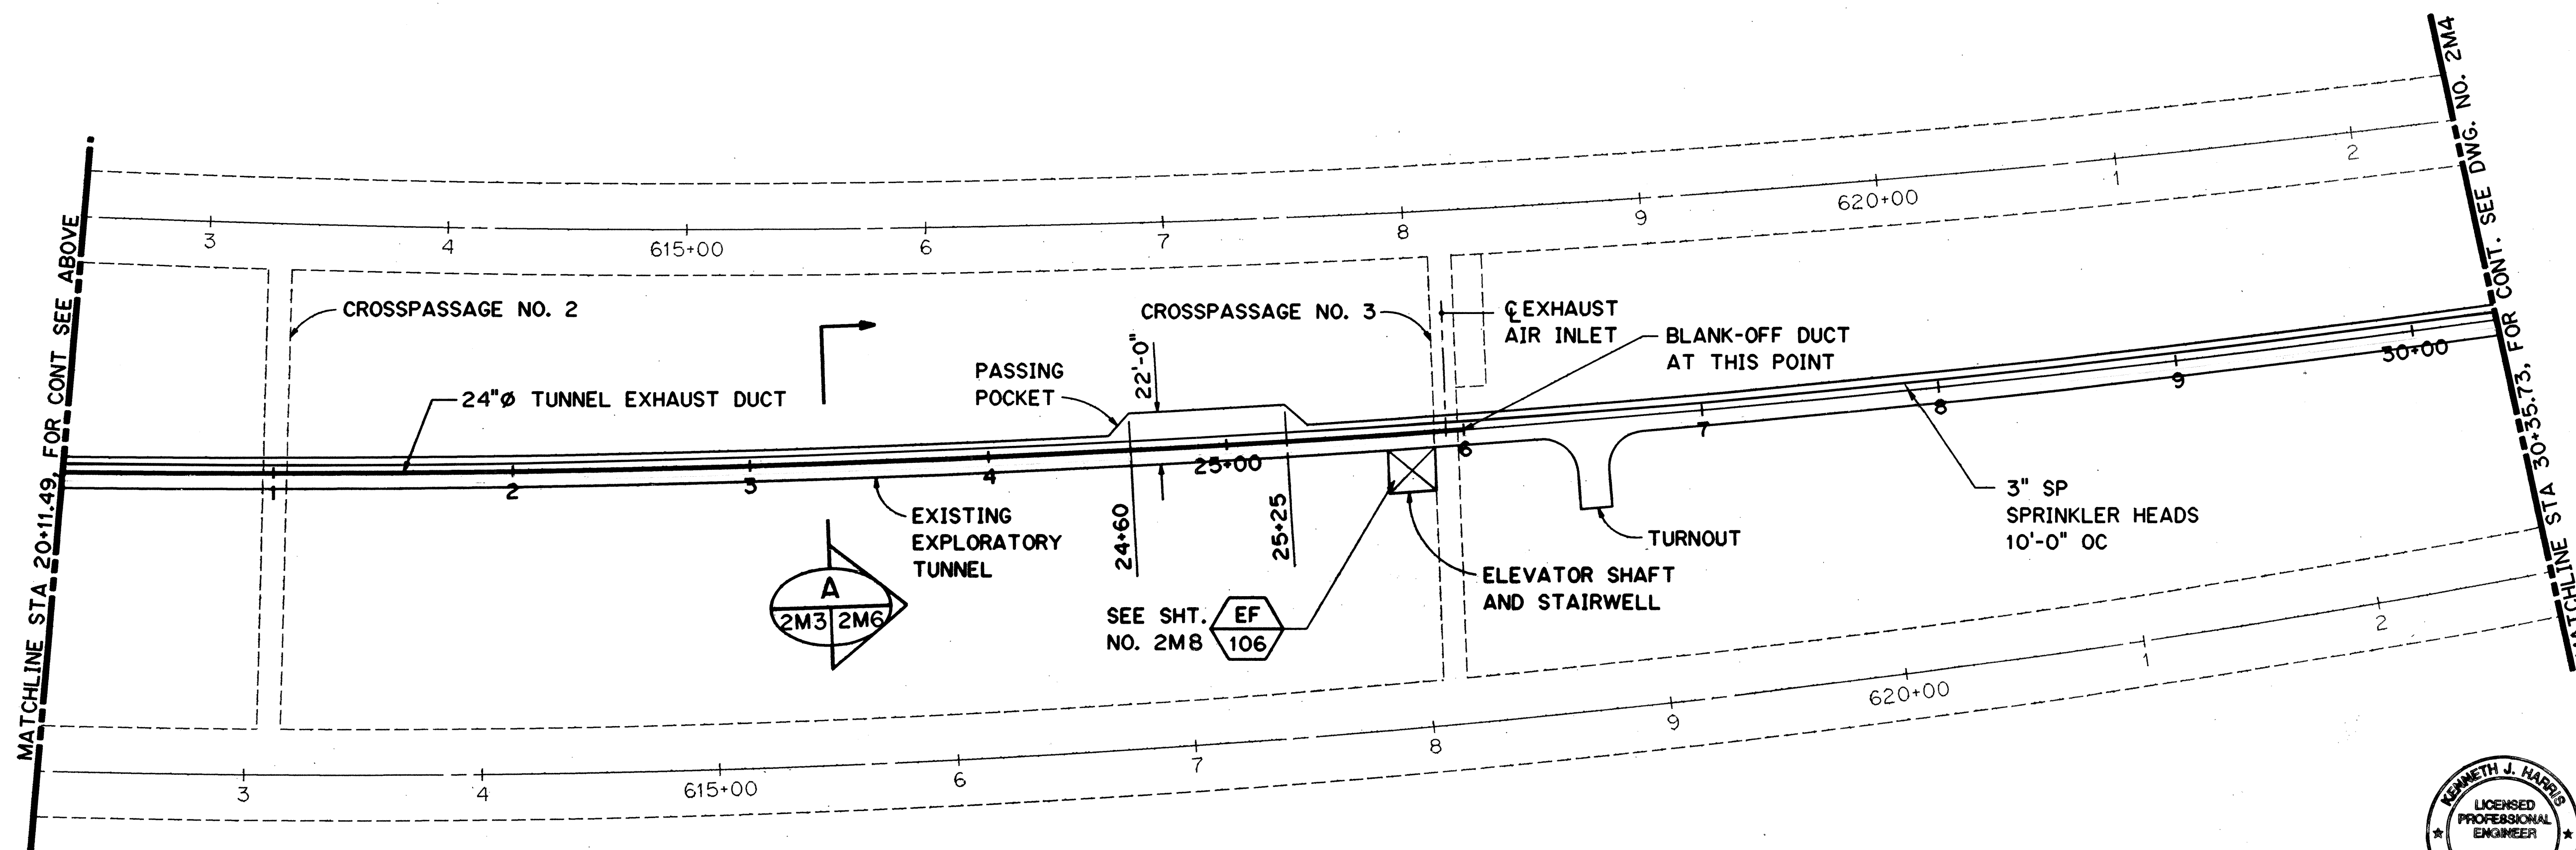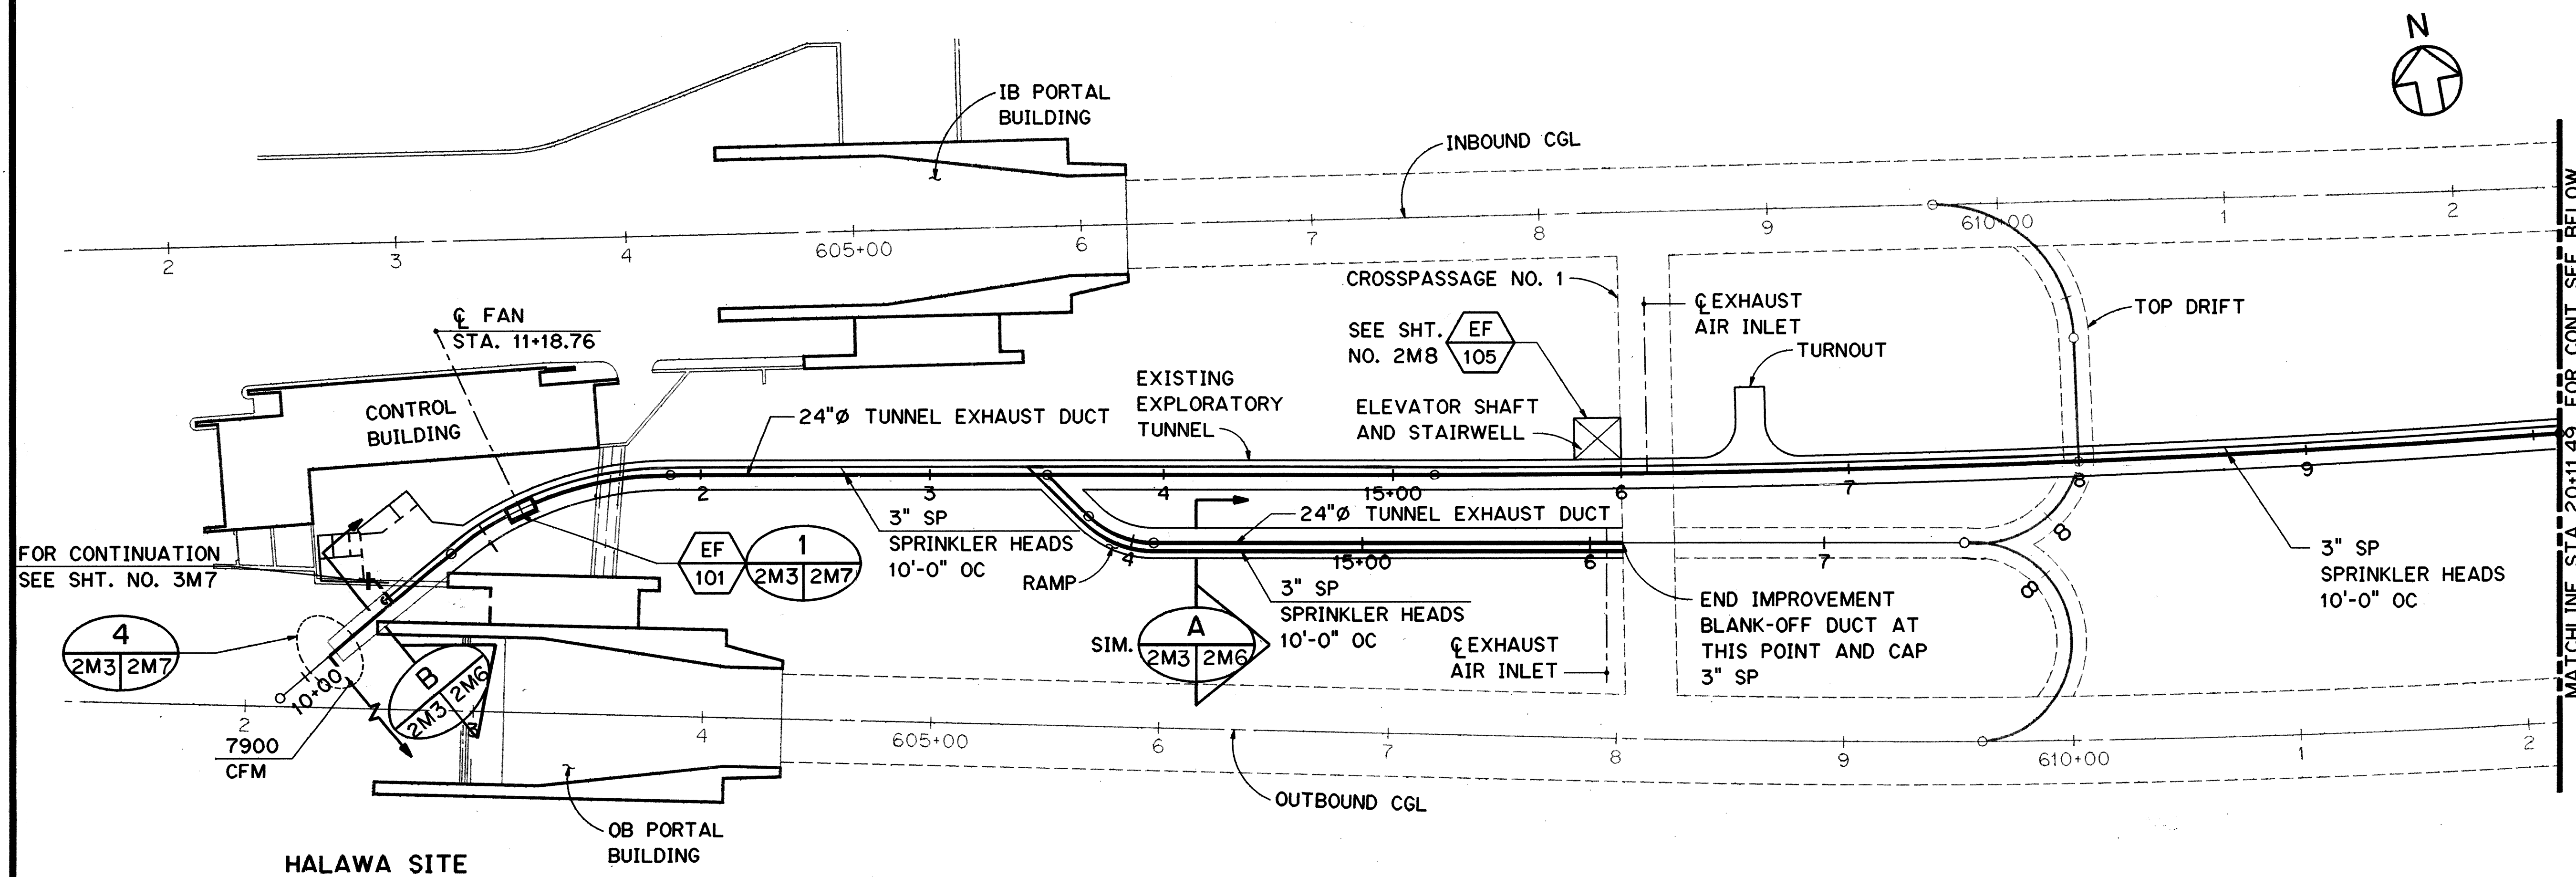


PARTIAL PLAN - EXPLORATORY TUNNEL

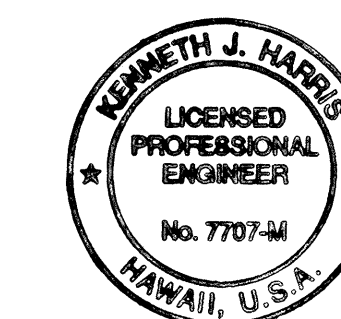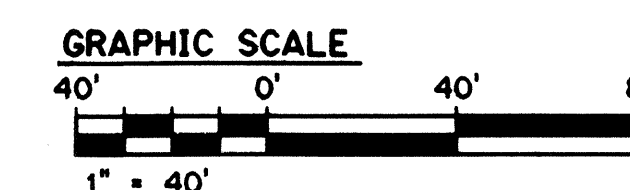

THIS WORK WAS PREPARED BY ME OR UNDER MY SUPERVISION

Kenneth J. Harris


10/13/95	ADDENDUM I
DATE	REVISION
STATE OF HAWAII DEPARTMENT OF TRANSPORTATION HIGHWAYS DIVISION	
VENTILATION AND PIPING PLAN - 1	
EXPLORATORY TUNNEL IMPROVEMENTS	
H-3 FINISH (UNIT III)	
FAIP NO. I-H3-1(75), UNIT III	
T.K. TUNNEL/ACCESS ROADS	
SCALE: 1" = 40'	DATE: JUN 1995
SHEET NO. 2M3	OF 8 SHEETS

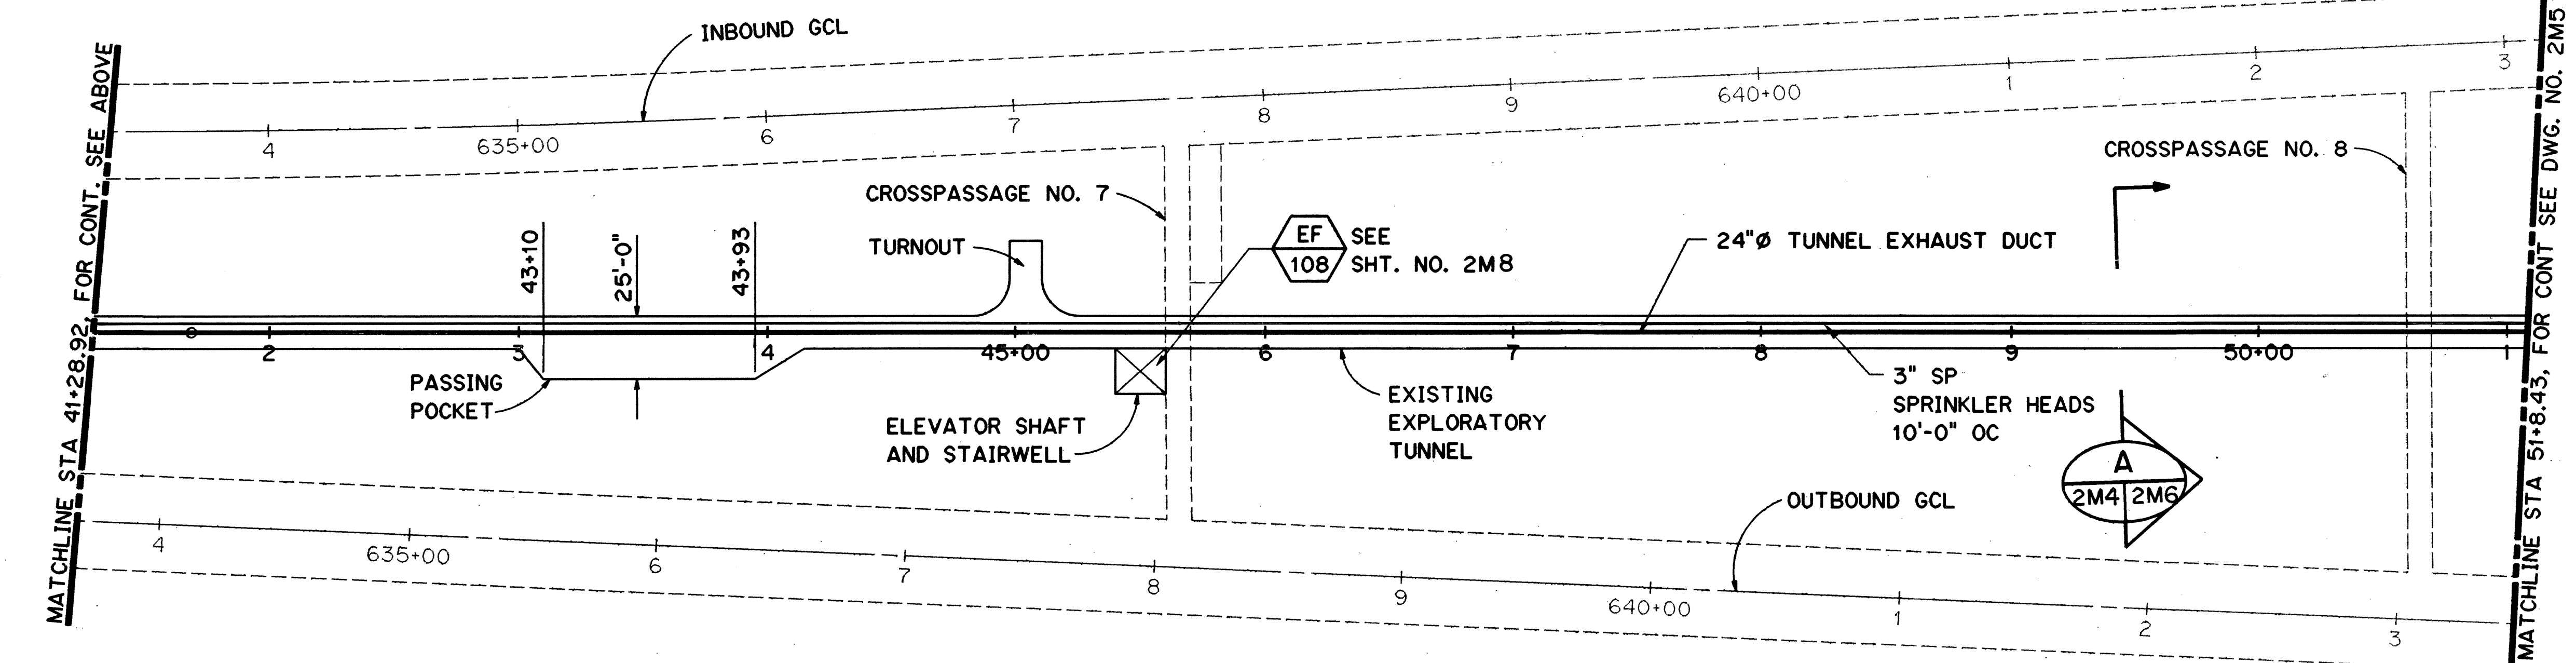

GRAPHIC SCALE

40' 0' 40' 80'

1" = 40'

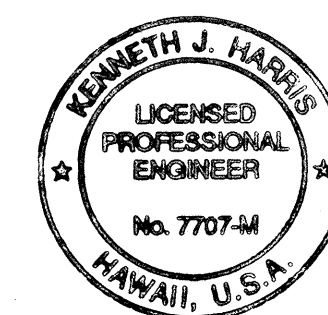

THIS WORK WAS PREPARED BY ME
OR UNDER MY SUPERVISION

Kenneth A. Hara


STATE OF HAWAII
DEPARTMENT OF TRANSPORTATION
HIGHWAYS DIVISION

VENTILATION AND
PIPING PLAN - 2

EXPLORATORY TUNNEL IMPROVEMENTS
H-3 FINISH (UNIT III)
FAIP NO. I-H3-1(75), UNIT III
T.K. TUNNEL/ACCESS ROADS

SCALE: 1" = 40' DATE: JUN 1995

SHEET NO. 2M4 OF 8 SHEETS

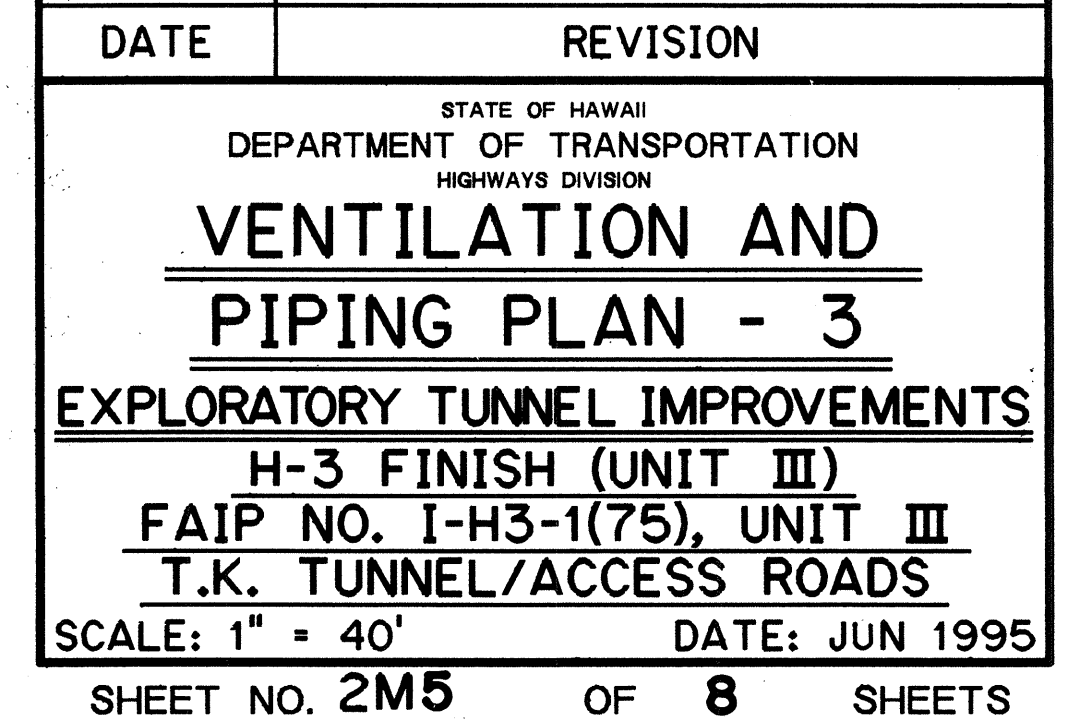


SECTION A

SCALE: 1" = 1'-0"

2M3
2M4
2M5

2M6

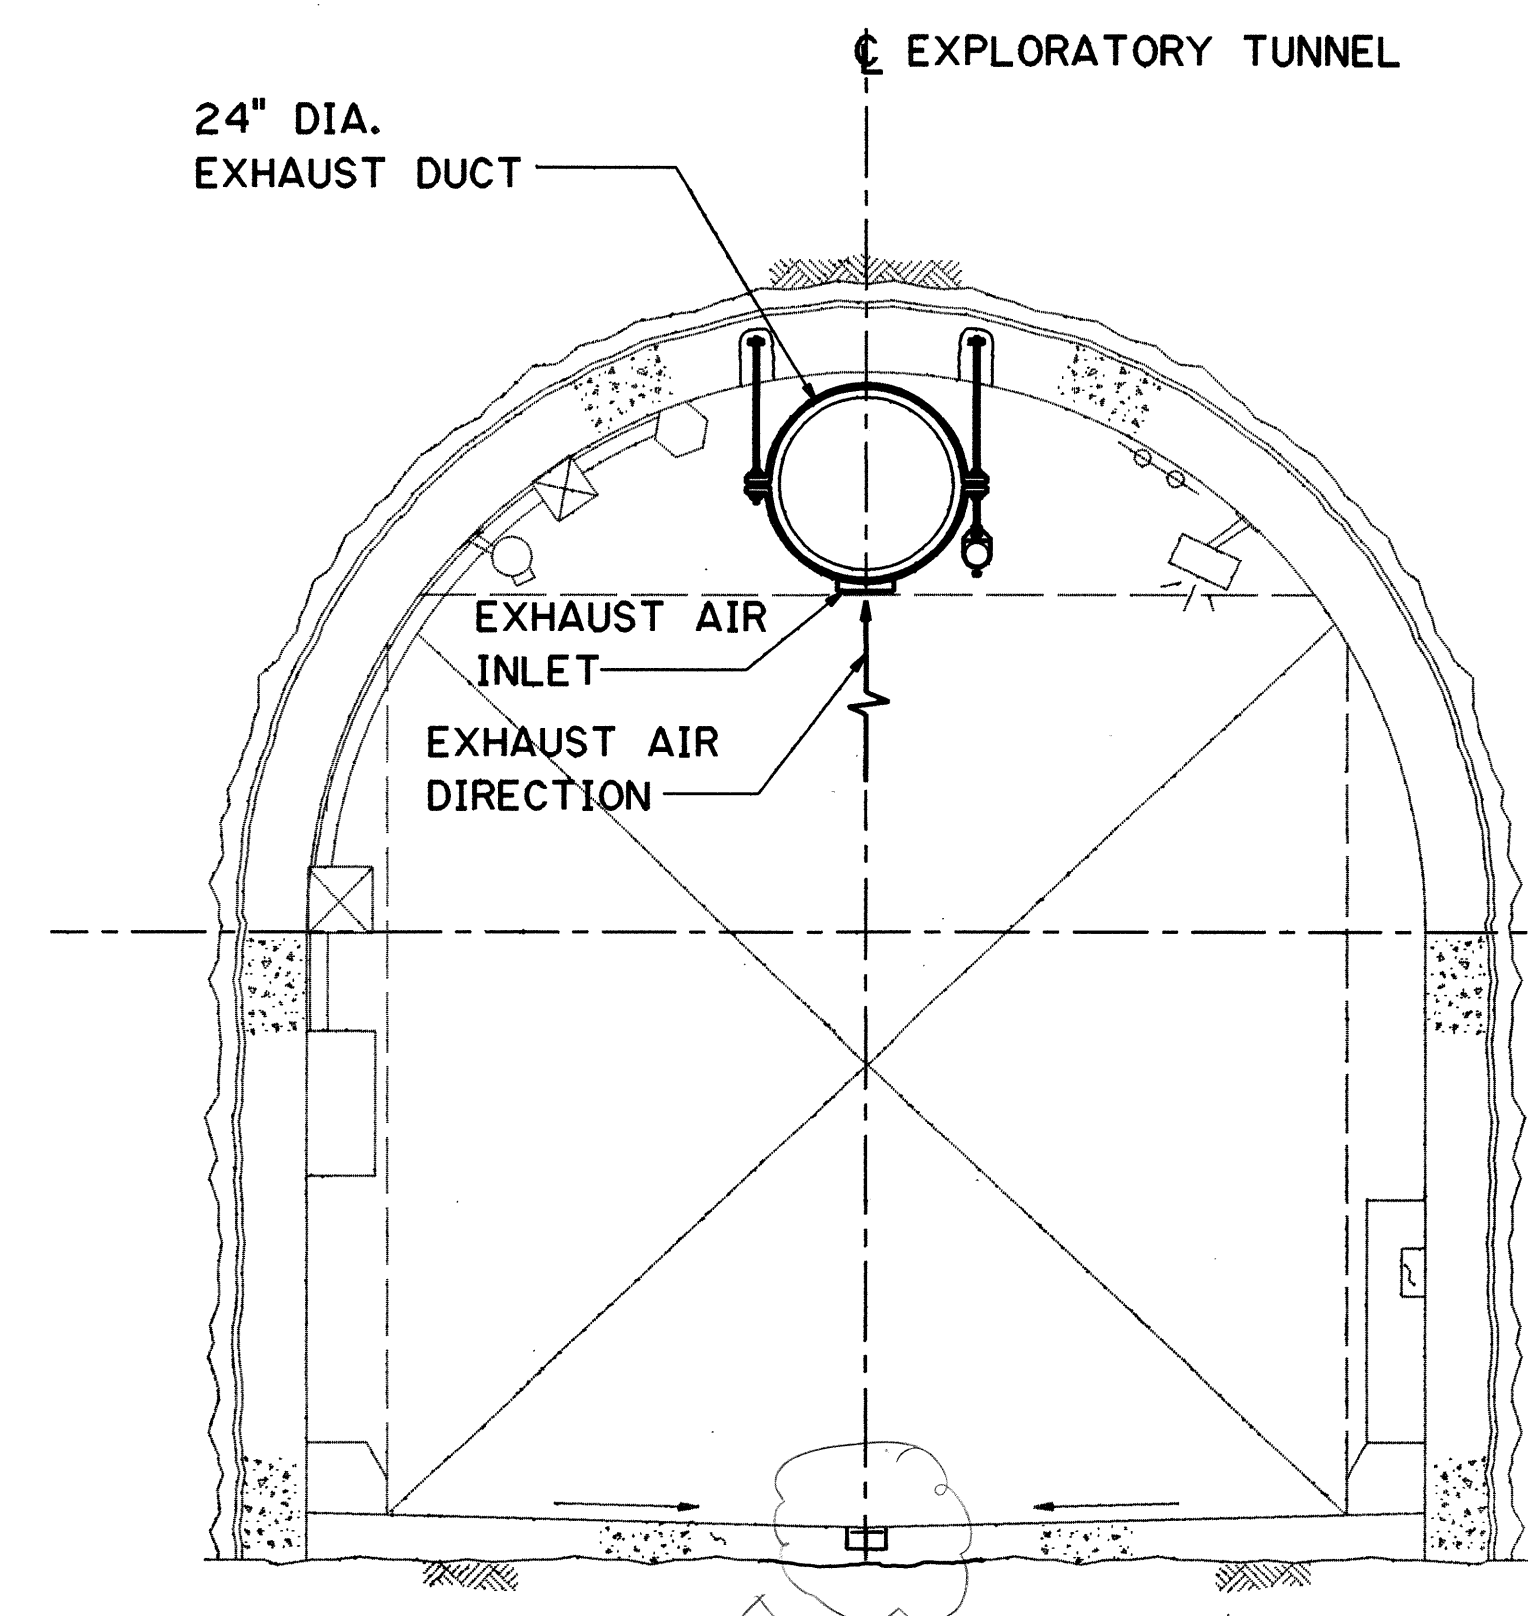

SECTION B
SCALE: 1/2" = 1'-0" 2M3 | 2M6

ORIG. MAP PLAN	SURVEY PLOTTED BY _____ DRAWN BY B. BUR/I FRACED BY _____ DESIGNED BY D. DYDDEN QUANTITIES BY _____ CHECKED BY K. HARRIS	DATE NOV 84 NOV 84 DEC 94
NO.		

9/ 3 /96	DCN75-007-REV. ET DRAIN
10/13/95	ADDENDUM I
DATE	REVISION

STATE OF HAWAII
DEPARTMENT OF TRANSPORTATION
HIGHWAYS DIVISION



VENTILATION AND
PIPING SECTIONS

EXPLORATORY TUNNEL IMPROVEMENTS

H-3 FINISH (UNIT III)
FAIP NO. I-H3-1(75), UNIT III
T.K. TUNNEL/ACCESS ROADS

SCALE: AS NOTED DATE: JUN 1995

SHEET NO. 2M6 OF 8 SHEETS

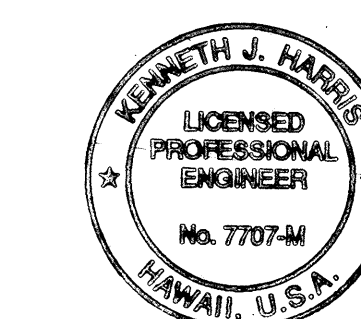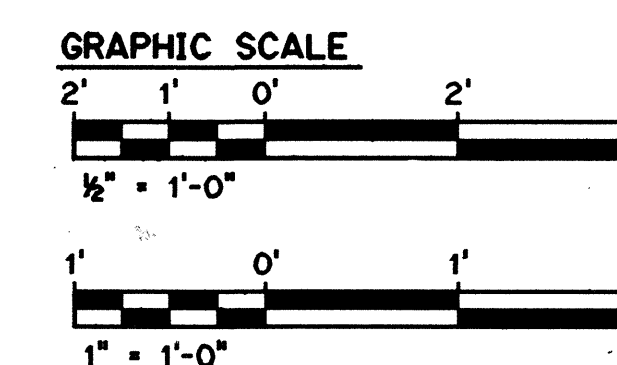


THIS WORK WAS PREPARED BY
OR UNDER MY SUPERVISION

Kenneth A. Acosta


FED. ROAD DIST. NO.	STATE	FED. AID PROJ. NO.	FISCAL YEAR	SHEET NO.	TOTAL SHEETS
HAWAII	HAW.	1-H3-1(75) UNIT III	1994	71	353

NOTES


- FAN MOTOR MAY BE MOUNTED ON EITHER SIDE OF FAN ON HORIZONTAL AXIS.
- VERIFY ALL DIMENIONS WITH FAN MANUFACTURER PRIOR TO FABRICATION.
- FOR DUCT SUPPORT DETAILS SEE SHT. NO. 3M9.

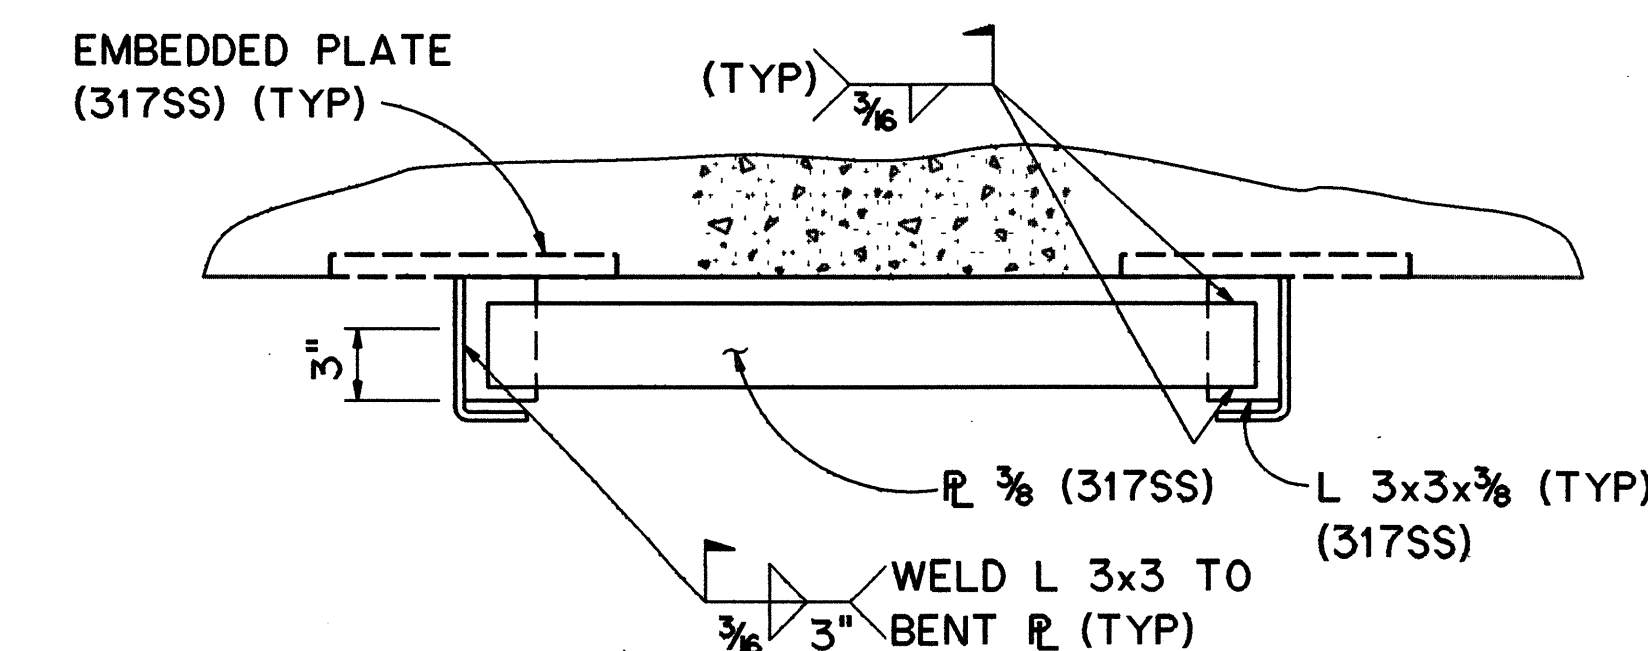


DETAIL 2

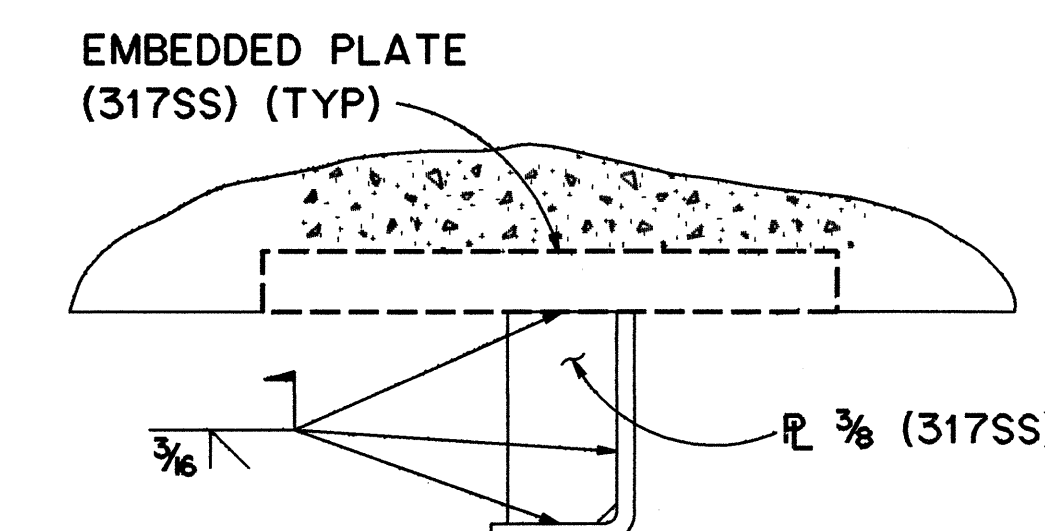


DETAIL 3

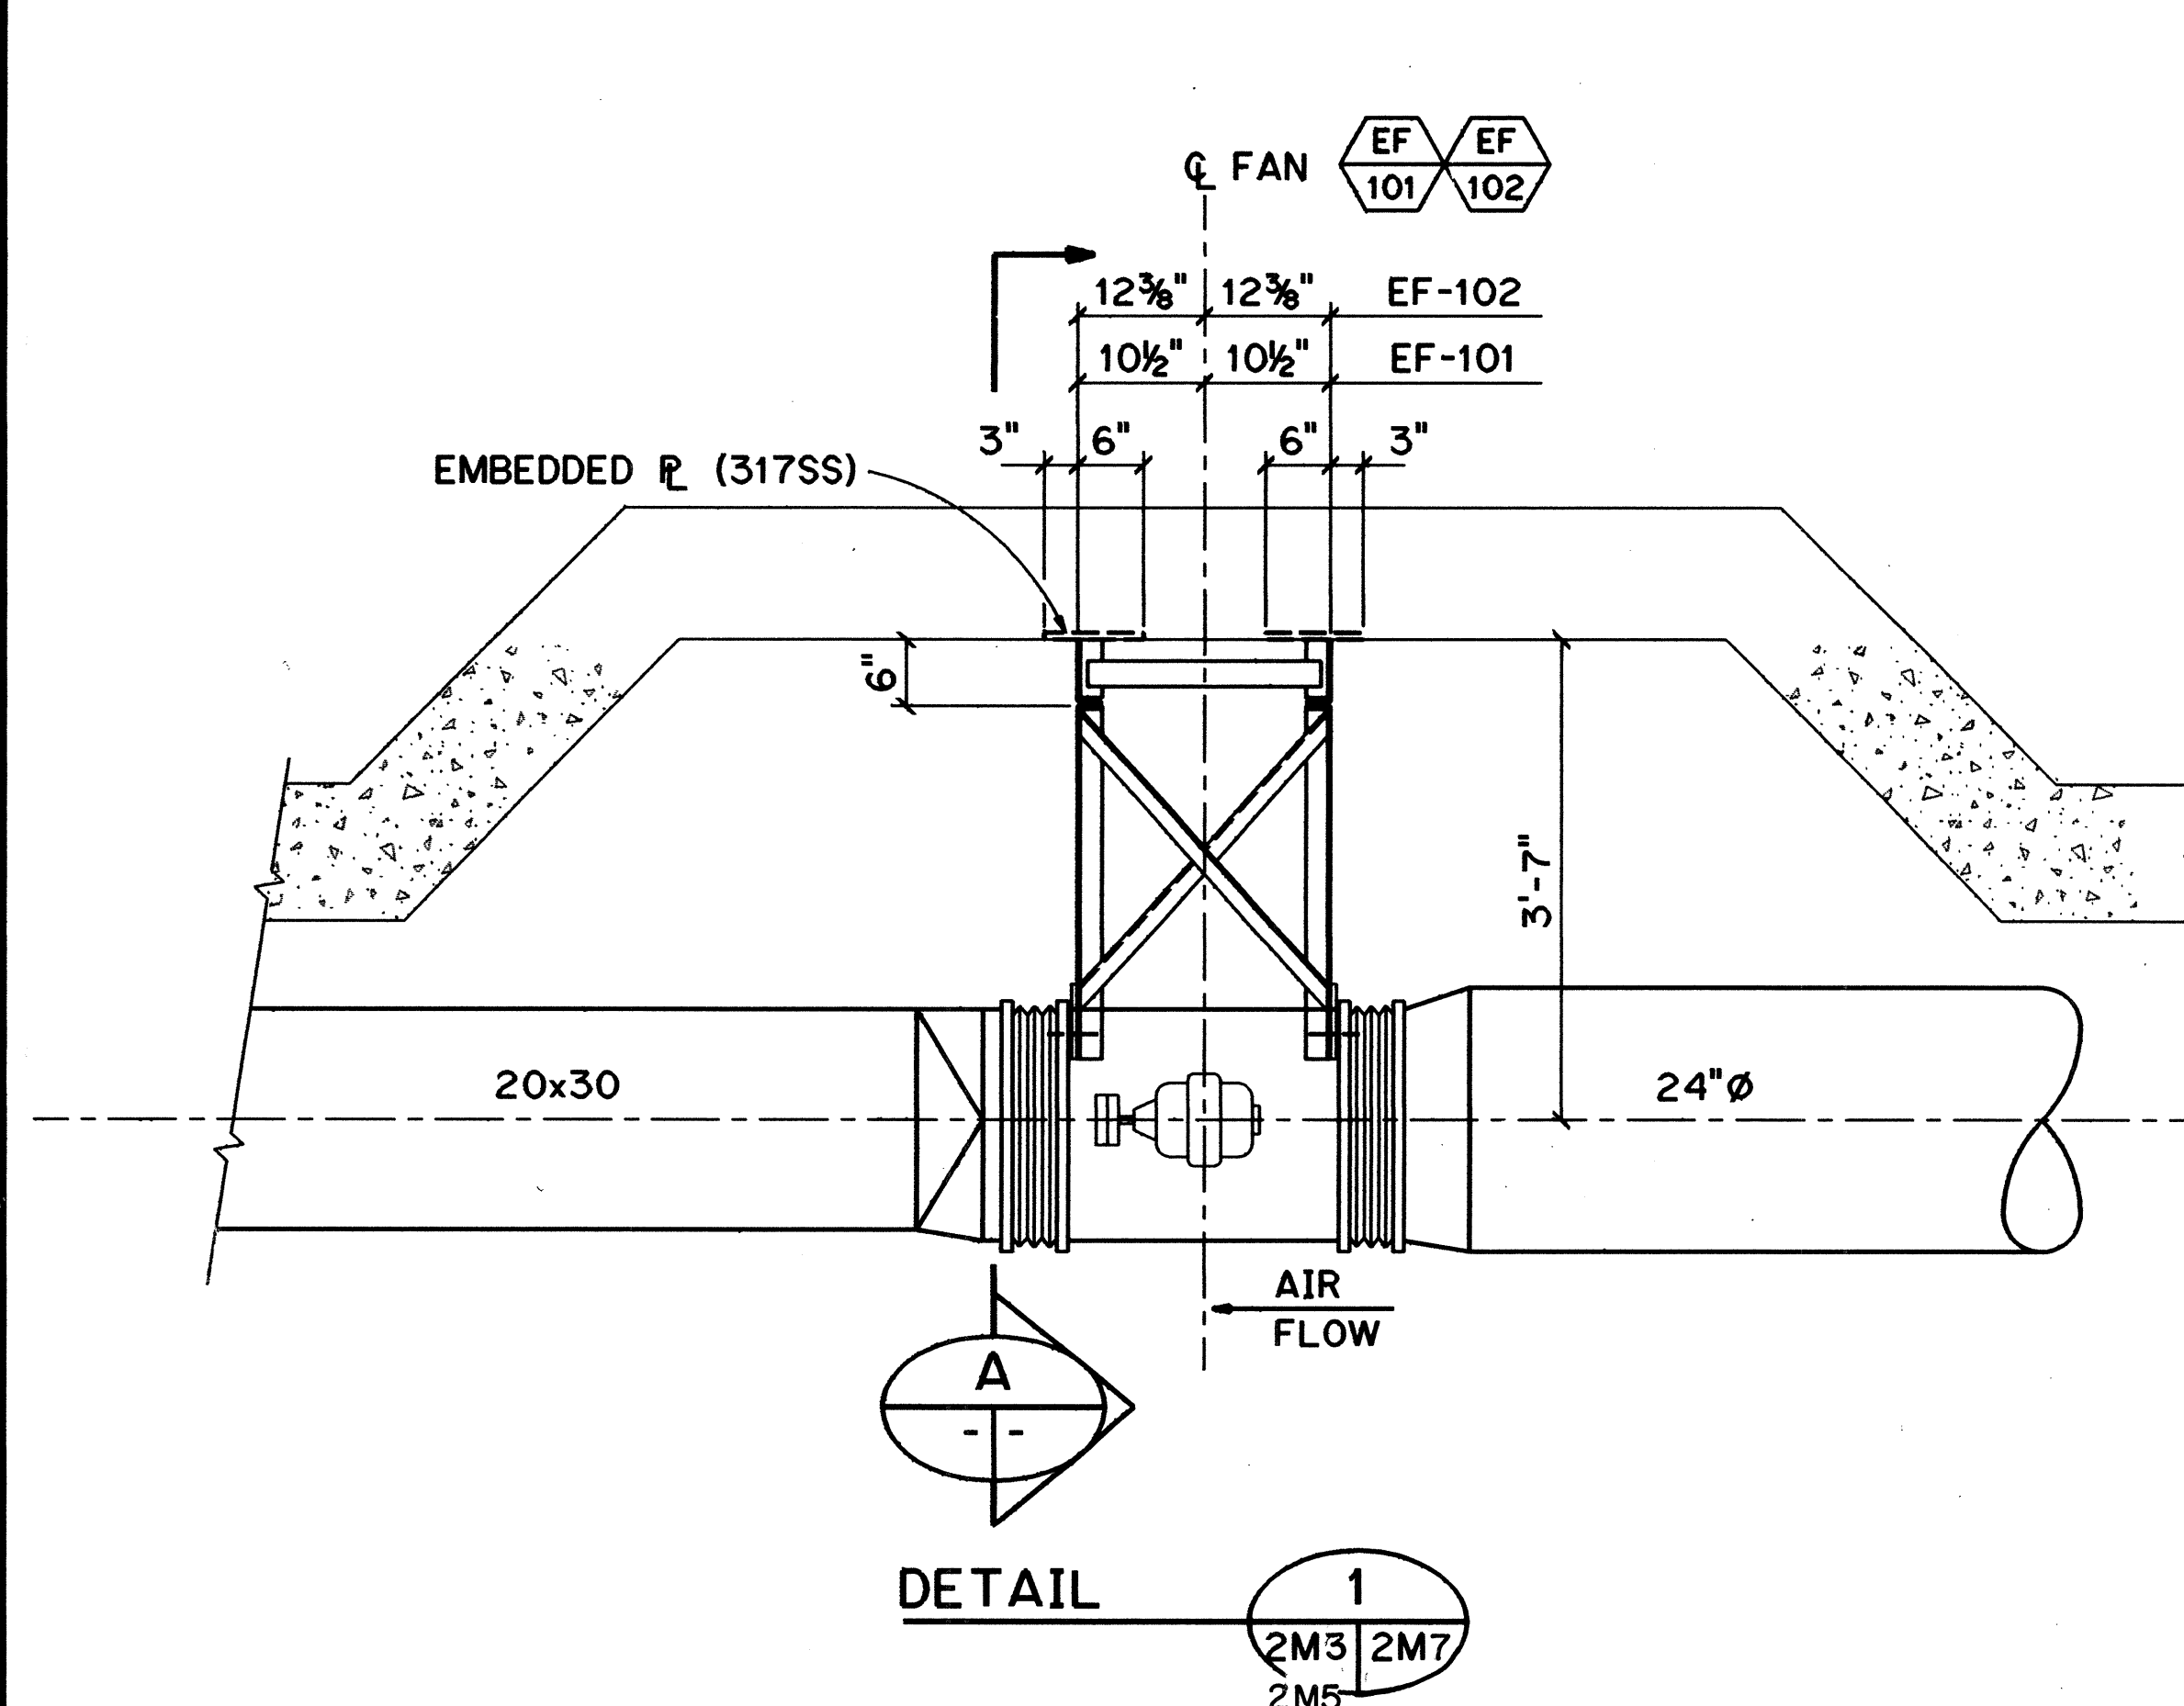


DETAIL 1

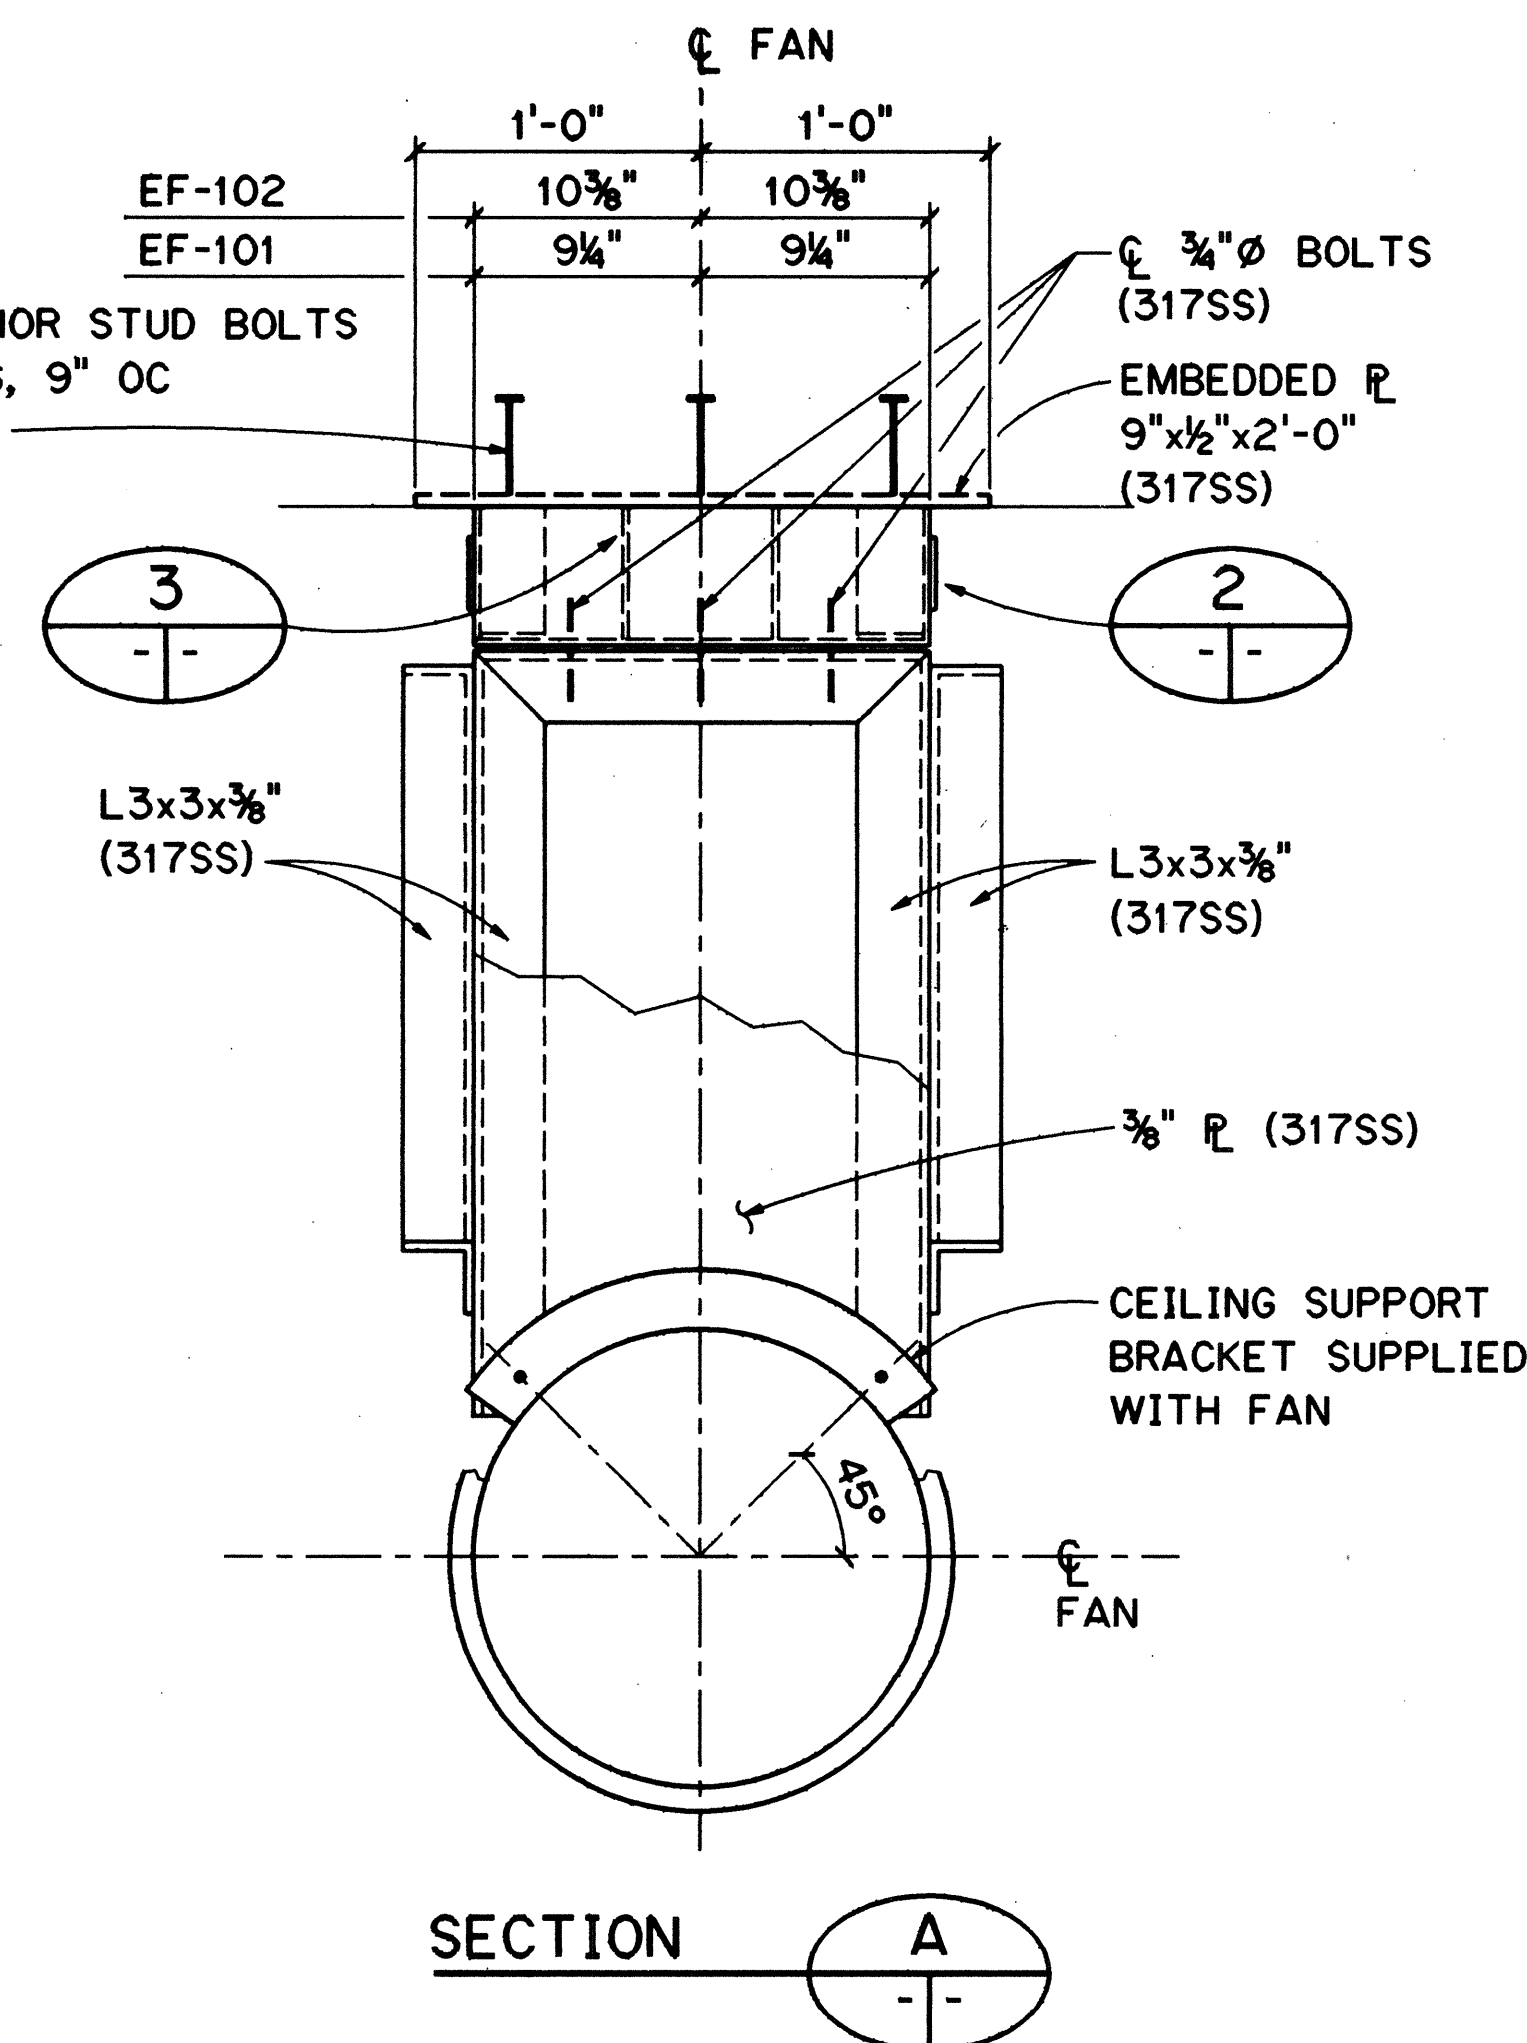

SECTION A

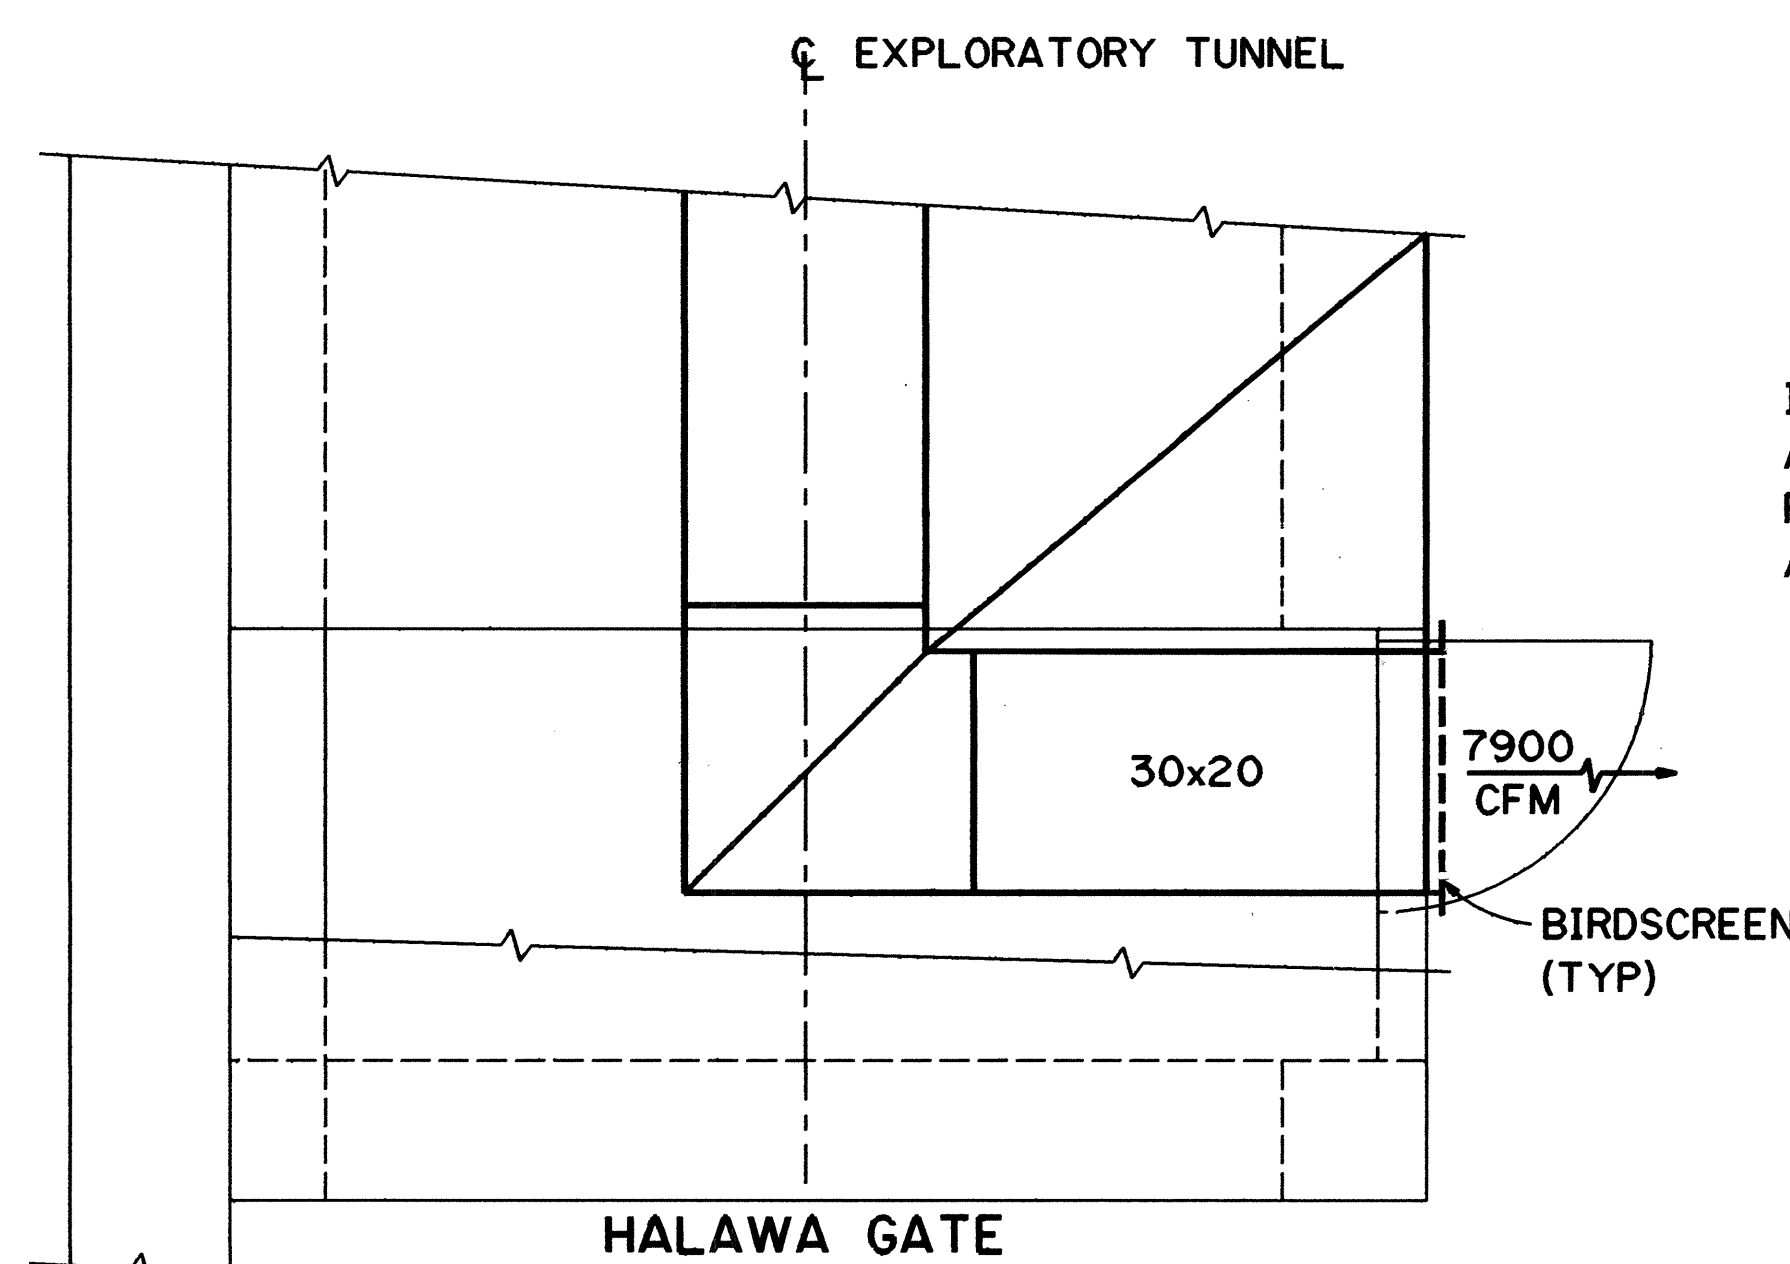


DETAIL 4

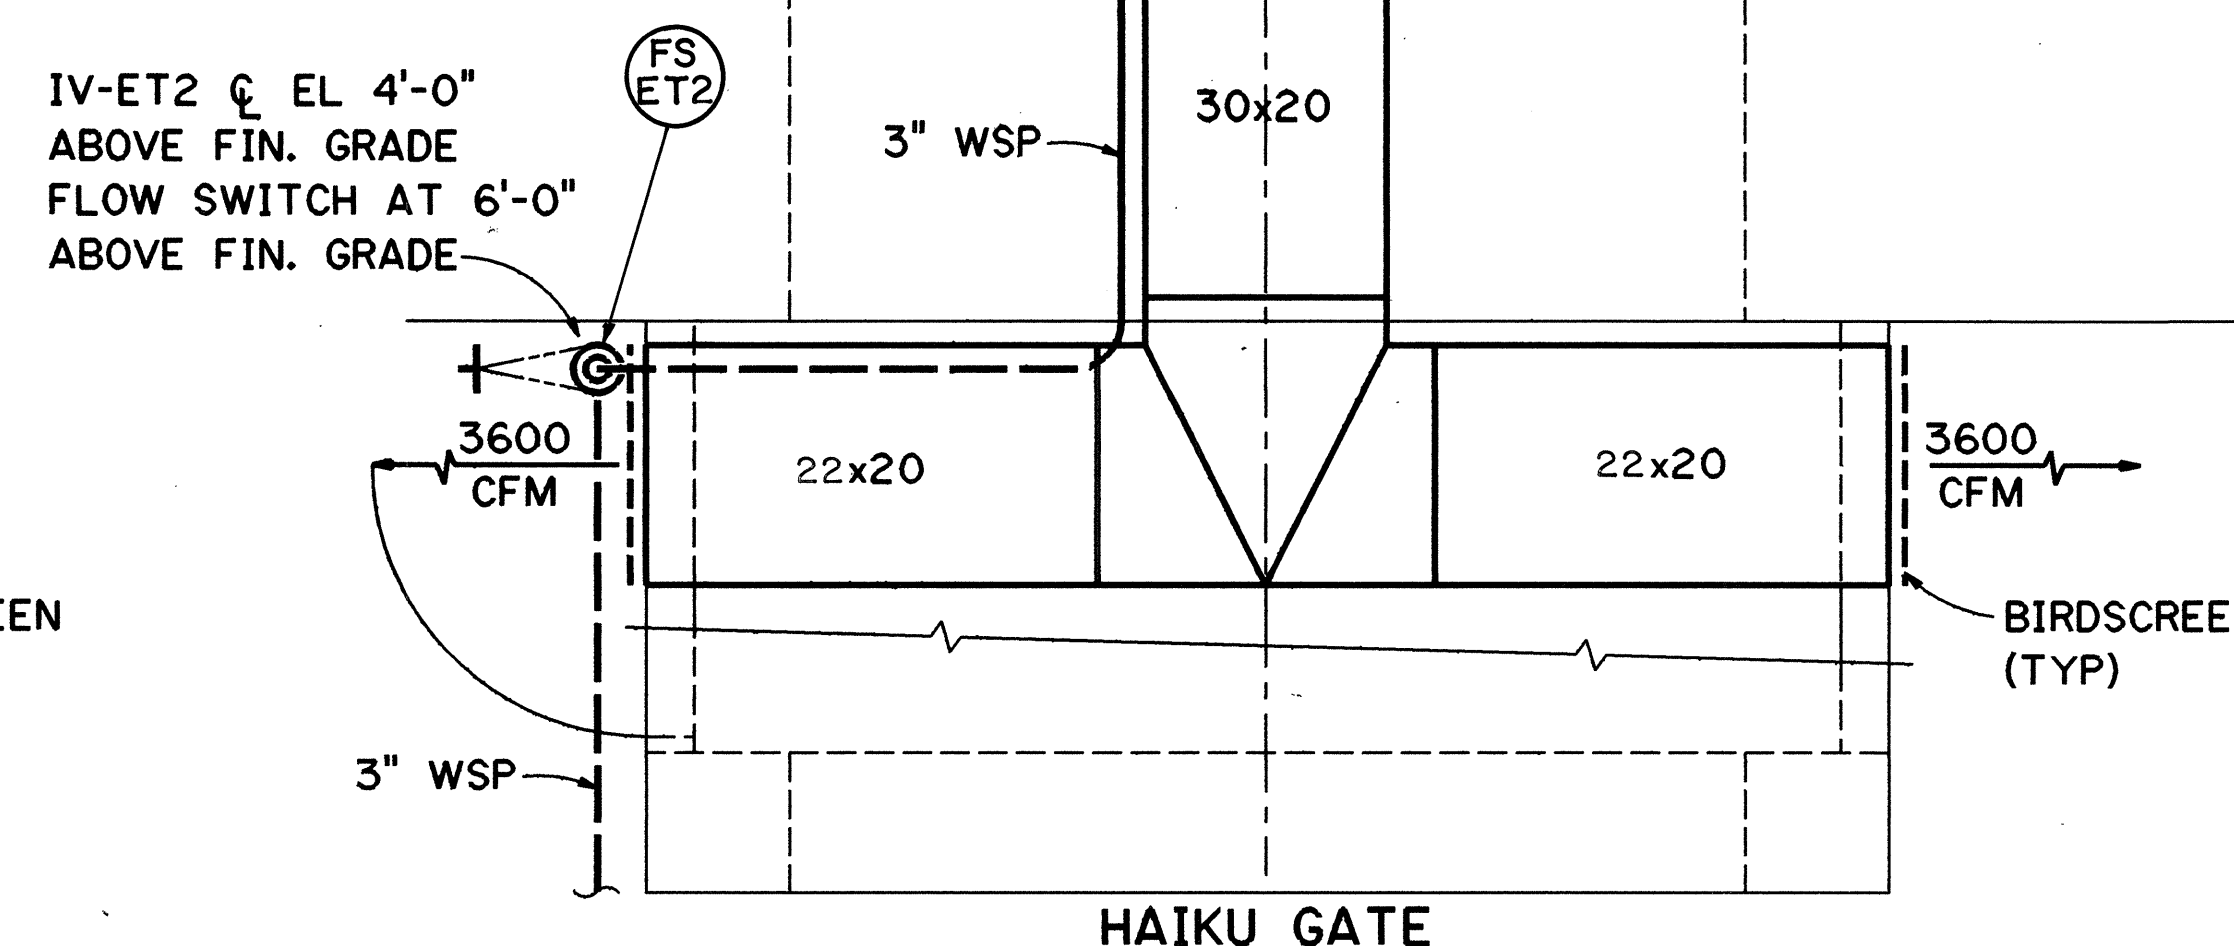

DETAIL 5

ORIGINAL PLAN	NOV 94
NOTE BOOK	OCT 94
NO.	JAN 95

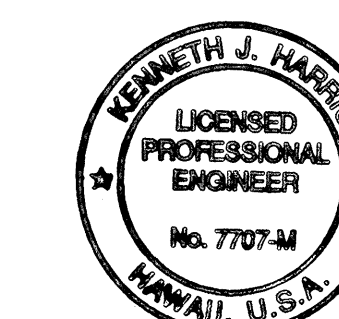


THIS WORK WAS PREPARED BY ME OR UNDER MY SUPERVISION

Kenneth J. Harris

10/13/95	ADDENDUM I
DATE	REVISION
STATE OF HAWAII DEPARTMENT OF TRANSPORTATION HIGHWAYS DIVISION	
VENTILATION AND PIPING DETAILS	
EXPLORATORY TUNNEL IMPROVEMENTS	
H-3 FINISH (UNIT III)	
FAIP NO. I-H3-1(75), UNIT III	
T.K. TUNNEL/ACCESS ROADS	
SCALE: NONE	DATE: JUN 1995
SHEET NO. 2M7	OF 8 SHEETS

ADD. 71

ORIGINAL PLAN	SURVEY PLOTTED BY	DATE
	DRAWN BY	
	TRACED BY	
	DESIGNED BY	
	QUANTITIES BY	
	CHECKED BY	
NO.		

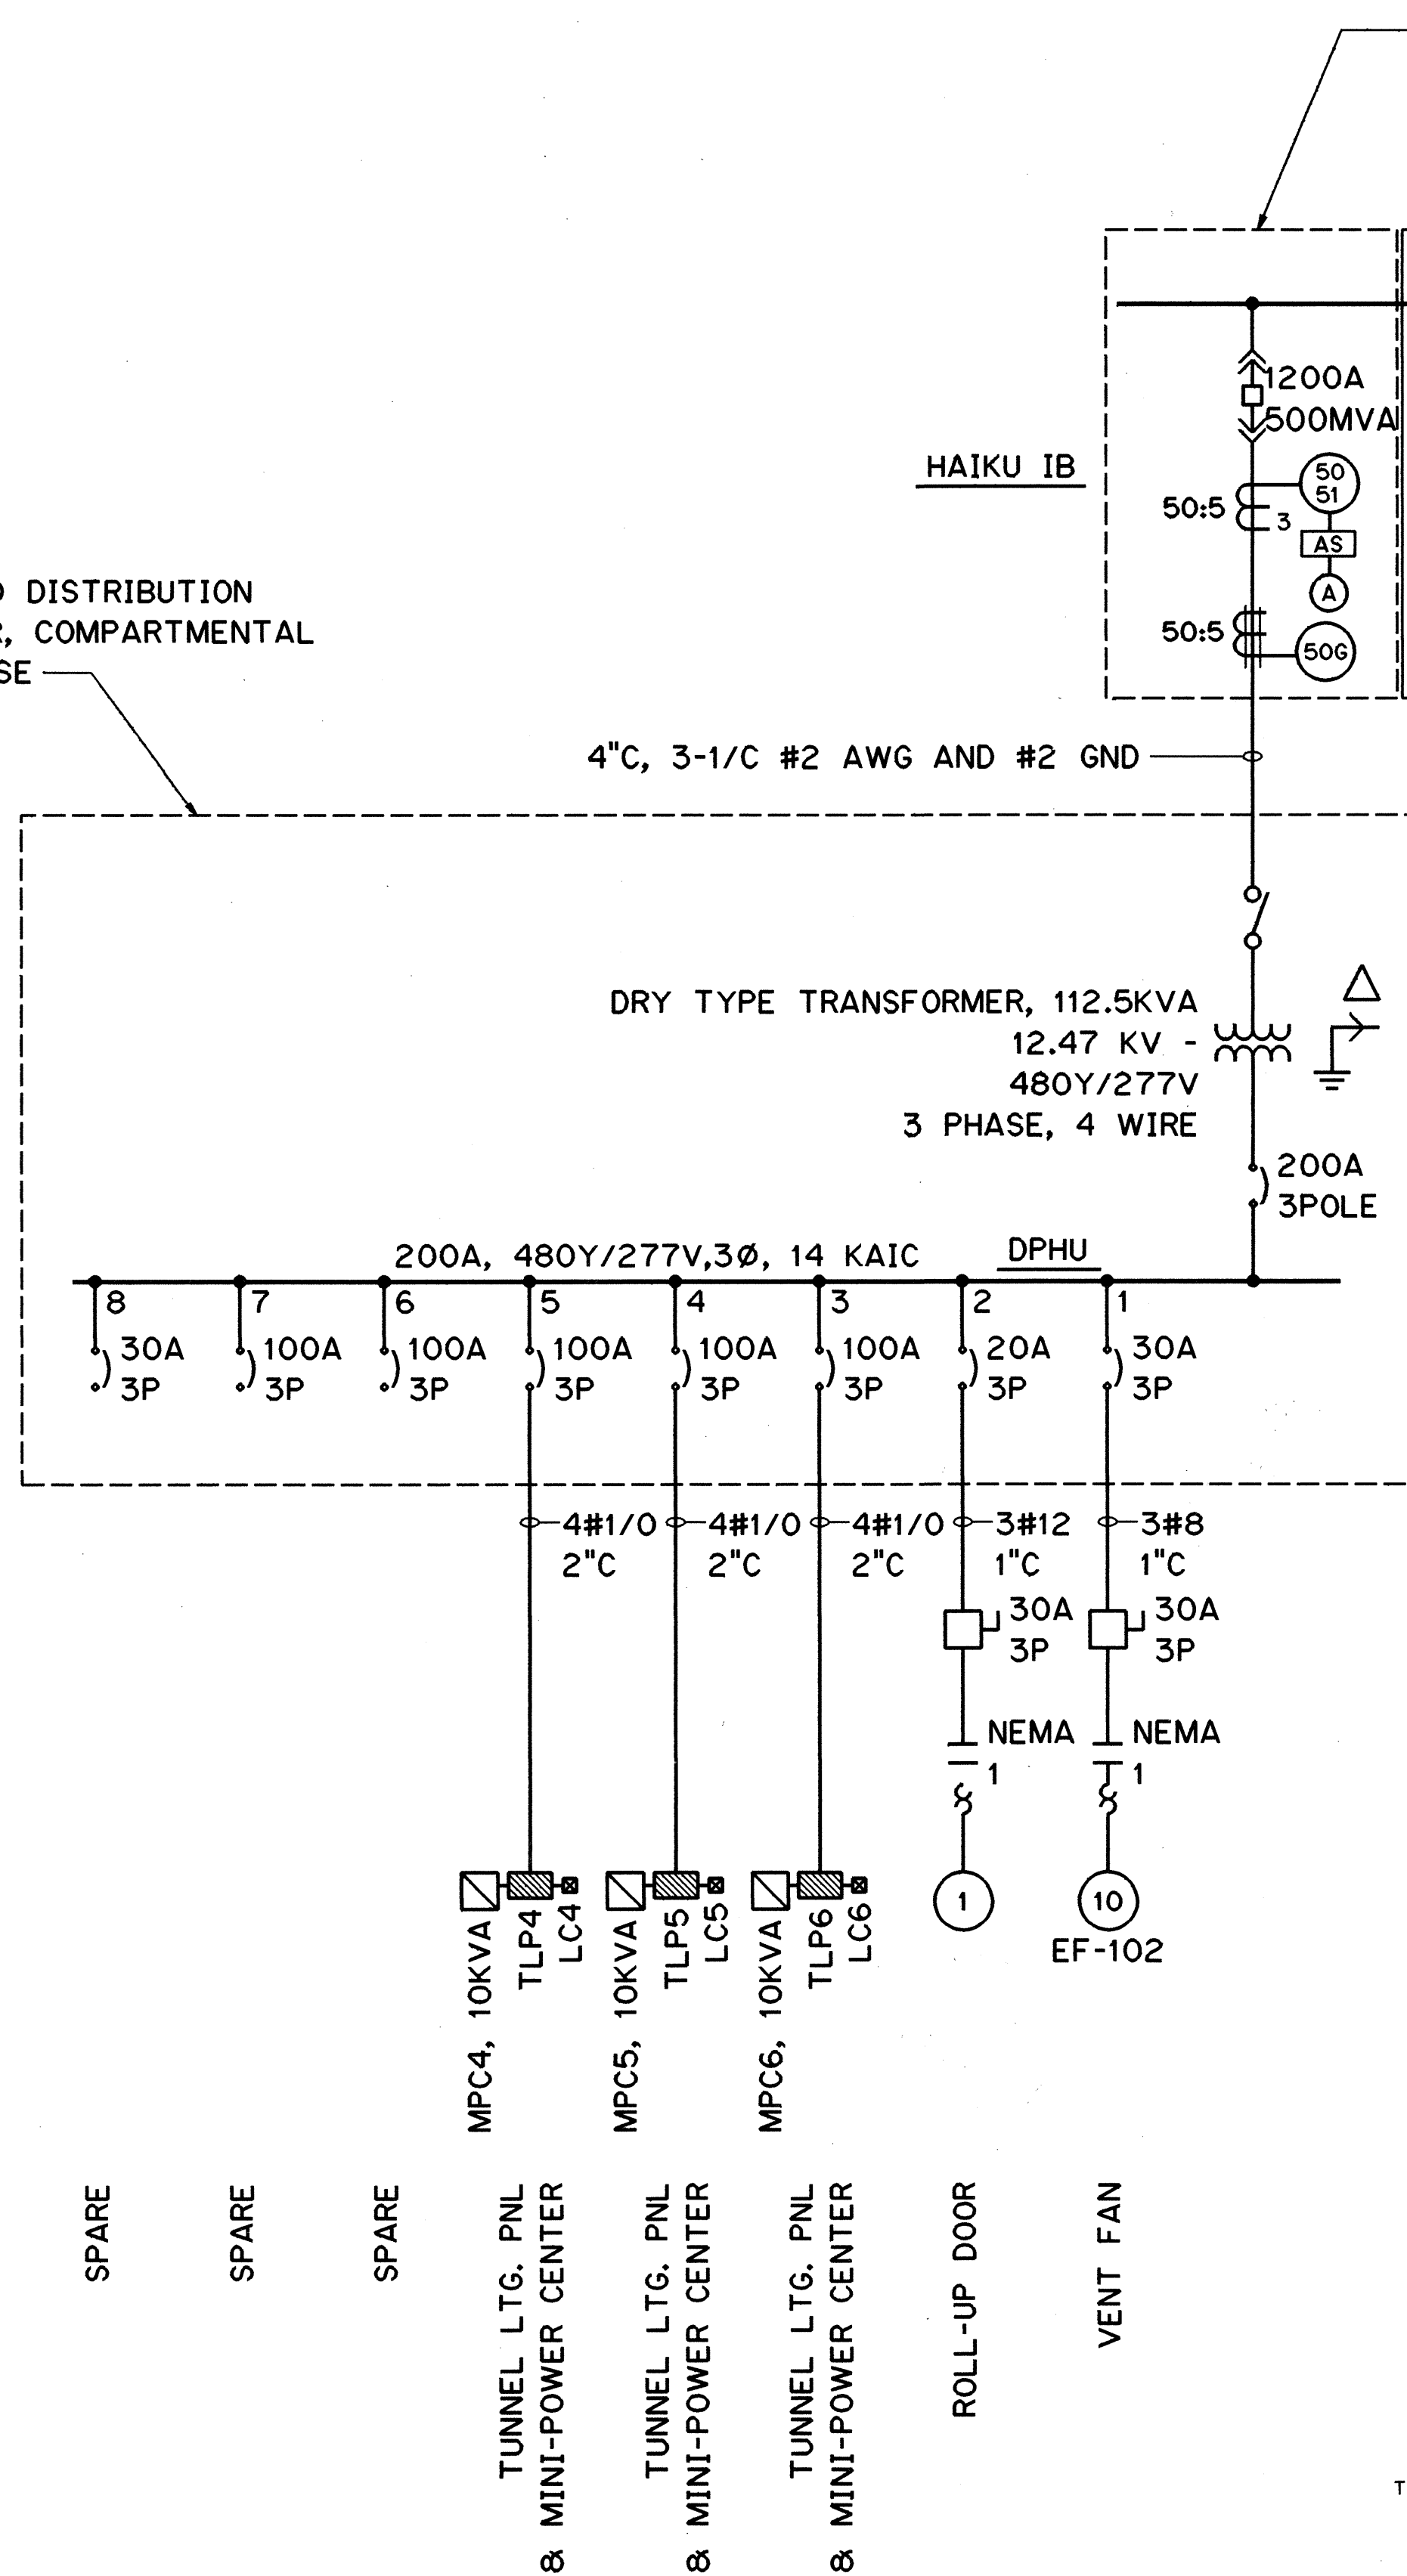

1. FOR HALAWA IB EXISTING AND NEW 12.47KV FEEDER CONDUIT ROUTING, REFER TO SHEET NOS. 2E8 THROUGH 2E13.
2. FOR HAIKU IB EXISTING AND NEW 12.47KV FEEDER CONDUIT ROUTING, LOCATION OF NEW PAD MOUNTED TRANSFORMER, REFER TO SHEET NOS. 2E14 THROUGH 2E19.
3. PROVIDE GROUND CONDUCTORS FOR ALL FEEDERS AND BRANCH CONDUITS. CONDUCTOR SIZES AS PER NEC.
4. REFER TO SHEET NOS. 2E24, 2E25, 2E26 AND 2E27 FOR TUNNEL PANEL SCHEDULES. REFER TO SHEET NO. 3E11 FOR PANEL CBAHP AND CBALP PANEL SCHEDULE.
5. CONTRACTOR SHALL NOTIFY THE ENGINEER IN CHARGE 48 HOURS IN ADVANCE OF ALL POWER SHUTDOWNS.

[illegible]

THIS WORK WAS PREPARED BY
OR UNDER MY SUPERVISION



Keene Matsuda

FED. ROAD DIST. NO.	STATE	FED. AID PROJ. NO.	FISCAL YEAR	SHEET NO.	TOTAL SHEETS
HAWAII	HAW.	1-H3-1(75) UNIT III	1994	74	353



PLAN SYMBOLS

(TYP. FOR SHEET NOS 2E3, 2E4 & 2E5 ONLY)

-  SURFACE-MOUNTED FLUORESCENT FIXTURE
-  SURFACE-MOUNTED FLUORESCENT FIXTURE EMERGENCY/NORMAL

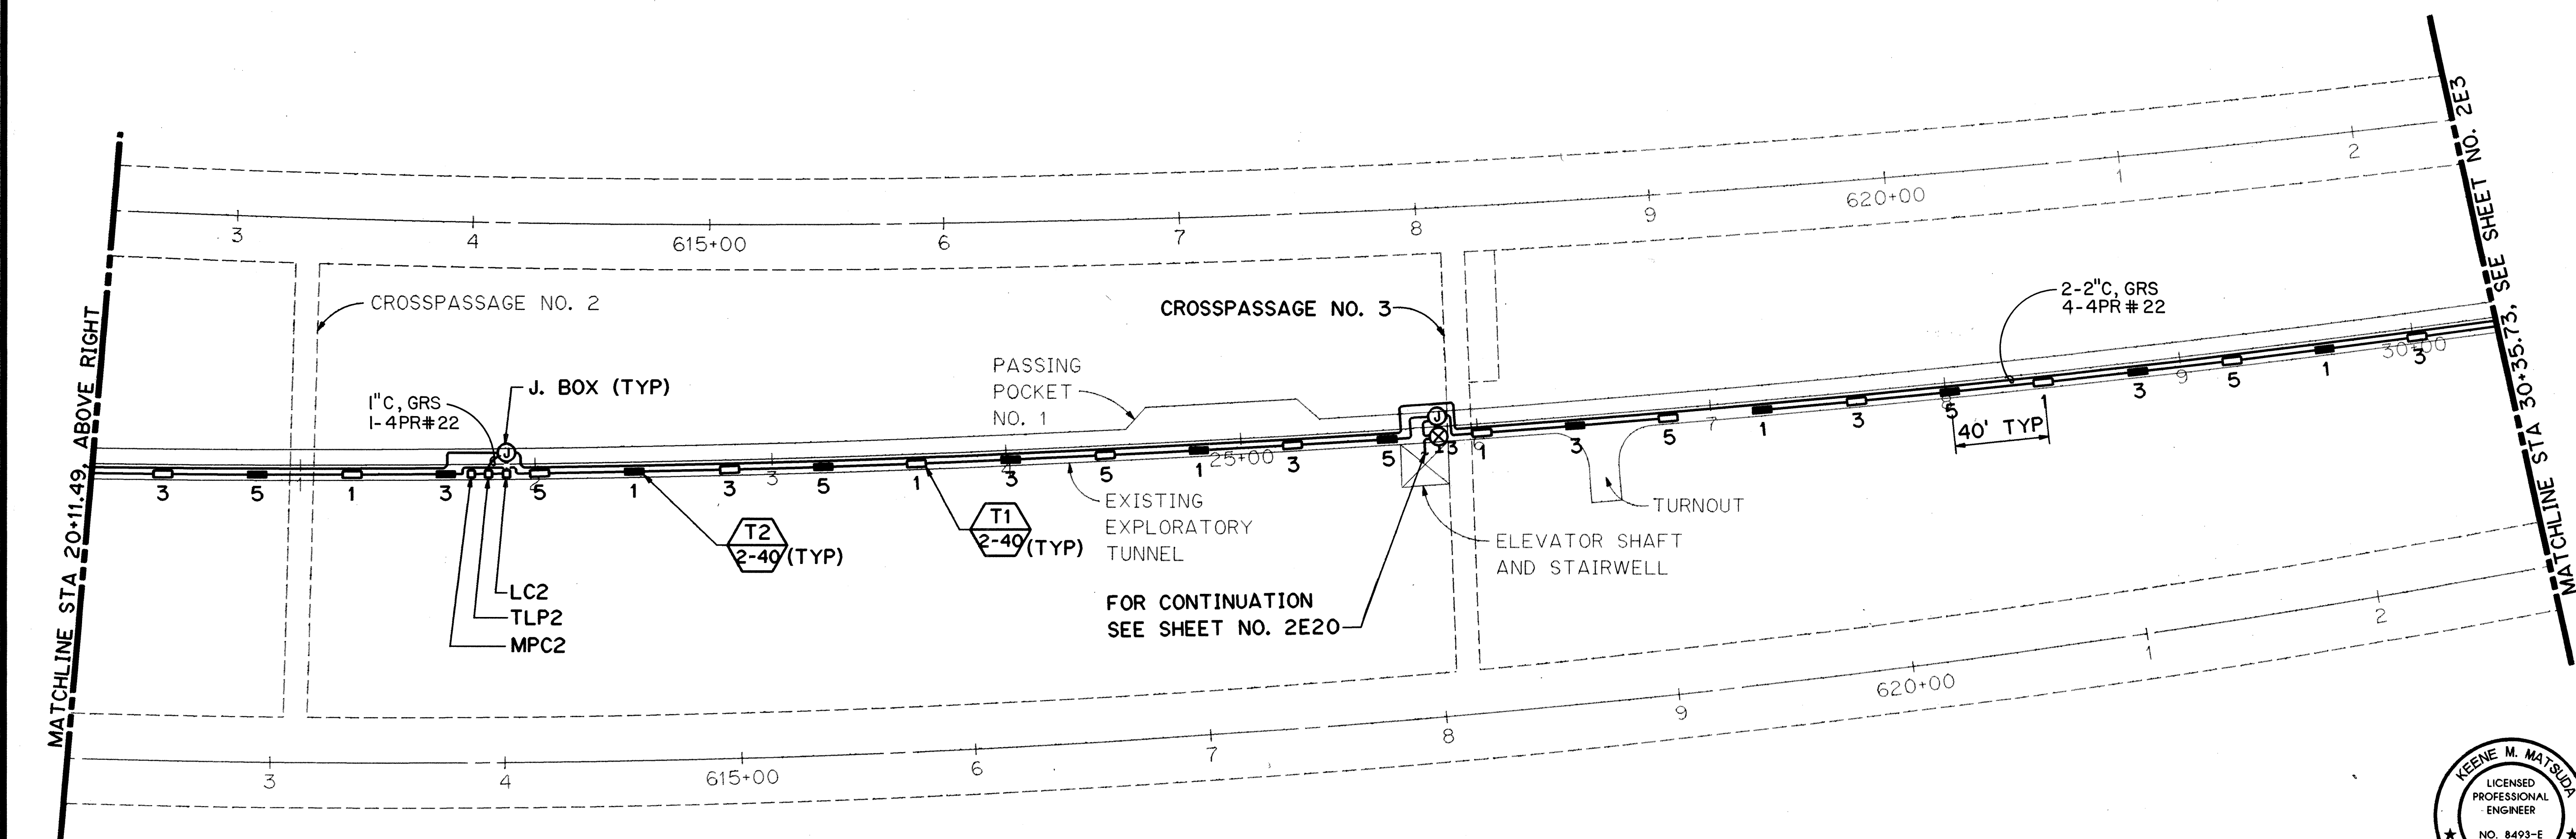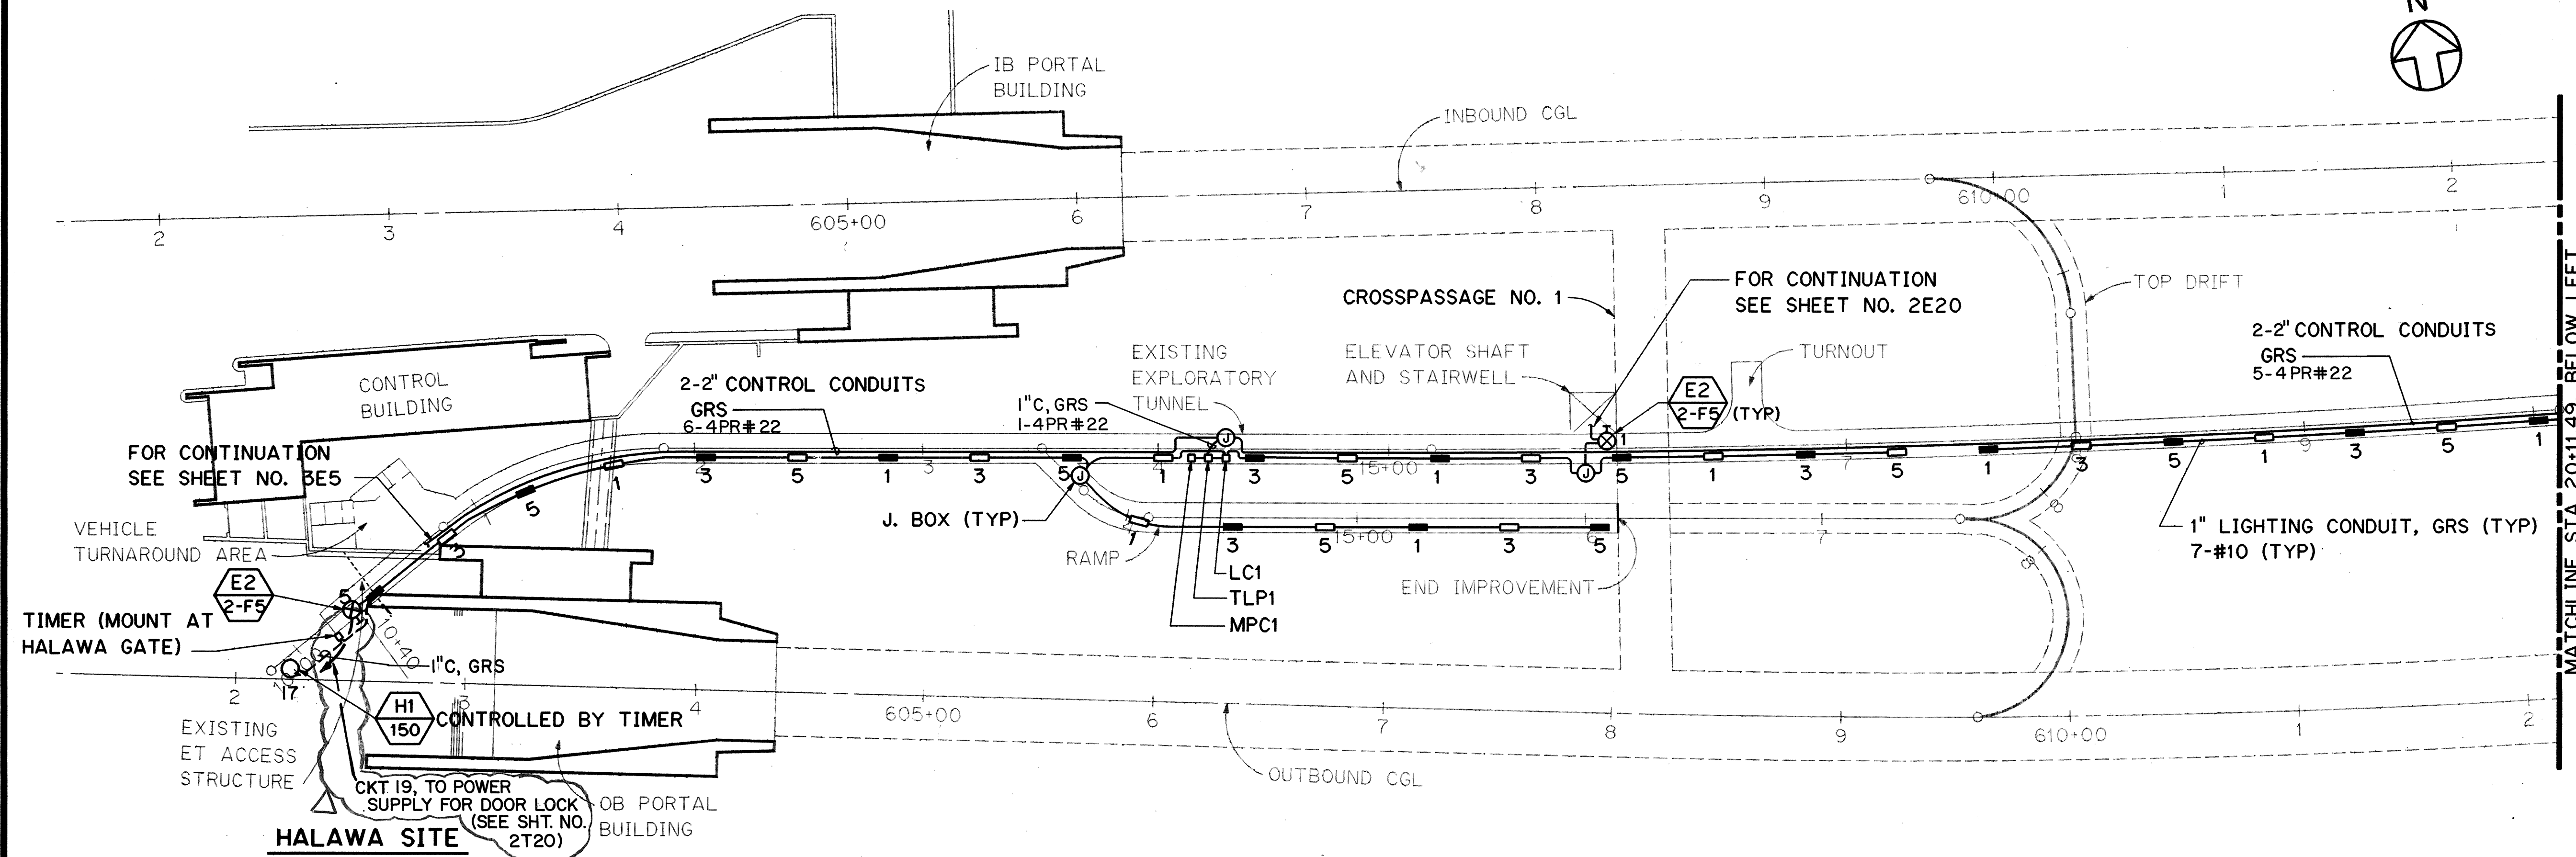

PARTIAL PLAN - EXPLORATORY TUNNEL

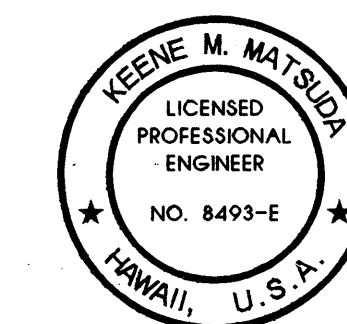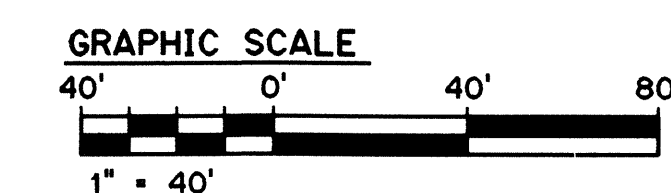

THIS WORK WAS PREPARED BY ME
OR UNDER MY SUPERVISION
Keene Matsuda

FOR DETAIL AS-BUILT INFORMATION
REFER TO CONSTRUCTION SUBMITTALS



5/29/97	DCN 75-019: ADDED CIRCUIT FOR HALAWA PORTAL DOOR LOCK POWER
10/27/95	ADDENDUM 2-DELETED CONTROL CONDUIT CONN. AT CP 1&3, ADDED LTG. CONTROL WIRE SIZE
10/13/95	ADDENDUM 1
DATE	REVISION
STATE OF HAWAII DEPARTMENT OF TRANSPORTATION HIGHWAYS DIVISION	
TUNNEL LIGHTING PLAN-1	
EXPLORATORY TUNNEL IMPROVEMENTS	
H-3 FINISH (UNIT III)	
FAIP NO. I-H3-I(75), UNIT III	
T.K. TUNNEL/ACCESS ROADS	
SCALE: 1" = 40'	DATE: JUN 1995
SHEET NO. 2E2	OF 30 SHEETS

C.O.ADD.74



SURVEY PLOTTED BY	DATE
DRAWN BY	NOT 94
DESIGNED BY	NOT 94
CHECKED BY	NOT 94
ORIGINAL PLAN	NO.
NOTE BOOK	NO.

HERNANDEZ ELWOOD:::2410:LDWG.ELECTR001.FGB71 13JUN95-08.05.10

FED. ROAD DIST. NO.	STATE	FED. AID PROJ. NO.	FISCAL YEAR	SHEET NO.	TOTAL SHEETS
HAWAII	HAW.	I-H3-1(75) UNIT III	1994	75	353

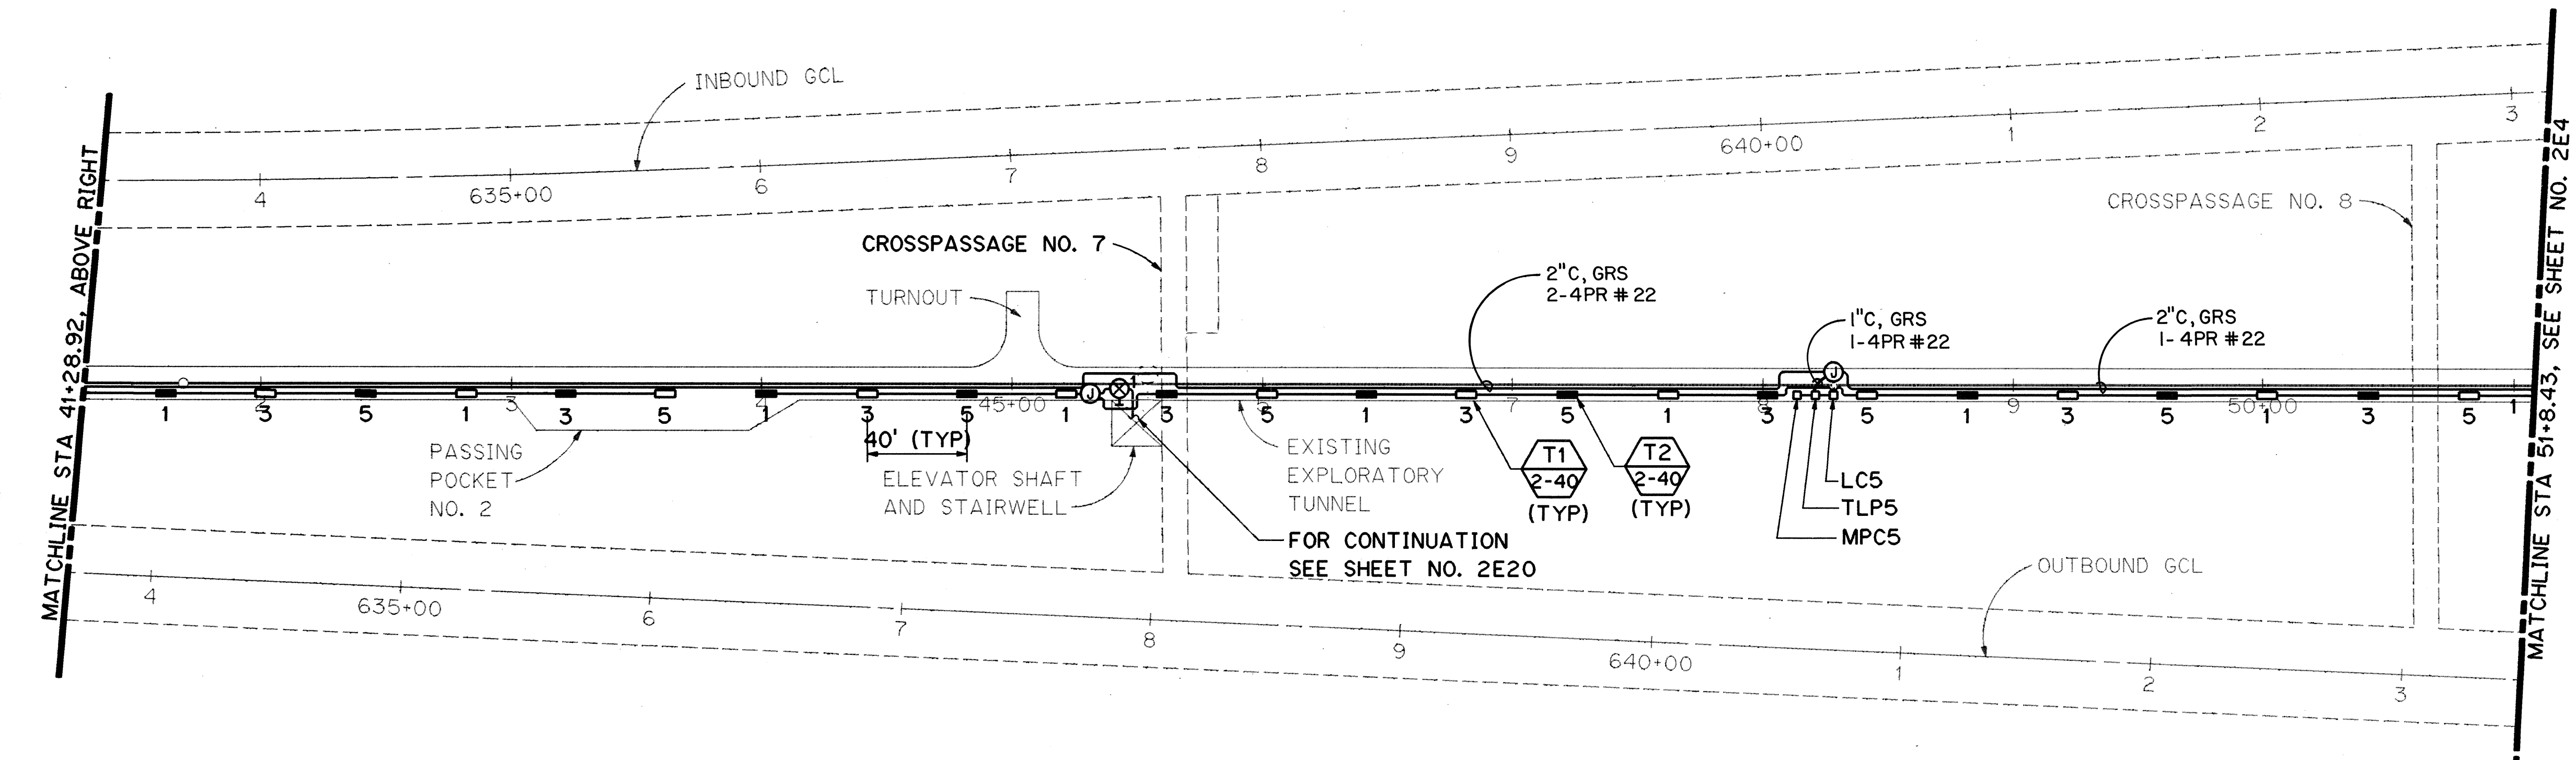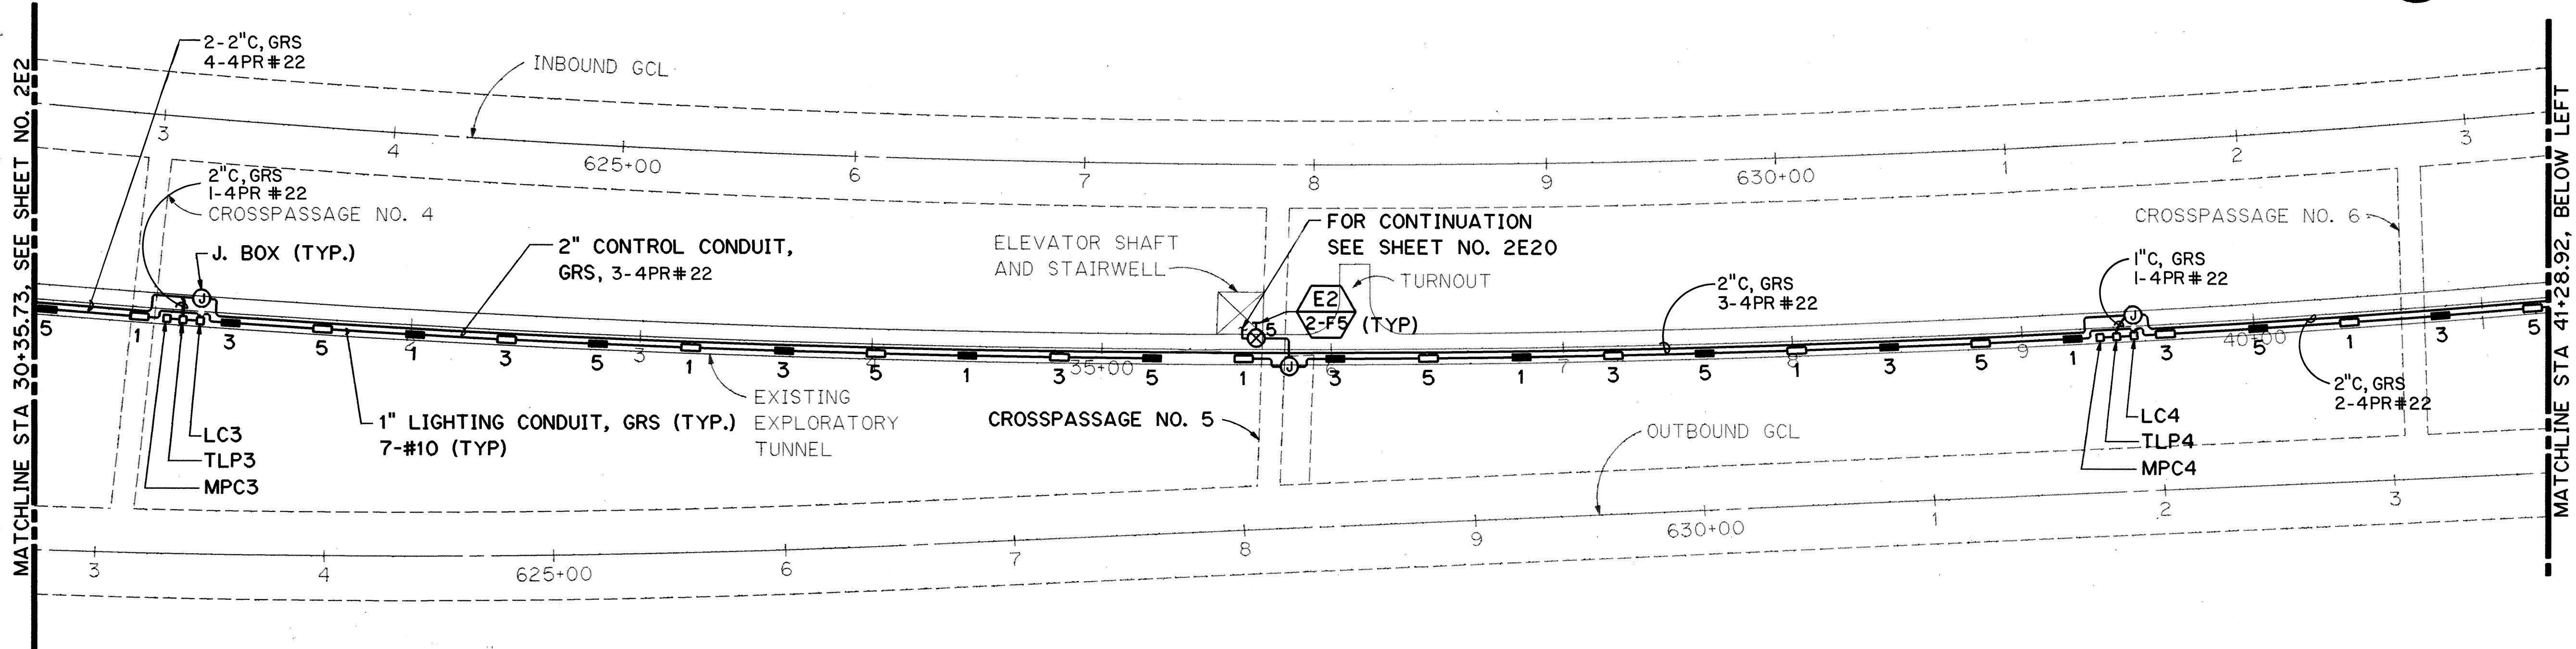

PARTIAL PLAN - EXPLORATORY TUNNEL

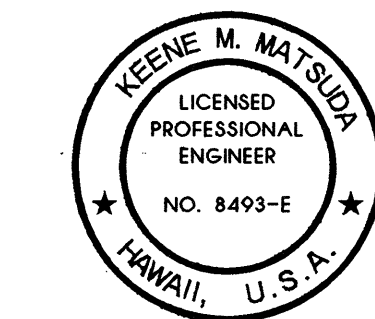
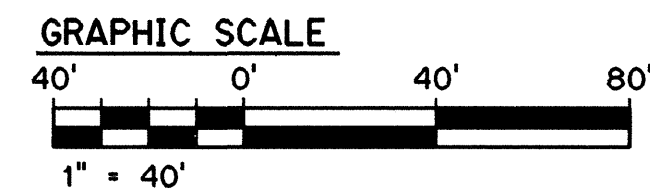


THIS WORK WAS PREPARED BY ME
OR UNDER MY SUPERVISION
Keene Matsumoto

DATE	REVISION
10/27/95	ADDENDUM 2-DELETED CONTROL CONDUIT CONN. AT CP 5 8 7, ADDED CONTROL WIRE SIZE
STATE OF HAWAII DEPARTMENT OF TRANSPORTATION HIGHWAYS DIVISION	
TUNNEL LIGHTING PLAN-2	
EXPLORATORY TUNNEL IMPROVEMENTS	
H-3 FINISH (UNIT III)	
FAIP NO. I-H3-1(75), UNIT III	
T.K. TUNNEL/ACCESS ROADS	
SCALE: 1" = 40'	DATE: JUN 1995
SHEET NO. 2E3	OF 30 SHEETS



DATE	NOV 94
DESIGNED BY	R. J. HERNANDEZ
TRACED BY	T. SANCHEZ
QUANTITIES BY	K. MATSUDA
CHECKED BY	DEC 94
NO.	

FED. ROAD DIST. NO.	STATE	FED. AID PROJ. NO.	FISCAL YEAR	SHEET NO.	TOTAL SHEETS
HAWAII	HAW.	1-H3-1(75) UNIT III	1994	76	353

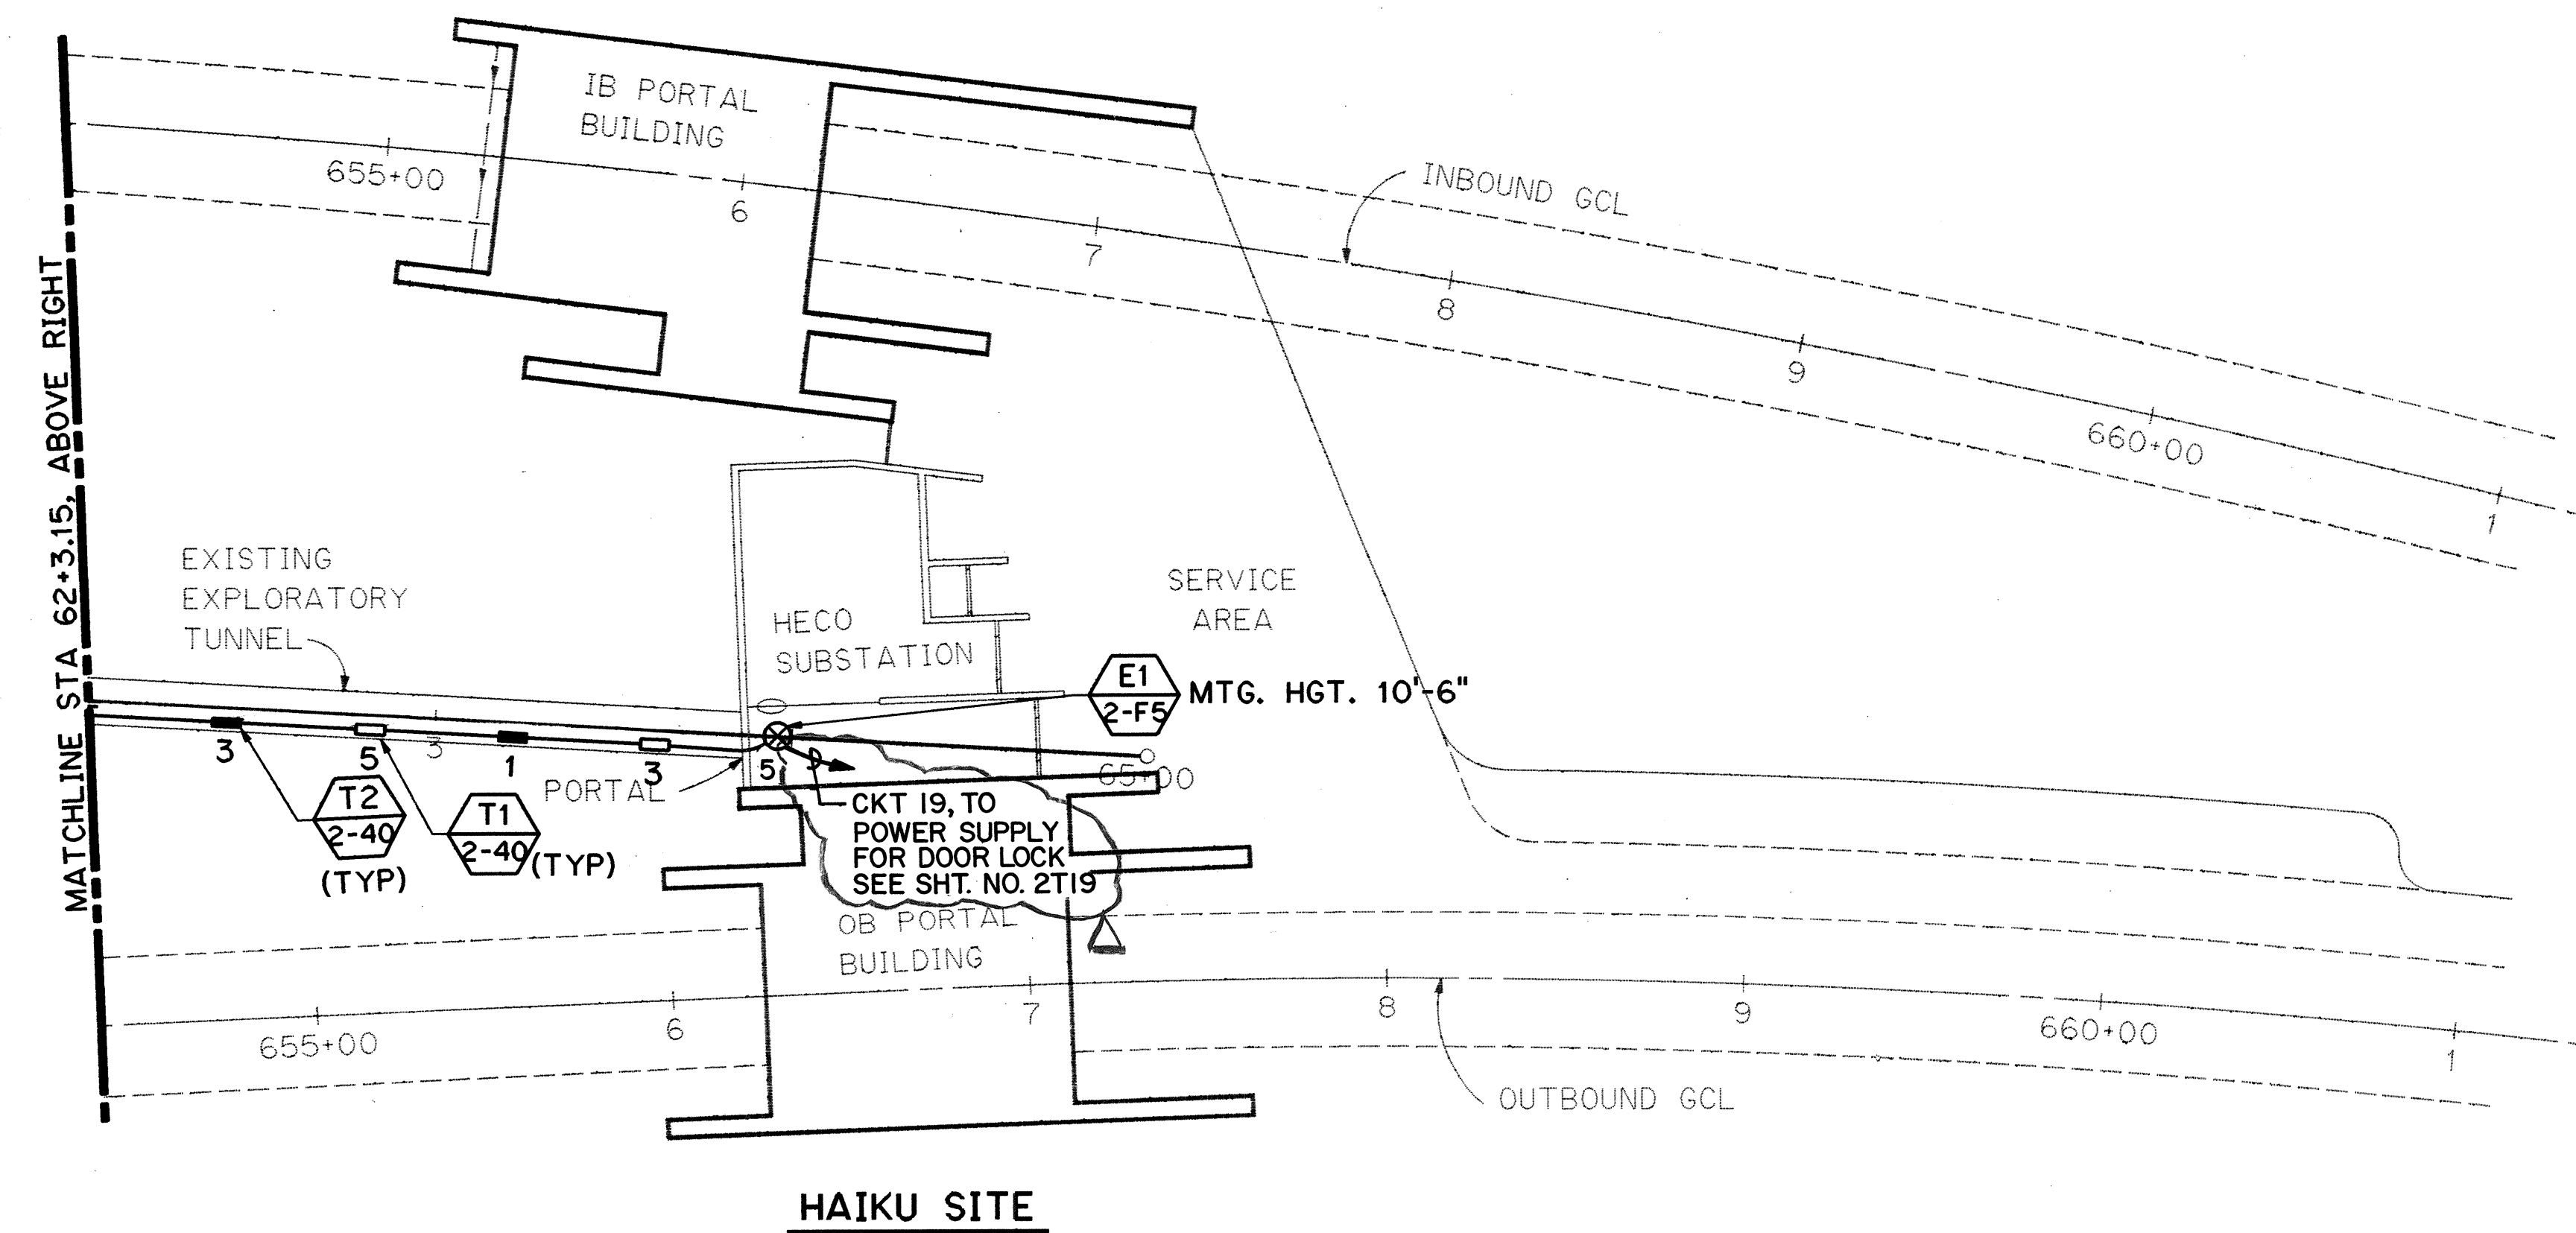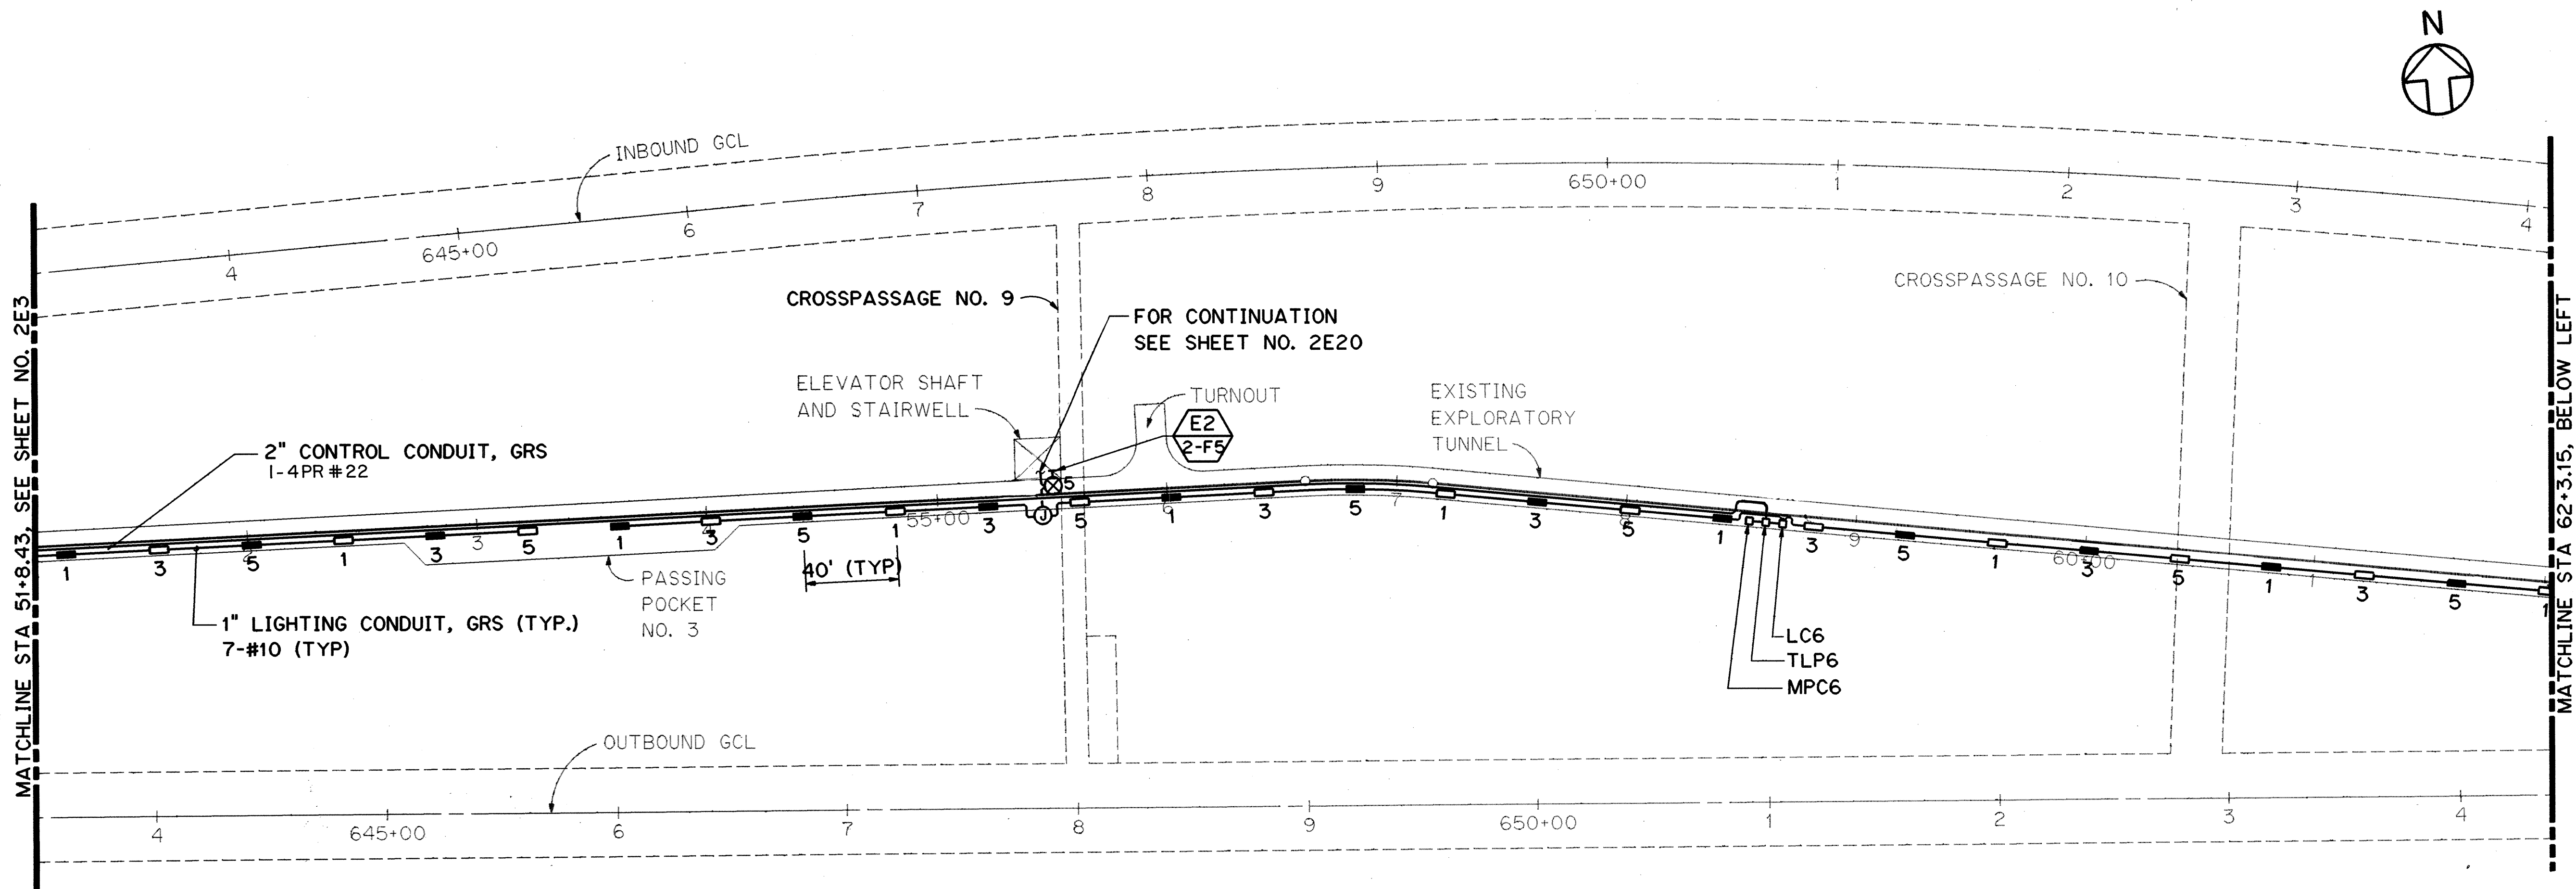

HAIKU SITE

PARTIAL PLAN - EXPLORATORY TUNNEL

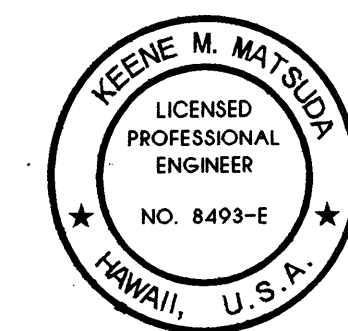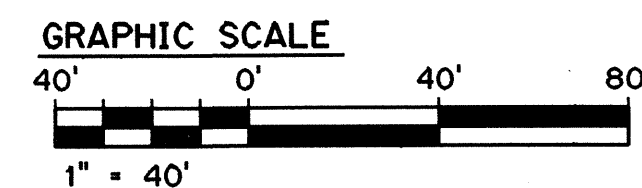

THIS WORK WAS PREPARED BY ME
OR UNDER MY SUPERVISION
Keene Matsuda

DATE	REVISION
5/29/97	DCN 75-019: ADDED CIRCUIT FOR HAIKU PORTAL POWER DOOR LOCK
10/27/95	ADDENDUM 2- ADDED LTG. CONTROL WIRE SIZE & DELETED 2\" CONTROL C FROM EF-102 TO TLP6
STATE OF HAWAII DEPARTMENT OF TRANSPORTATION HIGHWAYS DIVISION TUNNEL LIGHTING PLAN-3 EXPLORATORY TUNNEL IMPROVEMENTS H-3 FINISH (UNIT III) FAIP NO. I-H3-I(75), UNIT III T.K. TUNNEL/ACCESS ROADS SCALE: 1" = 40' DATE: JUN 1995	
SHEET NO. 2E4 OF 30 SHEETS	



C.O.ADD. 76

SURVEY PLOTTED BY	DATE
DRAWN BY	NOV 94
DESIGNED BY	NOV 94
QUANTITIES BY	
CHECKED BY	DEC 94
NO.	

FED. ROAD DIST. NO.	STATE	FED. AID PROJ. NO.	FISCAL YEAR	SHEET NO.	TOTAL SHEETS
HAWAII	HAW.	I-H3-1(75) UNIT III	1994	77	353

NOTES:

1. FOR TUNNEL POWER CONDUIT
ARRANGEMENT, REFER TO
SHEET NO. 2E21.

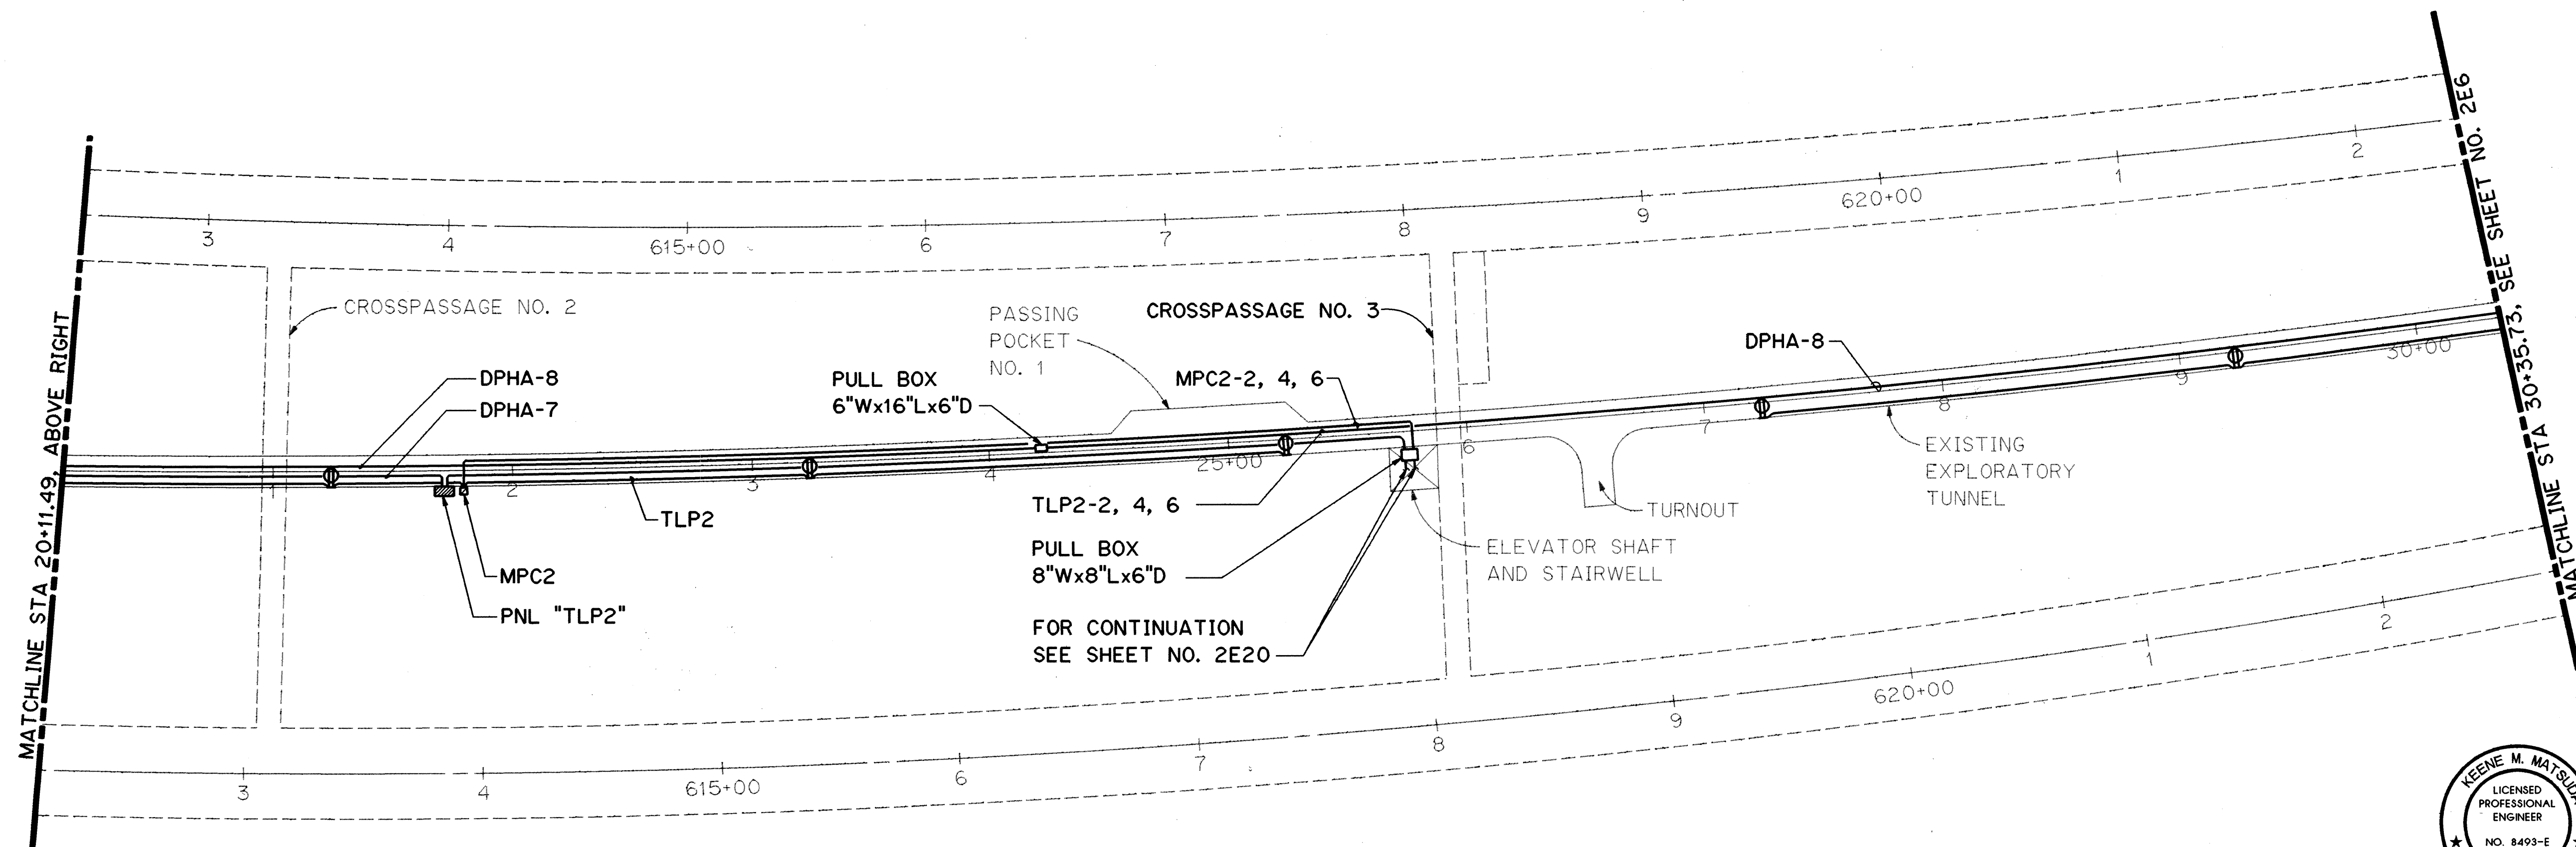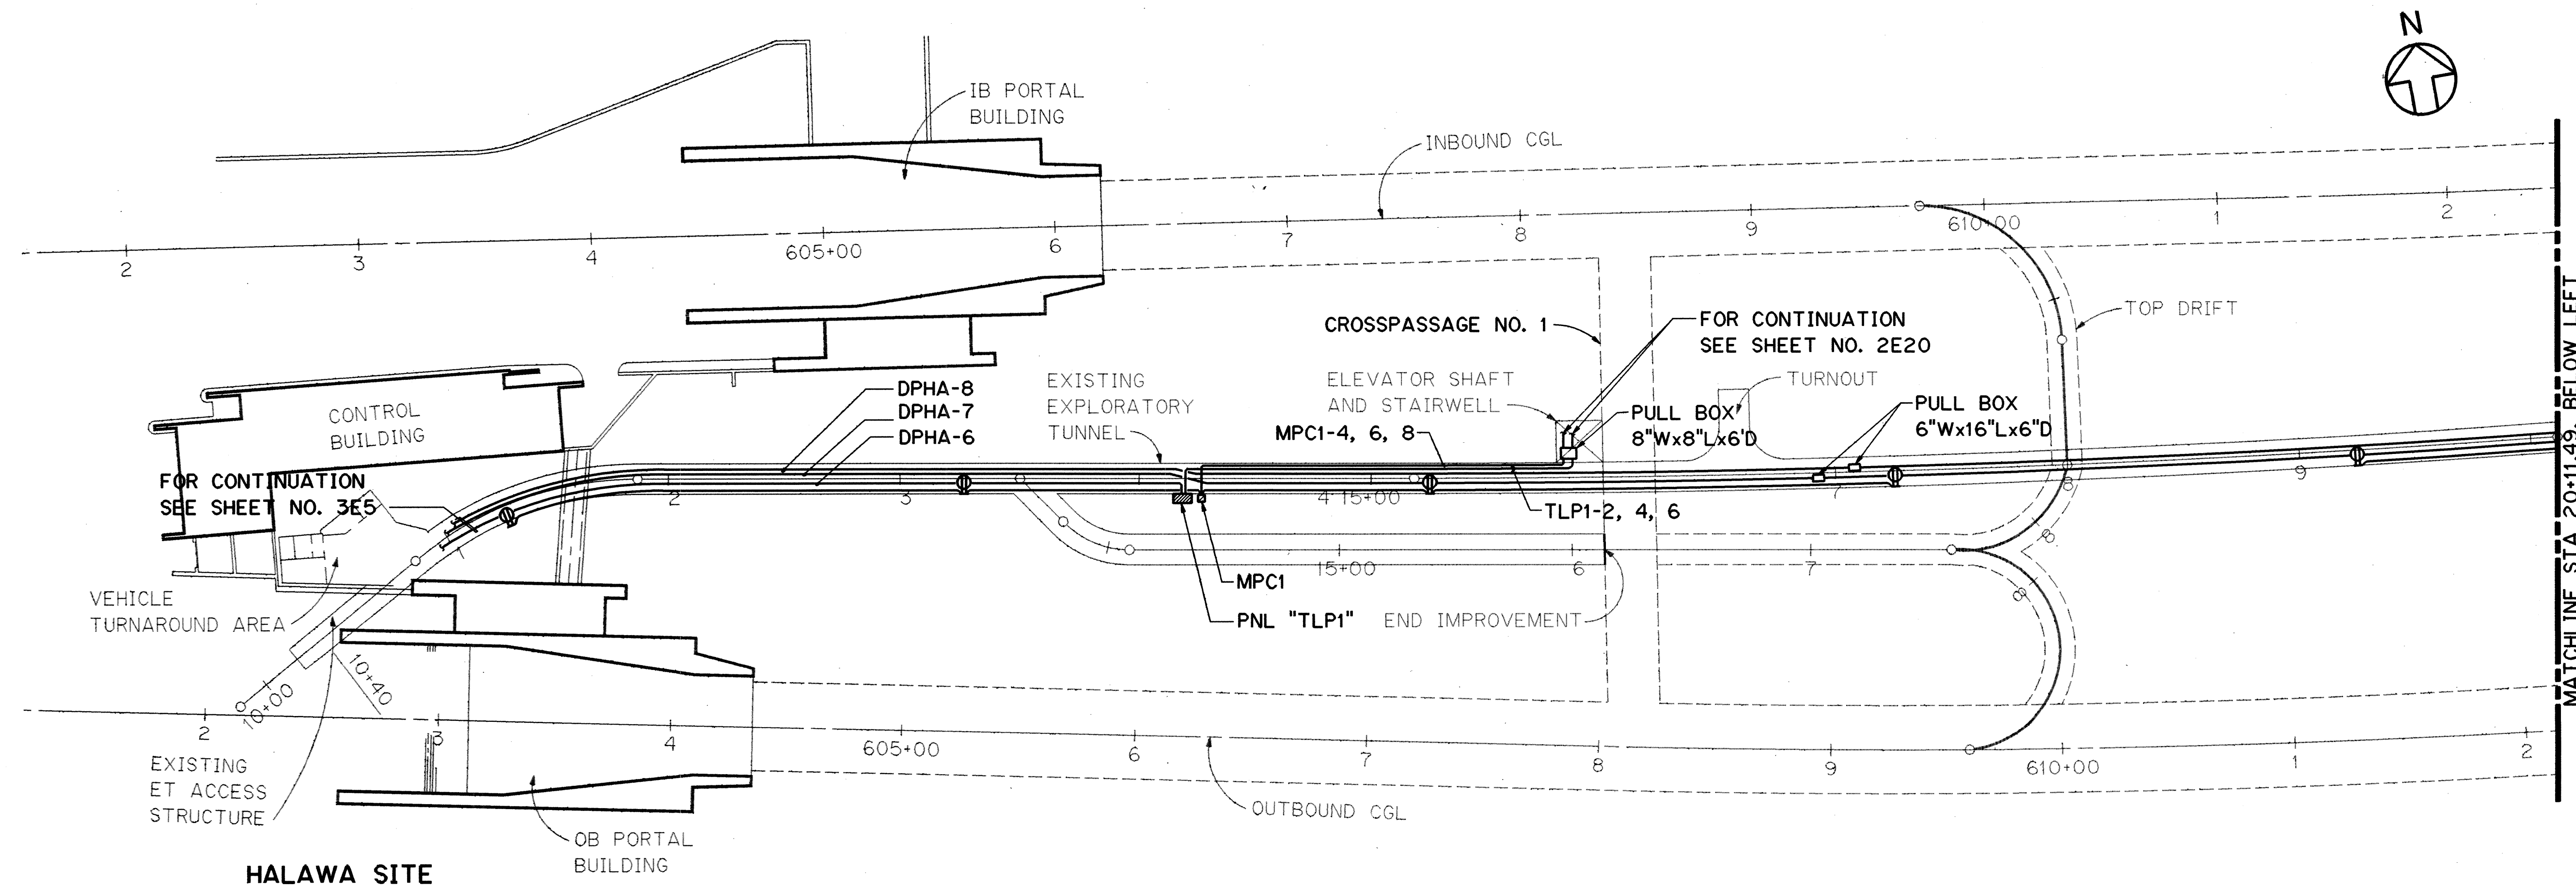

PARTIAL PLAN - EXPLORATORY TUNNEL

ORIGINAL PLAN	SURVEY PLOTTED BY	DATE
NOTE BOOK	DRAWN BY	R. J. HERNANDEZ
	DESIGNED BY	T. SANCHEZ
	QUANTITIES BY	
CHECKED BY		K. MATSUDA
NO.		DEC 94

[illegible]


STATE OF HAWAII
DEPARTMENT OF TRANSPORTATION
HIGHWAYS DIVISION

TUNNEL POWER PLAN-1
EXPLORATORY TUNNEL IMPROVEMENTS
H-3 FINISH (UNIT III)
FAIP NO. I-H3-1(75), UNIT III
T.K. TUNNEL/ACCESS ROADS

SCALE: 1" = 40' DATE: JUN 1995
SHEET NO. 2E5 OF 30 SHEETS



HERNANDEZ ELWOOD:::2410:[DWG.ELECT]E004.FGB;1 12JUN95-14.28.40

FED. ROAD DIST. NO.	STATE	FED. AID PROJ. NO.	FISCAL YEAR	SHEET NO.	TOTAL SHEETS
HAWAII	HAW.	1-H3-1(75) UNIT III	1994	79	353

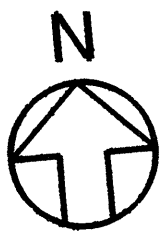



NOTES:

1. FOR TUNNEL POWER CONDUIT ARRANGEMENT, REFER TO SHEET NO. 2E21.

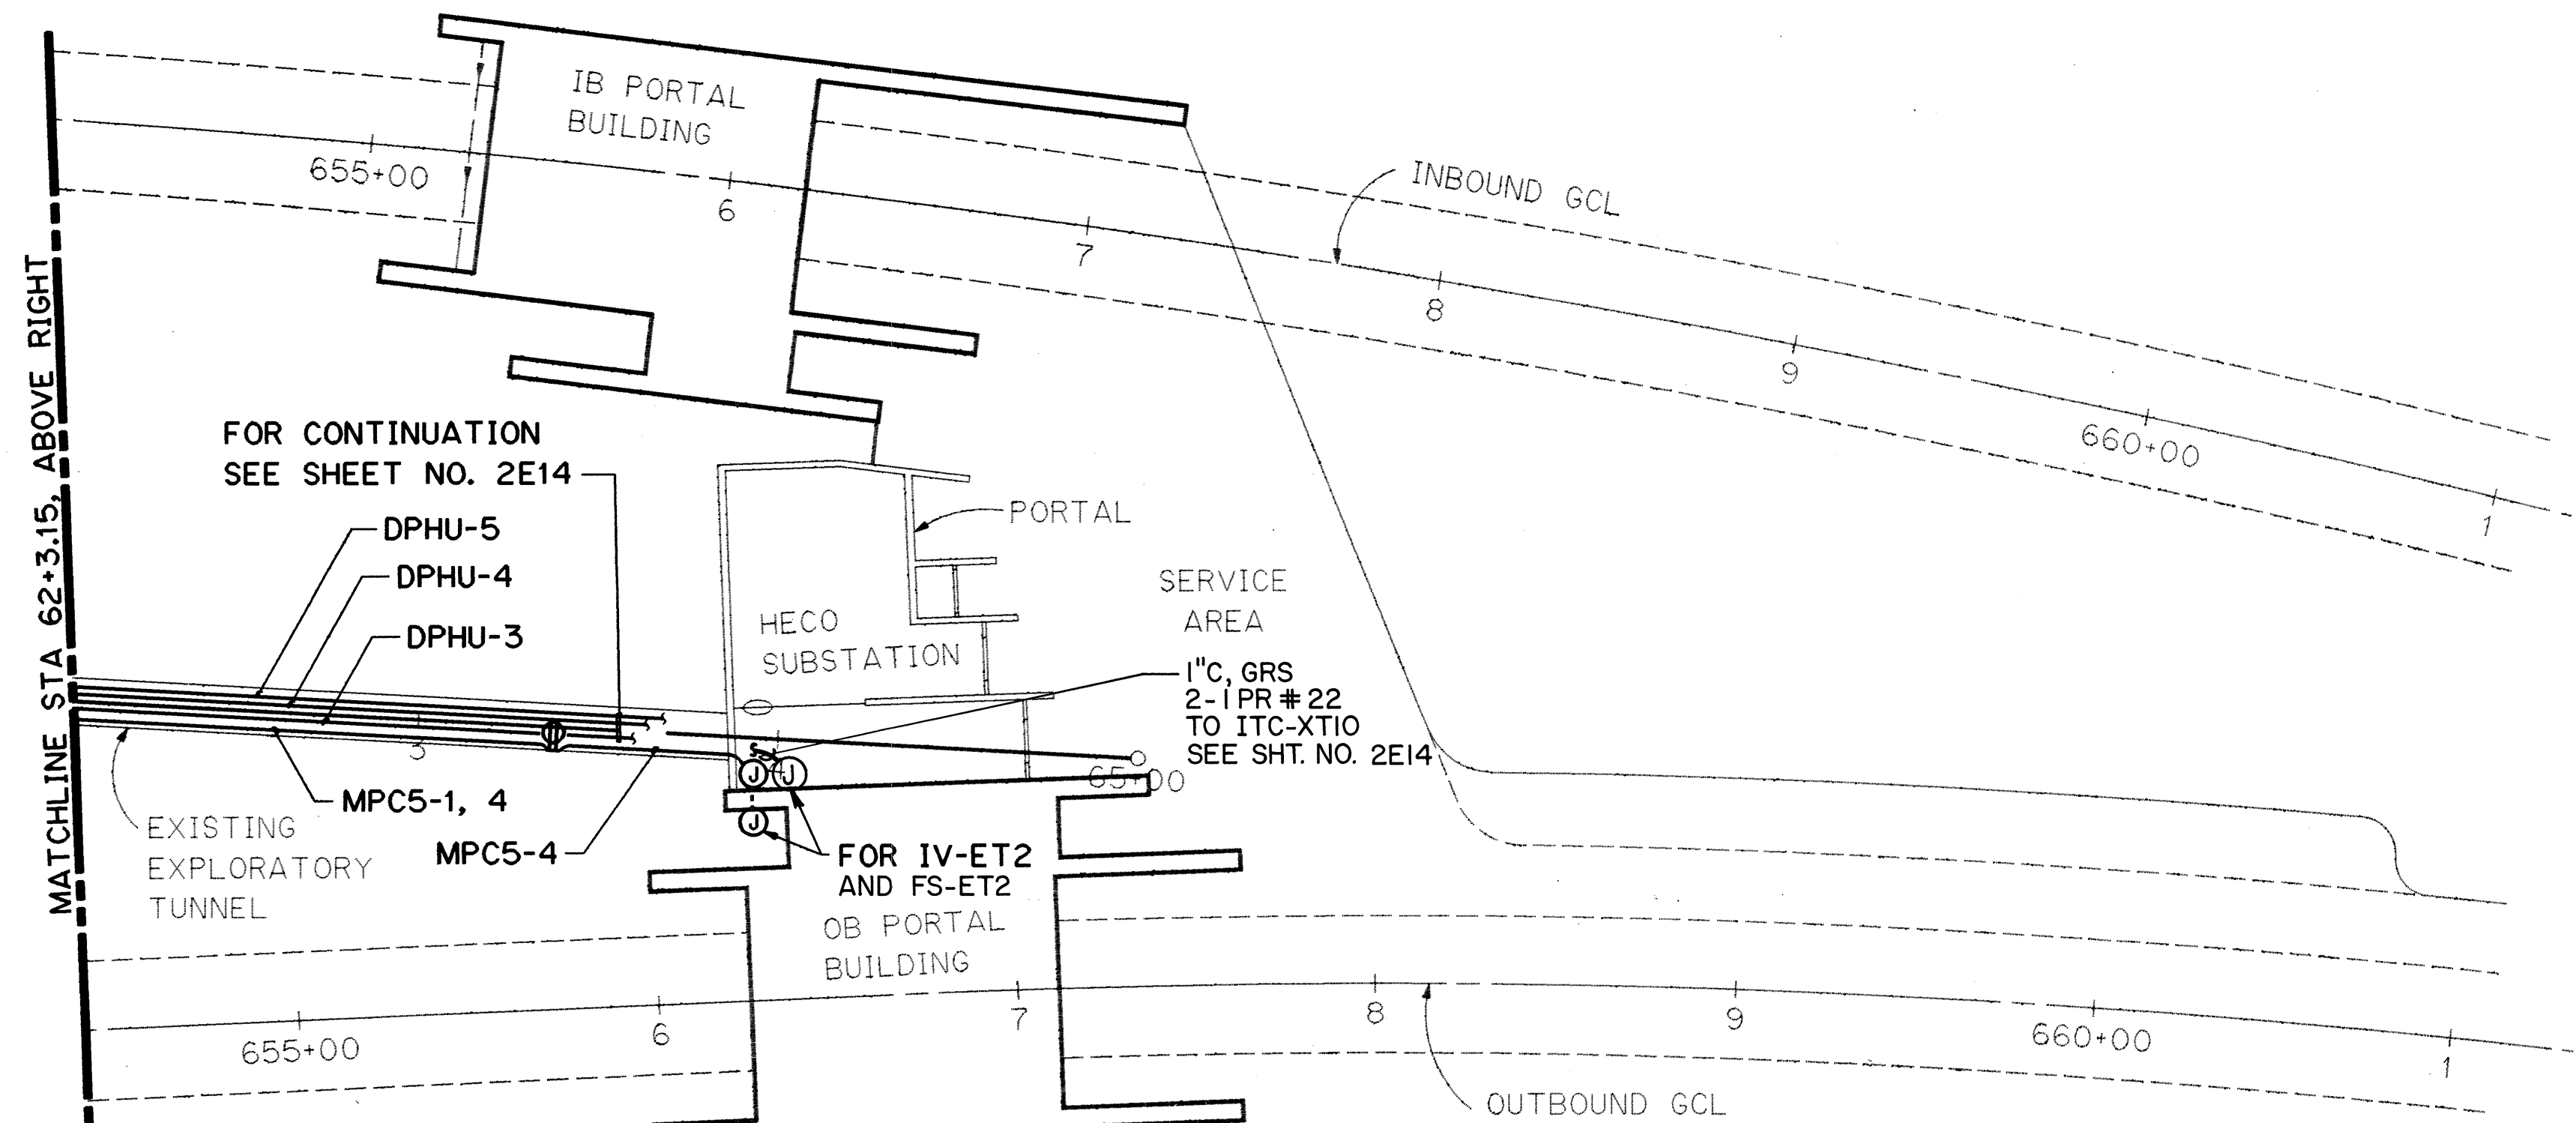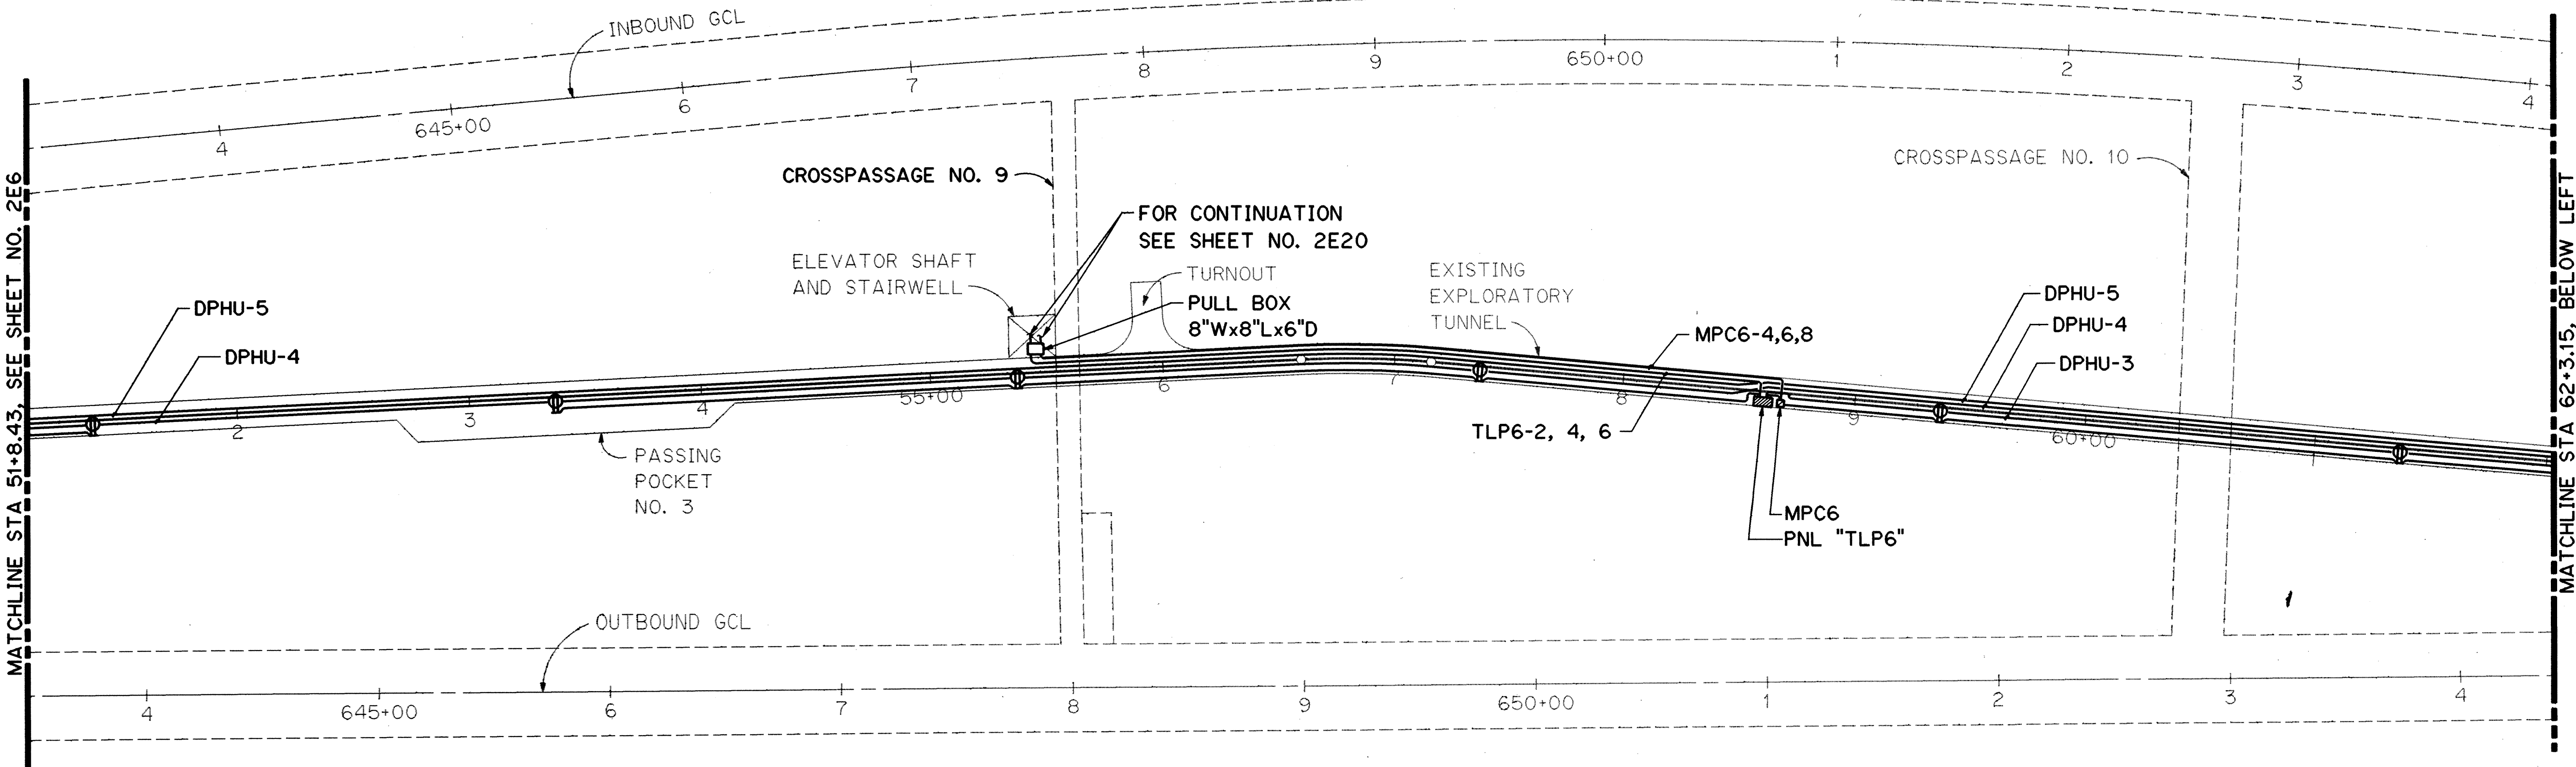

HAIKU SITE

PARTIAL PLAN - EXPLORATORY TUNNEL

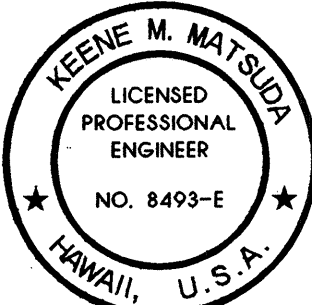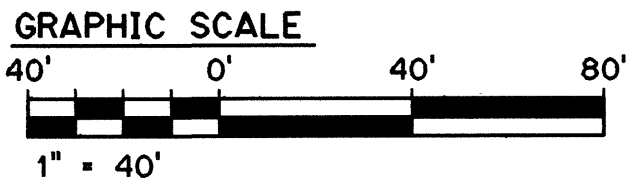


THIS WORK WAS PREPARED BY ME
OR UNDER MY SUPERVISION
Keene Matsuda

10/27/95	ADDENDUM 2-ADDED FS-ET2 & MONITORING CONDUIT FOR IV-ET2 & FS-ET2 TO ITC-XT10
DATE	REVISION
STATE OF HAWAII DEPARTMENT OF TRANSPORTATION HIGHWAYS DIVISION TUNNEL POWER PLAN-3 EXPLORATORY TUNNEL IMPROVEMENTS H-3 FINISH (UNIT III) FAIP NO. 1-H3-1(75), UNIT III T.K. TUNNEL/ACCESS ROADS SCALE: 1" = 40' DATE: JUN 1995	
SHEET NO. 2E7	OF 30 SHEETS

SURVEY PLOTTED BY	DATE
DRAWN BY	NOV 94
DESIGNED BY	NOV 94
CHECKED BY	DEC 94
ORIGINAL PLAN	
NOTE BOOK	
NO.	

FED. ROAD DIST. NO.	STATE	FED. AD PROJ. NO.	FISCAL YEAR	SHEET NO.	TOTAL SHEETS
HAWAII	HAW.	I-H3-I(75) UNIT III	1994	80	353

DATE	NOV 94
DESIGNED BY	L. WANG
DRAWN BY	T. SANCHEZ
CHECKED BY	E. MATSUDA
DATE	NOV 94
DATE	DEC 94

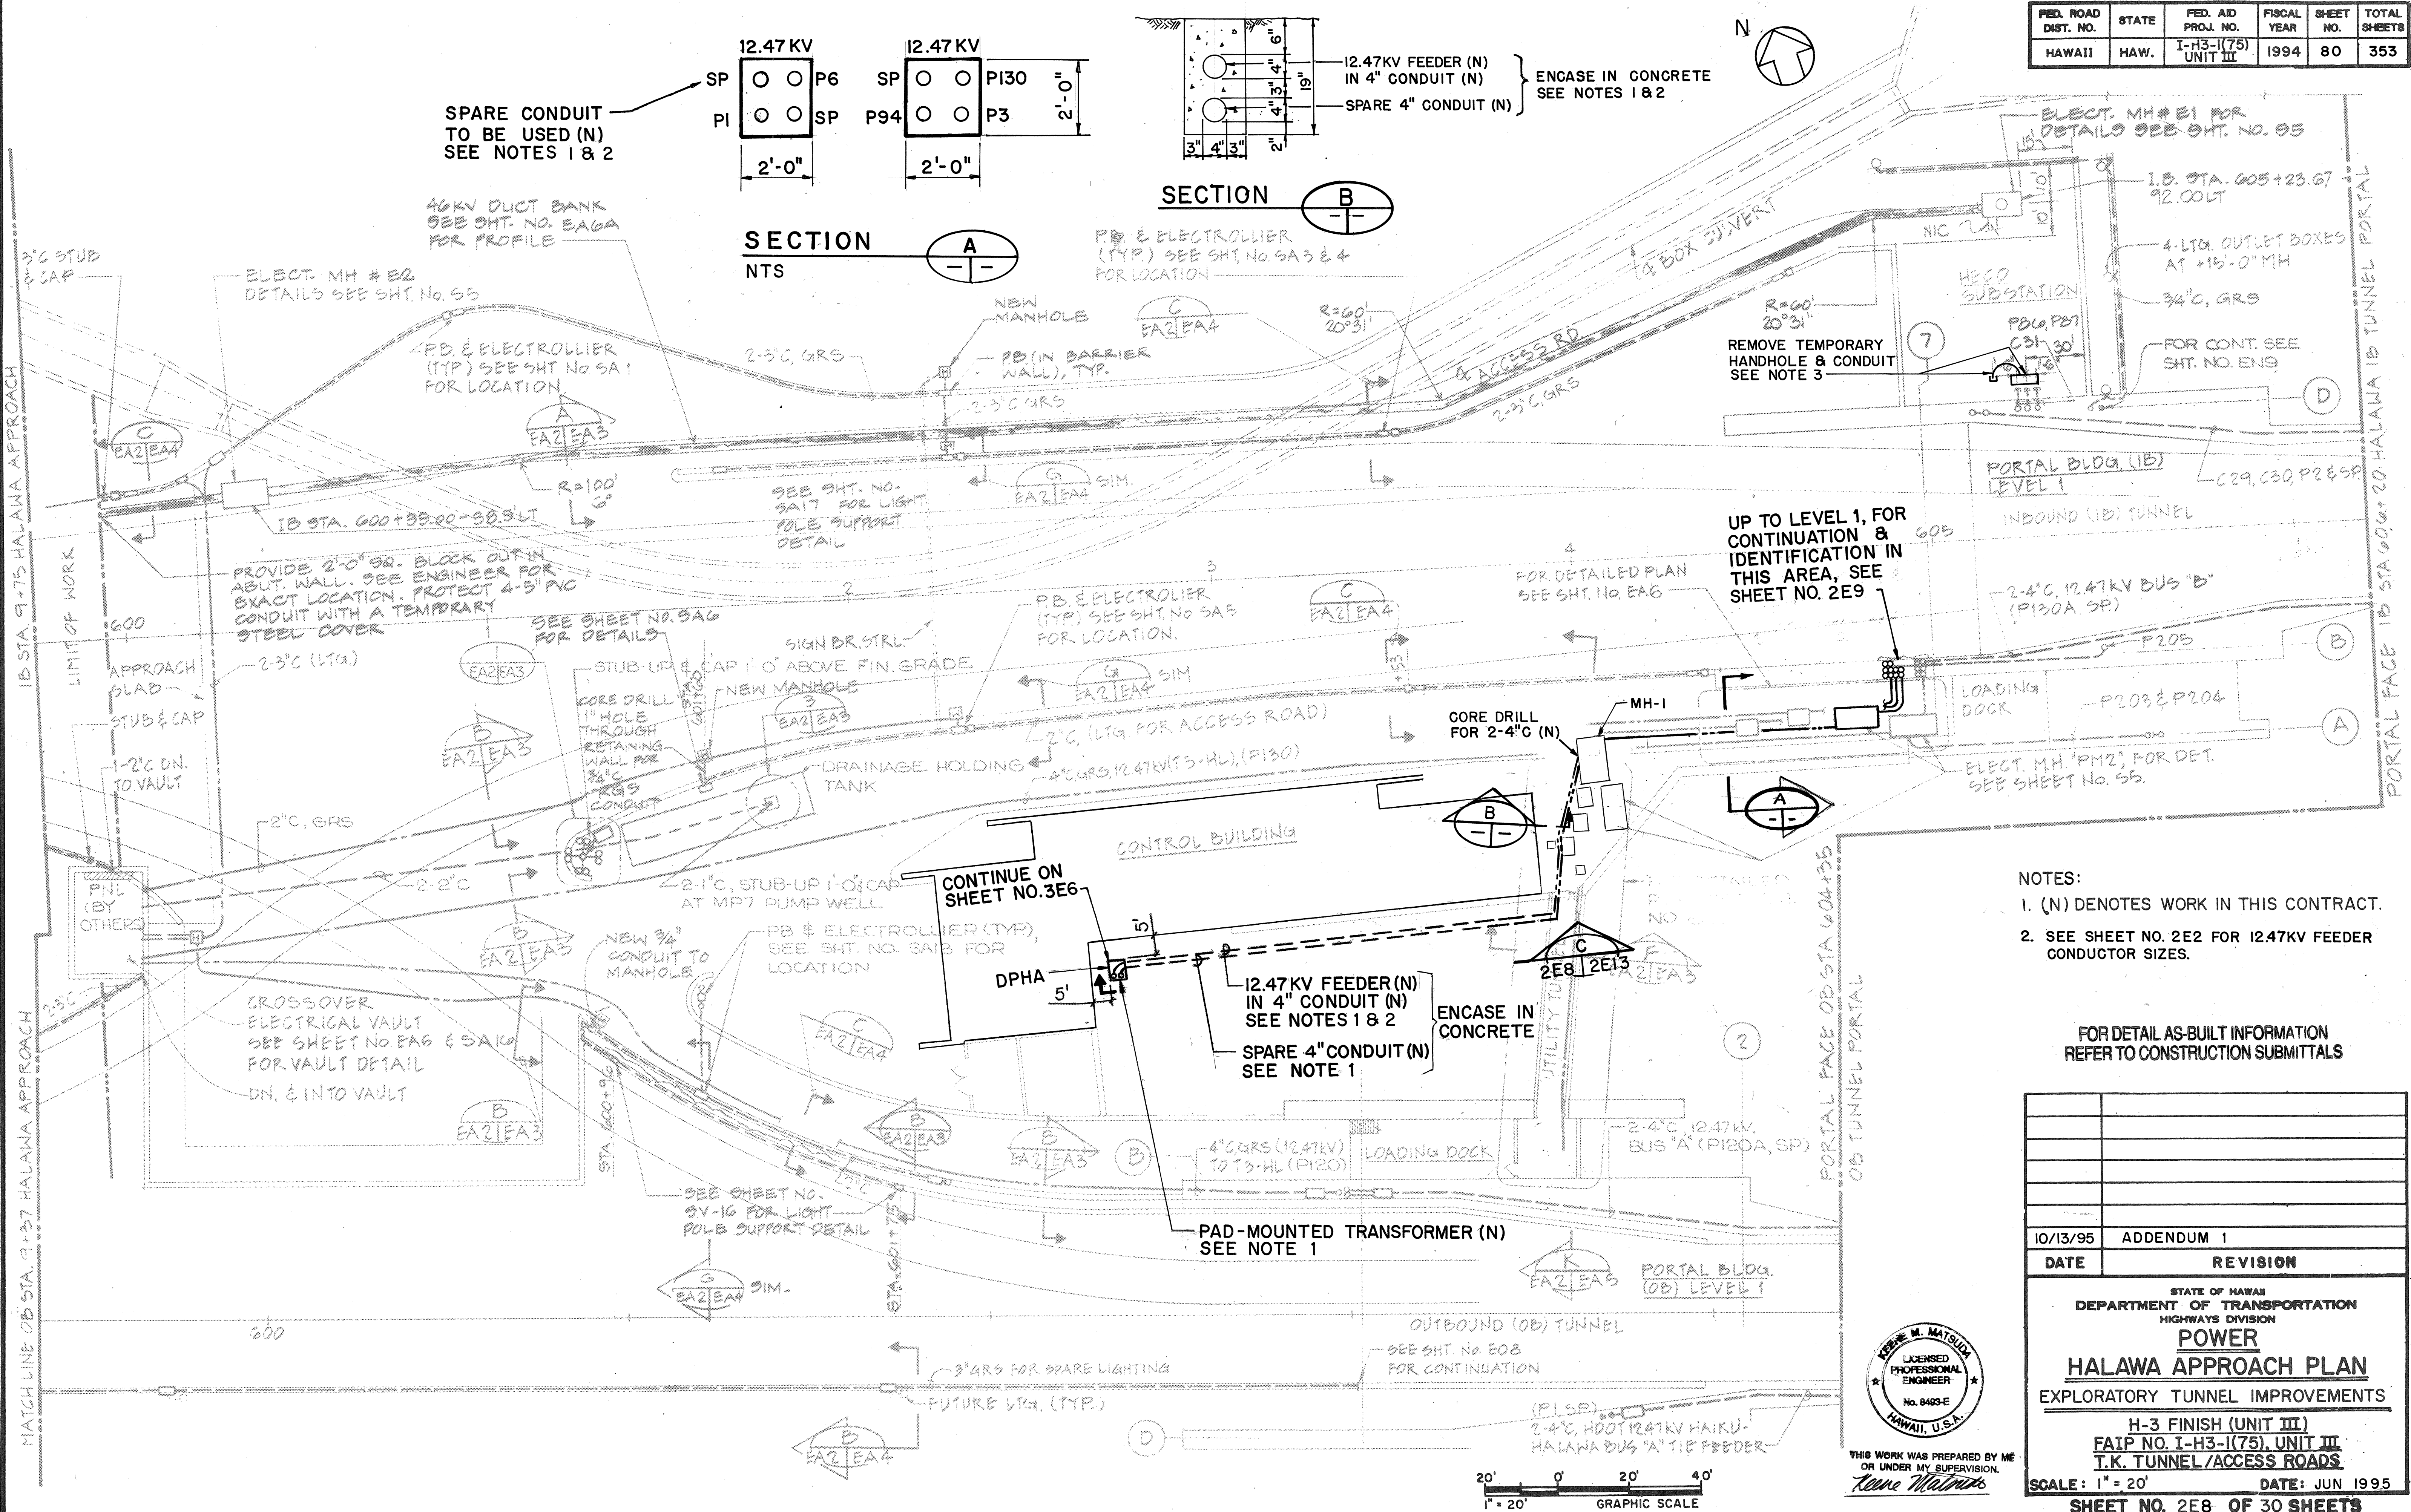


SECTION B

SECTION A

- NOTES:
- (N) DENOTES WORK IN THIS CONTRACT.
 - SEE SHEET NO. 2E2 FOR 12.47KV FEEDER CONDUCTOR SIZES.


FOR DETAIL AS-BUILT INFORMATION REFER TO CONSTRUCTION SUBMITTALS

DATE	REVISION
10/13/95	ADDENDUM 1

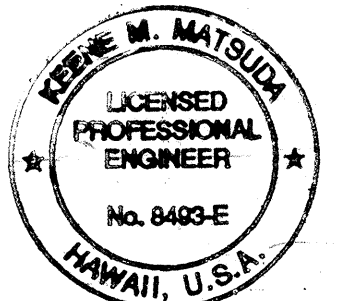

THIS WORK WAS PREPARED BY ME OR UNDER MY SUPERVISION.
Kenneth Matsuoka


STATE OF HAWAII
DEPARTMENT OF TRANSPORTATION
HIGHWAYS DIVISION
POWER
HALAWA APPROACH PLAN
EXPLORATORY TUNNEL IMPROVEMENTS
H-3 FINISH (UNIT III)
FAIP NO. I-H3-I(75), UNIT III
T.K. TUNNEL/ACCESS ROADS
SCALE: 1" = 20' DATE: JUN 1995
SHEET NO. 2E8 OF 30 SHEETS

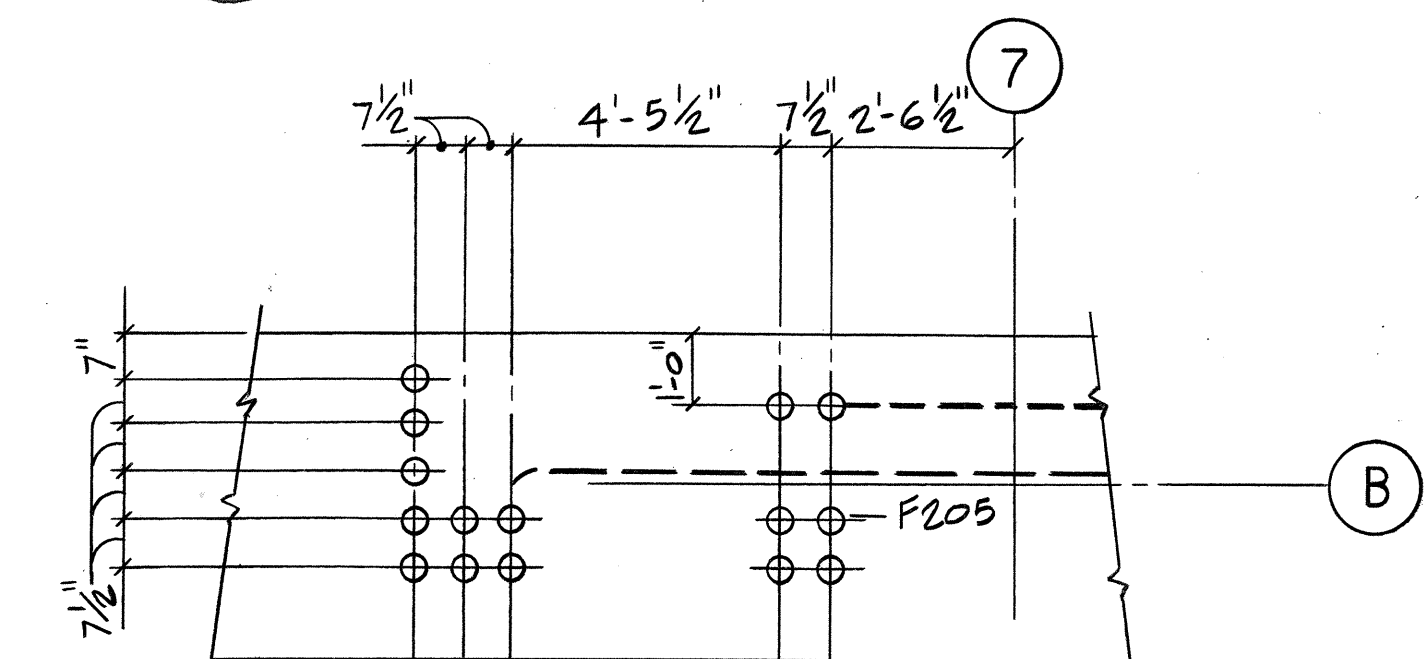

4 ¹ C (5P)	4 ¹ C (P130A)
4 ¹ C (P94)	4 ¹ C (P130)
4 ¹ C (5P)	4 ¹ C (P3)

DETAIL

N.T.S.

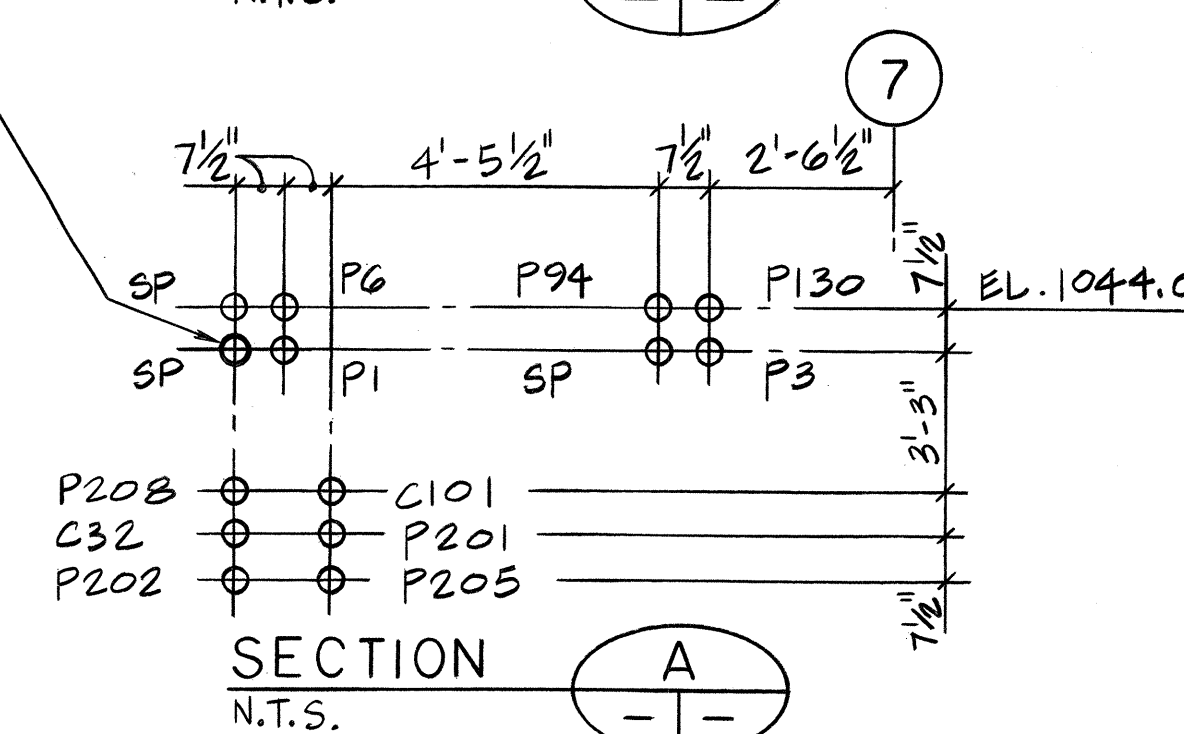

SPARE CONDUIT TO BE USED
FOR 12.47KV FEEDER (N)
SEE NOTE 1
CONT'D ON SHT. NO. 2

DATE	REVISION
------	----------

STATE OF HAWAII
DEPARTMENT OF TRANSPORTATION
HIGHWAYS DIVISION

POWER

HAI AWA PORTAL TR - 1 FVEI 1

THREATS TO THE ENVIRONMENT

EXPLORATORY TUNNEL IMPROVEMENTS

H-3 FINISH (UNIT III)

FAIP NO. 1-H3-1(75), UNIT III
T-K TUNNEL ACCESS ROADS

SCALE: 1/8" = 1' - 0" DATE: JUN 1985

SCALE: 1/8" = 1'-0" DATE: JUN 1993
SHEET NO. 258 OF 30 SHEETS

SHEET NO. 229 OF 30 SHEETS



THIS WORK WAS PREPARED BY ME
OR UNDER MY SUPERVISION.
Keene Watkins

SPARE CONDUIT TO BE USED (N) SEE NOTE 1 B

TOP TO BTM - LEFT TO RIGHT

TOP TO BTM - LEFT TO RIGHT

4" C (P208)	4" C (C32)	4" C (P202)	4" C (SP)	4" C (P130A)
4" C (SP)	4" C (P1)	4" C (P201)	4" C (P94)	4" C (P130)
4" C (SP)	4" C (P6)	3" C (C101)	4" C (SP)	4" C (P3)

DETAIL


NTS

DATE	REVISION



THIS WORK WAS PREPARED BY ME
OR UNDER MY SUPERVISION.
Keene Matlock


— SPARE CONDUIT
TO BE USED (N)
SEE NOTE 1

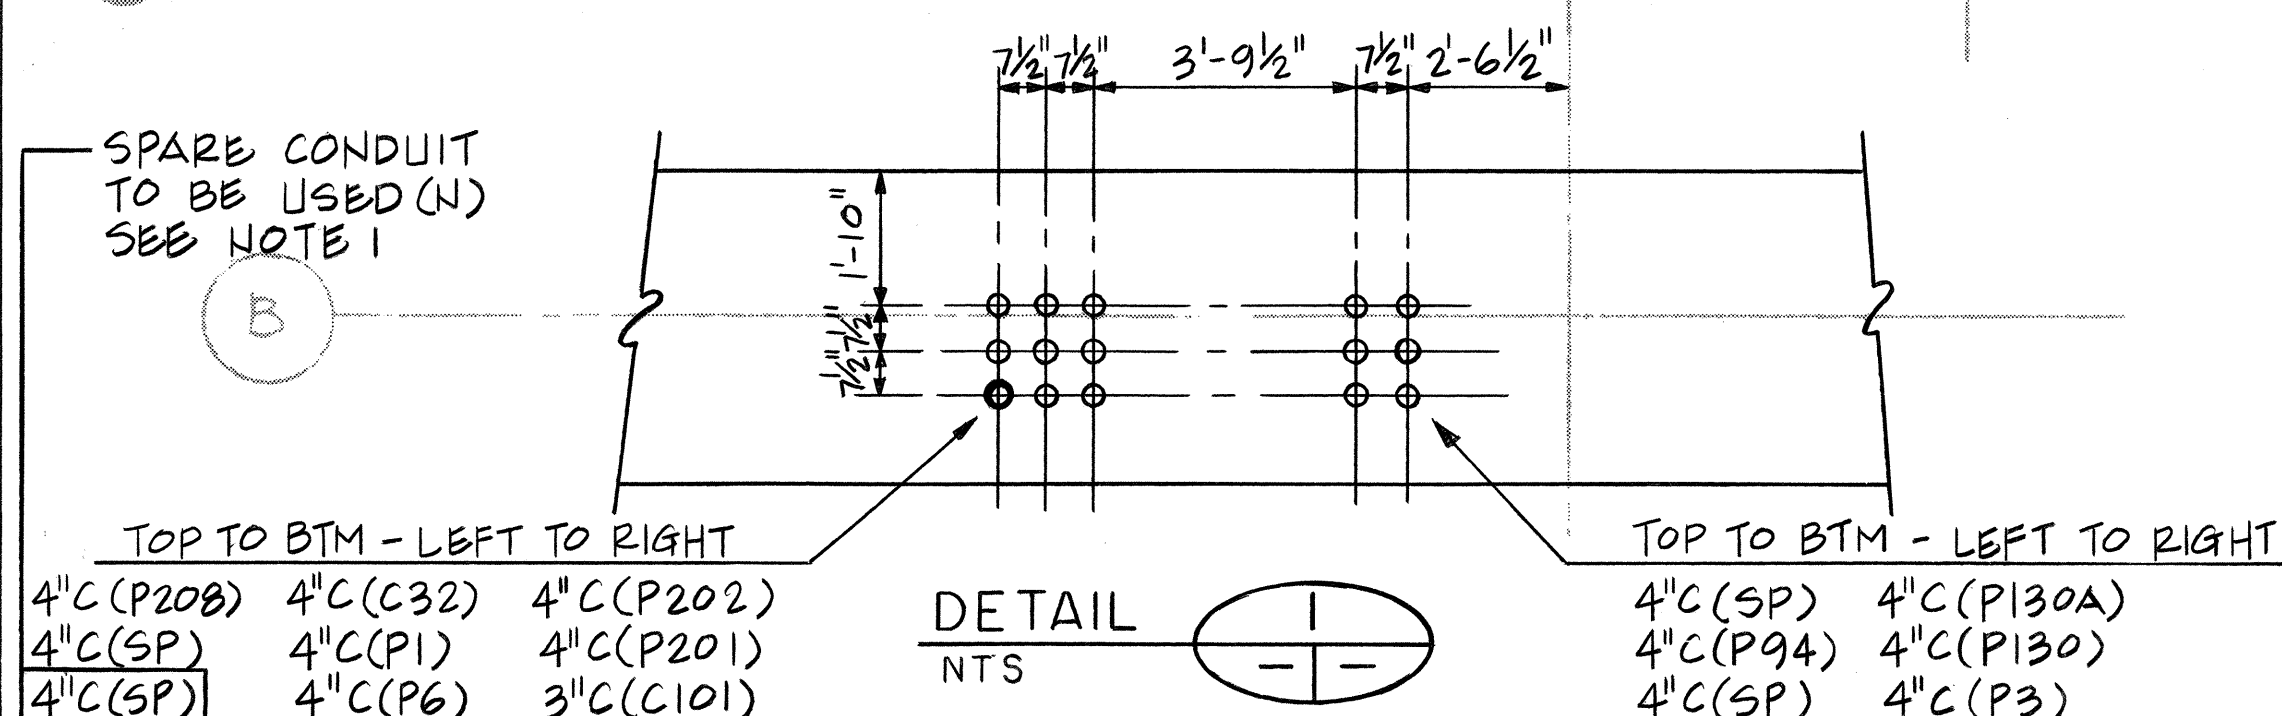


THIS WORK WAS PREPARED BY ME
OR UNDER MY SUPERVISION.
Keene Matlock

2410V152 2410: V152 ES0252.FGB;1 22SEP89-10.36.4

FED. ROAD DIST. NO.	STATE	FED. AID PROJ. NO.	FISCAL YEAR	SHEET NO.	TOTAL SHEETS
HAWAII	HAW.	I-H3-1(75) UNIT III	1994	84	353

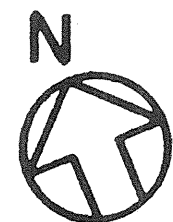

- NOTE:
- (N) DENOTES WORK IN THIS CONTRACT
 - PROVIDE SEISMIC RESTRAINTS FOR RACEWAYS.

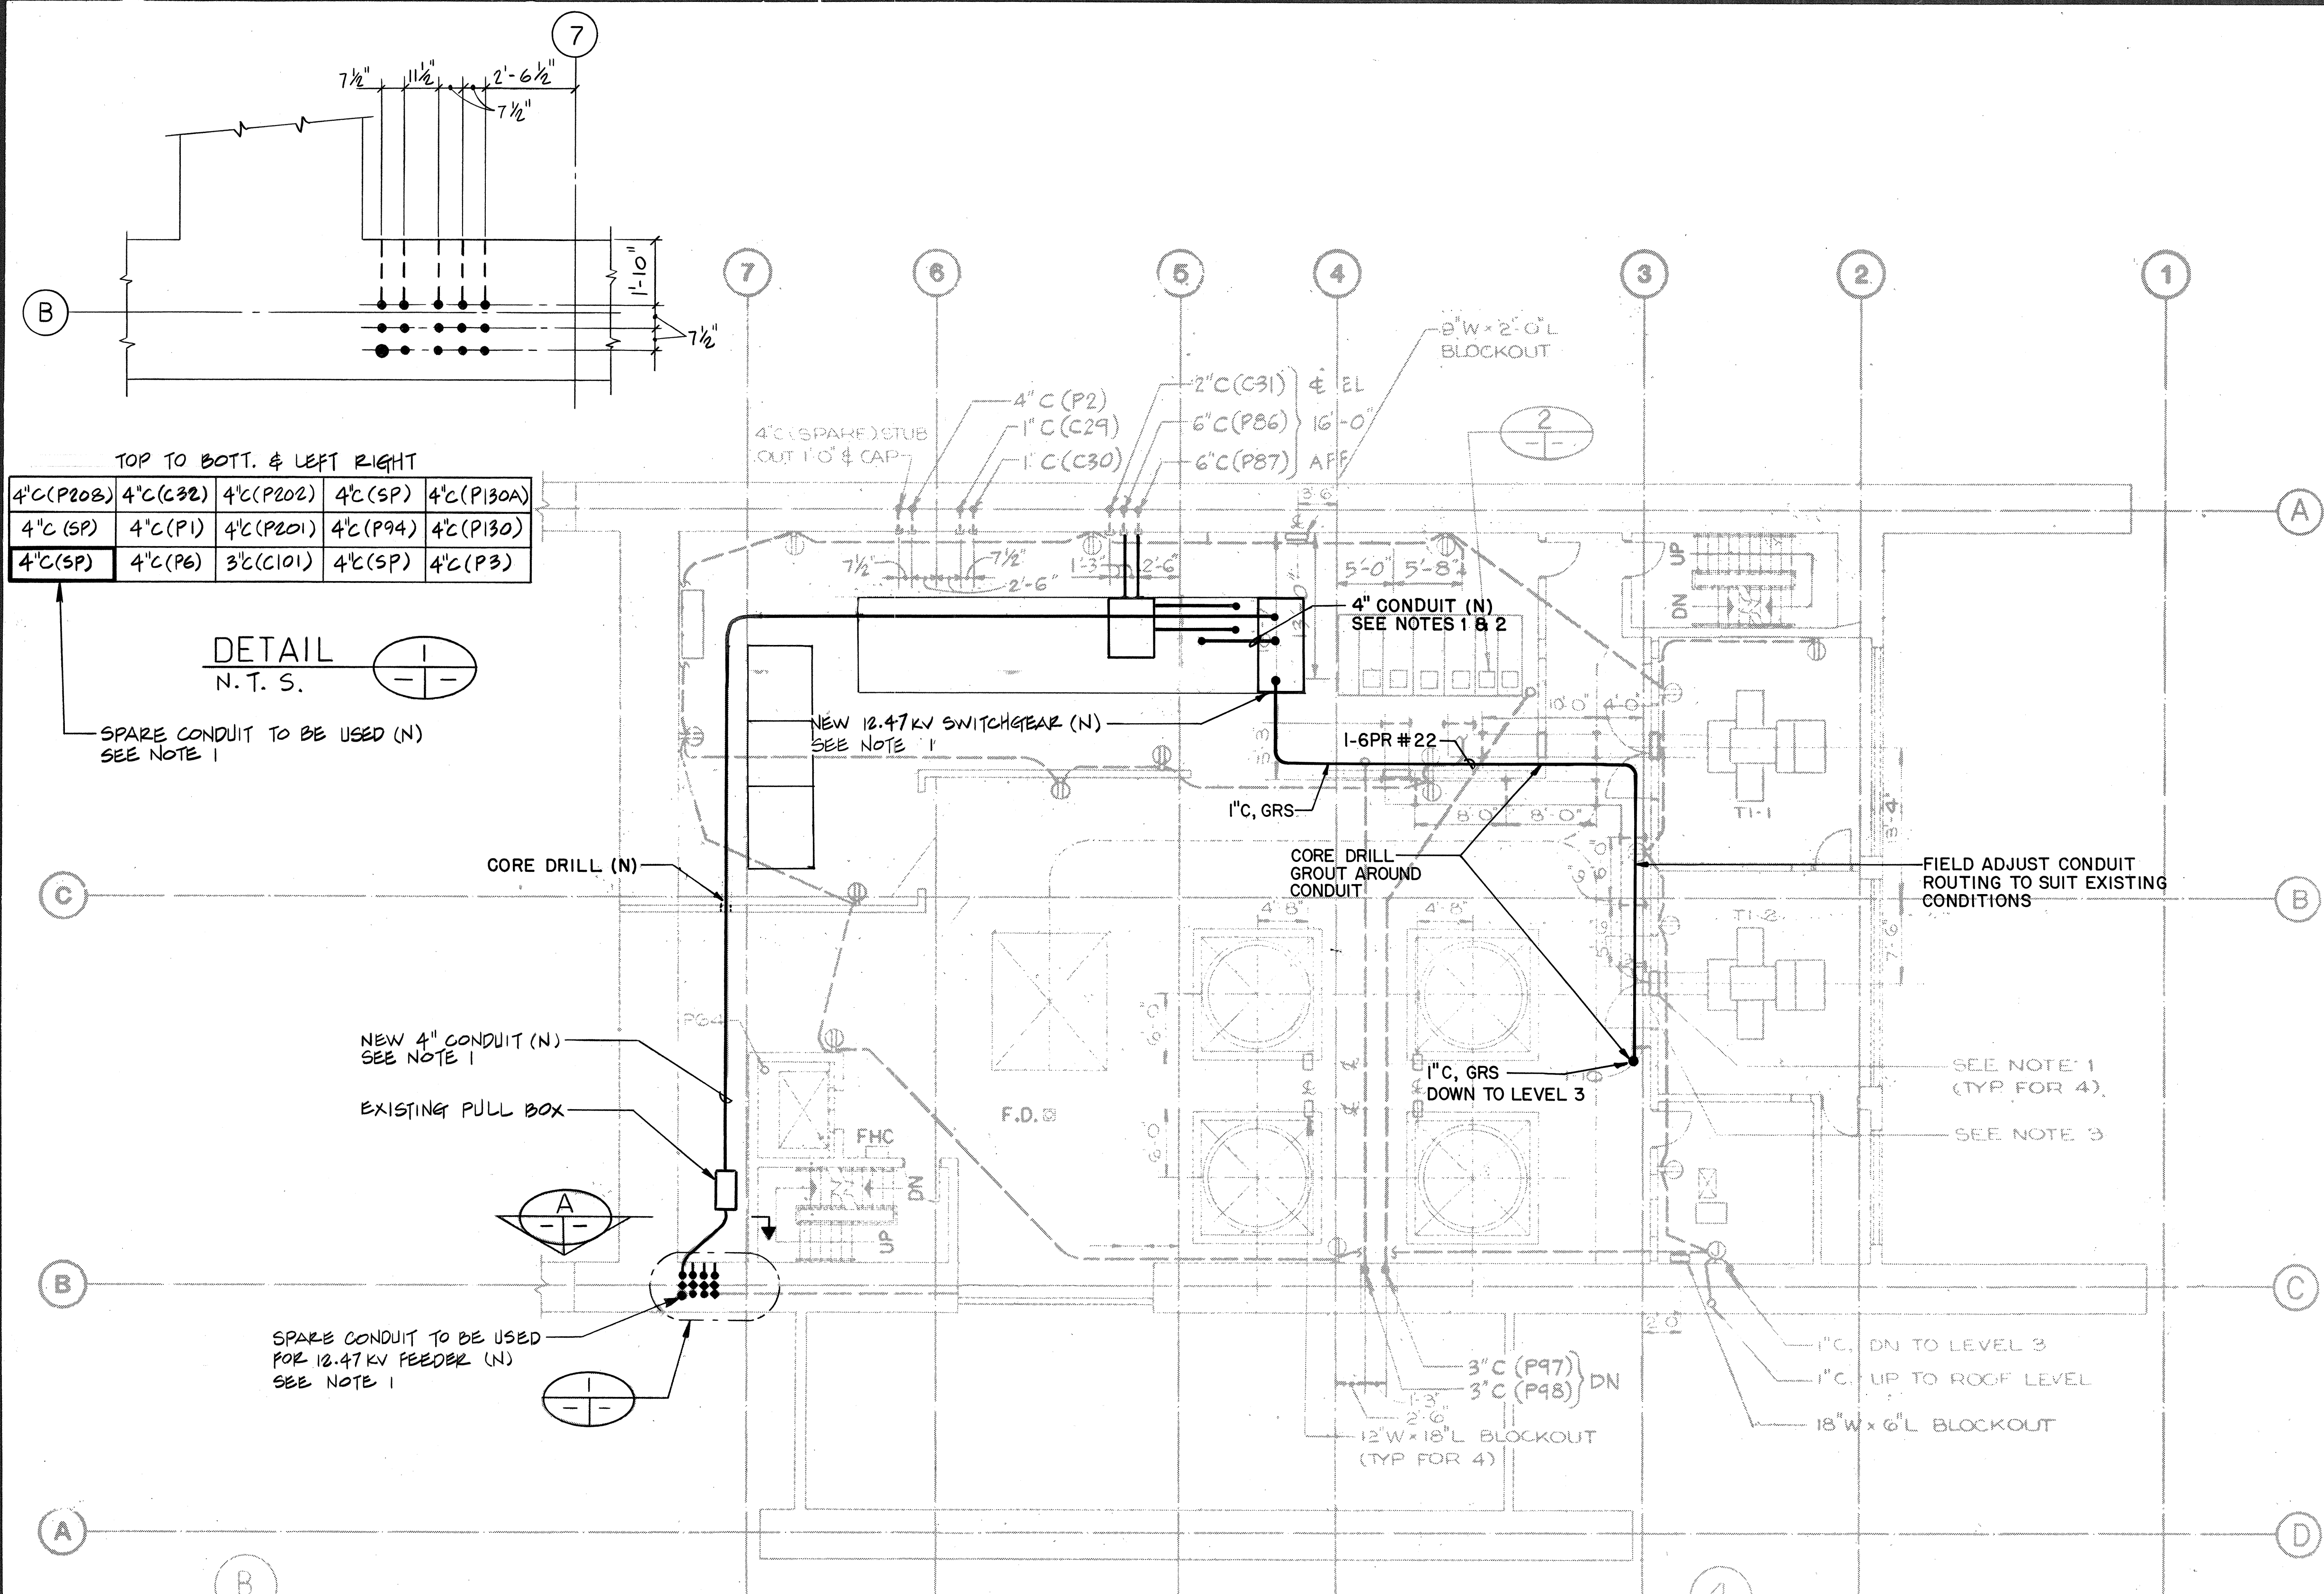


TOP TO BOTT. & LEFT RIGHT

4" C (P202)	4" C (C32)	4" C (P202)	4" C (SP)	4" C (P130A)
4" C (SP)	4" C (P1)	4" C (P201)	4" C (P94)	4" C (P130)
4" C (SP)	4" C (P6)	3" C (C101)	4" C (SP)	4" C (P3)

DETAIL
N.T.S.

SPARE CONDUIT TO BE USED (N)
SEE NOTE 1


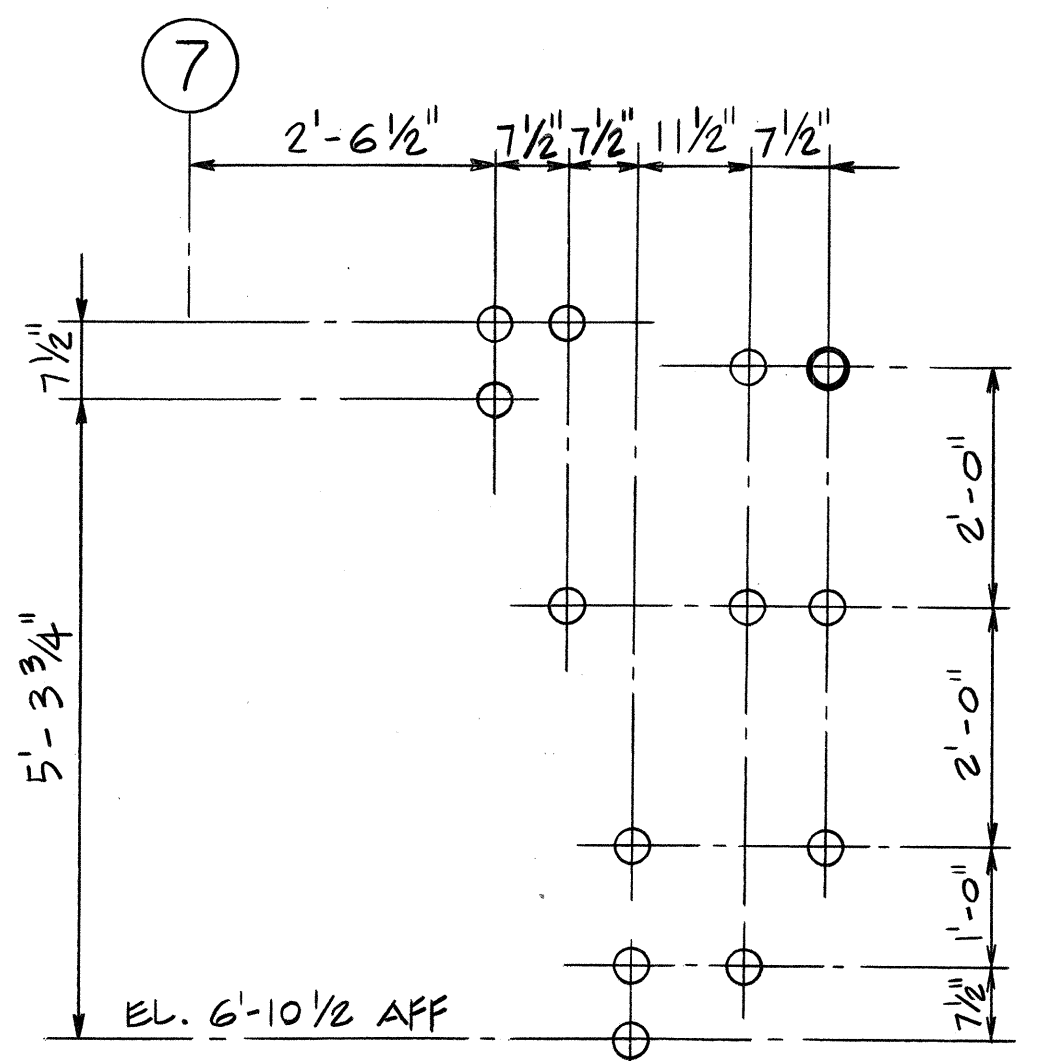


NOTE:
ALL CONDUIT SHALL
BE STUBBED-OUT
1'-0" & CAPPED.

TOP TO BOTT. LEFT TO RIGHT


4" C (P130A)	4" C (SP)	4" C (P6)	4" C (SP)
4" C (P130A)	4" C (P94)	4" C (P1)	4" C (SP)
		3" C (C101)	4" C (P208)
		4" C (P201)	4" C (C32)
		4" C (P202)	

SECTION
N.T.S.

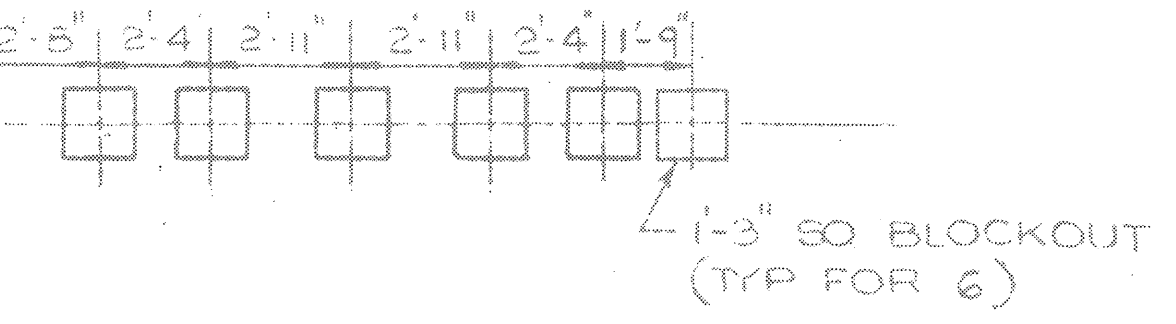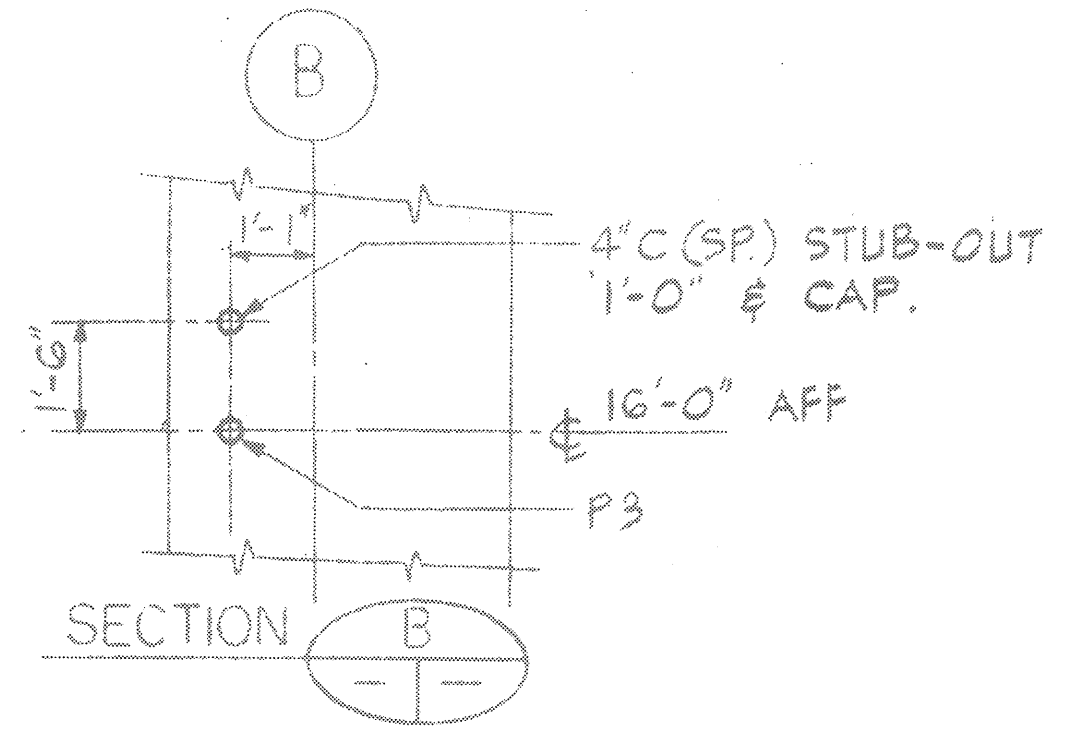

DETAIL
N.T.S.

DATE	REVISION
10/27/95	ADDENDUM 2 - ADDED CONTROL/MONITOR CABLE FROM SWITCHGEAR TO EXISTING RTU - LI (LEVEL 3)
10/13/95	ADDENDUM 1

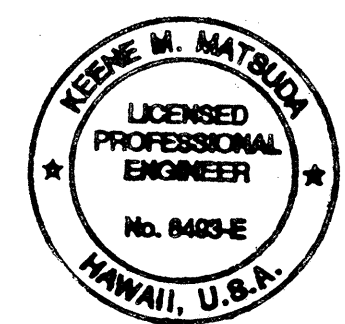


THIS WORK WAS PREPARED BY ME
OR UNDER MY SUPERVISION.
Terry Matsuda

STATE OF HAWAII
DEPARTMENT OF TRANSPORTATION
HIGHWAYS DIVISION
POWER
HALAWA PORTAL IB - LEVEL 4
EXPLORATORY TUNNEL IMPROVEMENTS
H-3 FINISH (UNIT III)
FAIP NO. I-H3-1(75) UNIT III
T.K. TUNNEL/ACCESS ROADS
SCALE: 1/8" = 1'-0" DATE: JUN 1995
SHEET NO. 2E12 OF 30 SHEETS

DESIGNED BY	NOV 94
CHECKED BY	NOV 94
NOTED BY	NOV 94
DATE	NOV 94



FED. ROAD DIST. NO.	STATE	FED. AID PROJ. NO.	FISCAL YEAR	SHEET NO.	TOTAL SHEETS
		I-H3-1(75) UNIT III	1994	85	353

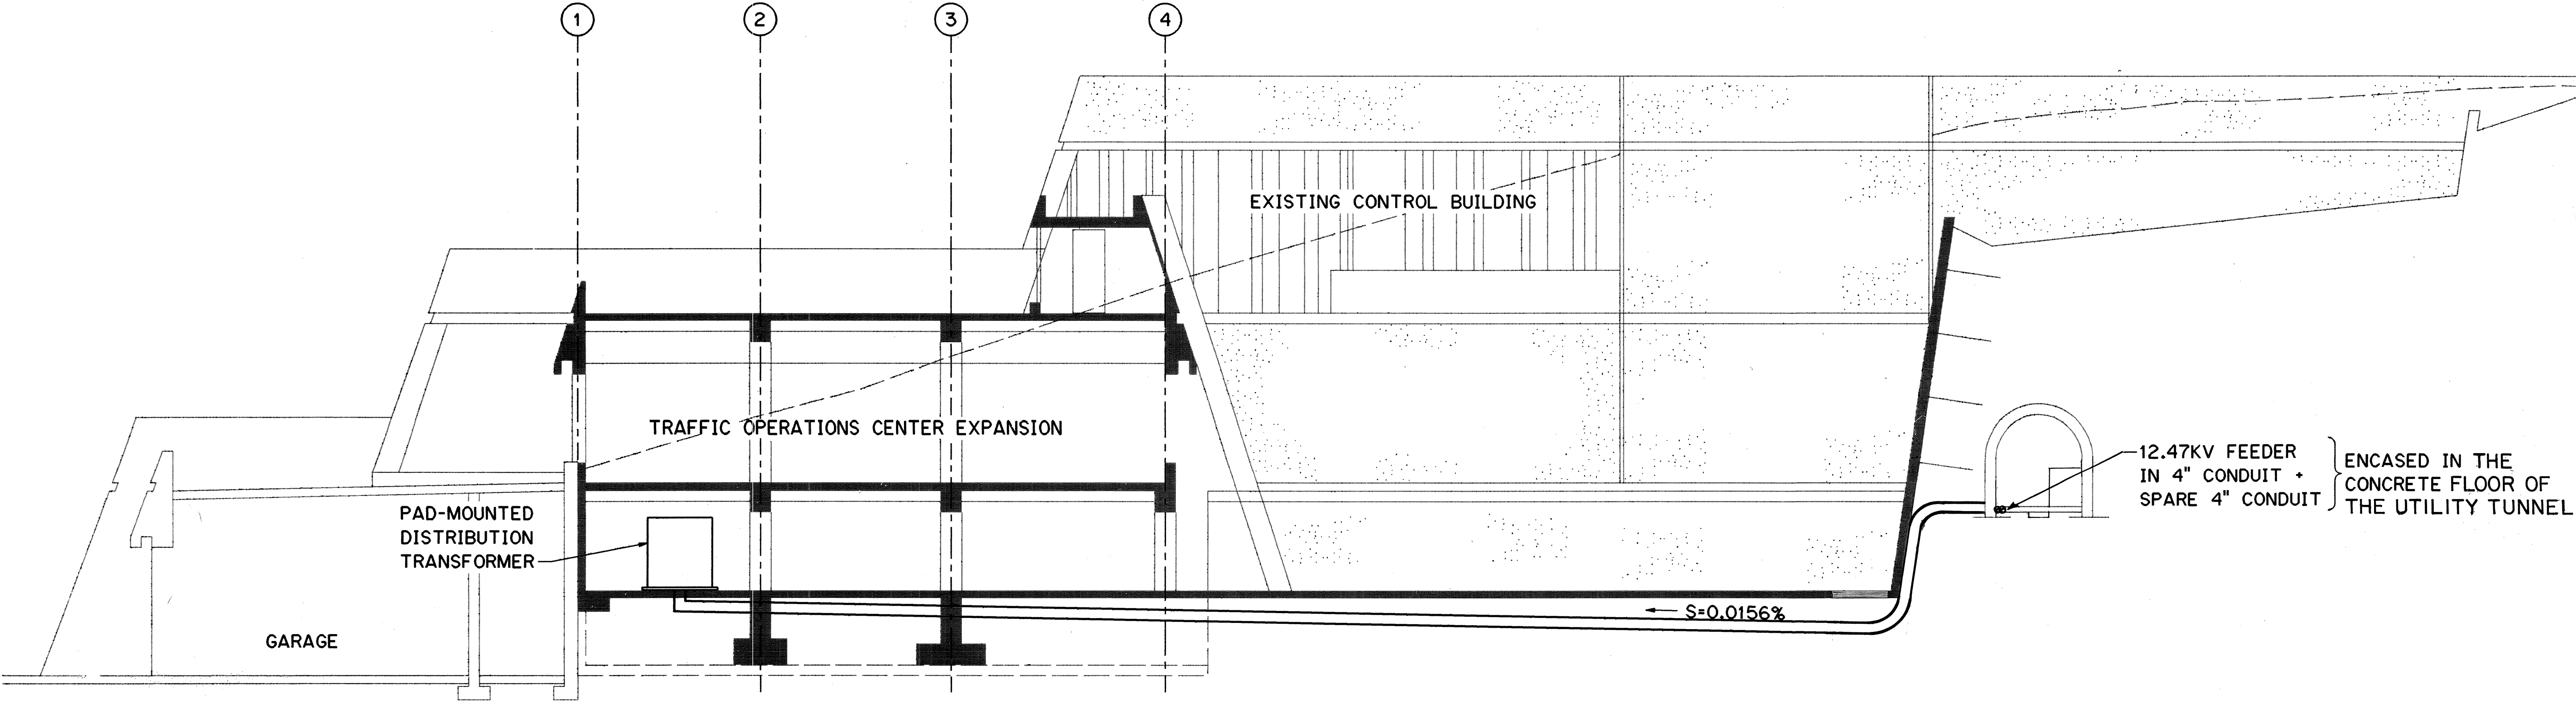

SECTION C
SCALE: 1/8" = 1'-0" 2E8 2E13

ORIGINAL PLAN	SURVEY PLOTTED BY T. BURNS	DATE APR 95
NOTE BOOK	DESIGNED BY J. HORTON	APR 95
NO.	CHECKED BY K. MATSUDA	APR 95



HERNANDEZ ELWOOD:::2410:IDWG.ELECT3E035.FGB71 12JUN95-14.11.40

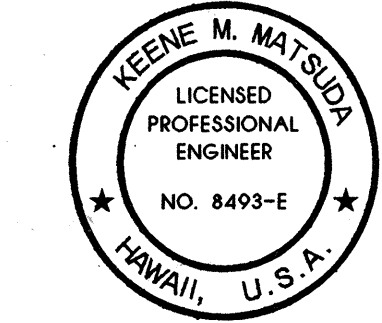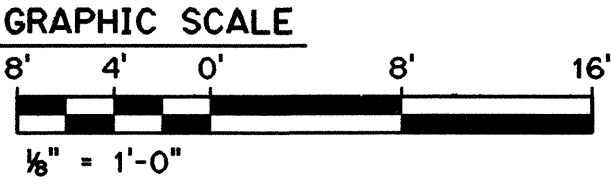


THIS WORK WAS PREPARED BY ME
OR UNDER MY SUPERVISION
Keene Matsuda

10/13/95	ADDENDUM I
DATE	REVISION
STATE OF HAWAII DEPARTMENT OF TRANSPORTATION HIGHWAYS DIVISION	
POWER HALAWA PORTAL	
SECTIONS	
EXPLORATORY TUNNEL IMPROVEMENTS	
H-3 FINISH (UNIT III)	
FAIP NO. I-H3-1(75), UNIT III	
T.K. TUNNEL/ACCESS ROADS	
SCALE: 1/8" = 1'-0"	DATE: JUN 1995
SHEET NO. 2E13	OF 30 SHEETS

FED. ROAD DIST. NO.	STATE	FED. AID PROJ. NO.	FISCAL YEAR	SHEET NO.	TOTAL SHEETS
HAWAII	HAW.	I-H3-1(75) UNIT III	1994	86	353

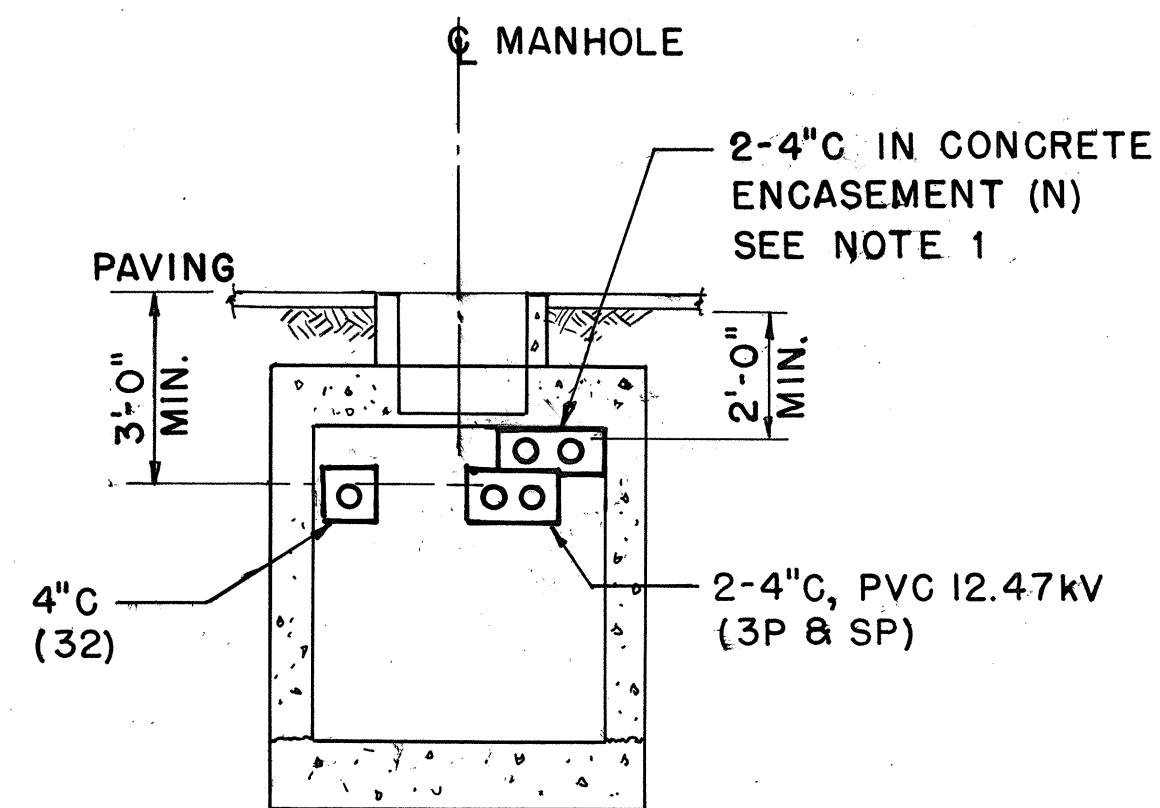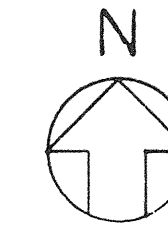


SECTION A
SCALE: 1/4"=1'-0"

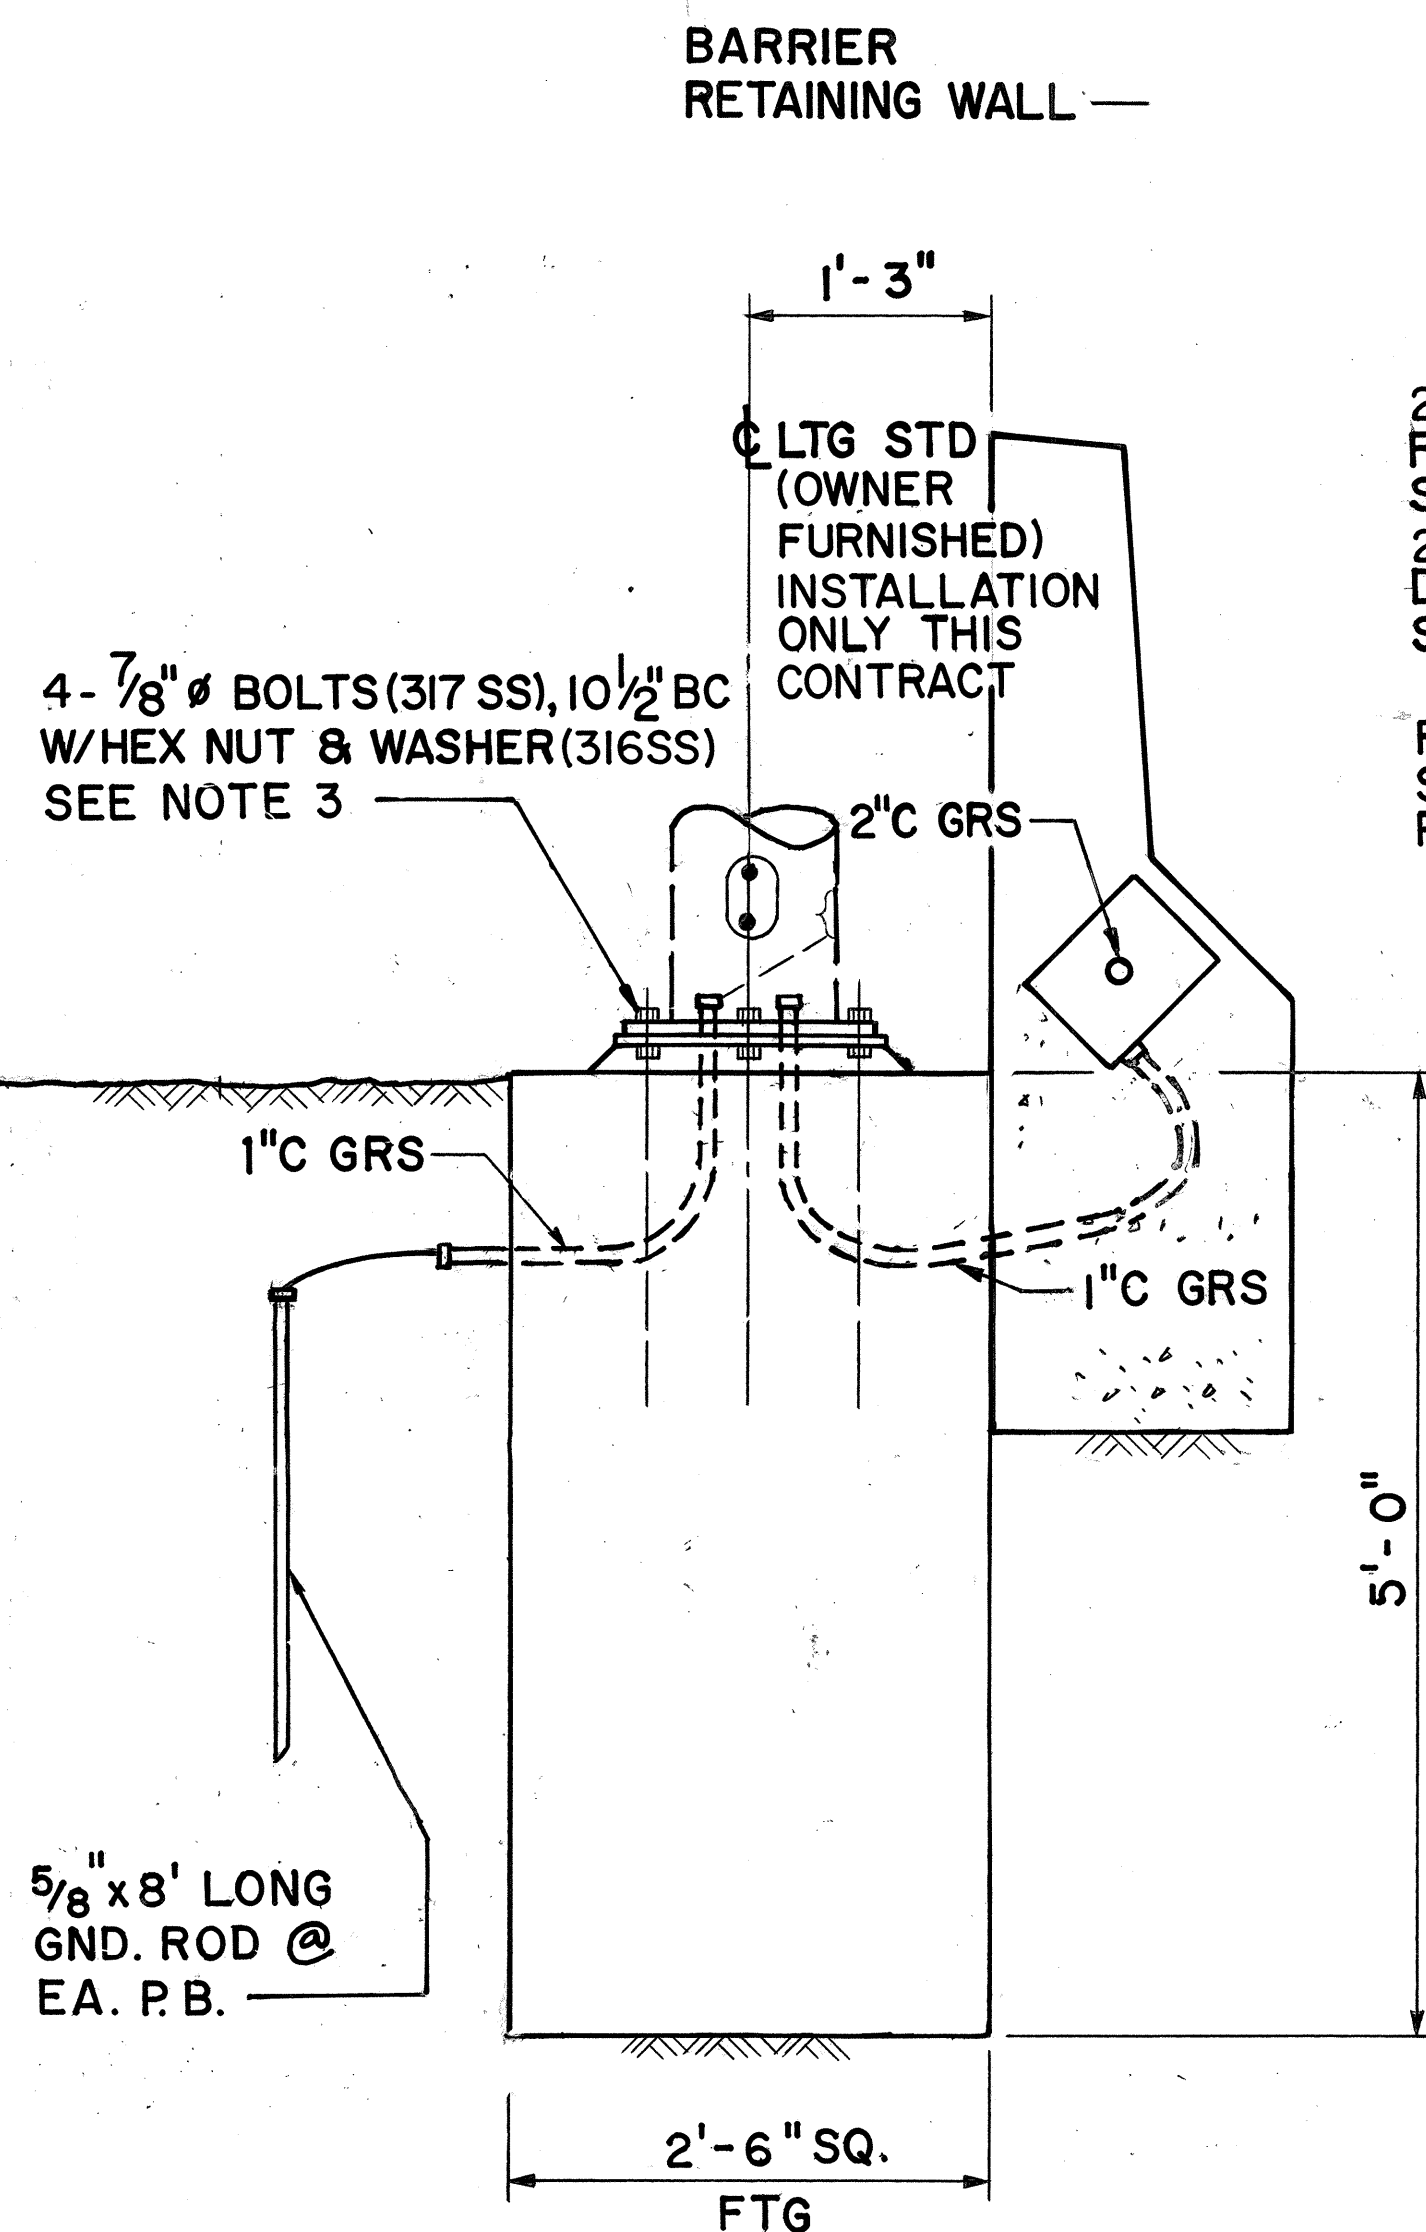

ALL WORK SHOWN THIS SECTION IS (N)- SEE NOTE 1

SECTION N
 SCALE: 1" = 1'-0"

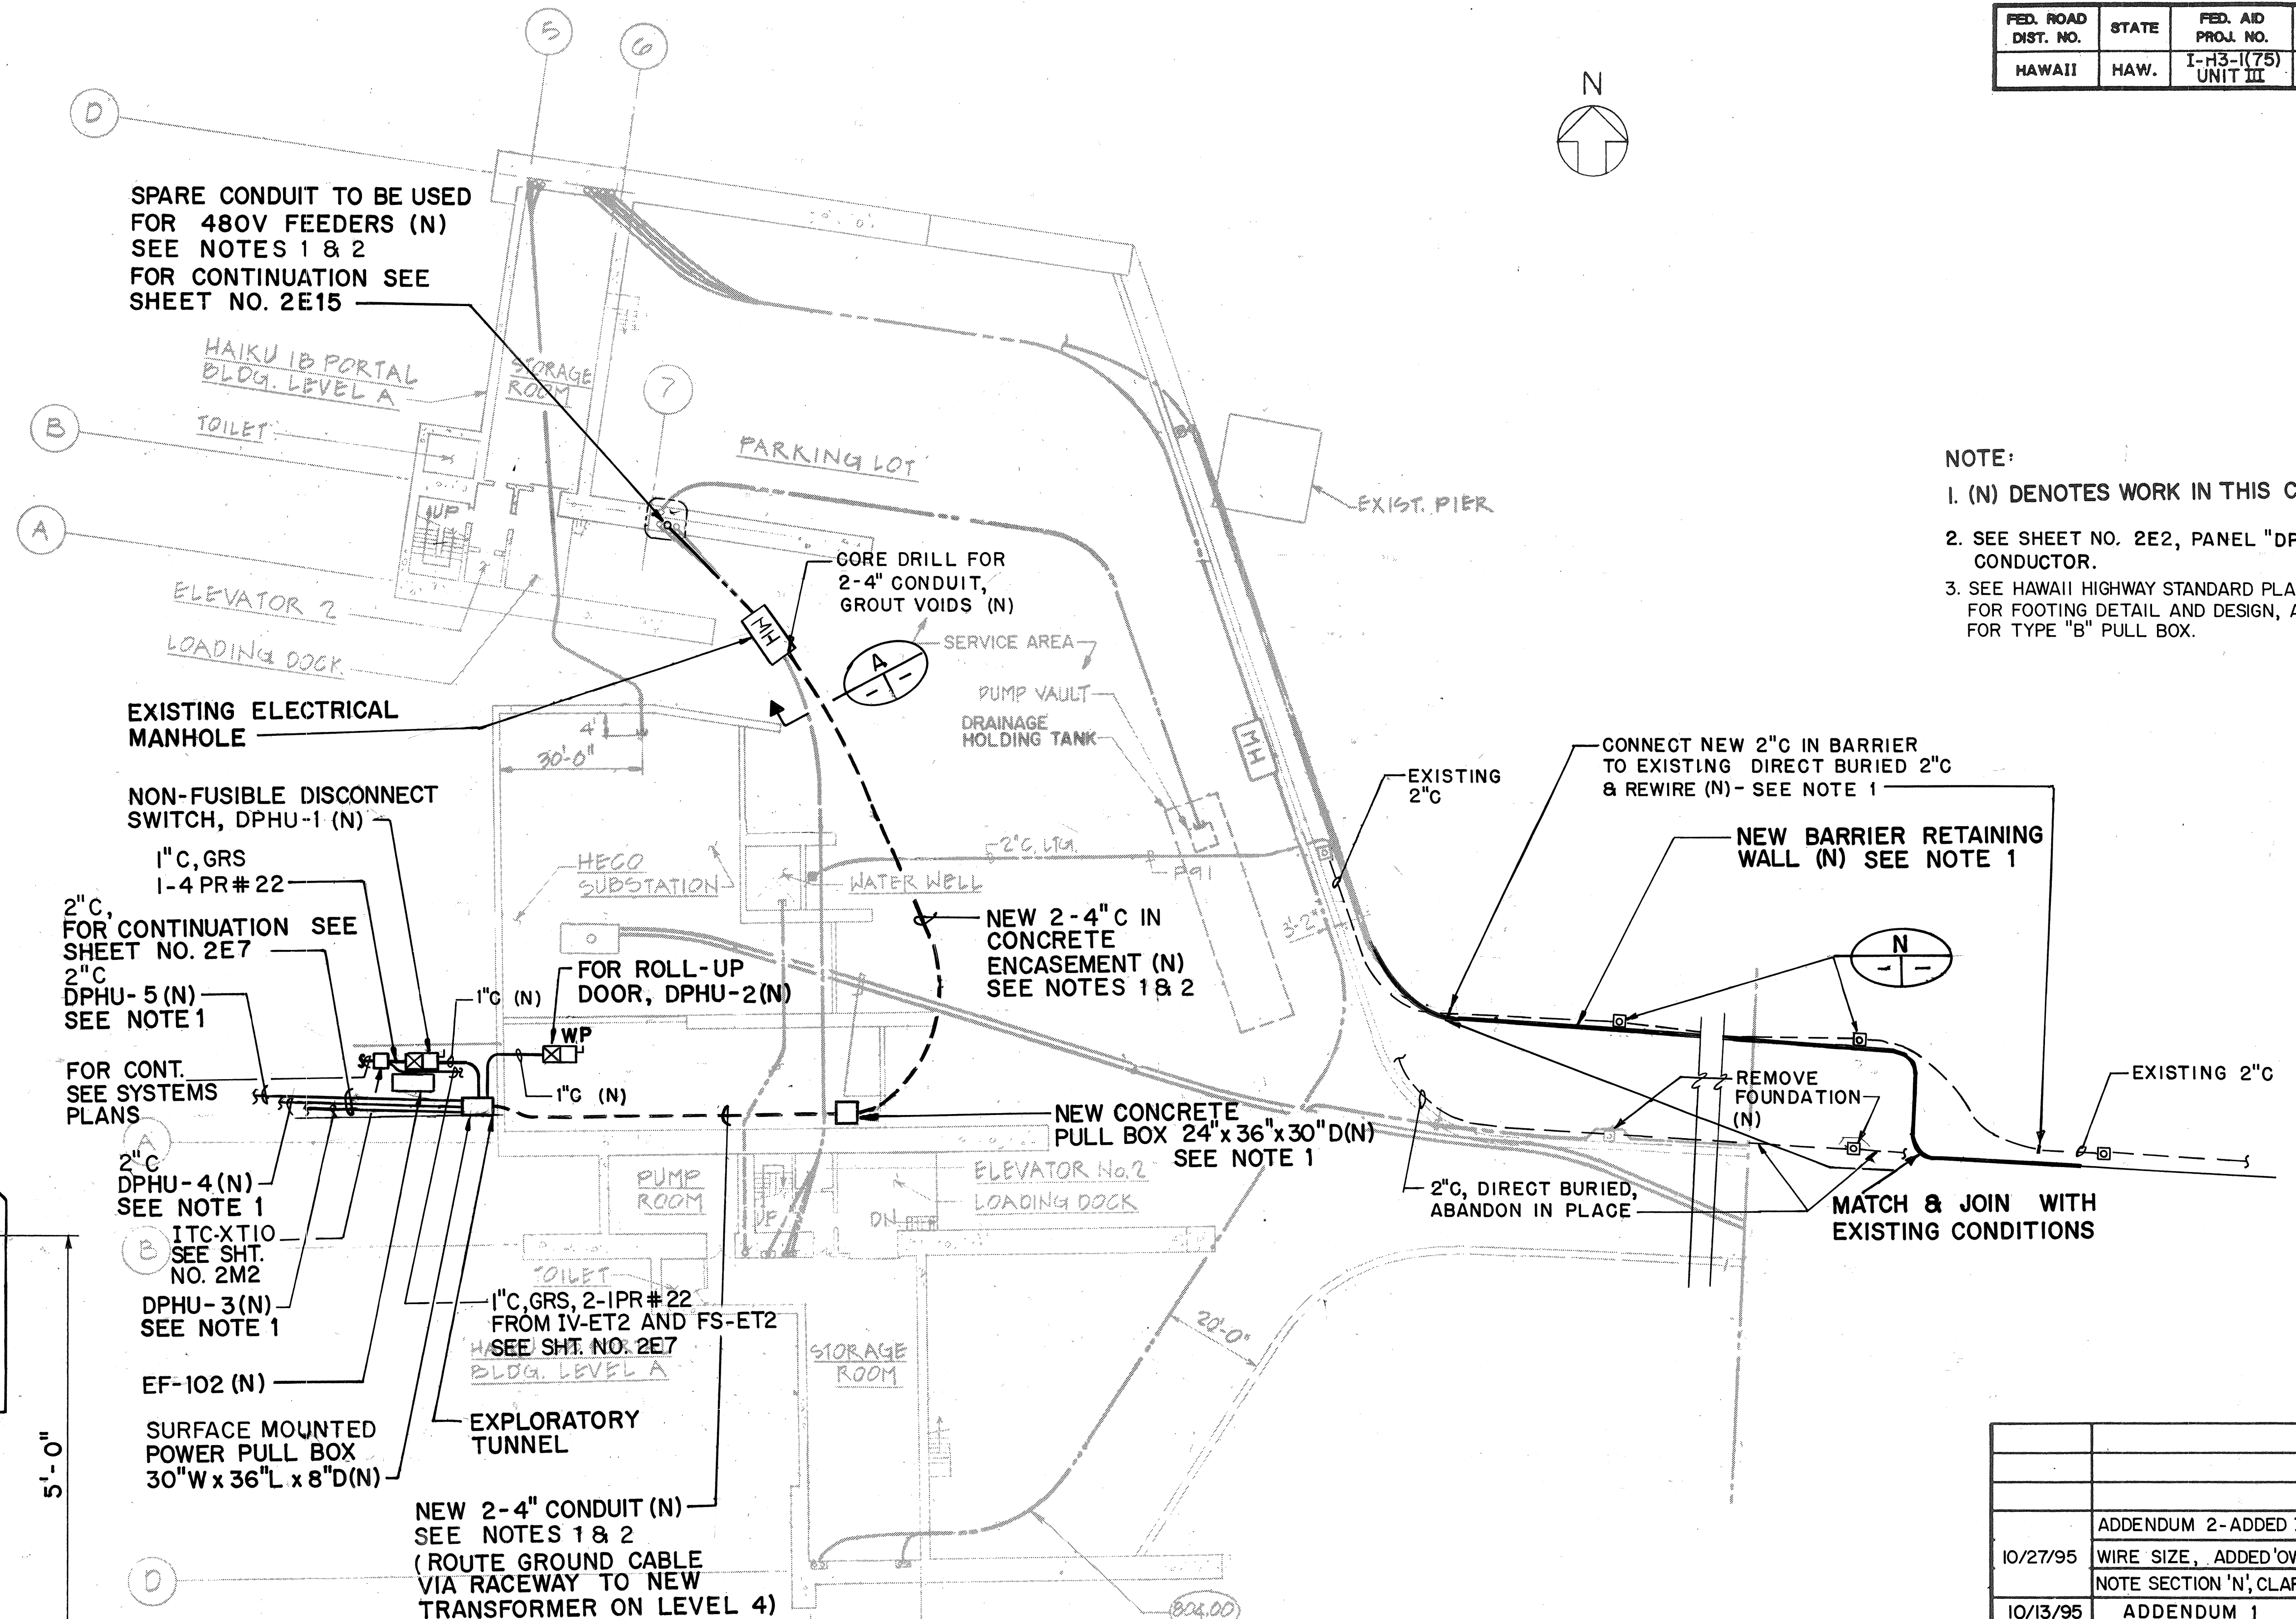


NOTE:

1. (N) DENOTES WORK IN THIS CONTRACT.
2. SEE SHEET NO. 2E2, PANEL "DPHU" FOR CONDUCTOR.
3. SEE HAWAII HIGHWAY STANDARD PLANS "TE-39" FOR FOOTING DETAIL AND DESIGN, AND "TE-41" FOR TYPE "B" PULL BOX.


	ADDENDUM 2- ADDED ITC-XTIO & CONTROL
10/27/95	WIRE SIZE, ADDED 'OWNER FURNISHED' NOTE SECTION 'N', CLARIFIED NOTES
10/13/95	ADDENDUM 1
DATE	REVISION

STATE OF HAWAII
DEPARTMENT OF TRANSPORTATION
HIGHWAYS DIVISION
POWER
HAIKU APPROACH PLAN
EXPLORATORY TUNNEL IMPROVEMENTS
H-3 FINISH (UNIT III)
FAIP NO. I-H3-I(75), UNIT III
T.K. TUNNEL/ACCESS ROADS
SCALE: 1" = 20' DATE: JUN 1995
SHEET NO. 2E14 OF 30 SHEETS

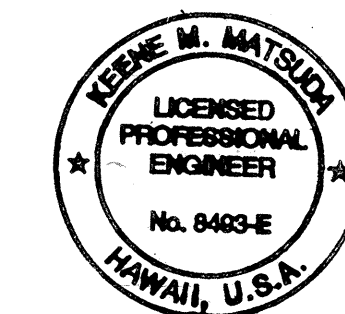

THIS WORK WAS PREPARED BY ME
OR UNDER MY SUPERVISION.

Keene Matilda

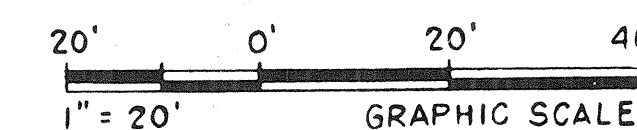

[illegible]

GRAPHIC SCALE

8' 4' 0' 8'

$\frac{1}{8}'' = 1'-0''$

87



GRAPHIC SCALE


A horizontal scale bar with alternating black and white segments. Above the bar, markings are labeled 8', 4', 0', 8', and 16'. Below the bar, the text $\frac{1}{8}" = 1'-0"$ is written.

ORIGINAL PLAN	SURVEY PLOTTED BY DRAWN BY	S. KONIG	DATE NOV 94
NOTE BOOK	TRACED BY DESIGNED BY	T. SANCHEZ	NOV 94
NO.	QUANTITIES BY CHECKED BY	L. MATSUDA	DEC 94

GRAPHIC SCALE

8' 4' 0' 8'

1/8" = 1'-0"

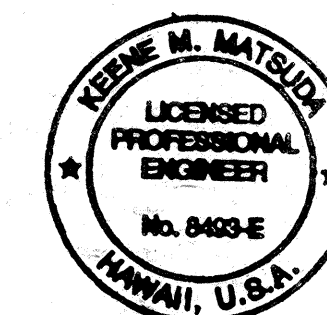


Keene Matrudd

ORIGINAL PLAN	SURVEY PLOTTED BY DRAWN BY <u>S. KONG</u>	DATE <u>NOV 94</u>
NOTE BOOK	TRACED BY DESIGNED BY <u>T. SANCHEZ</u>	<u>NOV 94</u>
NO.	QUANTITIES BY CHECKED BY <u>K. MATSUDA</u>	<u>DEC 94</u>





FED. ROAD DIST. NO.	STATE	FED. AID PROJ. NO.	FISCAL YEAR	SHEET NO.	TOTAL SHEETS
HAWAII	HAW.	I-H3-I(75) UNIT III	1994	90	353

NOTE:
I. (N) DENOTES WORK IN THIS CONTRACT.

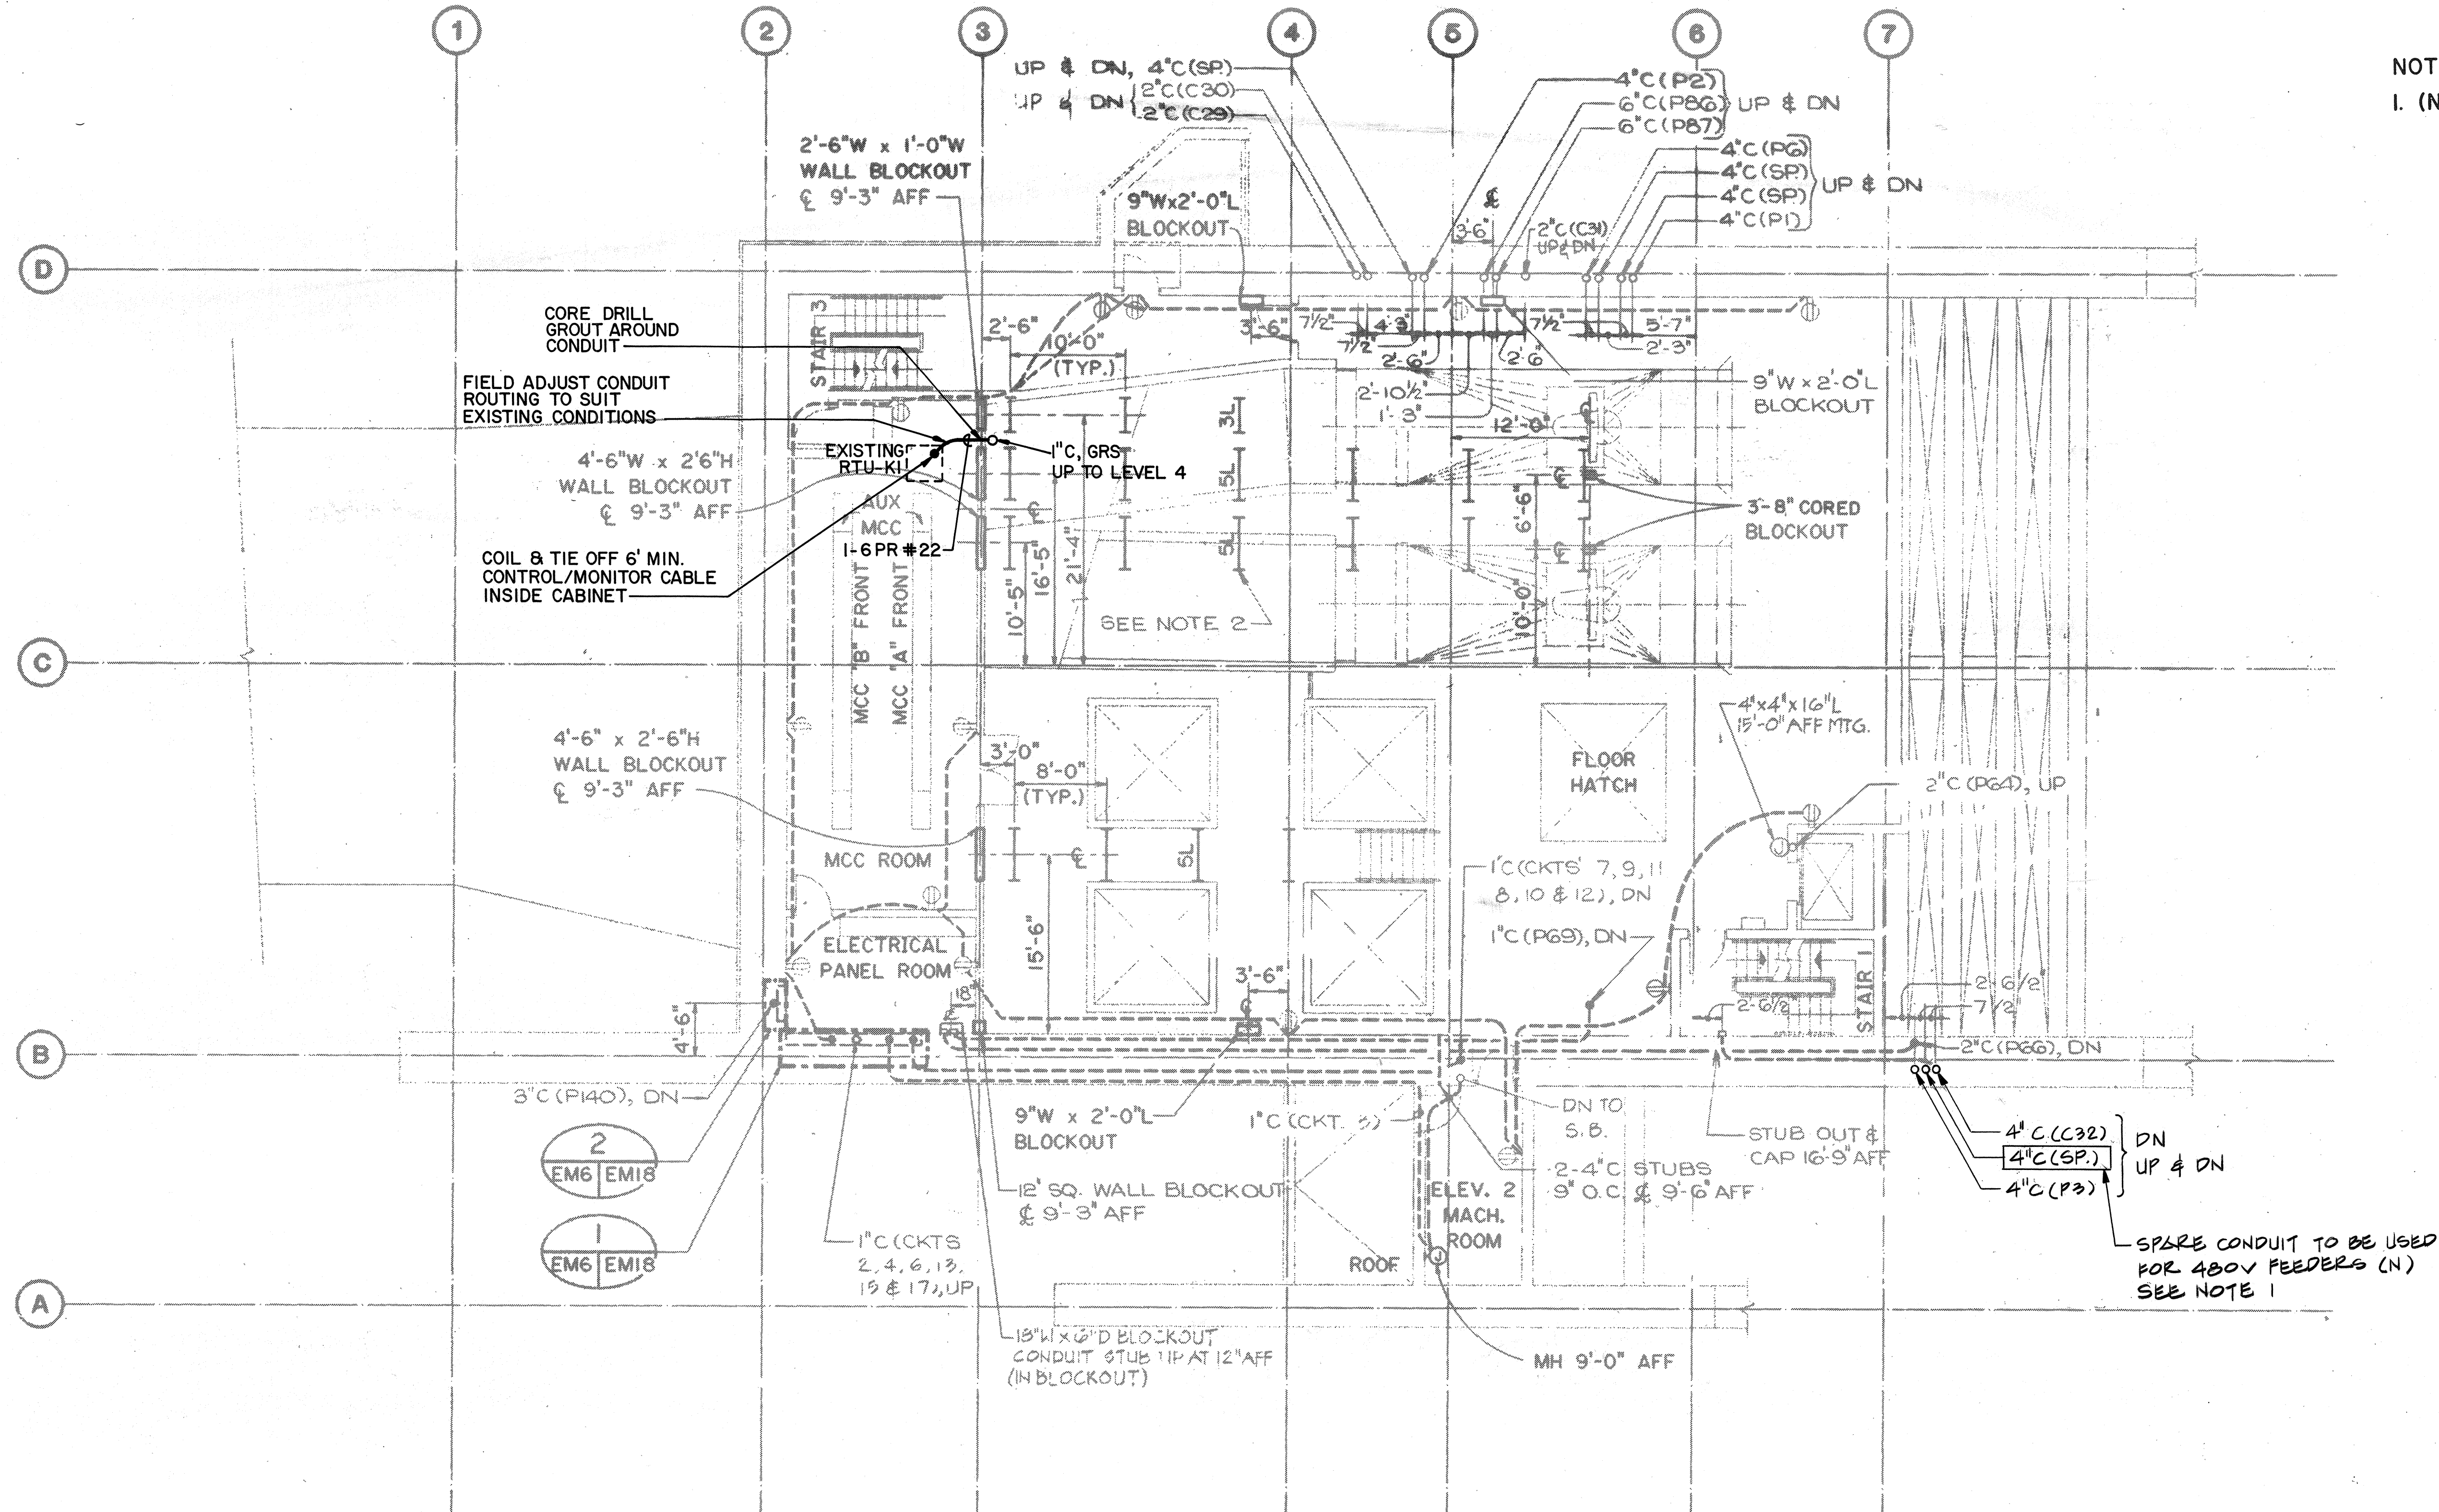


SPARE CONDUIT TO BE USED FOR ABOVE FEEDERS (N) SEE NOTE 1

DATE	NOV 94
DESIGNED BY	W. M. MATHIAS
DRAWN BY	W. M. MATHIAS
CHECKED BY	W. M. MATHIAS
ORIGINAL PLAN	NO
NOTE BOOK	NO

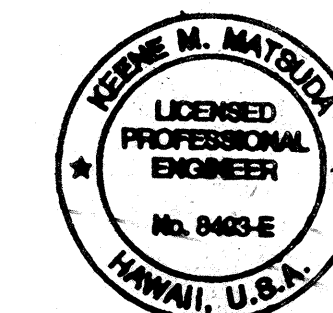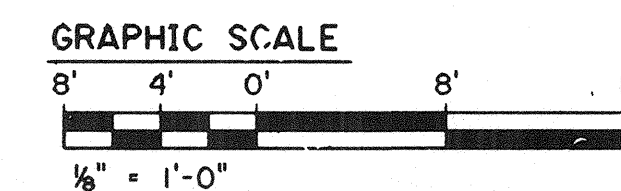




THIS WORK WAS PREPARED BY ME OR UNDER MY SUPERVISION.
W. M. Mathias

10/27/95	ADDENDUM 2-ADDED CONTROL/MONITOR CABLE FROM SWITCHGEAR (LEVEL 4) TO EXISTING RTU-KI
DATE	REVISION
STATE OF HAWAII DEPARTMENT OF TRANSPORTATION HIGHWAYS DIVISION POWER HAIKU PORTAL IB - LEVEL 3 EXPLORATORY TUNNEL IMPROVEMENTS H-3 FINISH (UNIT III) FAIP NO. I-H3-I(75) UNIT III T.K. TUNNEL/ACCESS ROADS SCALE: 1/8" = 1'-0" DATE: JUN 1995 SHEET NO. 2E18 OF 30 SHEETS	

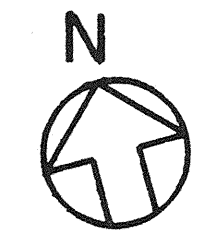


FED. ROAD DIST. NO.	STATE	FED. AID PROJ. NO.	FISCAL YEAR	SHEET NO.	TOTAL SHEETS
HAWAII	HAW.	I-H3-I(75) UNIT III	1994	91	353

NOTE:
I.(N) DENOTES WORK IN THIS CONTRACT.

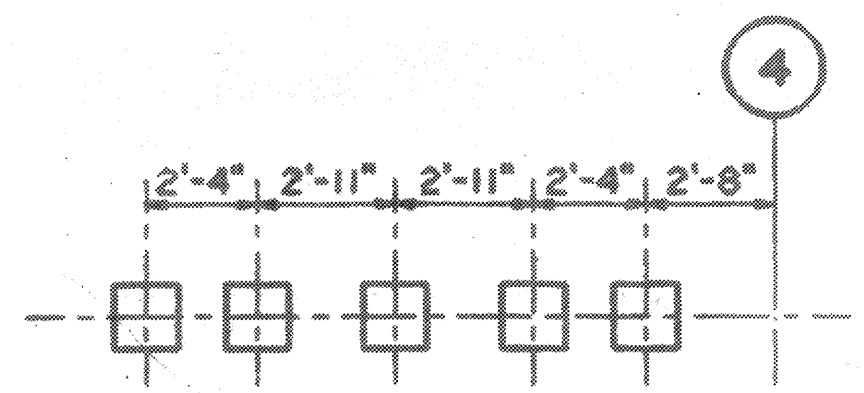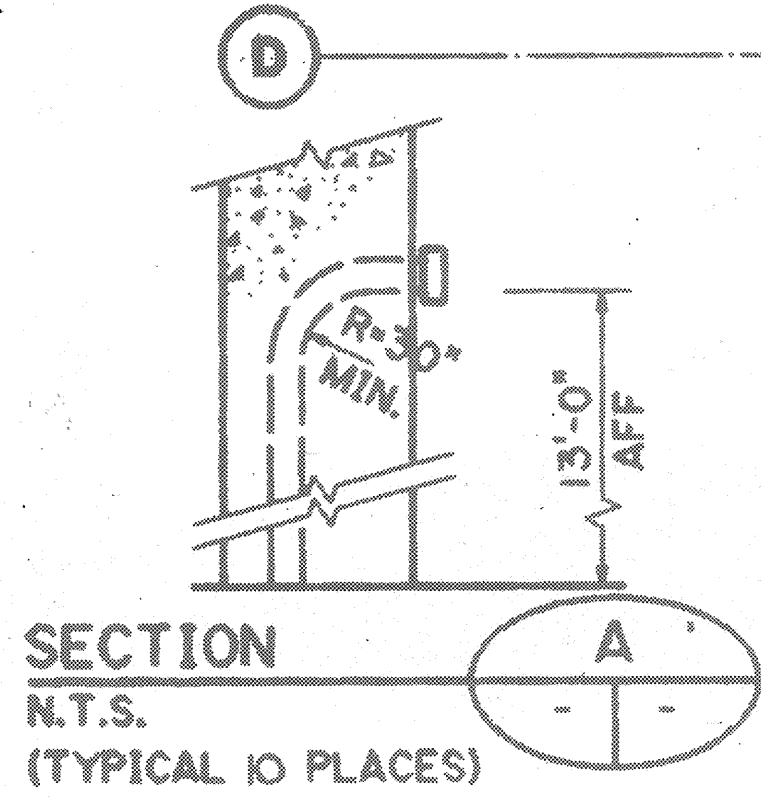
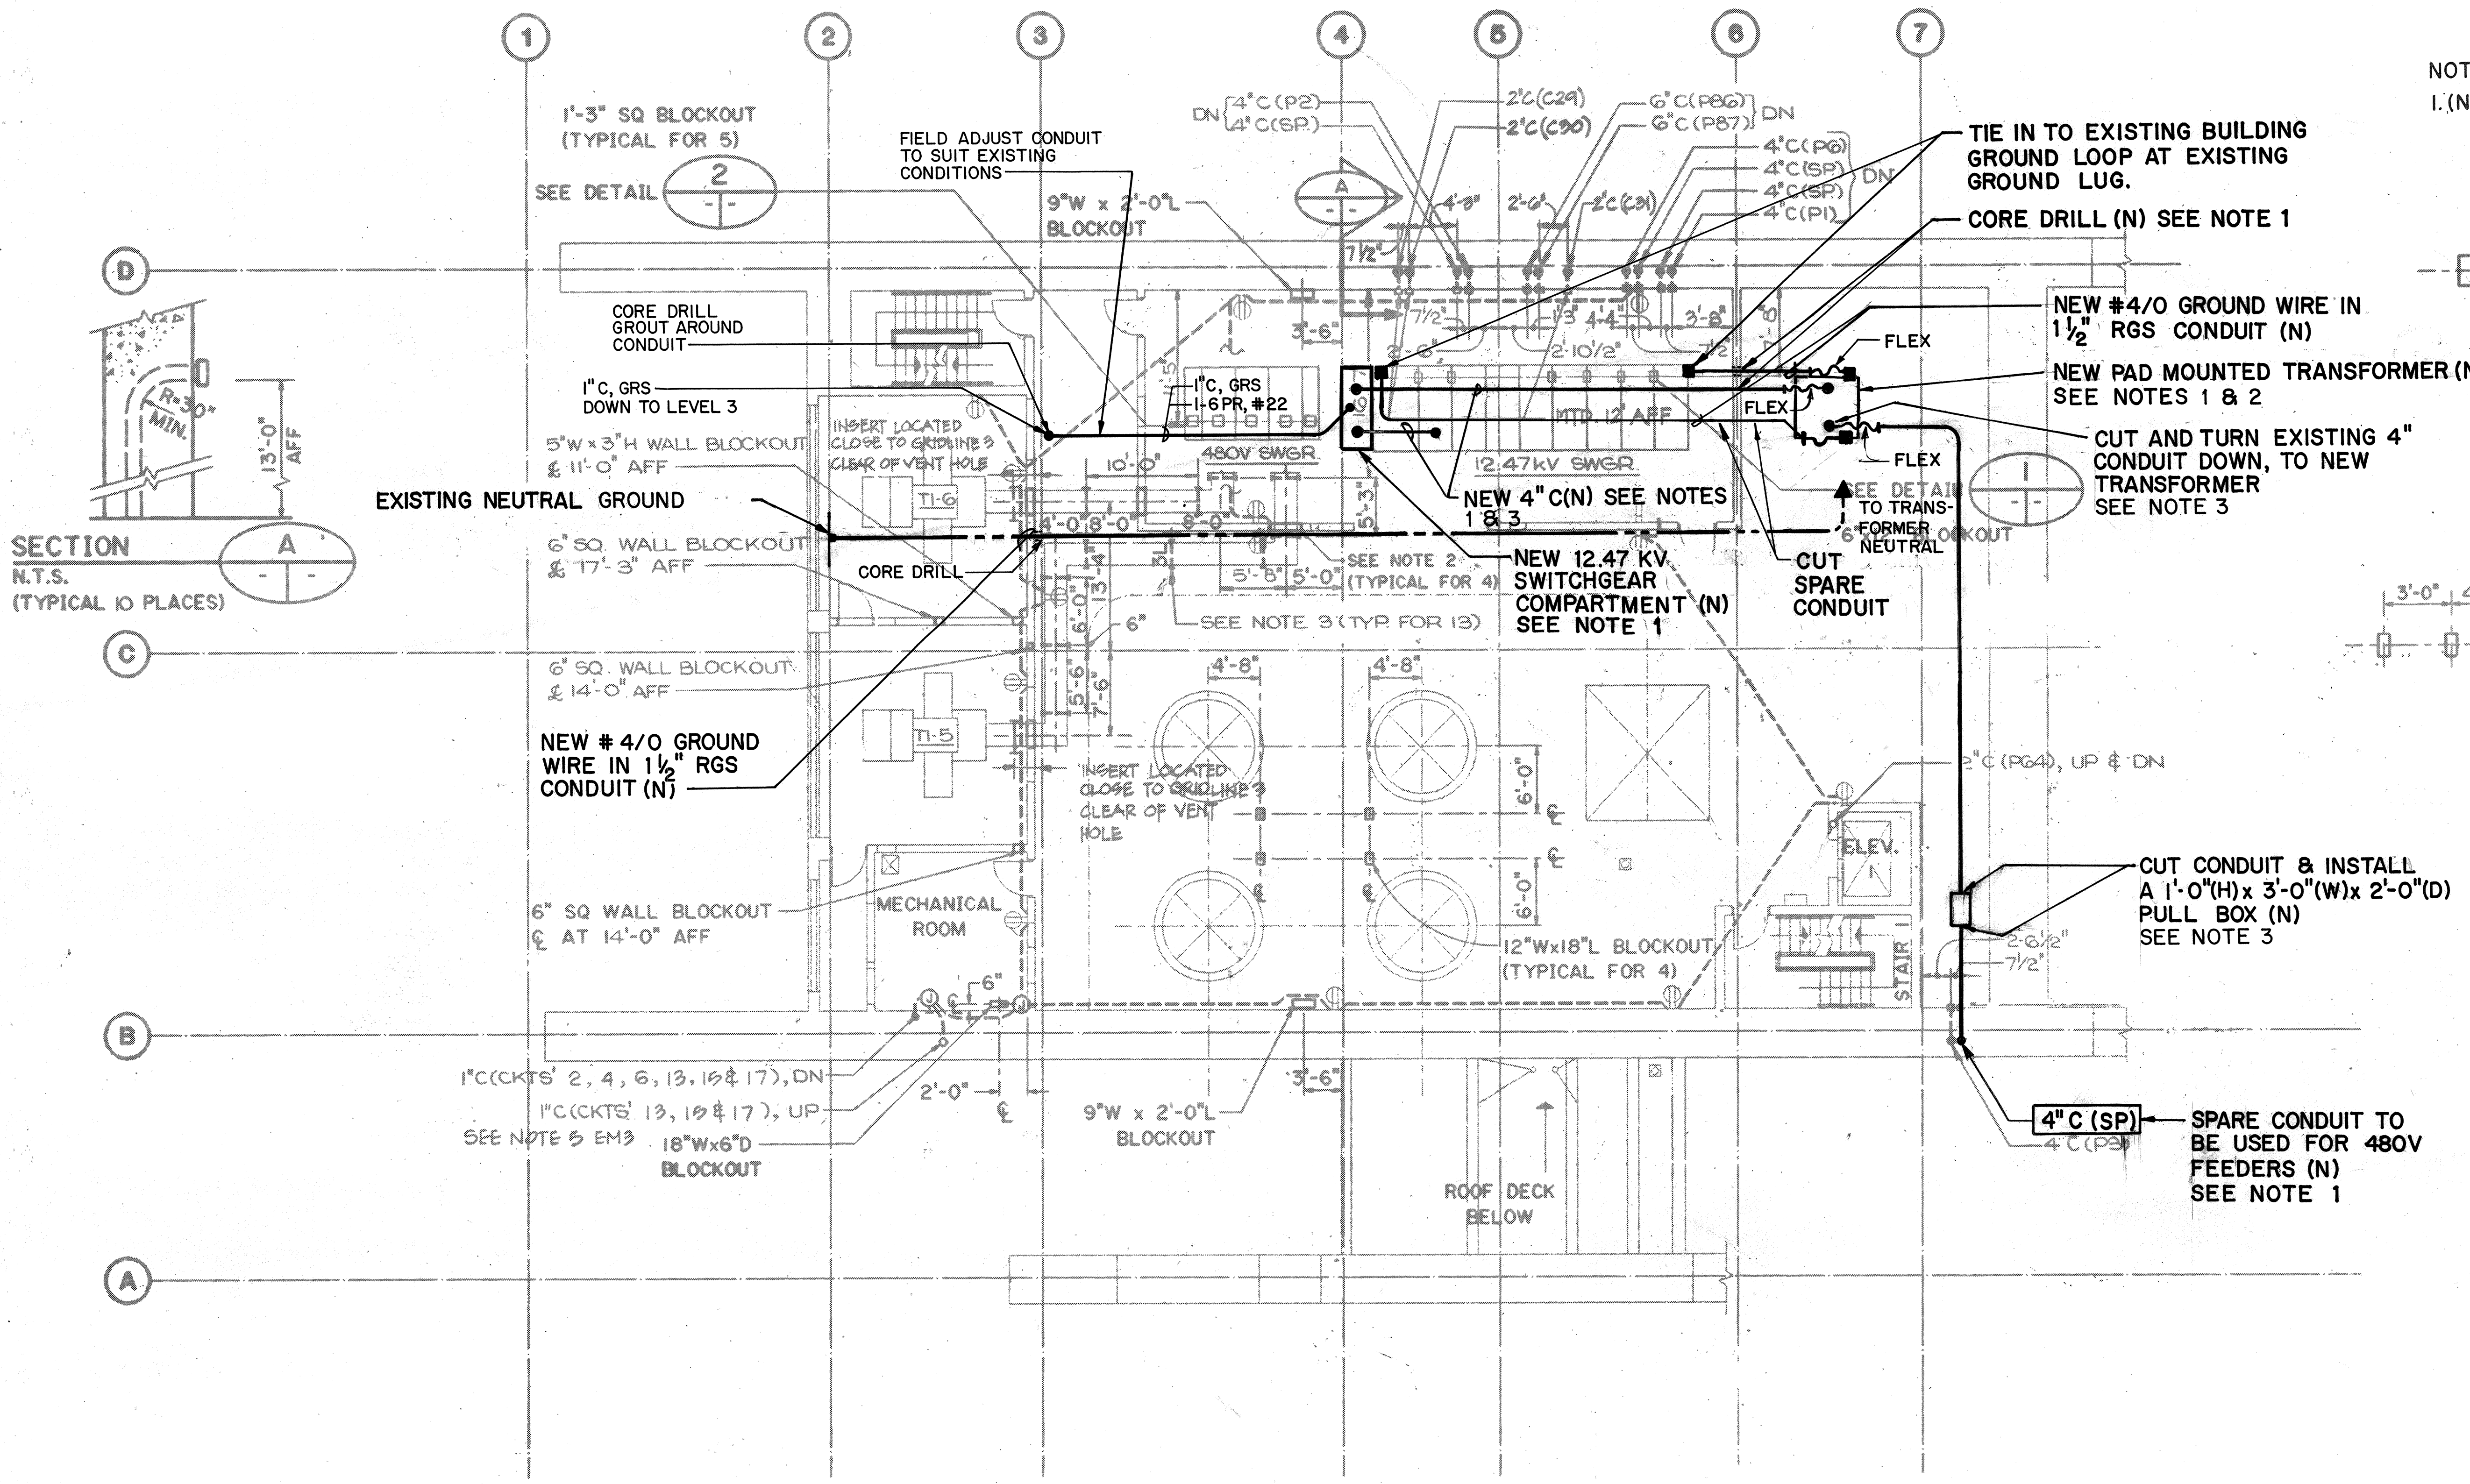


DETAIL 2
SCALE: 1/4"=1'-0"

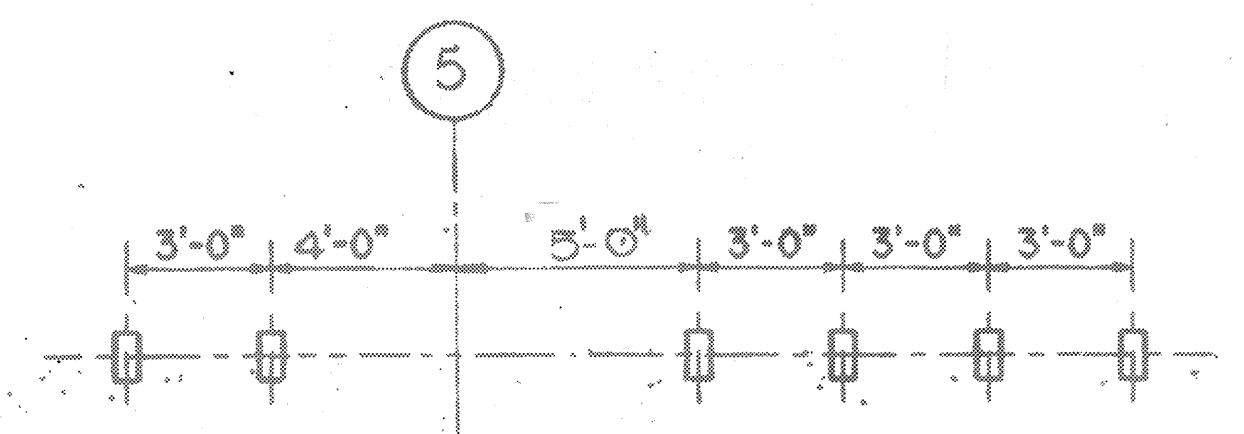

DETAIL 5
SCALE: 1/4"=1'-0"

- 2. PROVIDE FLOOR PAD ATTENUATOR FOR TRANSFORMER.
- 3. PROVIDE SEISMIC RESTRAINTS FOR RACEWAYS.

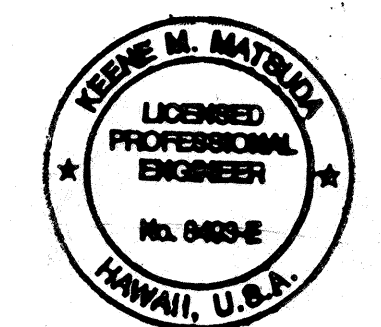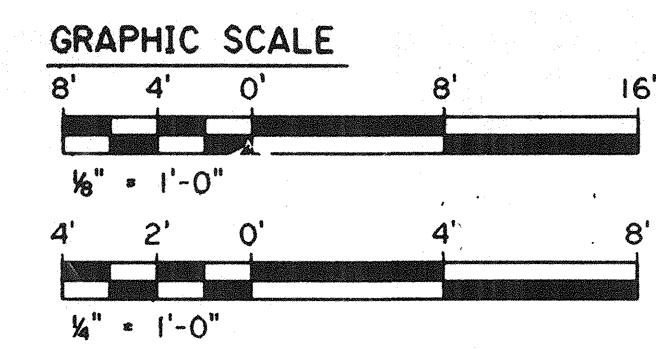


THIS WORK WAS PREPARED BY ME OR UNDER MY SUPERVISION.
Keene Matilda

DATE	REVISION
10/27/95	ADDENDUM 2-ADDED CONTROL/MONITOR CABLE FROM SWITCHGEAR TO EXISTING RTU-KI (LEVEL 3)
10/13/95	ADDENDUM 1
STATE OF HAWAII DEPARTMENT OF TRANSPORTATION HIGHWAYS DIVISION POWER HAIKU PORTAL IB - LEVEL 4 EXPLORATORY TUNNEL IMPROVEMENTS H-3 FINISH (UNIT III) FAIP NO. I-H3-I(75). UNIT III T.K. TUNNEL/ACCESS ROADS SCALE: AS NOTED DATE: JUN 1995 SHEET NO. 2E19 OF 30 SHEETS	


DESIGNED BY	NOV 94
TRACED BY	NOV 94
NOTE BOOK	NOV 94
QUANTITIES BY	NOV 94
CHECKED BY	NOV 94

FED. ROAD DIST. NO.	STATE	FED. AID PROJ. NO.	FISCAL YEAR	SHEET NO.	TOTAL SHEETS
HAWAII	HAW.	I-H3-1(75) UNIT III	1994	92	353


CROSS PASSAGE NO.	CONTINUATION OF LIGHTING CONDUIT	CONTINUATION OF POWER CONDUIT	EXHAUST FAN
1	2E2	2E5	EF-105
5	2E3	2E6	EF-107
9	2E4	2E7	EF-109
3	2E2	2E5	EF-106
7	2E3	2E6	EF-108

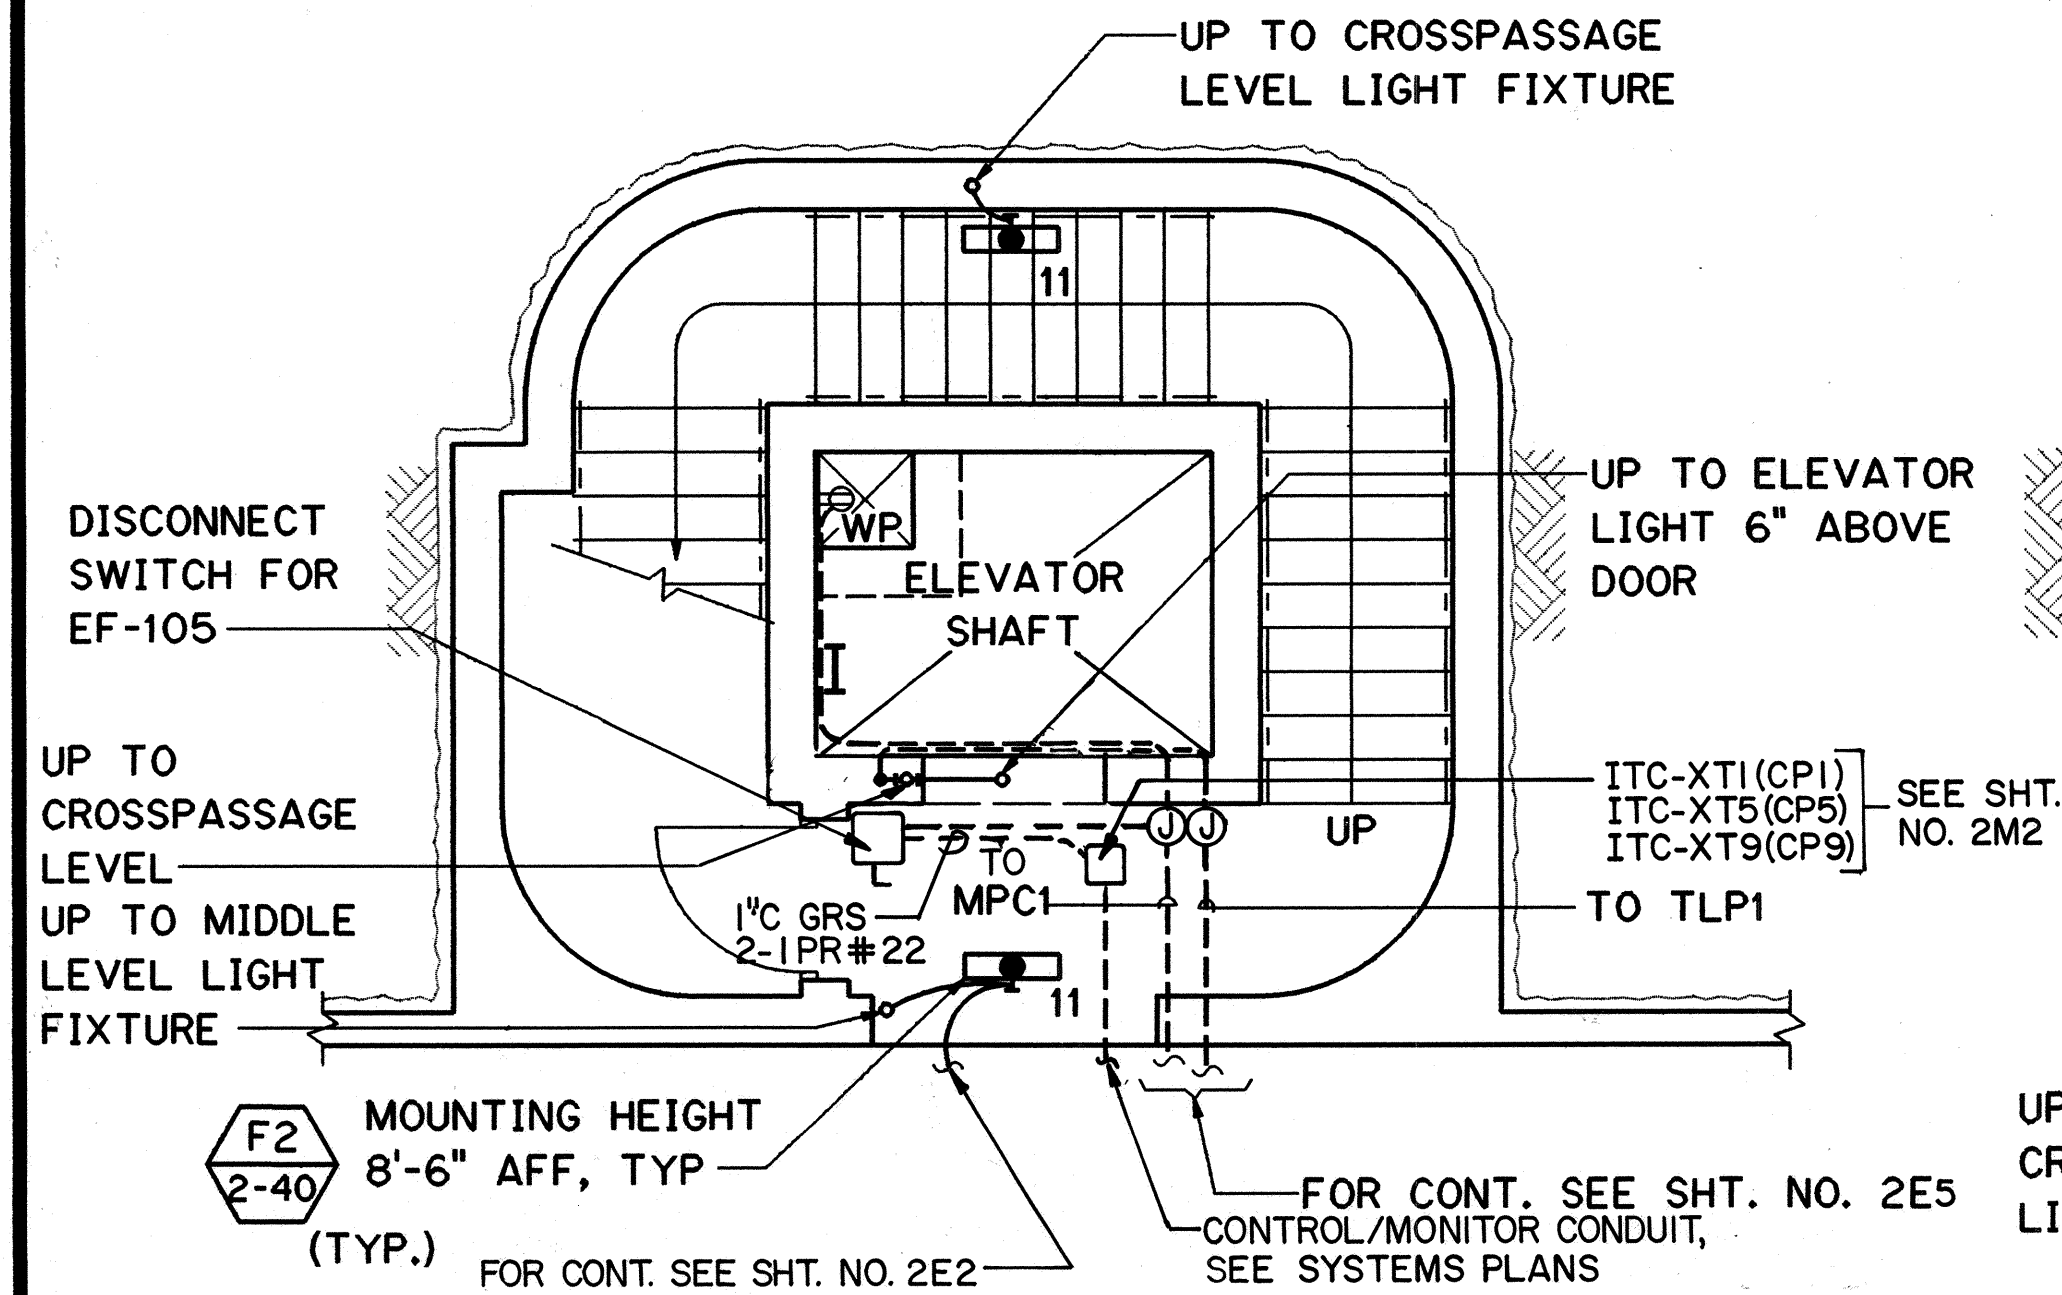

PLAN AT EXPLORATORY TUNNEL LEVEL

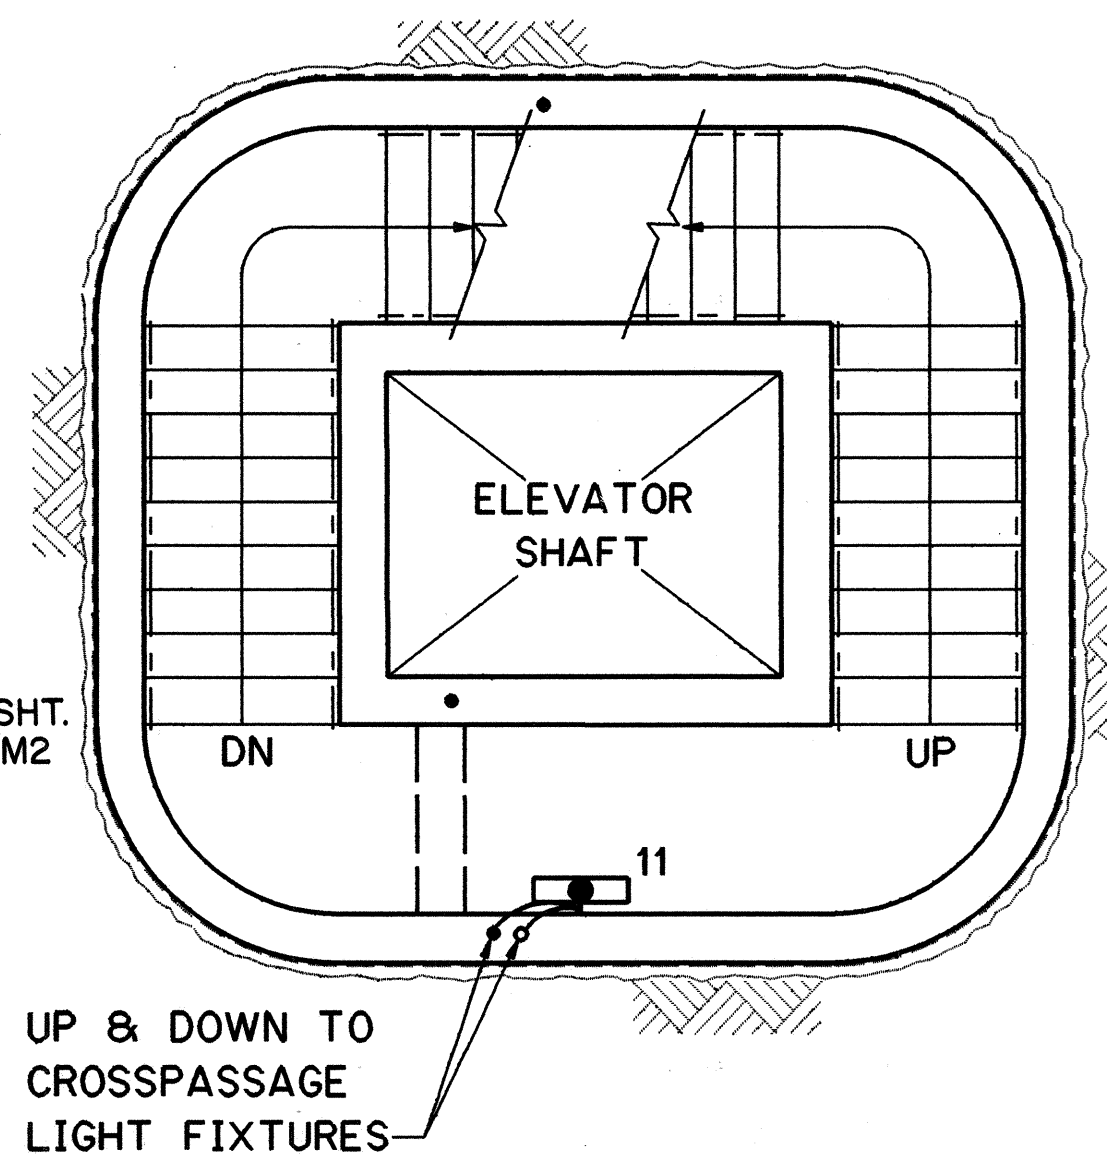


PLAN AT MIDDLE LEVEL

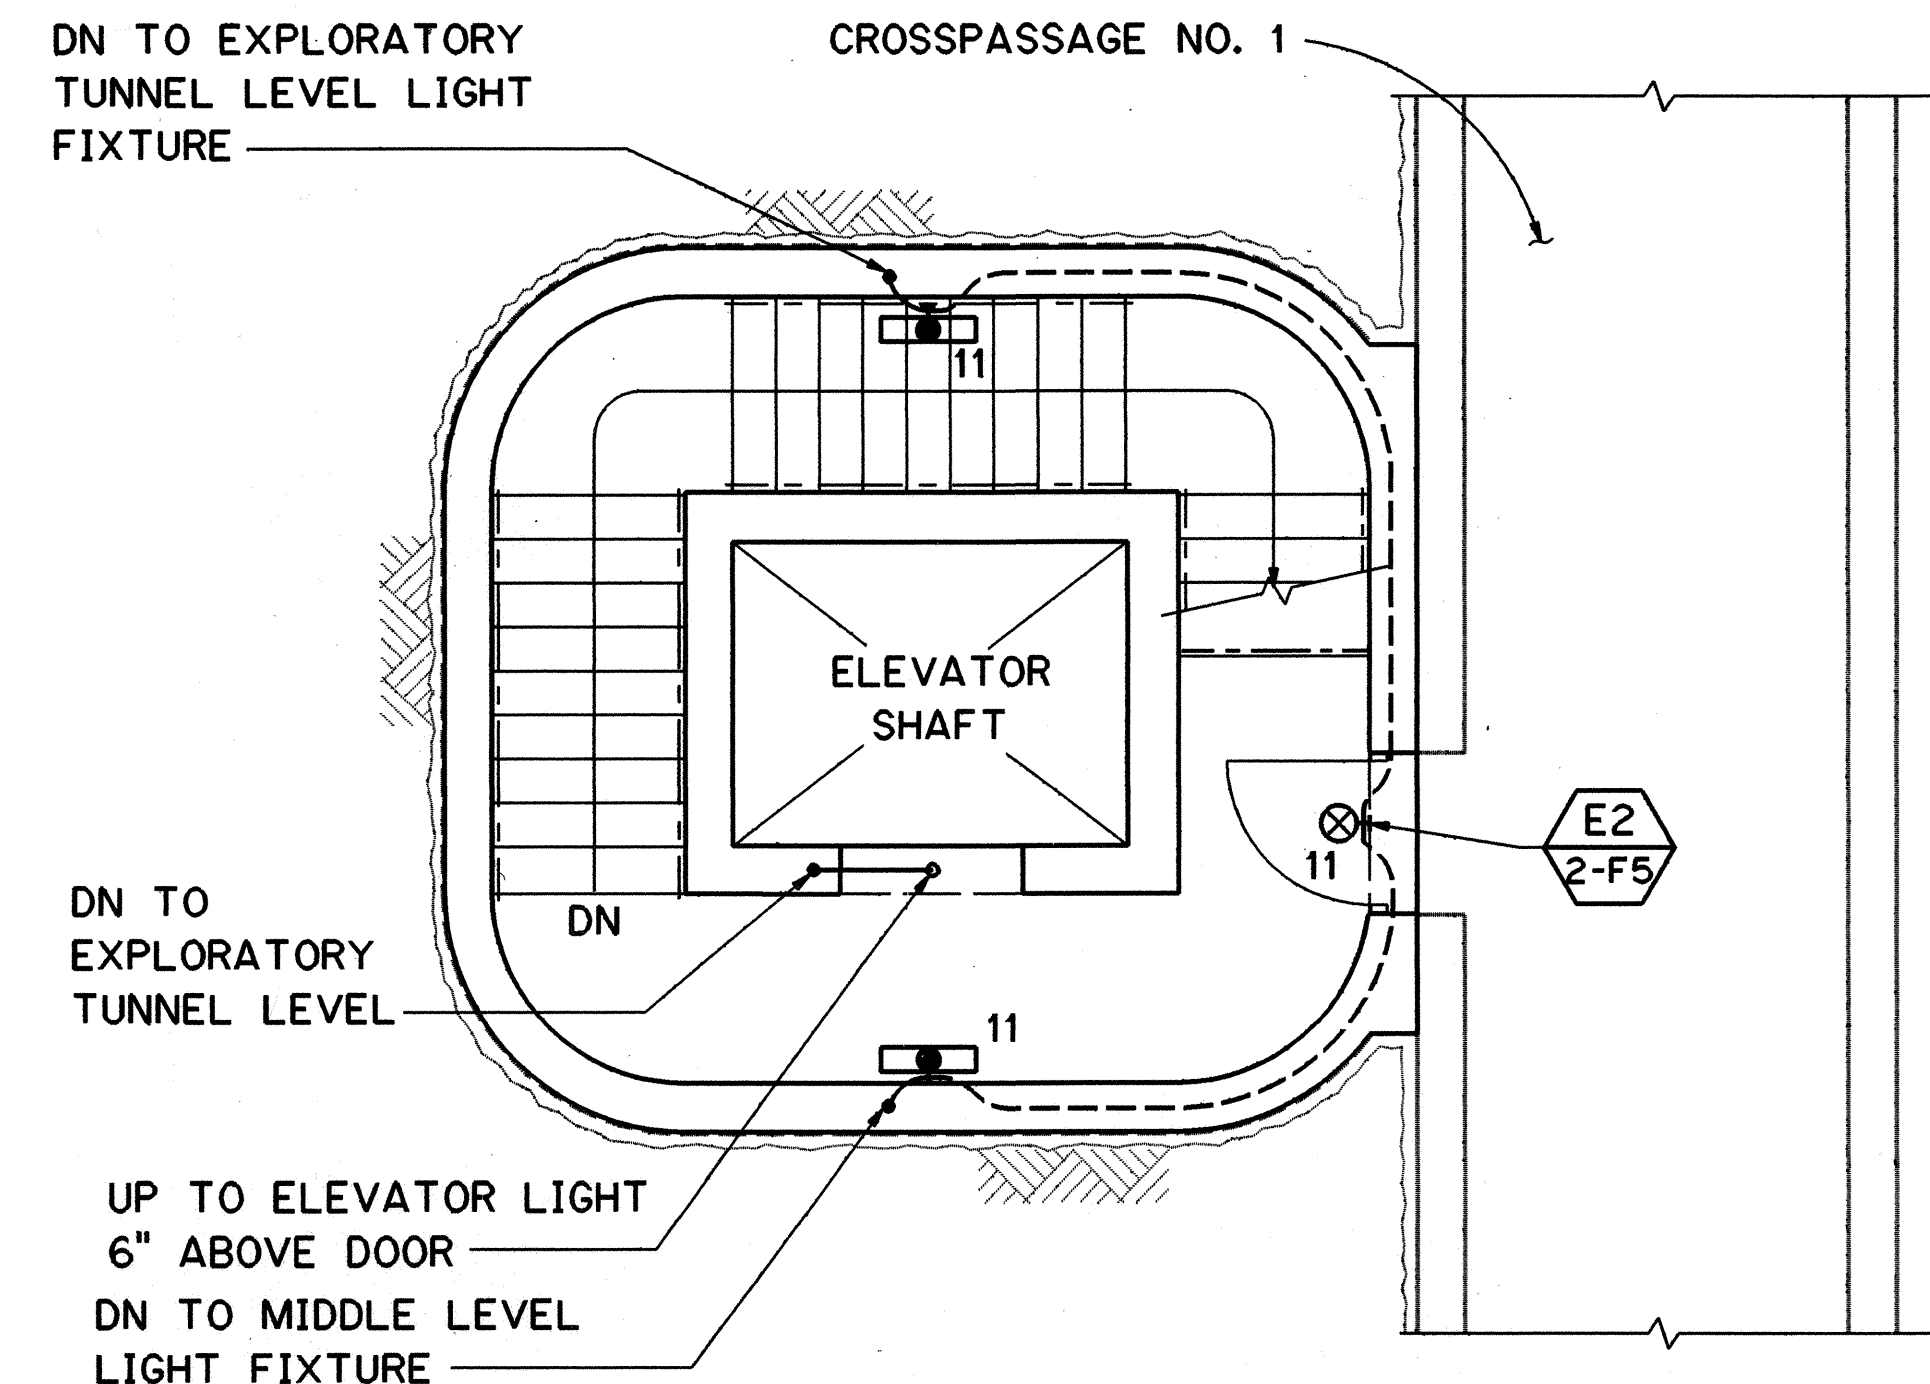


PLAN AT CROSSPASSAGE LEVEL


INSTALLATION FOR CROSSPASSAGE 1 (TYPICAL FOR CROSSPASSAGES 5 & 9)

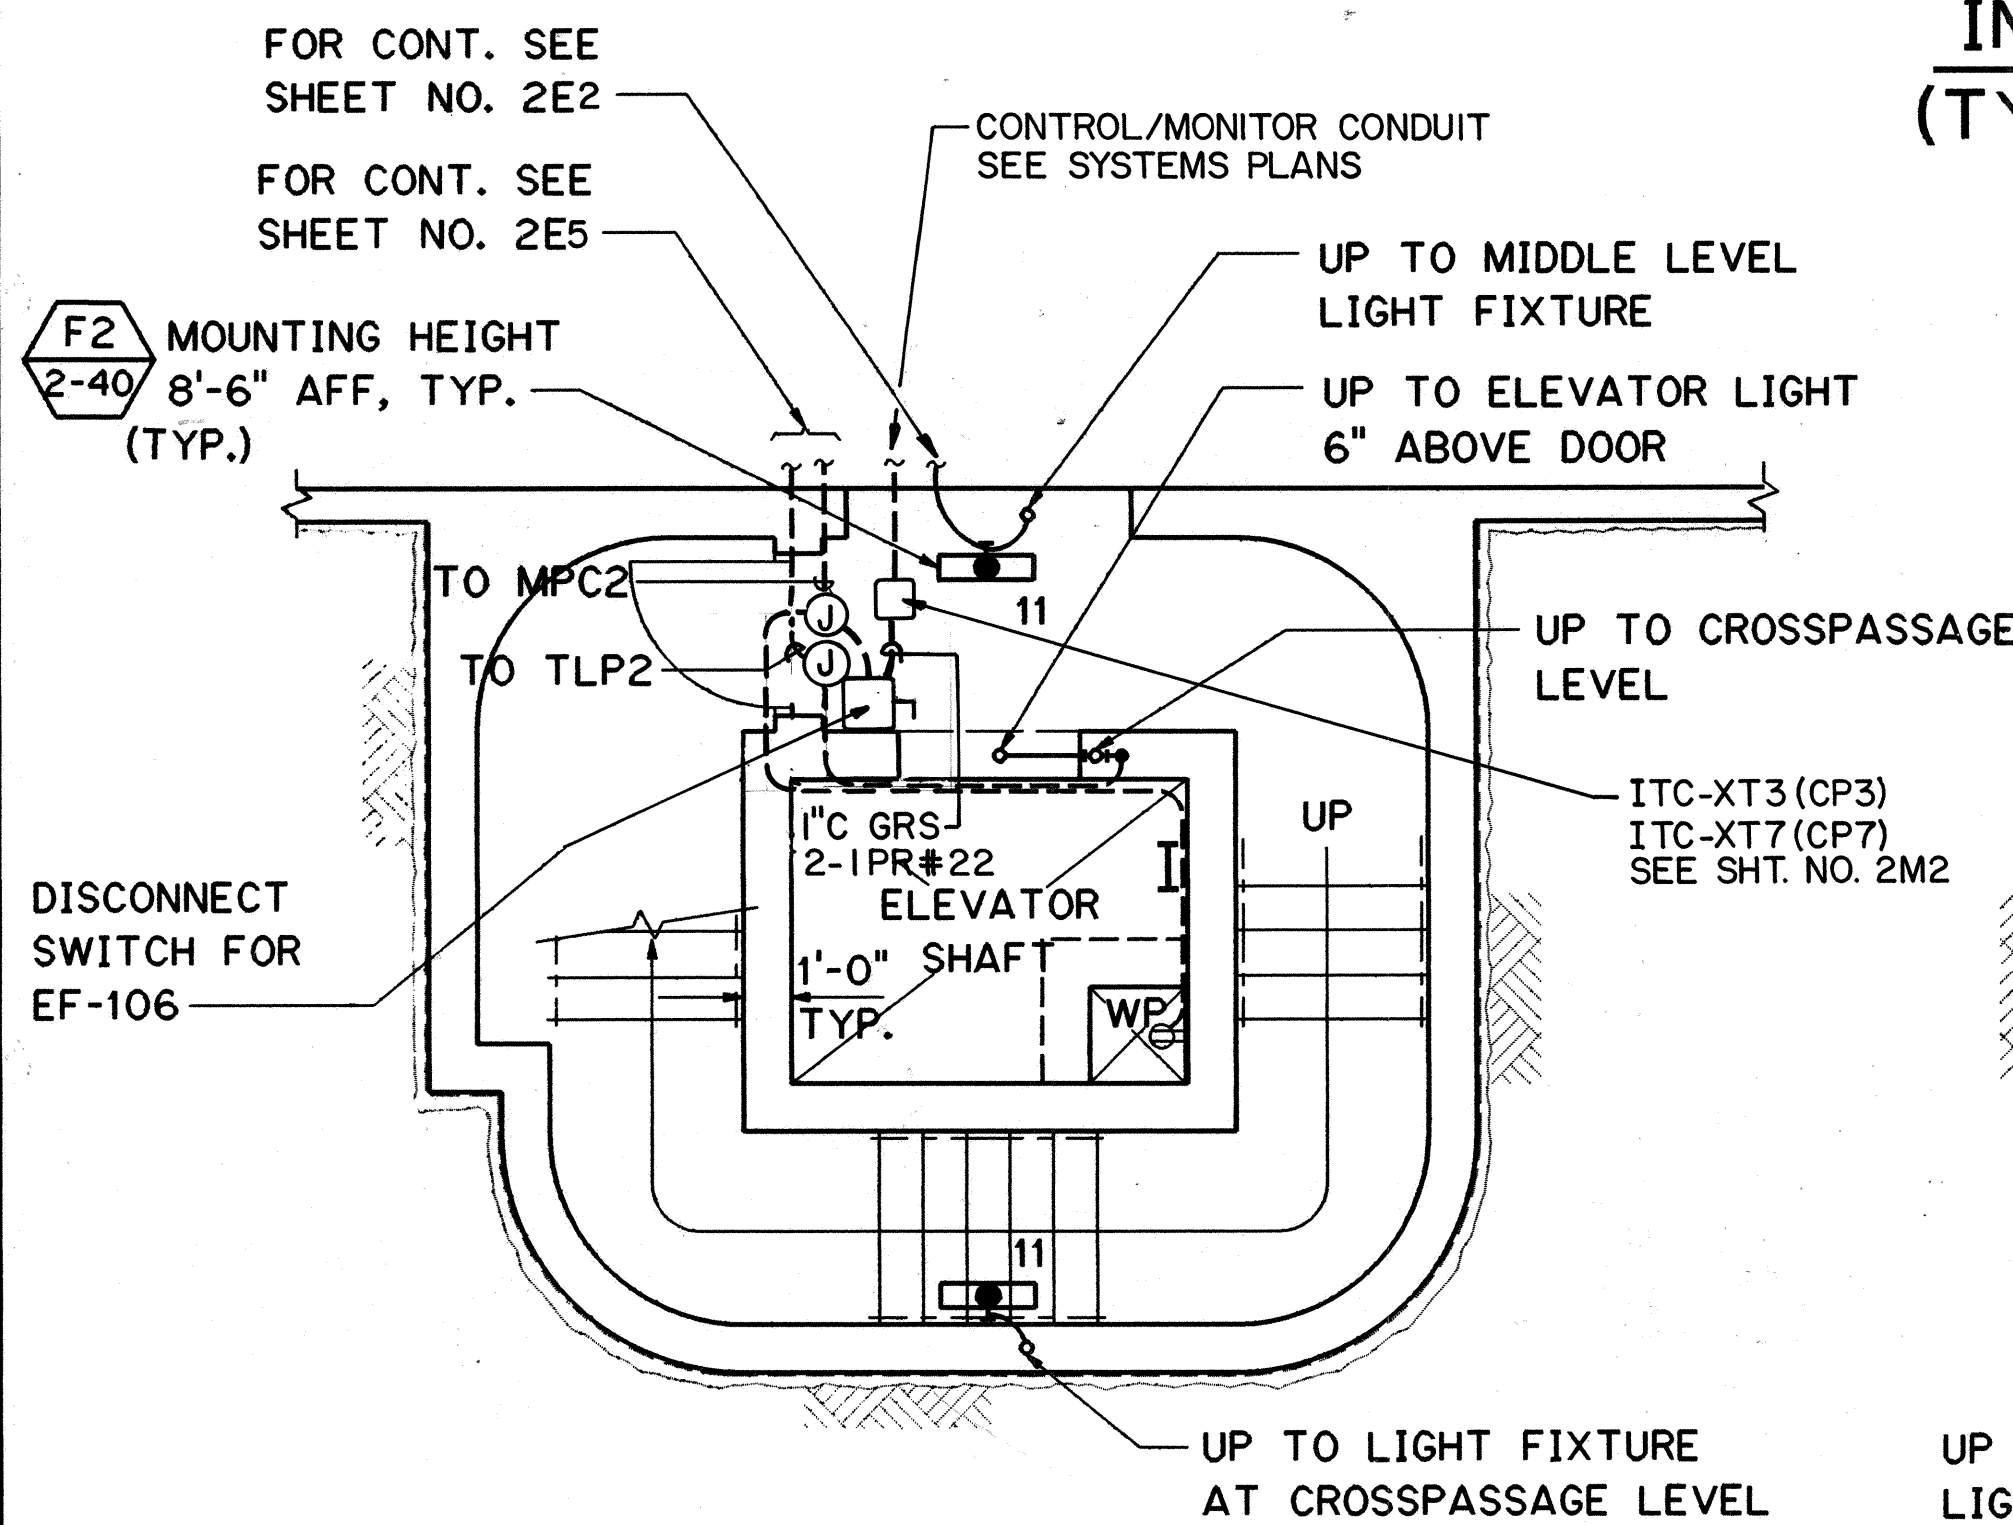

PLAN AT EXPLORATORY TUNNEL LEVEL

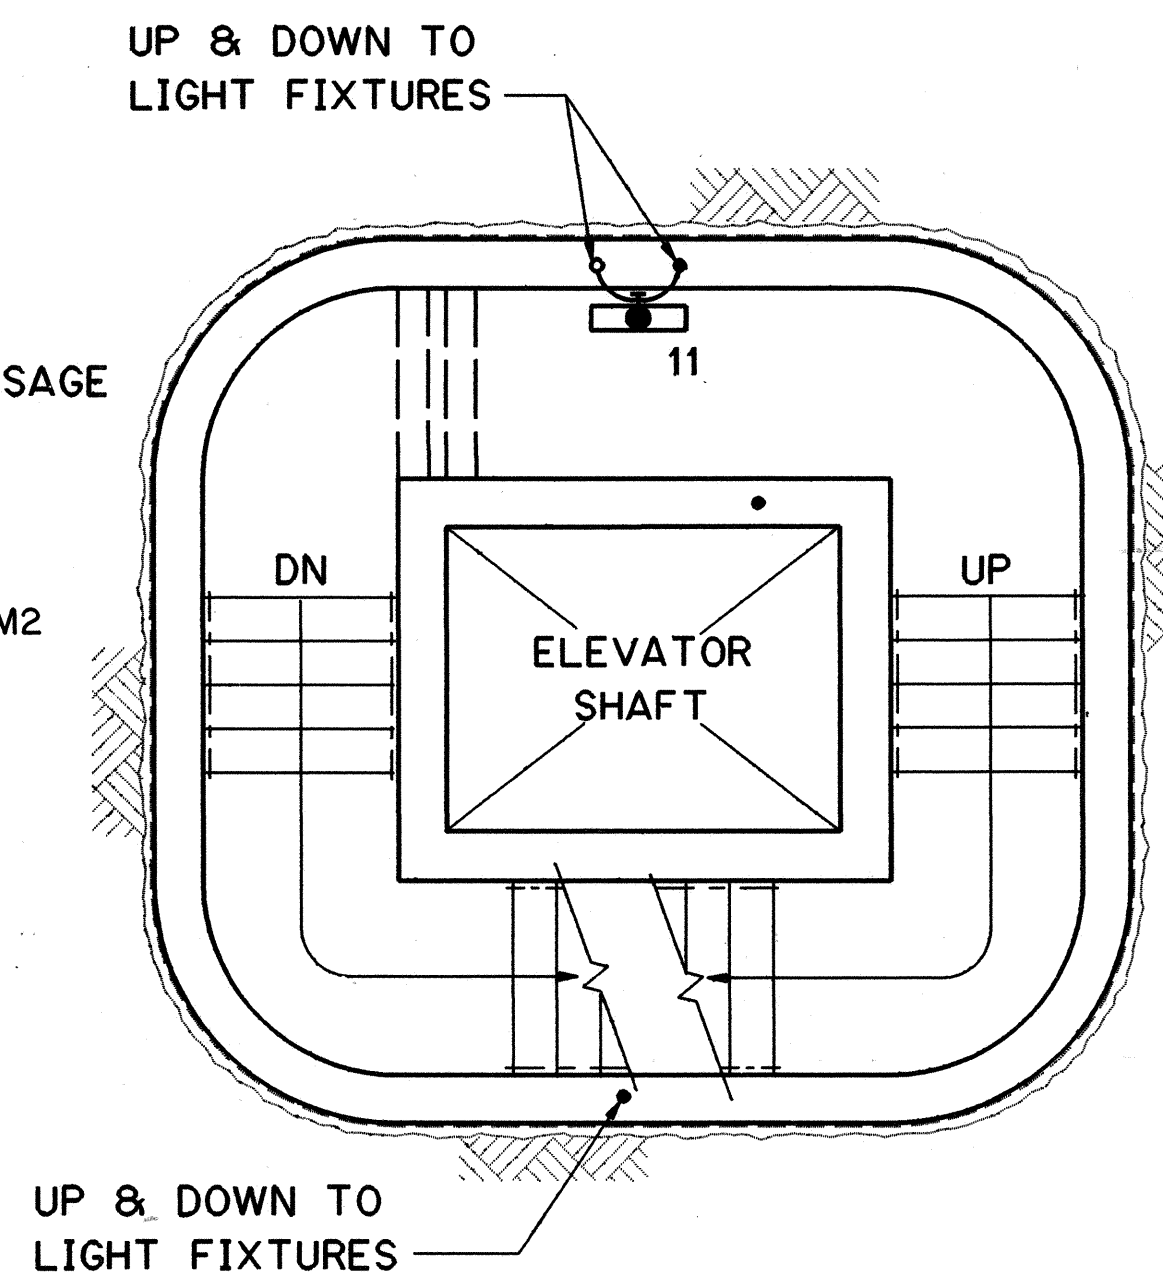



PLAN AT MIDDLE LEVEL

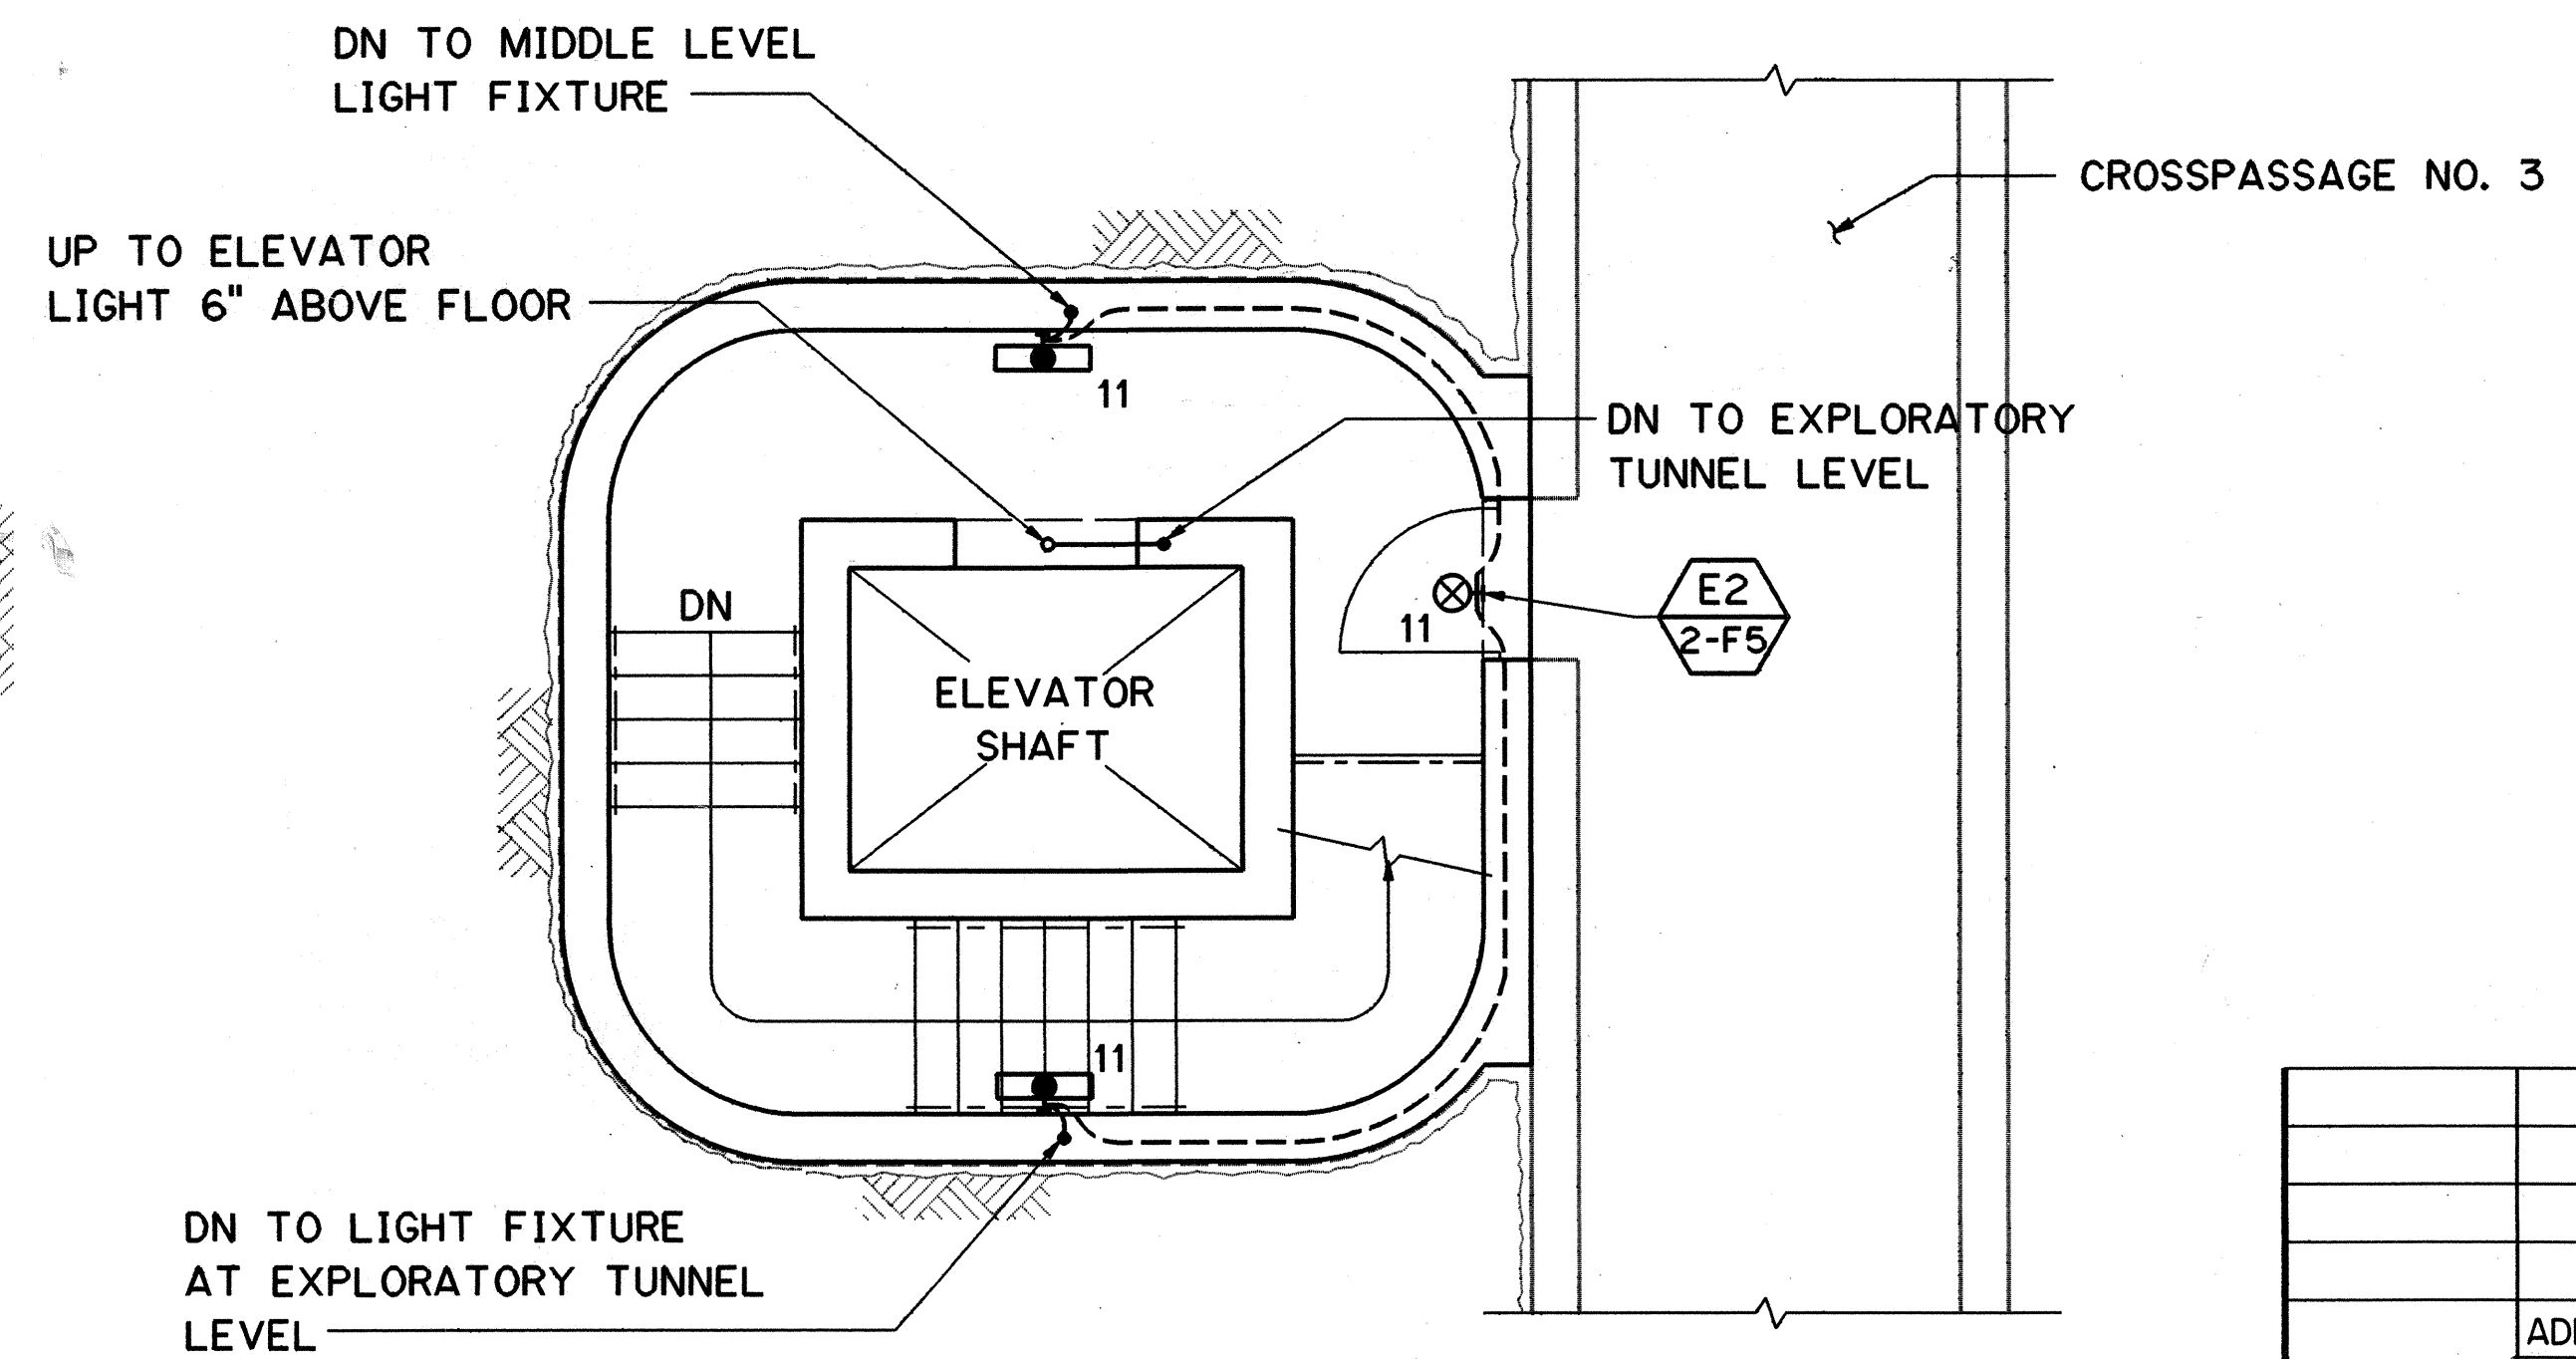

PLAN AT CROSSPASSAGE LEVEL

INSTALLATION FOR CROSSPASSAGE NO. 3 (TYPICAL FOR CROSSPASSAGE 7)

NOTE:
1. CONTROL FOR EXHAUST FANS IS BY ROOM THERMOSTAT OR THE LIGHTING CONTACTOR FROM LIGHTING CONTROL (LC) PANEL.

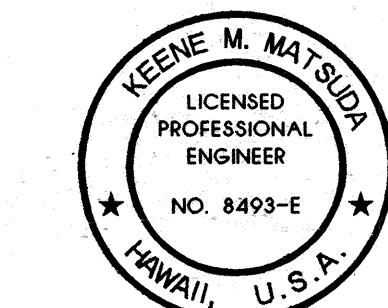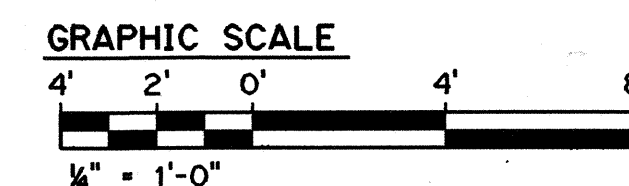

THIS WORK WAS PREPARED BY ME OR UNDER MY SUPERVISION


Keene Matsuda

DATE	REVISION
10/27/95	ADDENDUM 2- REVISED CONT. SHT. NOS., RELOCATED FAN DISCONNECT, POWER & LTG. JB'S, IDENTIFIED ITC'S.

STATE OF HAWAII DEPARTMENT OF TRANSPORTATION HIGHWAYS DIVISION
POWER & LIGHTING C.P. CONNECTION PLAN EXPLORATORY TUNNEL IMPROVEMENTS H-3 FINISH (UNIT III) FAIP NO. I-H3-1(75), UNIT III T.K. TUNNEL/ACCESS ROADS SCALE: 1/4"=1'-0" DATE: JUN 1995
SHEET NO. 2E20 OF 30 SHEETS


SURVEY PLOTTED BY	DATE
DRAWN BY	NOV 94
CHECKED BY	NOV 94
QUANTITIES BY	NOV 94
CHECKED BY	DEC 94
ORIGINAL PLAN	
NOTE BOOK	
NO.	

FED. ROAD DIST. NO.	STATE	FED. AID PROJ. NO.	FISCAL YEAR	SHEET NO.	TOTAL SHEETS
HAWAII	HAW.	I-H3-1(75) UNIT III	1994	93	353

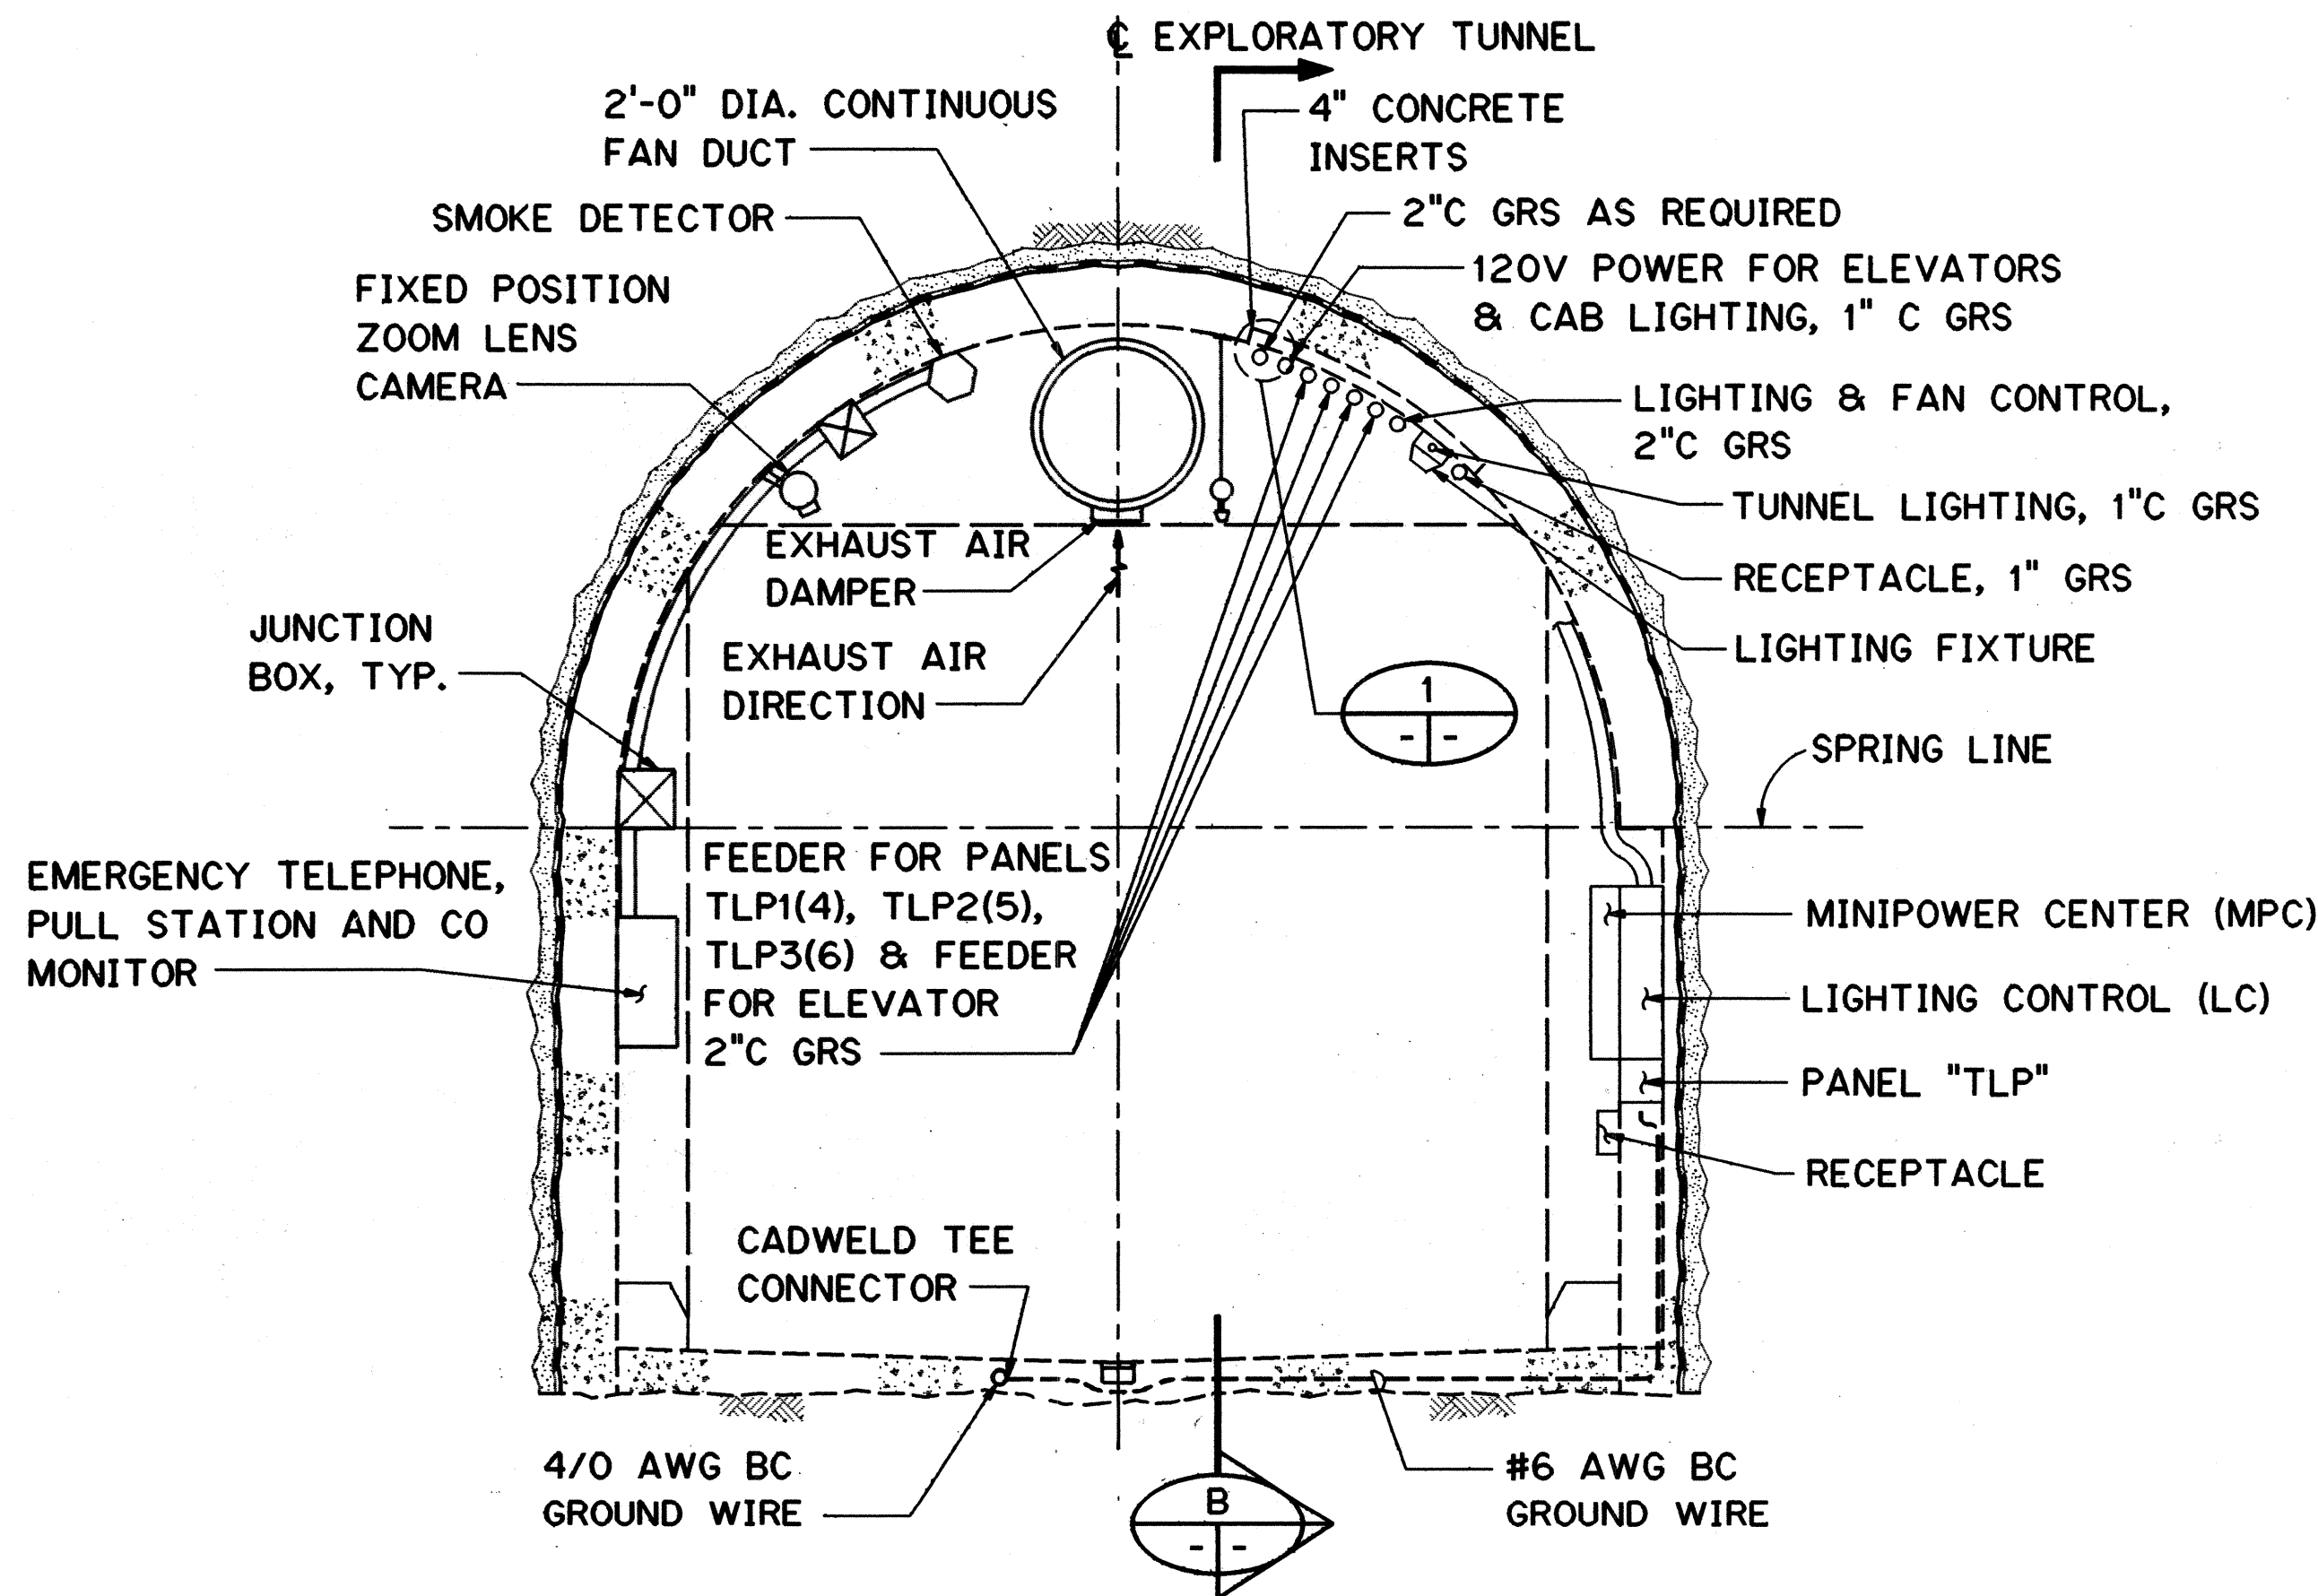


TYPICAL TUNNEL

SECTION A
SCALE: 1/2"=1'-0"

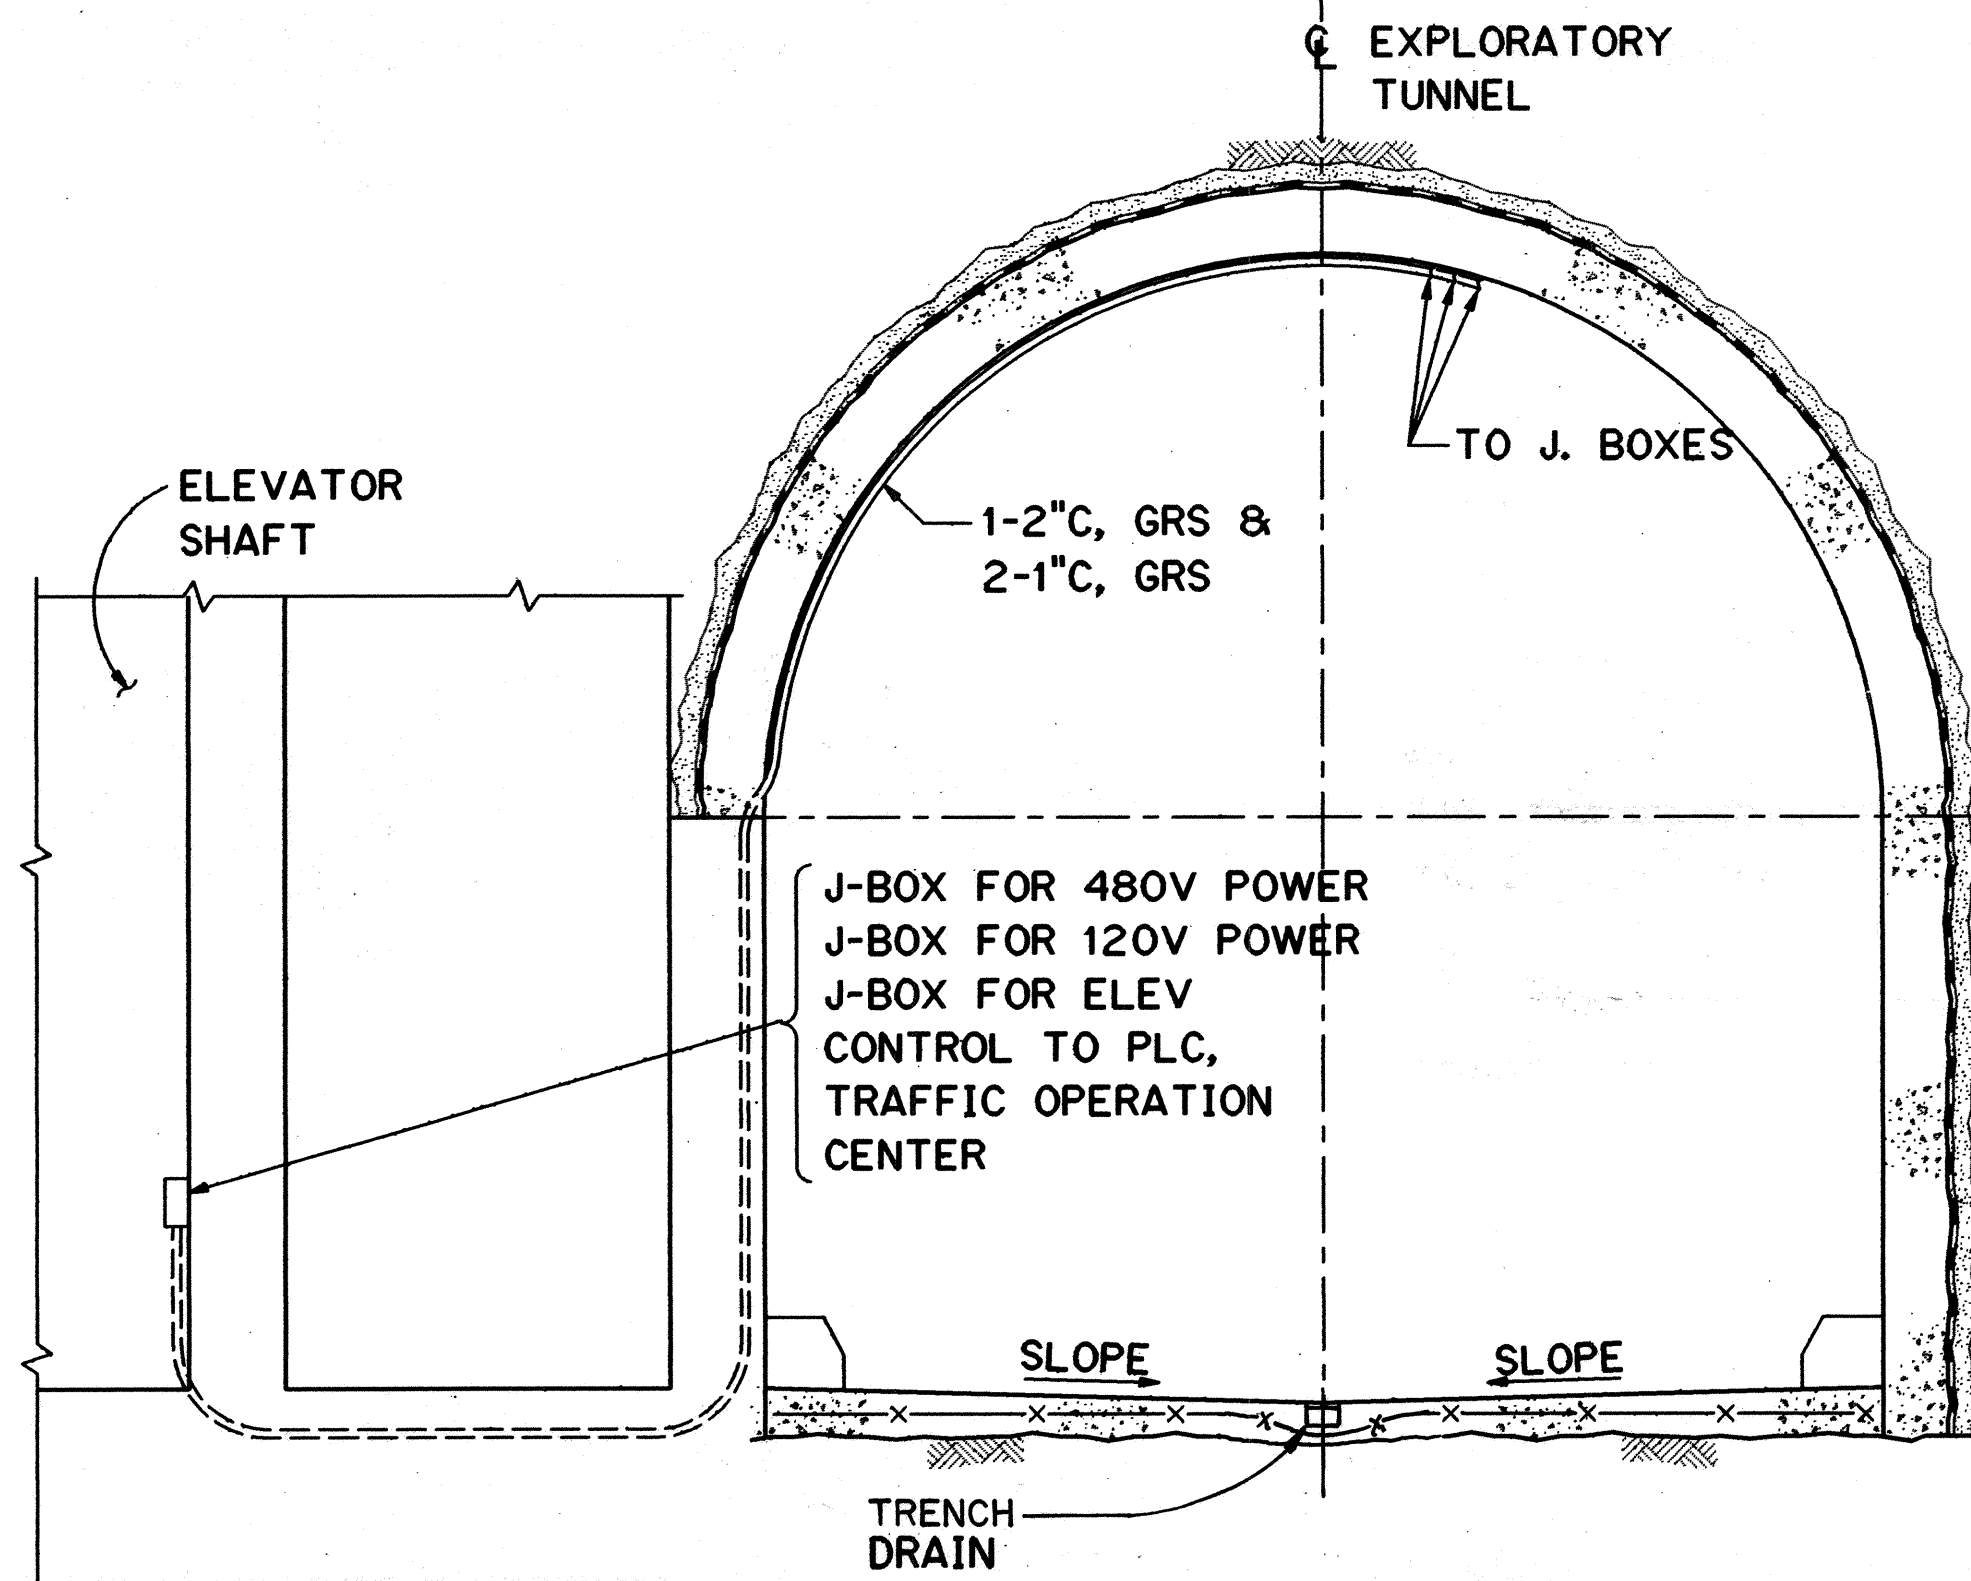


TYPICAL TUNNEL SECTION AT CROSSPASSAGES WITH ELEVATORS

SECTION C
SCALE: 1/2"=1'-0"

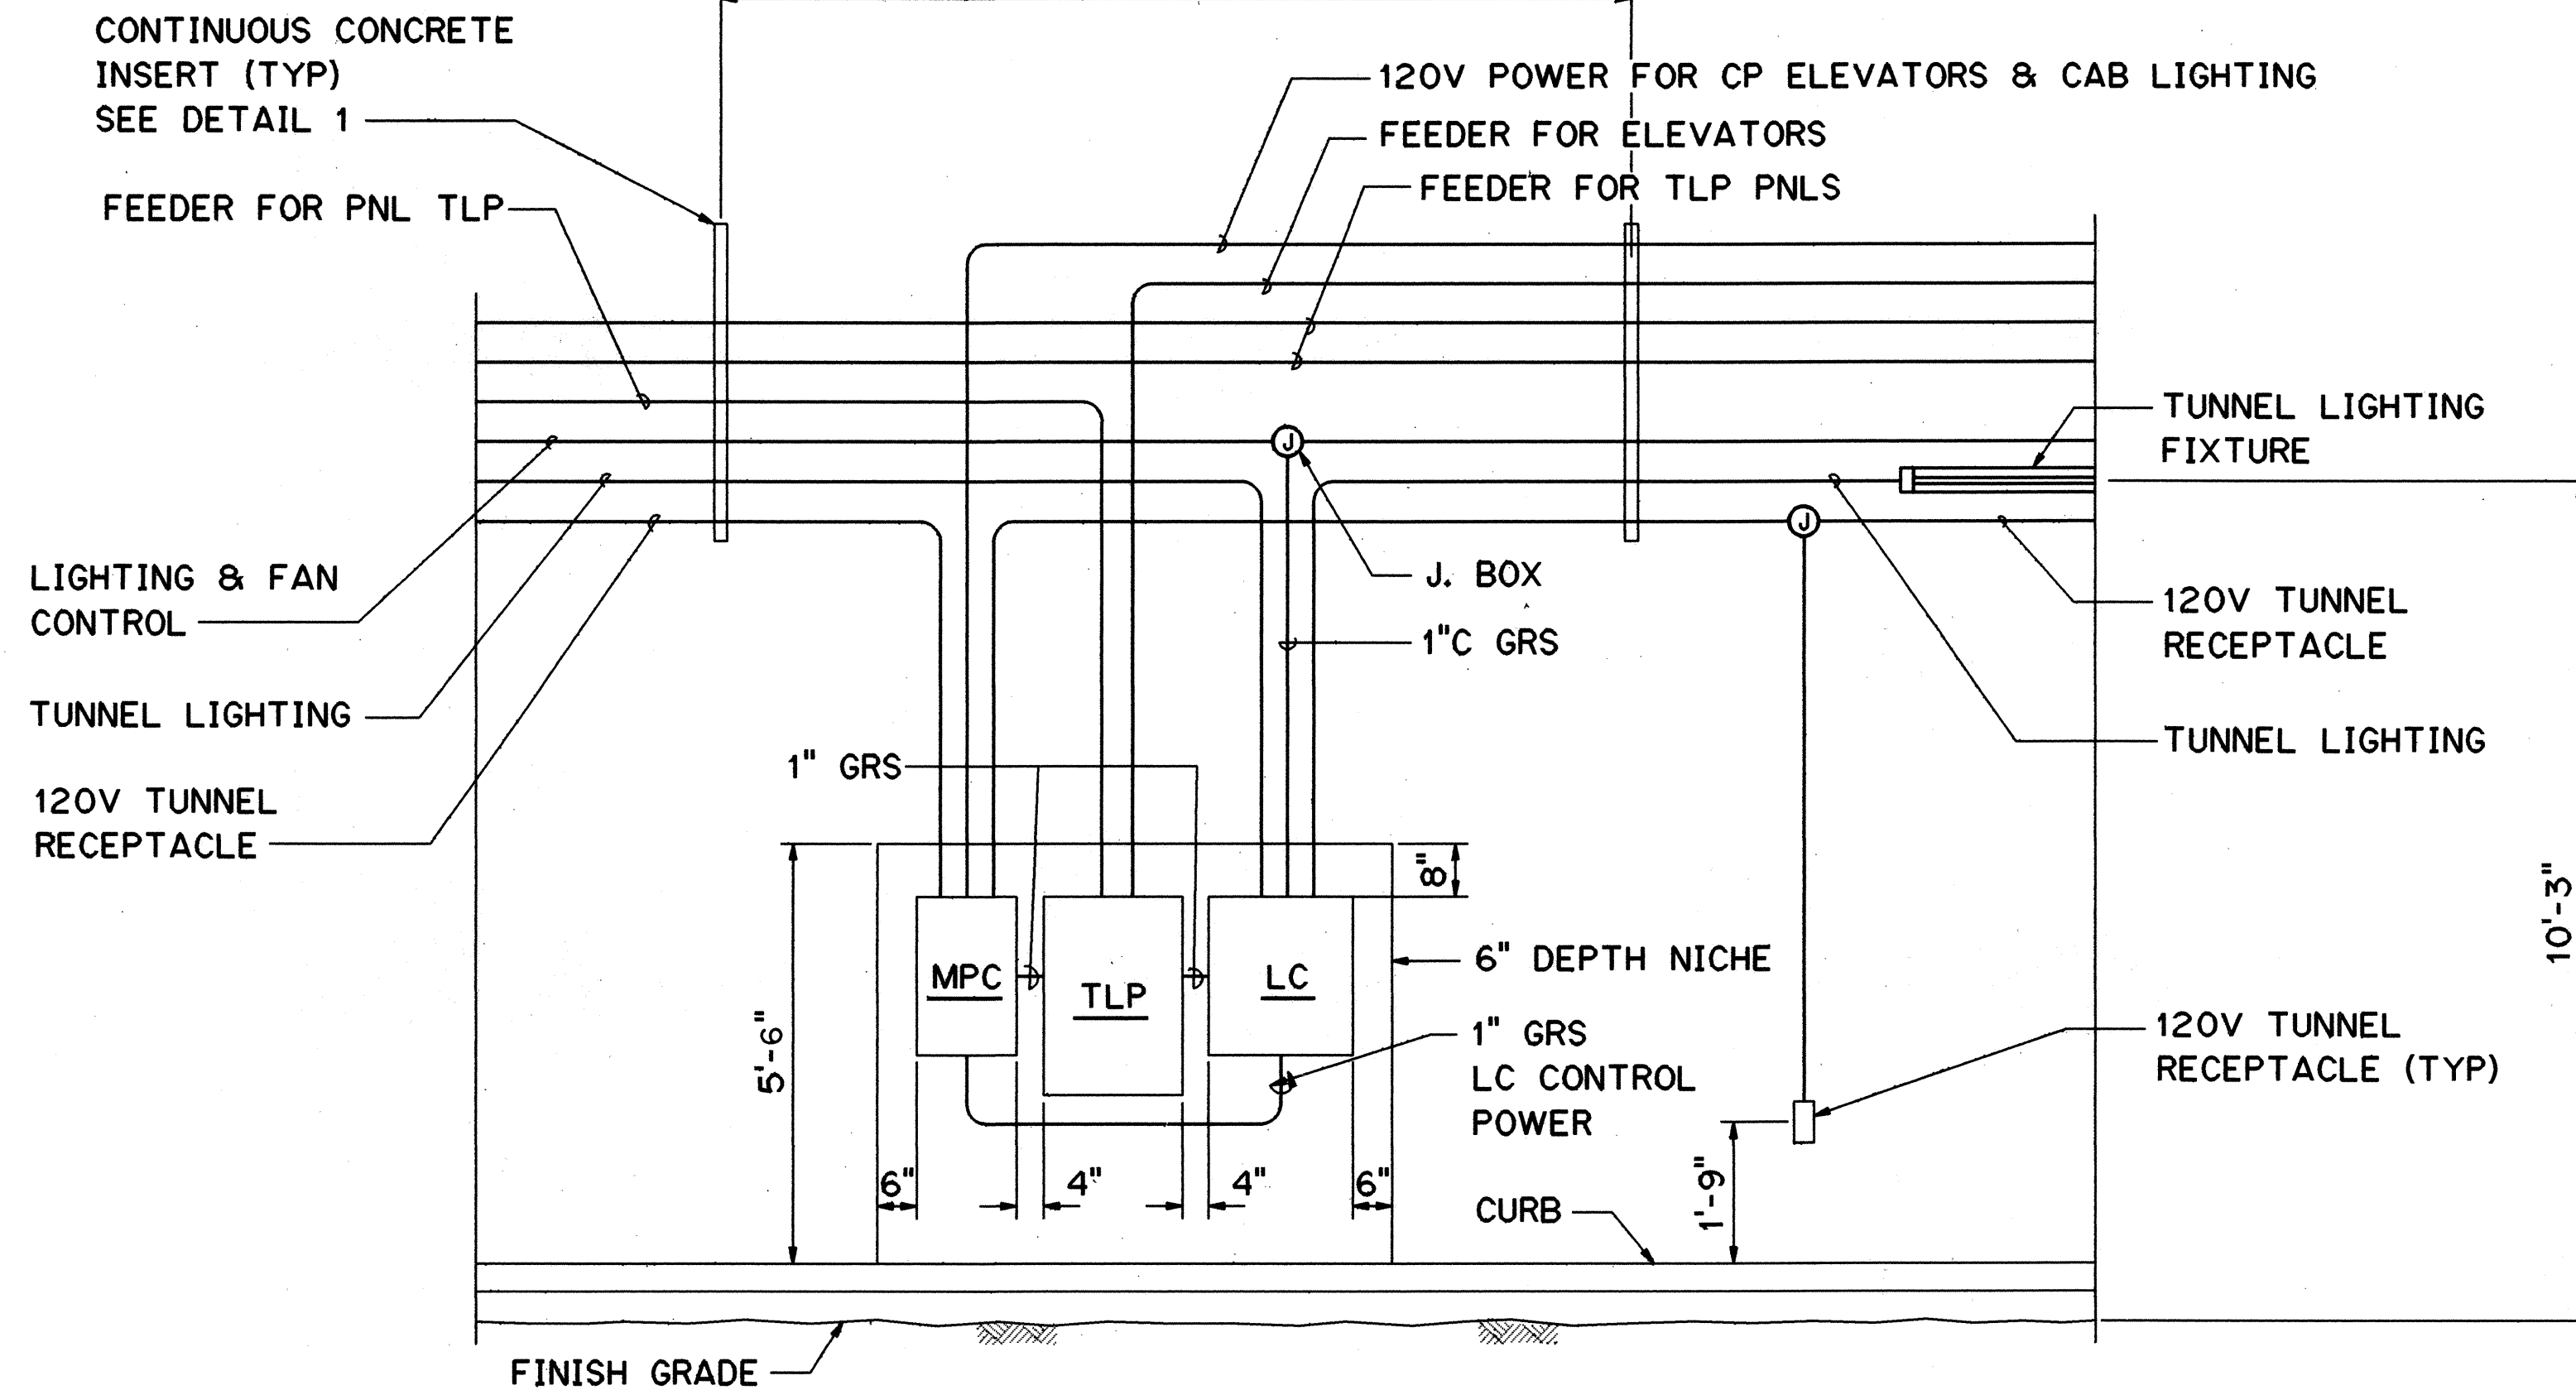


TYPICAL PANEL ARRANGEMENT

SECTION B
SCALE: 1/2"=1'-0"


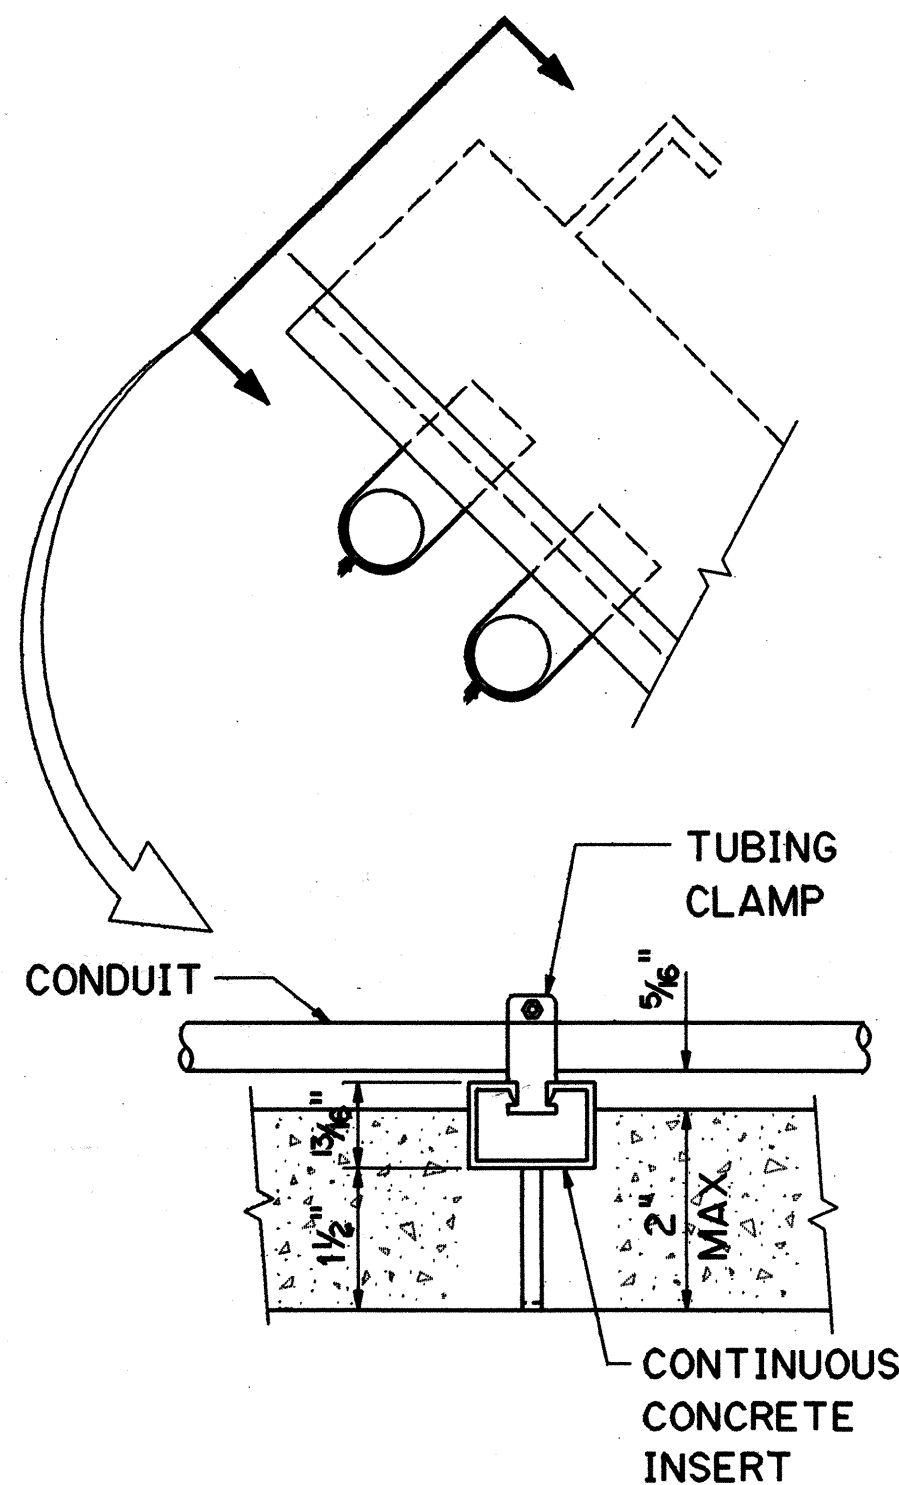


DETAIL 1
NTS

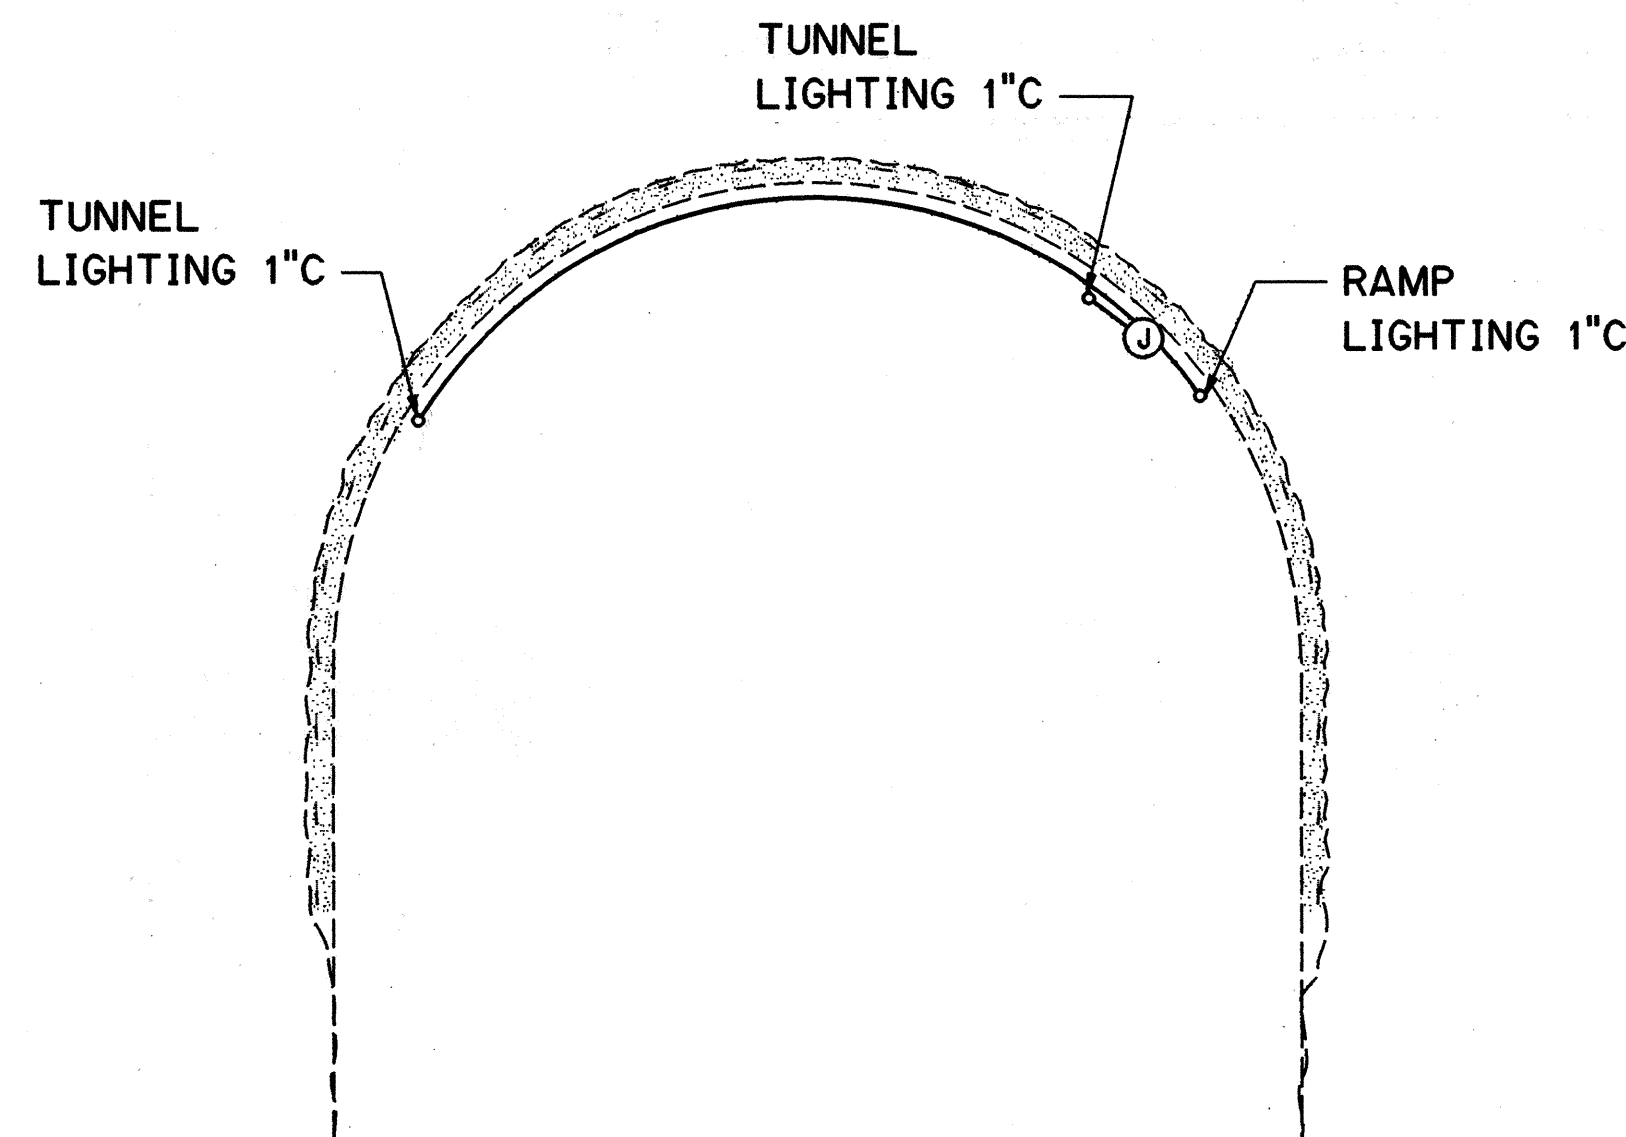

EXPLORATORY TUNNEL RAMP ENTRANCE

SECTION D
SCALE: 3/8"=1'-0"

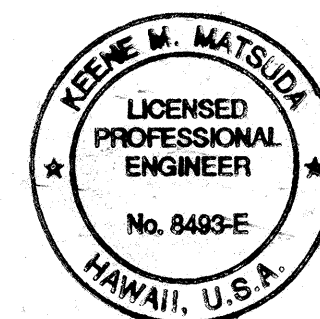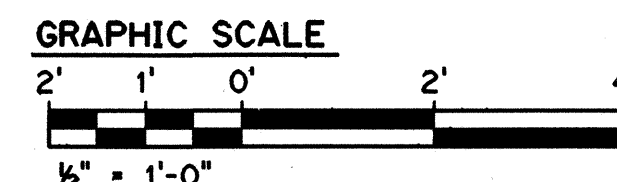


THIS WORK WAS PREPARED BY ME OR UNDER MY SUPERVISION
Keene Matsuda

NOTES:


1. REFER TO TUNNEL POWER & TUNNEL LIGHTING DRAWINGS FOR ROUTING AND NUMBER OF CONDUITS REQUIRED THROUGHOUT THE TUNNEL

8/21/96	DCN 75-007 REV. ET DRAIN
DATE	REVISION
STATE OF HAWAII DEPARTMENT OF TRANSPORTATION HIGHWAYS DIVISION SECTIONS & DETAILS EXPLORATORY TUNNEL IMPROVEMENTS H-3 FINISH (UNIT III) FAIP NO. I-H3-1(75), UNIT III T.K. TUNNEL/ACCESS ROADS SCALE: AS NOTED DATE: JUN 1995 SHEET NO. 2E21 OF 30 SHEETS	



DATE	NOV 94
SURVEY PLOTTED BY	R. J. HERNANDEZ
TRACED BY	T. SANCHEZ
NOTES BY	K. MATSUDA
CHECKED BY	NOV 94
NO.	DEC 94

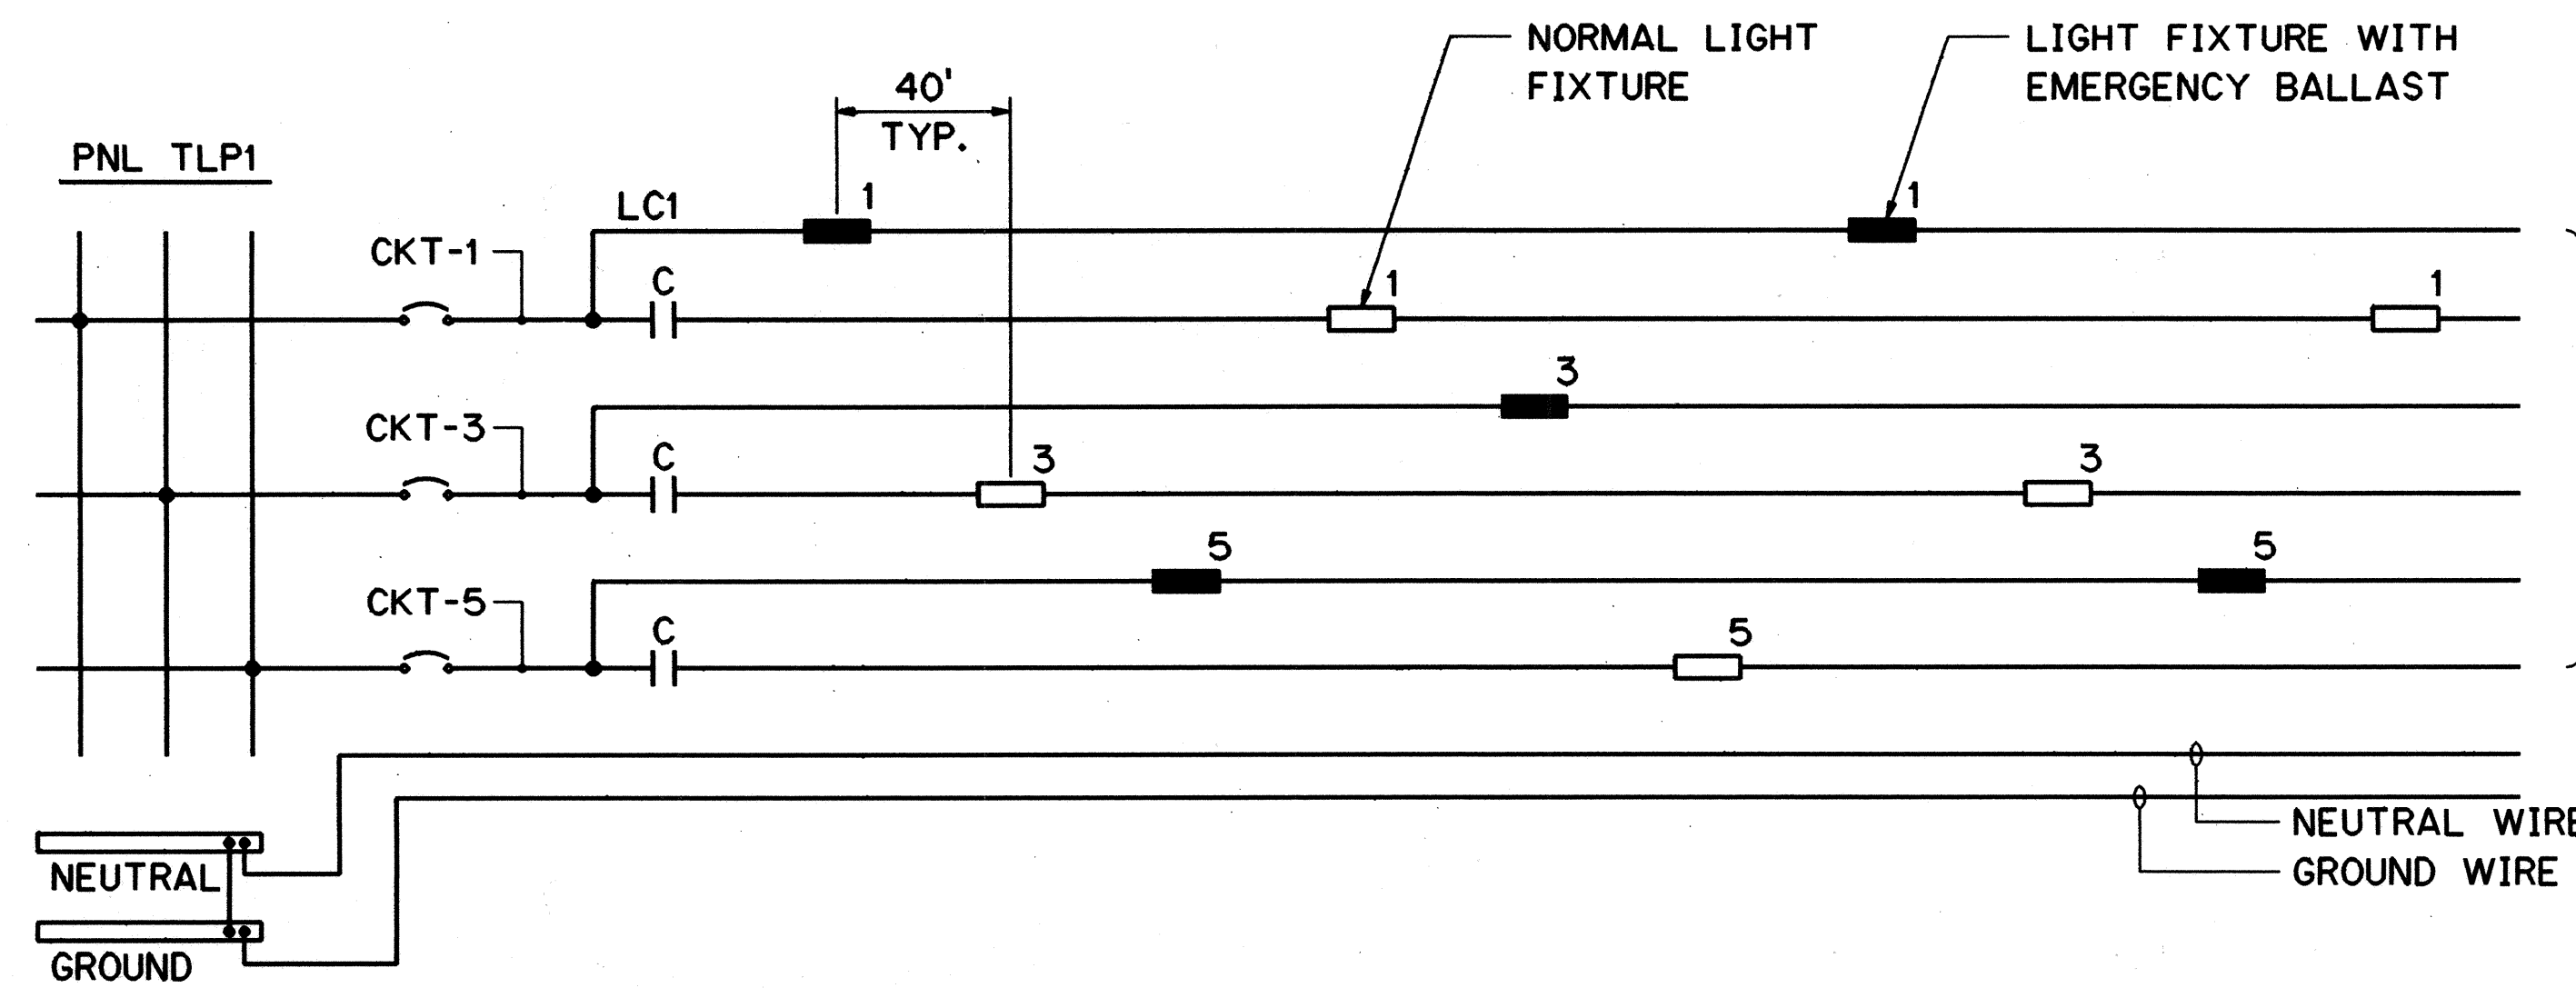

TLP1 TUNNEL LIGHTING CIRCUIT DIAGRAM
(TYP. FOR TLP2, TLP3, TLP4, TLP5 AND TLP6)

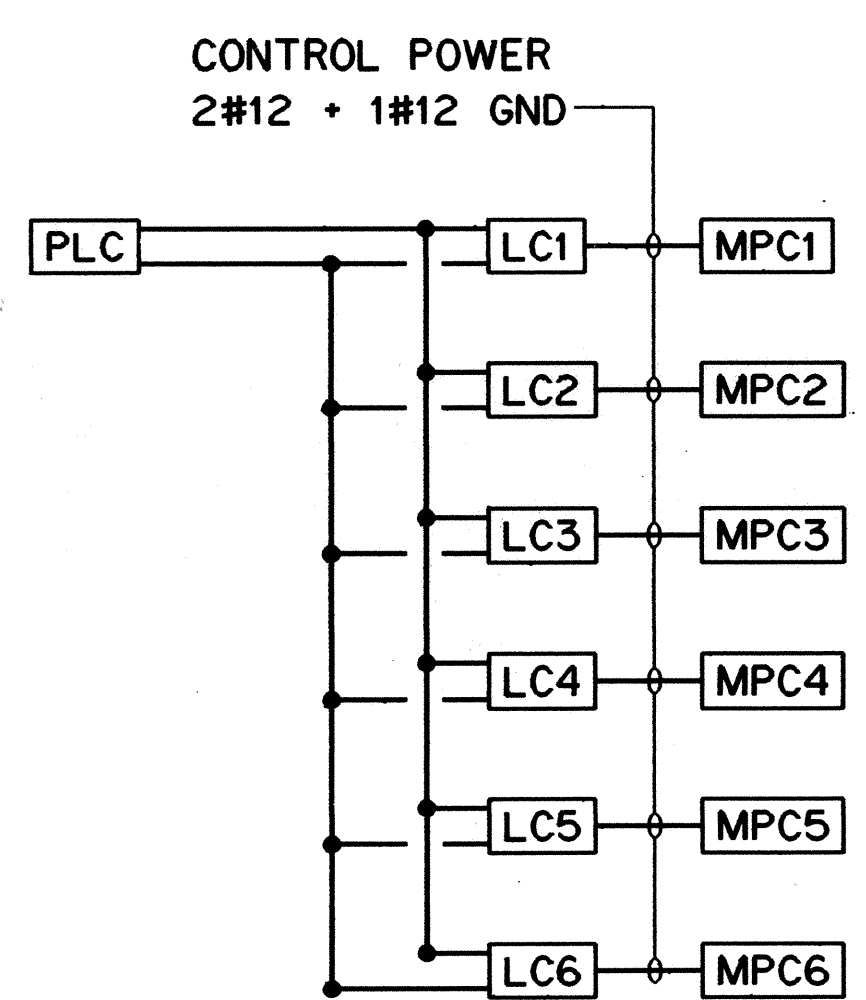


BLOCK DIAGRAM

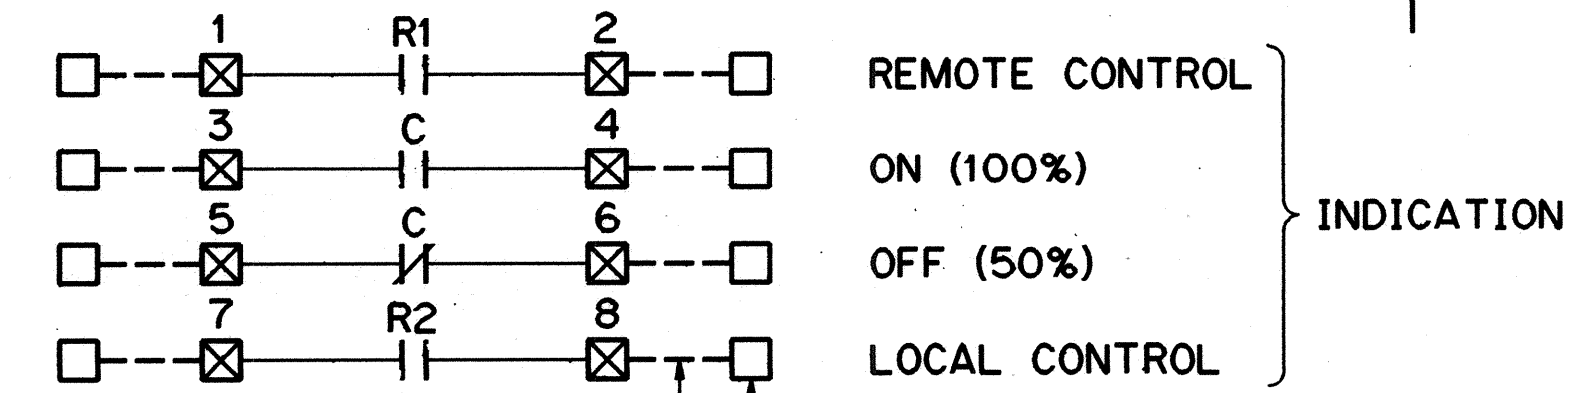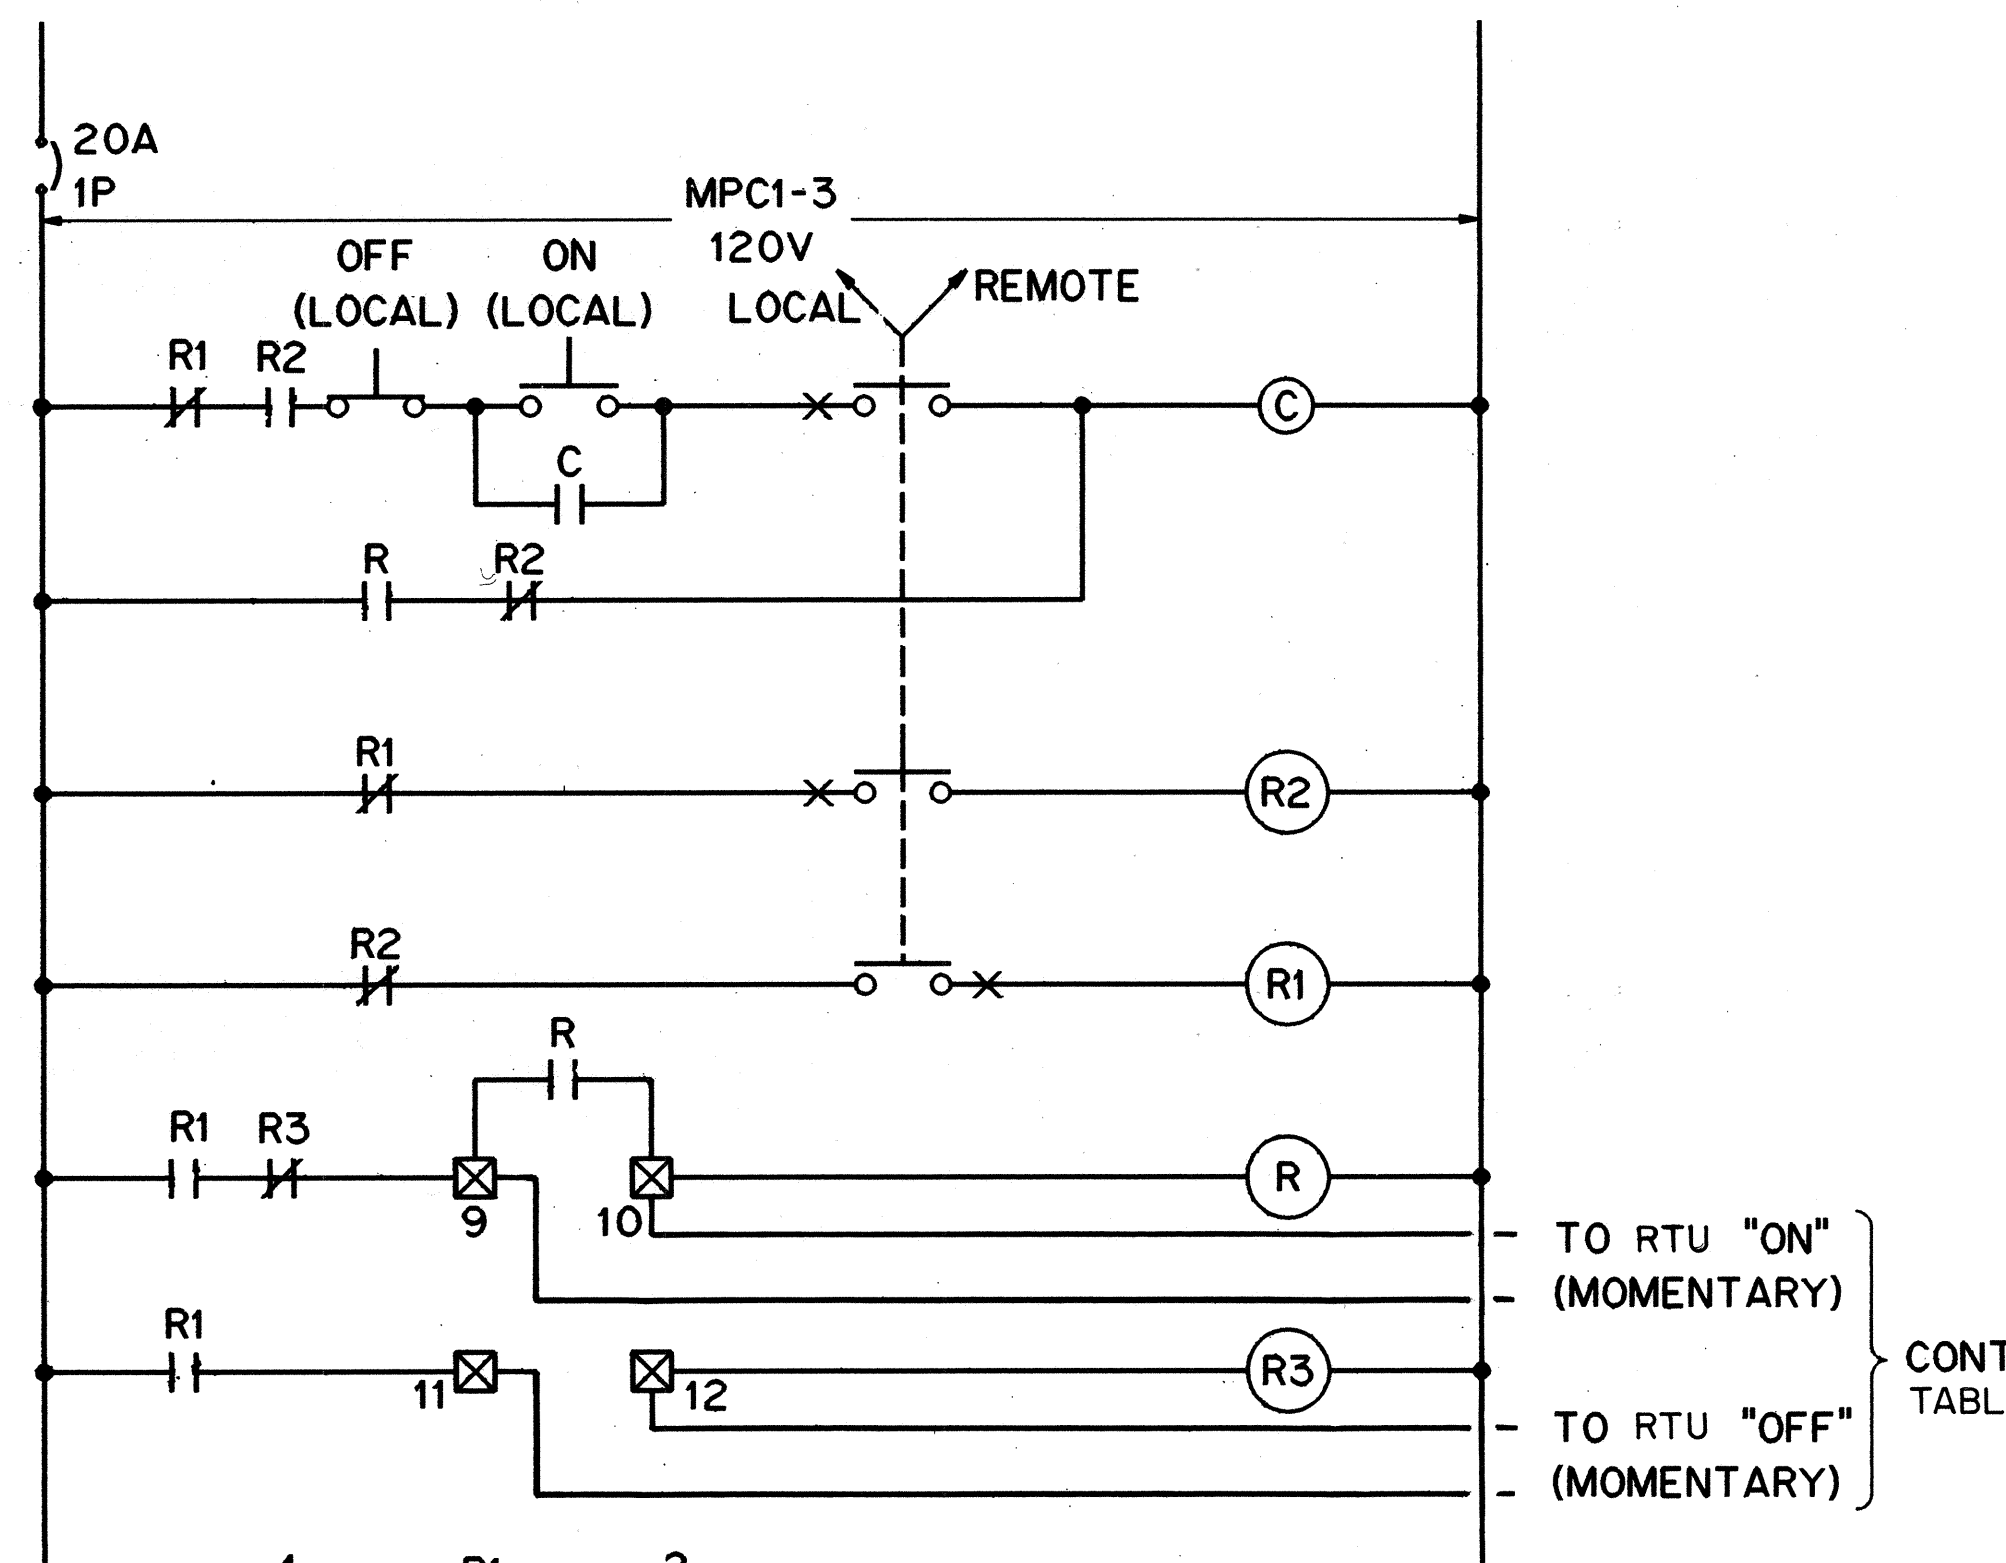



LC-1 CONTROL DIAGRAM
(TYP. FOR LC-2, LC-3, LC-4, LC-5 AND LC-6)

NOTES:


1. RELAY R1 AND R2 NORMALLY OPEN AND NORMALLY CLOSED. CONTACTS SHALL BE CAPABLE OF CARRYING CLOSING COIL CURRENT OR TUNNEL LIGHTING AND MOTOR CONTACTOR.

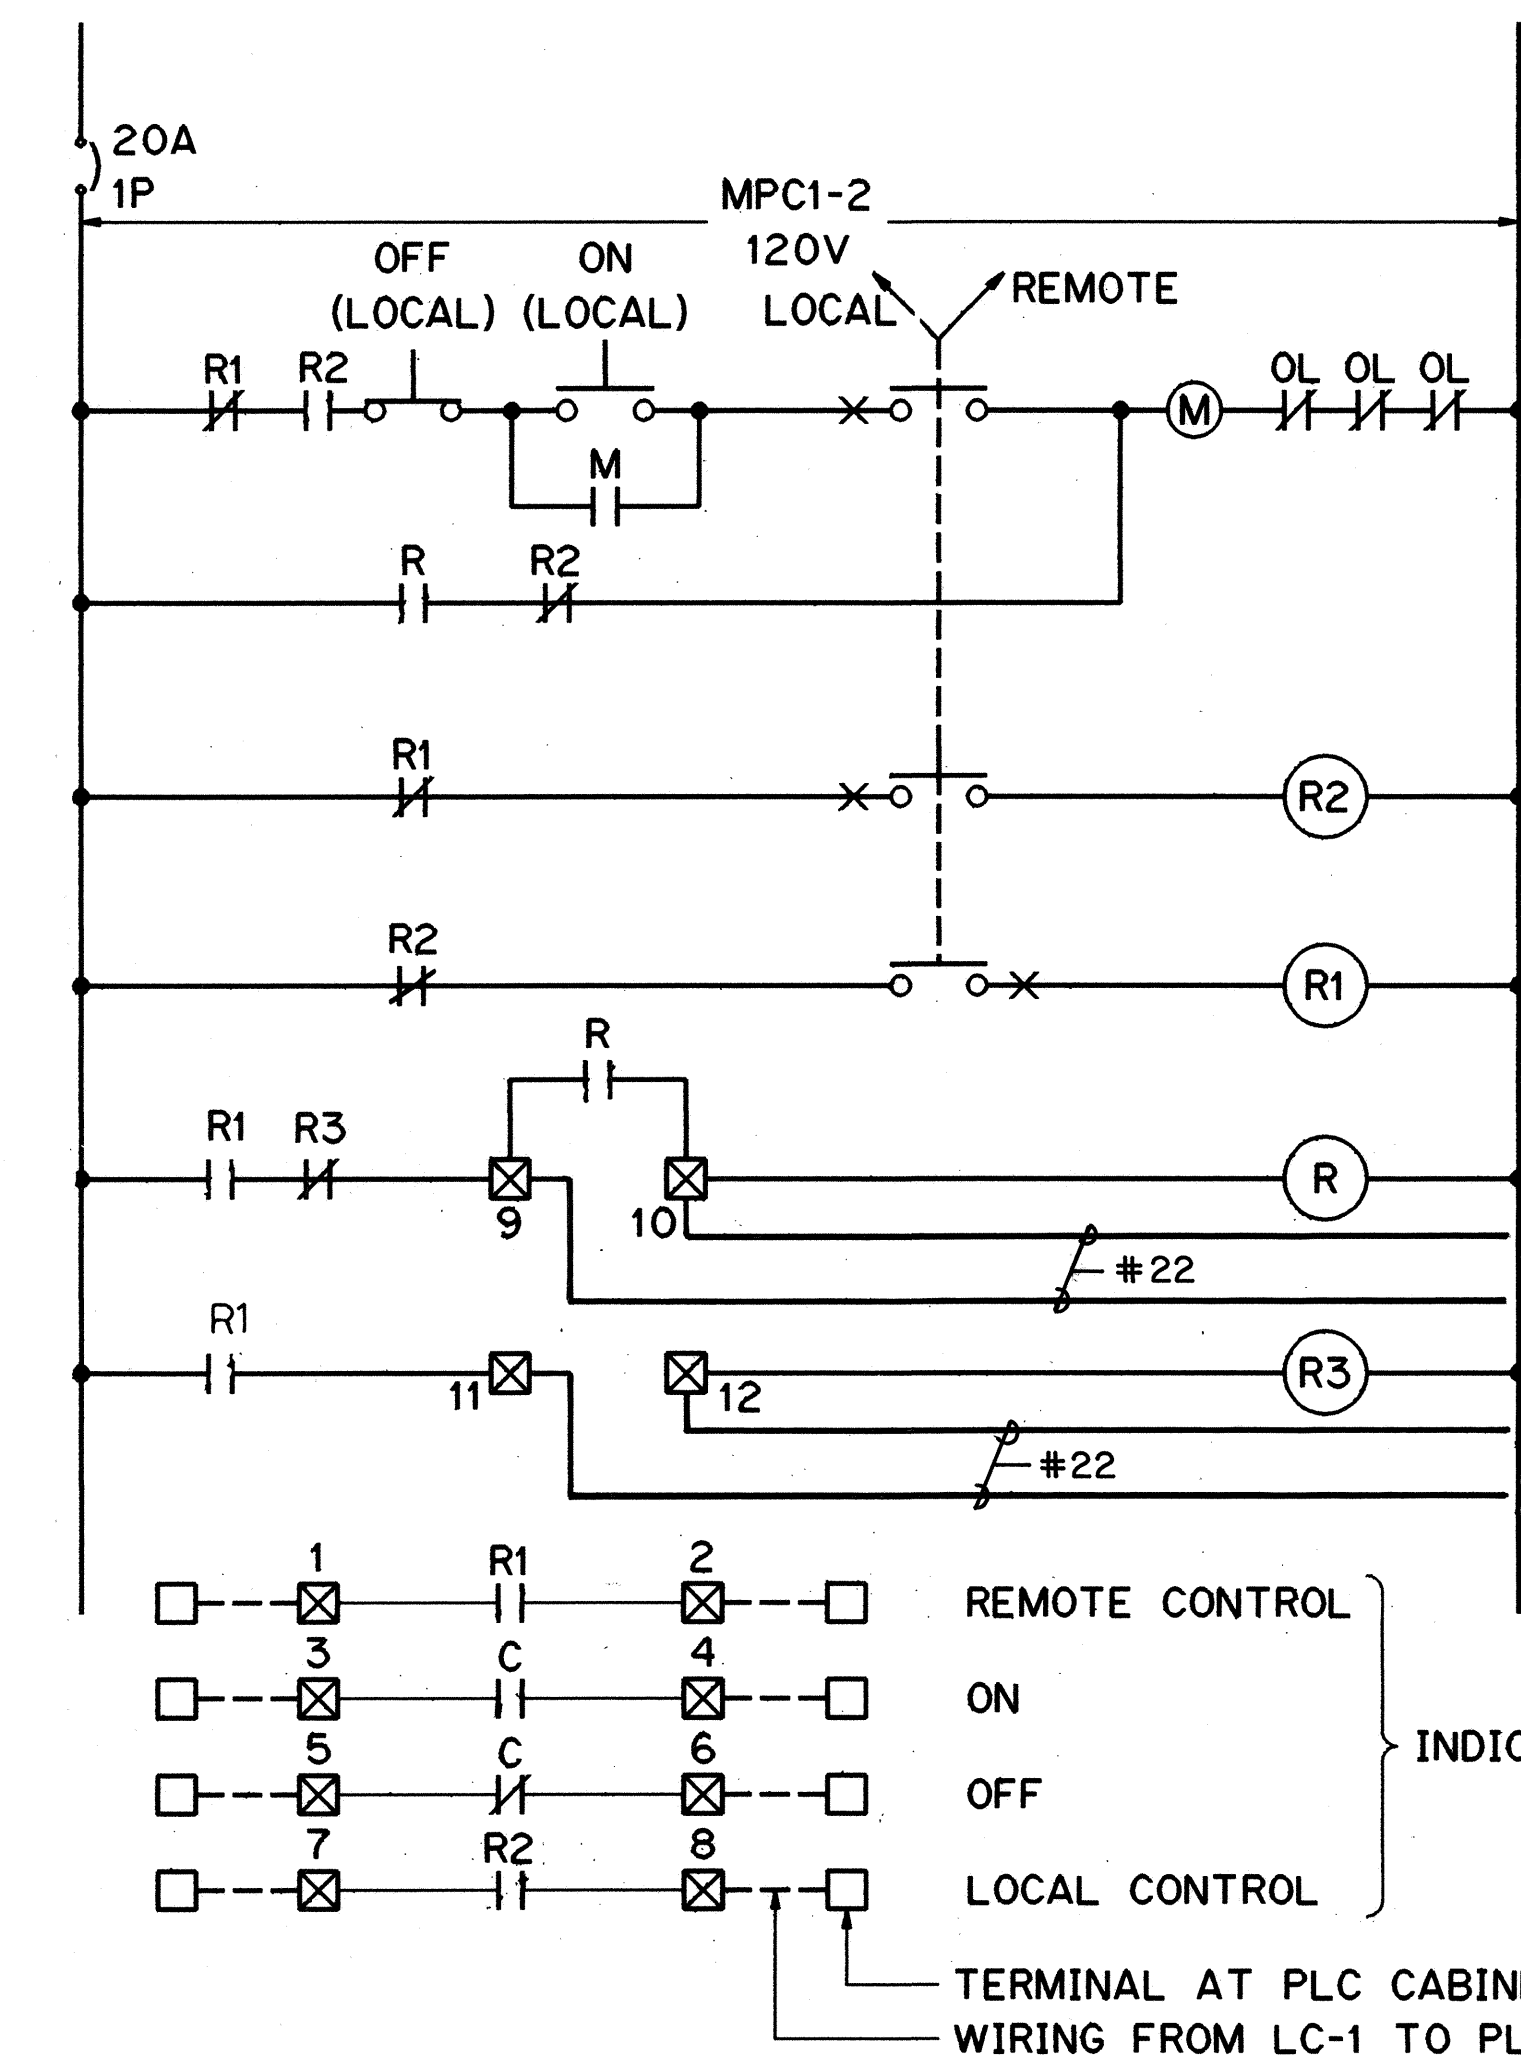

EF-101 CONTROL DIAGRAM
(TYPICAL FOR EF-102)

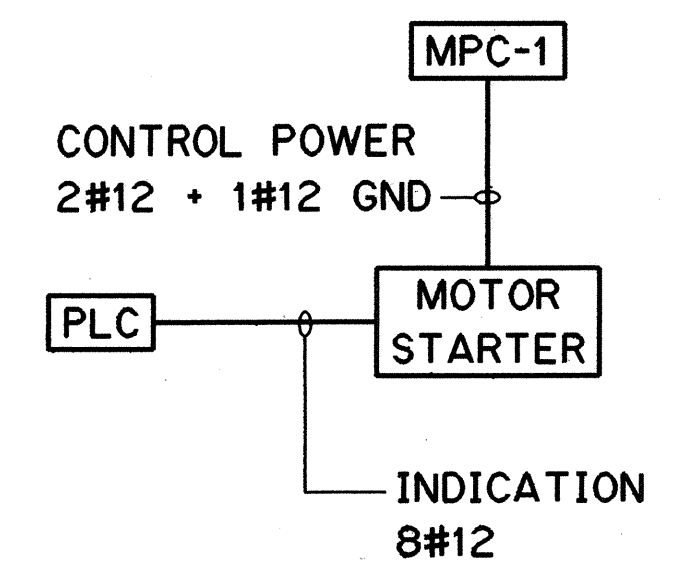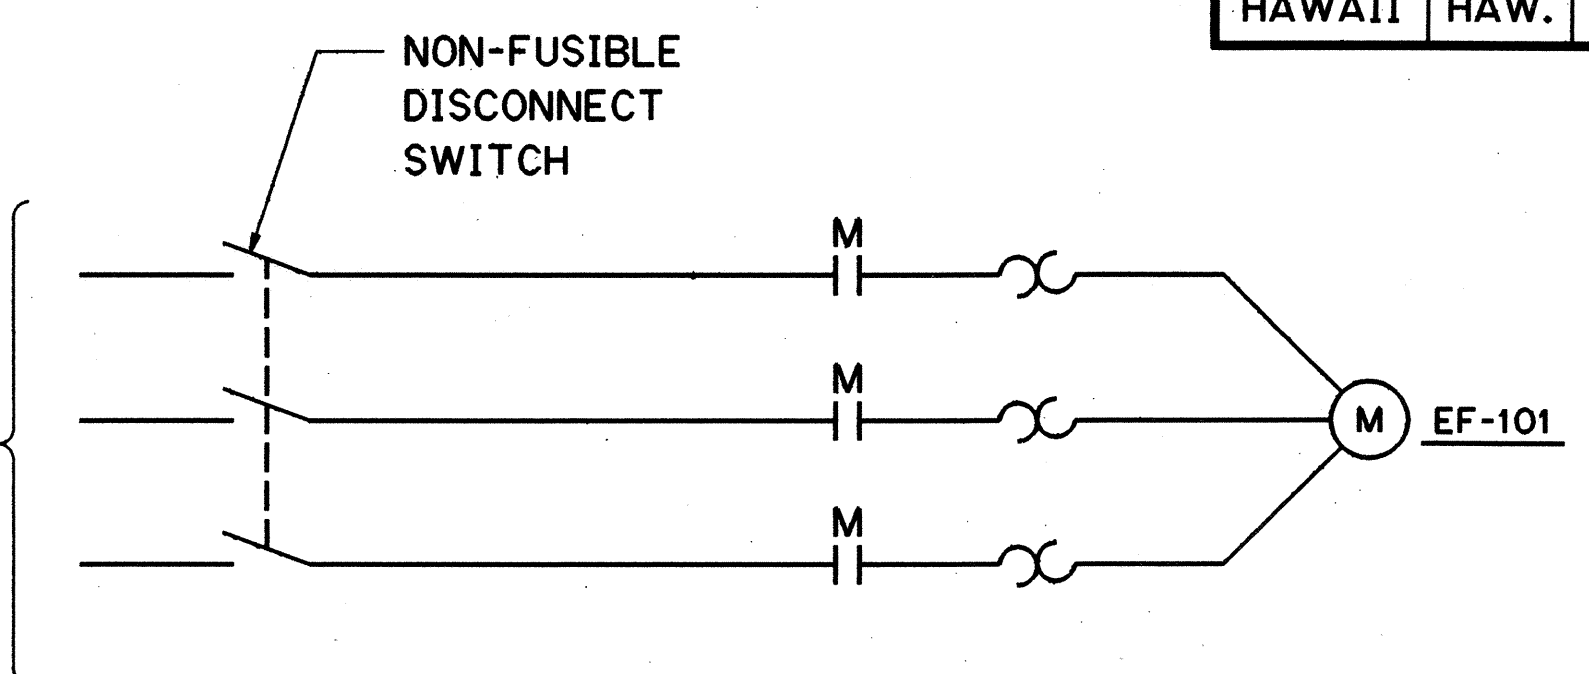

BLOCK DIAGRAM




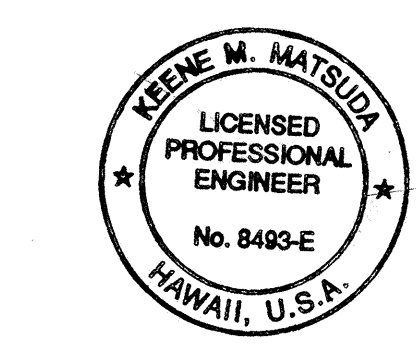


THIS WORK WAS PREPARED BY ME OR UNDER MY SUPERVISION


Keene Matsuda

DATE	REVISION
10/27/95	ADDENDUM 2 - ADDED CLARIFICATION OF CONTROL/MONITOR WIRING
ELEMENTARY DIAGRAM	
EXPLORATORY TUNNEL IMPROVEMENTS	
H-3 FINISH (UNIT III)	
FAIP NO. I-H3-1(75), UNIT III	
T.K. TUNNEL/ACCESS ROADS	
SCALE: NONE	DATE: JUN 1995
SHEET NO. 2E22	OF 30 SHEETS

LIGHTING FIXTURE SCHEDULE

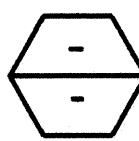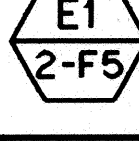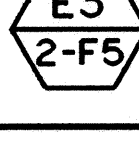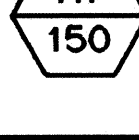SYMBOL	DESCRIPTION	MANUFACTURER	LAMP	INPUT POWER	INPUT VOLTAGE
	NOT USED	-	-	-	-
	WRAPAROUND LIGHTING FIXTURE COMPLETE W/ BATTERY AND CHARGERS FOR 90 MIN. OF EMERGENCY OPERATION, WALL MOUNTED	DAY-BRITE LIGHTING KEYSTONE	2-F40T12 CW/RS	100VA	277V
	TUNNEL LIGHTING FIXTURE WALL MOUNTED	NU-ART TNL-1-48+48-96 RS1500MA-277	2-F40T12 CW/RS	100VA	277V
	SAME AS T1 BUT COMPLETE WITH BATTERY AND CHARGERS FOR 90 MIN. OF EMERGENCY OPERATION	NU-ART TNL-1-48+48-96 RS1500MA-277	2-F40T12 CW/RS	100VA	277V
	EXIT SIGN FIXTURE ENCLOSED AND GASKETED, COMPLETE WITH BATTERY AND CHARGERS.	LITHONIA SYLVANIA GENERAL ELECTRIC	2-F5	12VA	277V
	SAME AS E2 EXCEPT FOR DIRECTIONAL ARROW RIGHT	LITHONIA SYLVANIA GENERAL ELECTRIC	2-F5	12VA	277V
	SAME AS E2 EXCEPT FOR DIRECTIONAL ARROW LEFT	LITHONIA SYLVANIA GENERAL ELECTRIC	2-F5	12VA	277V
	ROADWAY LUMINAIRE WITH A 4' ARM ON A 25' POLE	GE M2RC15S4H2GM3 EMCO GUARDCO	150W HPS	200VA	277V

SURVEY PLOTTED BY	DATE
DRAWN BY	NOV 94
TRACED BY	R. J. HERNANDEZ
CHECKED BY	T. SANCHEZ
QUANTITIES BY	NOV 94
NO.	DEC 94

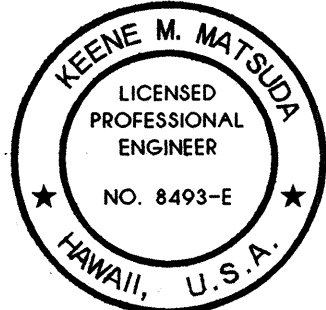

THIS WORK WAS PREPARED BY ME
OR UNDER MY SUPERVISION

Keene Matsuda

DATE	REVISION

STATE OF HAWAII
DEPARTMENT OF TRANSPORTATION
HIGHWAYS DIVISION

**LIGHTING FIXTURE
SCHEDULE**

EXPLORATORY TUNNEL IMPROVEMENTS

H-3 FINISH (UNIT III)
FAIP NO. I-H3-1(75), UNIT III
T.K. TUNNEL/ACCESS ROADS


SCALE: AS NOTED DATE: JUN 1995

SHEET NO. 2E23 OF 30 SHEETS

SYSTEM: 480Y/277V, 100A, 3Ø, 4W PANEL - TLP5										PANEL LOCATION: EXPLORATORY TUNNEL										
MAINS: 100A, 3P										SUPPLY LOCATION: HAIKU PORTAL BLDG, LEVEL 3										
SHORT CIRCUIT RATING: 14KAIC										PNL "DPHU"										
SERVICE	CKT. NO.	LOAD kVA			CIRCUIT BREAKER			WIRE AWG				WIRE AWG	CIRCUIT BREAKER			LOAD kVA			CKT. NO.	SERVICE
		A	B	C	FRAME	POLES	TRIP						TRIP	POLES	FRAME	A	B	C		
TNL LIGHTING	1	0.82			100	1	20	12				10	40	3		5.00		2	ELEVATOR	
TNL LIGHTING	3		0.80		100	1	20	12						3		5.00		4		
TNL LIGHTING	5			0.82	100	1	20	12						3	100		5.00	6		
MPC5	7	5.0			100	2	30	10					40	3	100			8	SPARE	
↓	9		5.0															10		
CP#7 STAIR LTG.	11			0.6	100	1	20	12										12	↓	
SPARE	13				100	2	30						20	1	100			14	SPARE	
↓	15												20	1	100			16	SPARE	
SPARE	17				100	1	20						20	1	100			18	SPARE	
SPARE	19				100	1	20						20	1	100			20	SPARE	
		</																		

SYSTEM: 480Y/277V, 100A, 3Ø, 4W PANEL - TLP6										PANEL LOCATION: EXPLORATORY TUNNEL									
MAINS: 100A, 3P										SUPPLY LOCATION: EXPLORATORY TUNNEL BLDG, LEVEL 3									
SHORT CIRCUIT RATING: 14KAIC										PNL "DPHU"									
SERVICE	CKT. NO.	LOAD kVA			CIRCUIT BREAKER			WIRE AWG		WIRE AWG	CIRCUIT BREAKER			LOAD kVA			CKT. NO.	SERVICE	
		A	B	C	FRAME	POLES	TRIP				TRIP	POLES	FRAME	A	B	C			
TNL LIGHTING	1	0.9			100	1	20	12			10	40	3	100	5.00		2	ELEVATOR	
TNL LIGHTING	3		0.9		100	1	20	12							5.00		4	↓	
TNL LIGHTING	5			1.14	100	1	20	12							5.00		6	↓	
MPC6	7	5.0			100	2	30	10			40	3	100				8	SPARE	
↓	9		5.0														10		
CP#9 STAIR LTG.	11			0.6	100	1	20	12									12	↓	
SPARE	13				100	2	30				20	1	100				14	SPARE	
↓	15										20	1	100				16	SPARE	
SPARE	17				100	1	20				20	1	100				18	SPARE	
POWER DOOR LOCK HAIKU PORTAL	19			0.1	100	1	20	12			20	1	100				20	SPARE	
	21																		
		</																	

SURVEY PLOTTED BY	DATE
DRNAT BY	NOV 94
DESIGNED BY	NOV 94
CHECKED BY	DEC 94
NO.	

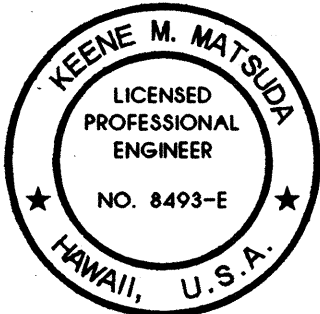

THIS WORK WAS PREPARED BY ME
OR UNDER MY SUPERVISION

Keene Matsuda

5/29/97	DCN 75-019: IDENTIFIED CIRCUIT FOR HAIKU PORTAL POWER DOOR LOCK PANEL TLP6
DATE	REVISION

STATE OF HAWAII DEPARTMENT OF TRANSPORTATION HIGHWAYS DIVISION	
<u>PANEL SCHEDULES - 2</u>	
<u>EXPLORATORY TUNNEL IMPROVEMENTS</u>	
<u>H-3 FINISH (UNIT III)</u>	
<u>FAIP NO. I-H3-1(75), UNIT III</u>	
<u>T.K. TUNNEL/ACCESS ROADS</u>	
SCALE: NONE	DATE: JUN 1995
SHEET NO. 2E25 OF 30 SHEETS	

FED. ROAD DIST. NO.	STATE	FED. AID PROJ. NO.	FISCAL YEAR	SHEET NO.	TOTAL SHEETS
HAWAII	HAW.	I-H3-1(75) UNIT III	1994	99	353

[illegible][illegible]

ORIGINAL PLAN	SURVEY PLOTTED BY	DATE
	DRAWN BY	"
	TRACED BY	"
NOTE BOOK	DESIGNED BY	"
	QUANTITIES BY	"
	CHECKED BY	"
NO.		"

10/27/95	ADDENDUM 2-ADDED FS-ET2 TO MPC5
DATE	REVISION

STATE OF HAWAII
DEPARTMENT OF TRANSPORTATION
HIGHWAYS DIVISION

PANEL SCHEDULES - 4

EXPLORATORY TUNNEL IMPROVEMENTS

H-3 FINISH (UNIT III)

FAIP NO. I-H3-1(75), UNIT III

T.K. TUNNEL/ACCESS ROADS

SCALE: NONE	DATE: JUN 1995
-------------	----------------

SHEET NO. 2E27 OF 30 SHEETS

A circular professional engineer seal. The outer ring contains the text "KEENE M. MATSUDA" at the top and "HAWAII, U.S.A." at the bottom, separated by two stars. The inner circle contains the text "LICENSED PROFESSIONAL ENGINEER" and "NO. 8493-E".


THIS WORK WAS PREPARED BY ME
OR UNDER MY SUPERVISION

Kare Matnick


FED. ROAD DIST. NO.	STATE	FED. AID PROJ. NO.	FISCAL YEAR	SHEET NO.	TOTAL SHEETS
HAWAII	HAW.	I-H3-1(75) UNIT III	1994	100	353

NOTES:



- FOR TUNNEL GROUND CONDUCTOR LOCATION, REFER TO SHEET NO. 2E21.

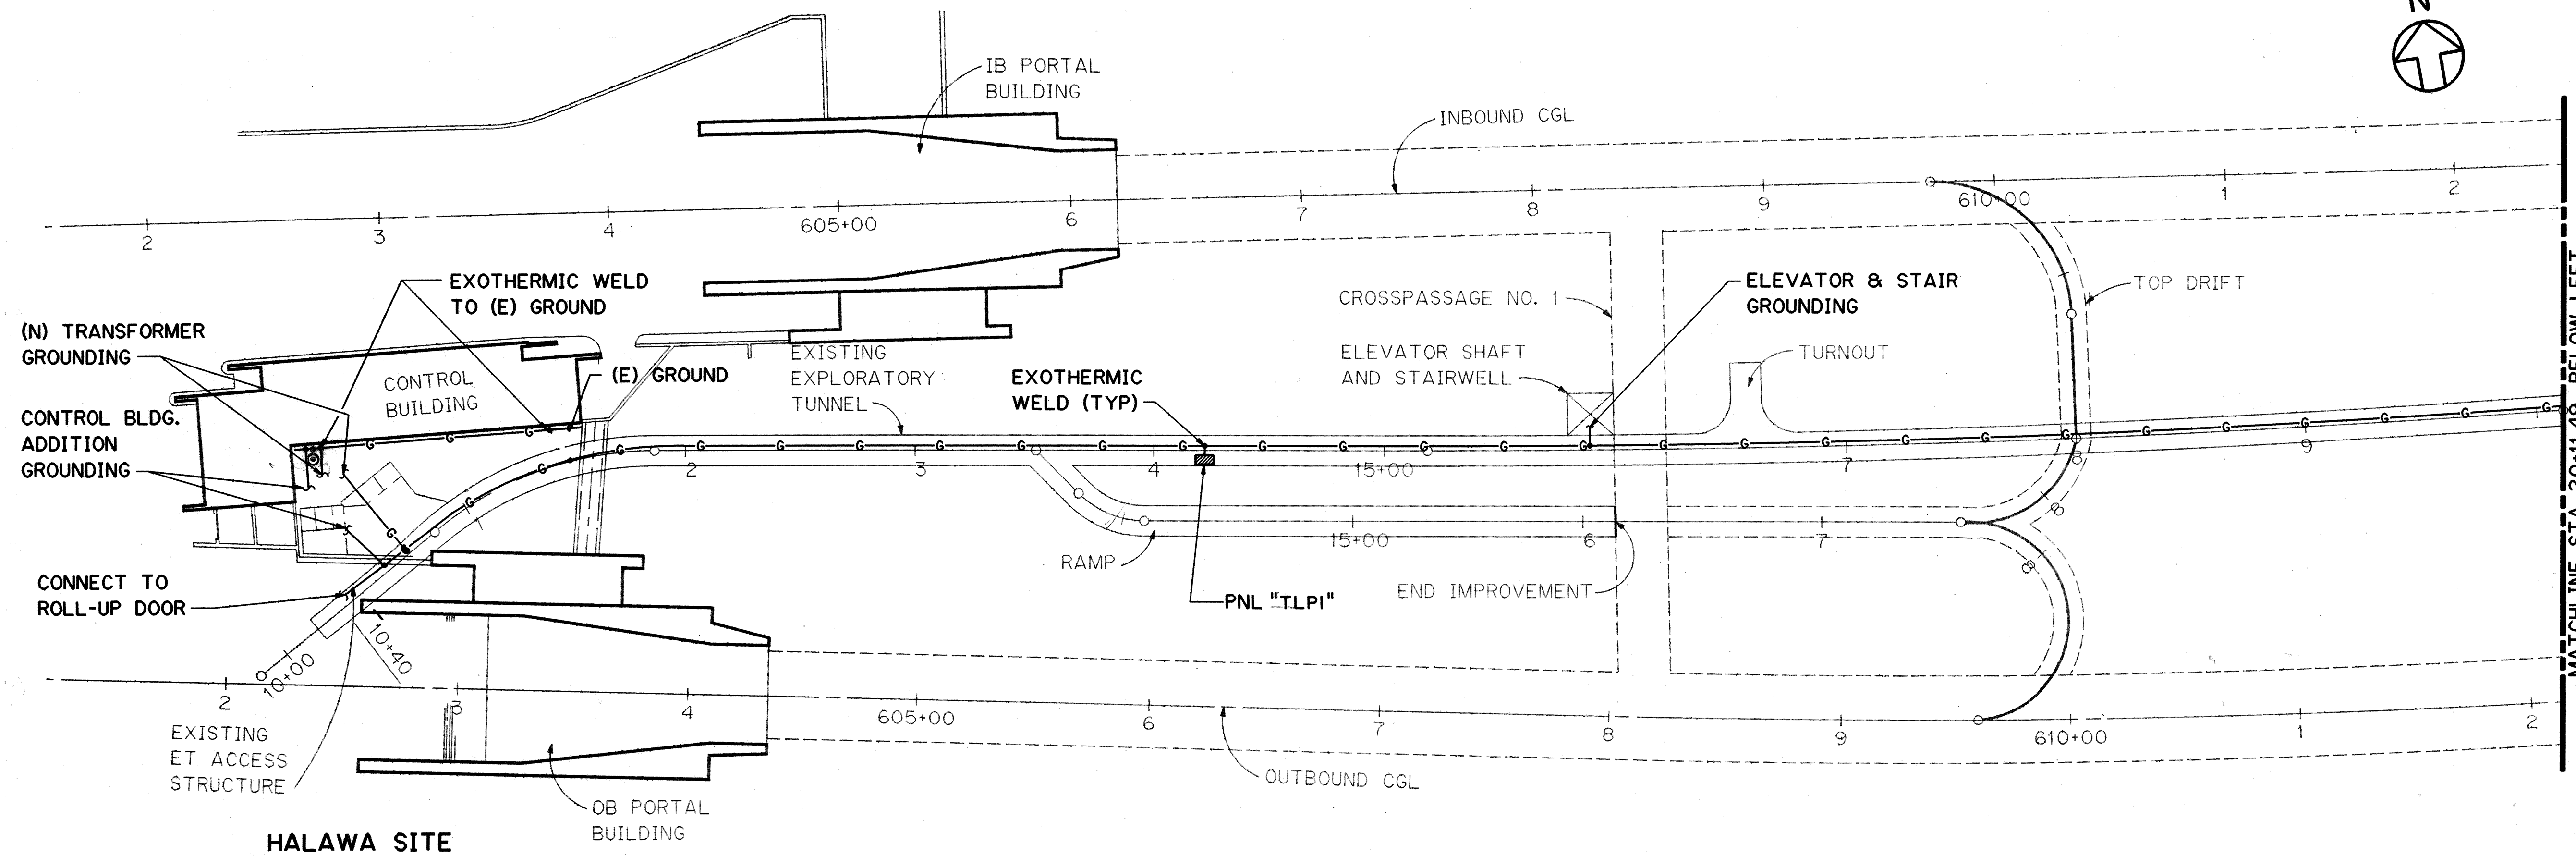

HALAWA SITE

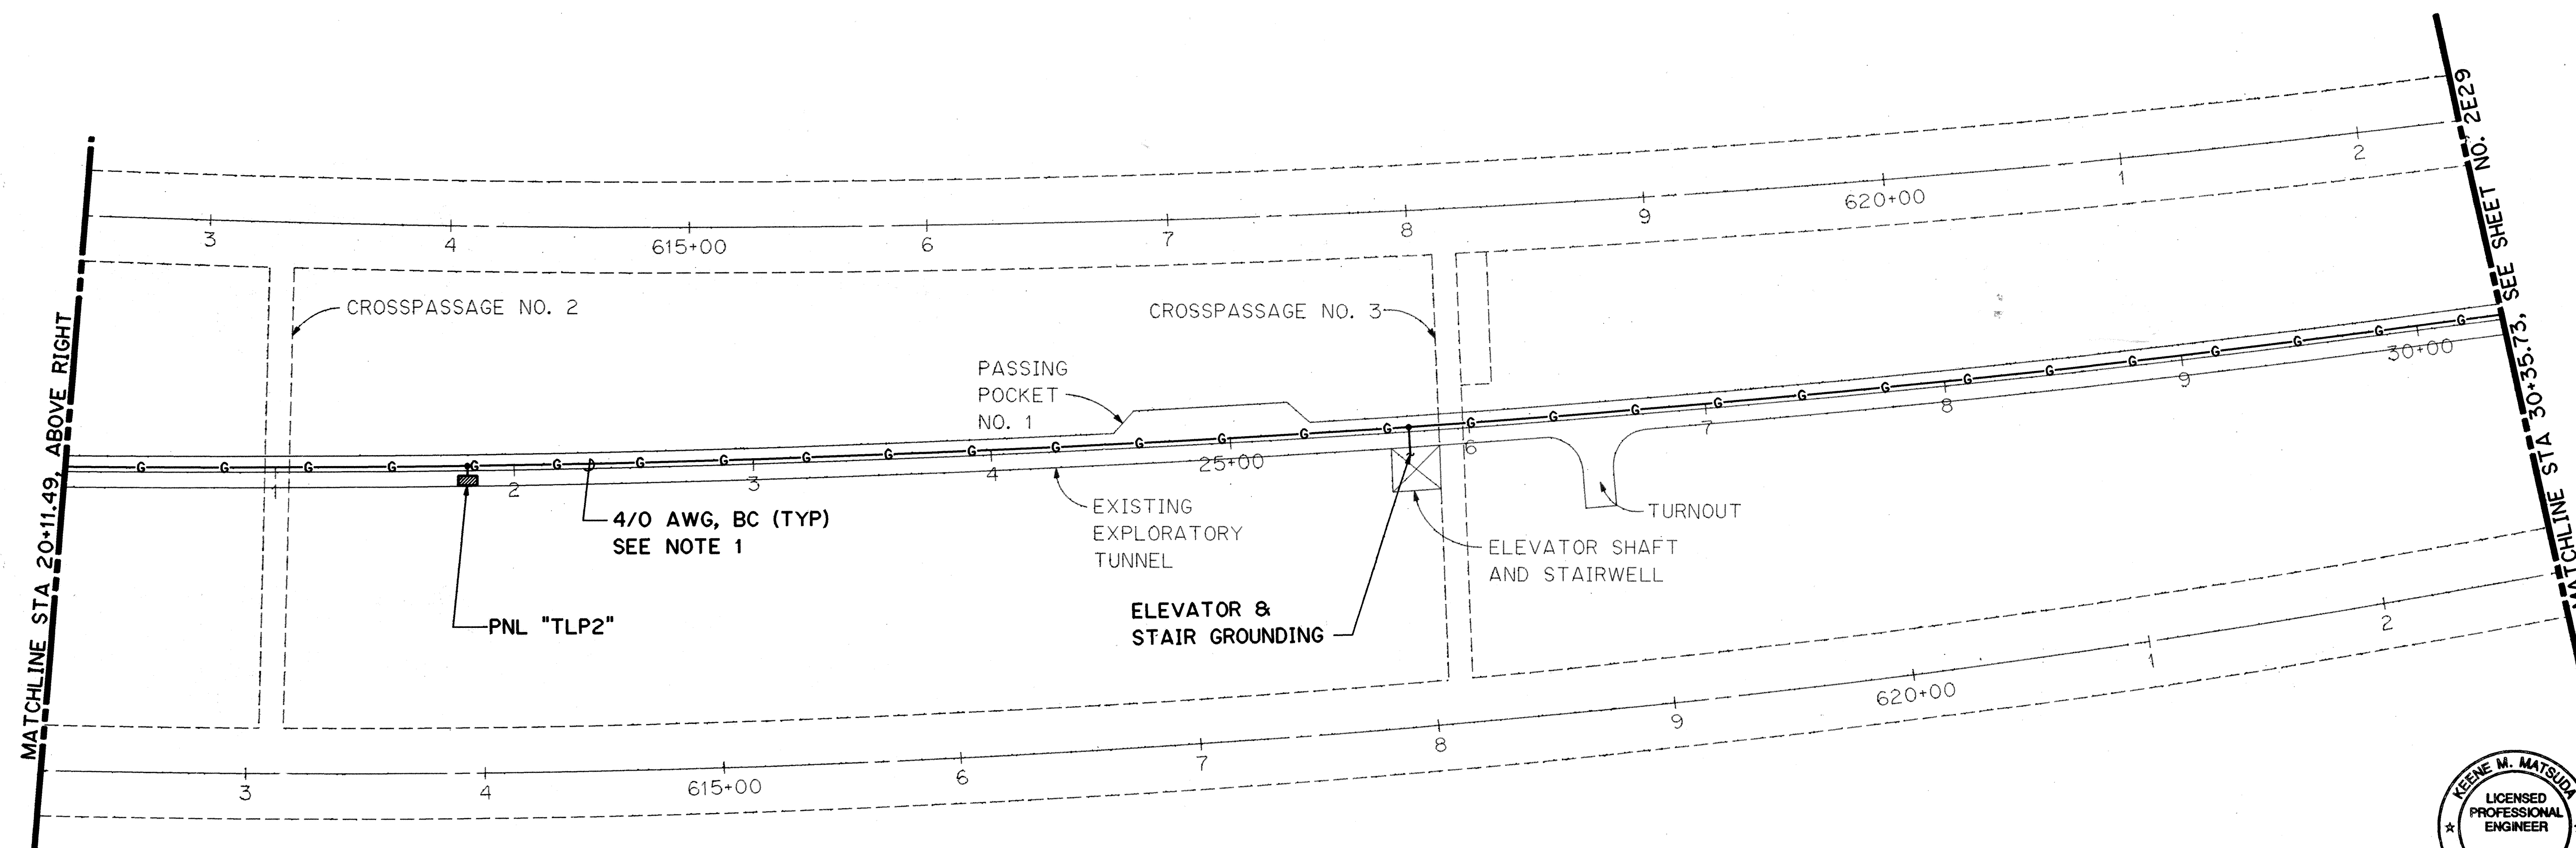

PARTIAL PLAN - EXPLORATORY TUNNEL

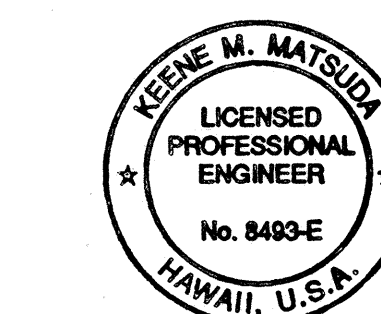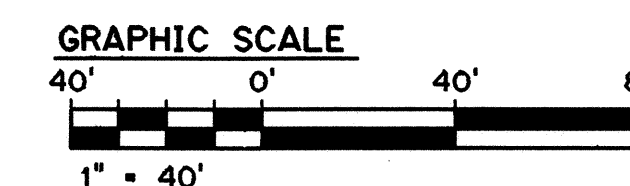

THIS WORK WAS PREPARED BY ME
OR UNDER MY SUPERVISION

Keene Matsuda


10/13/95	ADDENDUM I
DATE	REVISION
STATE OF HAWAII DEPARTMENT OF TRANSPORTATION HIGHWAYS DIVISION GROUNDING PLAN-1 EXPLORATORY TUNNEL IMPROVEMENTS H-3 FINISH (UNIT III) FAIP NO. I-H3-1(75), UNIT III T.K. TUNNEL/ACCESS ROADS SCALE: 1" = 40' DATE: JUN 1995 SHEET NO. 2E28 OF 30 SHEETS	

ADD. 100



DATE	NOV 94
SURVEY PLOTTED BY	R. J. HERNANDEZ
DESIGNED BY	T. SANCHEZ
CHECKED BY	K. MATSUDA
NO.	DEC 94

NOTES:

1. FOR TUNNEL GROUND CONDUCTOR
LOCATION, REFER TO SHEET NO. 2E21.

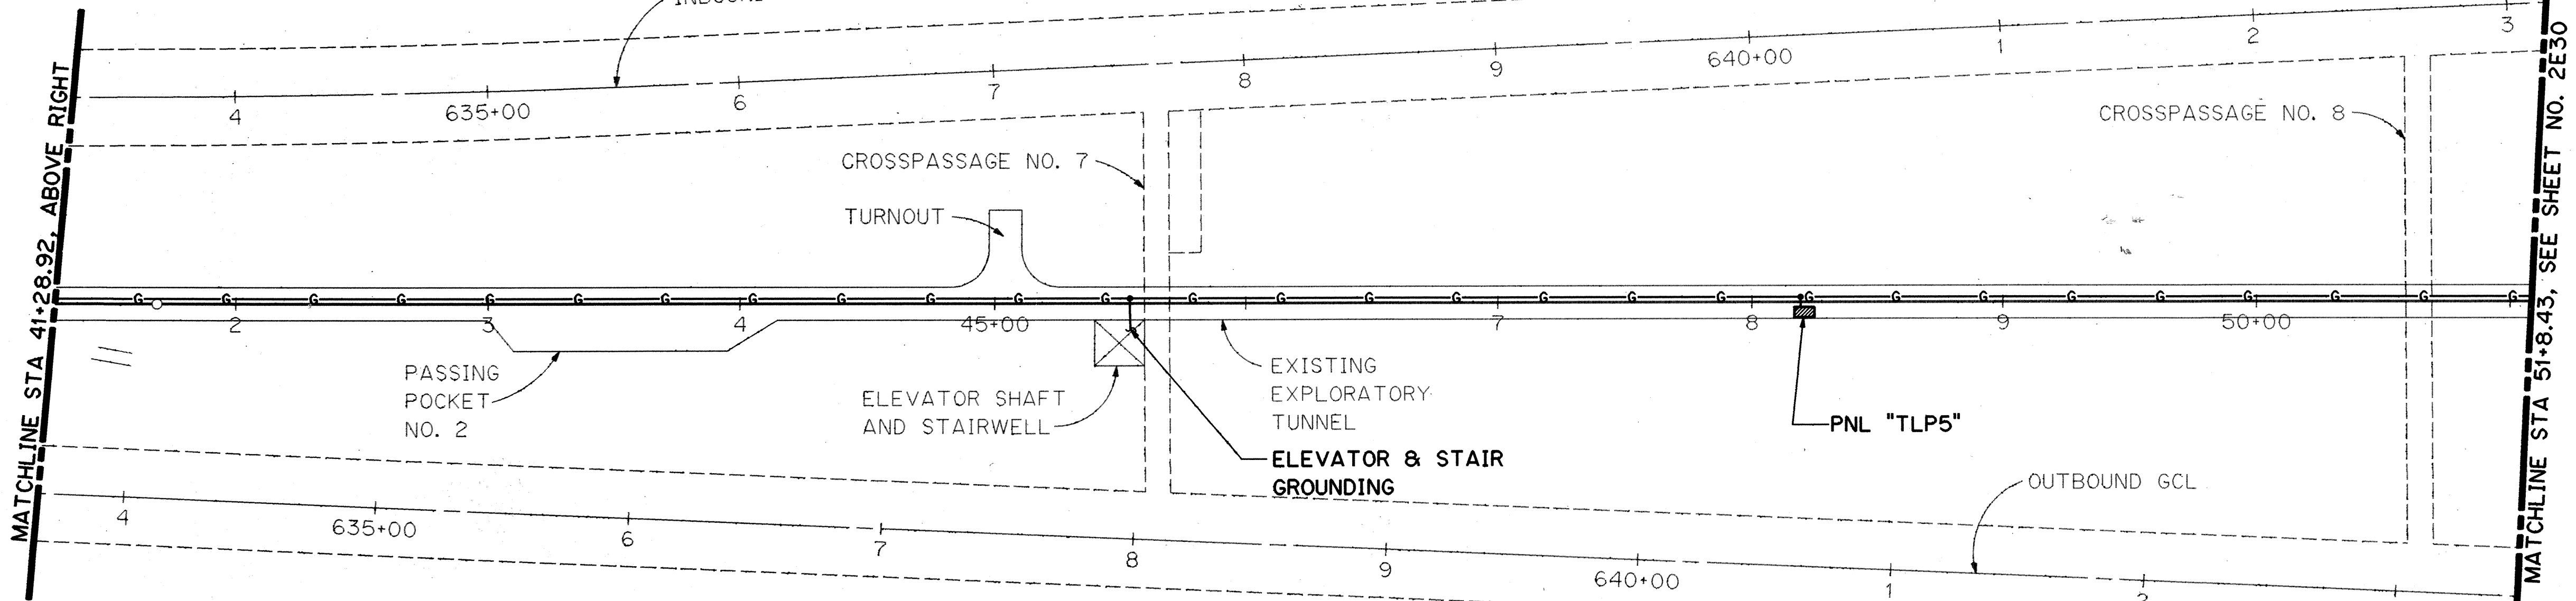

PARTIAL PLAN - EXPLORATORY TUNNEL

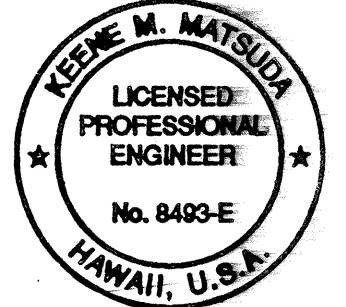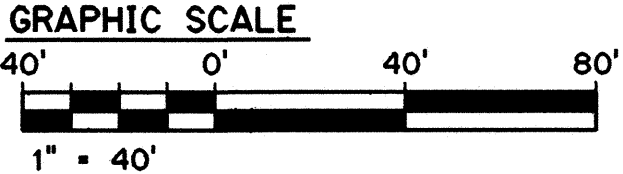

THIS WORK WAS PREPARED BY ME
OR UNDER MY SUPERVISION

Keene Maternity

DATE	REVISION

STATE OF HAWAII
DEPARTMENT OF TRANSPORTATION
HIGHWAYS DIVISION

GROUNDING PLAN-2

EXPLORATORY TUNNEL IMPROVEMENTS


H-3 FINISH (UNIT III)

FAIP NO. I-H3-I(75), UNIT III

T.K. TUNNEL/ACCESS ROADS



SHEET NO. 2E29 OF 30 SHEETS

FED. ROAD DIST. NO.	STATE	FED. AID PROJ. NO.	FISCAL YEAR	SHEET NO.	TOTAL SHEETS
HAWAII	HAW.	I-H3-1(75) UNIT III	1994	102	353

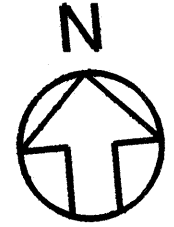



NOTES:

1. FOR TUNNEL GROUND CONDUCTOR LOCATION, REFER TO SHEET NO. 2E21.

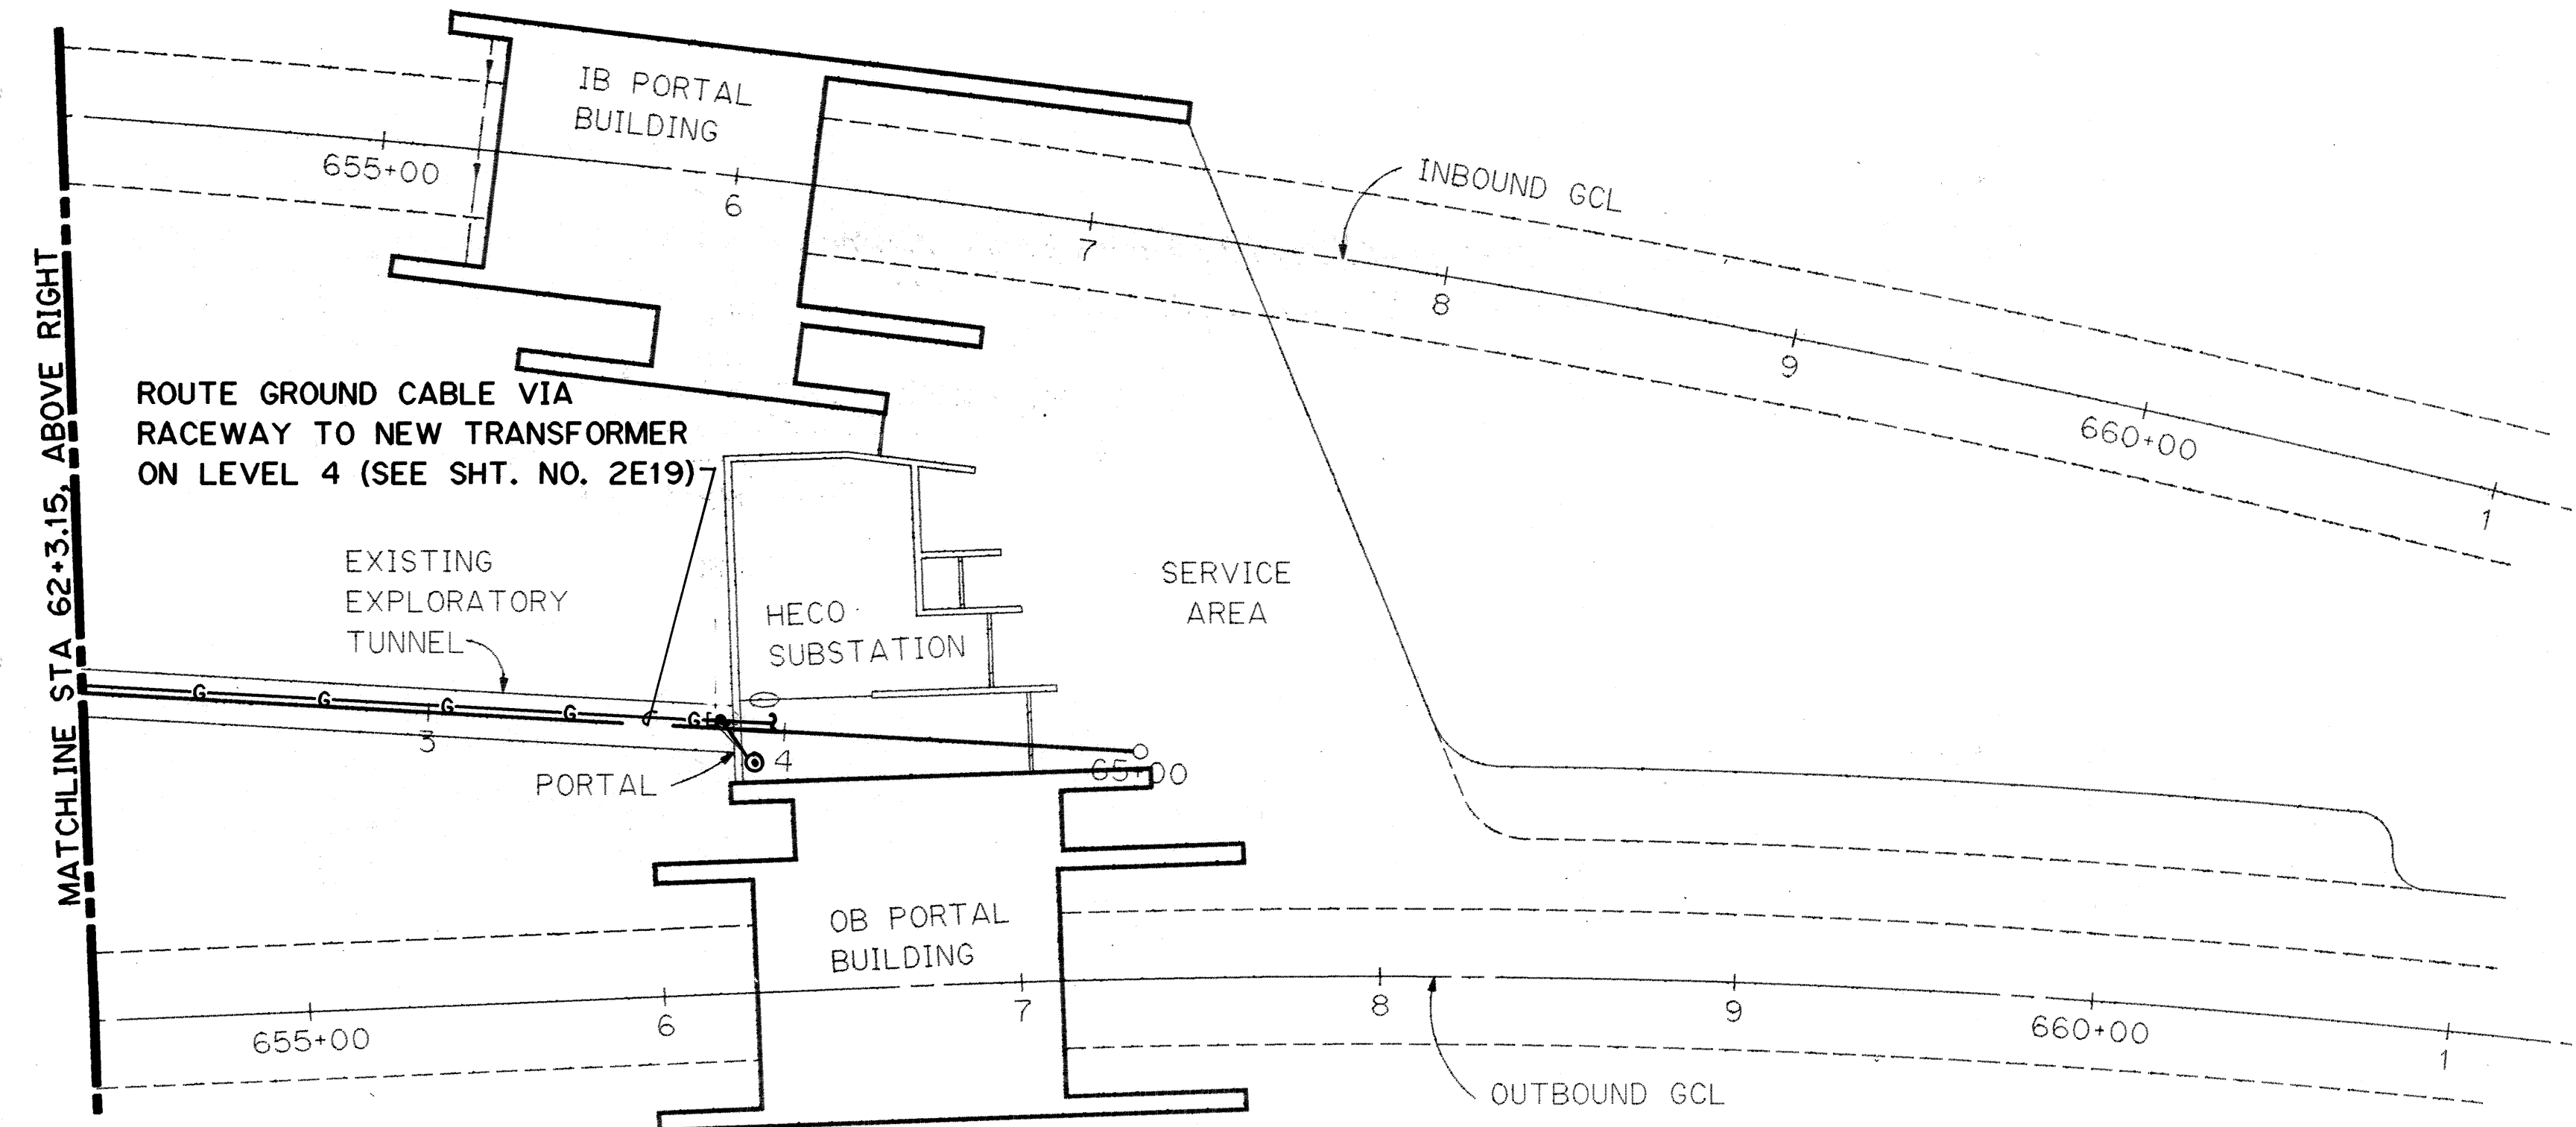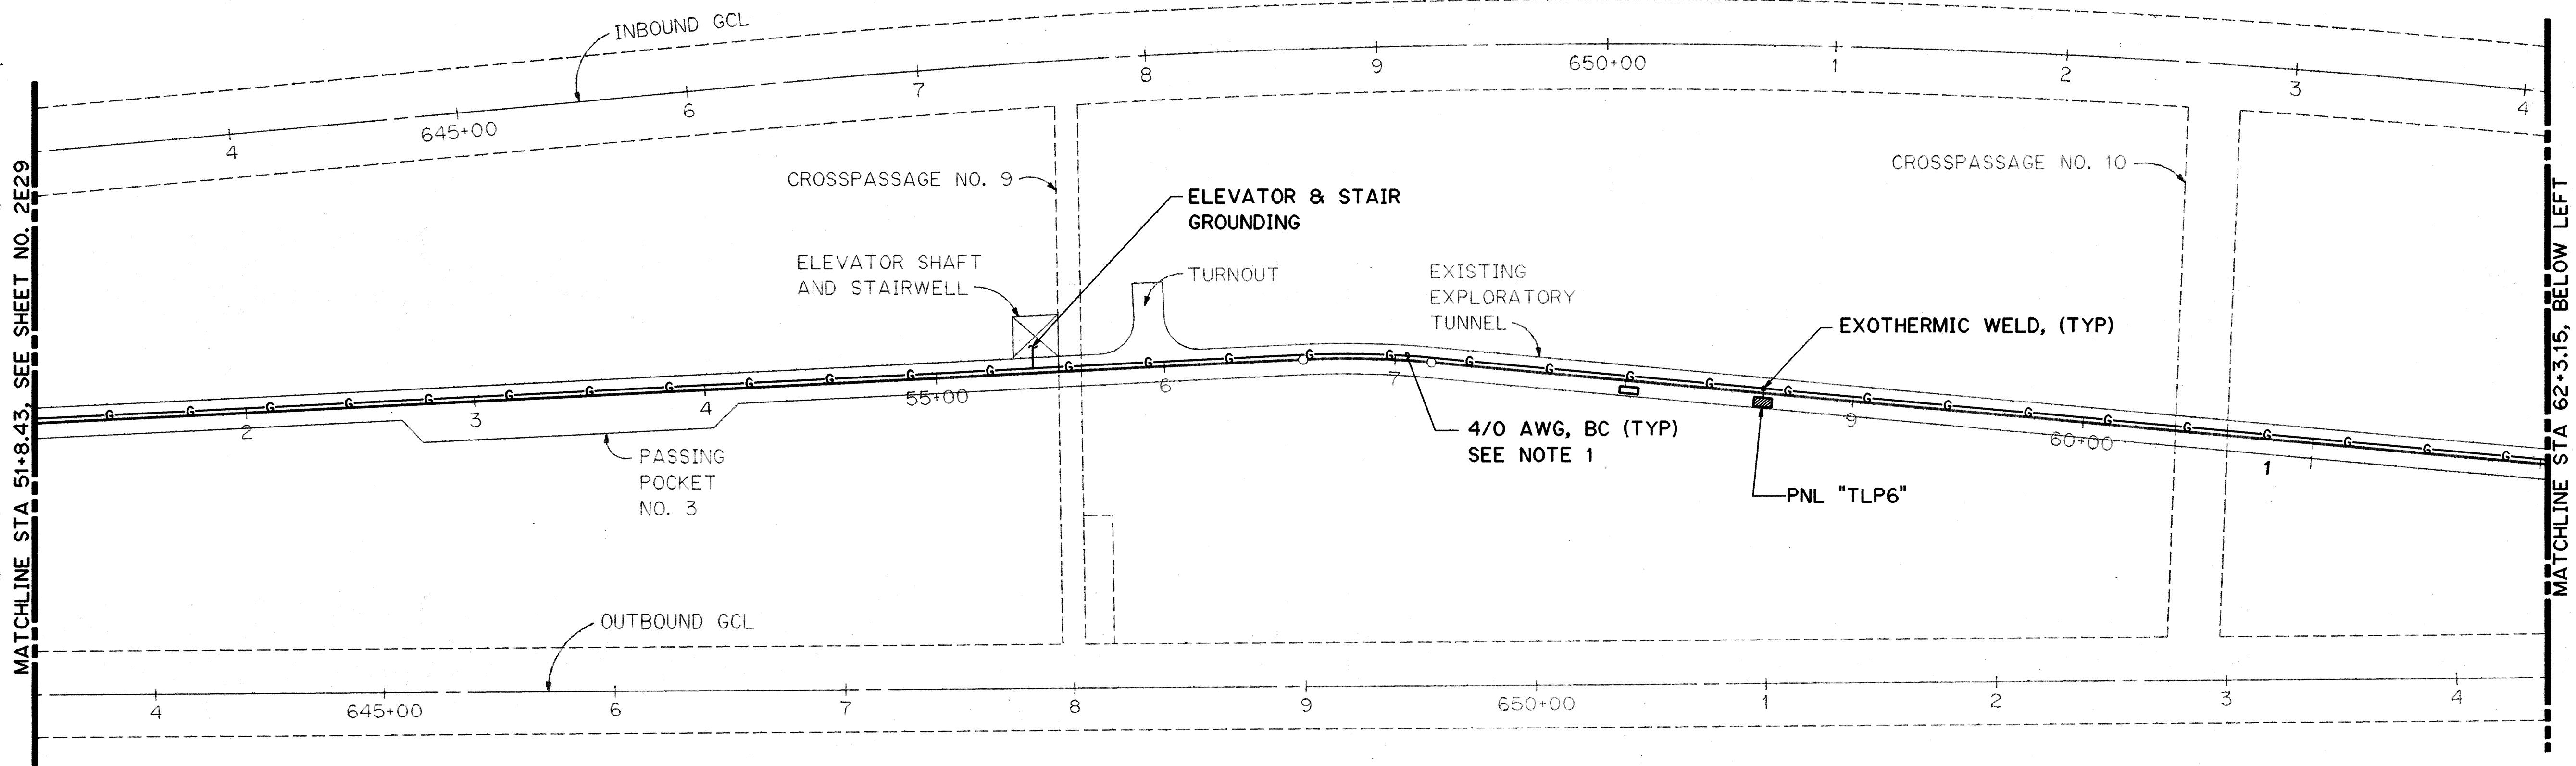

HAIKU SITE

PARTIAL PLAN - EXPLORATORY TUNNEL

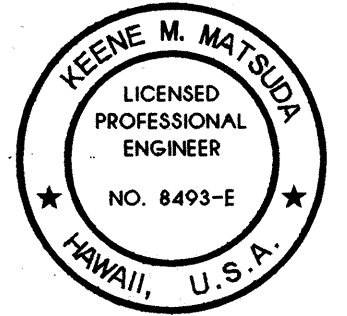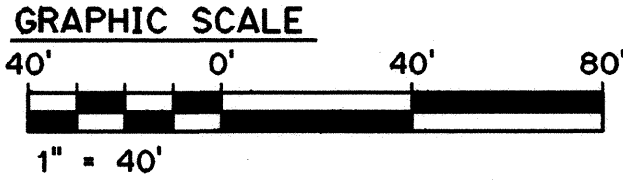

THIS WORK WAS PREPARED BY ME
OR UNDER MY SUPERVISION
Keene Matsumoto

10/13/95	ADDENDUM I
DATE	REVISION
STATE OF HAWAII DEPARTMENT OF TRANSPORTATION HIGHWAYS DIVISION GROUNDING PLAN-3 EXPLORATORY TUNNEL IMPROVEMENTS H-3 FINISH (UNIT III) FAIP NO. I-H3-1(75), UNIT III T.K. TUNNEL/ACCESS ROADS SCALE: 1" = 40' DATE: JUN 1995 SHEET NO. 2E30 OF 30 SHEETS	

SURVEY PLOTTED BY	DATE
R. J. HERNANDEZ	NOV 94
DESIGNED BY	NOV 94
T. SANCHEZ	NOV 94
QUANTITIES BY	DEC 94
K. MATSUDA	DEC 94
CHECKED BY	
NO.	

XREF LIST:
ETI-BRDR

CONDUIT AND CABLE SCHEDULE		
RUN NO.	CONDUIT	CONTENTS
1	0.50	1 - PULL STATION CABLE
2	0.75	1 - INTERCOM CABLE
3	0.50	1 - CO MONITOR CABLE
4	1.00	1 - CCTV VIDEO AND POWER CABLE
5	0.50	1 - SMOKE DETECTOR CABLE
6	1.00	1 - SMOKE DETECTOR CABLE, 1 - PULL STATION CABLE 1 - AUDIBLE/VISUAL ALARM CABLE
7	1.50	1 - CCTV VIDEO AND POWER CABLE, 1 - CO MONITOR CABLE, 1 - INTERCOM CABLE
8 **	3.00	2 - CCTV VIDEO AND POWER CABLES, 1 - CO MONITOR CABLE, 1 - INTERCOM CABLE, 1 - 15PR ELEVATOR CABLE, 1 - TELEPHONE CABLE, 2 - 1PR FAN CABLE
9	0.75	2 - SMOKE DETECTOR CABLES
10	1.00	2 - CCTV VIDEO AND POWER CABLES
11	0.75	1 - CCTV VIDEO AND POWER CABLE
12	1.00	2 - SMOKE DETECTOR CABLES, 1 - PULL STATION CABLE 1 - AUDIBLE/VISUAL ALARM CABLE
13	1.50	1 - 15 PR ELEVATOR CABLE, 1 - TELEPHONE CABLE
14	0.50	1 - INTRUSION DETECTOR CABLE
15 **	3.00	2 - CCTV VIDEO AND POWER CABLES, 1 - CO MONITOR CABLE, 1 - INTERCOM CABLE, 1 - INTRUSION DETECTOR CABLE, 1 - 15 PR ELEVATOR CABLE, 1 TELEPHONE CABLE, 2 - 1PR FAN CABLE
16	1.50	1 - CCTV VIDEO AND POWER CABLE, 2 - INTRUSION DETECTOR CABLES, 1 - CARD KEY ACCESS & POWER CABLE, 1 - INTERCOM CABLE, 1 - DOOR STRIKE CABLE
17	1.50	1 - INTERCOM CABLE, 2 - INTRUSION DETECTOR CABLES, 1 - CARD KEY ACCESS AND POWER CABLE, 1 - DOOR STRIKE CABLE
19	0.50	2 - SMOKE DETECTOR CABLE
20	NONE	2 - RADIO ANTENNA CABLES (ONE PAIR EACH SIDE OF TUNNEL)
21		NOT USED
22	1.00	1 - CARD KEY ACCESS AND POWER CABLE
23	1.25	1 - CARD KEY ACCESS AND POWER CABLE, 1 - INTERCOM CABLE 1 - INTRUSION DETECTION
24	1.00	1 - CARD KEY ACCESS CABLE, 1 - INTERCOM CABLE
25	0.50	1 - INTRUSION DETECTION (MOTOR LIMIT SWITCH)
26	0.75	1 - PULL STATION CABLE, 1 - AUDIBLE/VISUAL ALARM CABLE
27	2.00	1 - 4 PR FAN CABLE, 1 - PR ISOLATION VALVE, 1 - PR FLOW SWITCH
28	0.75	2 - 1PR FAN CABLE
29	2.00	1 - 15PR ELEVATOR CABLE, 1 - TELEPHONE CABLE, 2 - 1PR FAN CABLE
30	1.50	1 - 4PR FAN CABLE, 1 - PR ISOLATION VALVE, 1 - PR FLOW SWITCH, 1 - CCTV VIDEO AND POWER CABLE, 1 - INTERCOM CABLE
32	2.00	2 - INTRUSION DETECTION CABLE, 1 - CARD KEY ACCESS AND POWER CABLE, 1 - DOOR STRIKE CABLE

** FOR CROSSPASSAGE NO. 1, ADD 1 - CCTV VIDEO AND POWER CABLE (TOTAL OF 3)

GENERAL NOTES:

1. CONTRACTOR SHALL PROVIDE 1 - IOPR AND 1 - 5PR CABLE TO MEET THE 15PR ELEVATOR CABLE REQUIREMENT.

CONSTRUCTION NOTES

1. INSTALL ANTENNAE SUPPORT BRACKET EVERY 10' THROUGHOUT THE LENGTH OF THE TUNNEL. SEE SHEET NO. 2T21 FOR SUPPORT DETAIL.
2. INSTALL PTZ POSITION CLOSED CIRCUIT TELEVISION (CCTV) CAMERA AS SHOWN ON SHEET NO. 2T16, DETAIL NO. 1.
3. INSTALL FIXED POSITION CLOSED CIRCUIT TELEVISION (CCTV) CAMERA AS SHOWN ON SHEET NO. 2T16, DETAIL NO. 2.
4. INSTALL THE FIRE ALARM PULL STATION AND AUDIBLE/VISUAL ALARM PER DETAIL NO. 1 SHOWN ON SHEET NO. 2T18.
5. INSTALL CO MONITOR PER DETAIL NO. 1 SHOWN ON SHEET NO. 2T17.
6. INSTALL INTERCOM PER DETAIL NO. 2 SHOWN ON SHEET NO. 2T17.
7. INSTALL SMOKE DETECTOR PER DETAIL NO. 2 SHOWN ON SHEET NO. 2T18.
8. INSTALL INTRUSION DETECTOR PER DETAIL NO. 2 SHOWN ON SHEET NO. 2T19.
9. SURFACE MOUNT CONDUIT ONTO TUNNEL WALL WITH APPROVED FASTENING DEVICES. MAXIMUM SPACING PER NEC.
10. INSTALL CONDULET AT THE "T" INTERSECTION WHERE THE CONDUITS MEET.
11. SURFACE MOUNT CONDUIT TO SIDE OF BRIDGE PIER WITH APPROVED FASTENING DEVICES. MAXIMUM SPACING PER NEC.
12. RUN CONDUIT INTO THE EXISTING JUNCTION BOX.
13. INSTALL CONDUIT IN REVEAL PER DETAIL NO. 2 SHOWN ON SHEET NO. 2T20.
14. TERMINATE WIRING ON LIMIT SWITCH CONTACT.
15. INSTALL END OF THE LINE RESISTOR AT THIS DEVICE.

16. COIL AND TIE OFF 75' OF EACH CABLE ENTERING EQUIPMENT ROOM. SEE SPECIAL PROVISIONS FOR TESTING REQUIREMENTS. CONTRACTOR SHALL TAG EACH PAIR WITH THE APPROPRIATE CONTACT NUMBER.
17. COIL AND TIE OFF 30' OF EACH CABLE ENTERING EQUIPMENT ROOM. CONTRACTOR SHALL TAG EACH PAIR WITH APPROPRIATE CONTACT NUMBER.
18. CORE DRILL AND GROUT PER SPECIAL PROVISIONS.
19. LOCATION TO BE DETERMINED IN THE FIELD.
20. INSTALL INTRUSION DETECTOR ON CROSSPASSAGE DOOR PER DETAIL ON SHT. NO. 7T4L. DETAIL APPLIES TO ALL CROSS PASSAGE DOORS. (TOTAL OF 20 INSTALLATION LOCATIONS).
21. INSTALL NEW 3/4" CONDUIT. PENETRATE EXISTING JB IN CEILING. INSTALL 3/4" TO 2" CONDULET TO MATCH EXISTING 2" CONDUIT AT FLOOR. INSTALLATION IS REQUIRED AT CROSSPASSAGE NOS. 2, 3, 4, 6, 7, 8 AND 10.


NOTE: ALL CONDUIT AND CABLES INDICATED ON CONDUIT AND CABLE SCHEDULE SHALL BE PROVIDED AND INSTALLED AS PART OF THIS CONTRACT.

FOR DETAIL AS-BUILT INFORMATION
REFER TO CONSTRUCTION SUBMITTALS

CABLE SIZE ASSUMPTIONS FOR CONDUIT SIZING CALCULATIONS

CABLE TYPE	CABLE SIZE
INTRUSION DETECTOR CABLE, DOOR STRIKE CABLE	2/C #18
CARBON MONOXIDE MONITOR CABLE	2/C #18 SHIELDED
SMOKE DETECTOR CABLE	2/C #18
CARD READER CABLE	2/C #18 SHIELDED
CARD READER POWER CABLE	2 #18
INTERCOM CABLE	2 #22 TWISTED PAIR, SHIELDED
PULL STATION CABLE	2/C #16
AUDIBLE/VISUAL ALARM CABLE	2/C #16
RADIO COAXIAL CABLE	RG59
CCTV CONTROL CABLE	3/C #18 SHIELDED (2 CABLES)
CCTV VIDEO CABLE	RG59 TRIAX
CCTV POWER CABLE	#12 (3 CABLES)


DATE 10/94
SURVEY PLOTTED BY
DRAWN BY G. J. FROMM
CHECKED BY
DESIGNED BY G. J. FROMM
QUANTITIES BY
NOTE BOOK
ORIGINAL PLAN
No.

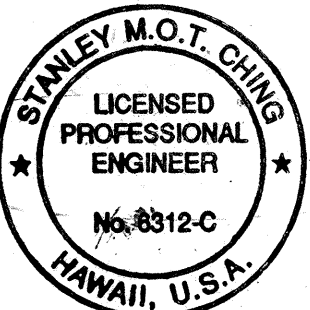

THIS WORK WAS PREPARED BY ME
OR UNDER MY SUPERVISION
Stanley M.O.T. Ching

1/14/97	DCN75-010: REVISED PER RESPONSE TO RFI # 4097-136
10/27/95	ADDENDUM 2 - REVISED CONST. NOTES 17 AND 20, ADDED CONST. NOTE 21, REVISED CONDUIT RUN 7,8,13,14,16,17 AND 18, ADDED CONDUIT RUN 30,31 AND 32
10/13/95	ADDENDUM 1
DATE	REVISION
STATE OF HAWAII DEPARTMENT OF TRANSPORTATION HIGHWAYS DIVISION CONDUIT/CABLE SCHEDULE & NOTES - SYSTEMS EXPLORATORY TUNNEL IMPROVEMENTS H-3 FINISH (UNIT III) FAIP NO. 1-H3-1(75). UNIT III T.K. TUNNEL/ACCESS ROADS SCALE: NONE DATE: JUN 1995 SHEET NO. 2T1 OF 21 SHEETS	


FED. ROAD DIST. NO.	STATE	FED. AID PROJ. NO.	FISCAL YEAR	SHEET NO.	TOTAL SHEETS
HAWAII	HAW.	I-H3-1(75) UNIT III	1994	104	353

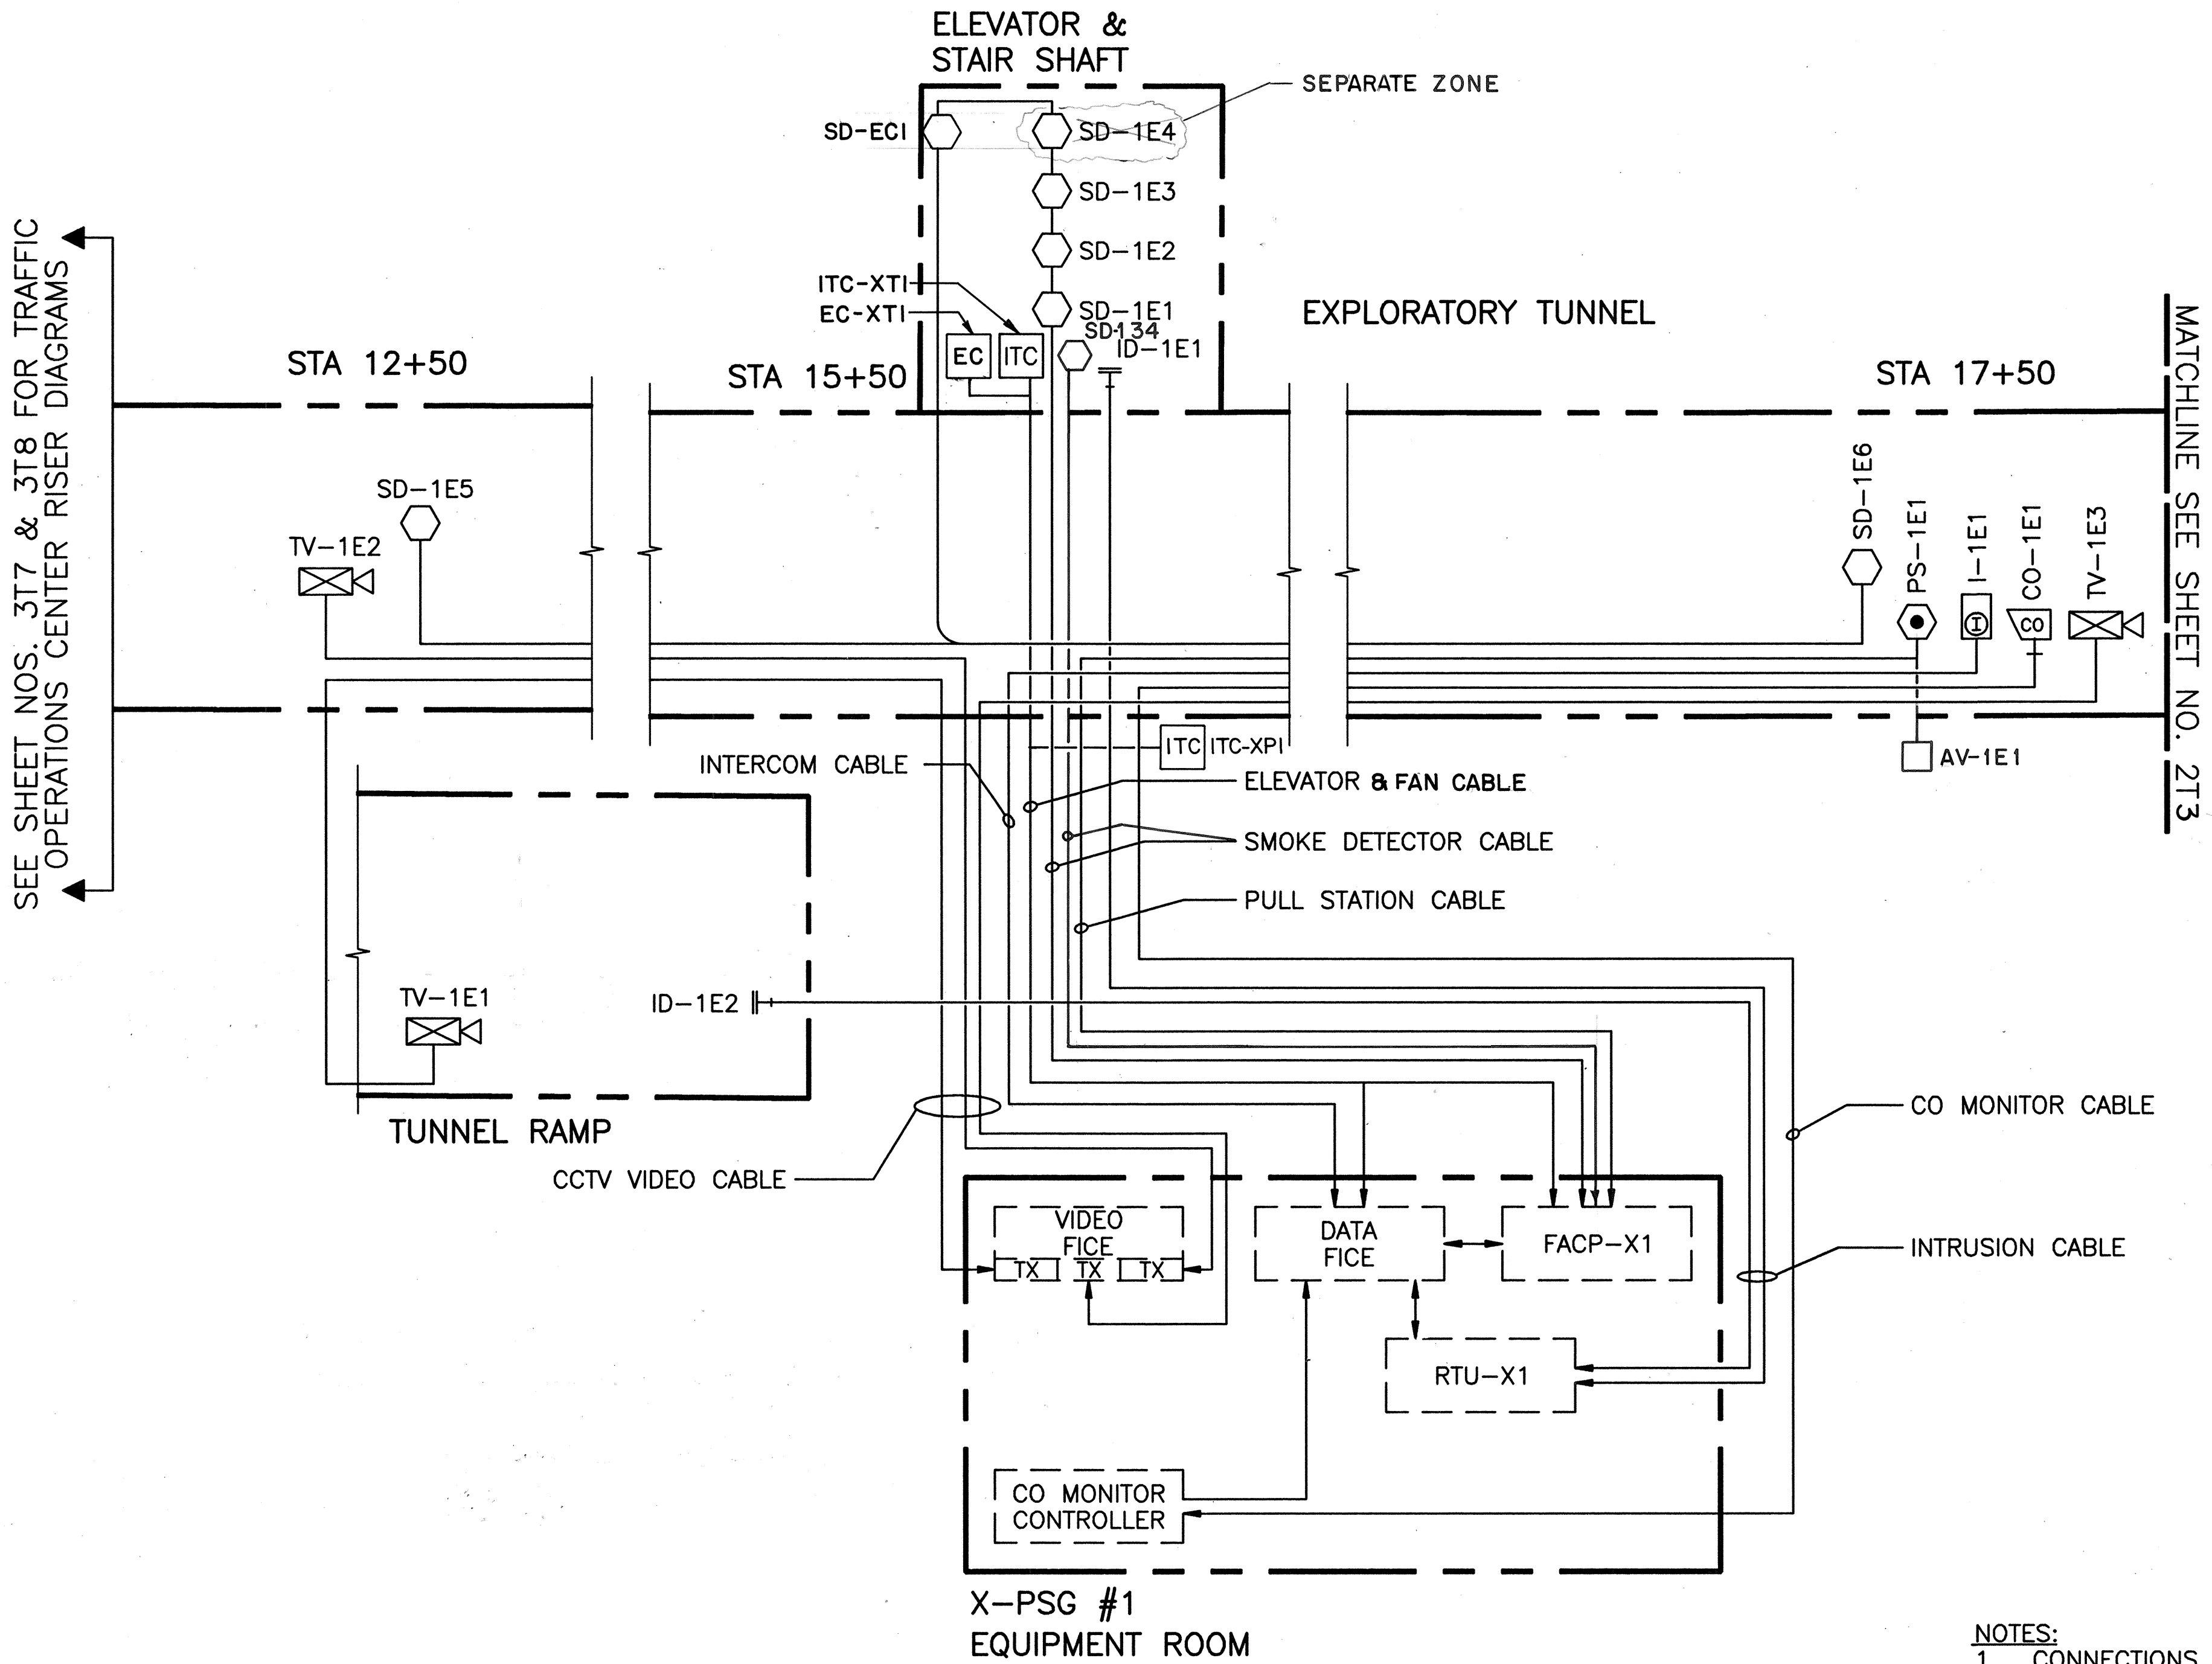

NOTES:

1. CONNECTIONS SHOWN TO THE DEVICES IN THE SYSTEMS EQRM ARE FOR INFORMATION ONLY. CONTRACTOR IS NOT RESPONSIBLE FOR MAKING THESE FINAL CONNECTIONS PER PLANS & SPECIAL PROVISIONS.

ORIGINAL PLAN	DATE
NO. _____	10/94
DESIGNED BY L. NELSON/D. ANDERSON	10/94
CHECKED BY _____	_____
QUANTITIES BY _____	_____
TRACED BY F. HITT	_____
SURVEY PLOTTED BY _____	DATE 10/94

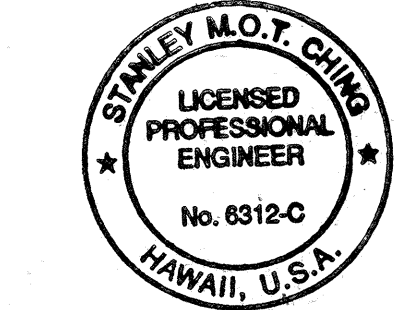


THIS WORK WAS PREPARED BY ME OR UNDER MY SUPERVISION


Stanley M.O.T. Chang

DATE	REVISION
10/27/95	ADDENDUM 2-ADDED LABEL FOR ITC-XPI
10/13/95	ADDENDUM 1
STATE OF HAWAII DEPARTMENT OF TRANSPORTATION HIGHWAYS DIVISION	
BLOCK DIAGRAM - 1	
SYSTEMS	
EXPLORATORY TUNNEL IMPROVEMENTS	
H-3 FINISH (UNIT III)	
FAIP NO. I-H3-1(75), UNIT III	
T.K. TUNNEL/ACCESS ROADS	
SCALE: NONE	DATE: JUN 1995
SHEET NO. 212 OF 21 SHEETS	

XREF LIST
ETI-BRDR

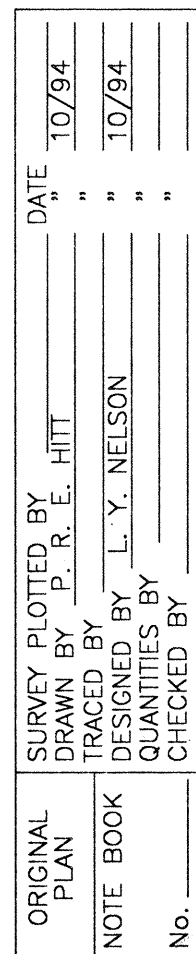


1. CONNECTIONS SHOWN TO THE DEVICES IN THE SYSTEMS EQRM ARE FOR INFORMATION ONLY. CONTRACTOR IS NOT RESPONSIBLE FOR MAKING THESE FINAL CONNECTIONS PER PLANS & SPECIAL PROVISIONS.

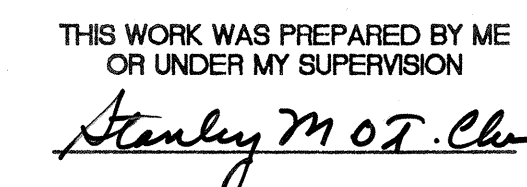


P:\H3\CONT.75\UNIT-III\EXP-TUN\H3-2T04.DWG

XREF LIST:
ETI-BRDR

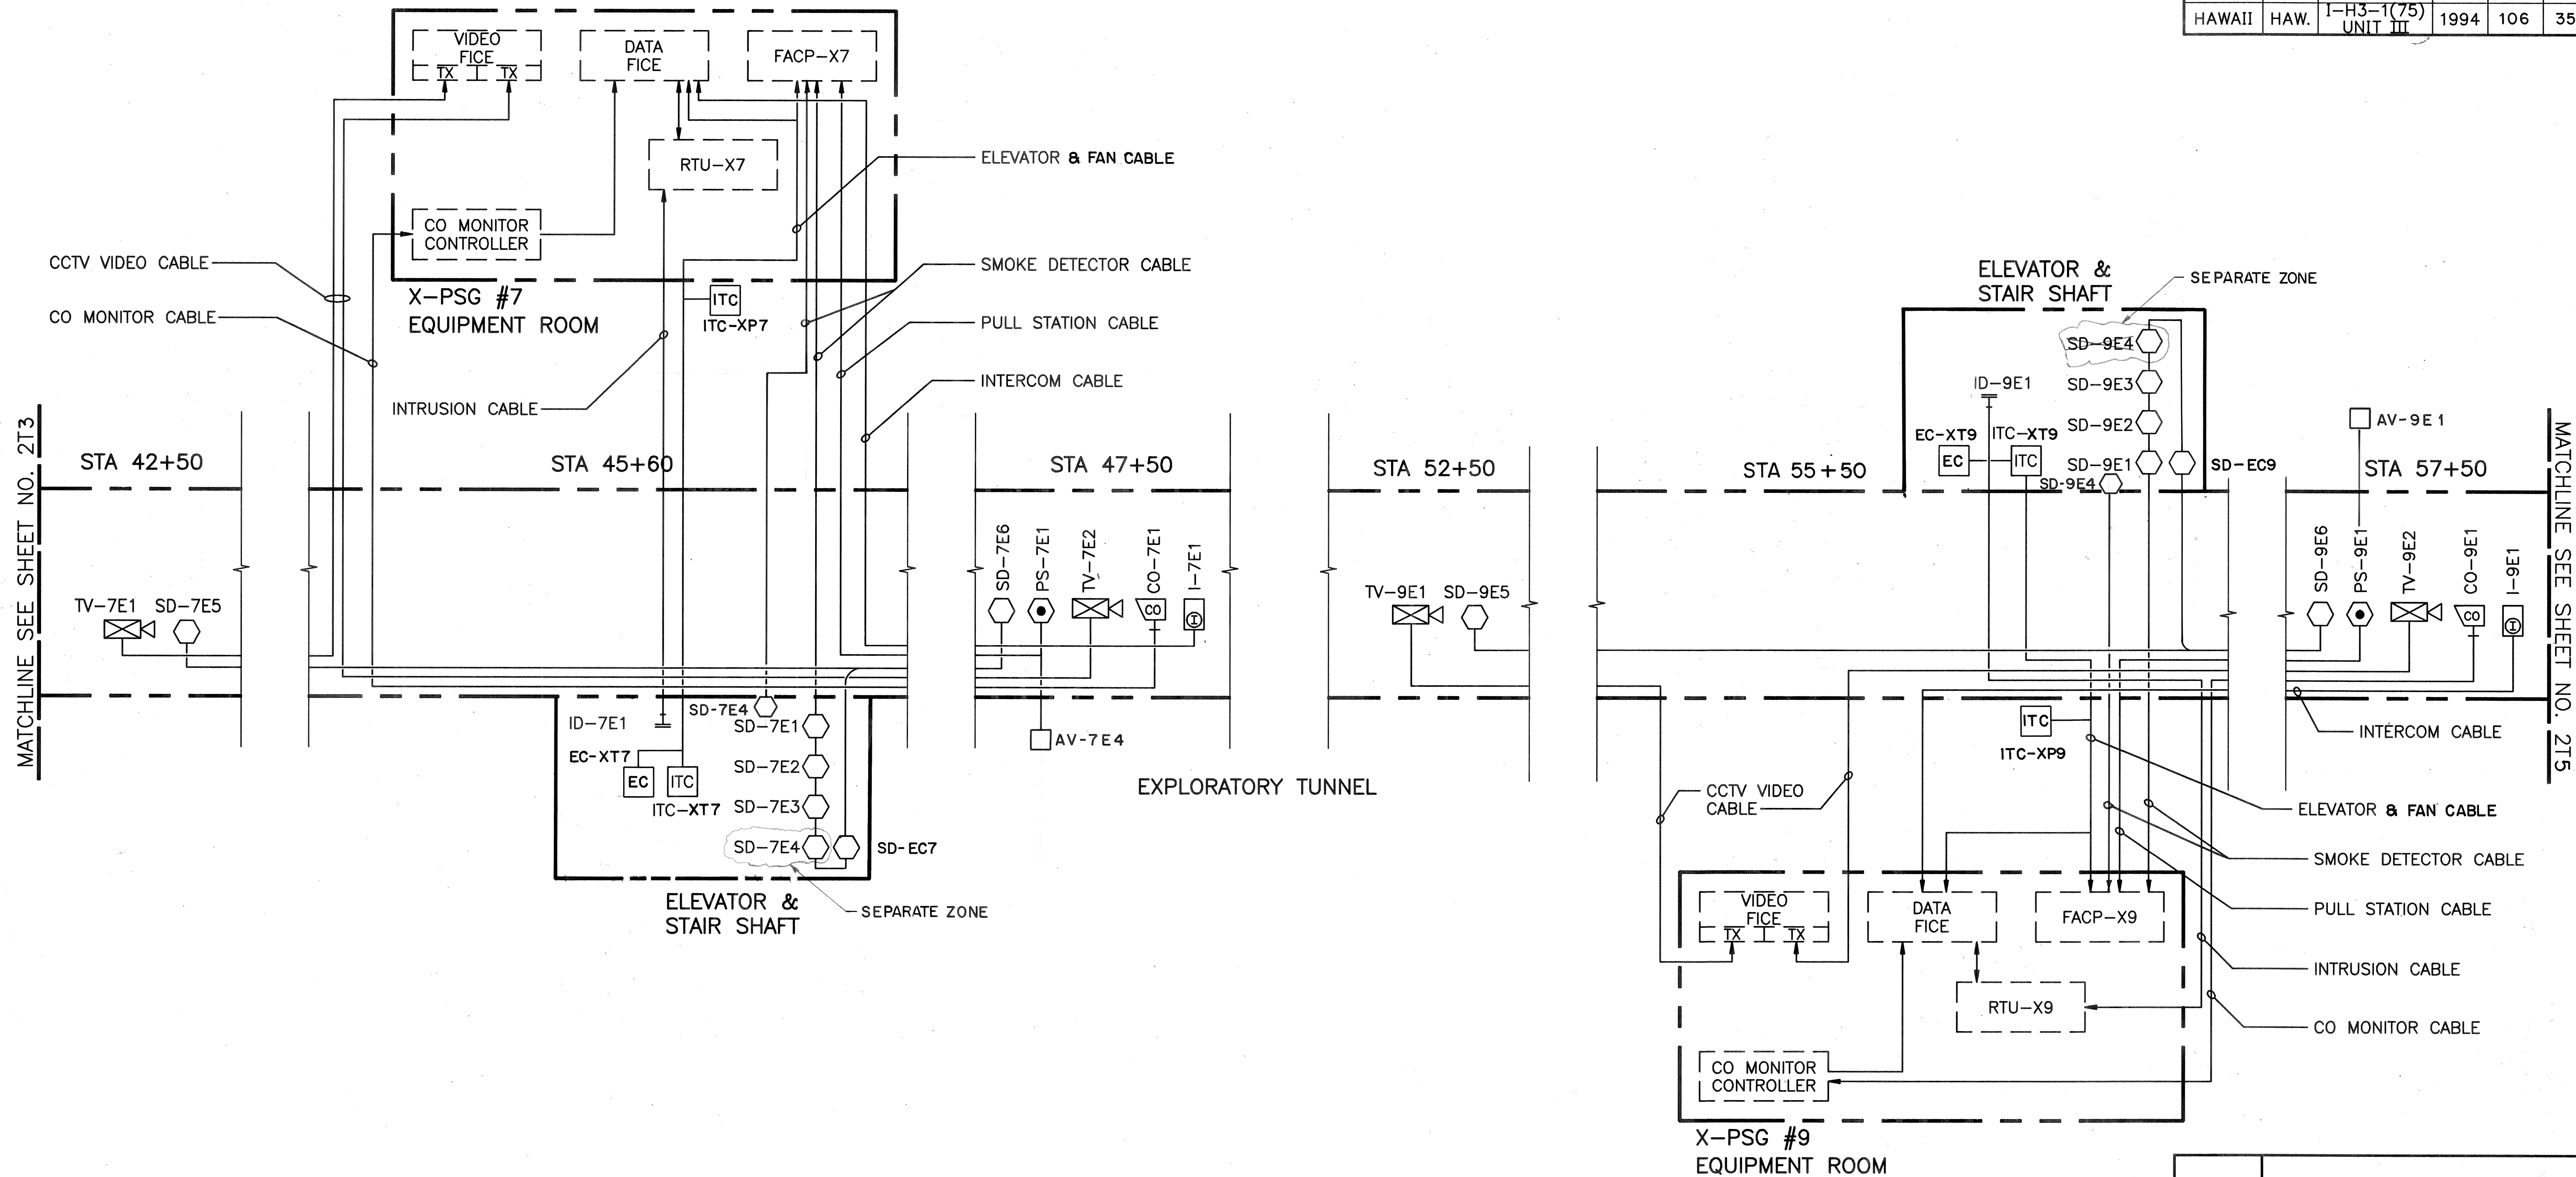

NOTES:
1. CONNECTIONS SHOWN TO THE DEVICES IN THE SYSTEMS EQRM ARE FOR INFORMATION ONLY. CONTRACTOR IS NOT RESPONSIBLE FOR MAKING THESE FINAL CONNECTIONS PER PLANS & SPECIAL PROVISIONS.

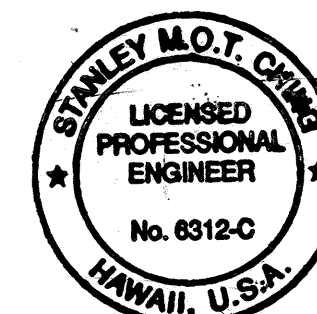


THIS WORK WAS PREPARED BY ME
OR UNDER MY SUPERVISION
Stanley M.O.T. Chung

10/13/95	ADDENDUM I
DATE	REVISION
STATE OF HAWAII DEPARTMENT OF TRANSPORTATION HIGHWAYS DIVISION	
BLOCK DIAGRAM - 3	
SYSTEMS	
EXPLORATORY TUNNEL IMPROVEMENTS	
H-3 FINISH (UNIT III)	
FAIP NO. I-H3-1(75), UNIT III	
T.K. TUNNEL/ACCESS ROADS	
SCALE: NONE	DATE: JUN 1995
SHEET NO. 214 OF 21 SHEETS	

ORIGINAL PLAN	DATE
NO. 1	10/94
SURVEY PLOTTED BY	DATE
DRAWN BY P. R. E. HIT	10/94
TRACED BY	
DESIGNED BY L. Y. NELSON	
CHECKED BY	
NO.	


FED. ROAD DIST. NO.	STATE	FED. AID PROJ. NO.	FISCAL YEAR	SHEET NO.	TOTAL SHEETS
HAWAII	HAW.	I-H3-1(75) UNIT III	1994	107	353

XREF LIST:
ETI--BRDR

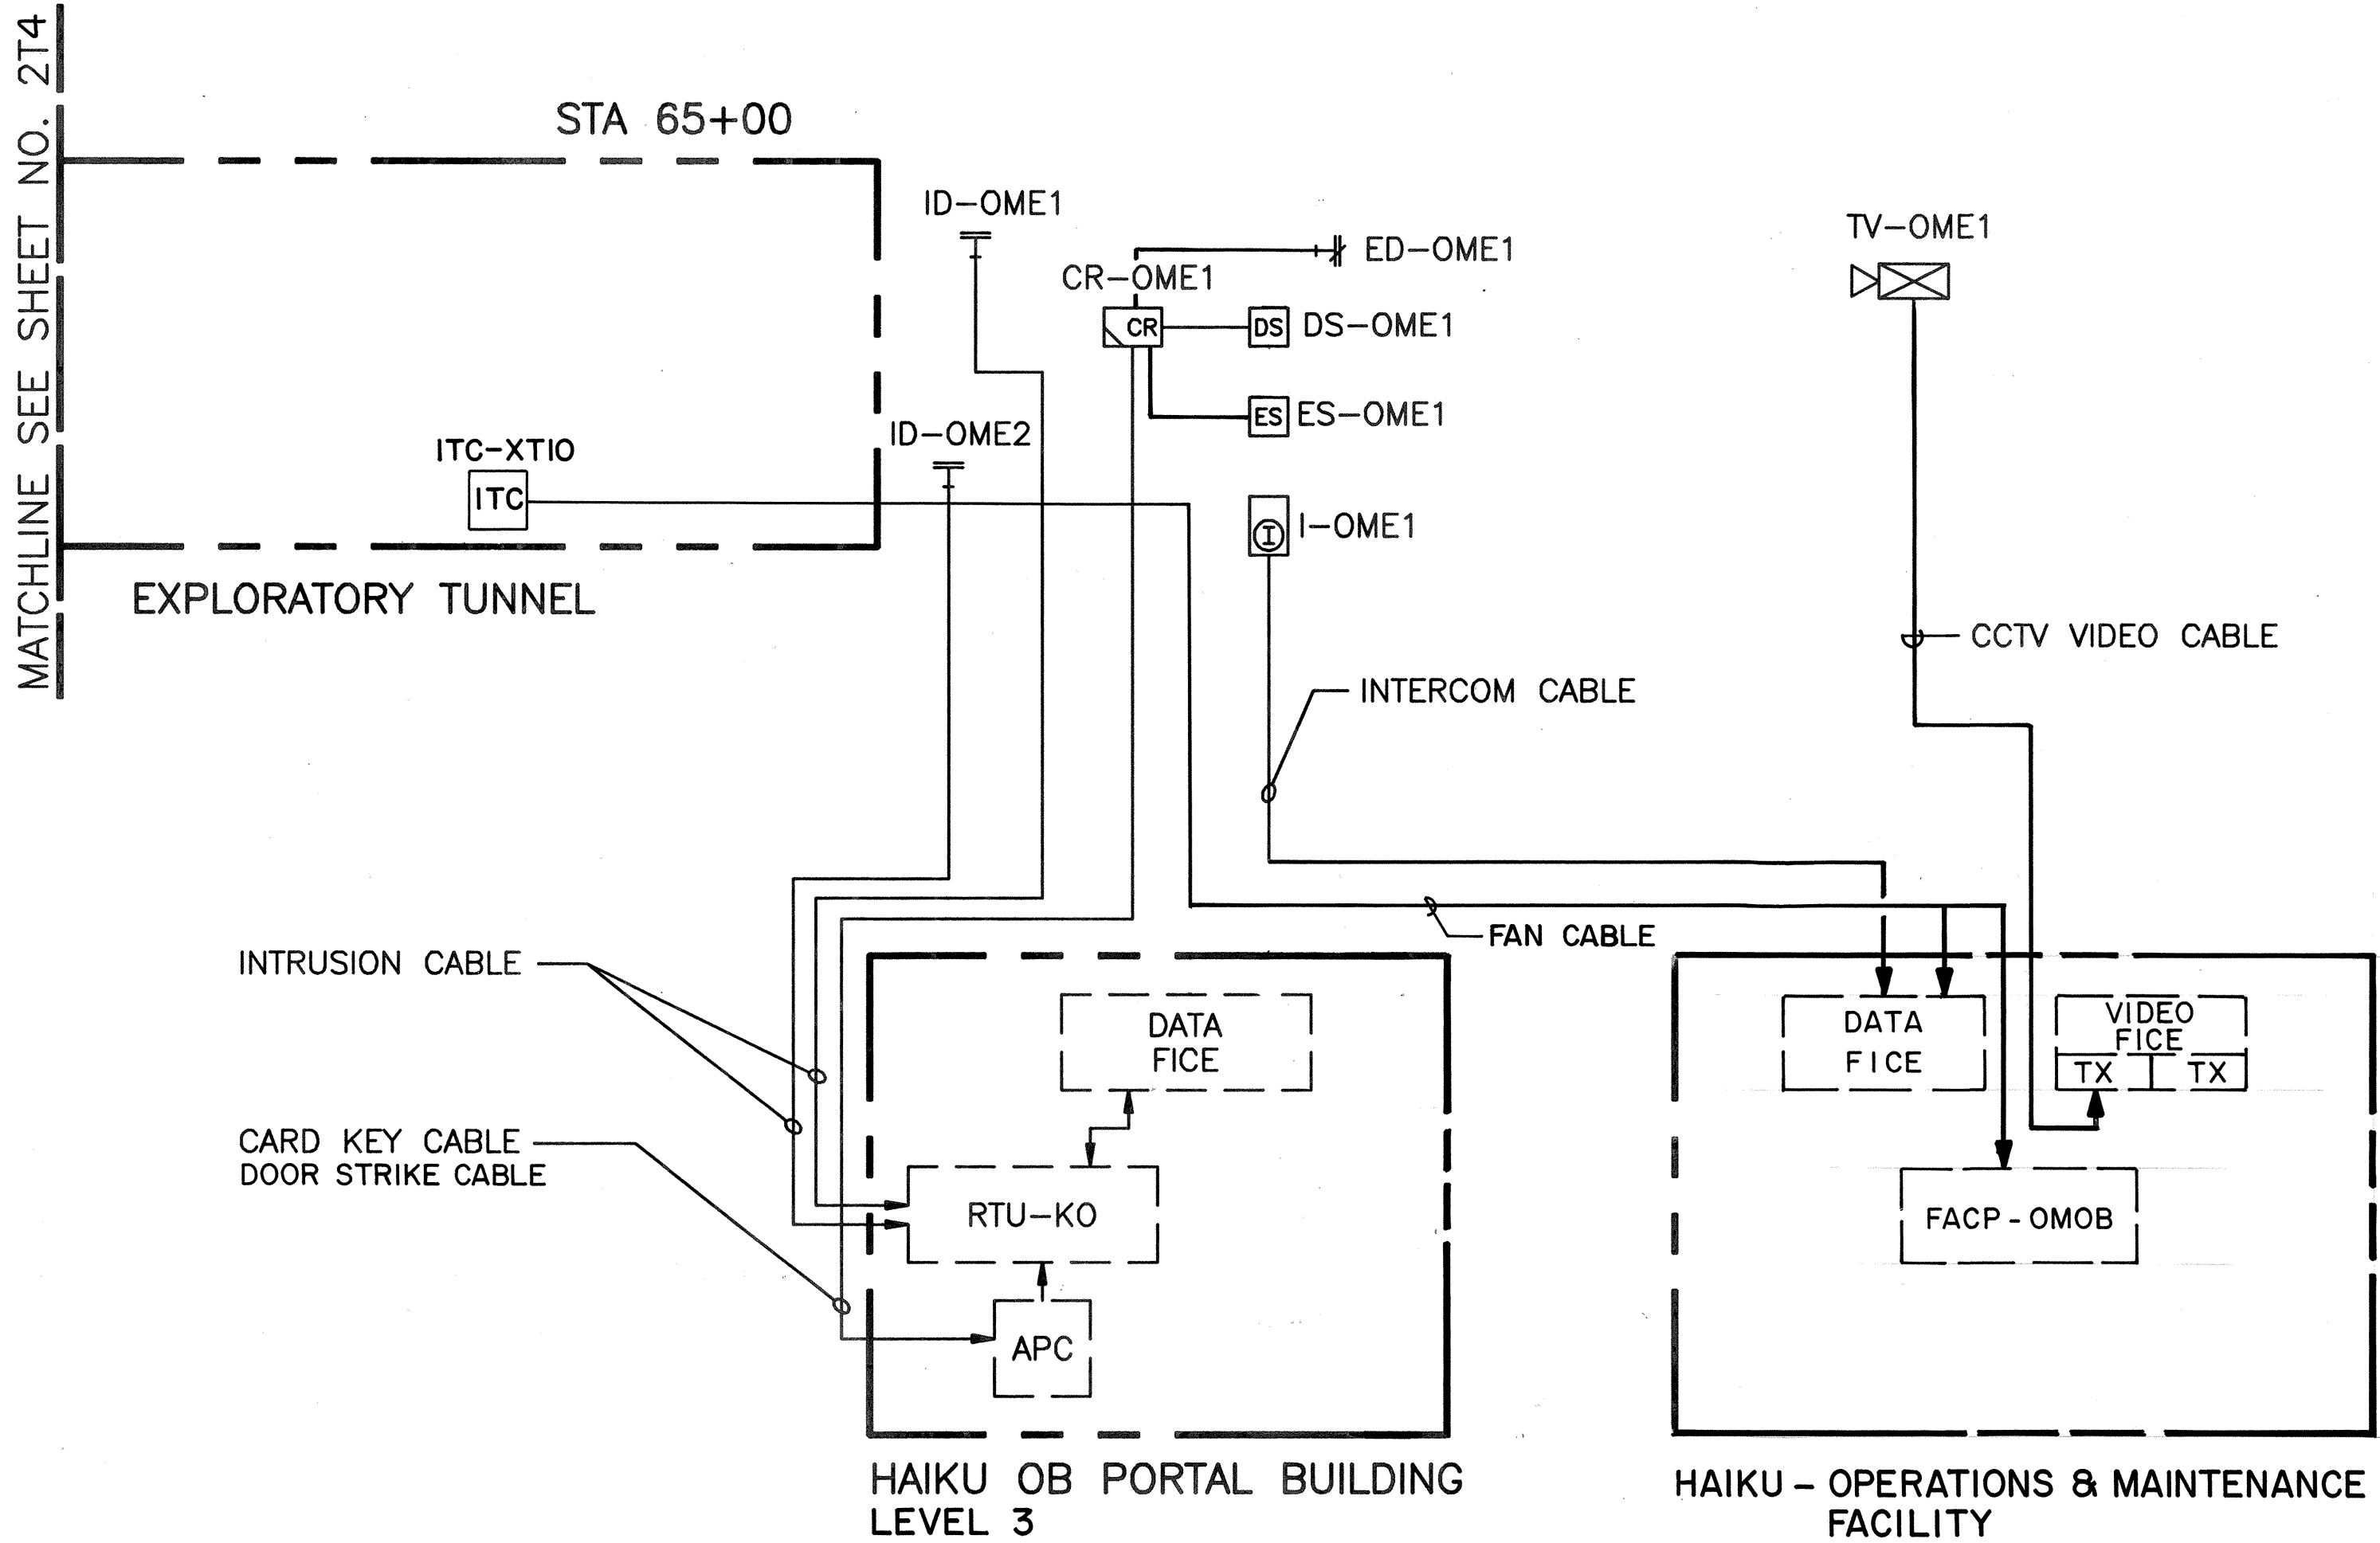

NOTES:
1. CONNECTIONS SHOWN TO THE DEVICES IN THE SYSTEMS EQRM ARE FOR INFORMATION ONLY. CONTRACTOR IS NOT RESPONSIBLE FOR MAKING THESE FINAL CONNECTIONS PER PLANS & SPECIAL PROVISIONS.

ORIGINAL PLAN	SURVEY PLOTTED BY	DATE
NOTE BOOK	DRAWN BY	10/94
No.	DESIGNED BY	10/94
	CHECKED BY	
	QUANTITIES BY	

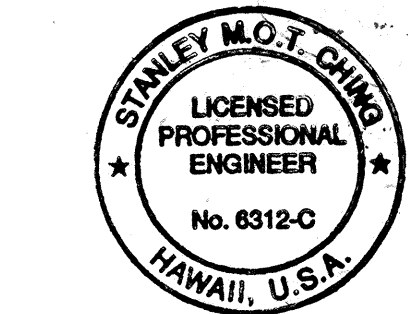


THIS WORK WAS PREPARED BY ME
OR UNDER MY SUPERVISION
Stanley M.O.T. Chung


10/27/95	ADDENDUM 2 - REVISED TO INDICATE O & M FACILITY
10/13/95	ADDENDUM 1
DATE	REVISION
STATE OF HAWAII DEPARTMENT OF TRANSPORTATION HIGHWAYS DIVISION BLOCK DIAGRAM - 4 SYSTEMS EXPLORATORY TUNNEL IMPROVEMENTS H-3 FINISH (UNIT III) FAIP NO. I-H3-1(75), UNIT III T.K. TUNNEL/ACCESS ROADS SCALE: NONE DATE: JUN 1995	
SHEET NO. 2T5 OF 21 SHEETS	

FED. ROAD DIST. NO.	STATE	FED. AID PROJ. NO.	FISCAL YEAR	SHEET NO.	TOTAL SHEETS
HAWAII	HAW.	I-H3-1(75) UNIT III	1994	108	353

SEE TRANSDYN DWG 300I-900-9009 AND CANAM DWG 1A.

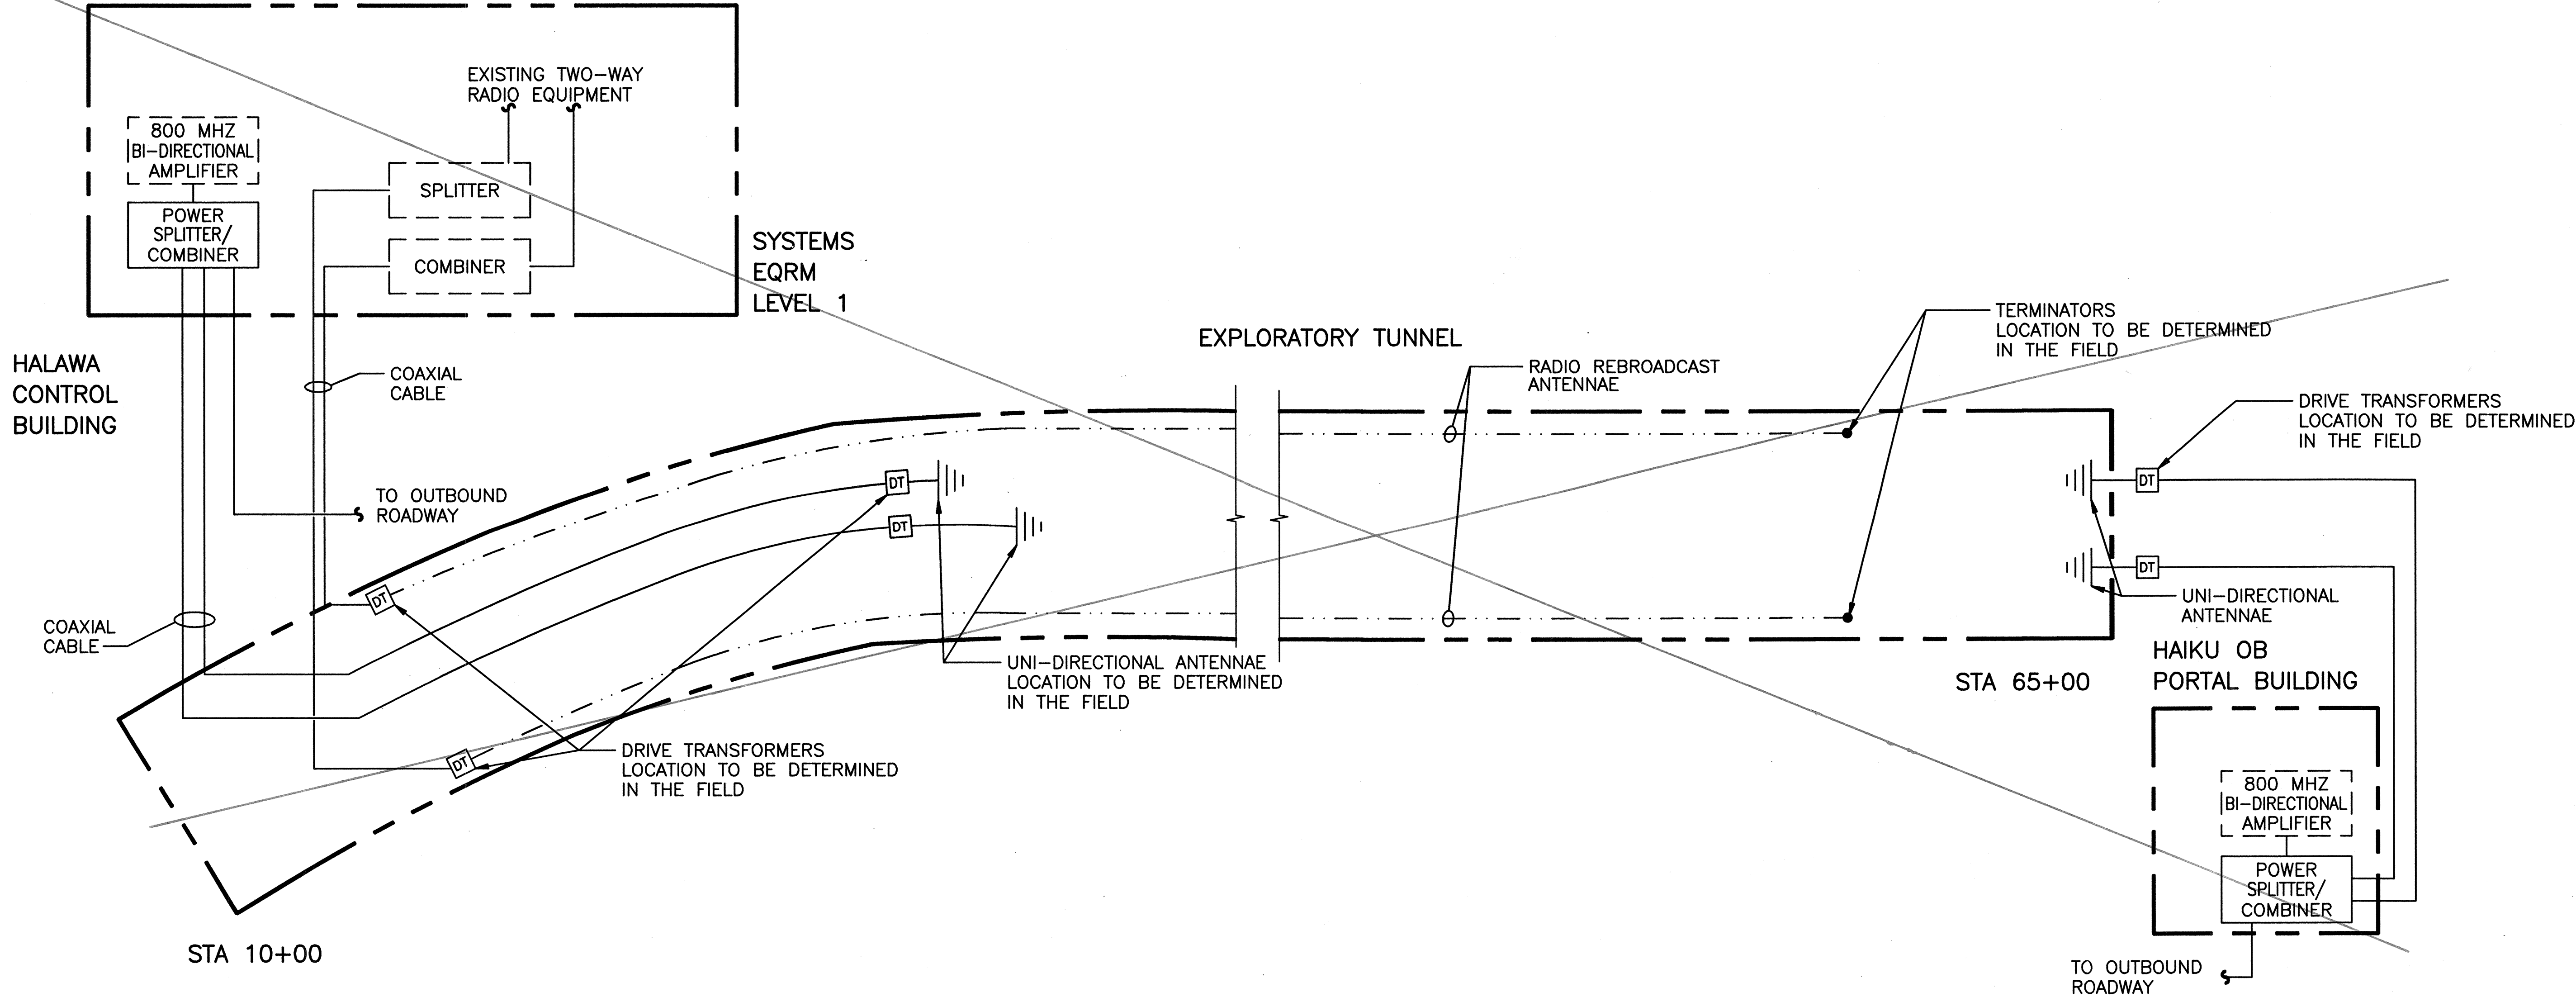


ORIGINAL PLAN	SURVEY PLOTTED BY	DATE
NOTE BOOK	DRAWN BY P. R. E. HITT	10/94
No.	DESIGNED BY P. L. FORDYCE	10/94
	CHECKED BY	

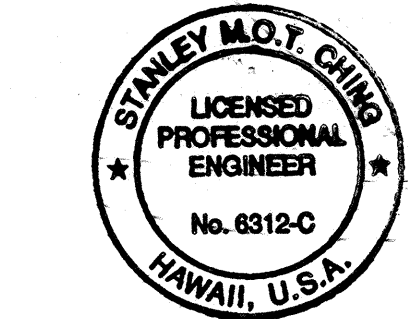

THIS WORK WAS PREPARED BY ME
OR UNDER MY SUPERVISION
Stanley M.O.T. Ching

DATE	REVISION
STATE OF HAWAII DEPARTMENT OF TRANSPORTATION HIGHWAYS DIVISION BLOCK DIAGRAM RADIO SYSTEMS EXPLORATORY TUNNEL IMPROVEMENTS H-3 FINISH (UNIT III) FAIP NO. I-H3-1(75), UNIT III I.K. TUNNEL/ACCESS ROADS SCALE: NONE DATE: JUN 1995	
SHEET NO. 2T6 OF 21 SHEETS	

XREF LIST:
ETI-BRDR
EXP-TUN
SCALE40

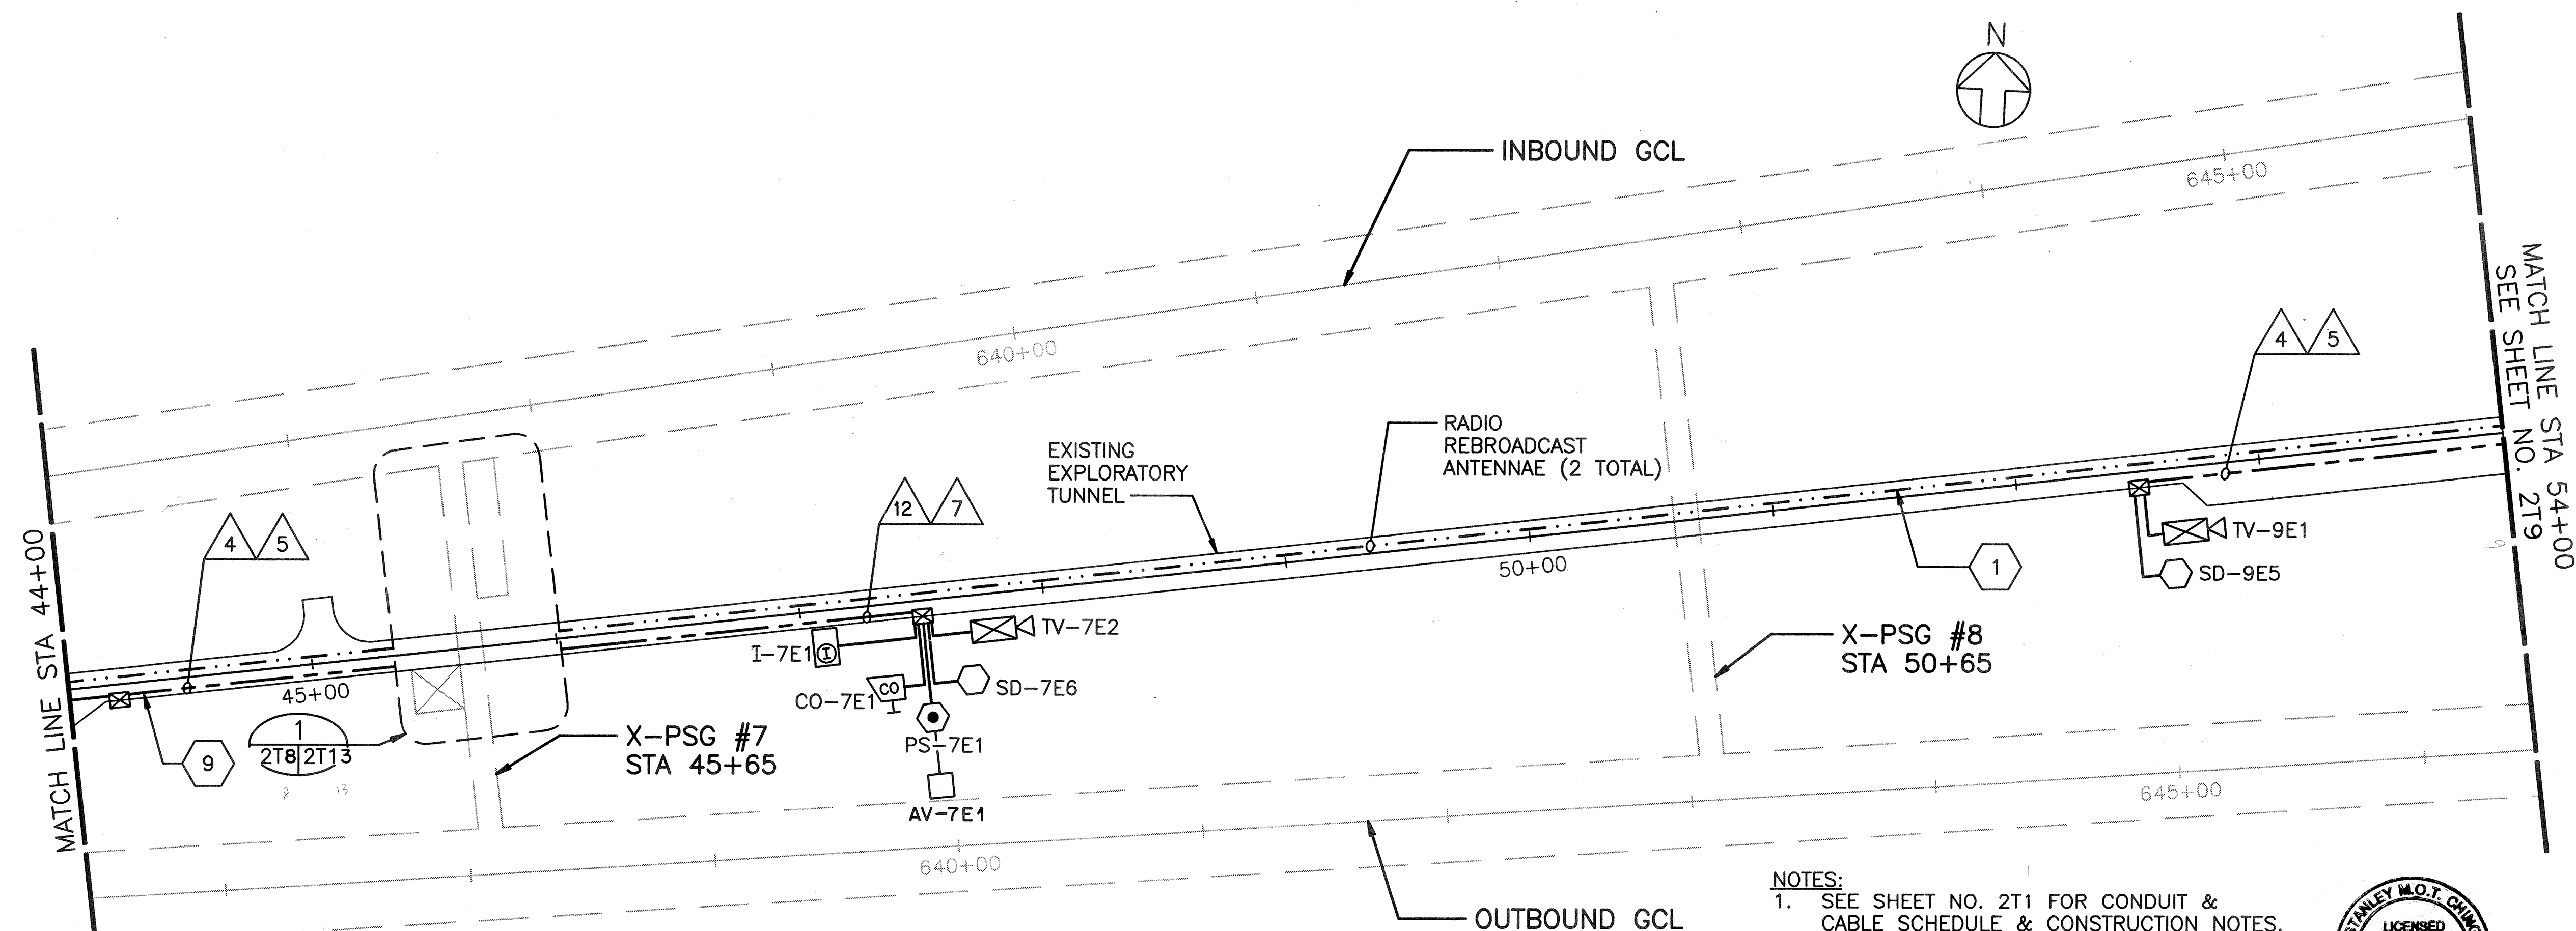


GRAPHIC SCALE:

40' 20' 0' 40' 80'

1" = 40'-0"

ORIGINAL PLAN	SURVEY PLOTTED BY _____	DATE
	DRAWN BY P. R. E. HITT	10/94
NOTE BOOK	TRACED BY _____	
	DESIGNED BY L. Y. NELSON	10/94
	QUANTITIES BY _____	
No. _____	CHECKED BY _____	

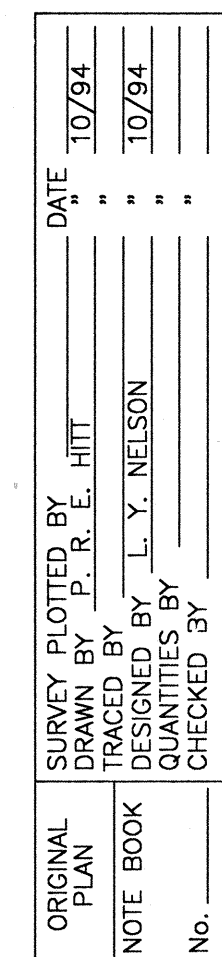

- 



GRAPHIC SCALE:

40' 20' 0' 40' 80'


1" = 40'-0"

111

FED. ROAD DIST. NO.	STATE	FED. AID PROJ. NO.	FISCAL YEAR	SHEET NO.	TOTAL SHEETS
HAWAII	HAW.	1-H3-1(75) UNIT III	1994	112	353

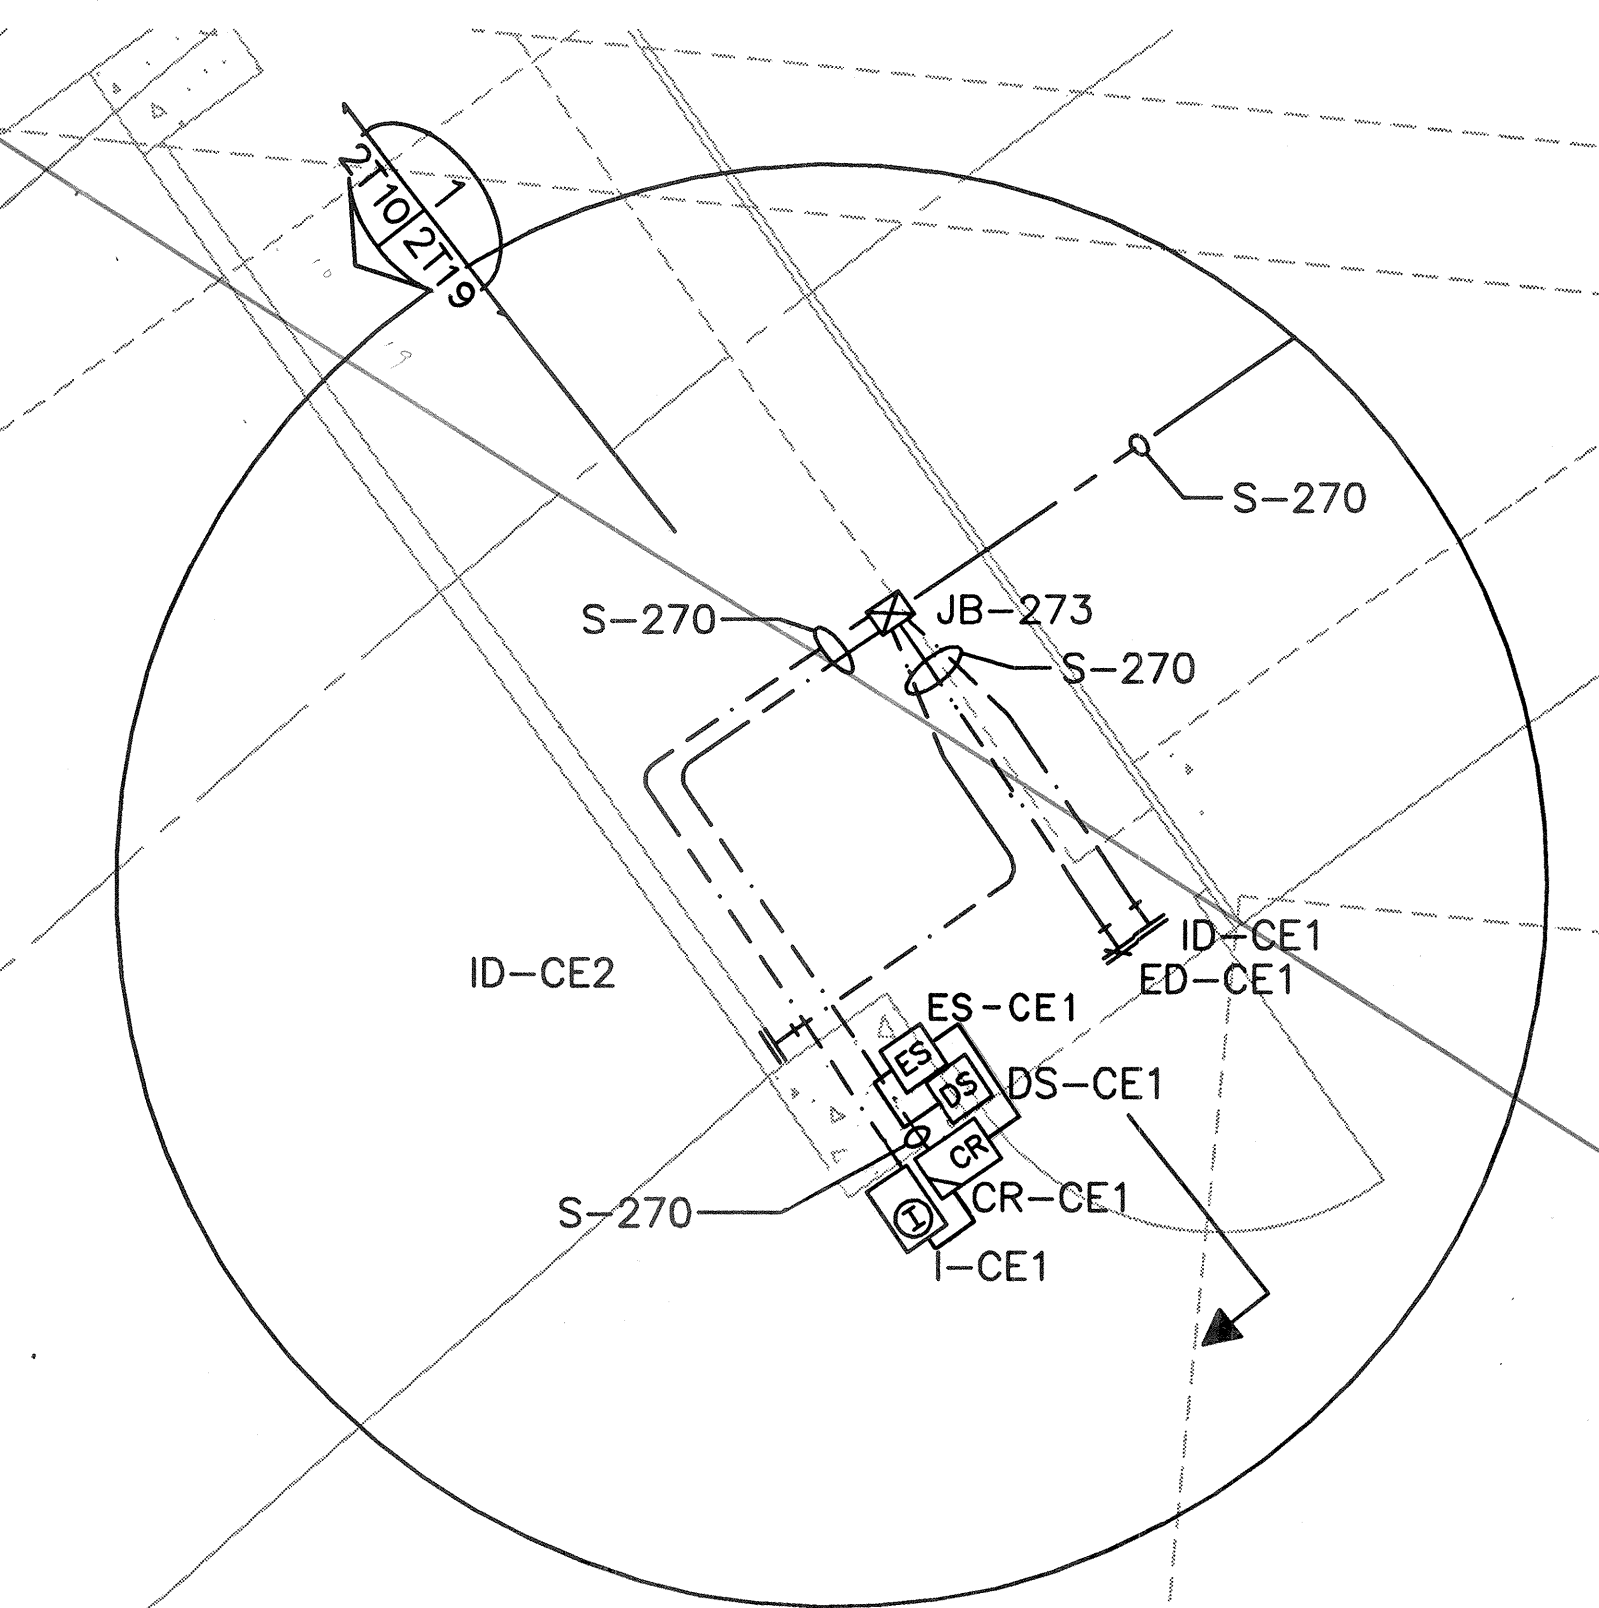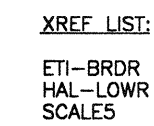

DETAIL @ PEDESTRIAN DOOR
SCALE: 1" = 2'-0"

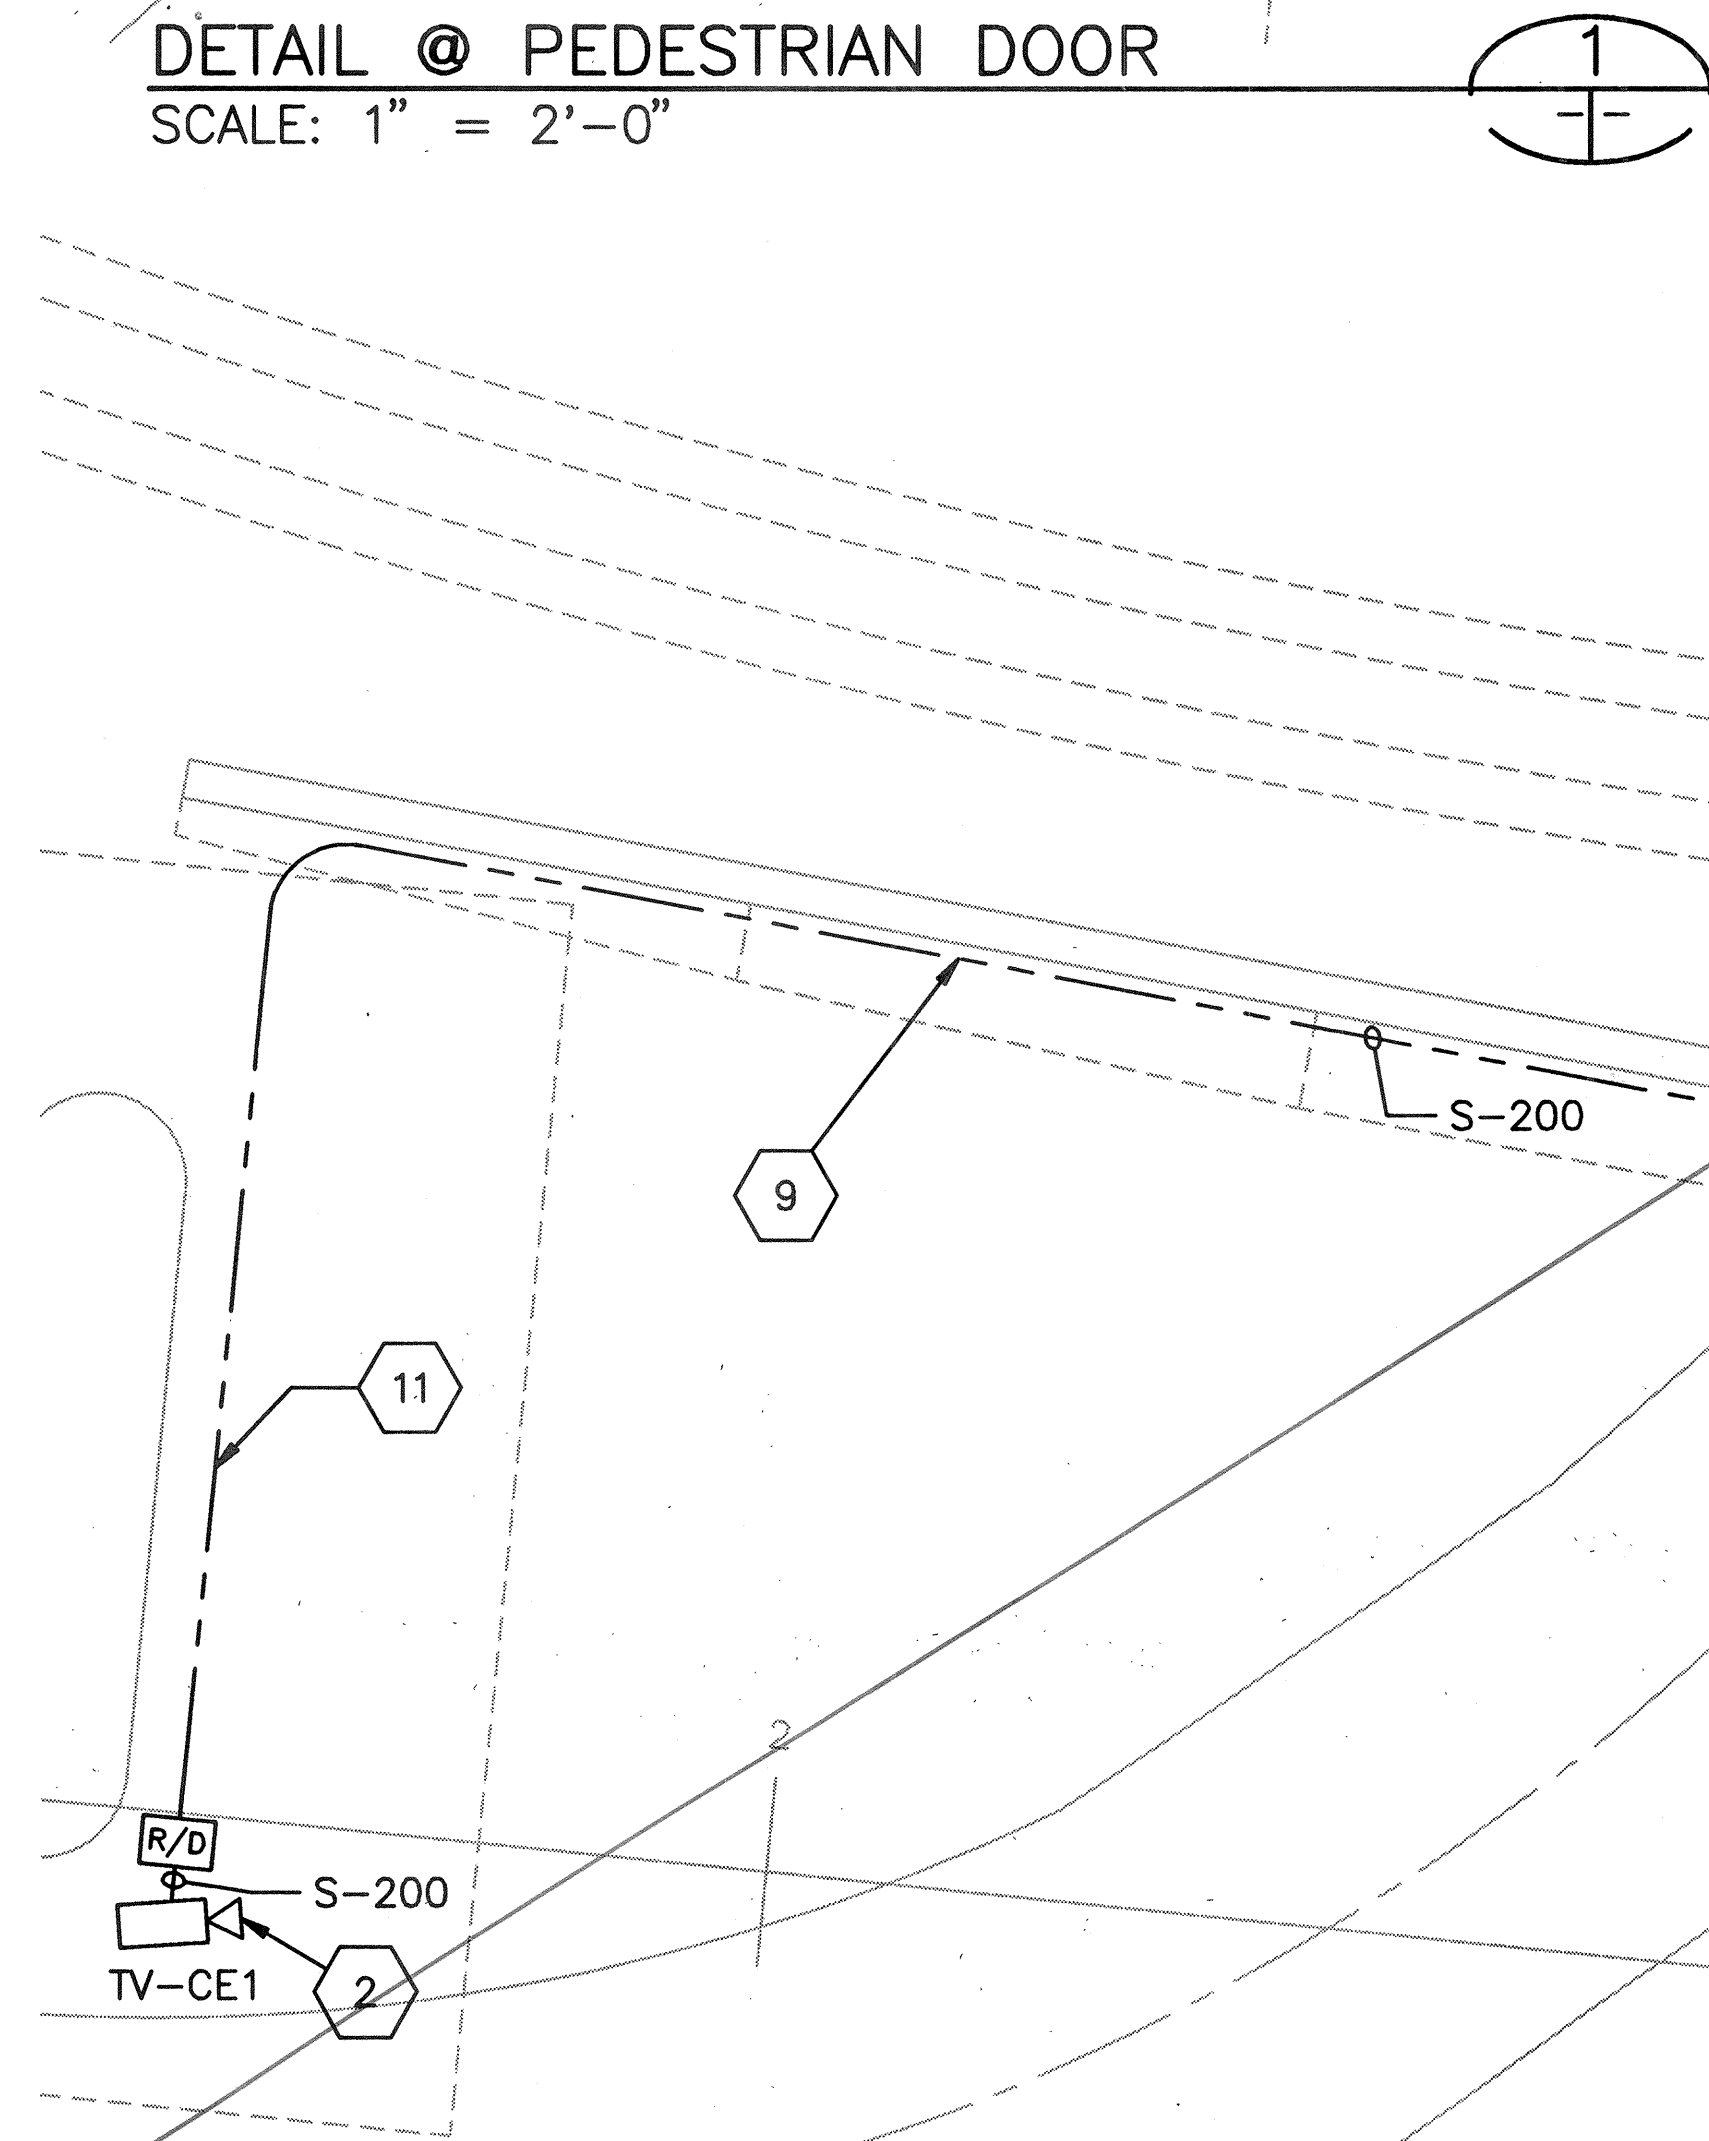


FOR CONDUIT AND CABLE CONTINUATION
SEE TRAFFIC OPERATIONS CENTER
EXPANSION PLAN, SHEET NO. 3T3.

— RADIO REBROADCAST ANTENNAE



SEE TRANSDYN DWG 3001-900-9009

NOTE:
1. FOR CONDUIT AND CABLE SCHEDULE AND NOTES SEE SHEET NO. 3T1 IN TRAFFIC OPERATIONS CENTER EXPANSION PLANS.

GRAPHIC SCALE:

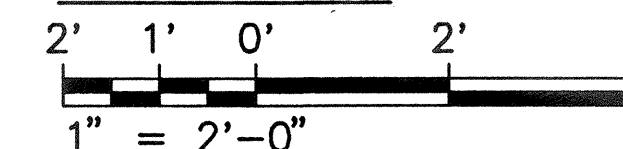

GRAPHIC SCALE:

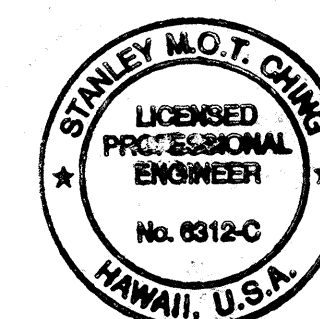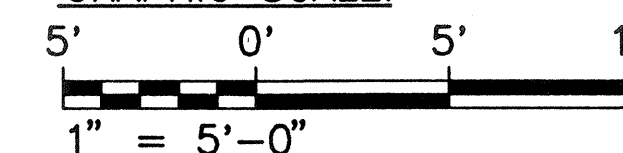

THIS WORK WAS PREPARED BY ME
OR UNDER MY SUPERVISION
Stanley M. O.T. Chung

DATE	REVISION

STATE OF HAWAII
DEPARTMENT OF TRANSPORTATION
HIGHWAYS DIVISION

SYSTEMS PLAN

HALAWA

EXPLORATORY TUNNEL IMPROVEMENTS

H-3 FINISH (UNIT III)

FAIP NO. I-H3-1(75), UNIT III

T.K. TUNNEL/ACCESS ROADS

SCALE: AS NOTED DATE: JUN 1995

SHEET NO. 2T10 OF 21 SHEETS

FED. ROAD DIST. NO.	STATE	FED. AID PROJ. NO.	FISCAL YEAR	SHEET NO.	TOTAL SHEETS
HAWAII	HAW.	1-H3-1(75) UNIT III	1994	113	353


XREF LIST:
ETI-BRDR
HKU-LVLA
SCALE 96

DATE	11/94
SURVEY PLOTTED BY	P. R. E. HITT
ORIGINAL PLAN	
NOTE BOOK	
DESIGNED BY	W. D. ANDERSON
CHECKED BY	
No.	




DETAIL @ PEDESTRIAN DOOR
SCALE: 1" = 5'-0"

NOTES:
1. SEE SHEET NO. 2T1 FOR CONDUIT & CABLE SCHEDULE & CONSTRUCTION NOTES.




1/14/97	DCN 75-010: REVISED PER RESPONSE TO RFI # 4097-136
10/27/95	ADDENDUM 2-ADDED CONDUIT RUNS 30,31,32
10/13/95	ADDENDUM 1
DATE	REVISION
STATE OF HAWAII DEPARTMENT OF TRANSPORTATION HIGHWAYS DIVISION SYSTEMS PLAN HAIKU EXPLORATORY TUNNEL IMPROVEMENTS H-3 FINISH (UNIT III) FAIP NO. 1-H3-1(75), UNIT III T.K. TUNNEL/ACCESS ROADS SCALE: AS NOTED DATE: JUN 1995 SHEET NO. 2T11 OF 21 SHEETS	

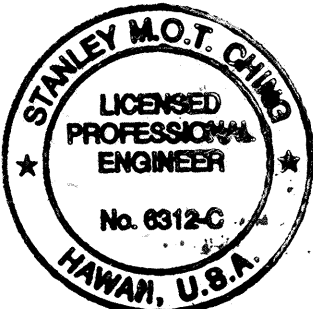


THIS WORK WAS PREPARED BY ME
OR UNDER MY SUPERVISION
Stanley M.O.T. Ching

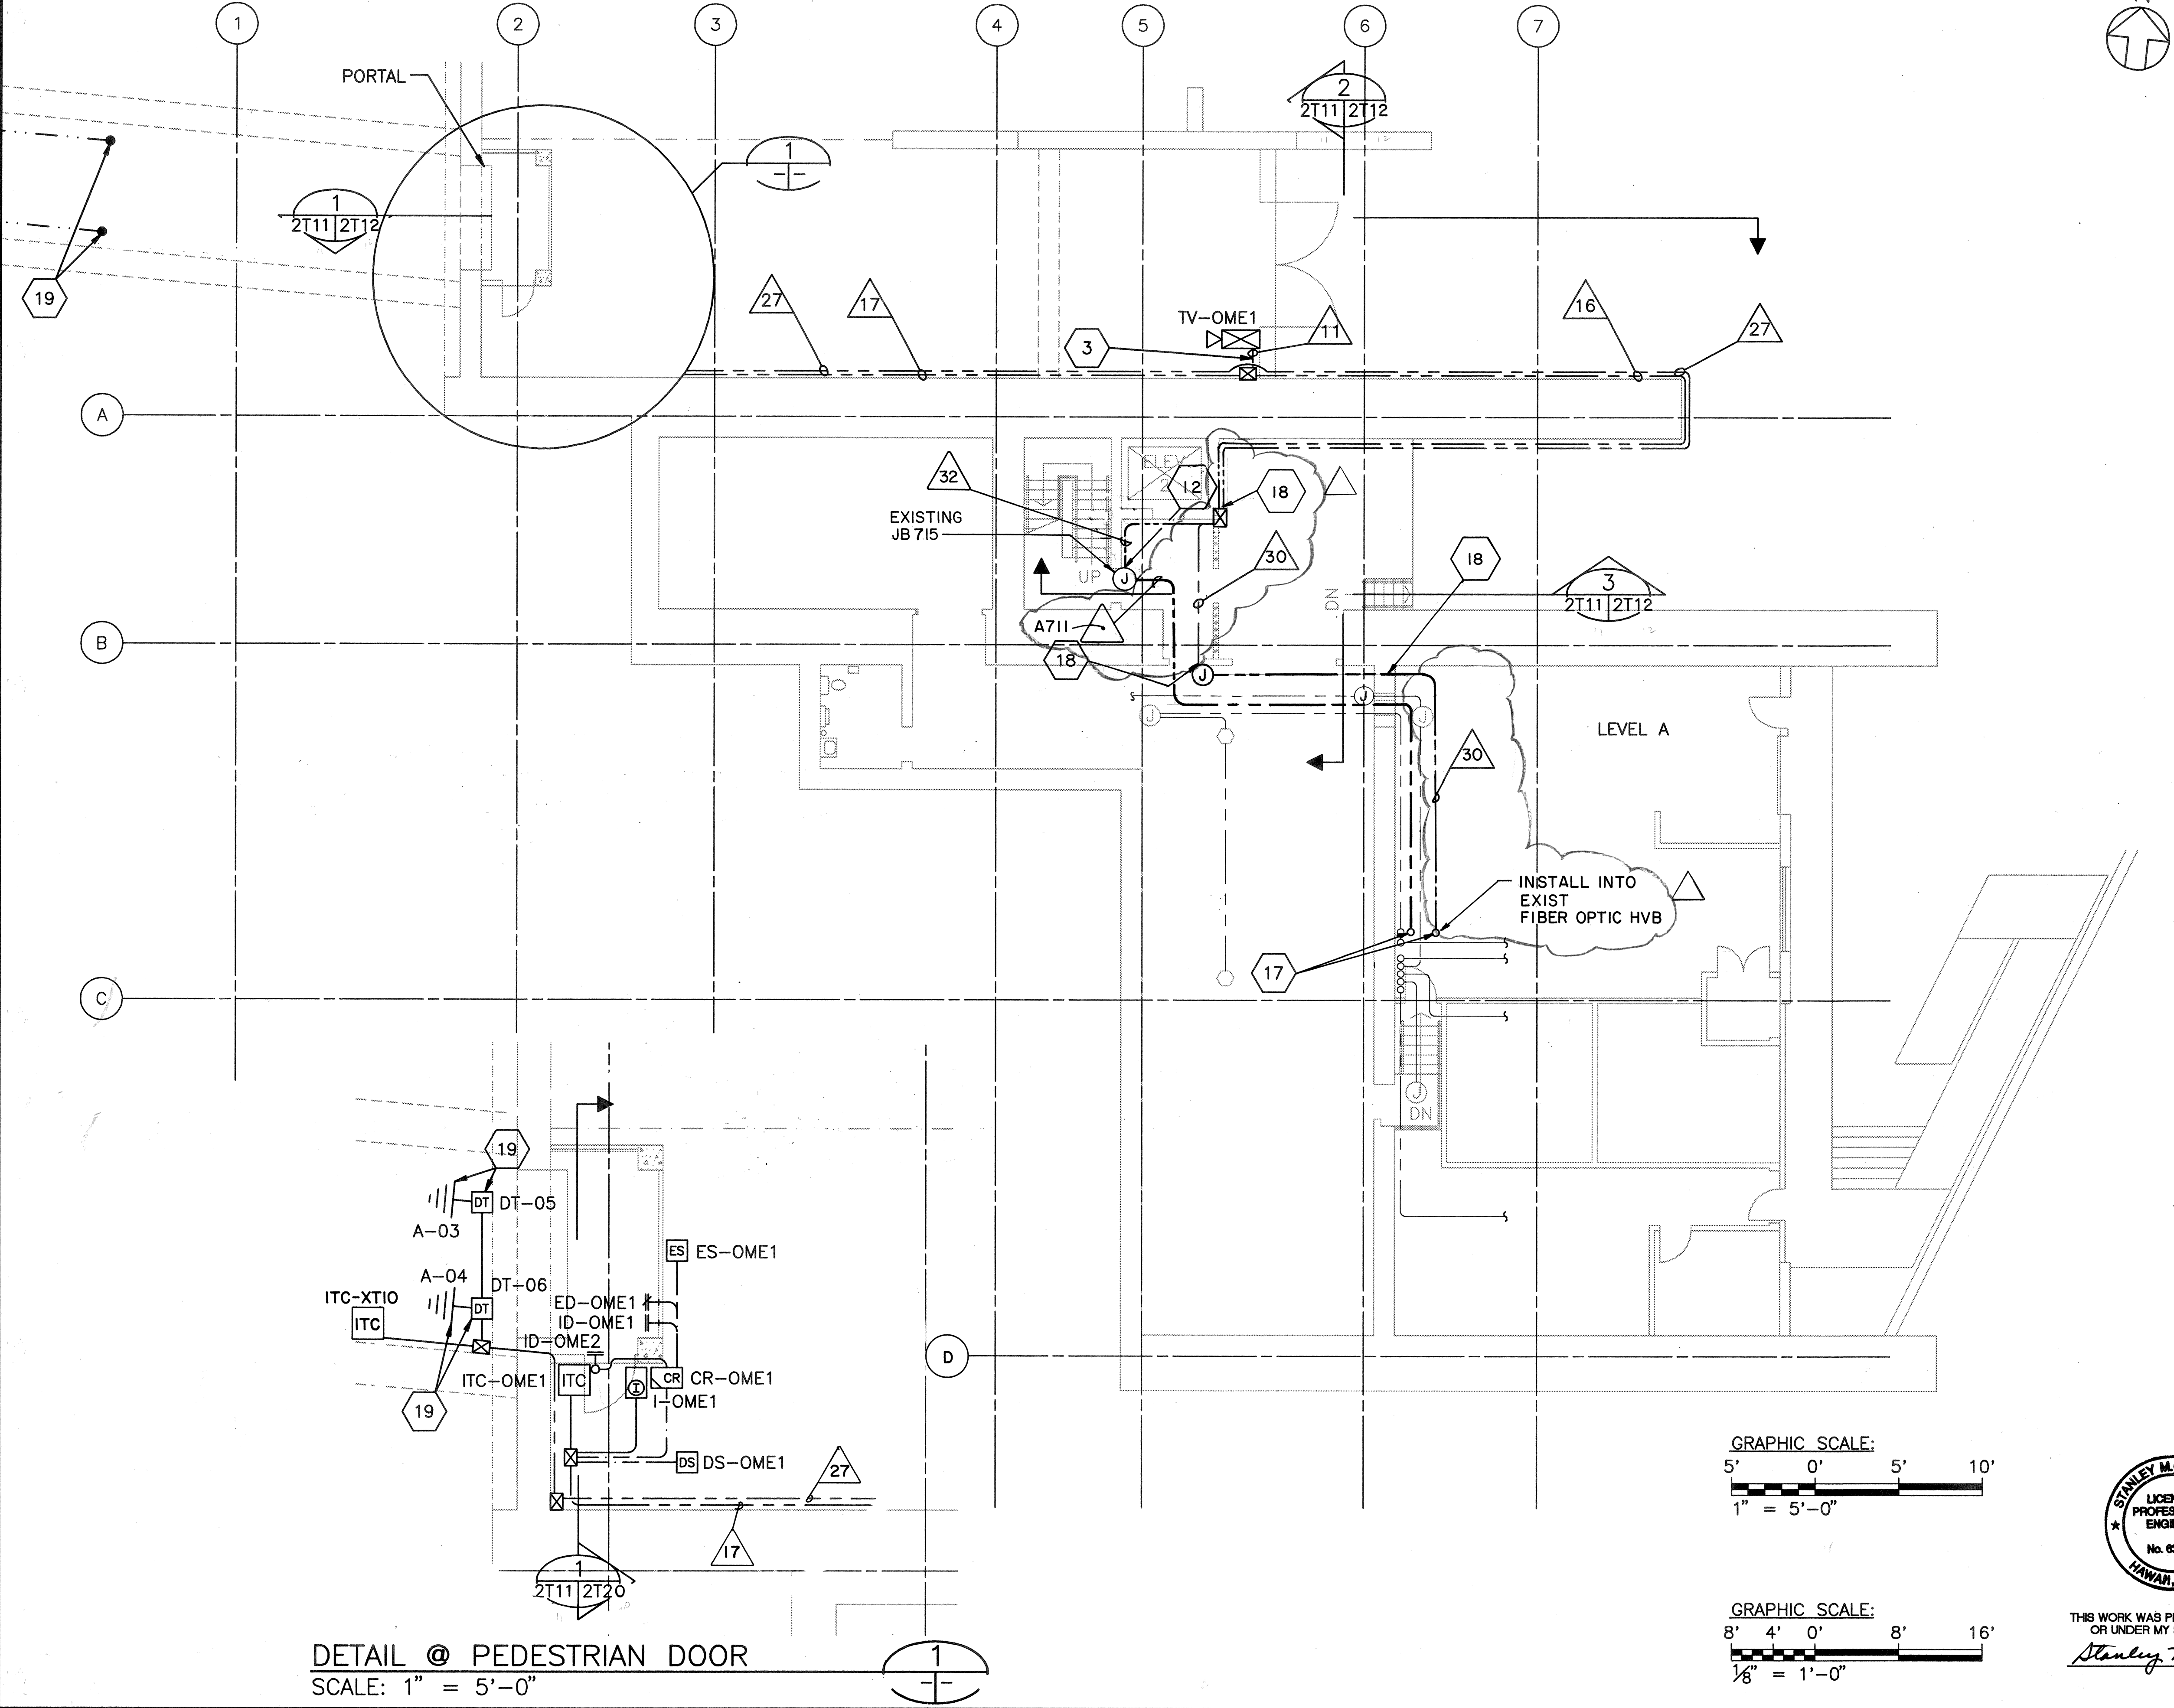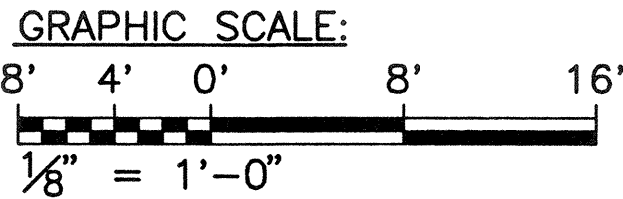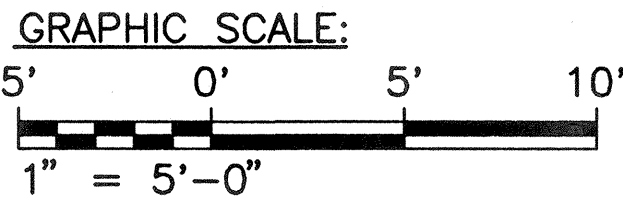

XREF LIST:
ETI-BRDR
SCALE96

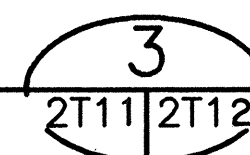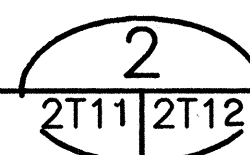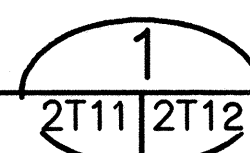

Stanley M.O.T. Ch...

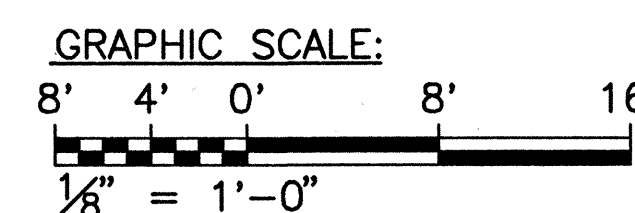


P:\H3\CONT.75\UNIT-III\EXP-TUN\H3-2T13.DWG

XREF LIST:
ETI-BRDR
SCALES


EQUIPMENT ROOM LEGEND

- | | |
|---|--------------|
| 1 | TC170 |
| 2 | RTU/FICE |
| 3 | CCTV |
| 4 | SC |
| 5 | LH |
| 6 | CO |
| 7 | XFMR |
| 8 | PNL |
| 9 | FACP & ANNUN |

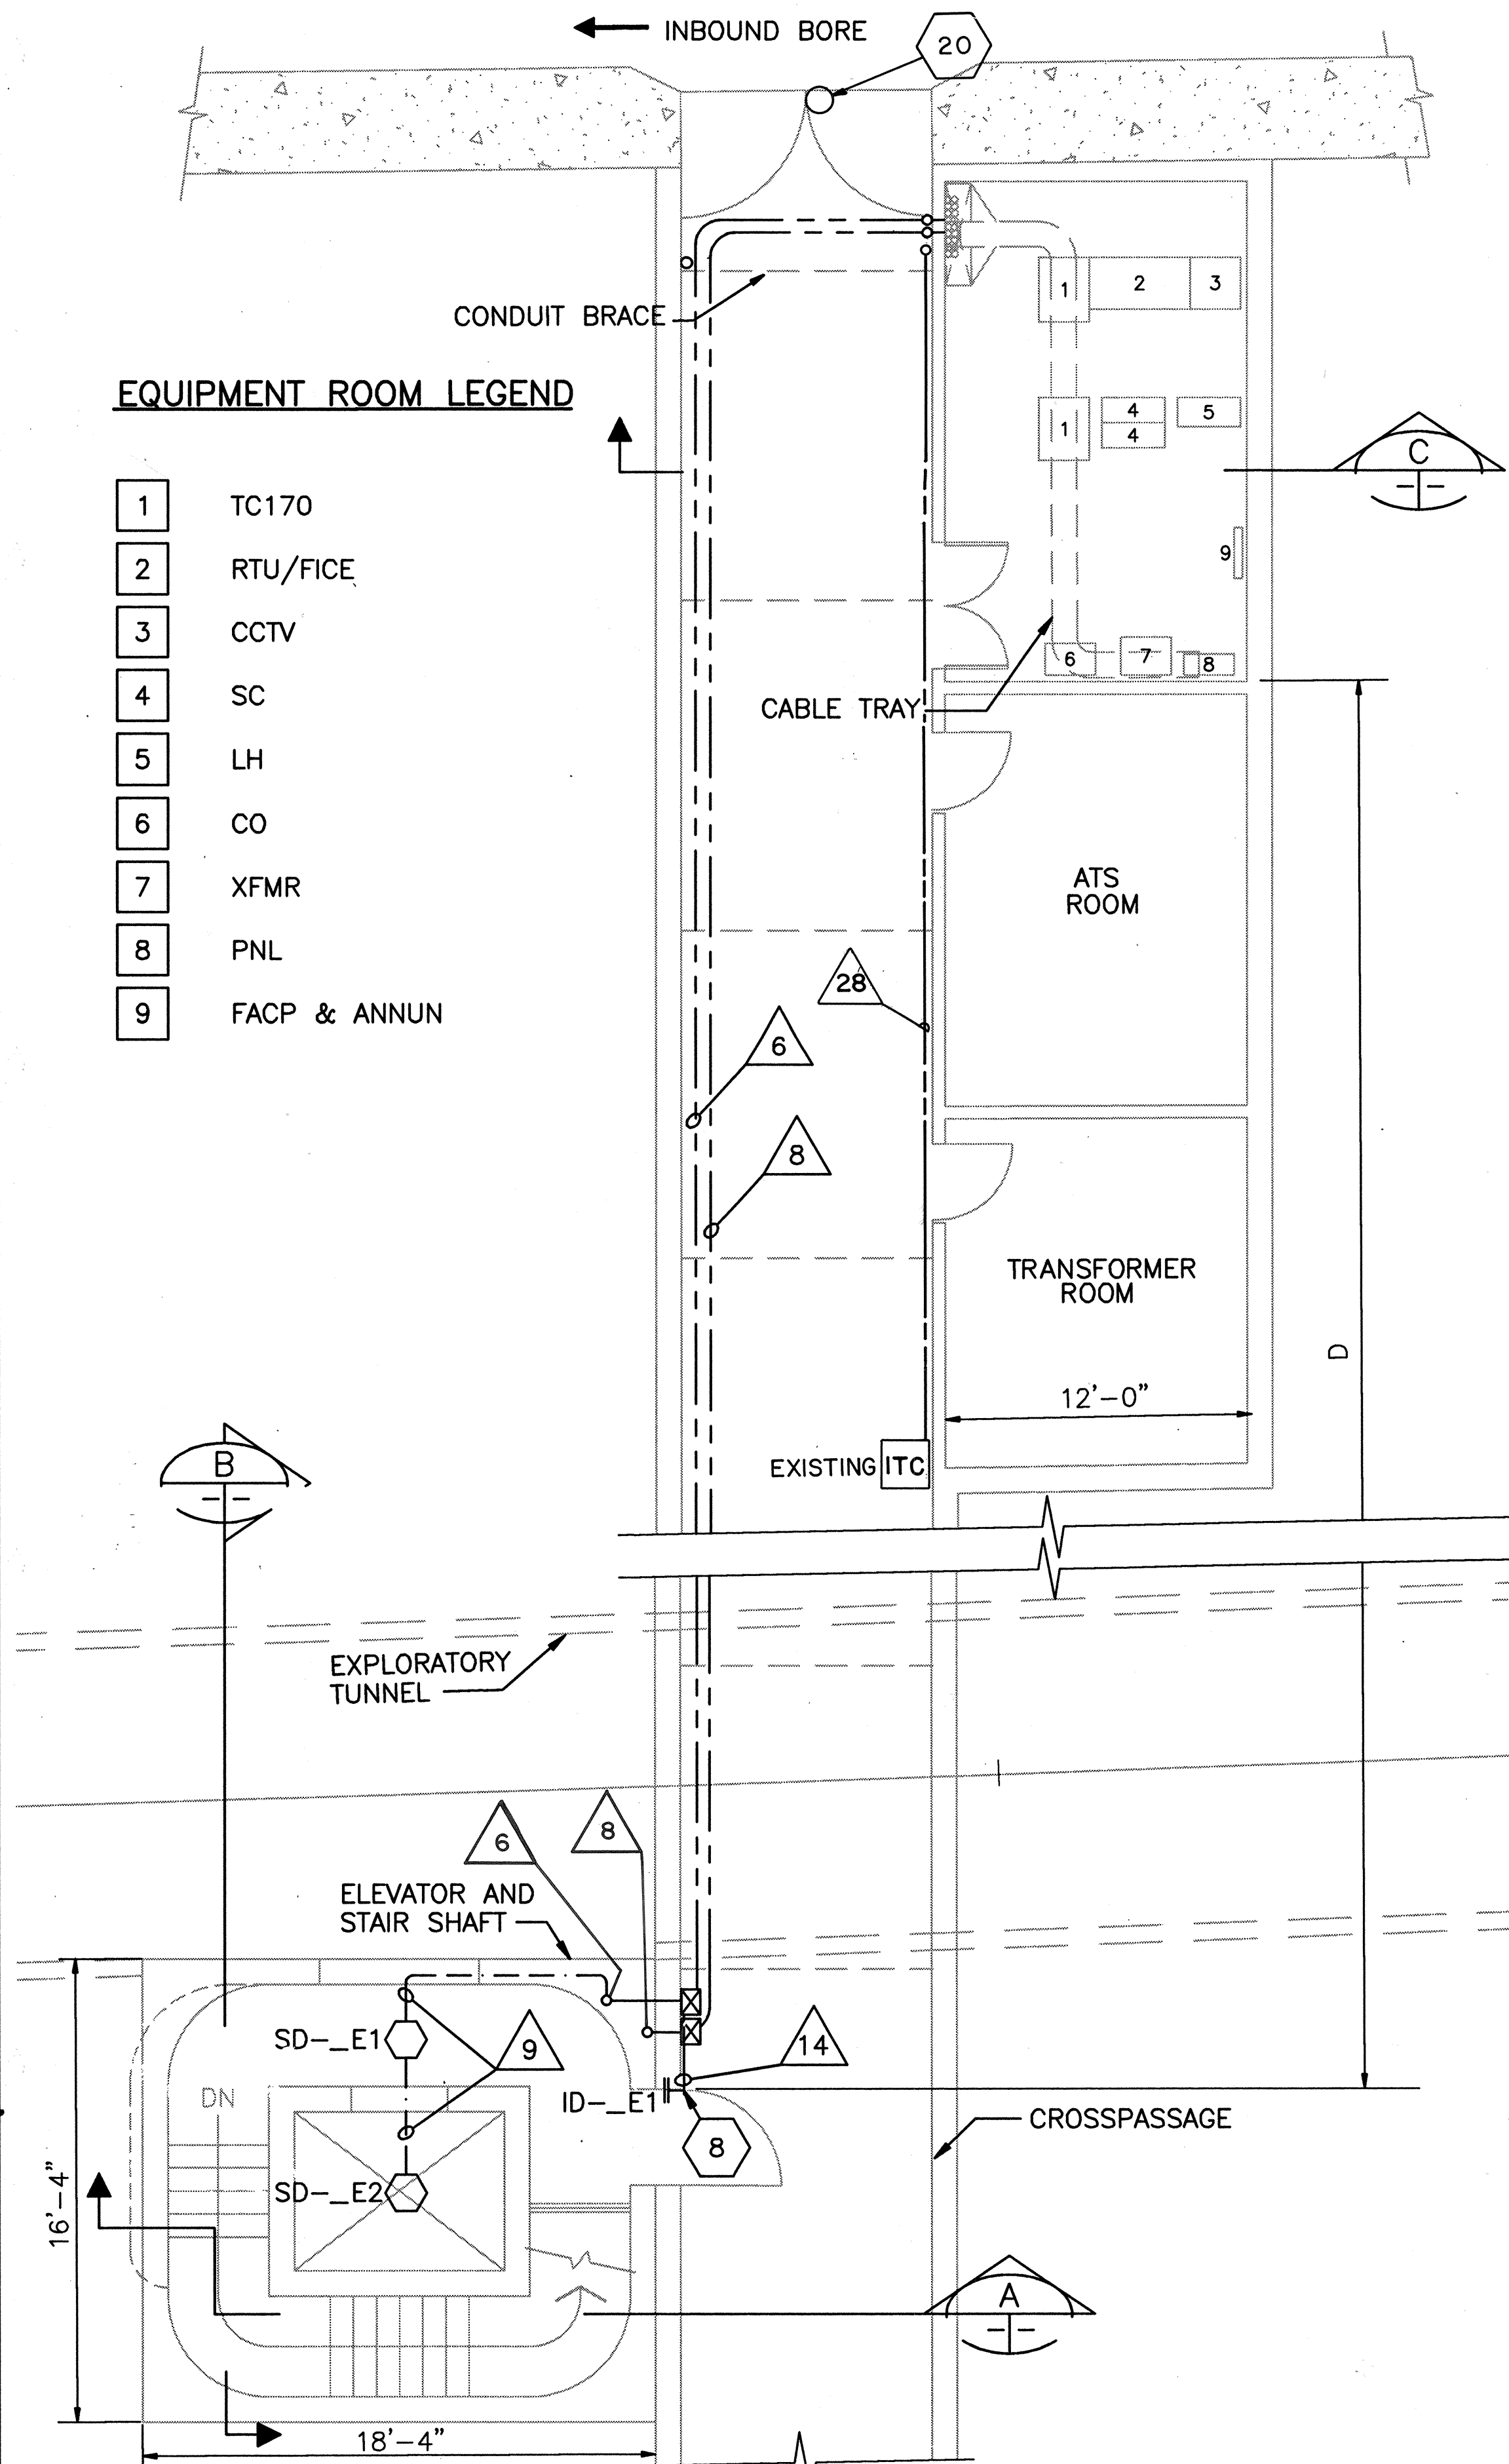


PLAN AT CROSSPASSAGE CONNECTION
SCALE: 1" = 5'-0"

2T7, 2T8, 2T9 | 2T13

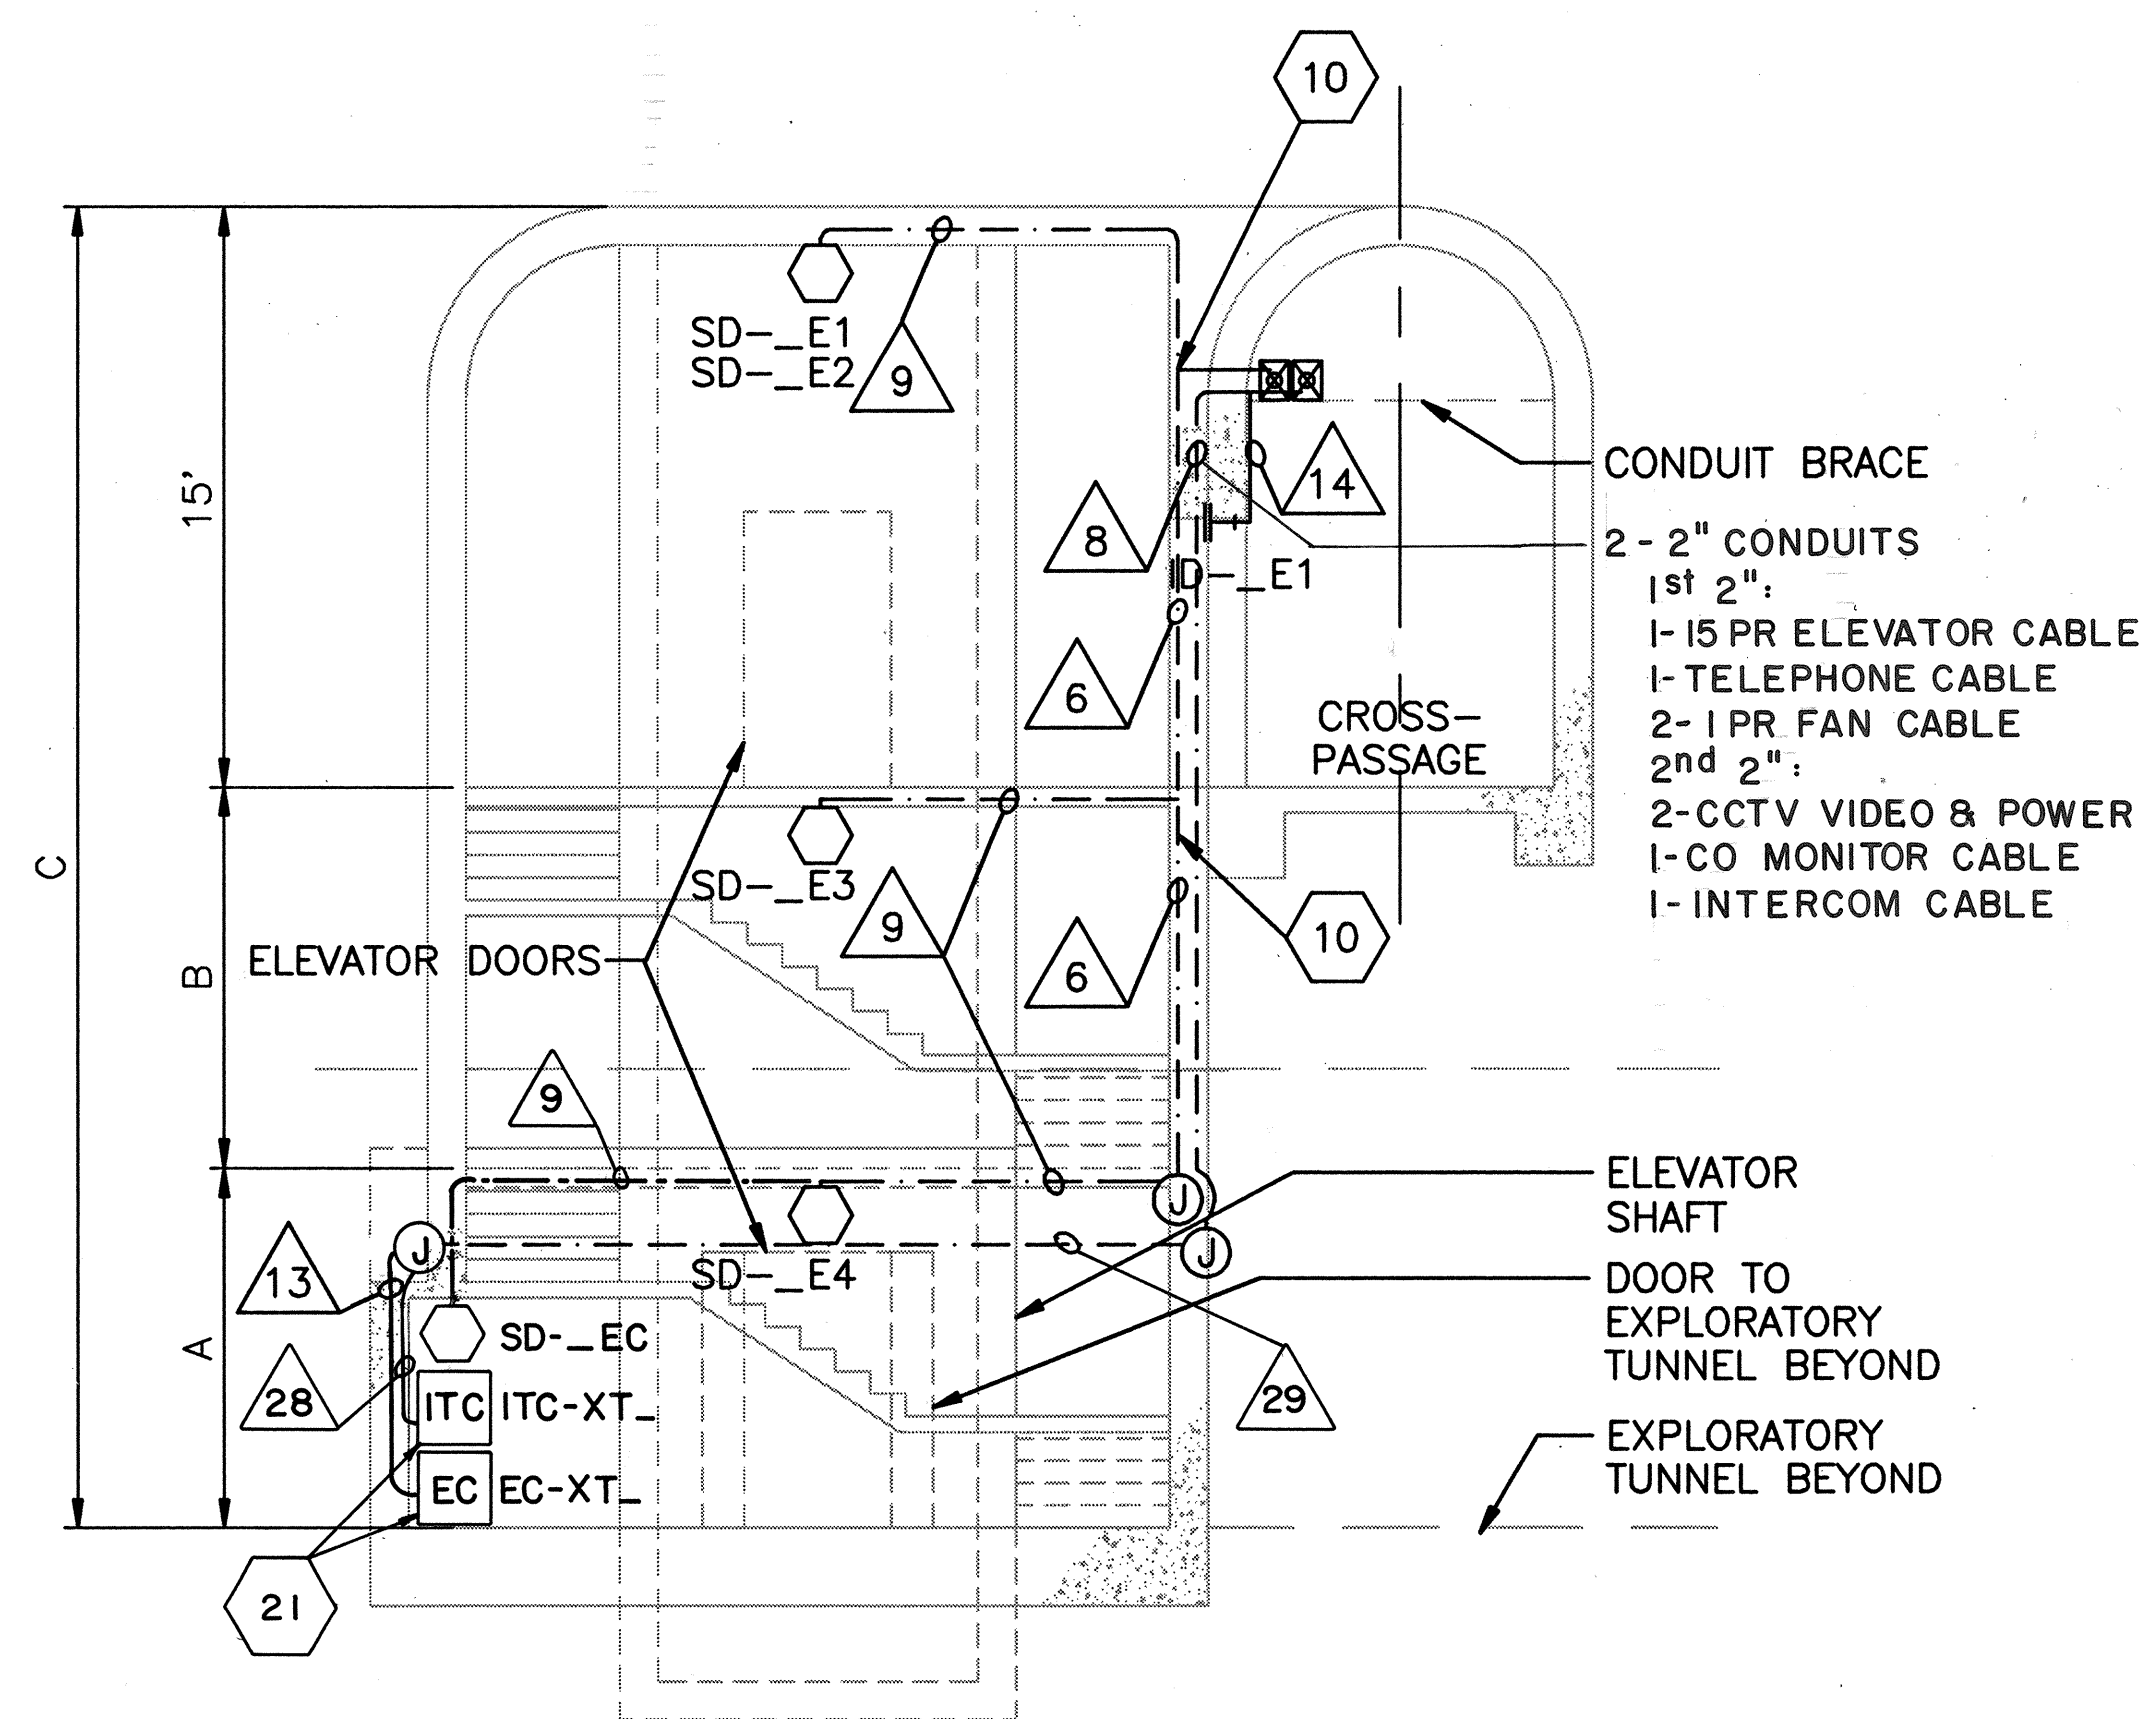

SECTION (TYP)
SCALE: 1" = 5'-0"

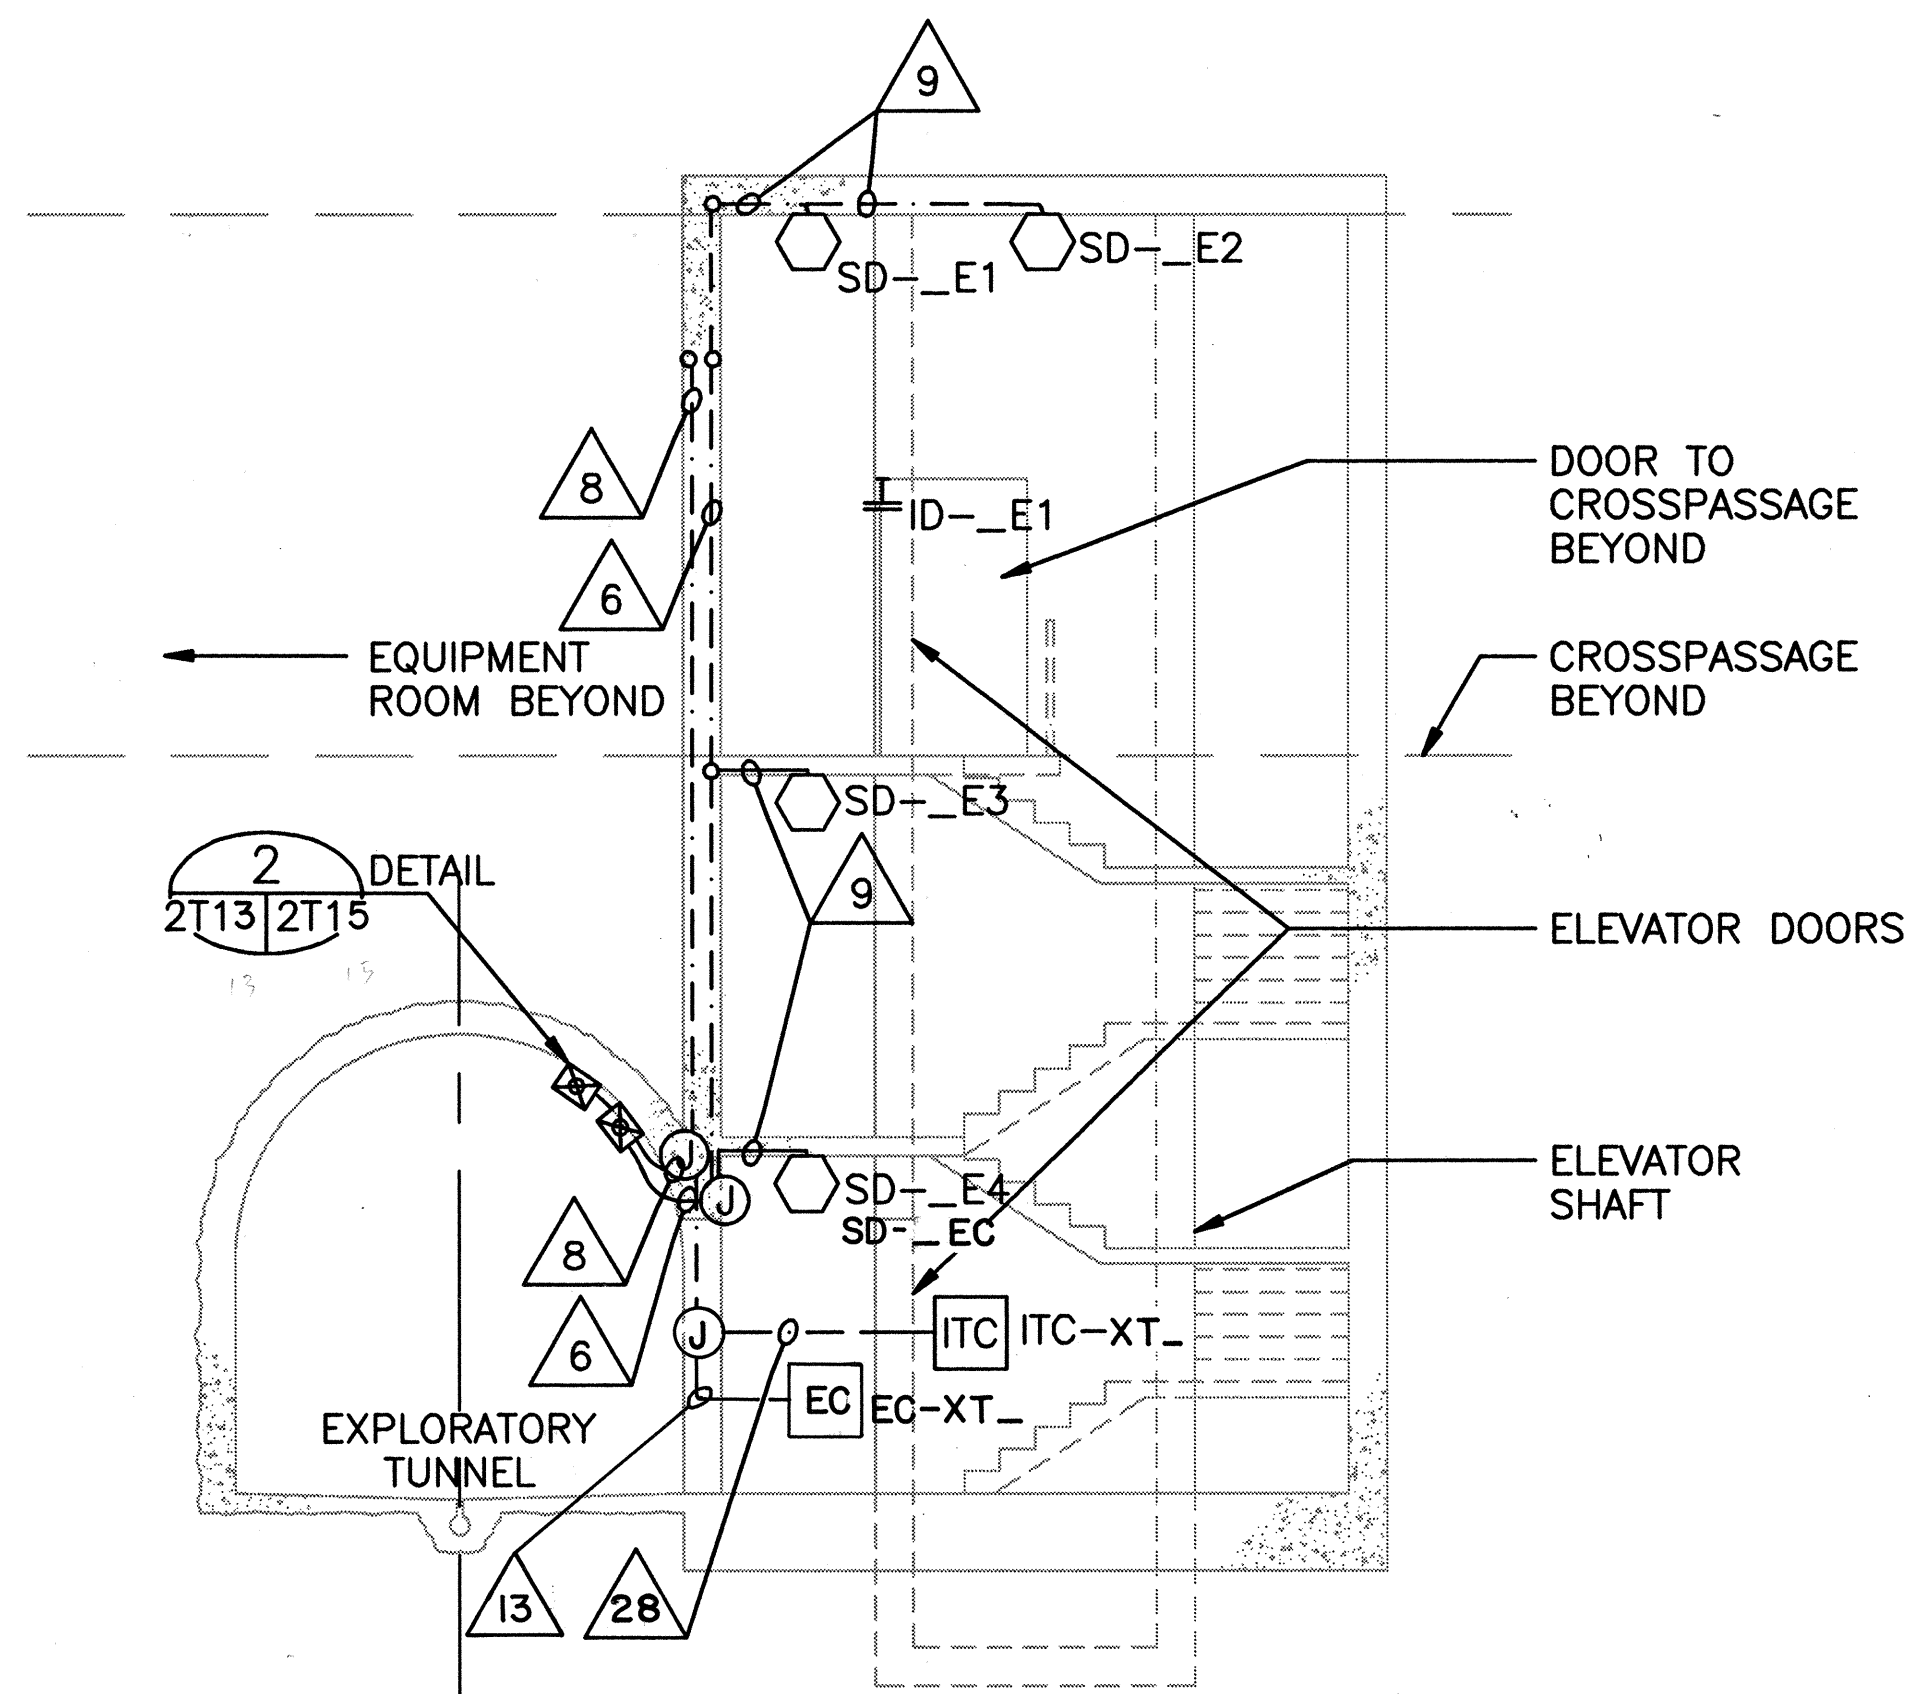


SECTION (TYP) LOOKING EAST
SCALE: 1" = 5'-0"

SHAFT & X-PSG DIMENSIONS



X-PSG	A	B	C	D
3	9'-3 1/2"	9'-10 1/2"	34'-2"	64'-2"
7	16'-10"	16'-10"	48'-8"	64'-2"

NOTES:

- SEE SHEET NO. 2T1 FOR CONDUIT & CABLE SCHEDULE & CONSTRUCTION NOTES.
- FOR AS BUILT CONDUITS AND WIRING, SEE TRANSDYN DRAWING 3001-900 - 9019 FOR CROSSPASSAGE 3; 3001-900 - 9021 FOR CROSSPASSAGE 7.

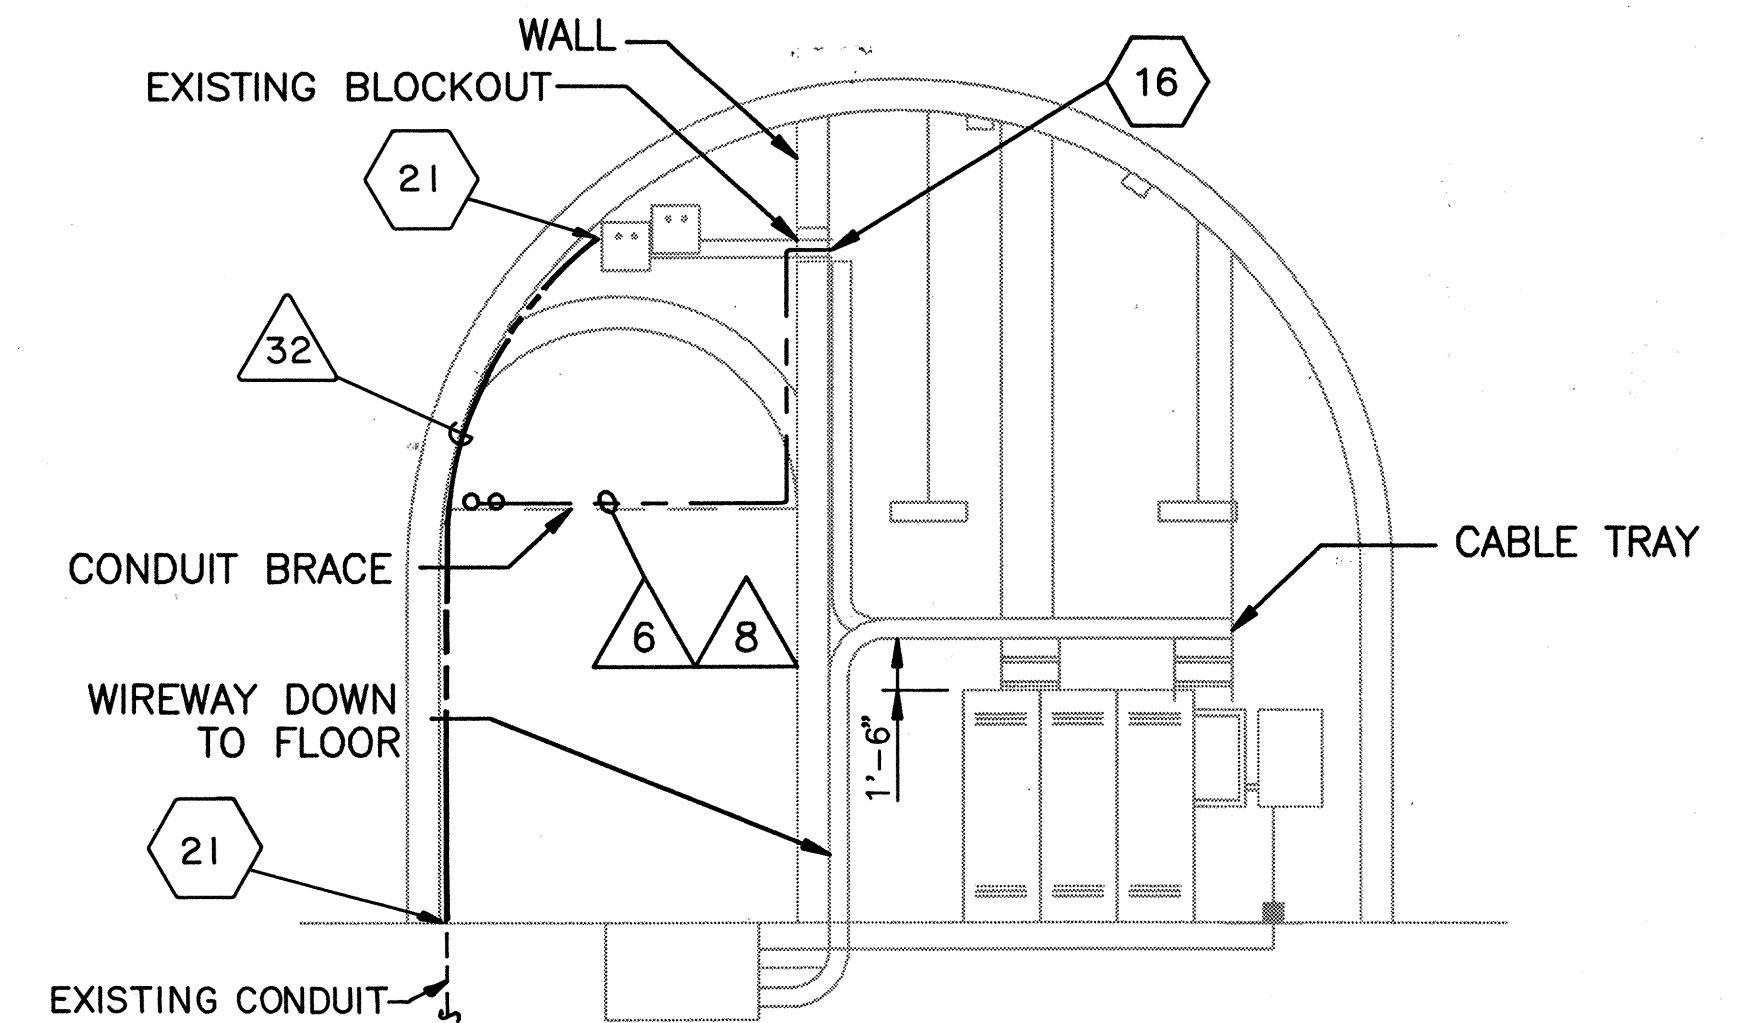

SECTION (TYP)
SCALE: 1" = 5'-0"

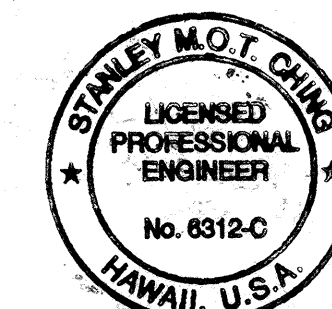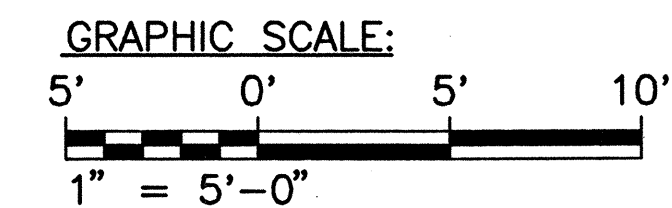

THIS WORK WAS PREPARED BY ME
OR UNDER MY SUPERVISION
Stanley M.O.T. Chang


	ADDENDUM 2 - INDICATED ITC AS
10/27/95	EXISTING AND ADDED CONDUIT RUN 32
	IN SECTION 'C'
10/13/95	ADDENDUM 1
DATE	REVISION
STATE OF HAWAII DEPARTMENT OF TRANSPORTATION HIGHWAYS DIVISION	
CROSSPASSAGE 3 & 7	
CONNECTIONS	
EXPLORATORY TUNNEL IMPROVEMENTS	
H-3 FINISH (UNIT III)	
FAIP NO. 1-H3-1(75), UNIT III	
T.K. TUNNEL/ACCESS ROADS	
SCALE: 1" = 5'	DATE: JUN 1995
SHEET NO. 2T13 OF 21 SHEETS	

FED. ROAD DIST. NO.	STATE	FED. AID PROJ. NO.	FISCAL YEAR	SHEET NO.	TOTAL SHEETS
HAWAII	HAW.	1-H3-1(75) UNIT III	1994	116	353



SHAFT & X-PSG DIMENSIONS

X-PSG	A	B	C	D
1	17'-3½"	17'-3½"	49'-7"	88'-2"
5	15'-8"	15'-8"	46'-4"	50'-2"
9	16'-10½"	16'-10½"	48'-9"	108'-2"

- NOTES:
- SEE SHEET NO. 2T1 FOR CONDUIT & CABLE SCHEDULE & CONSTRUCTION NOTES.
 - FOR TRUNK RADIOS IN CROSSPASSAGE 1 AND 5, SEE CT1 DRAWINGS 1A, 1B, 7, 8, 9, 10A, 10B, 11B, 21, 22A, 22B.

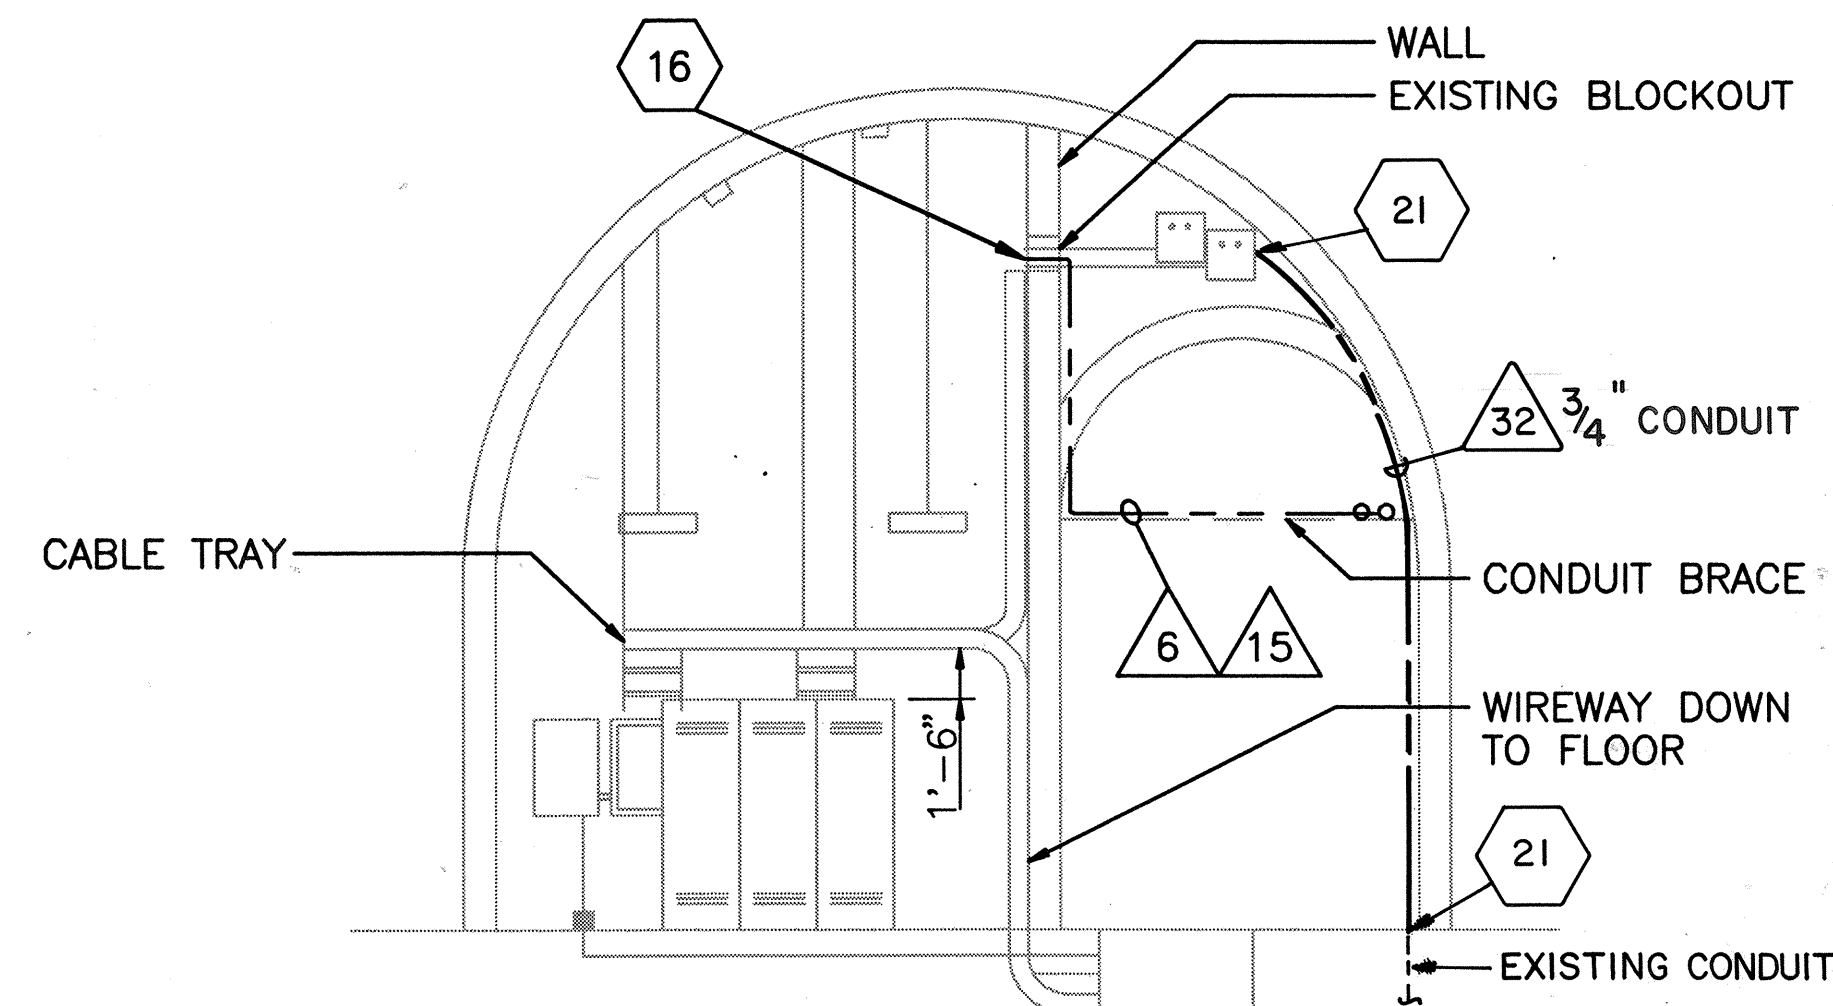


SECTION (TYP)
SCALE: 1" = 5'-0"

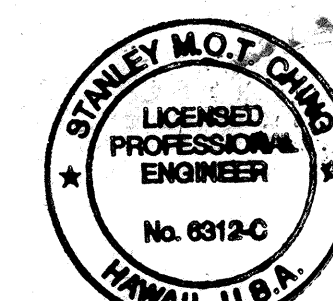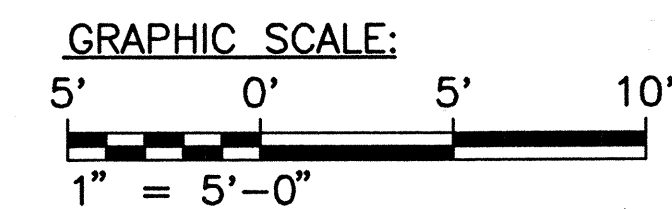

THIS WORK WAS PREPARED BY ME
OR UNDER MY SUPERVISION
Stanley M.O.T. Ching

DATE	REVISION
10/27/95	ADDENDUM 2-INDICATED ITC AS EXISTING AND ADDED CONDUIT RUN 32 IN SECTION 'C'
10/13/95	ADDENDUM 1
STATE OF HAWAII DEPARTMENT OF TRANSPORTATION HIGHWAYS DIVISION CROSSPASSAGE 1, 5 & 9 CONNECTIONS EXPLORATORY TUNNEL IMPROVEMENTS H-3 FINISH (UNIT III) FAIP NO. 1-H3-1(75), UNIT III T.K. TUNNEL/ACCESS ROADS SCALE: 1" = 5' DATE: JUN 1995 SHEET NO. 2T14 OF 21 SHEETS	

XBREF LIST:
ETI-BRDR
SCALES

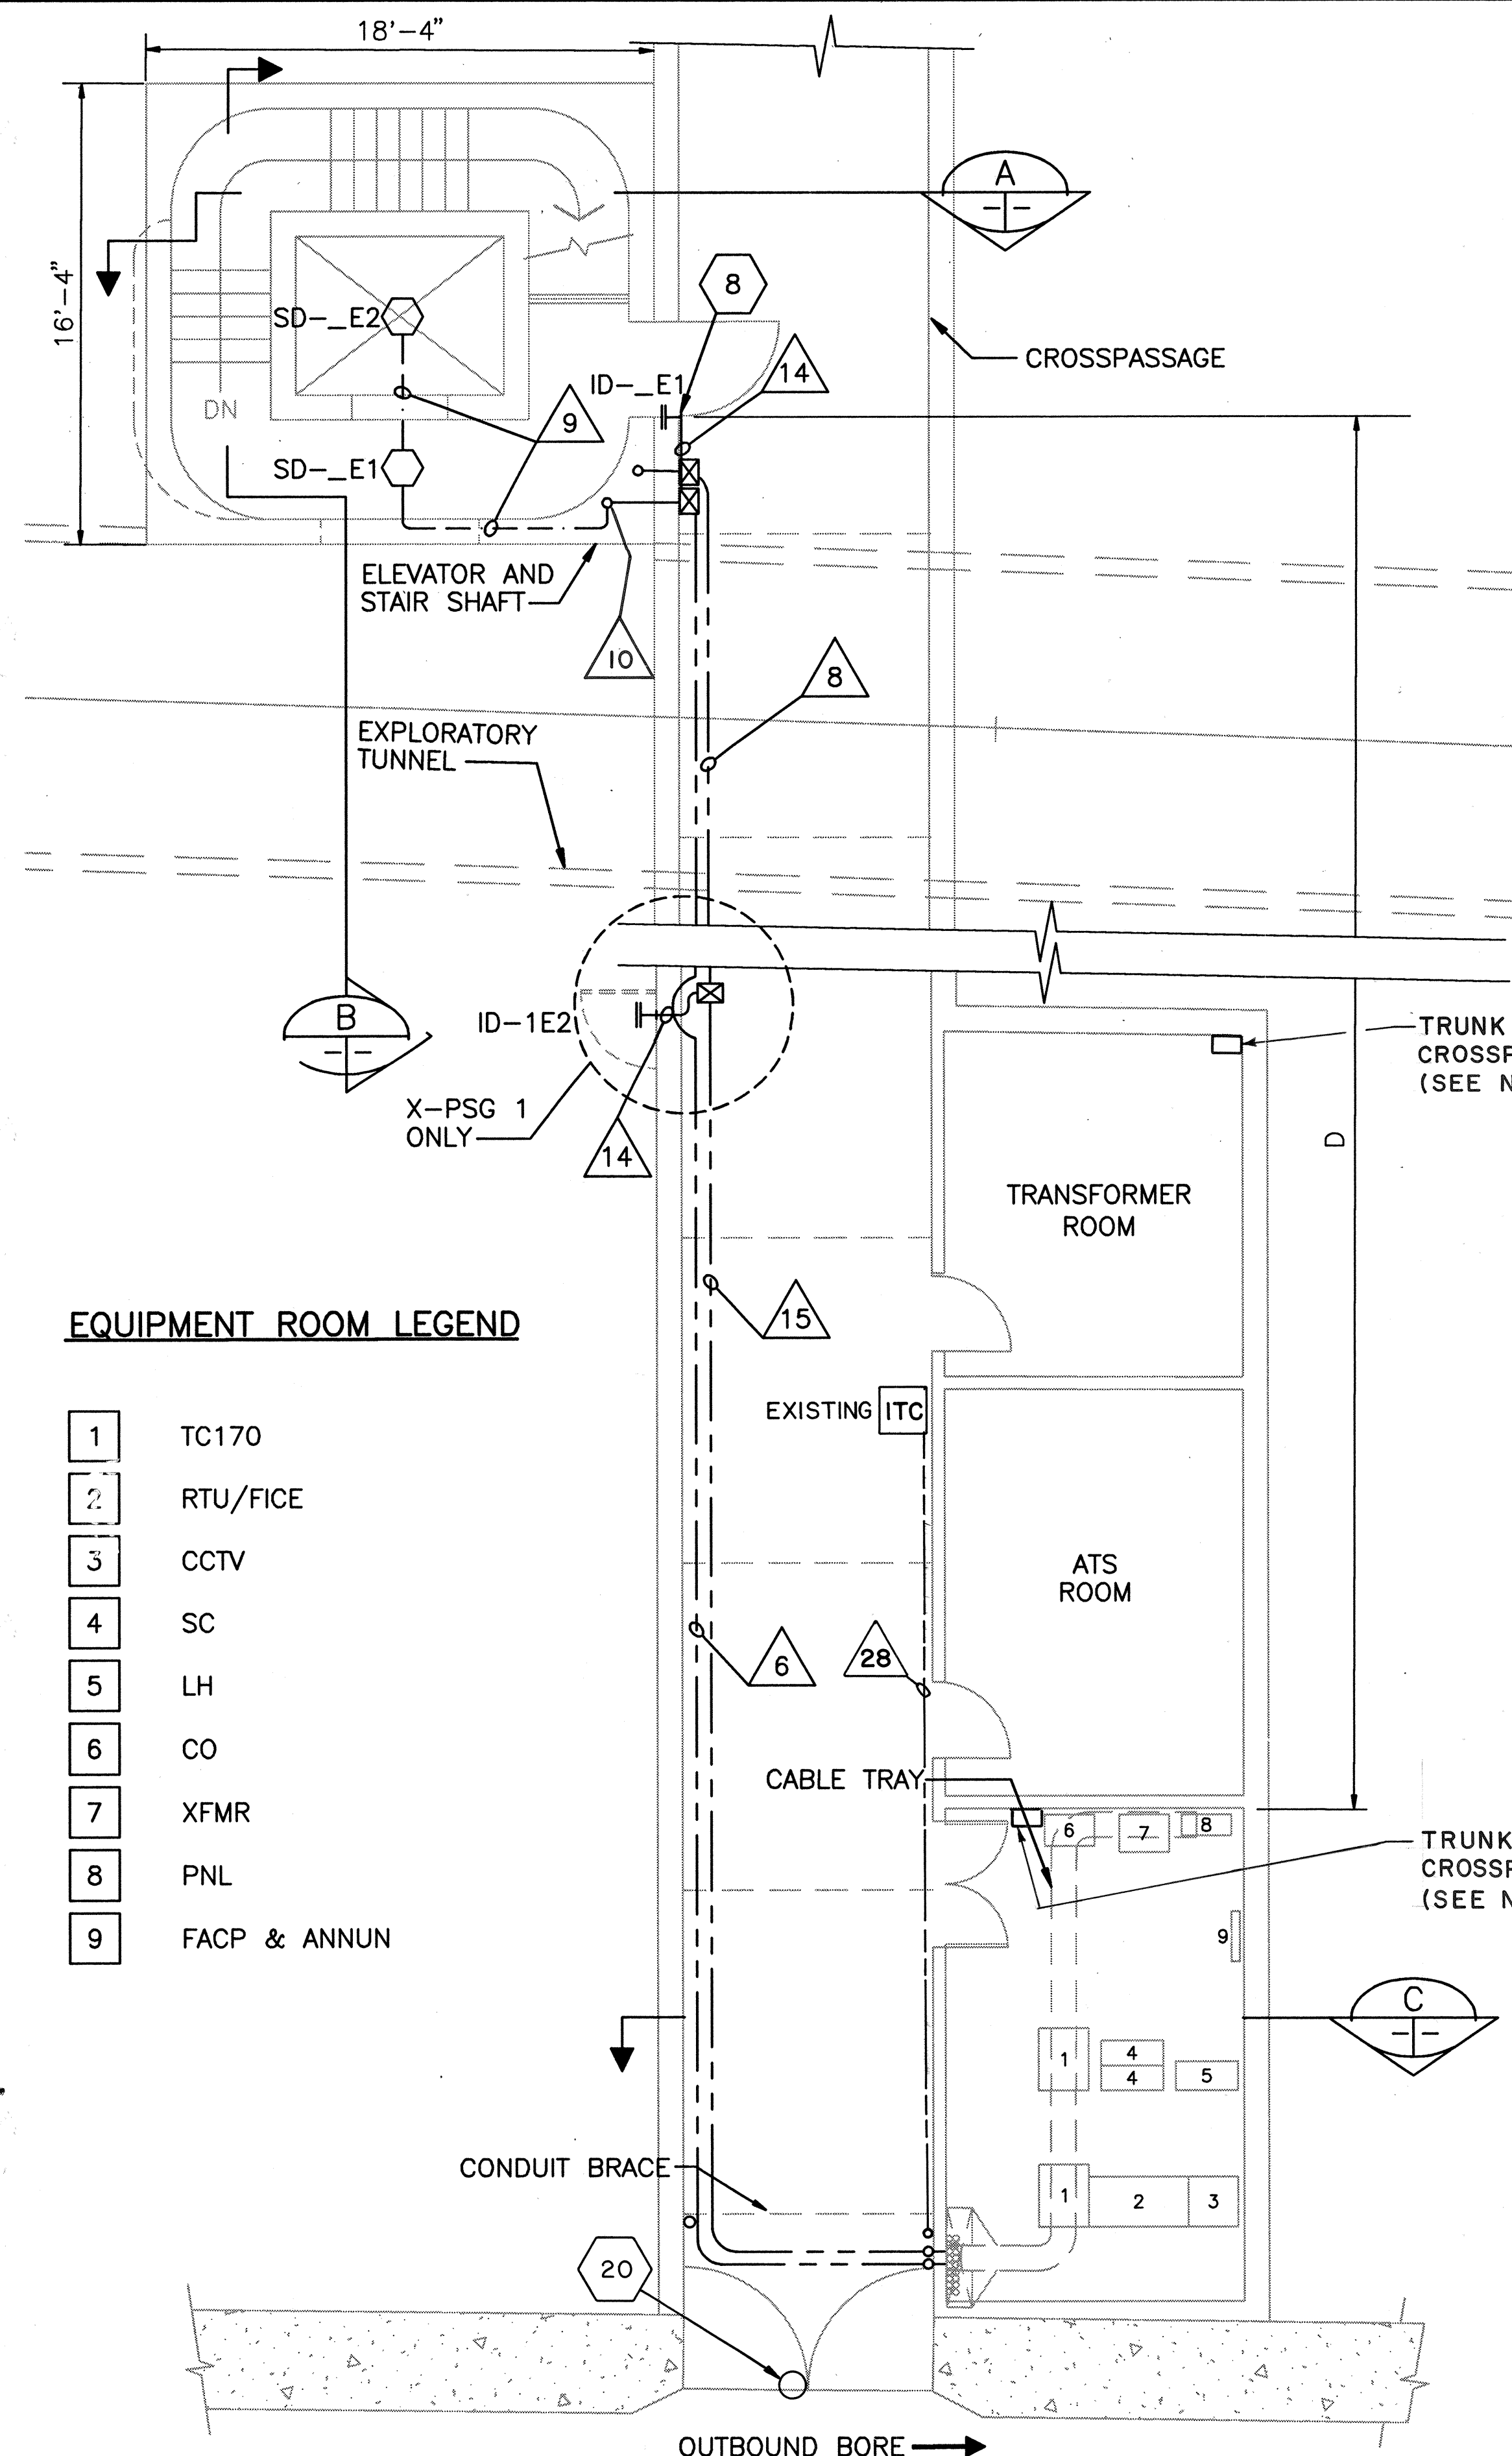


EQUIPMENT ROOM LEGEND


- | | |
|---|--------------|
| 1 | TC170 |
| 2 | RTU/FICE |
| 3 | CCTV |
| 4 | SC |
| 5 | LH |
| 6 | CO |
| 7 | XFMR |
| 8 | PNL |
| 9 | FACP & ANNUN |

PLAN AT CROSSPASSAGE CONNECTION


SCALE: 1" = 5'-0" 2T7, 2T8, 2T9 2T14

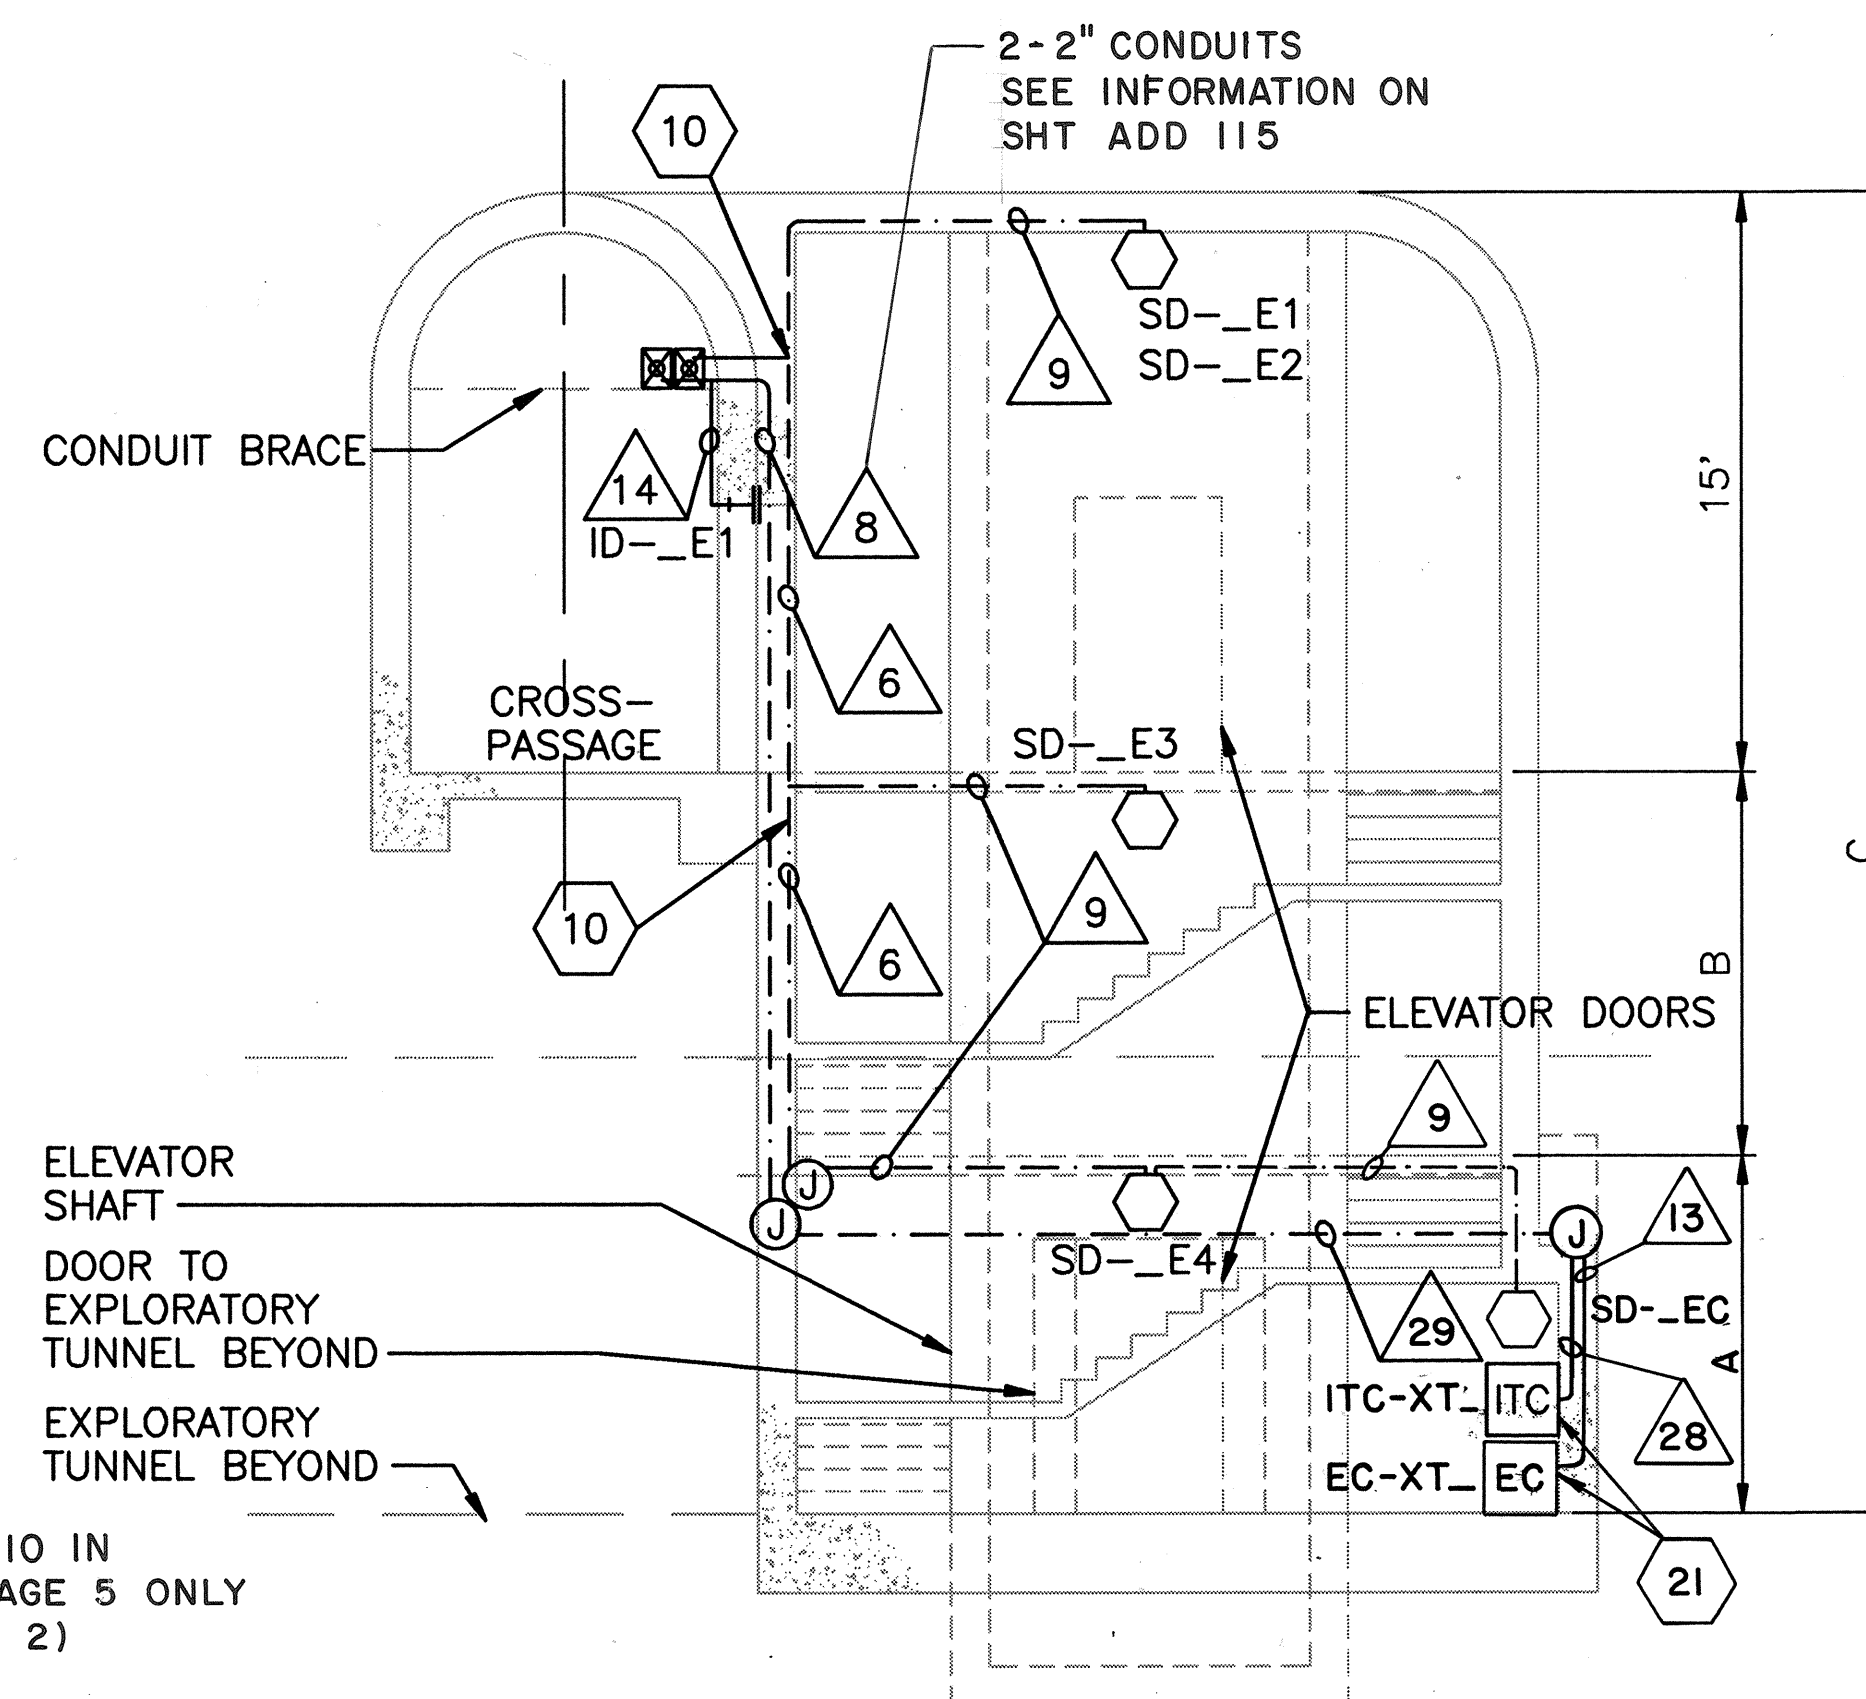

SECTION (TYP)
SCALE: 1" = 5'-0"

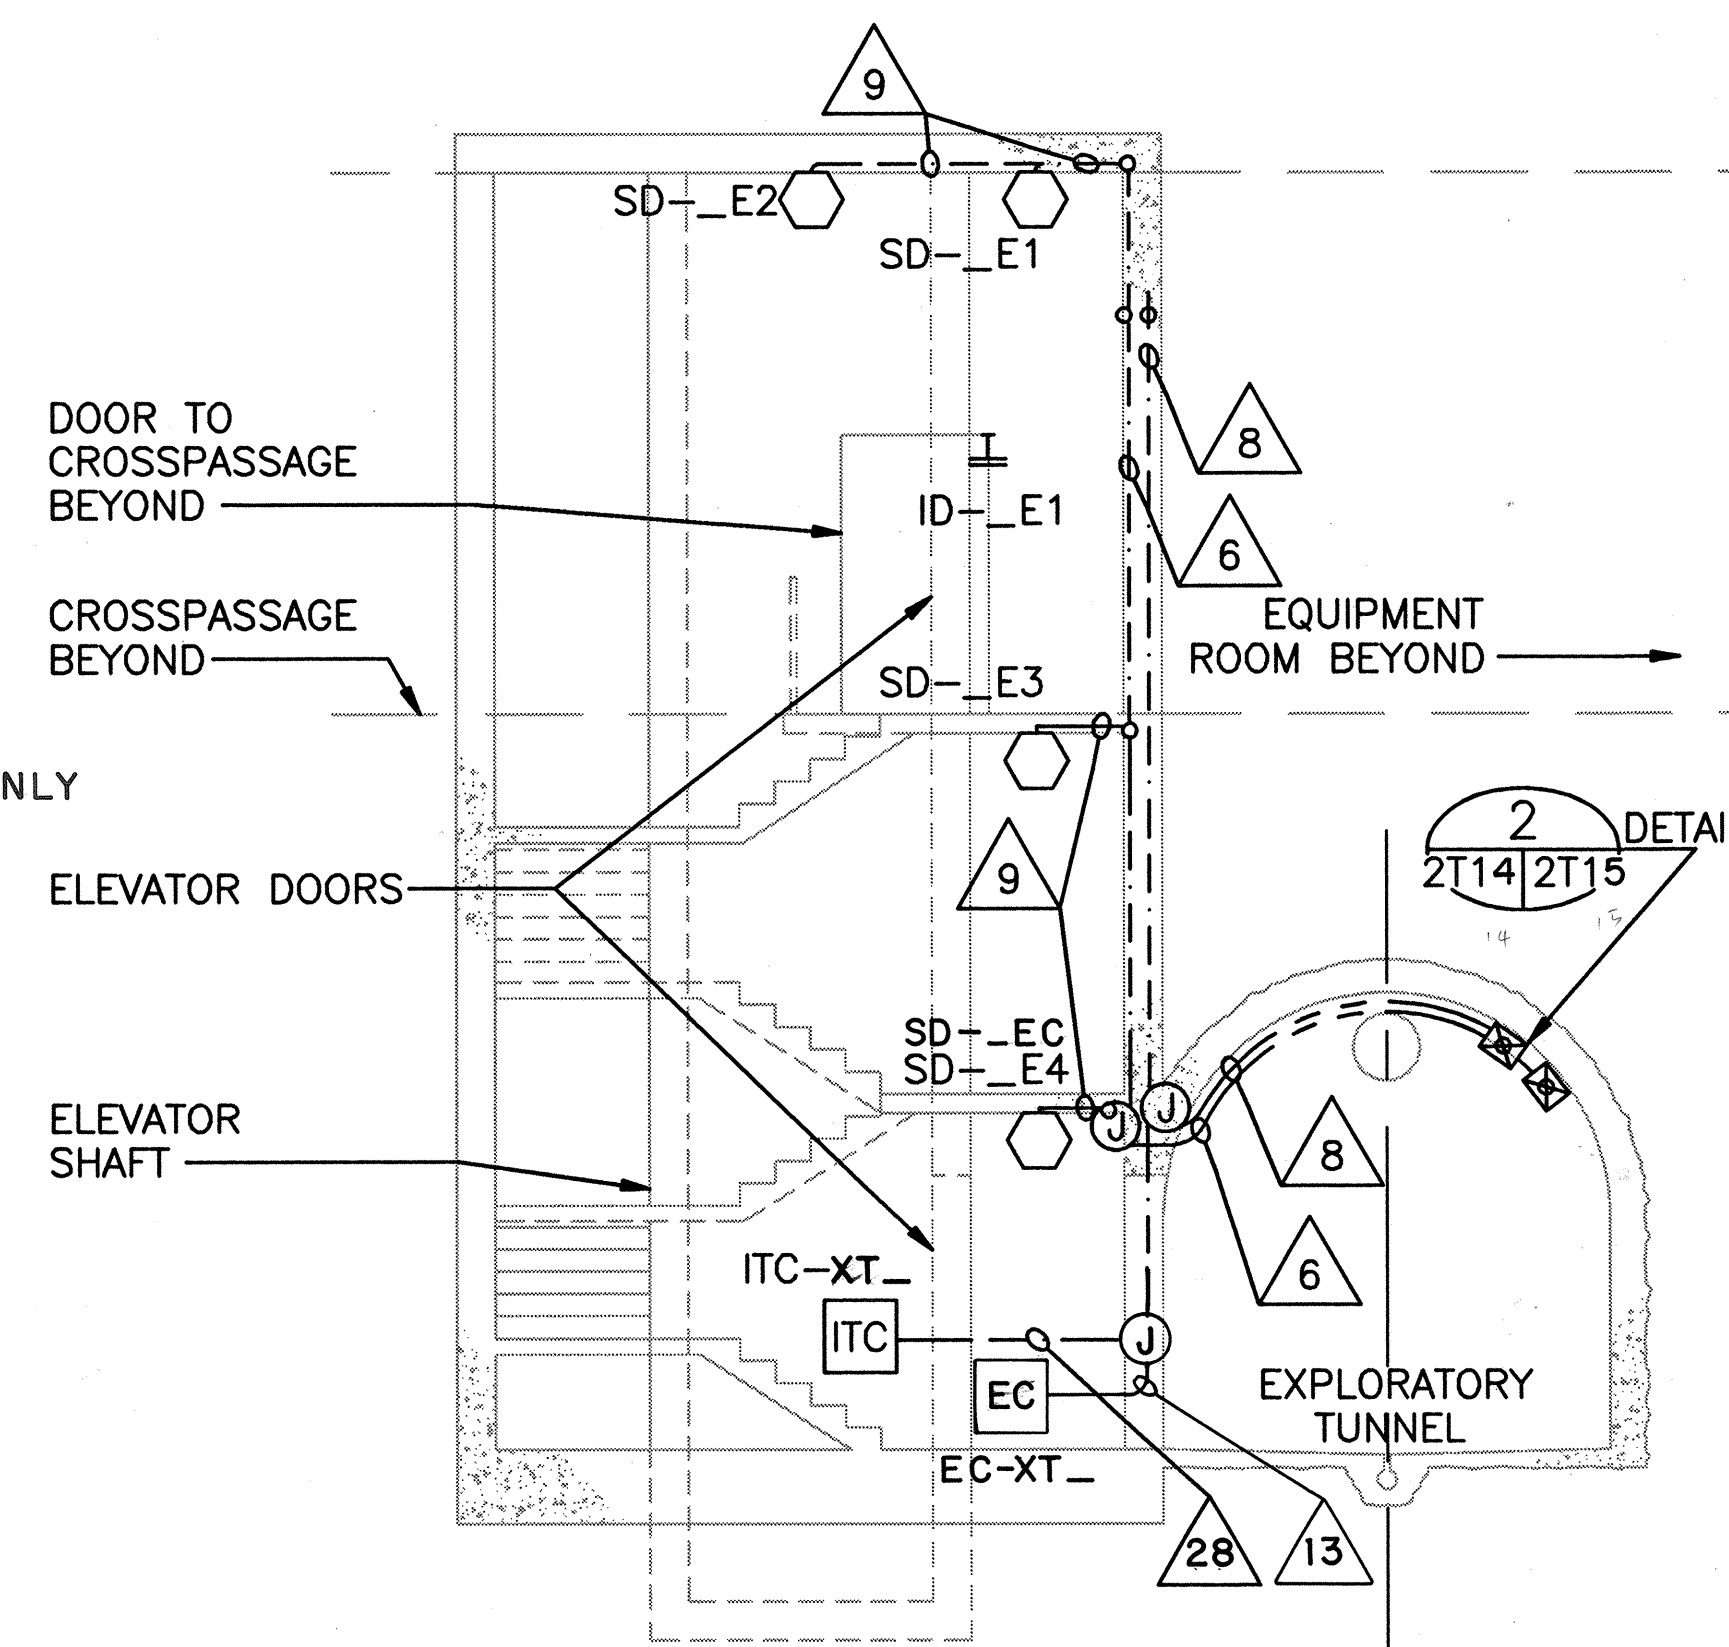

SECTION (TYP)
SCALE: 1" = 5'-0"

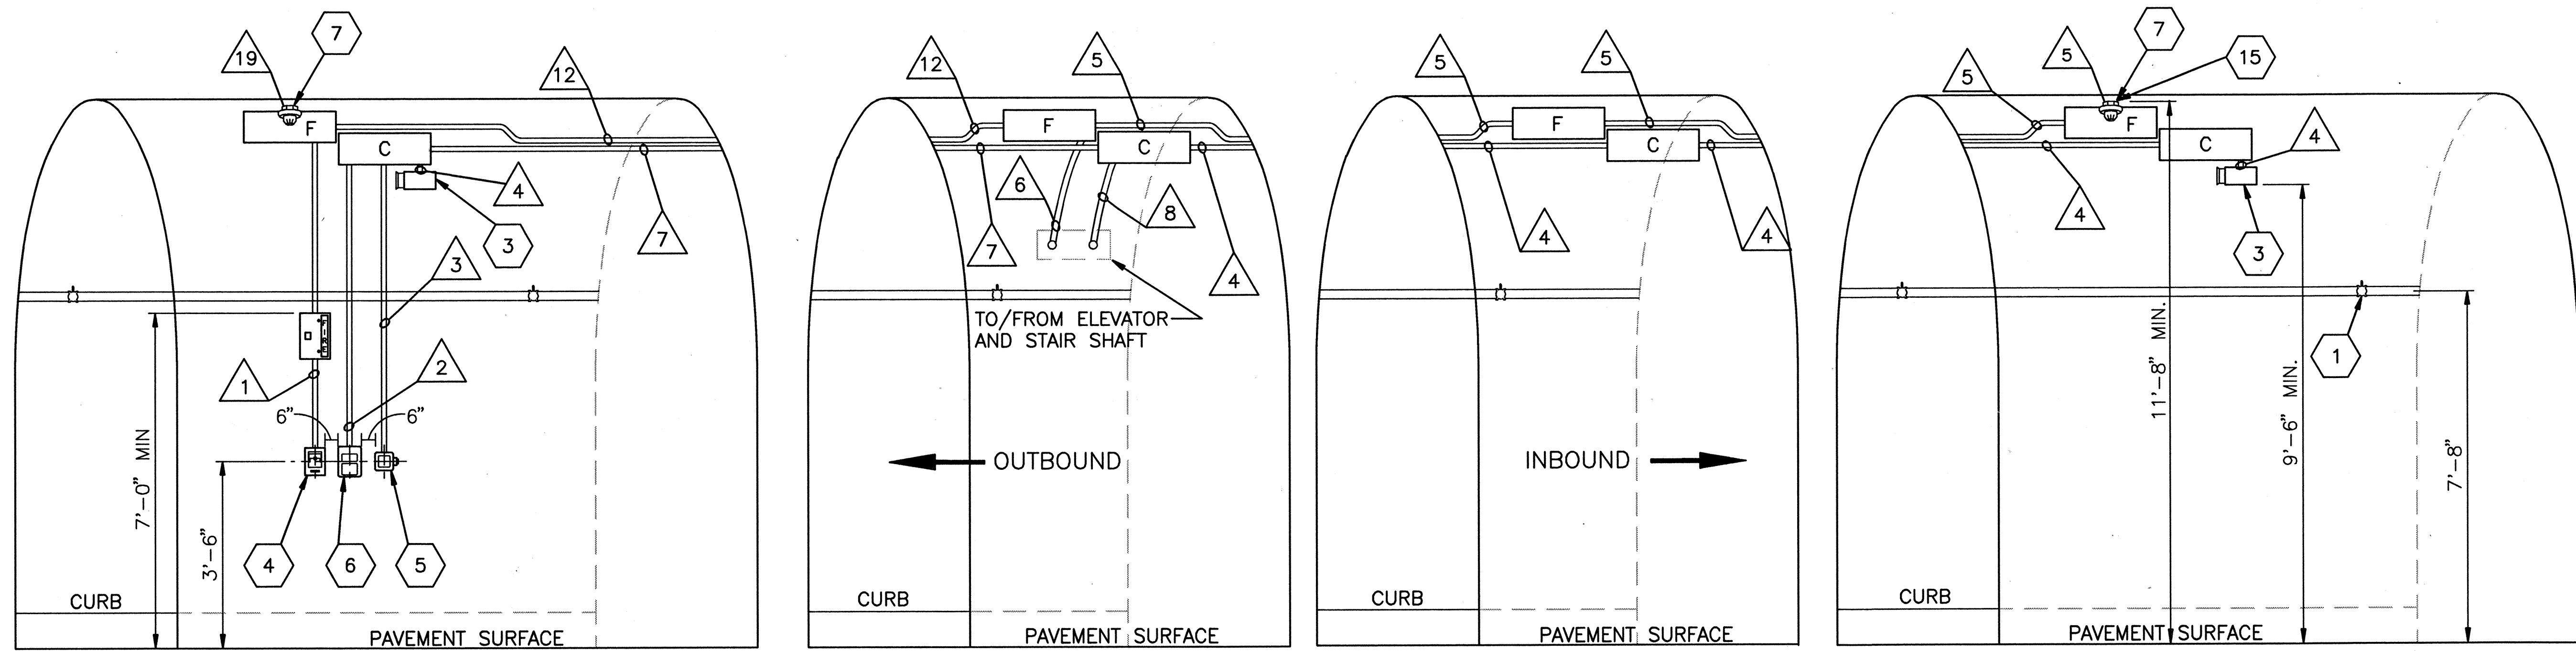


DETAIL 1
SCALE: 1/2" = 1'-0" 2T7,2T8,2T9 | 2T15



DETAIL 2
SCALE: 1/2" = 1'-0" 2T13,2T14 | 2T15

DETAIL 3
SCALE: 1/2" = 1'-0" 2T7,2T8,2T9 | 2T15

DETAIL 4
SCALE: 1/2" = 1'-0" 2T7,2T8 | 2T15

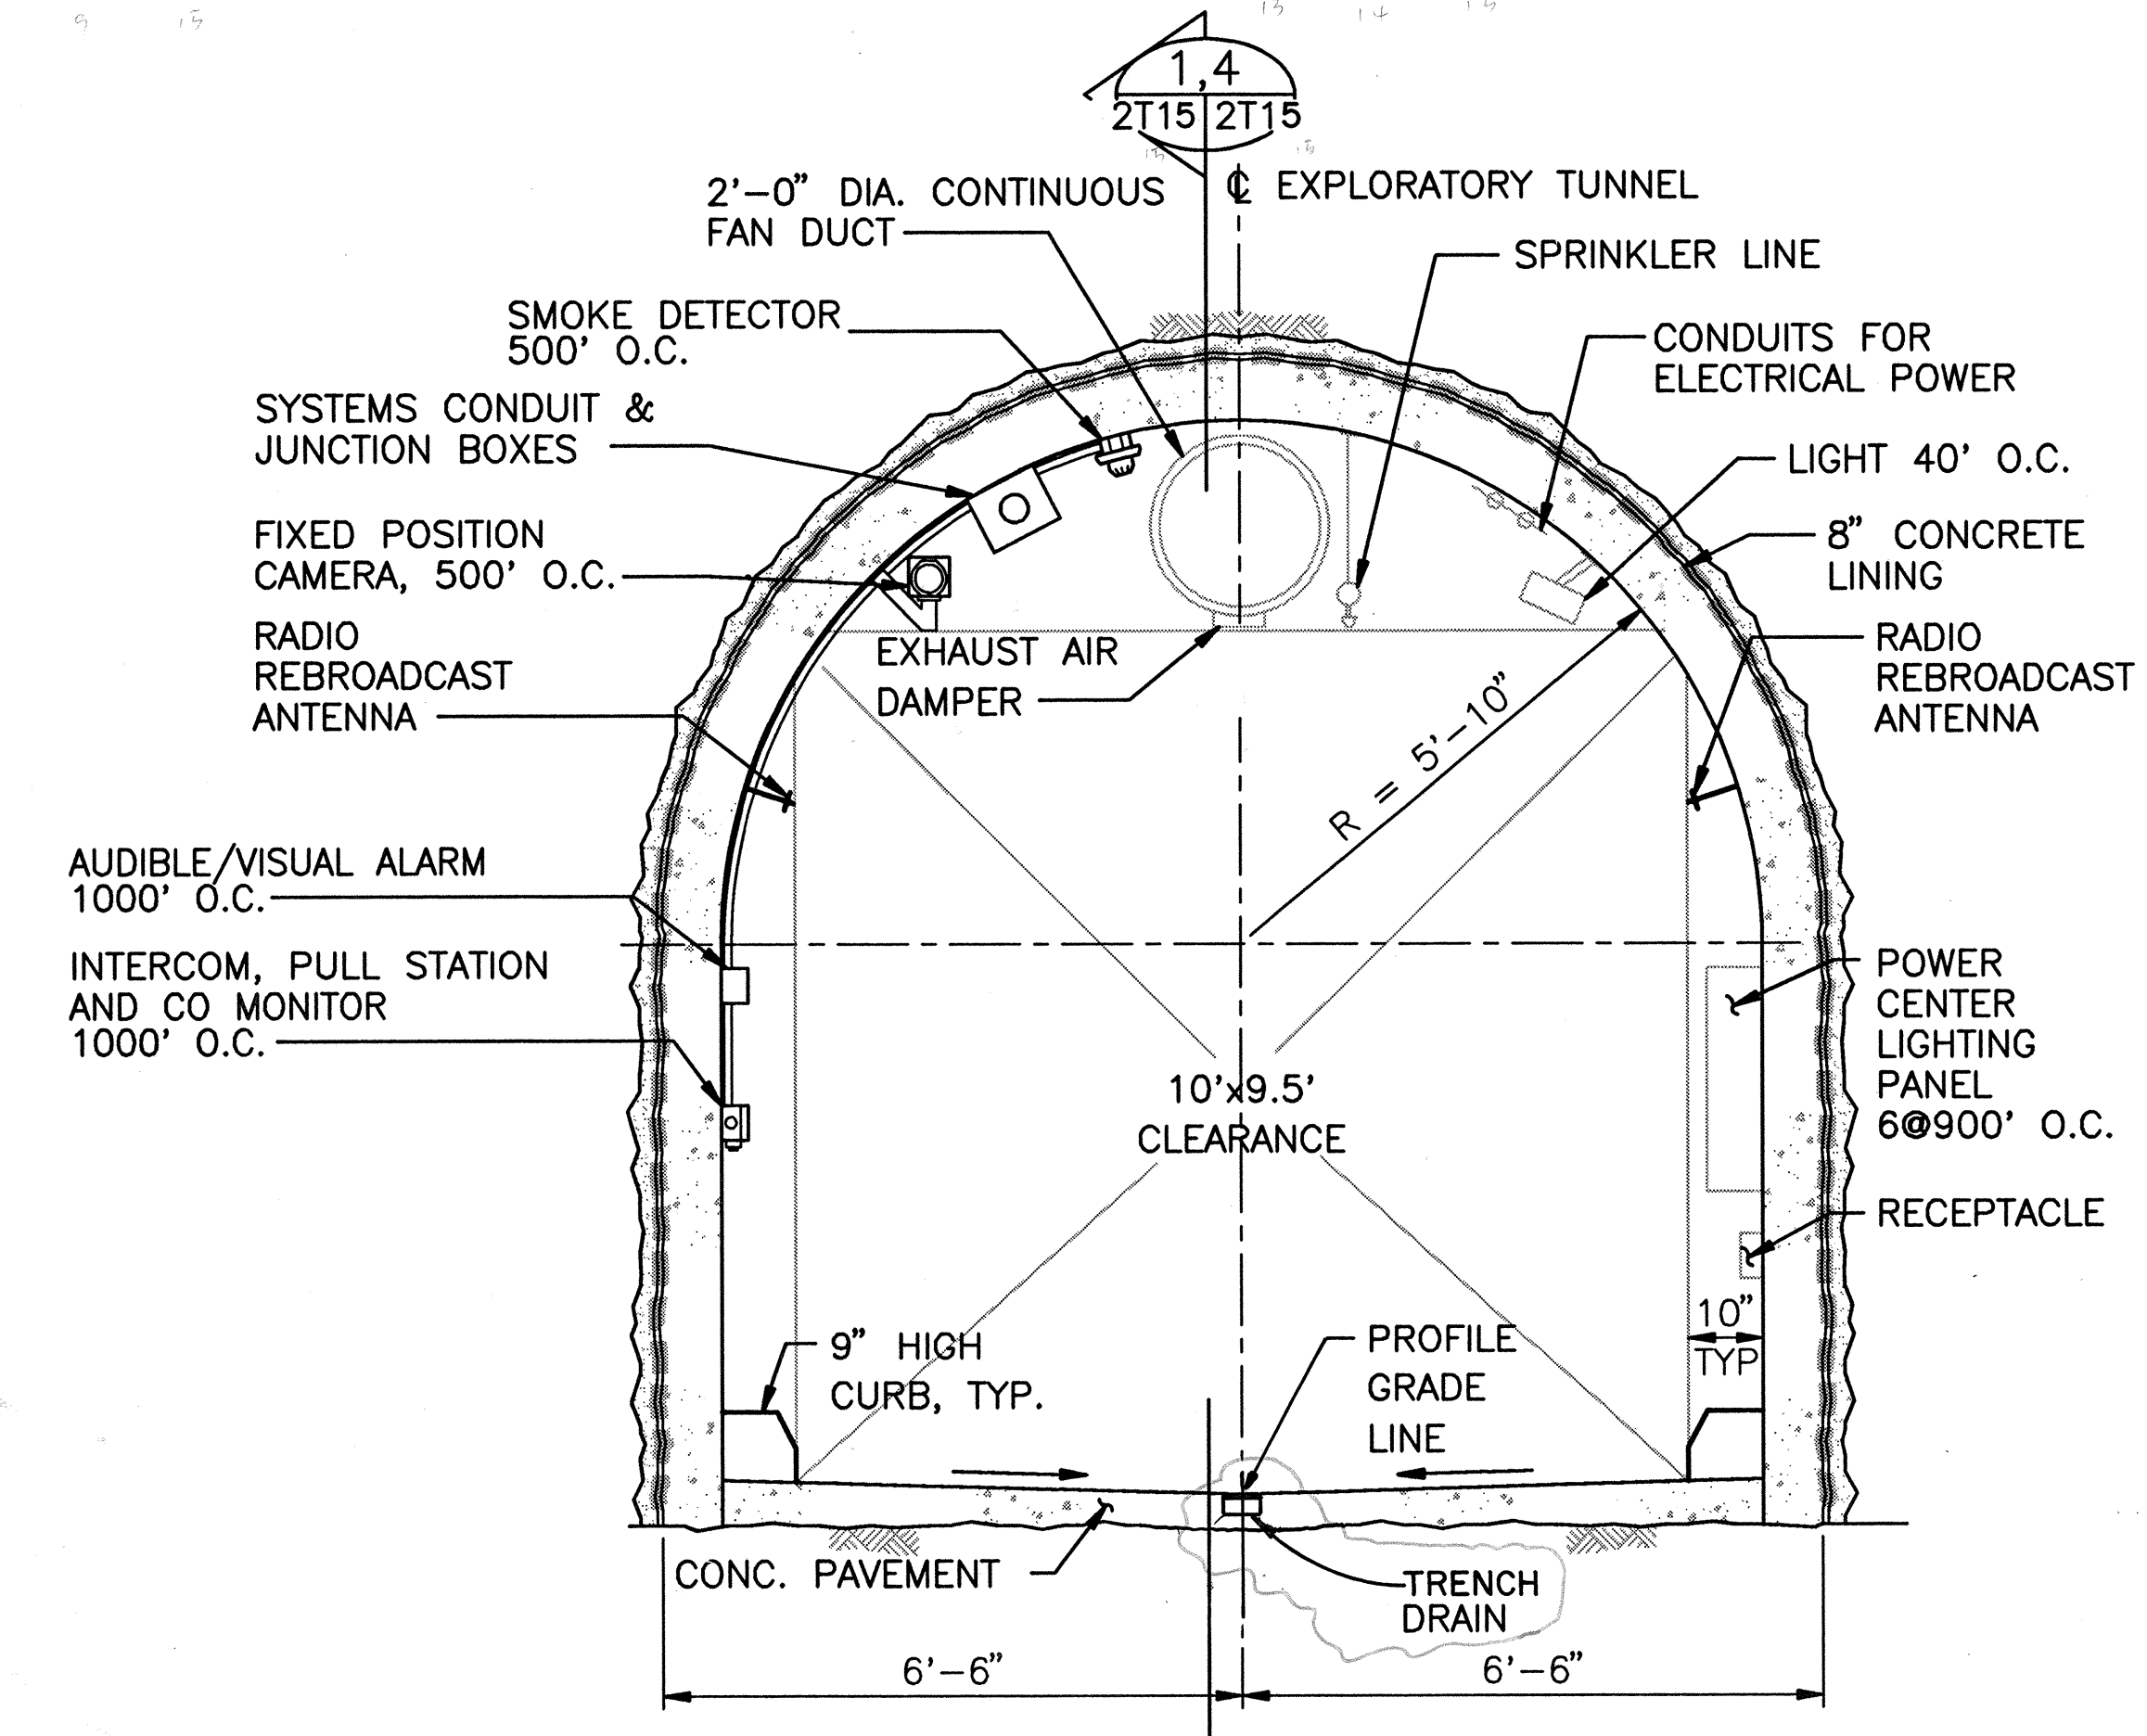

CROSS SECTION AT TUNNEL
SCALE: 1/2" = 1'-0"

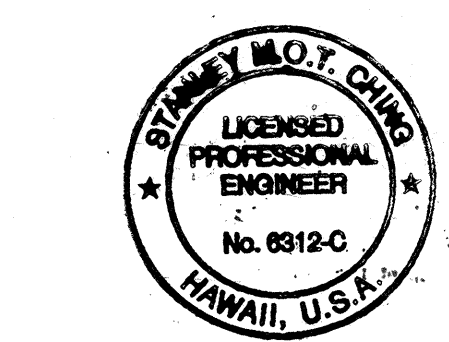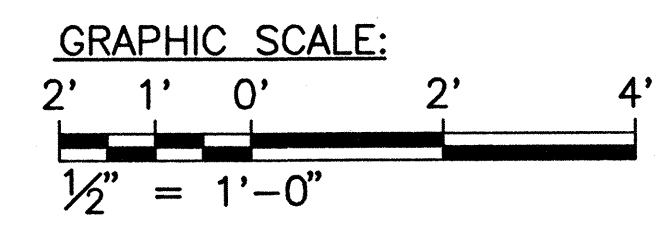

THIS WORK WAS PREPARED BY ME
OR UNDER MY SUPERVISION
Stanley M.O.T. Ching

8/21/96	DCN 75-007-REV. ET DRAIN
4/18/96	DCN 75-001: CLARIFICATION OF 'PROFILE GRADE LINE' LOCATION PER RESPONSE TO RFI NO. 4097-17, REV. 1
DATE	REVISION
STATE OF HAWAII DEPARTMENT OF TRANSPORTATION HIGHWAYS DIVISION	
MISCELLANEOUS DETAILS - 1	
SYSTEMS	
EXPLORATORY TUNNEL IMPROVEMENTS	
H-3 FINISH (UNIT III)	
FAIP NO. 1-H3-1(75), UNIT III	
T.K. TUNNEL/ACCESS ROADS	
SCALE: 1/2" = 1'-0" DATE: JUN 1995	
SHEET NO. 2T15 OF 21 SHEETS	

XREF LIST:
ET-BRDR
SCALE 24


SURVEY PLOTTED BY	DATE
DRAWN BY	10/94
DESIGNED BY	10/94
QUANTITIES BY	
CHECKED BY	
ORIGINAL PLAN	
NOTE BOOK	
No.	

FED. ROAD DIST. NO.	STATE	FED. AID PROJ. NO.	FISCAL YEAR	SHEET NO.	TOTAL SHEETS
HAWAII	HAW.	I-H3-1(75) UNIT III	1994	118	353

NOTES:


1. CABLES IN VERTICAL RUNS SHALL BE SUSPENDED SUCH THAT NONE OF THE CABLE WEIGHT IS TRANSFERRED TO THE CABLE CONNECTIONS OR TERMINATIONS.
2. PROVIDE SUFFICIENT CABLE/WIRE SLACK TO ALLOW FULL DESIGN MOVEMENT OF CAMERA.

XREF LIST:
ETI-BRDR
SCALE4
SCALE8

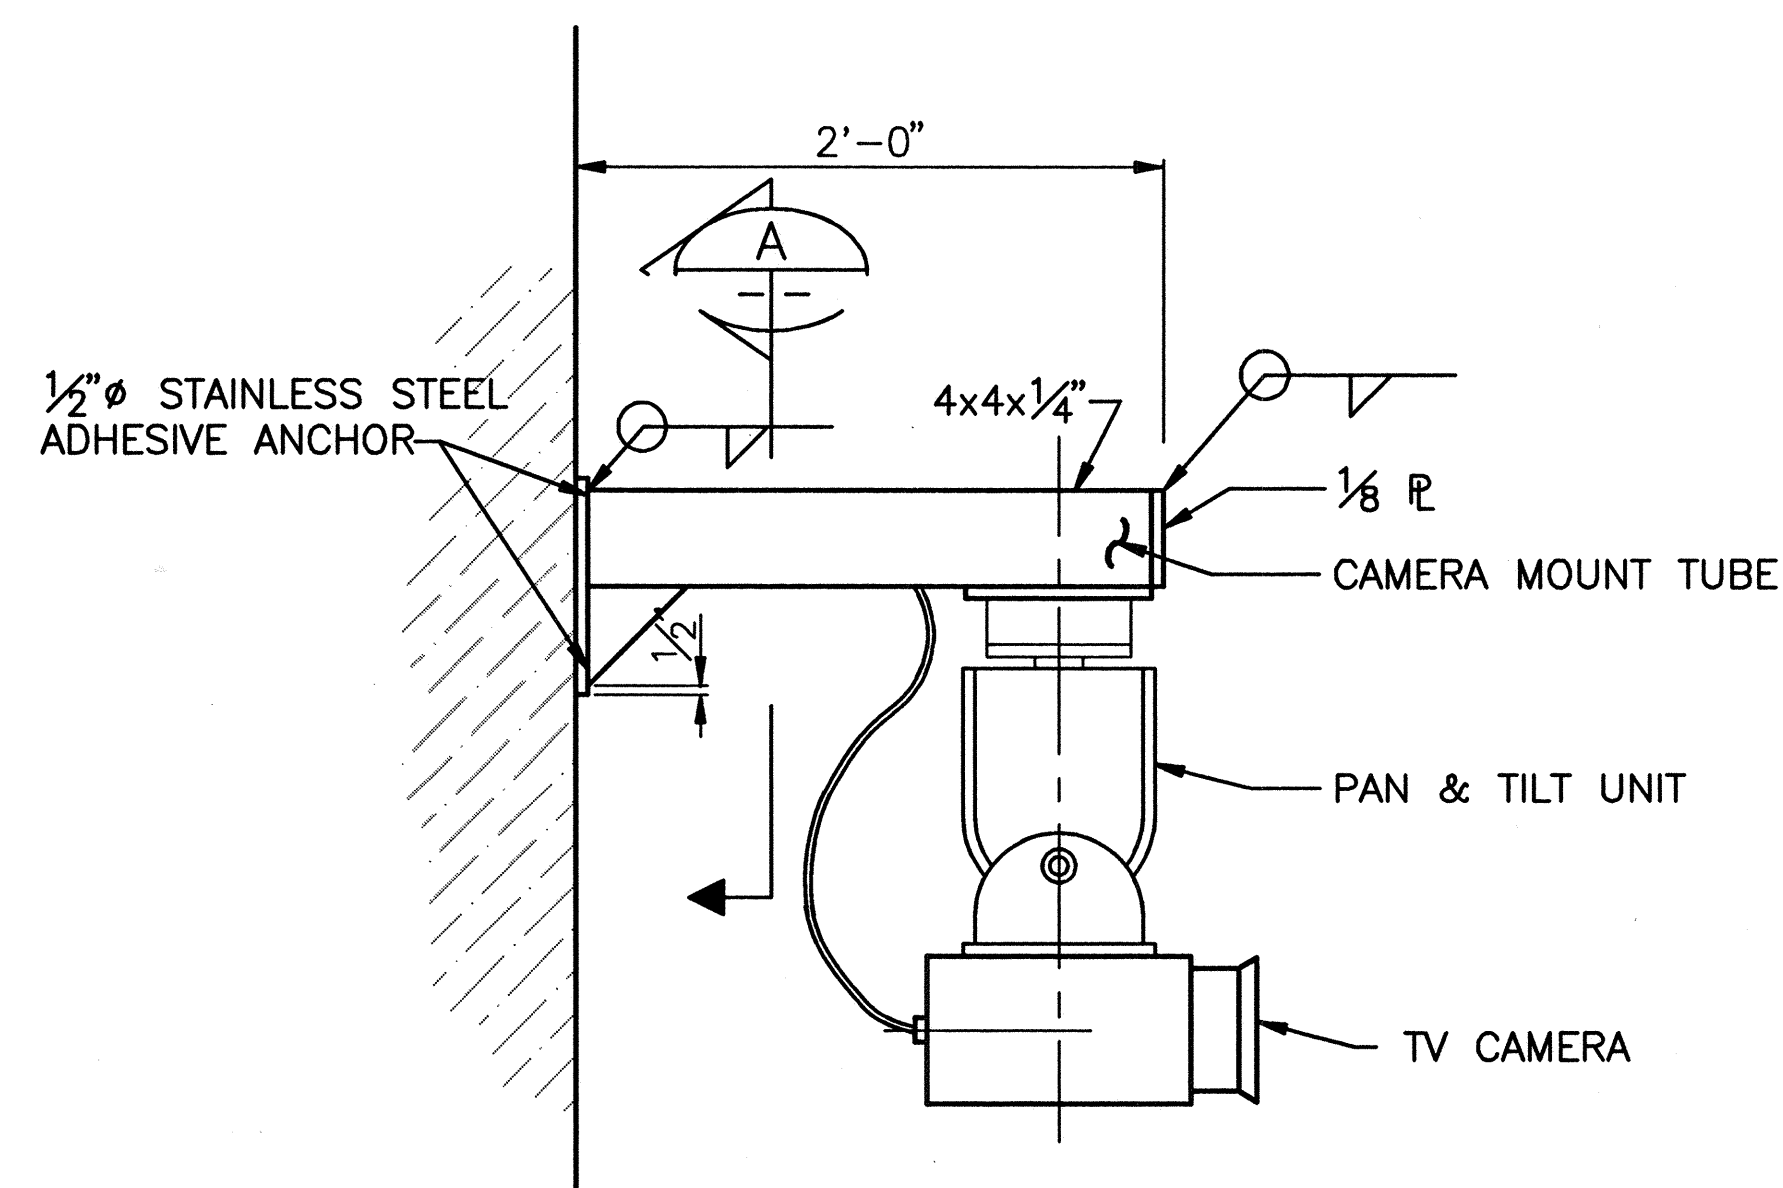


CCTV CAMERA MOUNTING DETAIL

SCALE: $1\frac{1}{2}" = 1'-0"$

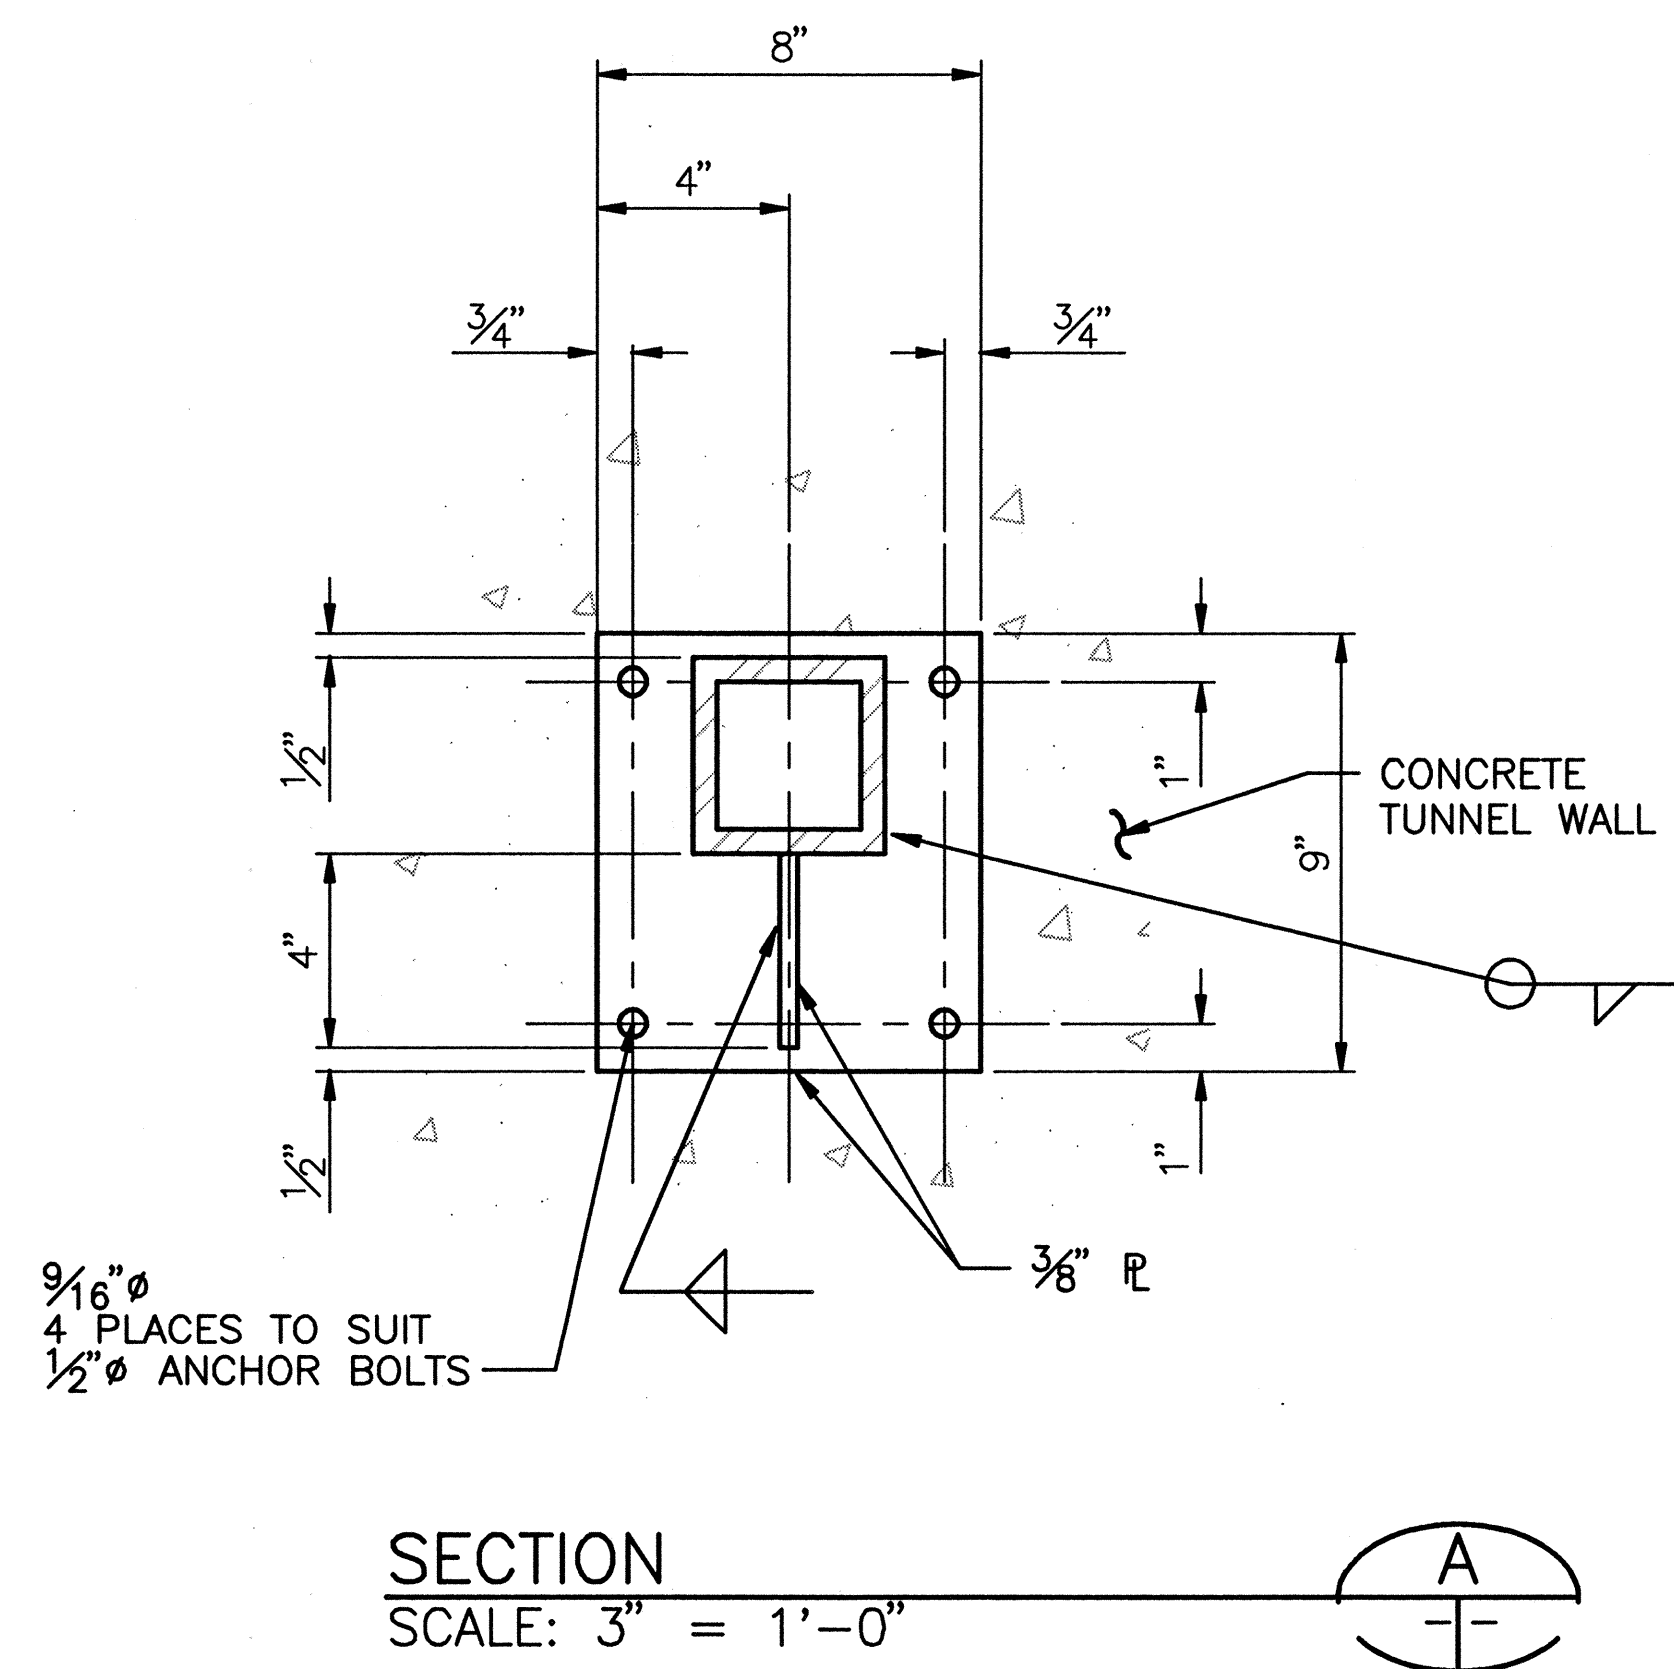


SECTION

SCALE: 3" = 1'-0"

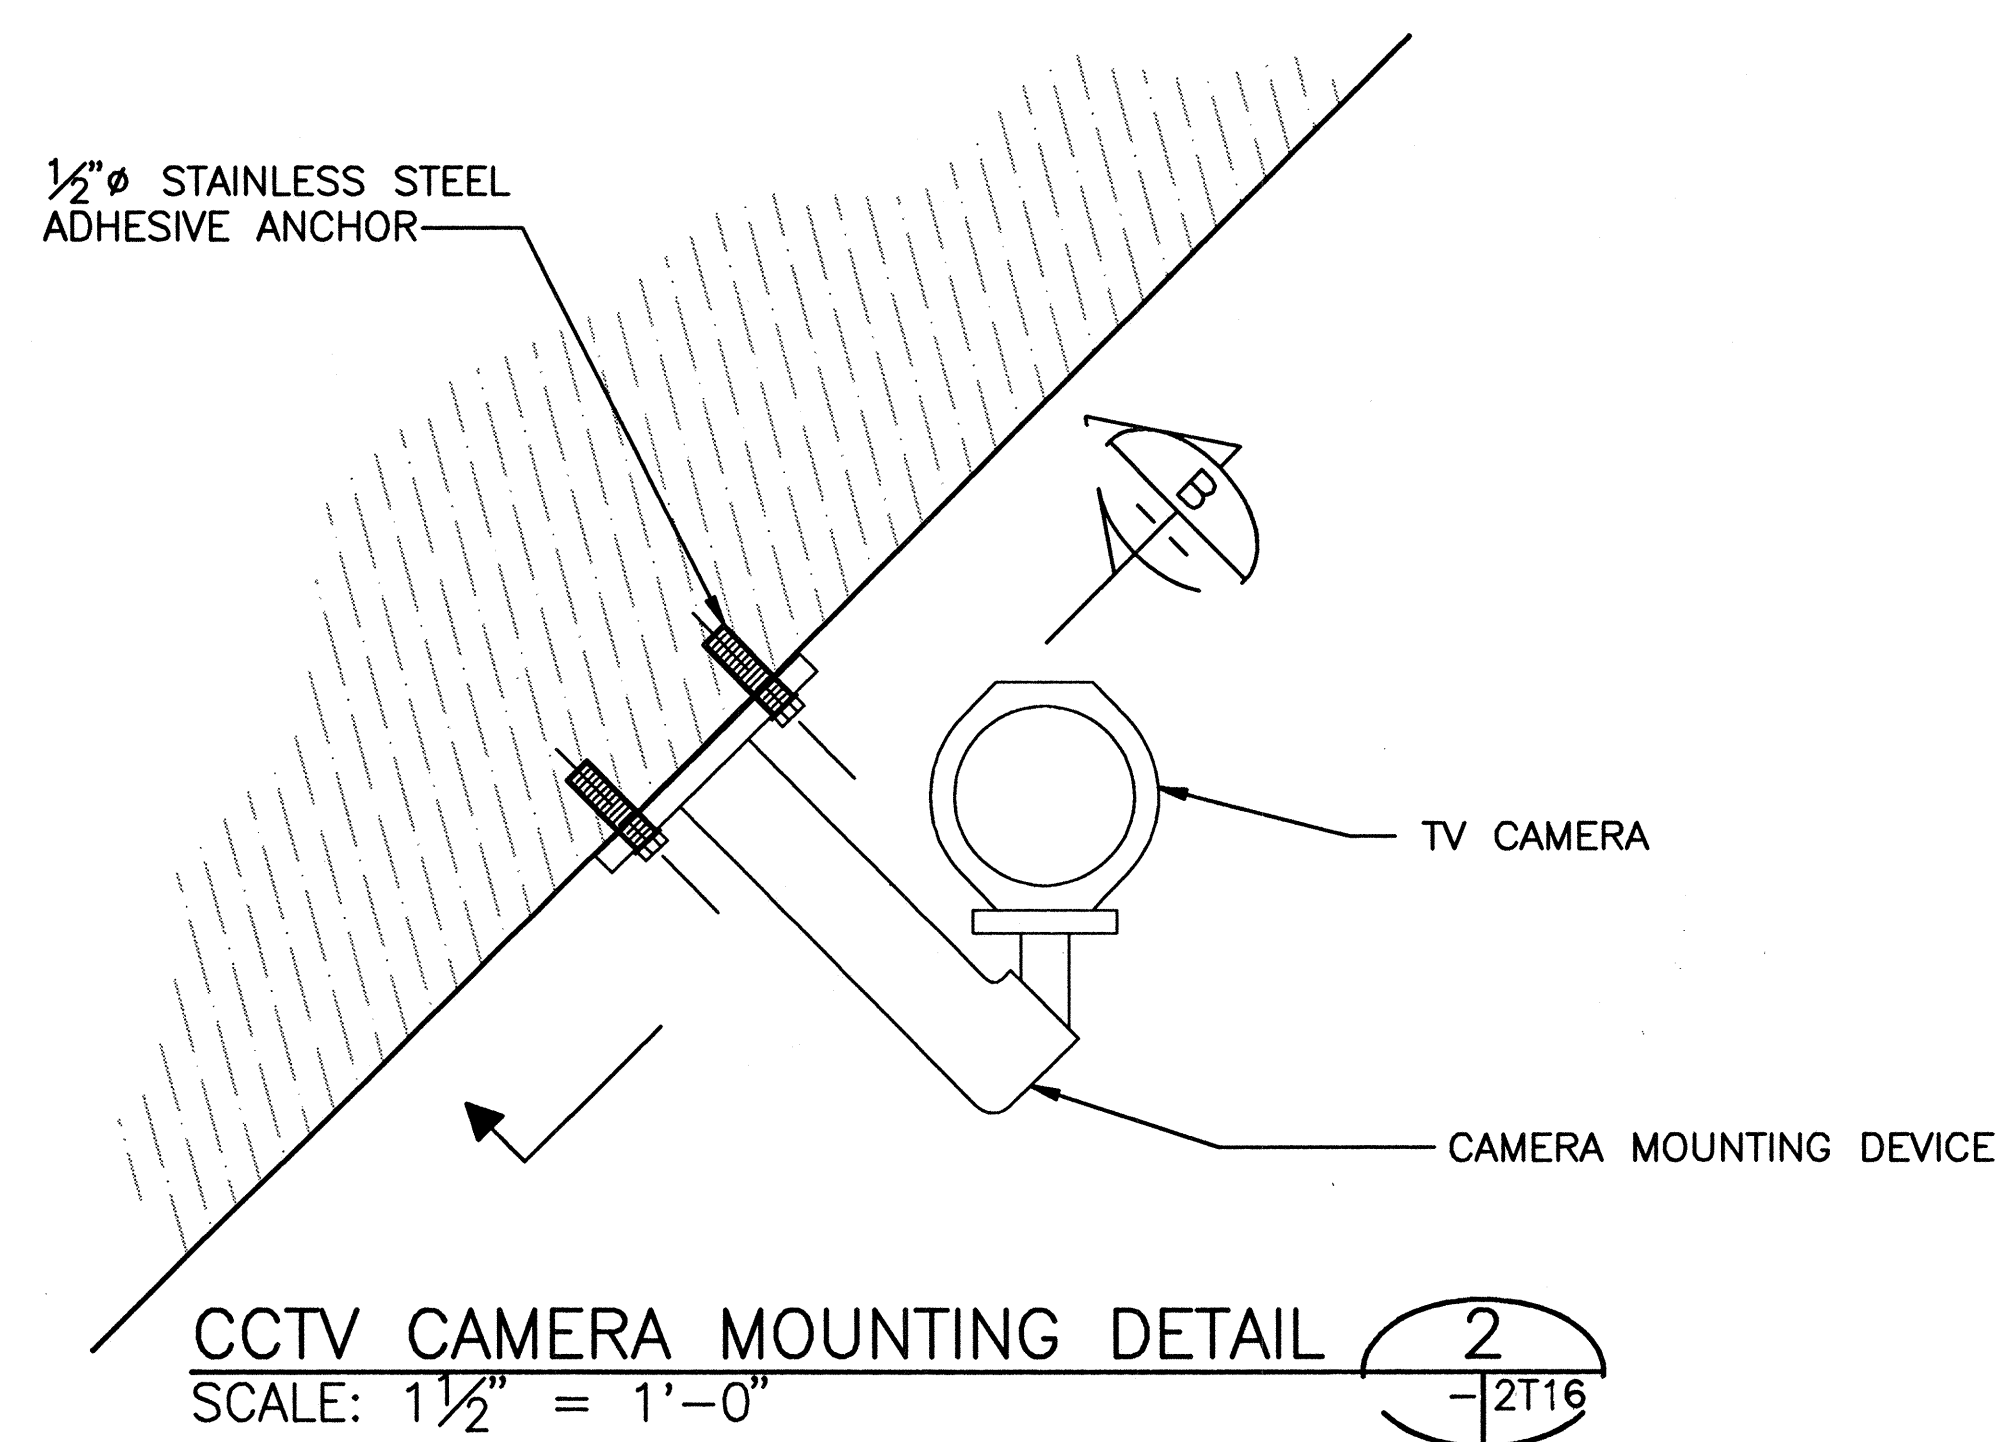




CCTV CAMERA MOUNTING DETAIL

SCALE: $1\frac{1}{2}" = 1'-0"$

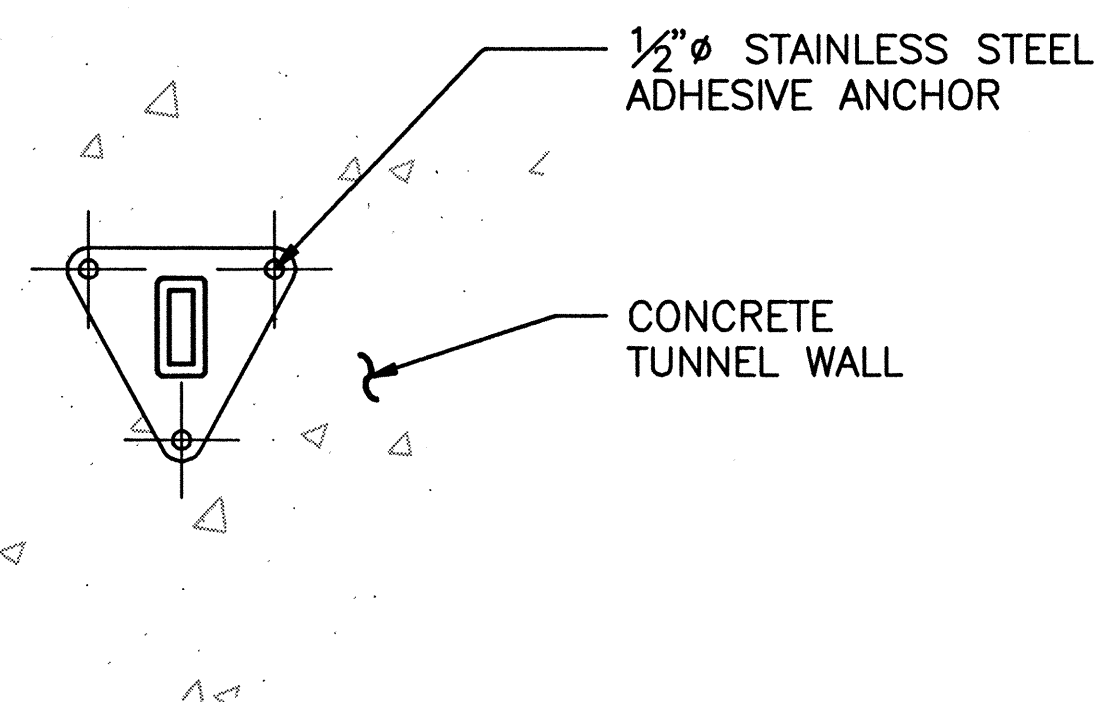

B

1	2	3	100
---	---	---	---	---	---	---	---	---	----	----	-----

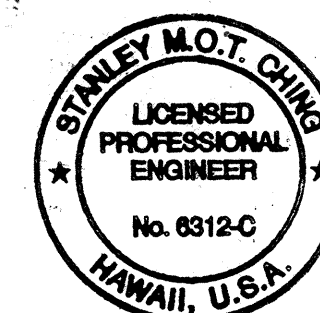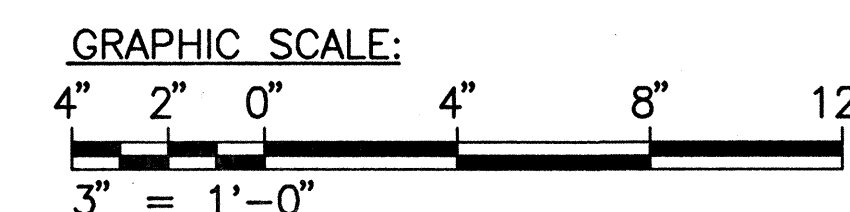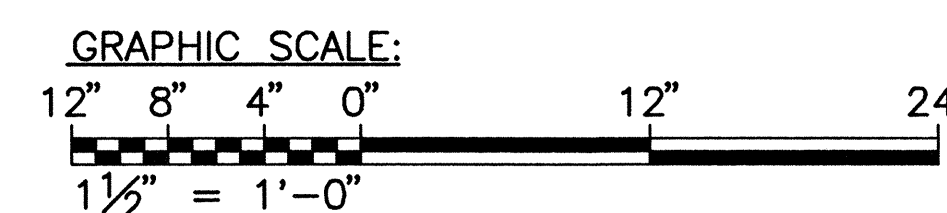

THIS WORK WAS PREPARED BY ME
OR UNDER MY SUPERVISION

Stanley M. O.T. Ch

DATE	REVISION

STATE OF HAWAII

DEPARTMENT OF TRANSPORTATION

HIGHWAYS DIVISION

MISCELLANEOUS DETAILS – 2

SYSTEMS

EXPLORATORY TUNNEL IMPROVEMENTS

H-3 FINISH (UNIT III)



FAIP NO. I-H3-1(75), UNIT III

T.K. TUNNEL/ACCESS ROADS

SCALE: AS NOTED
DATE: JUN 1995

SHEET NO. 2T16 OF 21 SHEETS

FED. ROAD DIST. NO.	STATE	FED. AID PROJ. NO.	FISCAL YEAR	SHEET NO.	TOTAL SHEETS
HAWAII	HAW.	I-H3-1(75) UNIT III	1994	120	353

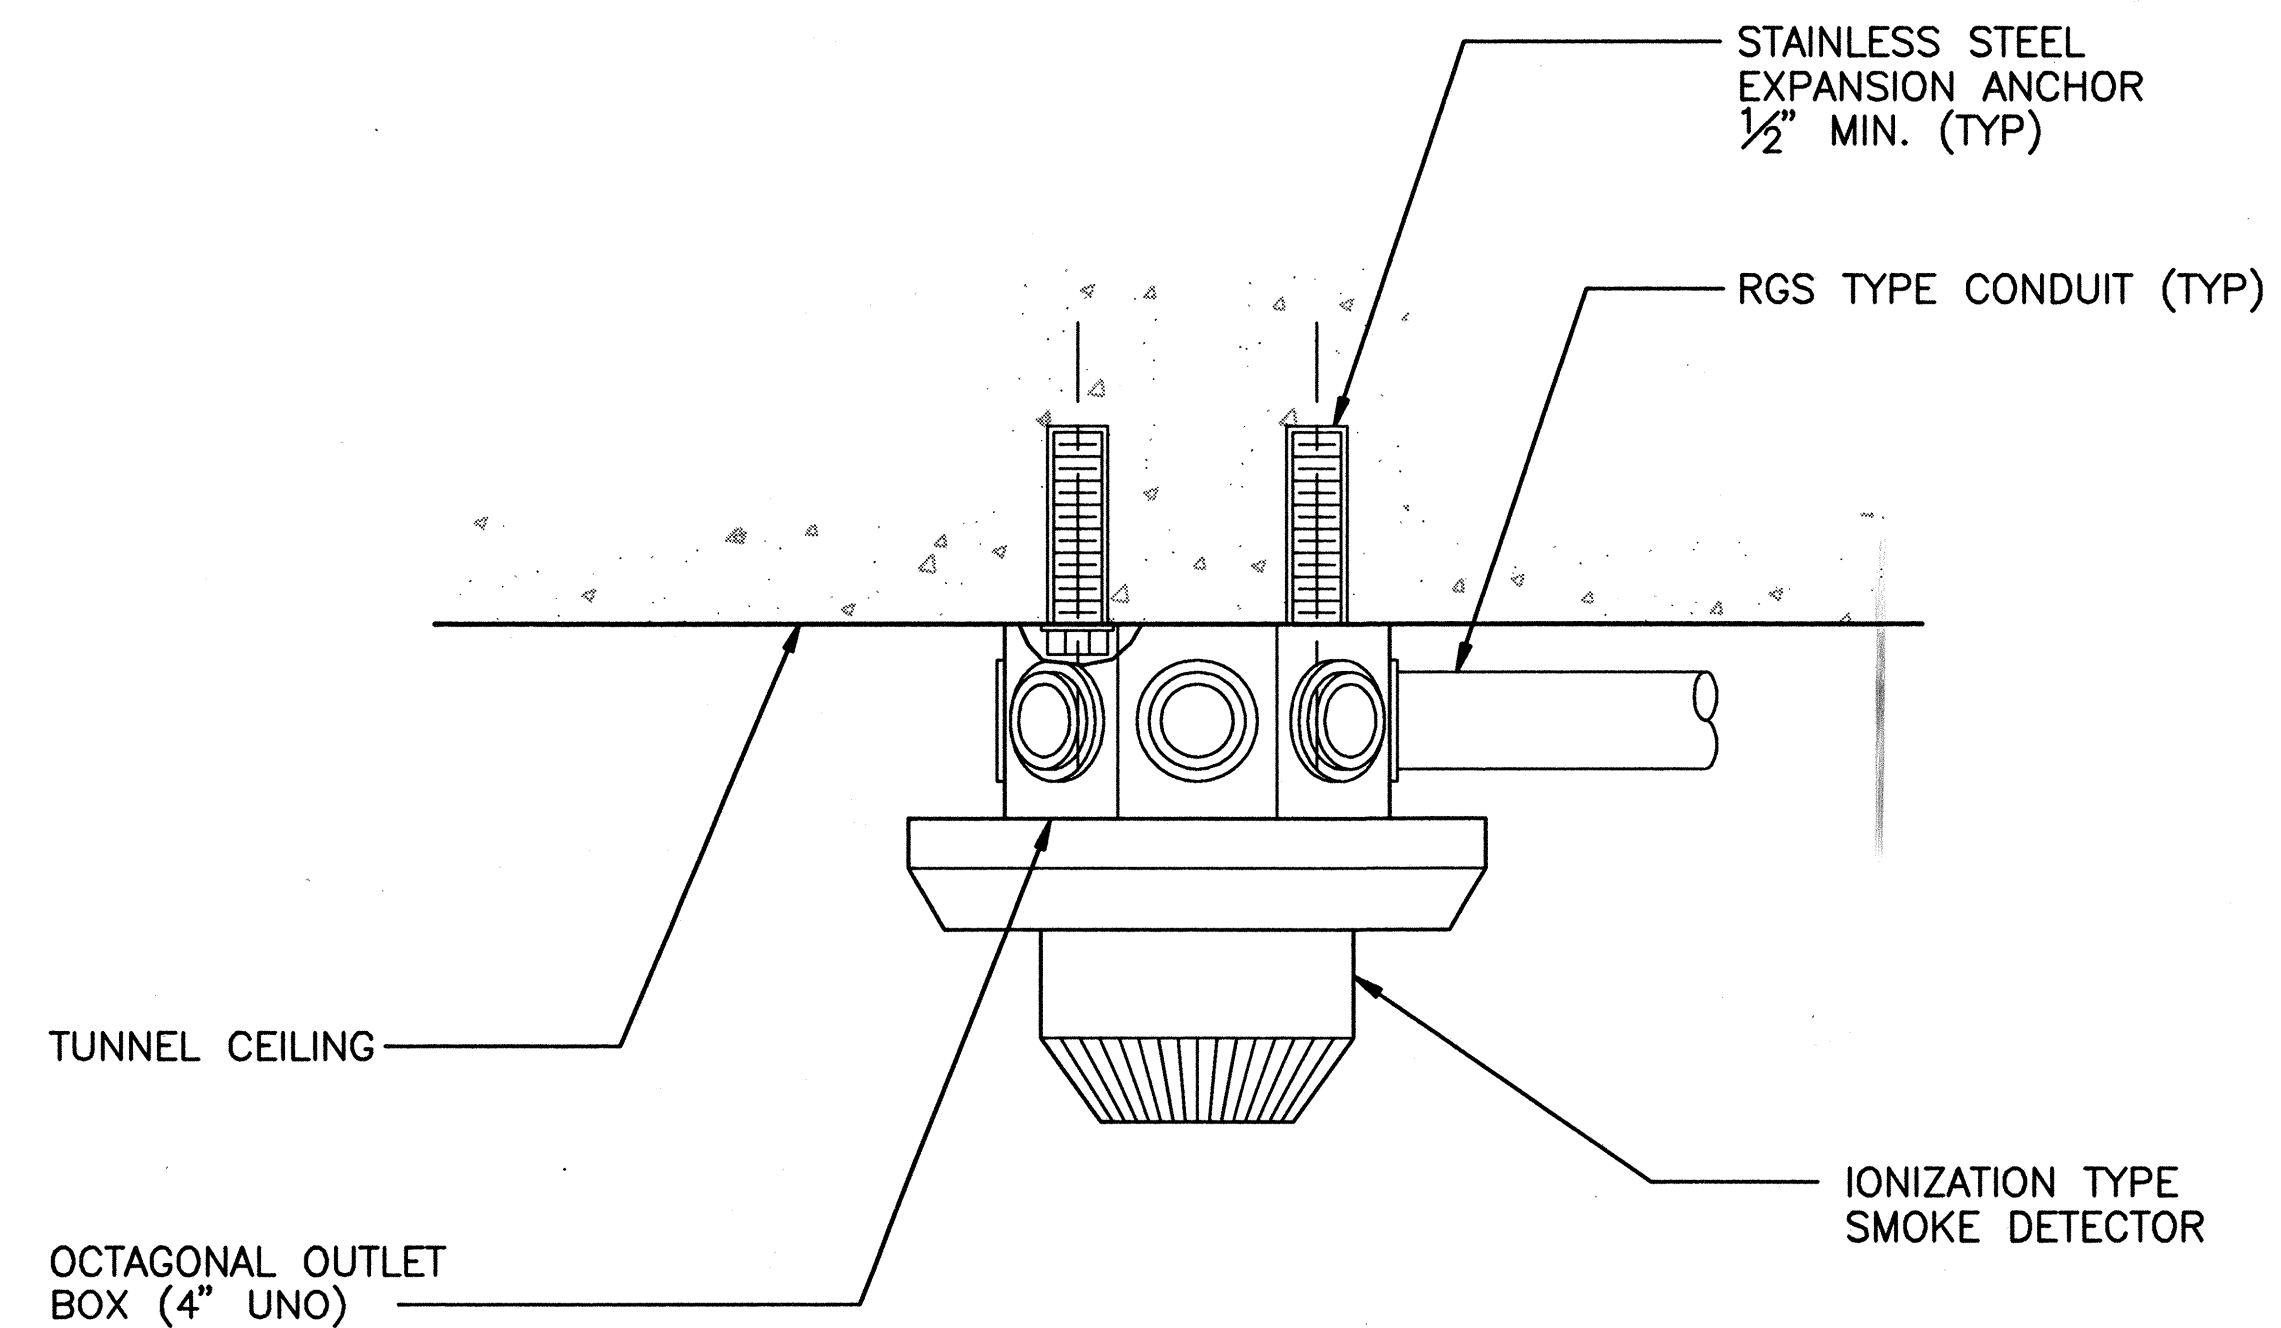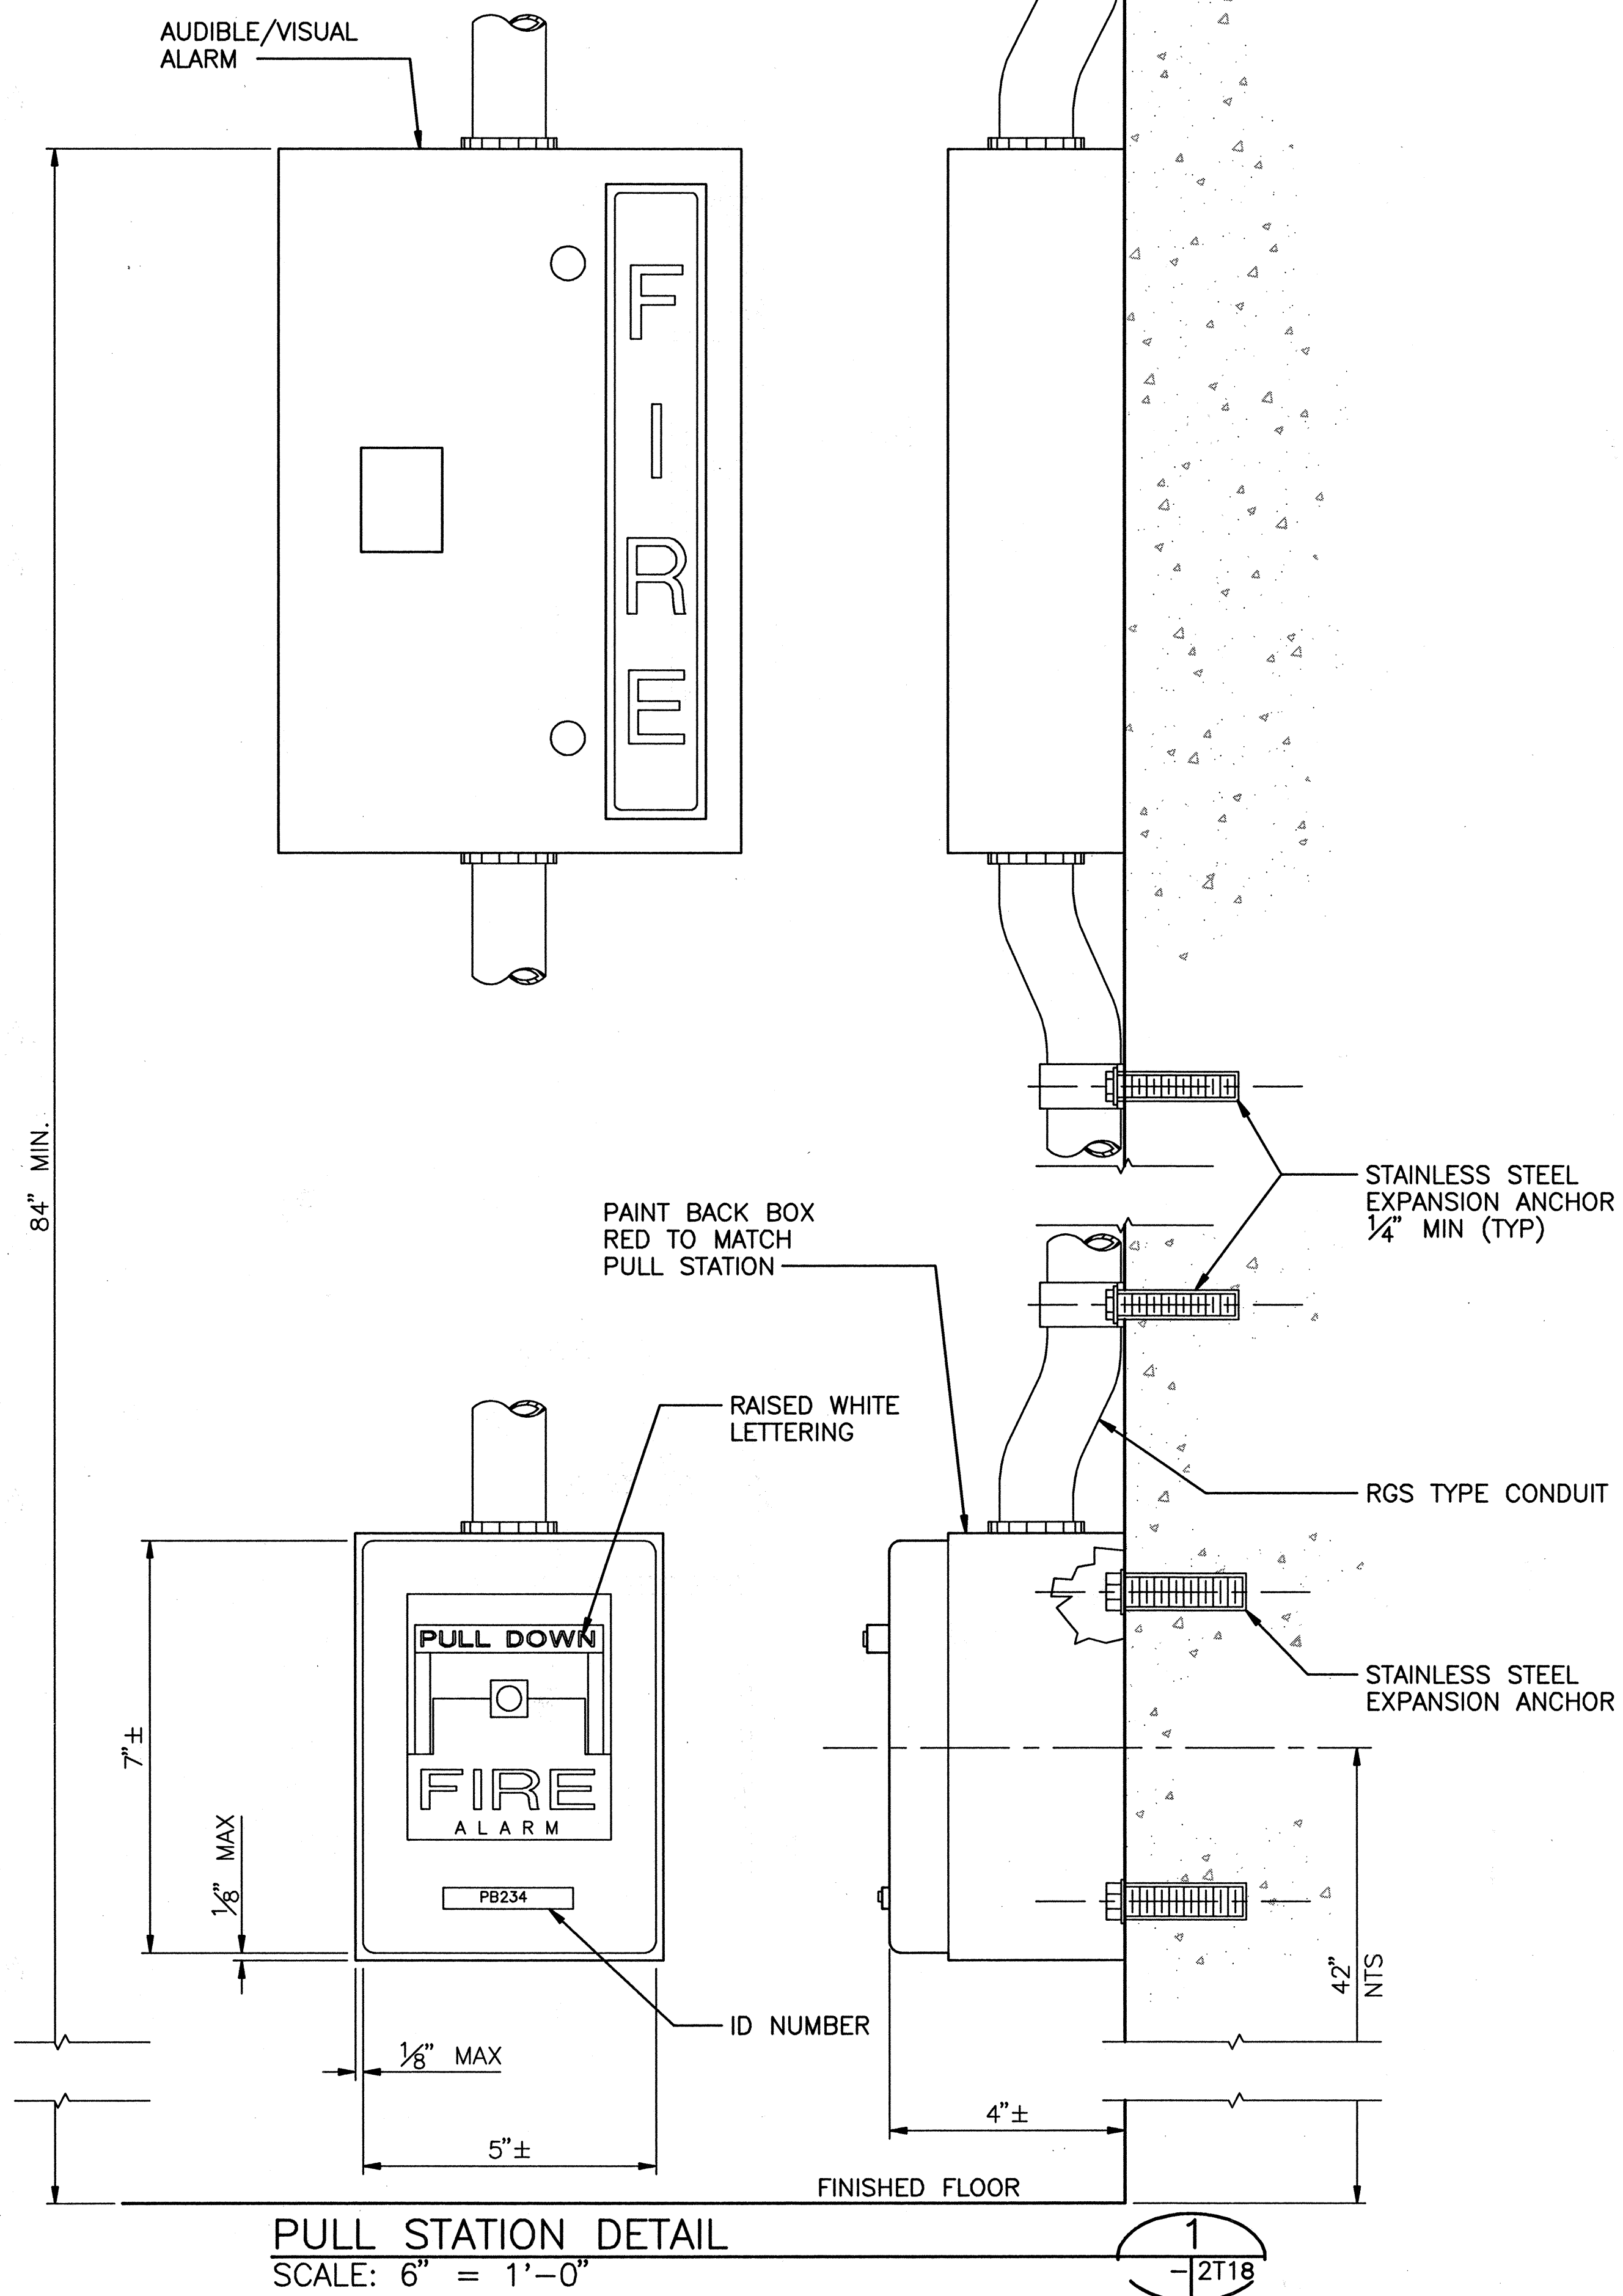

SMOKE DETECTOR CONNECTION –
SURFACE MOUNTED

SCALE: 6" = 1'-0"

$$\frac{2}{-2T1}$$

ORIGINAL PLAN	SURVEY PLOTTED BY DRAWN BY P. R. E. HITT	DATE " " " " " "	10/94
NOTE BOOK	DESIGNED BY L. Y. NELSON	" " " " " "	10/94
	QUANTITIES BY	" " " " " "	
	CHECKED BY	" " " " " "	
No. _____			

DATE	REVISION

STATE OF HAWAII
 DEPARTMENT OF TRANSPORTATION
 HIGHWAYS DIVISION

MISCELLANEOUS DETAILS — 4

SYSTEMS

EXPLORATORY TUNNEL IMPROVEMENTS


H-3 FINISH (UNIT III)

FAIP NO. I-H3-1(75), UNIT III

T.K. TUNNEL/ACCESS ROADS

SCALE: 6" = 1'-0" DATE: JUN 1995

SHEET NO. 2T18 OF 21 SHEETS

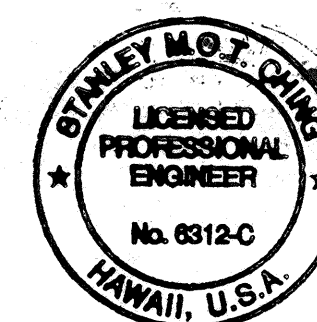

THIS WORK WAS PREPARED BY ME
OR UNDER MY SUPERVISION
Stanley M. O.T. Chu


GRAPHIC SCALE:

2" 1" 0" 2"


6" = 1'-0"

FED. ROAD DIST. NO.	STATE	FED. AID PROJ. NO.	FISCAL YEAR	SHEET NO.	TOTAL SHEETS
HAWAII	HAW.	1-H3-1(75) UNIT III	1994	121	353

XREF LIST:
ET-BRDR
SCALE24

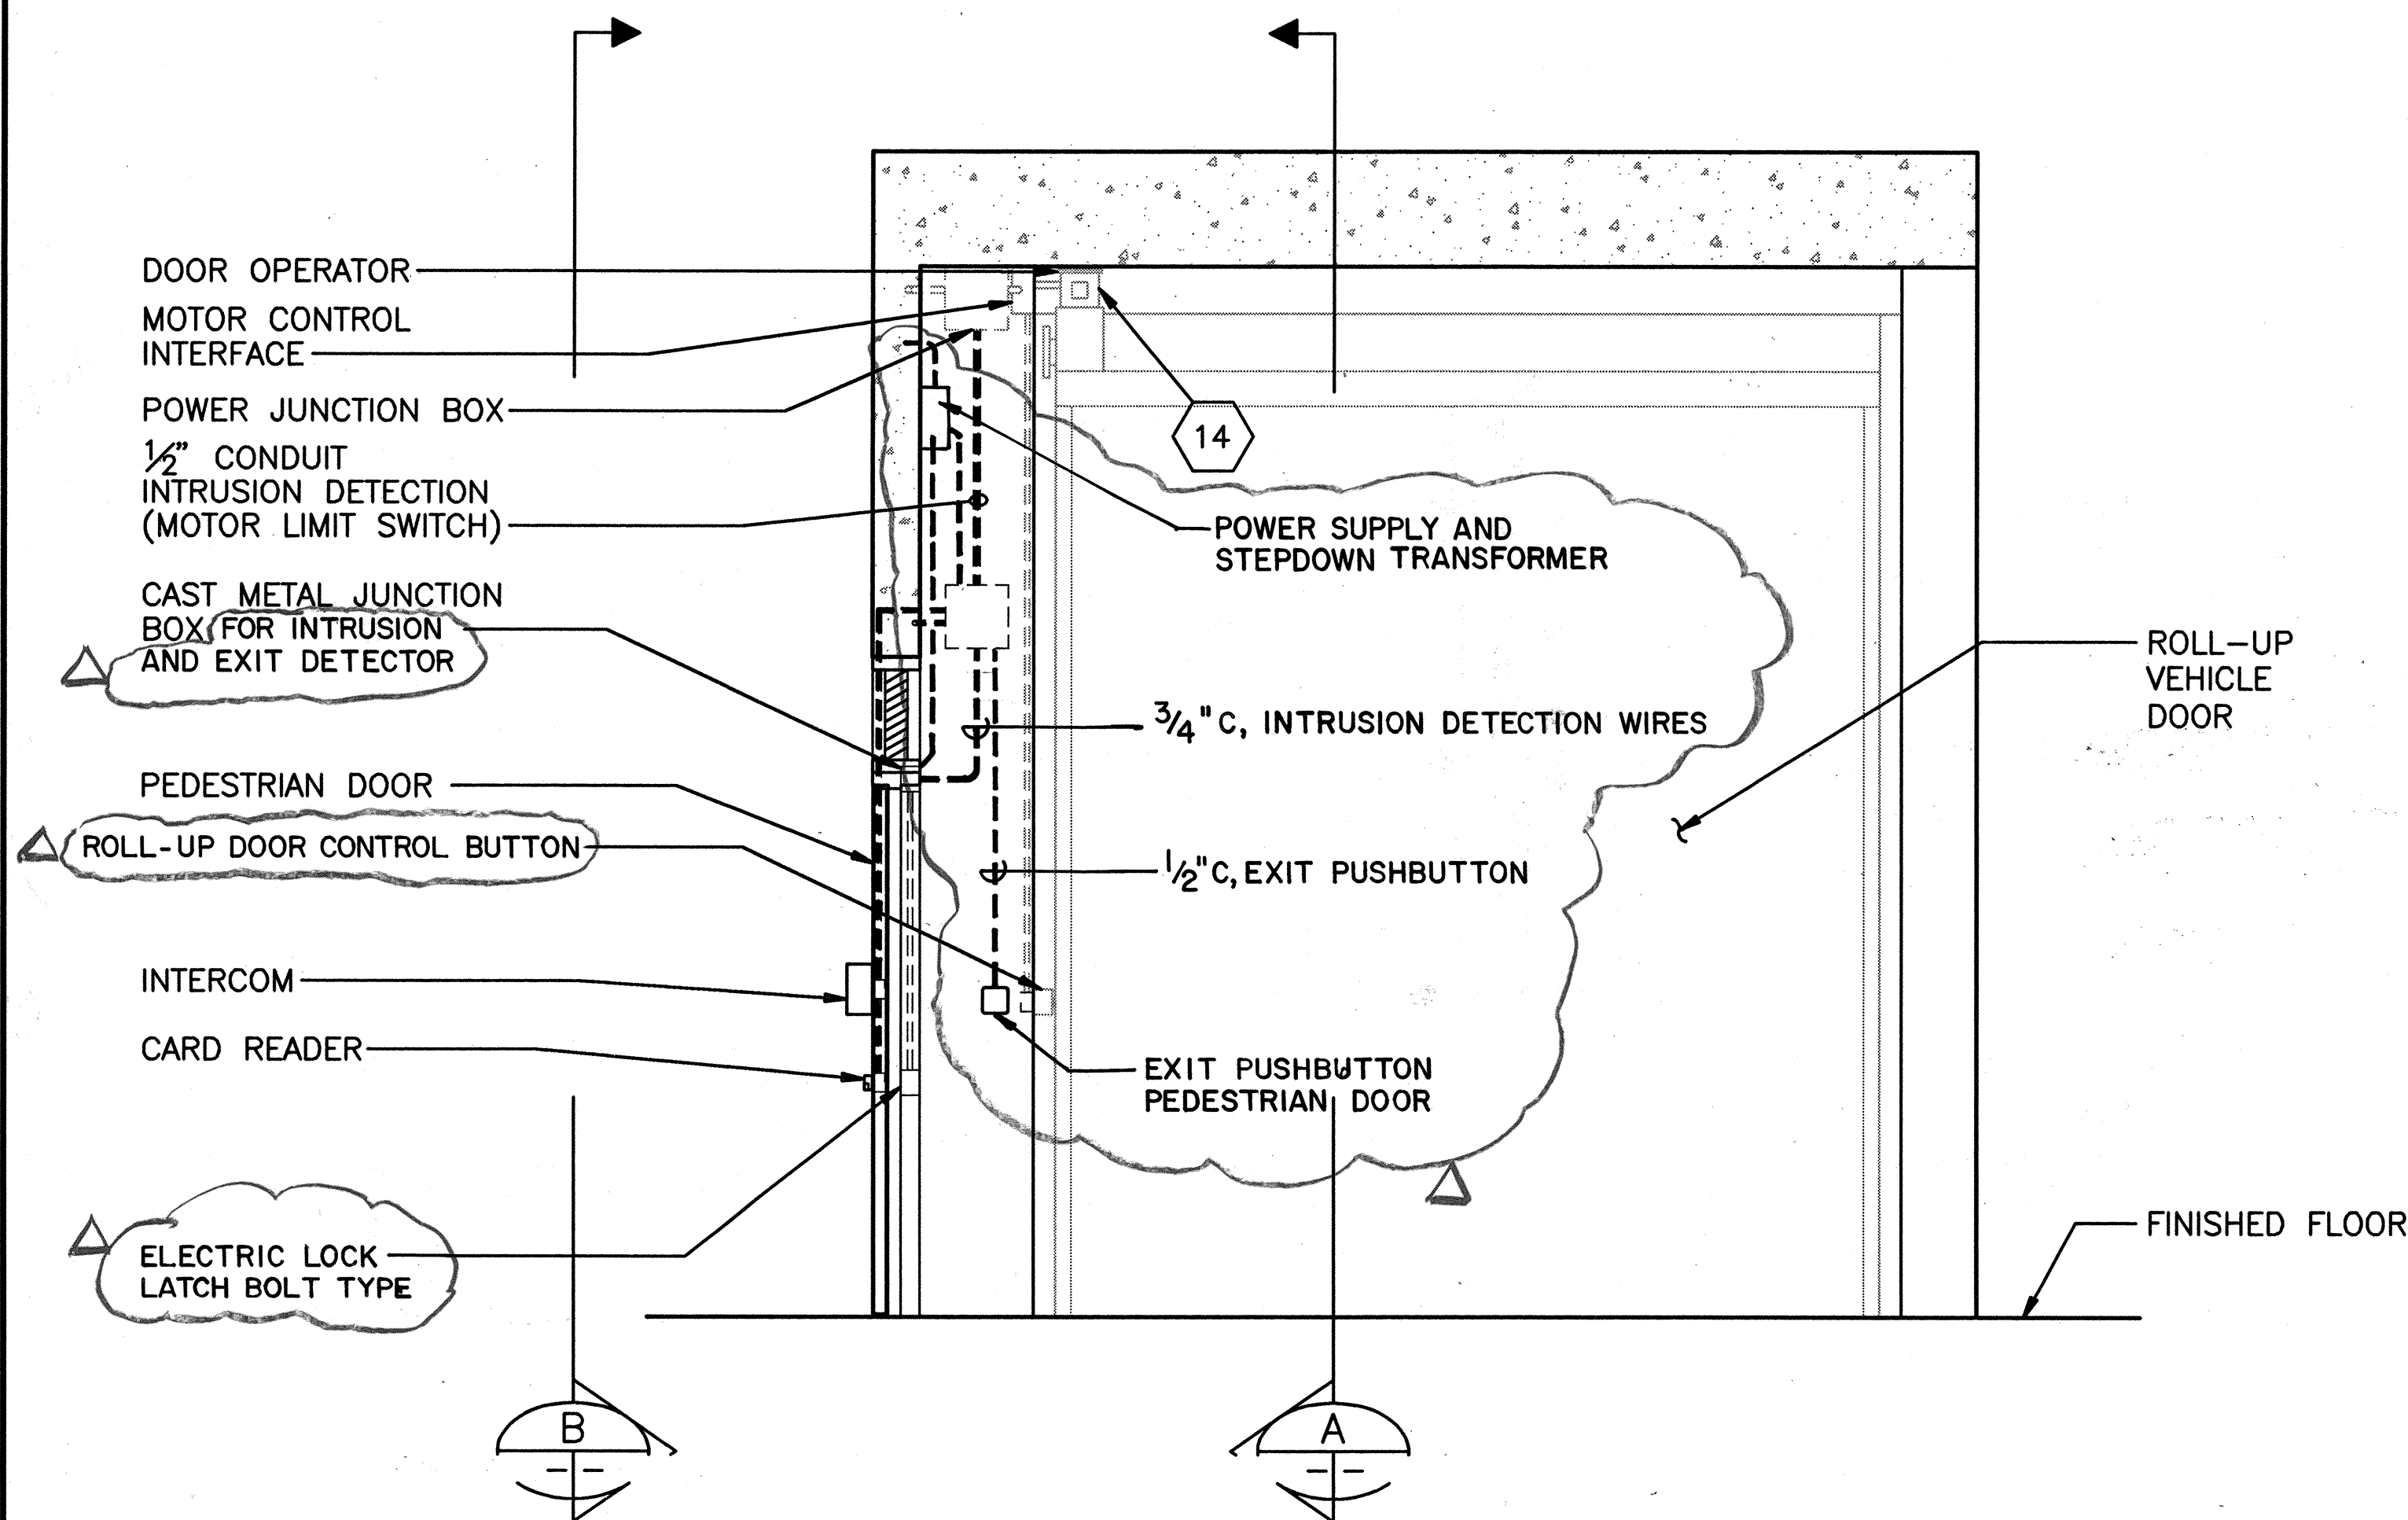


CARD KEY ACCESS DETAIL
SCALE: 1/2" = 1'-0"
1
2T10/2T19

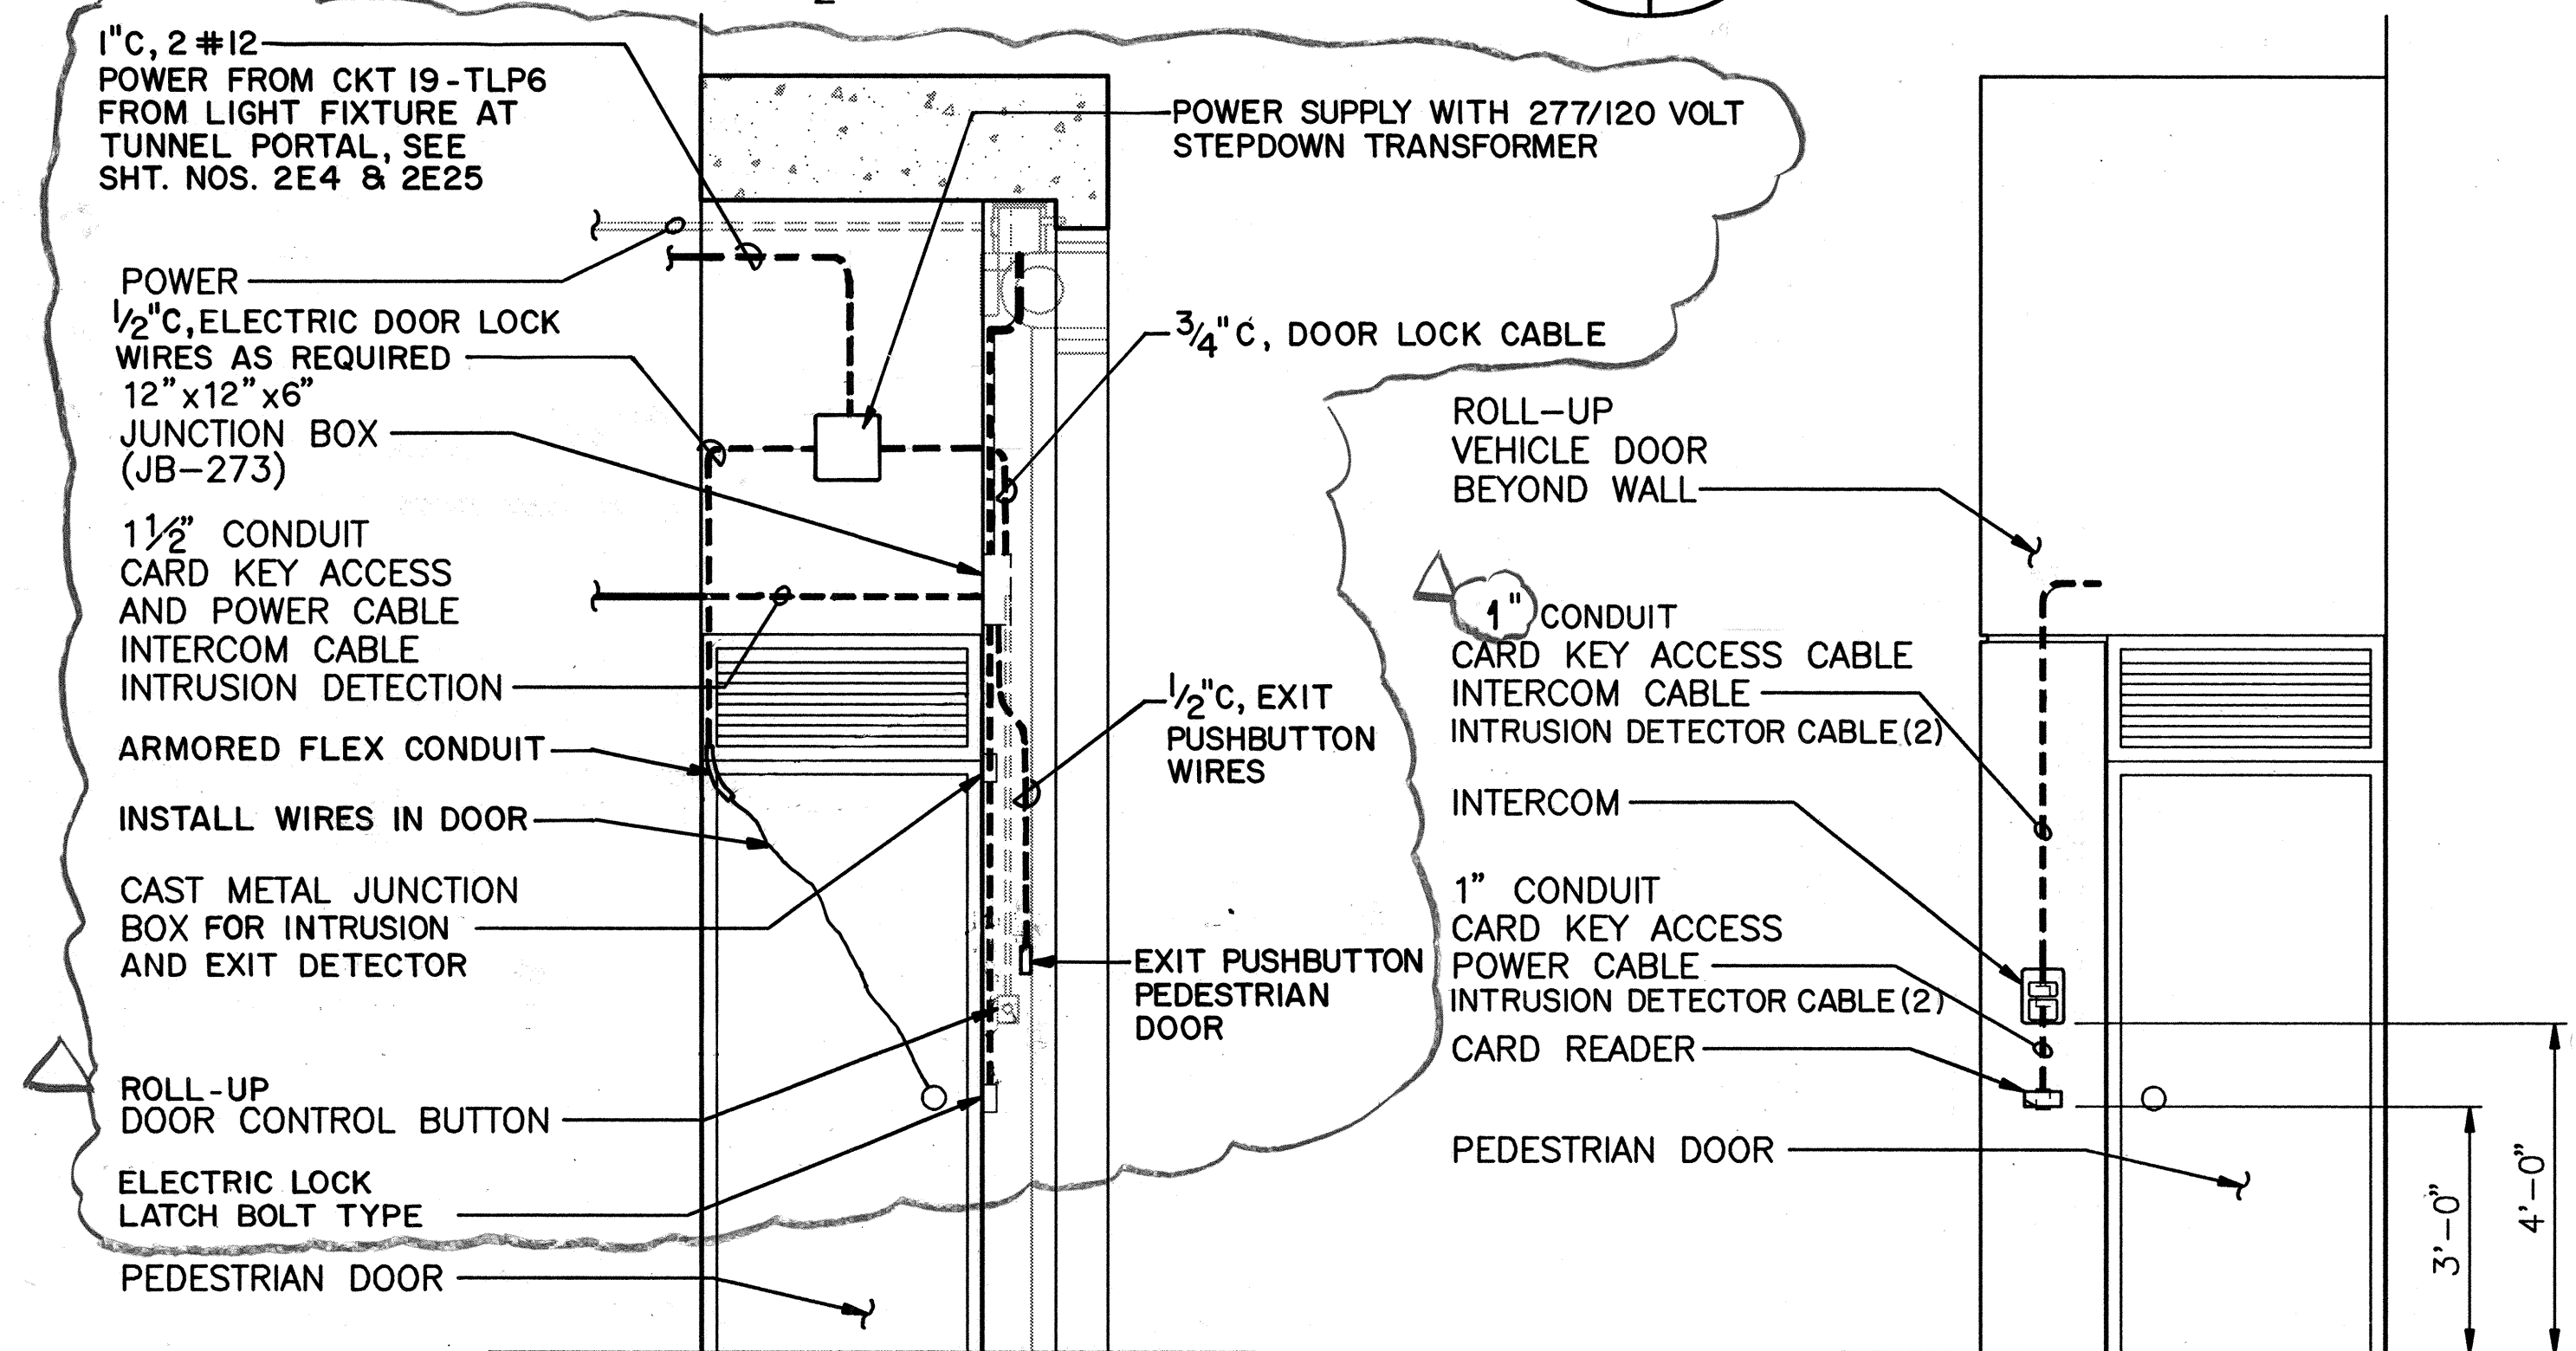


ELEVATION
SCALE: 1/2" = 1'-0"
A

ELEVATION
SCALE: 1/2" = 1'-0"
B

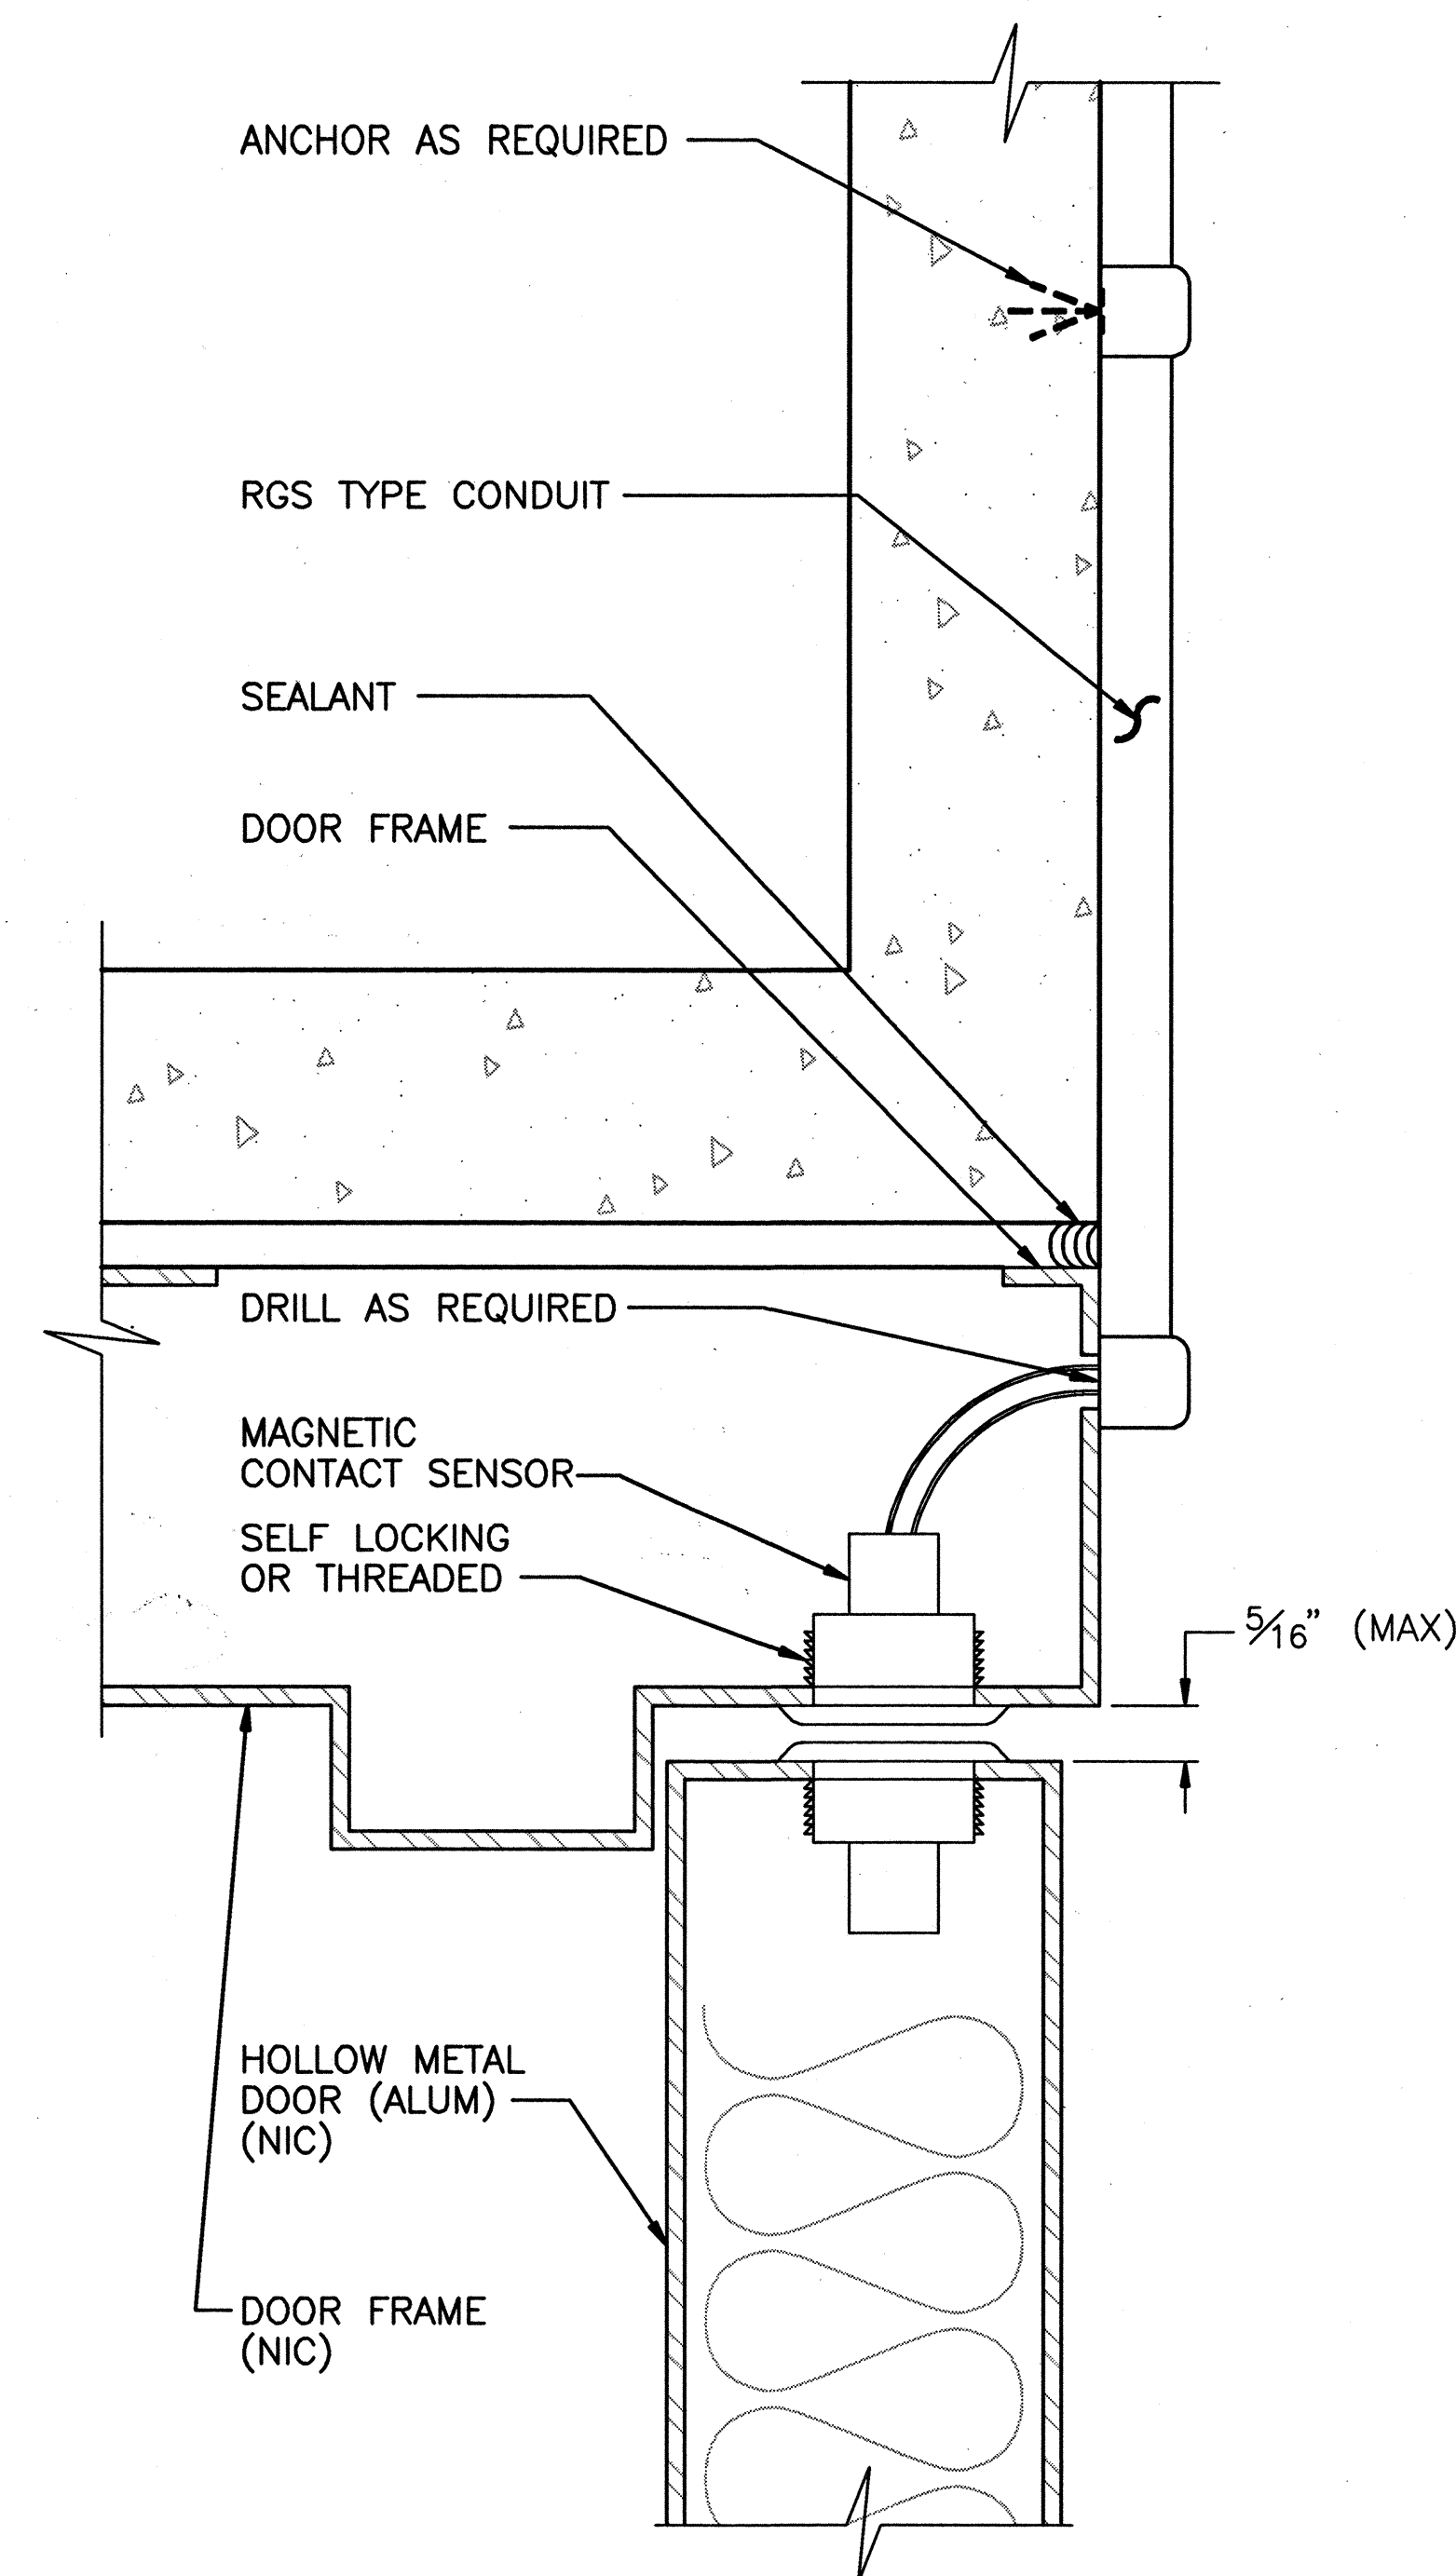

MAGNETIC DOOR CONTACT
(TYPICAL)
2
-2T19

- NOTES:
1. SEE SHEET NO. 3T7 FOR INTRUSION ALARM SYSTEM TYPICAL WIRING DIAGRAM.

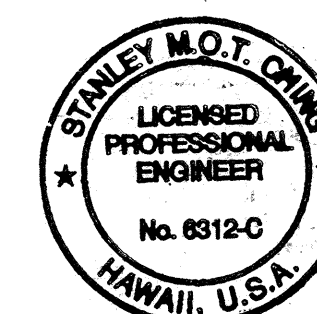


THIS WORK WAS PREPARED BY ME
OR UNDER MY SUPERVISION
Stanley M.O.T. Ching

GRAPHIC SCALE:
2' 1' 0' 2' 4'
1/2" = 1'-0"

5/29/97	DCN 75-019: ADDED ELECTRIC DOOR LOCK WIRING
DATE	REVISION
STATE OF HAWAII DEPARTMENT OF TRANSPORTATION HIGHWAYS DIVISION	
MISCELLANEOUS DETAILS - 5	
SYSTEMS	
EXPLORATORY TUNNEL IMPROVEMENTS	
H-3 FINISH (UNIT III)	
FAIP NO. 1-H3-1(75), UNIT III	
T.K. TUNNEL/ACCESS ROADS	
SCALE: AS NOTED	DATE: JUN 1995
SHEET NO. 2T19 OF 21 SHEETS	


FED. ROAD DIST. NO.	STATE	FED. AID PROJ. NO.	FISCAL YEAR	SHEET NO.	TOTAL SHEETS
HAWAII	HAW.	I-H3-1(75) UNIT III	1994	122	353

XREF LIST:
ETI-BRDR
SCALE: 24"

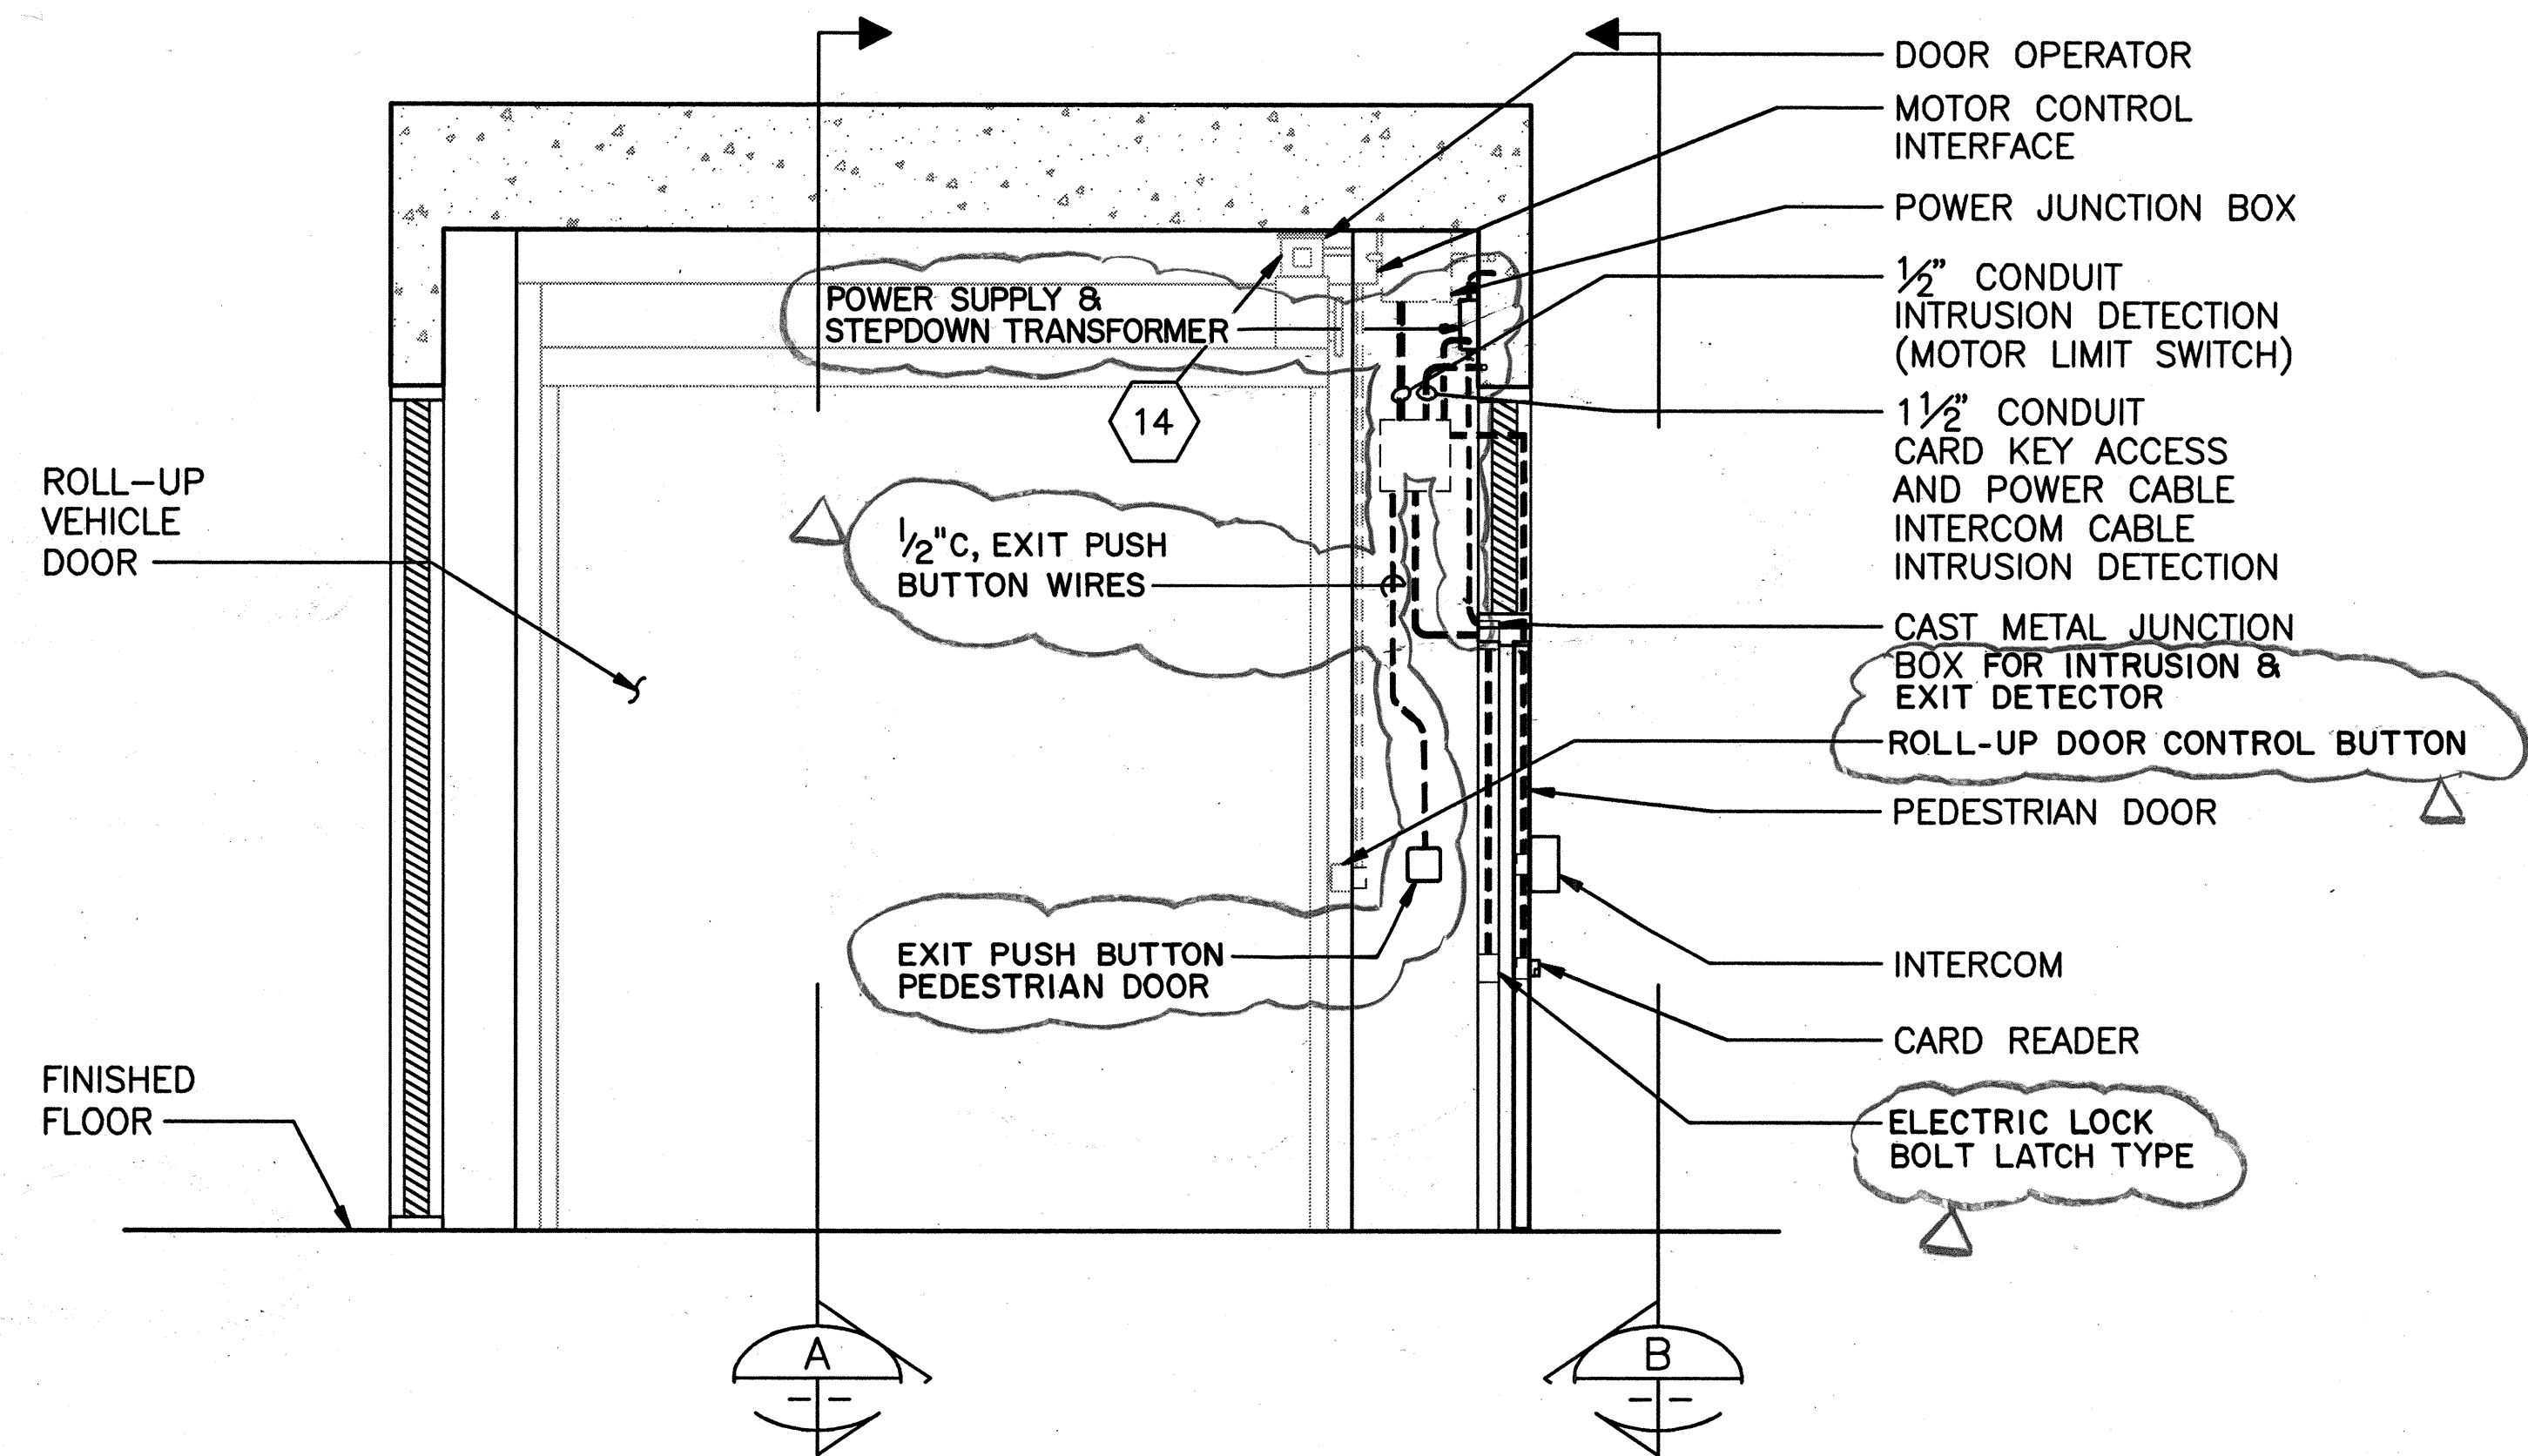


CARD KEY ACCESS DETAIL
SCALE: 1/2" = 1'-0"


1
2T11|2T20

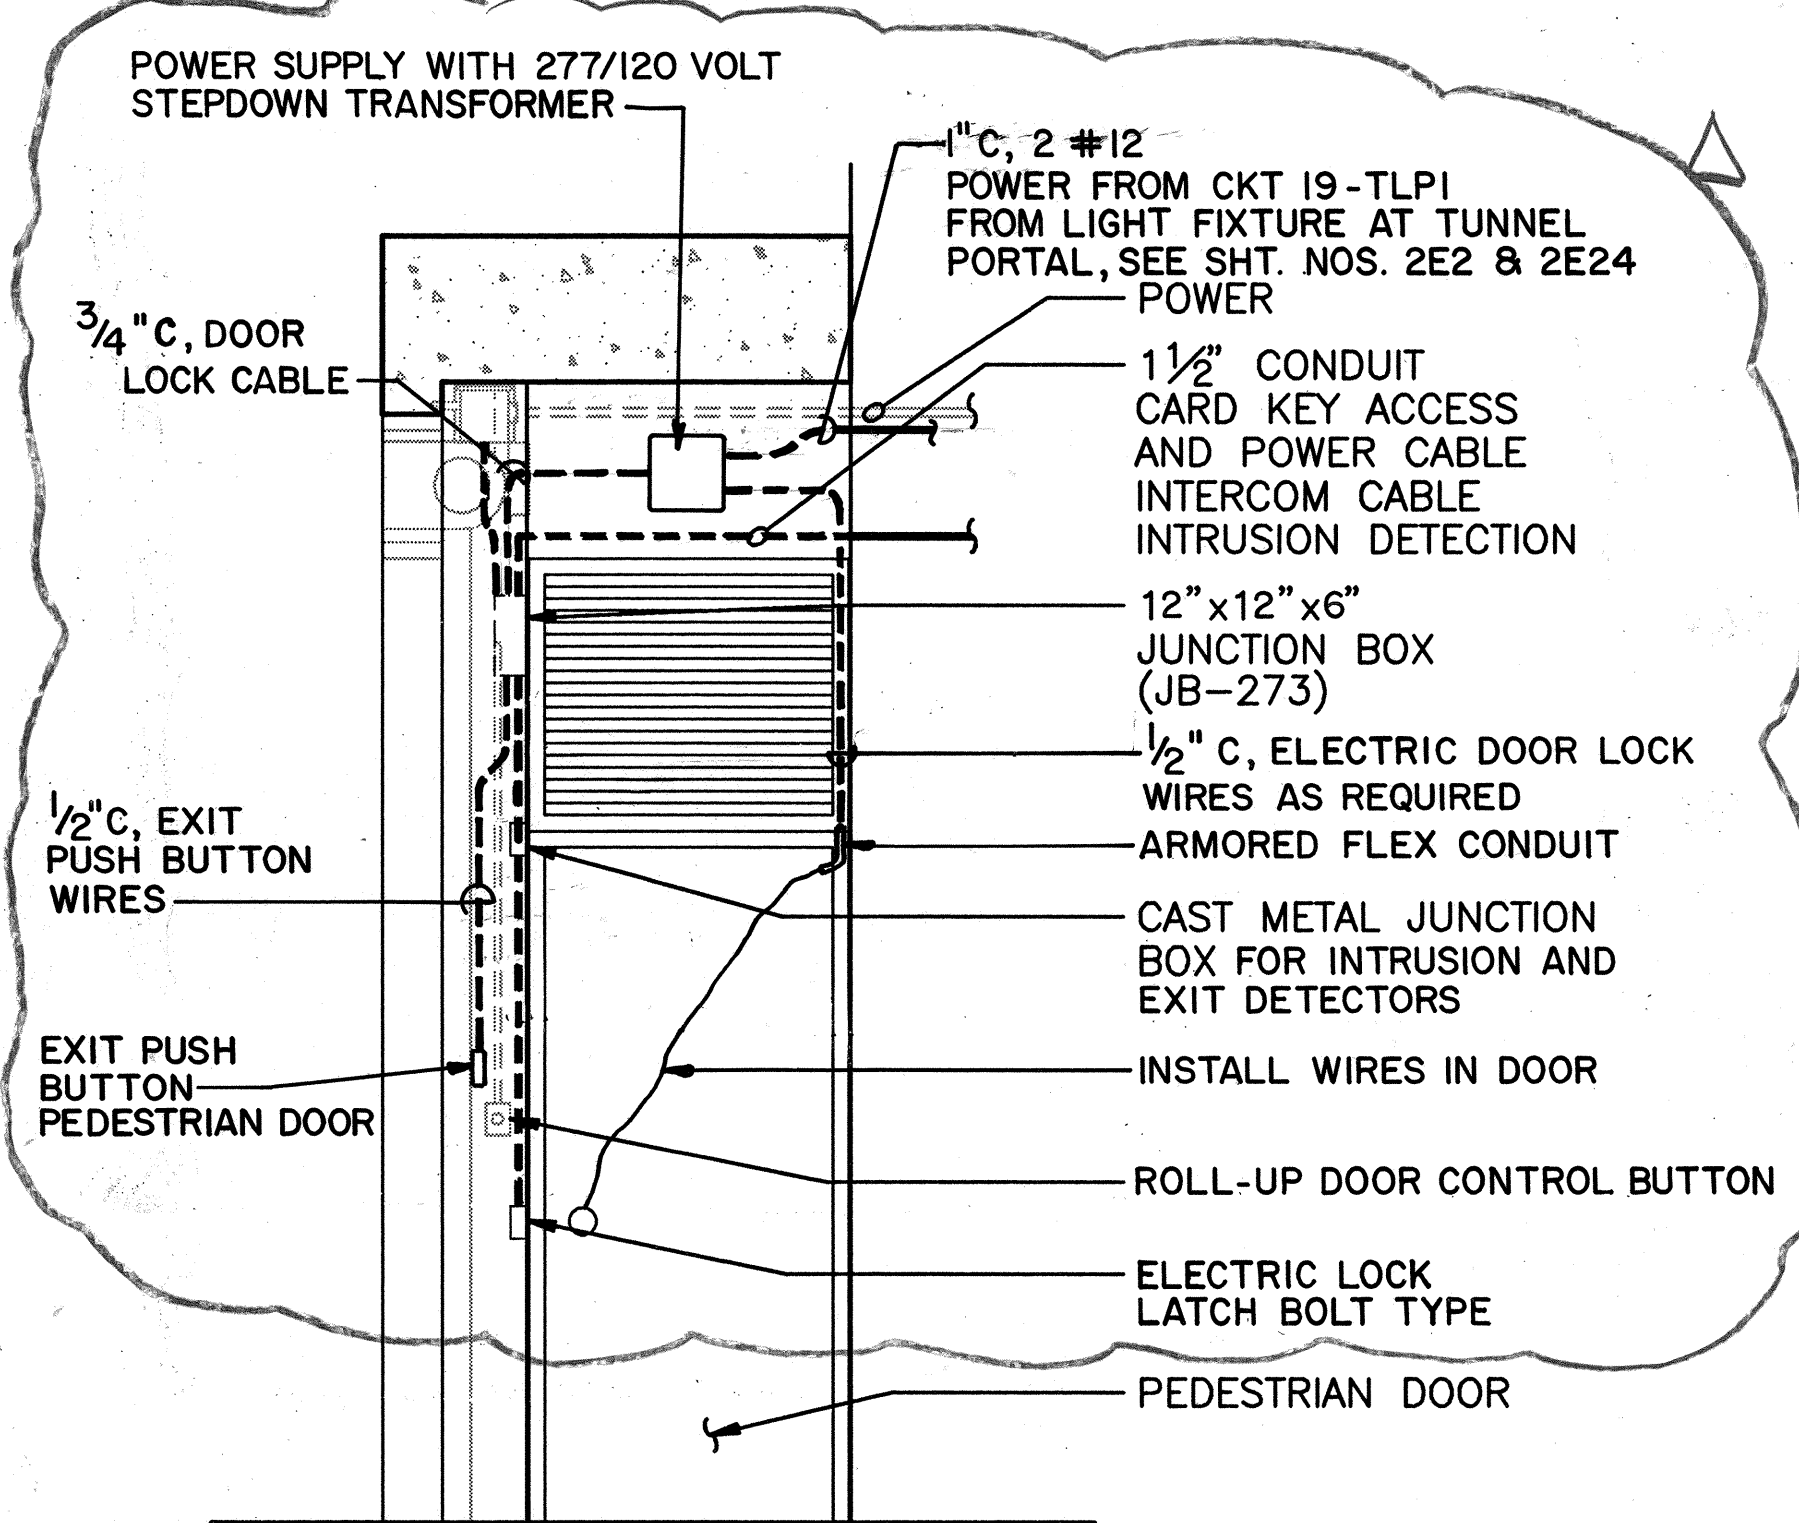

ELEVATION A
SCALE: 1/2" = 1'-0"

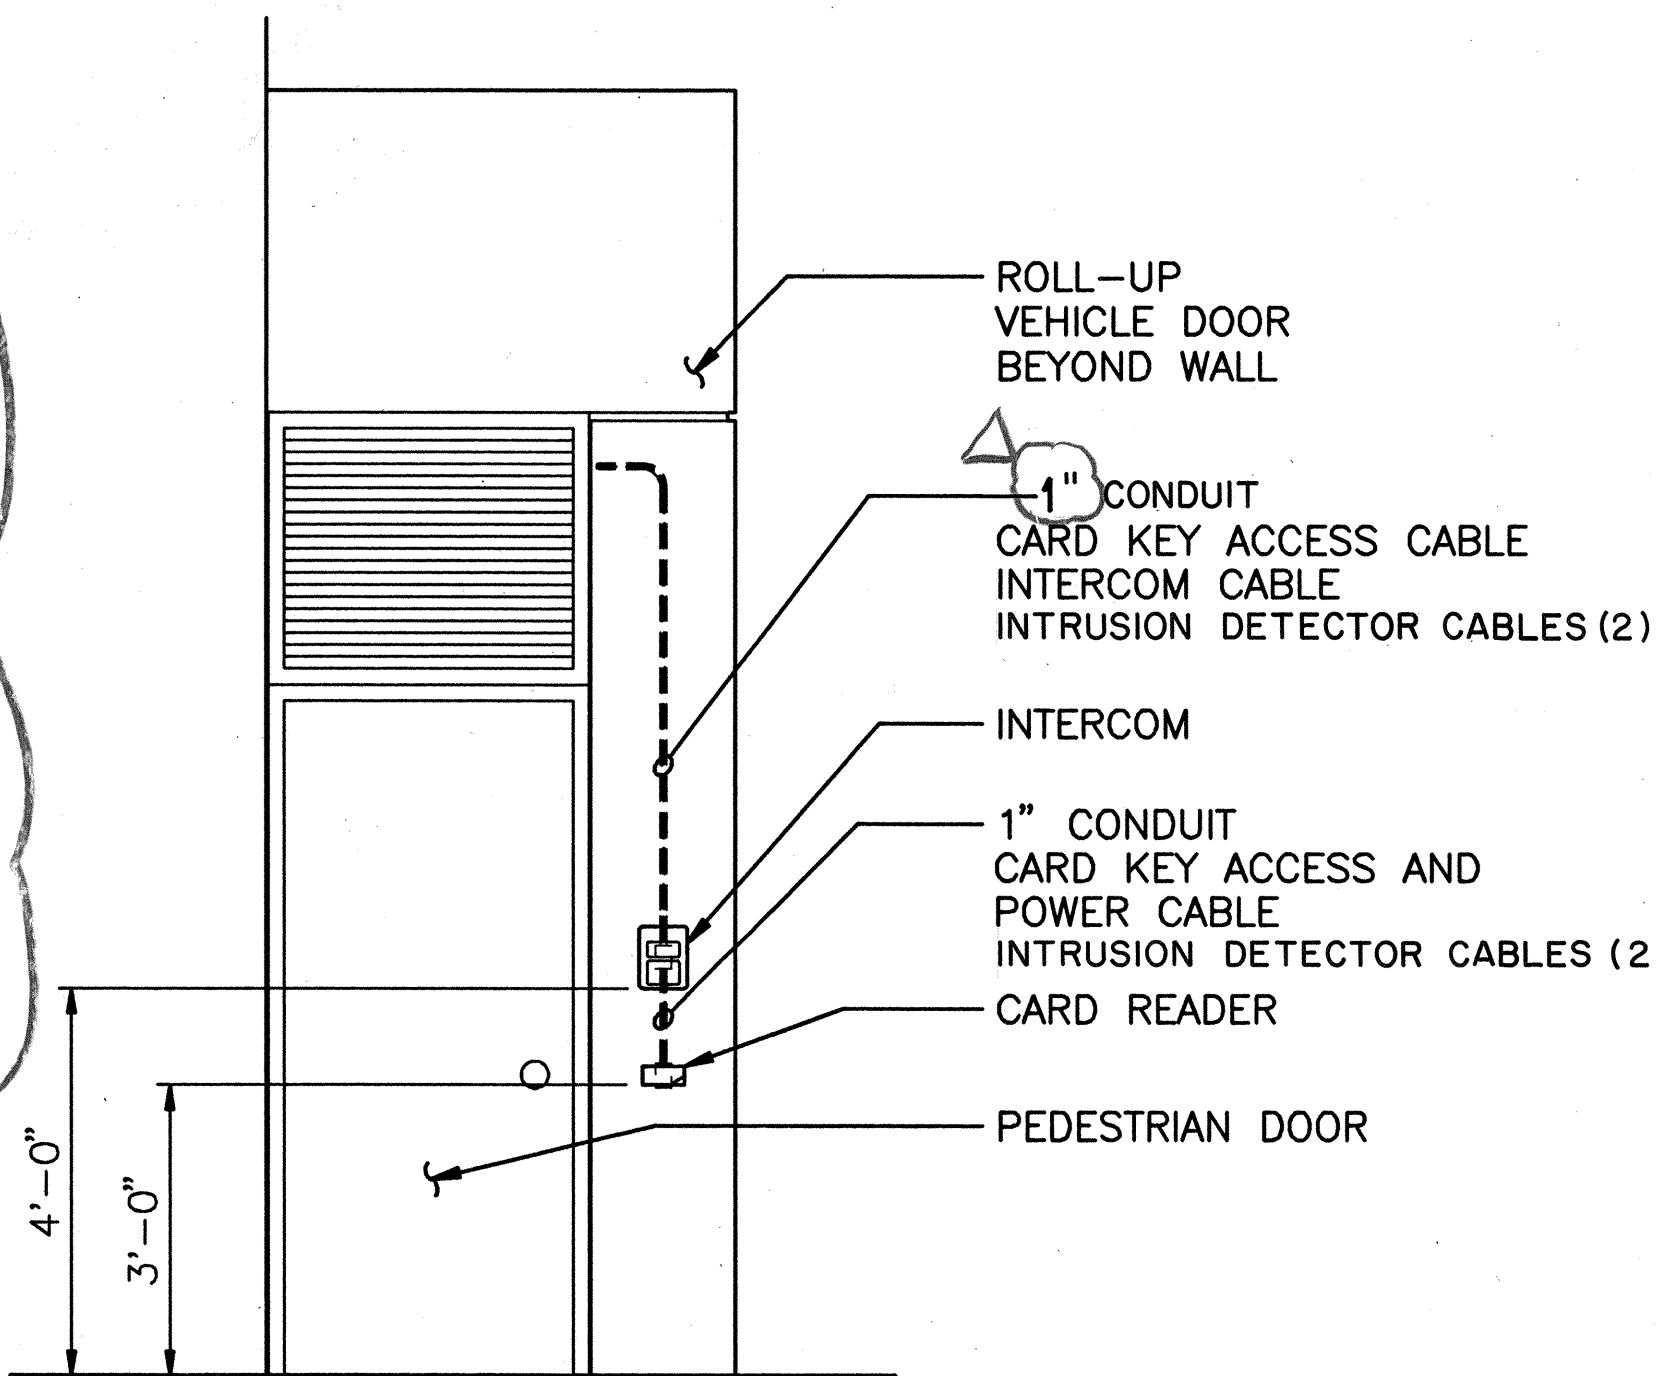




ELEVATION B
SCALE: 1/2" = 1'-0"

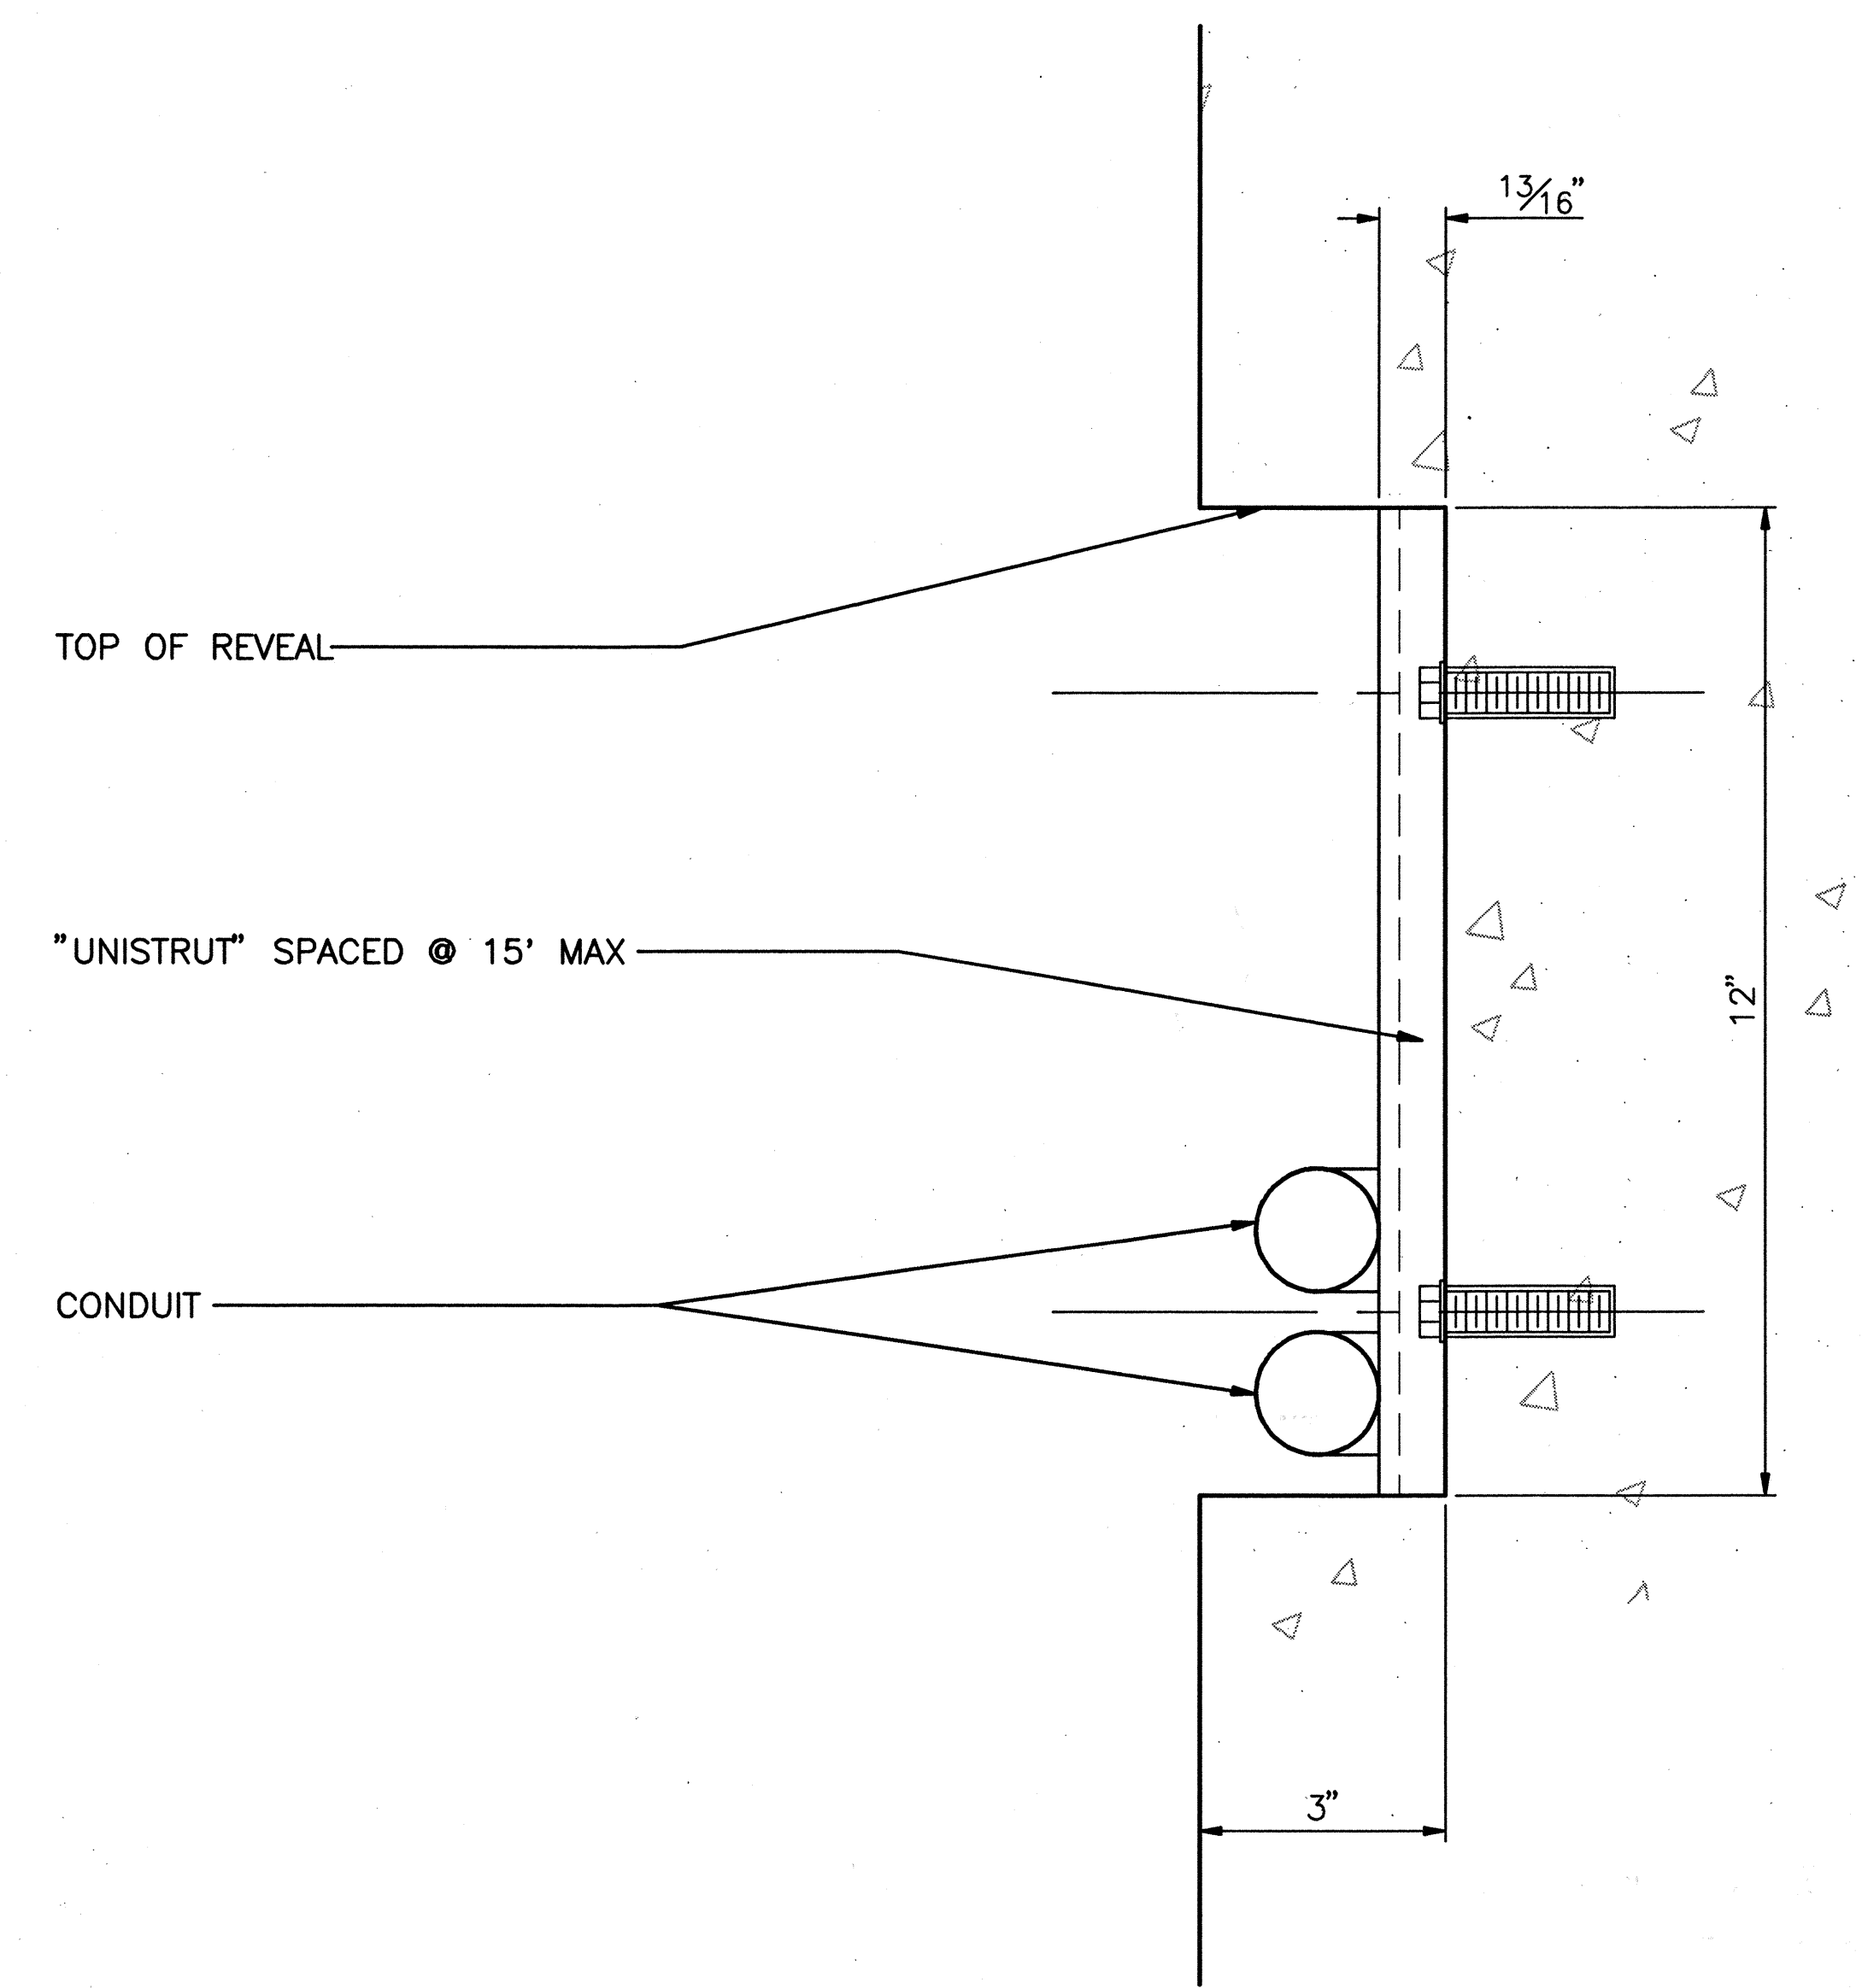

SECTION @ REVEAL
SCALE: 6" = 1'-0"

2
2T12|2T20

NOTES:
1. SEE SHEET NO. 3T7 FOR INTRUSION ALARM SYSTEM TYPICAL WIRING DIAGRAM.

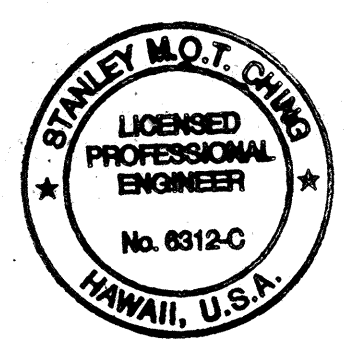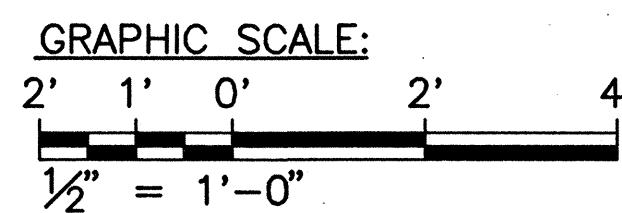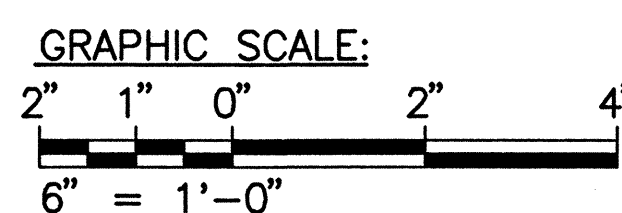


THIS WORK WAS PREPARED BY ME OR UNDER MY SUPERVISION
Stanley M.O. Ching

5/29/97	DCN75-019: ADDED ELECTRIC DOOR LOCK WIRING
DATE	REVISION
STATE OF HAWAII DEPARTMENT OF TRANSPORTATION HIGHWAYS DIVISION	
MISCELLANEOUS DETAILS - 6	
SYSTEMS	
EXPLORATORY TUNNEL IMPROVEMENTS	
H-3 FINISH (UNIT III)	
FAIP NO. I-H3-1(75), UNIT III	
T.K. TUNNEL/ACCESS ROADS	
SCALE: 1/2" = 1'-0" DATE: JUN 1995	
SHEET NO. 2T20 OF 21 SHEETS	

XREF LIST:
ETI-BRDR
SCALE2


1. MAINTAIN THE SAME DISTANCE SPACING BETWEEN THE TWO WIRES. PULL APPROXIMATELY 50 LBS. TENSION ON BOTH WIRES WHEN INSTALLING. ALLOW FOR TUNNEL EXPANSION/CONTRACTION BY PROVIDING PERIODIC LOOPS AS SHOWN IN SECTION A. PLACE LOOPS EVERY 200' TO 250' APART. MAKE LOOPS ON BOTH WIRES THE SAME SO SPACING IS CONSTANT.
2. WHEN CLAMPING WIRES TO SPACERS, USE ONLY PLASTIC TIE-WRAPPS, $7\frac{1}{2}$ " LONG BY 0.2" WIDE. TIGHTEN ENOUGH TO PREVENT SLIPPING. WHEN INSTALLING ANTENNA CABLE, CLAMP SMALL 4" LONG BY 0.15" WIDE TIE-WRAPPS DIRECTLY TO WIRE (AS SHOWN IN SECTION A) EVERY 4TH OR 5TH SPACER TO PREVENT SLIPPING. USE THESE SMALL TIE-WRAPPS IN THIS MANNER AT THE ENDS OF RADIATOR.
3. MATERIAL: SEE SPECIAL PROVISIONS FOR MATERIALS AND WIRE SIZE.
4. COORDINATE ANTENNA ROUTING WITH OTHER CEILING MOUNTED EQUIPMENT.

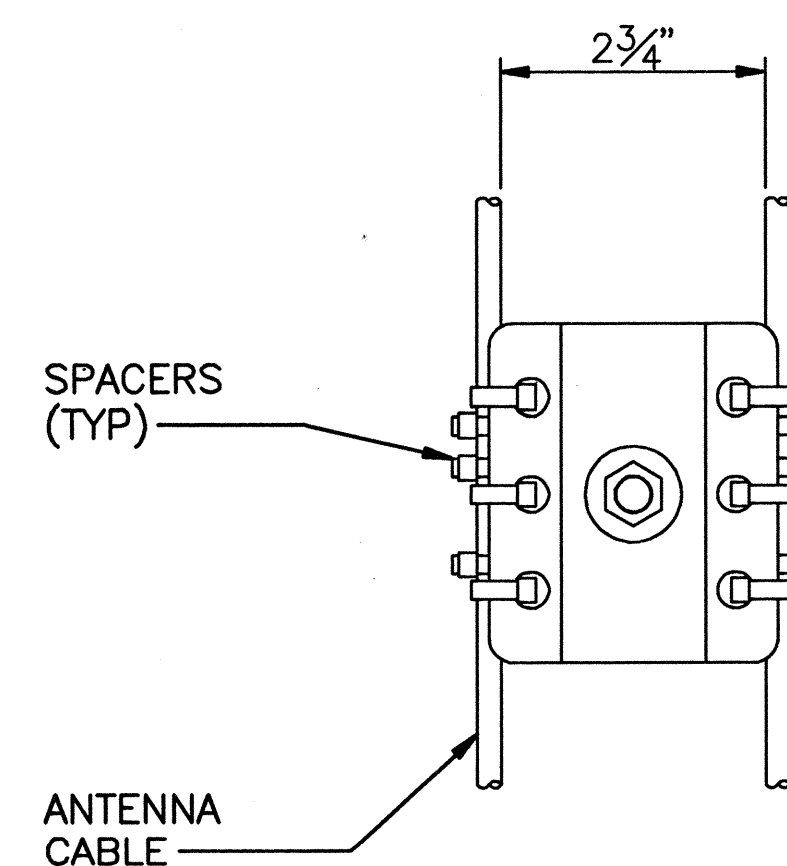

SCALE: 6" = 1'-0"



SCALE: 6" = 1'-0"

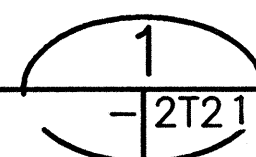

ORIGINAL PLAN	SURVEY PLOTTED BY DRAWN BY P. R. E. HITT	DATE 10/94
NOTE BOOK	TRACED BY	"
	DESIGNED BY P. L. FORDYCE	10/94
	QUANTITIES BY	"
No. _____	CHECKED BY	"



THIS WORK WAS PREPARED BY ME
OR UNDER MY SUPERVISION
Stanley M. O.T. Ch...

GRAPHIC SCALE:

